


Replaced
2002

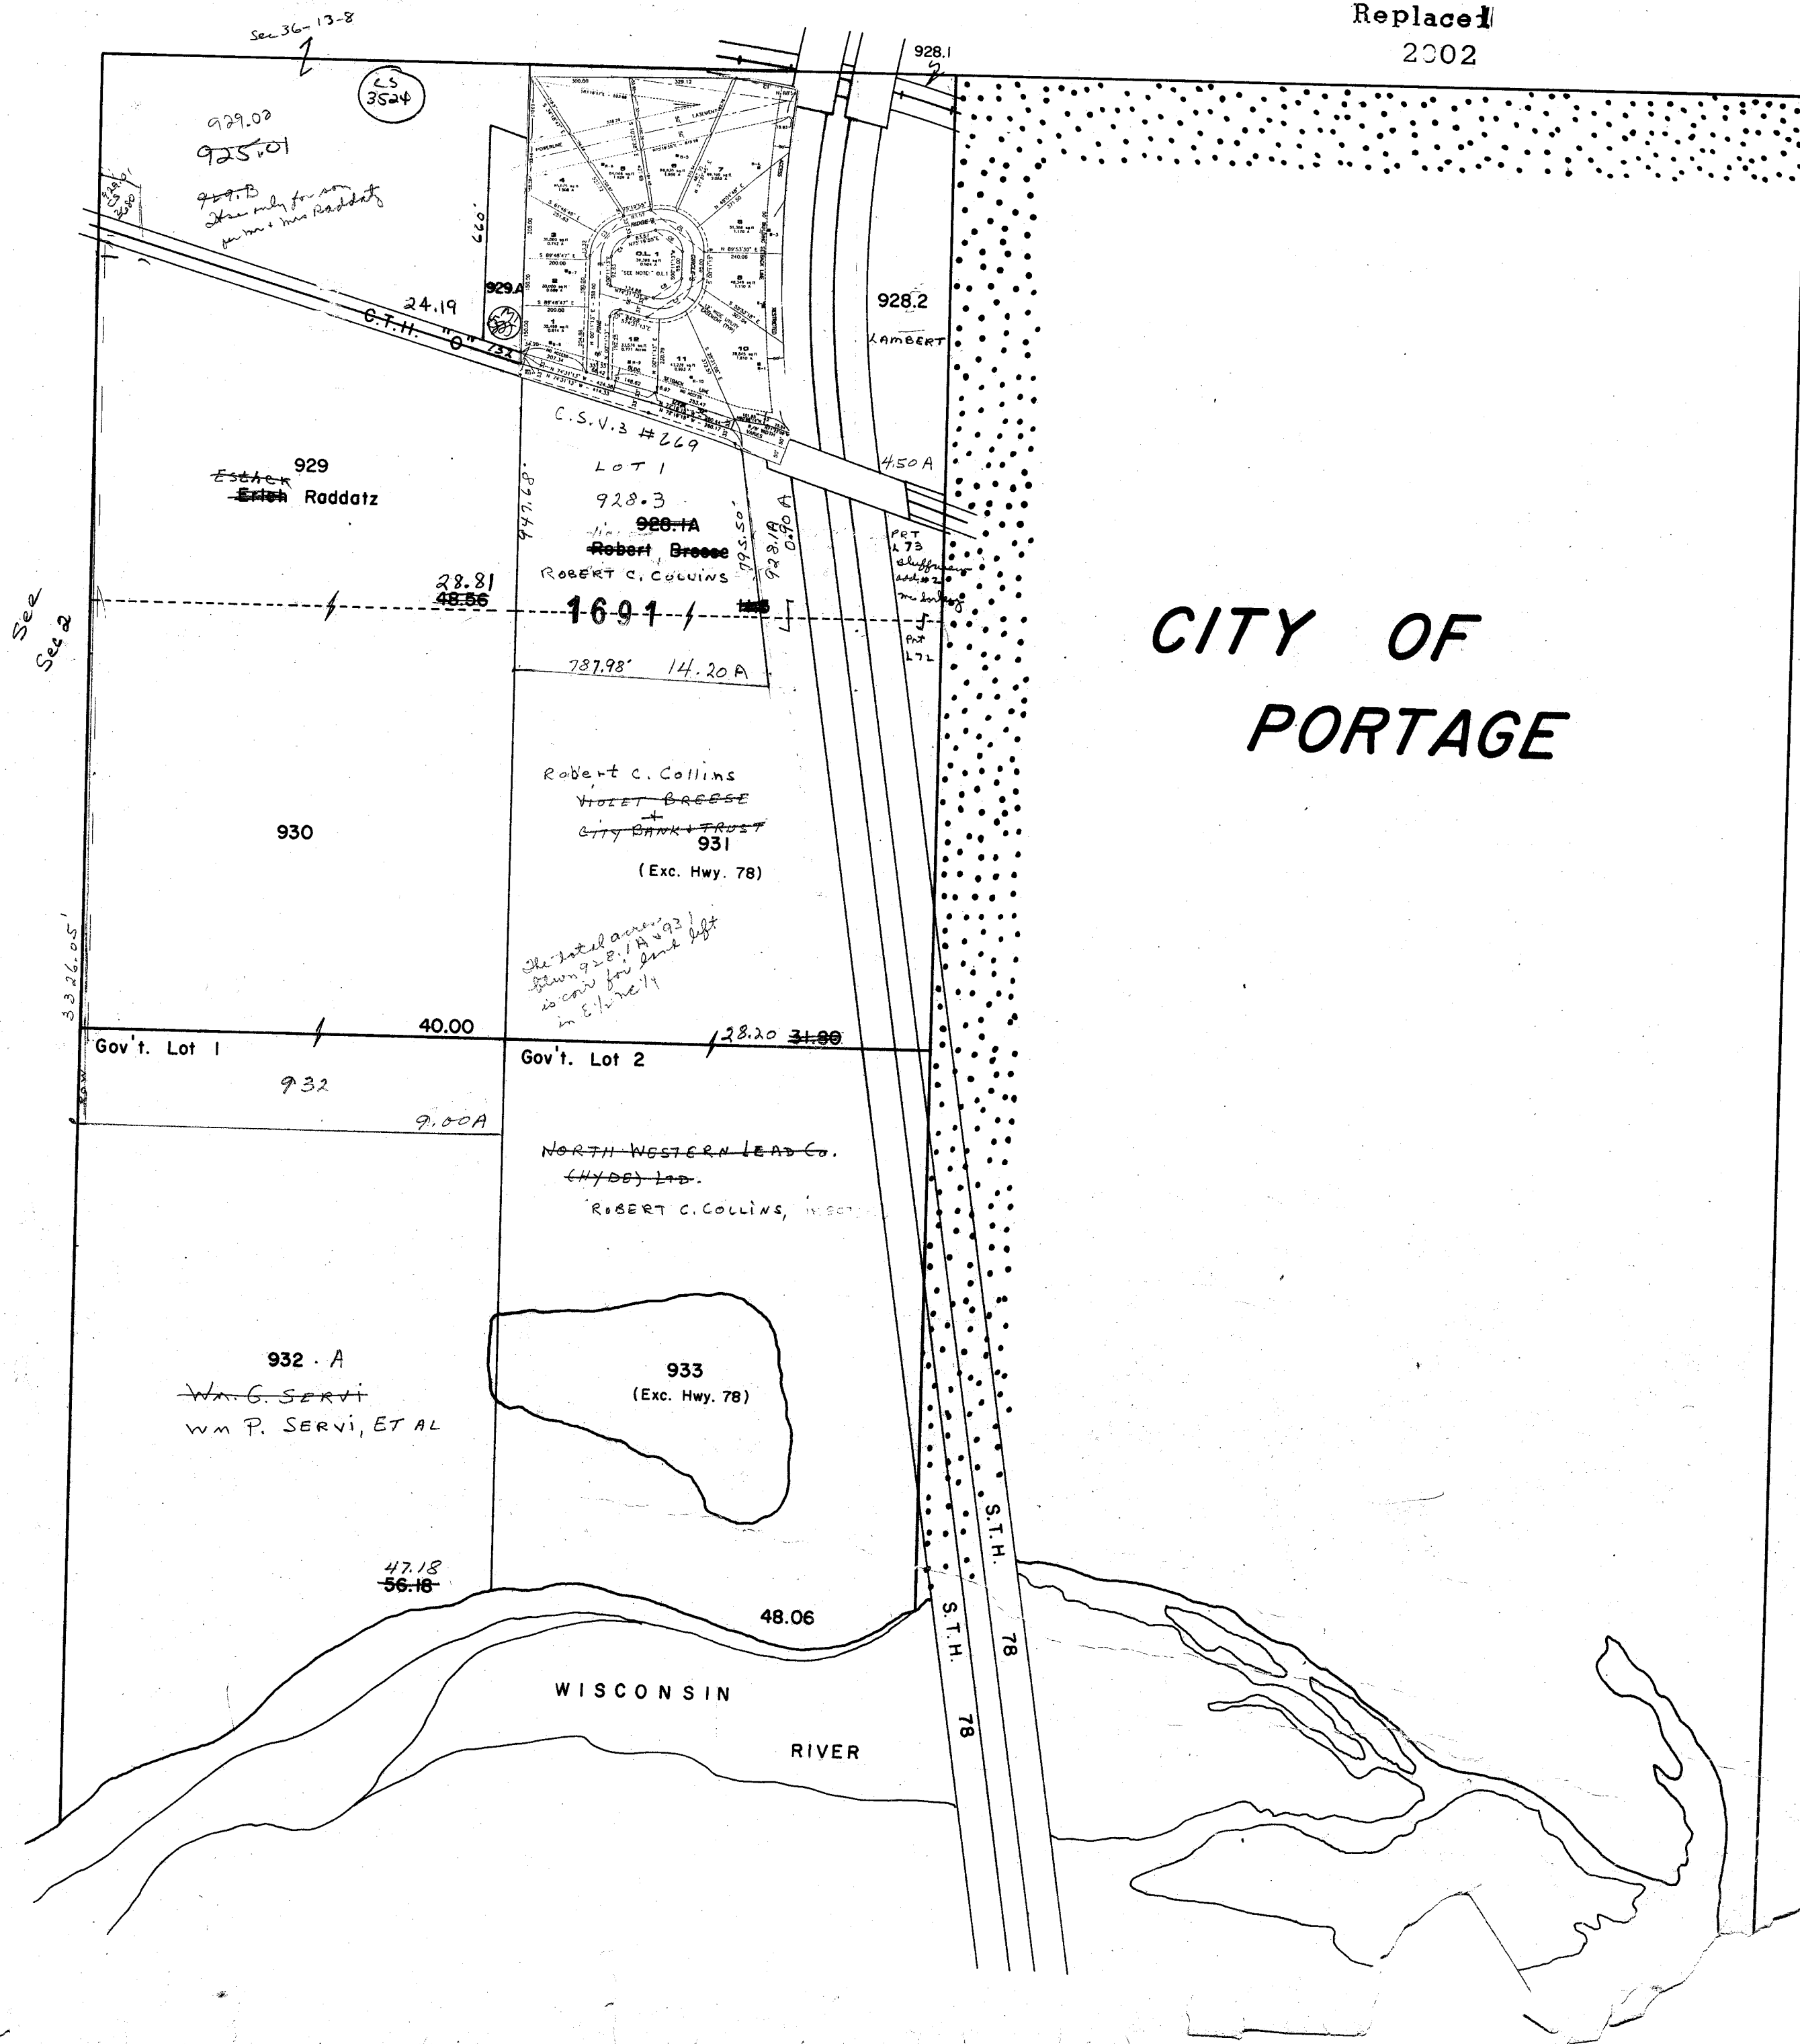

One Inch Equals Four Hundred Feet

MILES
0 1/16 1/8 1/4
FEET
0 400 800 1200 1600


NOTE: This map was prepared for assessment use in accordance with the Wis. St. Stat. Chap. 70.09. All information contained herein is advisory only. Map accuracy is limited to the quality of data obtained from other Public Records. This map is not intended to be a substitute for an actual field survey. Public Land Survey Base is derived from U.S.G.S Topographic maps unless otherwise noted. Other sources of the Land Base may be actual survey data. Base map data is from the April 1995 County Digital Orthophotos and/or U.S.G.S. 1:24,000 scale Topographic series. The user is responsible for the improper use of the data contained herein.

Created by The Columbia County Land Information Office -GIS Section. VMB.
September 2002.

TAX PARCEL MAP


TOWN of LEWISTON

TOWN 12 NORTH RANGE 8 EAST
COLUMBIA COUNTY, WISCONSIN

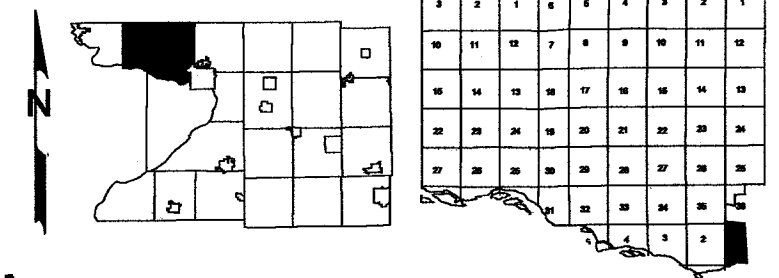

Replaced
2004


-SEE SECTION 36 T13N R8E -

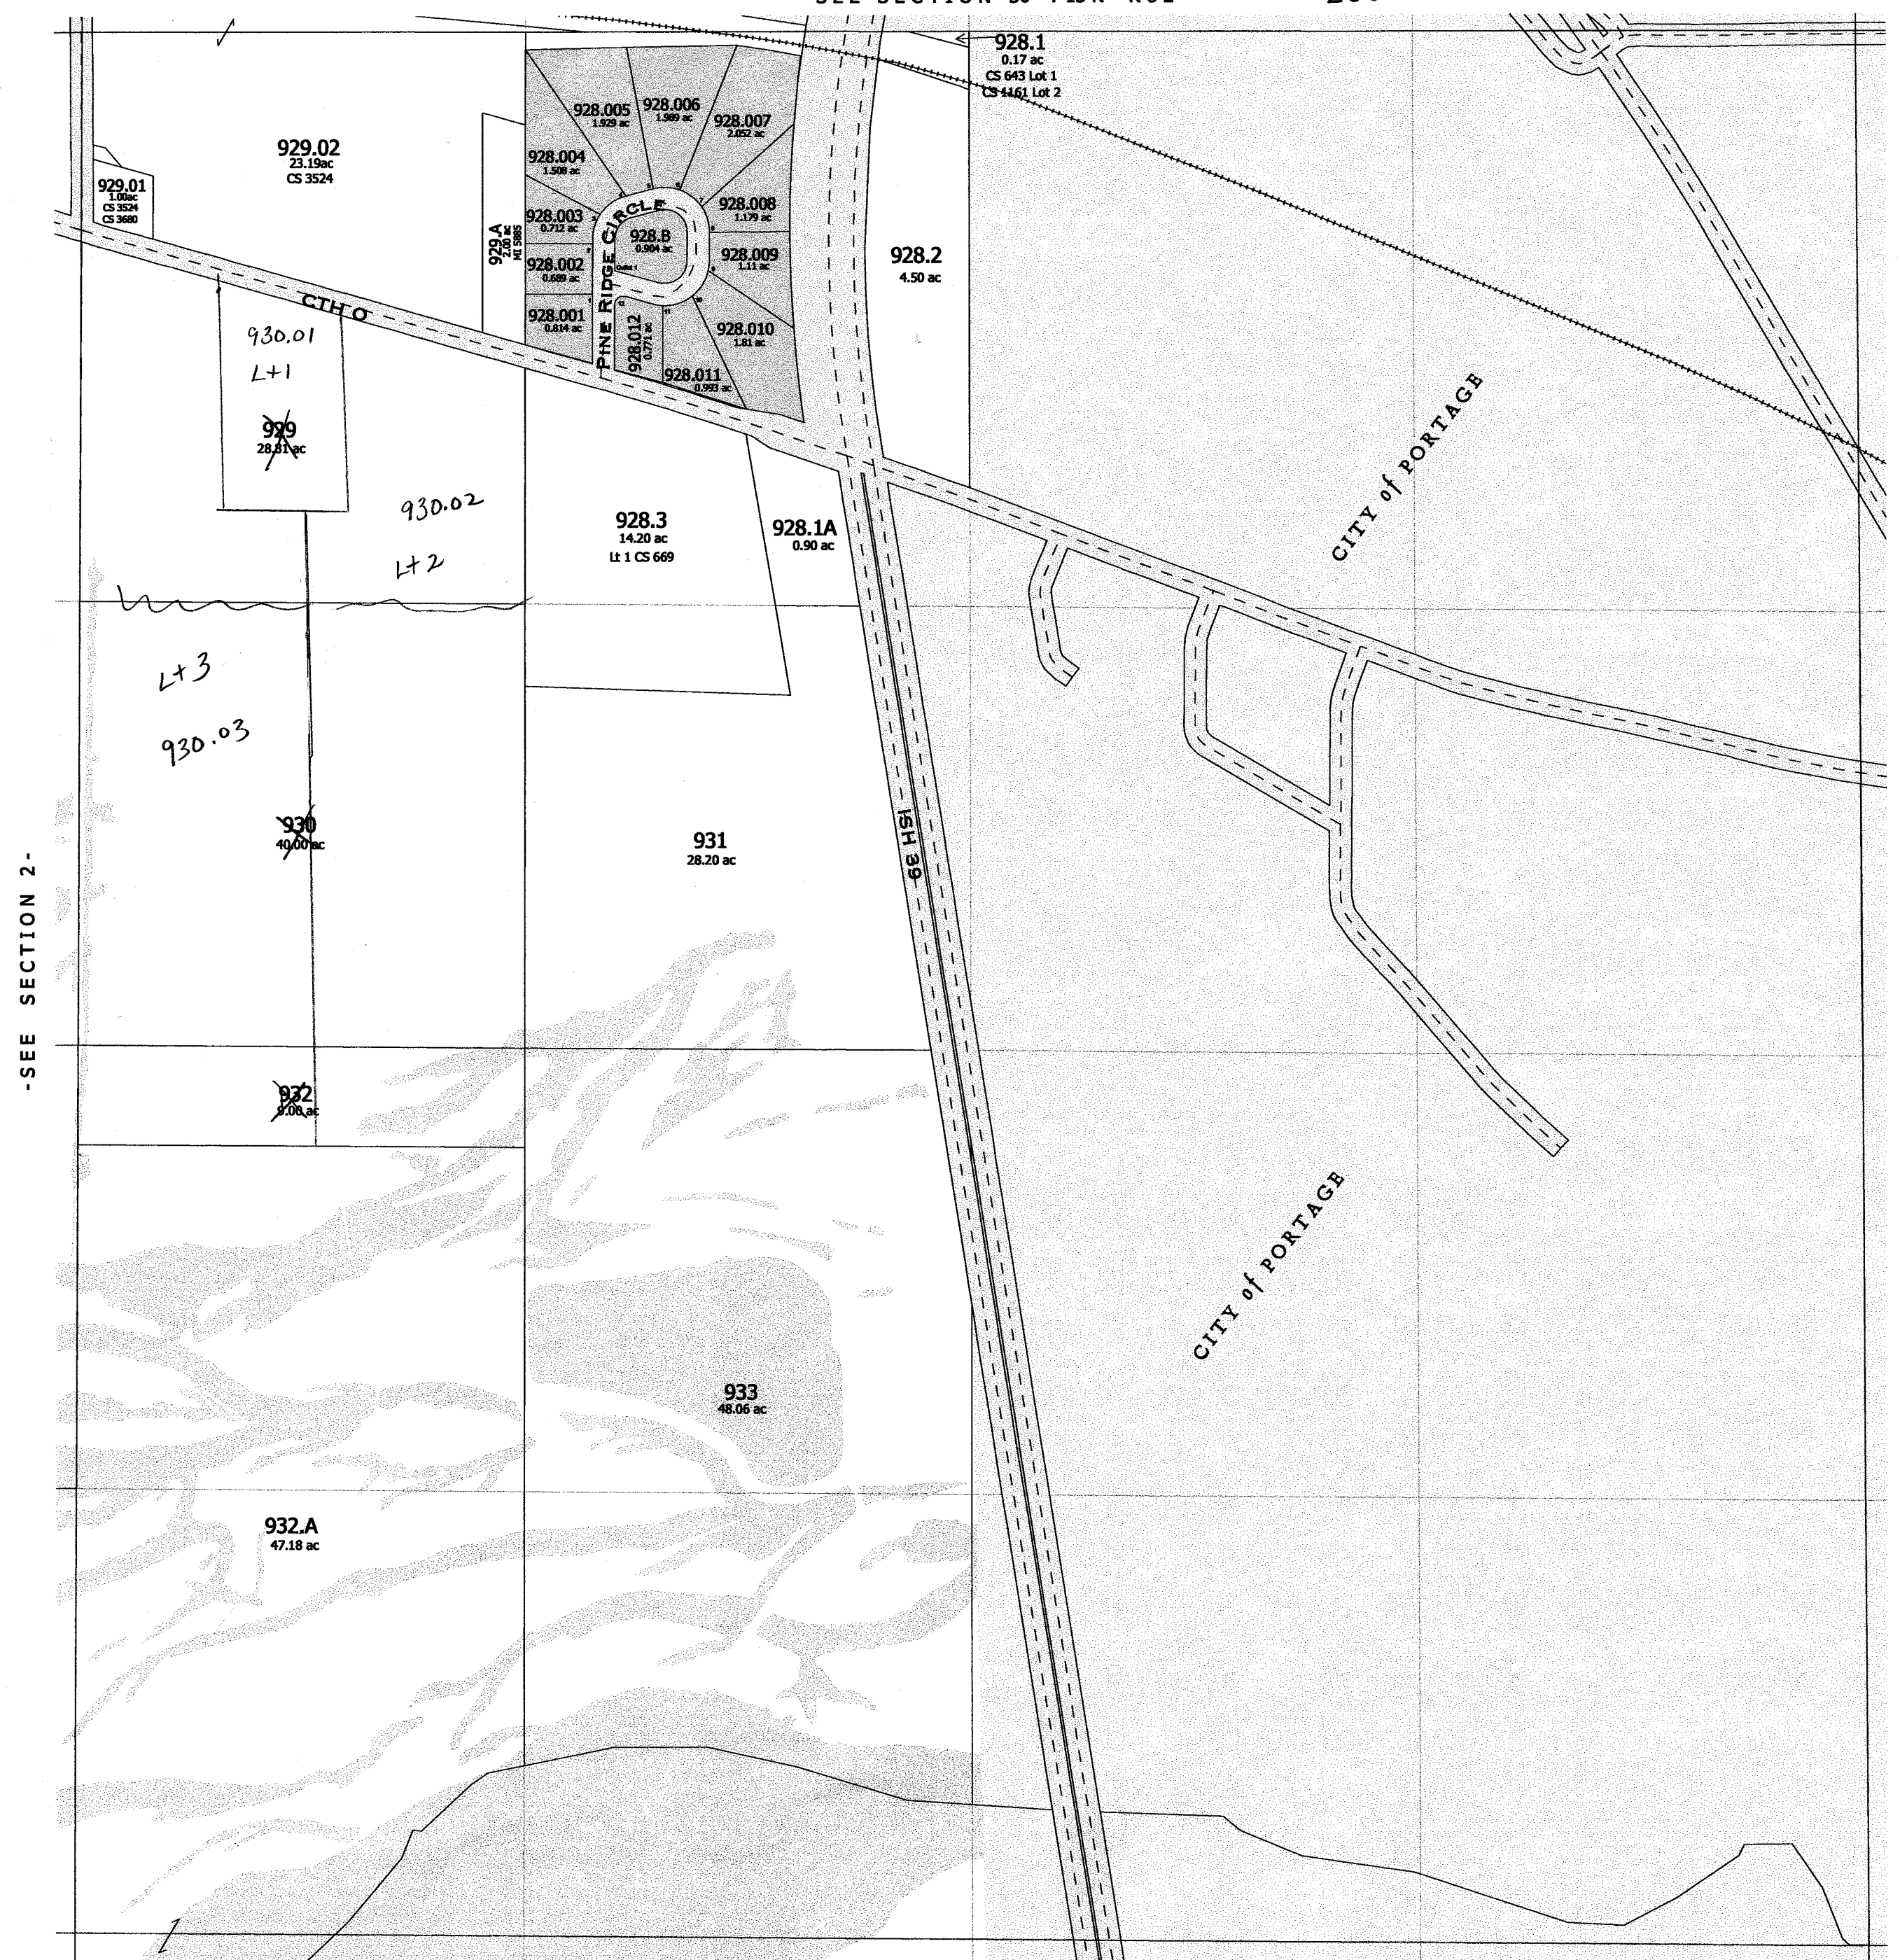

-SEE SECTION 2-

-SEE SECTION 12-

replaced 2004
-SECTION 1-

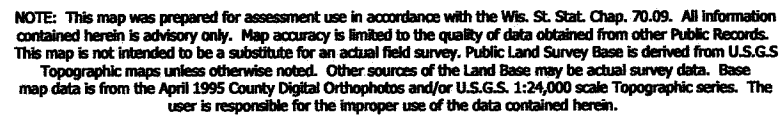


Created by The Columbia County Land Information Office -GIS Section. VMB.
March 2004.

TOWN of LEWISTON


TOWN 12 NORTH RANGE 8 EAST
COLUMBIA COUNTY, WISCONSIN

Replace ~~U~~
2007

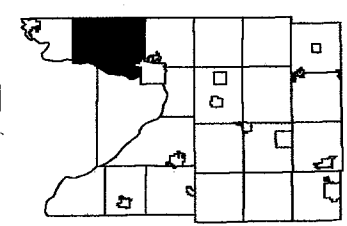

3	2	1	6	5	4	3	2	1
10	11	12	7	8	9	10	11	12
15	14	13	18	17	16	15	14	13
22	23	24	19	20	21	22	23	24
27	28	29	20	29	28	27	28	29
			31	30	29	34	35	
					4	3	2	

-SEE SECTION 36 T13N R8E-

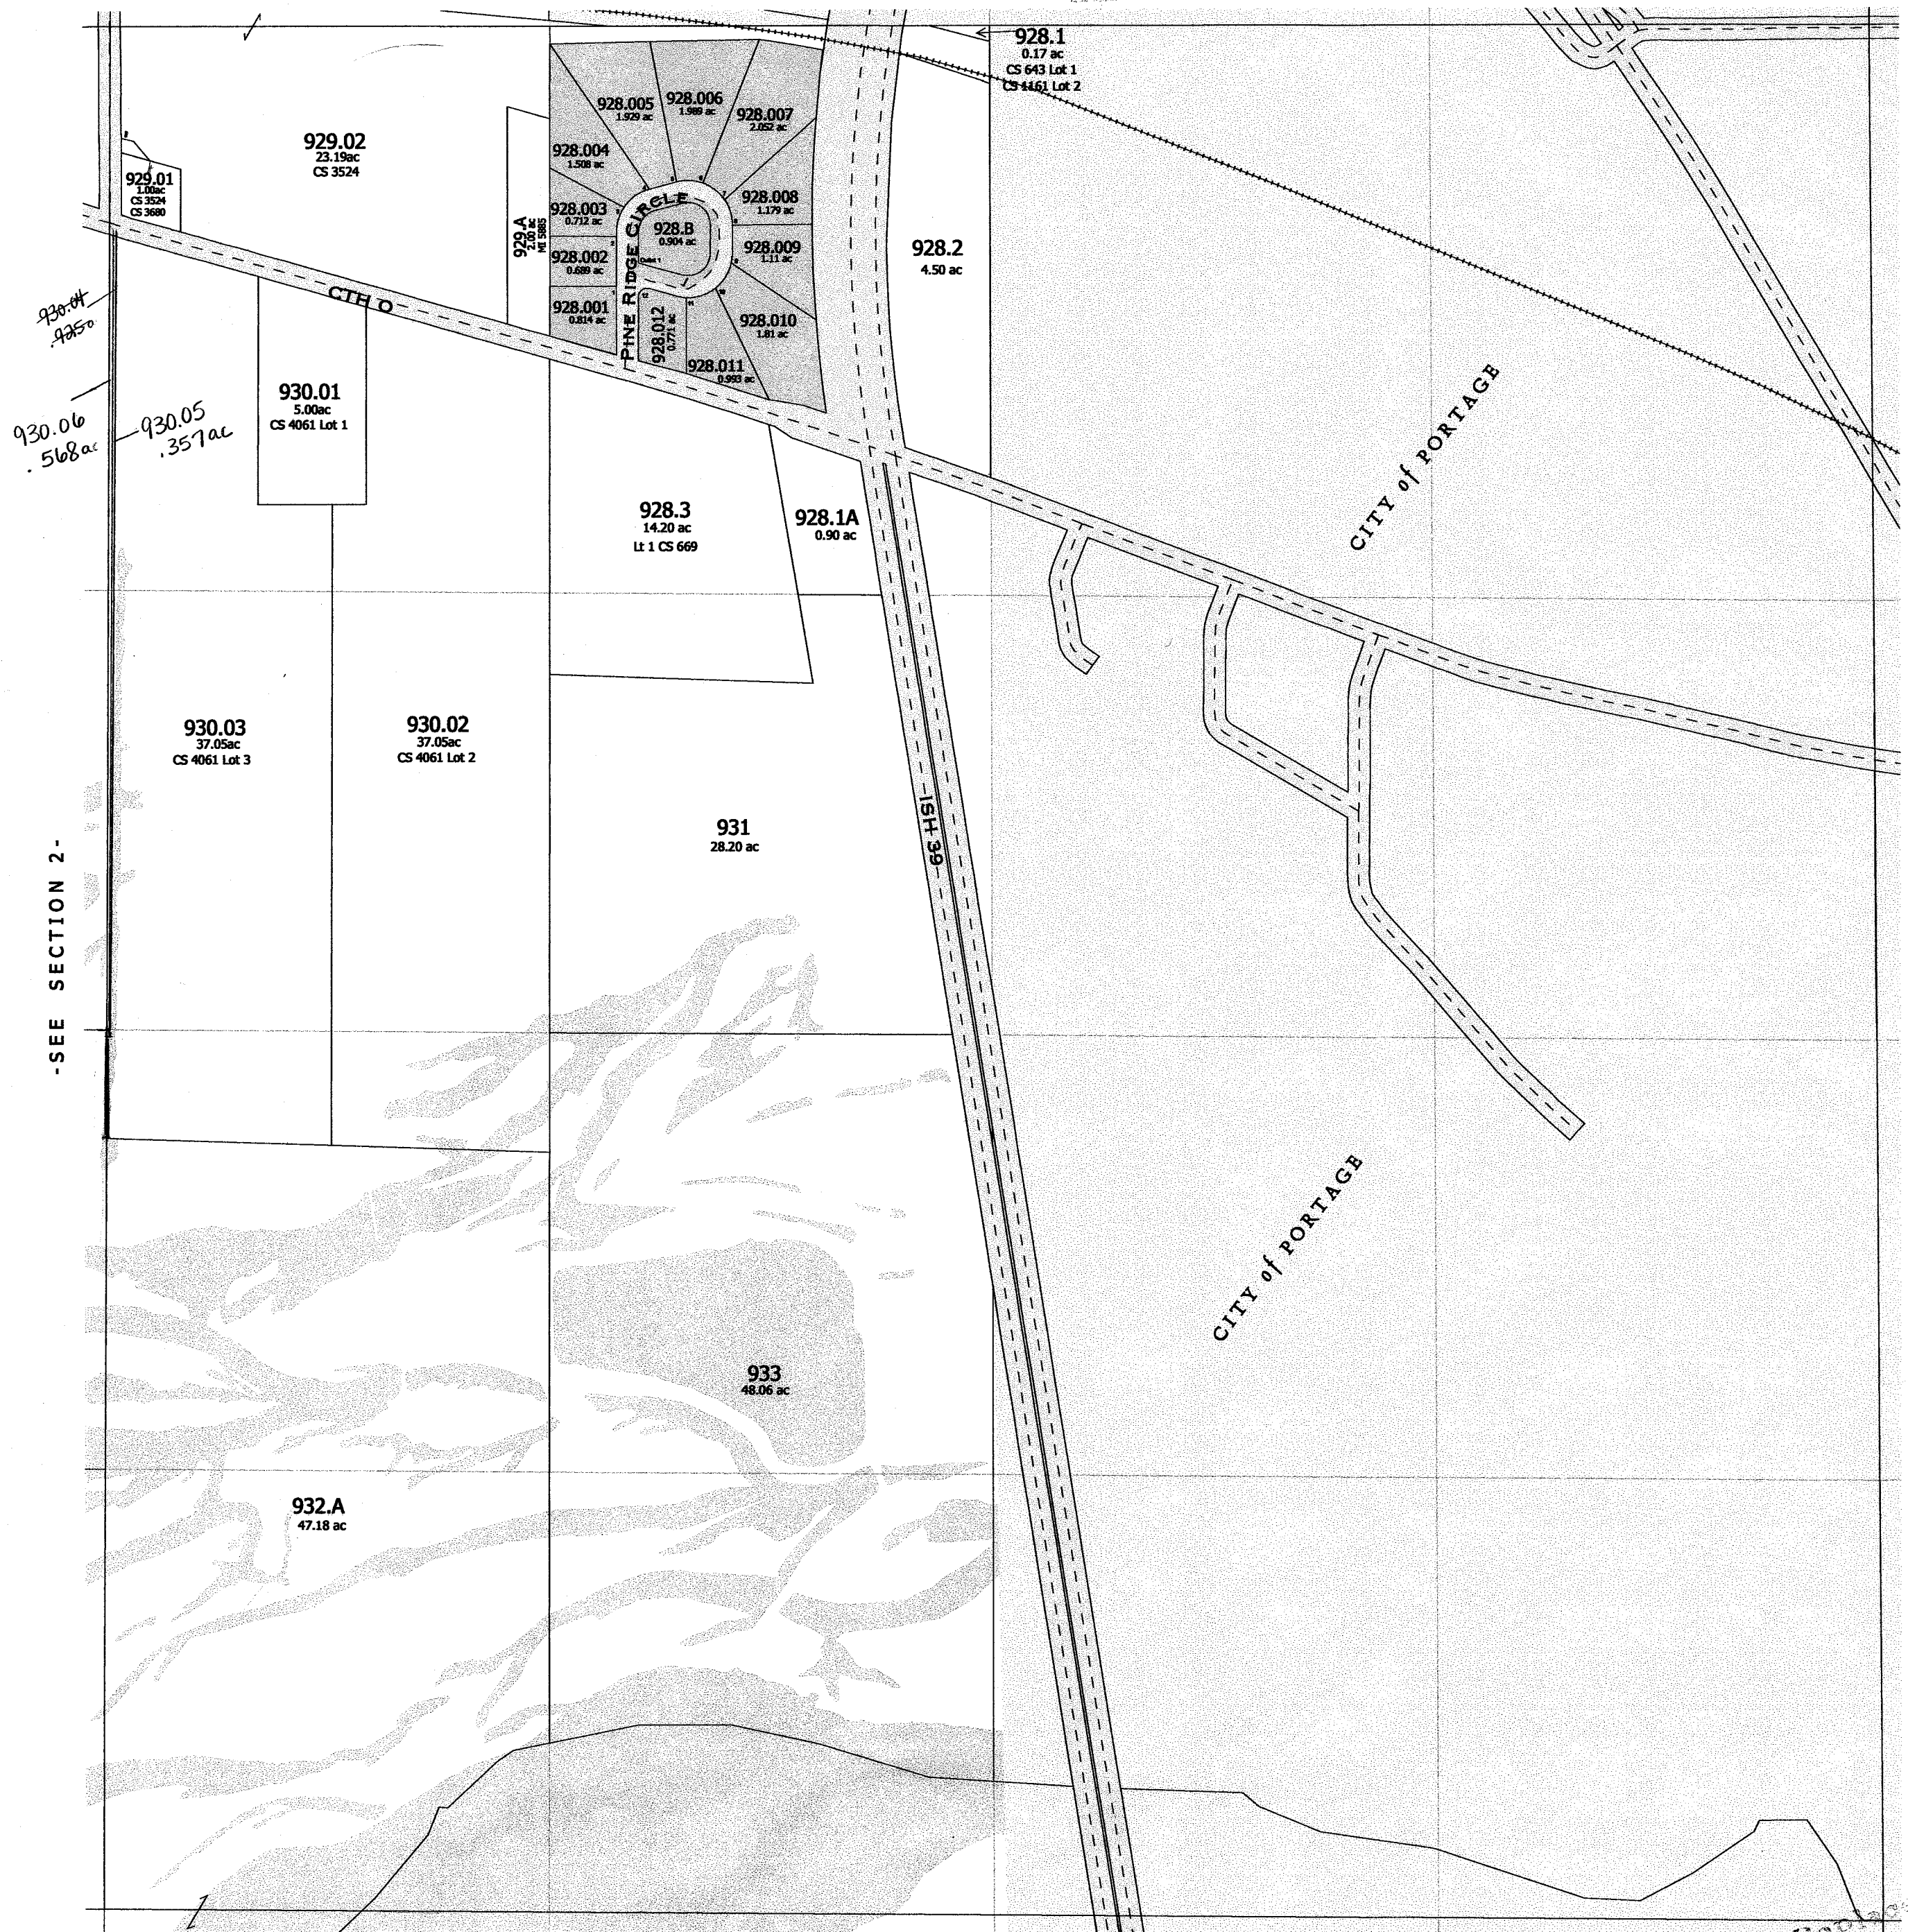

-SEE SECTION 12-

2001

-SECTION 1-

LEWISTON

SEC. 2 T12N R8E


ORIGINAL SURVEY 48.03A

ORIGINAL SURVEY 48.78A

ORIGINAL SURVEY 49.53A

ORIGINAL SURVEY 50.28A

Replaced
2002

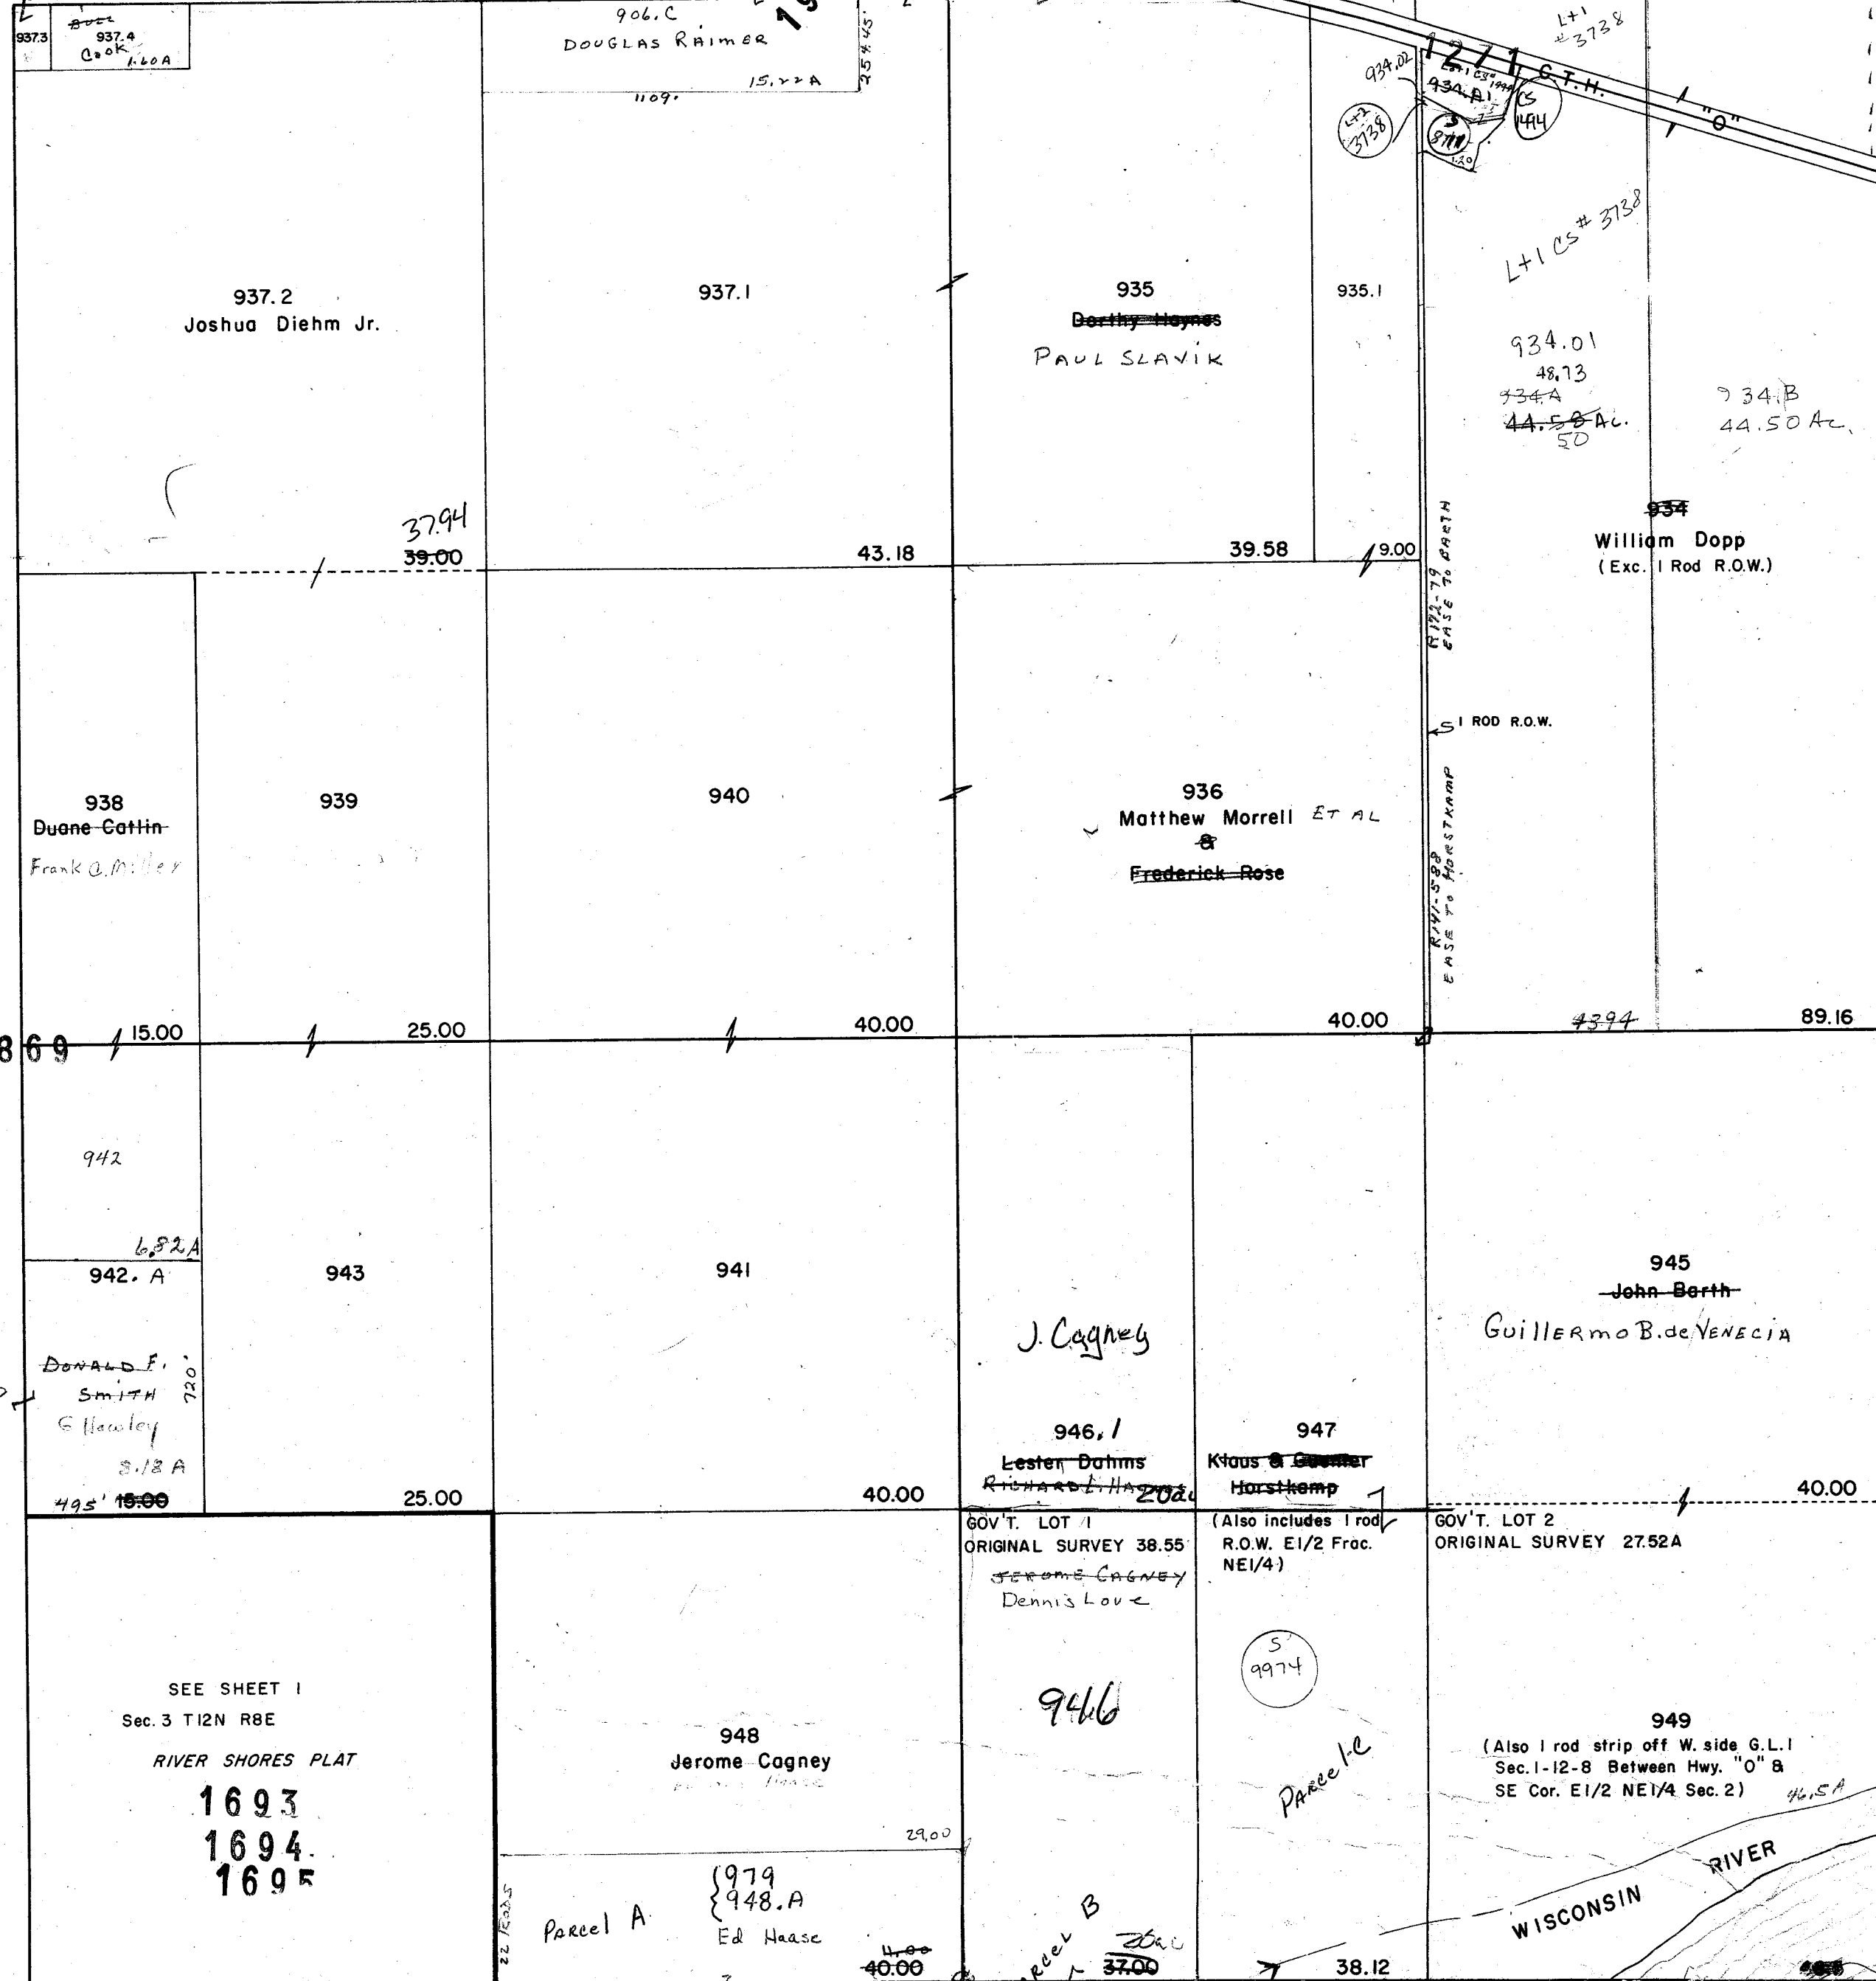

937.3
937.4
Cook
1.60A

906.C
DOUGLAS RAIMER

15.22A

937.2
Joshua Diehm Jr.

937.1

935
Dorothy Haynes
PAUL SLAVIK

935.1

934.01
48.73
44.50 Ac.
50

934.B
44.50 Ac.

937.3
SHIRLEY BAYER
Rich Schaper 0.43A

937.4
Wilbur Bull 1.60A
0.35A

37.94
39.00

43.18

39.58

9.00

934
William Dopp
(Exc. 1 Rod R.O.W.)

938
Duane Cottin
Frank O. Miller

939

940

936
Matthew Morrell ET AL
Frederick Rose

1 ROD R.O.W.
EASE TO RAMP
EASE TO RAMP

1 ROD R.O.W.

1869

15.00

25.00

40.00

40.00

43.94

89.16

942

942.A
6.82A

943

941

J. Cogney

946.1
Lester Dahms
Richard L. Hays

947
Klaus & Gertie
Horstkamp

945
John Berth
Guillermo B. de Venecia

DONALD F.
SMITH
G. Hawley
3.18A
49.5' 15.00

25.00

40.00

GOV'T. LOT 1
ORIGINAL SURVEY 38.55
Jerome Cogney
Dennis Love

(Also includes 1 rod
R.O.W. E1/2 Frac.
NE1/4)

GOV'T. LOT 2
ORIGINAL SURVEY 27.52A

40.00

SEE SHEET 1
Sec. 3 T12N R8E
RIVER SHORES PLAT

1693
1694
1695

948
Jerome Cogney

29.00

Parcel A
{ 979
948.A
Ed Haase

40.00

Parcel B
37.00


38.12

WISCONSIN RIVER

SOURCE: AERIAL WS-1JJ-161 5-13-68

979 27.93

Sec 11-12-8

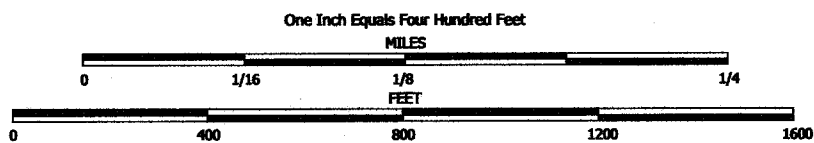

NOTE: This map was prepared for assessment use in accordance with the Wis. St. Stat. Chap. 70.09. All information contained herein is advisory only. Map accuracy is limited to the quality of data obtained from other Public Records. This map is not intended to be a substitute for an actual field survey. Public Land Survey Base is derived from U.S.G.S. Topographic maps unless otherwise noted. Other sources of the Land Base may be actual survey data. Base map data is from the April 1995 County Digital Orthophotos and/or U.S.G.S. 1:24,000 scale Topographic series. The user is responsible for the improper use of the data contained herein.


Created by The Columbia County Land Information Office - GIS Section. VMB.
September 2002.

TAX PARCEL MAP


TOWN of LEWISTON

TOWN 12 NORTH RANGE 8 EAST
COLUMBIA COUNTY, WISCONSIN

Replaced
2007

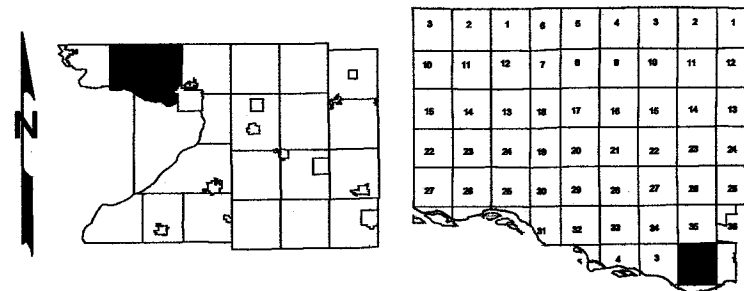


-SEE SECTION 35 T13N R8E -

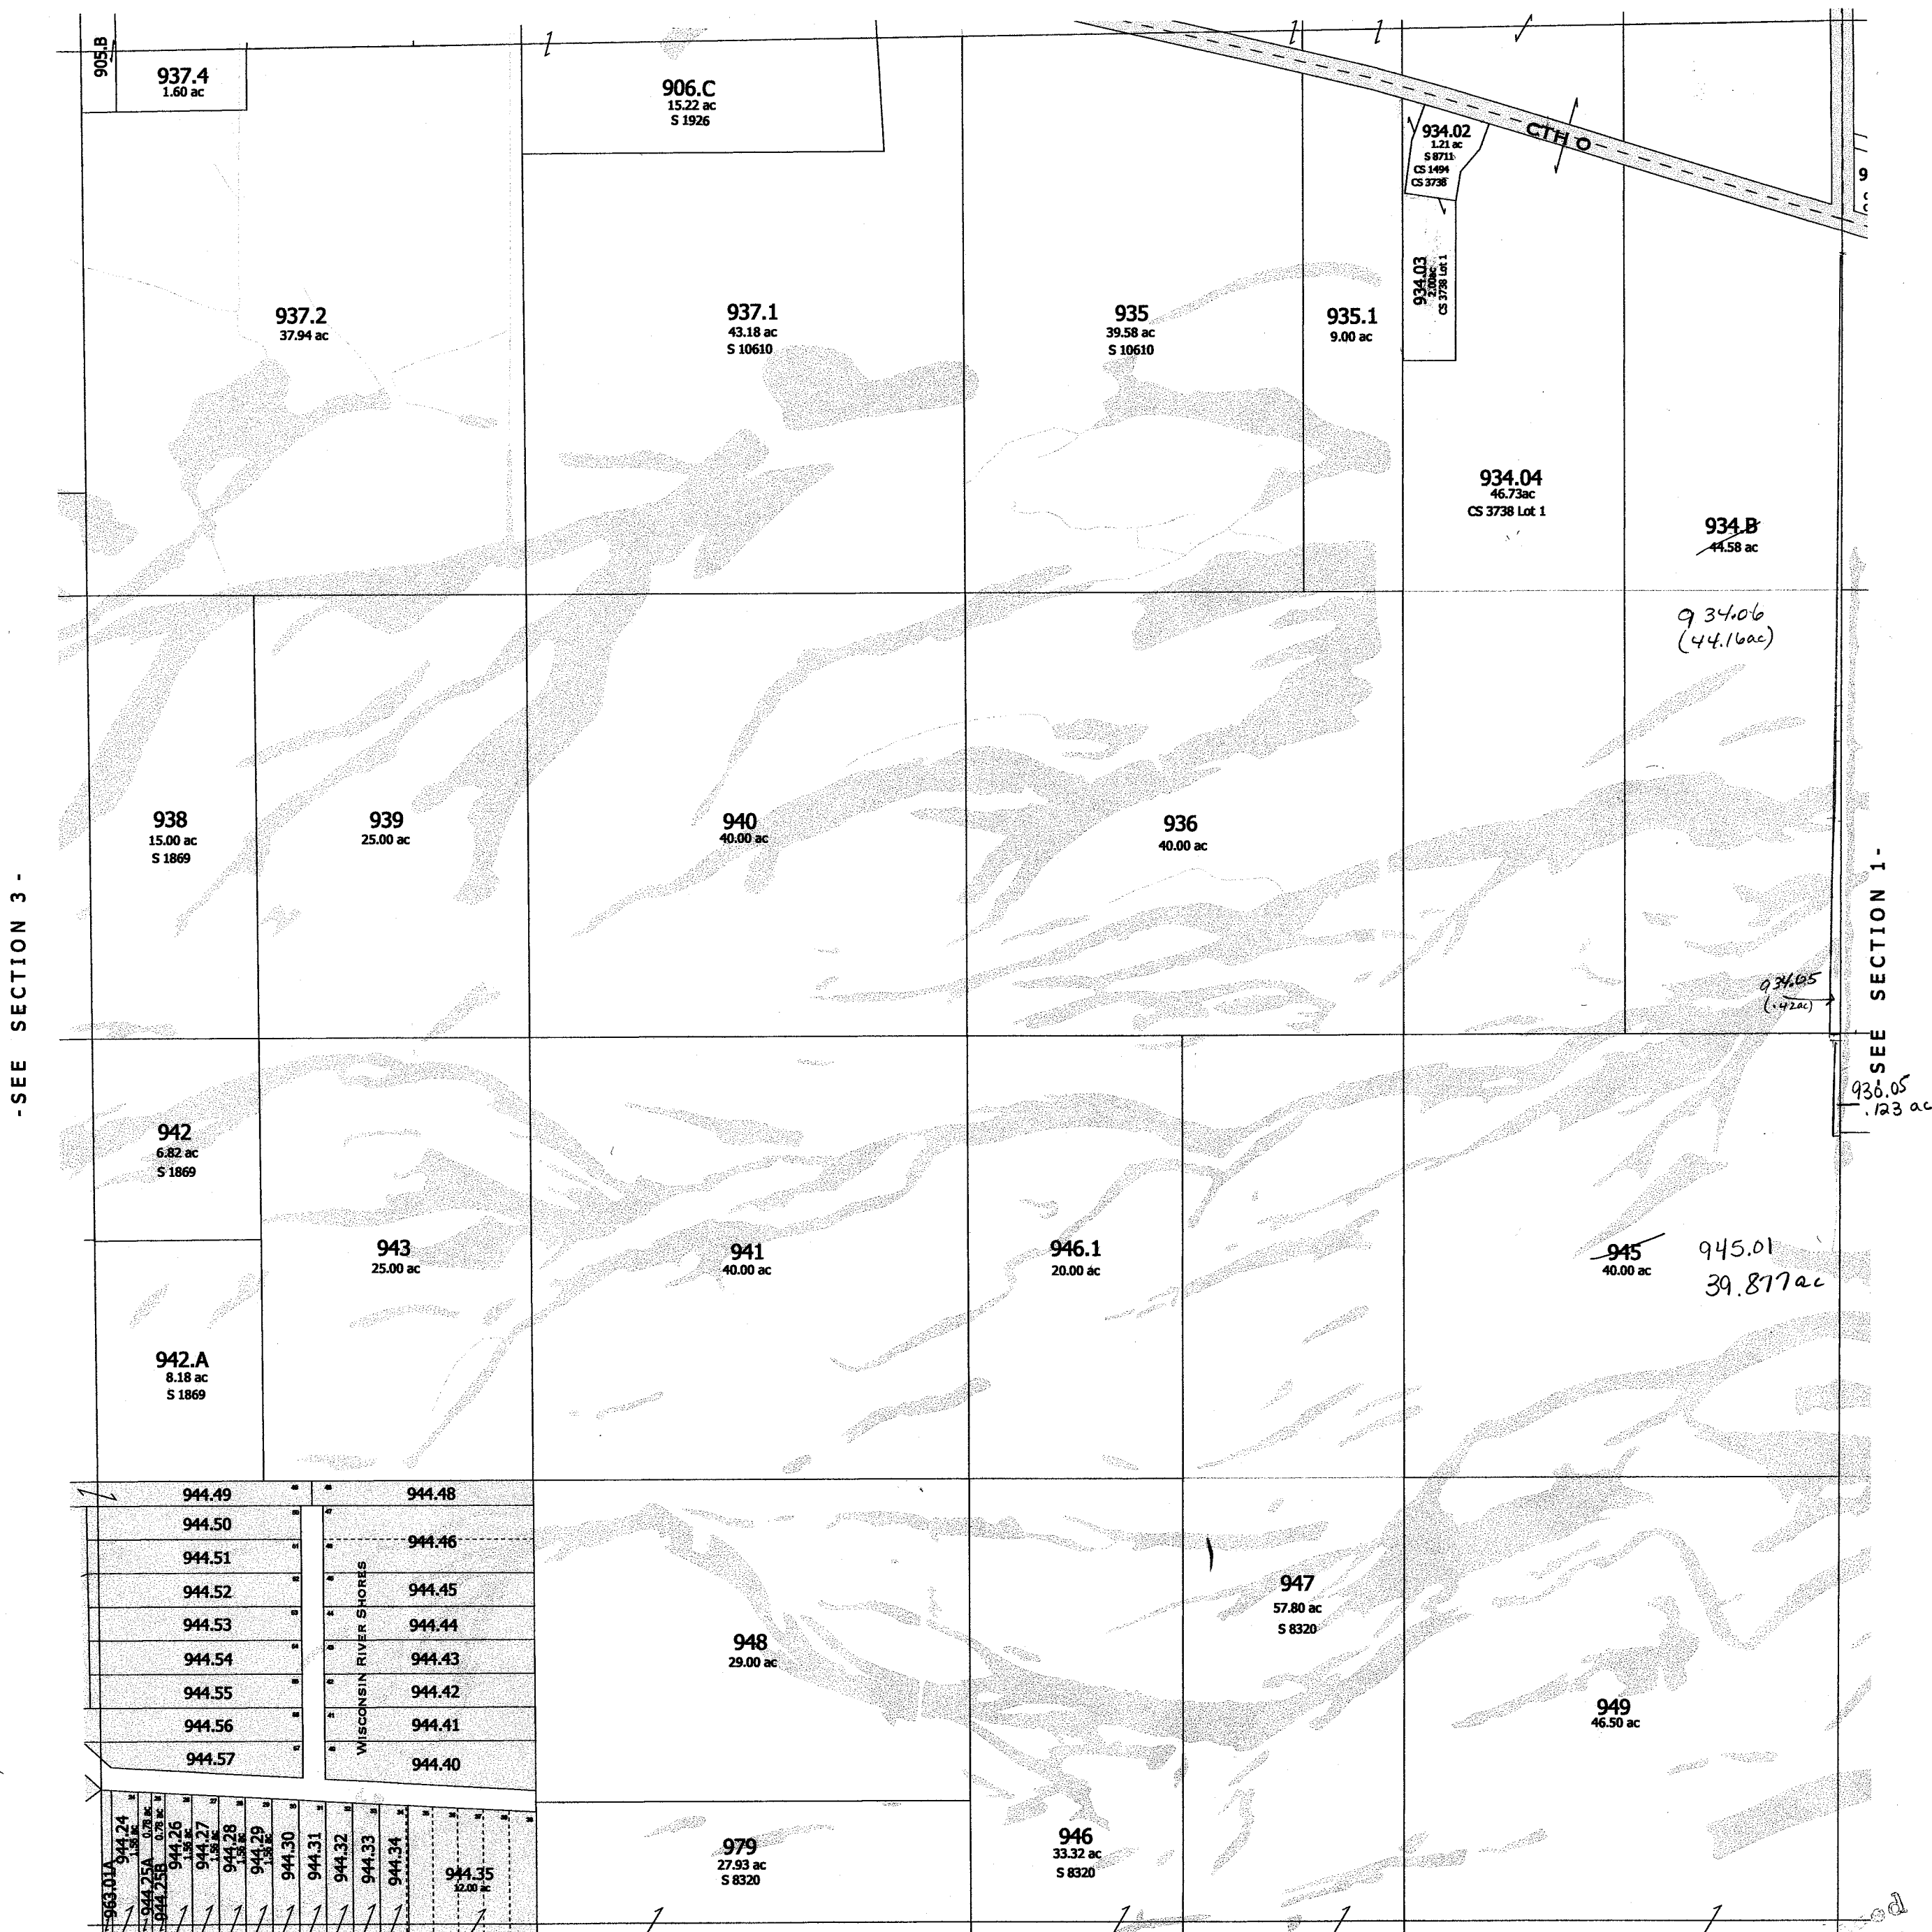


LEWISTON

SEC. 3 T12N R8E

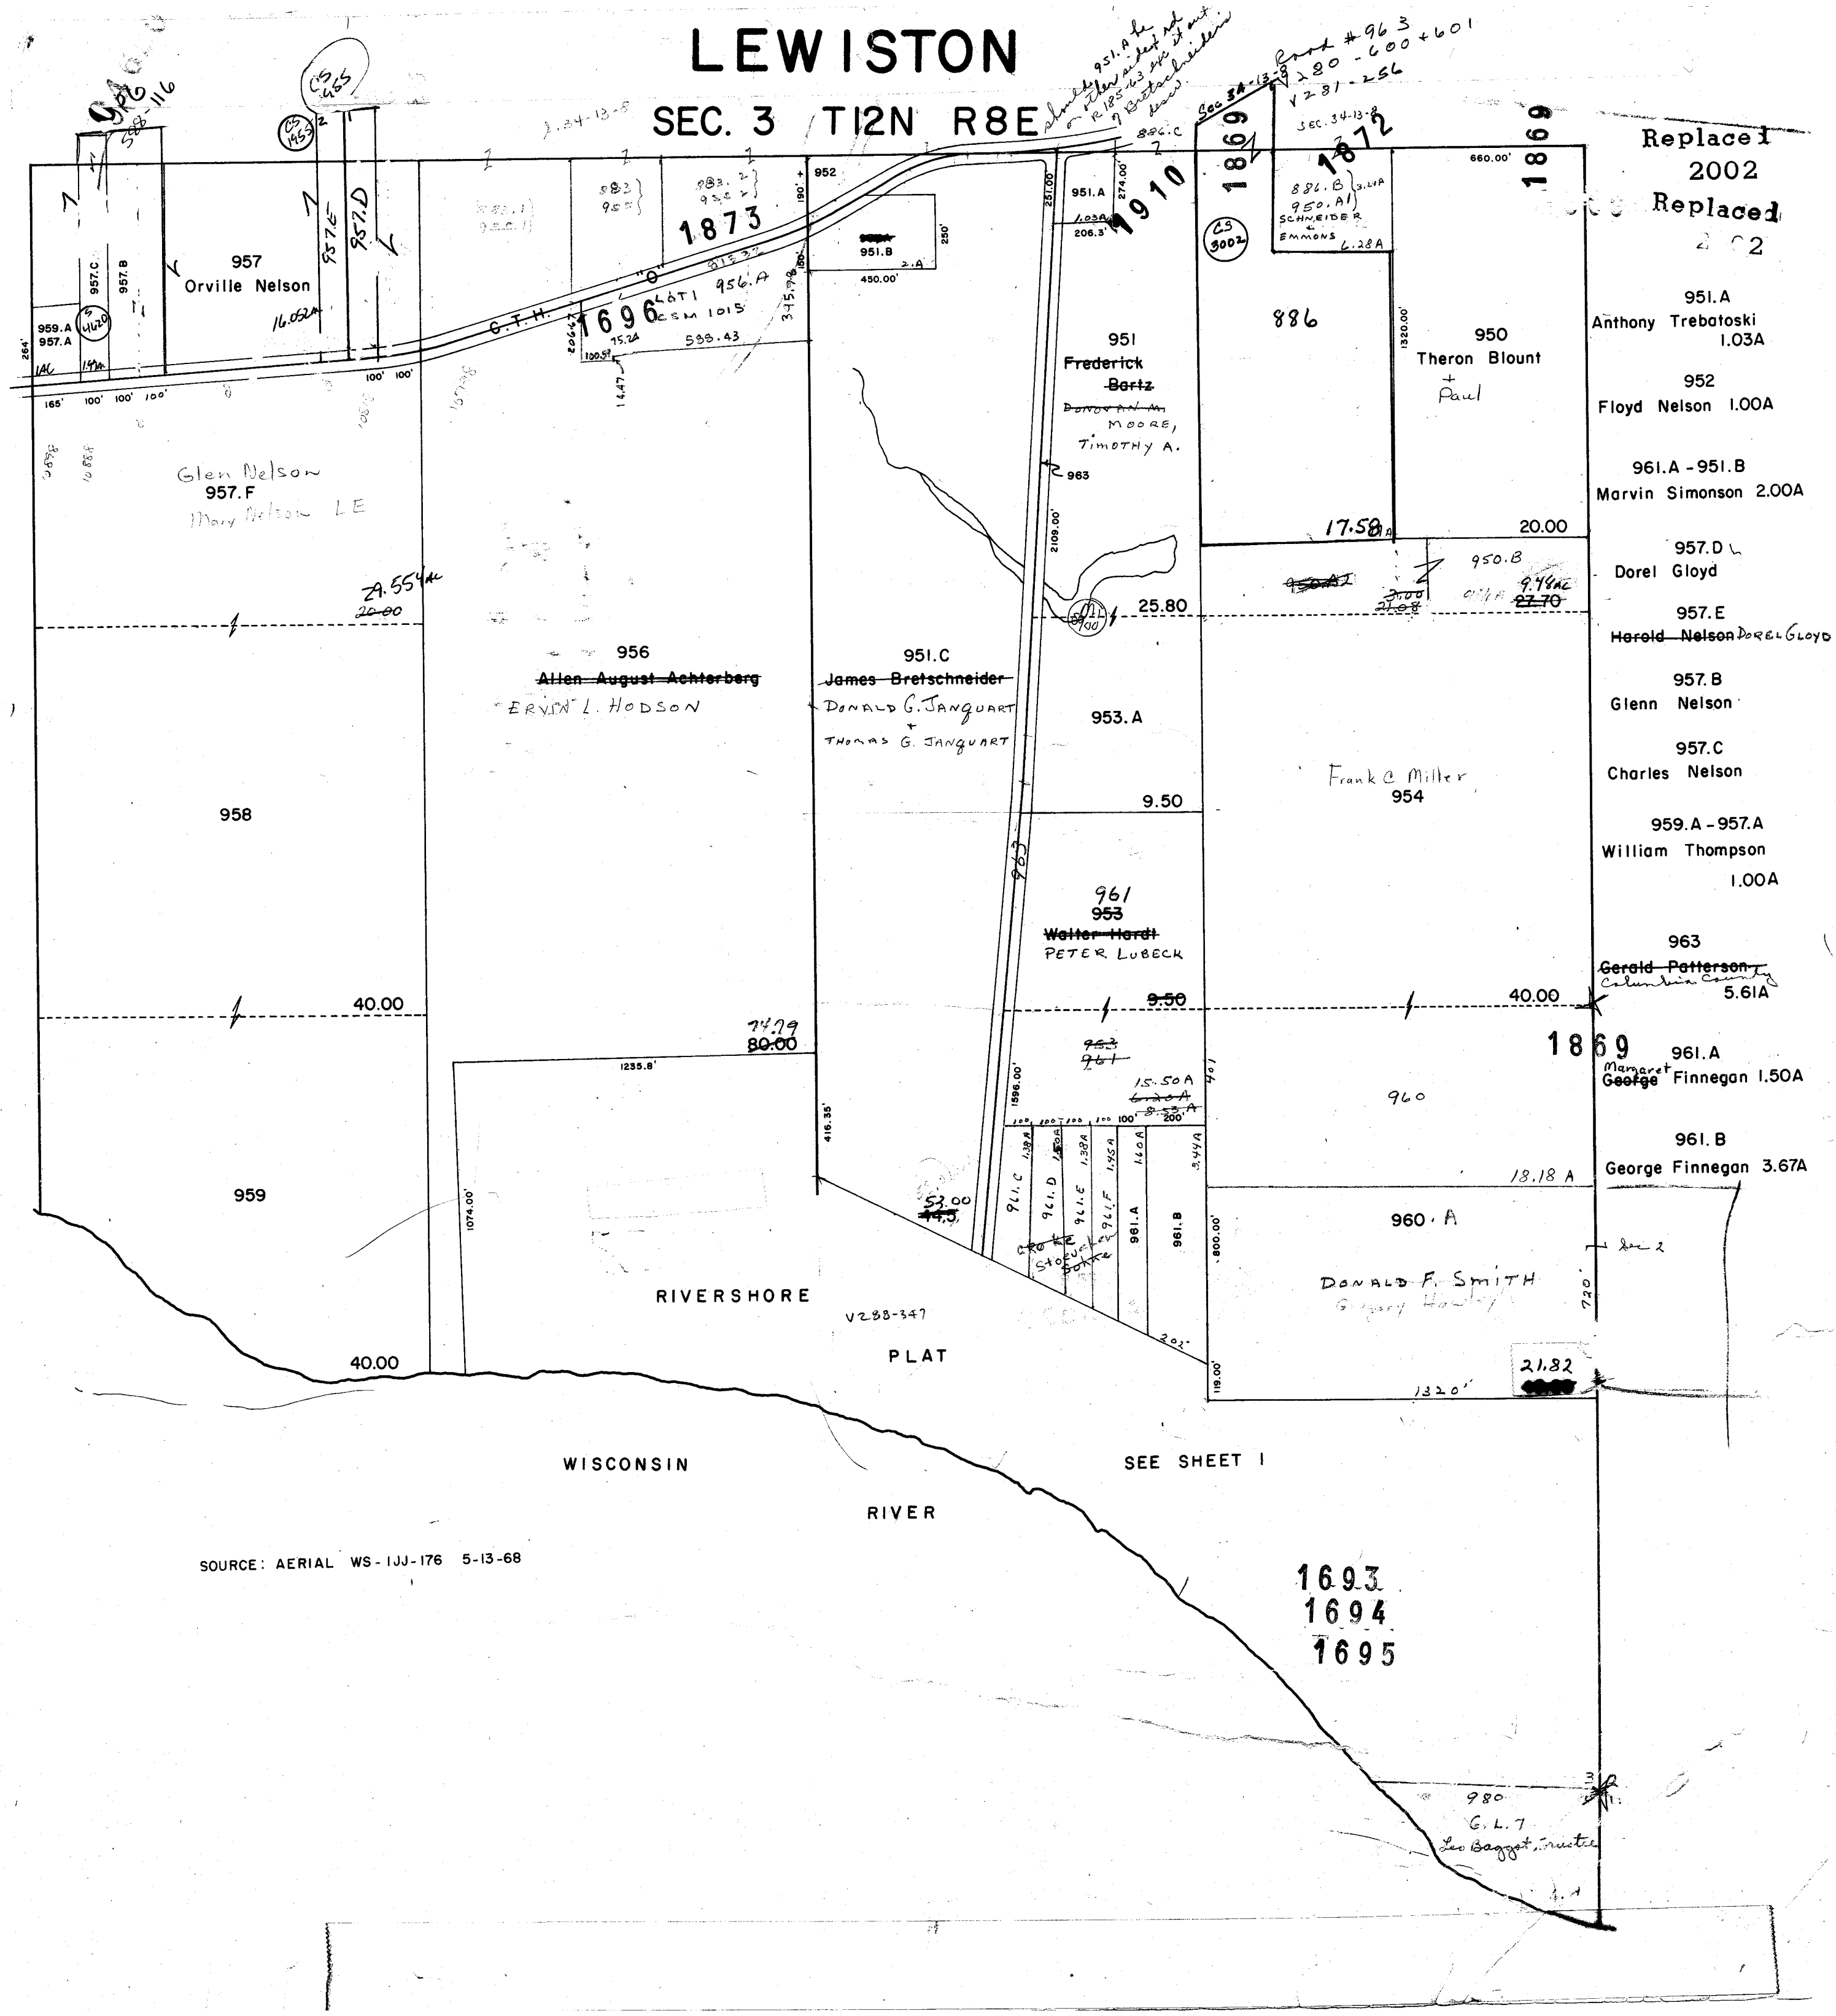

SOURCE: AERIAL WS-1JJ-176 5-13-68

1693
1694
1695

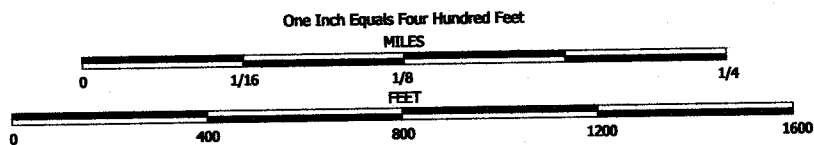

NOTE: This map was prepared for assessment use in accordance with the Wis. Stat. Chap. 70.09. All information contained herein is advisory only. Map accuracy is limited to the quality of data obtained from other Public Records. This map is not intended to be a substitute for an actual field survey. Public Land Survey Base is derived from U.S.G.S. Topographic maps unless otherwise noted. Other sources of the Land Base may be actual survey data. Base map data is from the April 1995 County Digital Orthophotos and/or U.S.G.S. 1:24,000 scale Topographic series. The user is responsible for the improper use of the data contained herein.



Created by The Columbia County Land Information Office -GIS Section. VMB.
September 2002.

TAX PARCEL MAP

TOWN of LEWISTON

TOWN 12 NORTH RANGE 8 EAST
COLUMBIA COUNTY, WISCONSIN

Replaced
2007

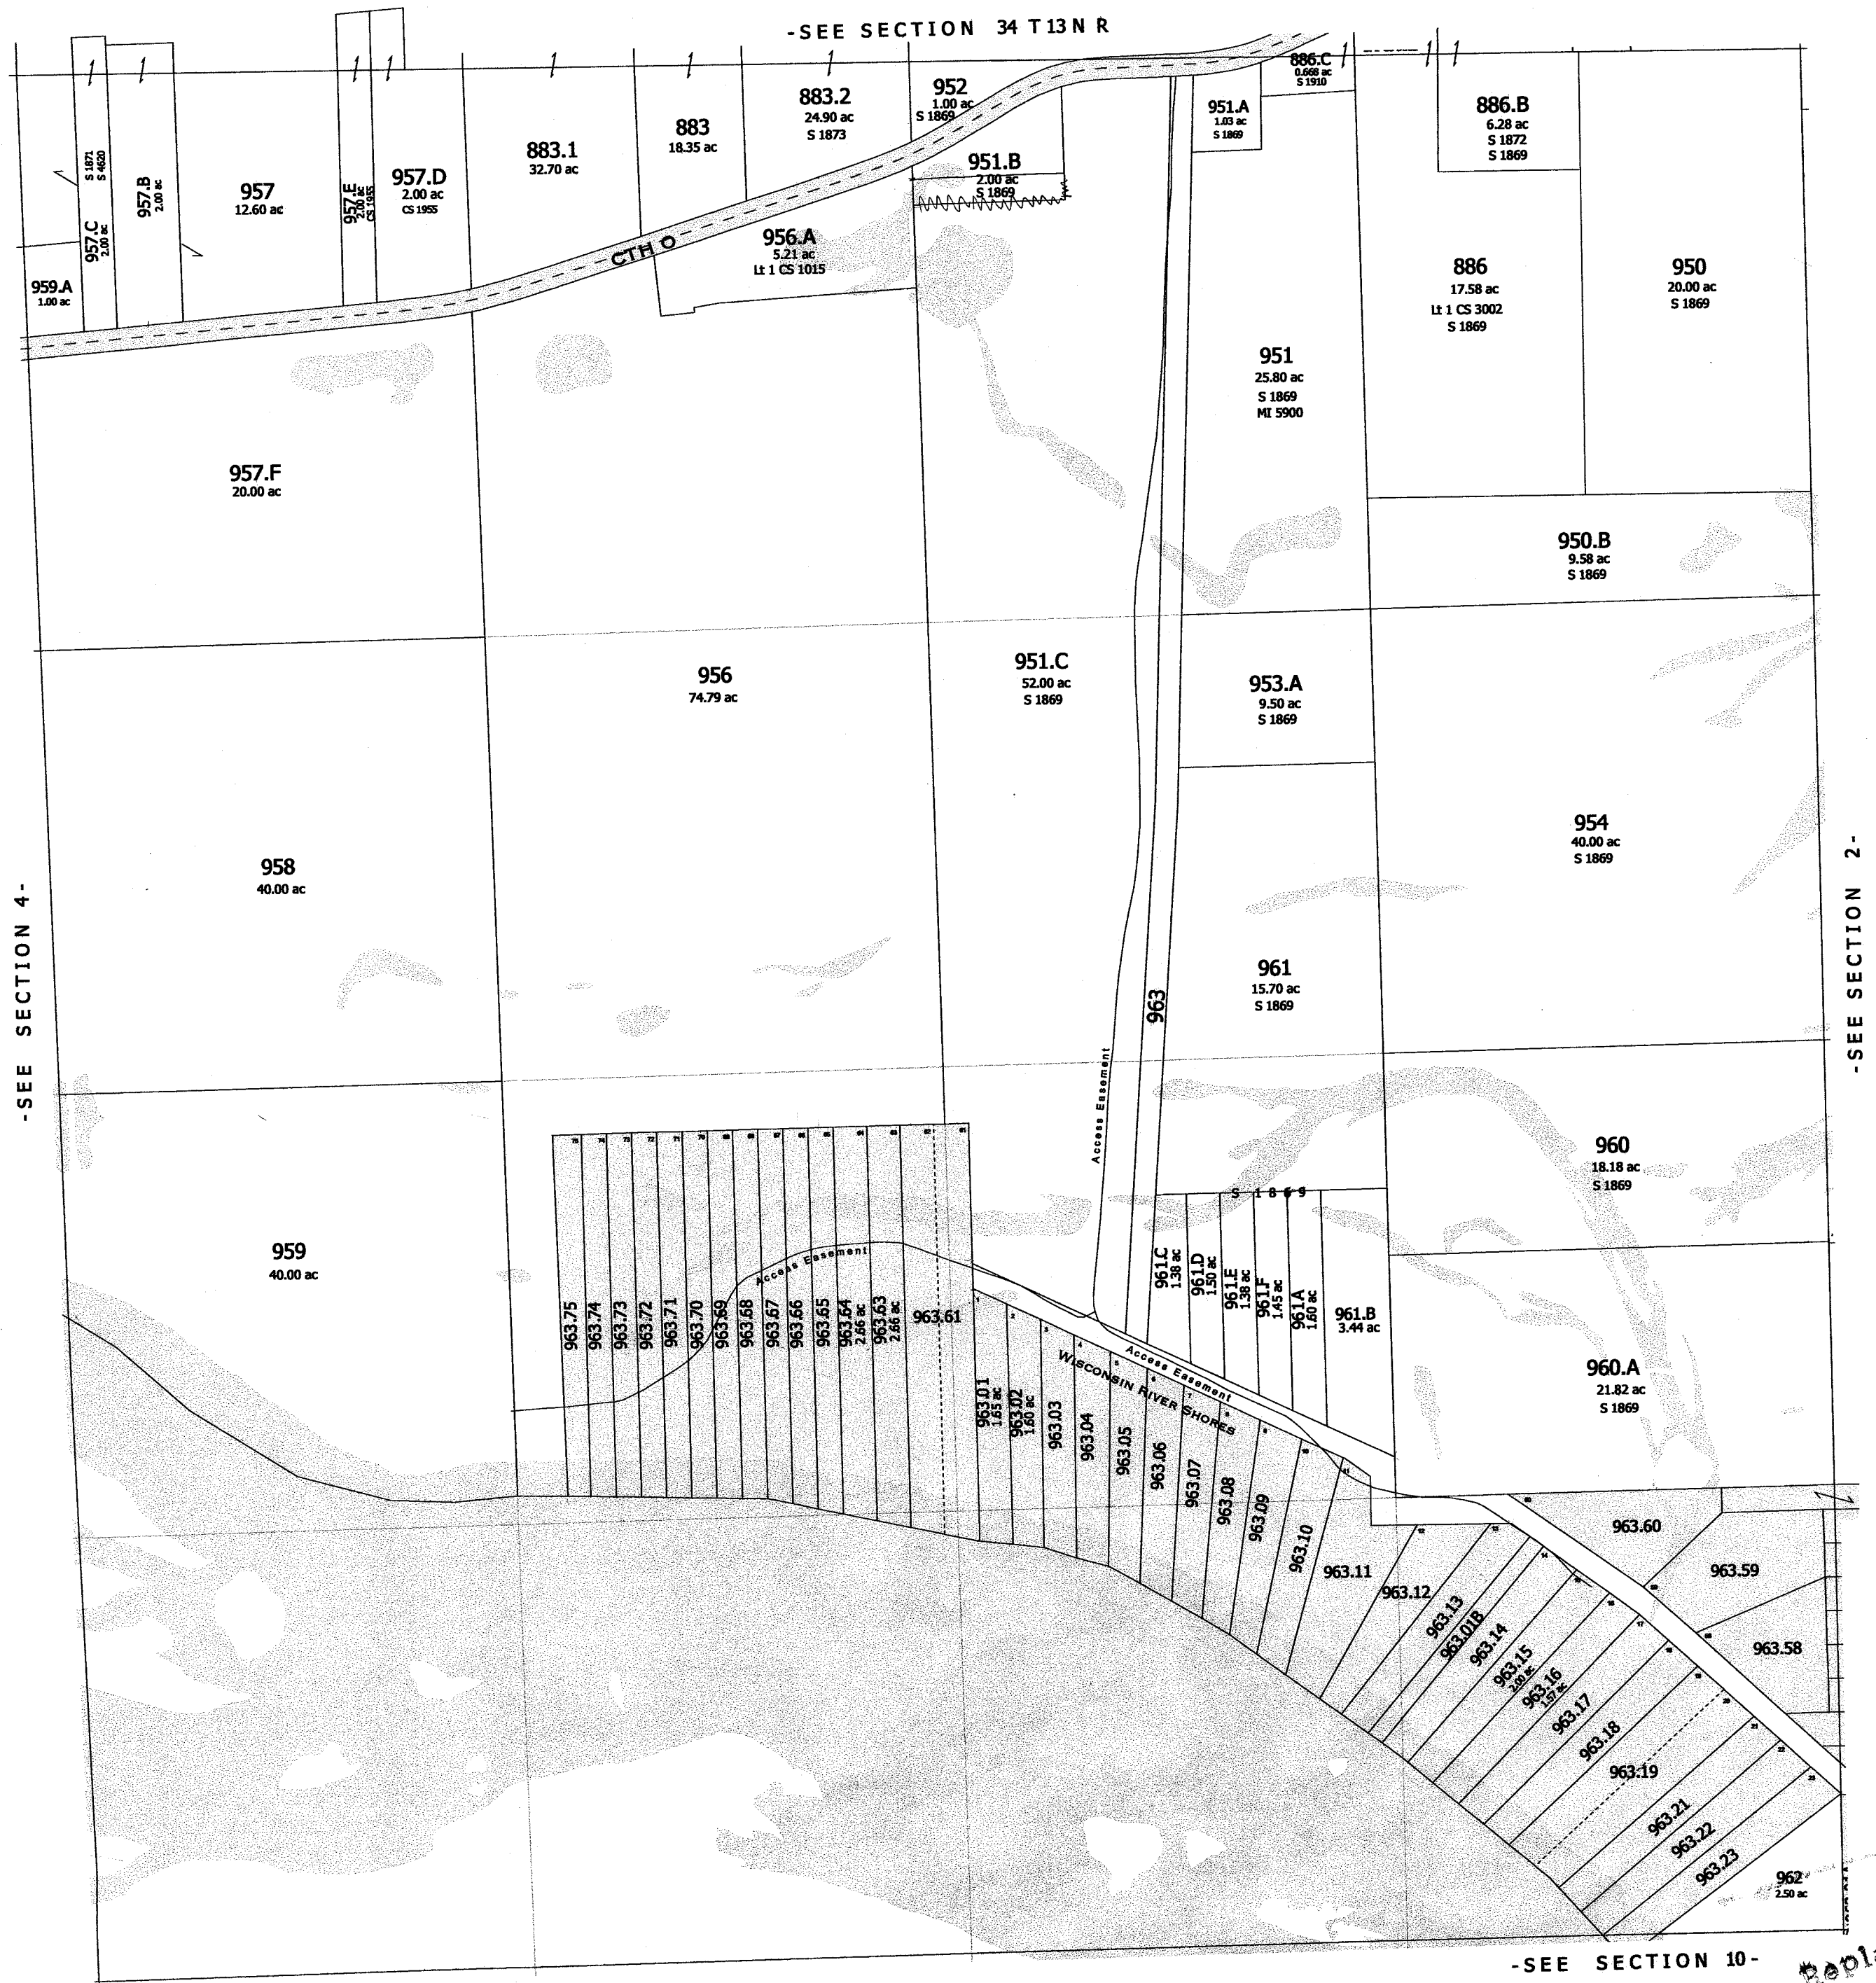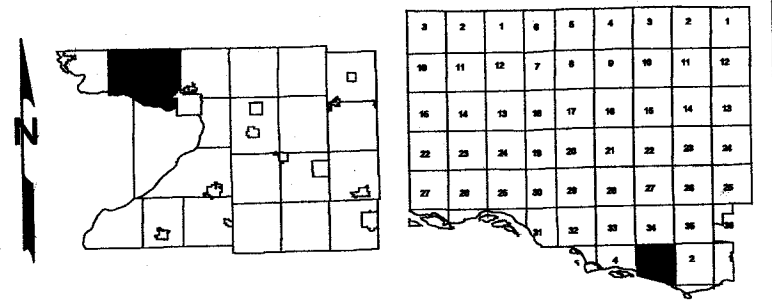

Replaced
2002



One Inch Equals Four Hundred Feet
MILES
0 1/16 1/8 1/4
FEET
0 400 800 1200 1600


NOTE: This map was prepared for assessment use in accordance with the Wis. St. Stat. Chap. 70.09. All information contained herein is advisory only. Map accuracy is limited to the quality of data obtained from other Public Records. This map is not intended to be a substitute for an actual field survey. Public Land Survey Base is derived from U.S.G.S. Topographic maps unless otherwise noted. Other sources of the Land Base may be actual survey data. Base map data is from the April 1995 County Digital Orthophotos and/or U.S.G.S. 1:24,000 scale Topographic series. The user is responsible for the improper use of the data contained herein.

Created by The Columbia County Land Information Office -GIS Section. VMB.
September 2002.


TAX PARCEL MAP

TOWN of LEWISTON

TOWN 12 NORTH RANGE 8 EAST
COLUMBIA COUNTY, WISCONSIN

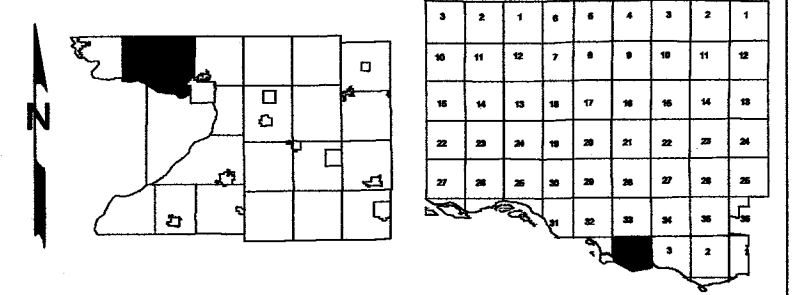


Replaced
2004

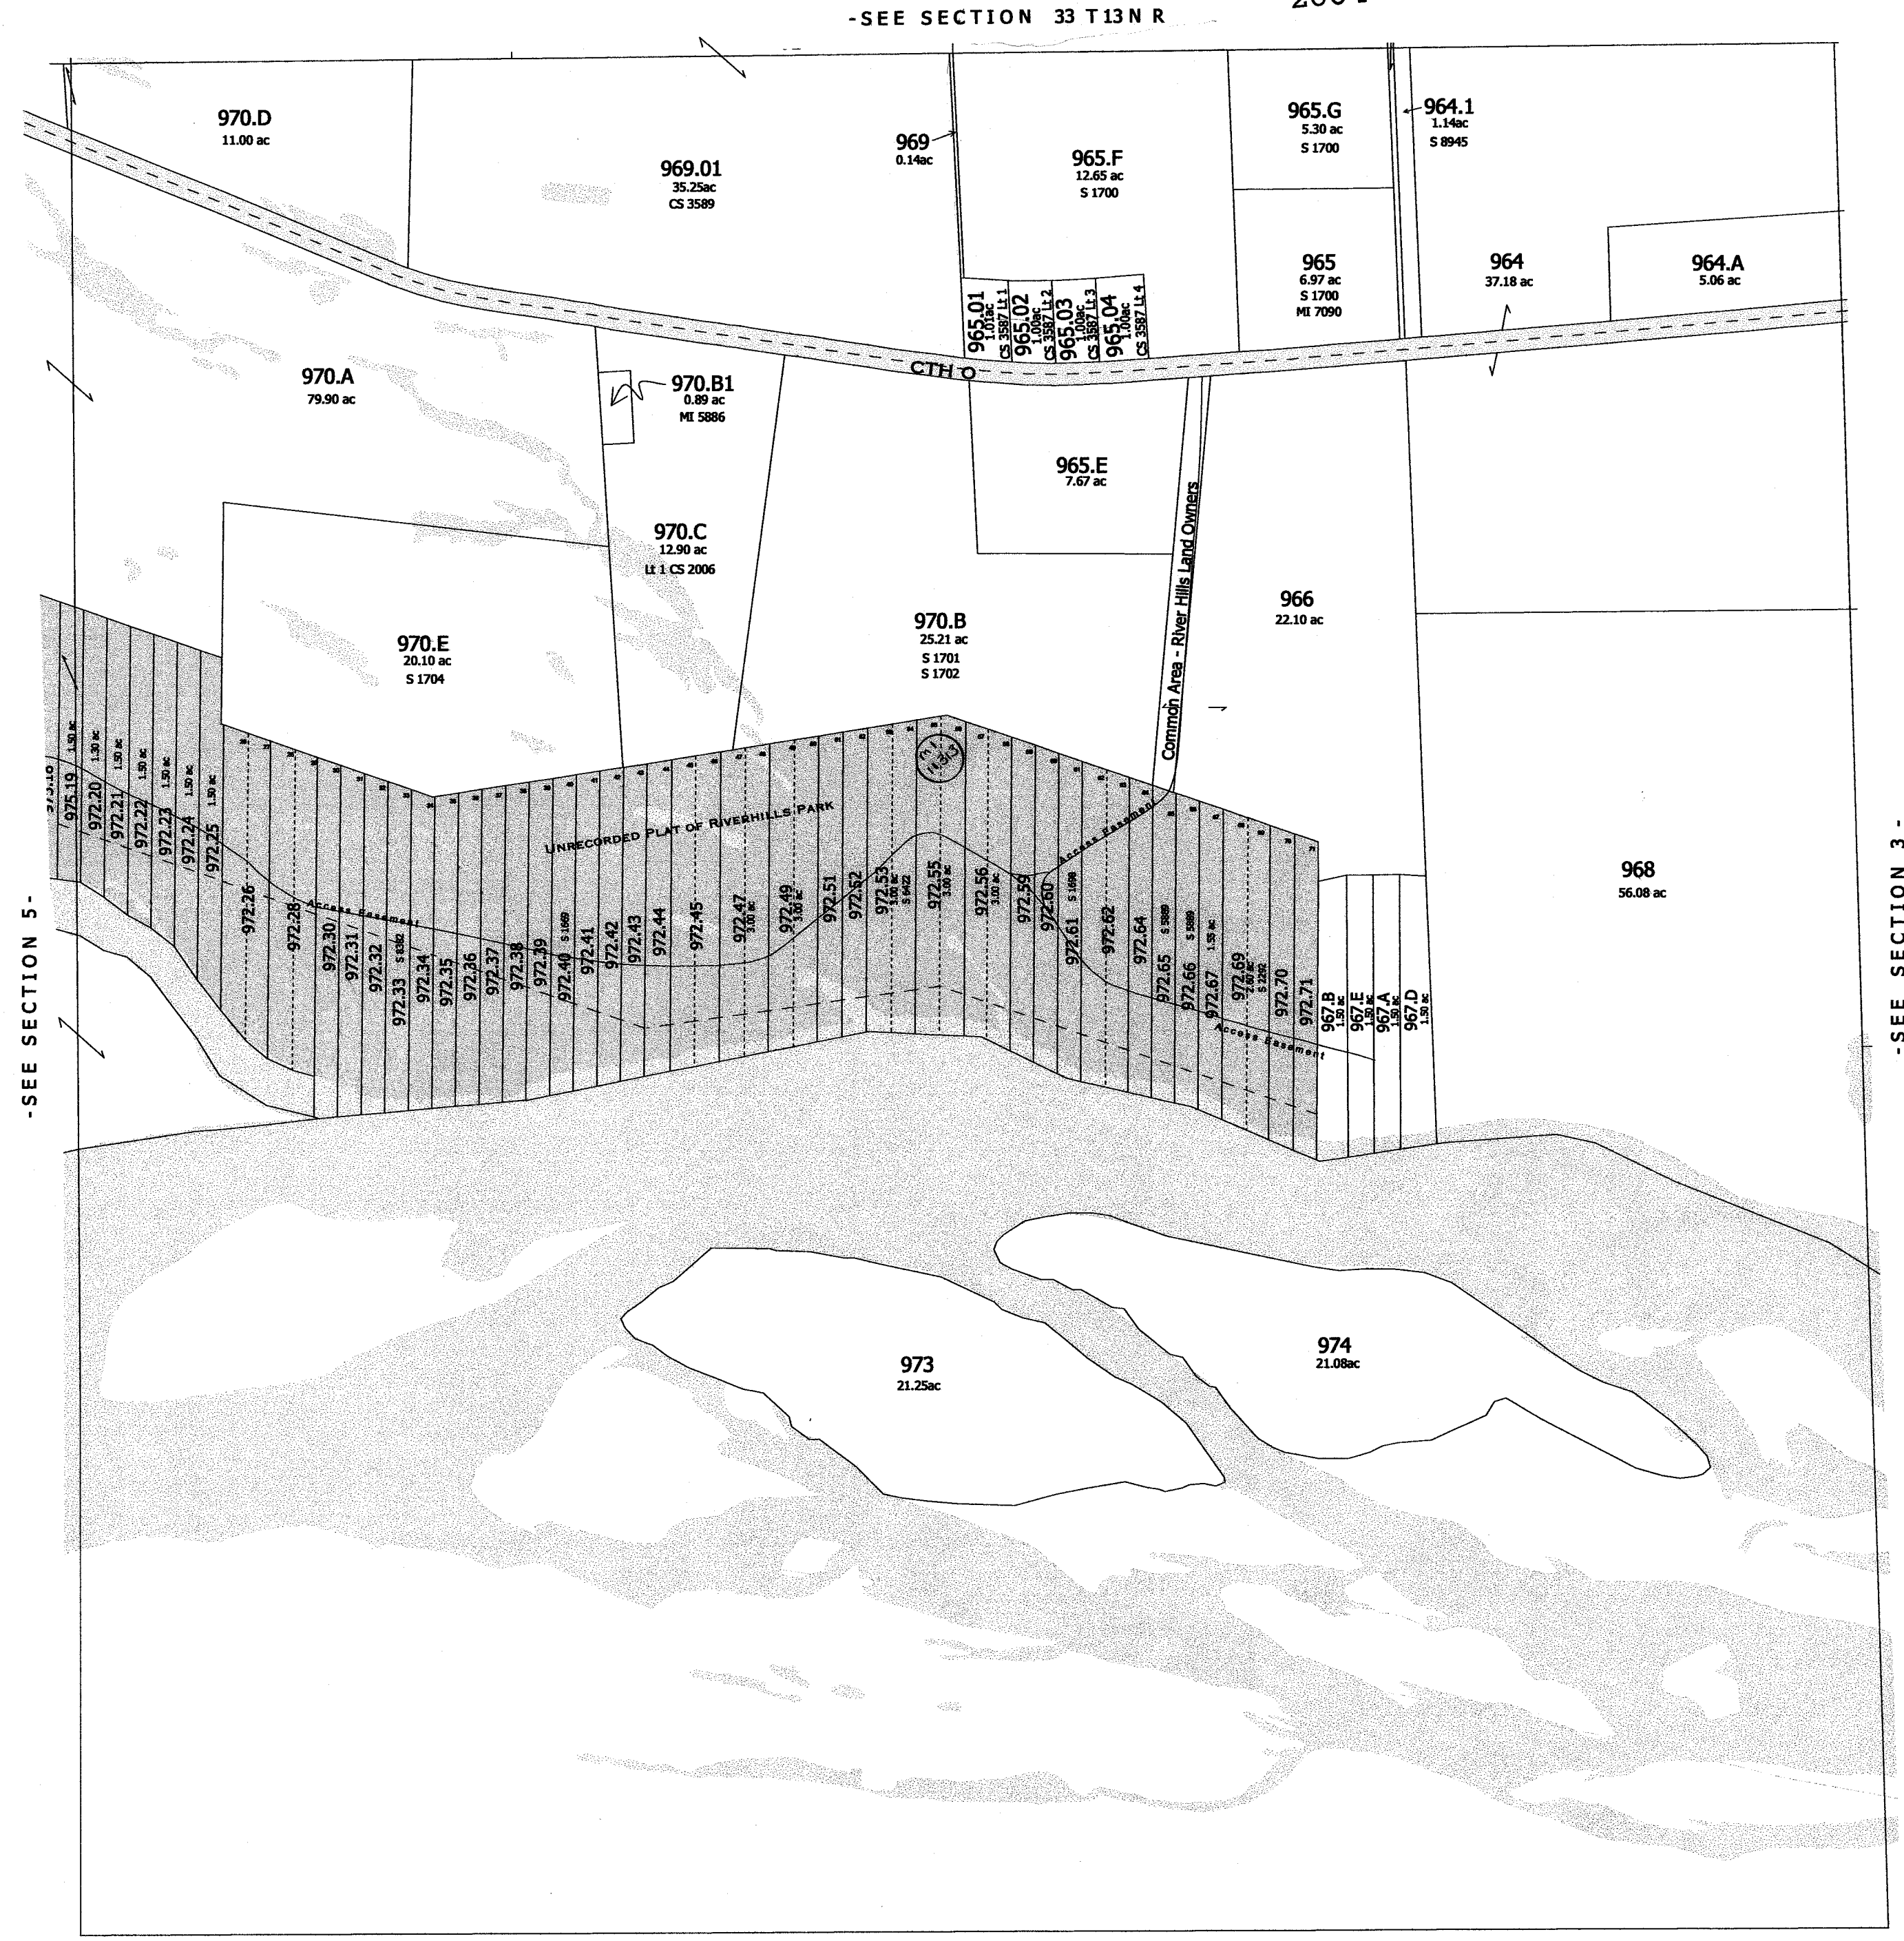

-SEE SECTION 9-

Replaced 2004
-SECTION 4-

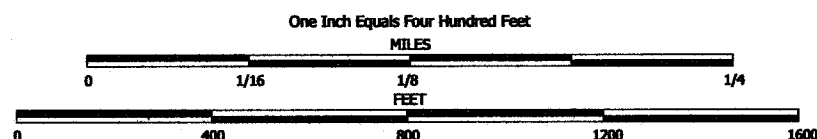


NOTE: This map was prepared for assessment use in accordance with the Wis. Stat. Chap. 70.09. All information contained herein is advisory only. Map accuracy is limited to the quality of data obtained from other Public Records. This map is not intended to be a substitute for an actual field survey. Public Land Survey Base is derived from U.S.G.S. Topographic maps unless otherwise noted. Other sources of the Land Base may be actual survey data. Base map data is from the April 1995 County Digital Orthophotos and/or U.S.G.S. 1:24,000 scale Topographic series. The user is responsible for the improper use of the data contained herein.

Created by The Columbia County Land Information Office -GIS Section. VMB.
March 2004.

TAX PARCEL MAP


TOWN of LEWISTON

TOWN 12 NORTH RANGE 8 EAST
COLUMBIA COUNTY, WISCONSIN

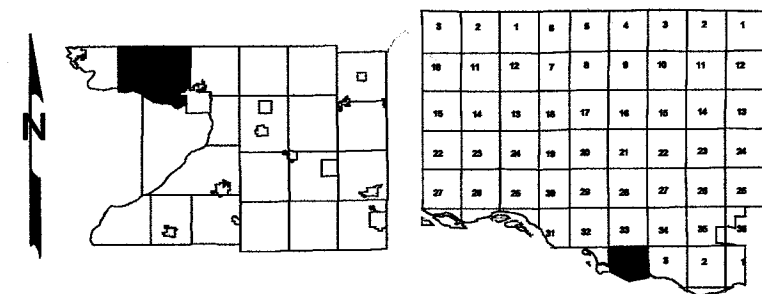

Replaced
2005

-SEE SECTION 33 T13N(R 8E

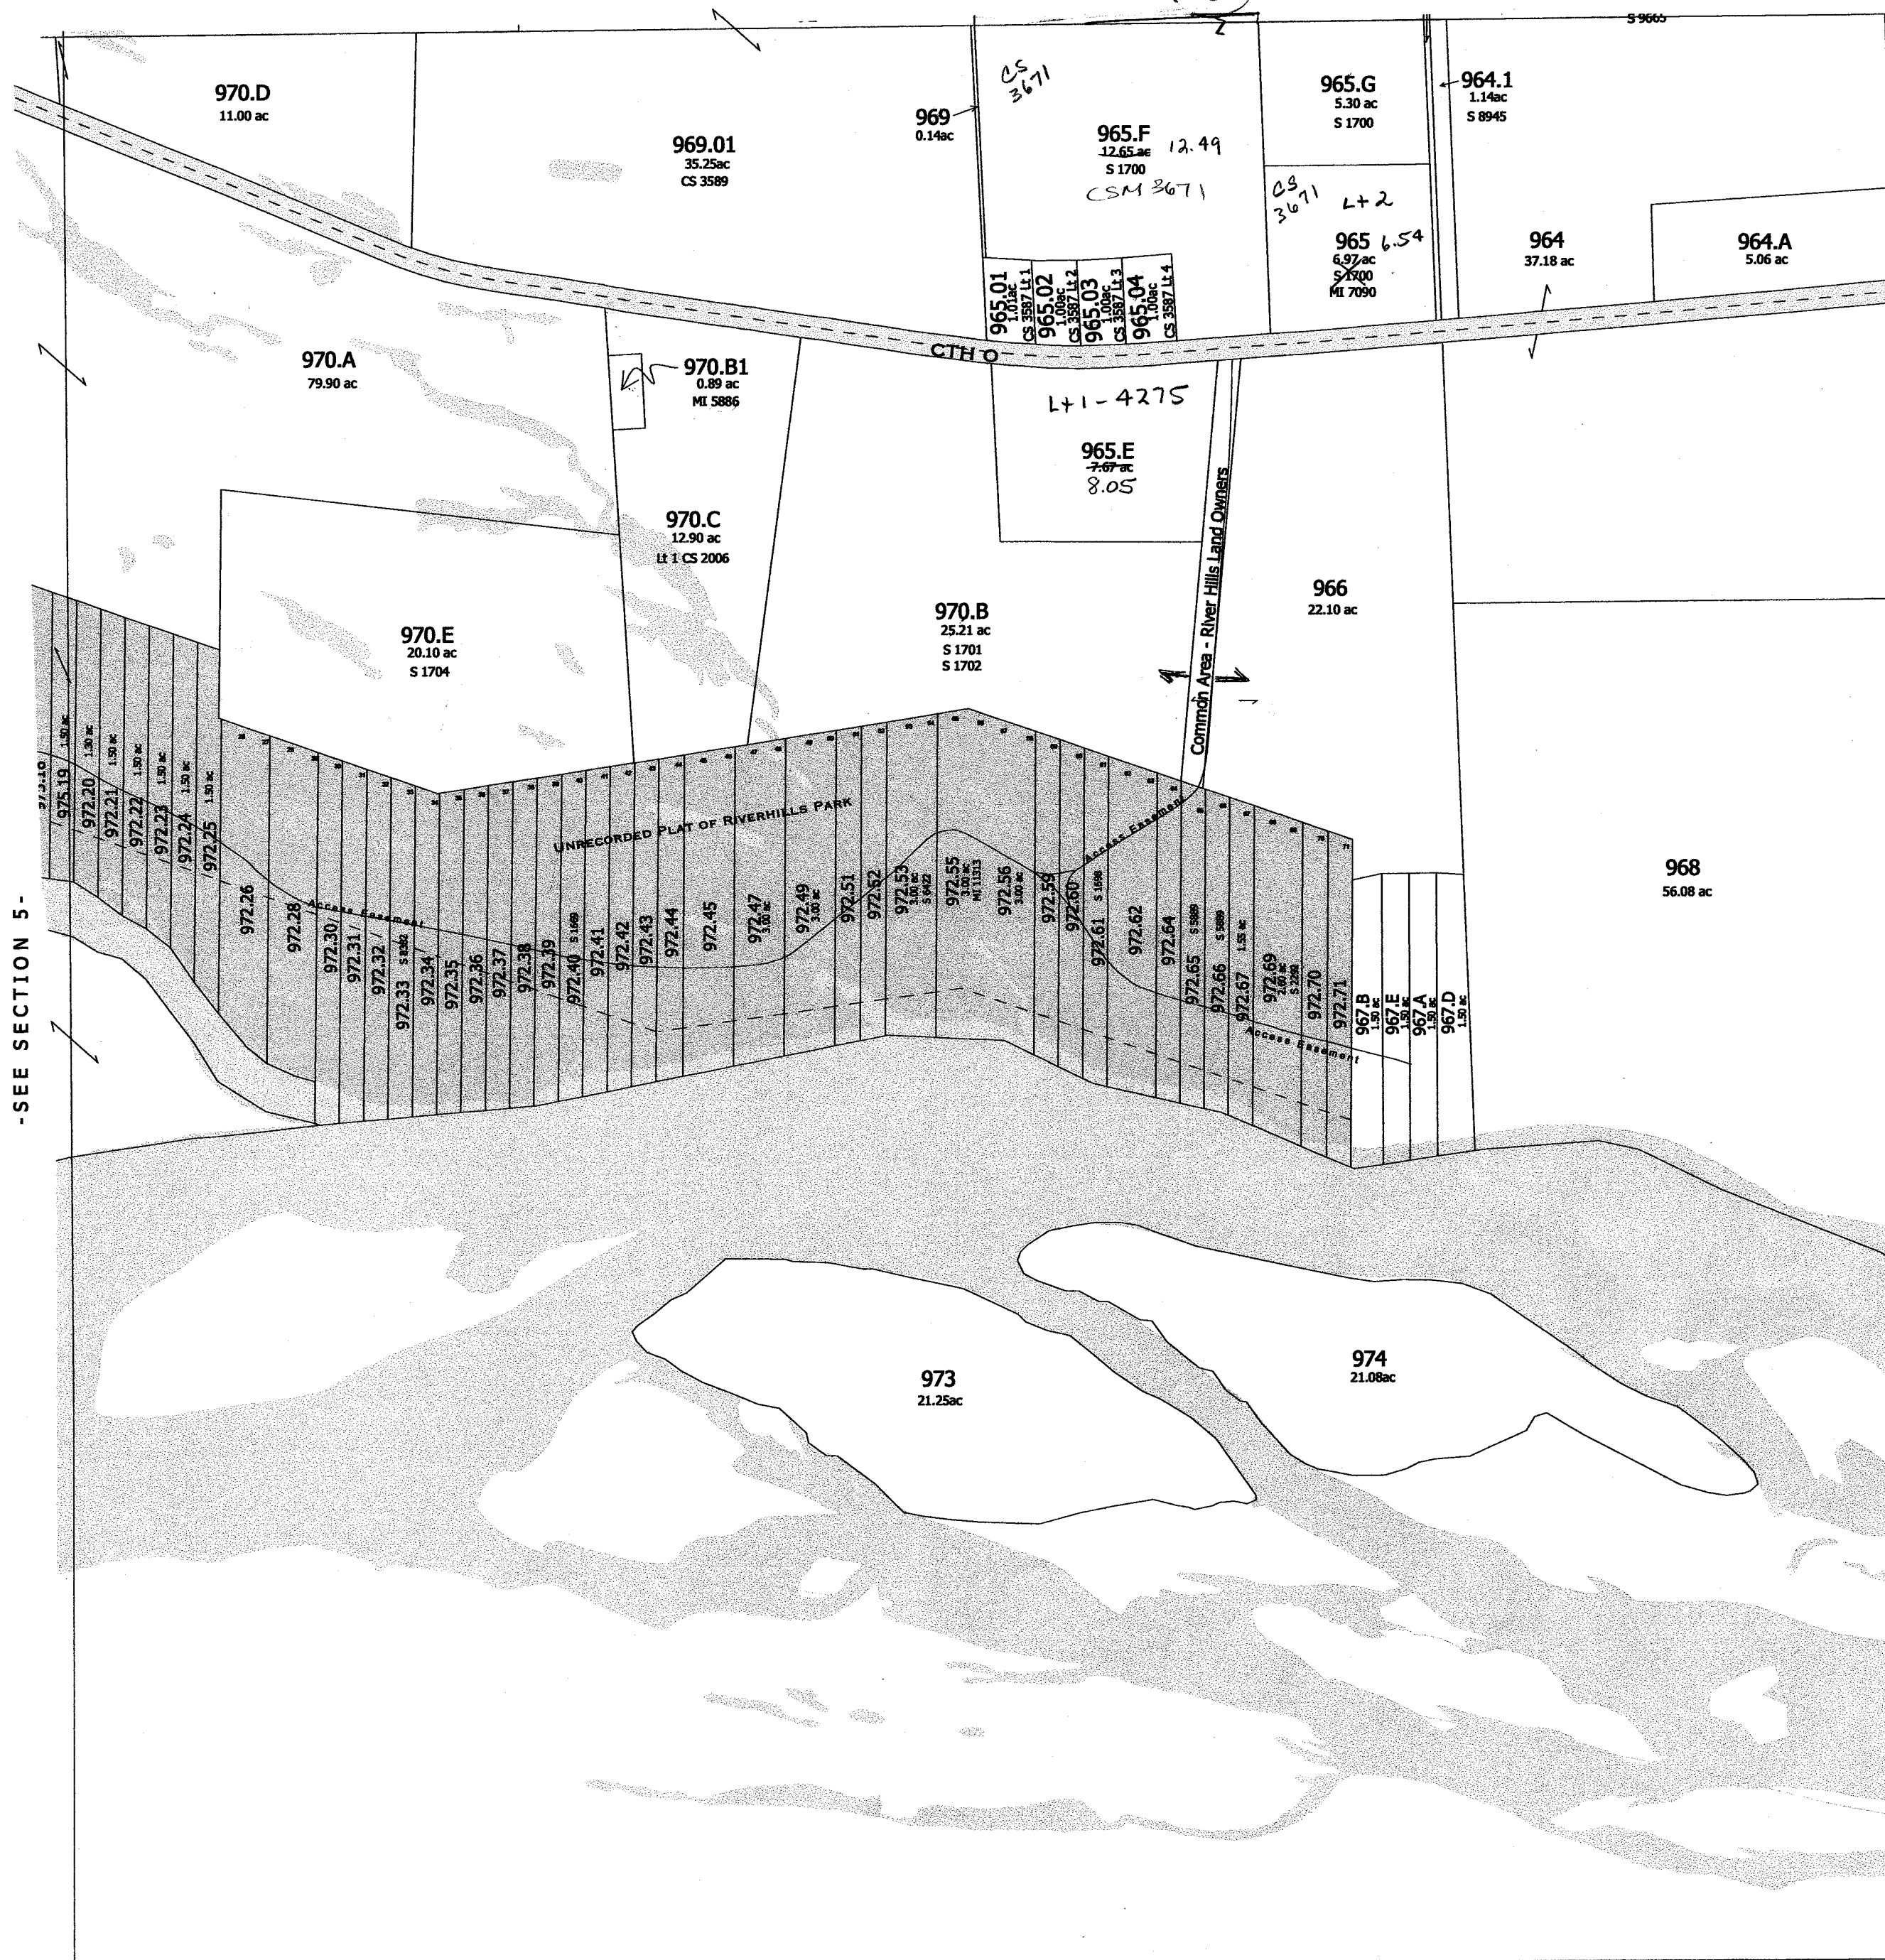


-SEE SECTION 5-

-SEE SECTION 3-

-SEE SECTION 9-

-SECTION 4-

2005

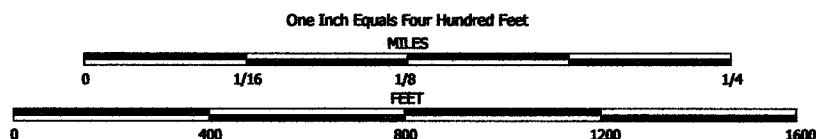

NOTE: This map was prepared for assessment use in accordance with the Wis. St. Stat. Chap. 70.05. All information contained herein is advisory only. Map accuracy is limited to the quality of data obtained from other Public Records. This map is not intended to be a substitute for an actual field survey. Public Land Survey Base is derived from U.S.G.S. Topographic maps unless otherwise noted. Other sources of the Land Base may be actual survey data. Base map data is from the April 1995 County Digital Orthophotos and/or U.S.G.S. 1:24,000 scale Topographic series. The user is responsible for the improper use of the data contained herein.



Created by The Columbia County Land Information Office -GIS Section. VMB.
February 2005.

TAX PARCEL MAP


TOWN of LEWISTON

TOWN 12 NORTH RANGE 8 EAST
COLUMBIA COUNTY, WISCONSIN

Replaced
2006

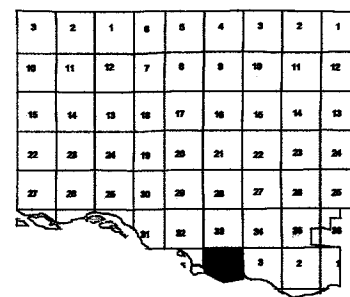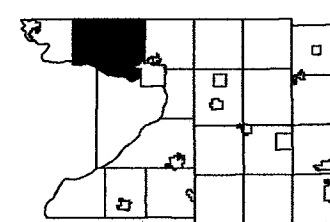

-SEE SECTION 33 T13N R8E-

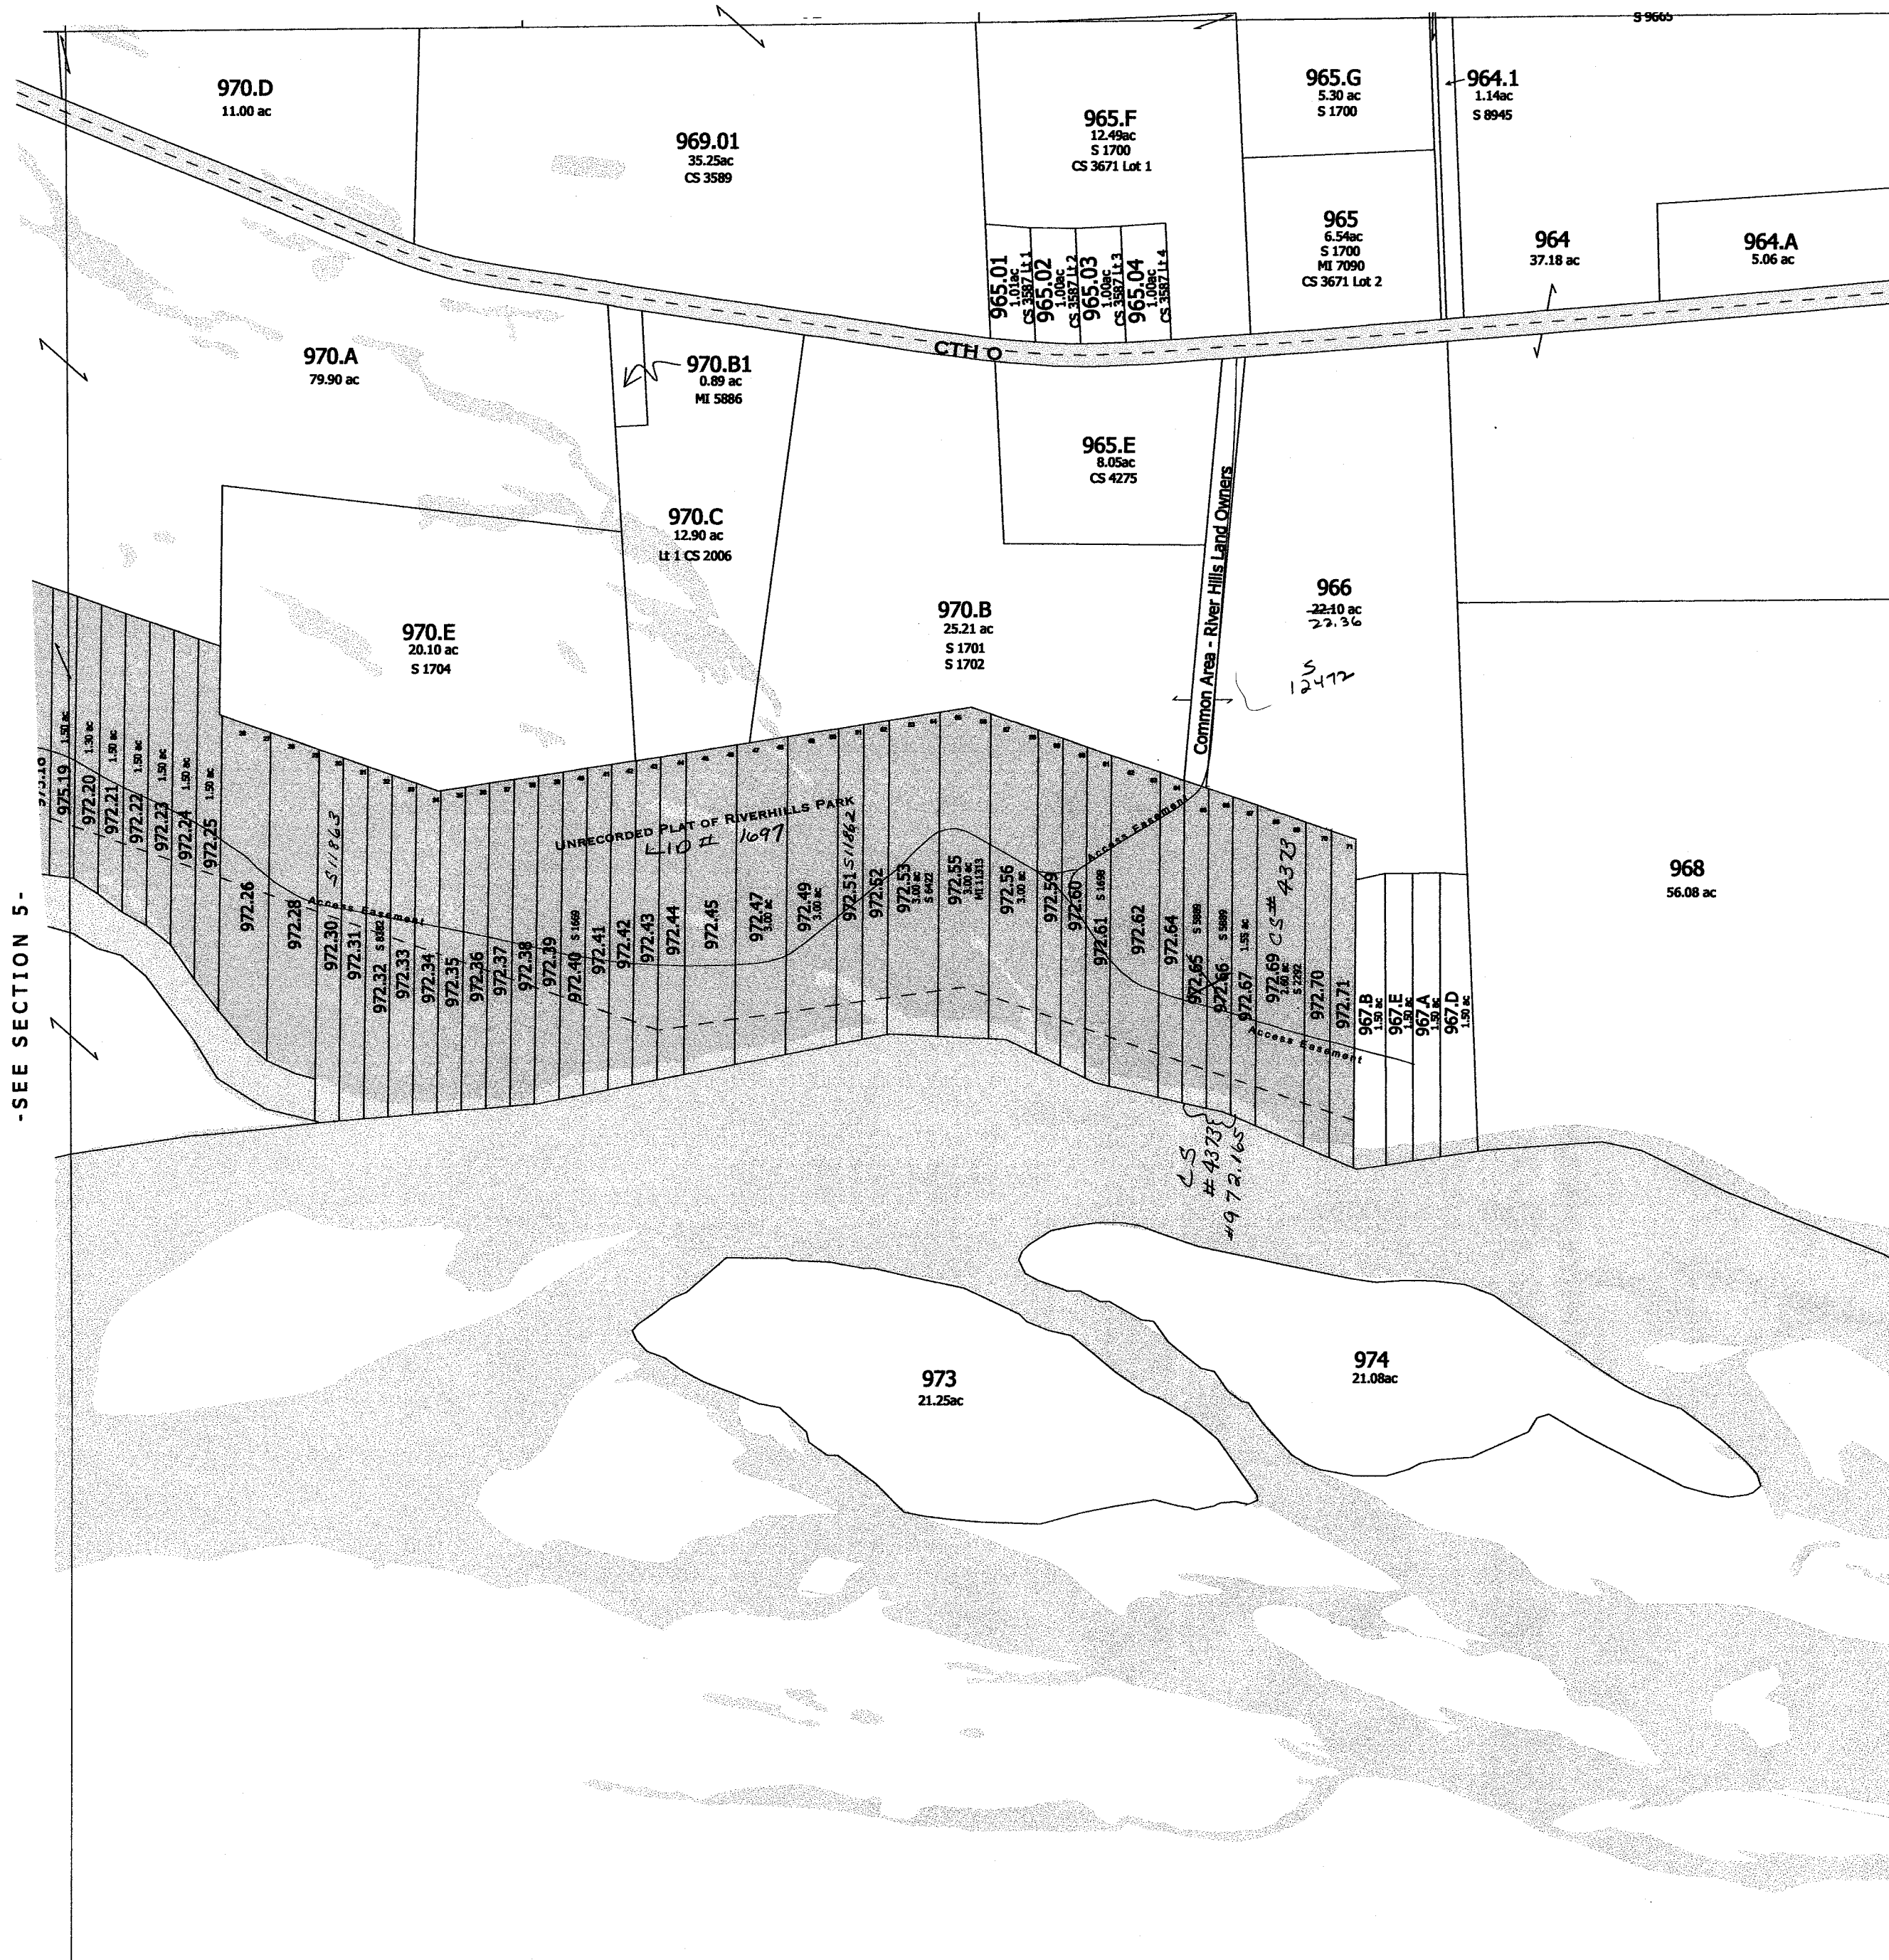


-SEE SECTION 5-

-SEE SECTION 3-

-SEE SECTION 9-

-SECTION 4-

Replaced
2006

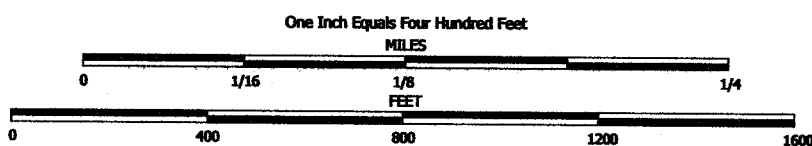


NOTE: This map was prepared for assessment use in accordance with the Wis. St. Stat. Chap. 70.09. All information contained herein is advisory only. Map accuracy is limited to the quality of data obtained from other Public Records. This map is not intended to be a substitute for an actual field survey. Public Land Survey Base is derived from U.S.G.S. Topographic maps unless otherwise noted. Other sources of the Land Base may be actual survey data. Base map data is from the April 1995 County Digital Orthophotos and/or U.S.G.S. 1:24,000 scale Topographic series. The user is responsible for the improper use of the data contained herein.

Created by The Columbia County Land Information Office -GIS Section. VMB.
February 2006.

TAX PARCEL MAP

TOWN of LEWISTON


TOWN 12 NORTH RANGE 8 EAST
COLUMBIA COUNTY, WISCONSIN

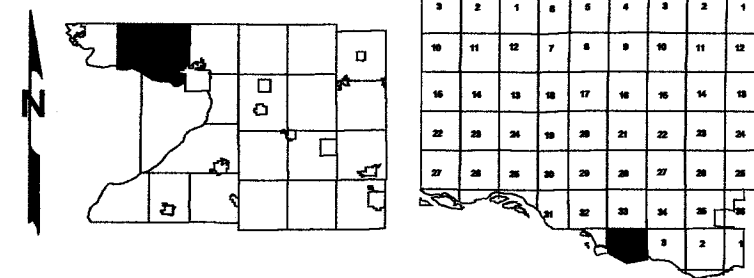

Replaced

2007

-SEE SECTION 33 T13N R8E-

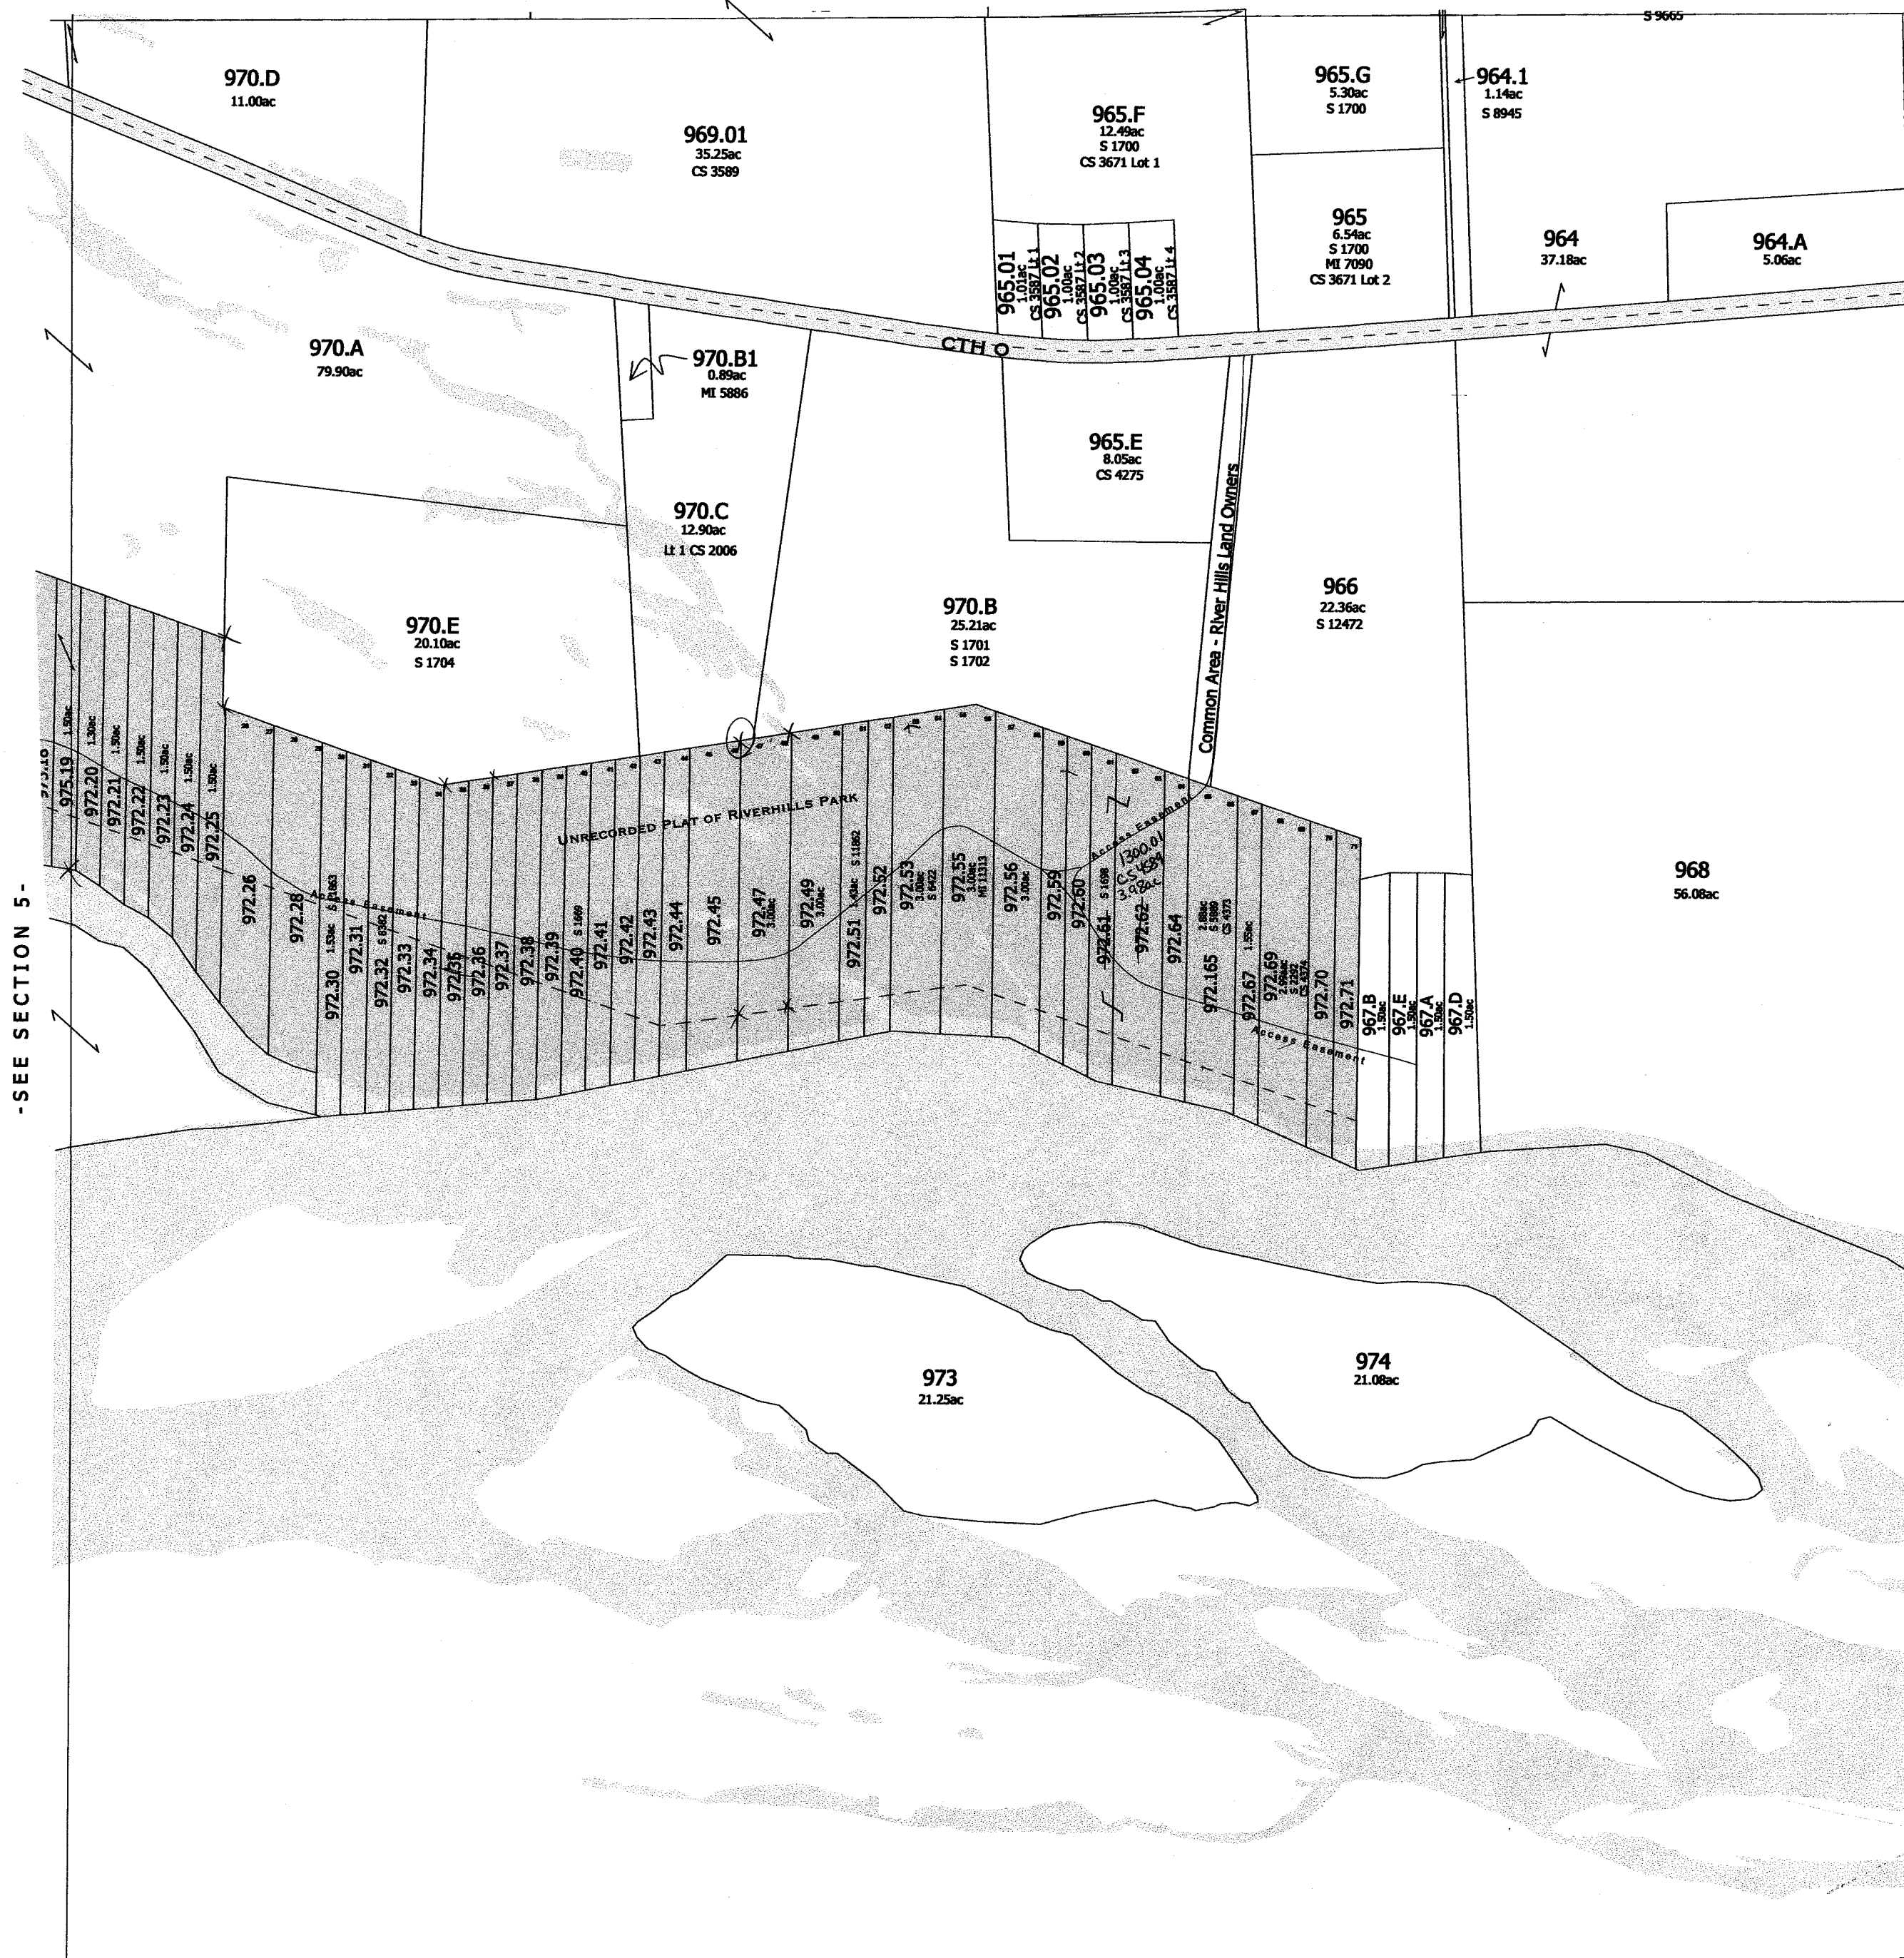

-SEE SECTION 5-

-SEE SECTION 3-

-SEE SECTION 9-

-SECTION 4-

Replaced
2007

LEWISTON


SEC. 4 & PART OF SEC. 5 T12N R8E

Replaced
2002

RIVERHILLS 1697

PARK

Unrecorded PLAT

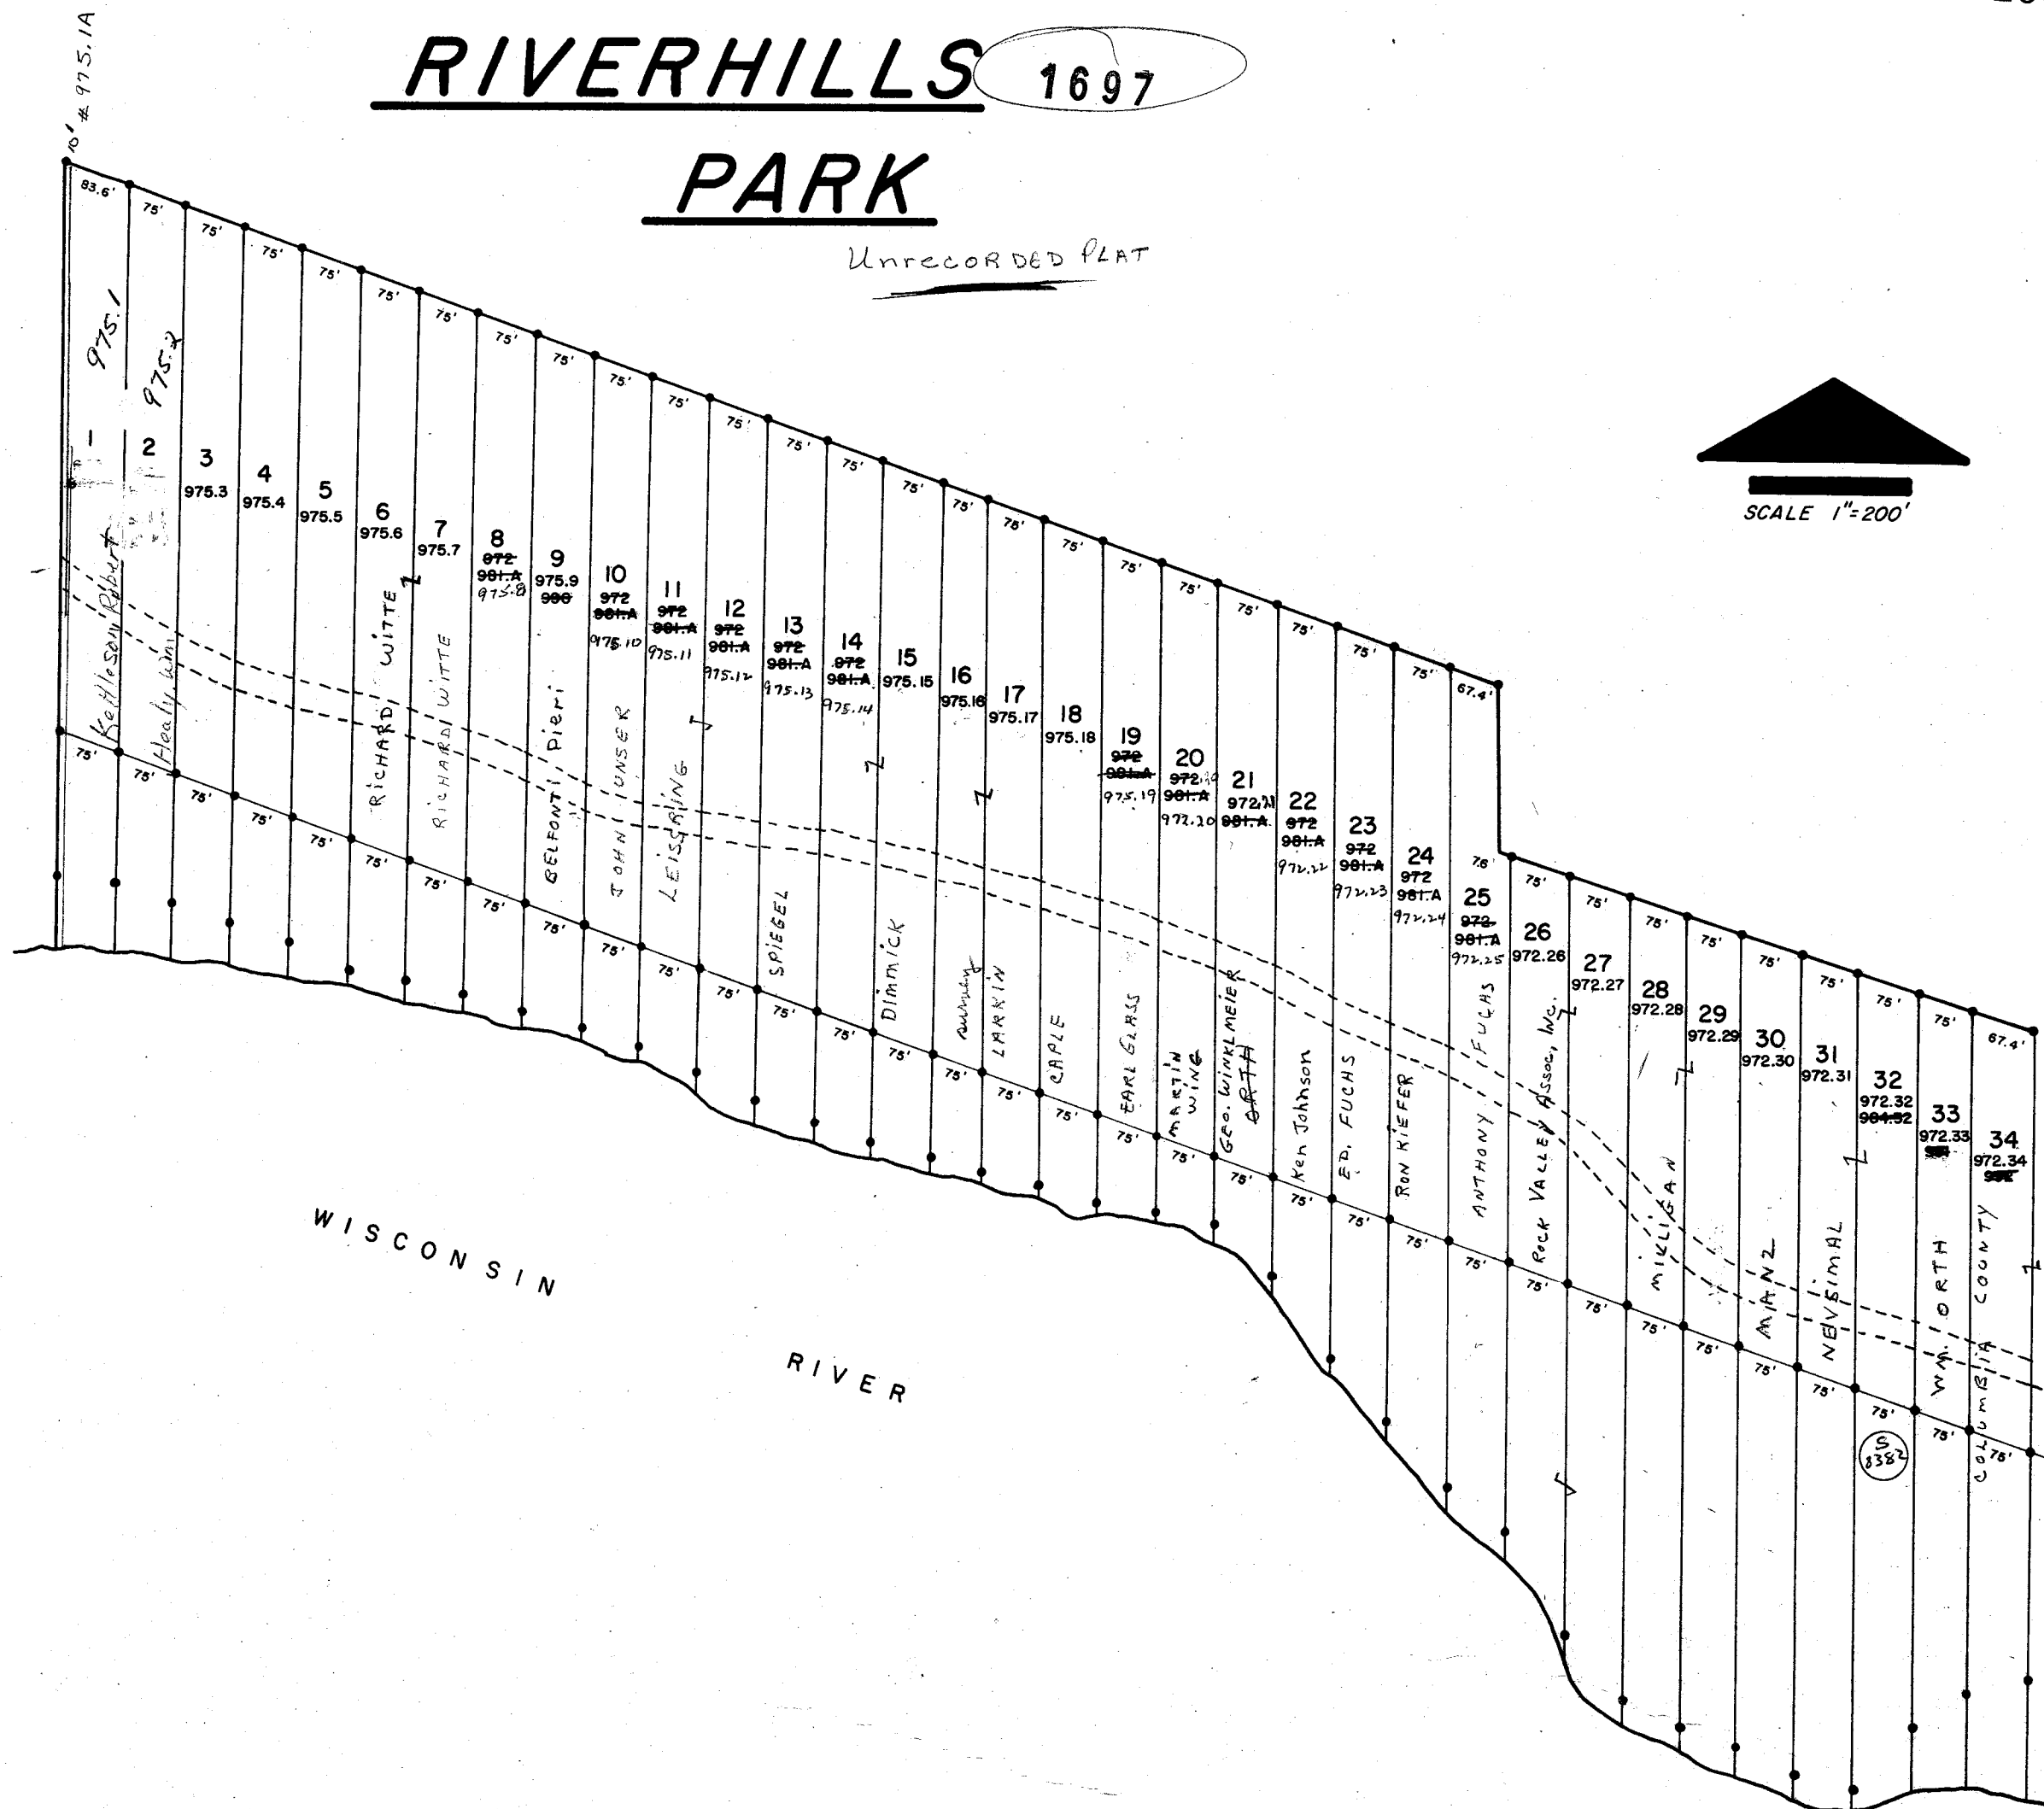


LEWISTON
SEC. 4 T12N R8E

Replaced
2002

RIVERHILLS
PARK


1697

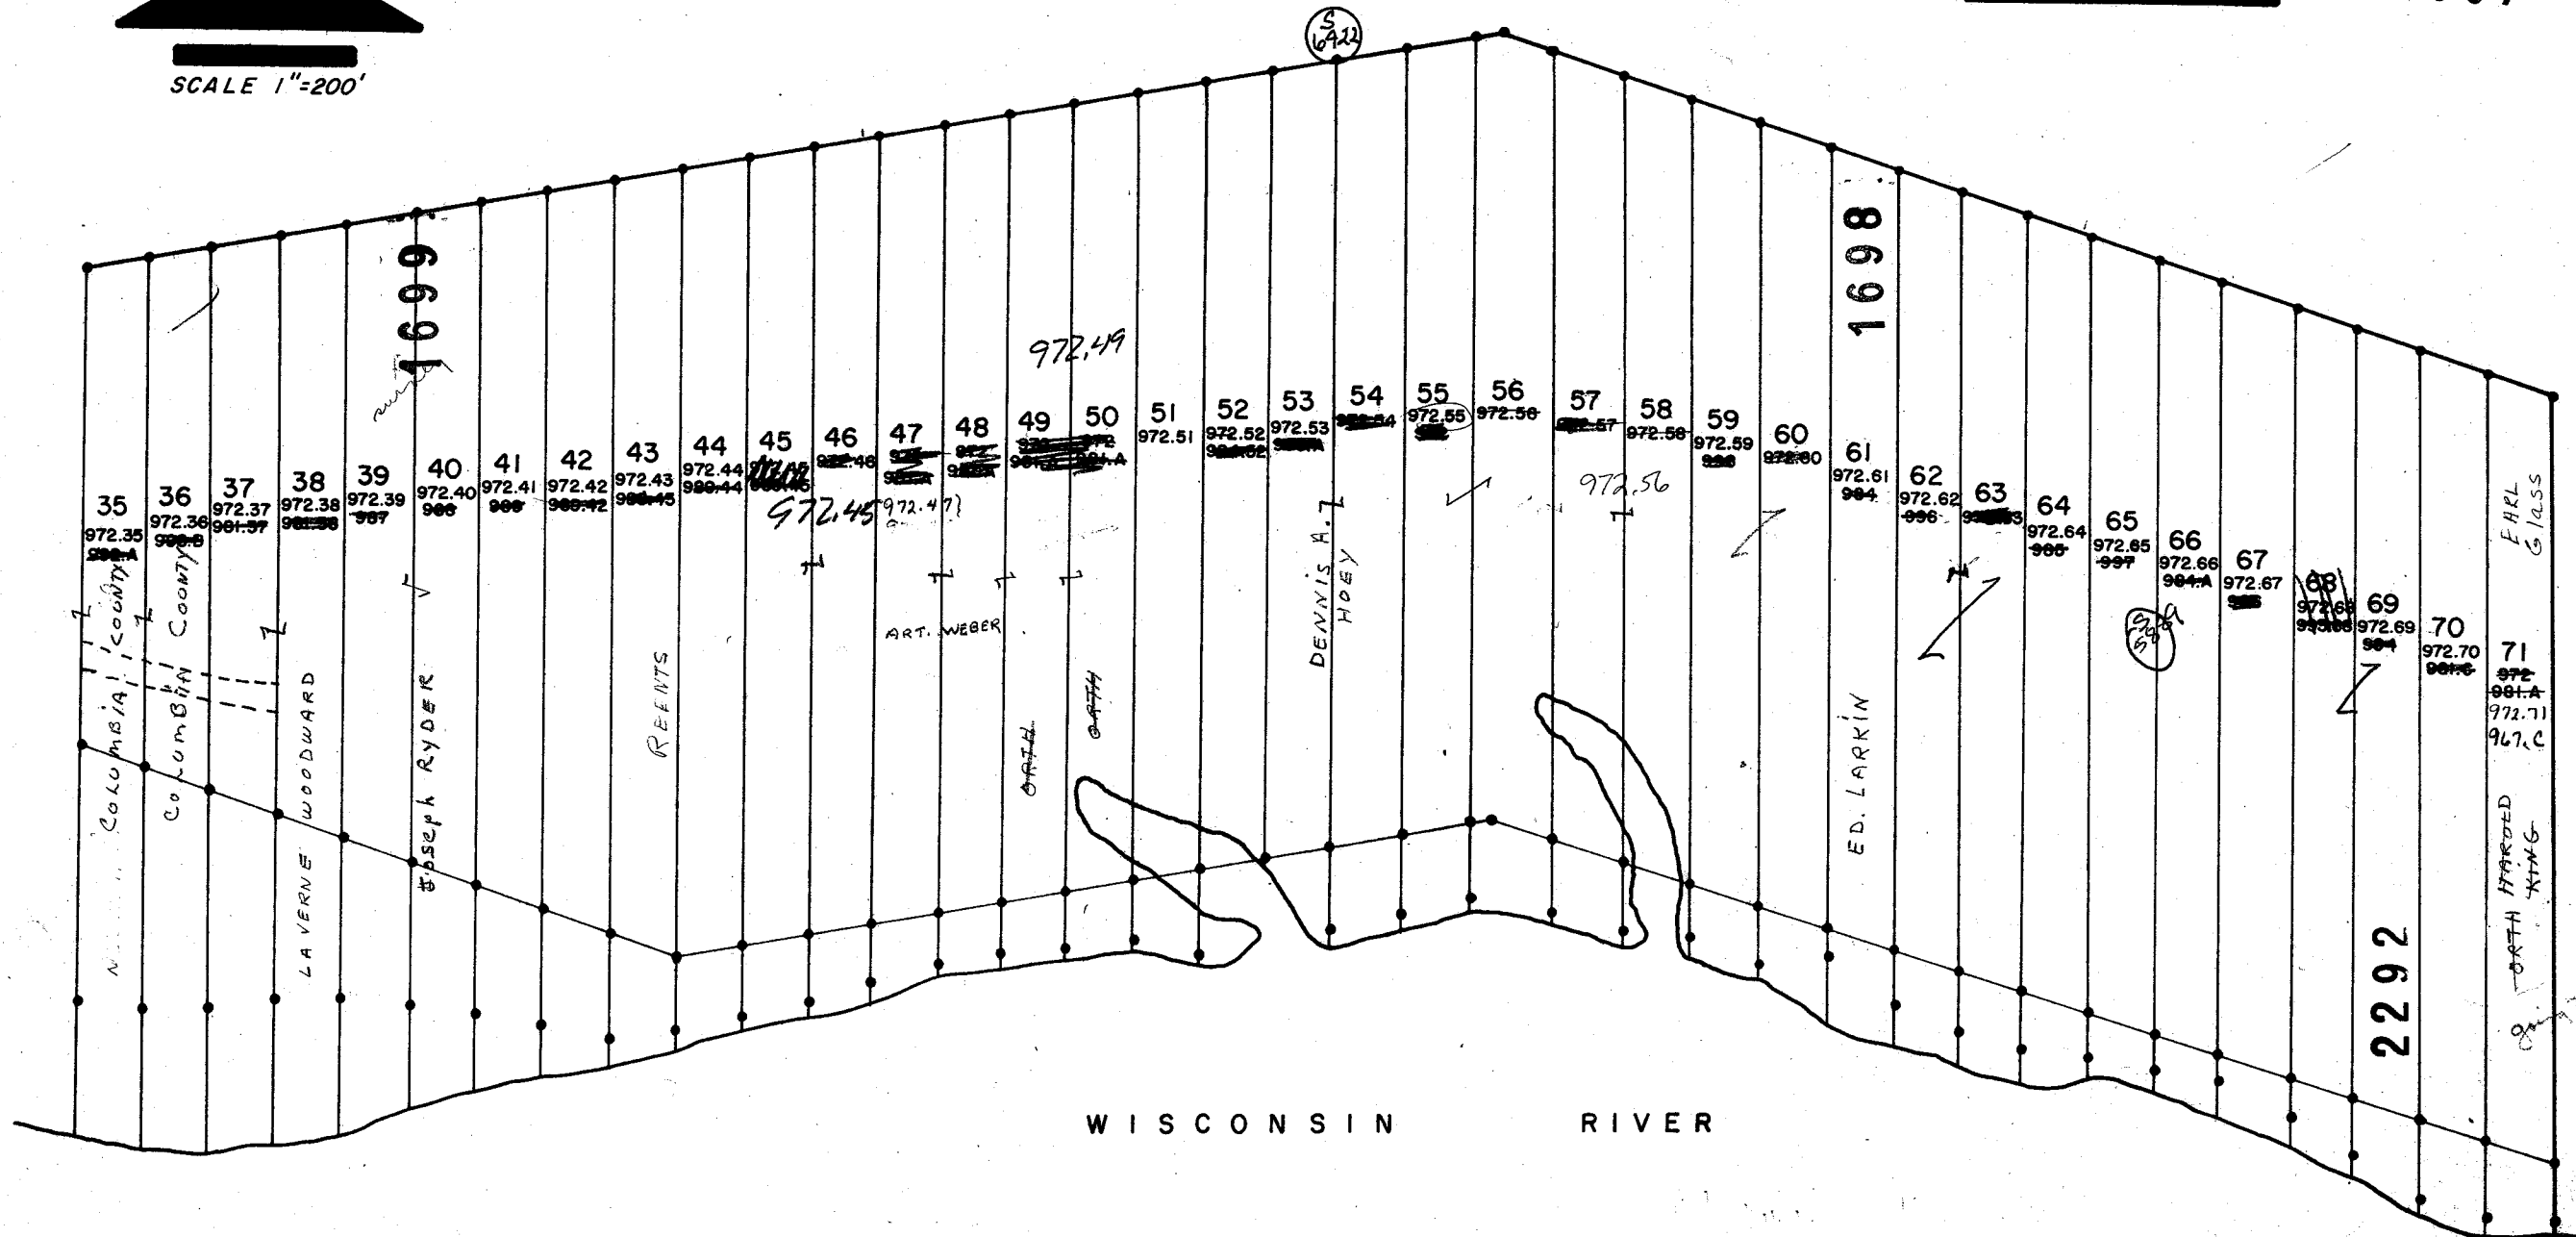

LEWISTON


SEC. 5 T12N R8E

Replaced
2002

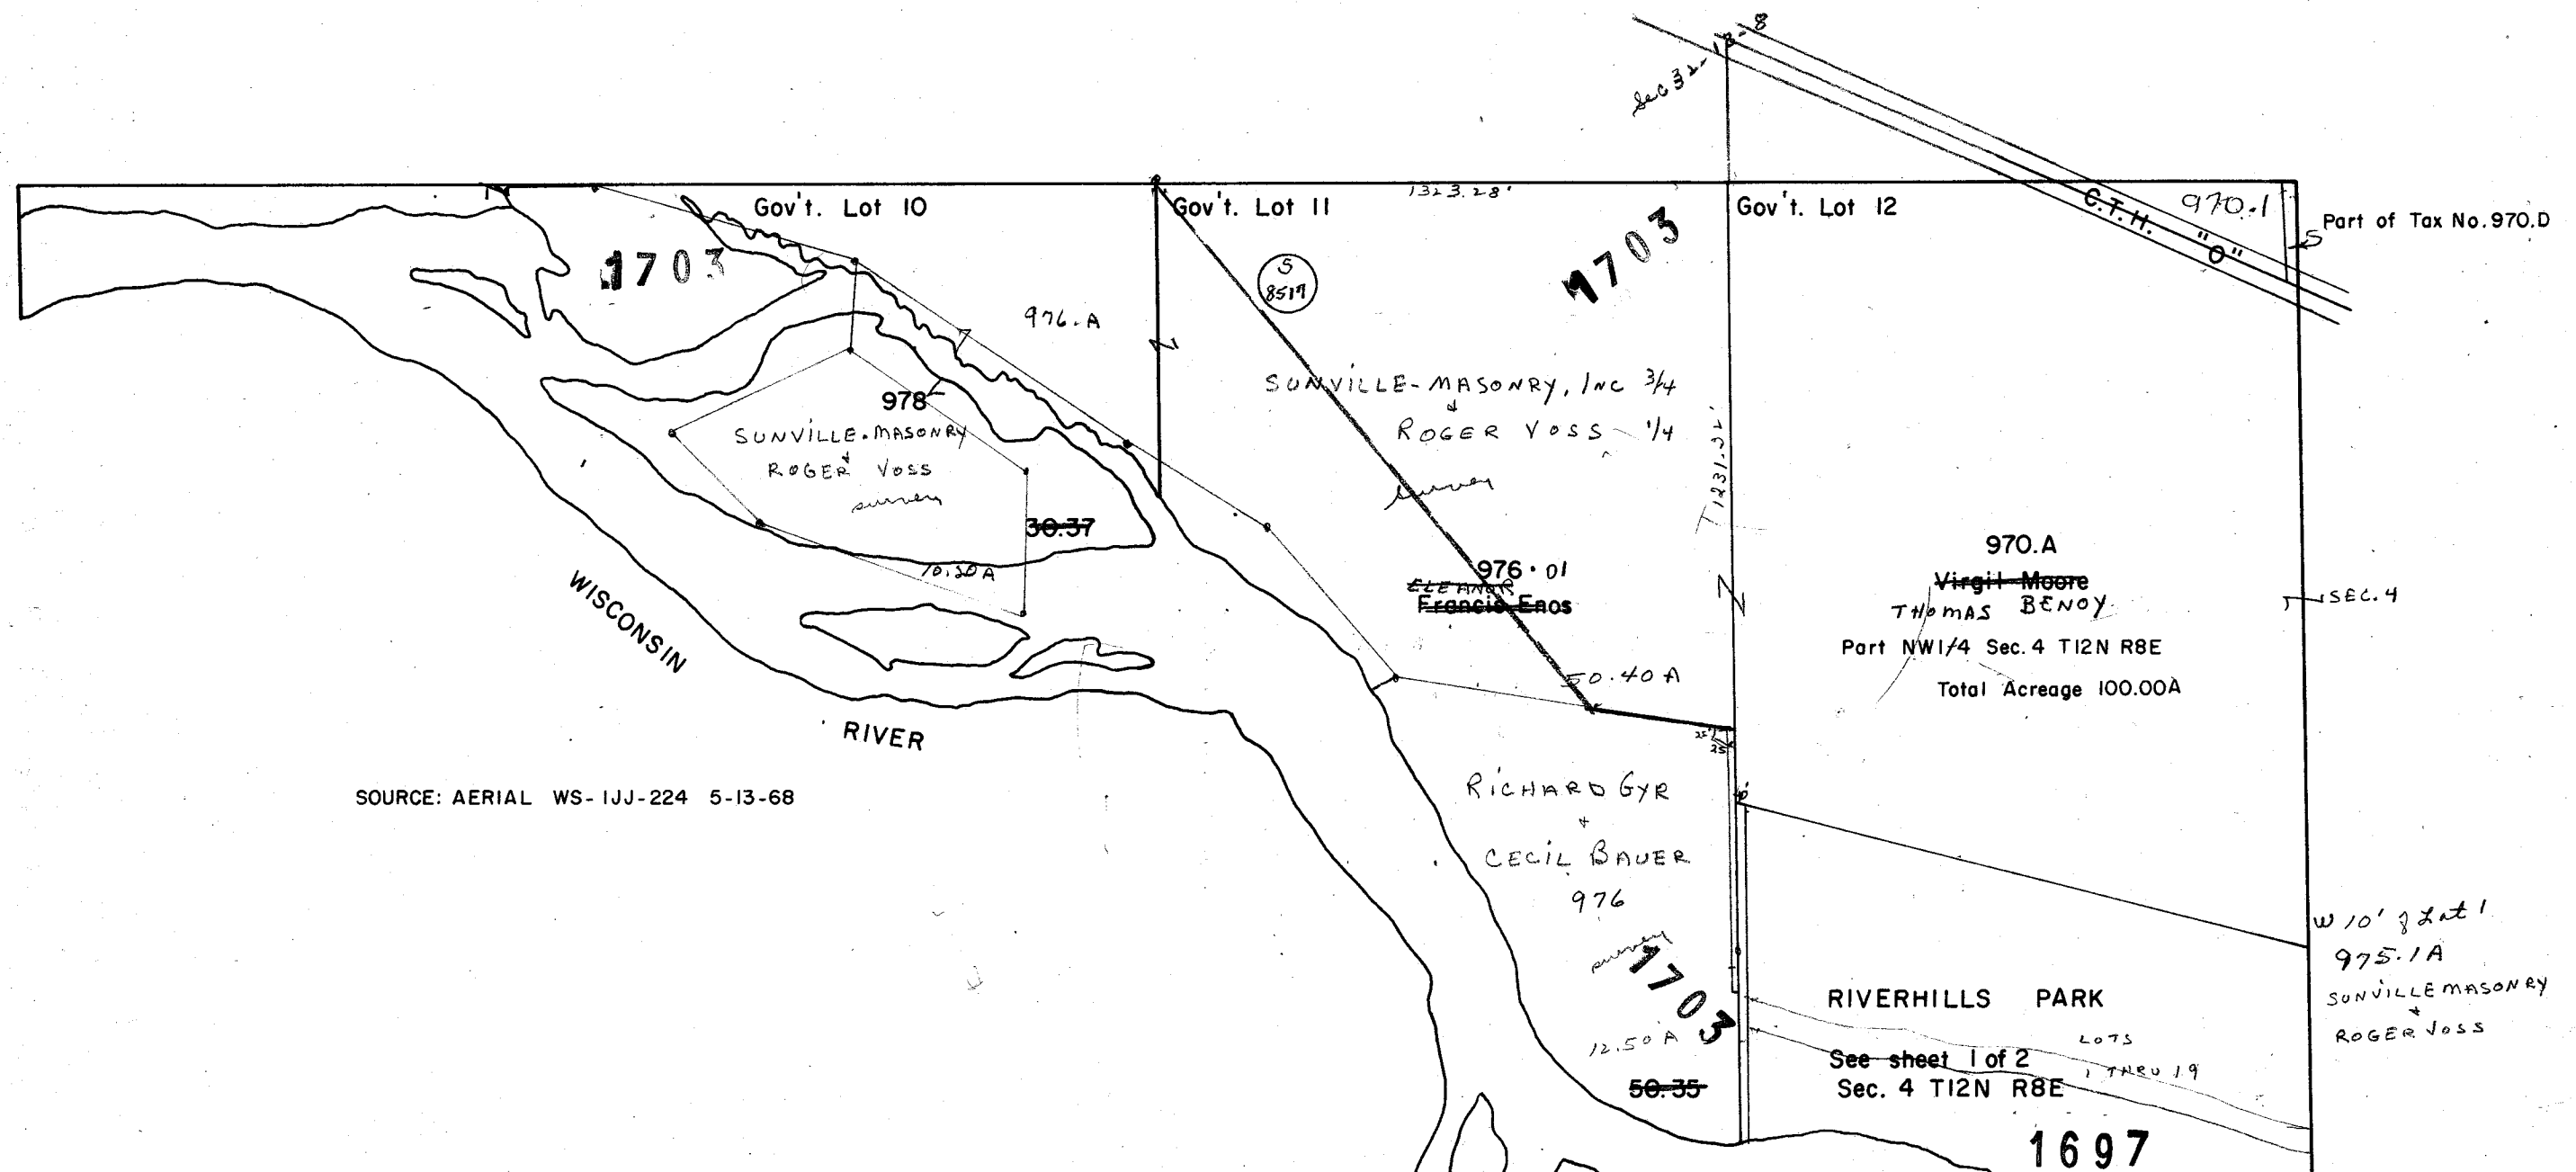


SEC. 10

SEC. 11

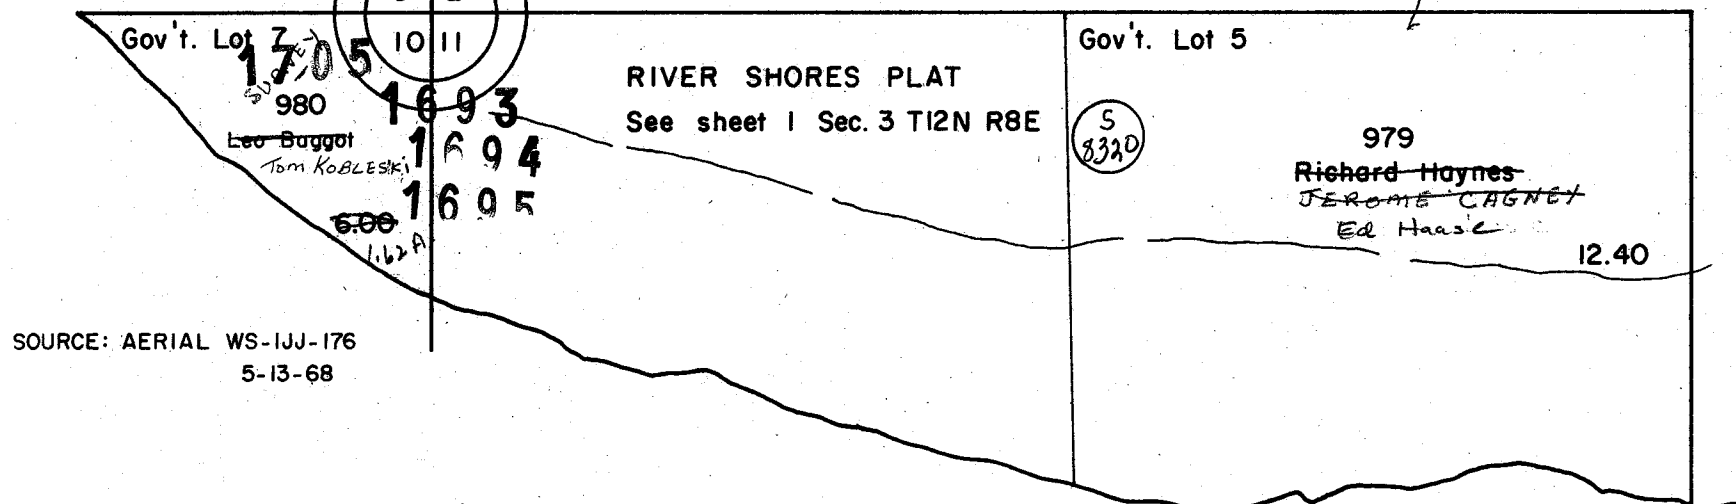

SOURCE: AERIAL WS-IJJ-161 5-13-68

T12 R08 SECTION 6 → Underwater by
these maps!
SEE
T12 R8 Section 31

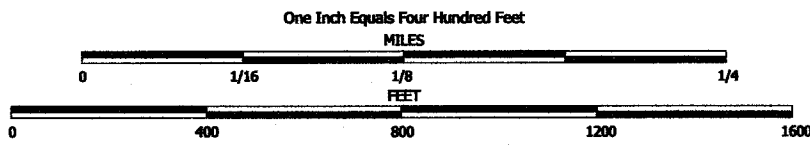

NOTE: This map was prepared for assessment use in accordance with the Wis. St. Stat. Chap. 70.09. All information contained herein is advisory only. Map accuracy is limited to the quality of data obtained from other Public Records. This map is not intended to be a substitute for an actual field survey. Public Land Survey Base is derived from U.S.G.S. Topographic maps unless otherwise noted. Other sources of the Land Base may be actual survey data. Base map data is from the April 1995 County Digital Orthophotos and/or U.S.G.S. 1:24,000 scale Topographic series. The user is responsible for the improper use of the data contained herein.



Created by The Columbia County Land Information Office -GIS Section. VMB.
September 2002.

TAX PARCEL MAP


TOWN of LEWISTON

TOWN 12 NORTH RANGE 8 EAST
COLUMBIA COUNTY, WISCONSIN

Replaced
2003

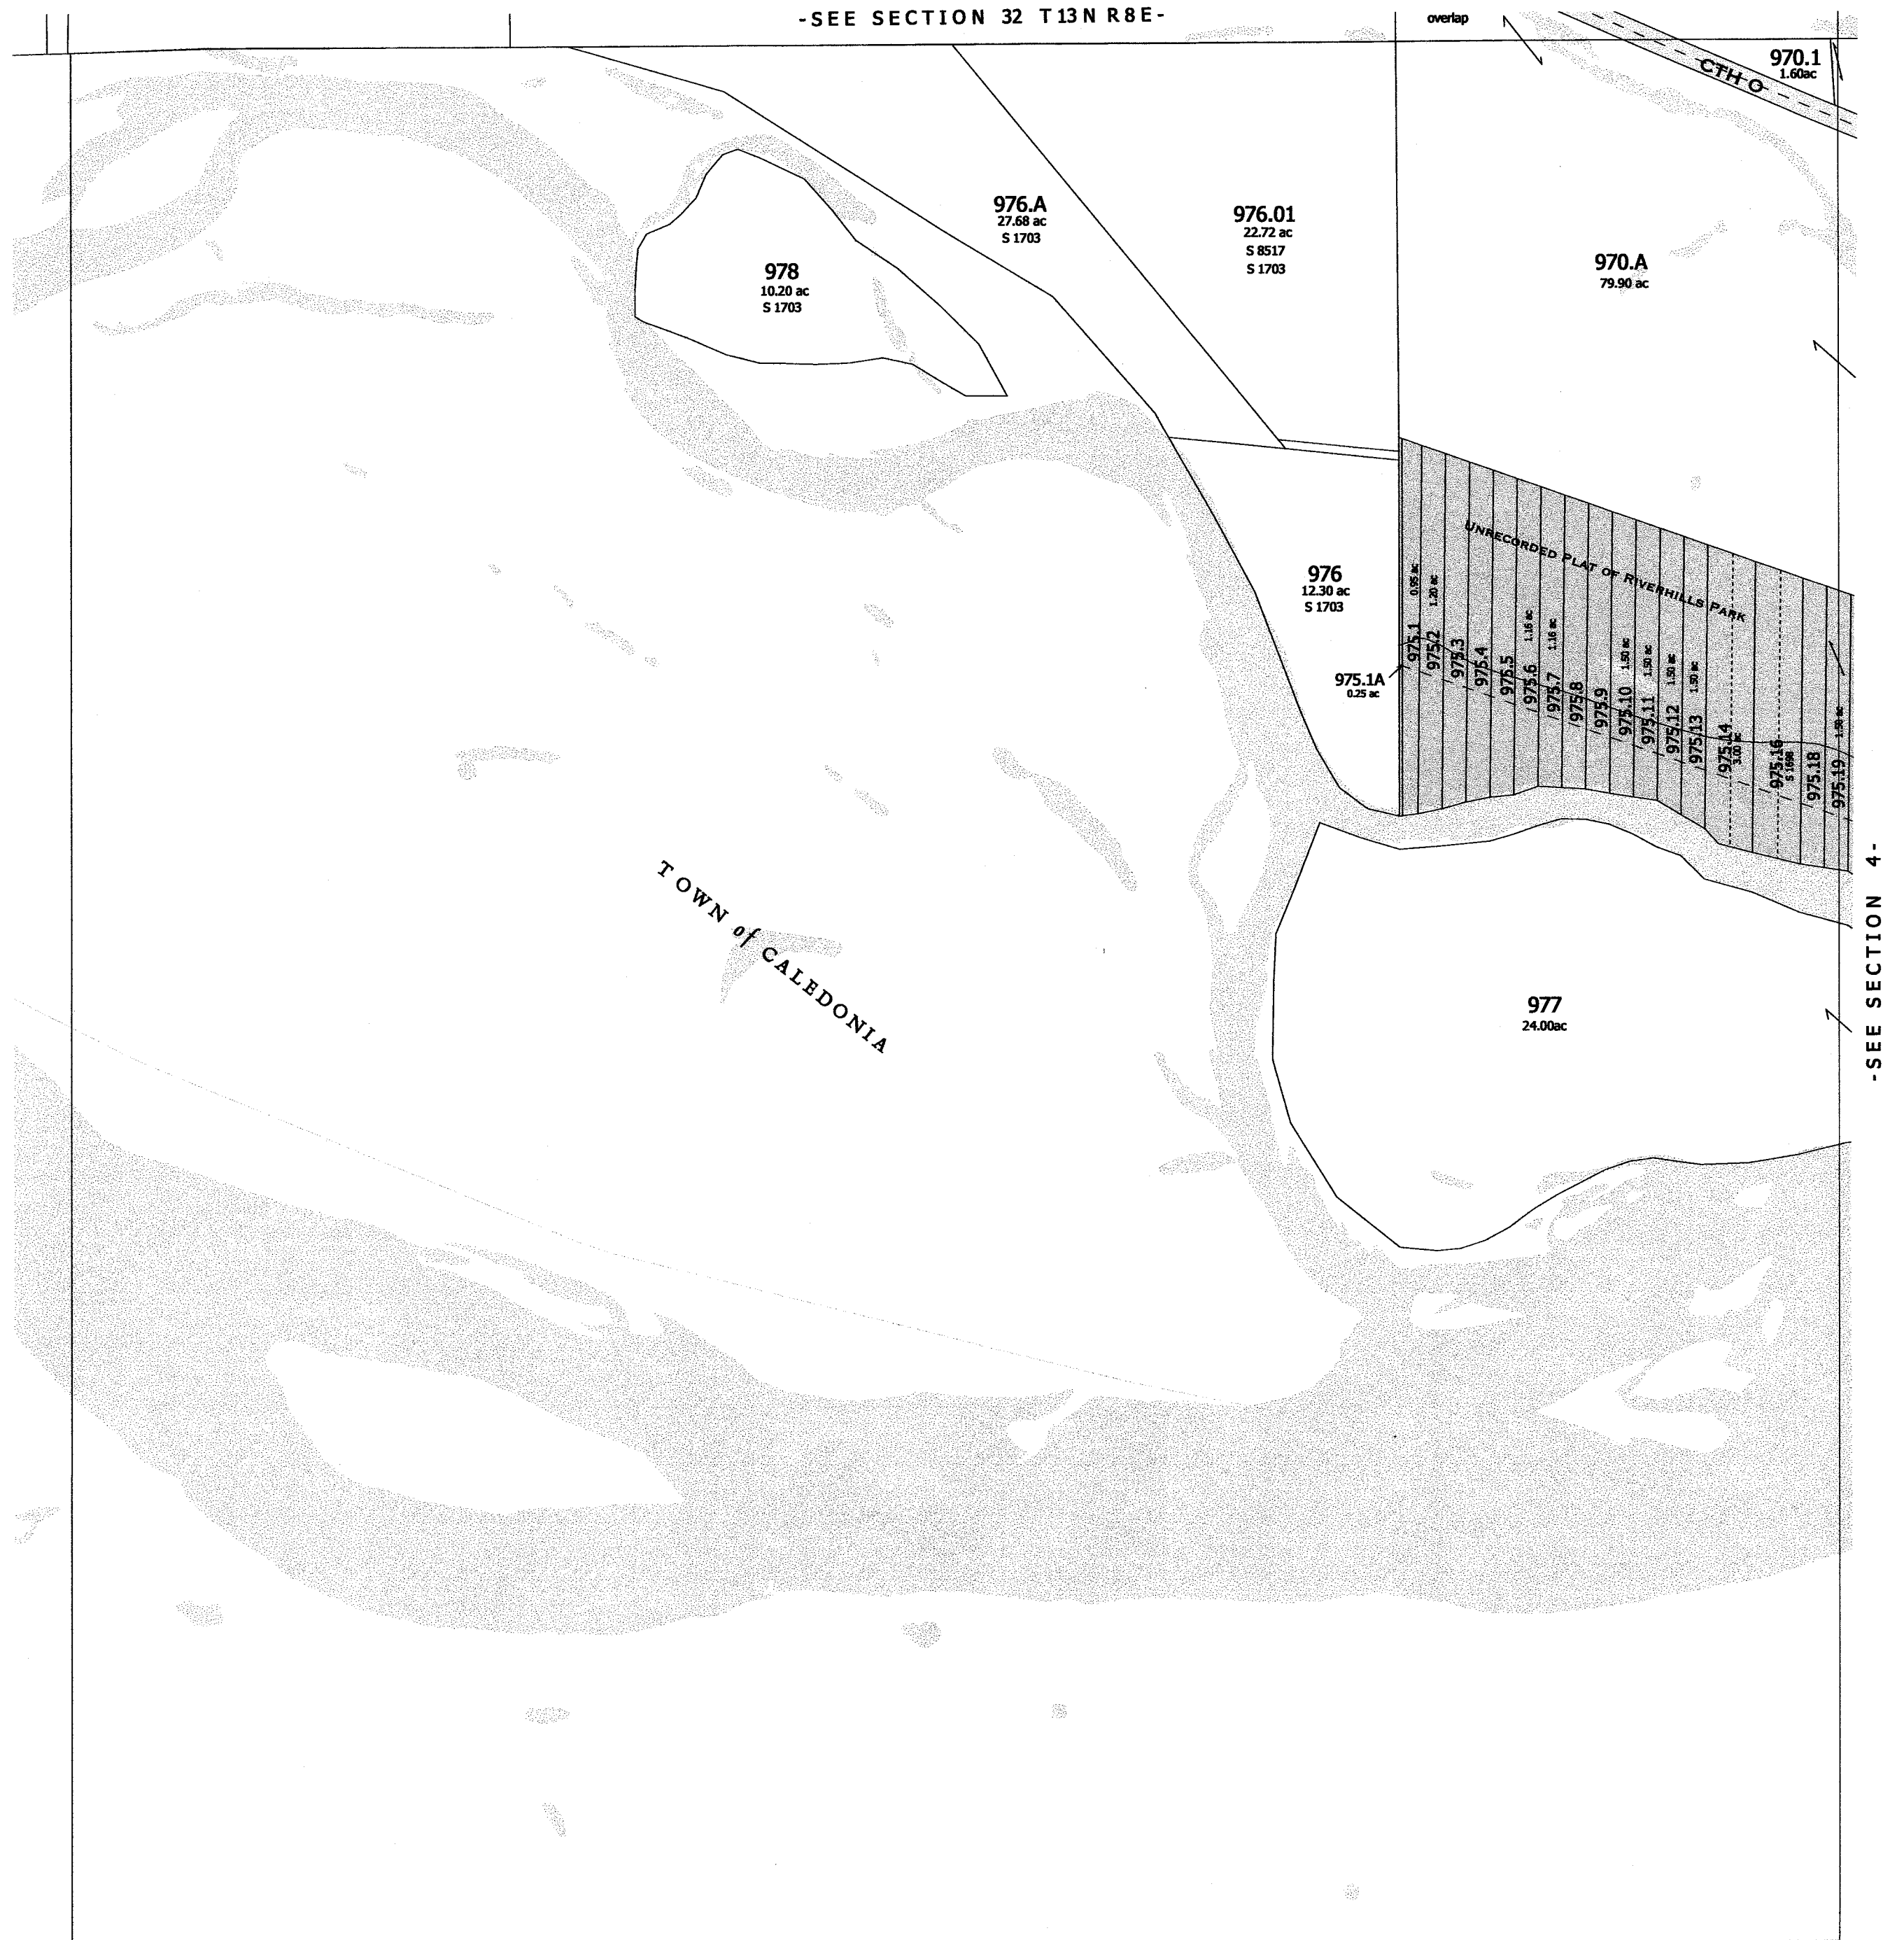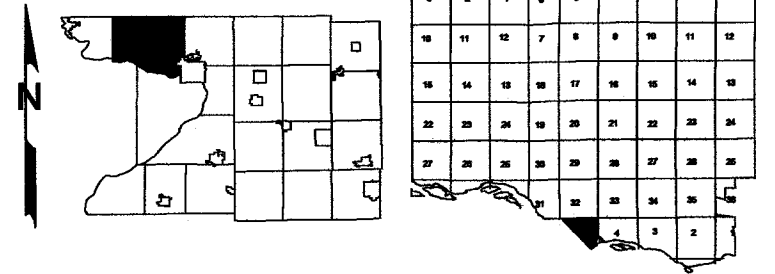

replaced 2003
-SECTION 5-

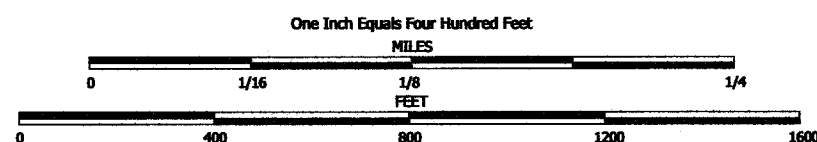

NOTE: This map was prepared for assessment use in accordance with the Wis. St. Stat. Chap. 70.09. All information contained herein is advisory only. Map accuracy is limited to the quality of data obtained from other Public Records. This map is not intended to be a substitute for an actual field survey. Public Land Survey Base is derived from U.S.G.S. Topographic maps unless otherwise noted. Other sources of the Land Base may be actual survey data. Base map data is from the April 1995 County Digital Orthophotos and/or U.S.G.S. 1:25,000 scale Topographic series. The user is responsible for the improper use of the data contained herein.


Created by The Columbia County Land Information Office -GIS Section. VMB.
September 2002.

TAX PARCEL MAP

TOWN of LEWISTON

TOWN 12 NORTH RANGE 8 EAST
COLUMBIA COUNTY, WISCONSIN

Replaced
2003

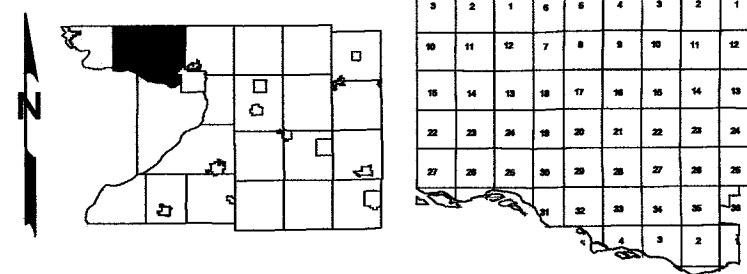


-SEE SECTION 3-

980
1.62 ac
S 1889
S 1705

TOWN of CALEDONIA

-SEE SECTION 11-

Replaced 2003
-SECTION 10-

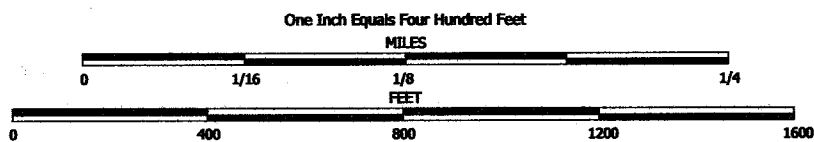


NOTE: This map was prepared for assessment use in accordance with the Wis. St. Stat. Chap. 70.09. All information contained herein is advisory only. Map accuracy is limited to the quality of data obtained from other Public Records. This map is not intended to be a substitute for an actual field survey. Public Land Survey Base is derived from U.S.G.S Topographic maps unless otherwise noted. Other sources of the Land Base may be actual survey data. Base map data is from the April 1995 County Digital Orthophotos and/or U.S.G.S. 1:24,000 scale Topographic series. The user is responsible for the improper use of the data contained herein.

Created by The Columbia County Land Information Office -GIS Section. VMB.
February 2003.

TAX PARCEL MAP

TOWN of LEWISTON

TOWN 12 NORTH RANGE 8 EAST
COLUMBIA COUNTY, WISCONSIN

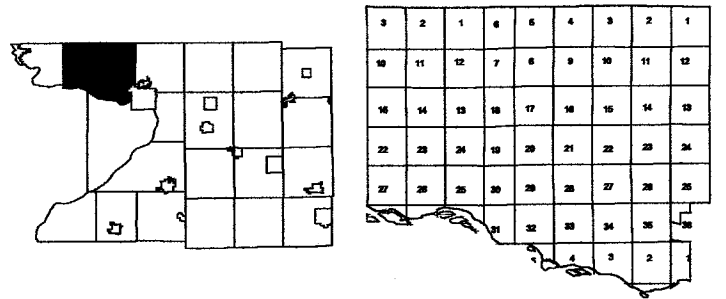

Replaced
2004

-SEE SECTION 1-



-SEE SECTION 11-

SW CORNER
SECTION 1-13-8
NW CORNER
SECTION 12-13-8

SE CORNER
SECTION 1-13-8
NE CORNER
SECTION 12-13-8


replaced 2004
-SECTION 12-

LEWISTON

SEC. 1 T13N R7E

5
Q1112


Replaced
2003

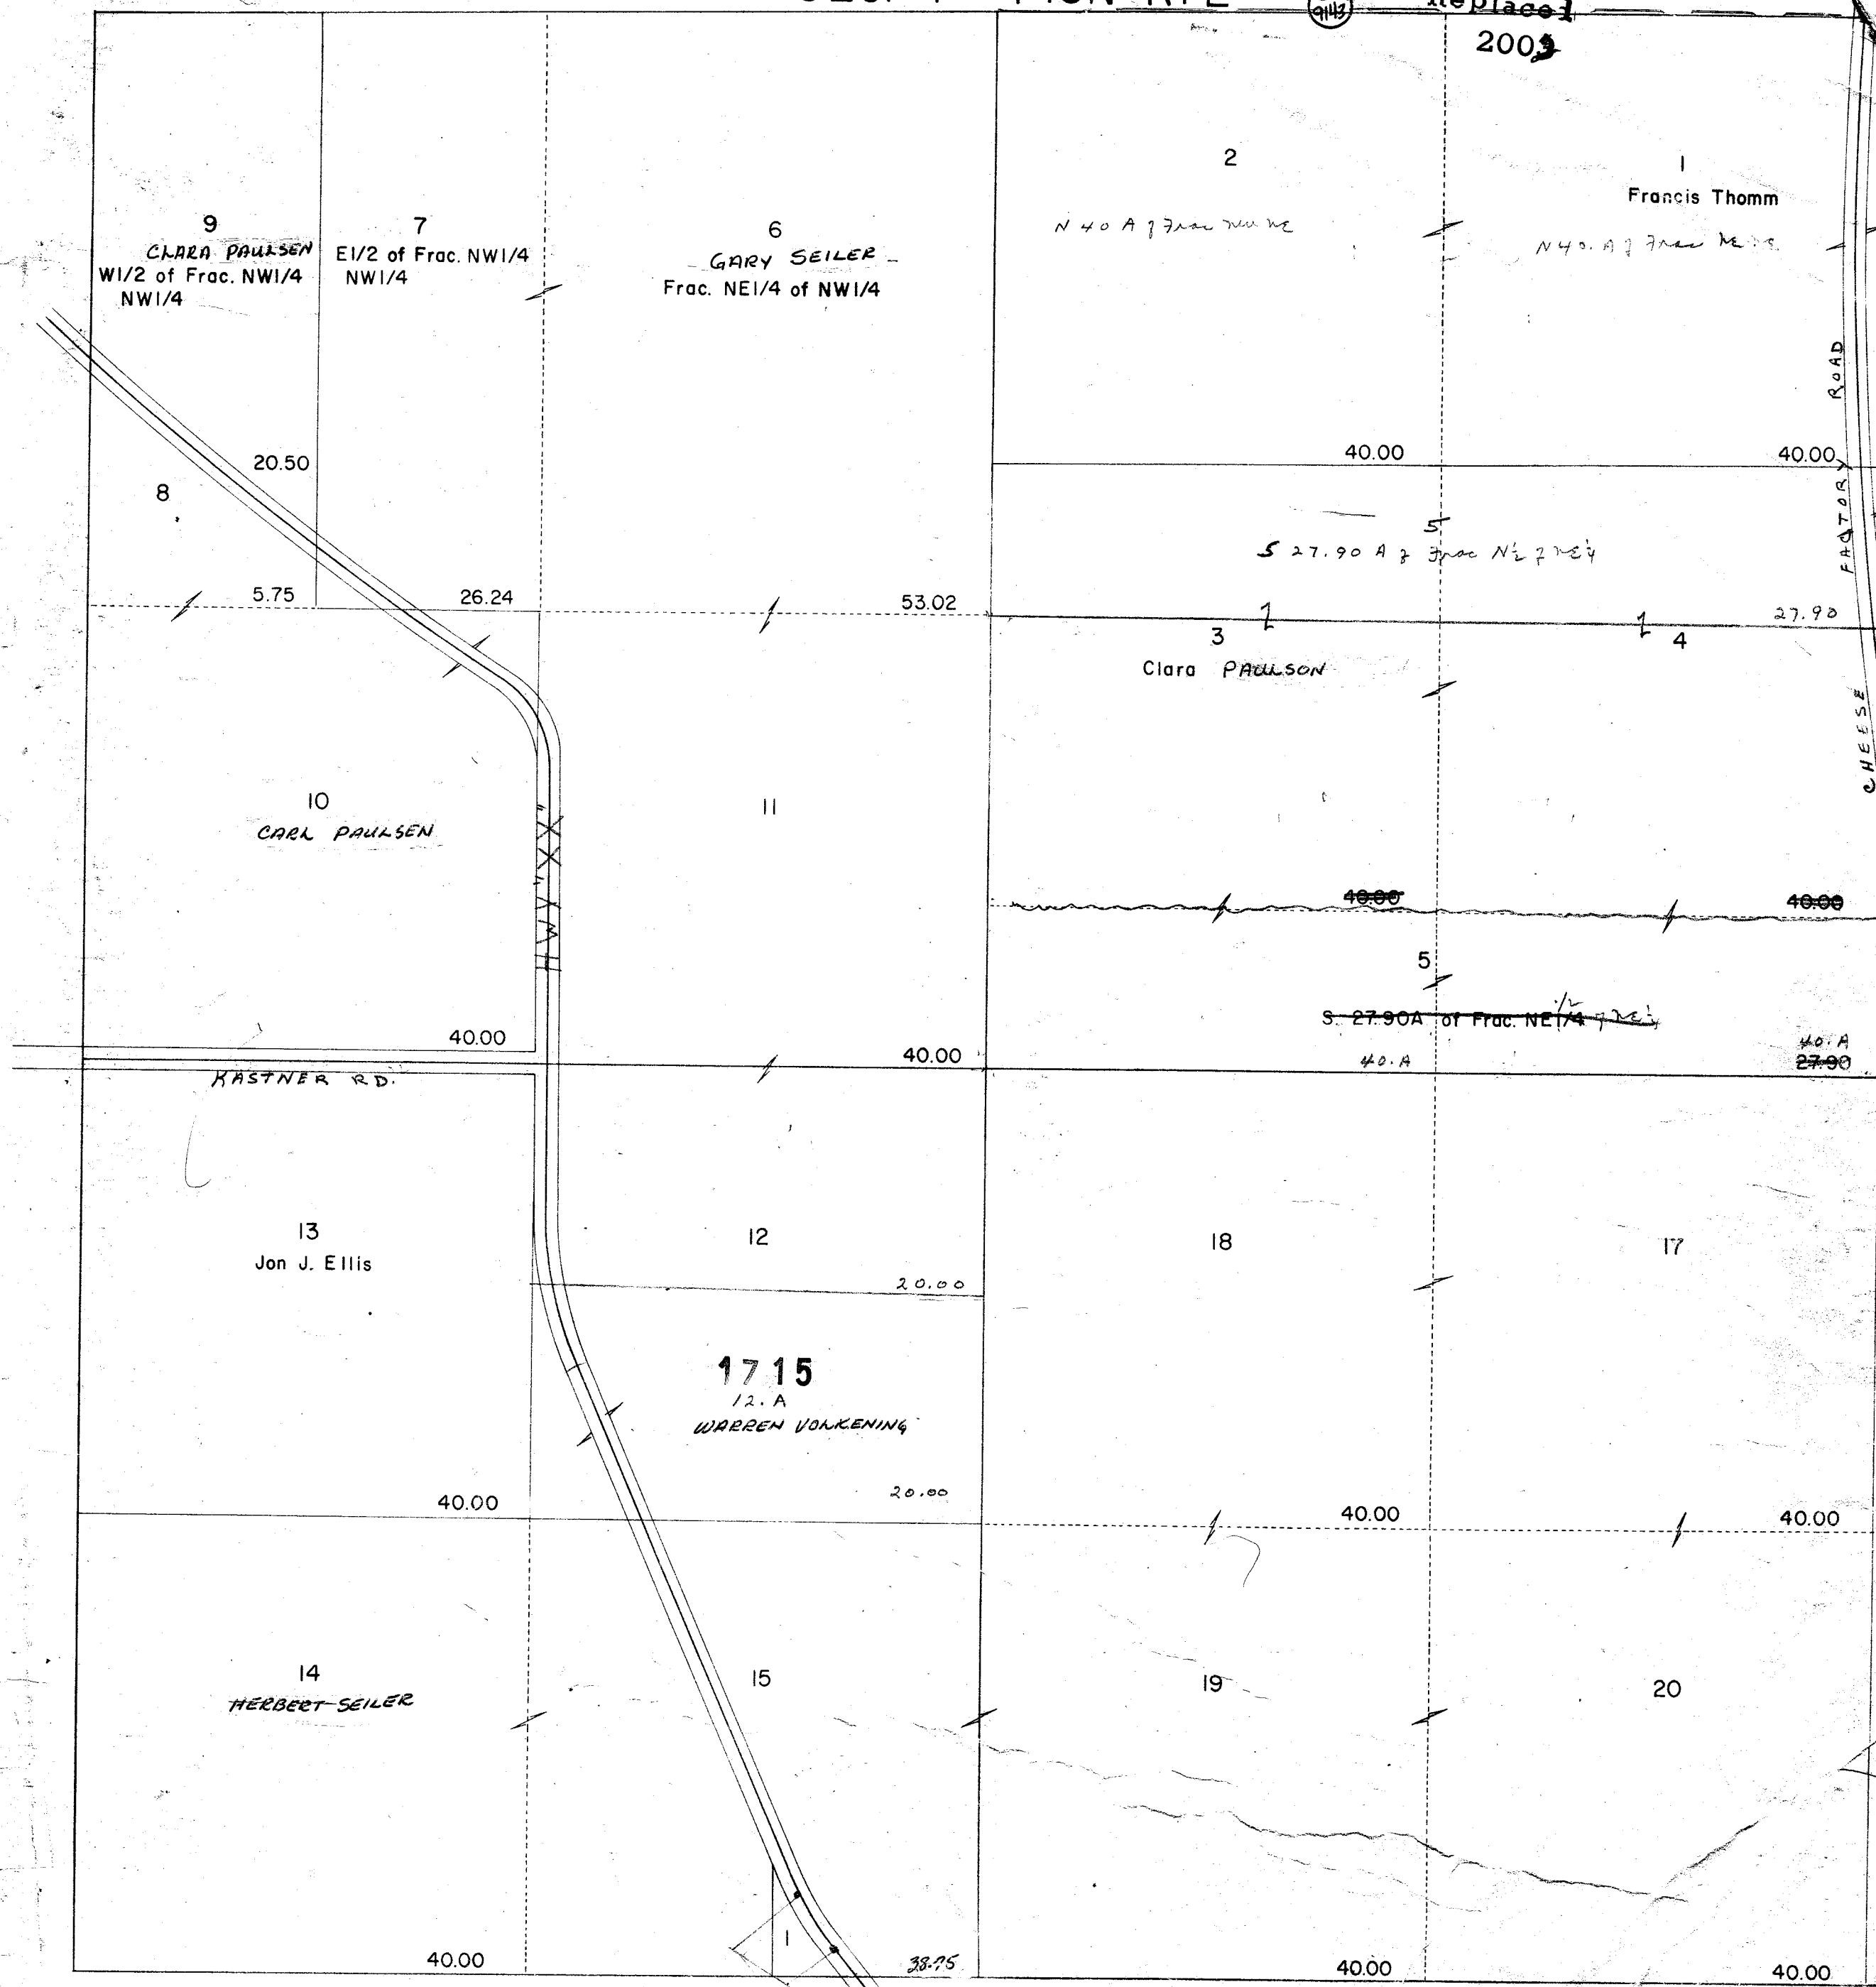

The land
of Paul
is not
accounted for
but, has been
taken in for
now. This is
not a
part of this
probably belongs
to him (Cottier)

96
1-96
HERBERT
SEILER
125A

Replaced
2003
T13N-R7E
SECTION TWO
Town of Lewiston

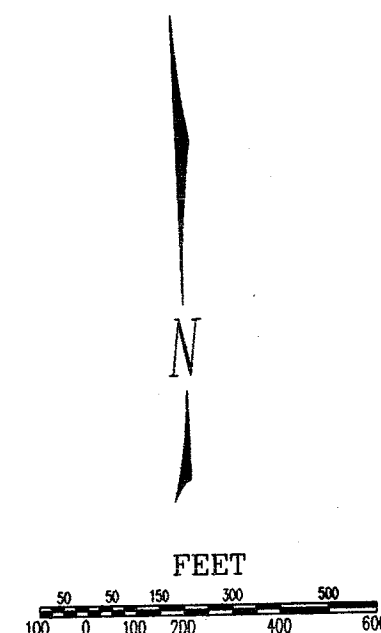


- ...Plat on File
- ...Survey on File
- ...Certified Survey Map
- ...Mortgage Inspection on
- ...Monumented Section Corner

NOTE: This map was prepared for assessment use in accordance with Wis. St. Stat. Chap. 70.09. All information contained herein is advisory only. Map accuracy is limited to the quality of data obtained from other Public Records. This map is not intended to be a substitute for an actual field survey.

COLUMBIA COUNTY Land Information Department Portage, Wisconsin	
ORIGINAL SCALE: 1" = 400'	LATEST REVISION DATE:
DATE: 10/23/96	CAD Filename: 021307.dwg
SEC.-TOWN.-RANGE 02-13-07	1/4 SEC



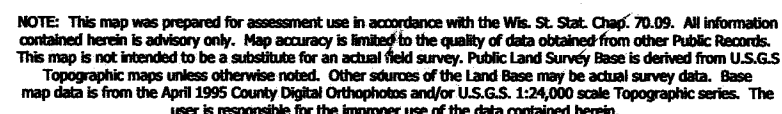


Created by The Columbia County Land Information Office -GIS Section. VMB.
September 2002.


TOWN of LEWISTON

TOWN 13 NORTH RANGE 7 EAST
COLUMBIA COUNTY, WISCONSIN

Replaced
2006

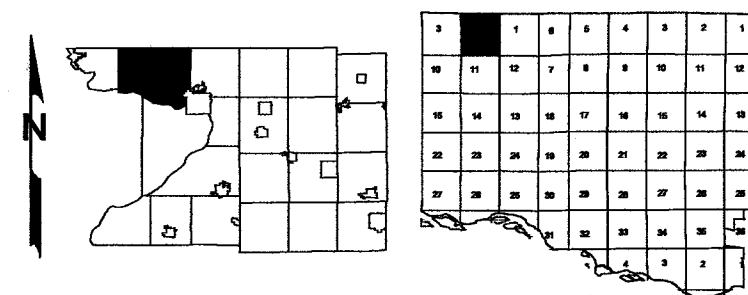

Adams ~~MARQUETTE~~ COUNTY

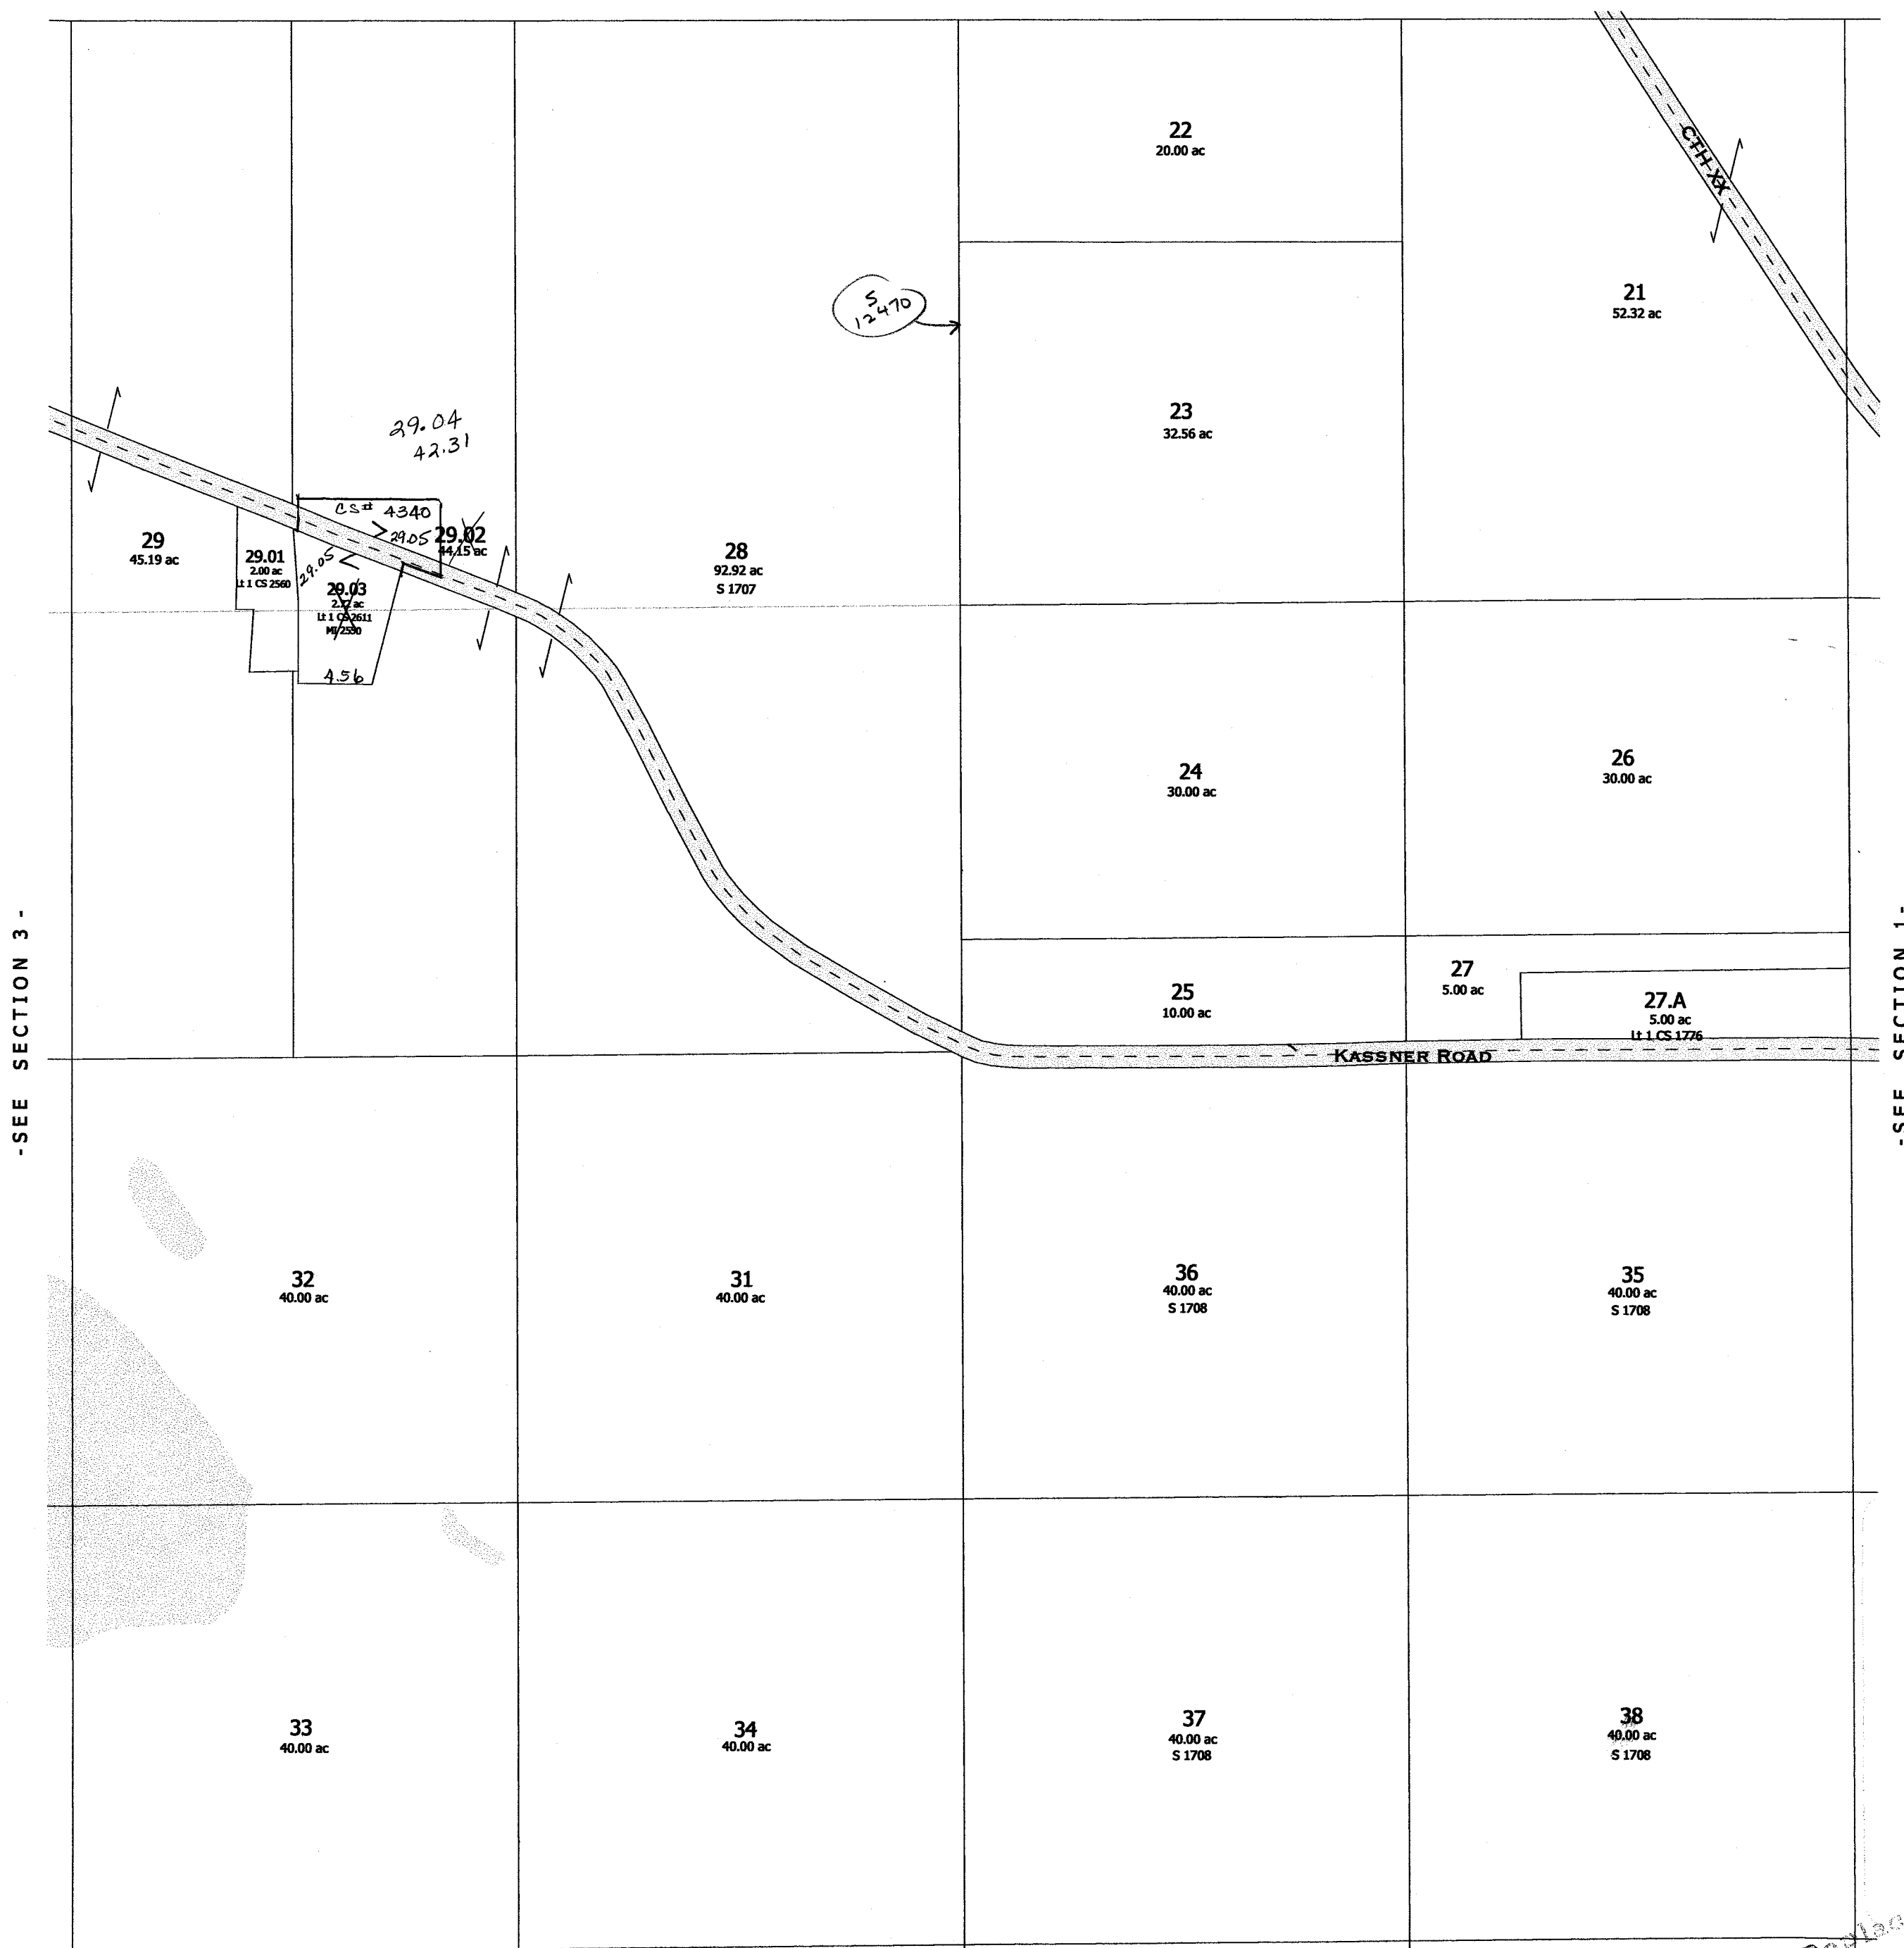

-SEE SECTION 11-

-SECTION 2-

Replaced
2006

SEC. 3 T13N R7E

Replaced
2009

Dec 4-13-7
newport ←

3296 *Sueveg*
N/L NW 1/4

Survey for this line 1710

46
CHARLES E.
~~Franklin~~ Julson

45
Howard Ekberg
Dennis Smithbaek

42
Lot 1
Jerry Hamm

11.00

43
Lot 2
~~WILLIAM KASSNER~~
Ernst Schuepbach
10.00

40
Maurice Krueger

39
~~William Kassner~~
DENNIS R. KASSNER

55.34
~~56.34~~

57.34
~~56.34~~

44
Lot 3
Jerry Hamm

19.00

32.00

93.58

47
~~Herbert Kossner~~
MERLIN N. HARE
Roger Stowers

48
William Kassner
Donald Tranchita

41
Carleton Kassner
ETAL

40.001709

50
Jerry Hamm

49
VINCENT TRANCHITA

55

54
~~Rich Jones &~~
Don Tranchita
*
VINCENT TRANCHITA

53

40.00

40 00

20 00

20.00

10.00


51

52
Lewiston Outing Club

56


57

...

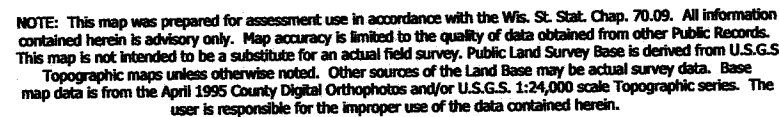

Created by The Columbia County Land Information Office -GIS Section. VMB.
September 2002.

TOWN 13 NORTH RANGE 7 EAST
COLUMBIA COUNTY, WISCONSIN

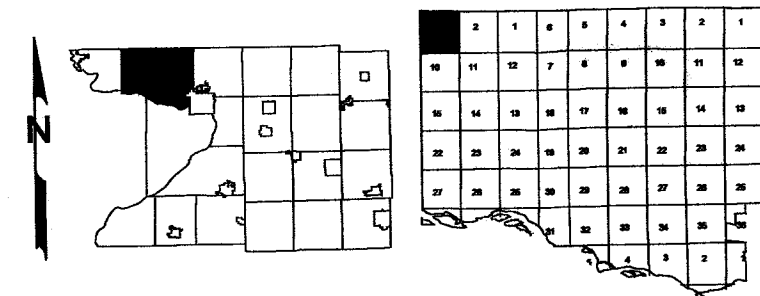

~~Replaced~~
2005

MARQUETTE COUNTY




-SEE SECTION 10-

-SECTION 3-

2005

LEWISTON
SEC. 10 T13N R7E


Replaced
2009

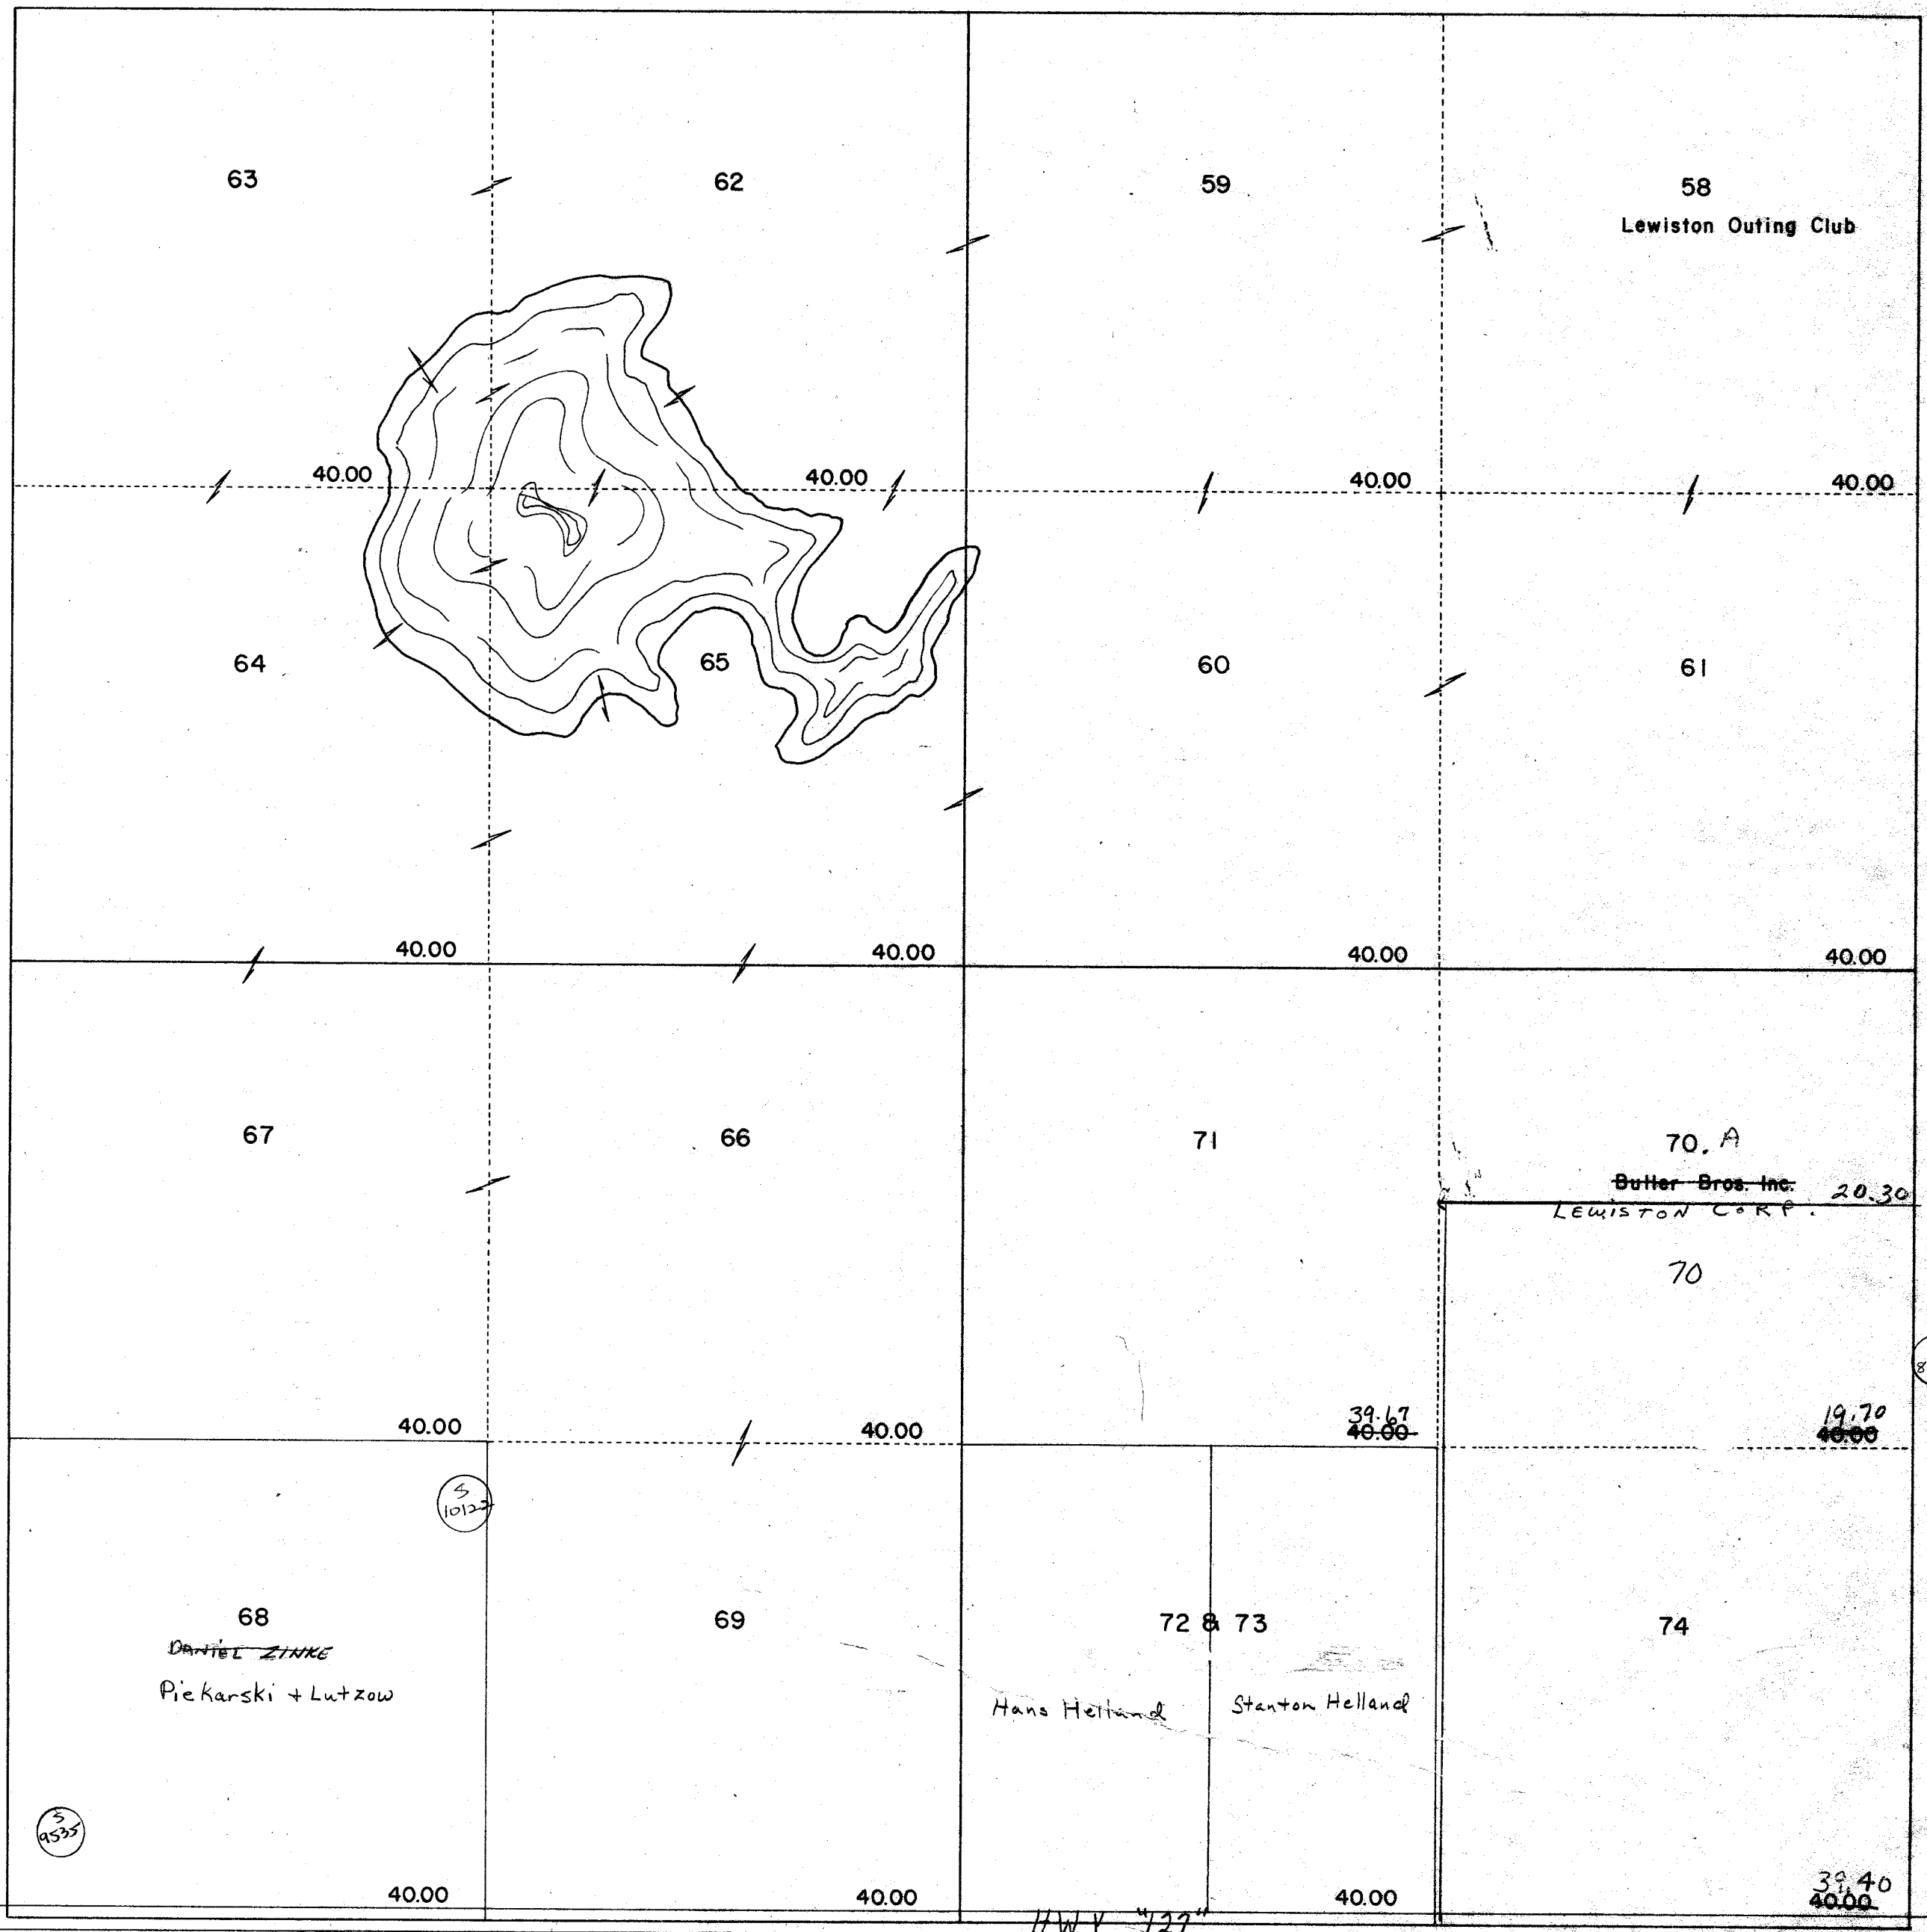

PROPERTY OF TAX LISTING DEPARTMENT


Replaced
2003

86. AI
Charles
Stanford
2.00A

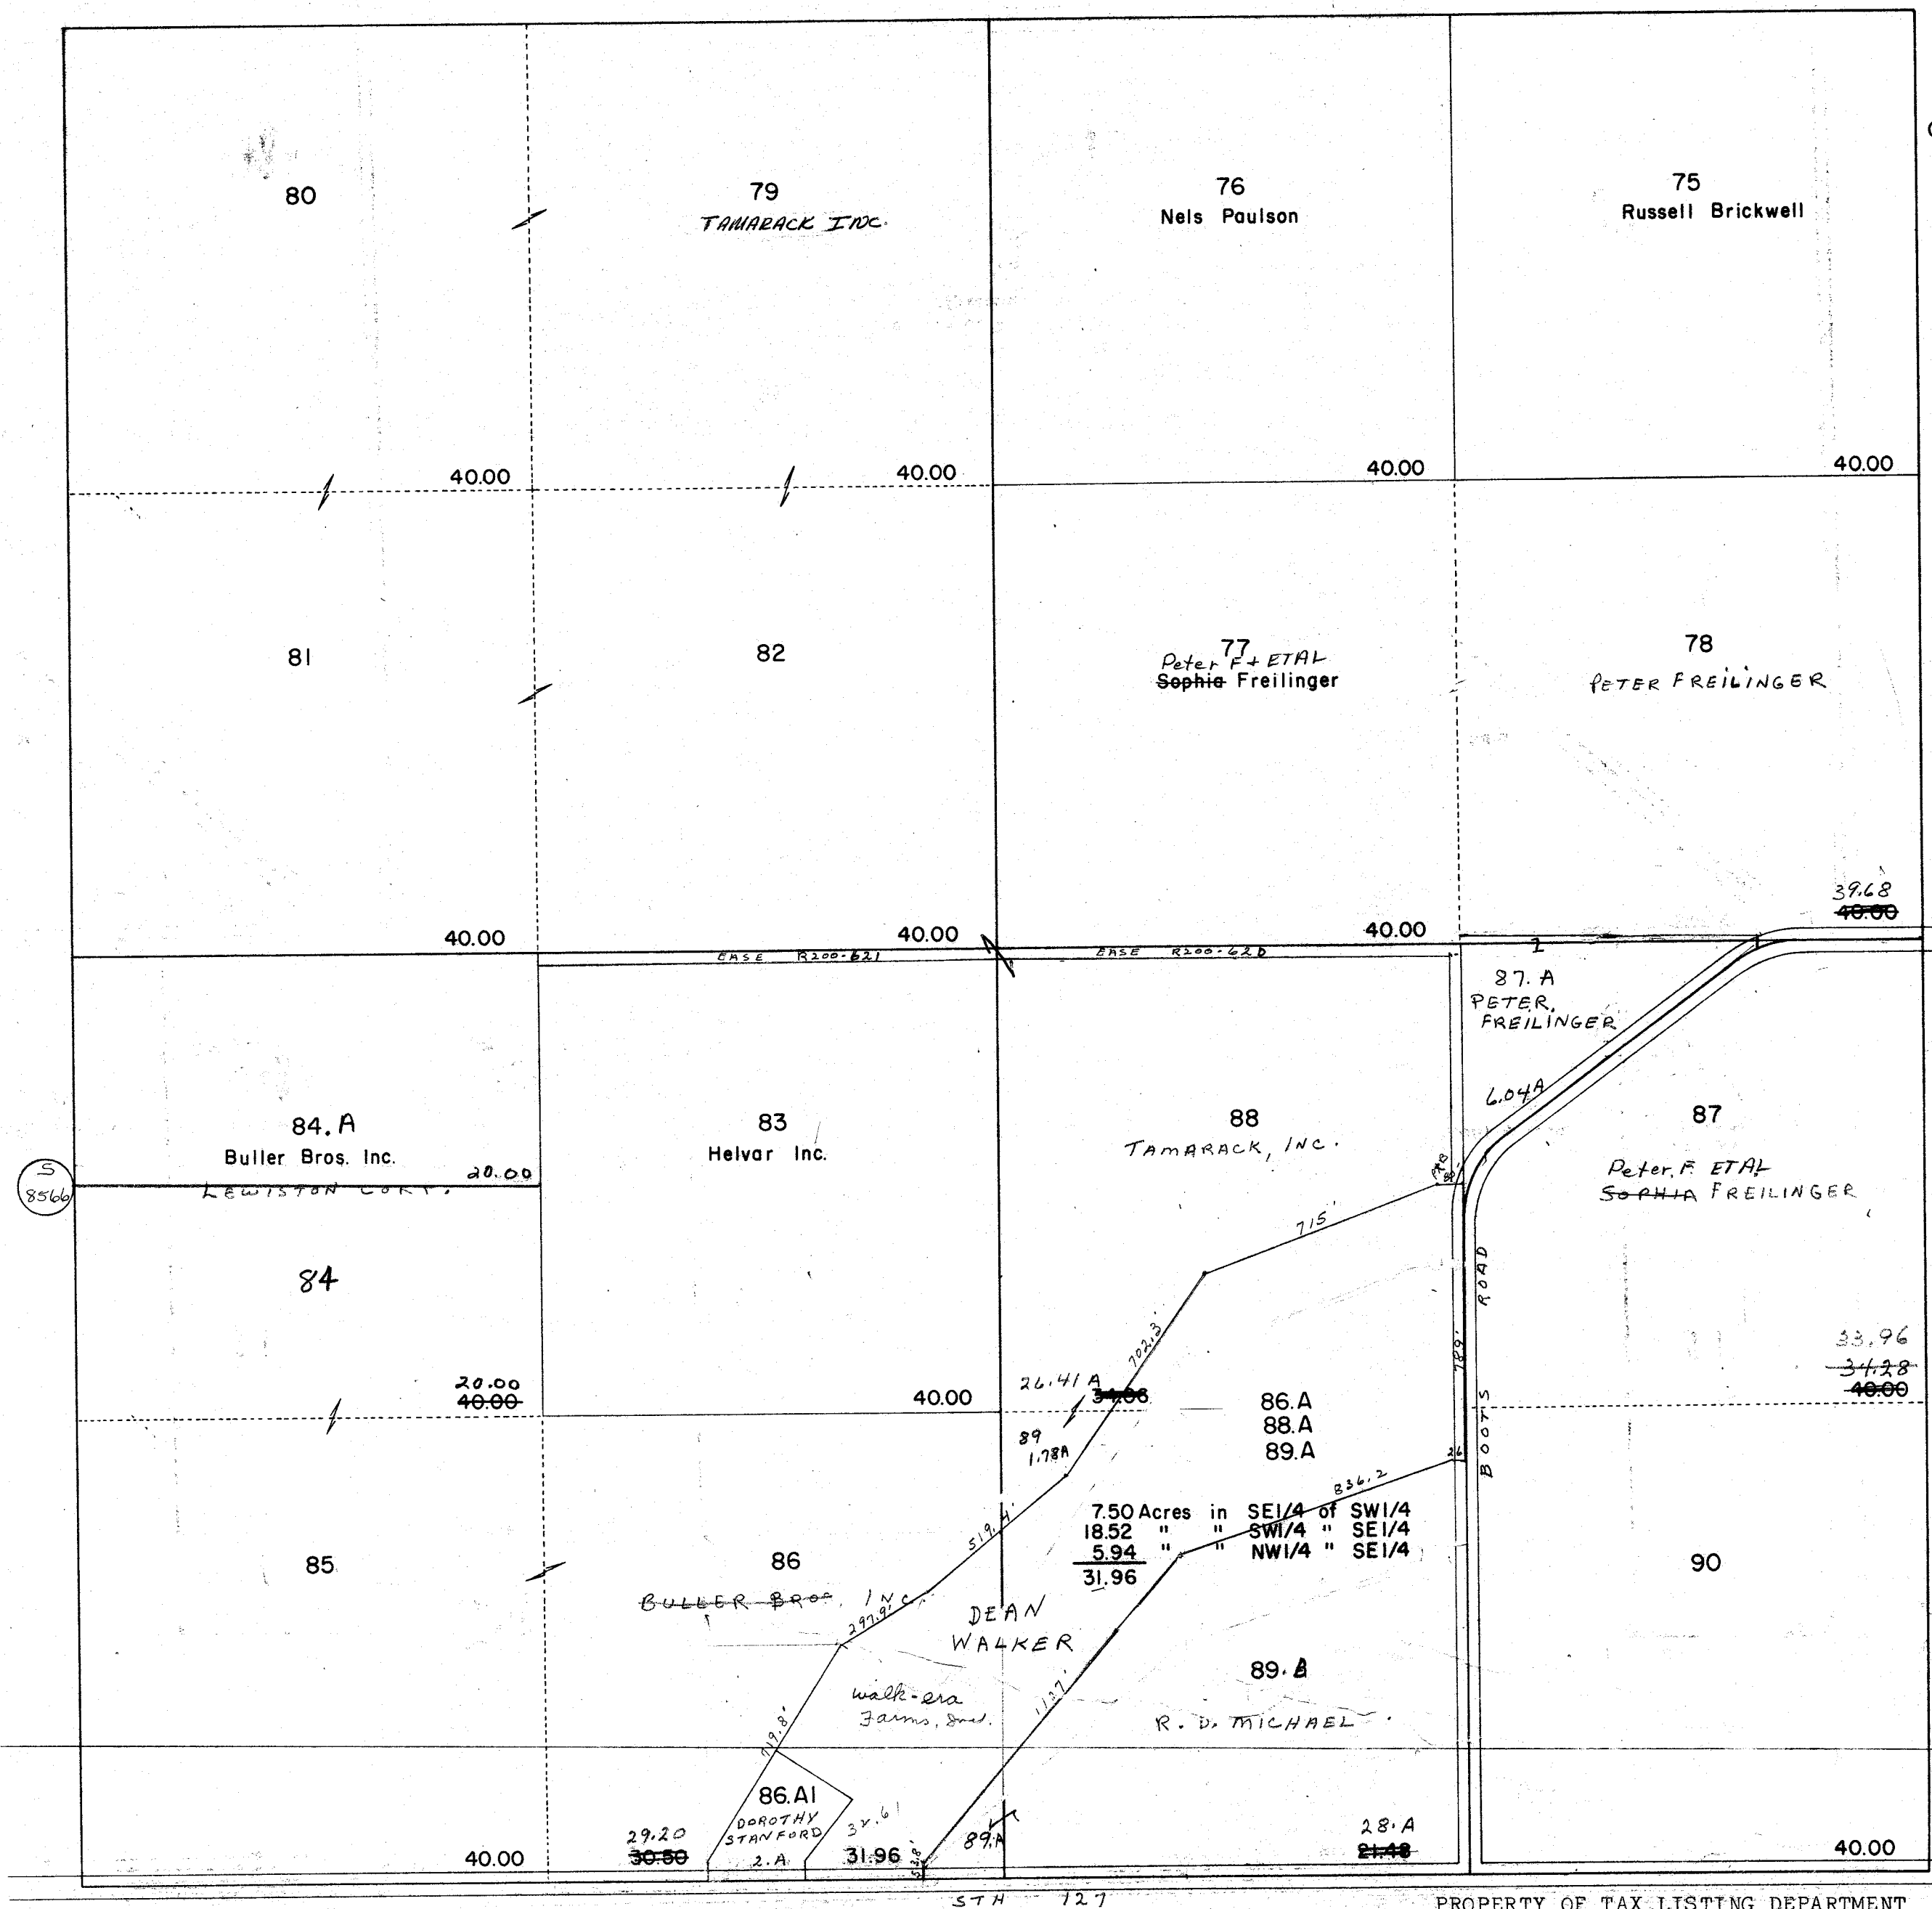

LEWISTON
SEC. 12 T13N R7E

Replaced
2009

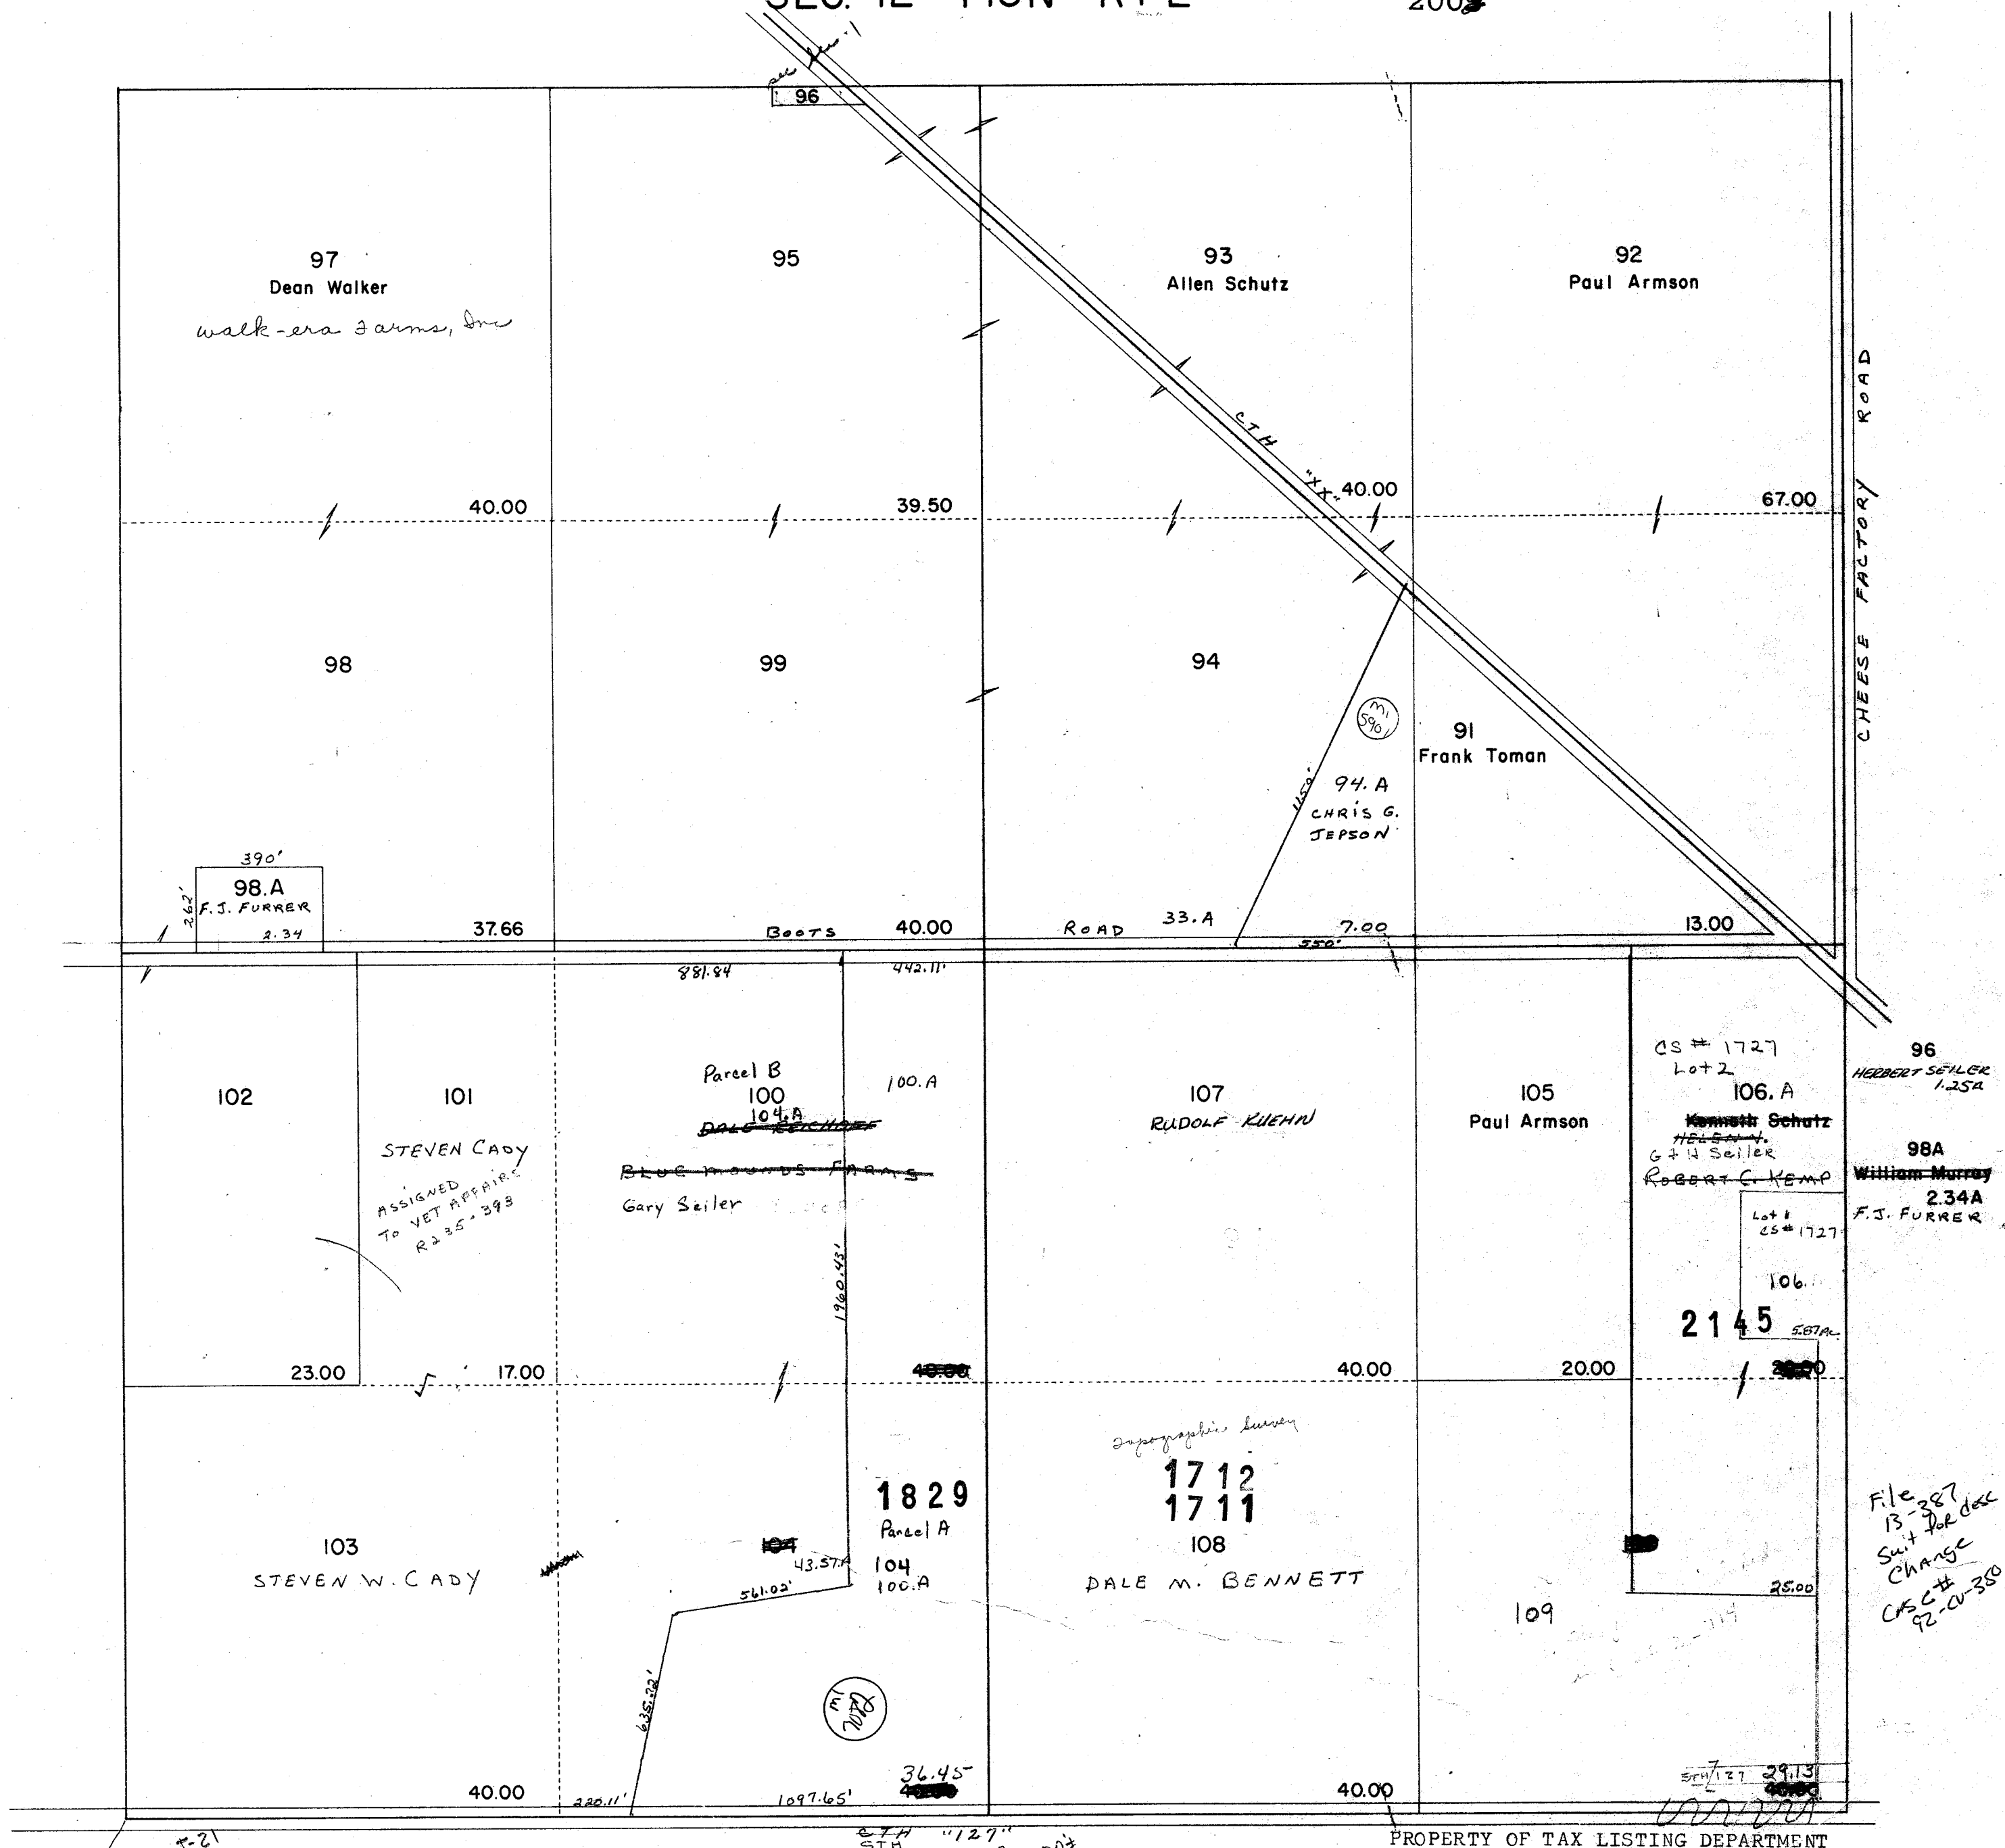

CHEESE FACTORY ROAD

96
HERBERT SEILER
1.25A


98A
William Murray
2.34A
F.J. FURRER

File
13-287
Suit for dec
change
CSC#
92-00-350

15.4
8.2
23.7
11.85
8.3
3.55
Part J-21
The Cor
13.3.5+5.5
to part

Part J-23
The Cor. 15.30
SOUTH of PART

PROPERTY OF TAX LISTING DEPARTMENT

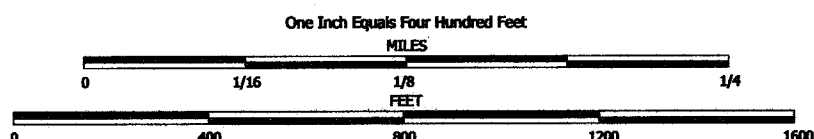


NOTE: This map was prepared for assessment use in accordance with the Wis. St. Stat. Chap. 70.09. All information contained herein is advisory only. Map accuracy is limited to the quality of data obtained from other Public Records. This map is not intended to be a substitute for an actual field survey. Public Land Survey Base is derived from U.S.G.S. Topographic maps unless otherwise noted. Other sources of the land base may be actual survey data. Base map data is from the April 1995 County Digital Orthophotos and/or U.S.G.S. 1:24,000 scale Topographic series. The user is responsible for the improper use of the data contained herein.

Created by The Columbia County Land Information Office -GIS Section. VMB.
September 2002.

TAX PARCEL MAP

TOWN of LEWISTON

TOWN 13 NORTH RANGE 7 EAST
COLUMBIA COUNTY, WISCONSIN

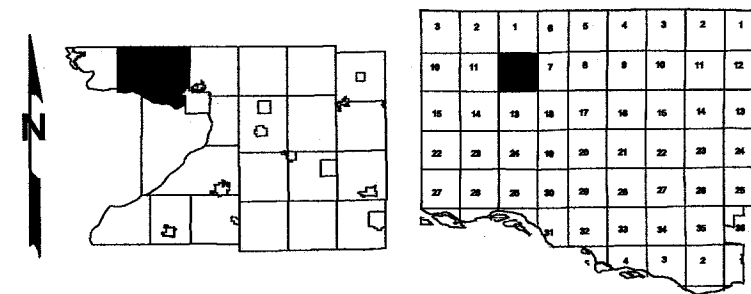

Replaced
2004

-SEE SECTION 1-




-SEE SECTION 13-

replaced 2004
-SECTION 12-


Replaced
2009

Highway North of
Section line

5
826

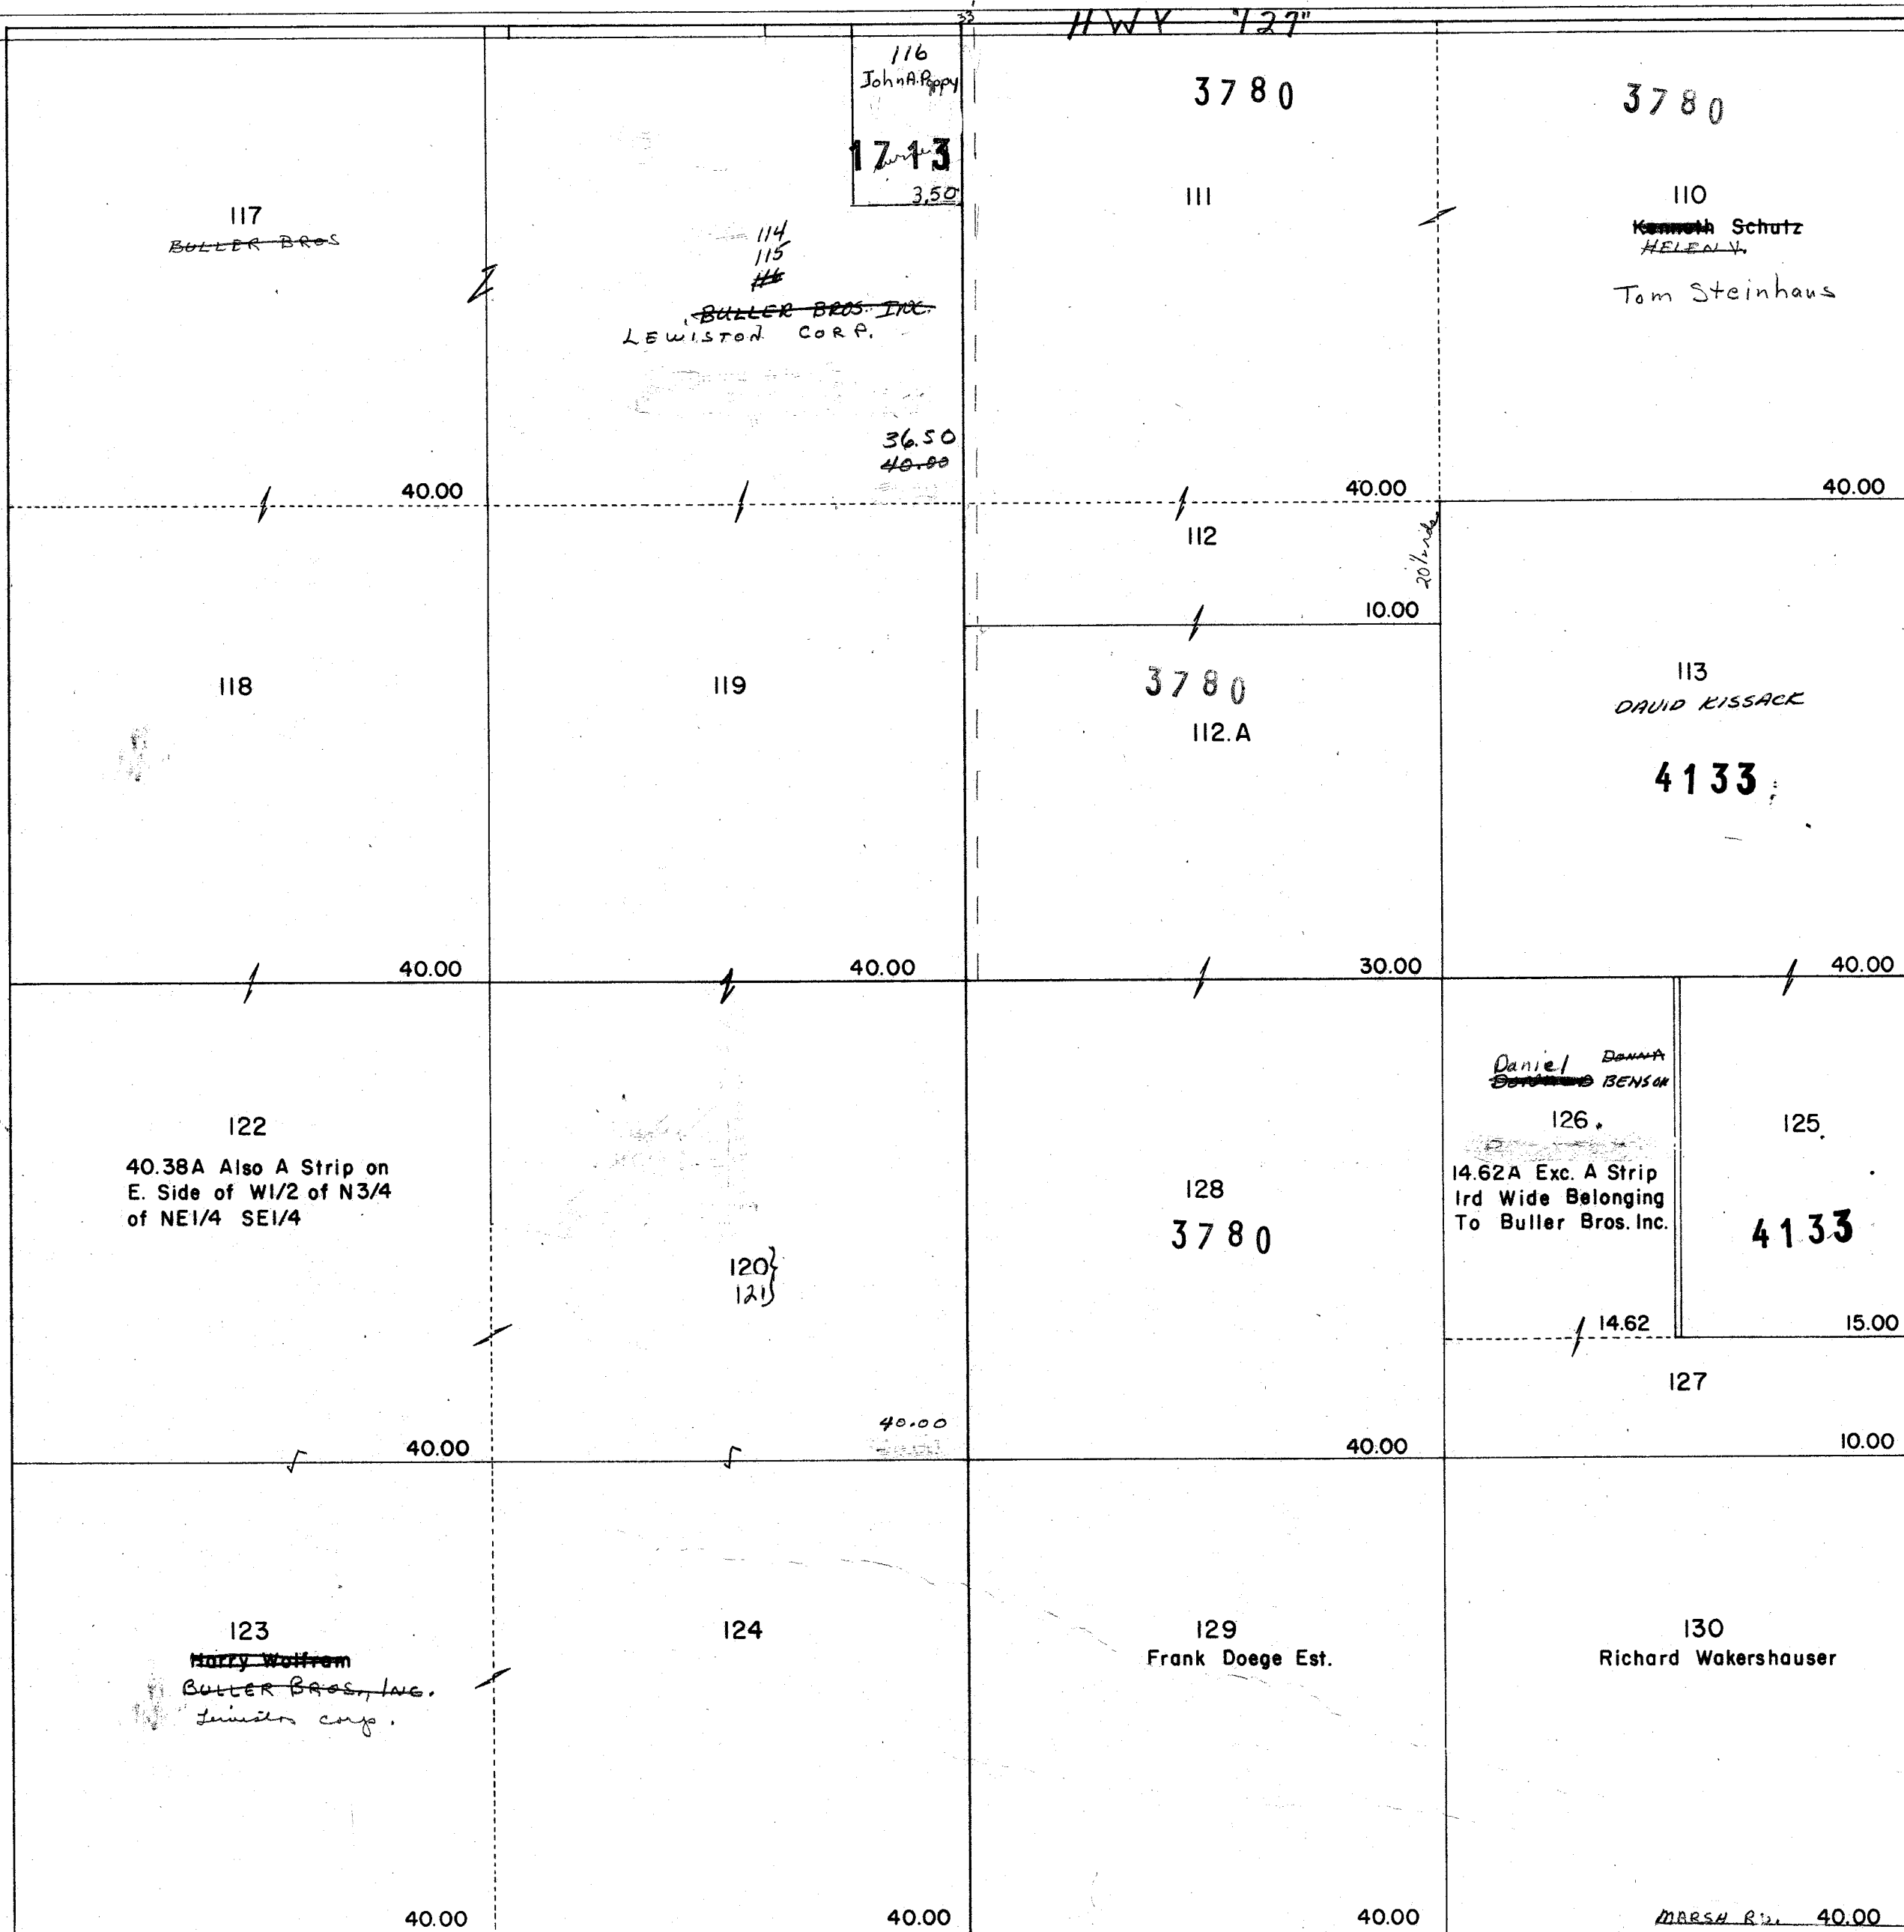

PROPERTY OF TAX LISTING DEPARTMENT

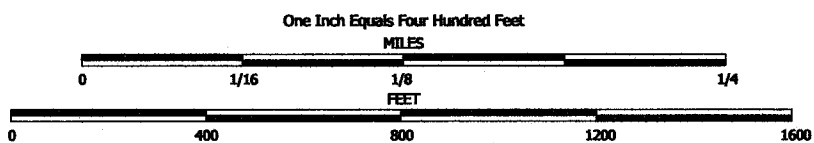


NOTE: This map was prepared for assessment use in accordance with the Wis. St. Stat. Chap. 70.09. All information contained herein is advisory only. Map accuracy is limited to the quality of data obtained from other Public Records. This map is not intended to be a substitute for an actual field survey. Public Land Survey Base is derived from U.S.G.S. Topographic maps unless otherwise noted. Other sources of the Land Base may be actual survey data. Base map data is from the April 1995 County Digital Orthophotos and/or U.S.G.S. 1:24,000 scale Topographic series. The user is responsible for the improper use of the data contained herein.

Created by The Columbia County Land Information Office -GIS Section. VMB.
September 2002.

TAX PARCEL MAP


TOWN of LEWISTON

TOWN 13 NORTH RANGE 7 EAST
COLUMBIA COUNTY, WISCONSIN

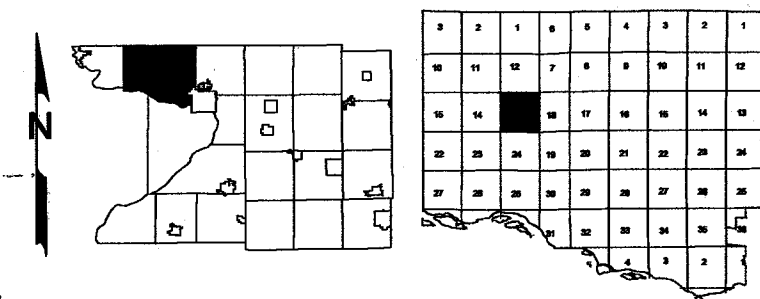

Replaced
2006

-SEE SECTION 12-

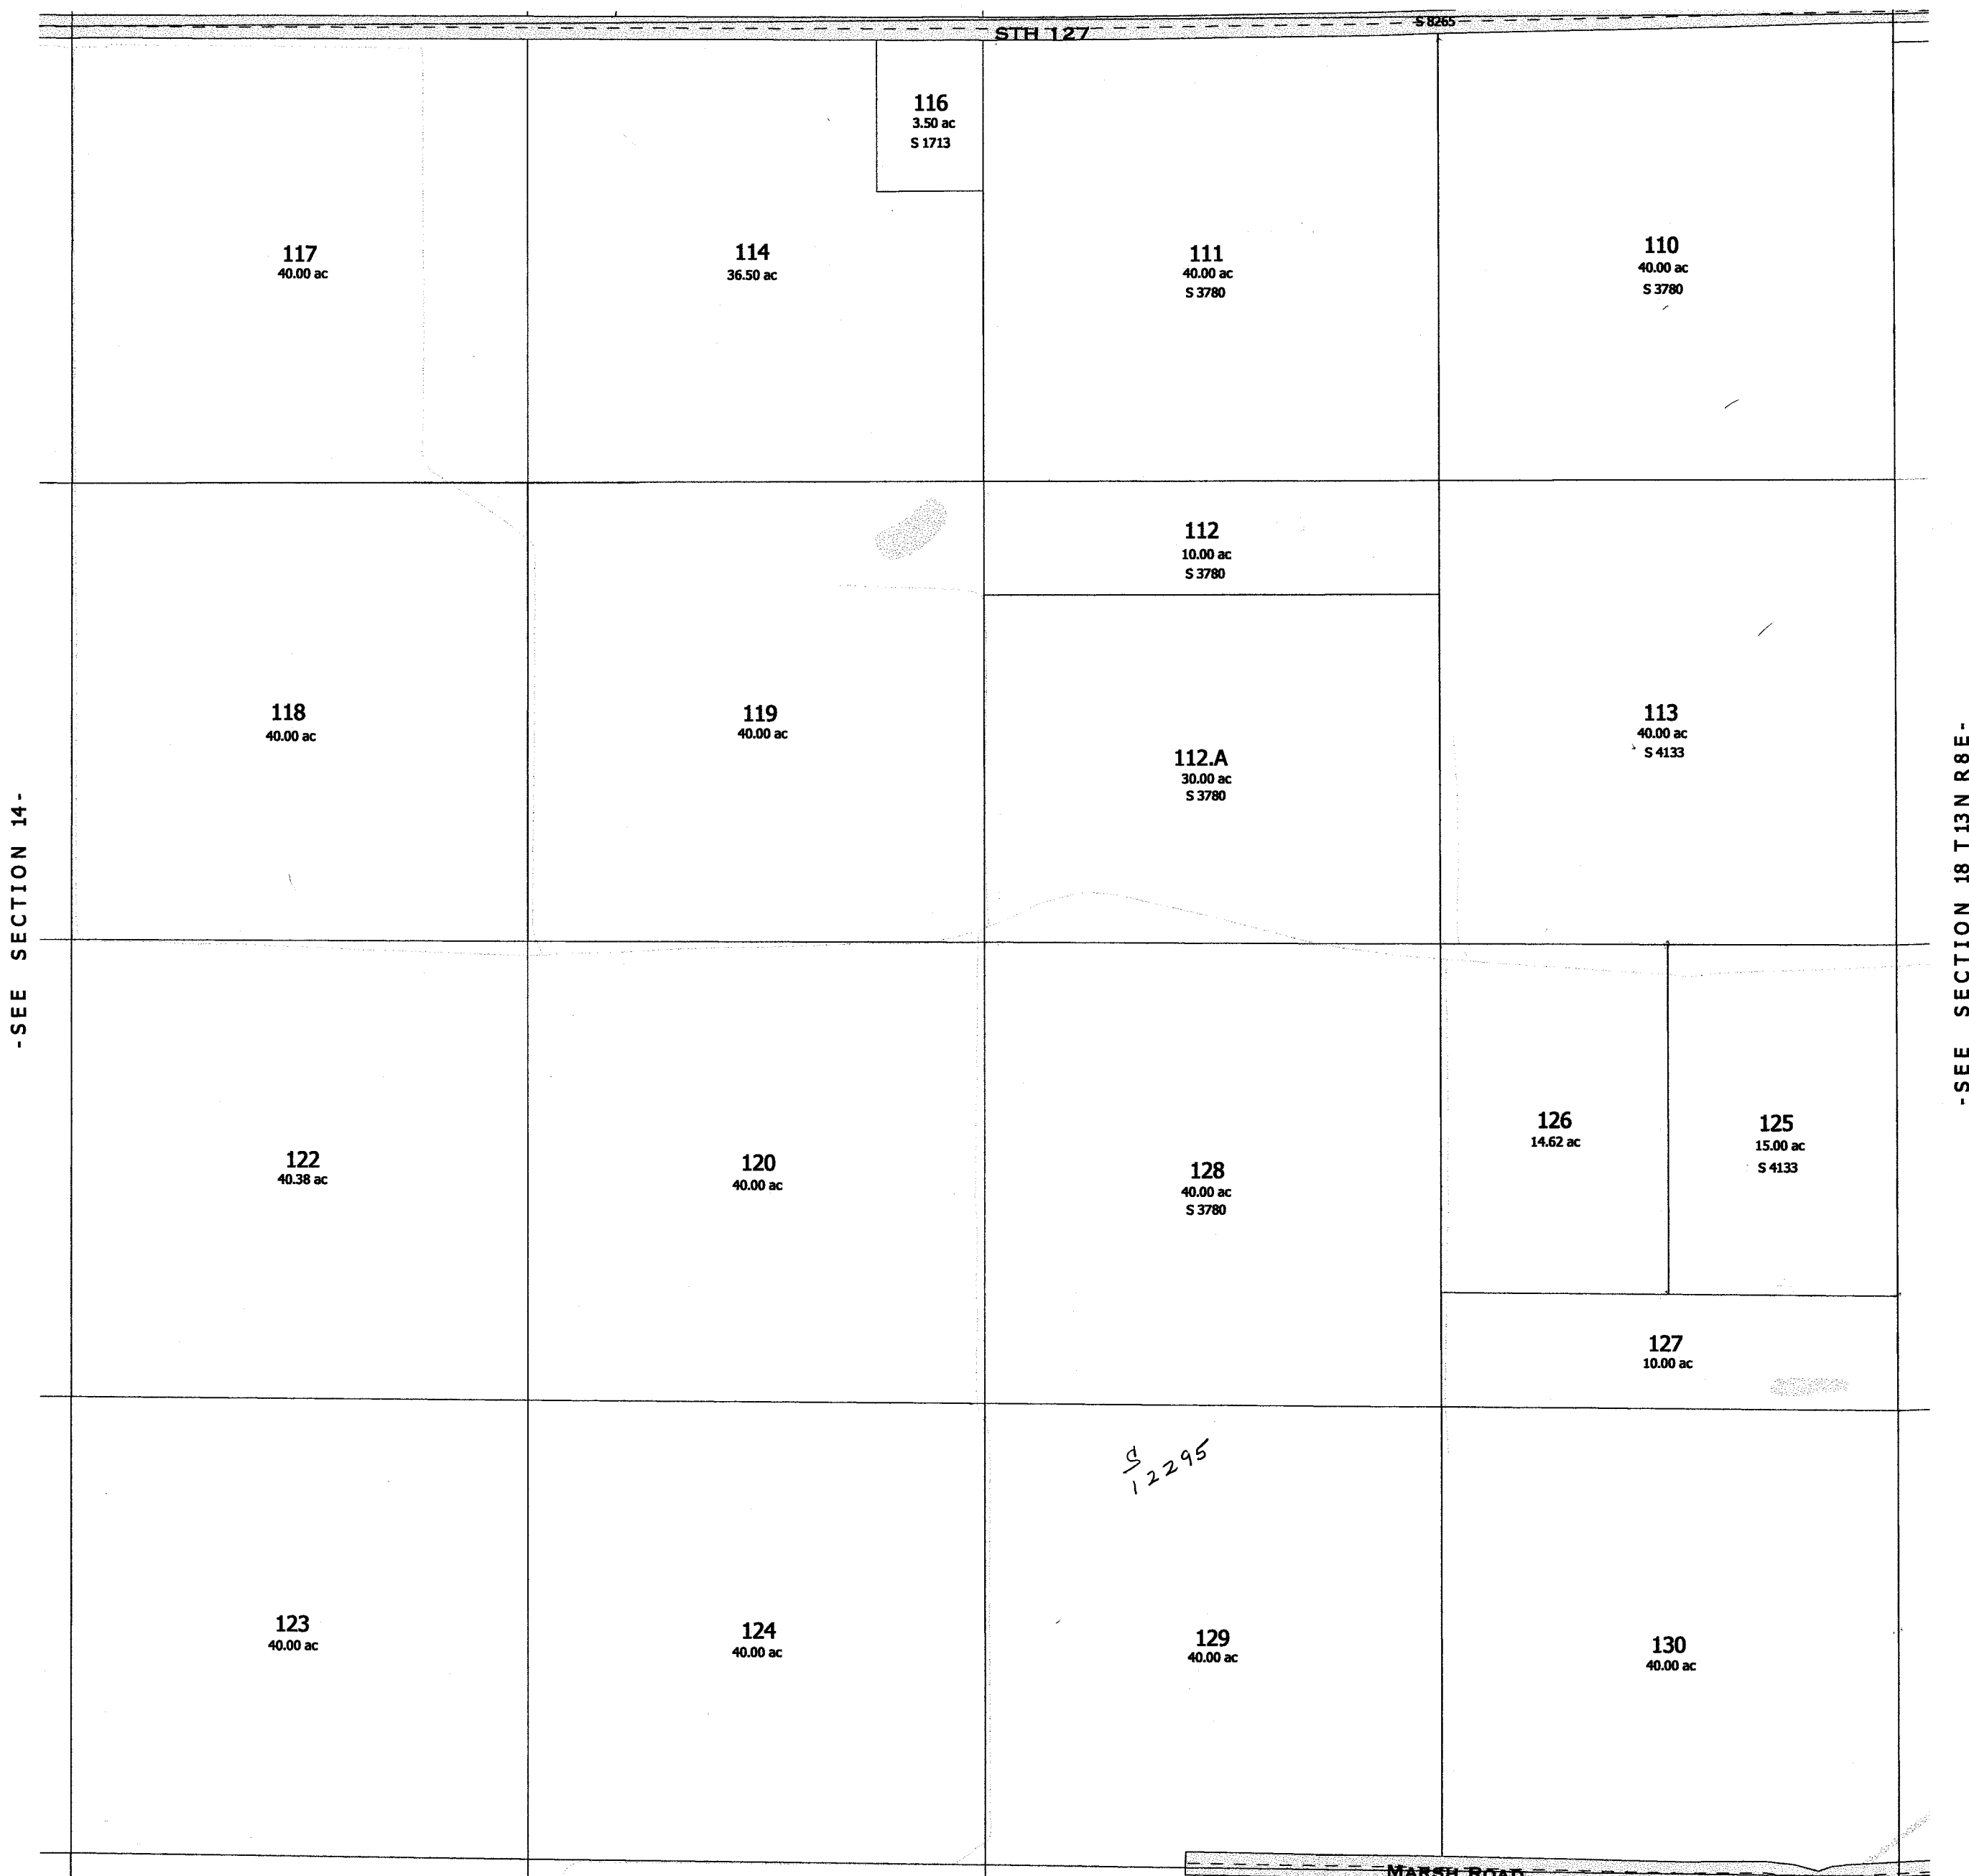


-SEE SECTION 24-


Replaced
2006

-SECTION 13-

LEWISTON
SEC. 14 T13N R7E

Replaced
2009

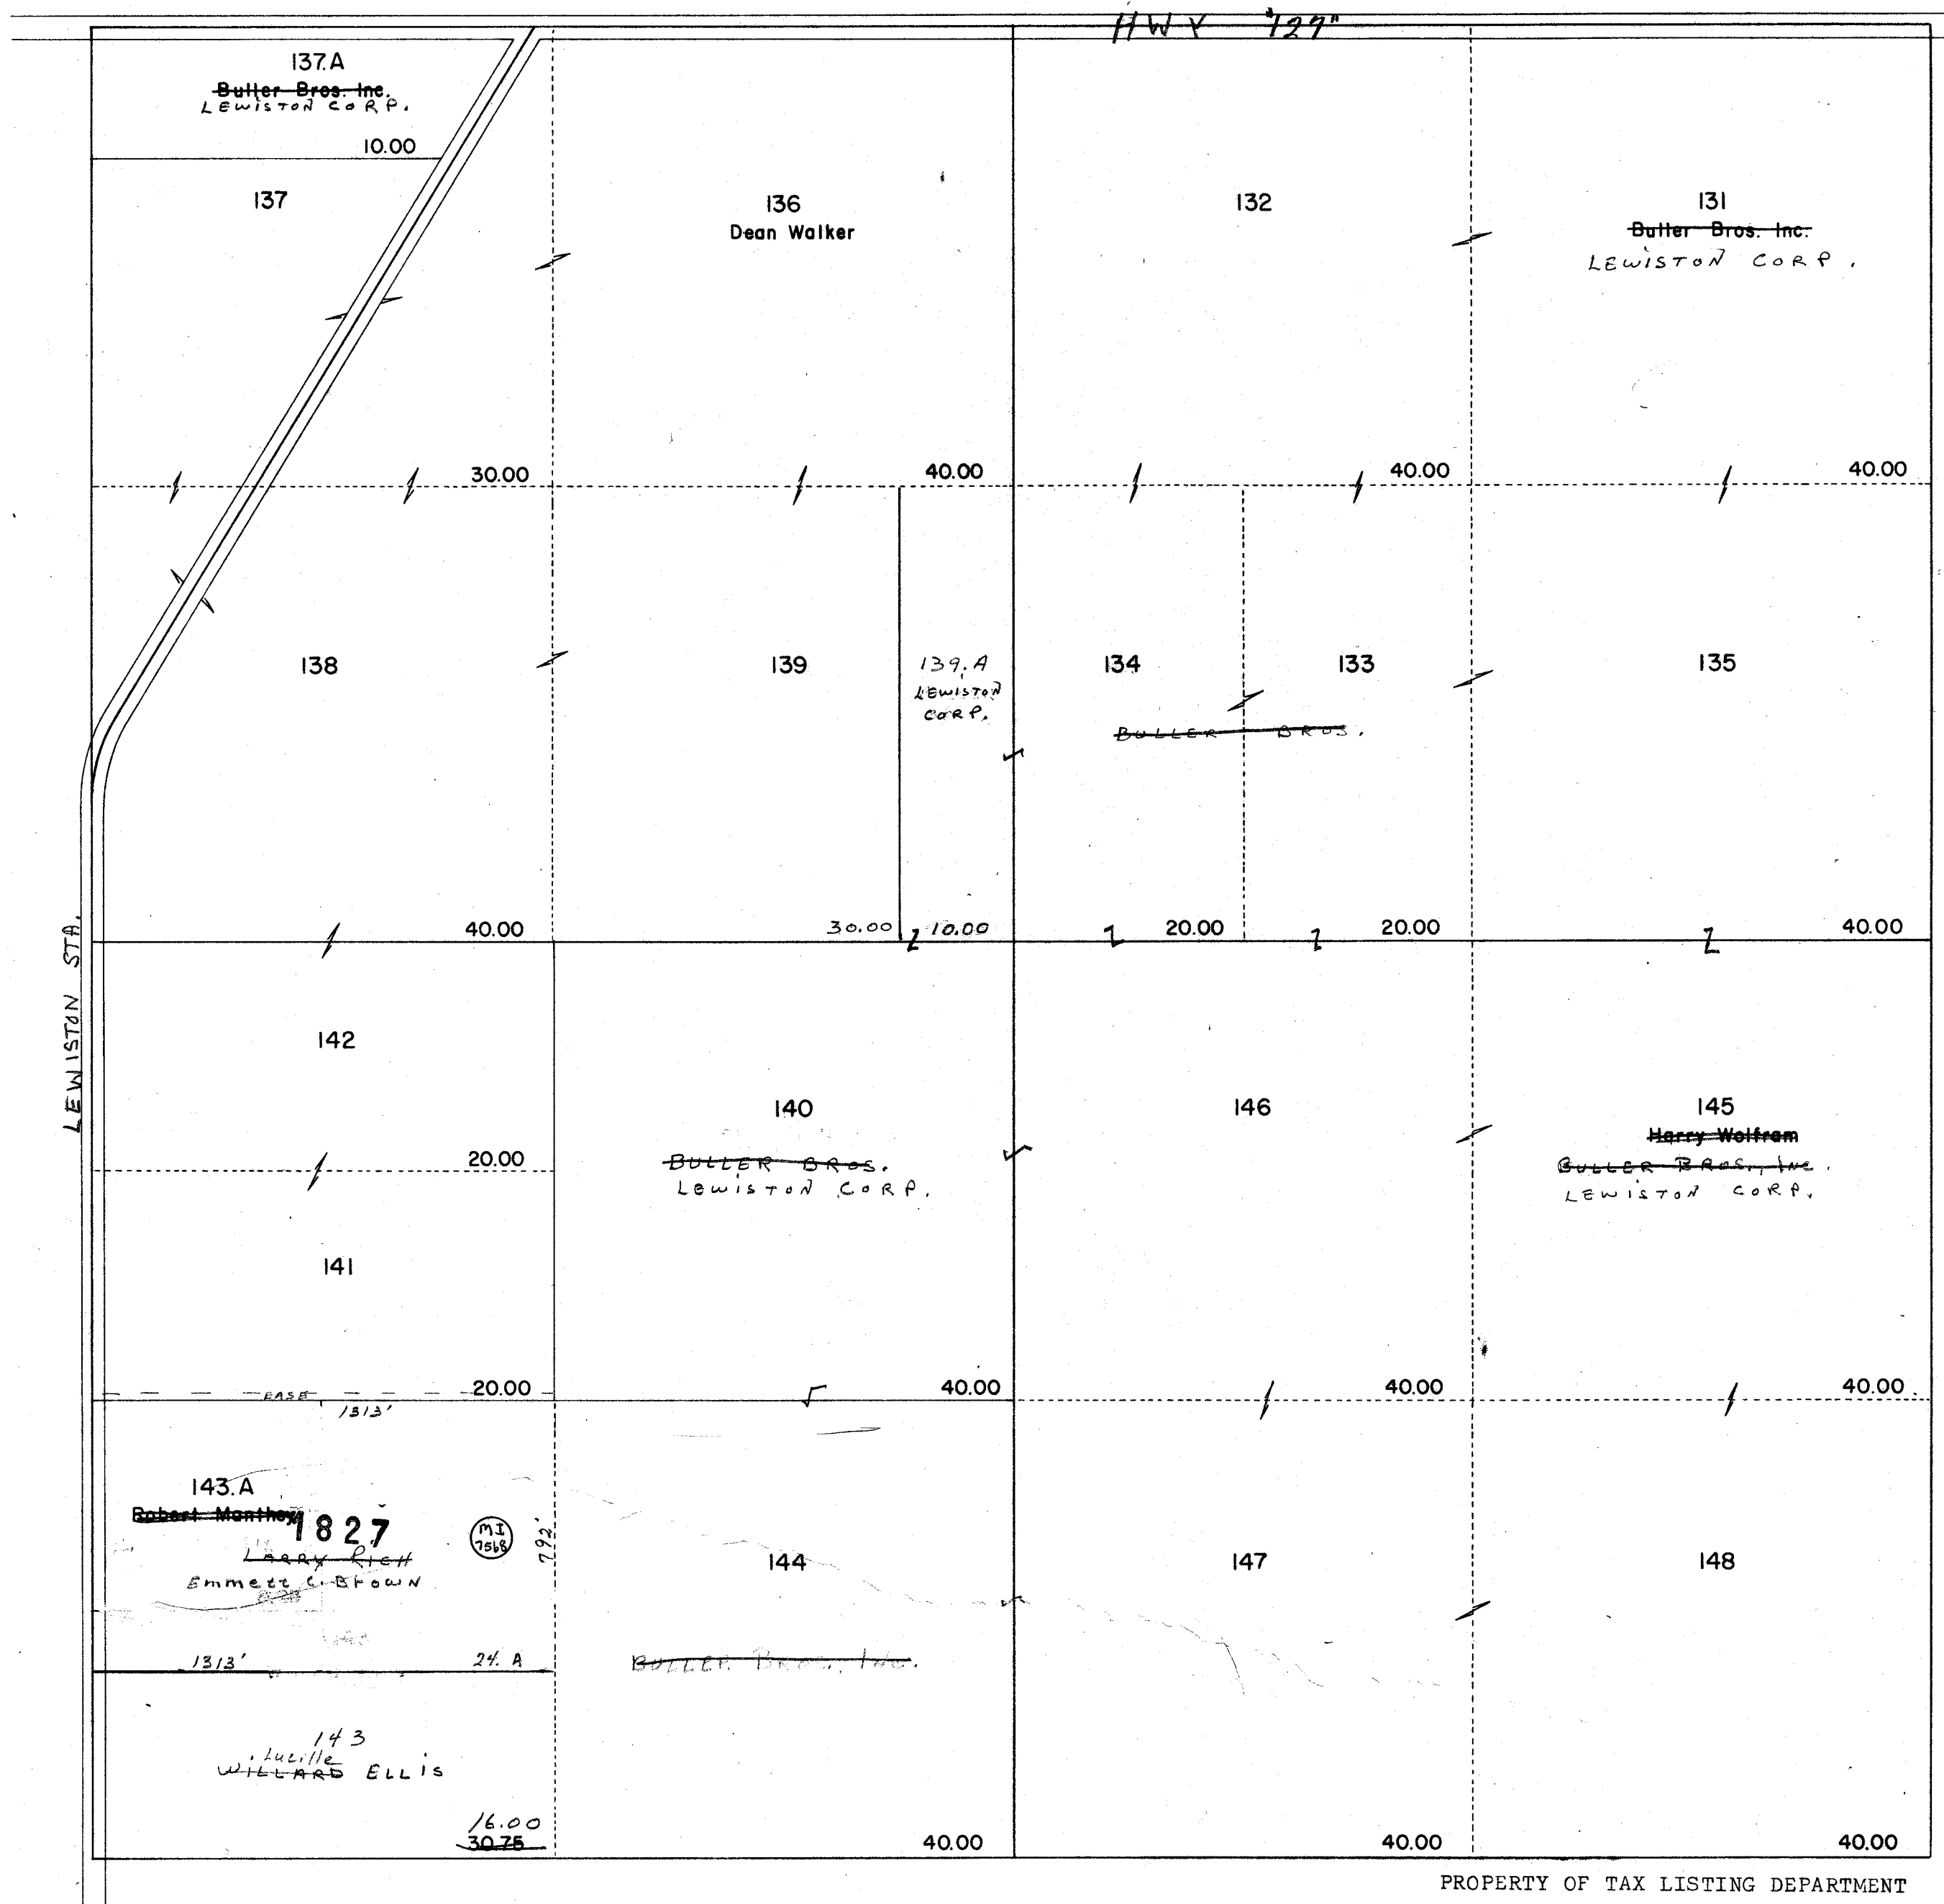

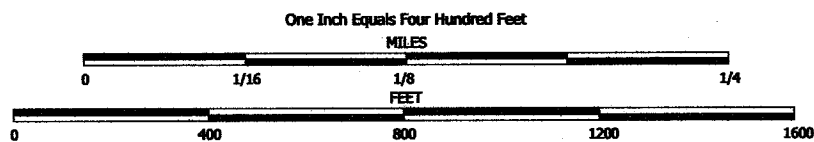


NOTE: This map was prepared for assessment use in accordance with the Wis. St. Stat. Chap. 70.09. All information contained herein is advisory only. Map accuracy is limited to the quality of data obtained from other Public Records. This map is not intended to be a substitute for an actual field survey. Public Land Survey Base is derived from U.S.G.S. Topographic maps unless otherwise noted. Other sources of the Land Base may be actual survey data. Base map data is from the April 1995 County Digital Orthophotos and/or U.S.G.S. 1:24,000 scale Topographic series. The user is responsible for the improper use of the data contained herein.

Created by The Columbia County Land Information Office -GIS Section. VMB.
September 2002.

TAX PARCEL MAP

TOWN of LEWISTON

TOWN 13 NORTH RANGE 7 EAST
COLUMBIA COUNTY, WISCONSIN

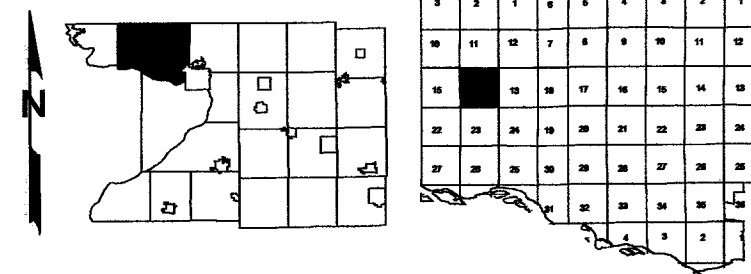

Replaced
2006

-SEE SECTION 11-




-SEE SECTION 23-


Replaced
2006

-SECTION 14-


Replaced
2009

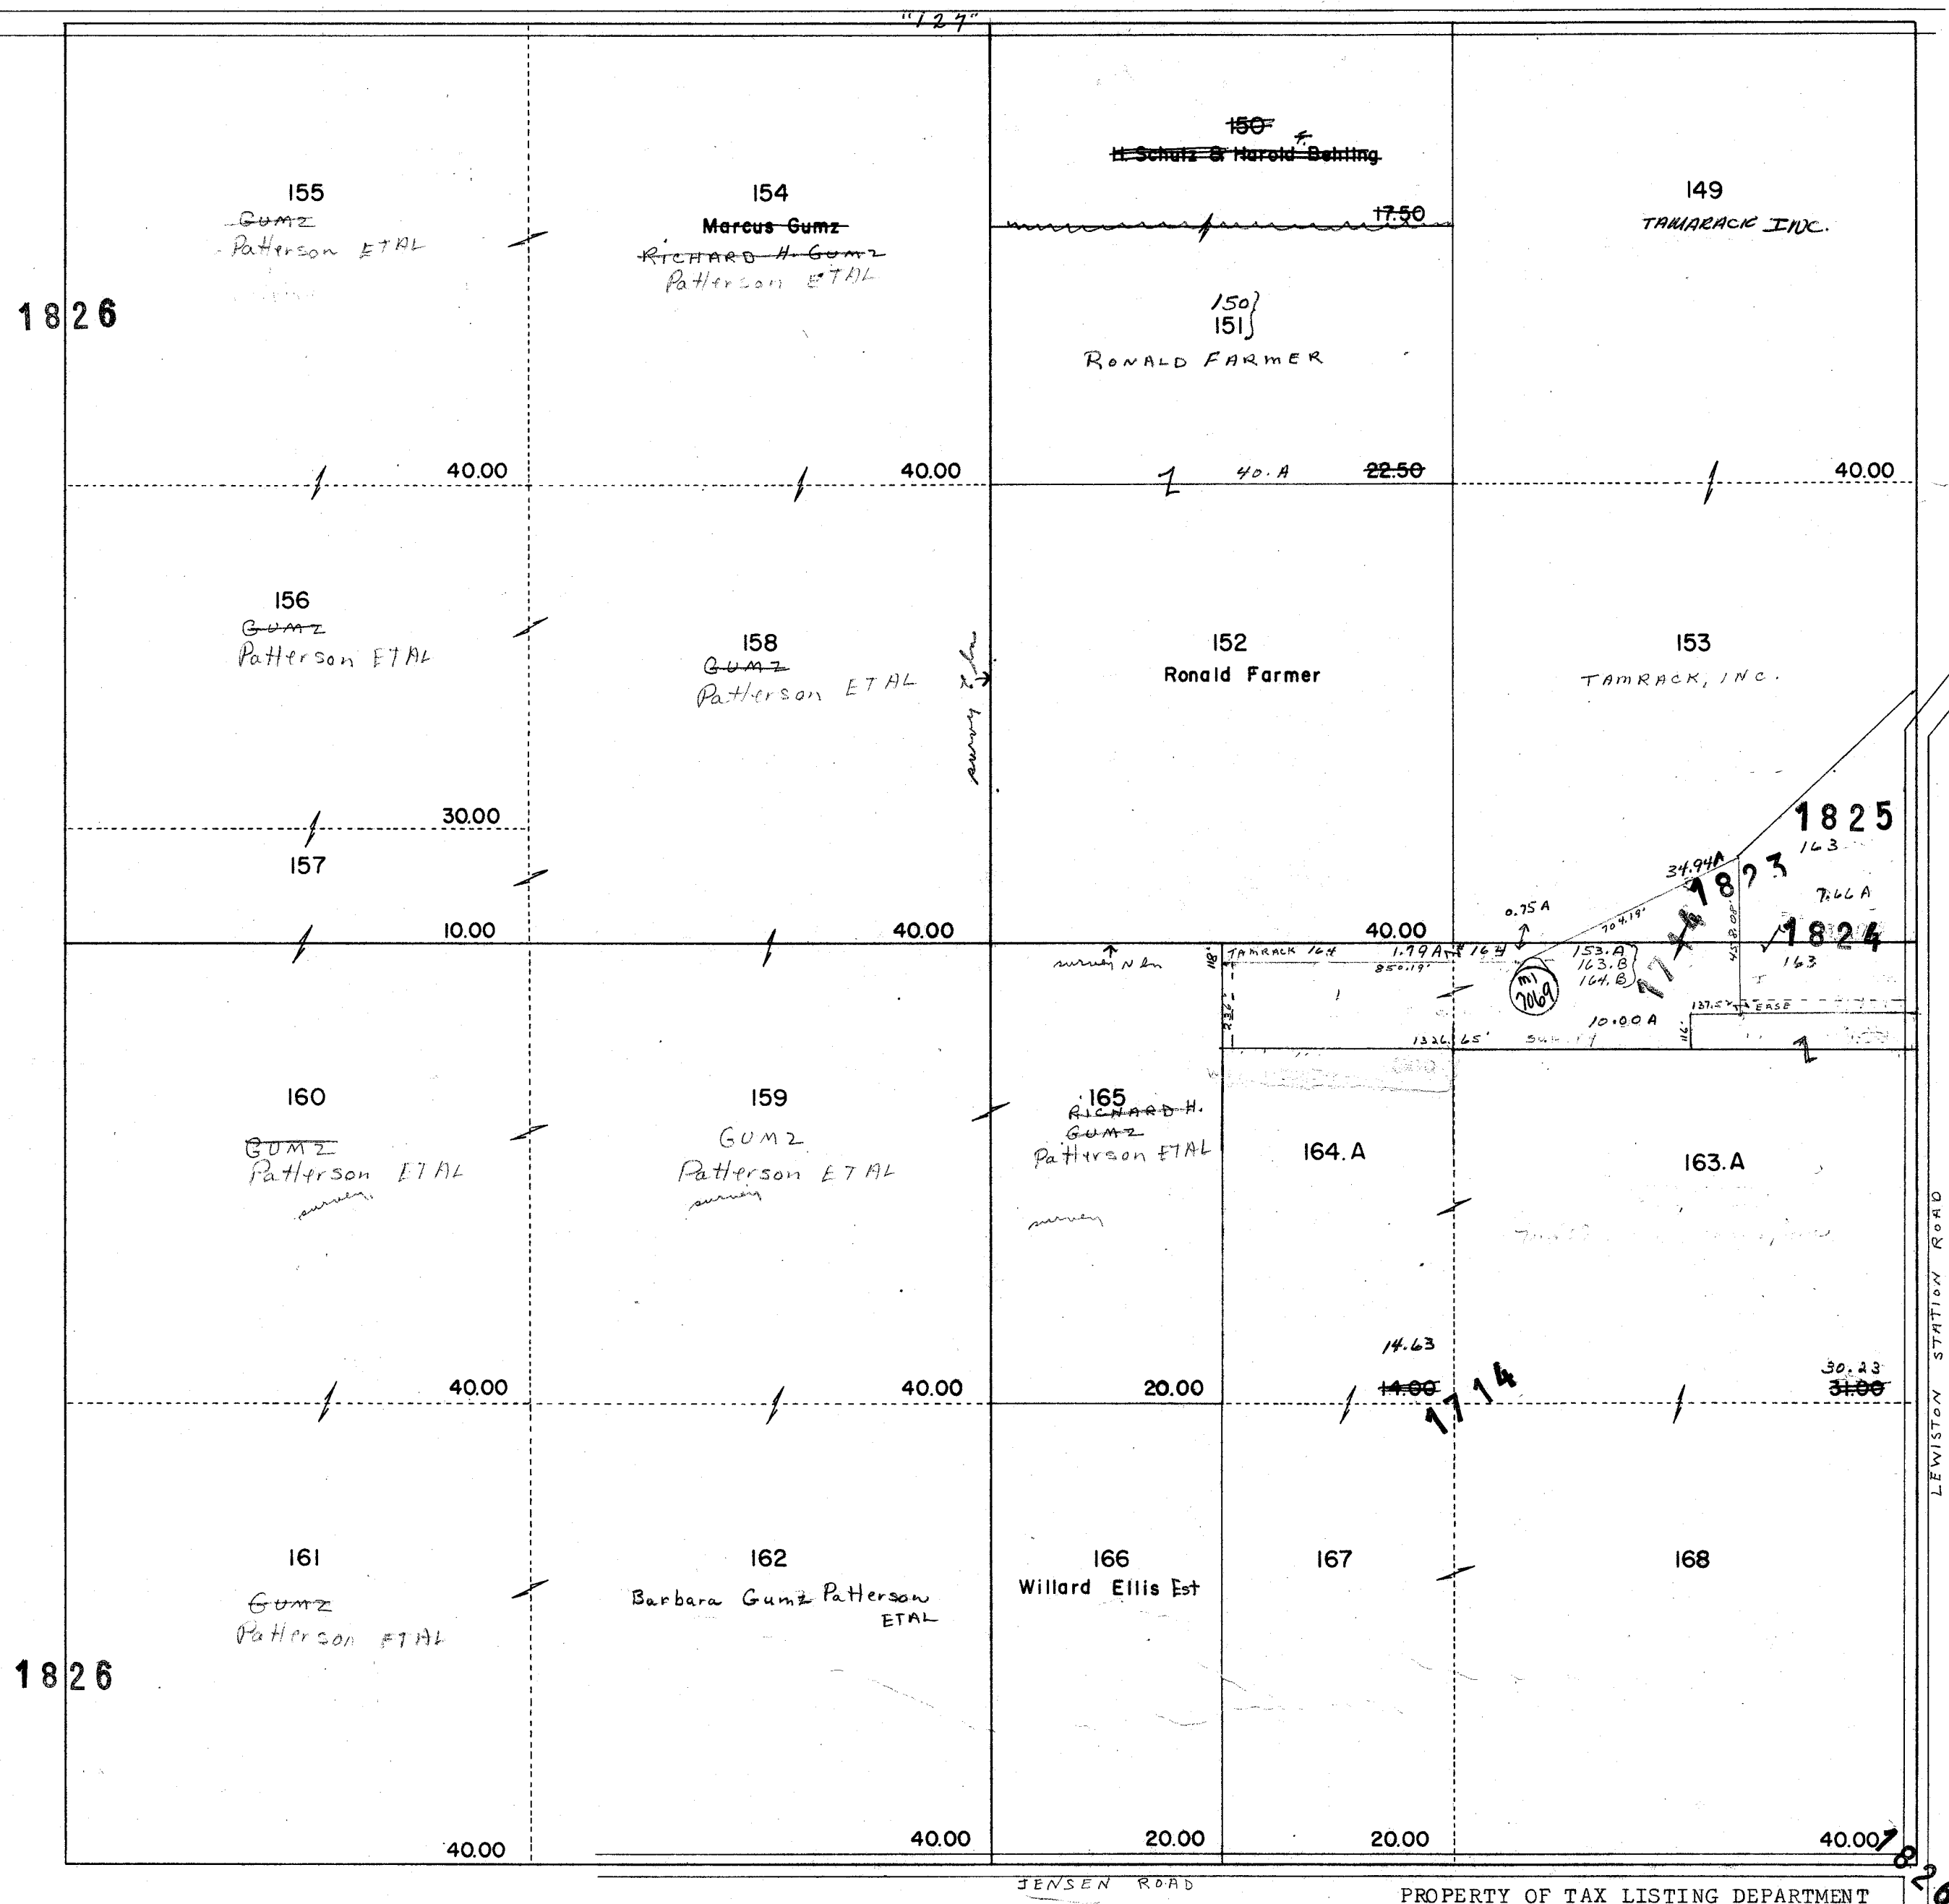


Replaced
2009

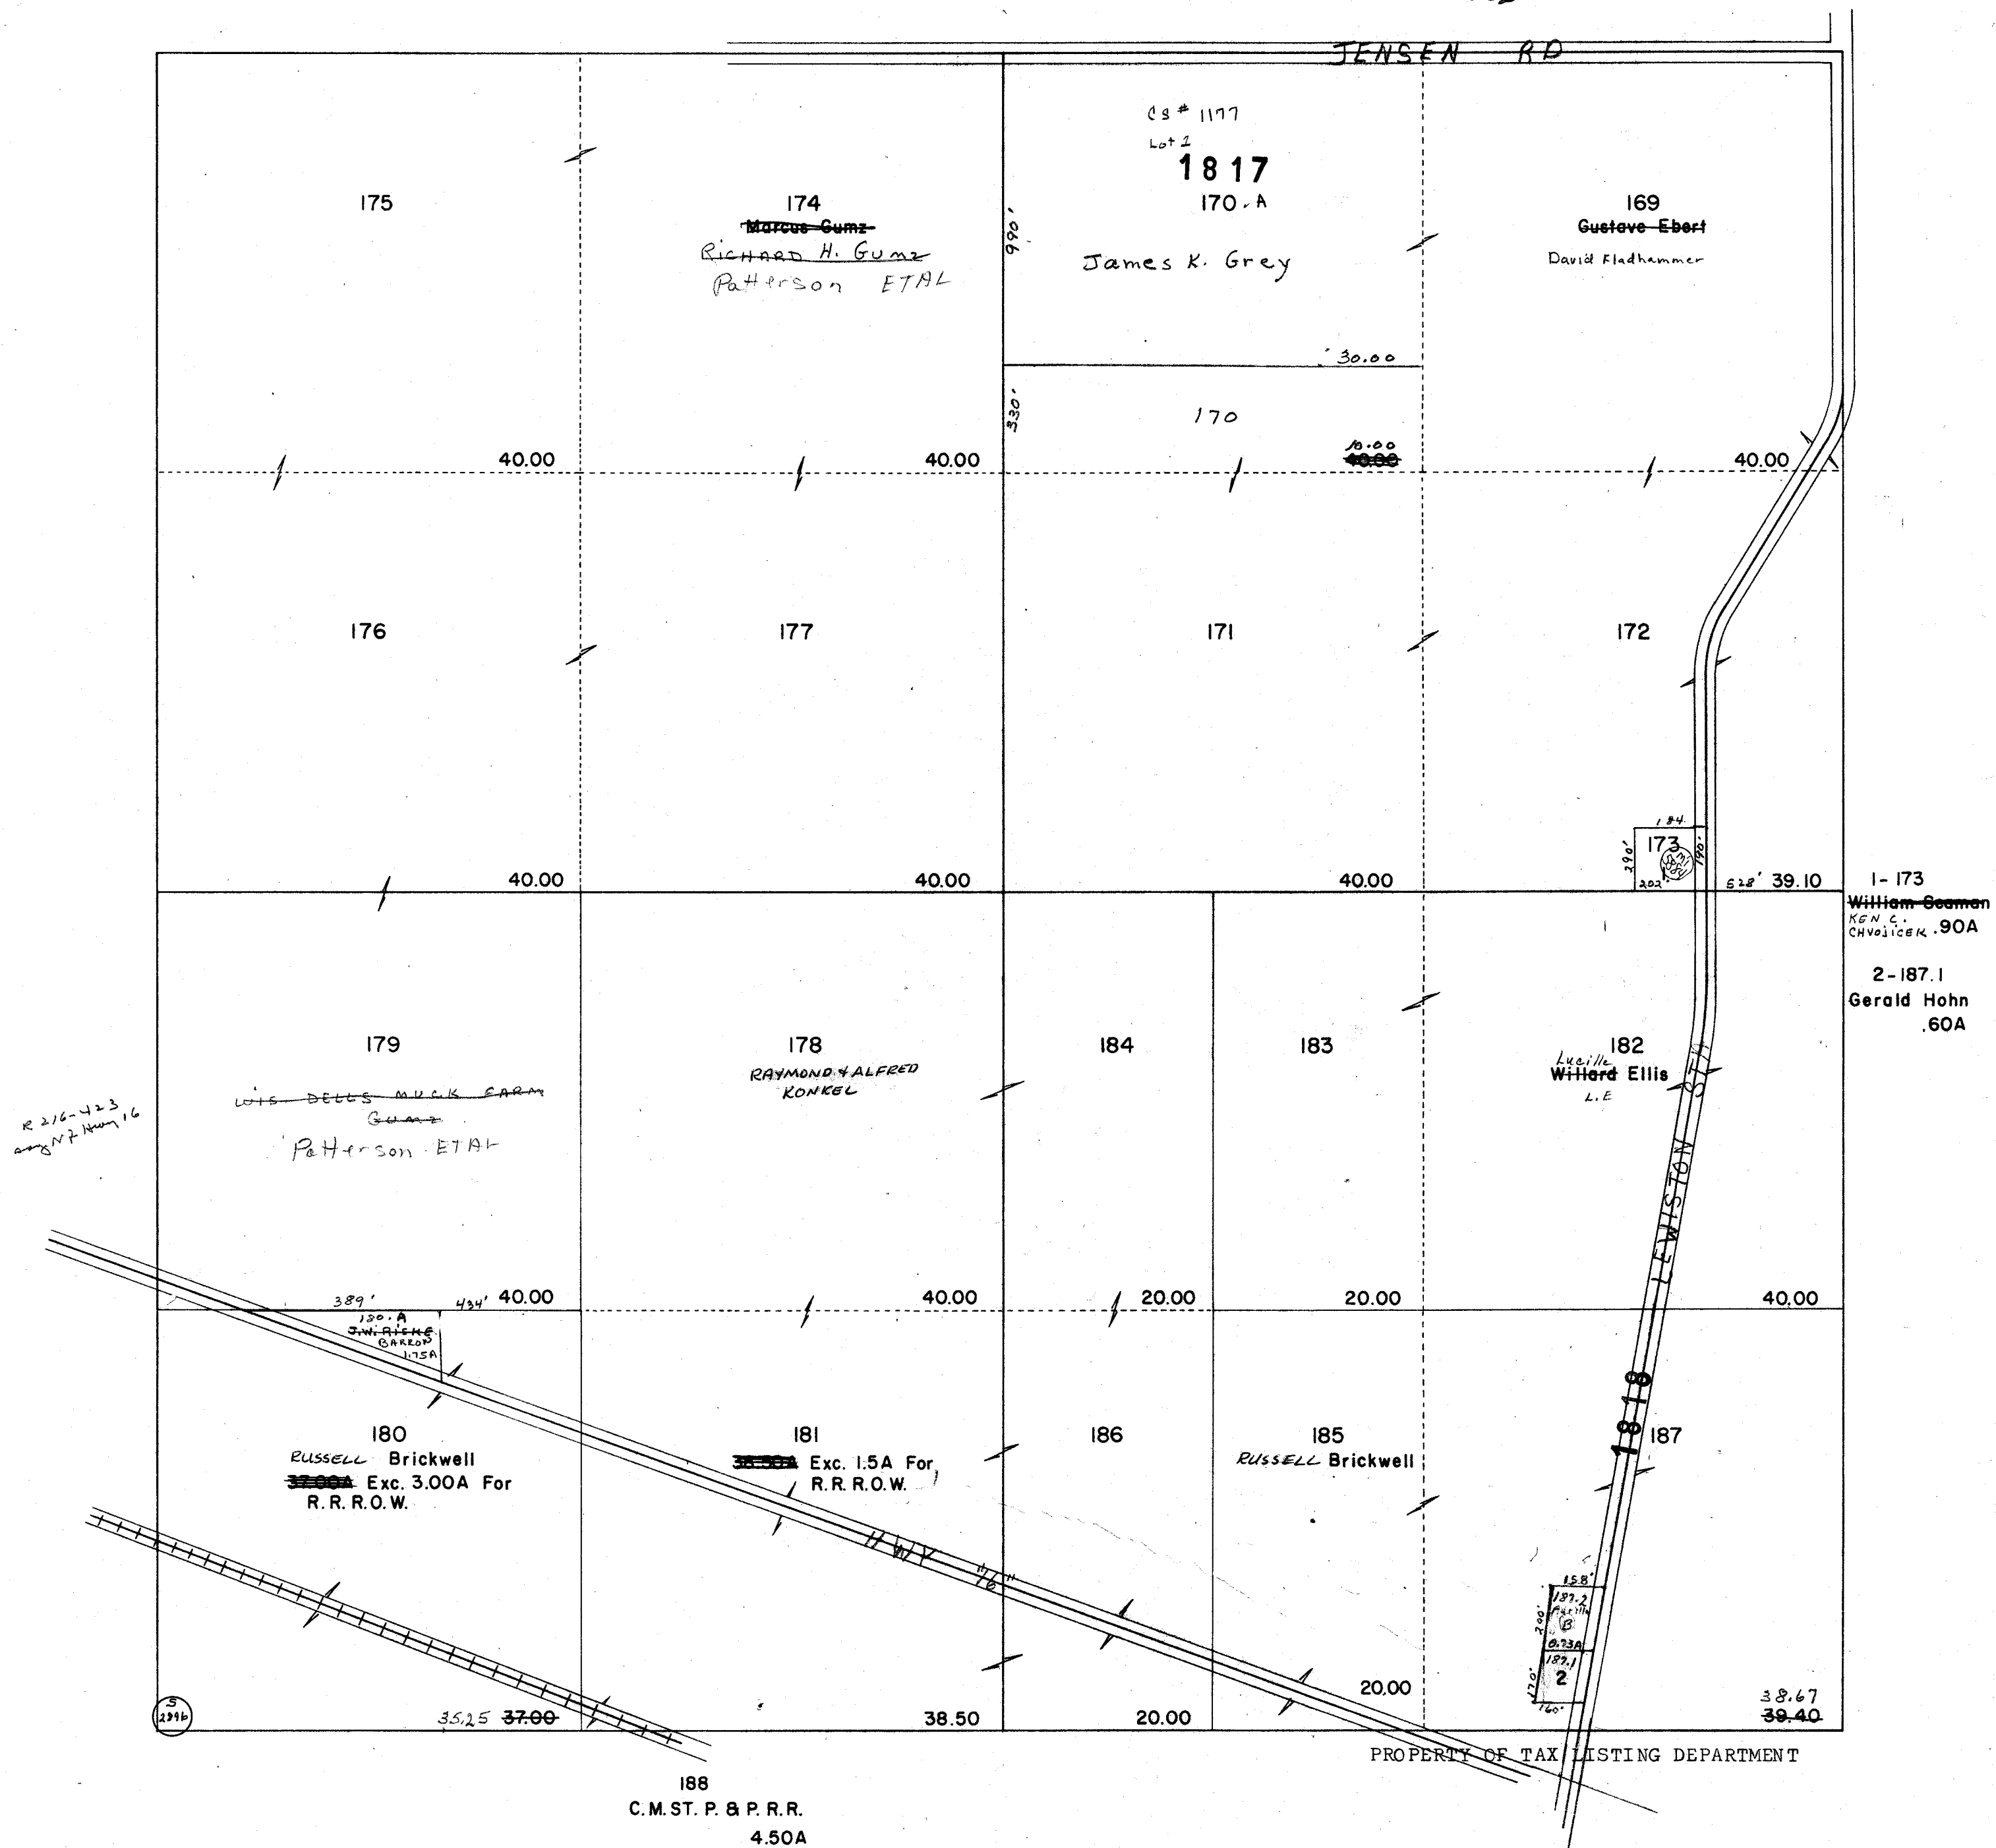

Replaced
2002

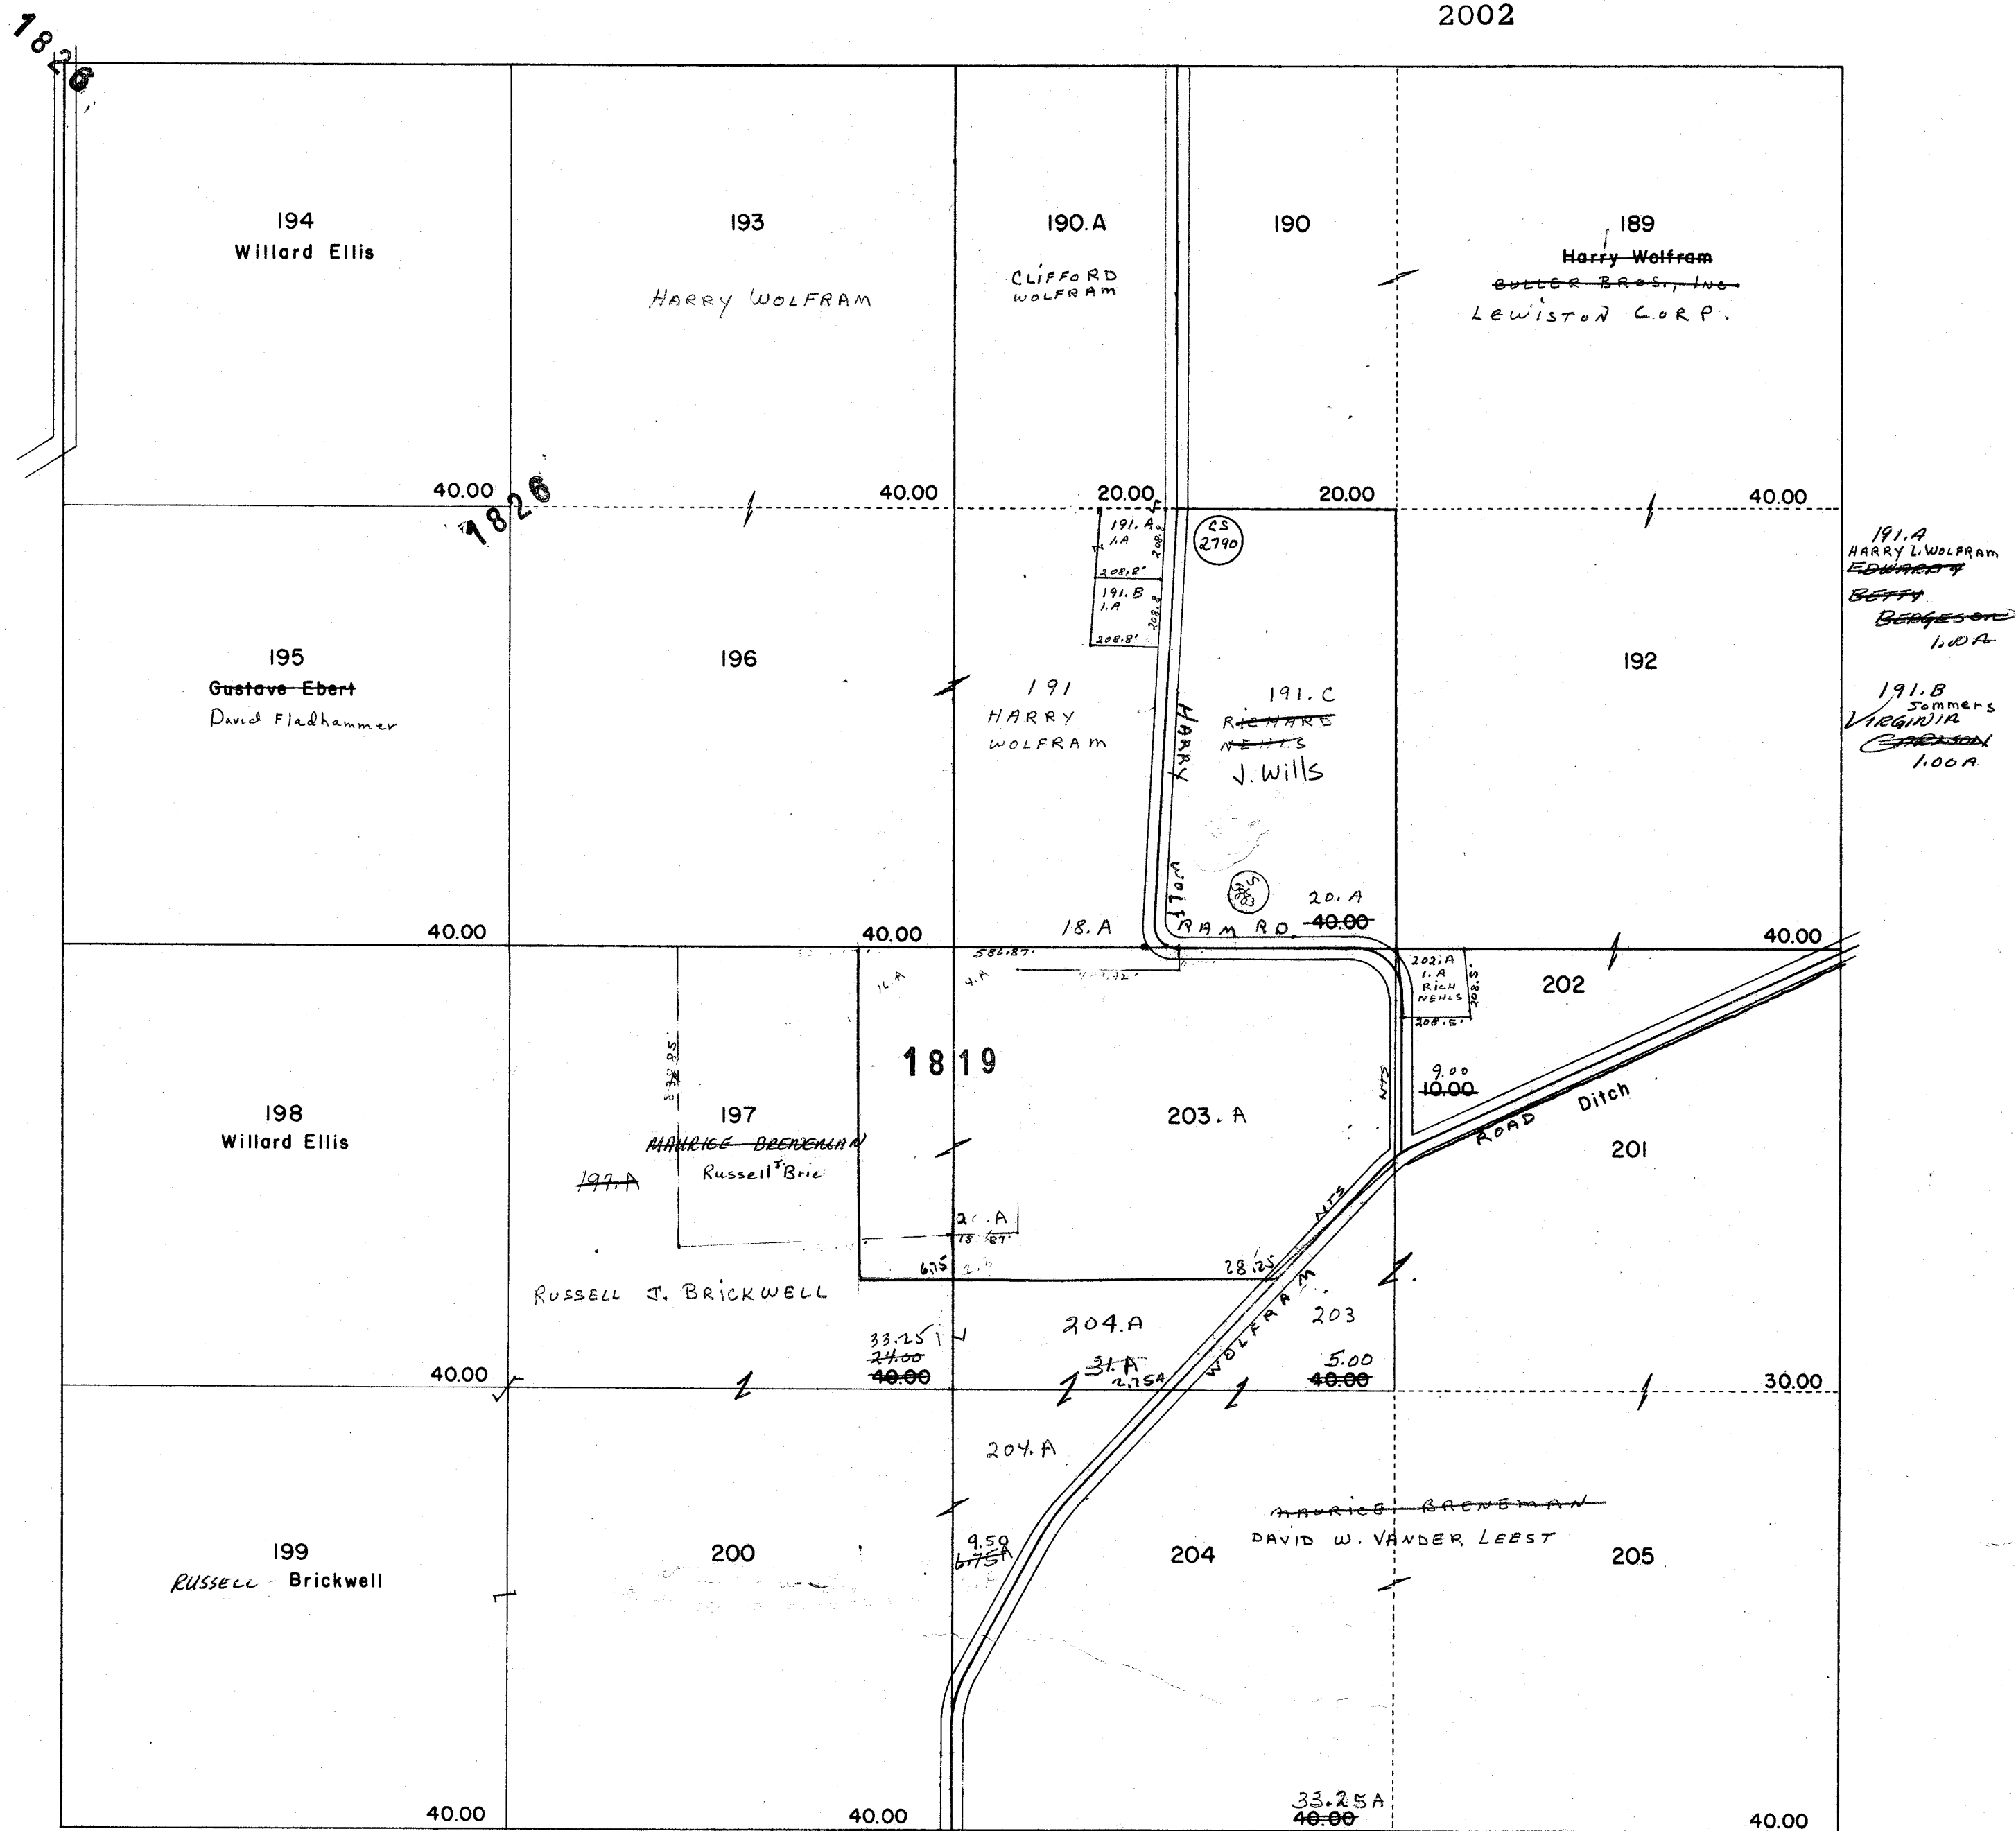

PROPERTY OF TAX LISTING DEPARTMENT

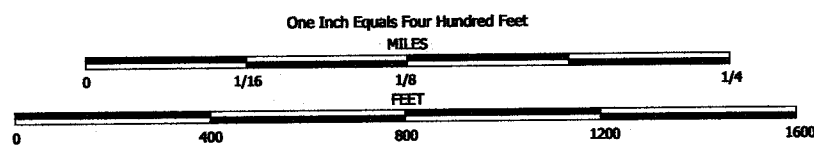


NOTE: This map was prepared for assessment use in accordance with the Wis. St. Stat. Chap. 70.09. All information contained herein is advisory only. Map accuracy is limited to the quality of data obtained from other Public Records. This map is not intended to be a substitute for an actual field survey. Public Land Survey Base is derived from U.S.G.S. Topographic maps unless otherwise noted. Other sources of the Land Base may be actual survey data. Base map data is from the April 1995 County Digital Orthophotos and/or U.S.G.S. 1:24,000 scale Topographic series. The user is responsible for the improper use of the data contained herein.

Created by The Columbia County Land Information Office -GIS Section. VMB.
September 2002.

TAX PARCEL MAP

TOWN of LEWISTON

TOWN 13 NORTH RANGE 7 EAST
COLUMBIA COUNTY, WISCONSIN

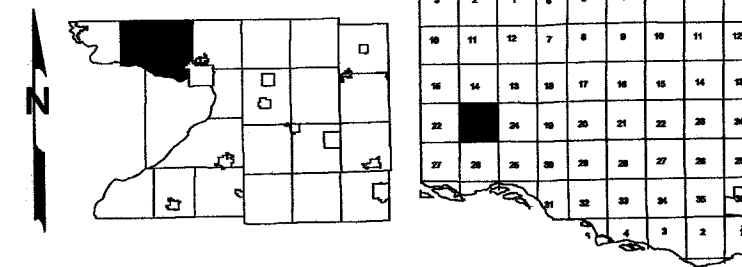

Replaced
2004

-SEE SECTION 14-



-SEE SECTION 22-


-SEE SECTION 24-

-SEE SECTION 26-

replaced
2004
-SECTION 23-


LEWISTON
SEC. 24 T13N R7E

Replaced
2002

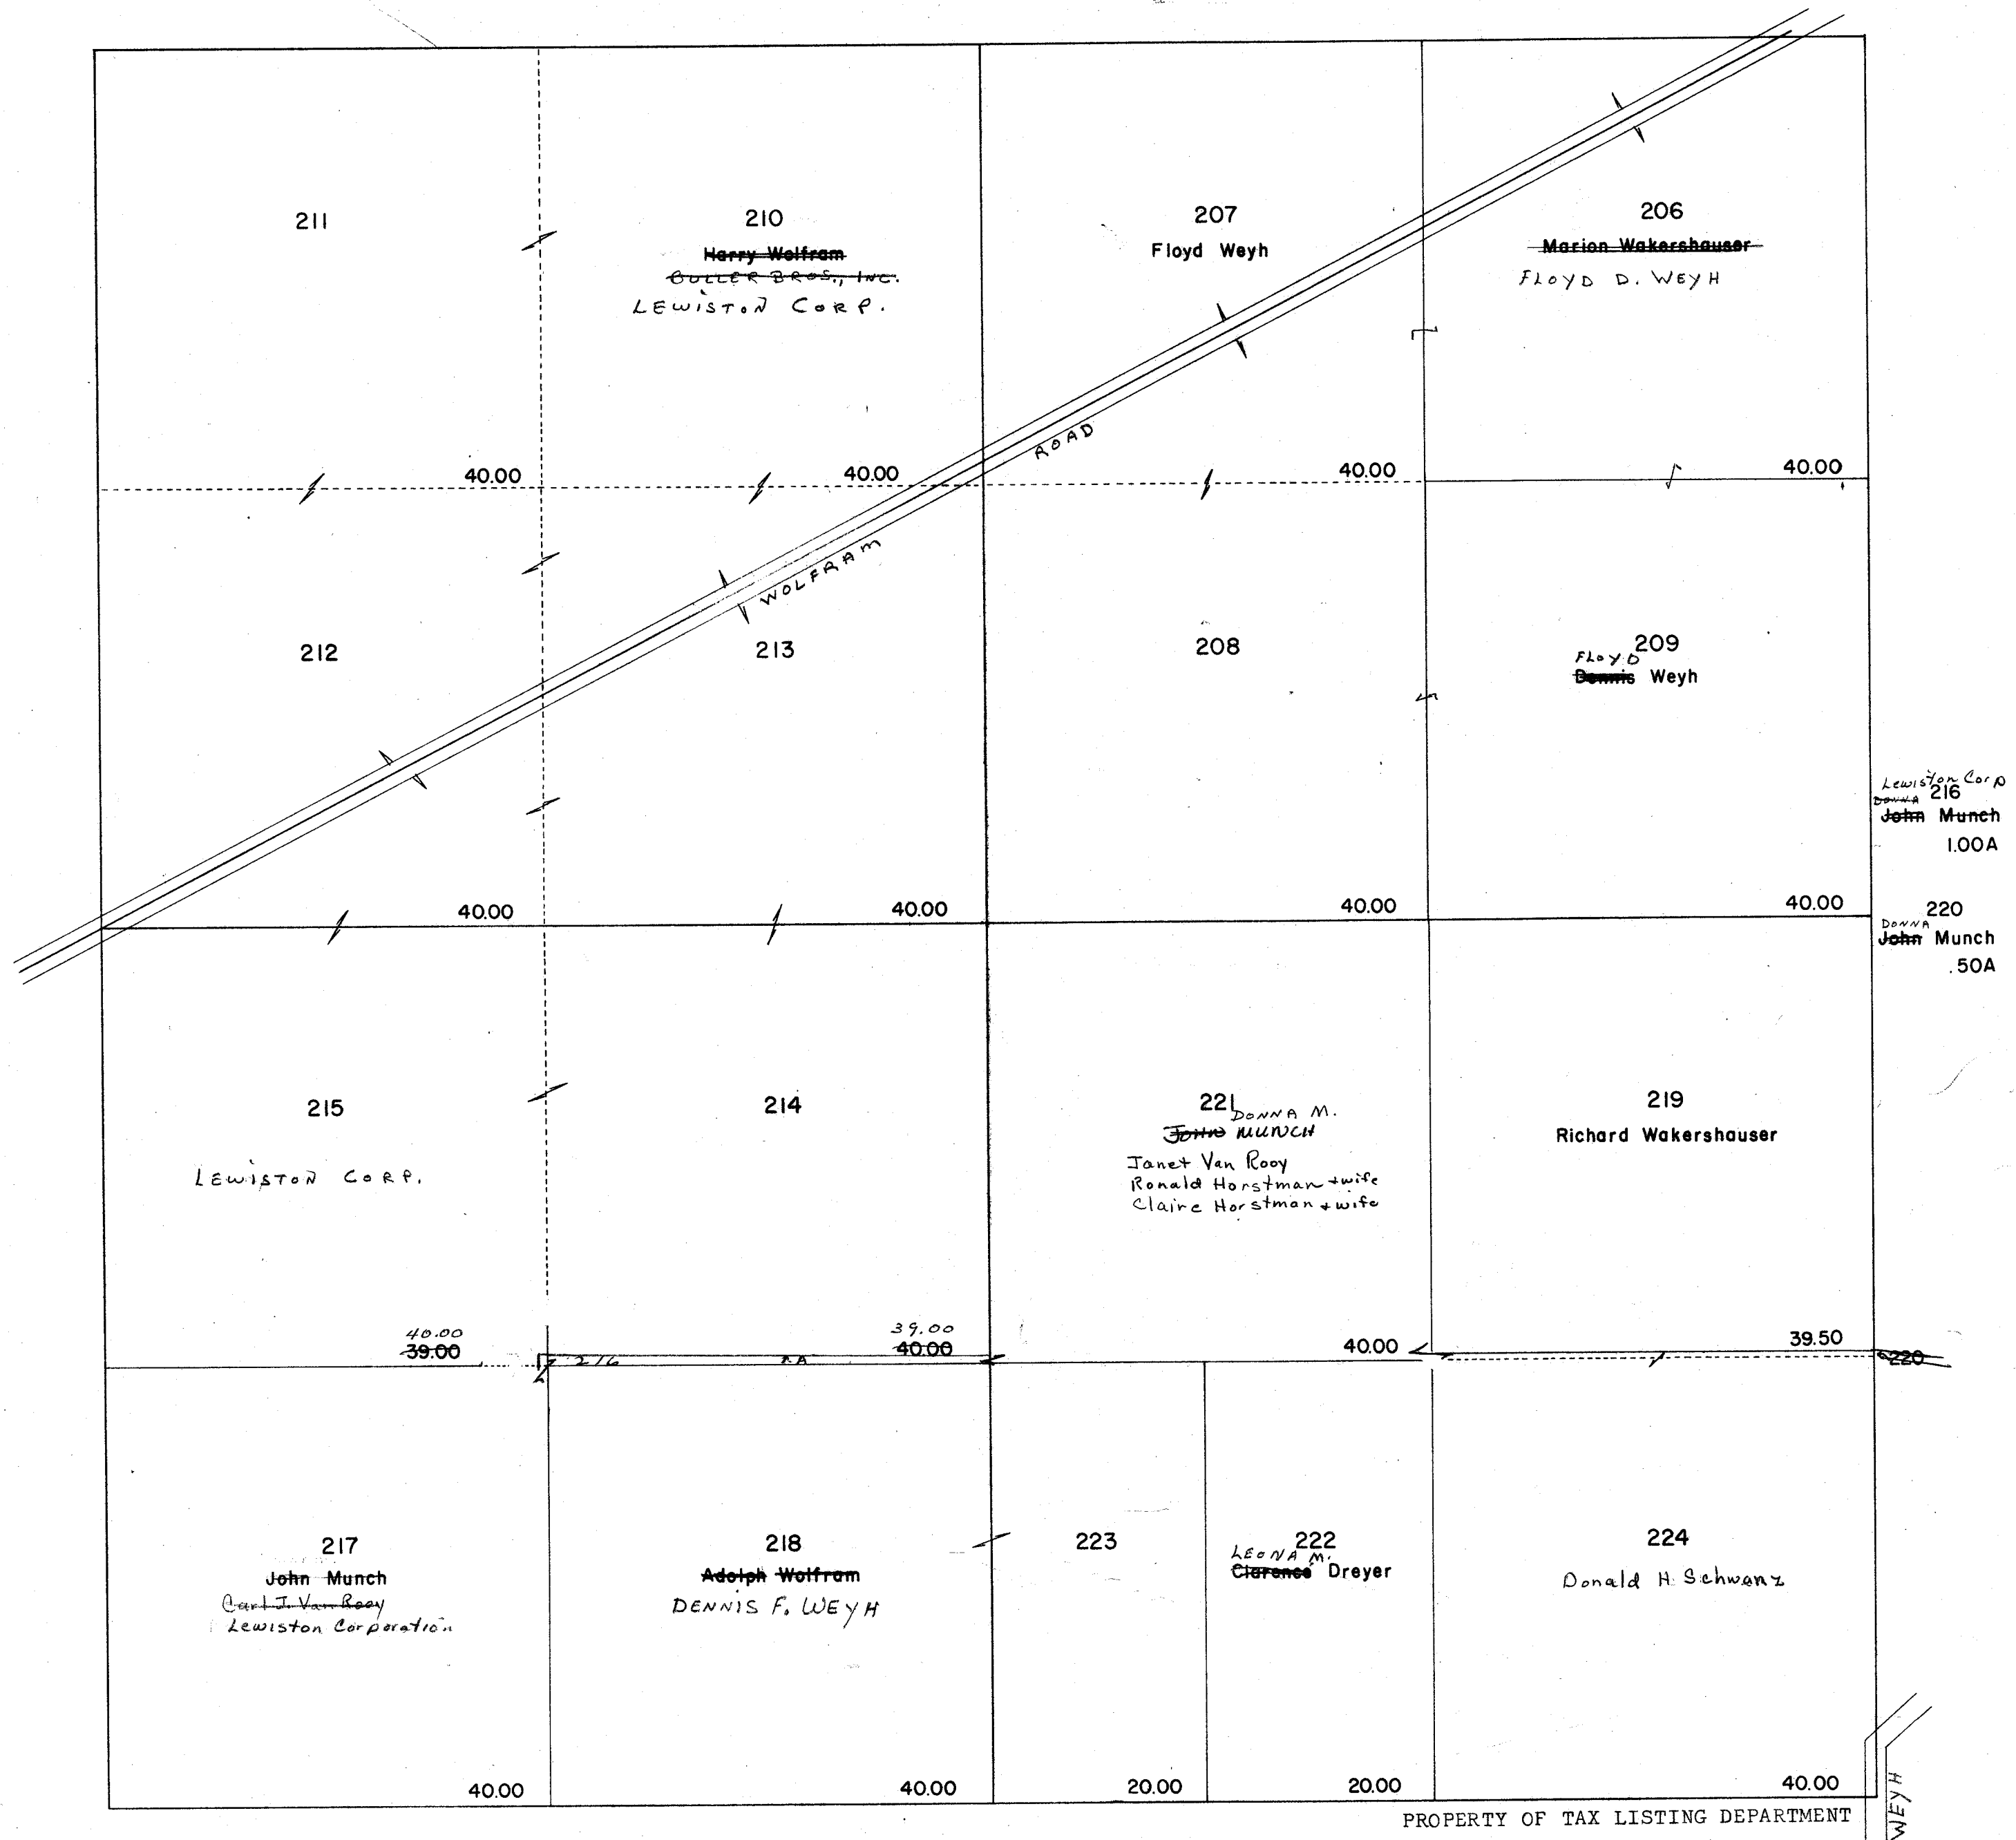

LEWISTON
SEC. 25 T13N R7E


Replaced
2002

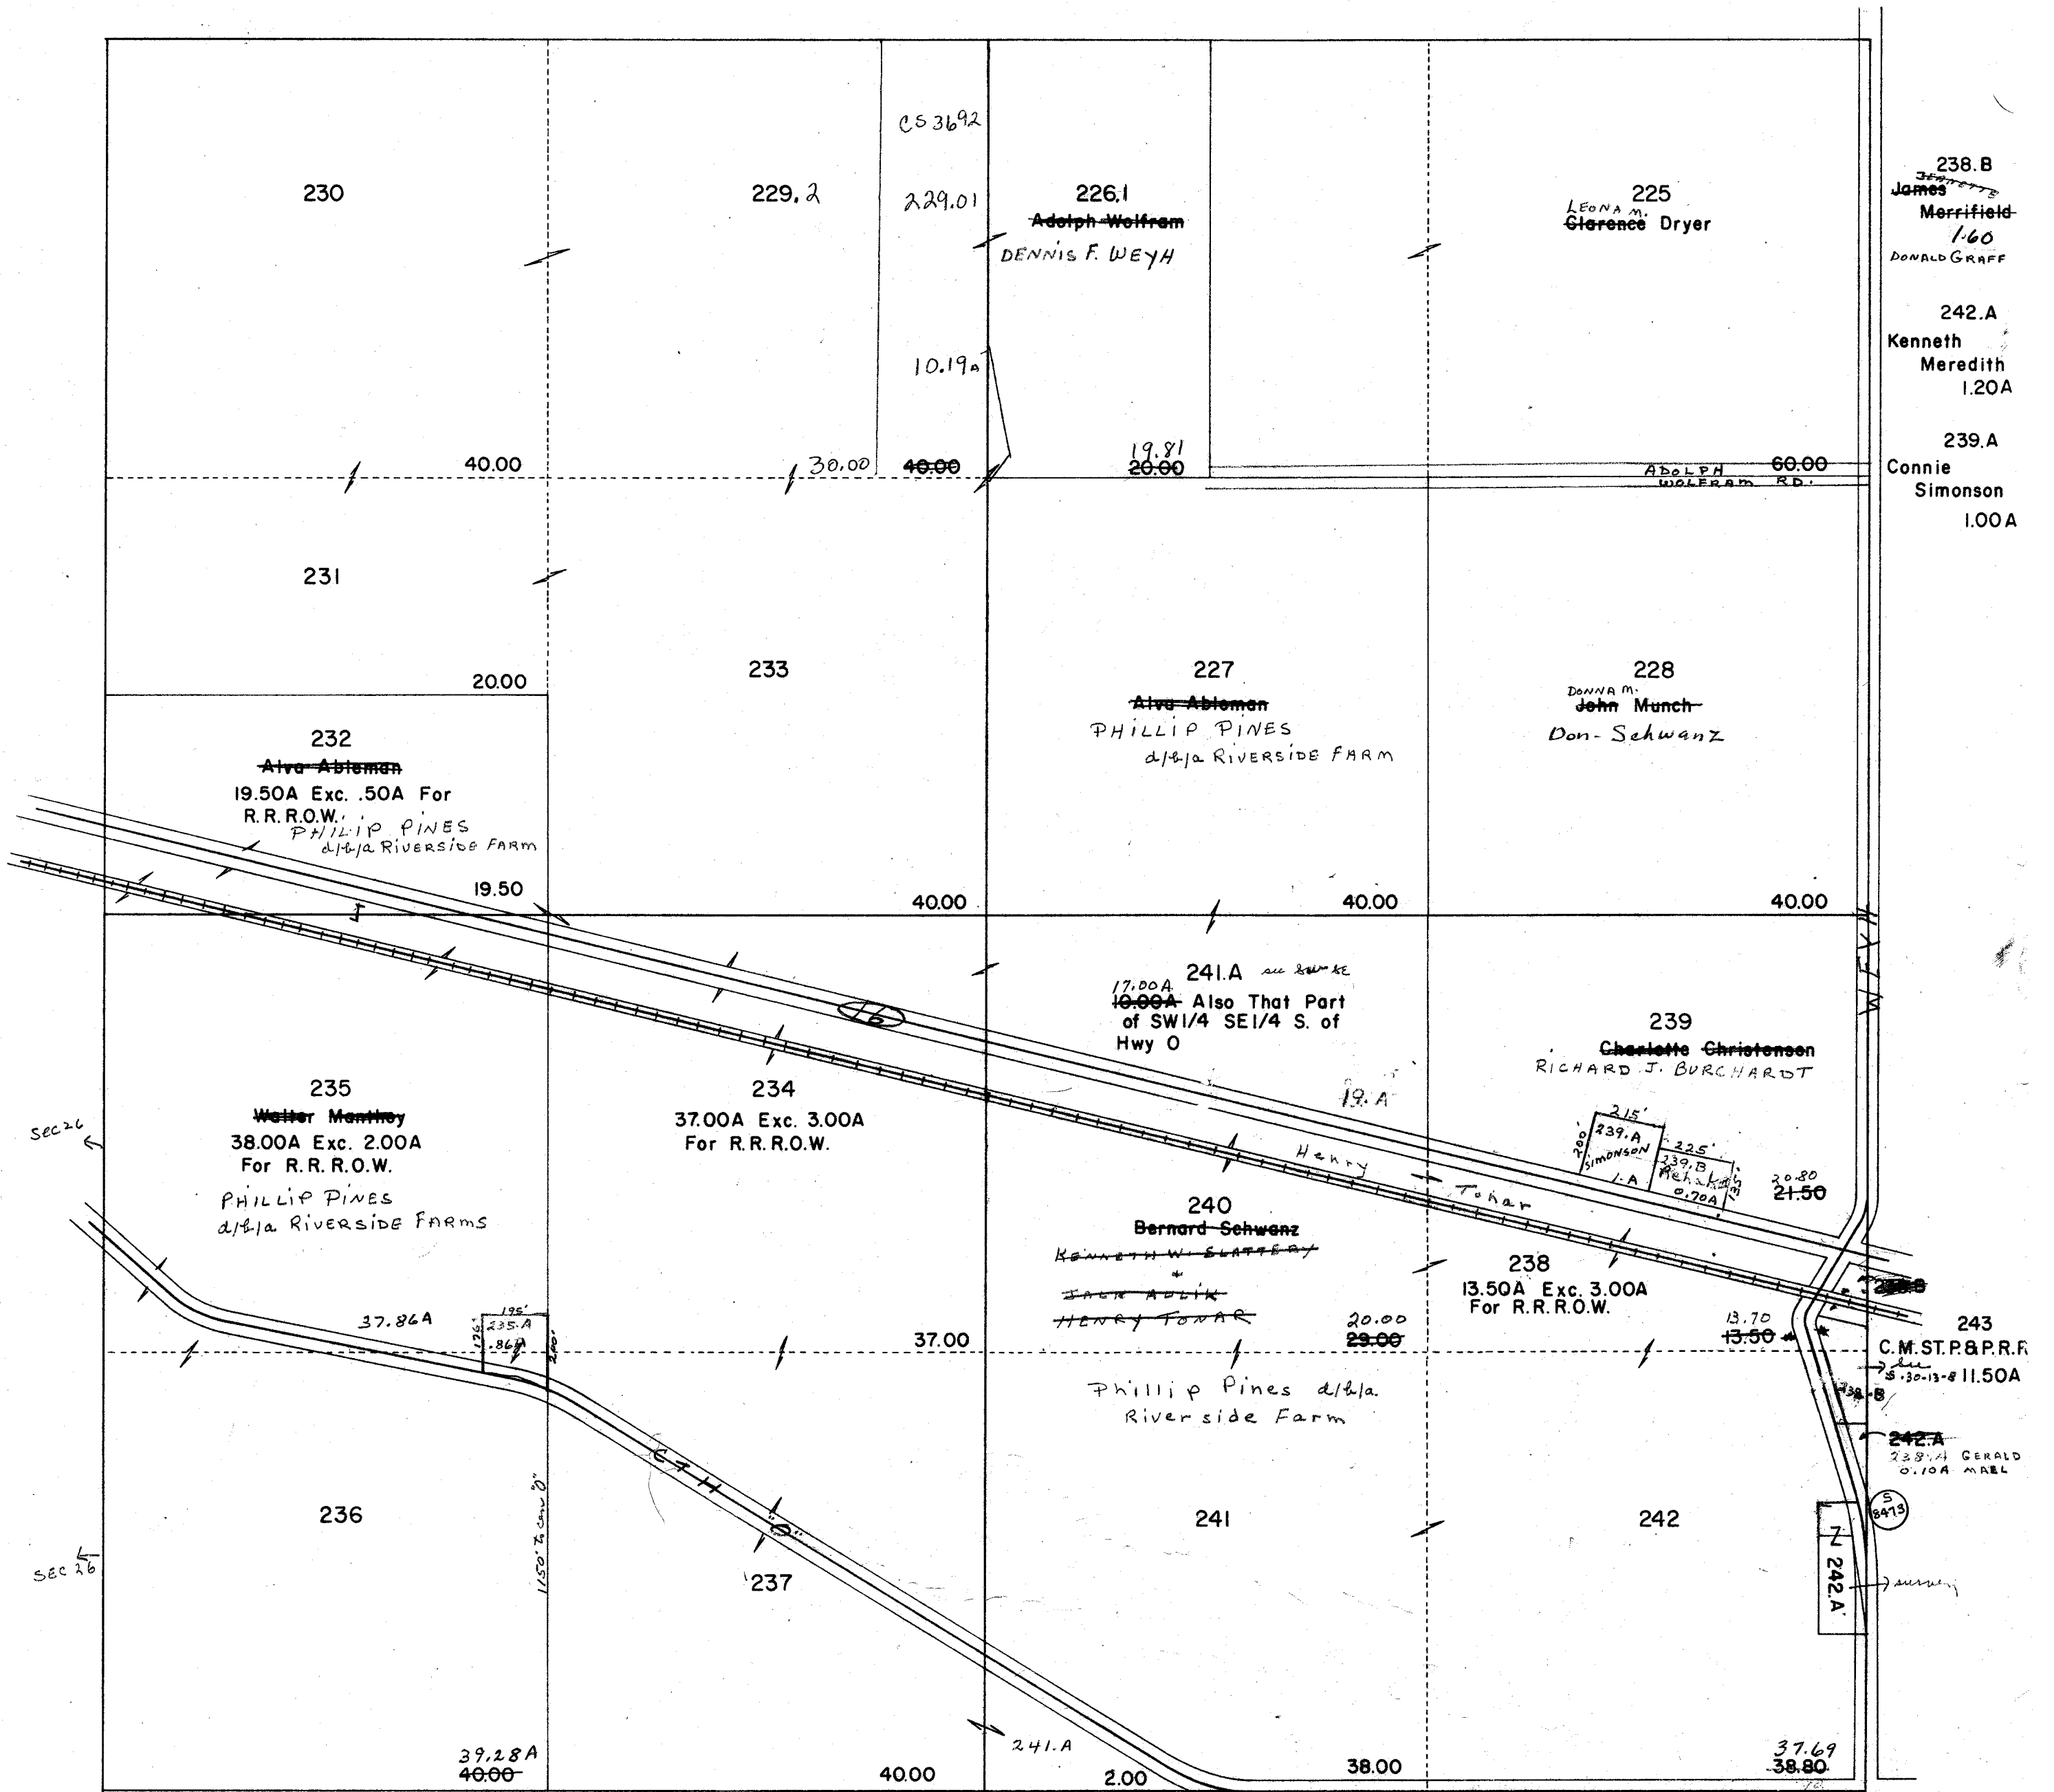

LEWISTON

SEC. 26 T13N R7E

Replace
2002

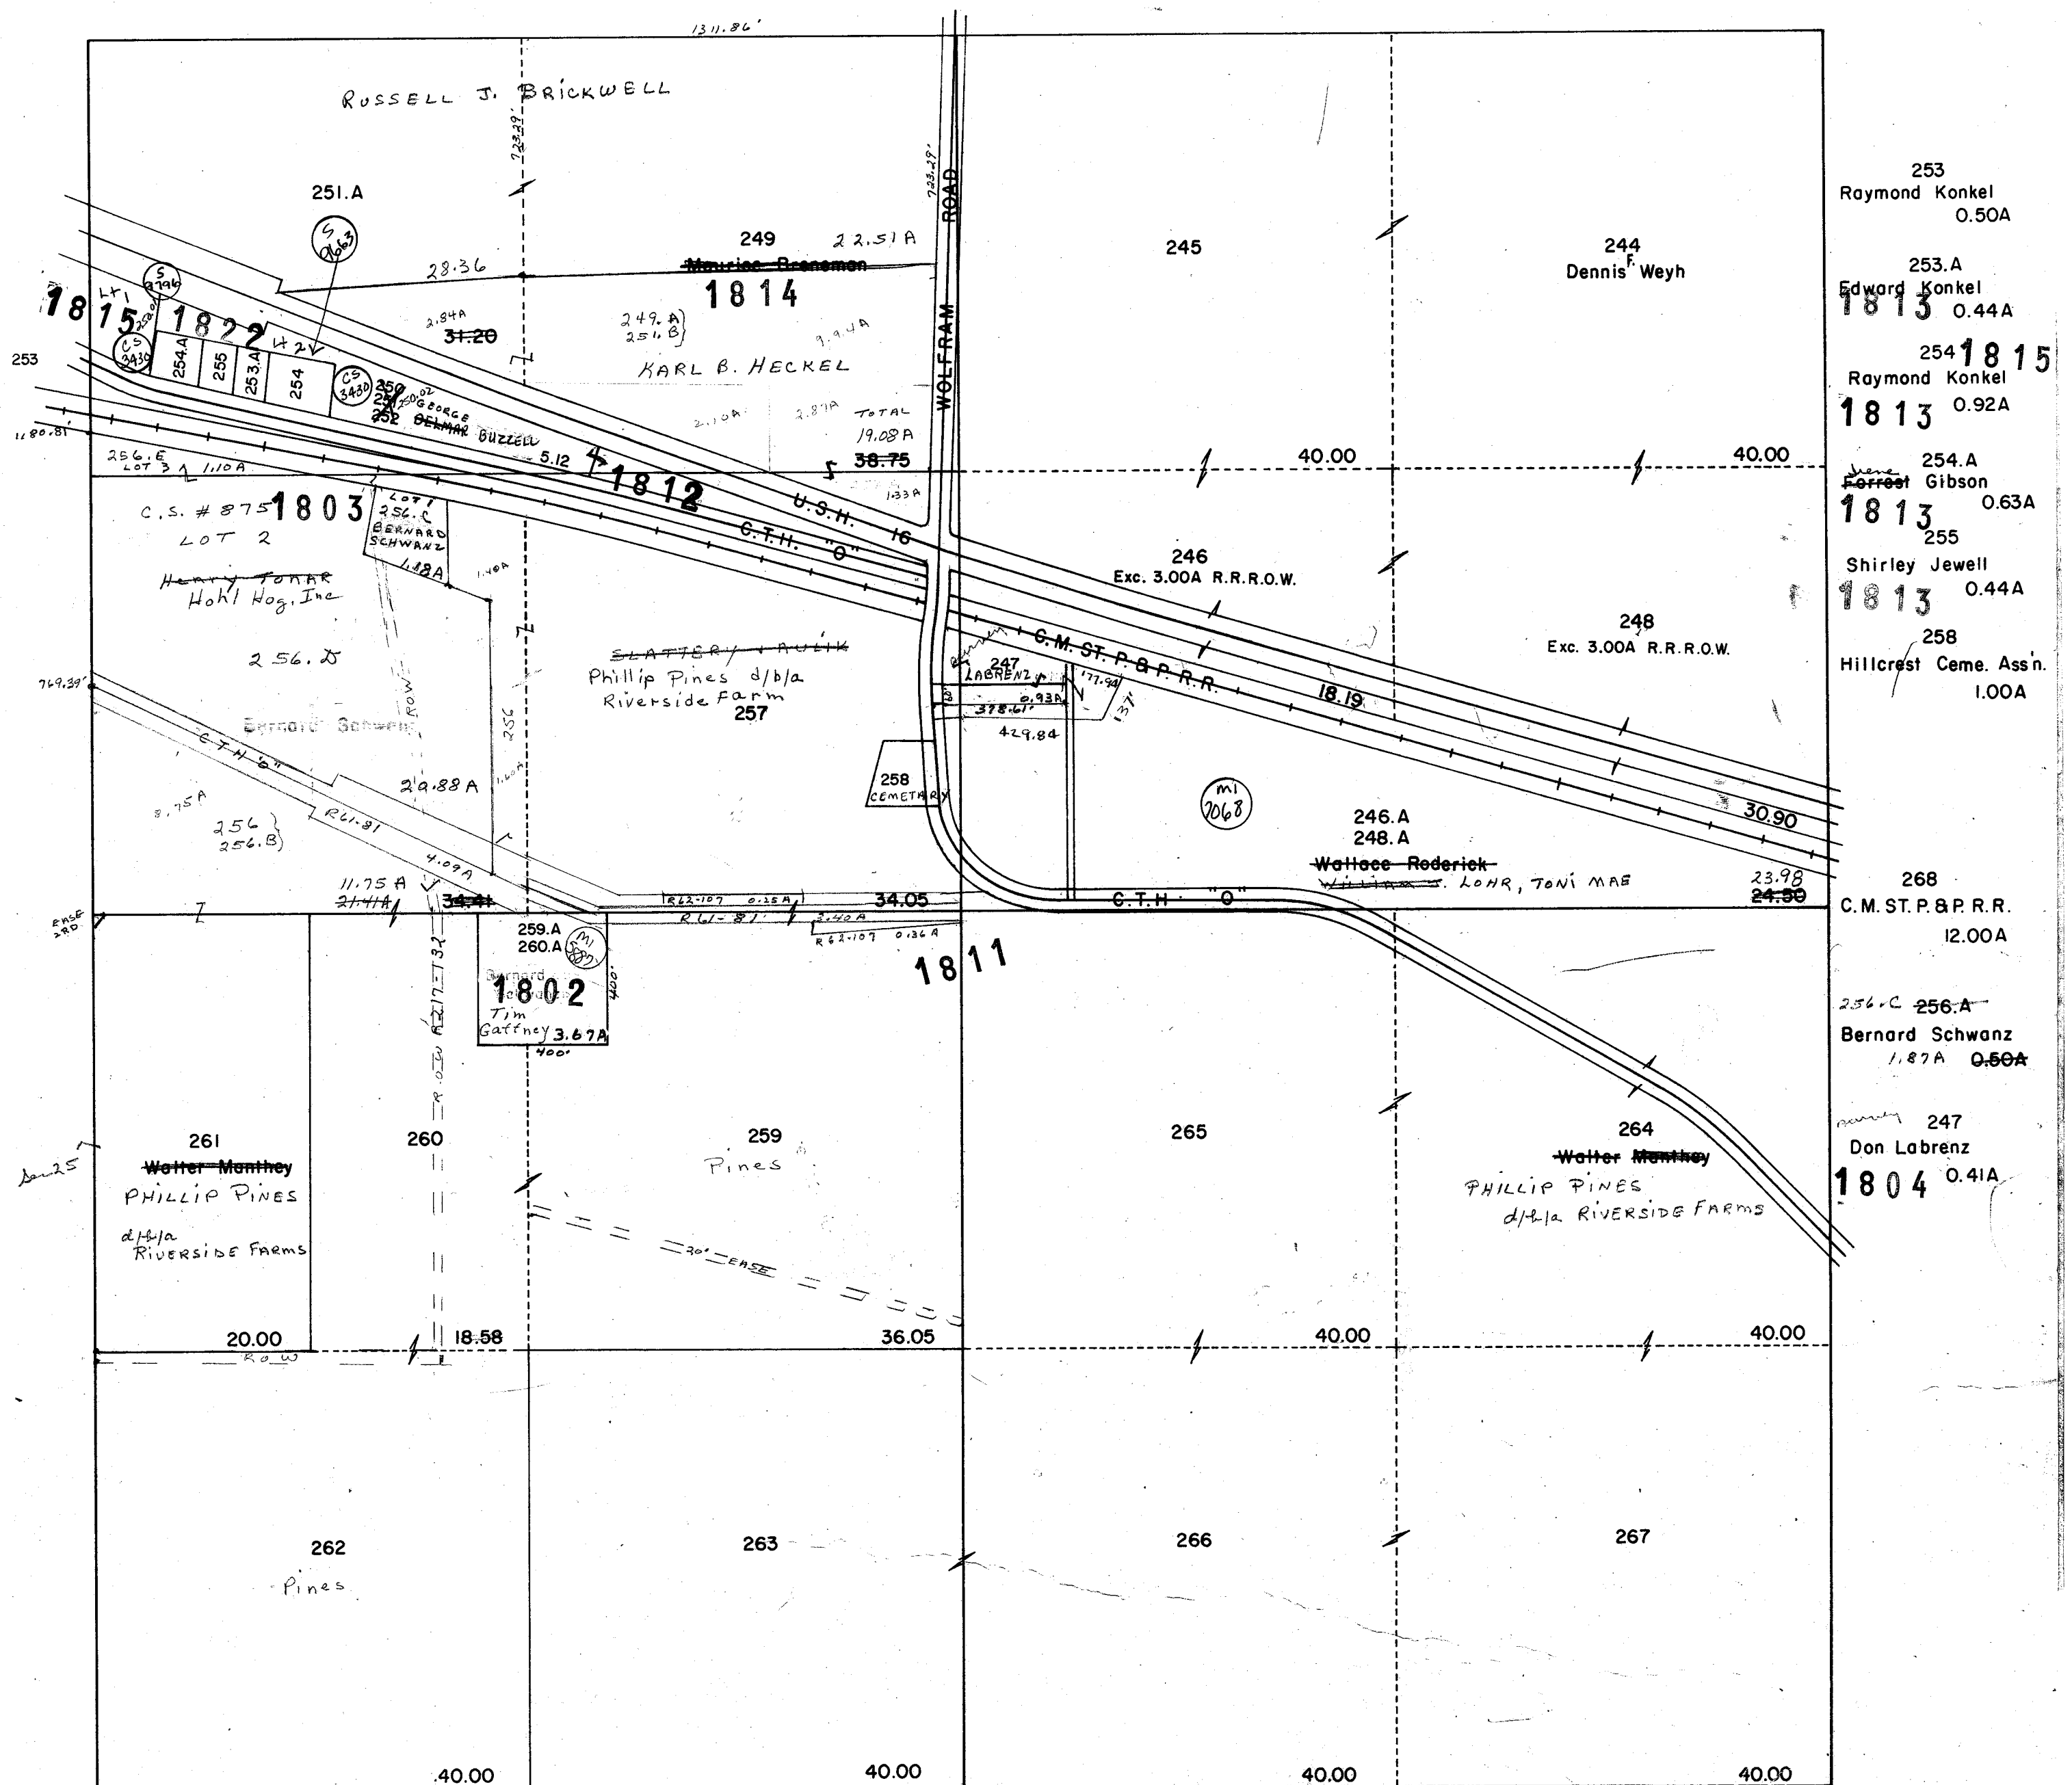


Jew N

LEWISTON

SECTION 26 T.13 R.7

Replaced
2002

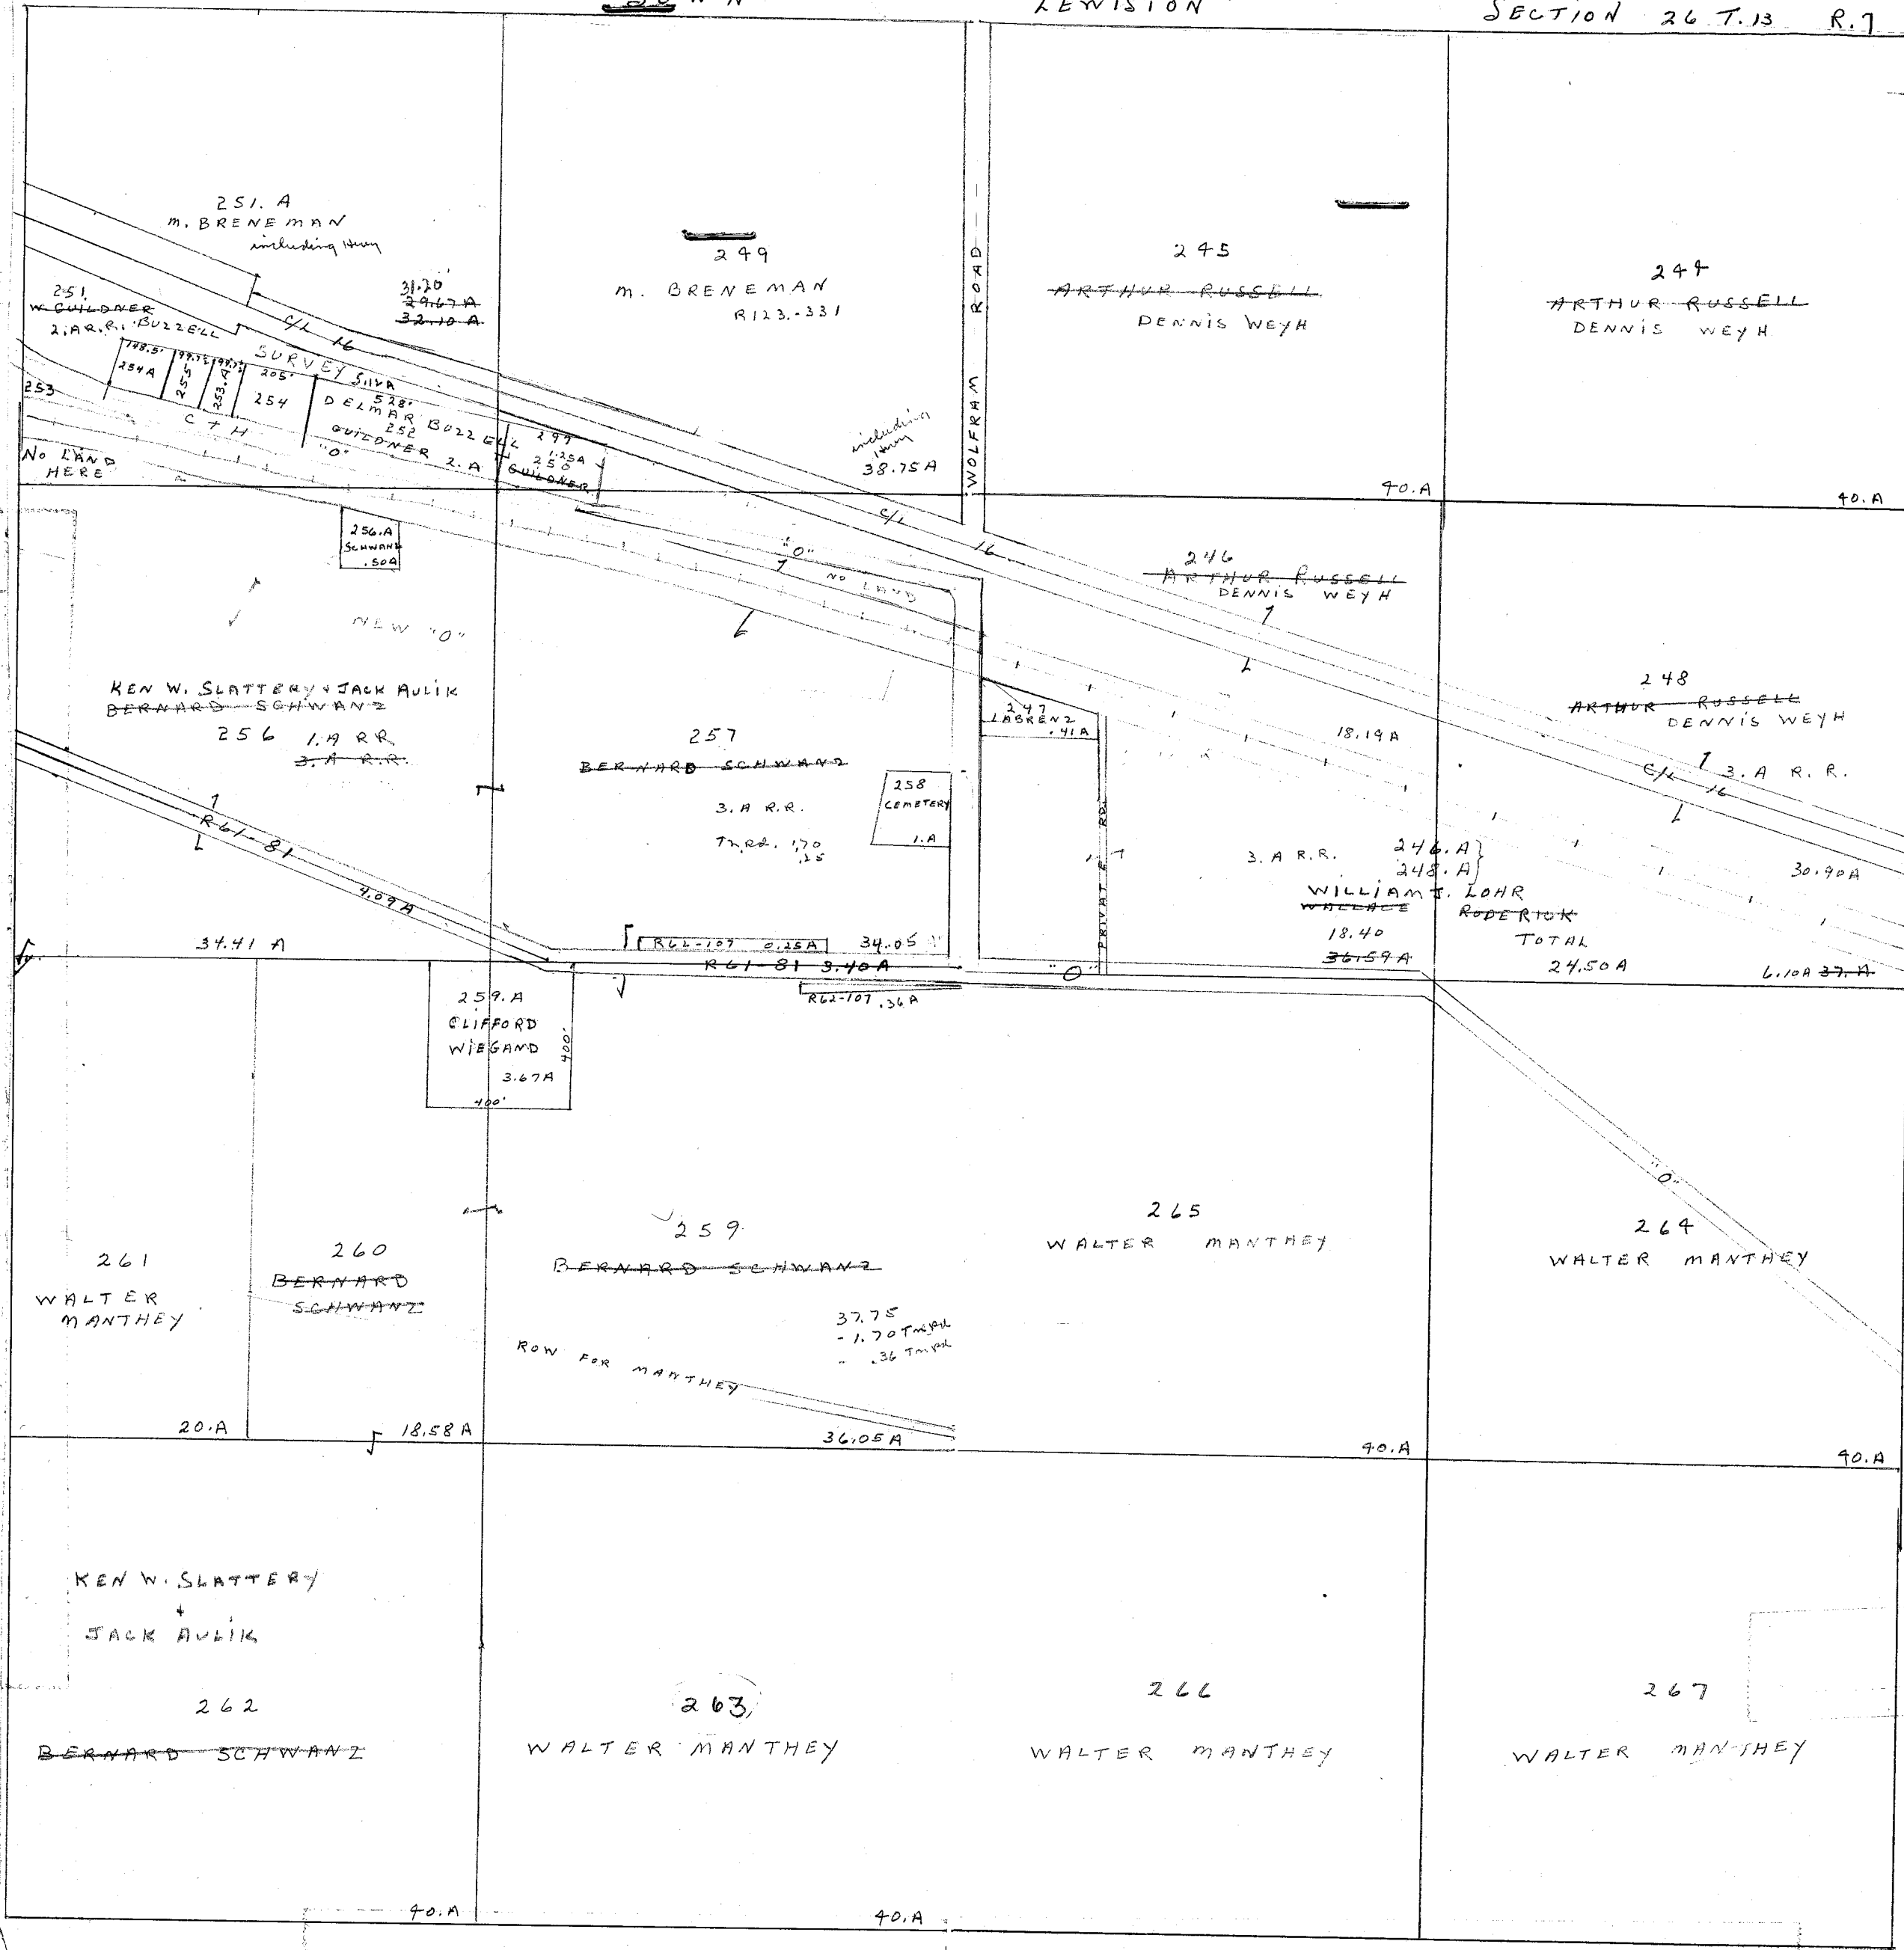


250 W. GULLIVER	1.25A
251 W. GULLIVER	3.40A
252 W. GULLIVER	2.00A
253 R. A. KONKEL	0.50A
253A ED. KONKEL	0.44A
254 R. A. KONKEL	0.92A
254A F. GIBSON	0.63A
255 S. JEWELL	0.44A
256A B. SCHWANZ	0.50A


HWY 7.74A T. 13 N. R. 7 E.

268 - C.M. ST. P. R. R.
1.1A

SEC. 27 T13N R7E

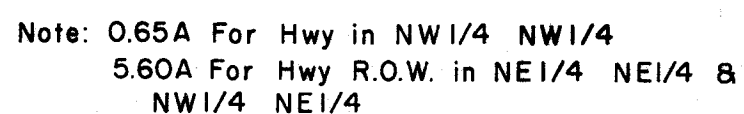

PROPERTY OF TAX LISTING DEPARTMENT

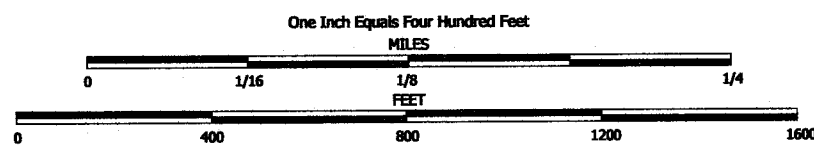

NOTE: This map was prepared for assessment use in accordance with the Wis. St. Stat. Chap. 70.09. All information contained herein is advisory only. Map accuracy is limited to the quality of data obtained from other Public Records. This map is not intended to be a substitute for an actual field survey. Public Land Survey Base is derived from U.S.G.S. Topographic maps unless otherwise noted. Other sources of the Land Base may be actual survey data. Base map data is from the April 1995 County Digital Orthophotos and/or U.S.G.S. 1:24,000 scale Topographic series. The user is responsible for the improper use of the data contained herein.


Created by The Columbia County Land Information Office -GIS Section. VMB.
September 2002.

TAX PARCEL MAP

TOWN of LEWISTON

TOWN 13 NORTH RANGE 7 EAST
COLUMBIA COUNTY, WISCONSIN

Replaced
2006

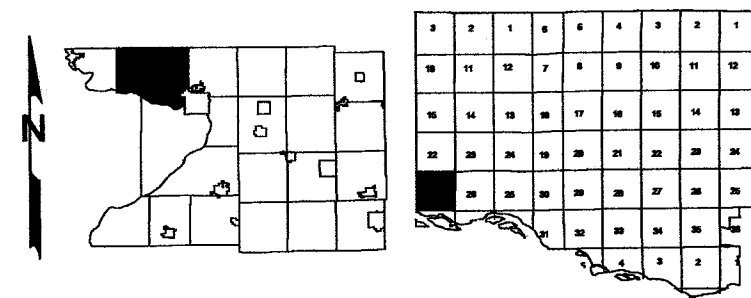


Replaced
2006

-SECTION 27-


LEWISTON
SEC. 34 T13N R7E

Replaced
2002

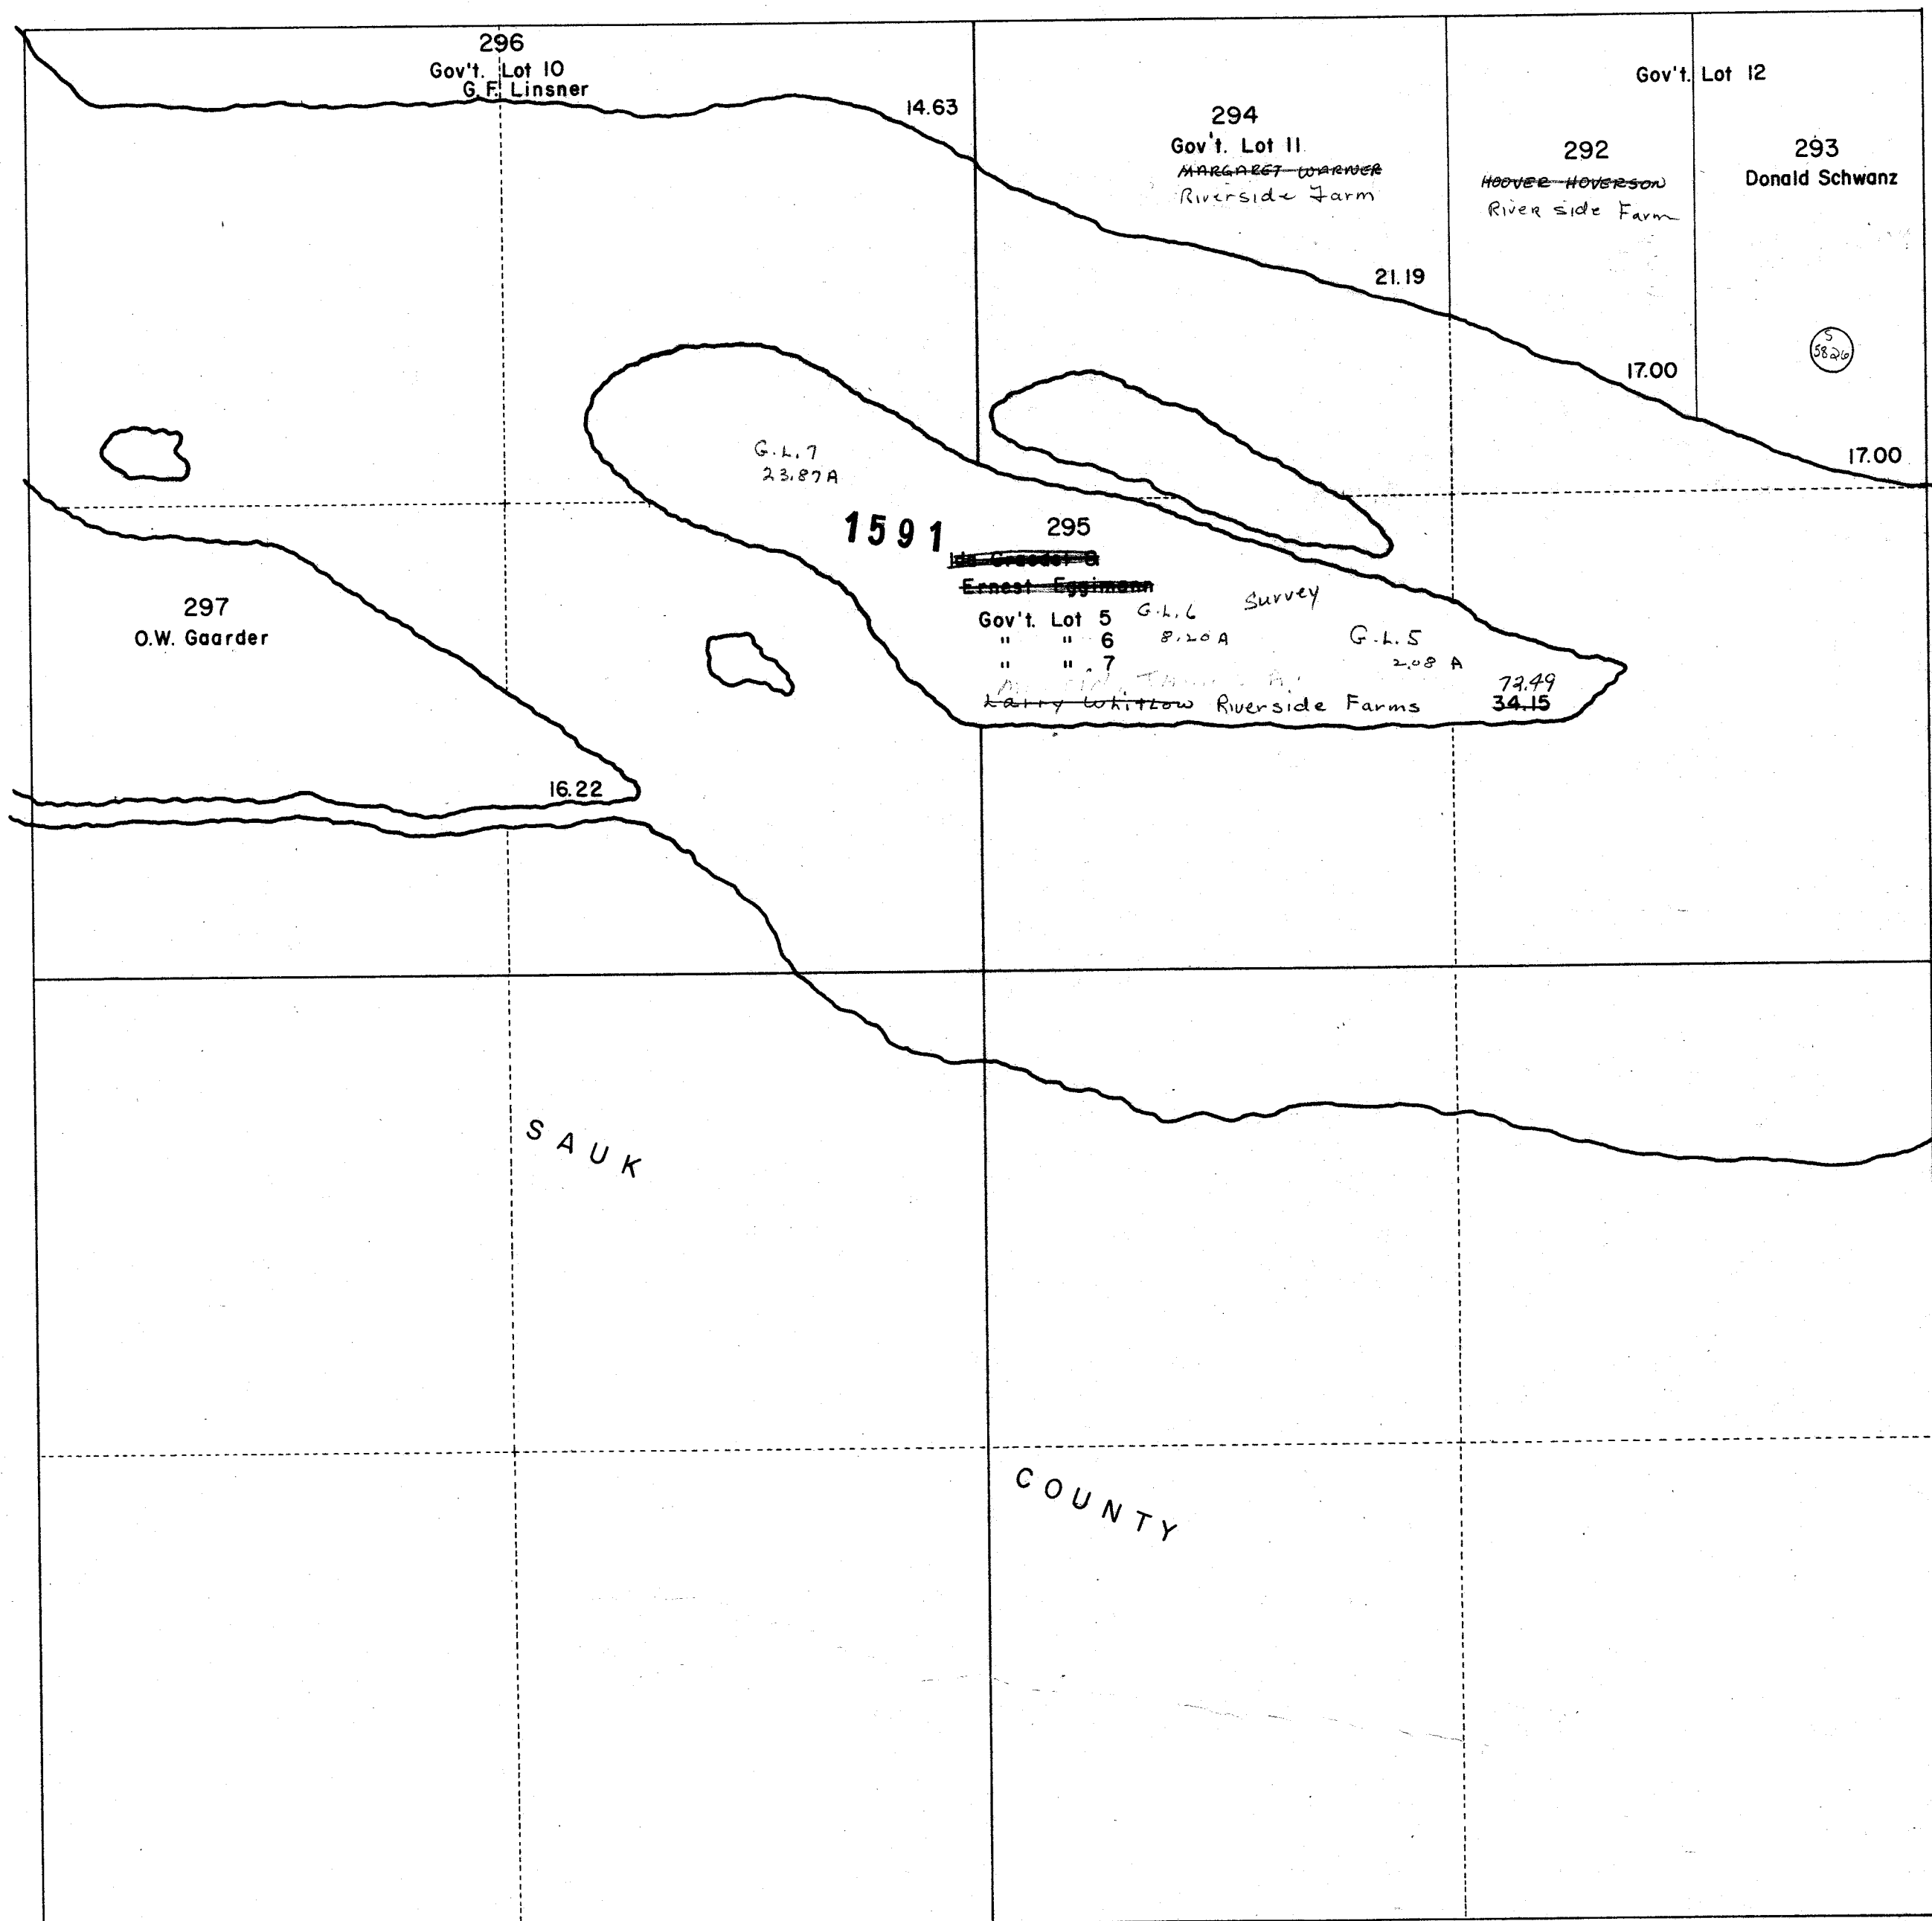

LEWISTON
SEC. 35 T13N R7E


Replaced
2002

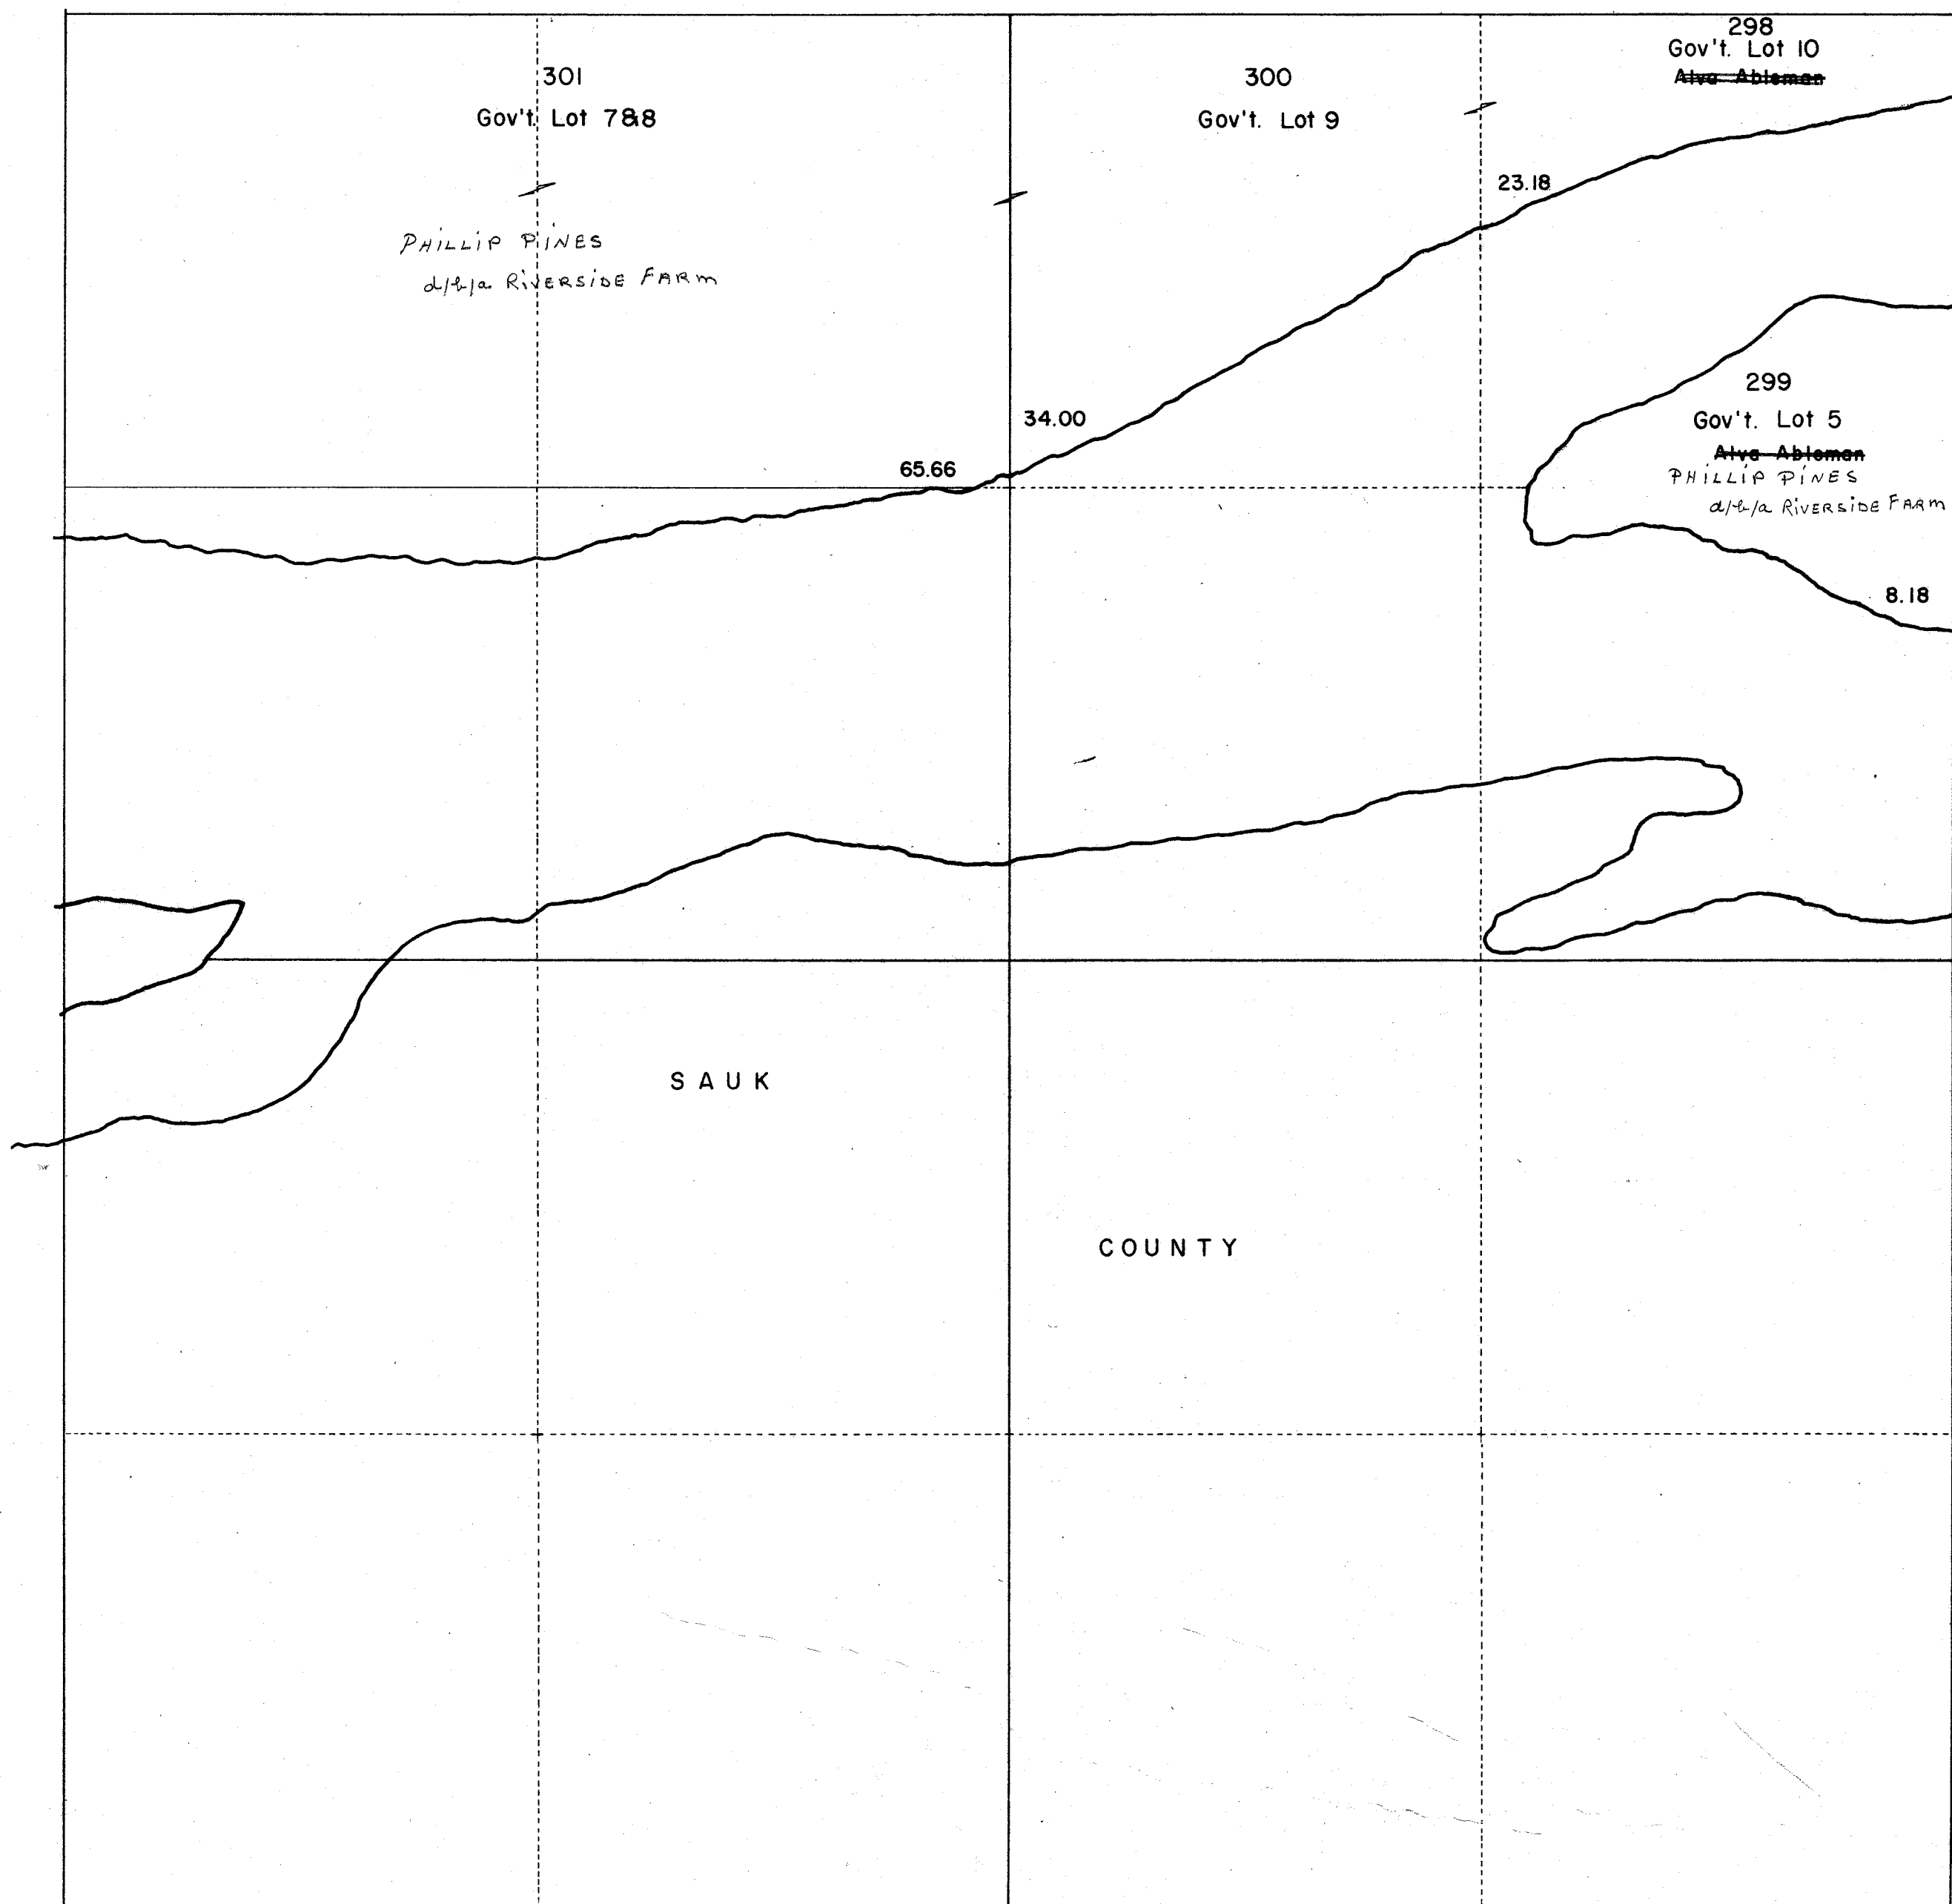

PROPERTY OF TAX LISTING DEPARTMENT


LEWISTON
SEC. 36 T13N R7E


Replaced
2002

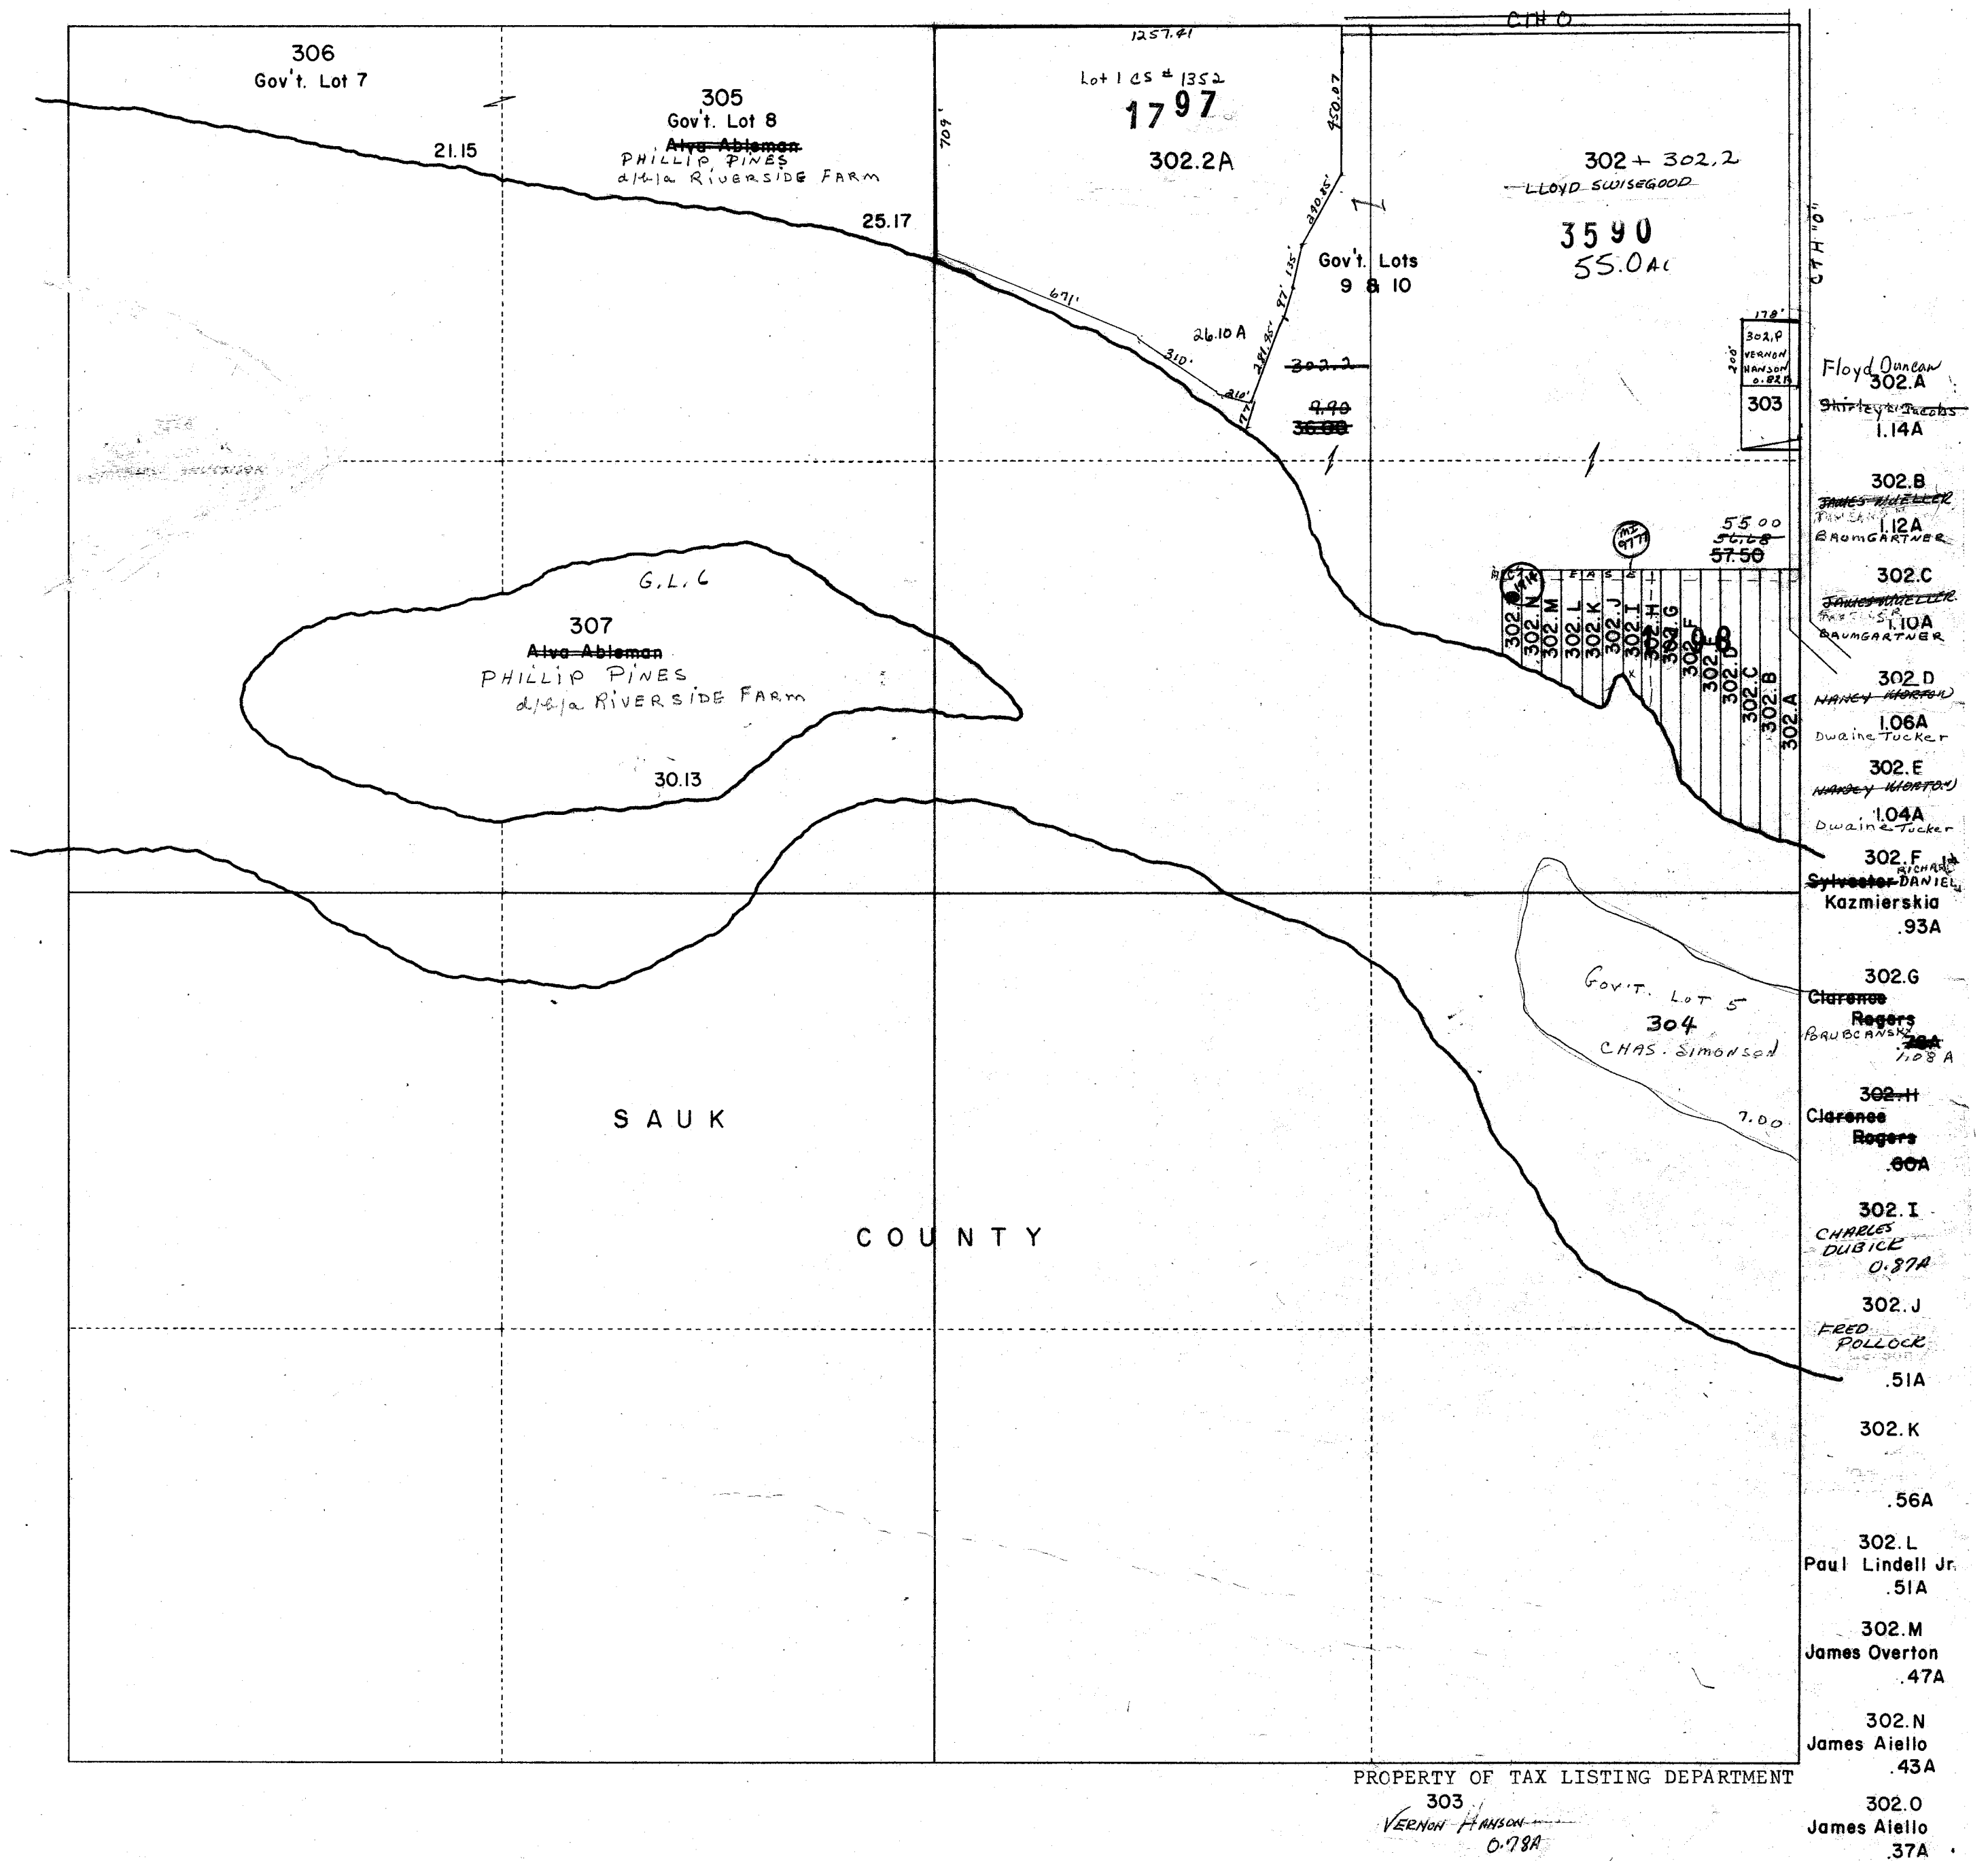

SEC. 1 T13N R8E

2002-acreage map
w/2 sec 1

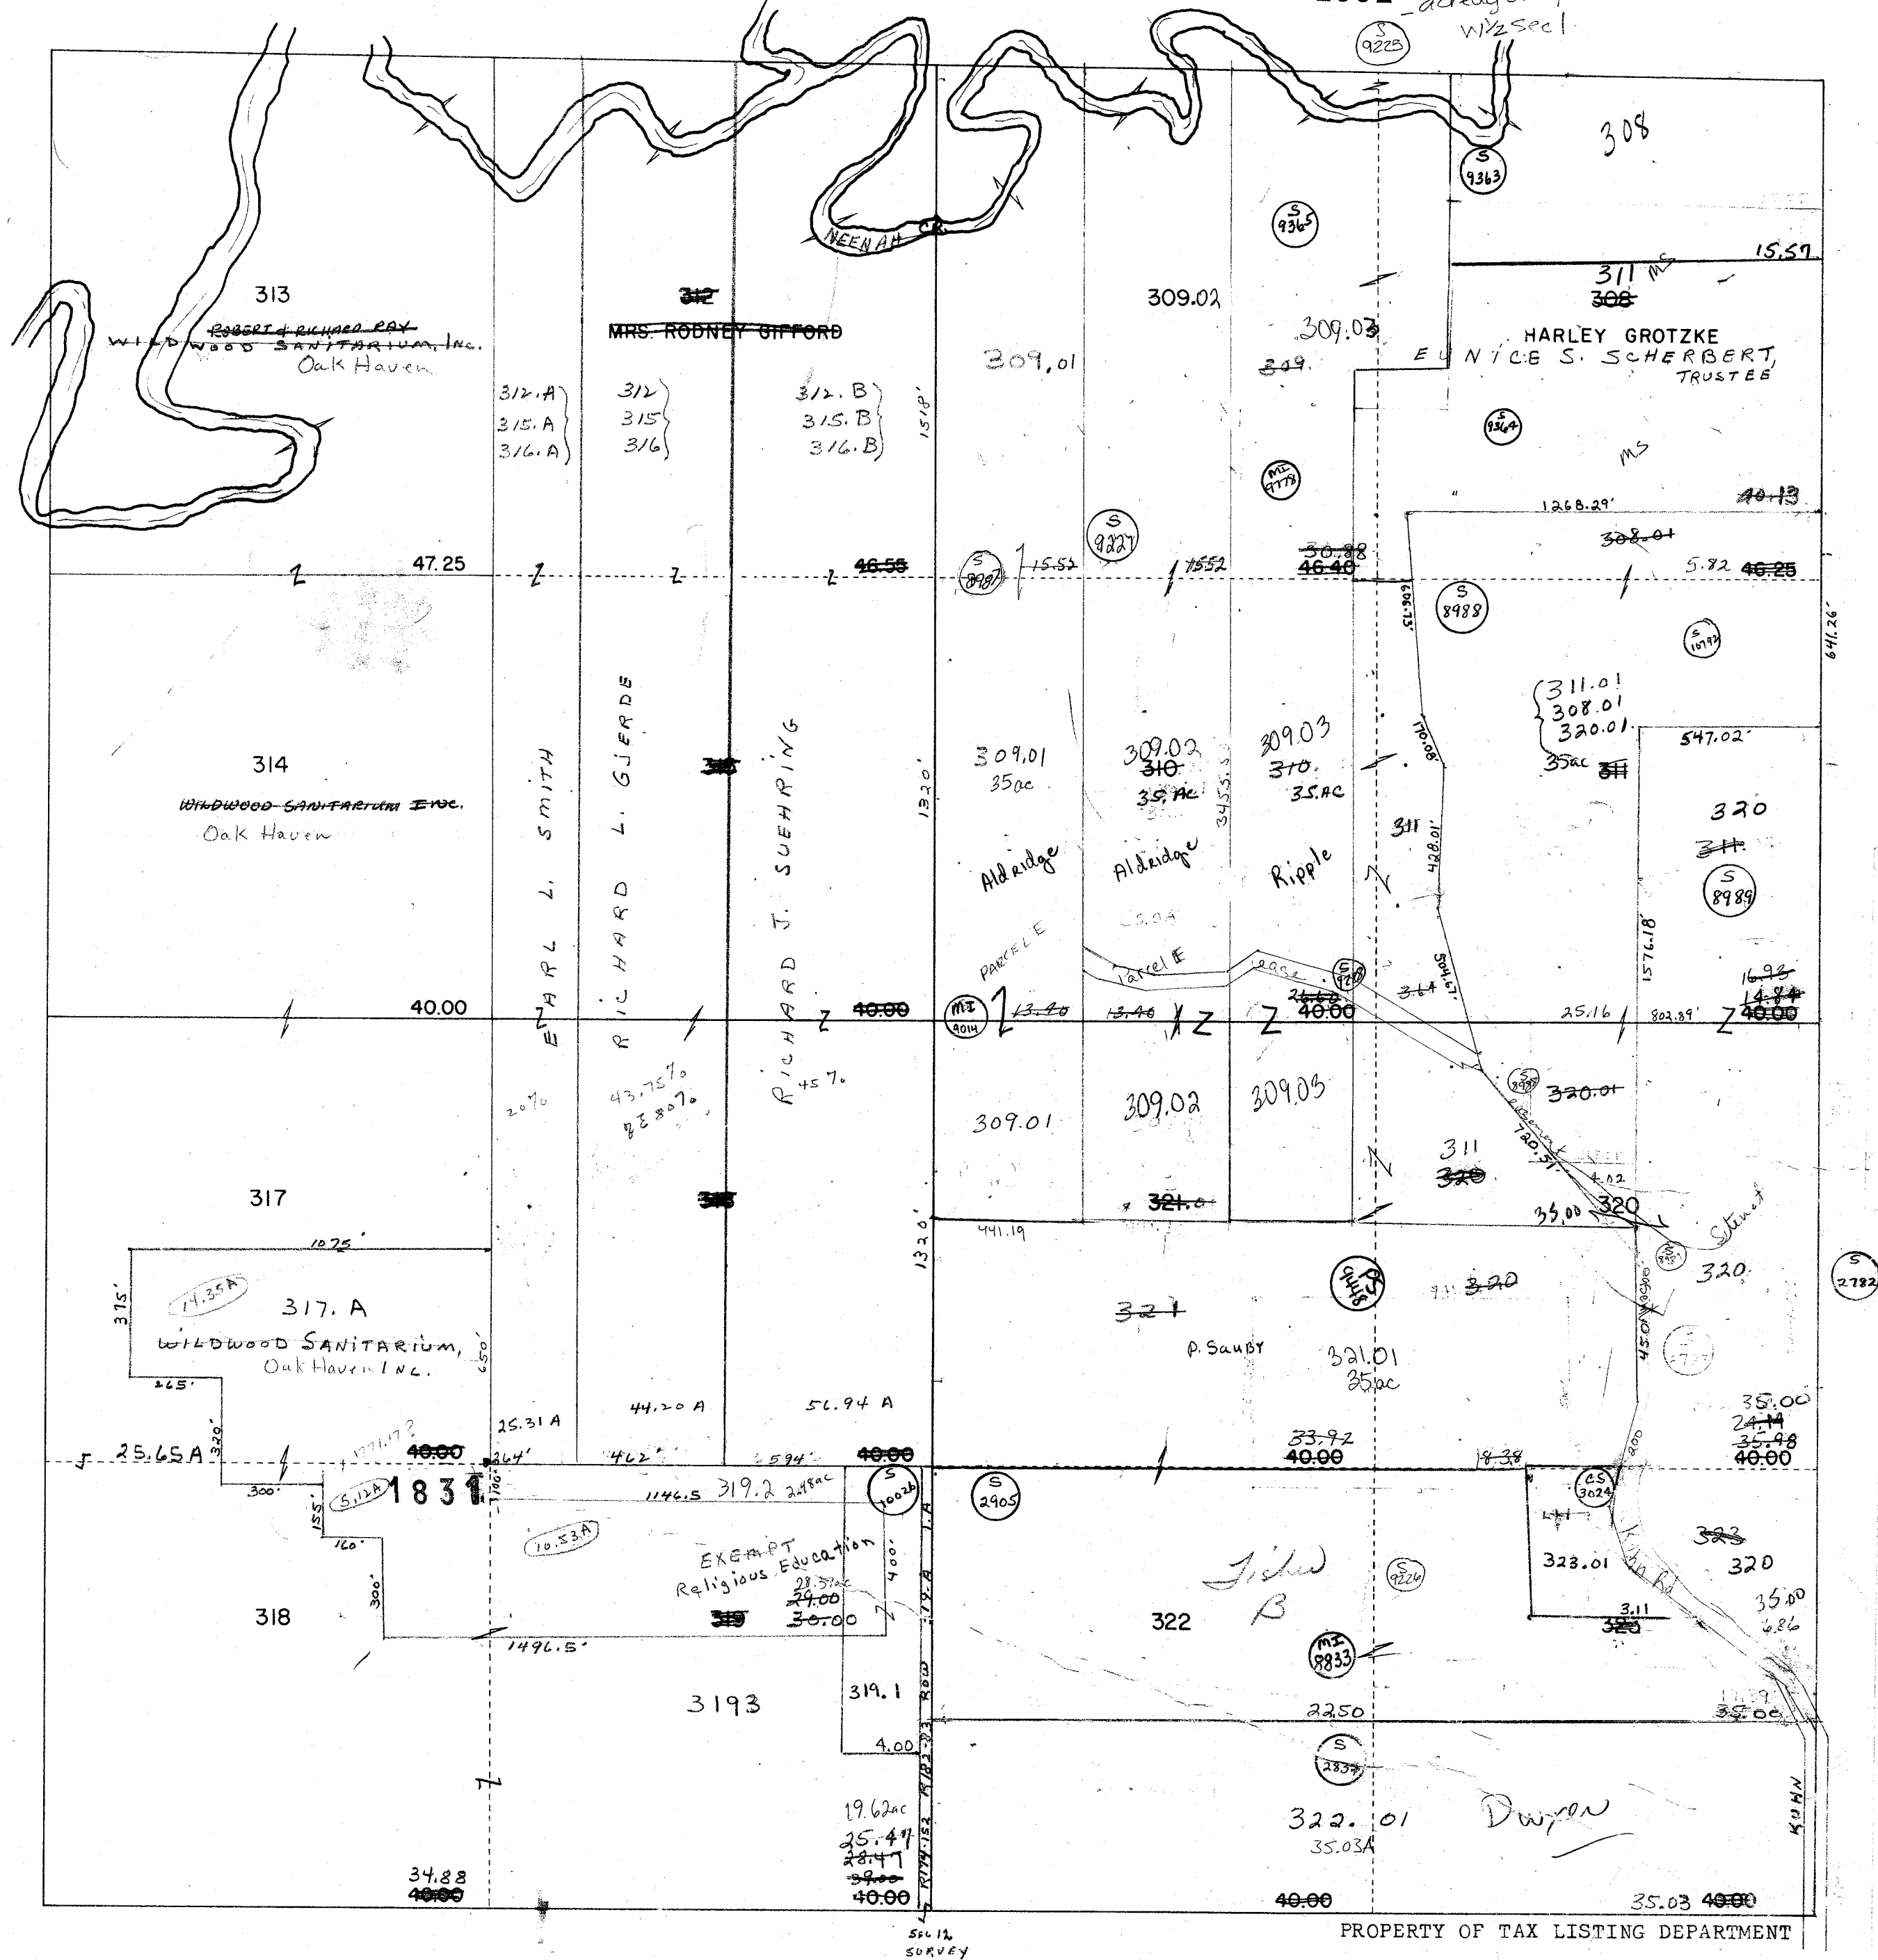


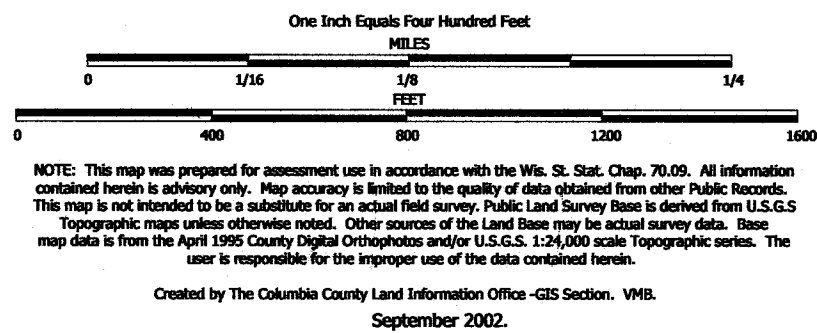


TAX PARCEL MAP

TOWN of LEWISTON

TOWN 13 NORTH RANGE 8 EAST
COLUMBIA COUNTY, WISCONSIN

Replaced
2003

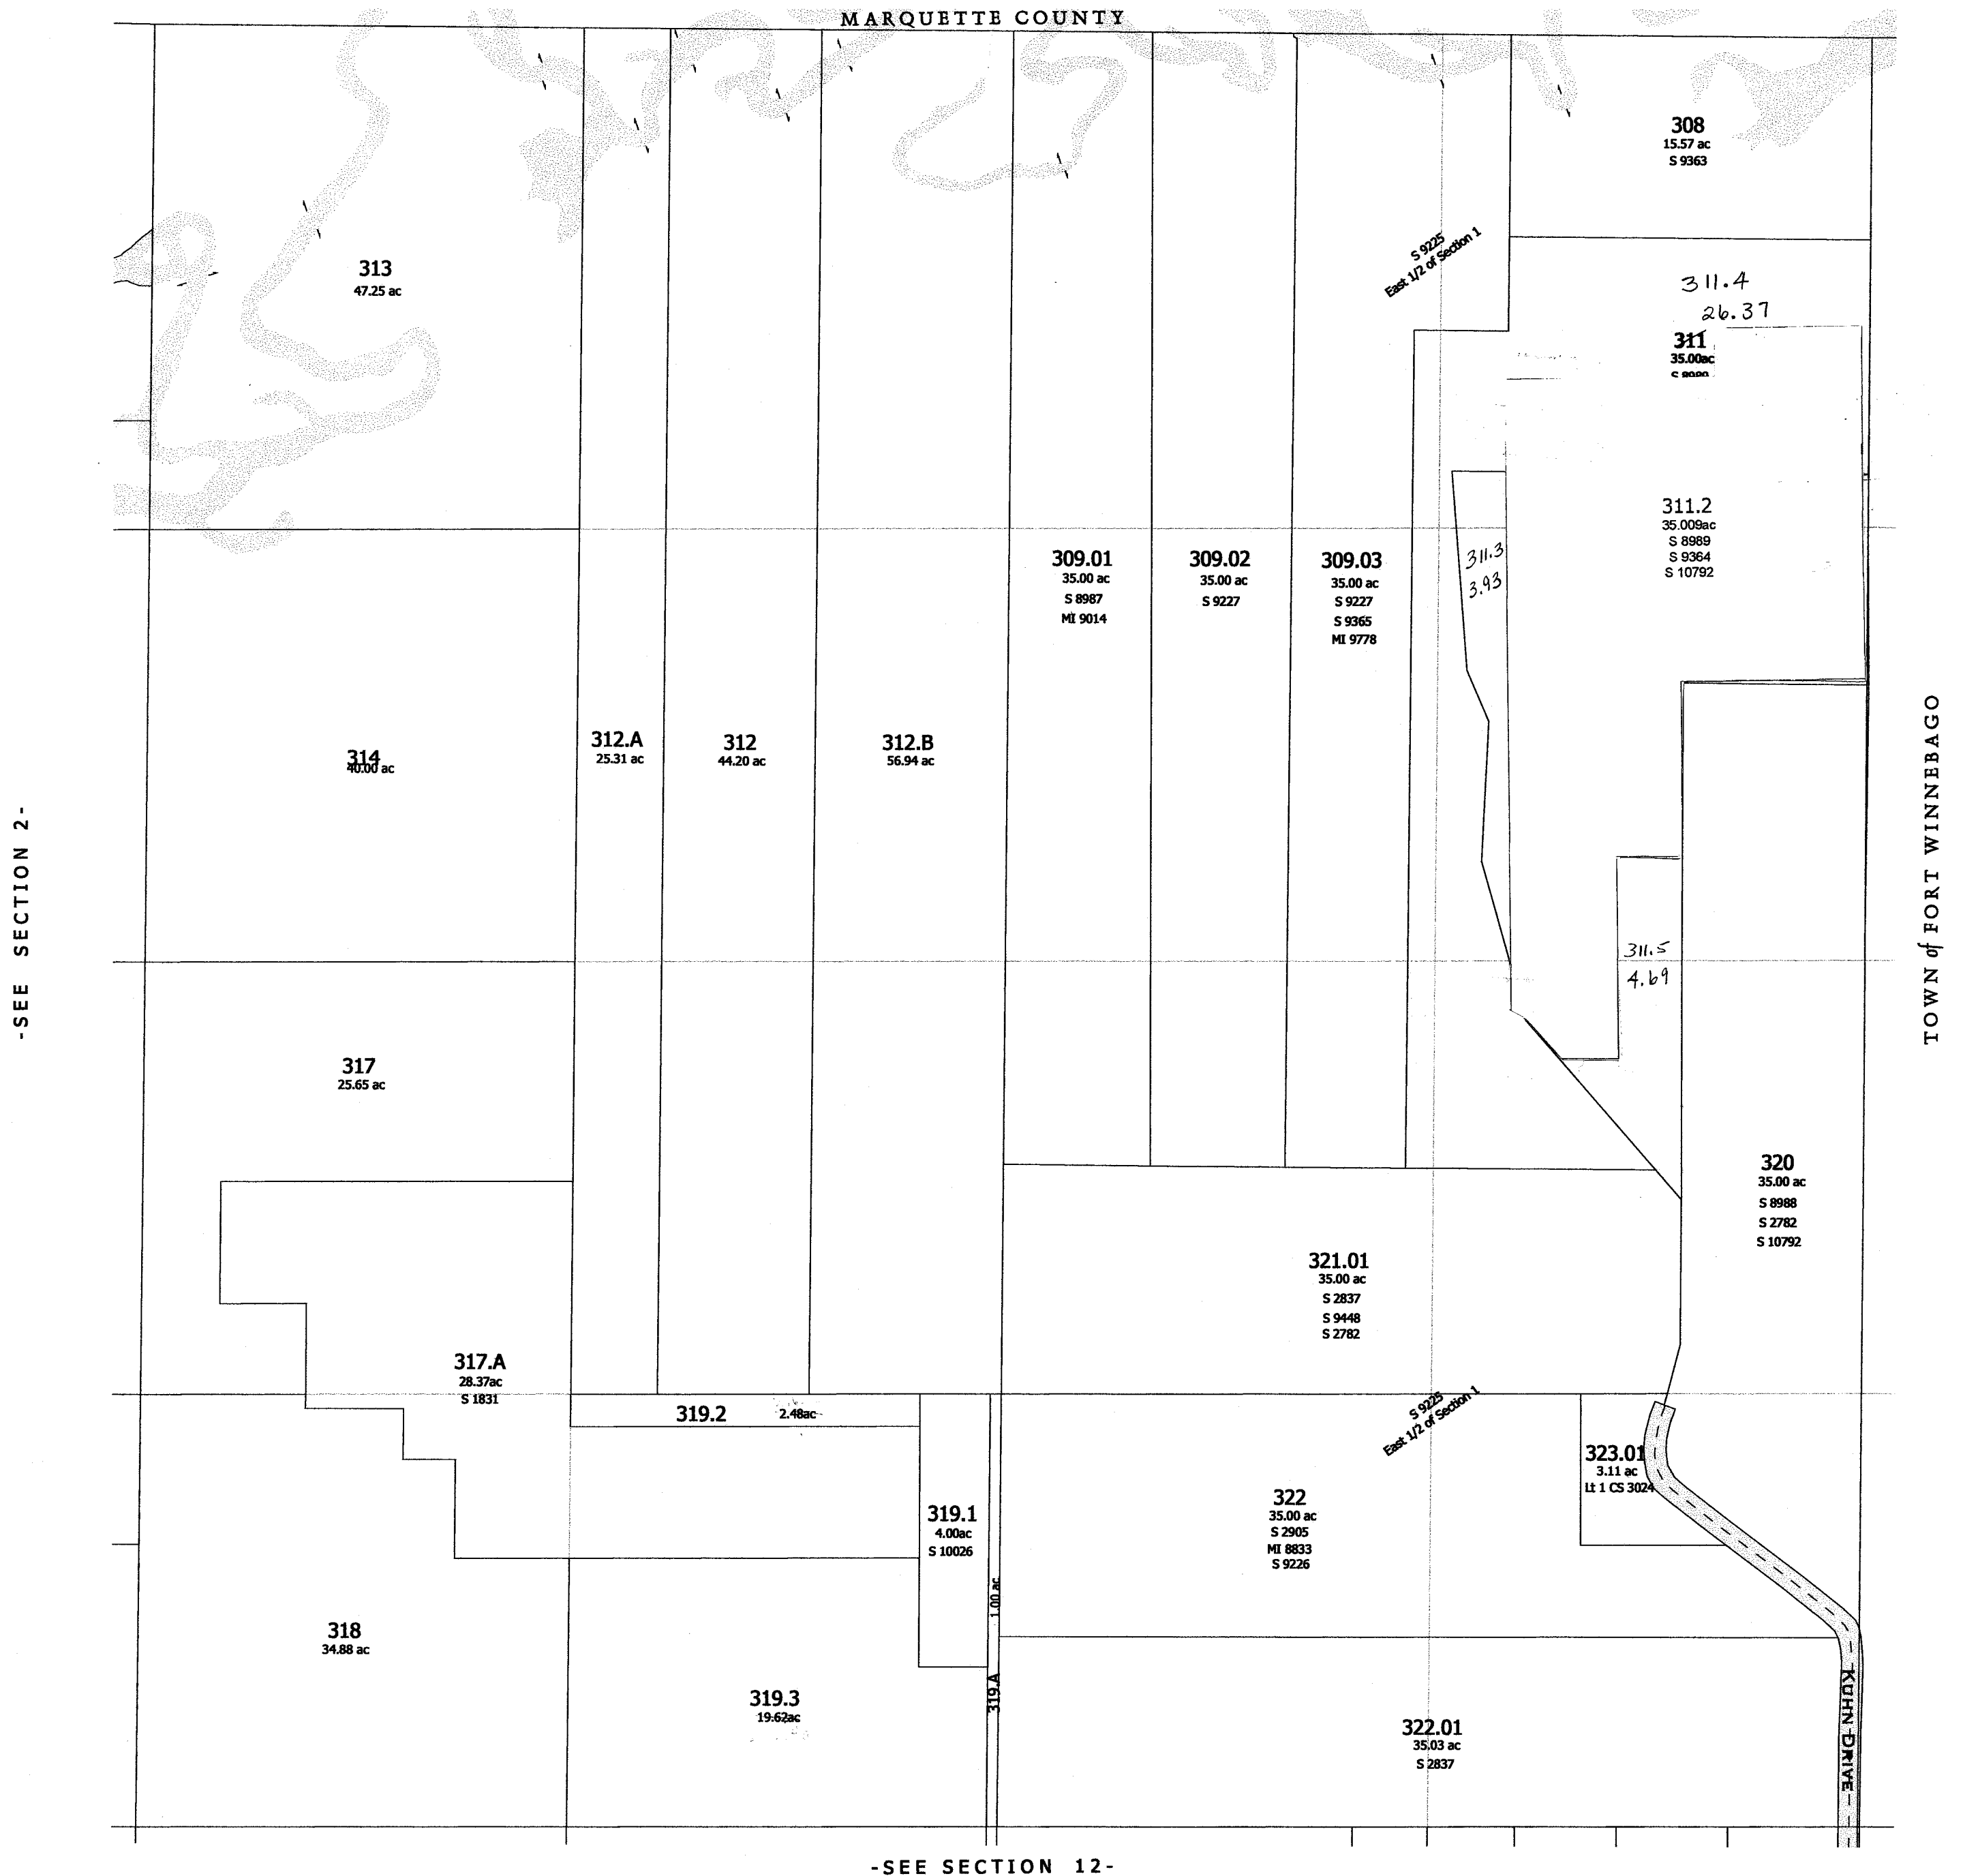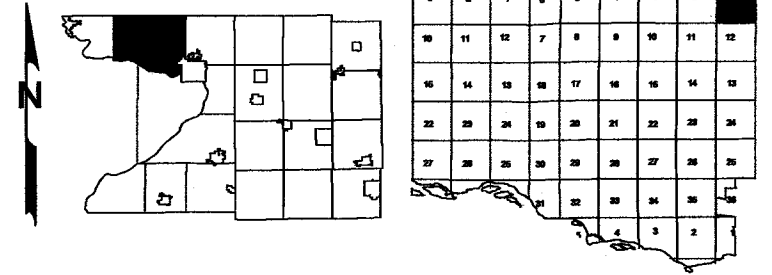

One Inch Equals Four Hundred Feet
MILES
0 1/16 1/8 1/4
FEET
0 400 800 1200 1600

NOTE: This map was prepared for assessment use in accordance with the Wis. St. Stat. Chap. 70.09. All information contained herein is advisory only. Map accuracy is limited to the quality of data obtained from other Public Records. This map is not intended to be a substitute for an actual field survey. Public Land Survey Base is derived from U.S.G.S Topographic maps unless otherwise noted. Other sources of the Land Base may be actual survey data. Base map data is from the April 1995 County Digital Orthophotos and/or U.S.G.S. 1:24,000 scale Topographic series. The user is responsible for the improper use of the data contained herein.


Created by The Columbia County Land Information Office -GIS Section. VMB.
February 2003.

TAX PARCEL MAP


TOWN of LEWISTON

TOWN 13 NORTH RANGE 8 EAST
COLUMBIA COUNTY, WISCONSIN

Replaced
2004

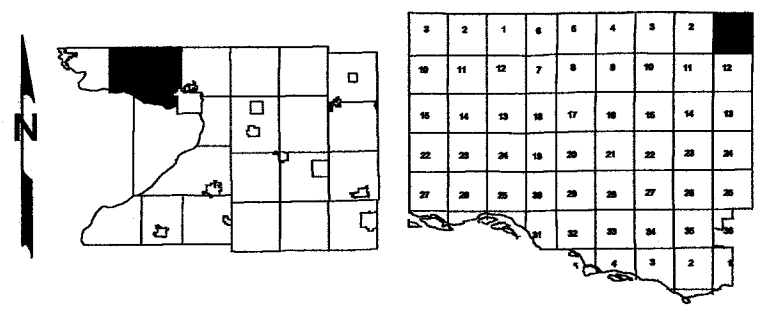

-SEE SECTION 2-

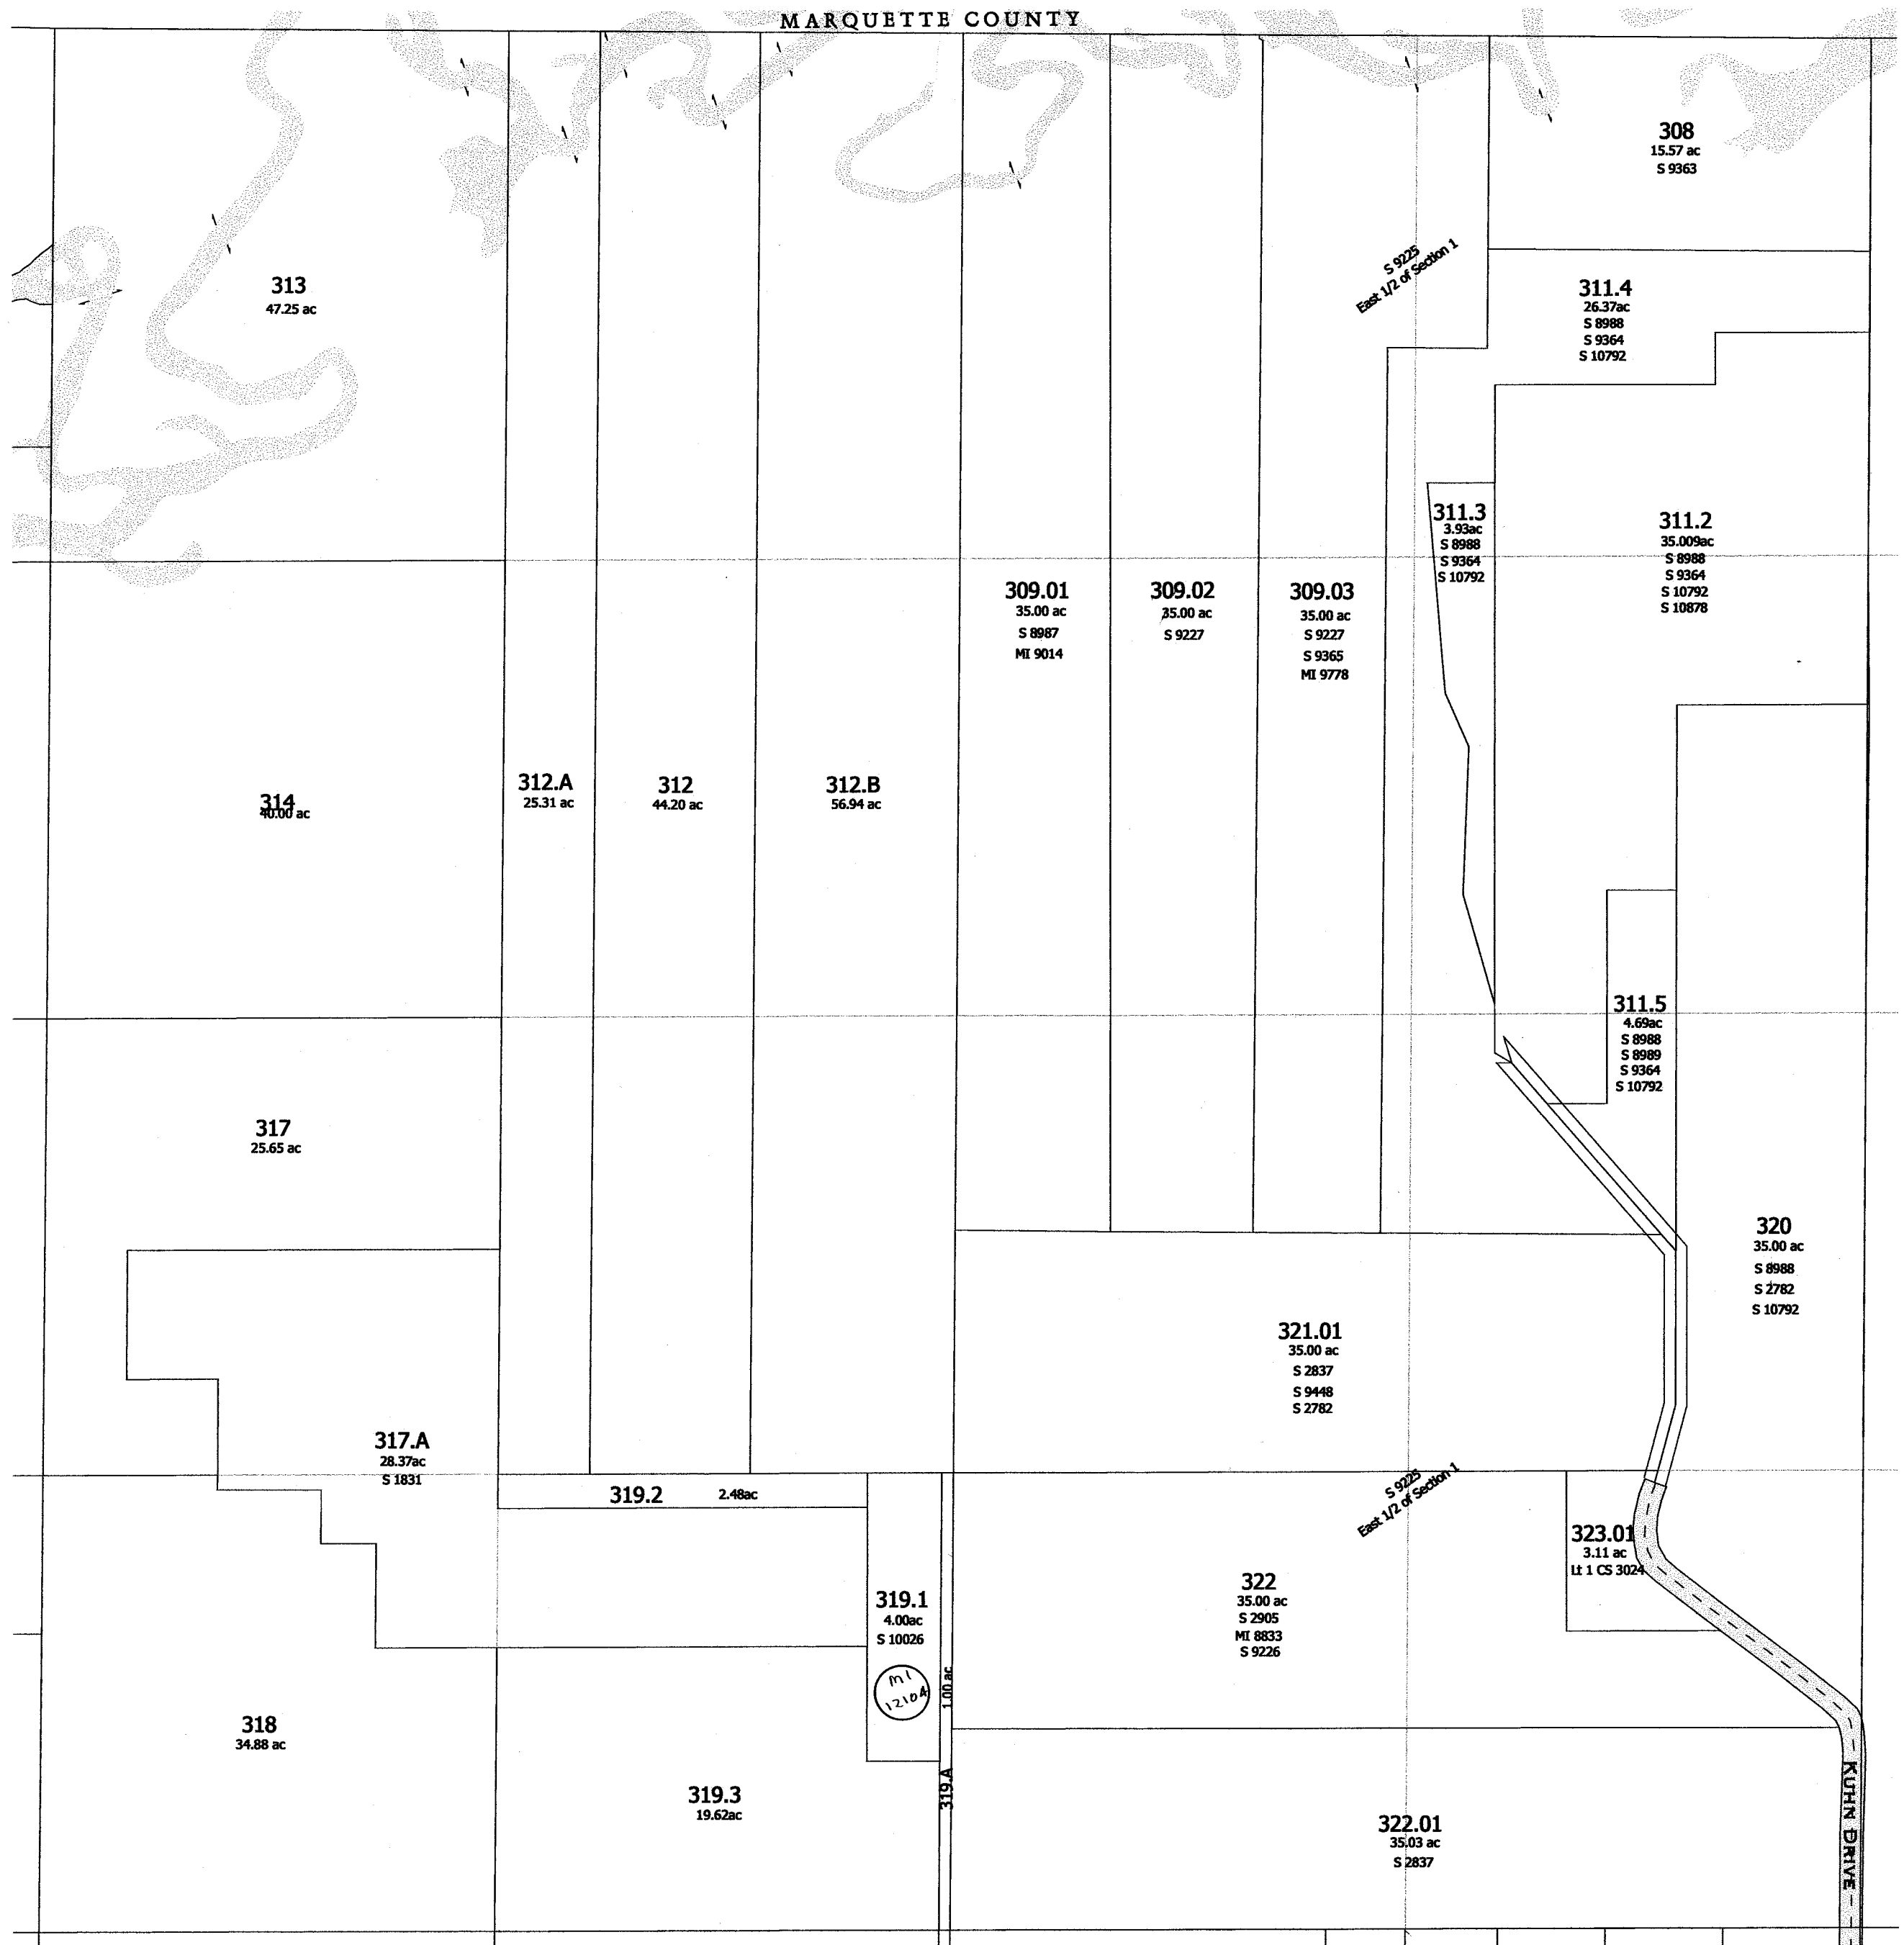

TOWN of FORT WINNEBAGO

-SEE SECTION 12-

replaced 2004
-SECTION 1-


Replaced
2002


Replaced
2002

46.94 A

6.947
1852

patent
re re
R263-633
46.94A

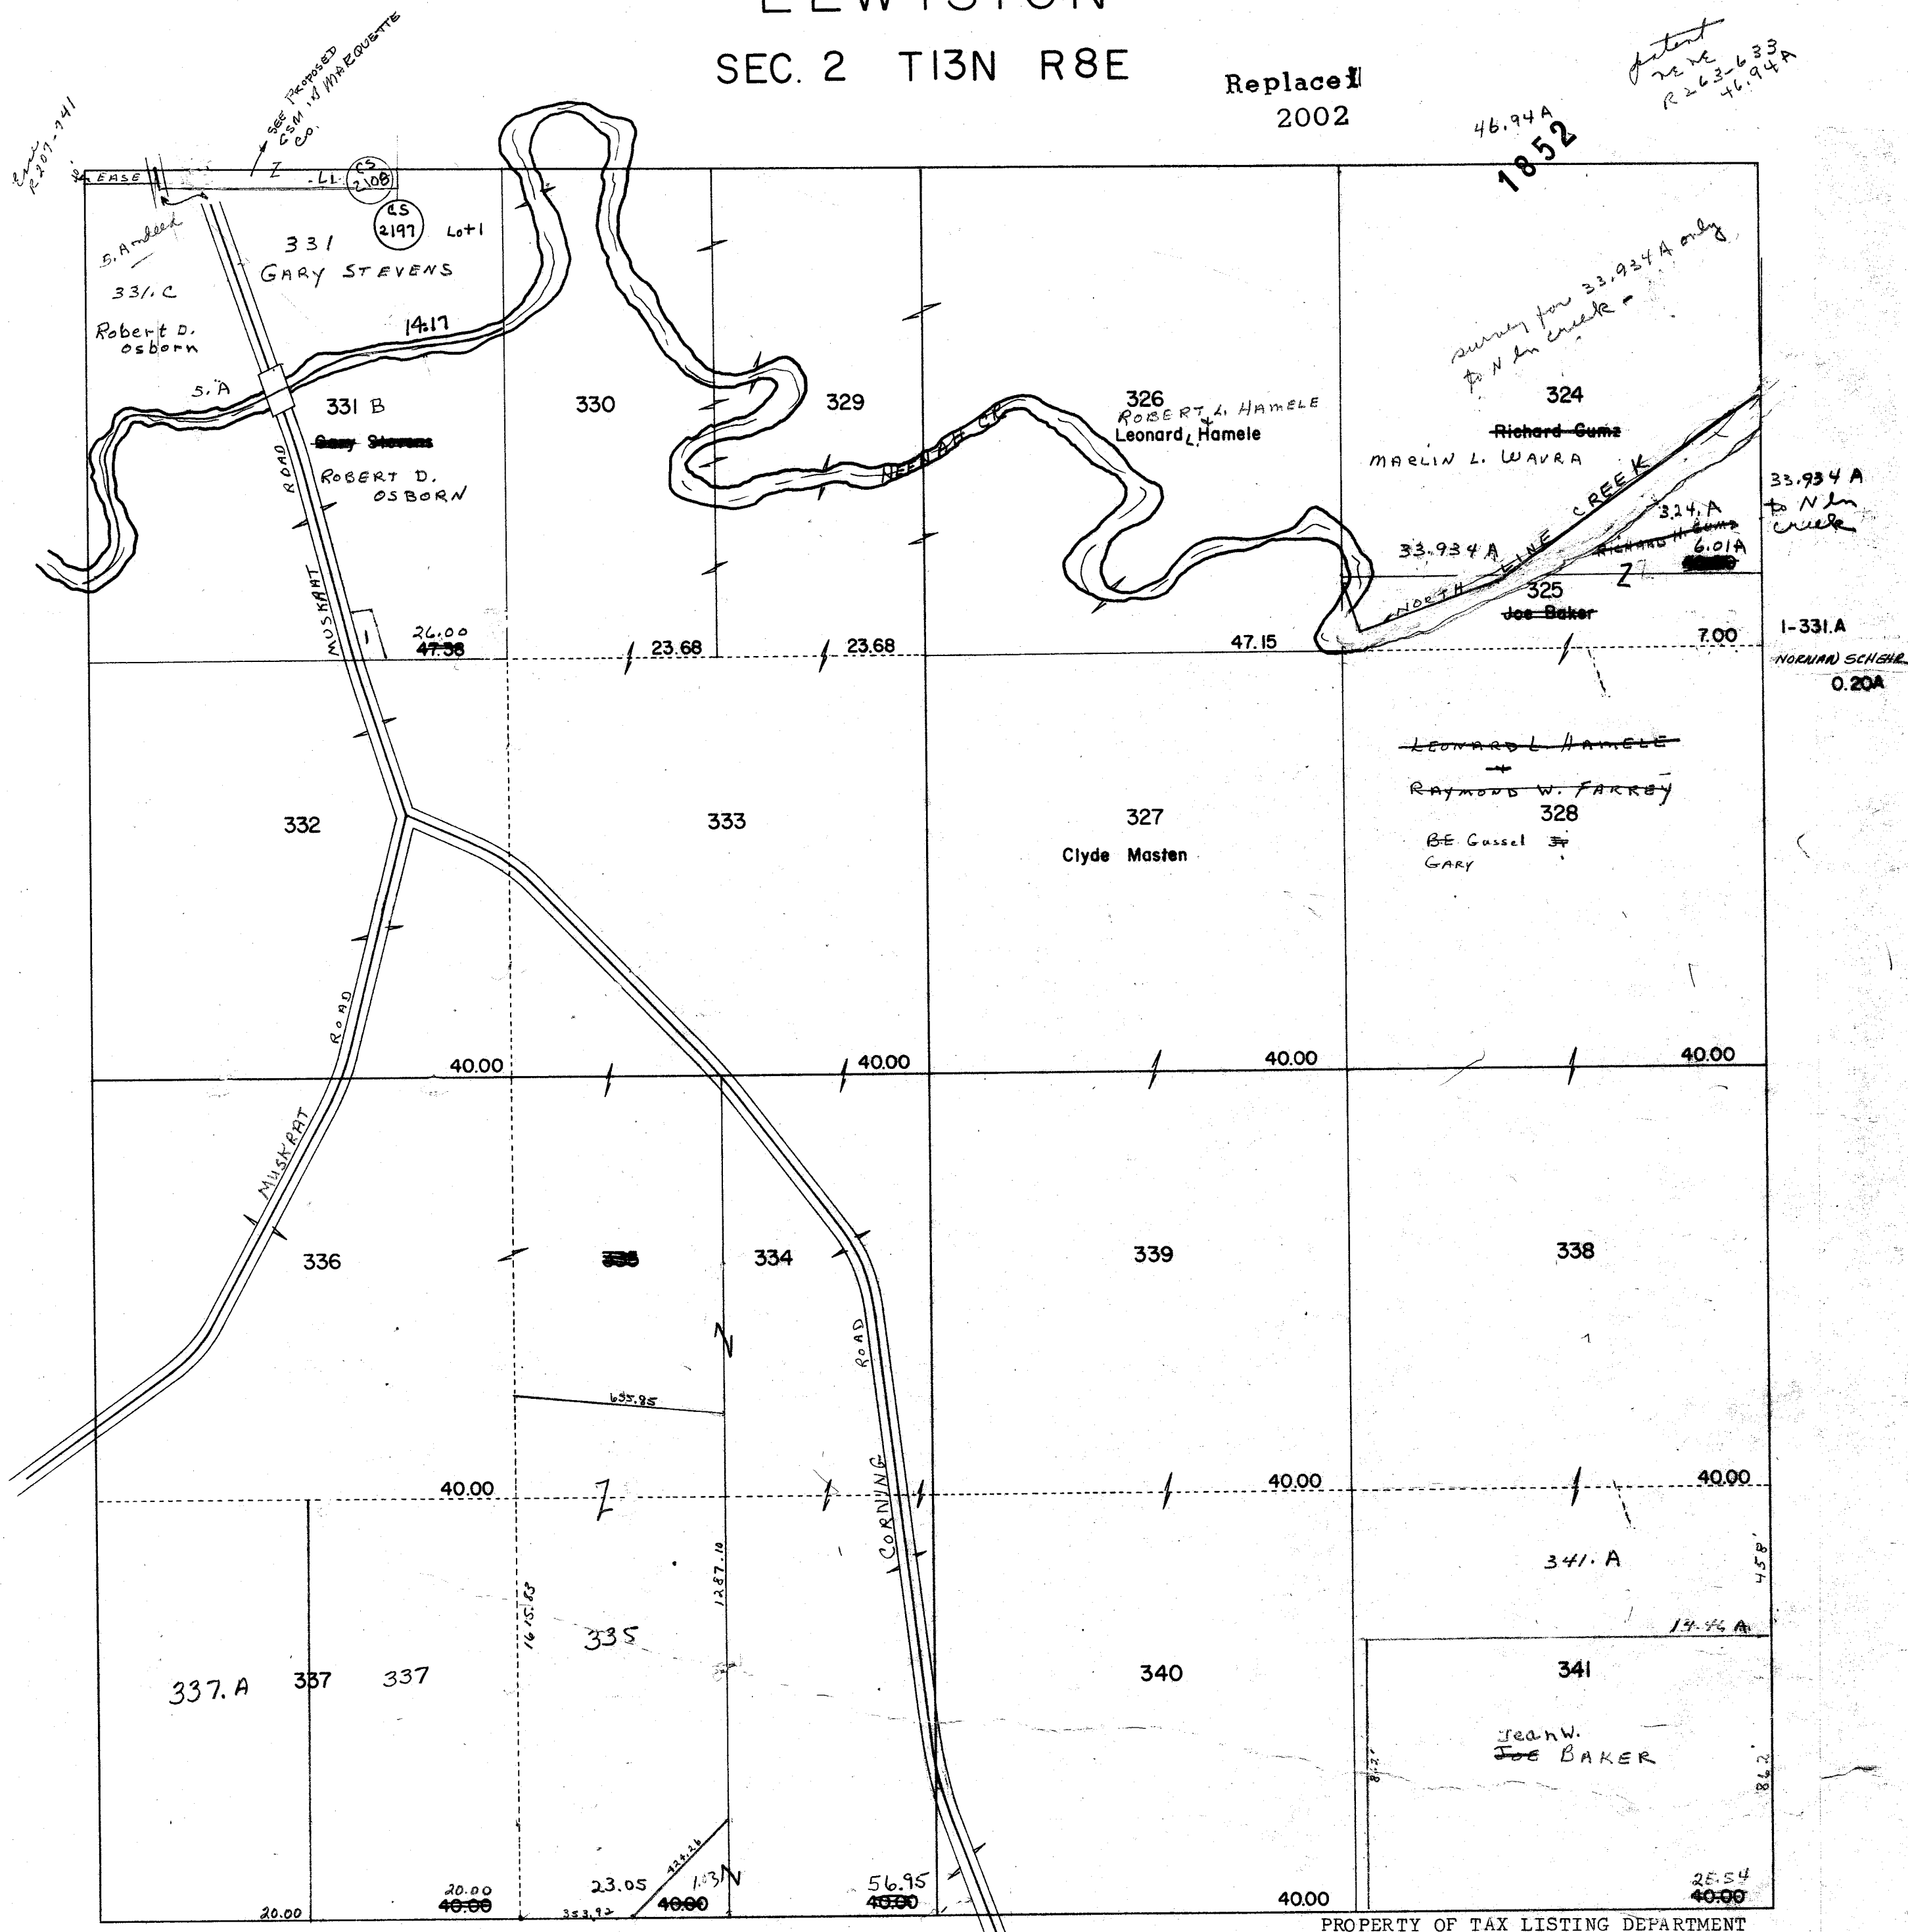

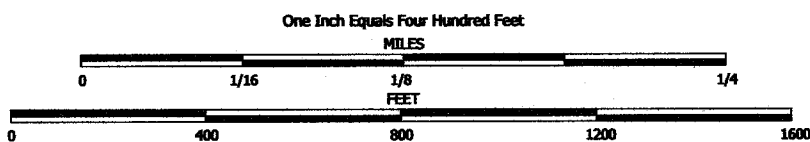


NOTE: This map was prepared for assessment use in accordance with the Wis. St. Stat. Chap. 70.09. All information contained herein is advisory only. Map accuracy is limited to the quality of data obtained from other Public Records. This map is not intended to be a substitute for an actual field survey. Public Land Survey Base is derived from U.S.G.S. Topographic maps unless otherwise noted. Other sources of the Land Base may be actual survey data. Base map data is from the April 1995 County Digital Orthophotos and/or U.S.G.S. 1:24,000 scale Topographic series. The user is responsible for the improper use of the data contained herein.

Created by The Columbia County Land Information Office -GIS Section. VMB.
September 2002.


TAX PARCEL MAP

TOWN of LEWISTON

TOWN 13 NORTH RANGE 8 EAST
COLUMBIA COUNTY, WISCONSIN

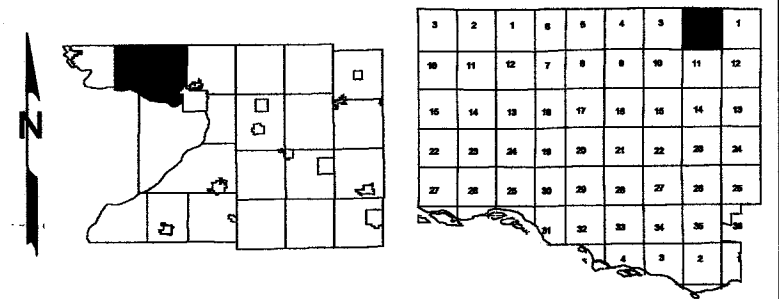


Replaced
2005

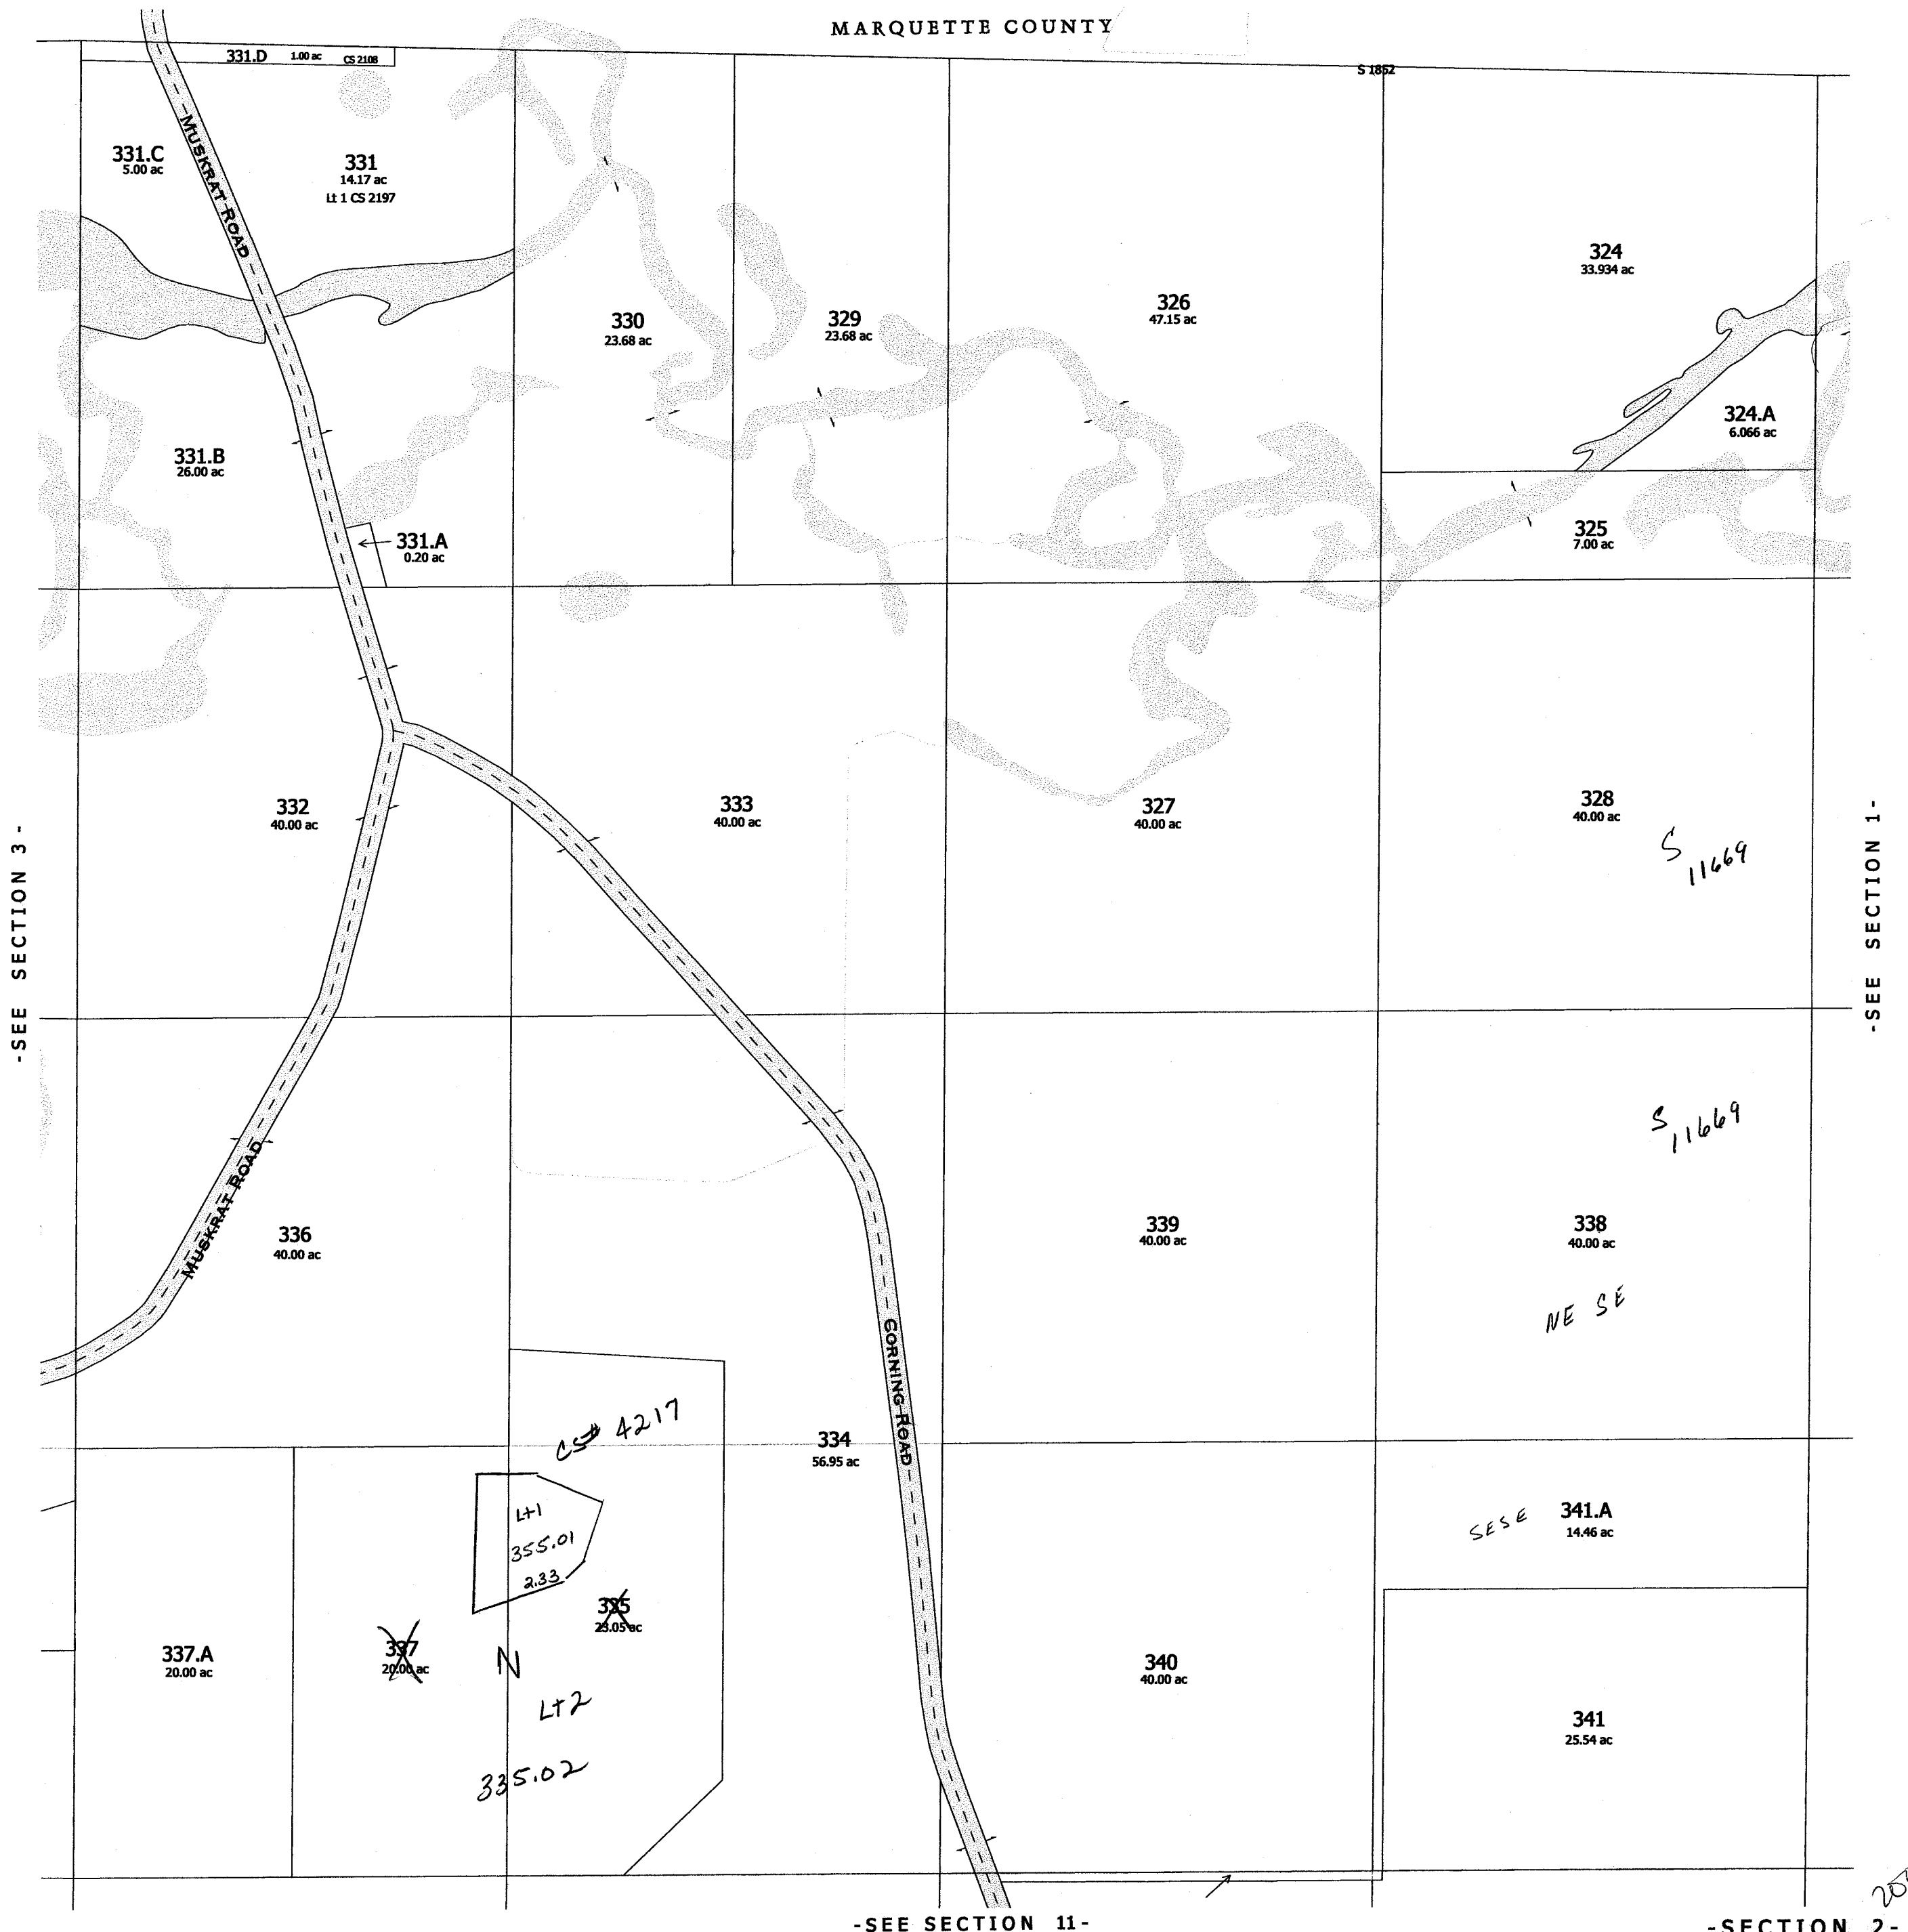


Section 3 Town 13 N Range 8 E

Replaced
2002

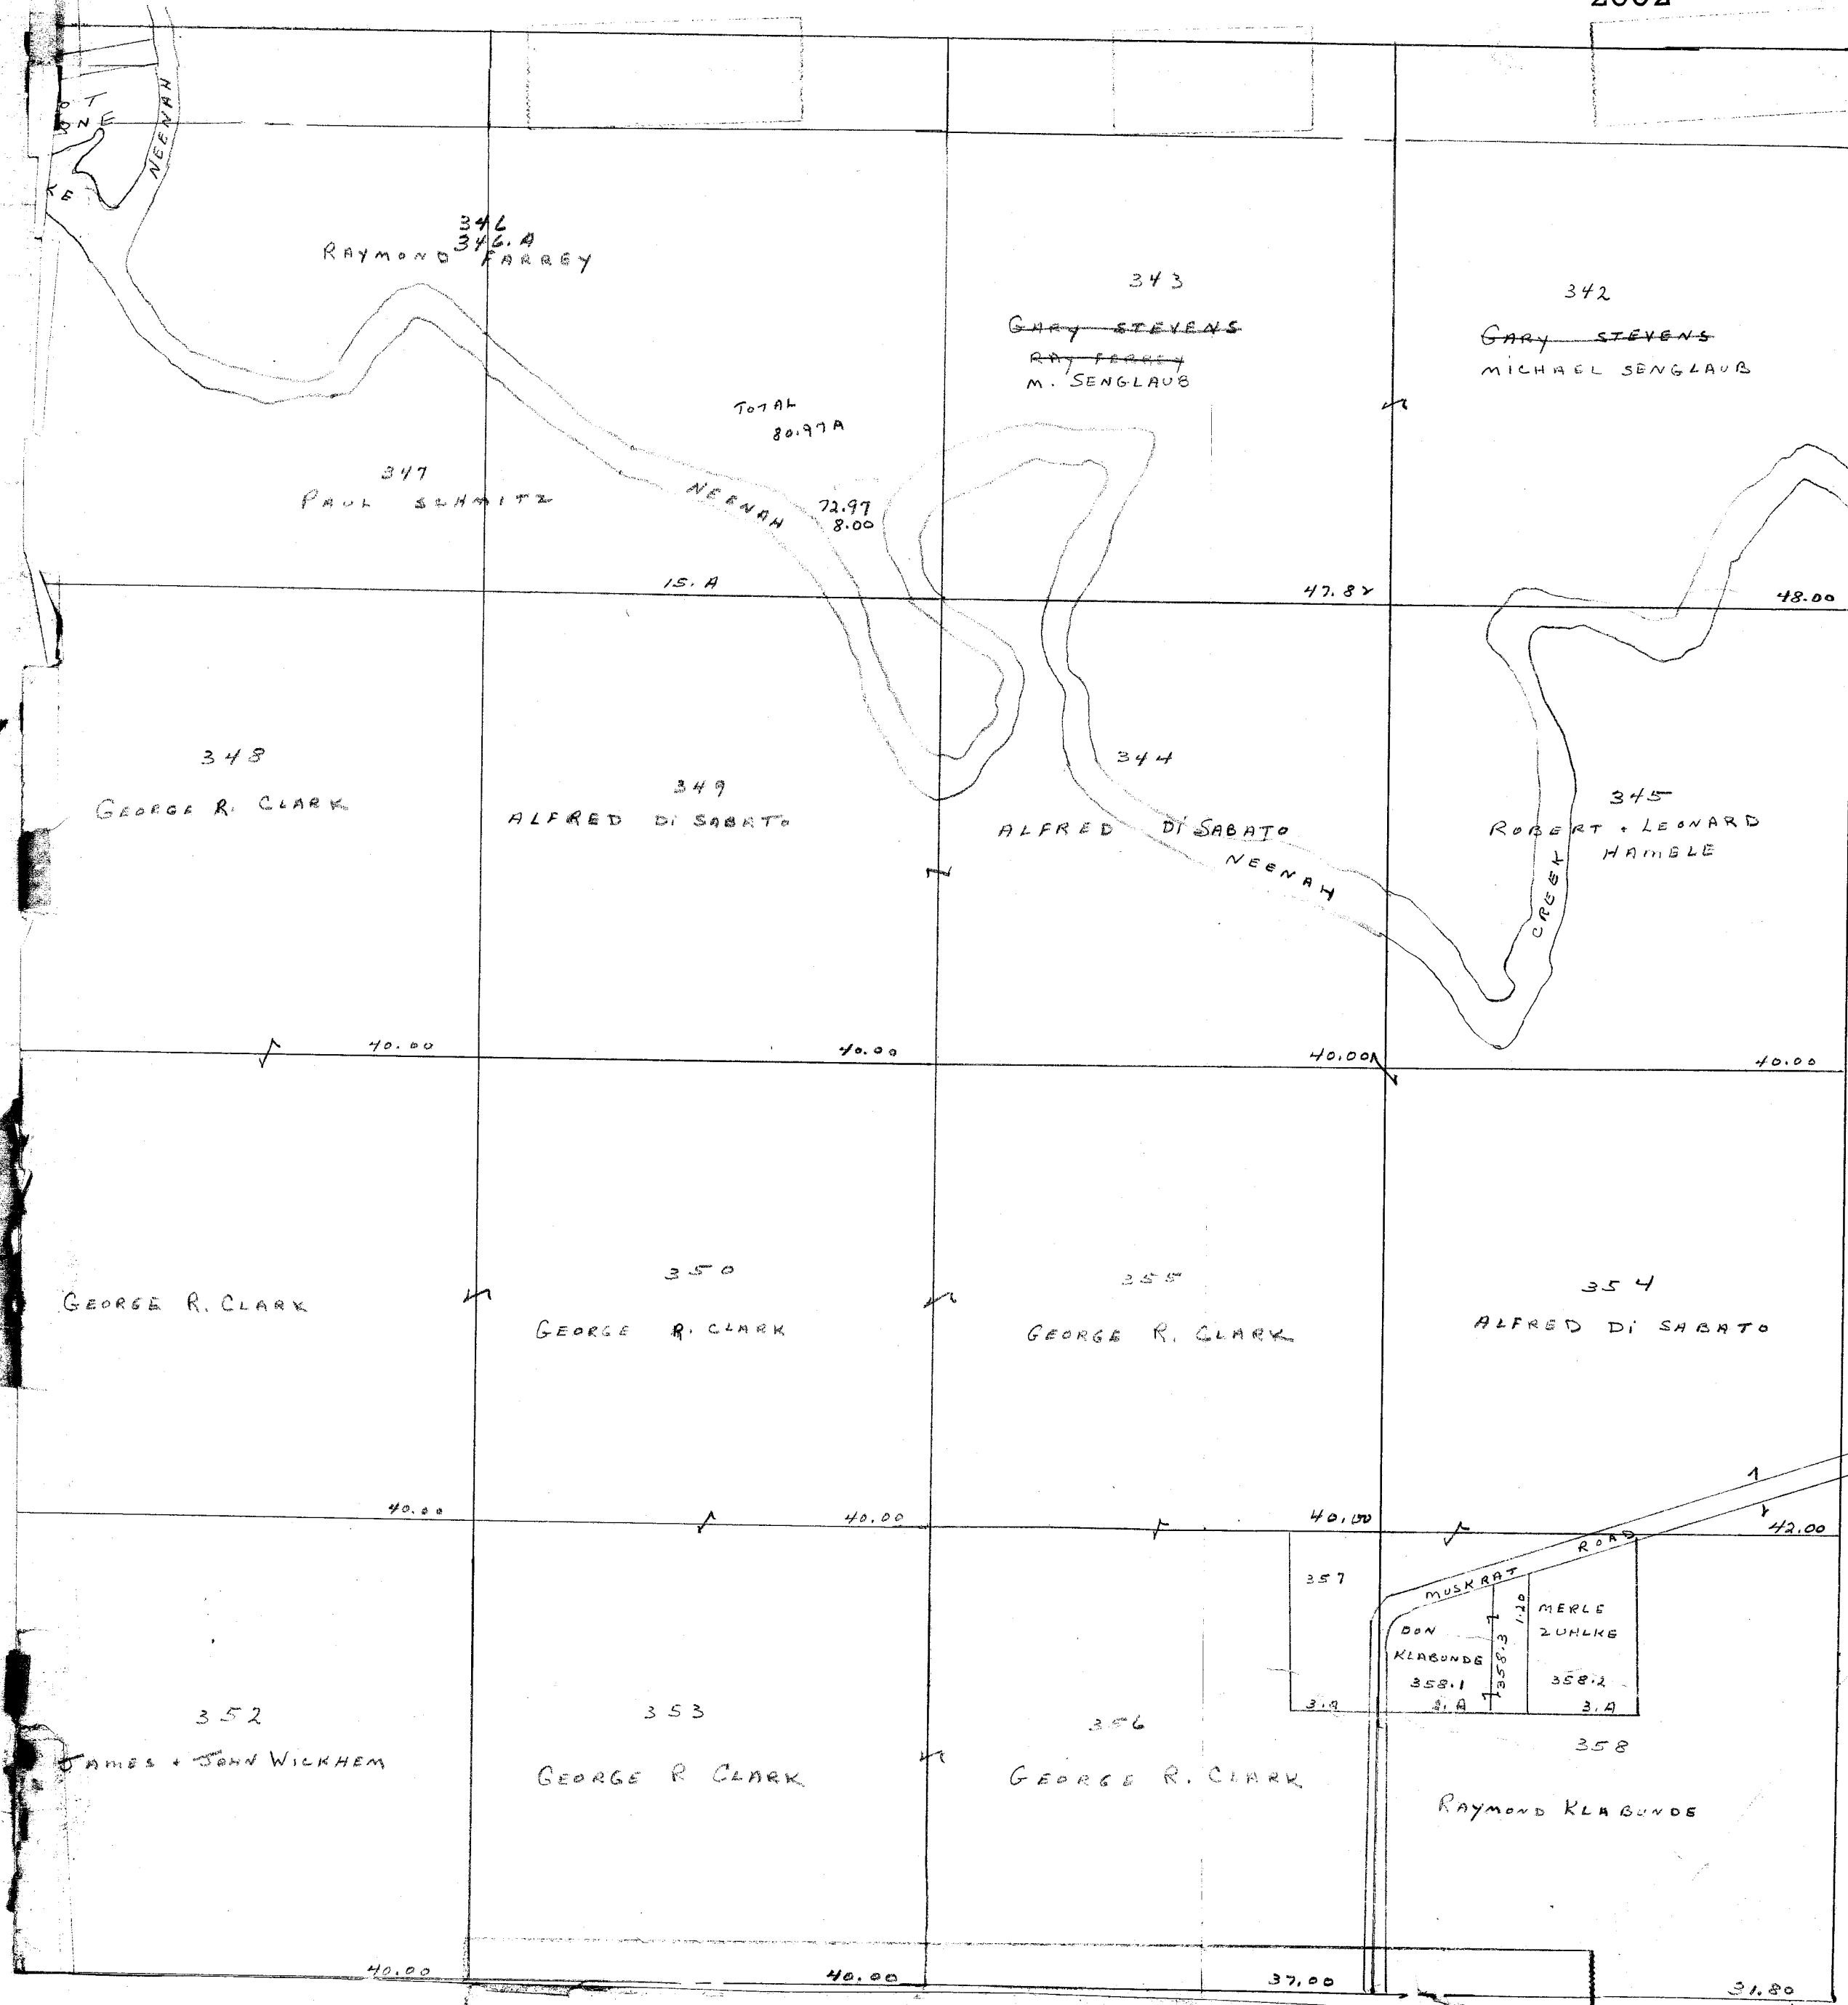


LEWISTON
SEC. 3 T13N R8E

Replaced
2002

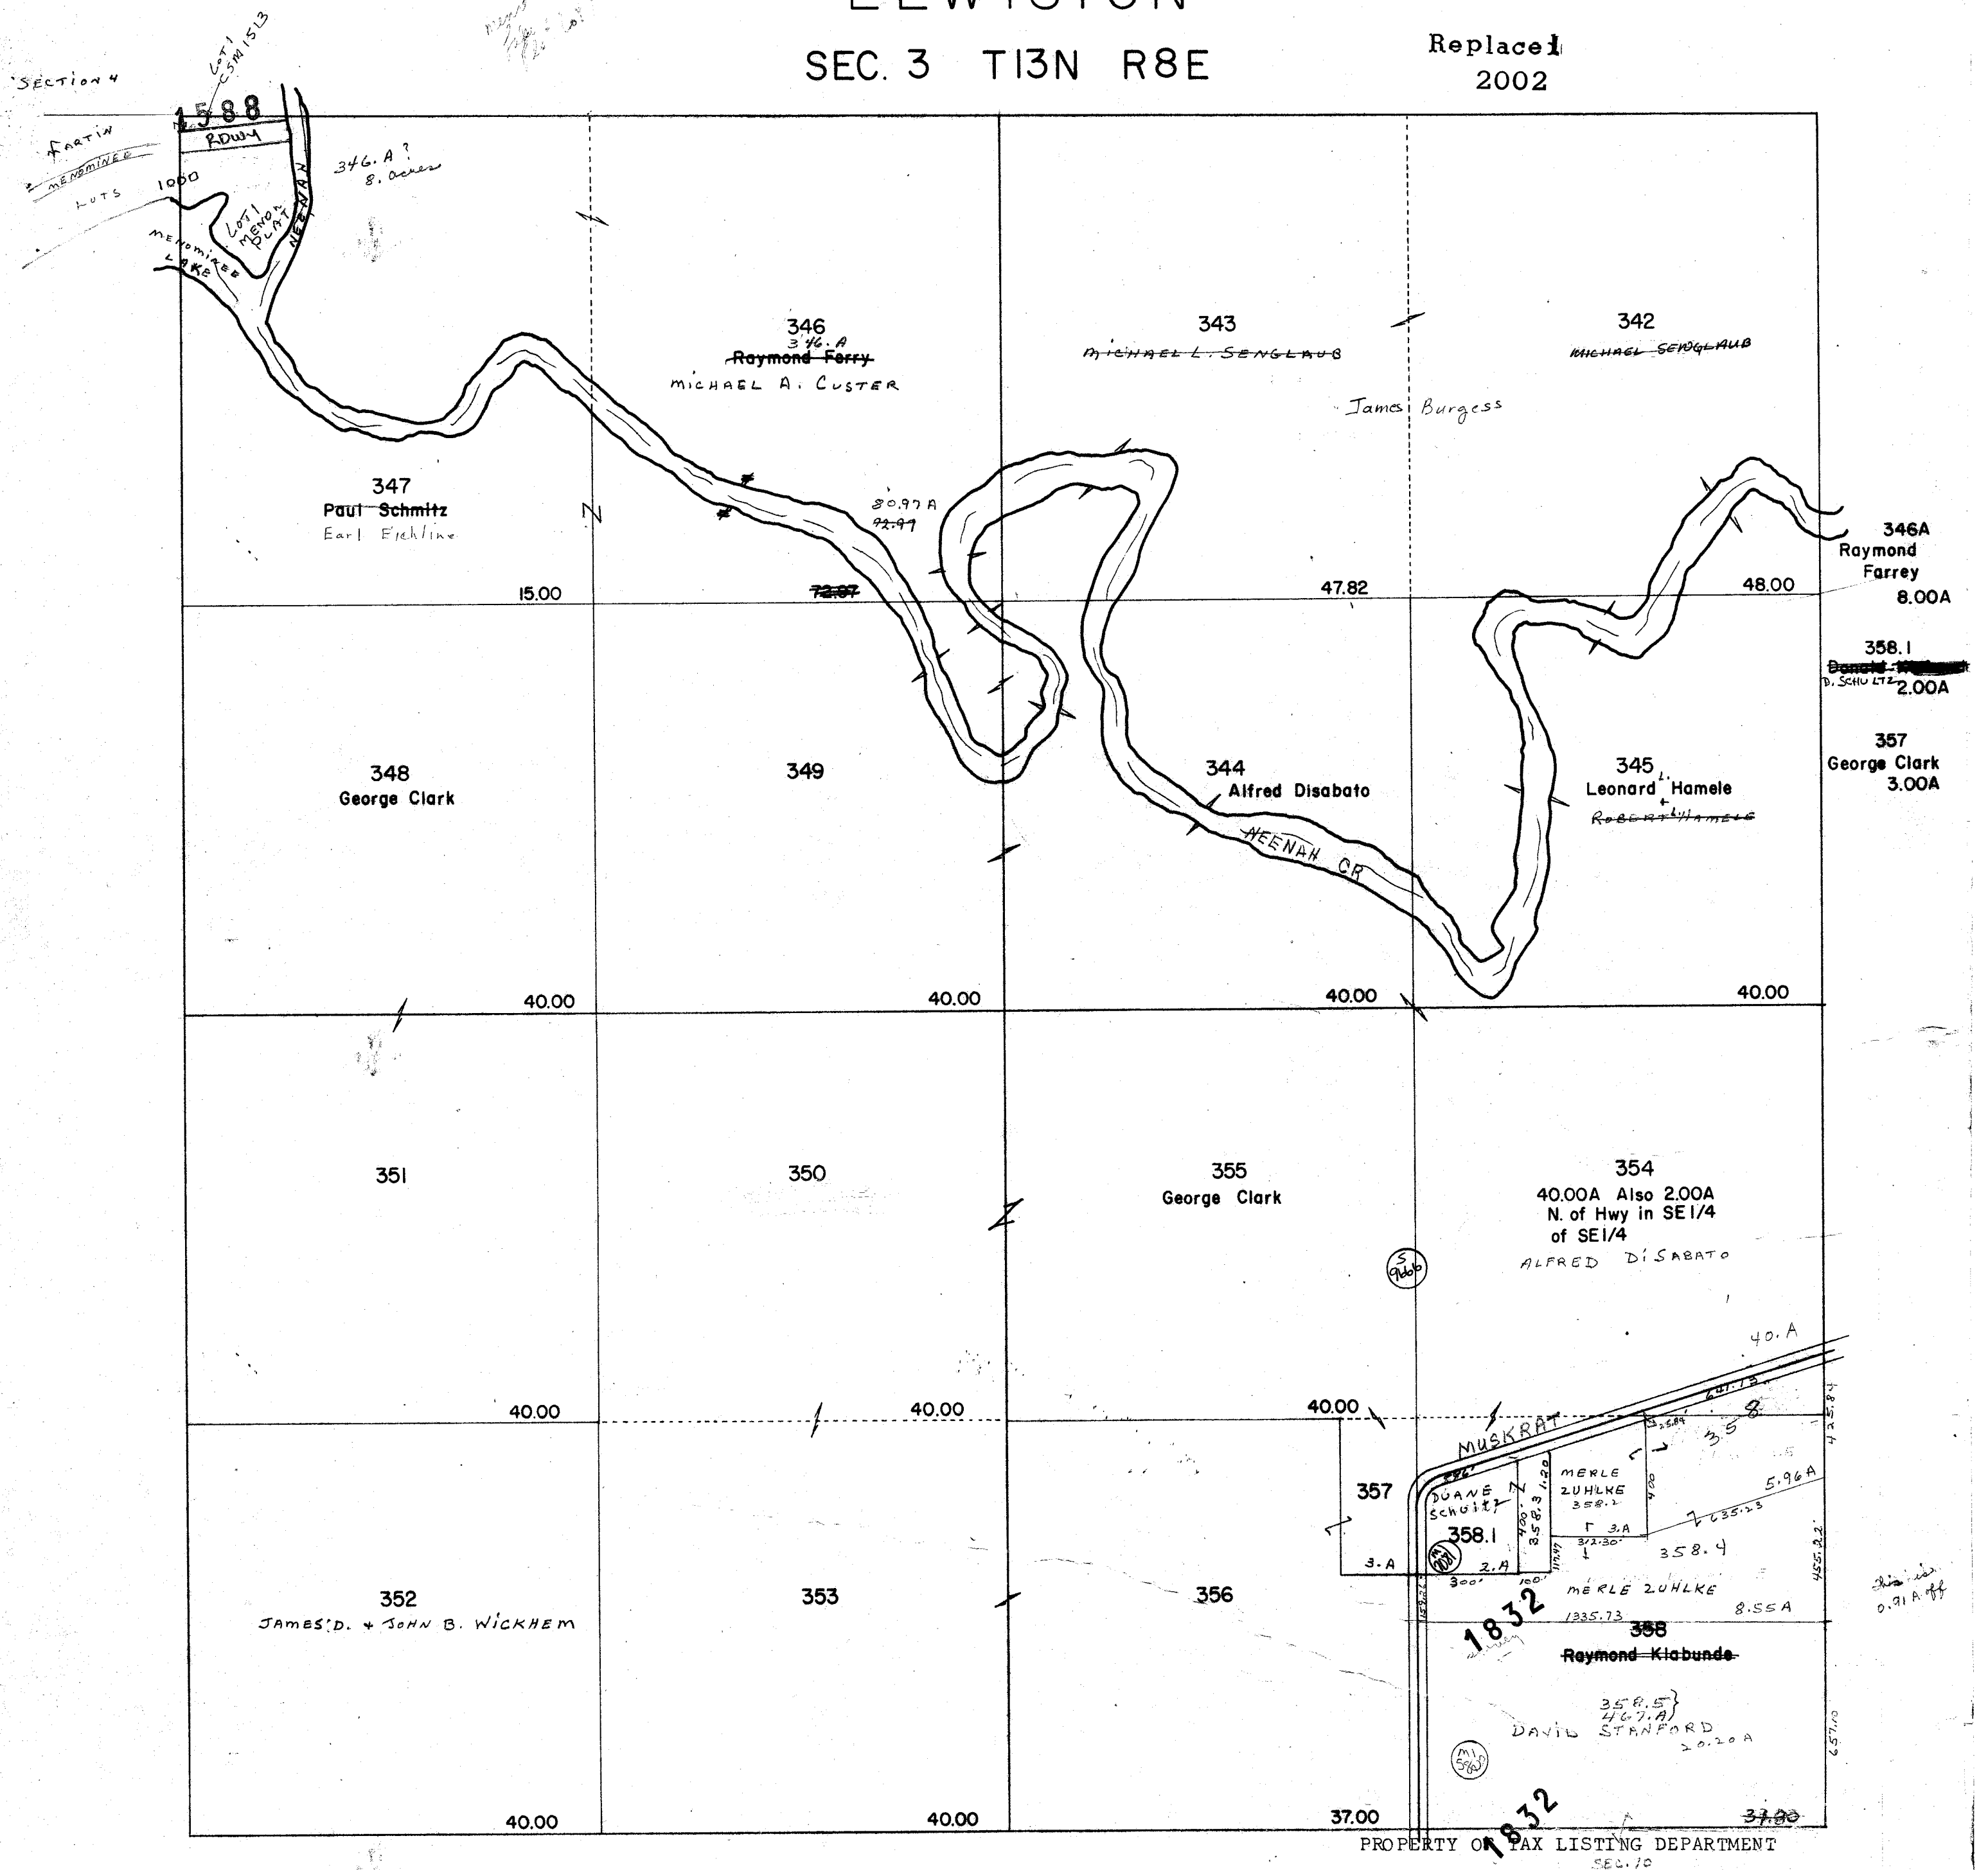

PROPERTY OR TAX LISTING DEPARTMENT
SEC. 70

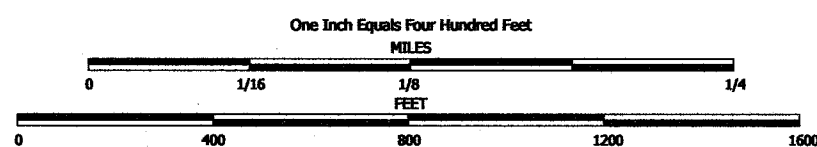



NOTE: This map was prepared for assessment use in accordance with the Wis. St. Stat. Chap. 70.09. All information contained herein is advisory only. Map accuracy is limited to the quality of data obtained from other Public Records. This map is not intended to be a substitute for an actual field survey. Public Land Survey Base is derived from U.S.G.S Topographic maps unless otherwise noted. Other sources of the Land Base may be actual survey data. Base map data is from the April 1995 County Digital Orthophotos and/or U.S.G.S. 1:24,000 scale Topographic series. The user is responsible for the improper use of the data contained herein.

Created by The Columbia County Land Information Office -GIS Section. VMB.
February 2003.

TAX PARCEL MAP


TOWN of LEWISTON

TOWN 13 NORTH RANGE 8 EAST
COLUMBIA COUNTY, WISCONSIN

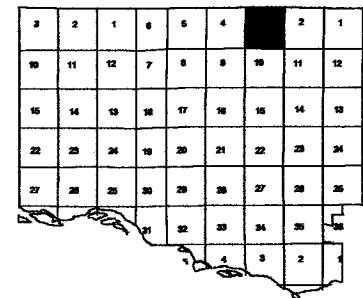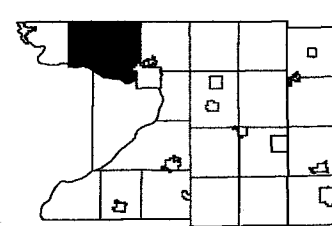

Replaced
2003


MARQUETTE COUNTY

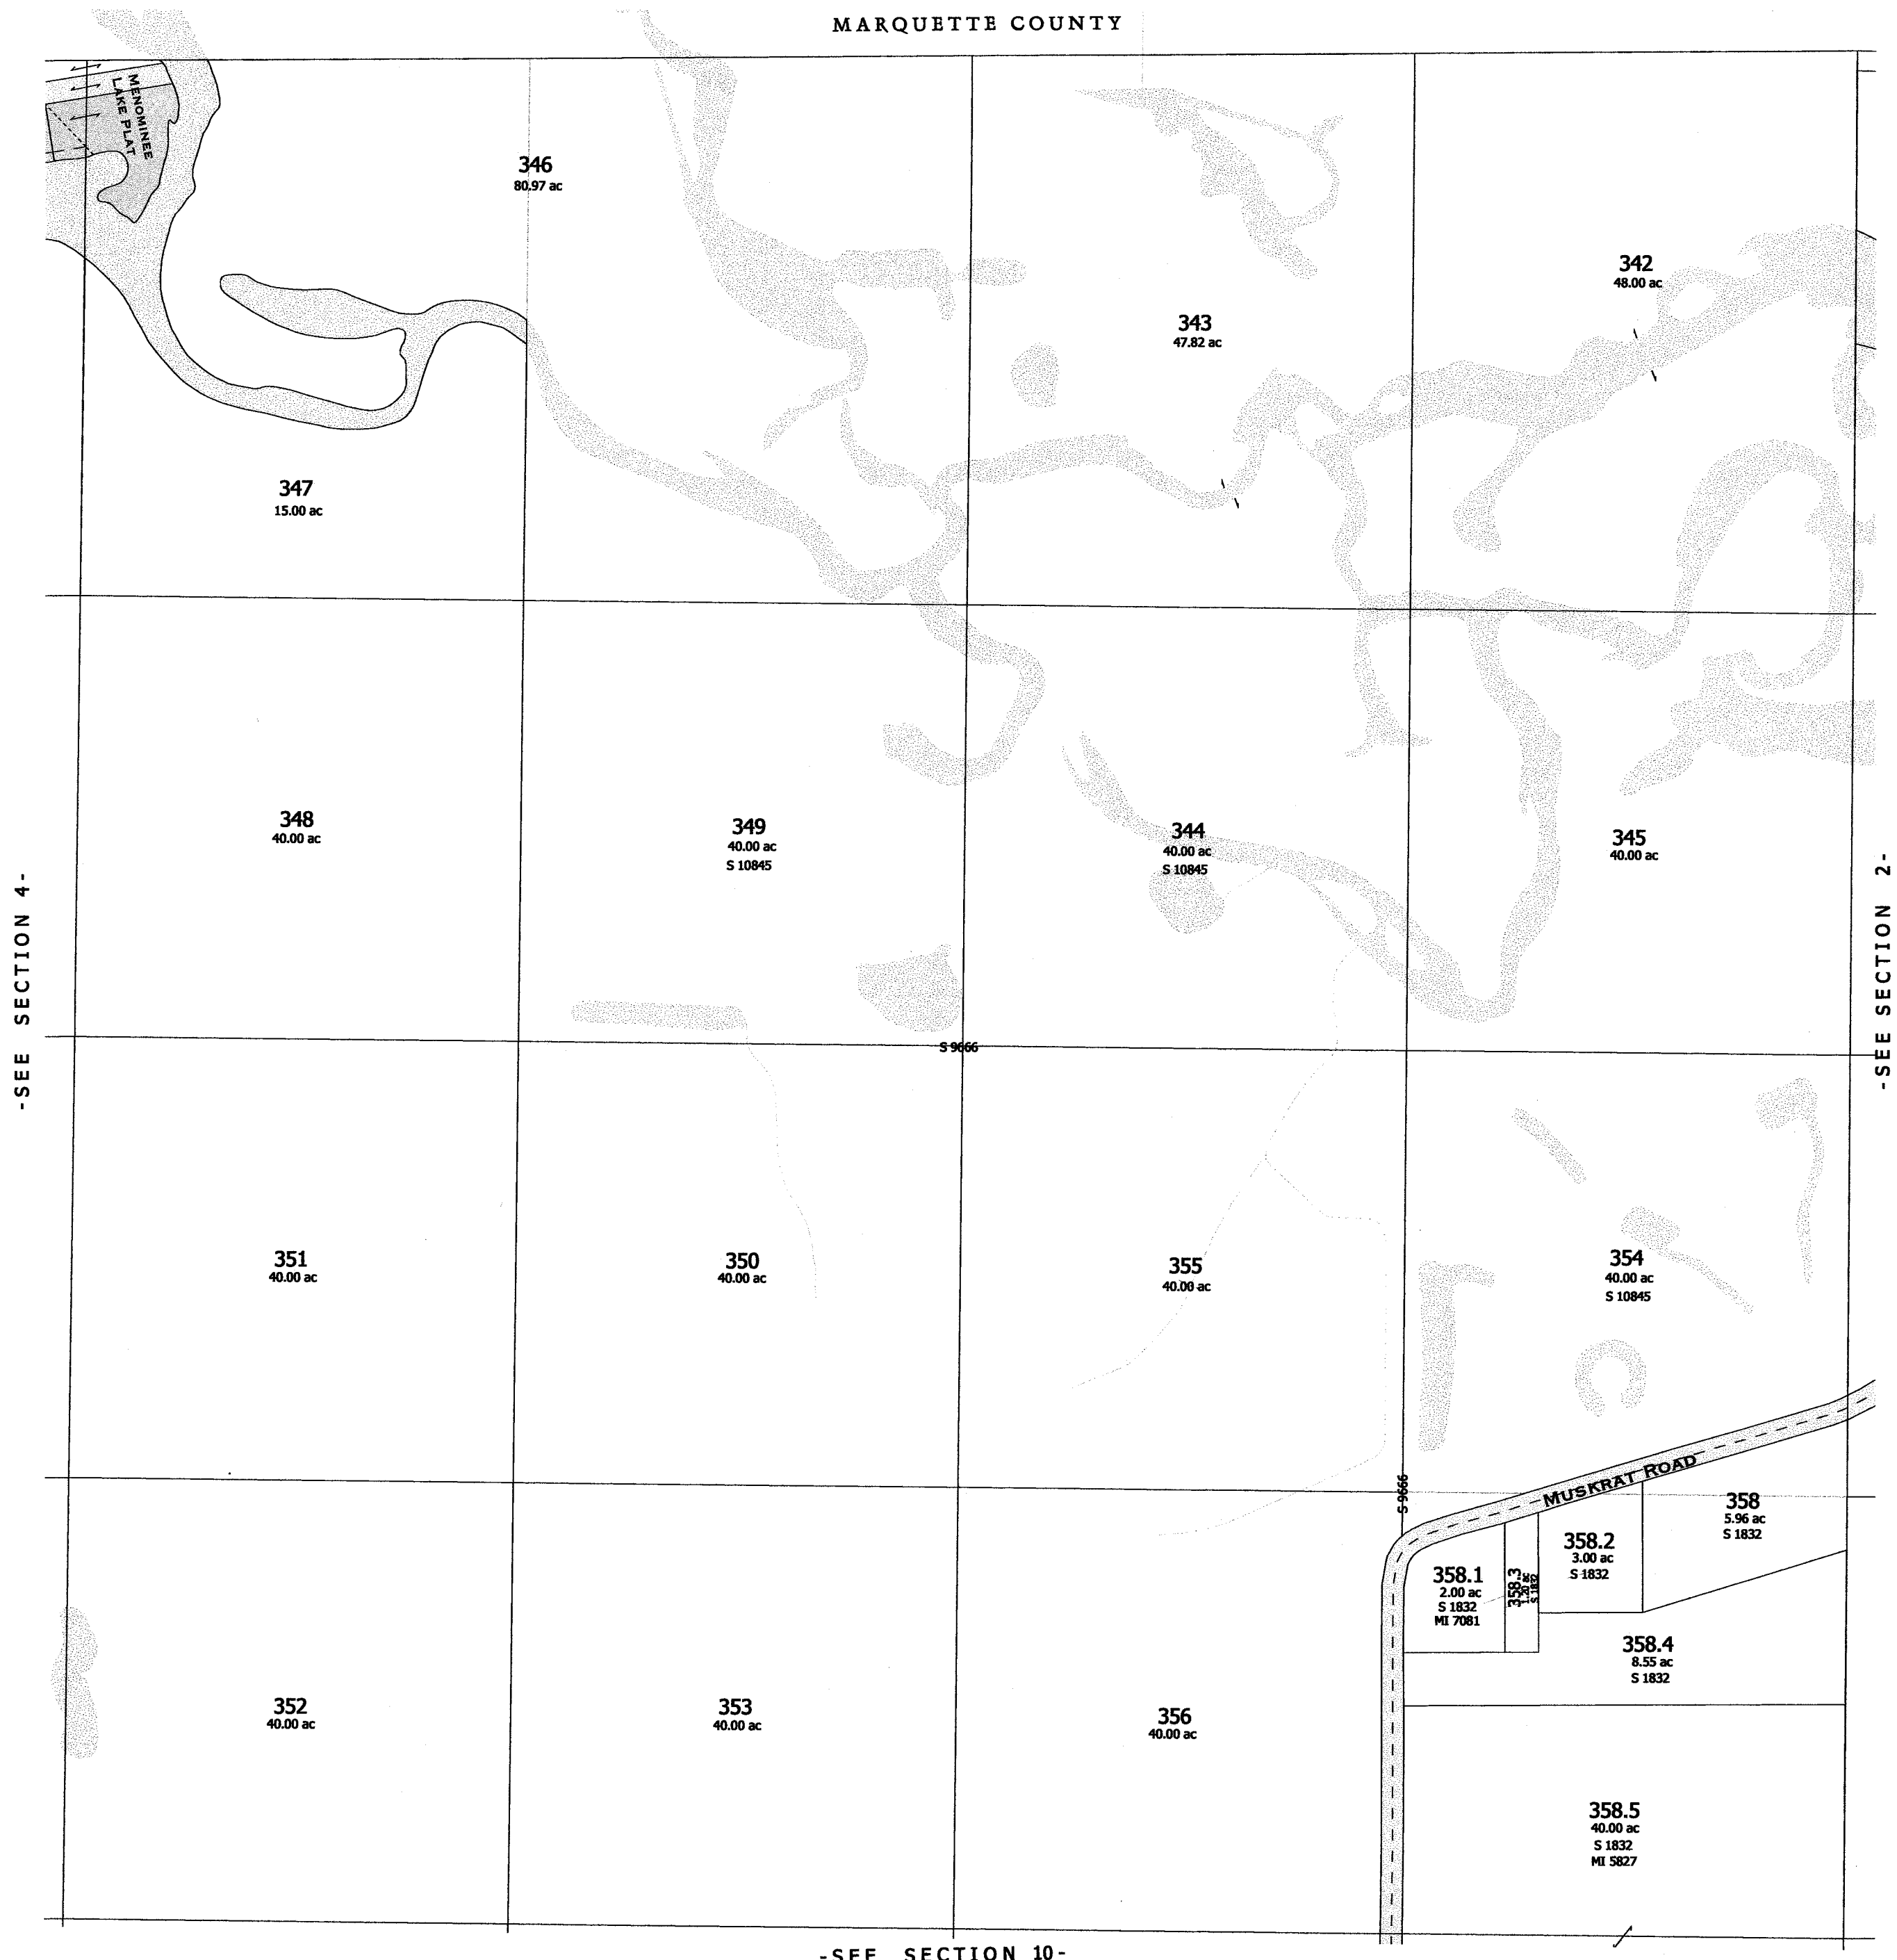

-SEE SECTION 10-



- SEE THE FOLLOWING PAGES FOR DETAILED MAP OF SUBDIVISION -

replaced 2003
-SECTION 3-

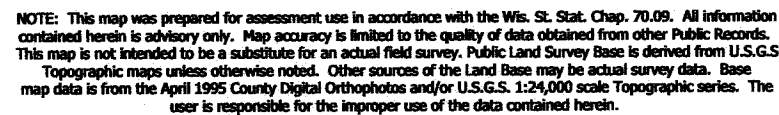


Created by The Columbia County Land Information Office-GIS Section. VMB.
September 2002.

TOWN 13 NORTH RANGE 8 EAST
COLUMBIA COUNTY, WISCONSIN

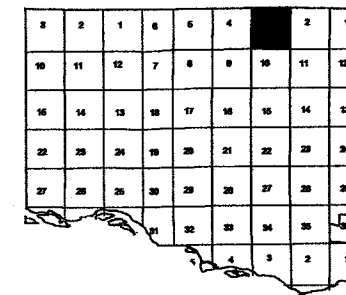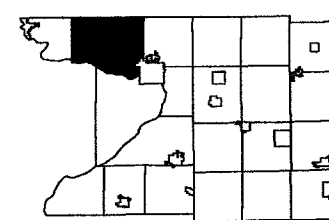

~~Replaced~~
2004

MARQUETTE COUNTY

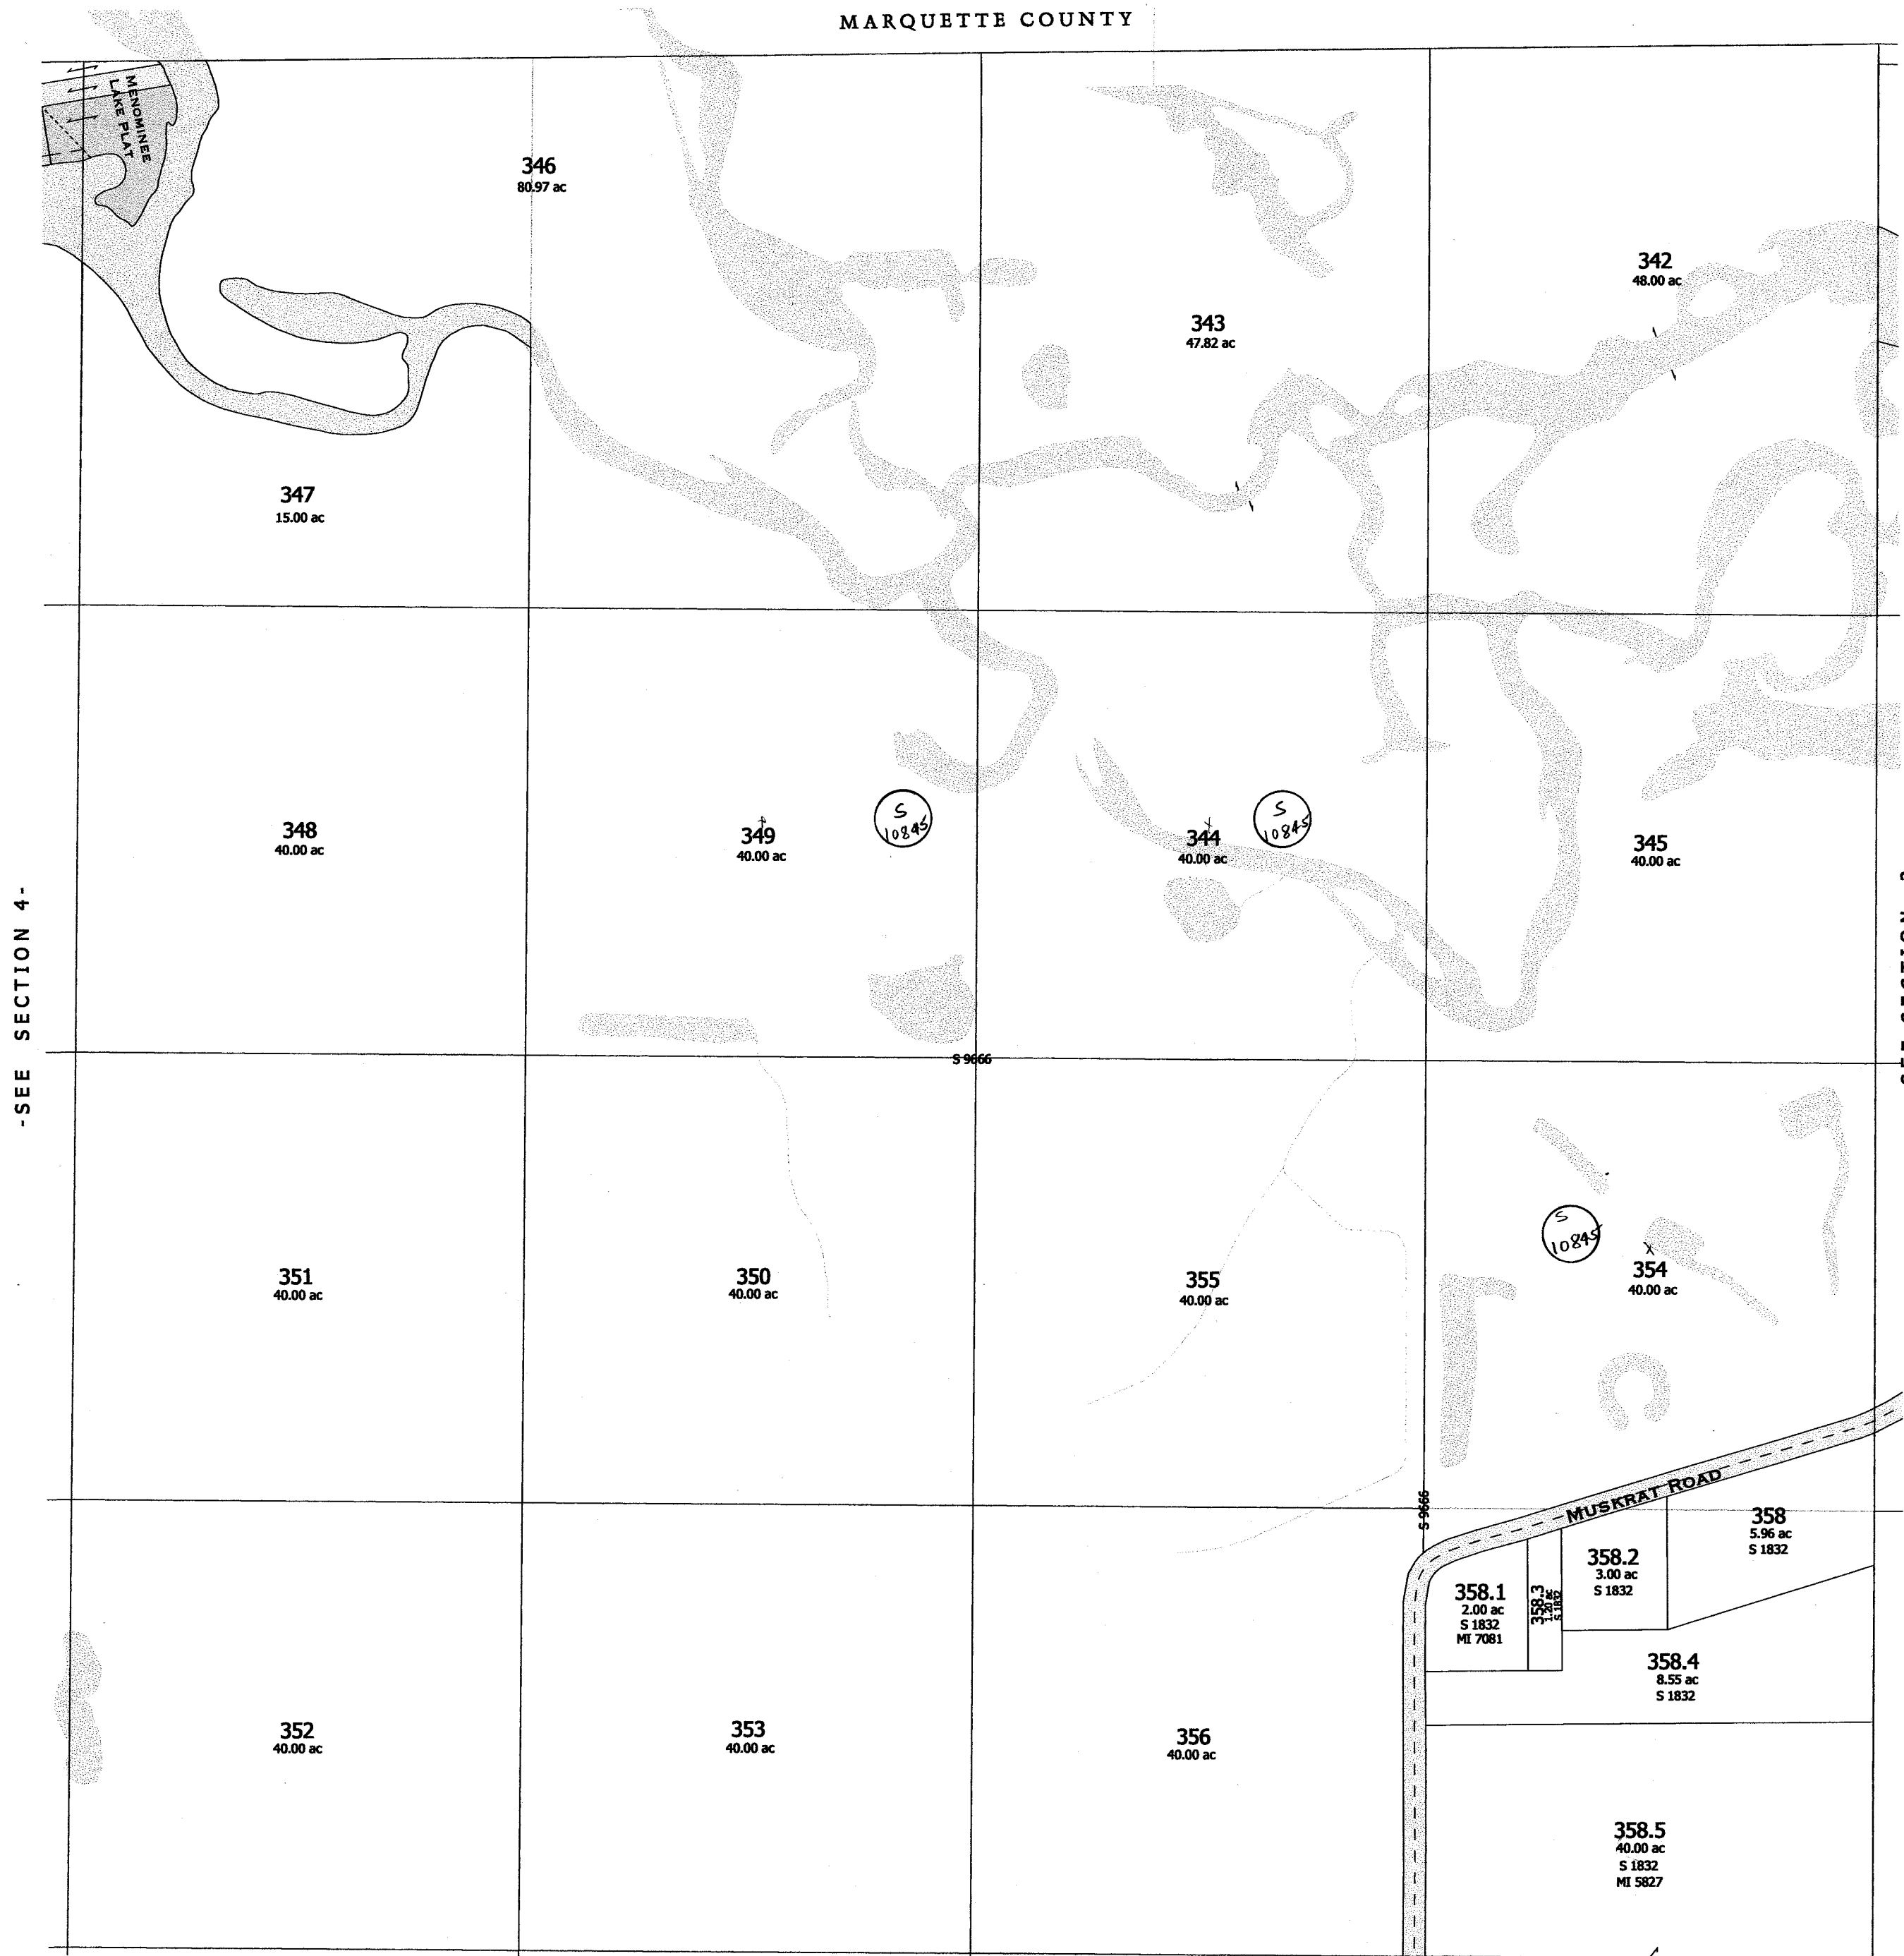


-SEE SECTION 4-

2
3
4
-SEE SECTION 10-

- SEE THE FOLLOWING PAGES FOR DETAILED MAP OF SUBDIVISION -


replaced with
-SECTION 3.

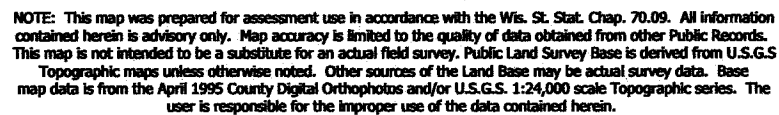

Created by The Columbia County Land Information Office -GIS Section. VMB.
March 2004.

TOWN of LEWISTON


TOWN 13 NORTH RANGE 8 EAST
COLUMBIA COUNTY, WISCONSIN

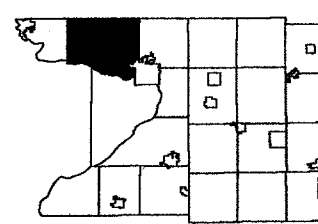

Replaced

2005

MARQUETTE COUNTY

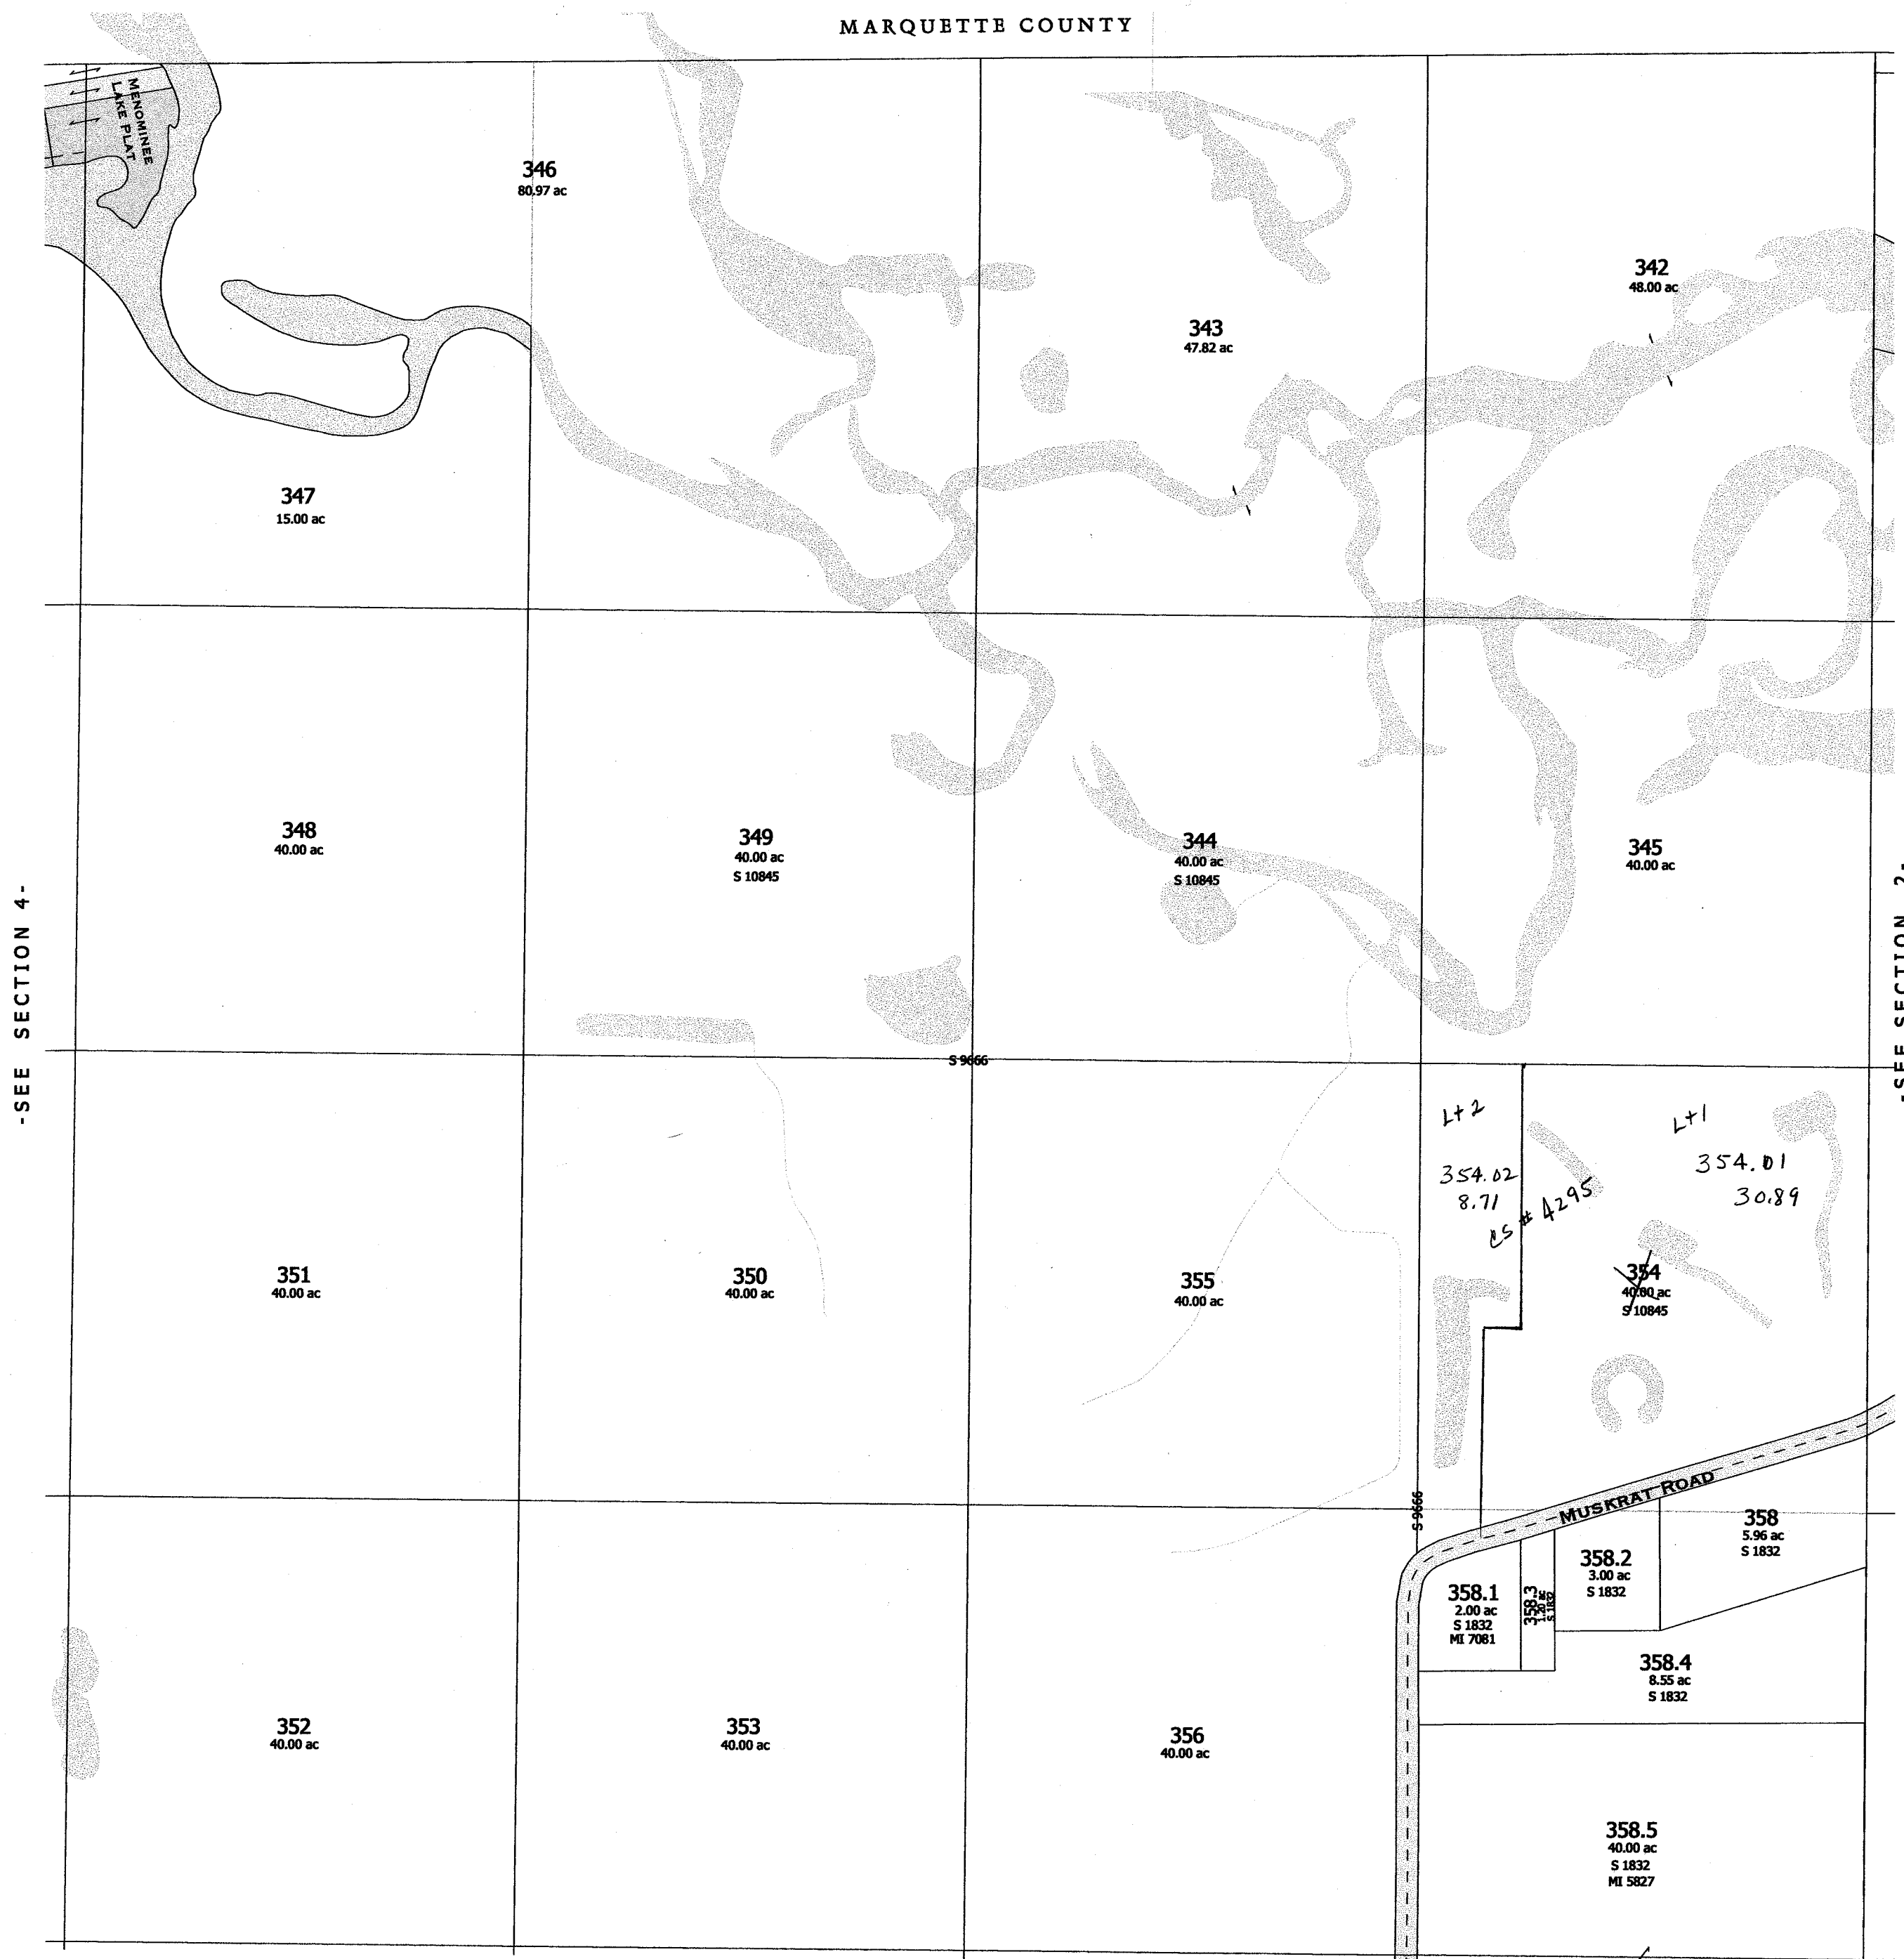

-SEE SECTION 10-

- SEE THE FOLLOWING PAGES FOR DETAILED MAP OF SUBDIVISION -

-SECTION 3-

2005

One Inch Equals Four Hundred Feet
MILES
0 1/16 1/8 1/4
FEET
0 400 800 1200 1600




NOTE: This map was prepared for assessment use in accordance with the Wis. St. Stat. Chap. 70.09. All information contained herein is advisory only. Map accuracy is limited to the quality of data obtained from other Public Records. This map is not intended to be a substitute for an actual field survey. Public Land Survey Base is derived from U.S.G.S. Topographic maps unless otherwise noted. Other sources of the Land Base may be actual survey data. Base map data is from the April 1995 County Digital Orthophotos and/or U.S.G.S. 1:24,000 scale Topographic series. The user is responsible for the improper use of the data contained herein.

Created by The Columbia County Land Information Office -GIS Section. VMB.
February 2005.

TAX PARCEL MAP
TOWN of LEWISTON


TOWN 13 NORTH RANGE 8 EAST
COLUMBIA COUNTY, WISCONSIN

Replaced
2006

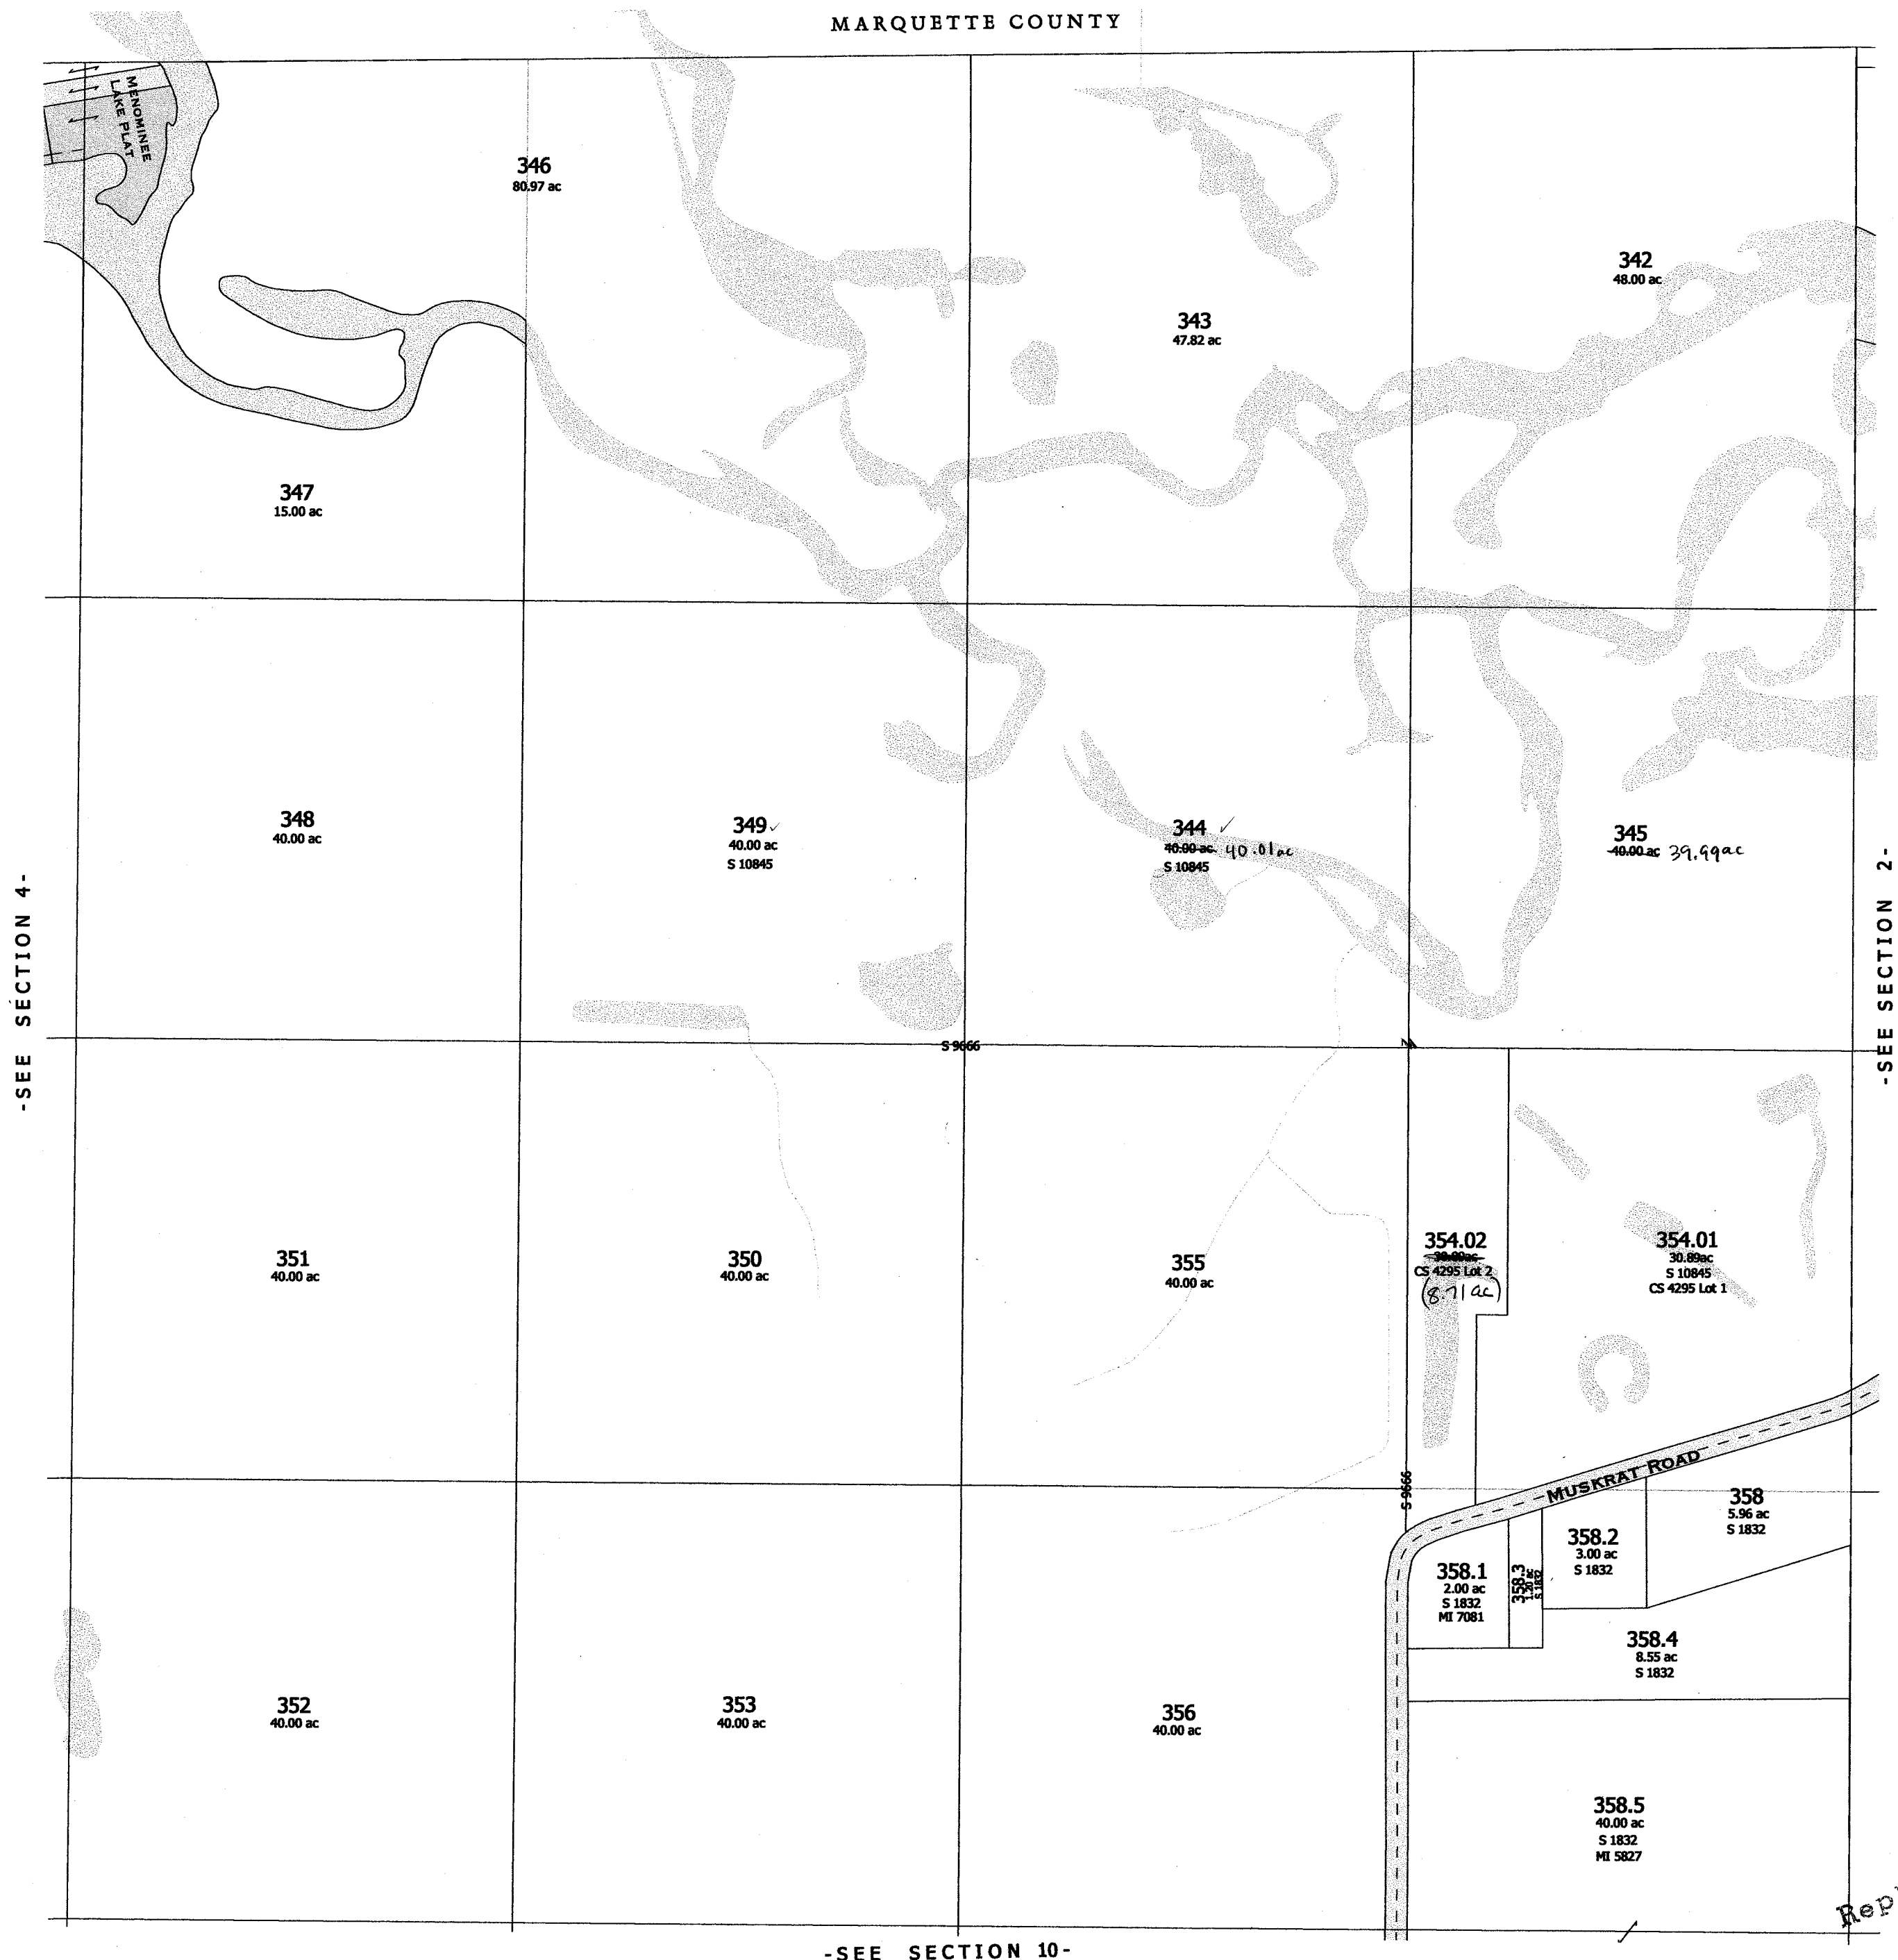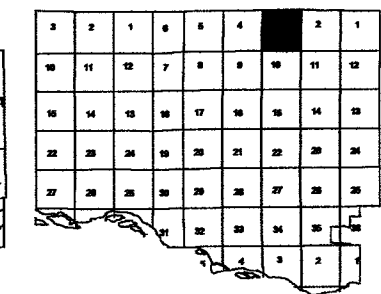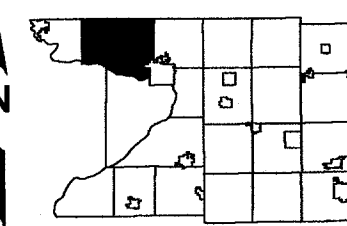

Replaced
2006


Replaced
2002

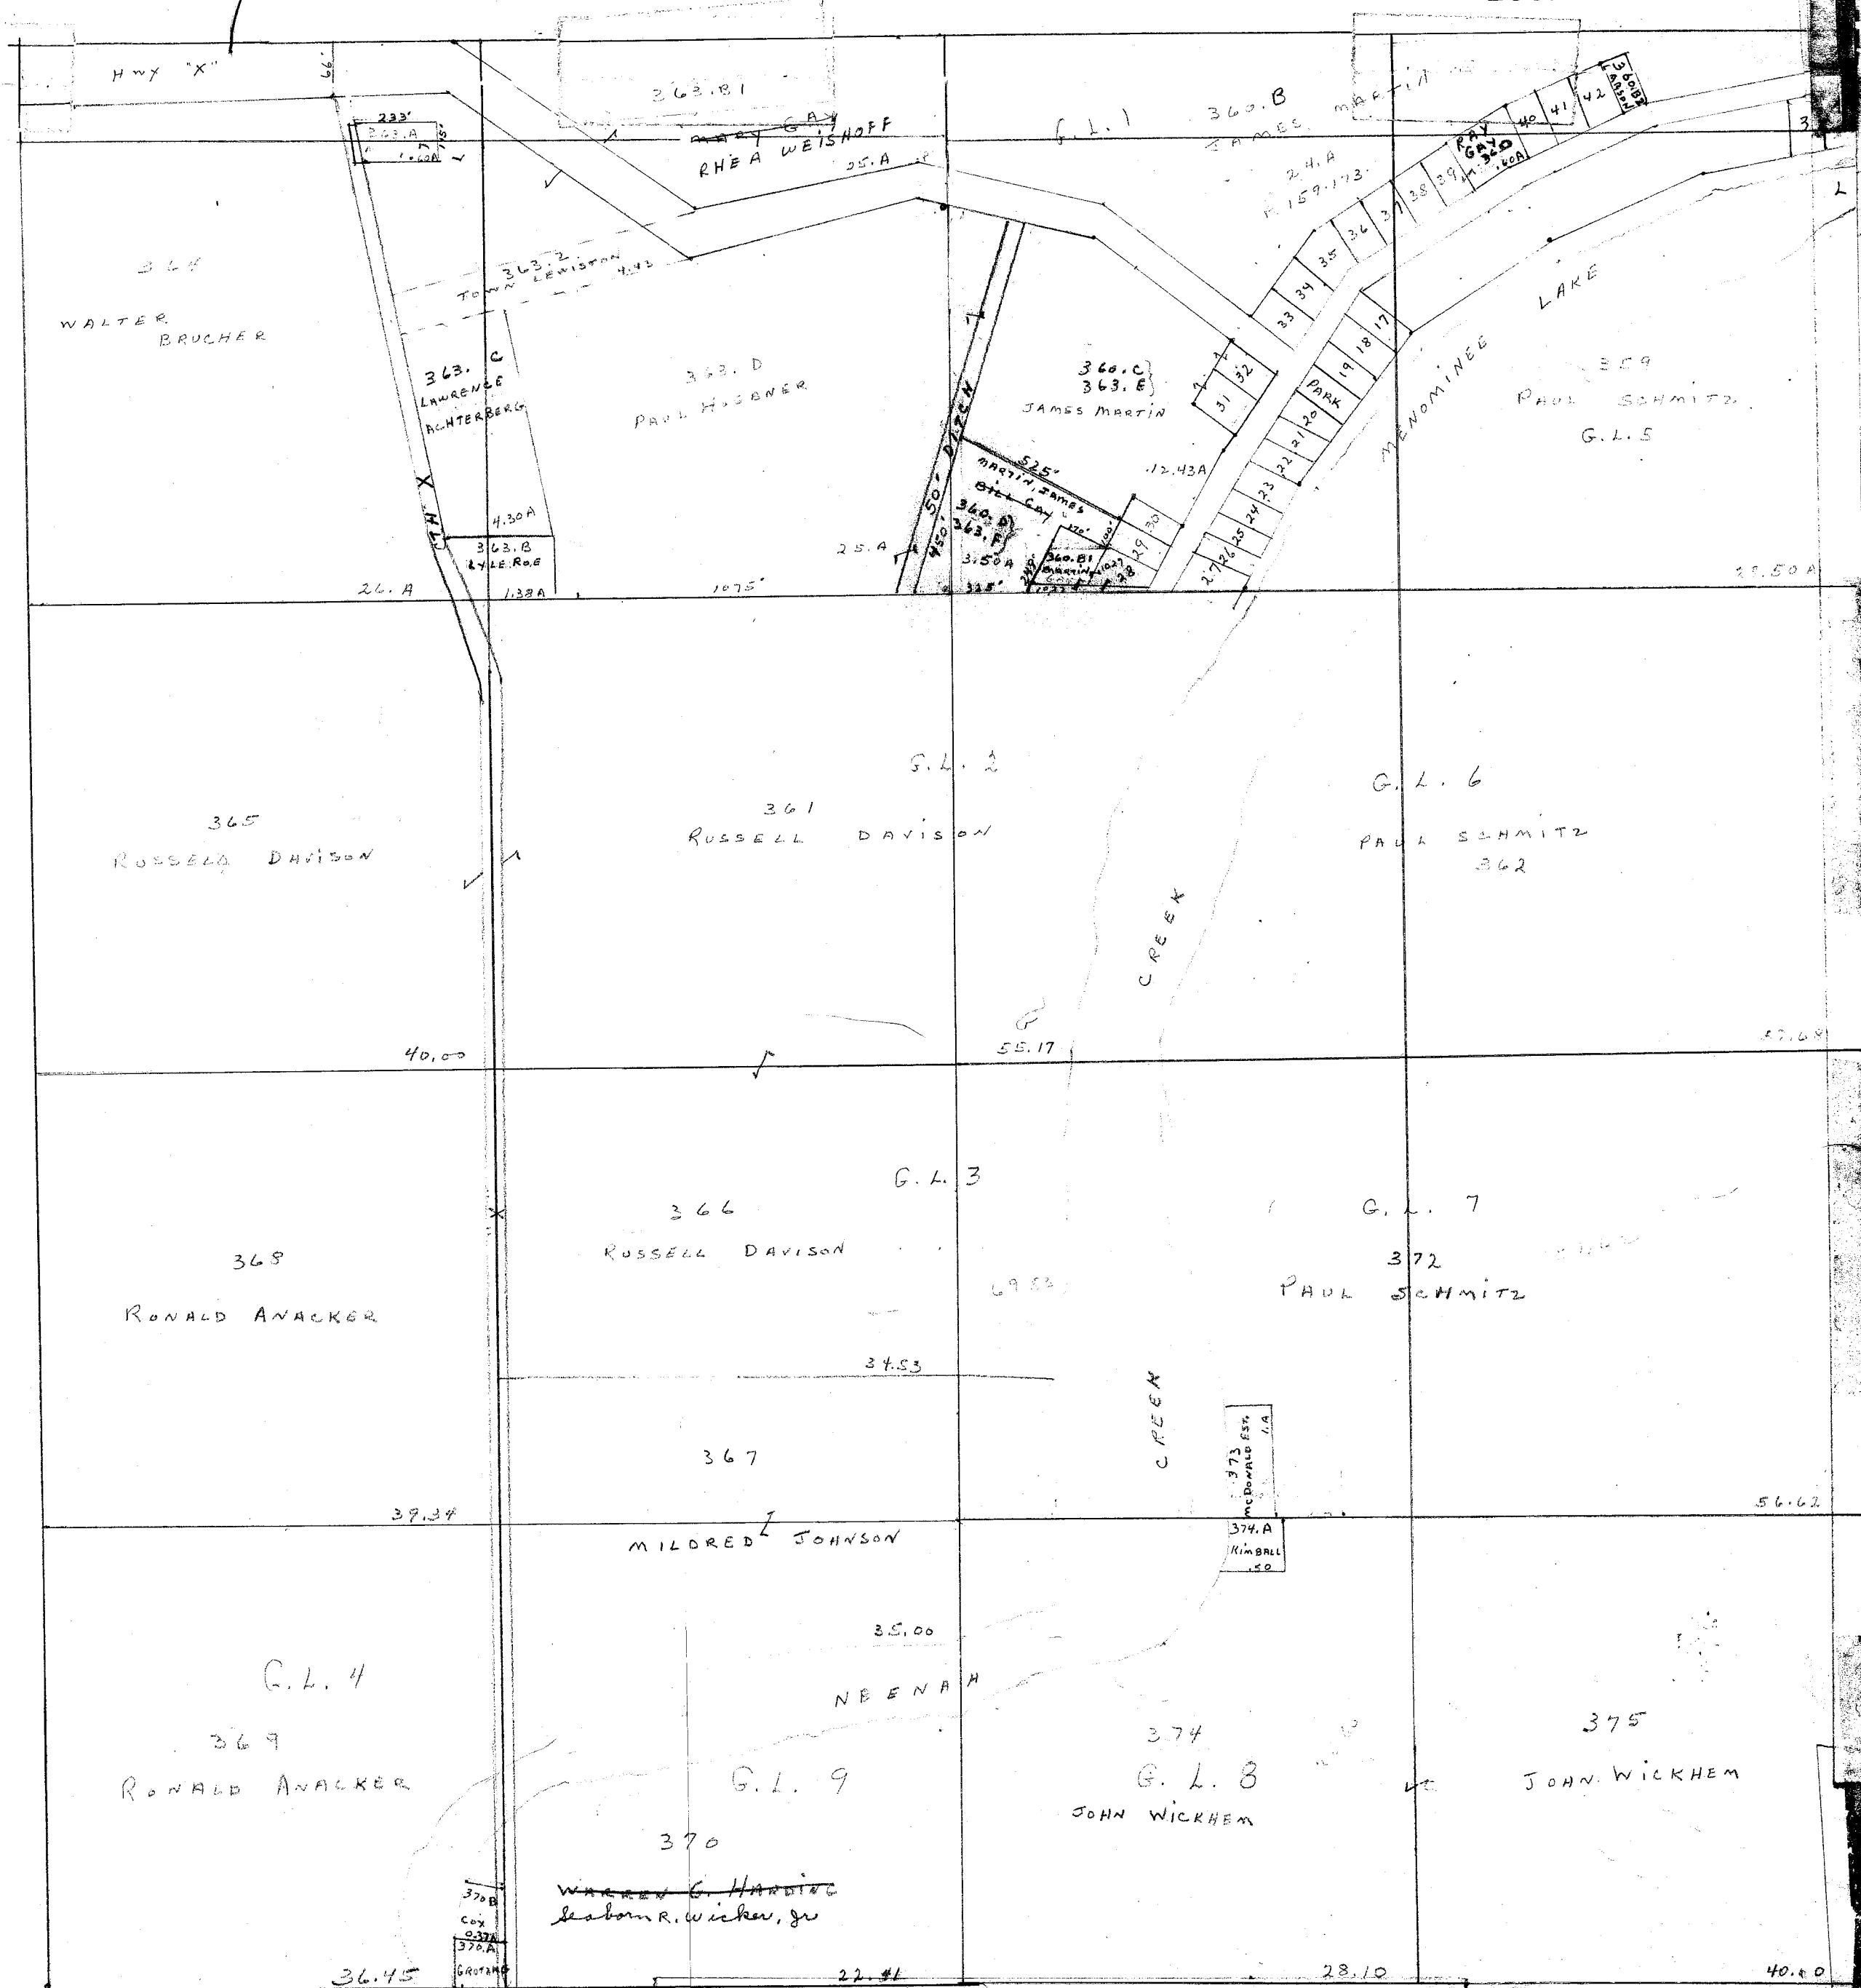


LEWISTON

SEC. 4 T13N R8E

Replaced
2002

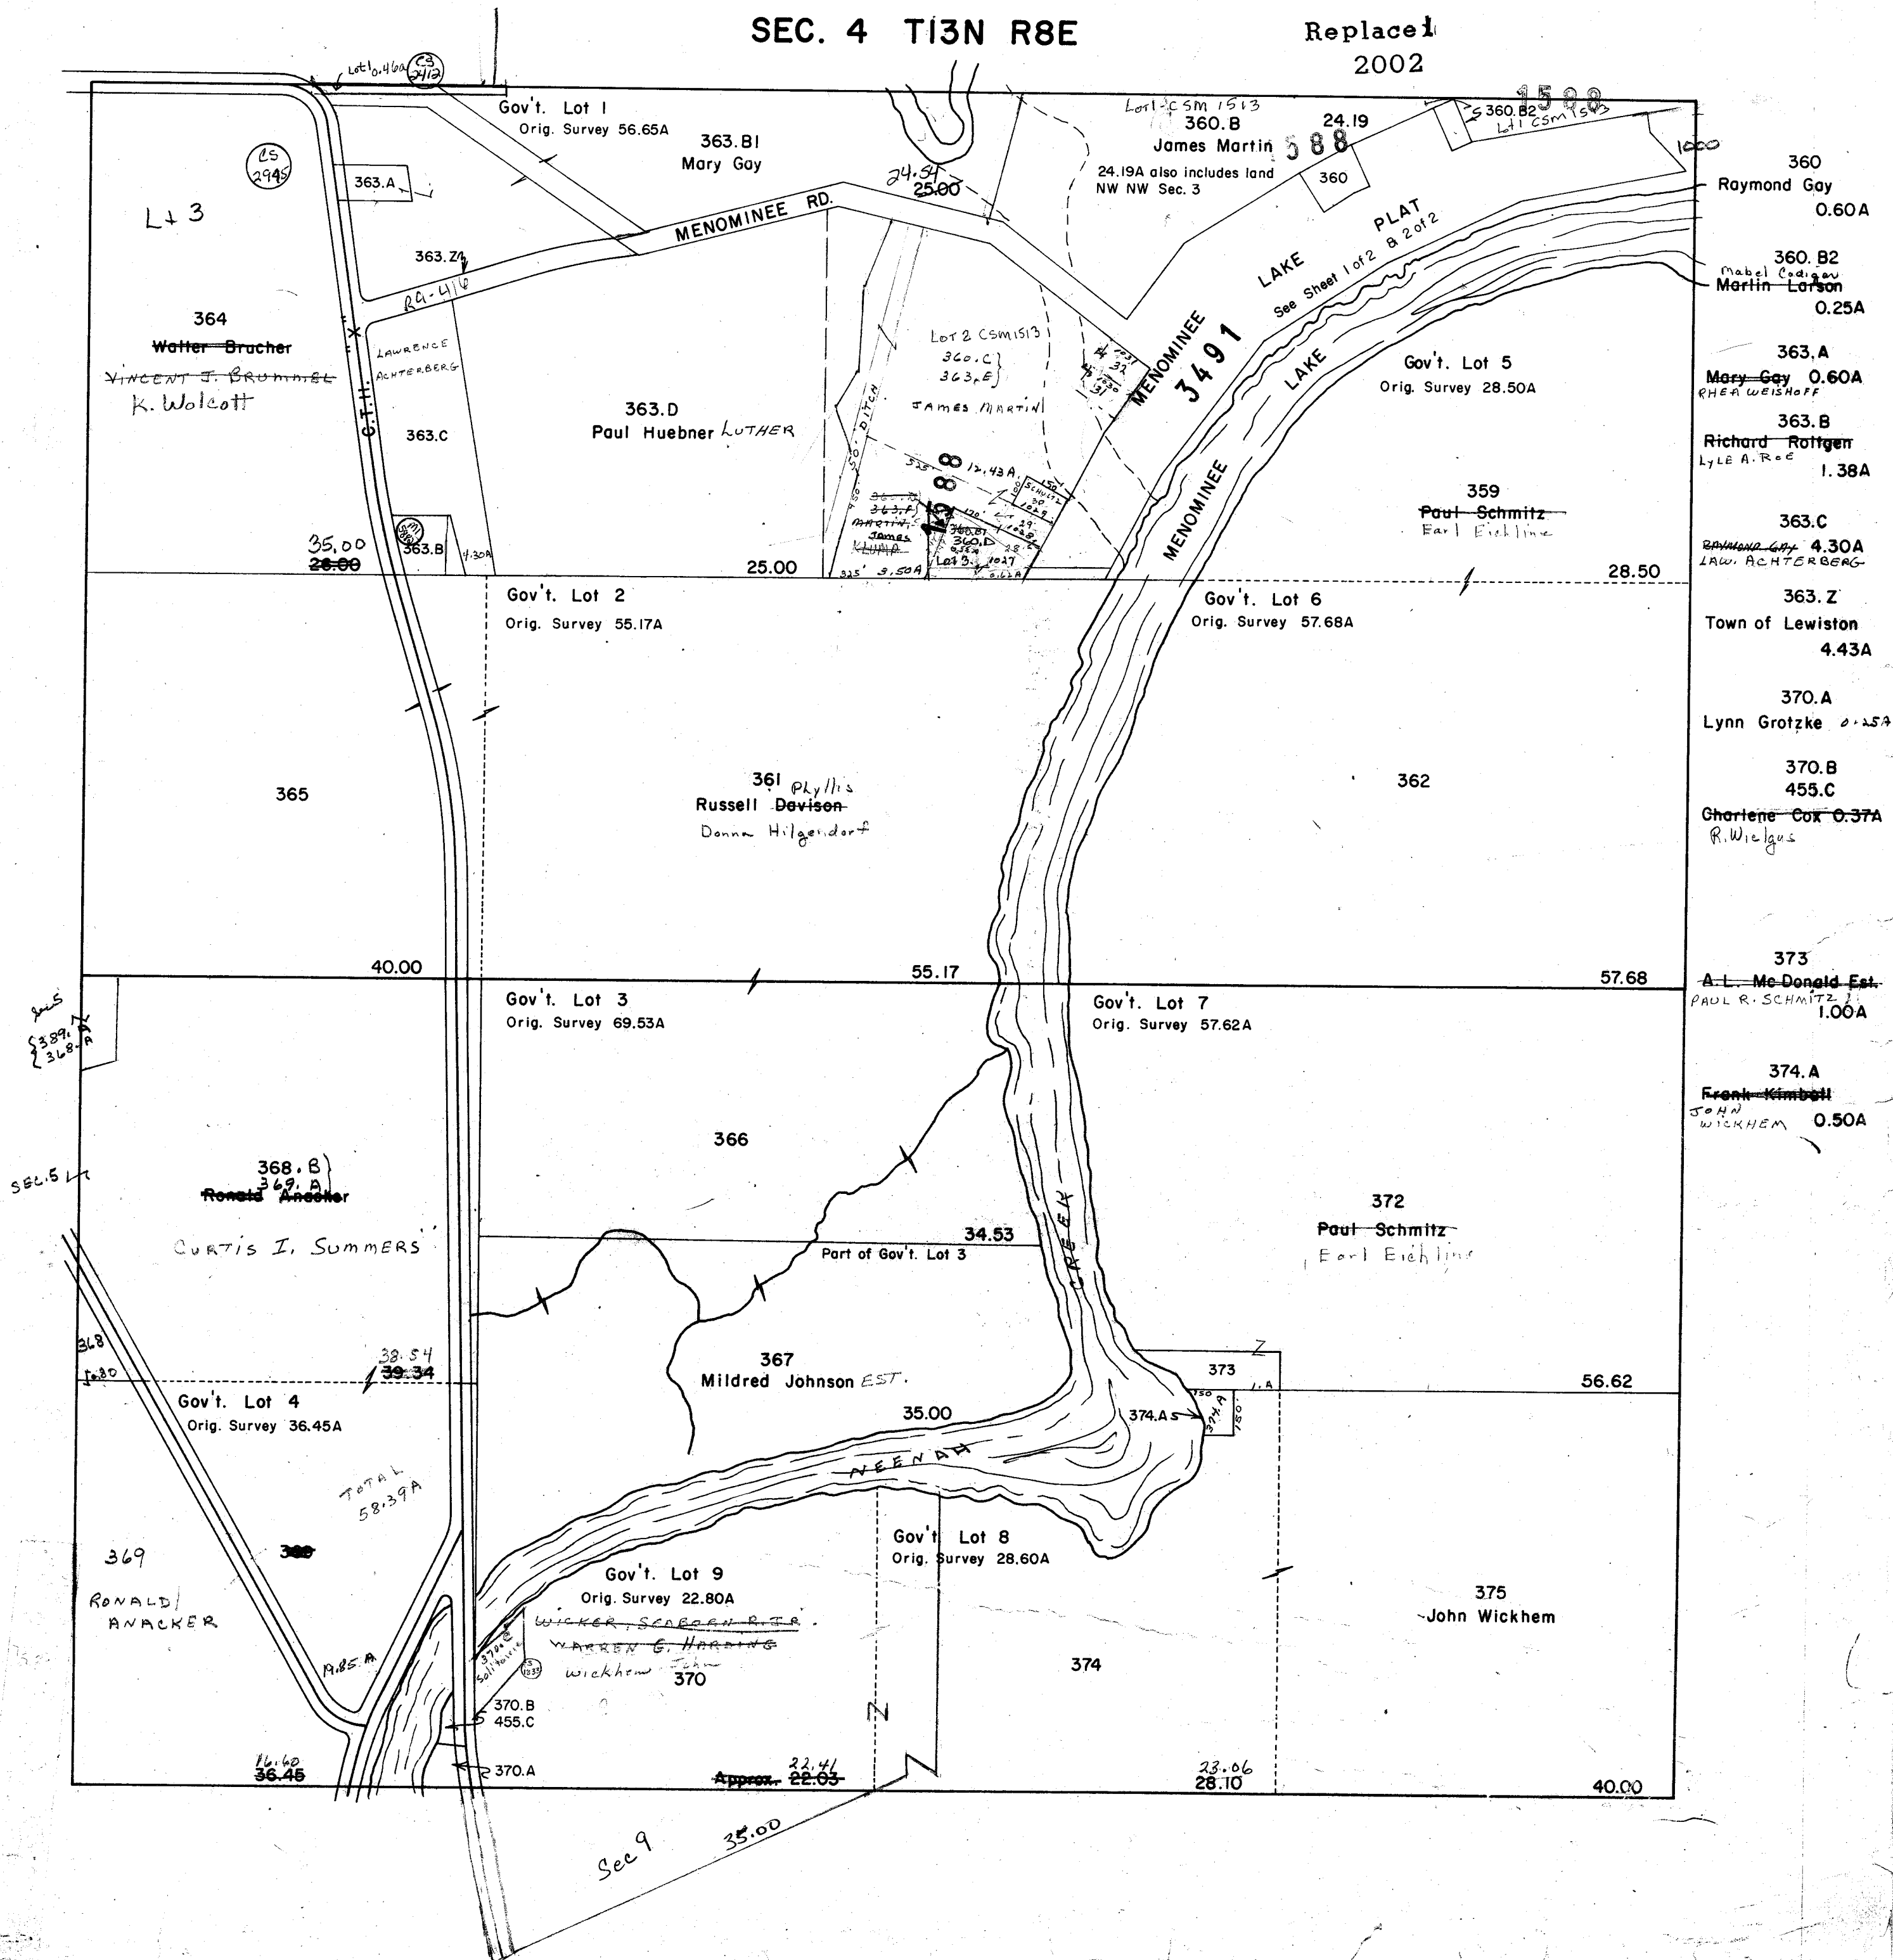

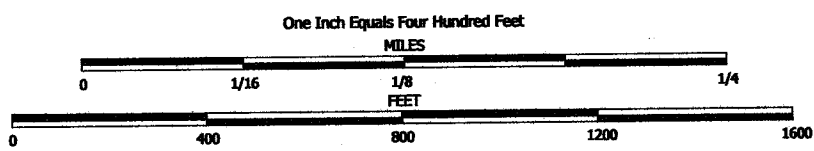


NOTE: This map was prepared for assessment use in accordance with the Wis. St. Stat. Chap. 70.09. All information contained herein is advisory only. Map accuracy is limited to the quality of data obtained from other Public Records. This map is not intended to be a substitute for an actual field survey. Public Land Survey Base is derived from U.S.G.S. Topographic maps unless otherwise noted. Other sources of the Land Base may be actual survey data. Base map data is from the April 1995 County Digital Orthophotos and/or U.S.G.S. 1:24,000 scale Topographic series. The user is responsible for the improper use of the data contained herein.

Created by The Columbia County Land Information Office -GIS Section. VMB.
September 2002.


TAX PARCEL MAP

TOWN of LEWISTON

TOWN 13 NORTH RANGE 8 EAST
COLUMBIA COUNTY, WISCONSIN

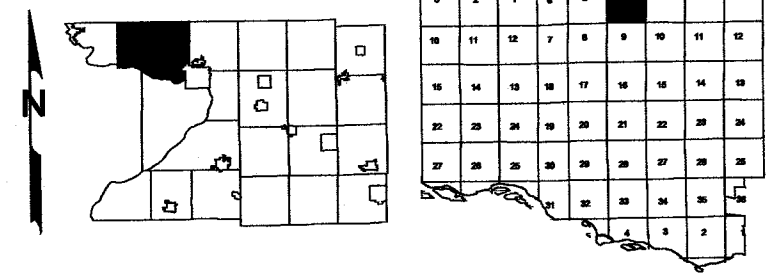

Replaced
2005

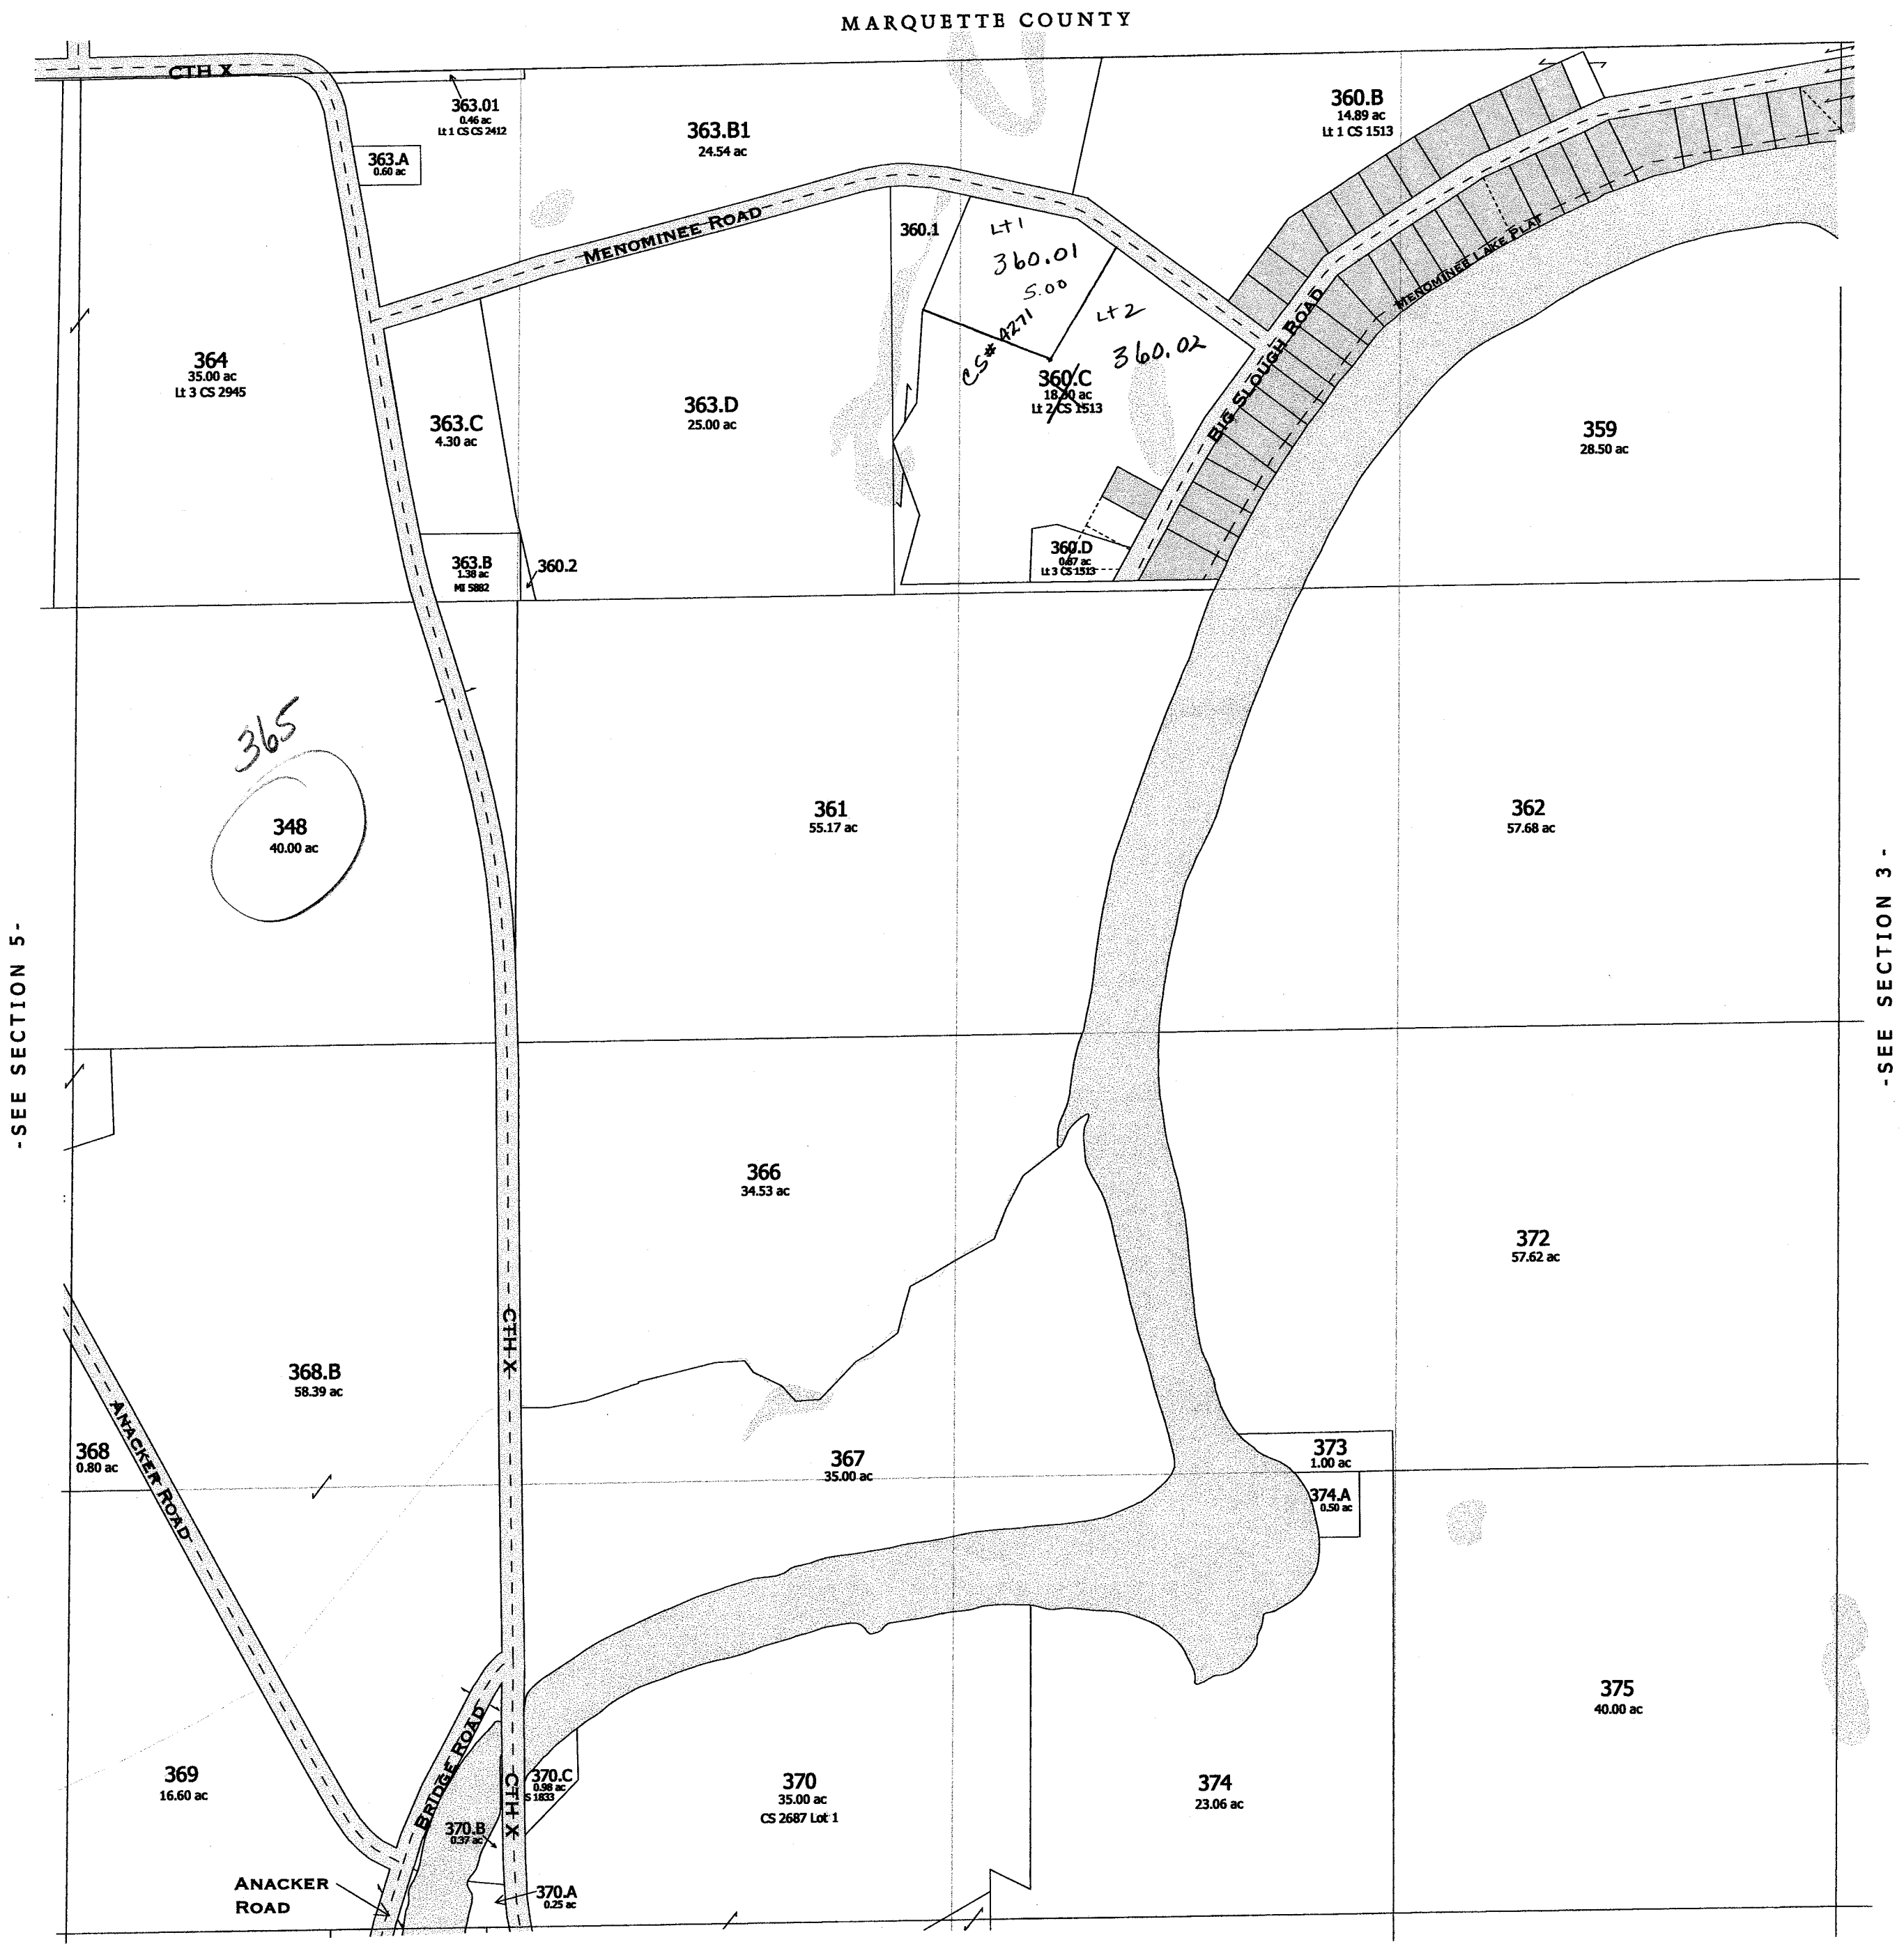

-SEE SECTION 5-

-SEE SECTION 3-

-SEE SECTION 9-

-SEE THE FOLLOWING PAGE FOR DETAILED MAP OF SUBDIVISION-



-SECTION 4-

2005

SEC. 4 & Part of SEC. 3

Replaced
2002


MENOMINEE
LAKE
PLAT

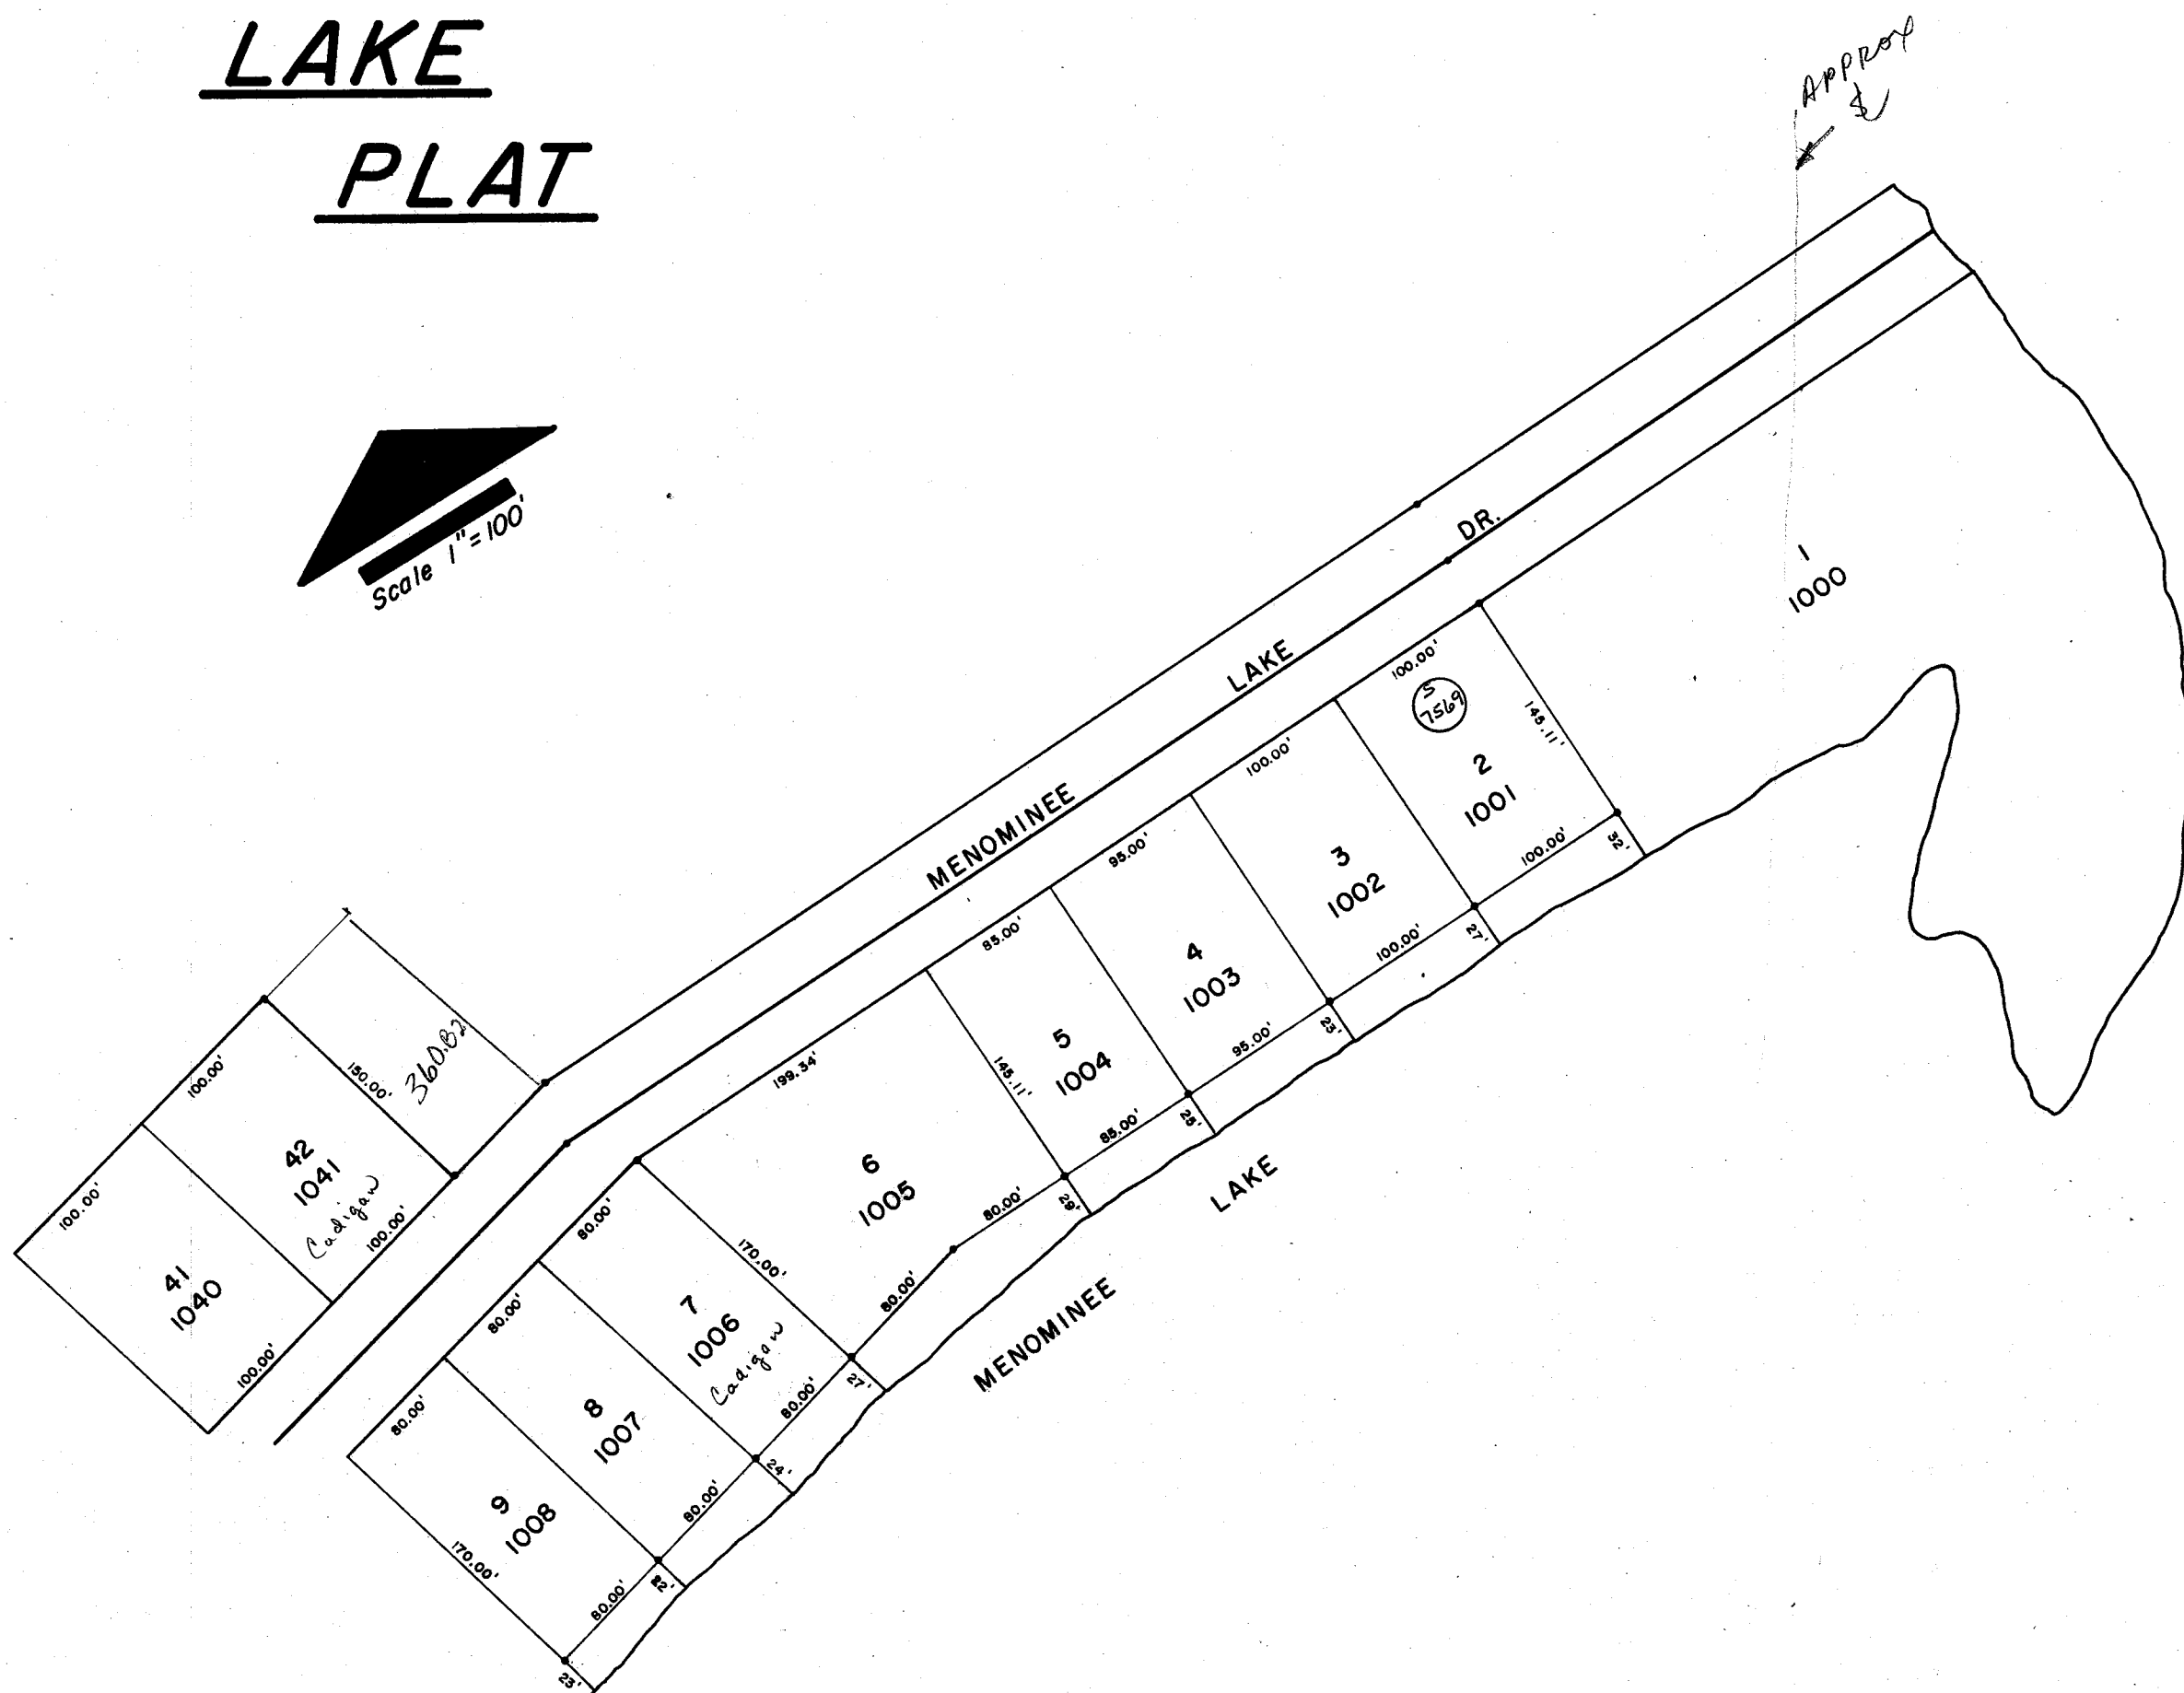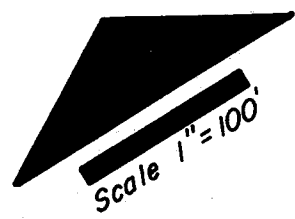

SEC. 4 T13N R8E

Scale 1"=100'

LAKE
PLAT

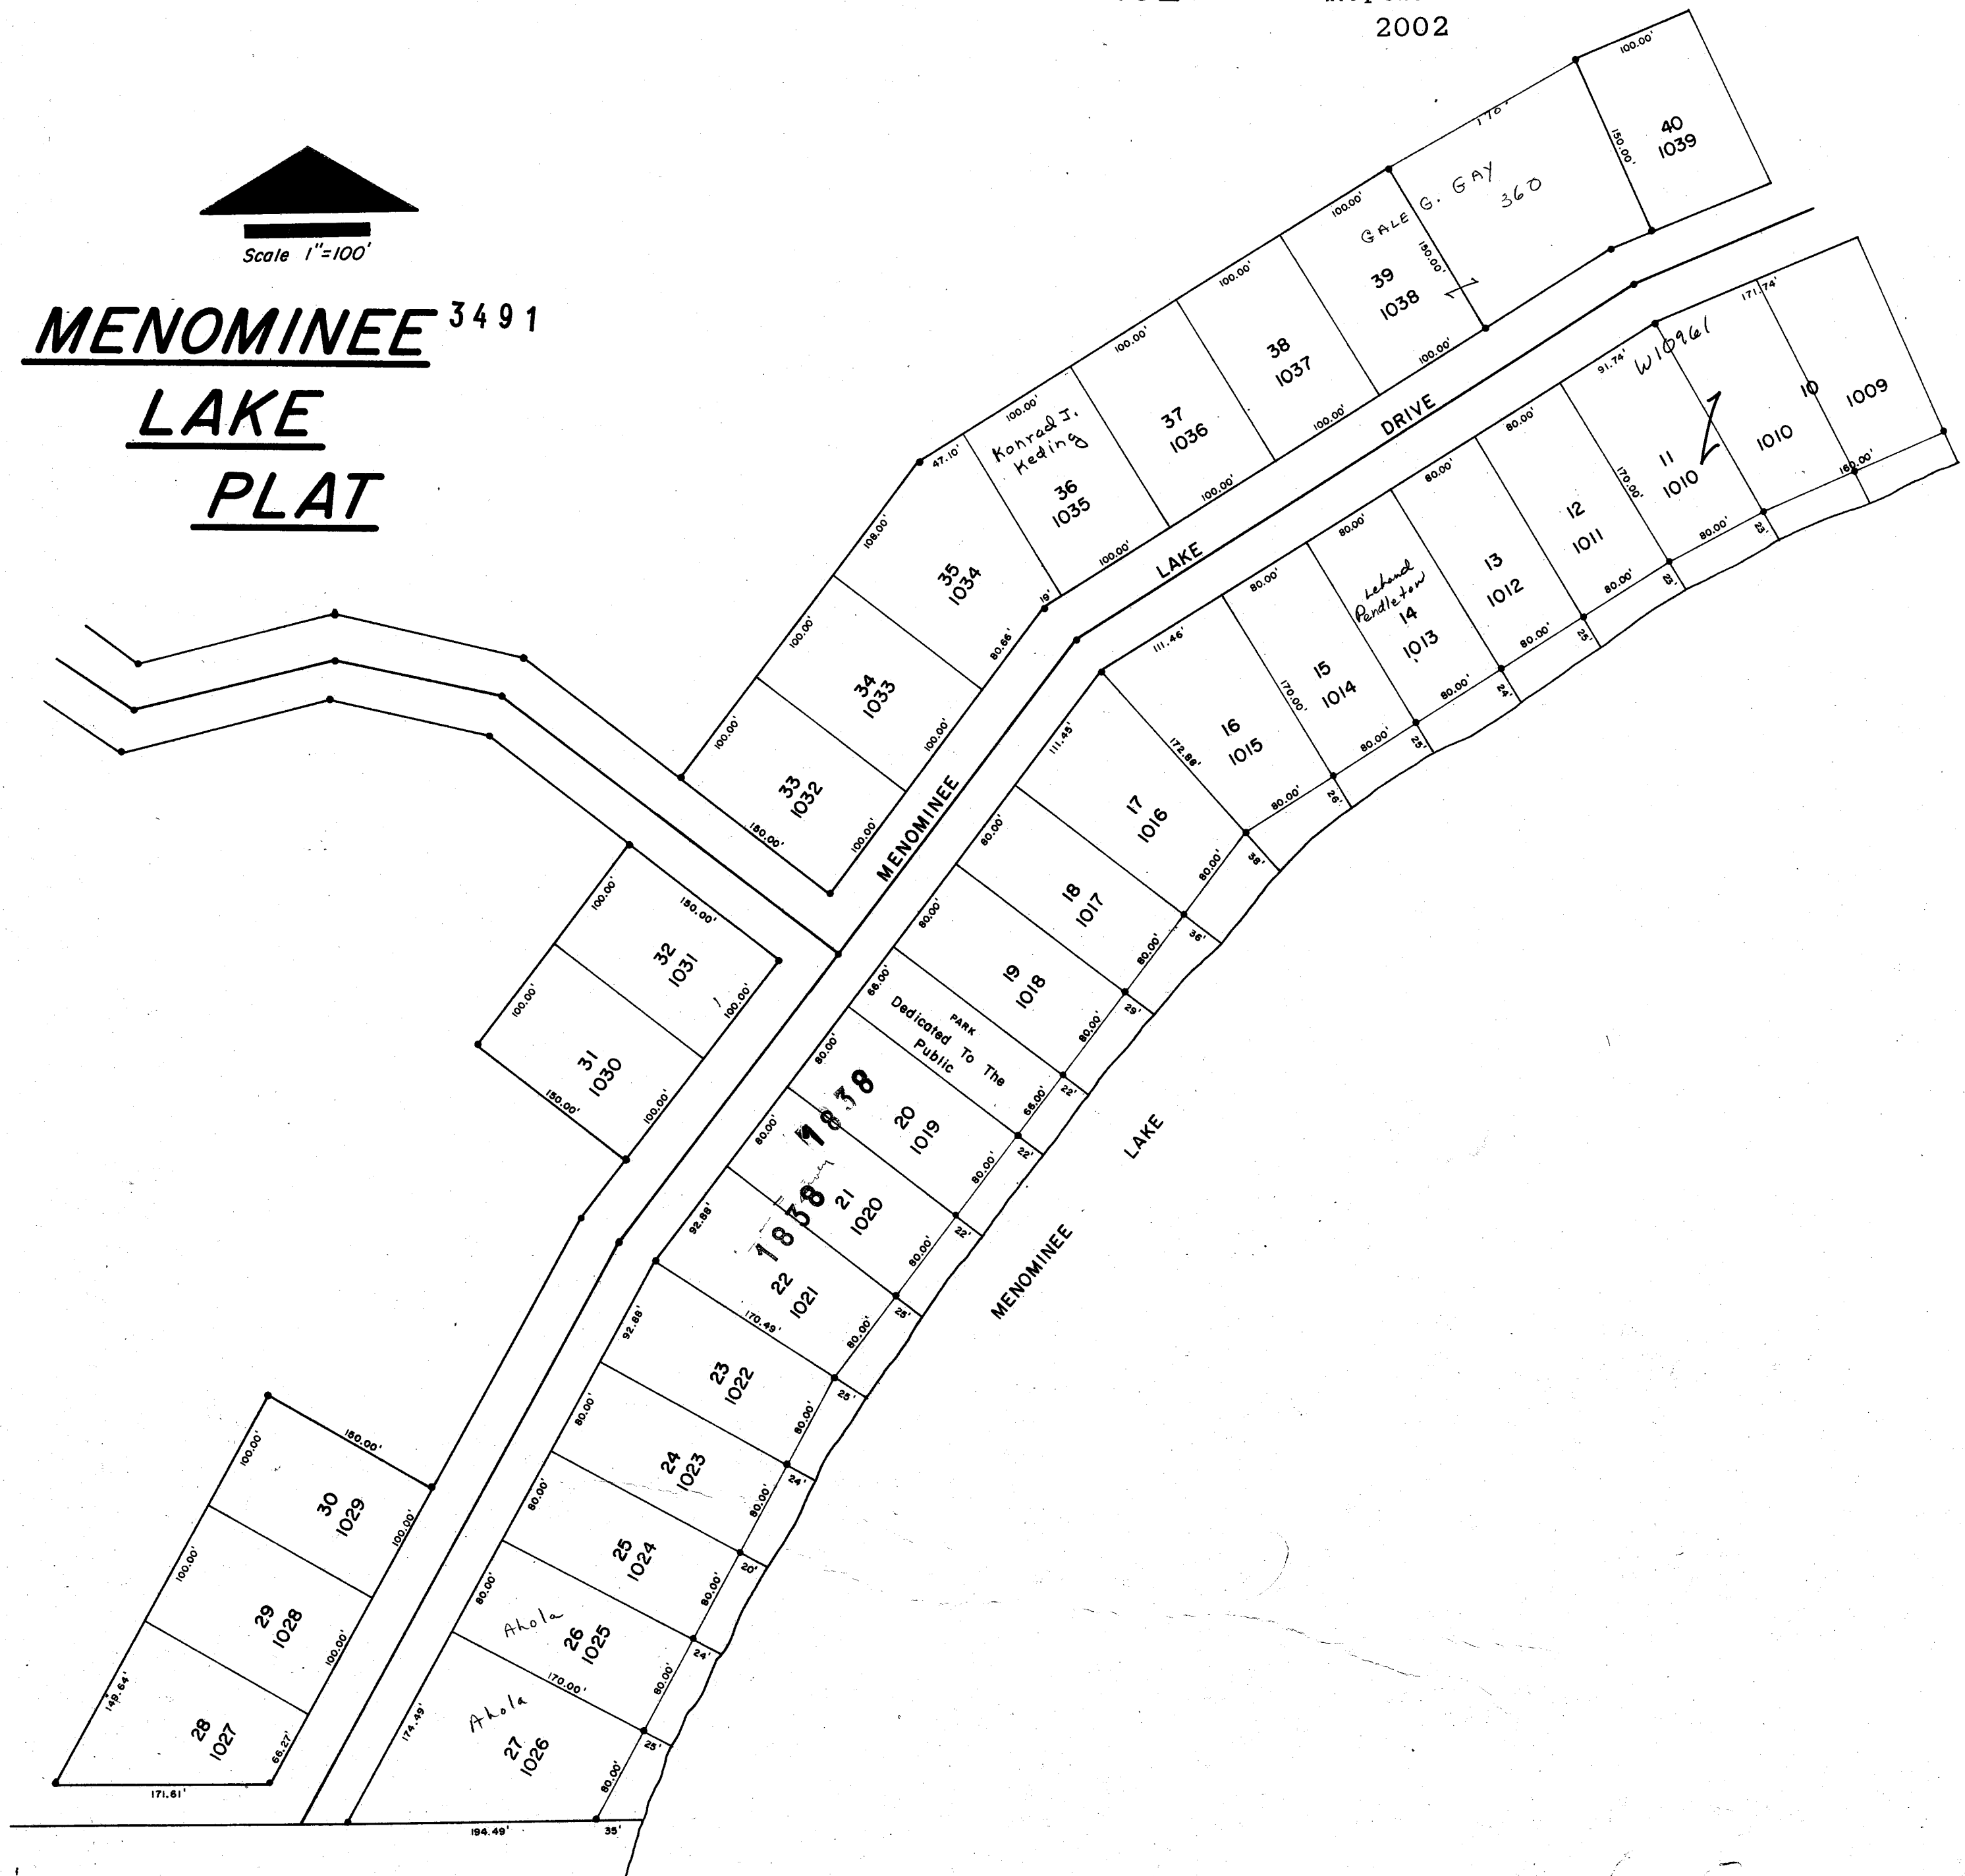


LEWISTON
SEC. 5 T13N R8E

Replaced
2002

CS
2945

See Deed

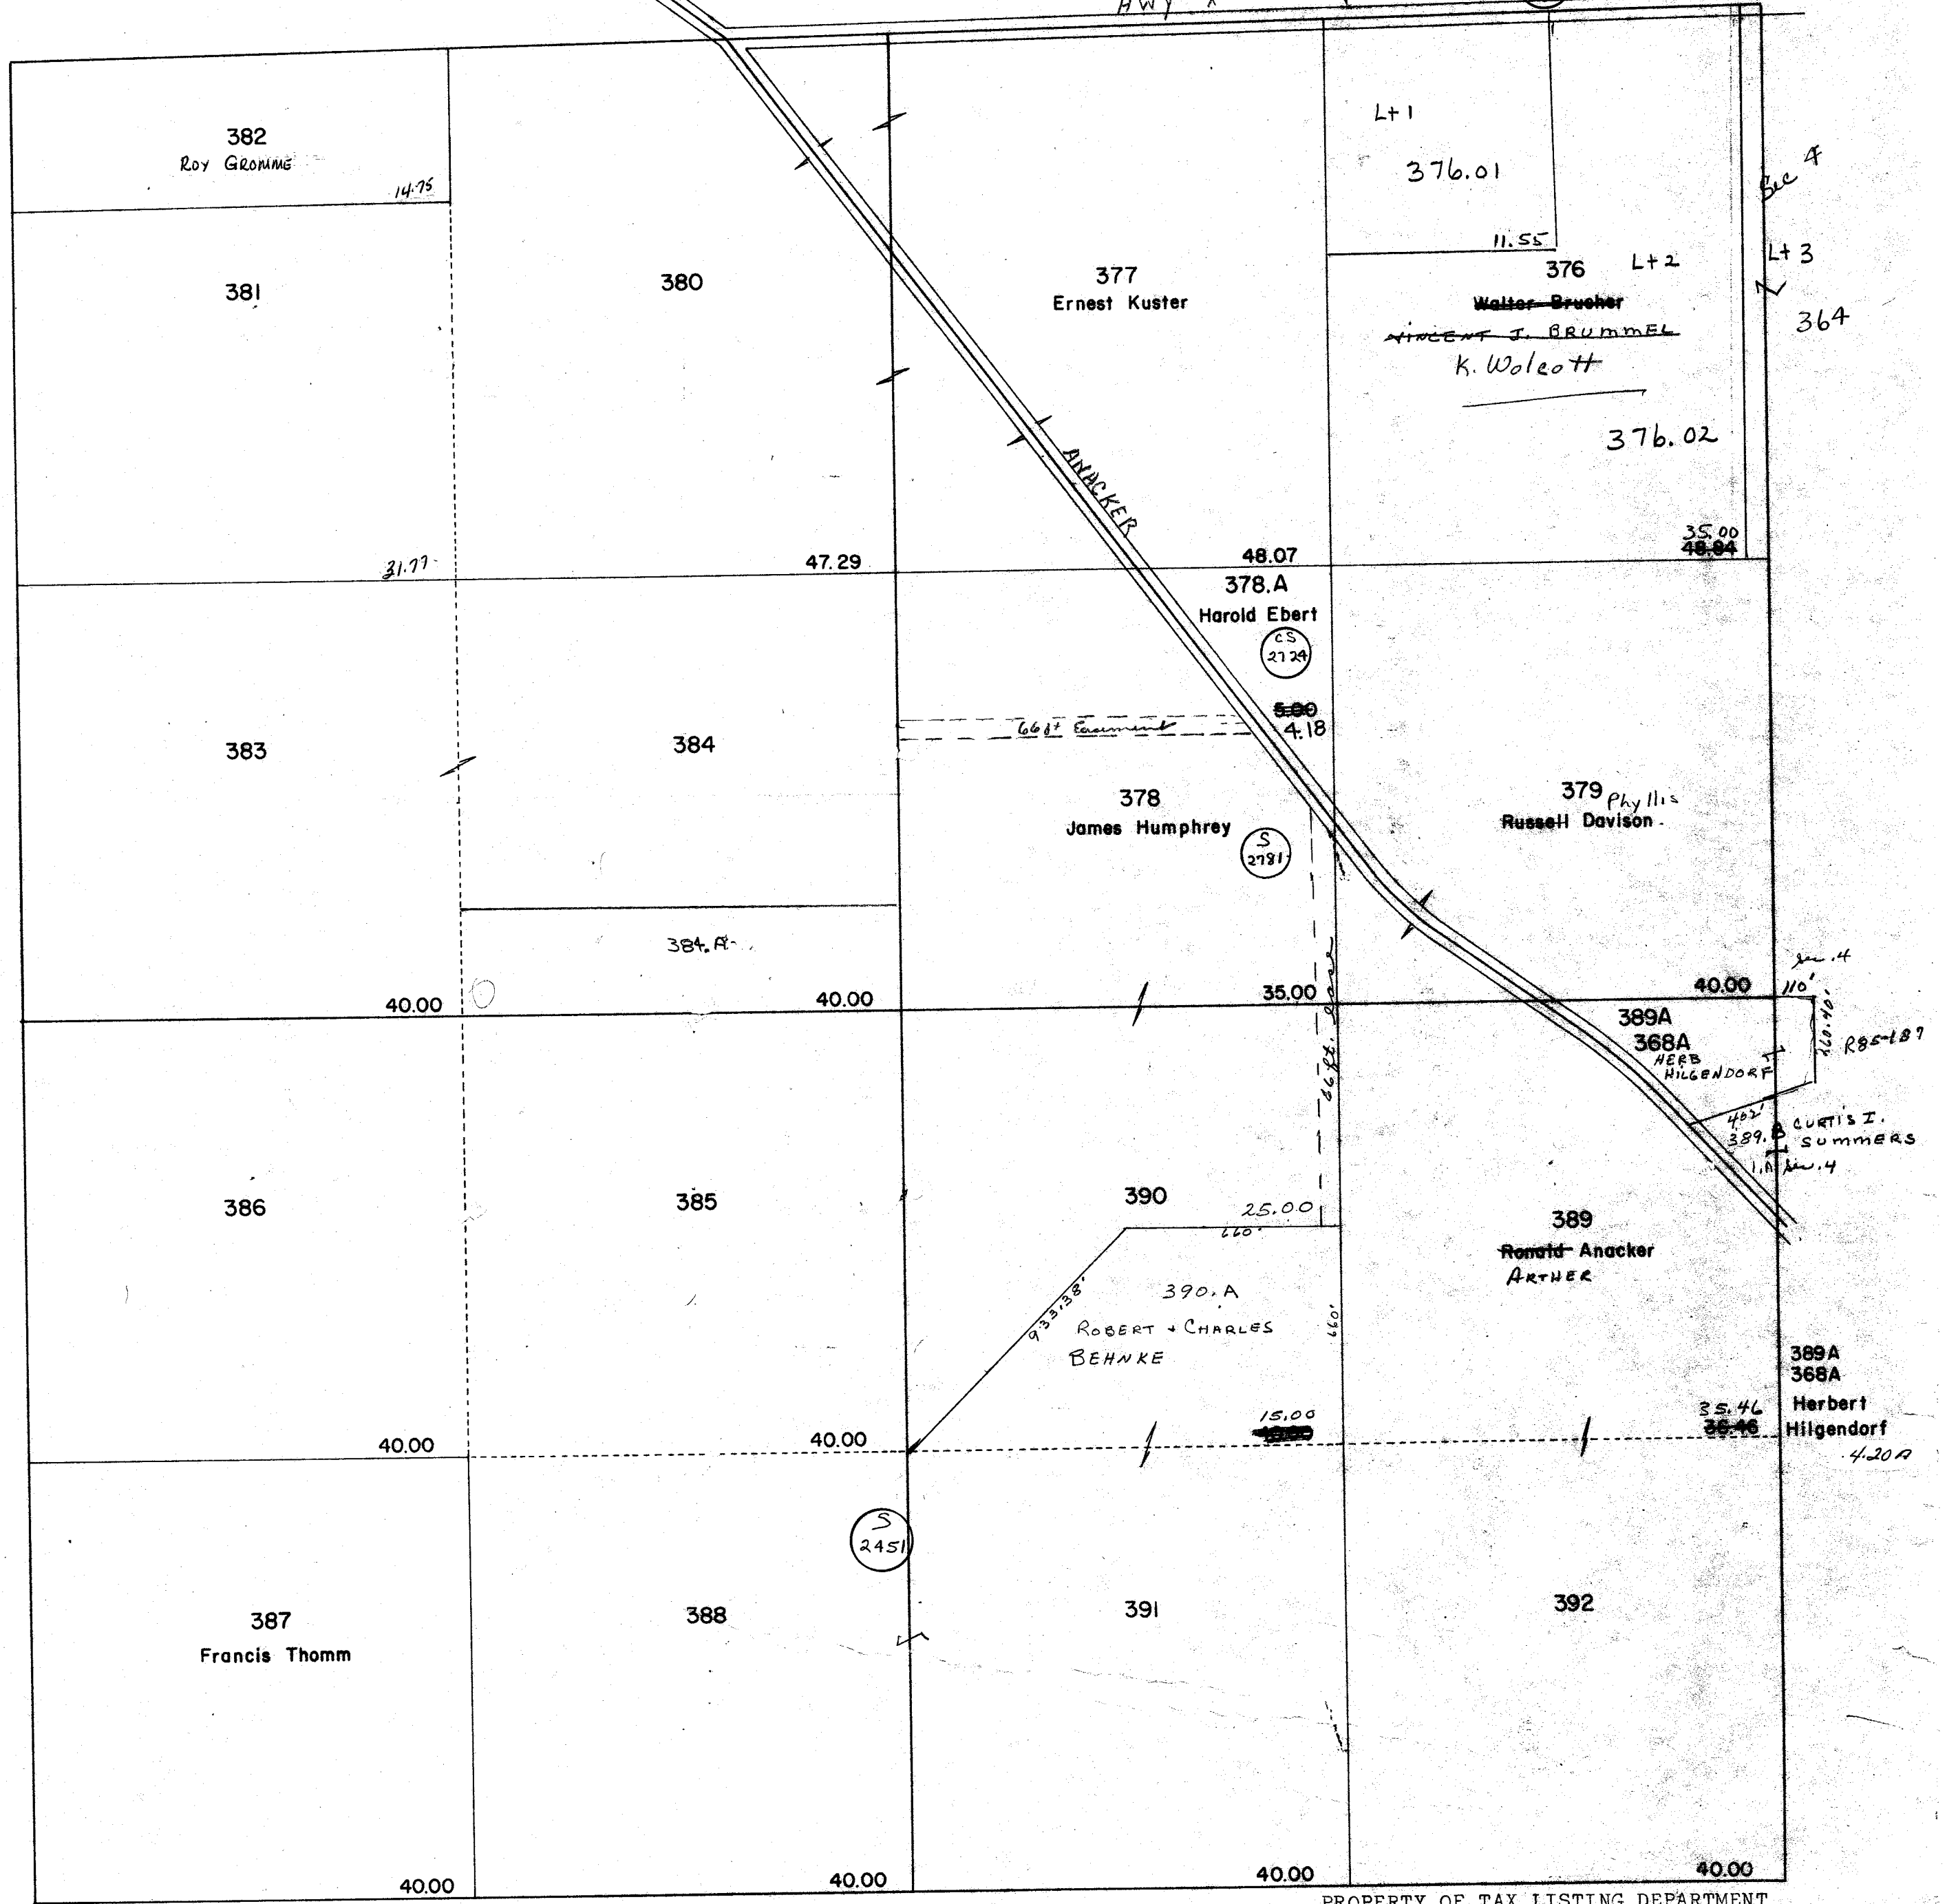

One Inch Equals Four Hundred Feet

MILES
0 1/16 1/8 1/4

FEET
0 400 800 1200 1600


NOTE: This map was prepared for assessment use in accordance with the Wis. Stat. Chap. 70.09. All information contained herein is advisory only. Map accuracy is limited to the quality of data obtained from other Public Records. This map is not intended to be a substitute for an actual field survey. Public Land Survey Base is derived from U.S.G.S. Topographic maps unless otherwise noted. Other sources of the Land Base may be actual survey data. Base map data is from the April 1995 County Digital Orthophotos and/or U.S.G.S. 1:24,000 scale Topographic series. The user is responsible for the improper use of the data contained herein.

Created by The Columbia County Land Information Office -GIS Section. VMB.
September 2002.


TAX PARCEL MAP

TOWN of LEWISTON

TOWN 13 NORTH RANGE 8 EAST
COLUMBIA COUNTY, WISCONSIN

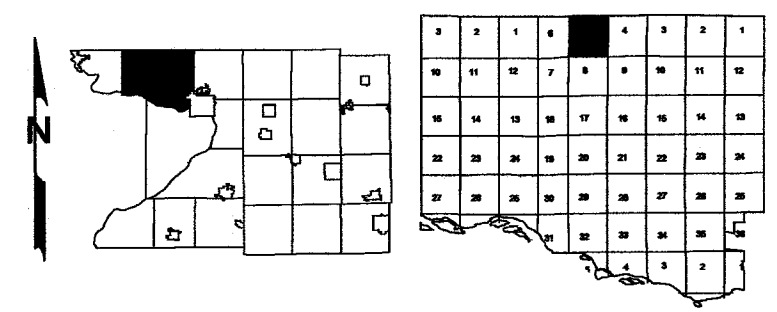

Replaced
2006

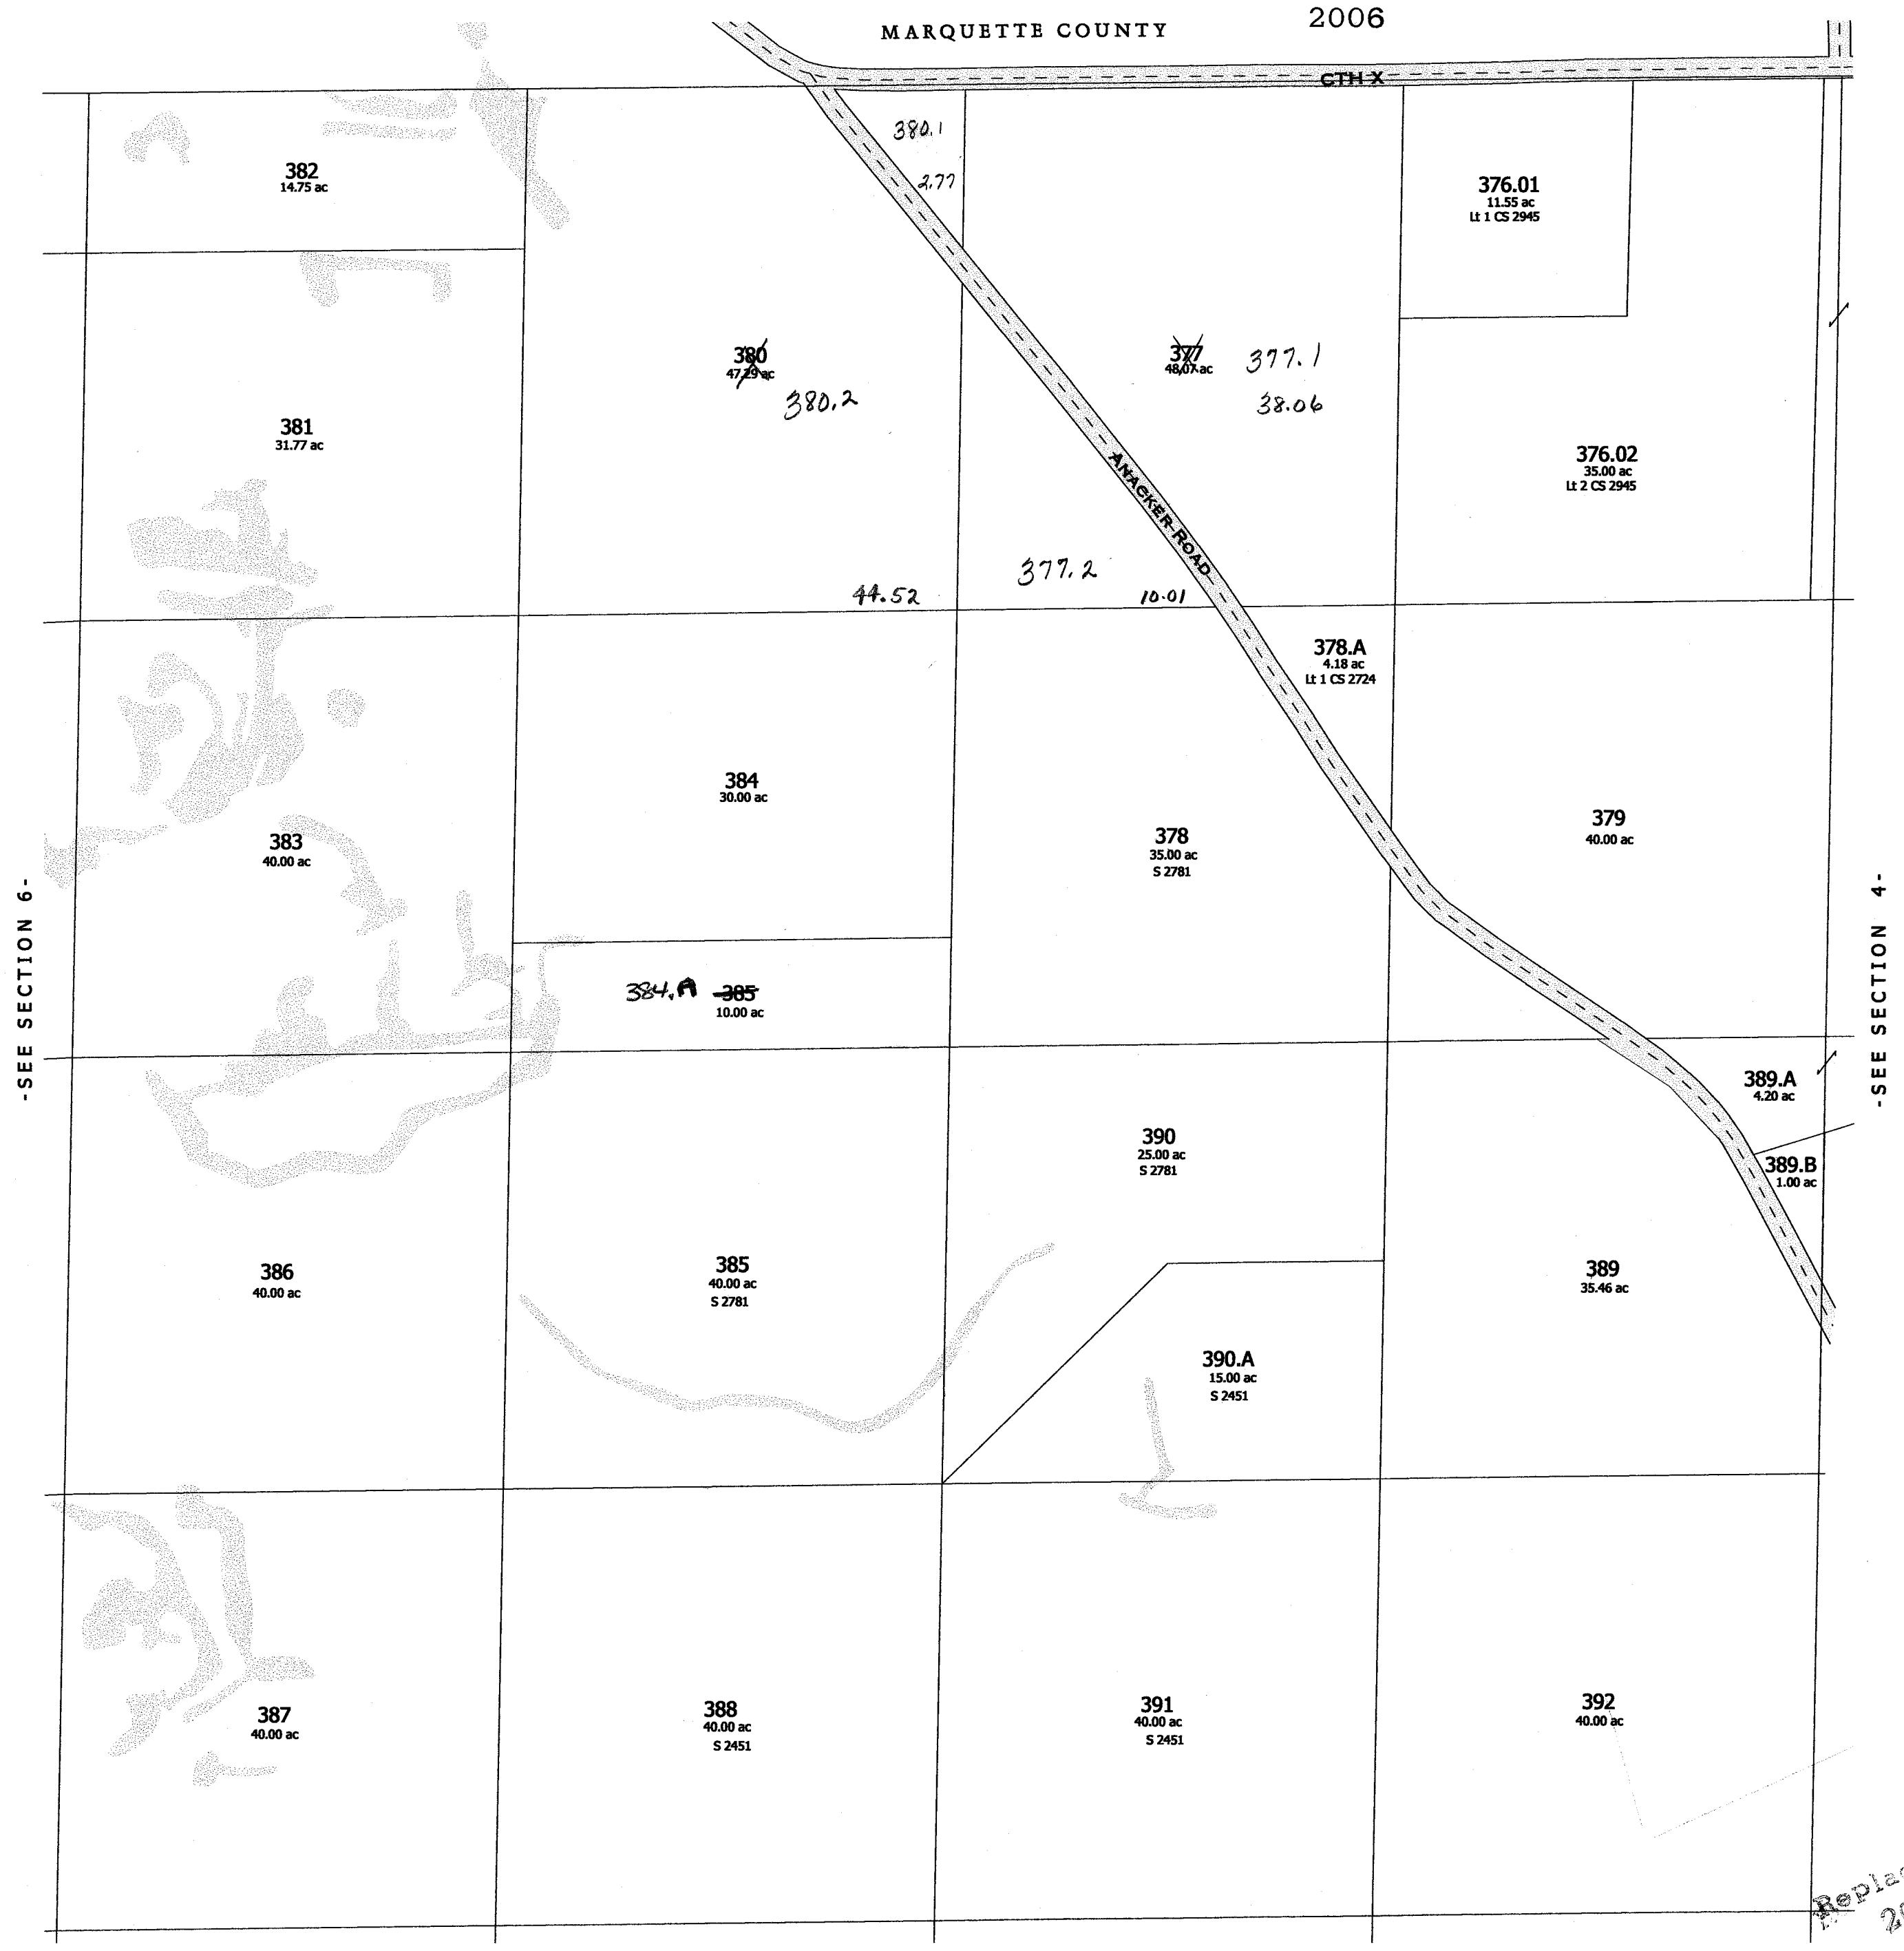



-SEE SECTION 8-

Replaced
2006

-SECTION 5-

Replaced
2002


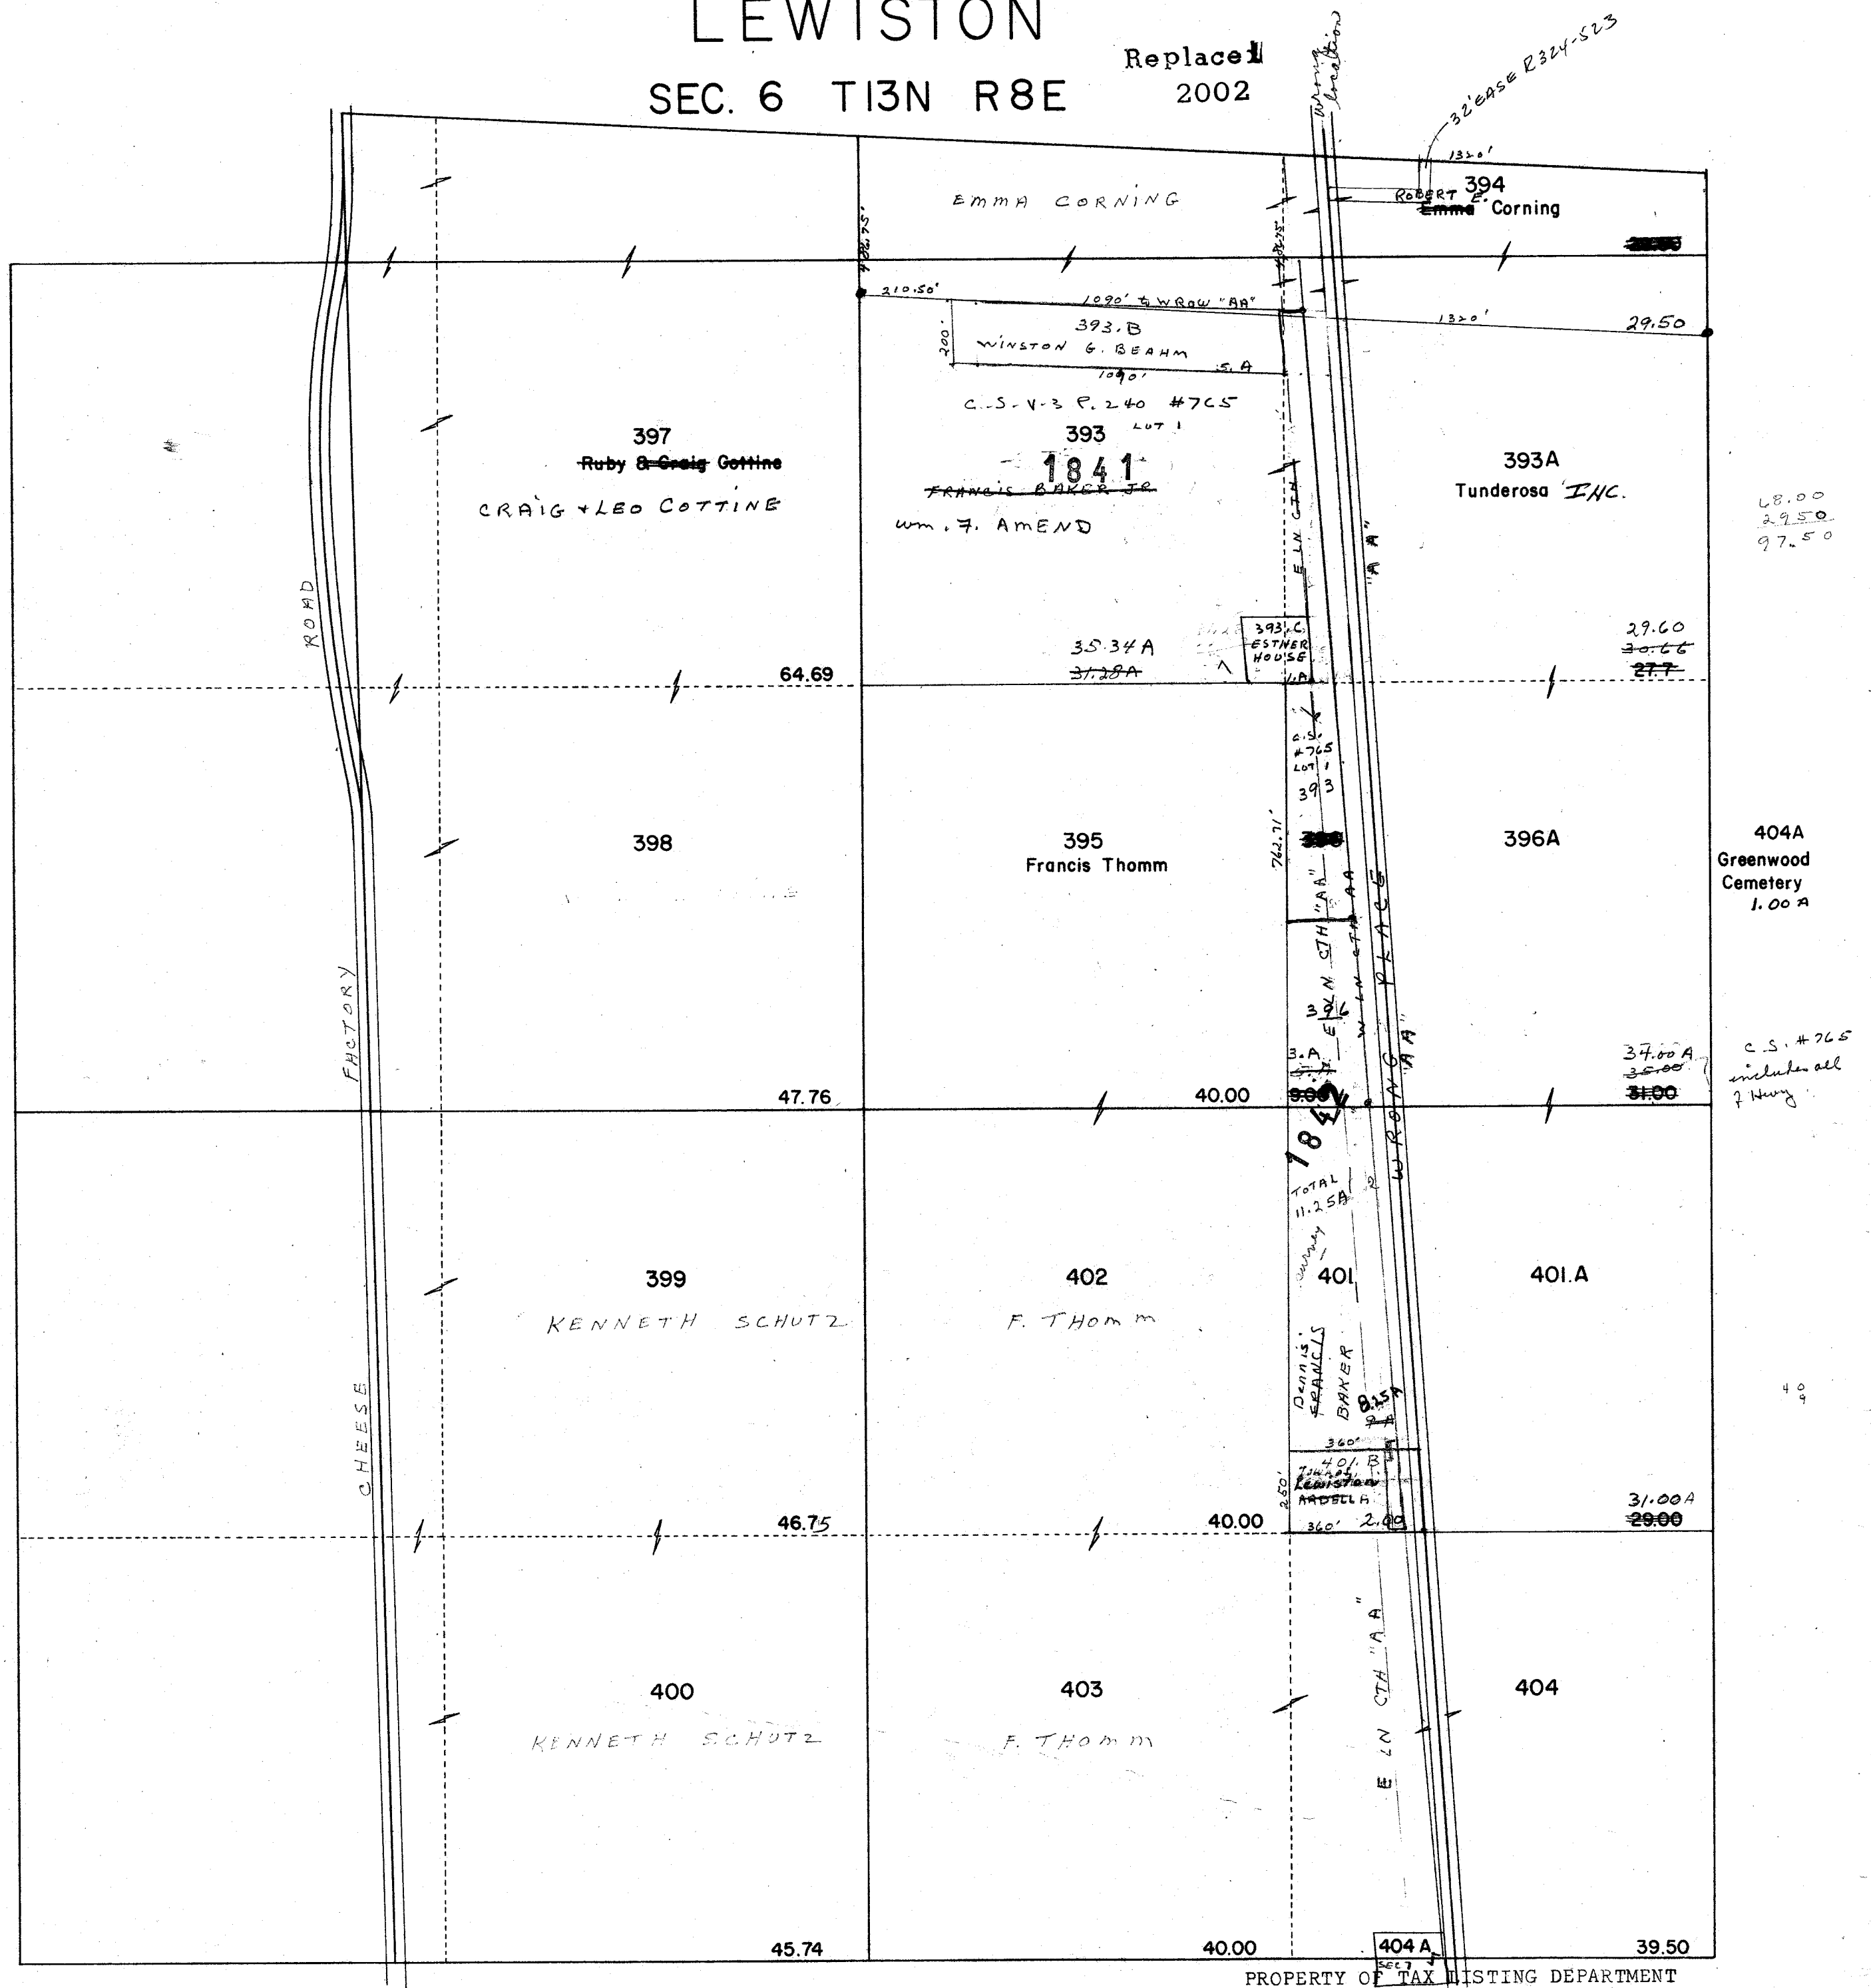


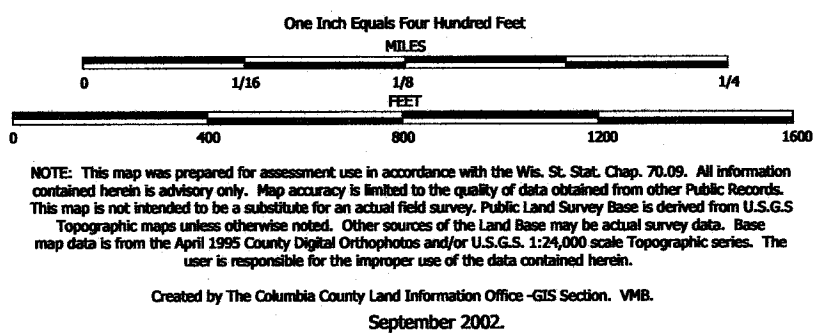

TAX PARCEL MAP

TOWN of LEWISTON

TOWN 13 NORTH RANGE 8 EAST
COLUMBIA COUNTY, WISCONSIN

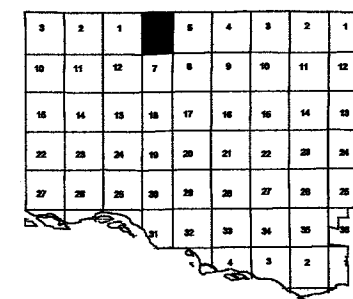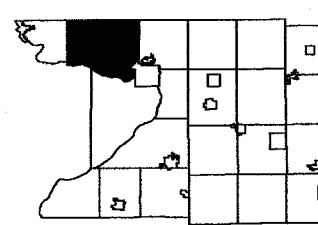

Replaced

2006

MARQUETTE COUNTY




-SEE SECTION 7-


Replaced
2006

-SECTION 6-

LEWISTON
SEC. 7 T13N R8E

Replaced
2002

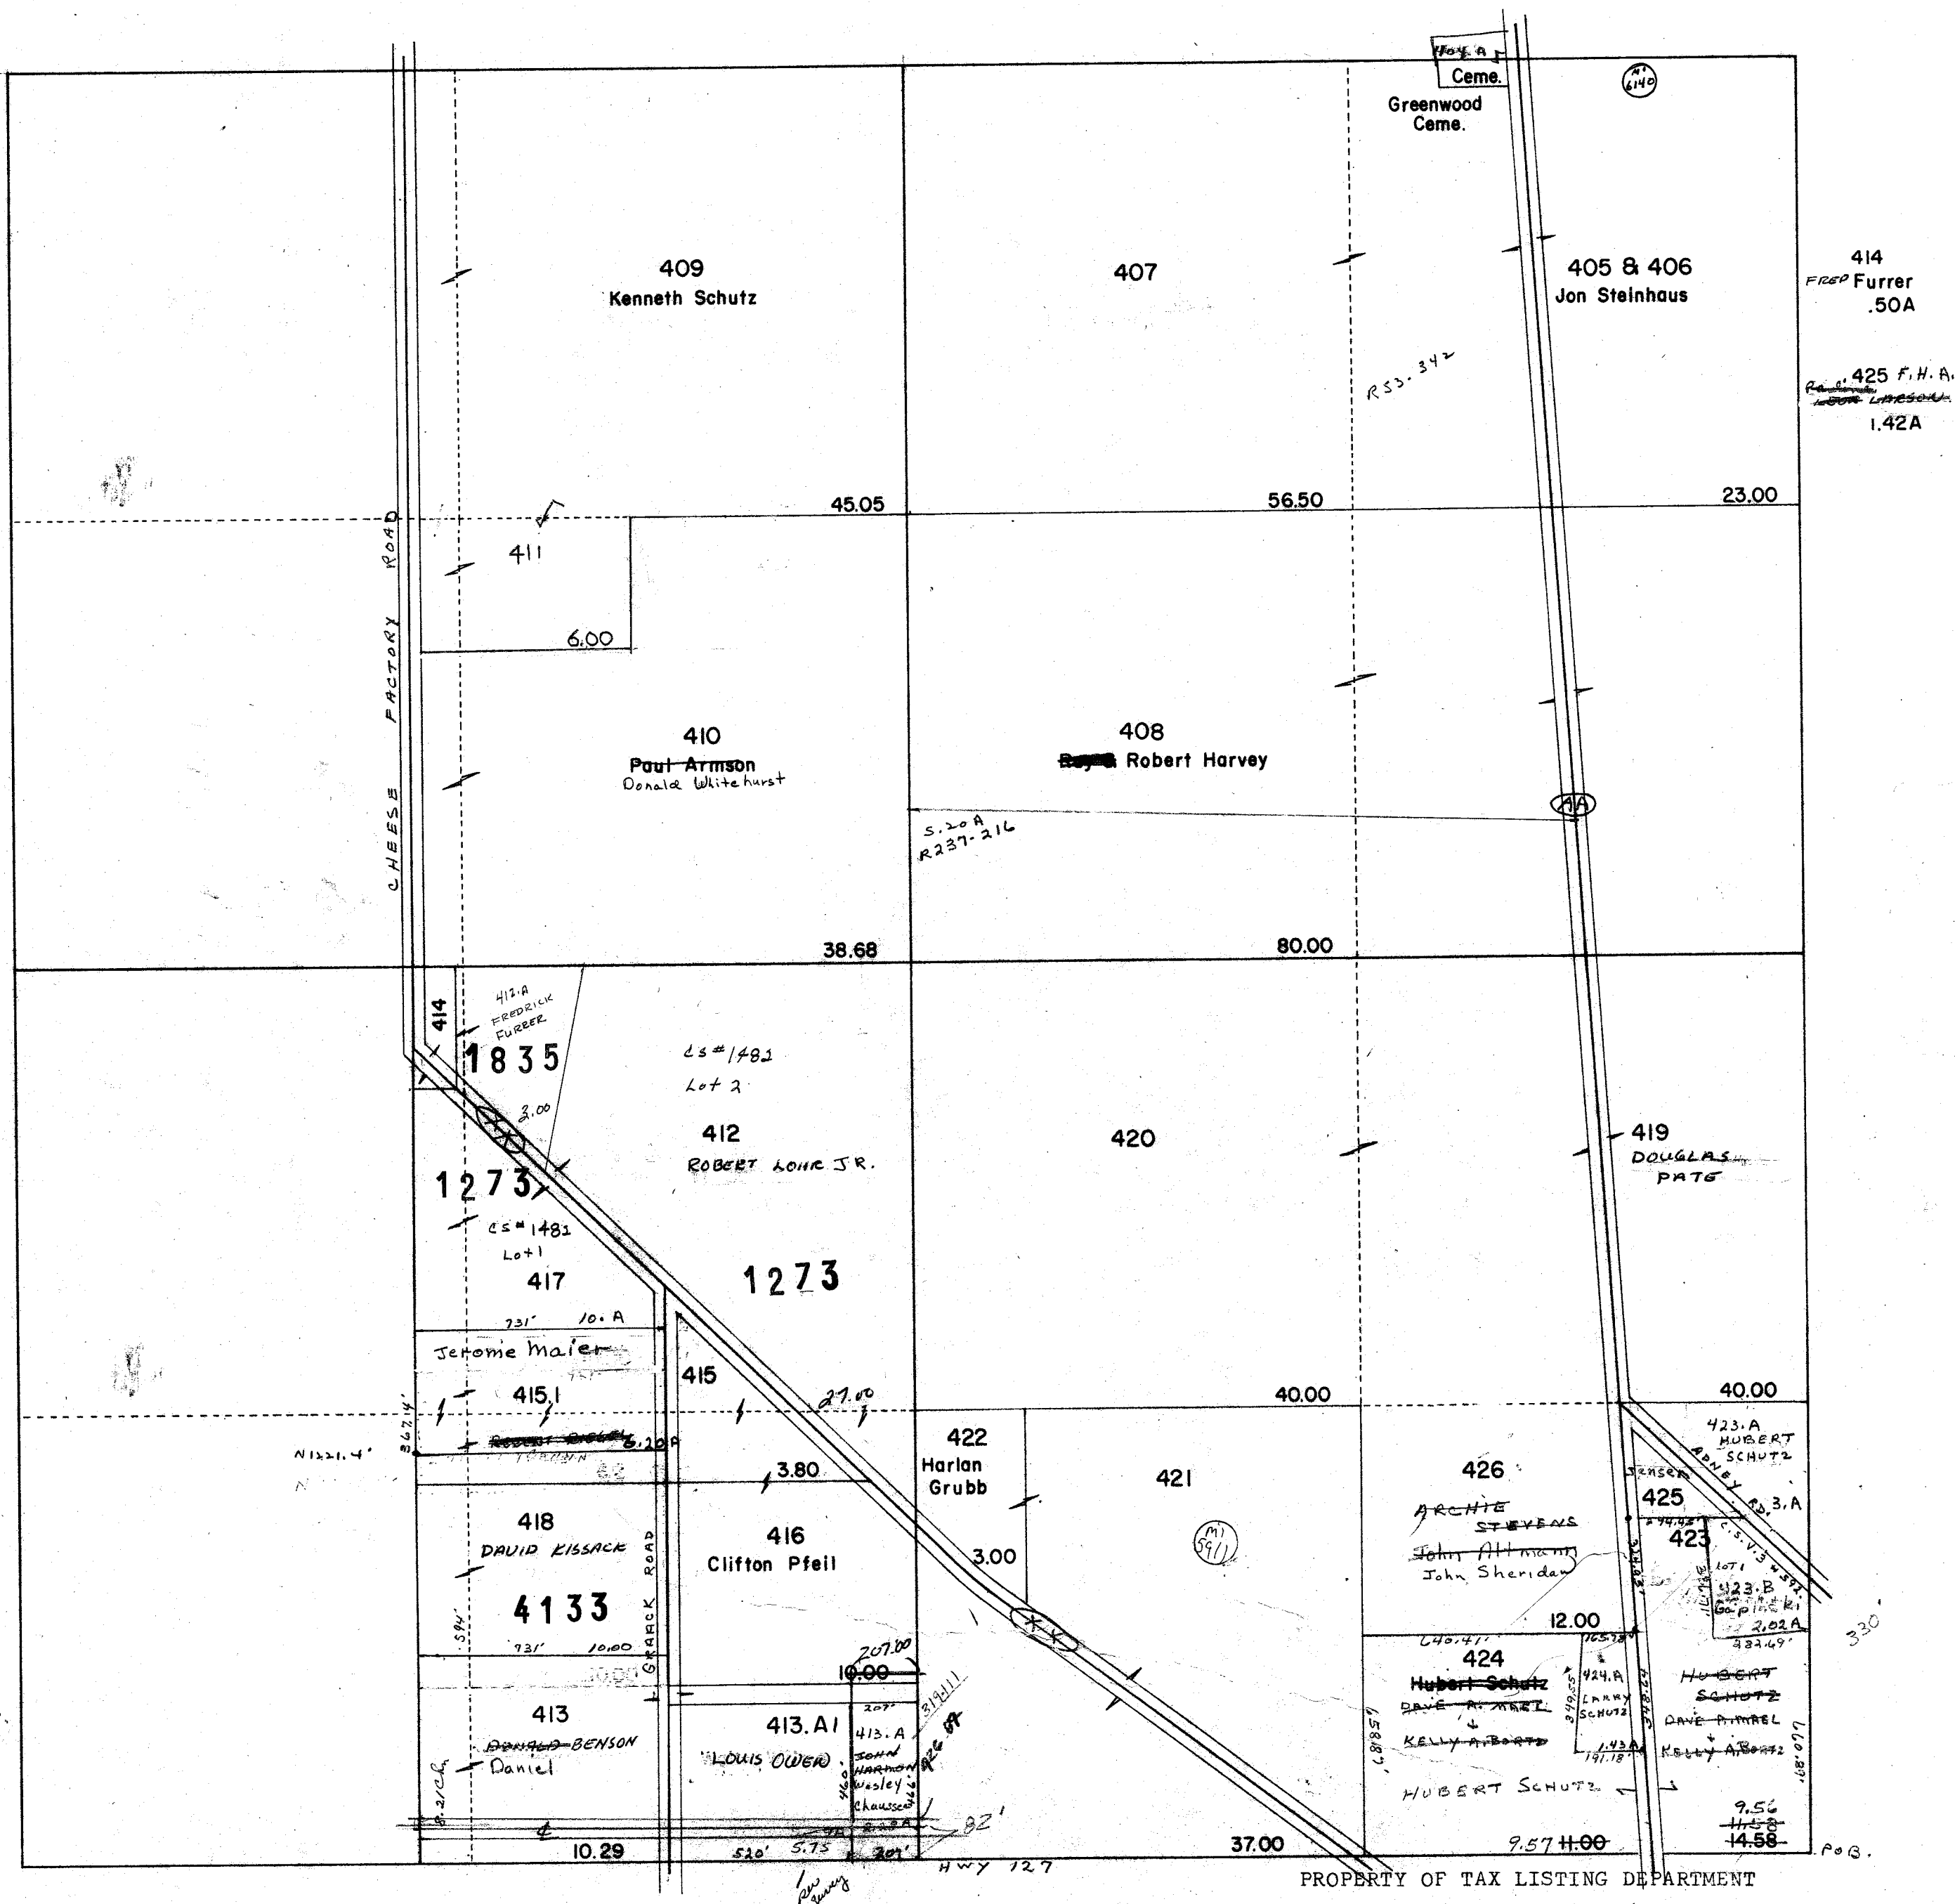


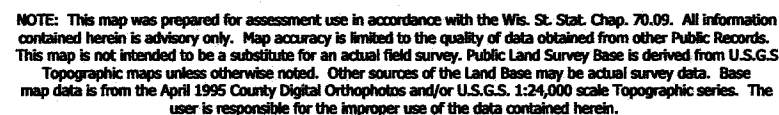

Created by The Columbia County Land Information Office -GIS Section. VMB.
September 2002.

TOWN of LEWISTON


TOWN 13 NORTH RANGE 8 EAST
COLUMBIA COUNTY, WISCONSIN

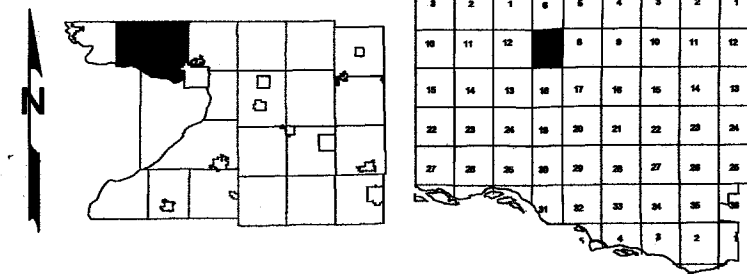

Replaced


2005

-SEE SECTION 6-

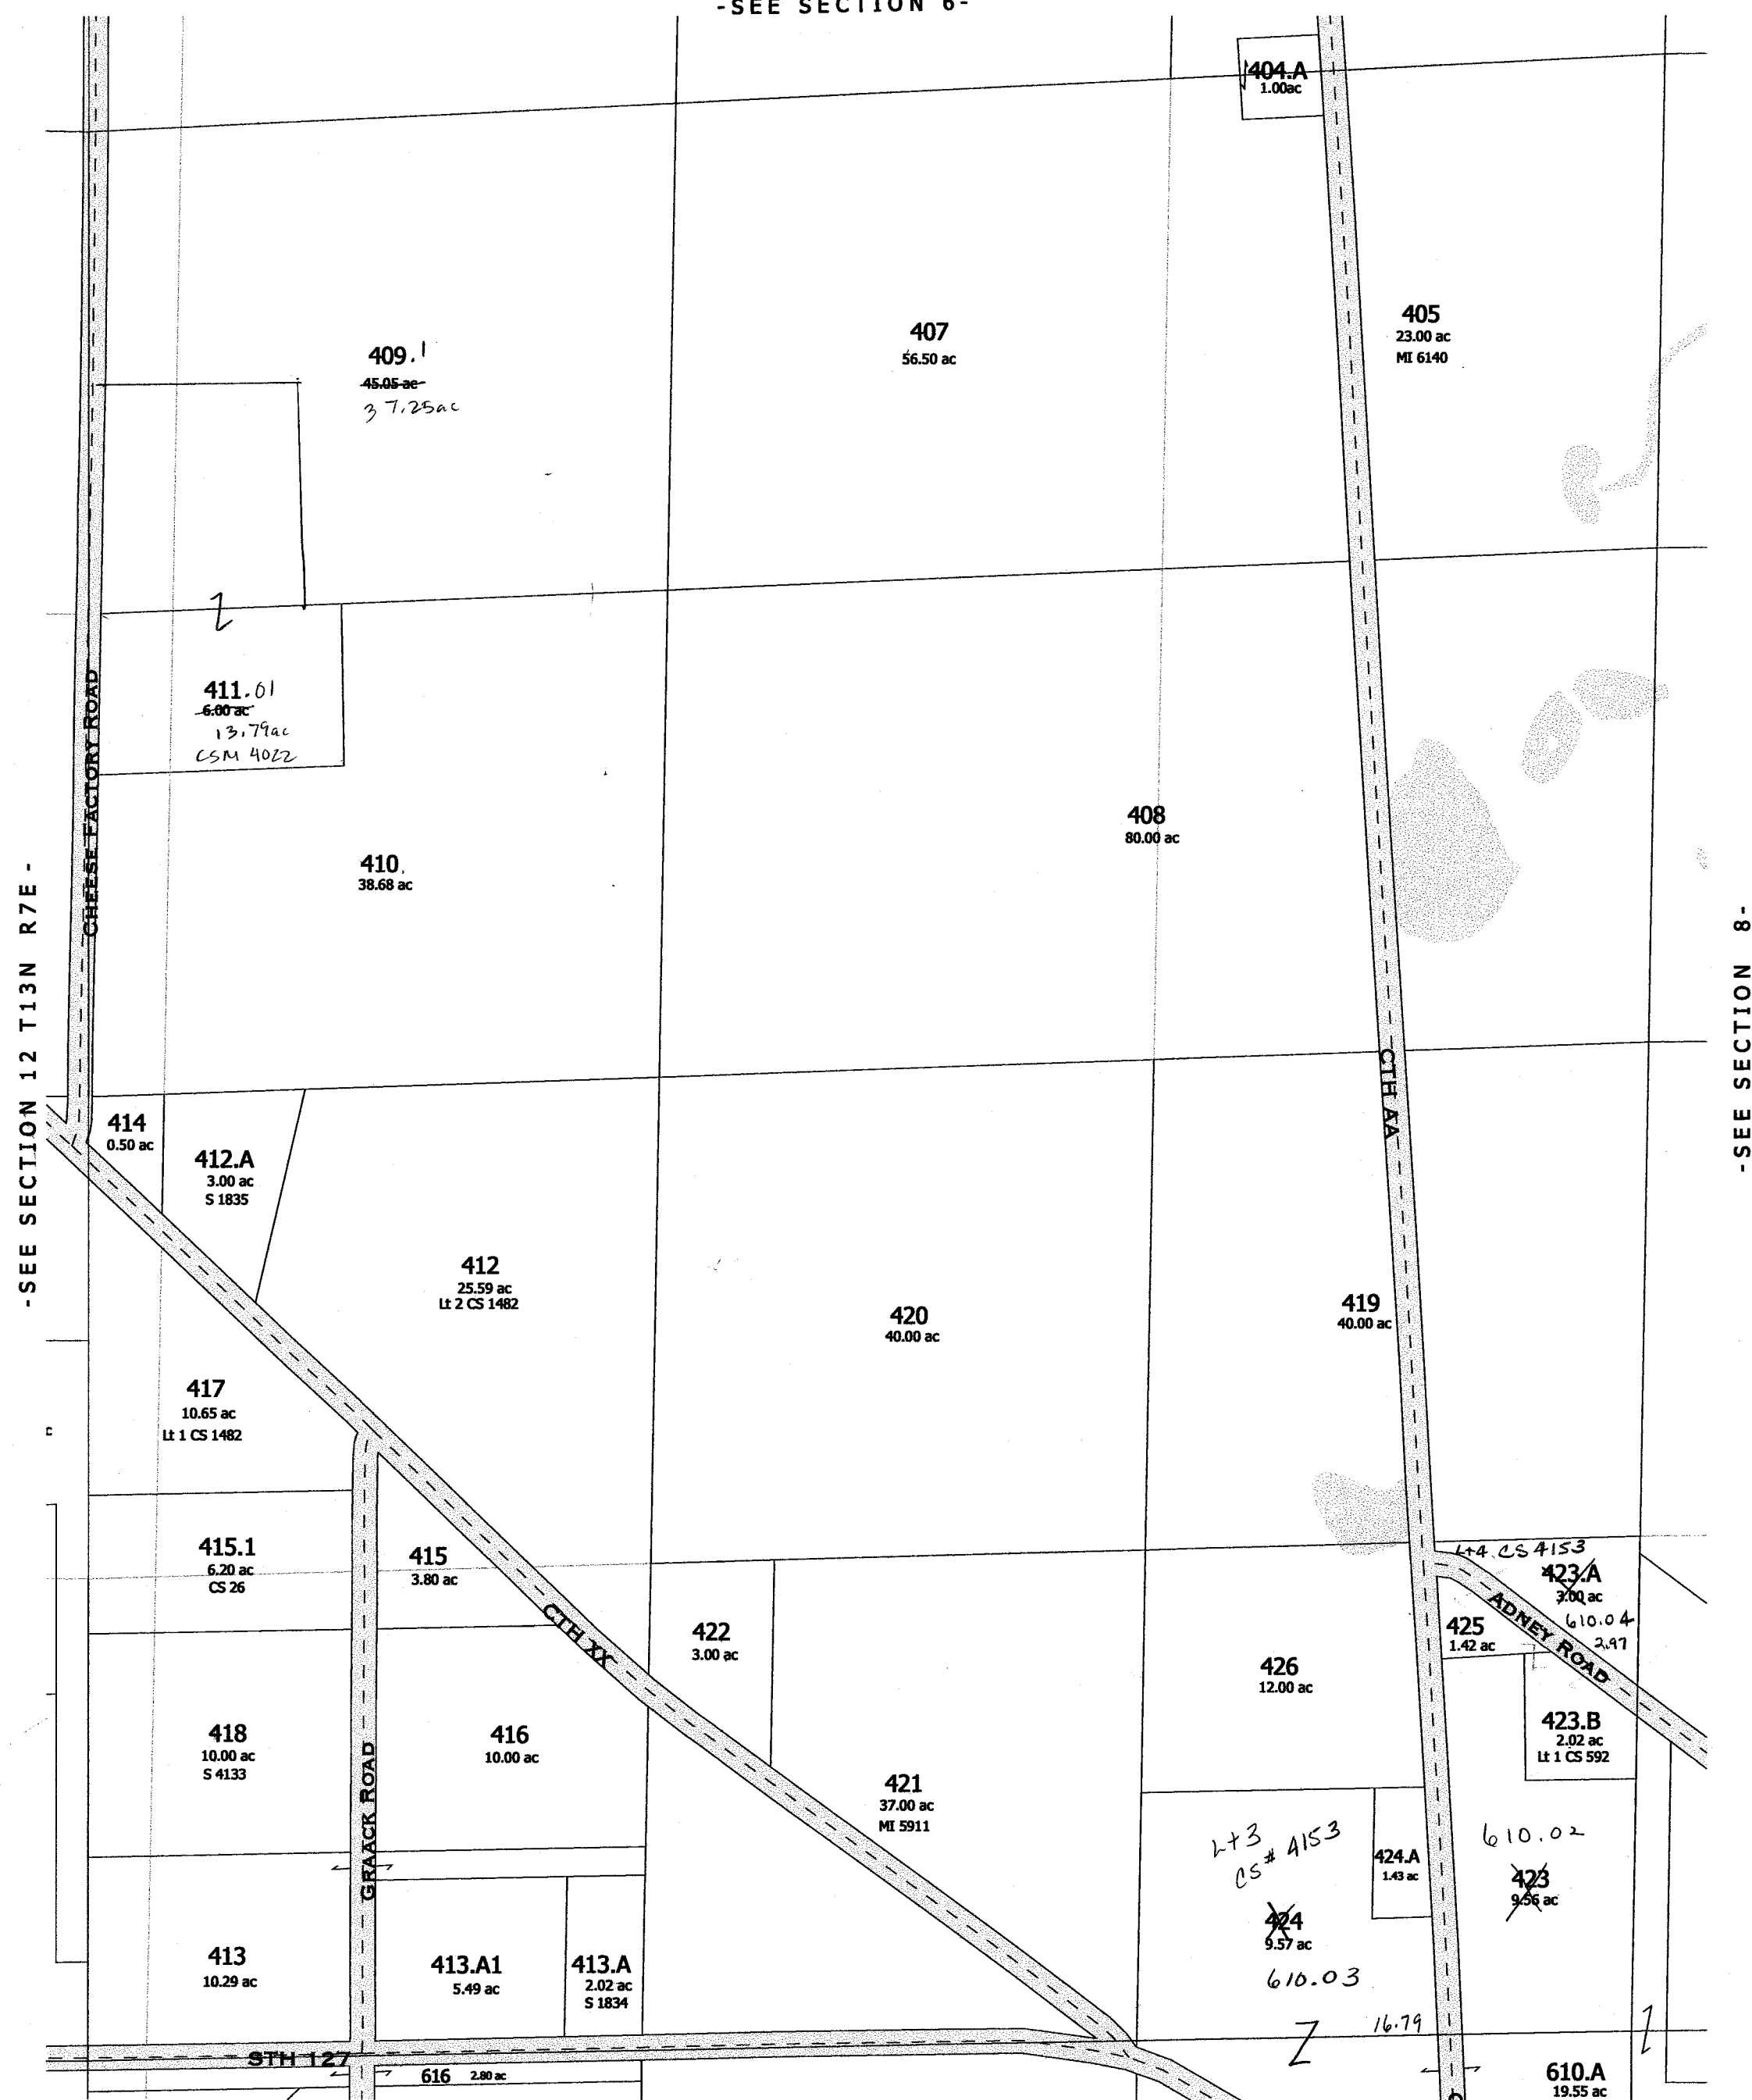

- SEE SECTION 18 -

-SECTION 7-

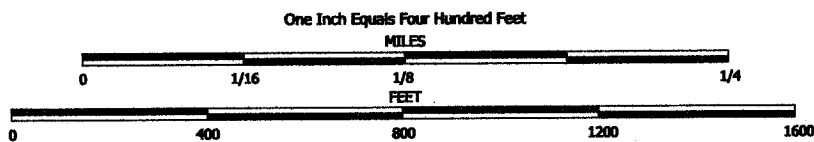



NOTE: This map was prepared for assessment use in accordance with the Wis. St. Stat. Chap. 70.09. All information contained herein is advisory only. Map accuracy is limited to the quality of data obtained from other Public Records. This map is not intended to be a substitute for an actual field survey. Public Land Survey Base is derived from U.S.G.S. Topographic maps unless otherwise noted. Other sources of the land base may be actual survey data. Base map data is from the April 1995 County Digital Orthophotos and/or U.S.G.S. 1:24,000 scale Topographic series. The user is responsible for the improper use of the data contained herein.

Created by The Columbia County Land Information Office -GIS Section. VMB.
February 2005.

TAX PARCEL MAP


TOWN of LEWISTON

TOWN 13 NORTH RANGE 8 EAST
COLUMBIA COUNTY, WISCONSIN

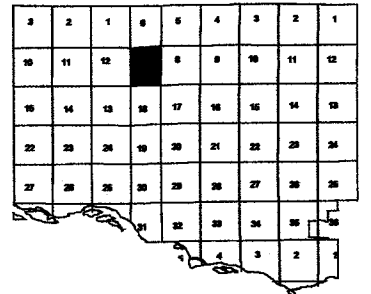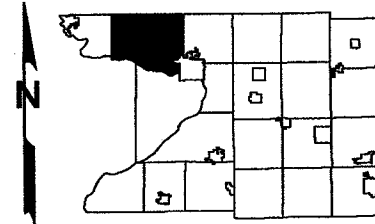

Replaced

2006

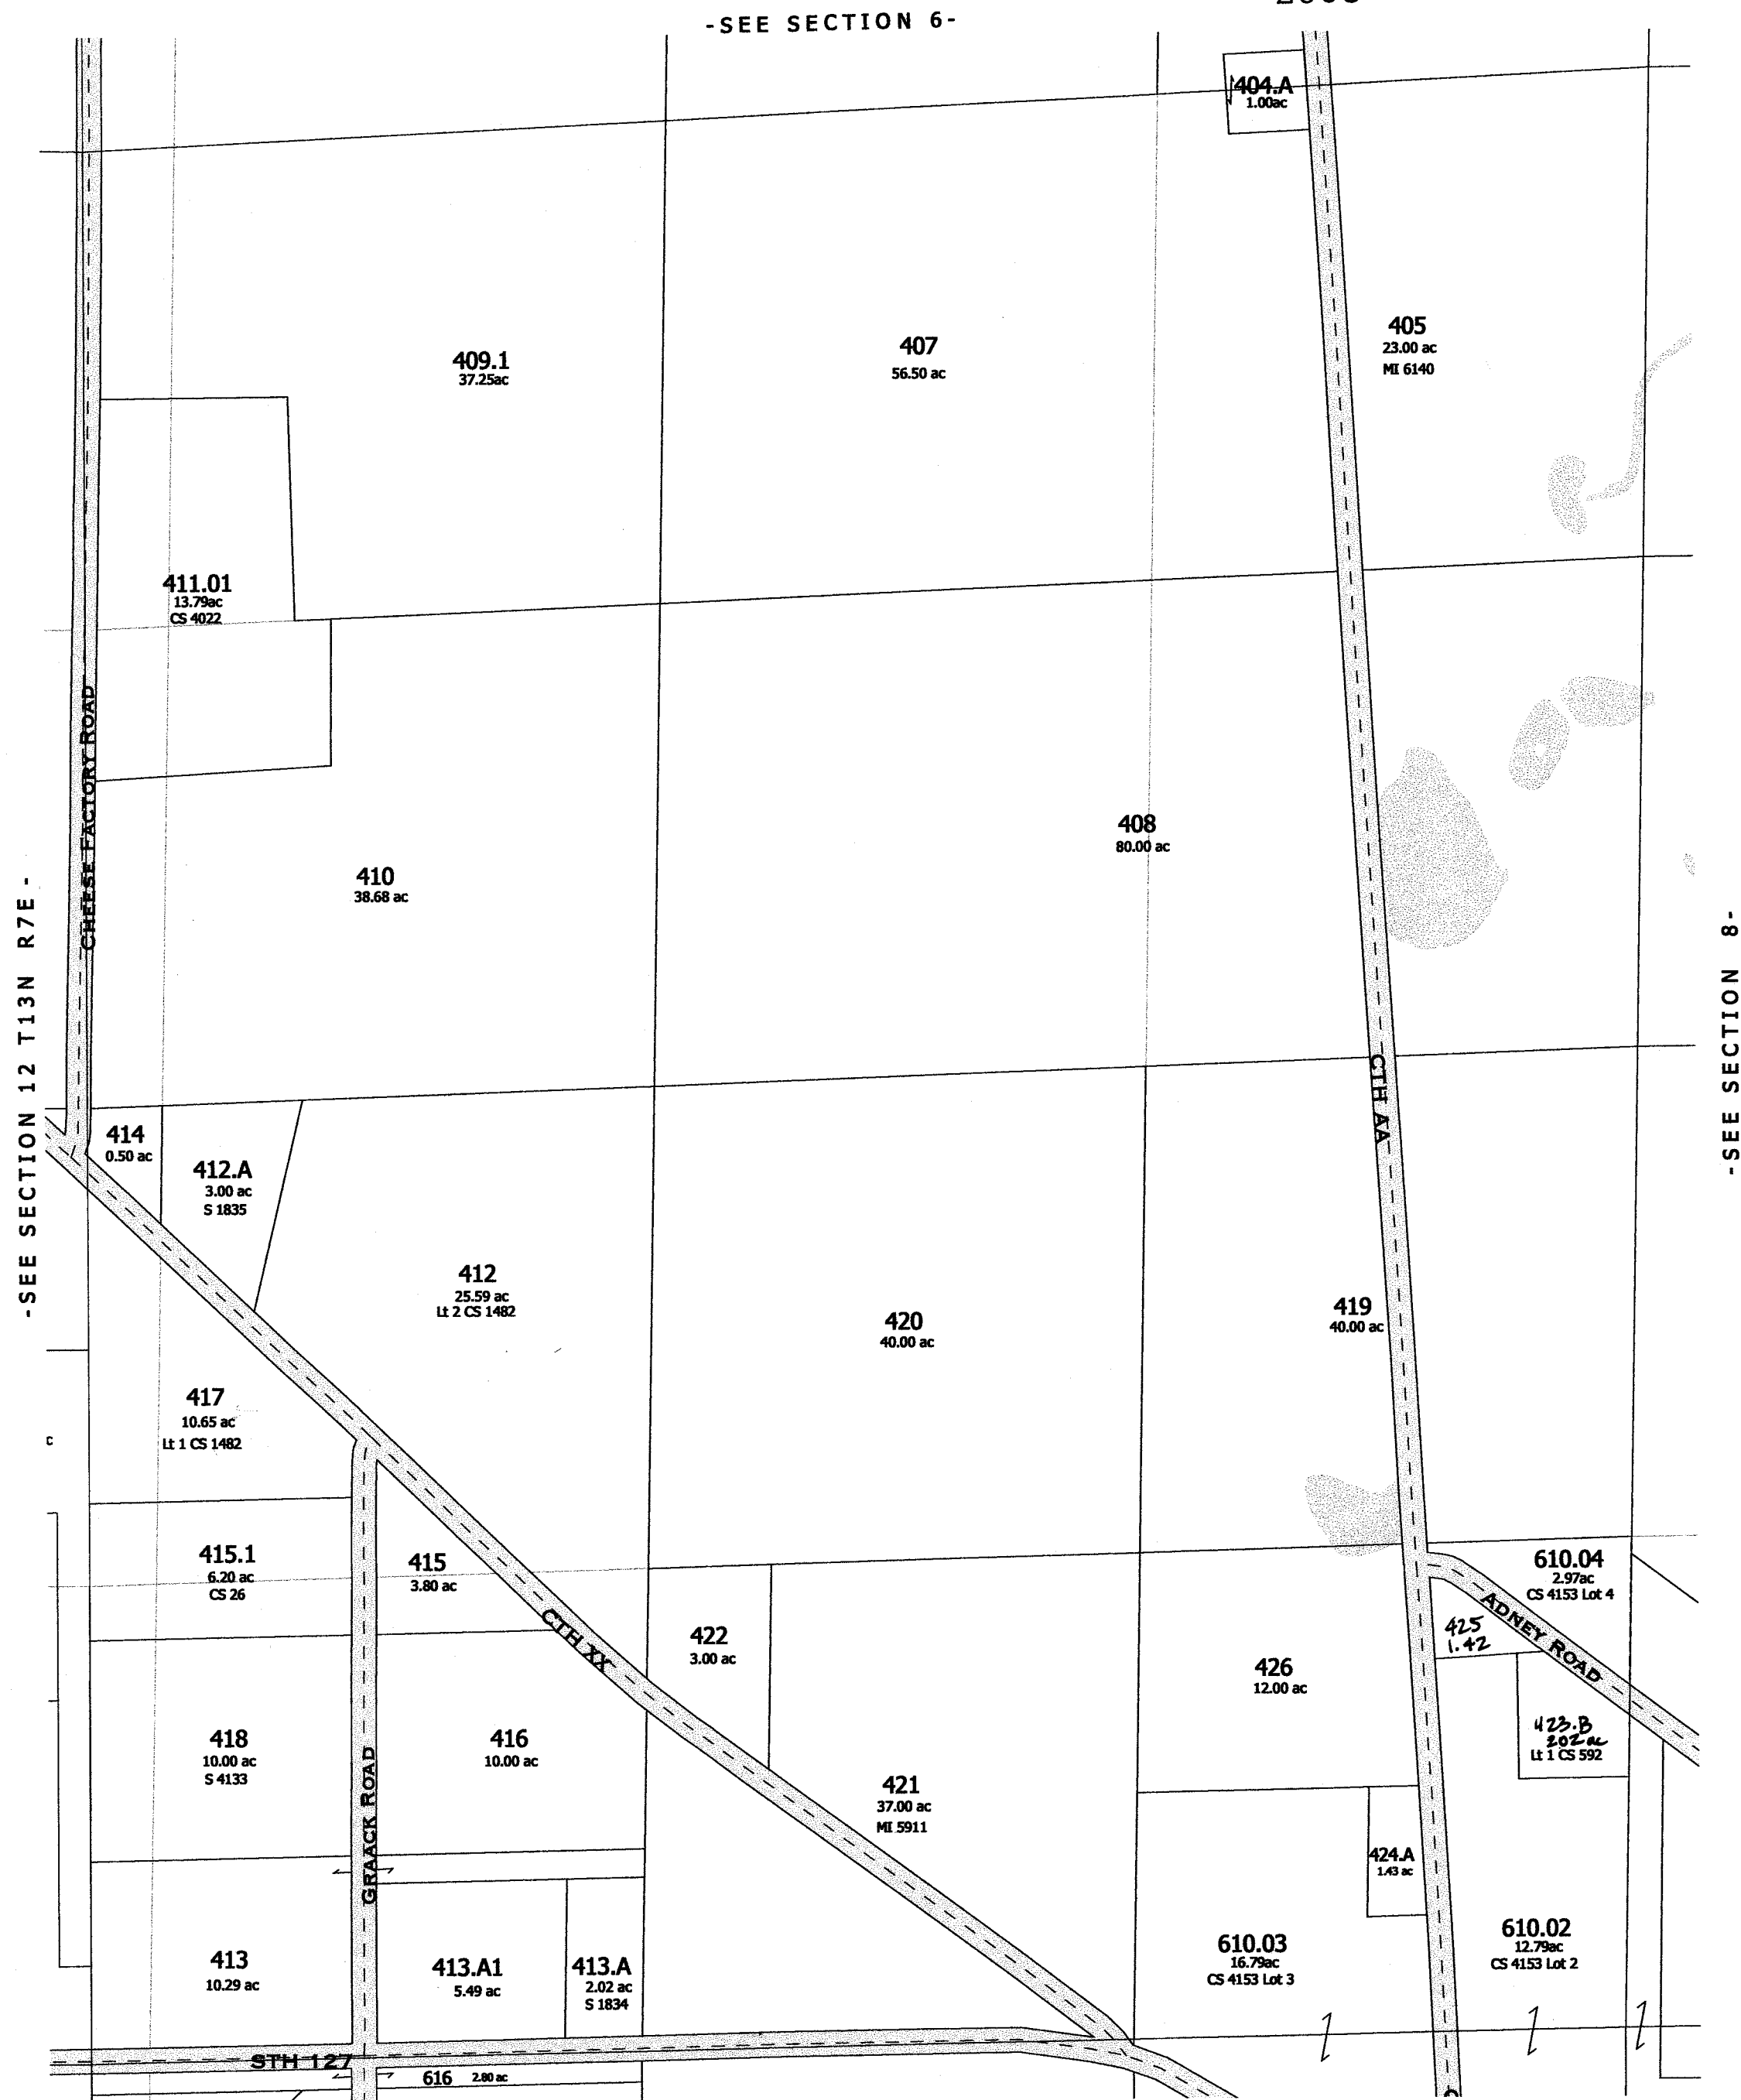


-SEE SECTION 18-

Replaced
2006

-SECTION 7-




TOWN 13 NORTH RANGE 8 EAST
COLUMBIA COUNTY, WISCONSIN

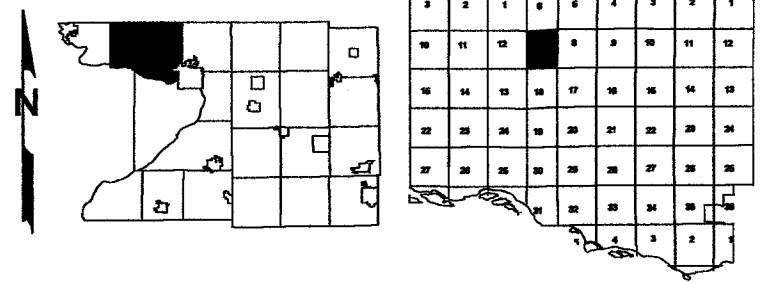

Replace Li

2007

-SEE SECTION 6-

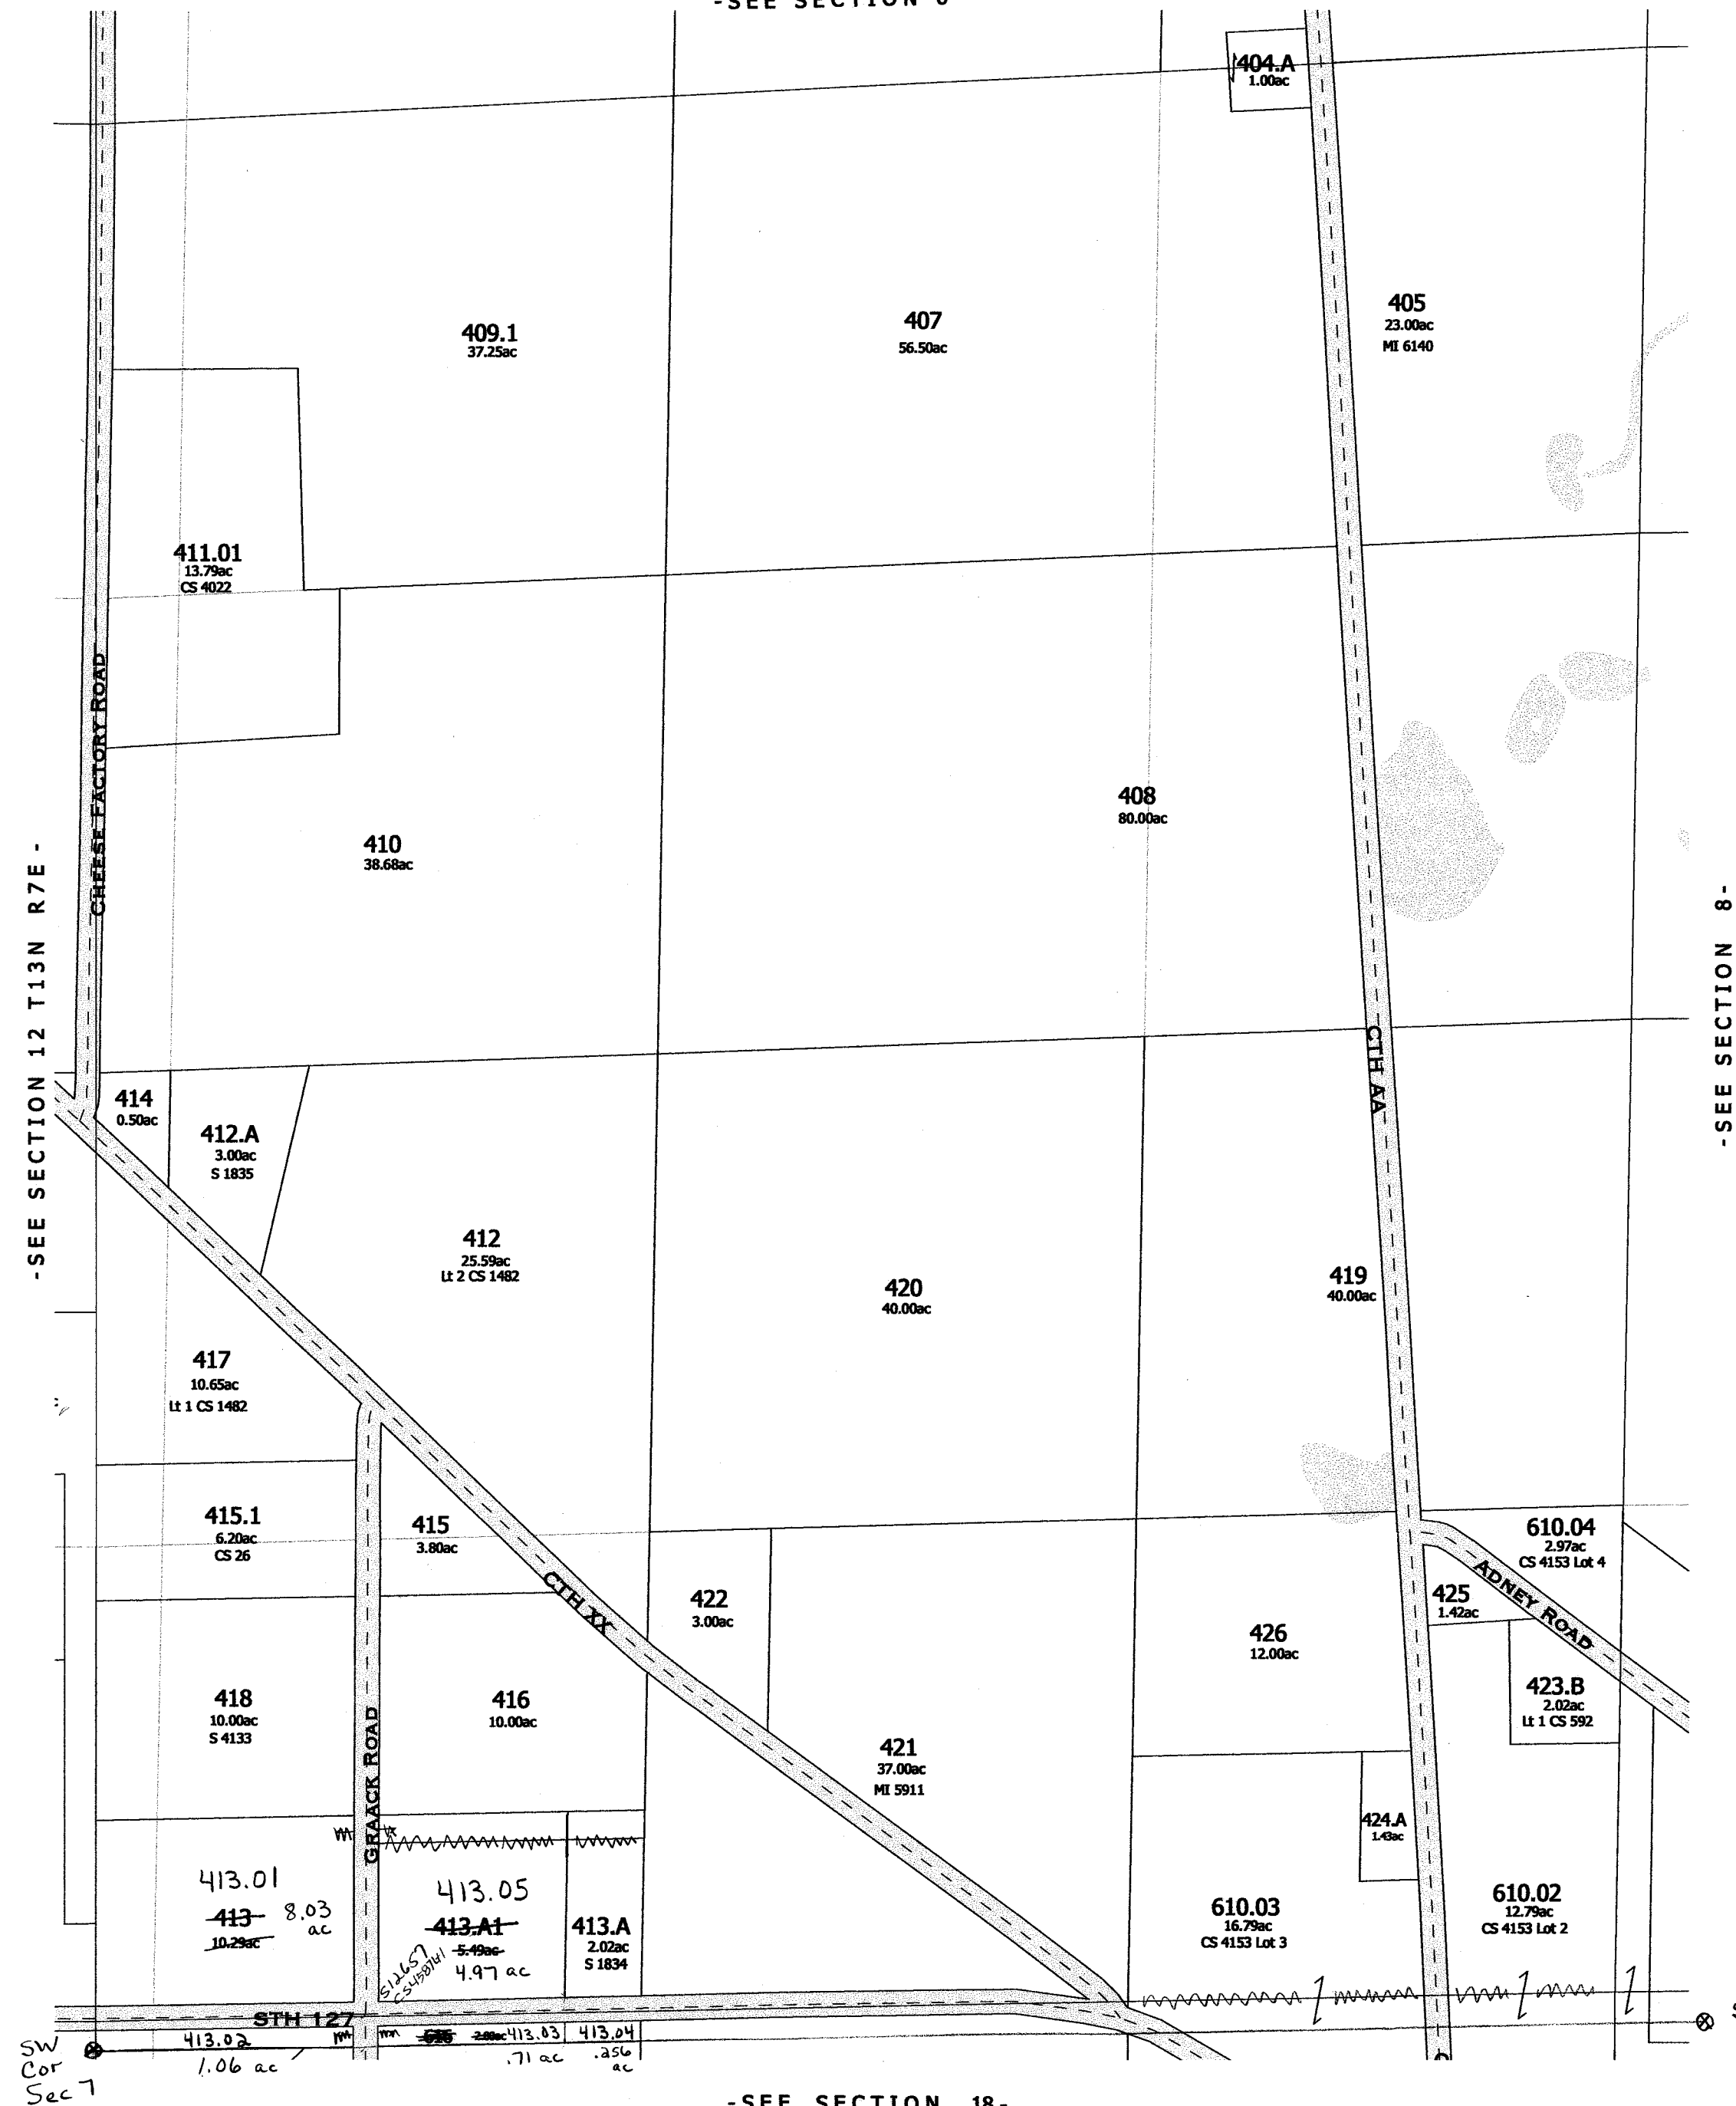



South
Section
Line

Replaced
2007

-SECTION 7-

Replaced
2002

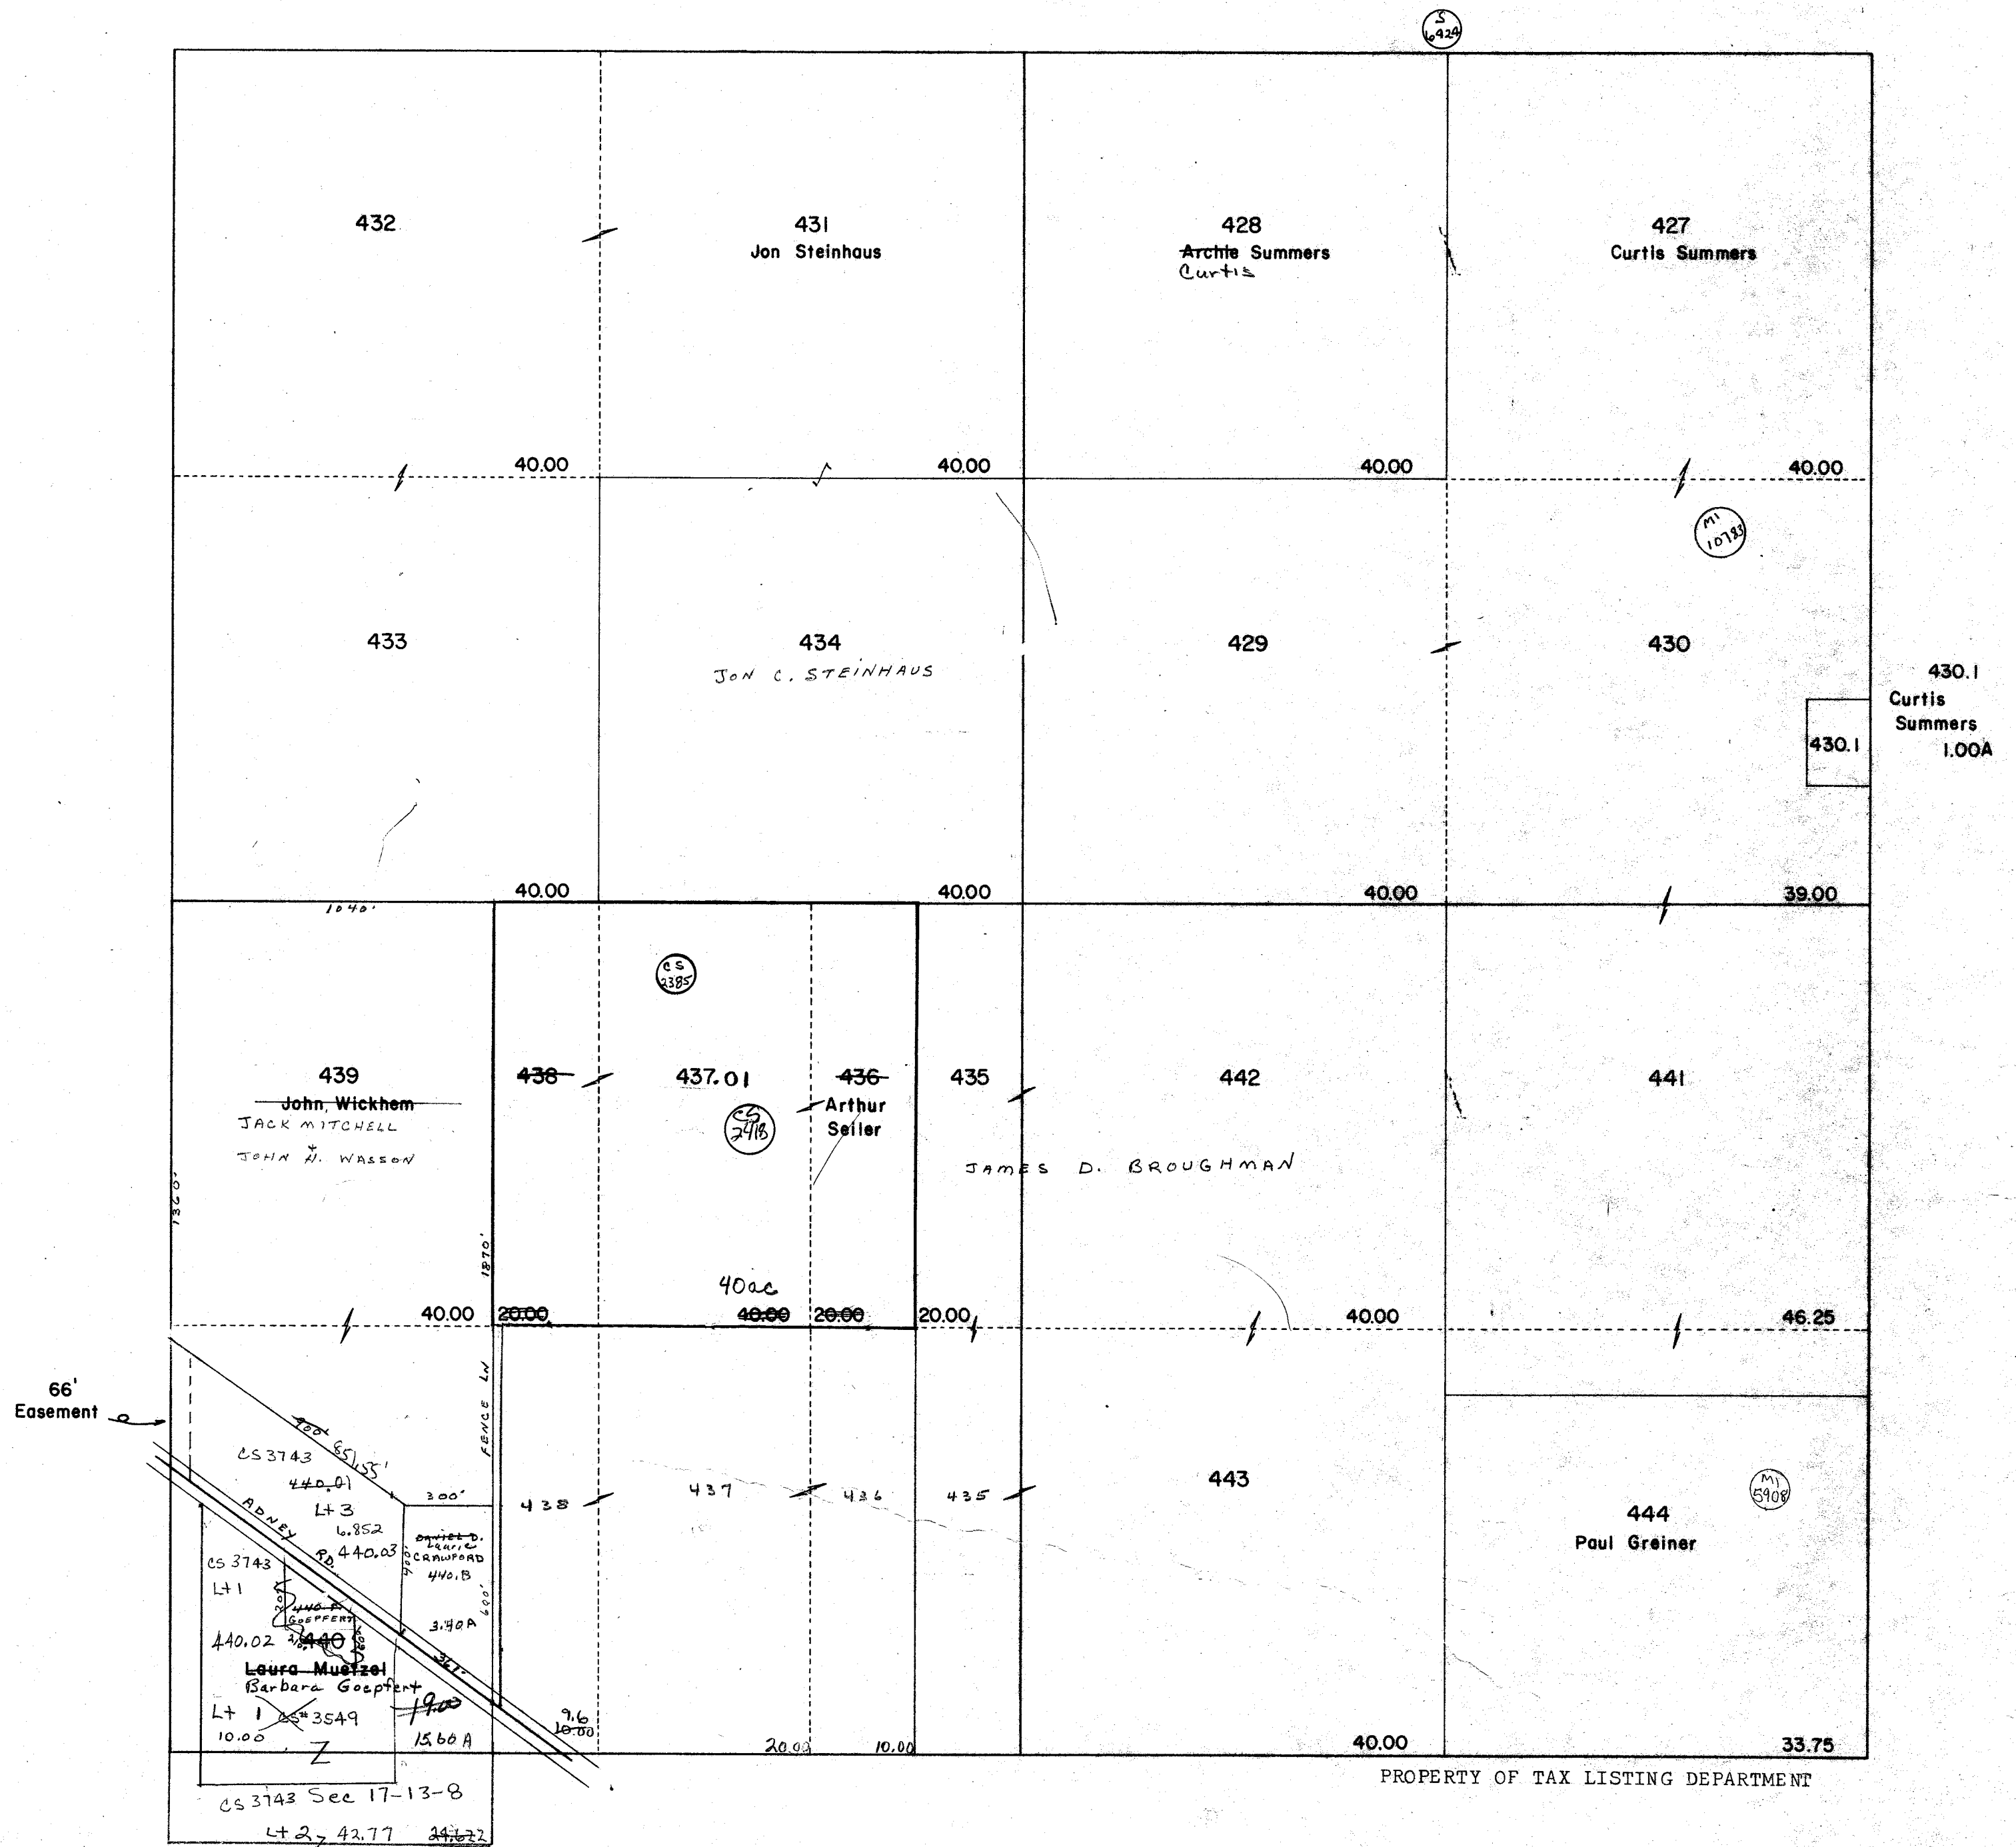

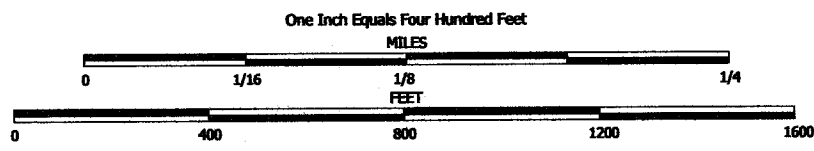


NOTE: This map was prepared for assessment use in accordance with the Wis. St. Stat. Chap. 70.09. All information contained herein is advisory only. Map accuracy is limited to the quality of data obtained from other Public Records. This map is not intended to be a substitute for an actual field survey. Public Land Survey Base is derived from U.S.G.S. Topographic maps unless otherwise noted. Other sources of the Land Base may be actual survey data. Base map data is from the April 1995 County Digital Orthophotos and/or U.S.G.S. 1:24,000 scale Topographic series. The user is responsible for the improper use of the data contained herein.

Created by The Columbia County Land Information Office -GIS Section. VMB.
September 2002.

TAX PARCEL MAP

TOWN of LEWISTON

TOWN 13 NORTH RANGE 8 EAST
COLUMBIA COUNTY, WISCONSIN

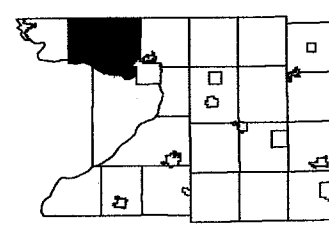

2	3	1	6	4	3	2	1
10	11	12	7	8	10	11	12
15	14	13	16	17	18	15	14
20	23	24	19	20	21	22	24
27	28	26	25	29	28	27	26
32	31	30	33	32	31	30	32

Replaced
2003

-SEE SECTION 5-



-SEE SECTION 7-

-SEE SECTION 9-


-SEE SECTION 17-

replaced 2003
-SECTION 8-

LEWISTON

SEC. 9 T13N R8E



Replaced
2002

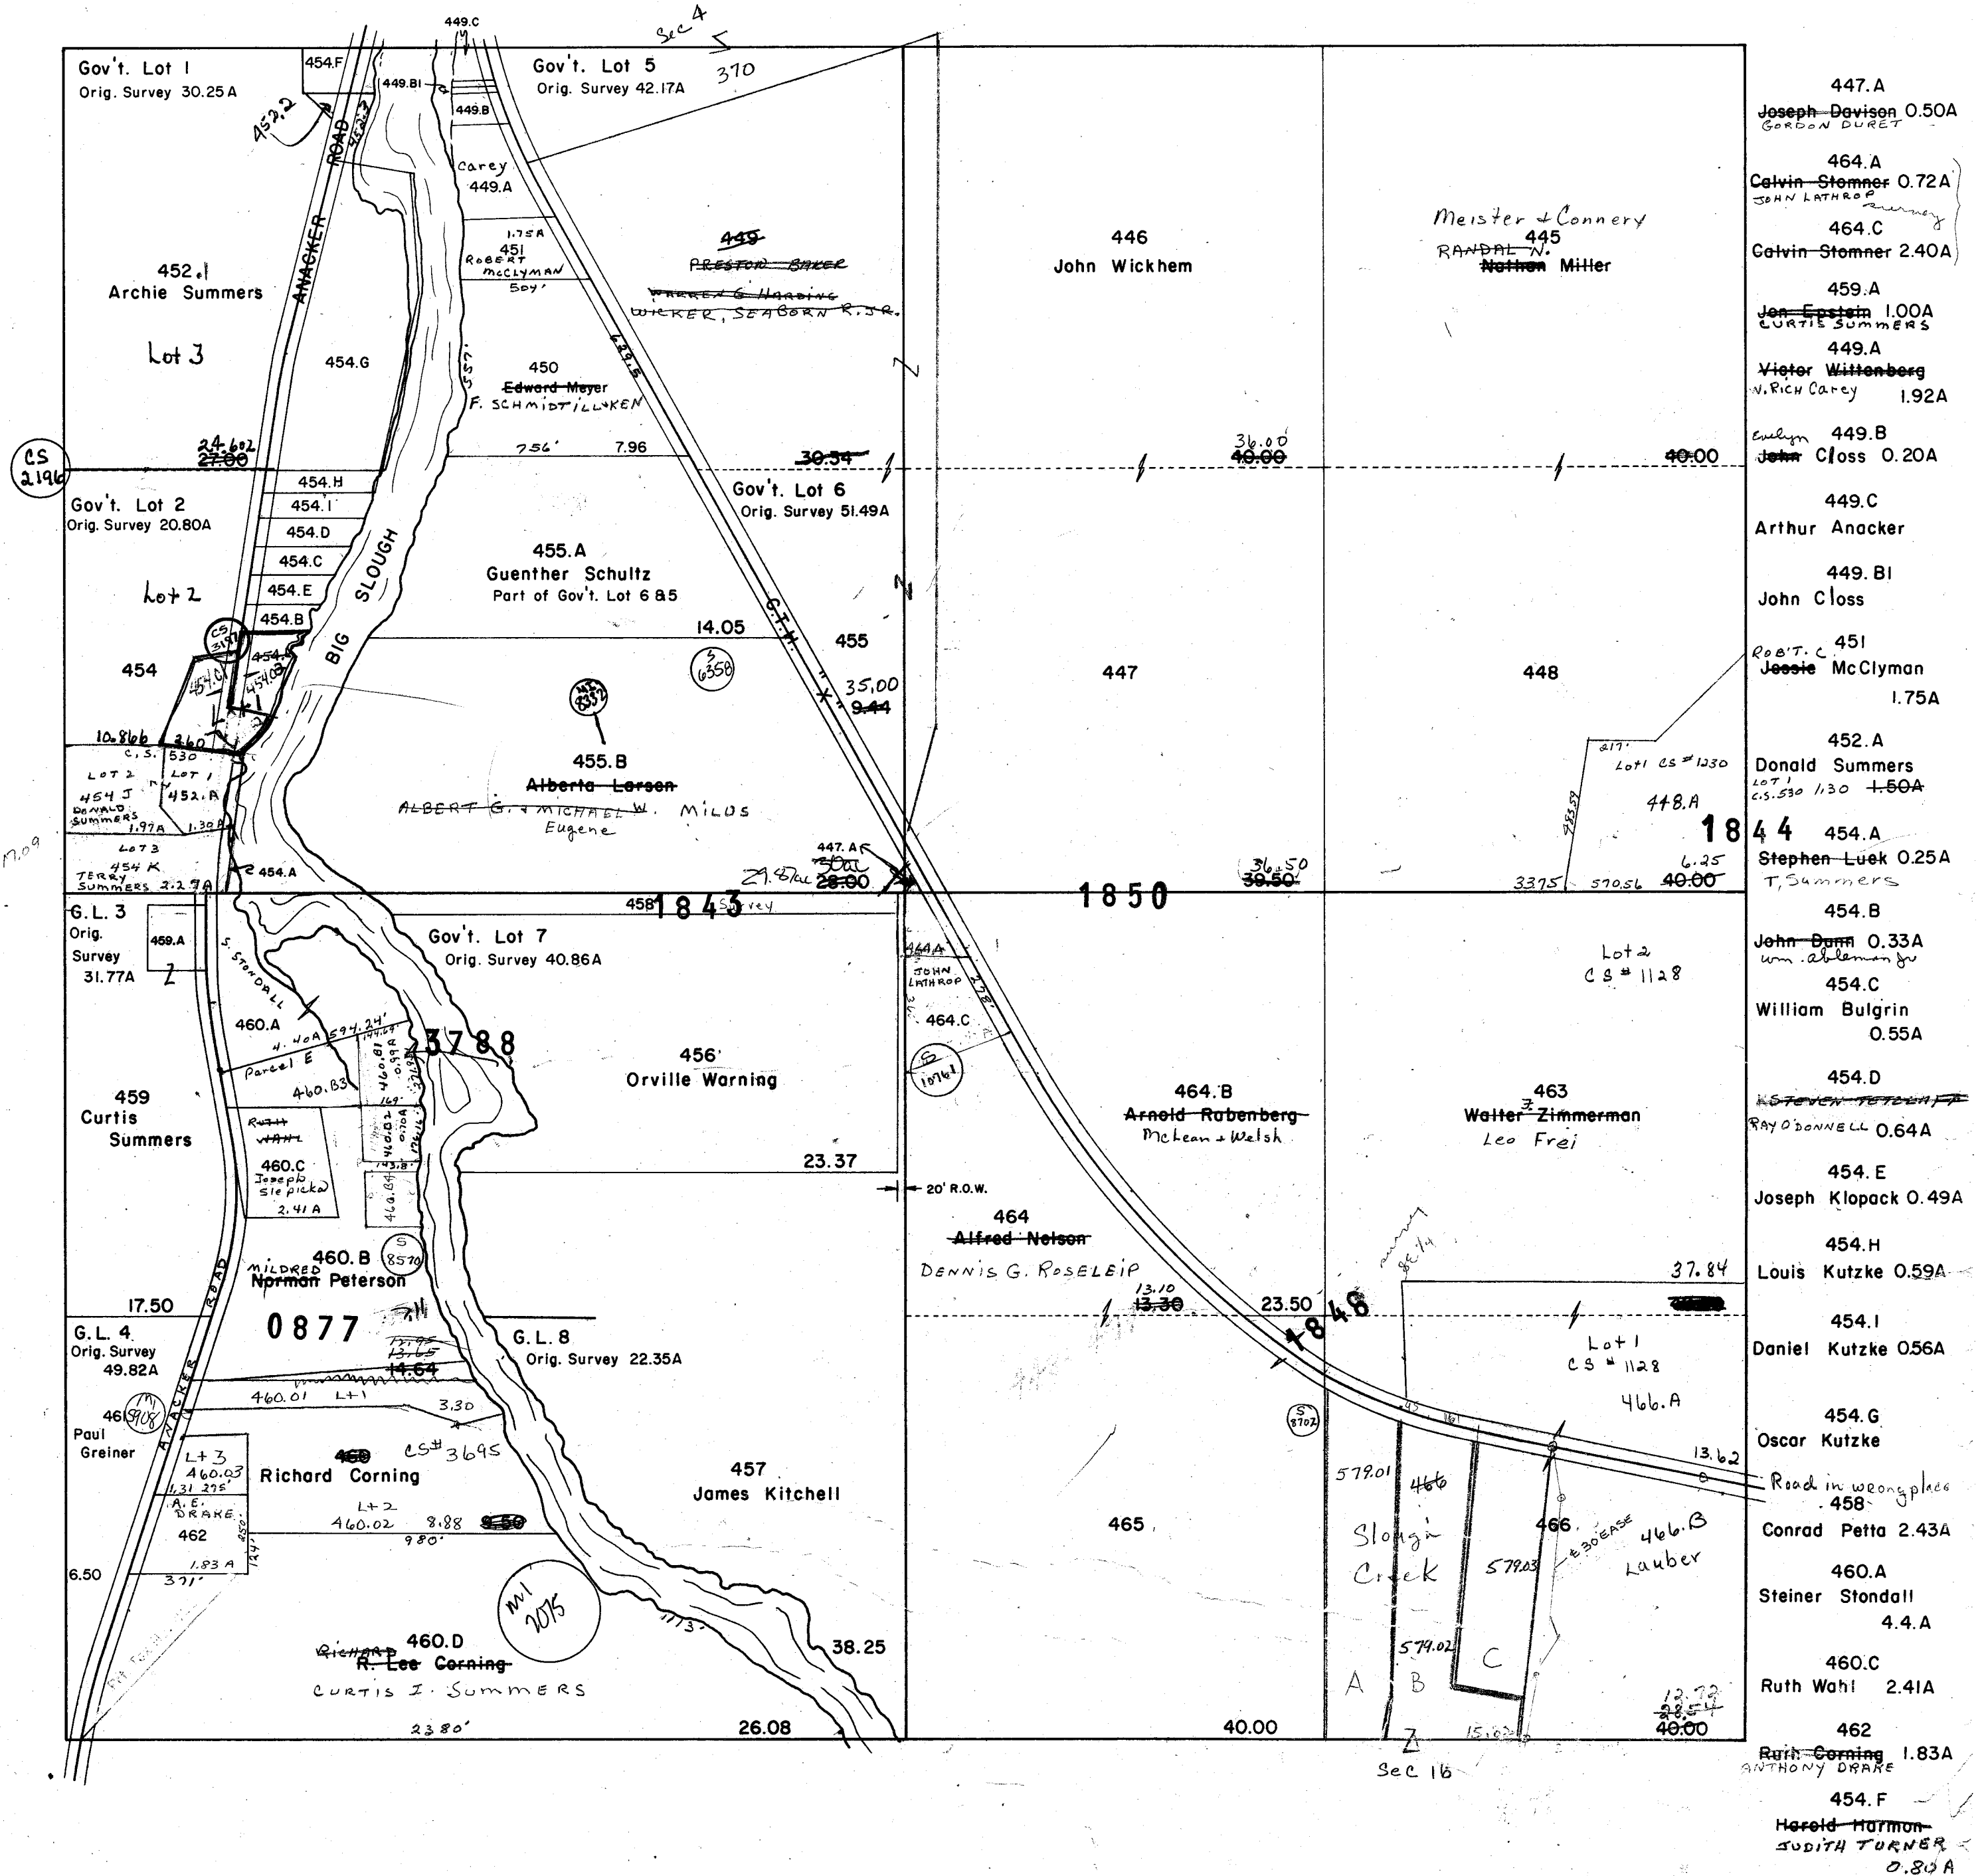

One Inch Equals Four Hundred Feet
MILES
0 1/16 1/8 1/4
0 400 800 1200 1600
FEET
NOTE: This map was prepared for assessment use in accordance with the Wis. St. Stat. Chap. 70.09. All information contained herein is advisory only. Map accuracy is limited to the quality of data obtained from other Public Records. This map is not intended to be a substitute for an actual field survey. Public Land Survey Base is derived from U.S.G.S. Topographic maps unless otherwise noted. Other sources of the Land Base may be actual survey data. Base map data is from the April 1995 County Digital Orthophotos and/or U.S.G.S. 1:24,000 scale Topographic series. The user is responsible for the improper use of the data contained herein.
Created by The Columbia County Land Information Office -GIS Section. VMB.
September 2002.


TAX PARCEL MAP
TOWN of LEWISTON

TOWN 13 NORTH RANGE 8 EAST
COLUMBIA COUNTY, WISCONSIN

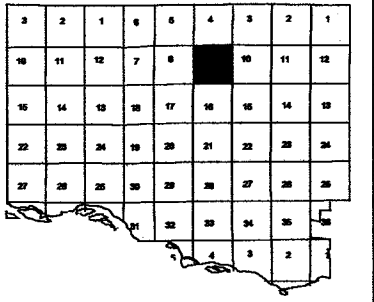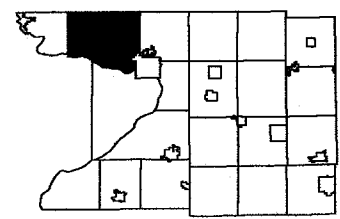


Replaced
2003

-SEE SECTION 4-

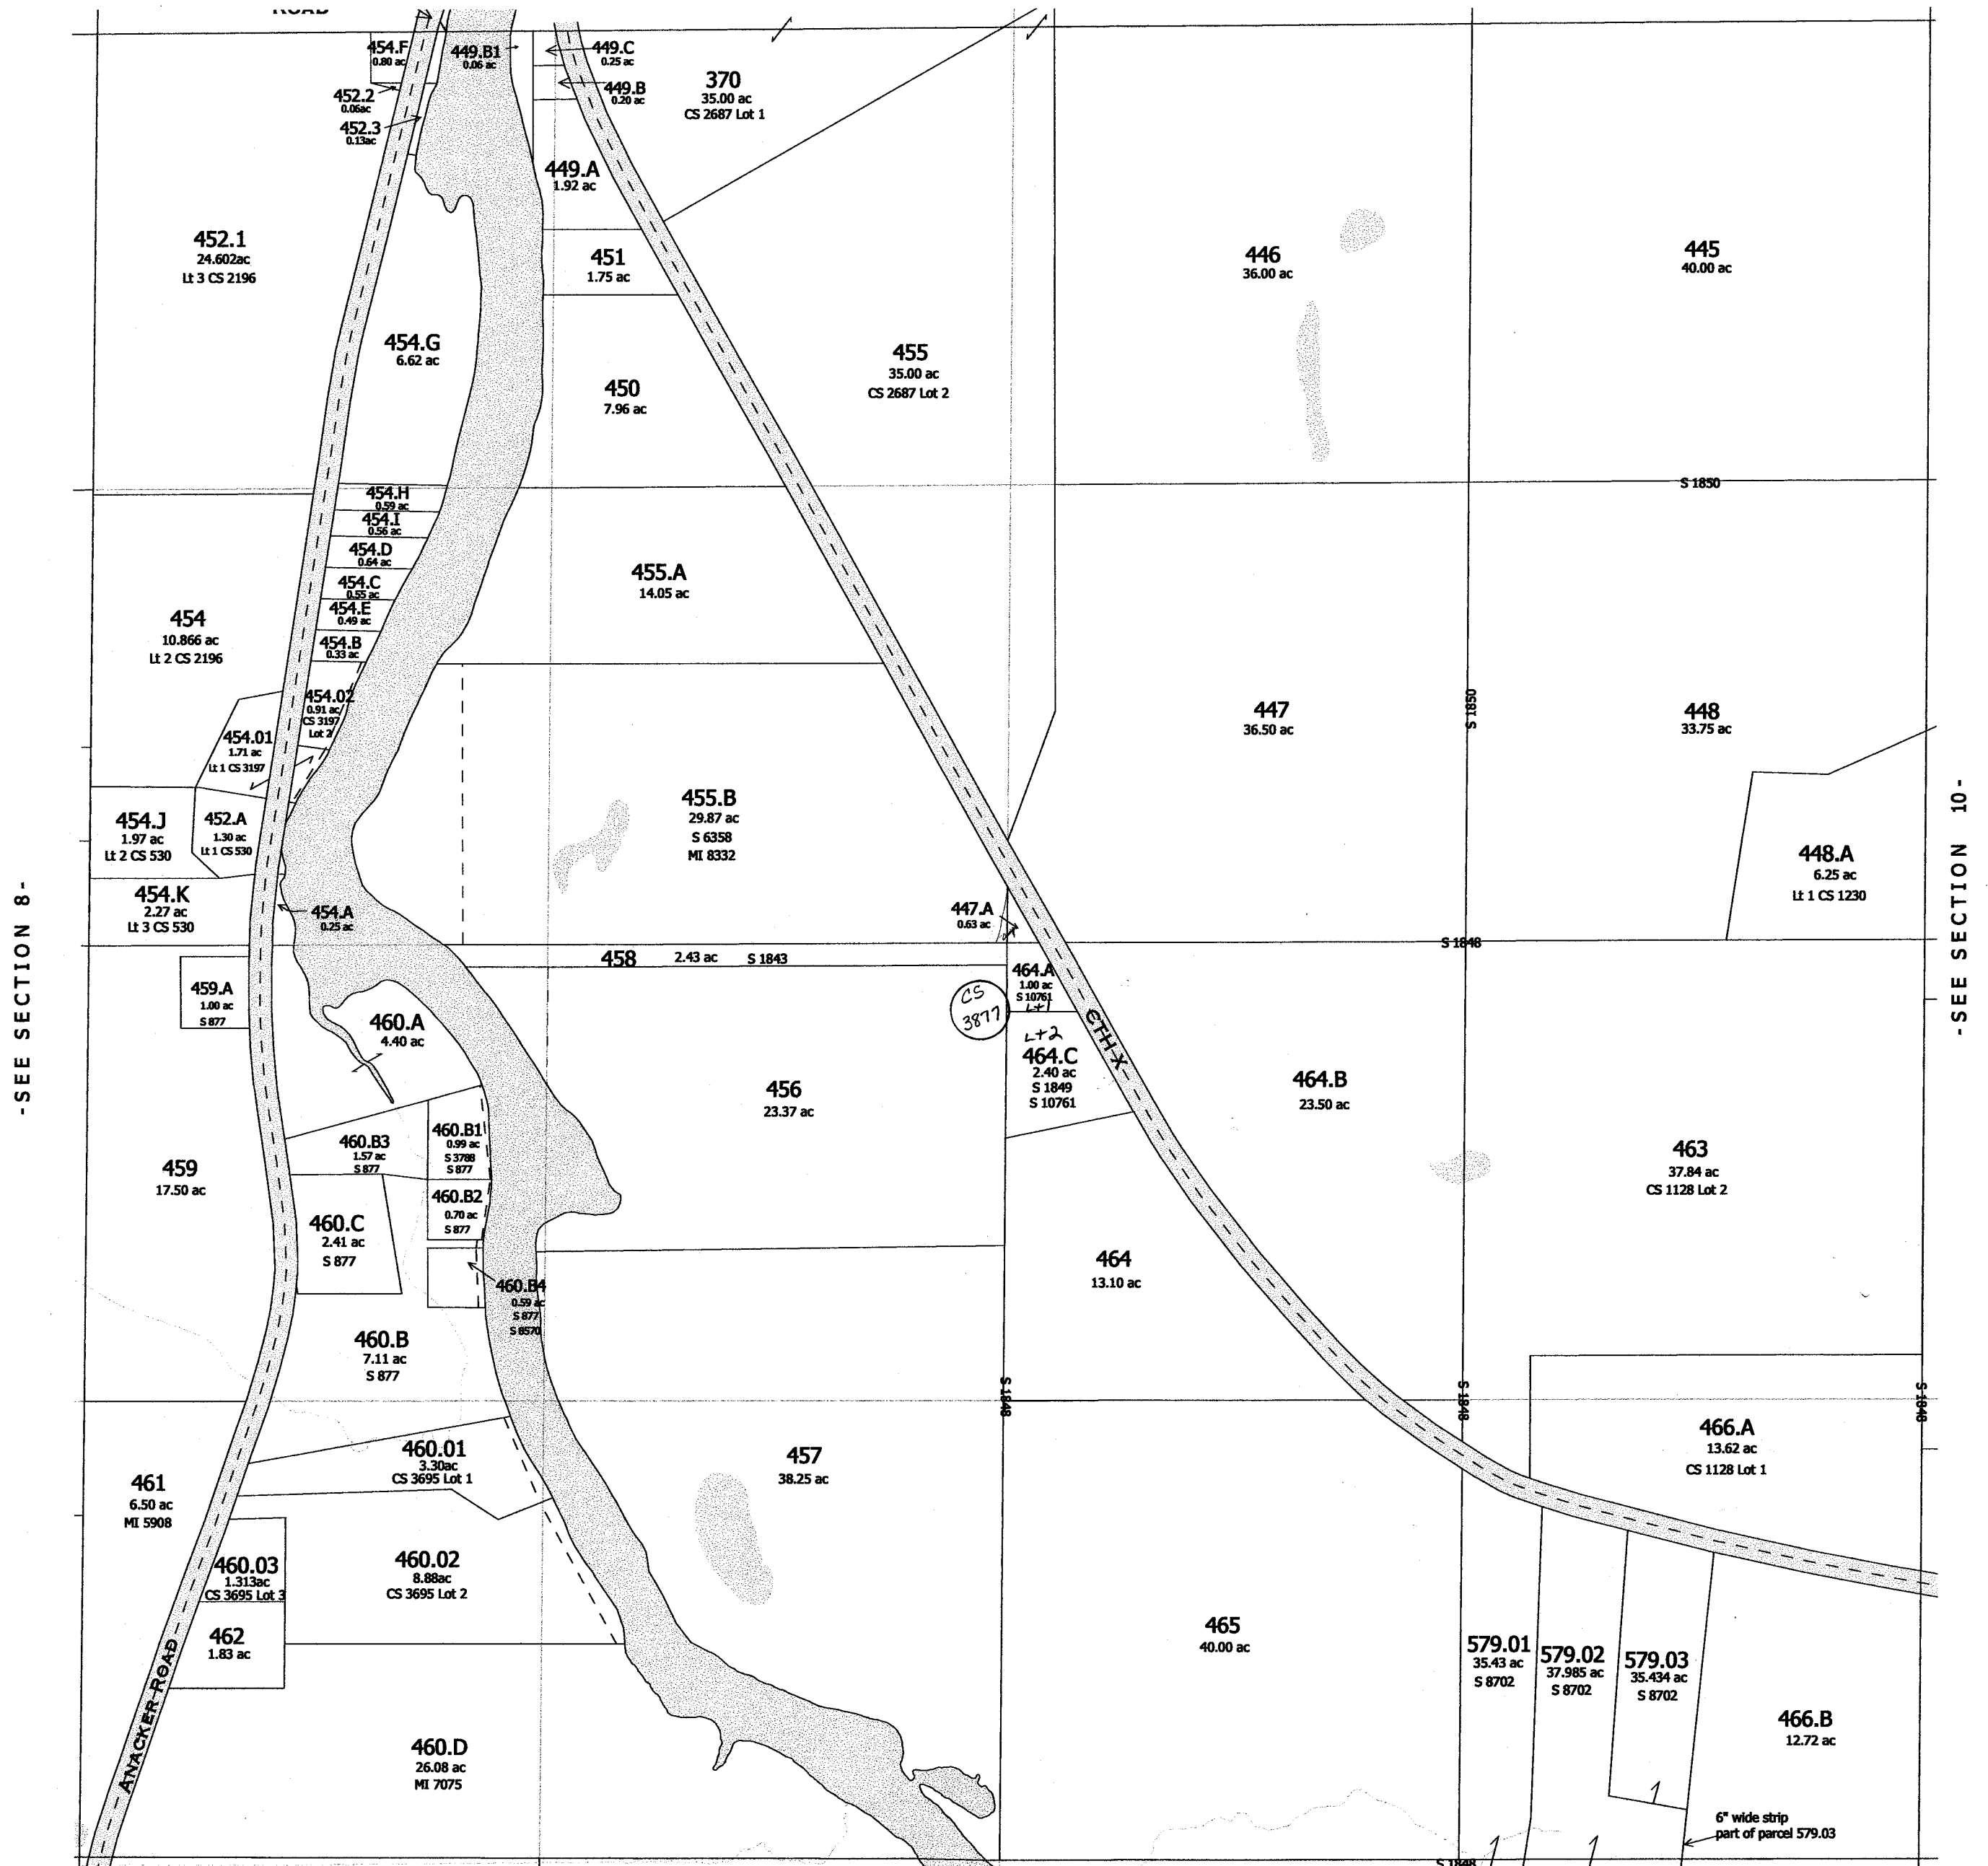

-SEE SECTION 16-


Replaced 2003
-SECTION 9-

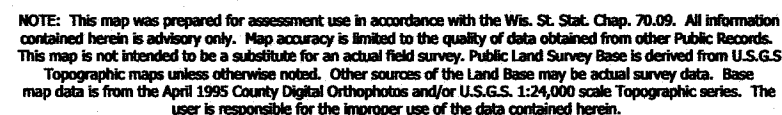

Created by The Columbia County Land Information Office -GIS Section. VMB.
February 2003.


TOWN of LEWISTON

TOWN 13 NORTH RANGE 8 EAST
COLUMBIA COUNTY, WISCONSIN

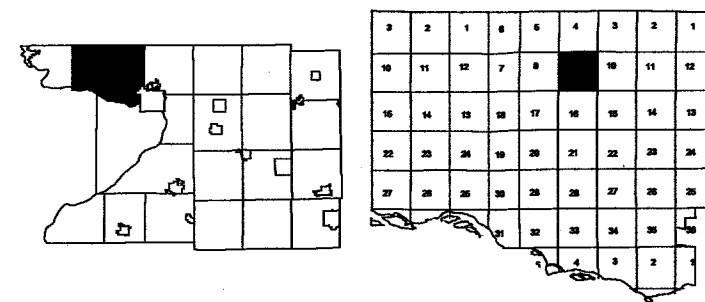

Replace
2006

-SEE SECTION 4-

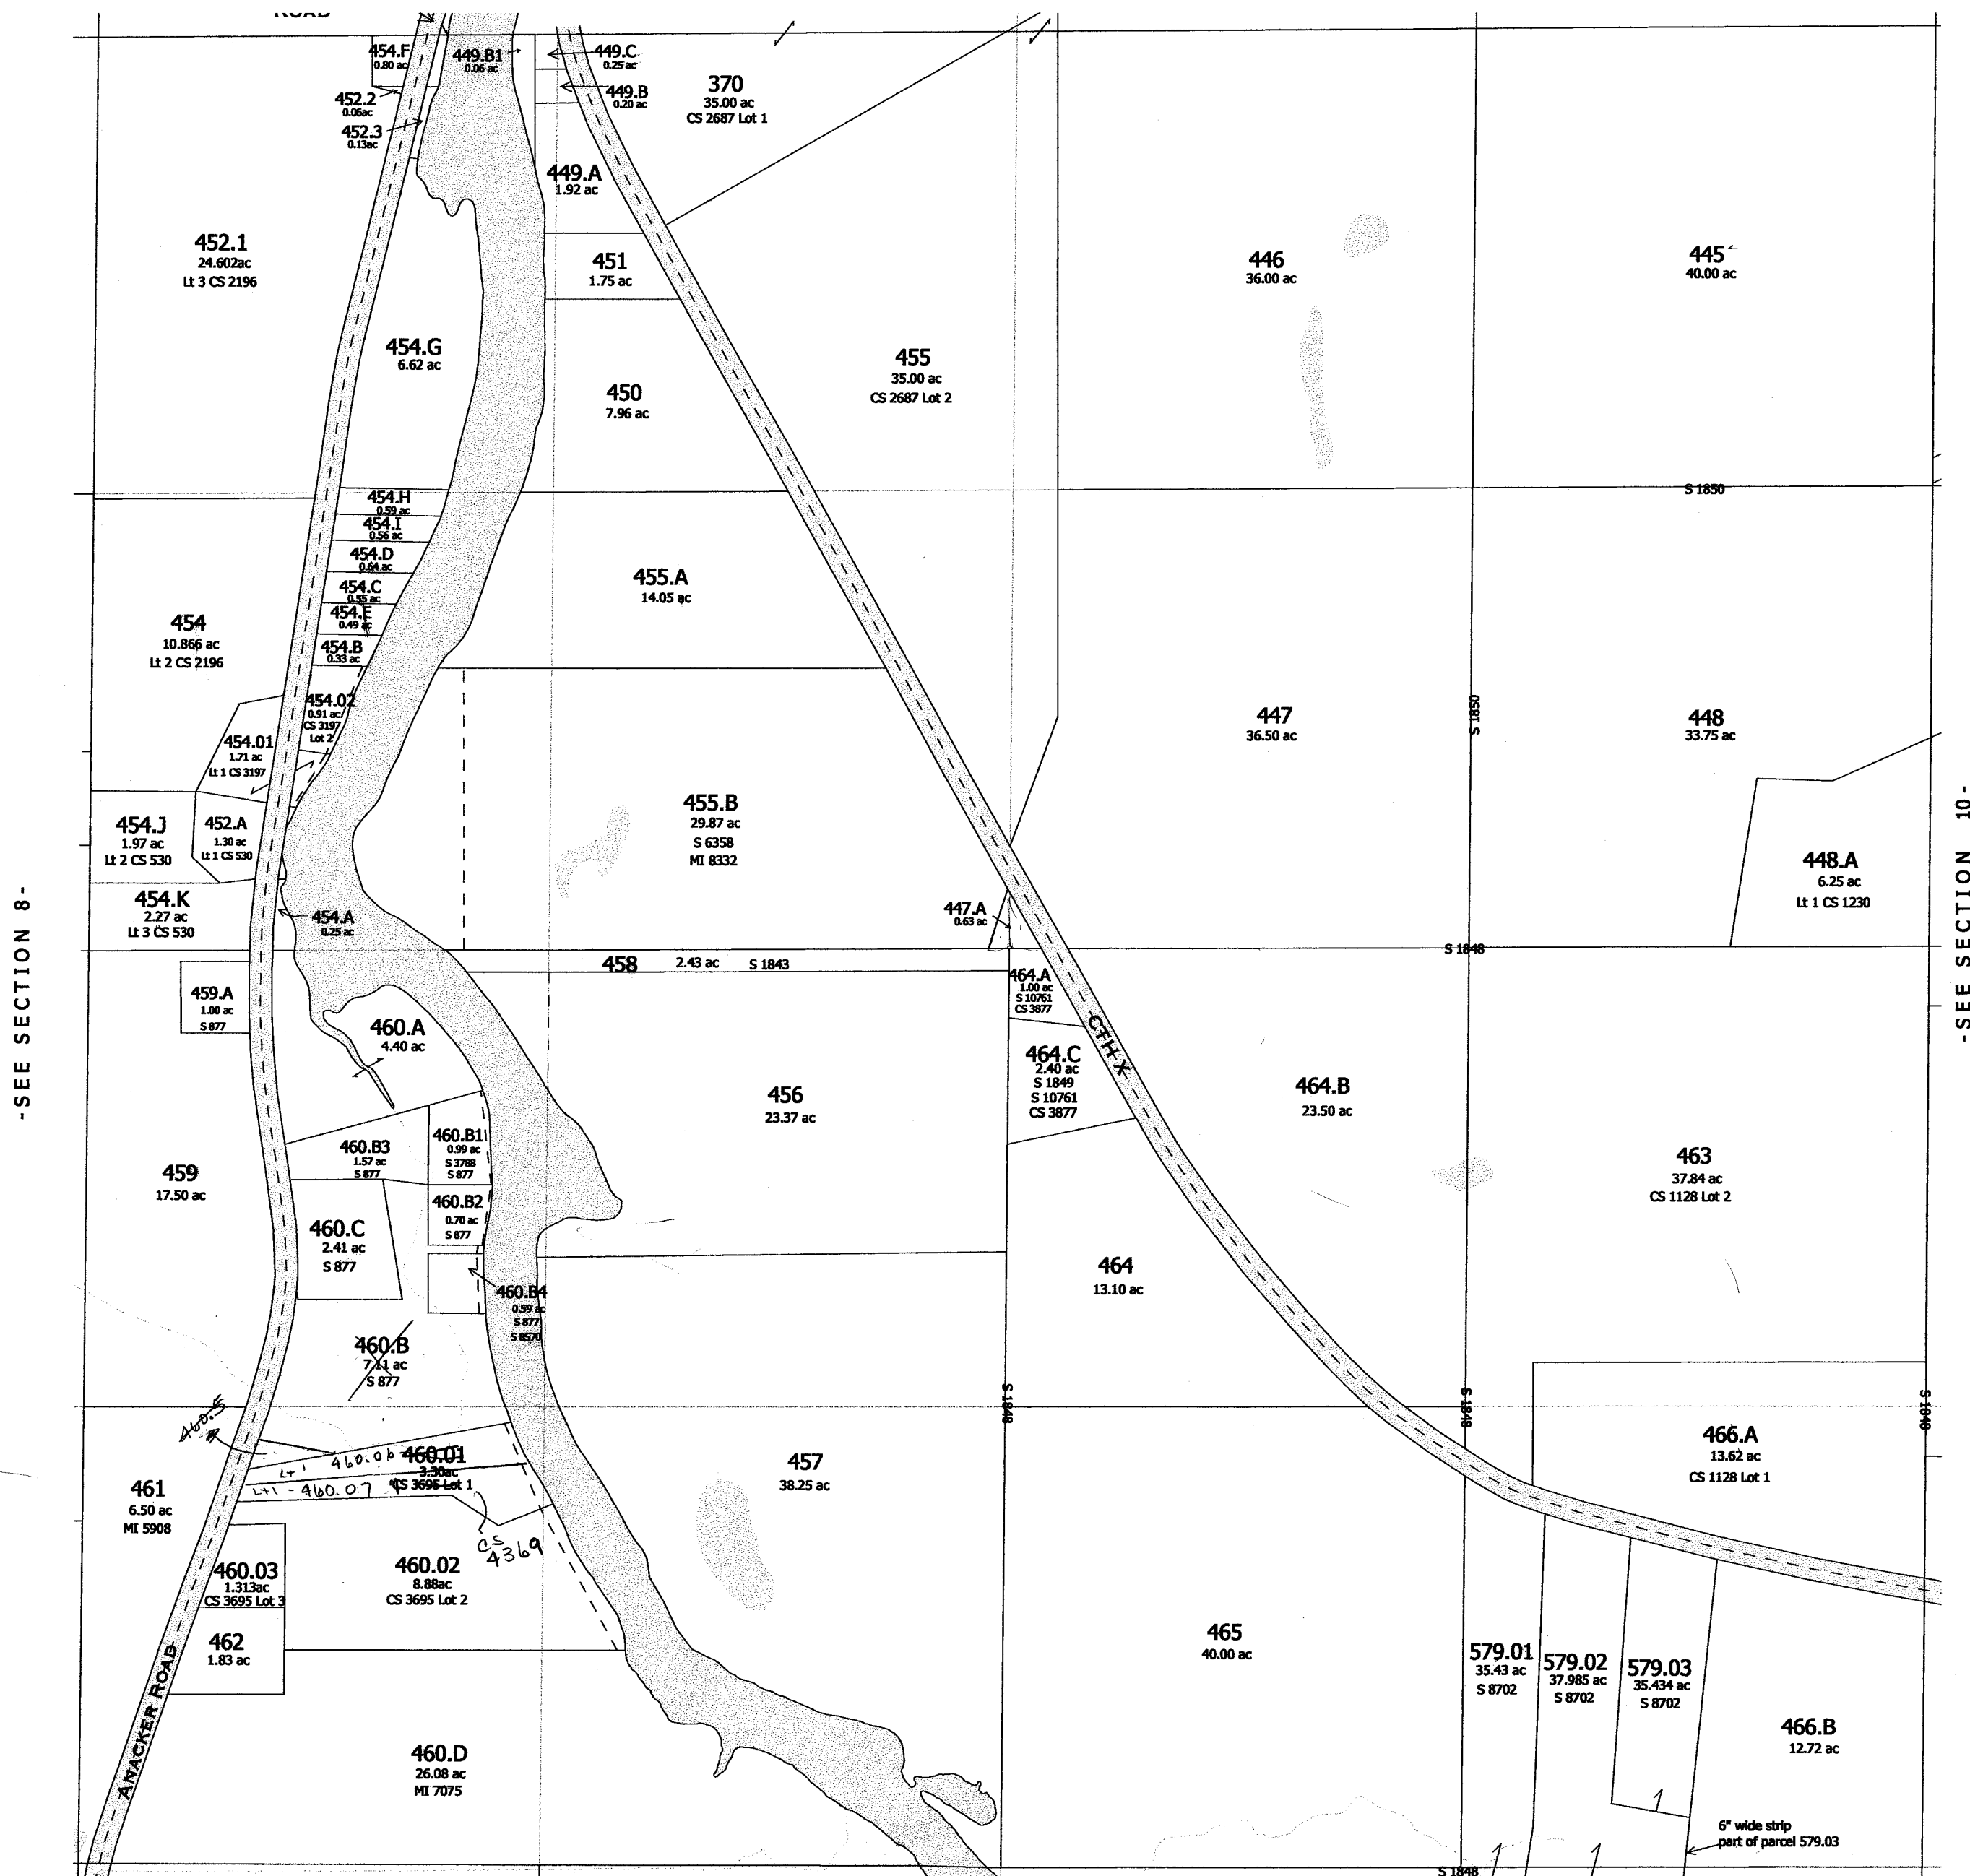


- SEE SECTION 16 -

-SECTION 9-

Replaced
2005

Replaced
2002

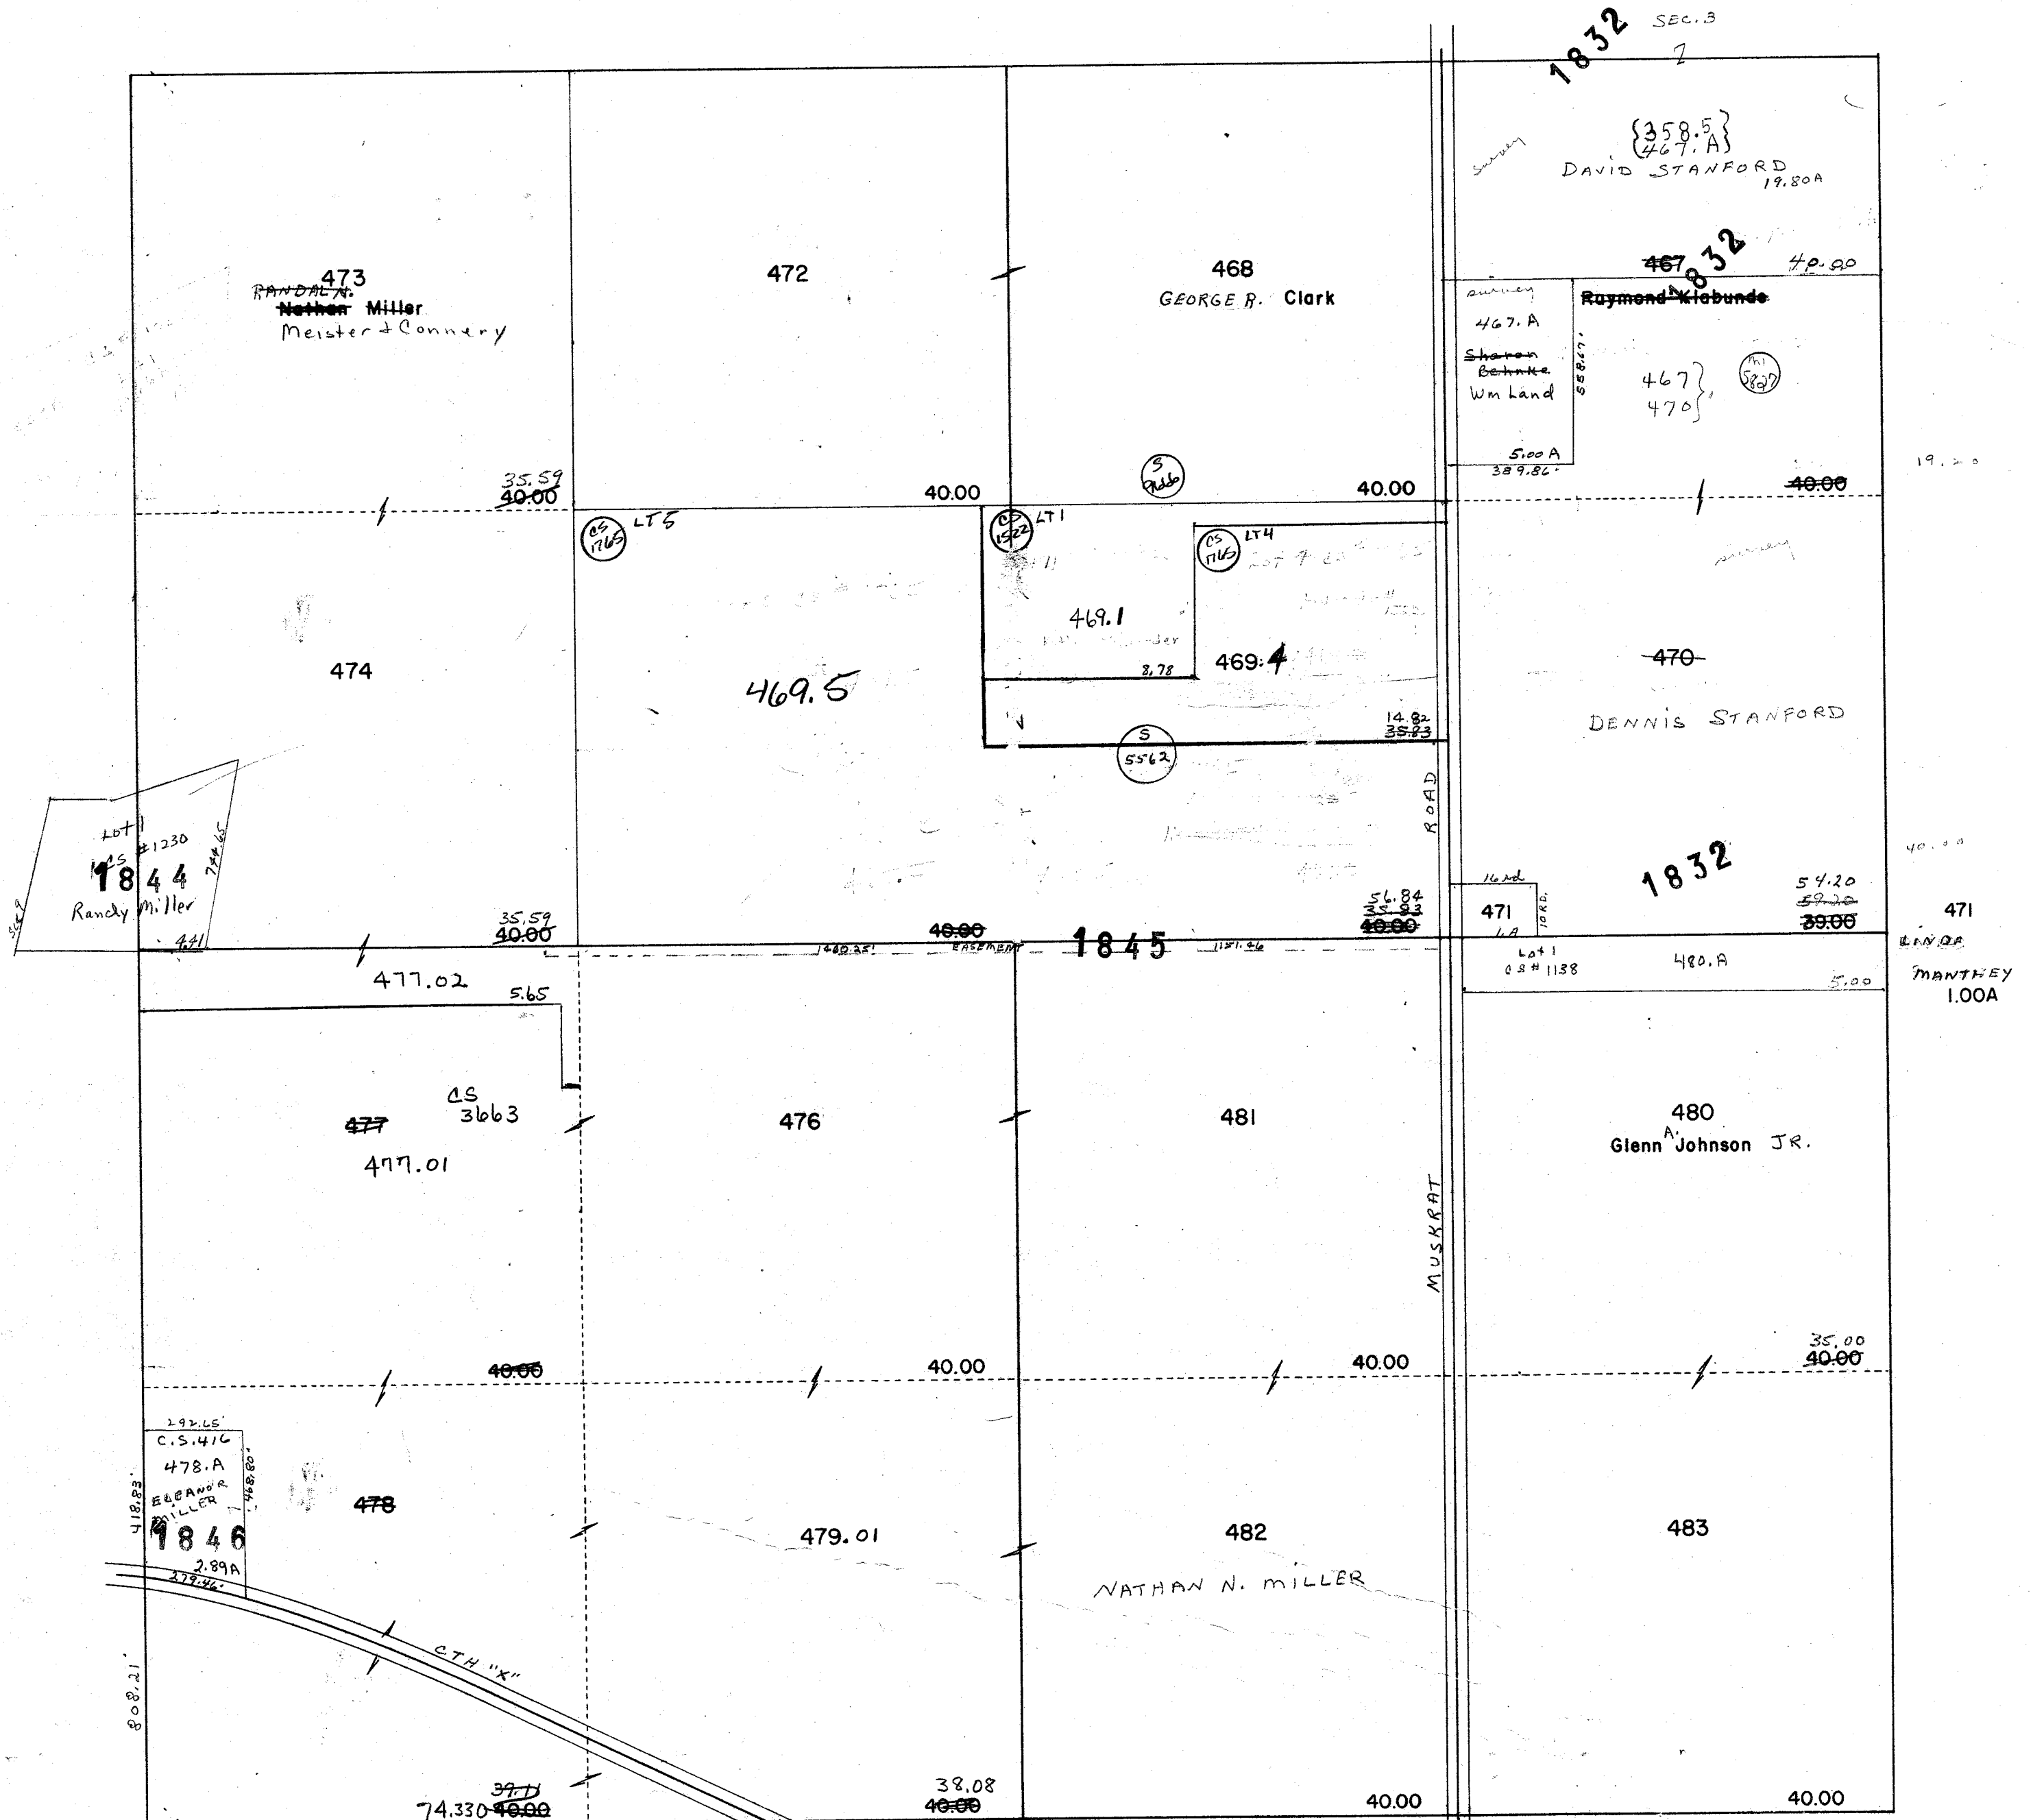

PROPERTY OF TAX LISTING DEPARTMENT

One Inch Equals Four Hundred Feet
MILES
0 1/16 1/8 1/4
FEET
0 400 800 1200 1600


NOTE: This map was prepared for assessment use in accordance with the Wis. St. Stat. Chap. 70.09. All information contained herein is advisory only. Map accuracy is limited to the quality of data obtained from other Public Records. This map is not intended to be a substitute for an actual field survey. Public Land Survey Base is derived from U.S.G.S. Topographic maps unless otherwise noted. Other sources of the Land Base may be actual survey data. Base map data is from the April 1995 County Digital Orthophotos and/or U.S.G.S. 1:24,000 scale Topographic series. The user is responsible for the improper use of the data contained herein.

Created by The Columbia County Land Information Office -GIS Section. VMB.
September 2002.

TAX PARCEL MAP


TOWN of LEWISTON

TOWN 13 NORTH RANGE 8 EAST
COLUMBIA COUNTY, WISCONSIN

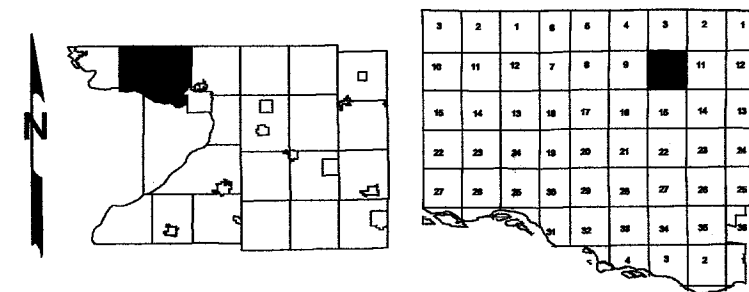

Replaced
2004

-SEE SECTION 3-

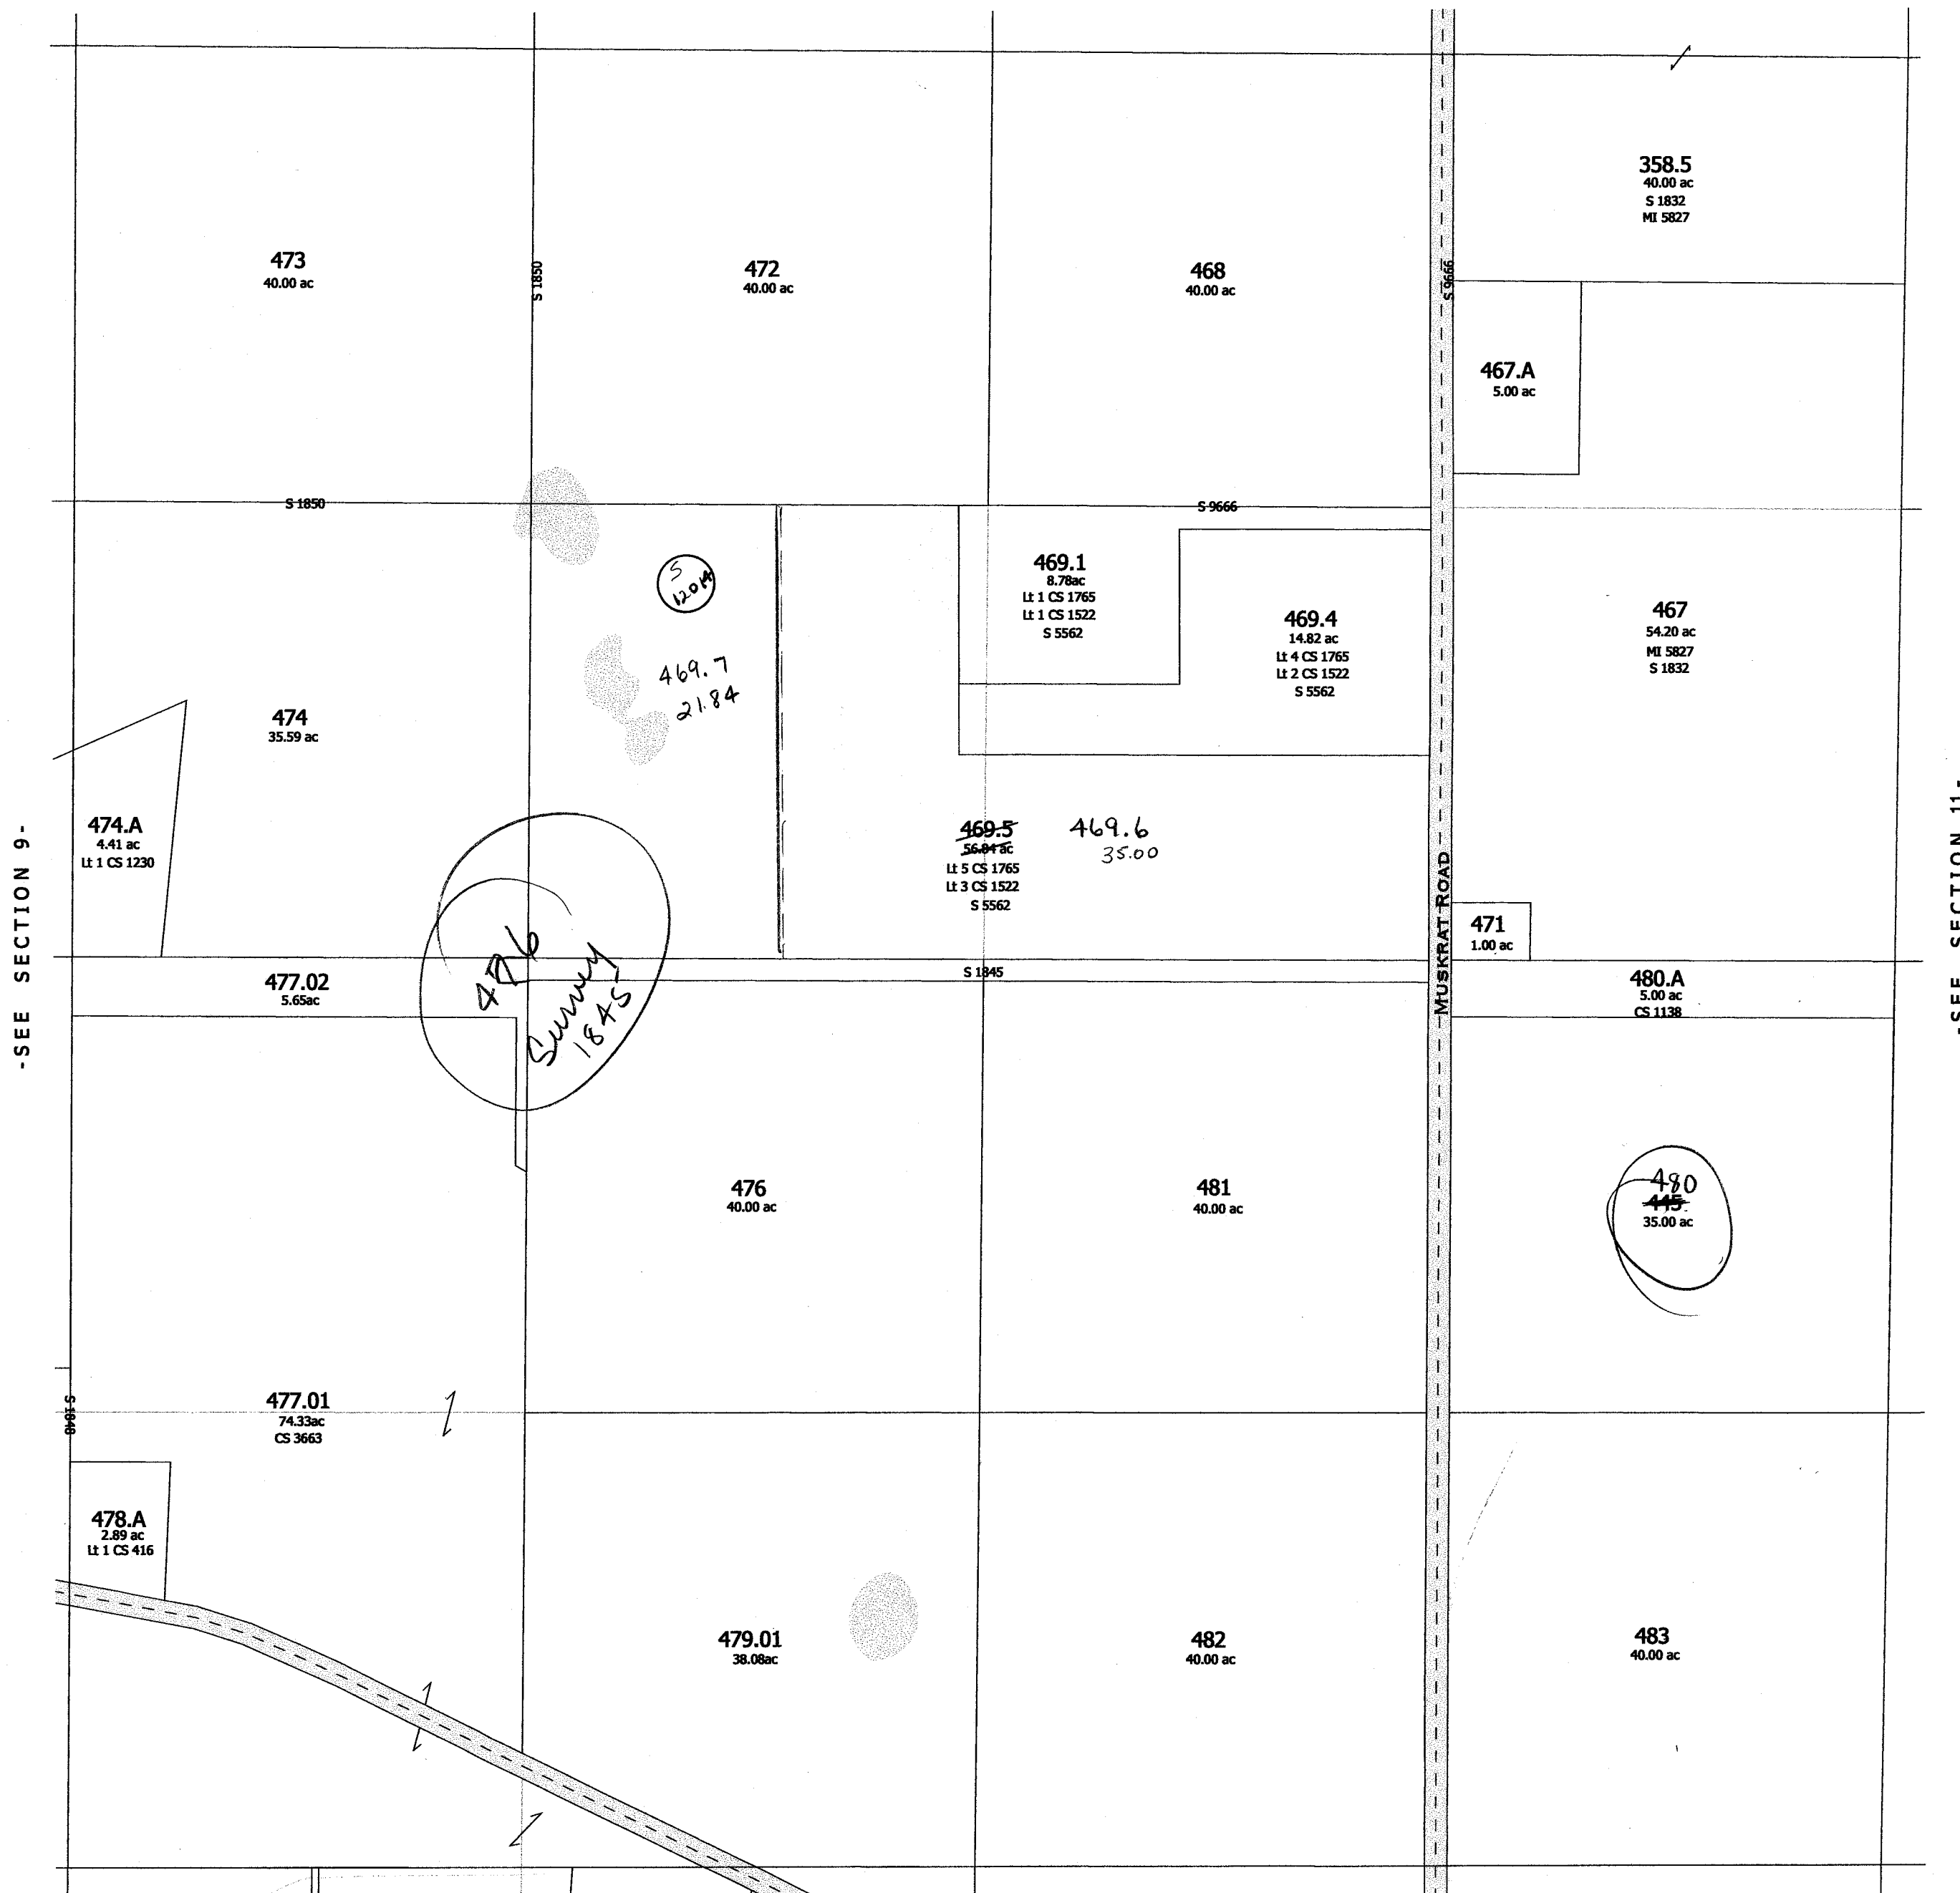


-SEE SECTION 9-

-SEE SECTION 11-

-SEE SECTION 15-

replaced 2004
-SECTION 10-

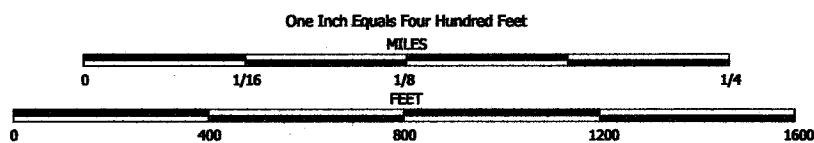


NOTE: This map was prepared for assessment use in accordance with the Wis. St. Stat. Chap. 70.09. All information contained herein is advisory only. Map accuracy is limited to the quality of data obtained from other Public Records. This map is not intended to be a substitute for an actual field survey. Public Land Survey Base is derived from U.S.G.S Topographic maps unless otherwise noted. Other sources of the Land Base may be actual survey data. Base map data is from the April 1995 County Digital Orthophotos and/or U.S.G.S. 1:24,000 scale Topographic series. The user is responsible for the improper use of the data contained herein.

Created by The Columbia County Land Information Office -GIS Section- VMB.
March 2004.

TAX PARCEL MAP

TOWN of LEWISTON

TOWN 13 NORTH RANGE 8 EAST
COLUMBIA COUNTY, WISCONSIN

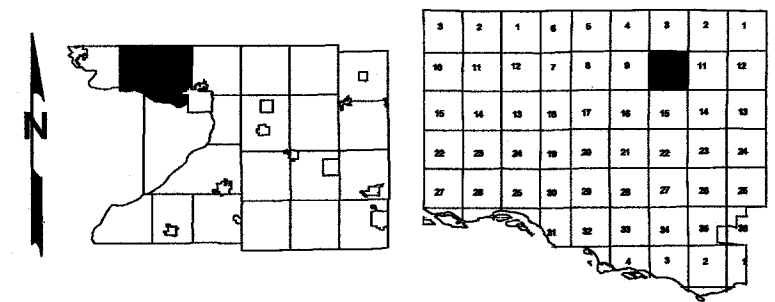

Replaced
2006

-SEE SECTION 3-




-SEE SECTION 15-

Replaced
2006

-SECTION 10-

LEWISTON
SEC. II T13N R8E

Replaced
2002

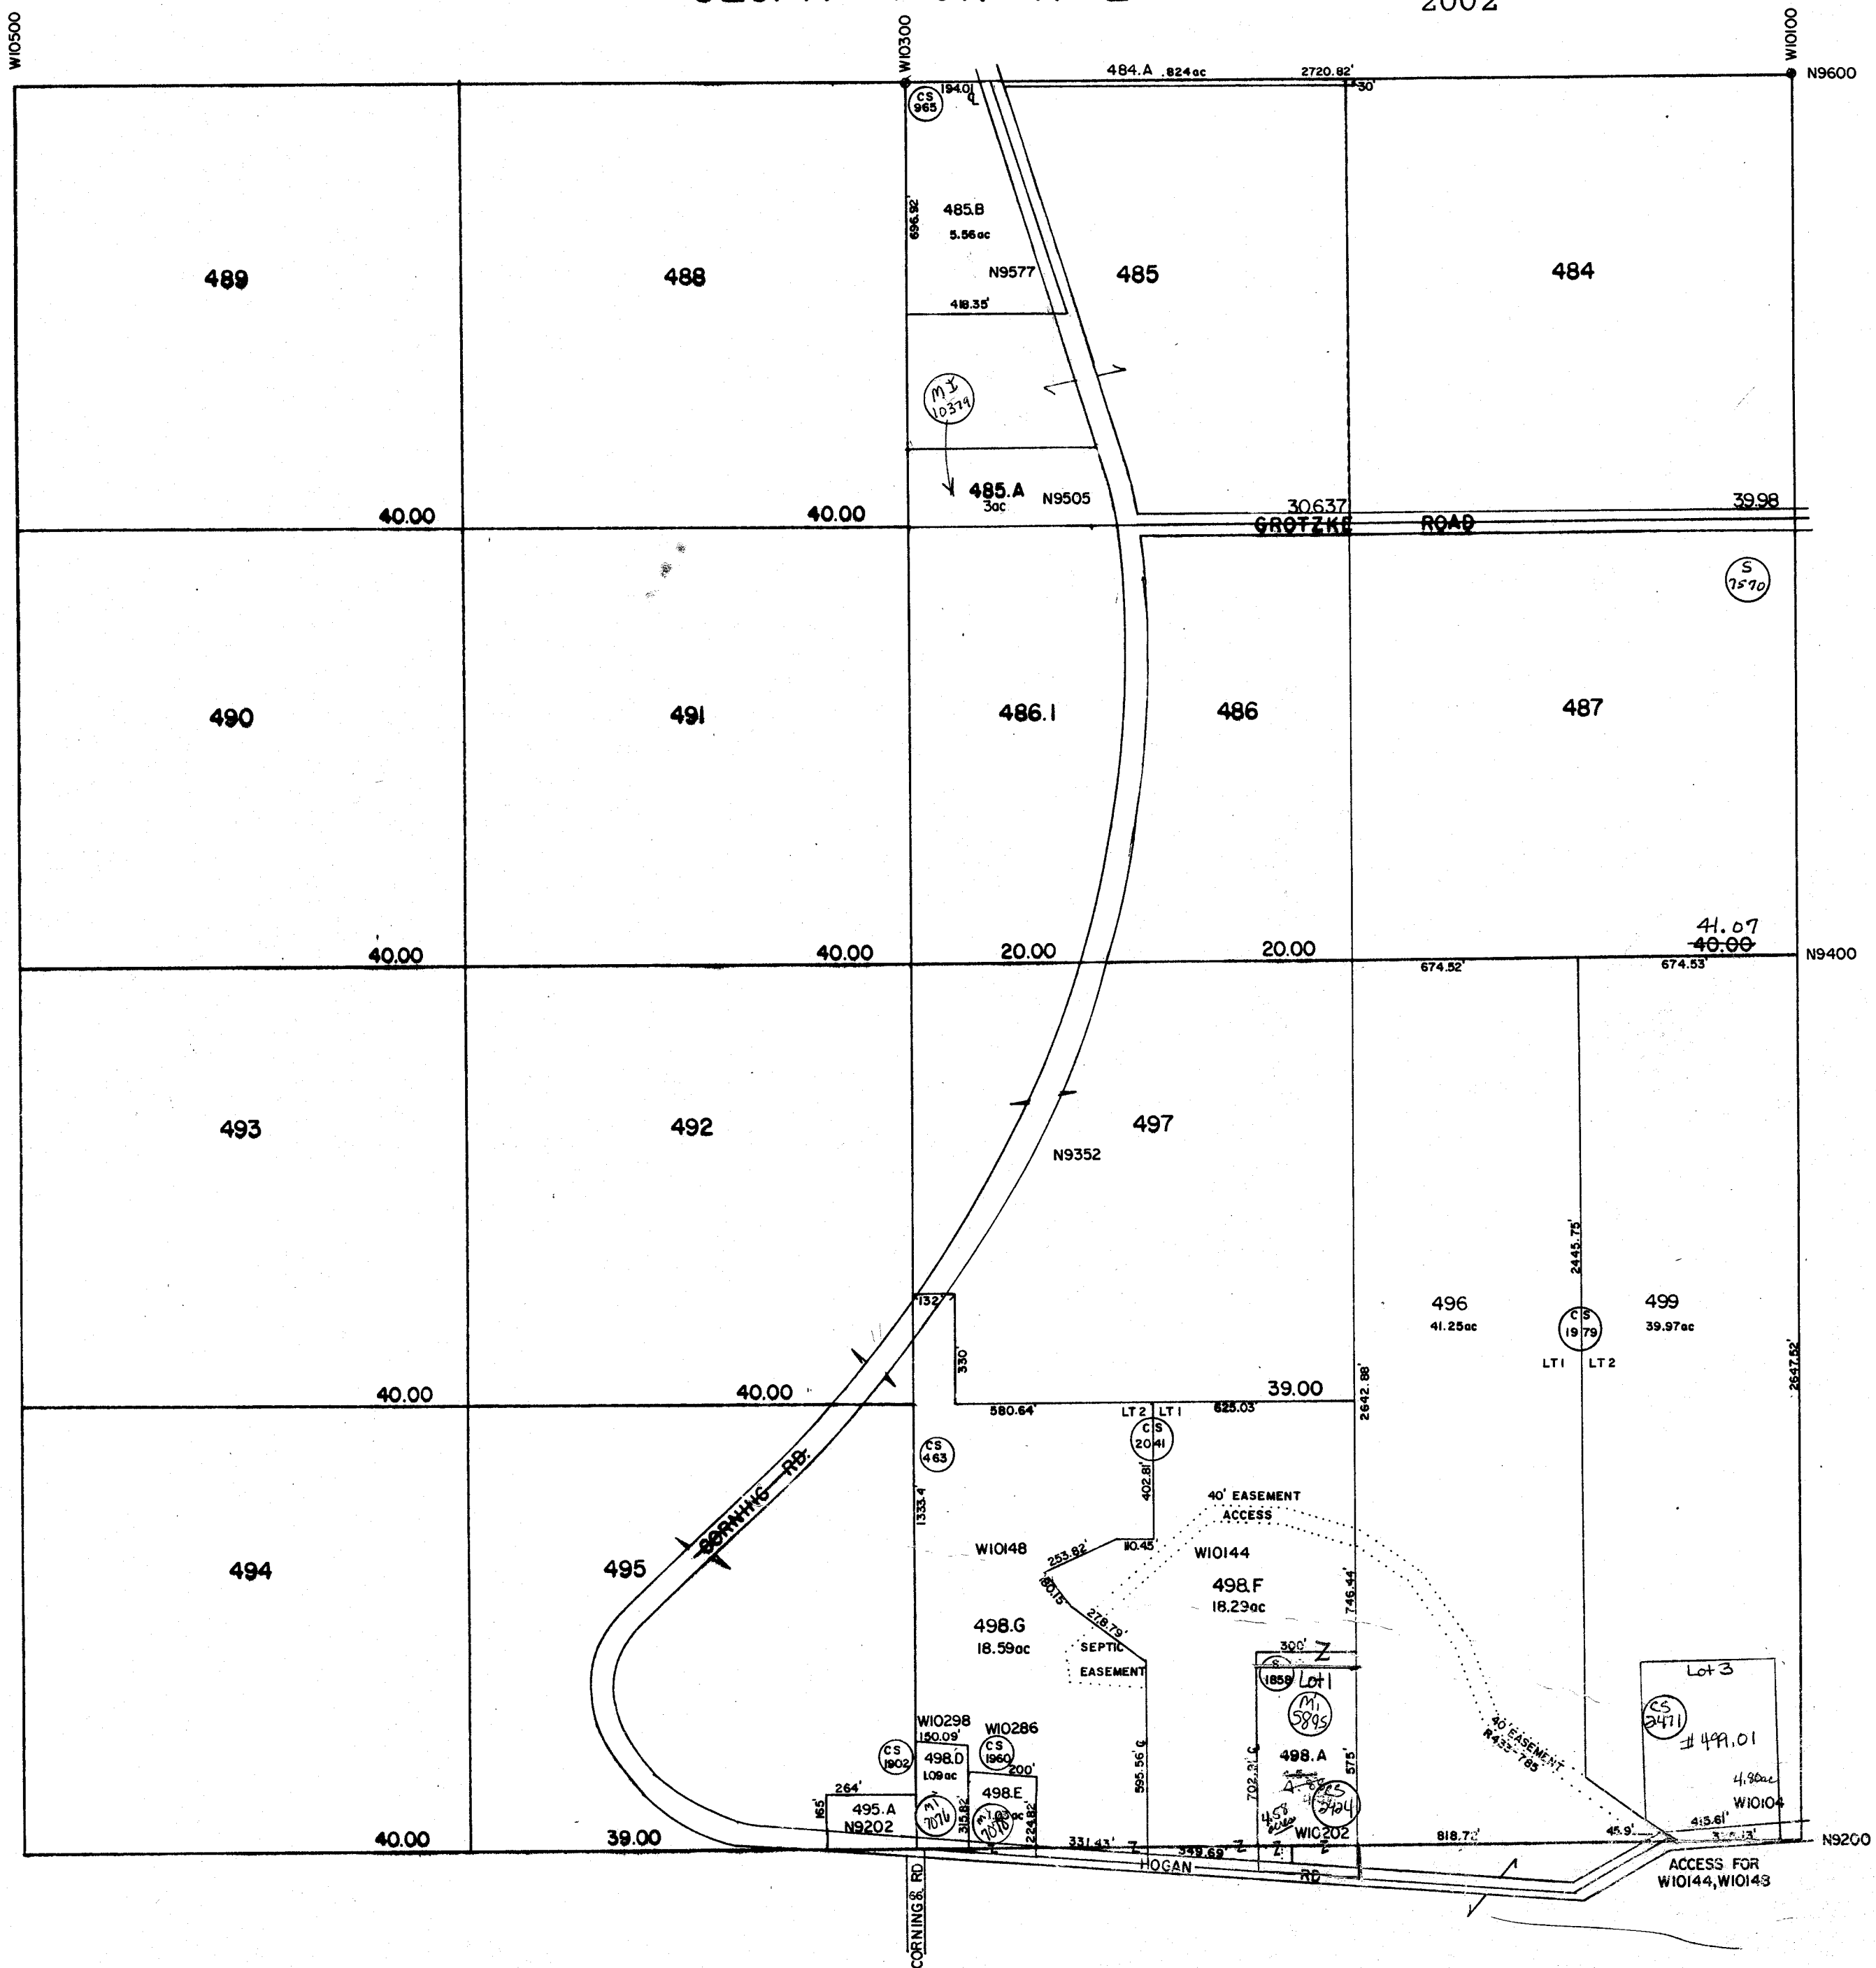

One Inch Equals Four Hundred Feet

MILES
0 1/16 1/8 1/4

FEET
0 400 800 1200 1600



NOTE: This map was prepared for assessment use in accordance with the Wis. St. Stat. Chap. 70.09. All information contained herein is advisory only. Map accuracy is limited to the quality of data obtained from other Public Records. This map is not intended to be a substitute for an actual field survey. Public Land Survey Base is derived from U.S.G.S. Topographic maps unless otherwise noted. Other sources of the Land Base may be actual survey data. Base map data is from the April 1995 County Digital Orthophotos and/or U.S.G.S. 1:24,000 scale Topographic series. The user is responsible for the improper use of the data contained herein.

Created by The Columbia County Land Information Office -GIS Section. VMB.
September 2002.

TOWN of LEWISTON

TOWN 13 NORTH RANGE 8 EAST
COLUMBIA COUNTY, WISCONSIN

Replaced
2004

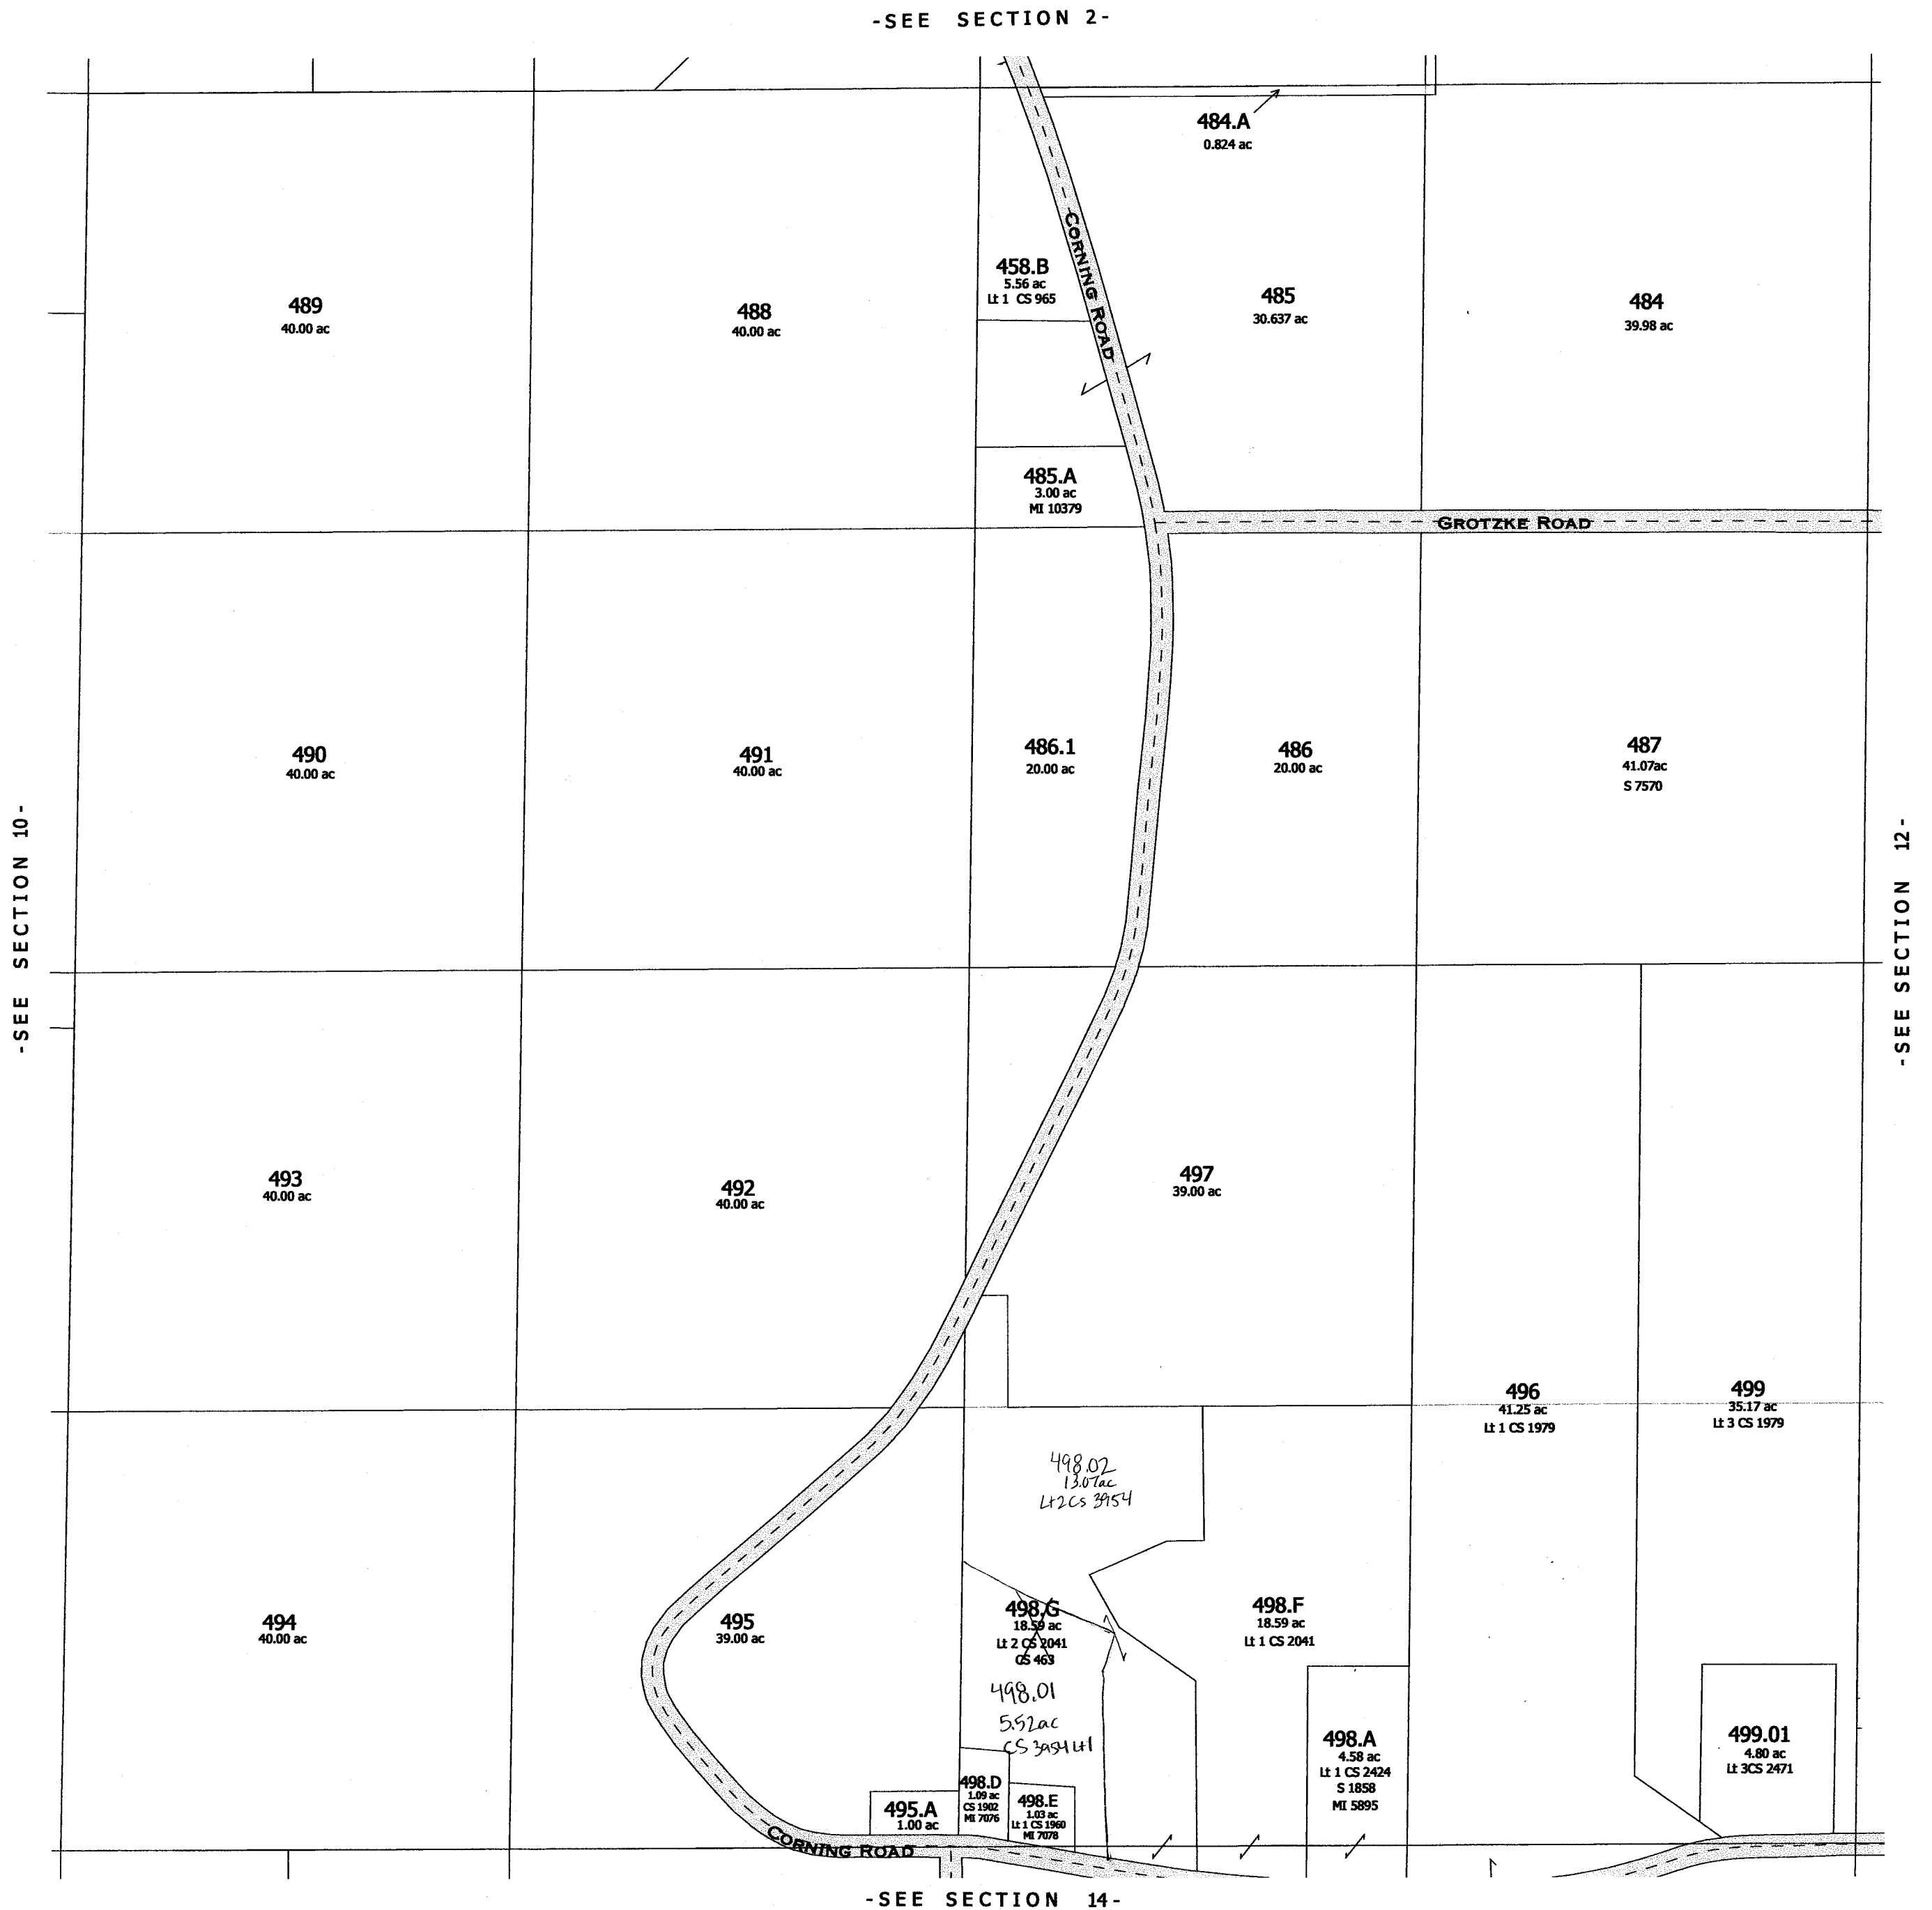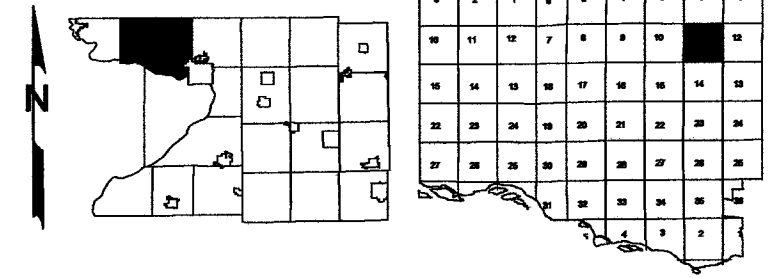

replaced 2004
-SECTION 11-

One Inch Equals Four Hundred Feet

MILES
0 1/16 1/8 1/4
FEET
0 400 800 1200 1600


NOTE: This map was prepared for assessment use in accordance with the Wis. St. Stat. Chap. 70.09. All information contained herein is advisory only. Map accuracy is limited to the quality of data obtained from other Public Records. This map is not intended to be a substitute for an actual field survey. Public Land Survey Base is derived from U.S.G.S. Topographic maps unless otherwise noted. Other sources of the Land Base may be actual survey data. Base map data is from the April 1995 County Digital Orthophotos and/or U.S.G.S. 1:24,000 scale Topographic series. The user is responsible for the improper use of the data contained herein.

Created by The Columbia County Land Information Office -GIS Section. VMB.
March 2004.


TAX PARCEL MAP

TOWN of LEWISTON

TOWN 13 NORTH RANGE 8 EAST
COLUMBIA COUNTY, WISCONSIN

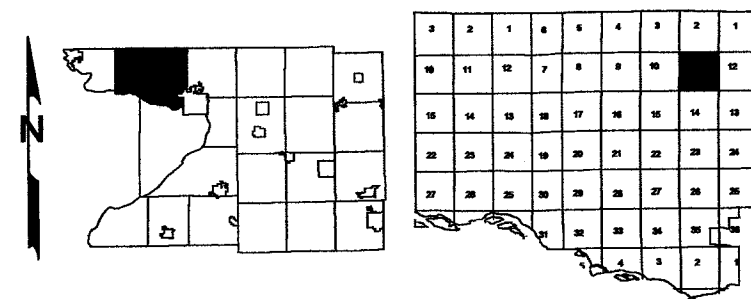



Replaced
2005

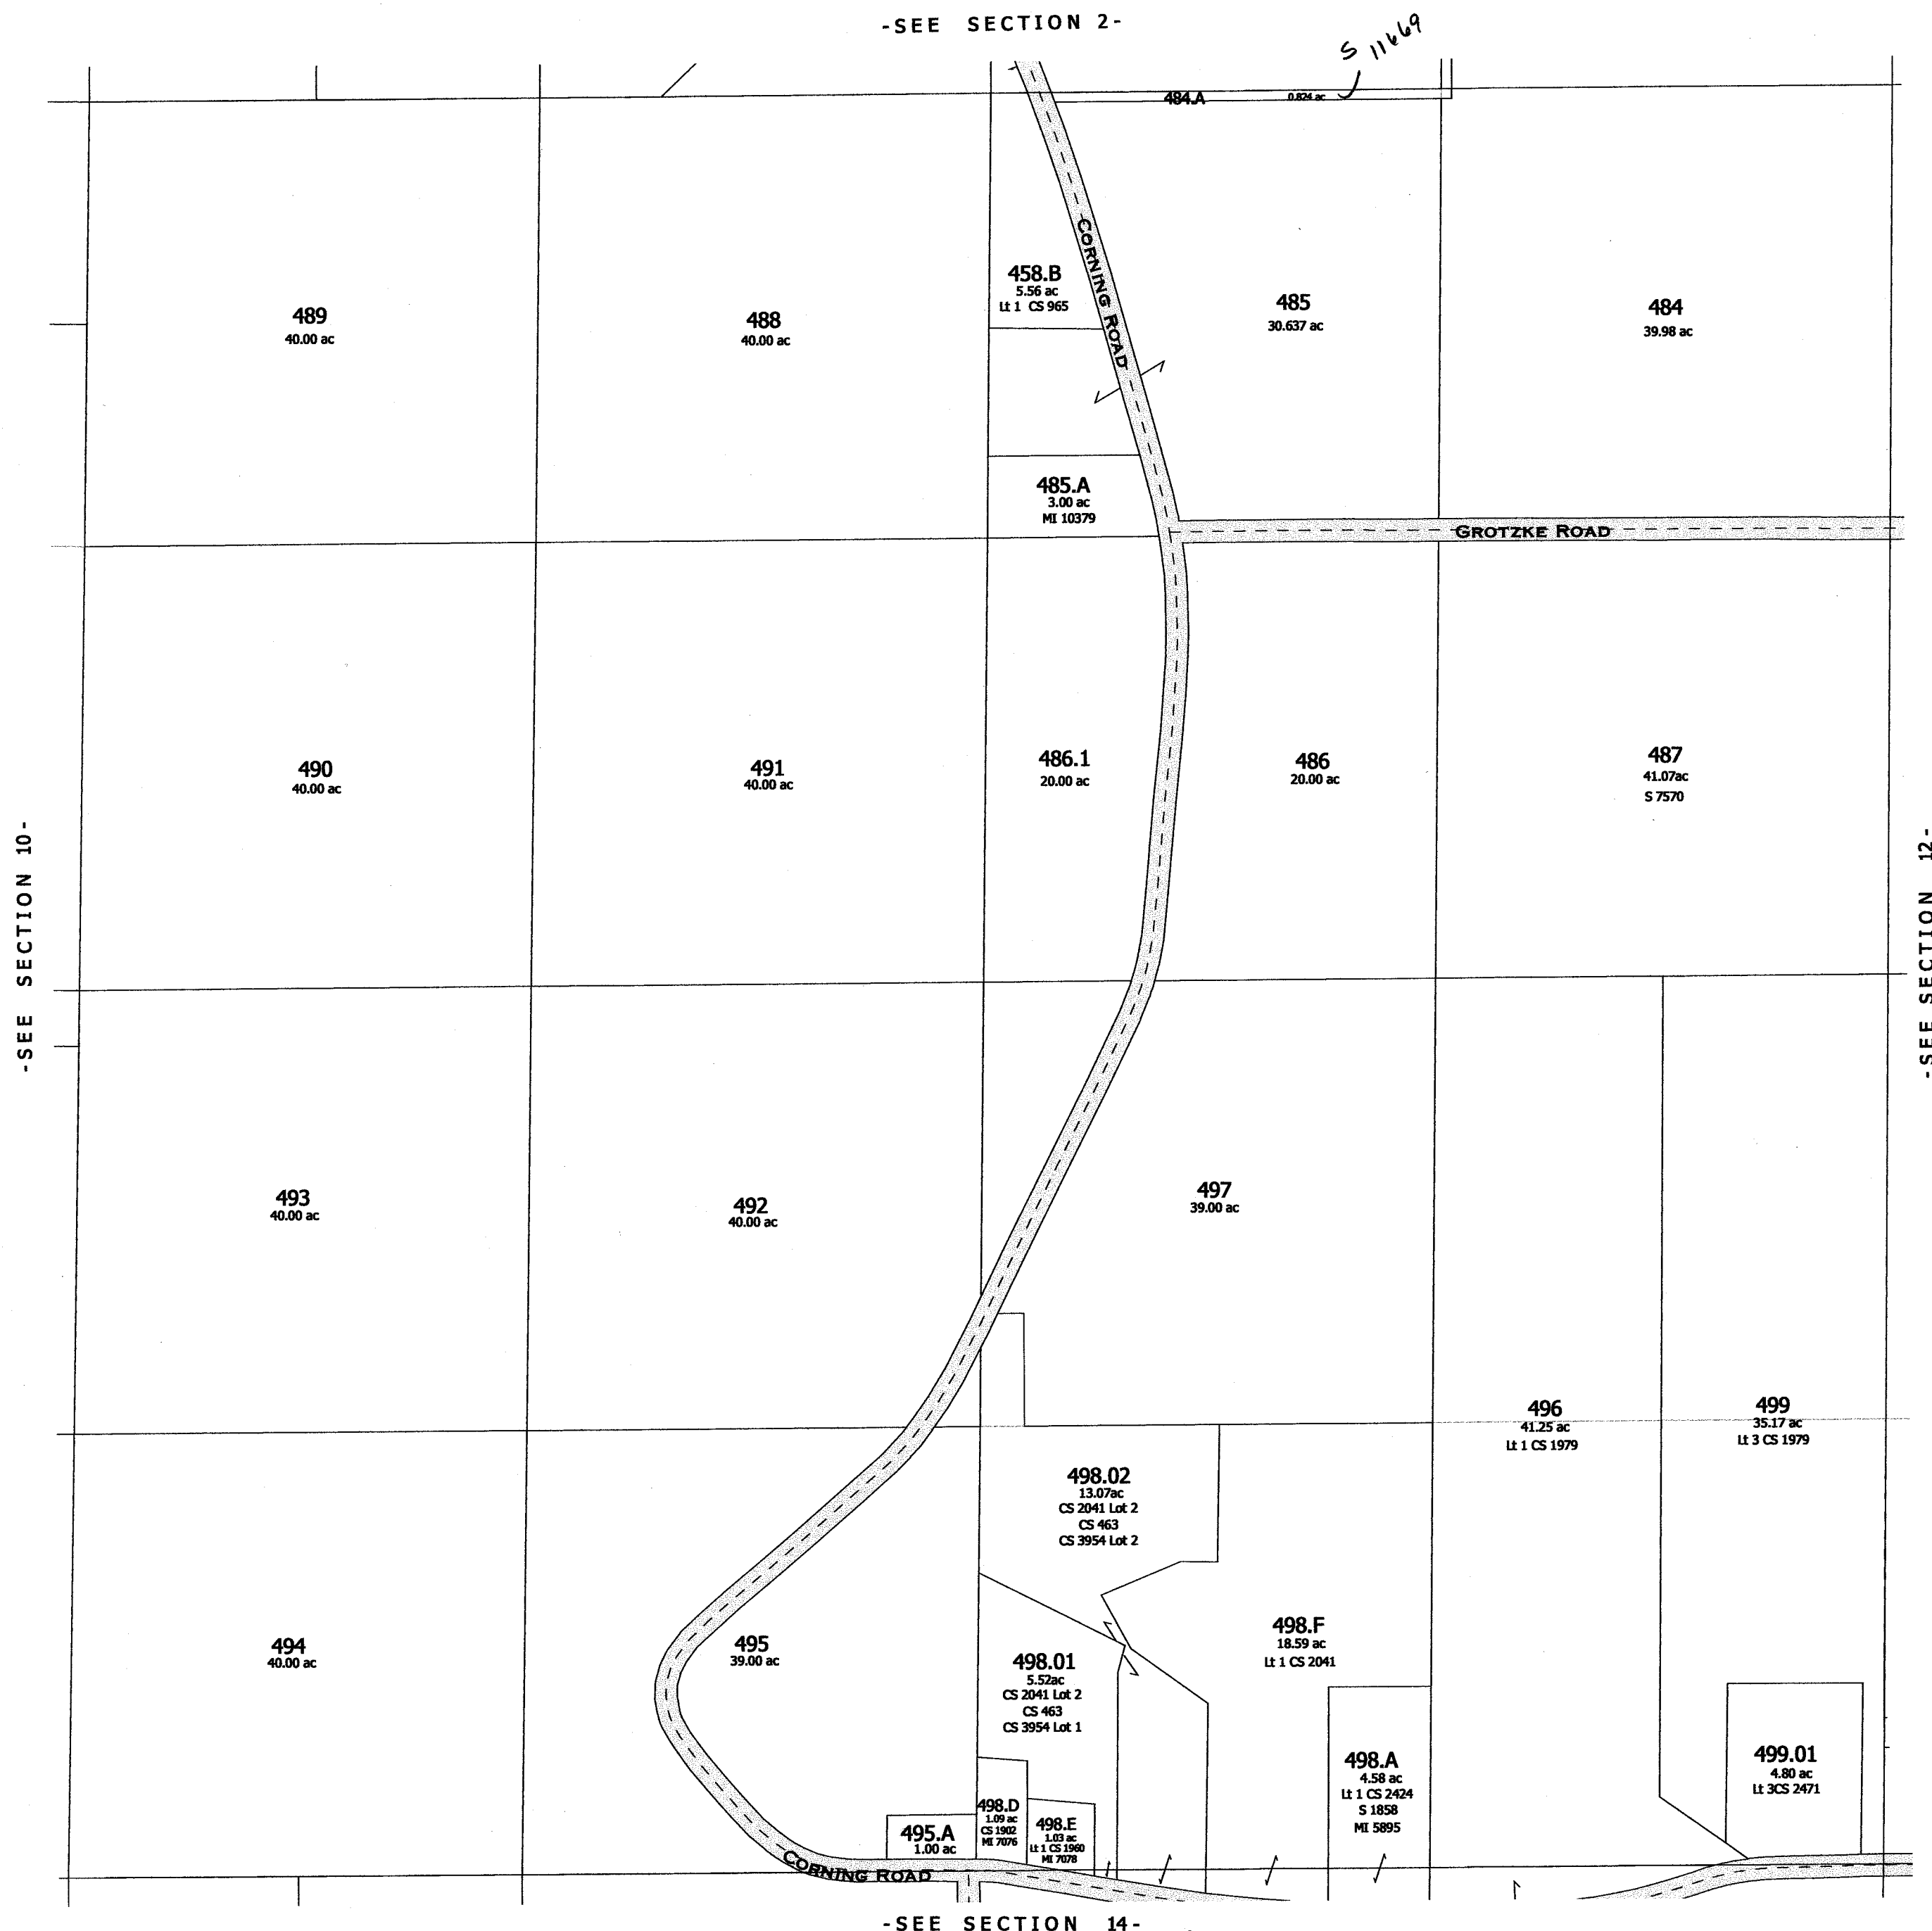

2005
-SECTION 11-

Replaced
2002

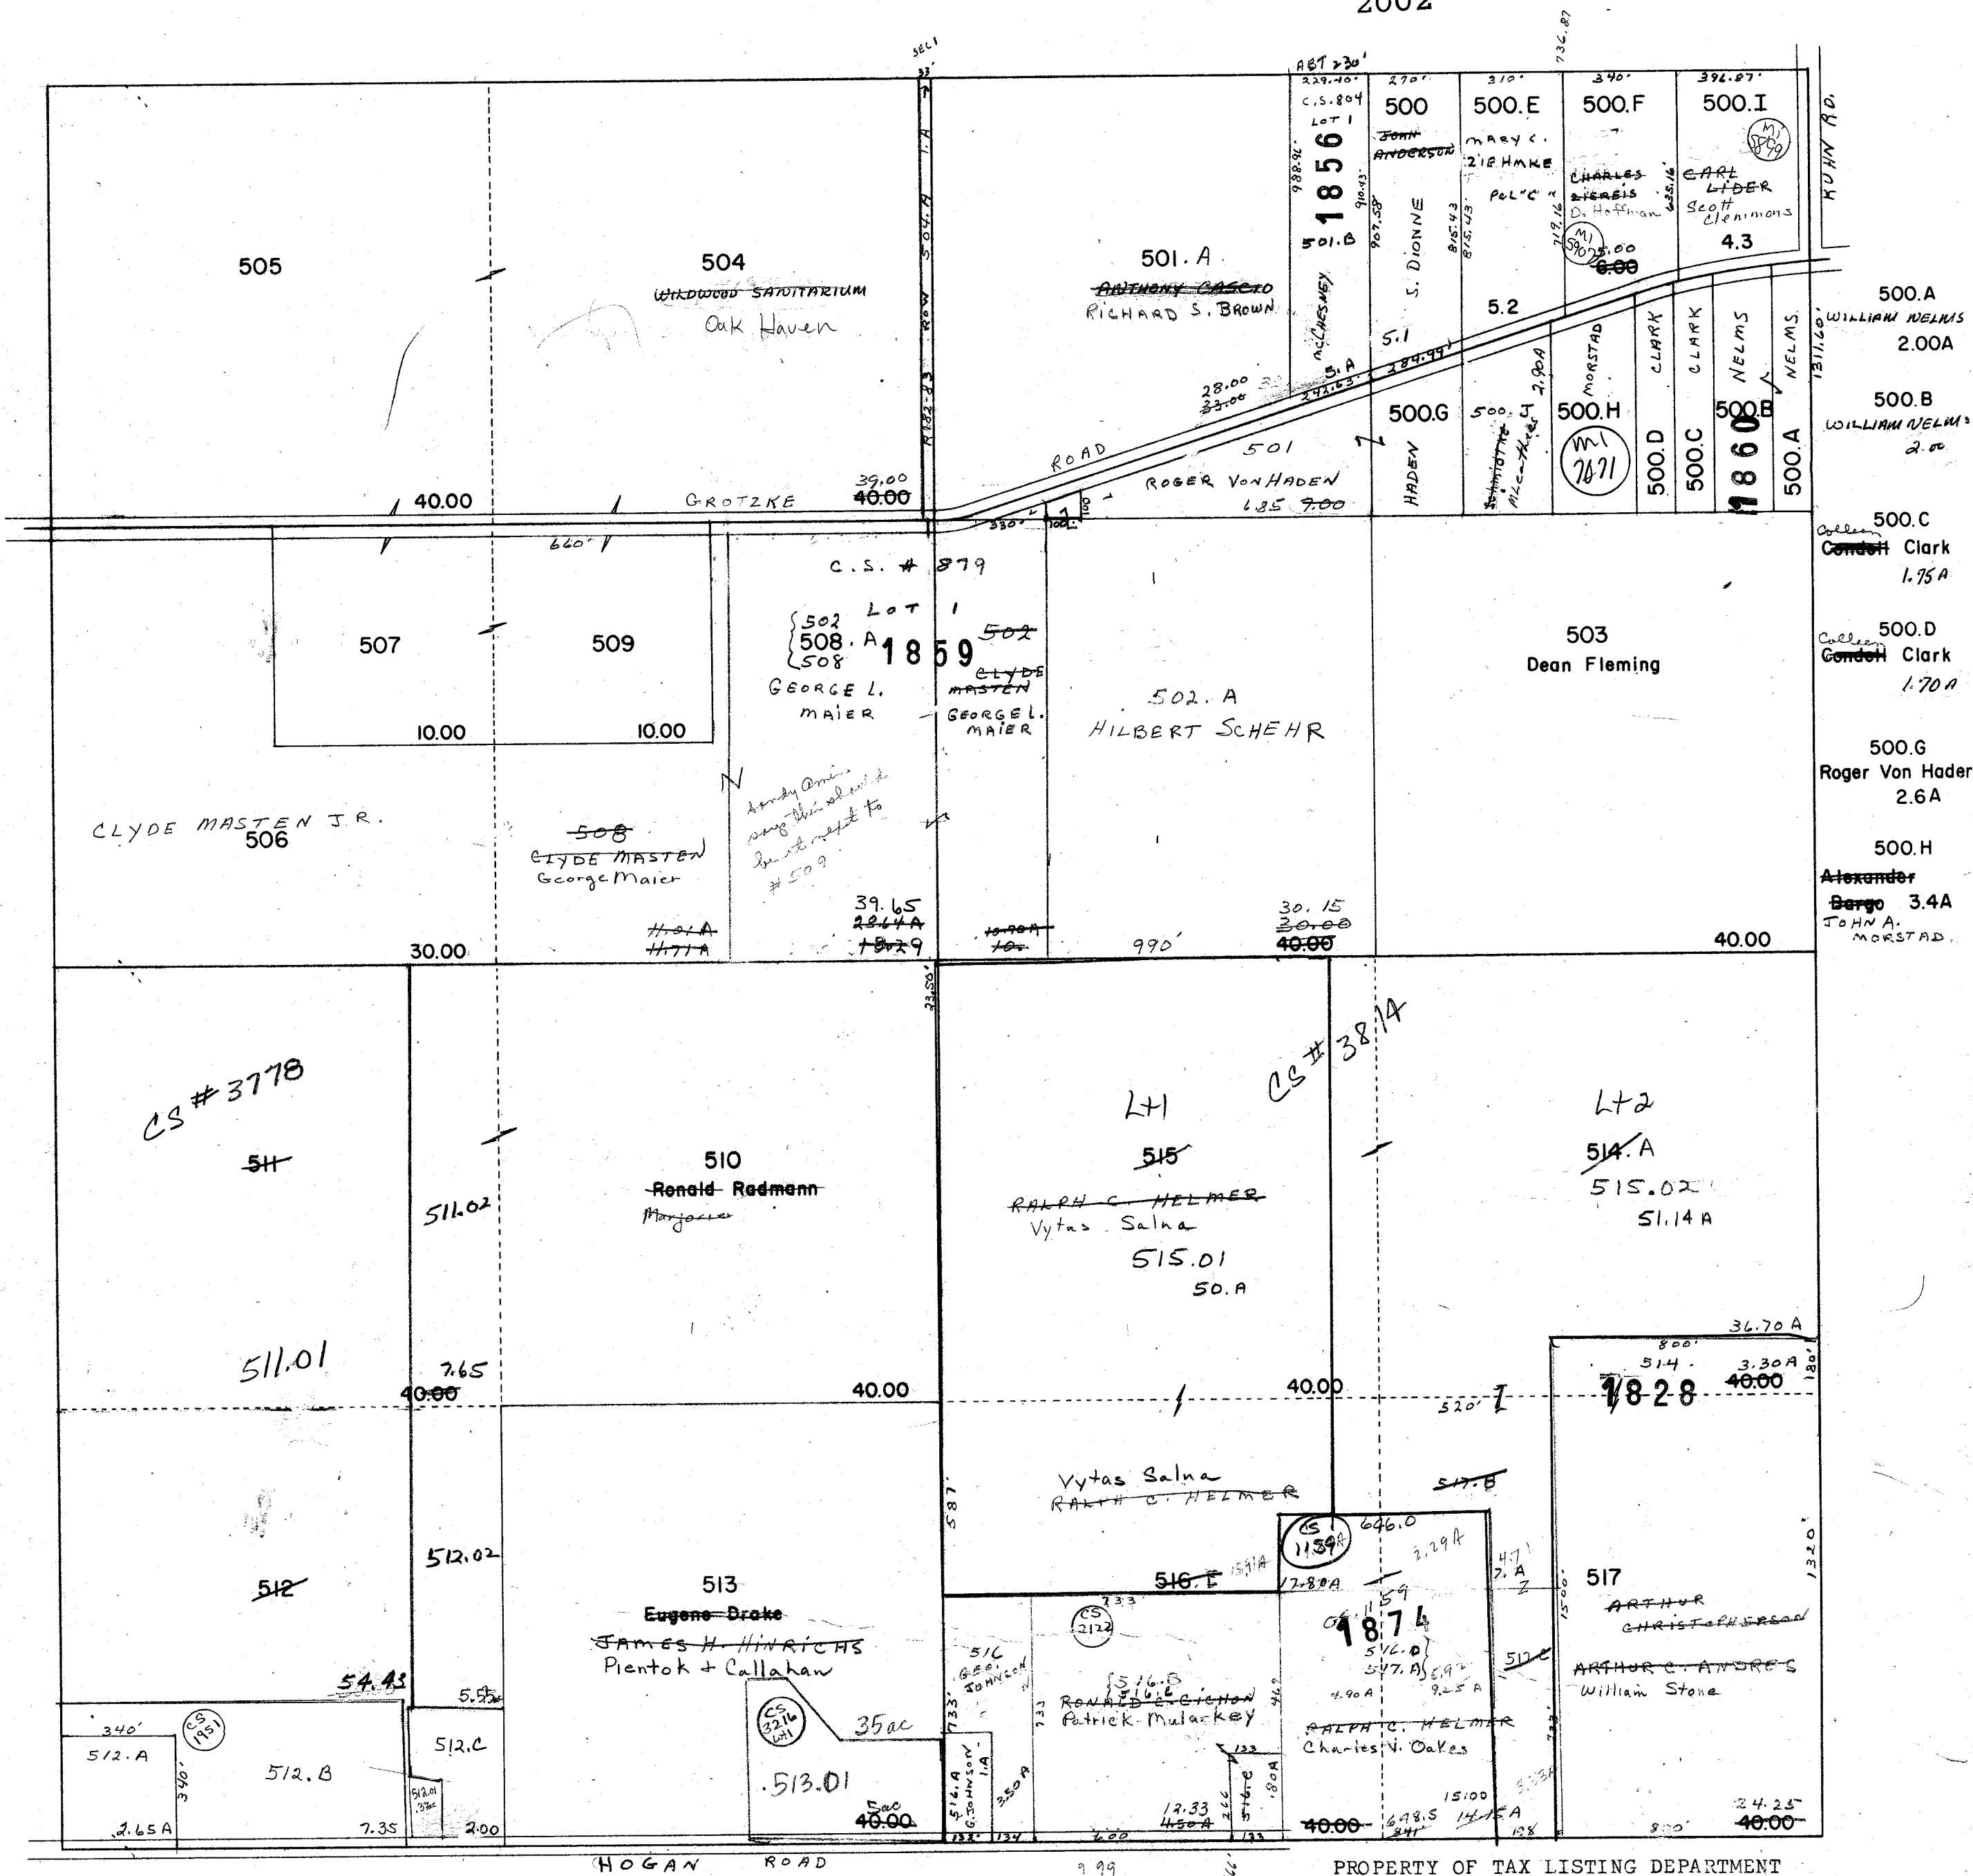

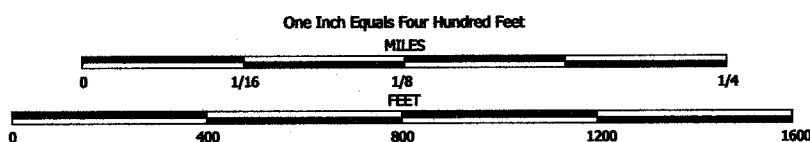



NOTE: This map was prepared for assessment use in accordance with the Wis. St. Stat. Chap. 70.09. All information contained herein is advisory only. Map accuracy is limited to the quality of data obtained from other Public Records. This map is not intended to be a substitute for an actual field survey. Public Land Survey Base is derived from U.S.G.S. Topographic maps unless otherwise noted. Other sources of the Land Base may be actual survey data. Base map data is from the April 1995 County Digital Orthophotos and/or U.S.G.S. 1:24,000 scale Topographic series. The user is responsible for the improper use of the data contained herein.

Created by The Columbia County Land Information Office -GIS Section. VMB.
September 2002.

TAX PARCEL MAP

TOWN of LEWISTON

TOWN 13 NORTH RANGE 8 EAST
COLUMBIA COUNTY, WISCONSIN

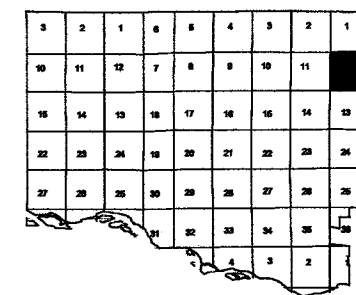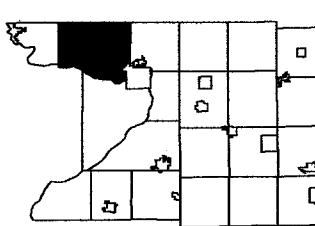

Replaced
2003


-SEE SECTION 1-



-SEE SECTION 13-


replaced 2003
-SECTION 12-

Replaced
2002

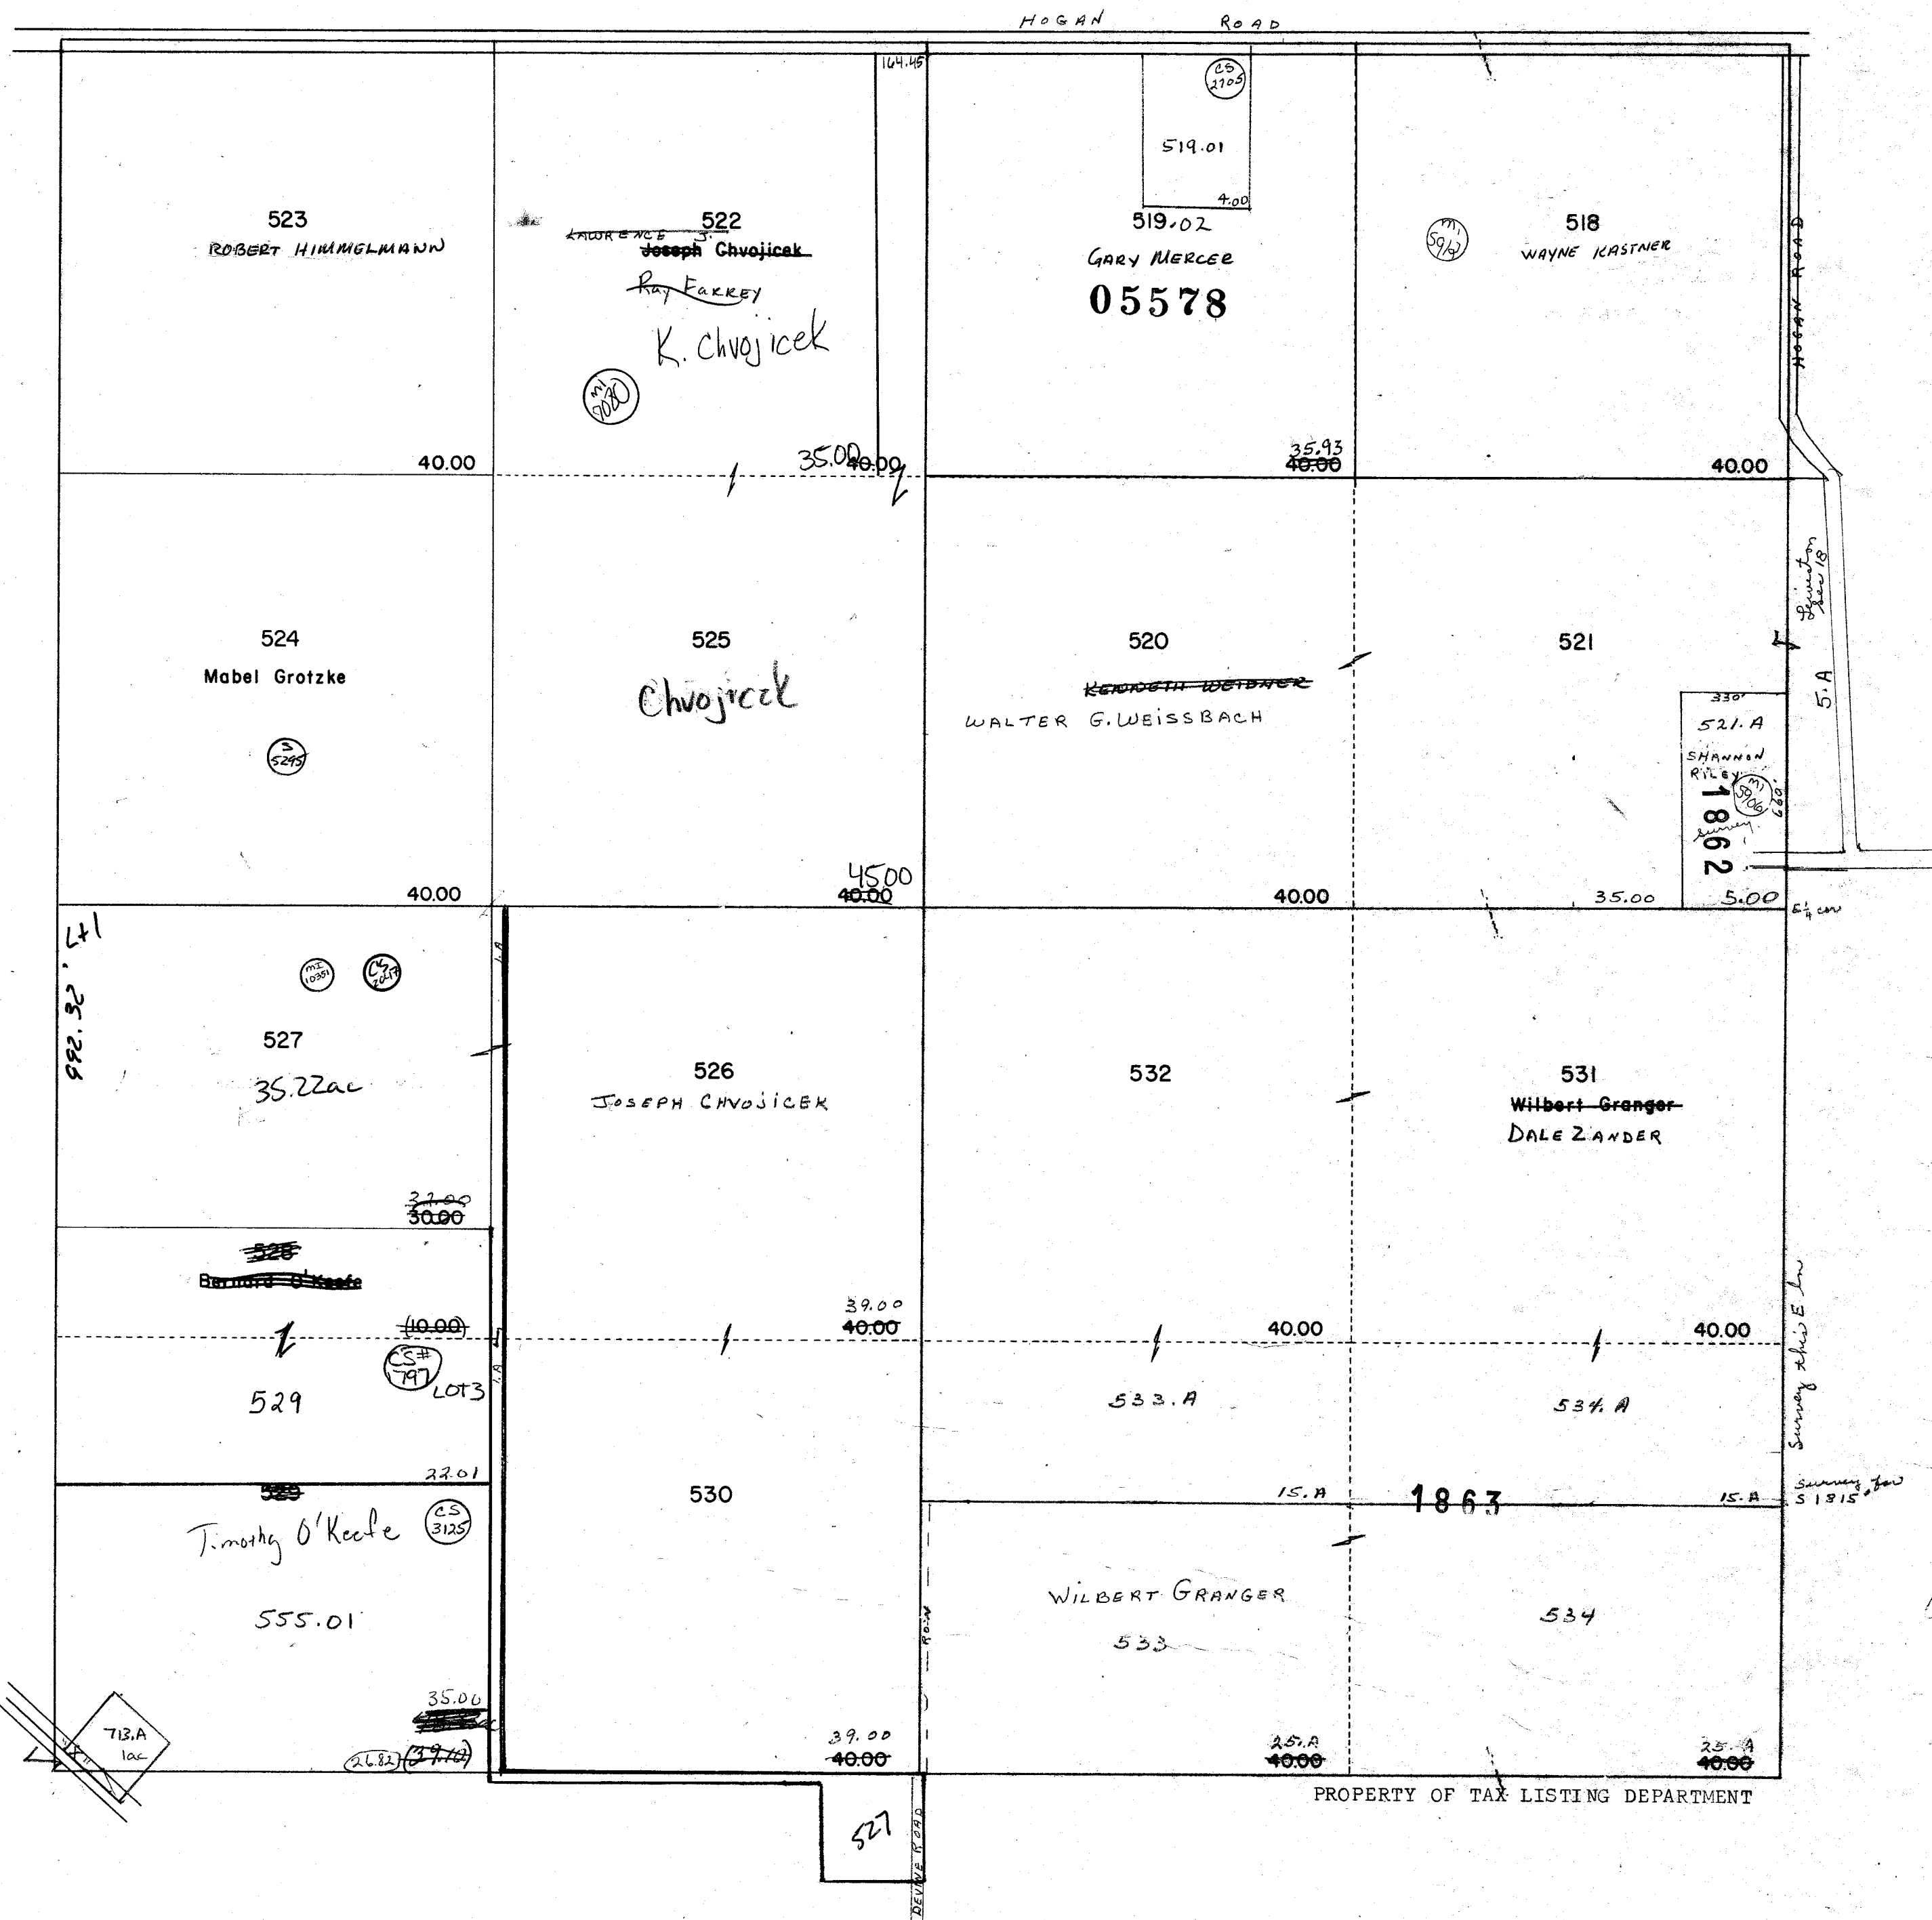


One Inch Equals Four Hundred Feet
MILES
0 1/16 1/8 1/4
FEET
0 400 800 1200 1600
NOTE: This map was prepared for assessment use in accordance with the Wis. Stat. Chap. 70.09. All information contained herein is advisory only. Map accuracy is limited to the quality of data obtained from other Public Records. This map is not intended to be a substitute for an actual field survey. Public Land Survey Base is derived from U.S.G.S Topographic maps unless otherwise noted. Other sources of the Land Base may be actual survey data. Base map data is from the April 1995 County Digital Orthophotos and/or U.S.G.S. 1:24,000 scale Topographic series. The user is responsible for the improper use of the data contained herein.
Created by The Columbia County Land Information Office -GIS Section. VMB.
September 2002.

TAX PARCEL MAP
TOWN of LEWISTON
TOWN 13 NORTH RANGE 8 EAST
COLUMBIA COUNTY, WISCONSIN

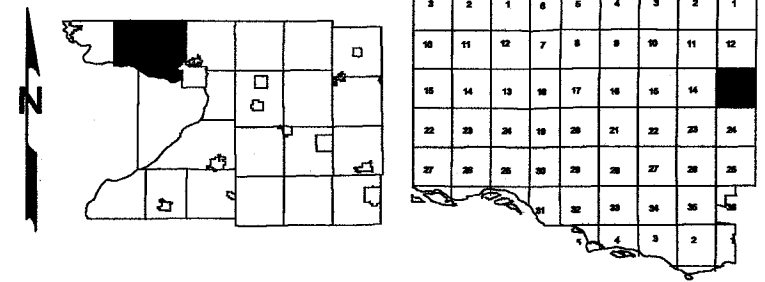


Replaced
2006


-SEE SECTION 12-

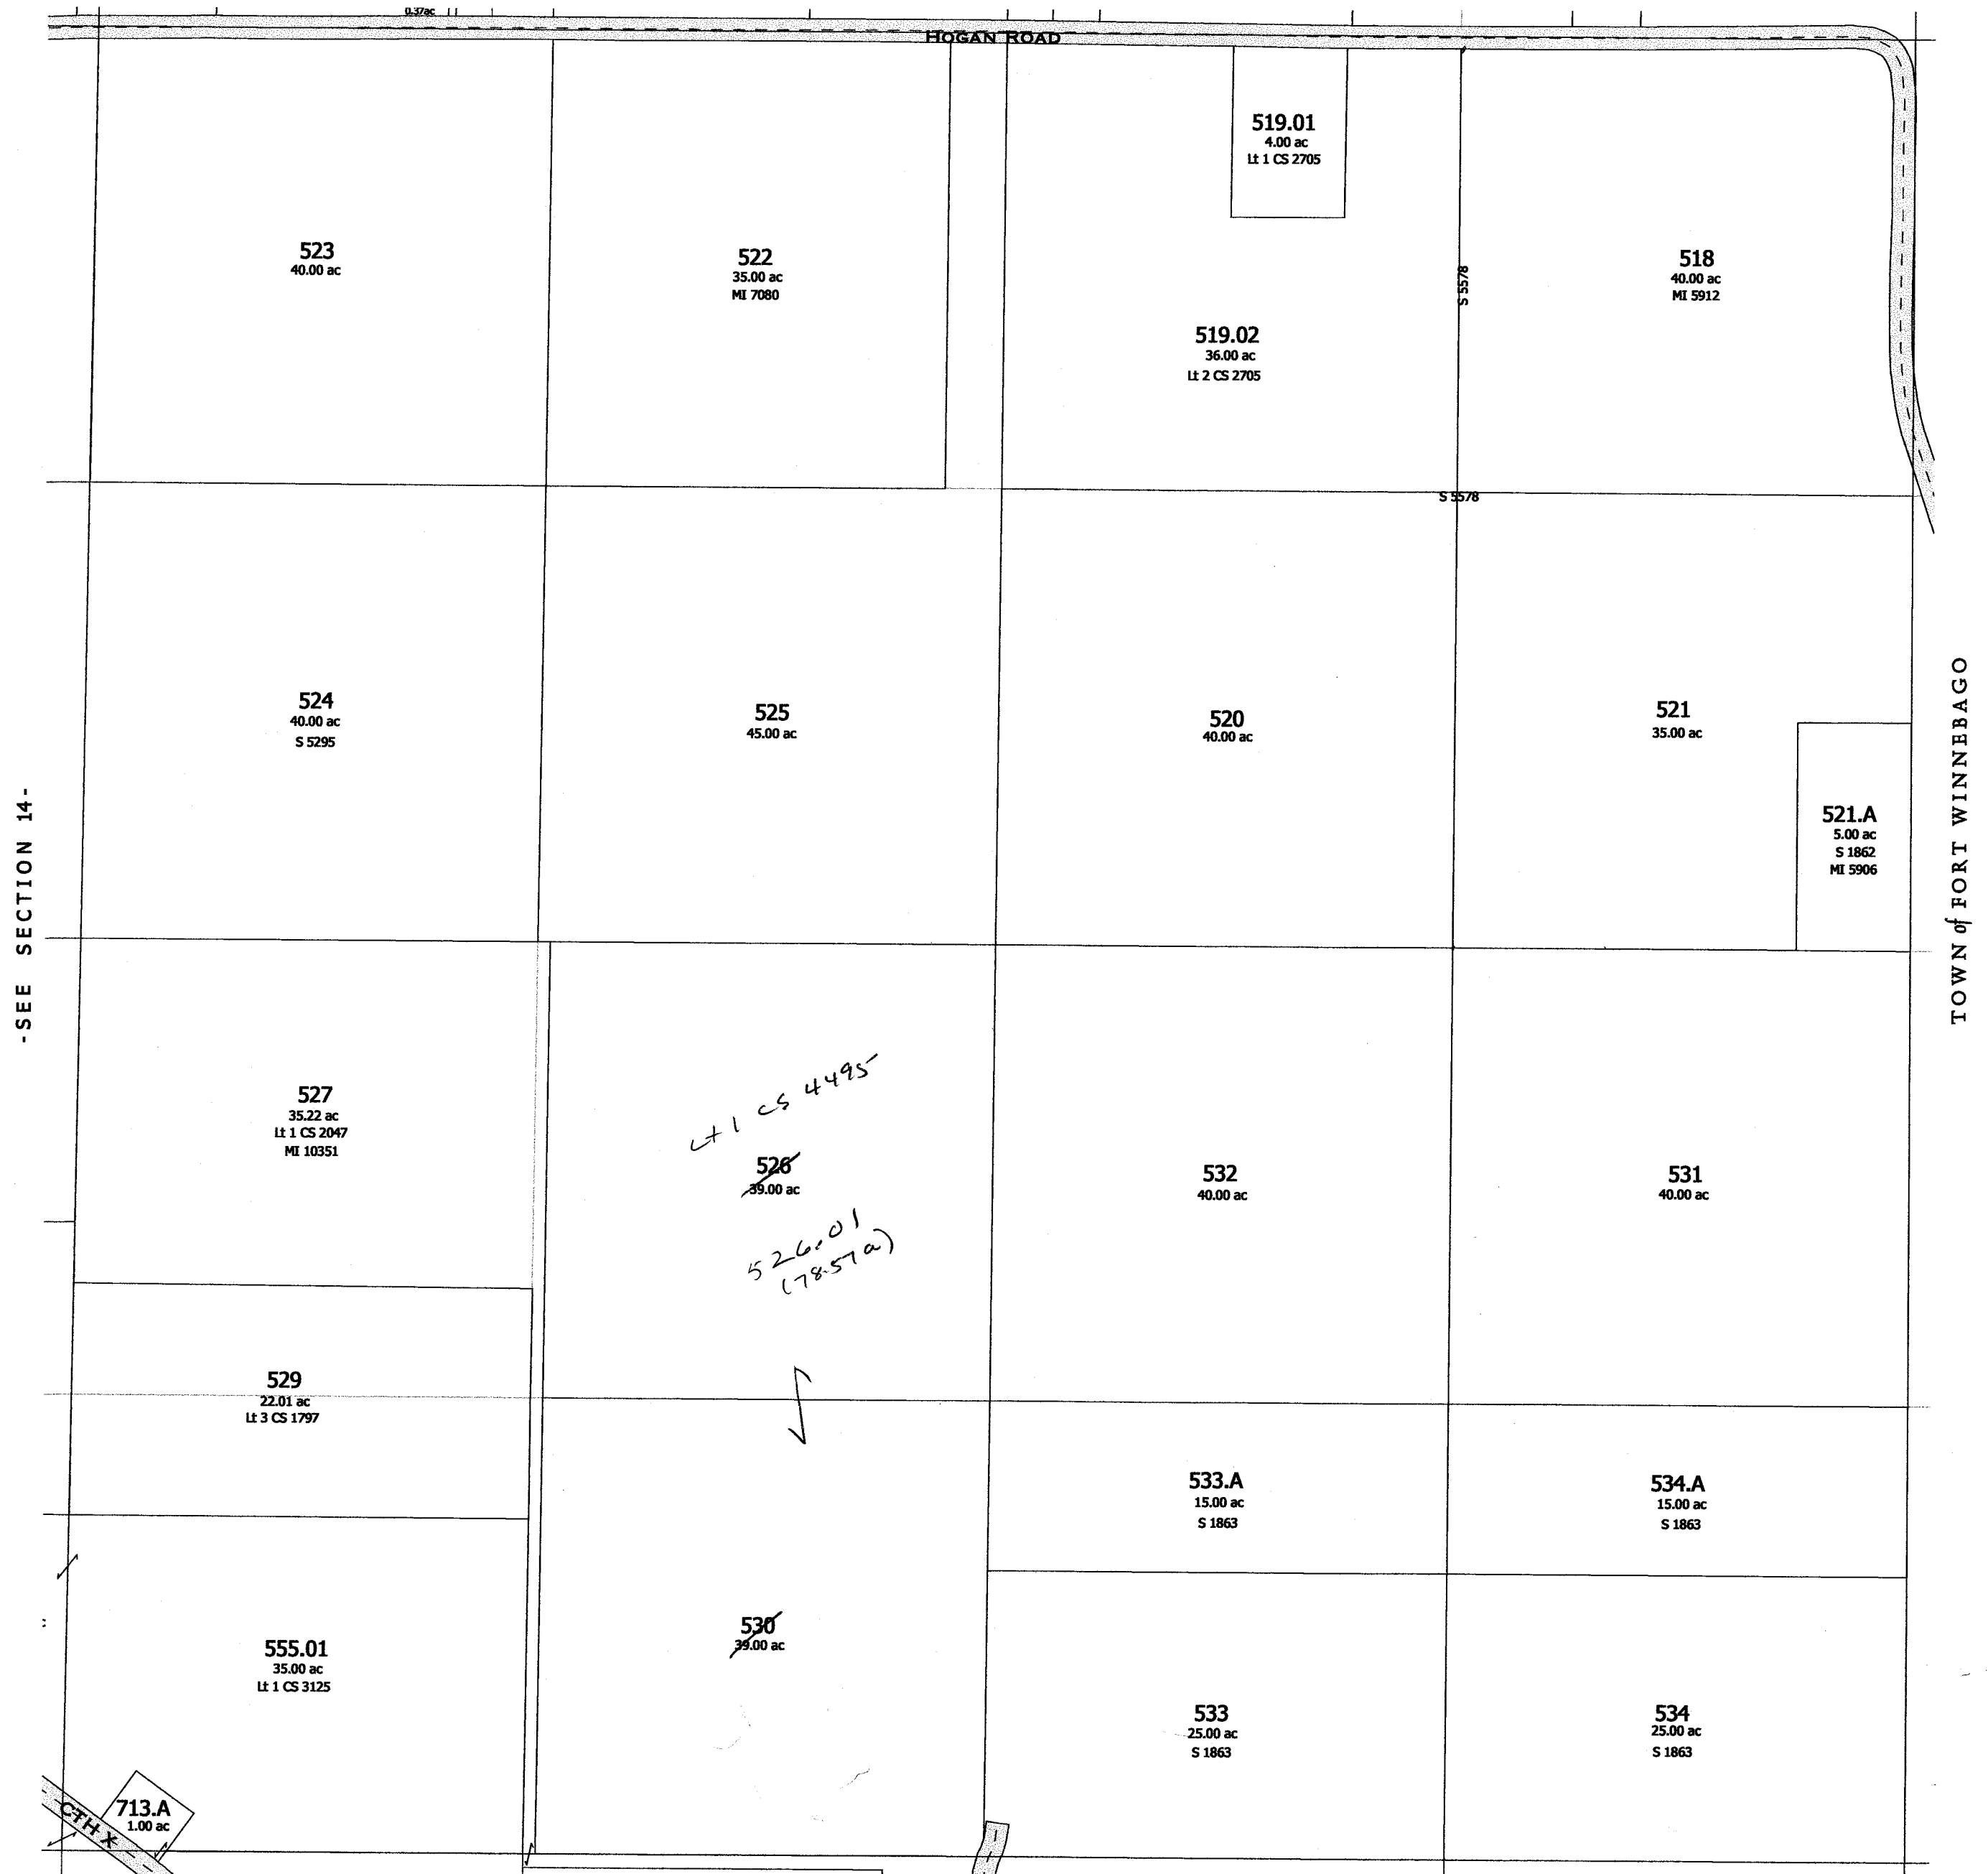

2006

Replaced
2002

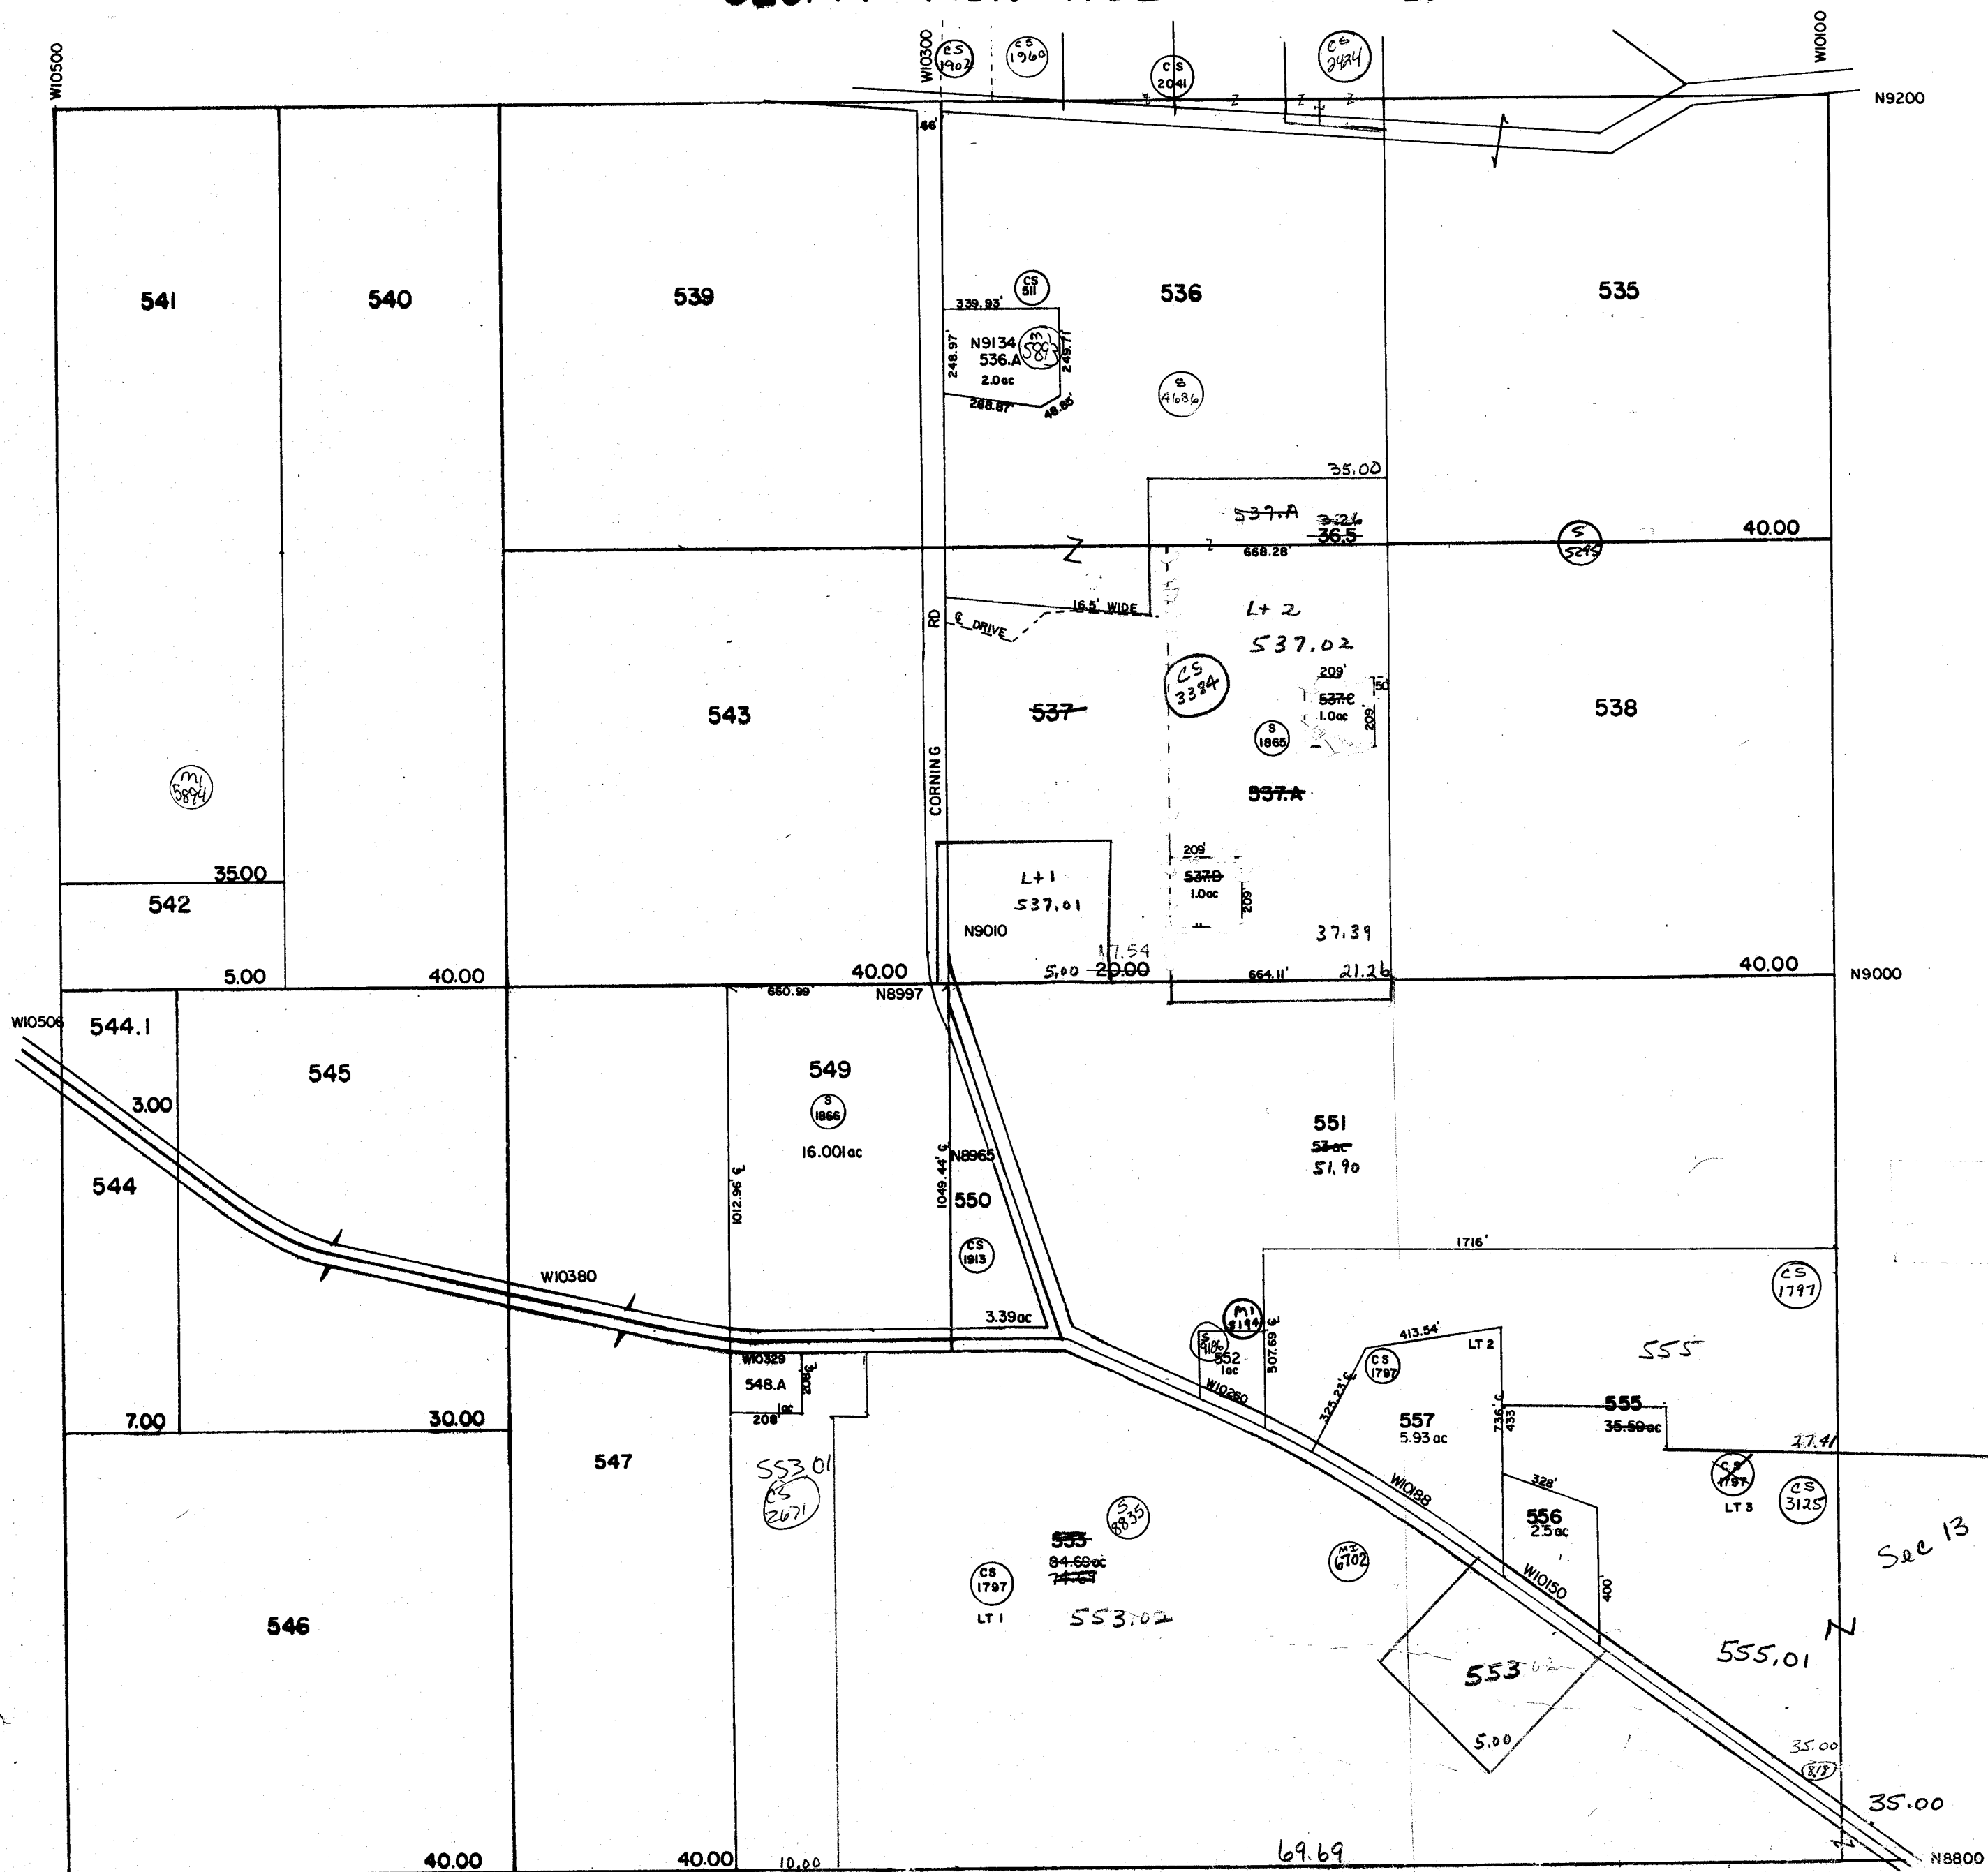

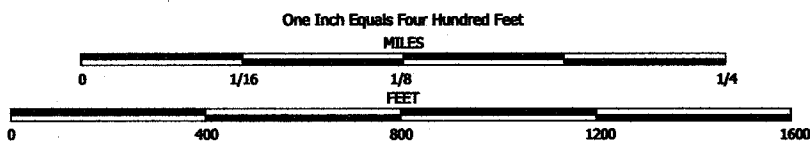



NOTE: This map was prepared for assessment use in accordance with the Wis. St. Stat. Chap. 70.09. All information contained herein is advisory only. Map accuracy is limited to the quality of data obtained from other Public Records. This map is not intended to be a substitute for an actual field survey. Public Land Survey Base is derived from U.S.G.S. Topographic maps unless otherwise noted. Other sources of the Land Base may be actual survey data. Base map data is from the April 1995 County Digital Orthophotos and/or U.S.G.S. 1:24,000 scale Topographic series. The user is responsible for the improper use of the data contained herein.

Created by The Columbia County Land Information Office -GIS Section, VMB.
September 2002.

TAX PARCEL MAP


TOWN of LEWISTON

TOWN 13 NORTH RANGE 8 EAST
COLUMBIA COUNTY, WISCONSIN

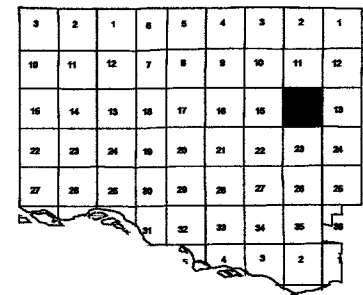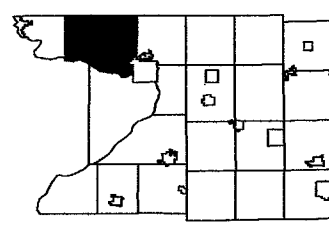

Replaced
2004


-SEE SECTION 11-

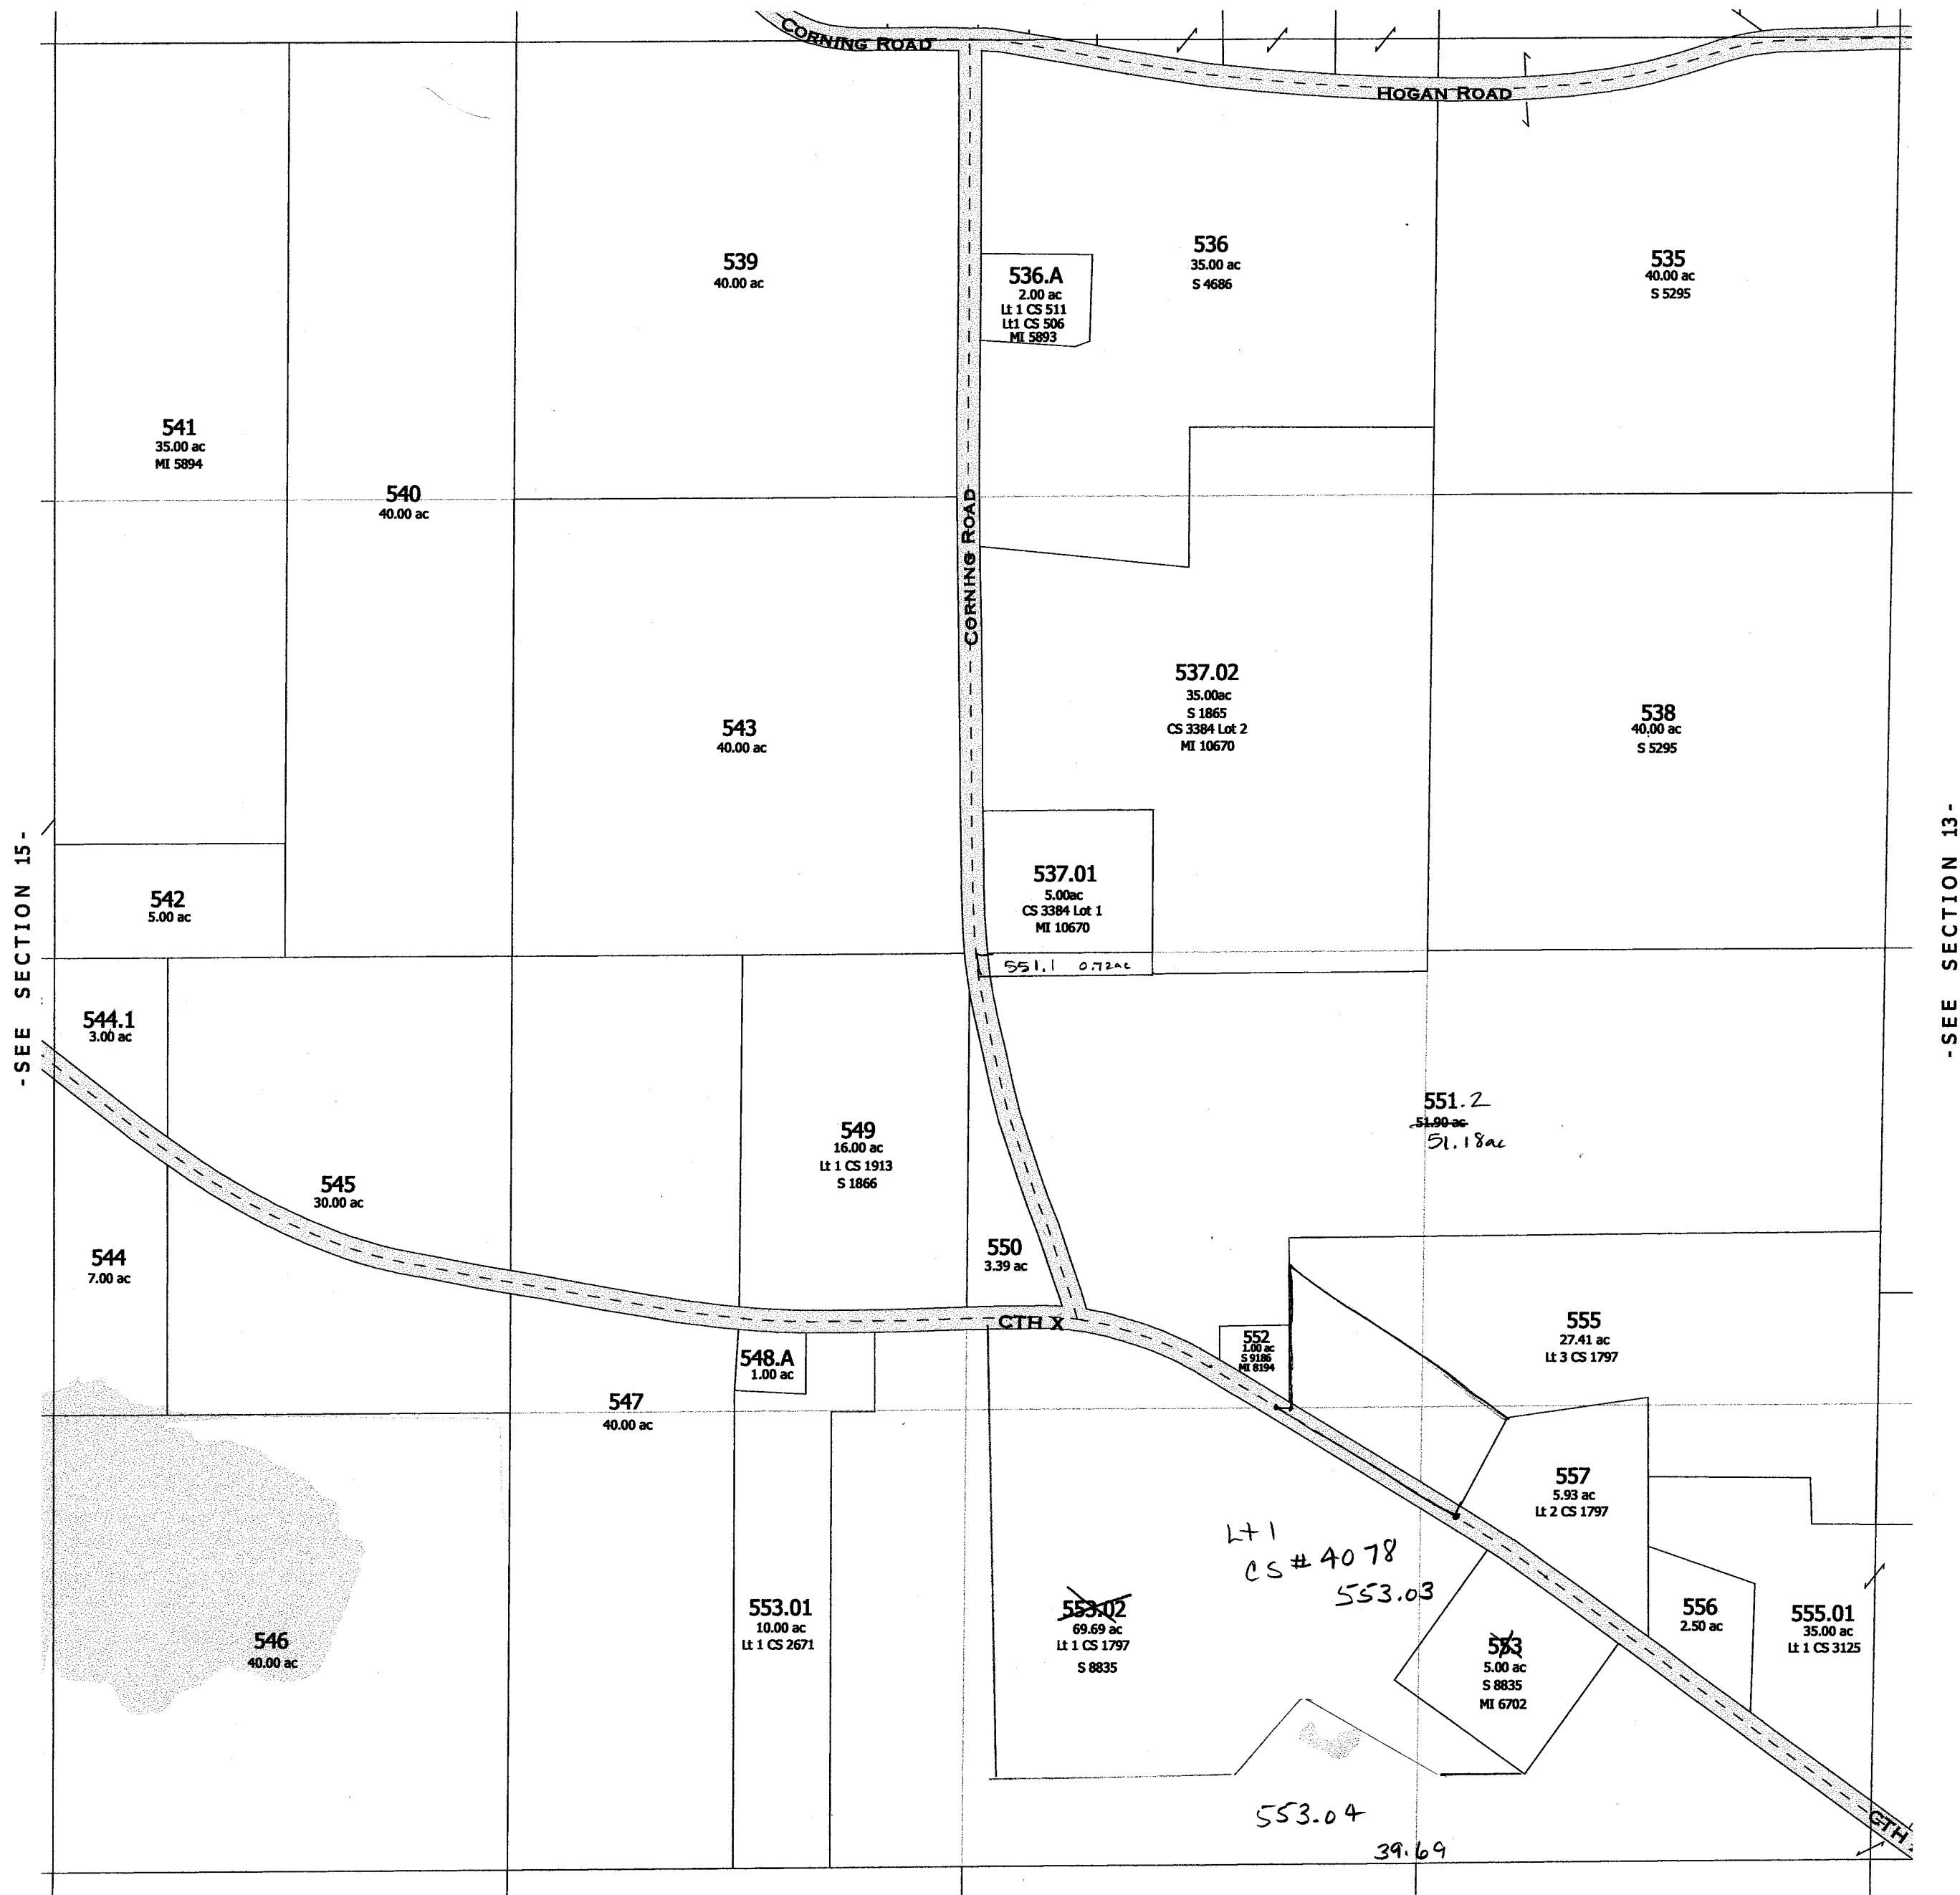

-SEE SECTION 13-

-SEE SECTION 23-

Replaced 2004
-SECTION 14-

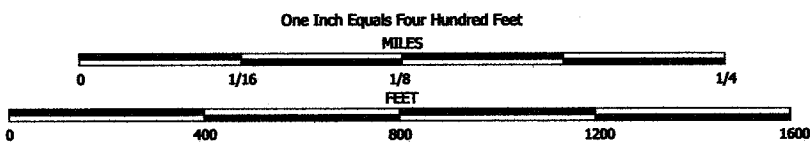



NOTE: This map was prepared for assessment use in accordance with the Wis. St. Stat. Chap. 70.09. All information contained herein is advisory only. Map accuracy is limited to the quality of data obtained from other Public Records. This map is not intended to be a substitute for an actual field survey. Public Land Survey Base is derived from U.S.G.S. Topographic maps unless otherwise noted. Other sources of the Land Base may be actual survey data. Base map data is from the April 1995 County Digital Orthophotos and/or U.S.G.S. 1:24,000 scale Topographic series. The user is responsible for the improper use of the data contained herein.

Created by The Columbia County Land Information Office -GIS Section, YMB.
March 2004.

TAX PARCEL MAP

TOWN of LEWISTON


TOWN 13 NORTH RANGE 8 EAST
COLUMBIA COUNTY, WISCONSIN

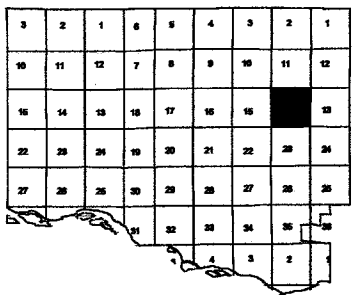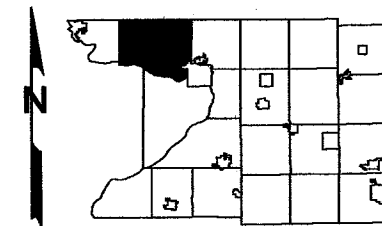

Replaced
2005



-SECTION 14-

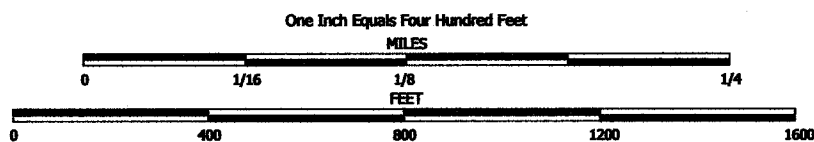


NOTE: This map was prepared for assessment use in accordance with the Wis. St. Stat. Chap. 70.09. All information contained herein is advisory only. Map accuracy is limited to the quality of data obtained from other Public Records. This map is not intended to be a substitute for an actual field survey. Public Land Survey Base is derived from U.S.G.S. Topographic maps unless otherwise noted. Other sources of the Land Base may be actual survey data. Base map data is from the April 1995 County Digital Orthophotos and/or U.S.G.S. 1:24,000 scale Topographic series. The user is responsible for the improper use of the data contained herein.

Created by The Columbia County Land Information Office -GIS Section. VMB.
February 2005.


TAX PARCEL MAP

TOWN of LEWISTON

TOWN 13 NORTH RANGE 8 EAST
COLUMBIA COUNTY, WISCONSIN

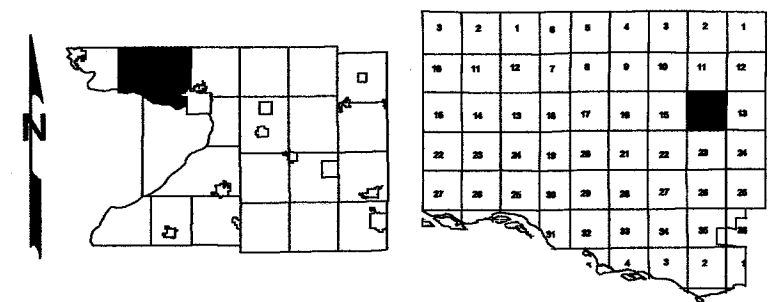


Replaced
2006

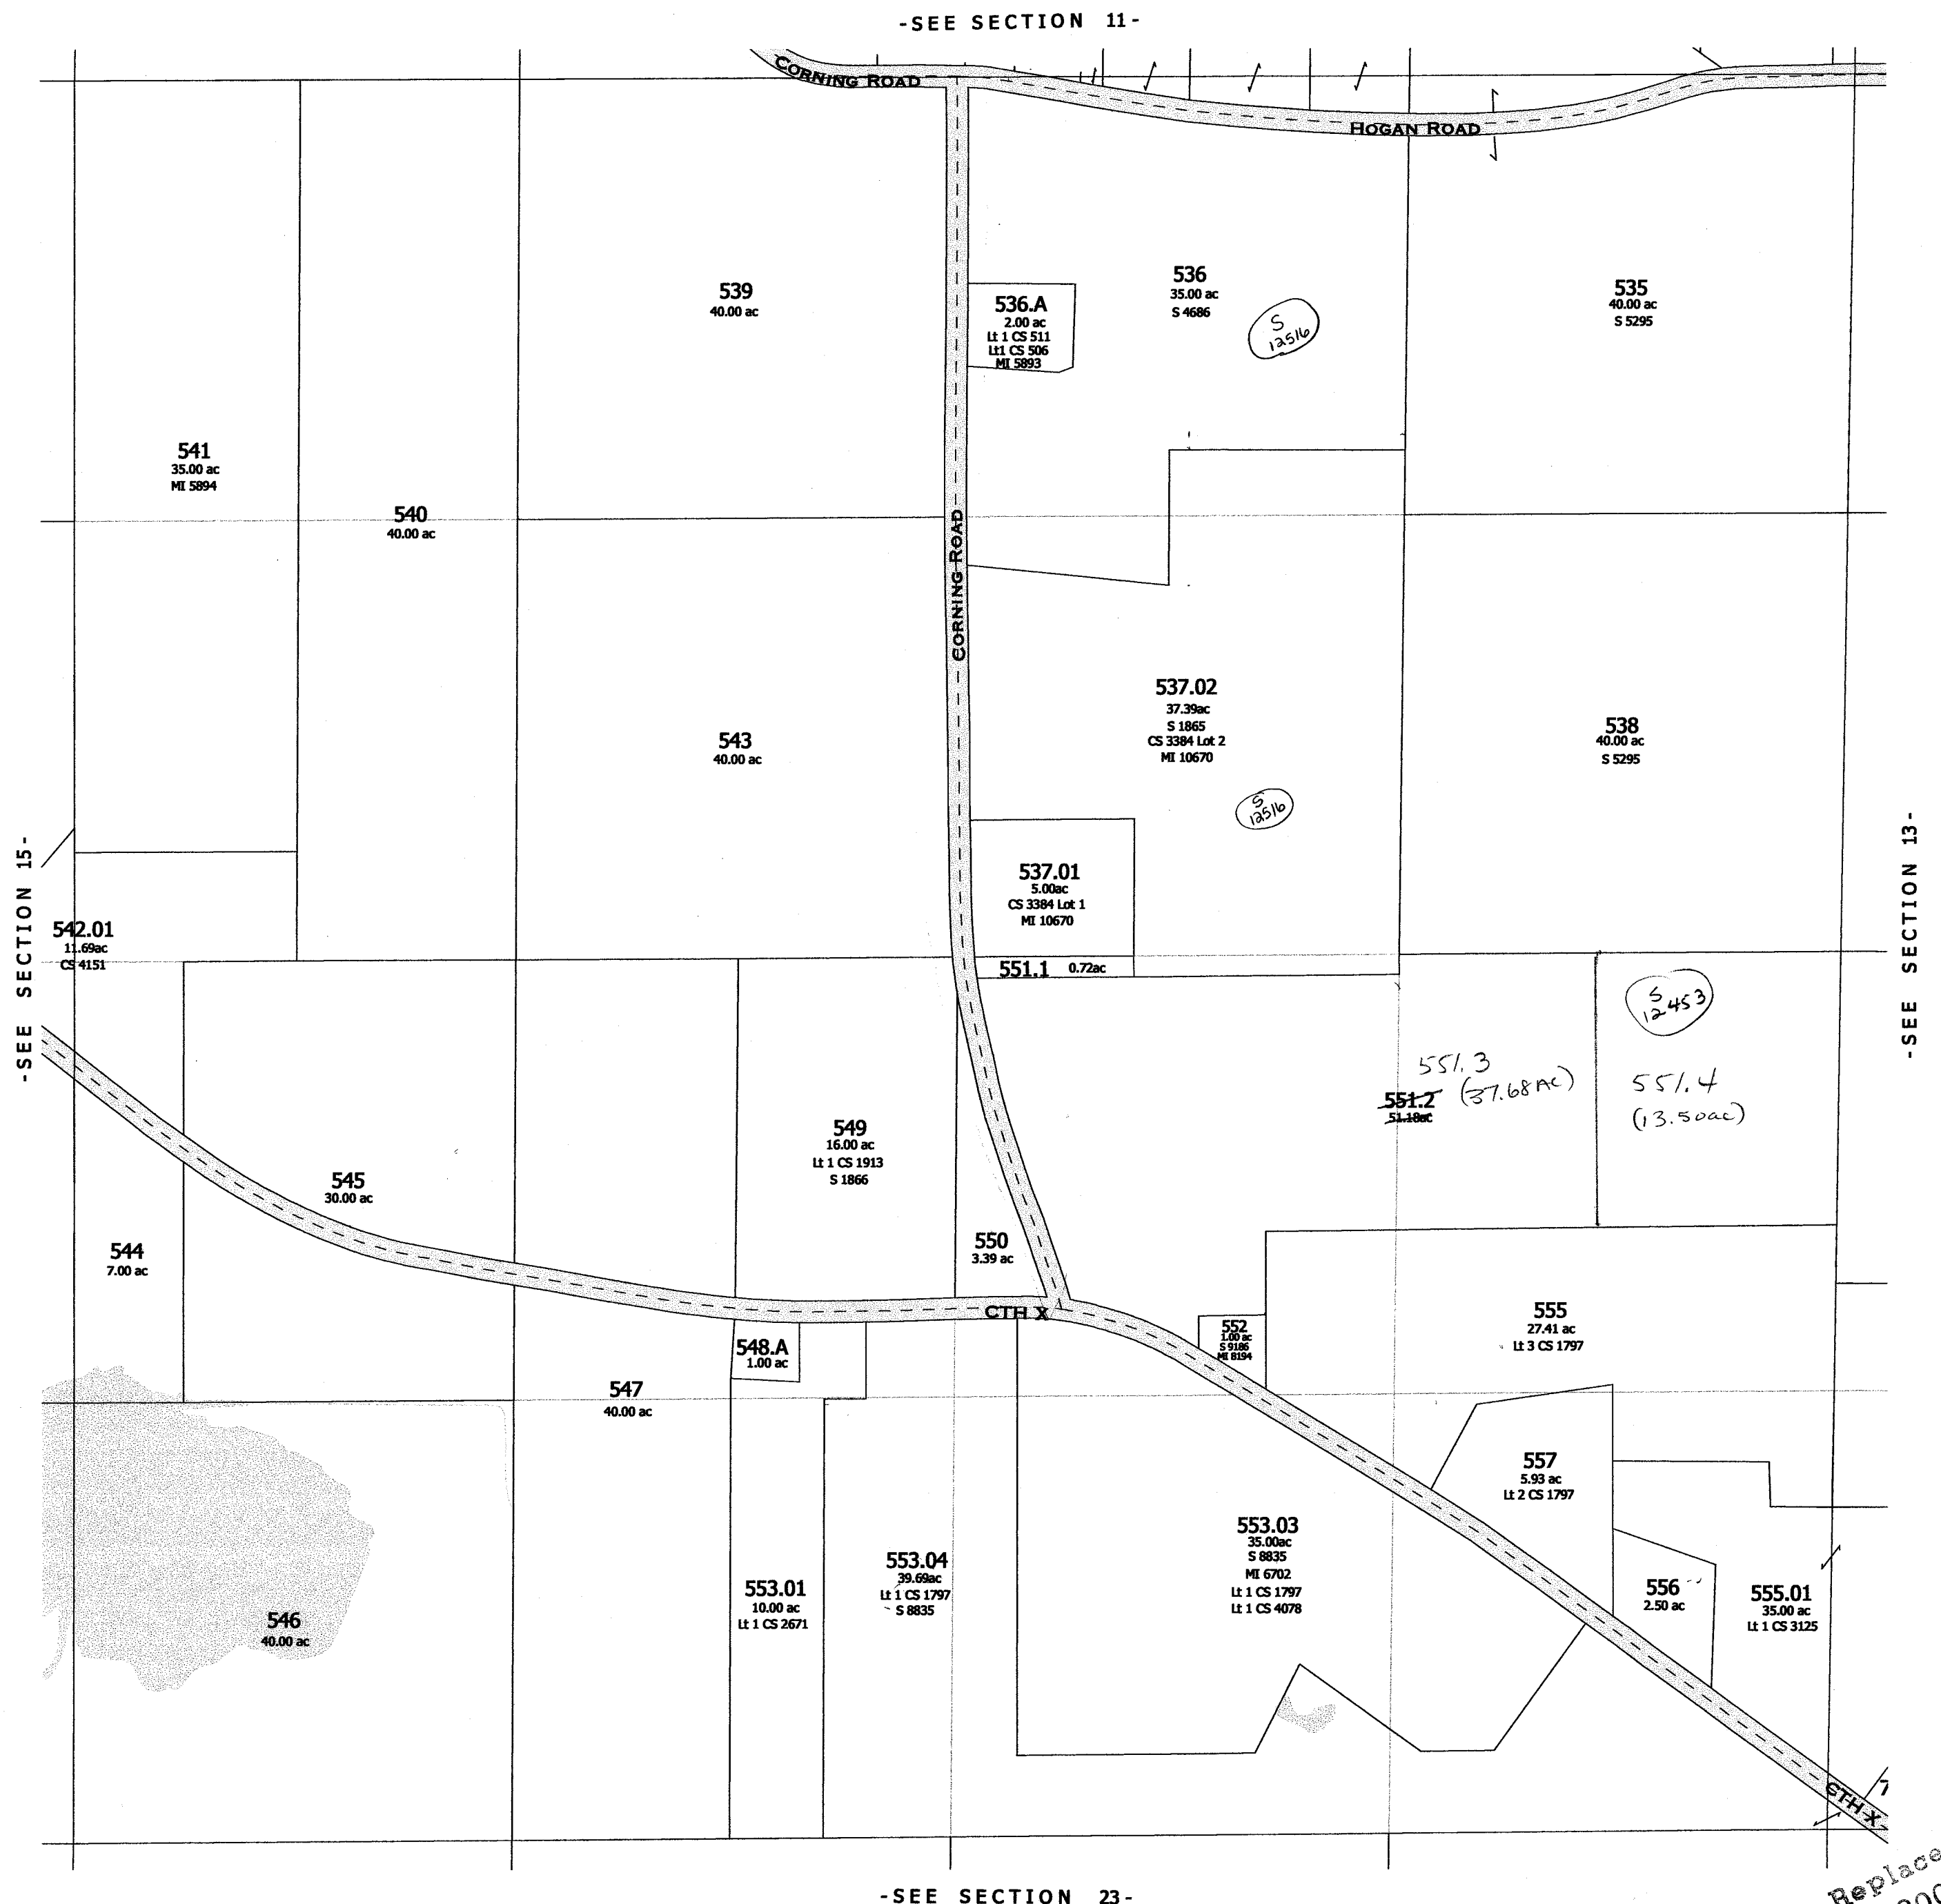

Replaced
2006

-SECTION 14-

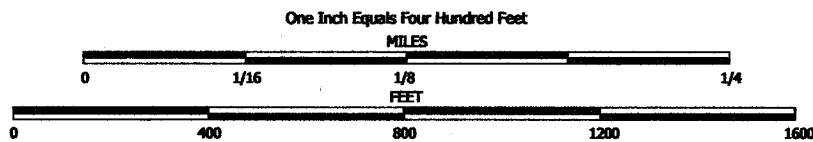



NOTE: This map was prepared for assessment use in accordance with the Wis. St. Stat. Chap. 70.09. All information contained herein is advisory only. Map accuracy is limited to the quality of data obtained from other Public Records. This map is not intended to be a substitute for an actual field survey. Public Land Survey Base is derived from U.S.G.S. Topographic maps unless otherwise noted. Other sources of the Land Base may be actual survey data. Base map data is from the April 1995 County Digital Orthophotos and/or U.S.G.S. 1:24,000 scale Topographic series. The user is responsible for the improper use of the data contained herein.

Created by The Columbia County Land Information Office -GIS Section. VMB.
February 2006.

TAX PARCEL MAP

TOWN of LEWISTON

TOWN 13 NORTH RANGE 8 EAST
COLUMBIA COUNTY, WISCONSIN

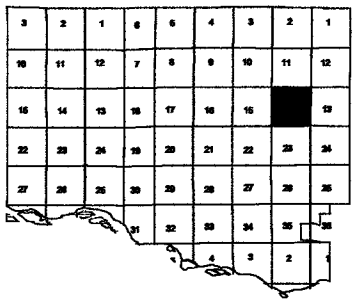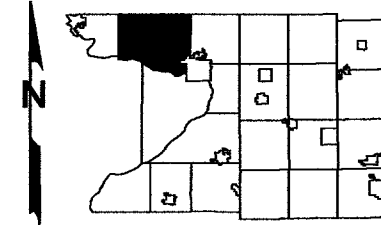

Replaced
2007

-SEE SECTION 11-




-SEE SECTION 23-

Replaced
2007

-SECTION 14-

Replaced
2.02

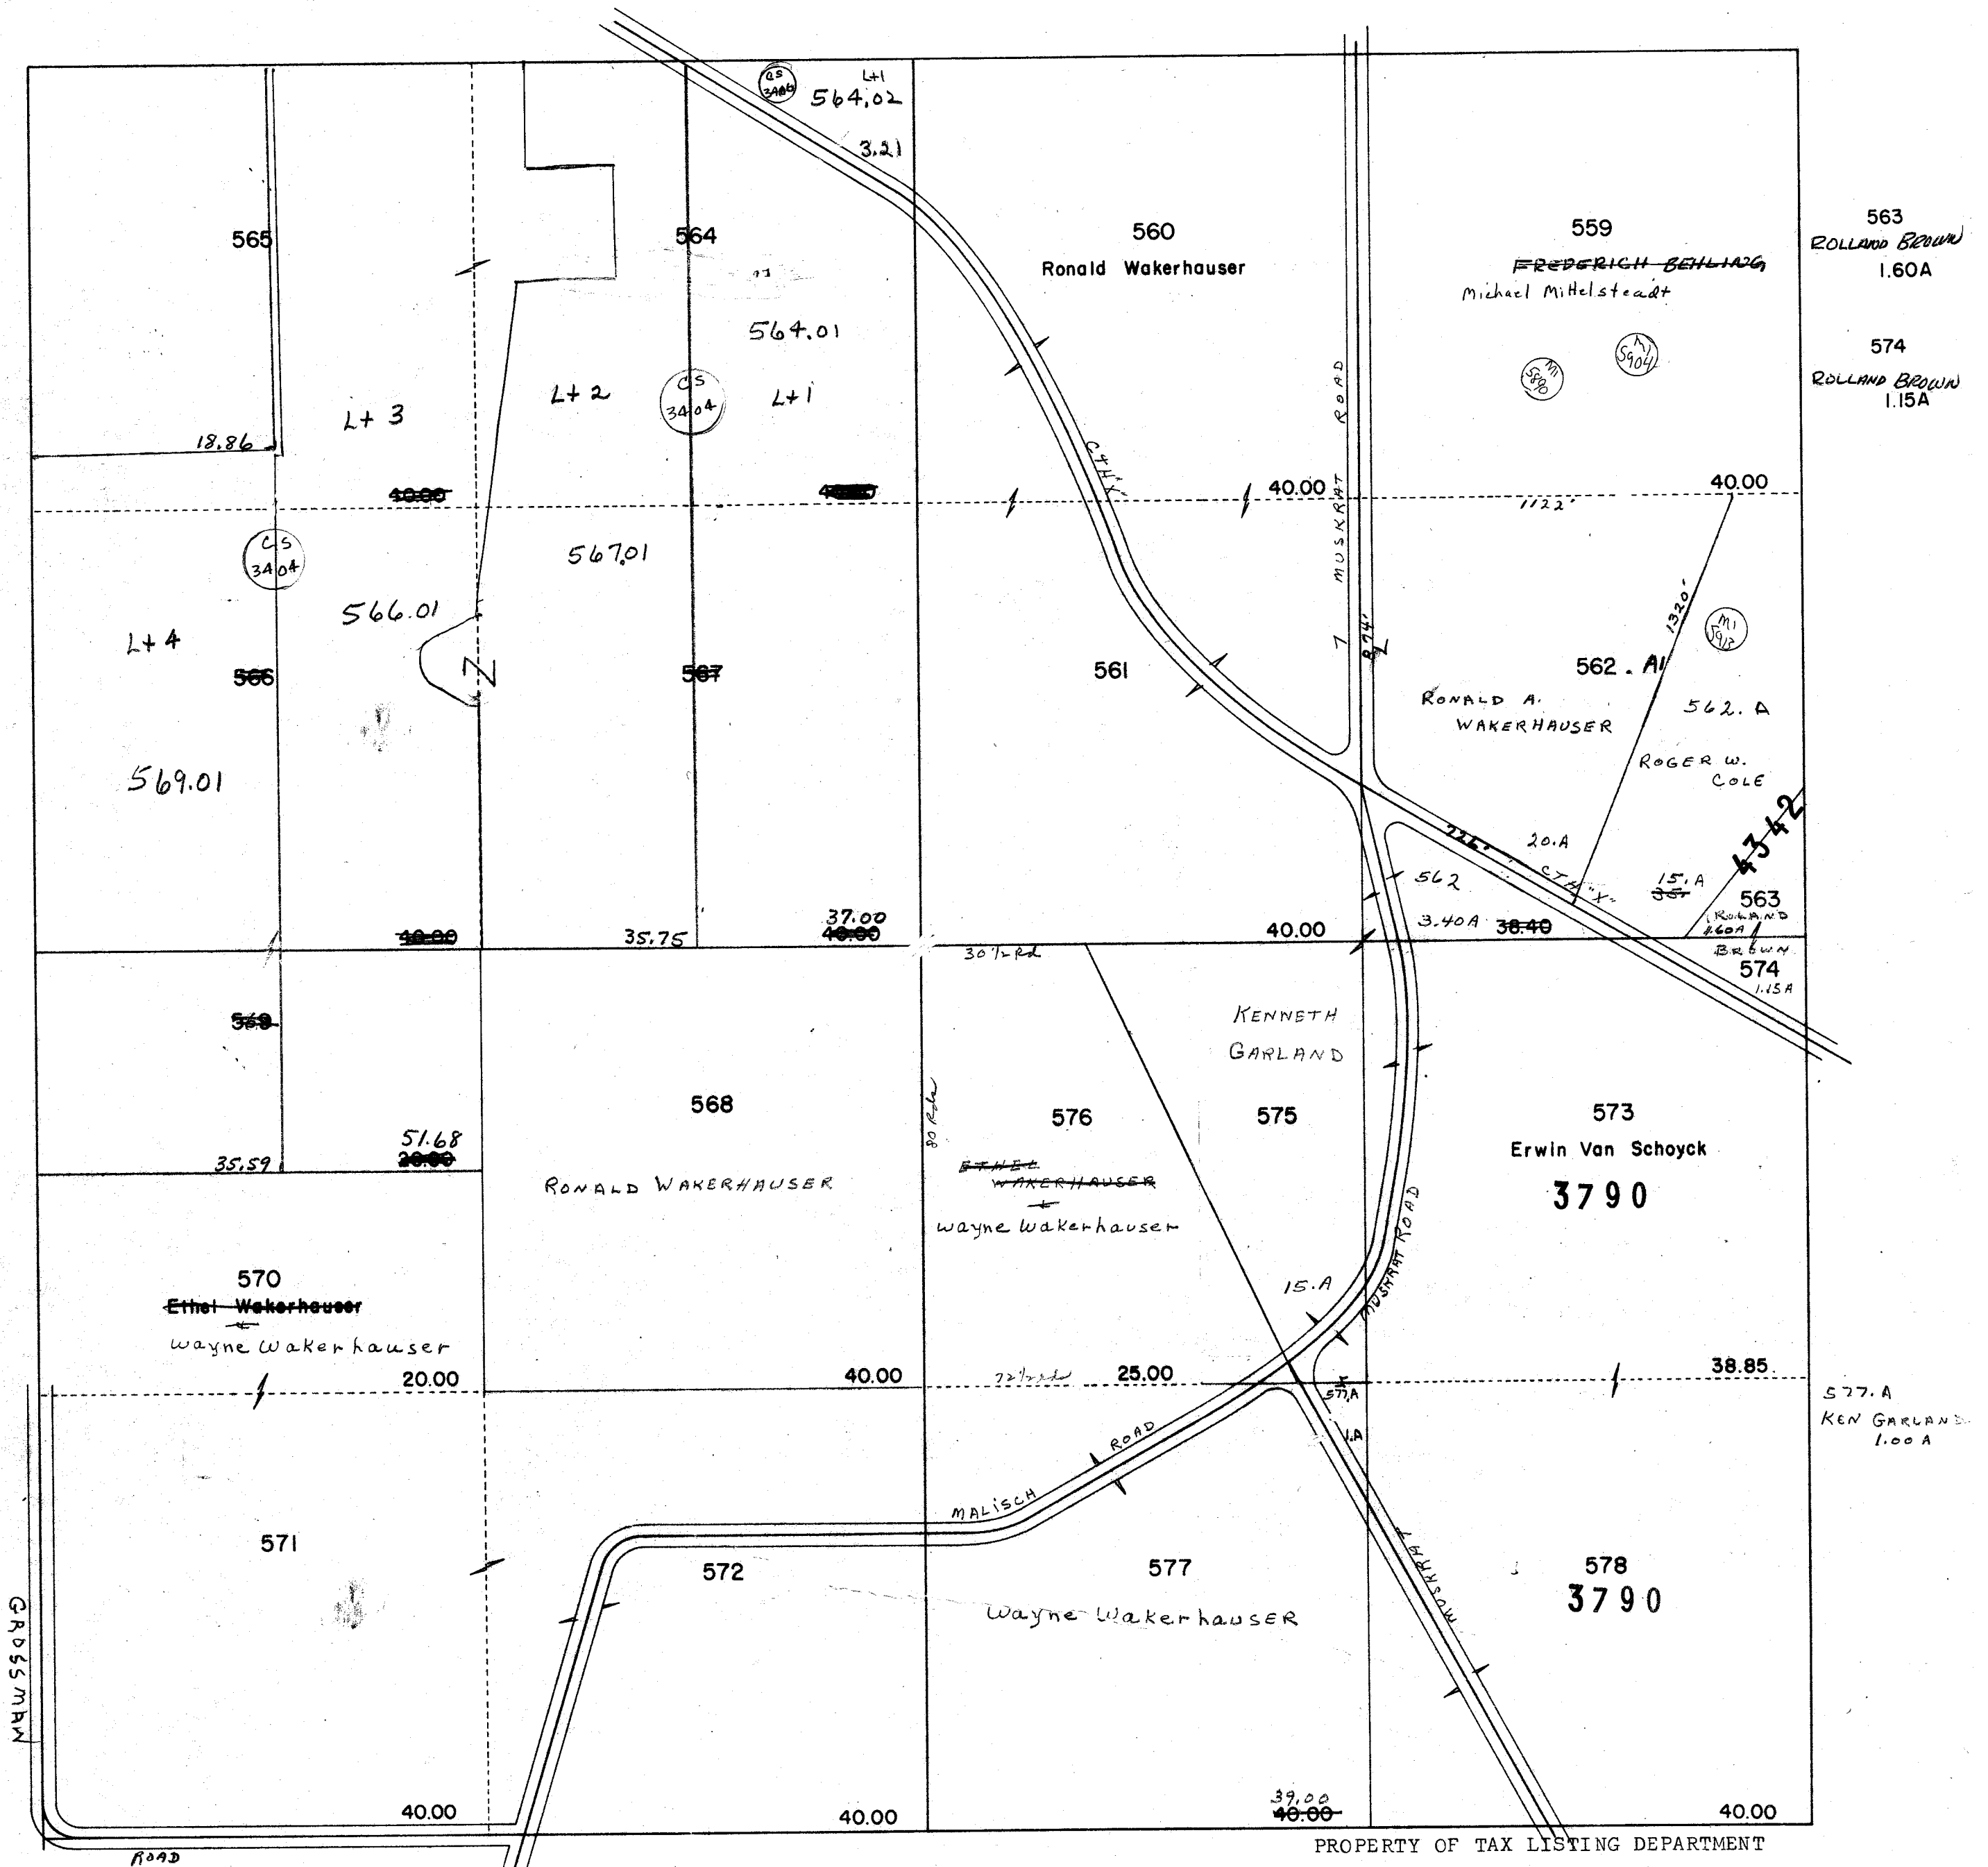

One Inch Equals Four Hundred Feet

MILES
0 1/16 1/8 1/4
FEET
0 400 800 1200 1600


NOTE: This map was prepared for assessment use in accordance with the Wis. St. Stat. Chap. 70.09. All information contained herein is advisory only. Map accuracy is limited to the quality of data obtained from other Public Records. This map is not intended to be a substitute for an actual field survey. Public Land Survey Base is derived from U.S.G.S. Topographic maps unless otherwise noted. Other sources of the Land Base may be actual survey data. Base map data is from the April 1995 County Digital Orthophotos and/or U.S.G.S. 1:24,000 scale Topographic series. The user is responsible for the improper use of the data contained herein.

Created by The Columbia County Land Information Office -GIS Section. VMB.
September 2002.

TAX PARCEL MAP


TOWN of LEWISTON

TOWN 13 NORTH RANGE 8 EAST
COLUMBIA COUNTY, WISCONSIN

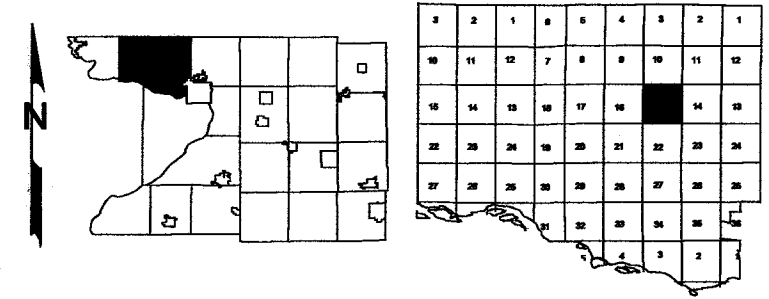

Replaced
2005


-SEE SECTION 10-

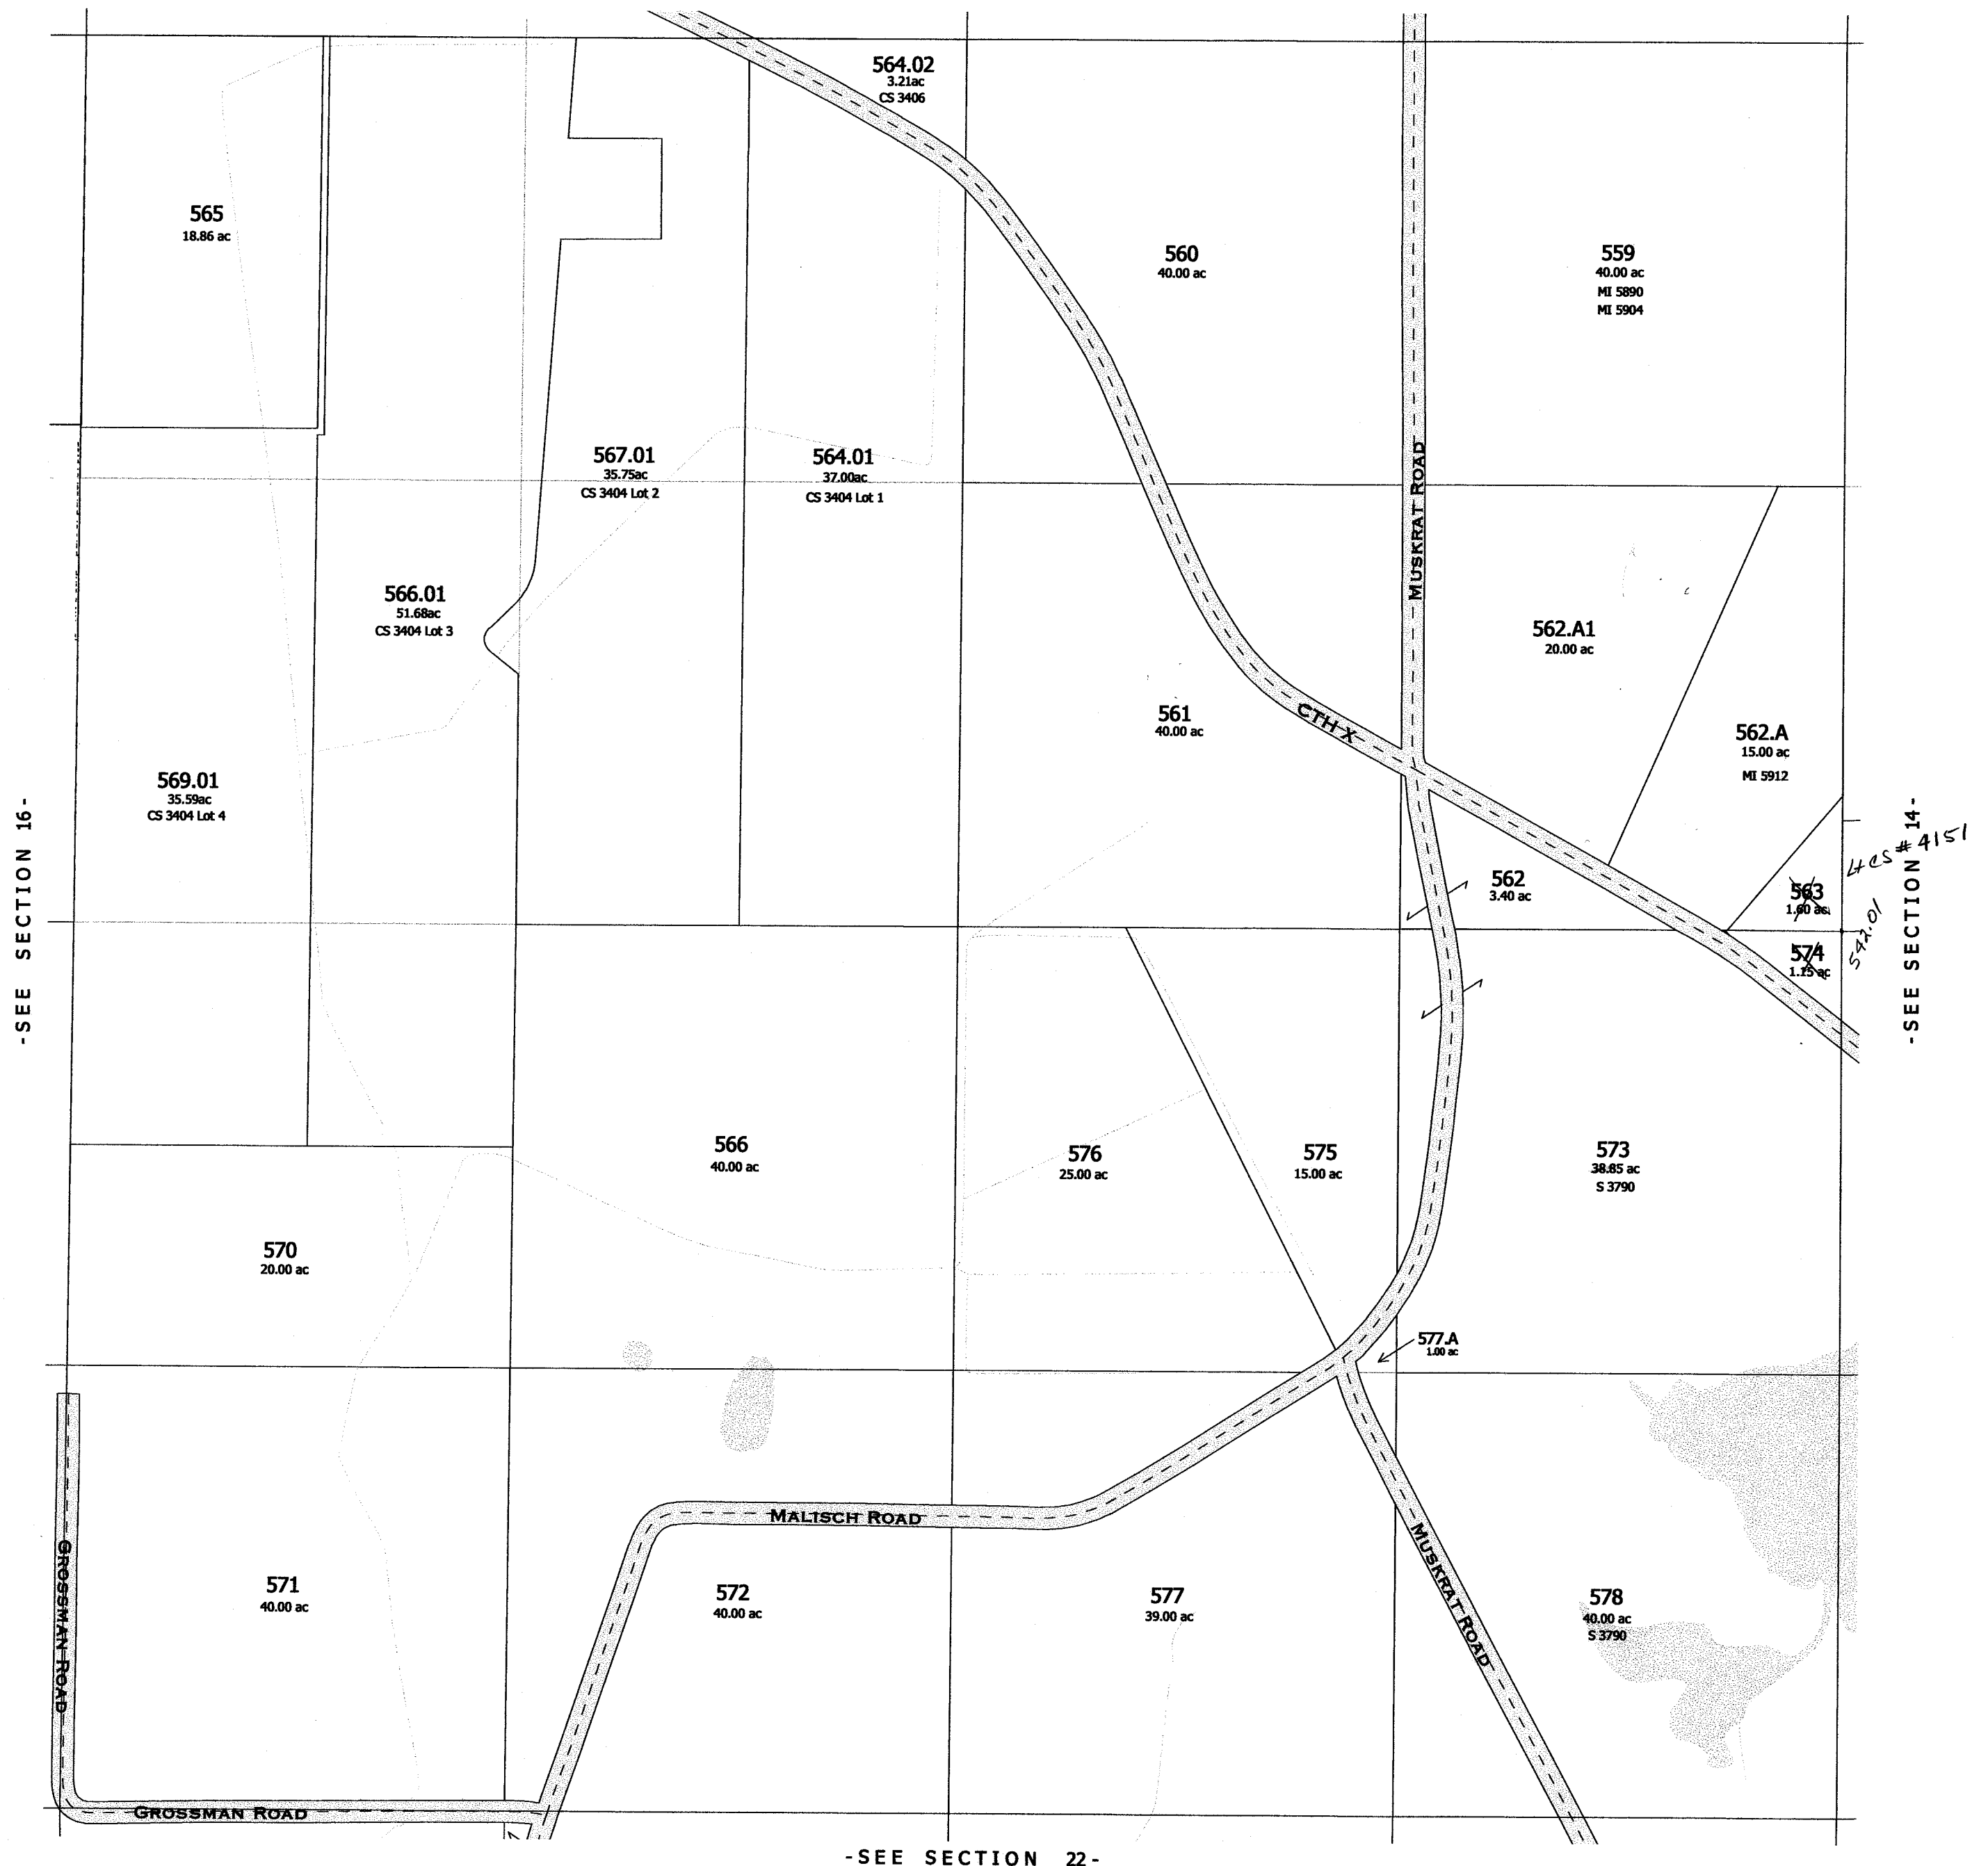

-SEE SECTION 16-

-SEE SECTION 14-



-SEE SECTION 22-

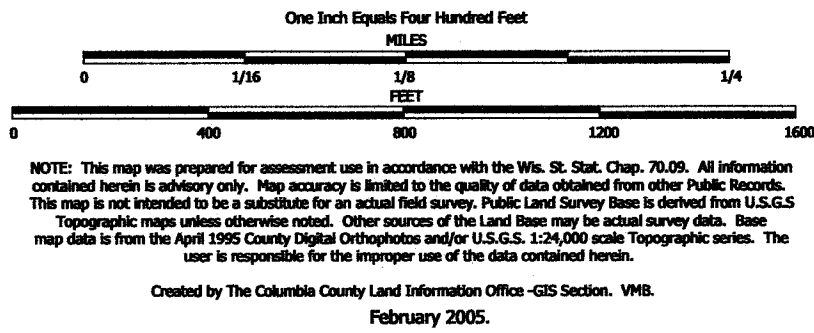


TAX PARCEL MAP

TOWN of LEWISTON

TOWN 13 NORTH RANGE 8 EAST
COLUMBIA COUNTY, WISCONSIN

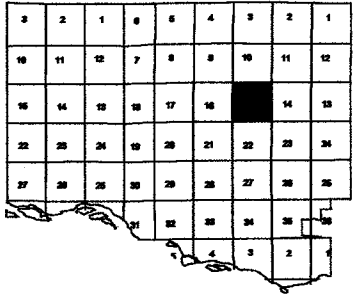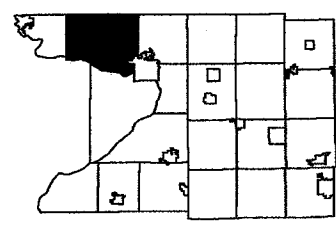

Replaced
2006

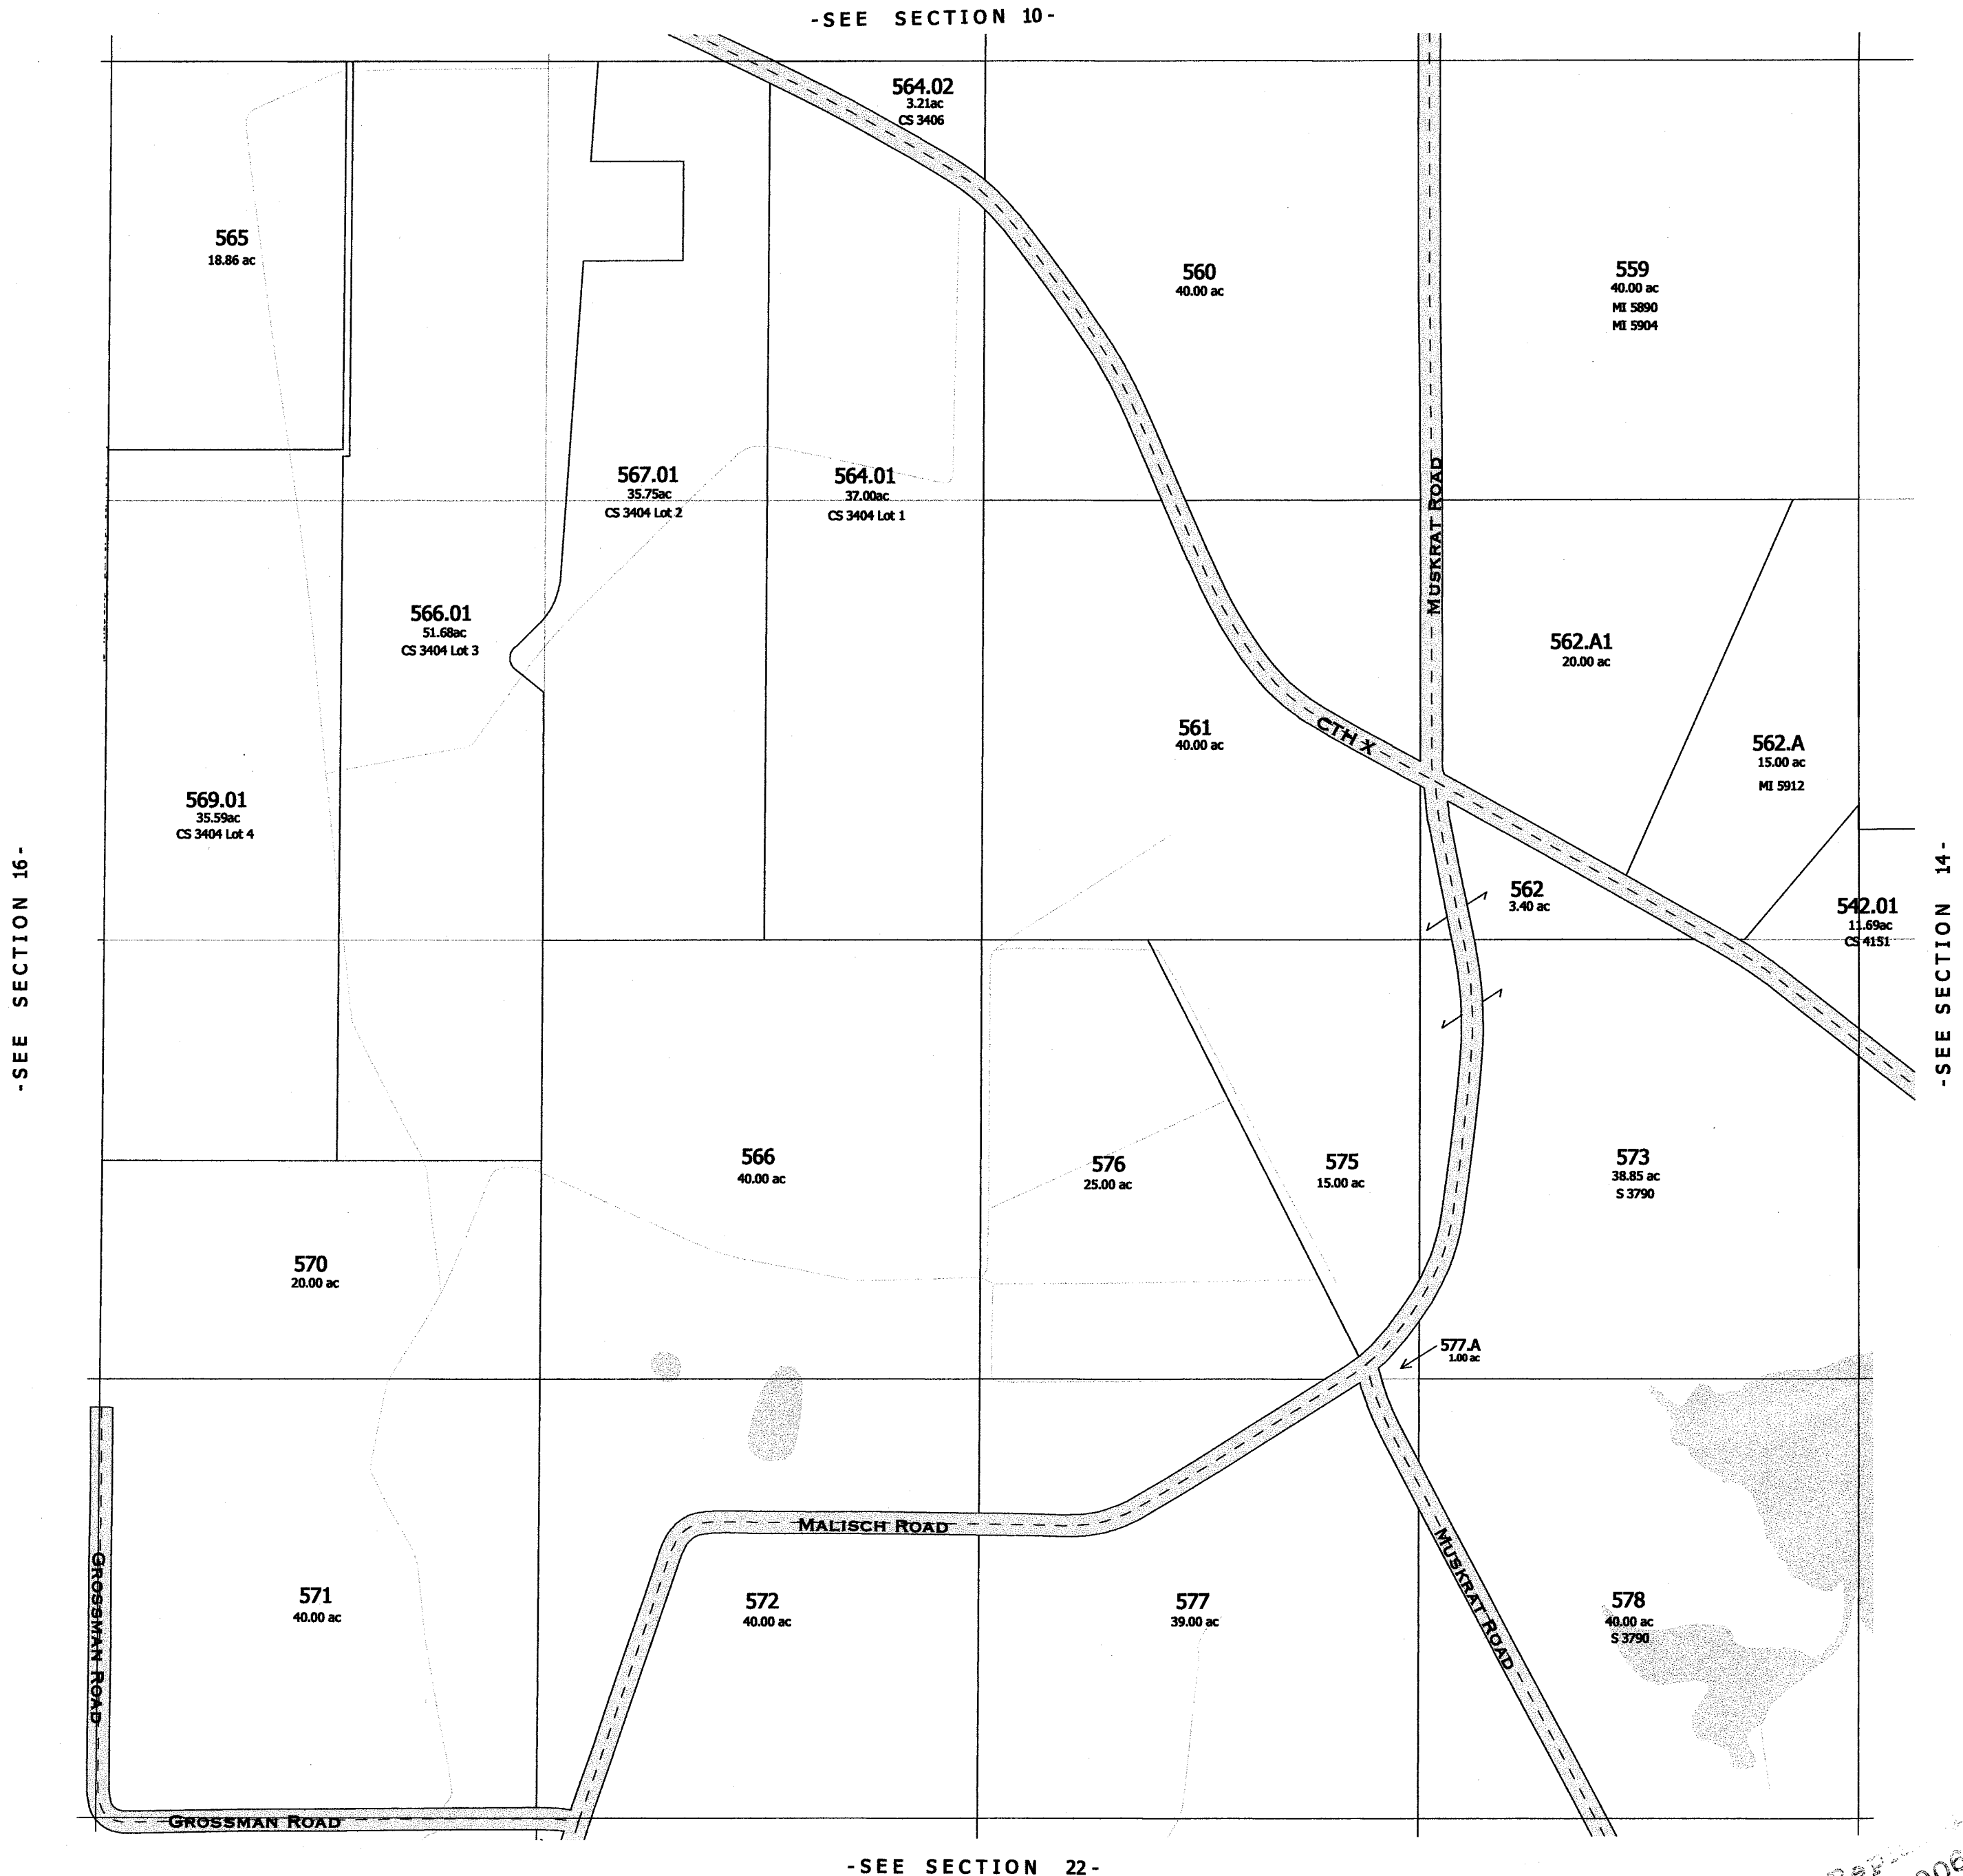


Replaced
2006


-SECTION 15-

LEWISTON

SEC. 16 T13N R8E

Replaced
2002

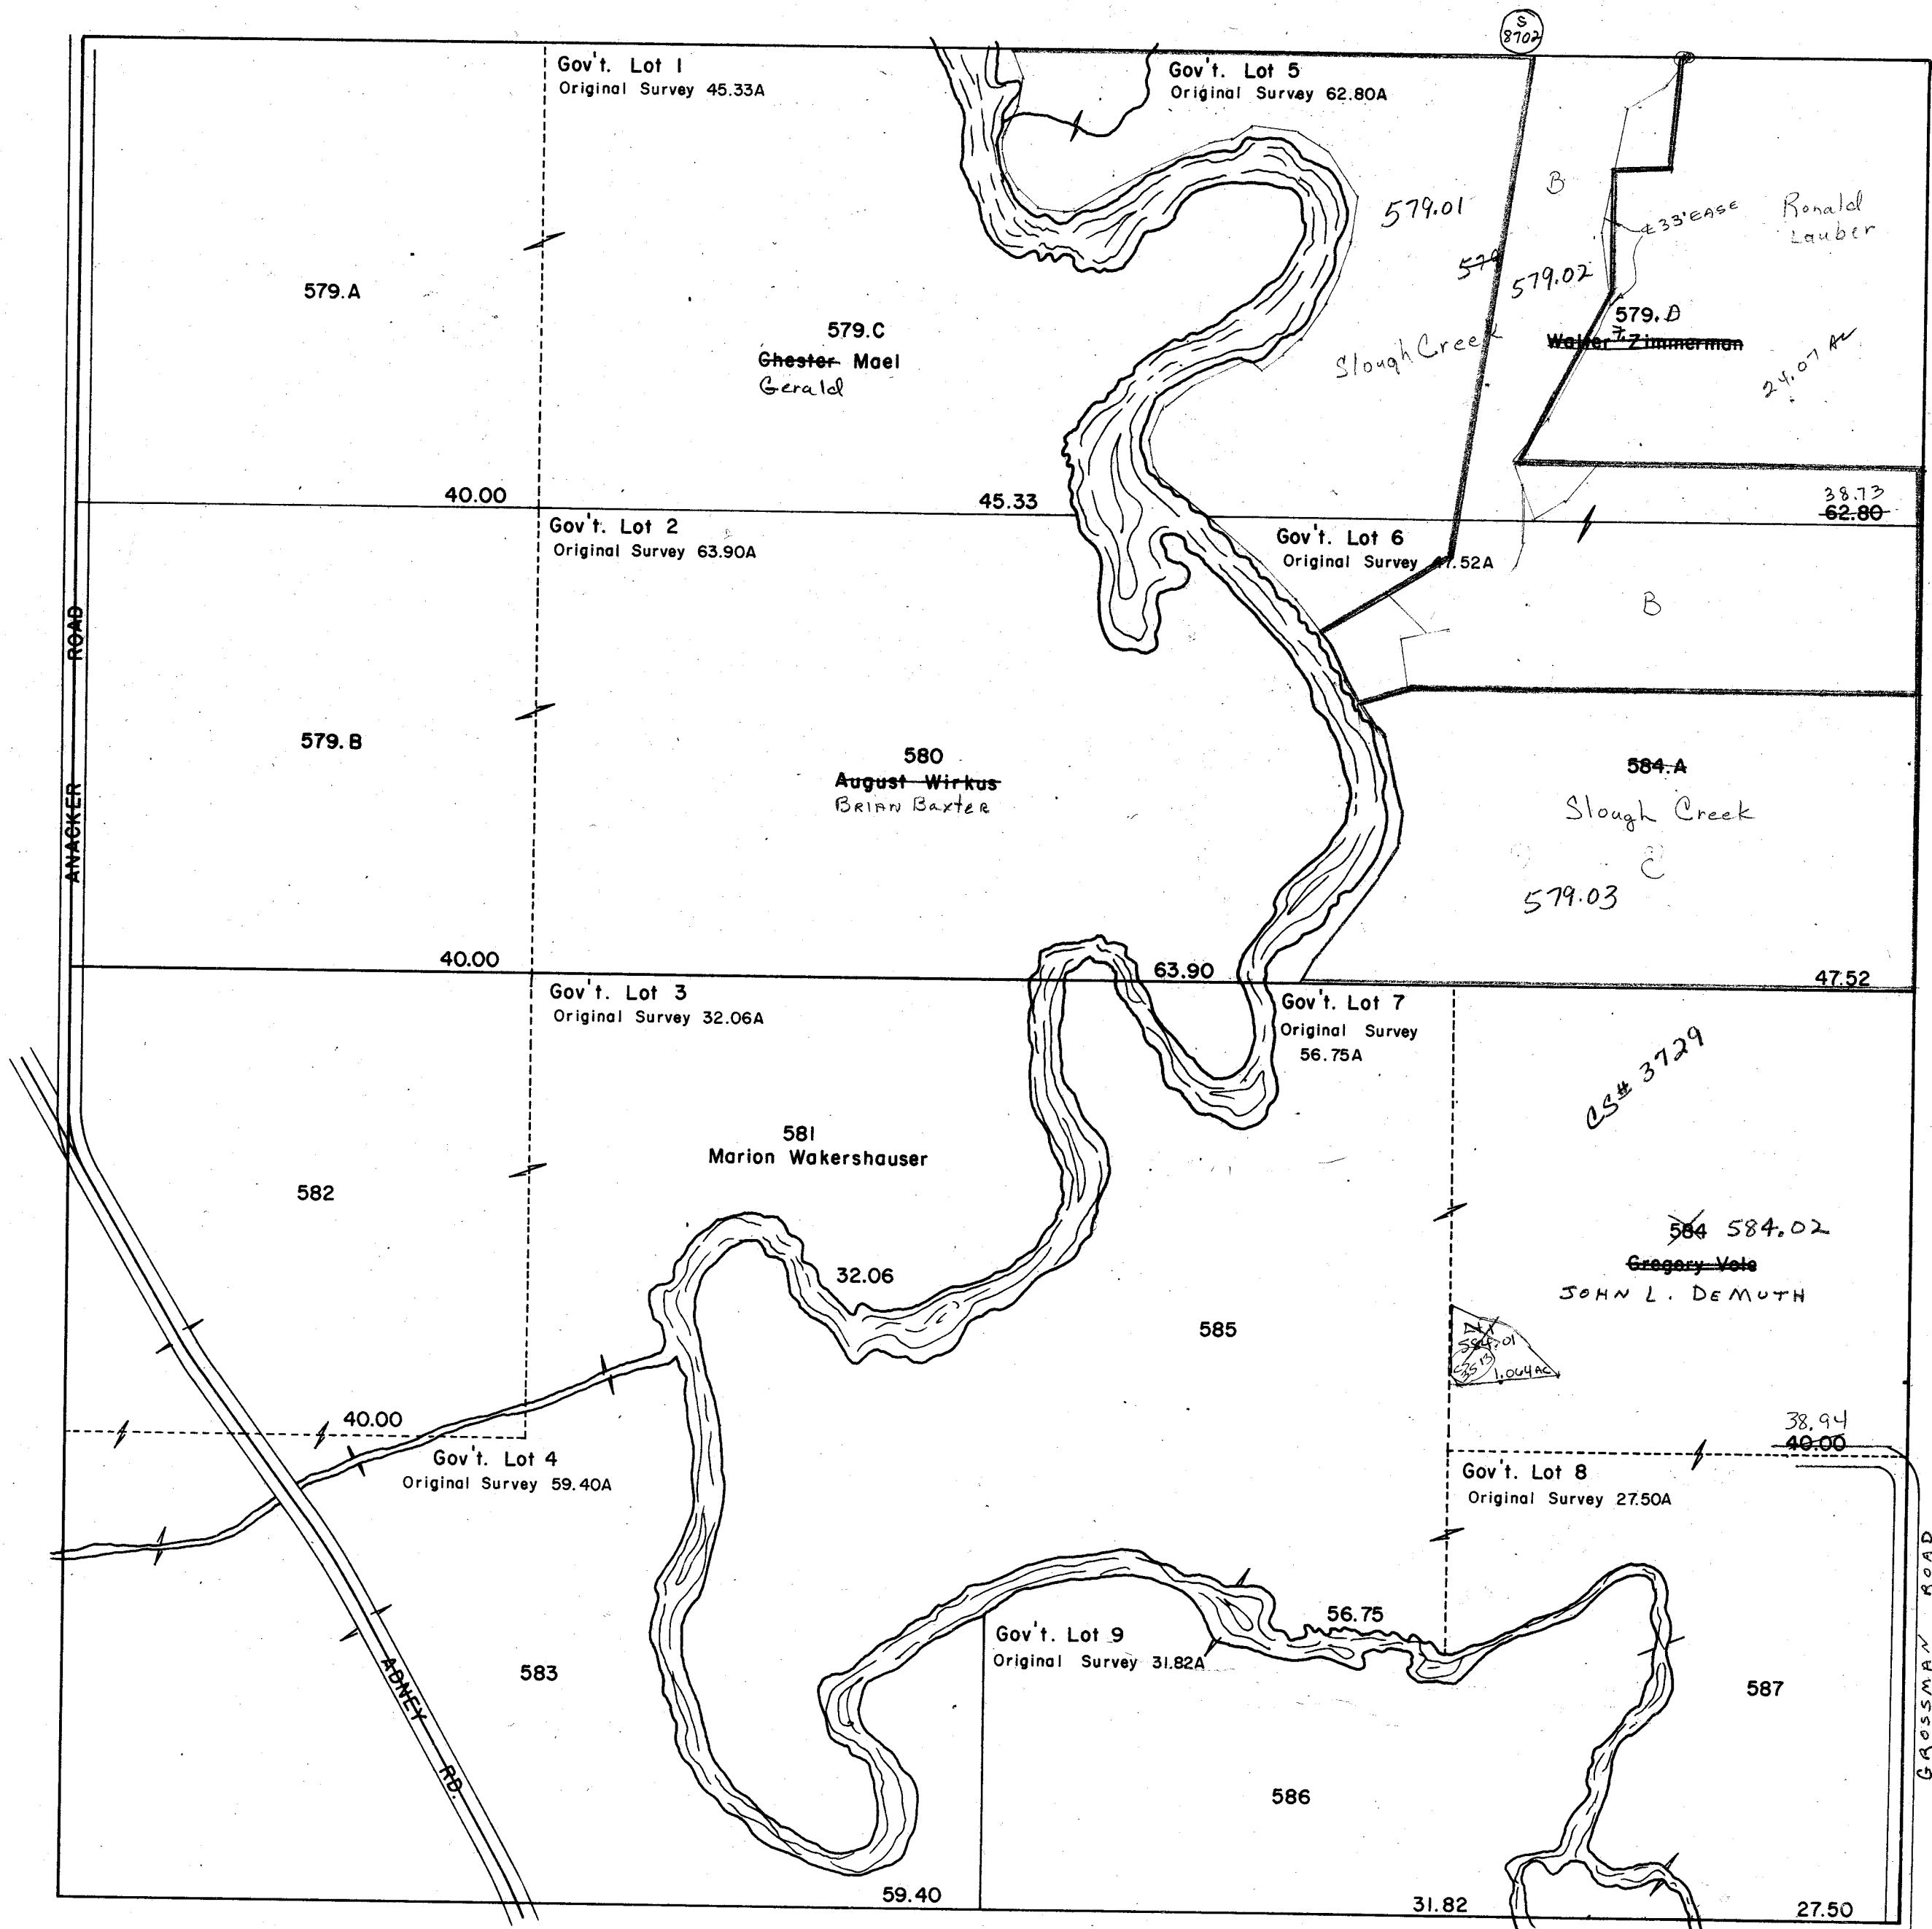

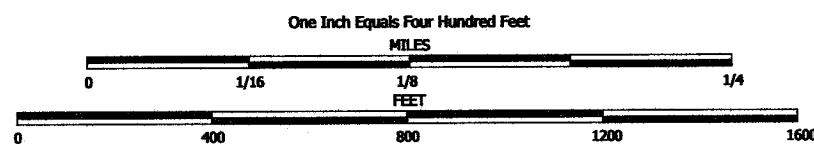


NOTE: This map was prepared for assessment use in accordance with the Wis. St. Stat. Chap. 70.09. All information contained herein is advisory only. Map accuracy is limited to the quality of data obtained from other Public Records. This map is not intended to be a substitute for an actual field survey. Public Land Survey Base is derived from U.S.G.S. Topographic maps unless otherwise noted. Other sources of the Land Base may be actual survey data. Base map data is from the April 1995 County Digital Orthophotos and/or U.S.G.S. 1:24,000 scale Topographic series. The user is responsible for the improper use of the data contained herein.

Created by The Columbia County Land Information Office -GIS Section. VMB.
September 2002.


TAX PARCEL MAP

TOWN of LEWISTON

TOWN 13 NORTH RANGE 8 EAST
COLUMBIA COUNTY, WISCONSIN

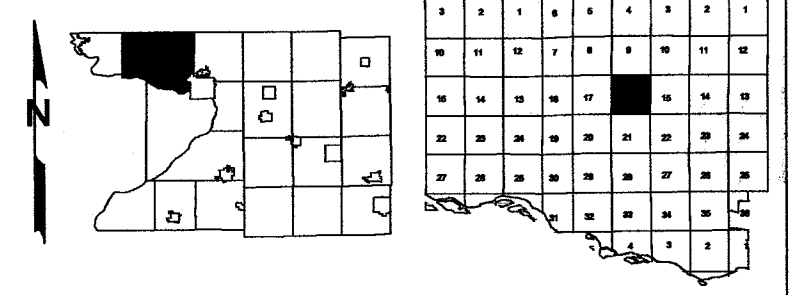


Replaced
2006

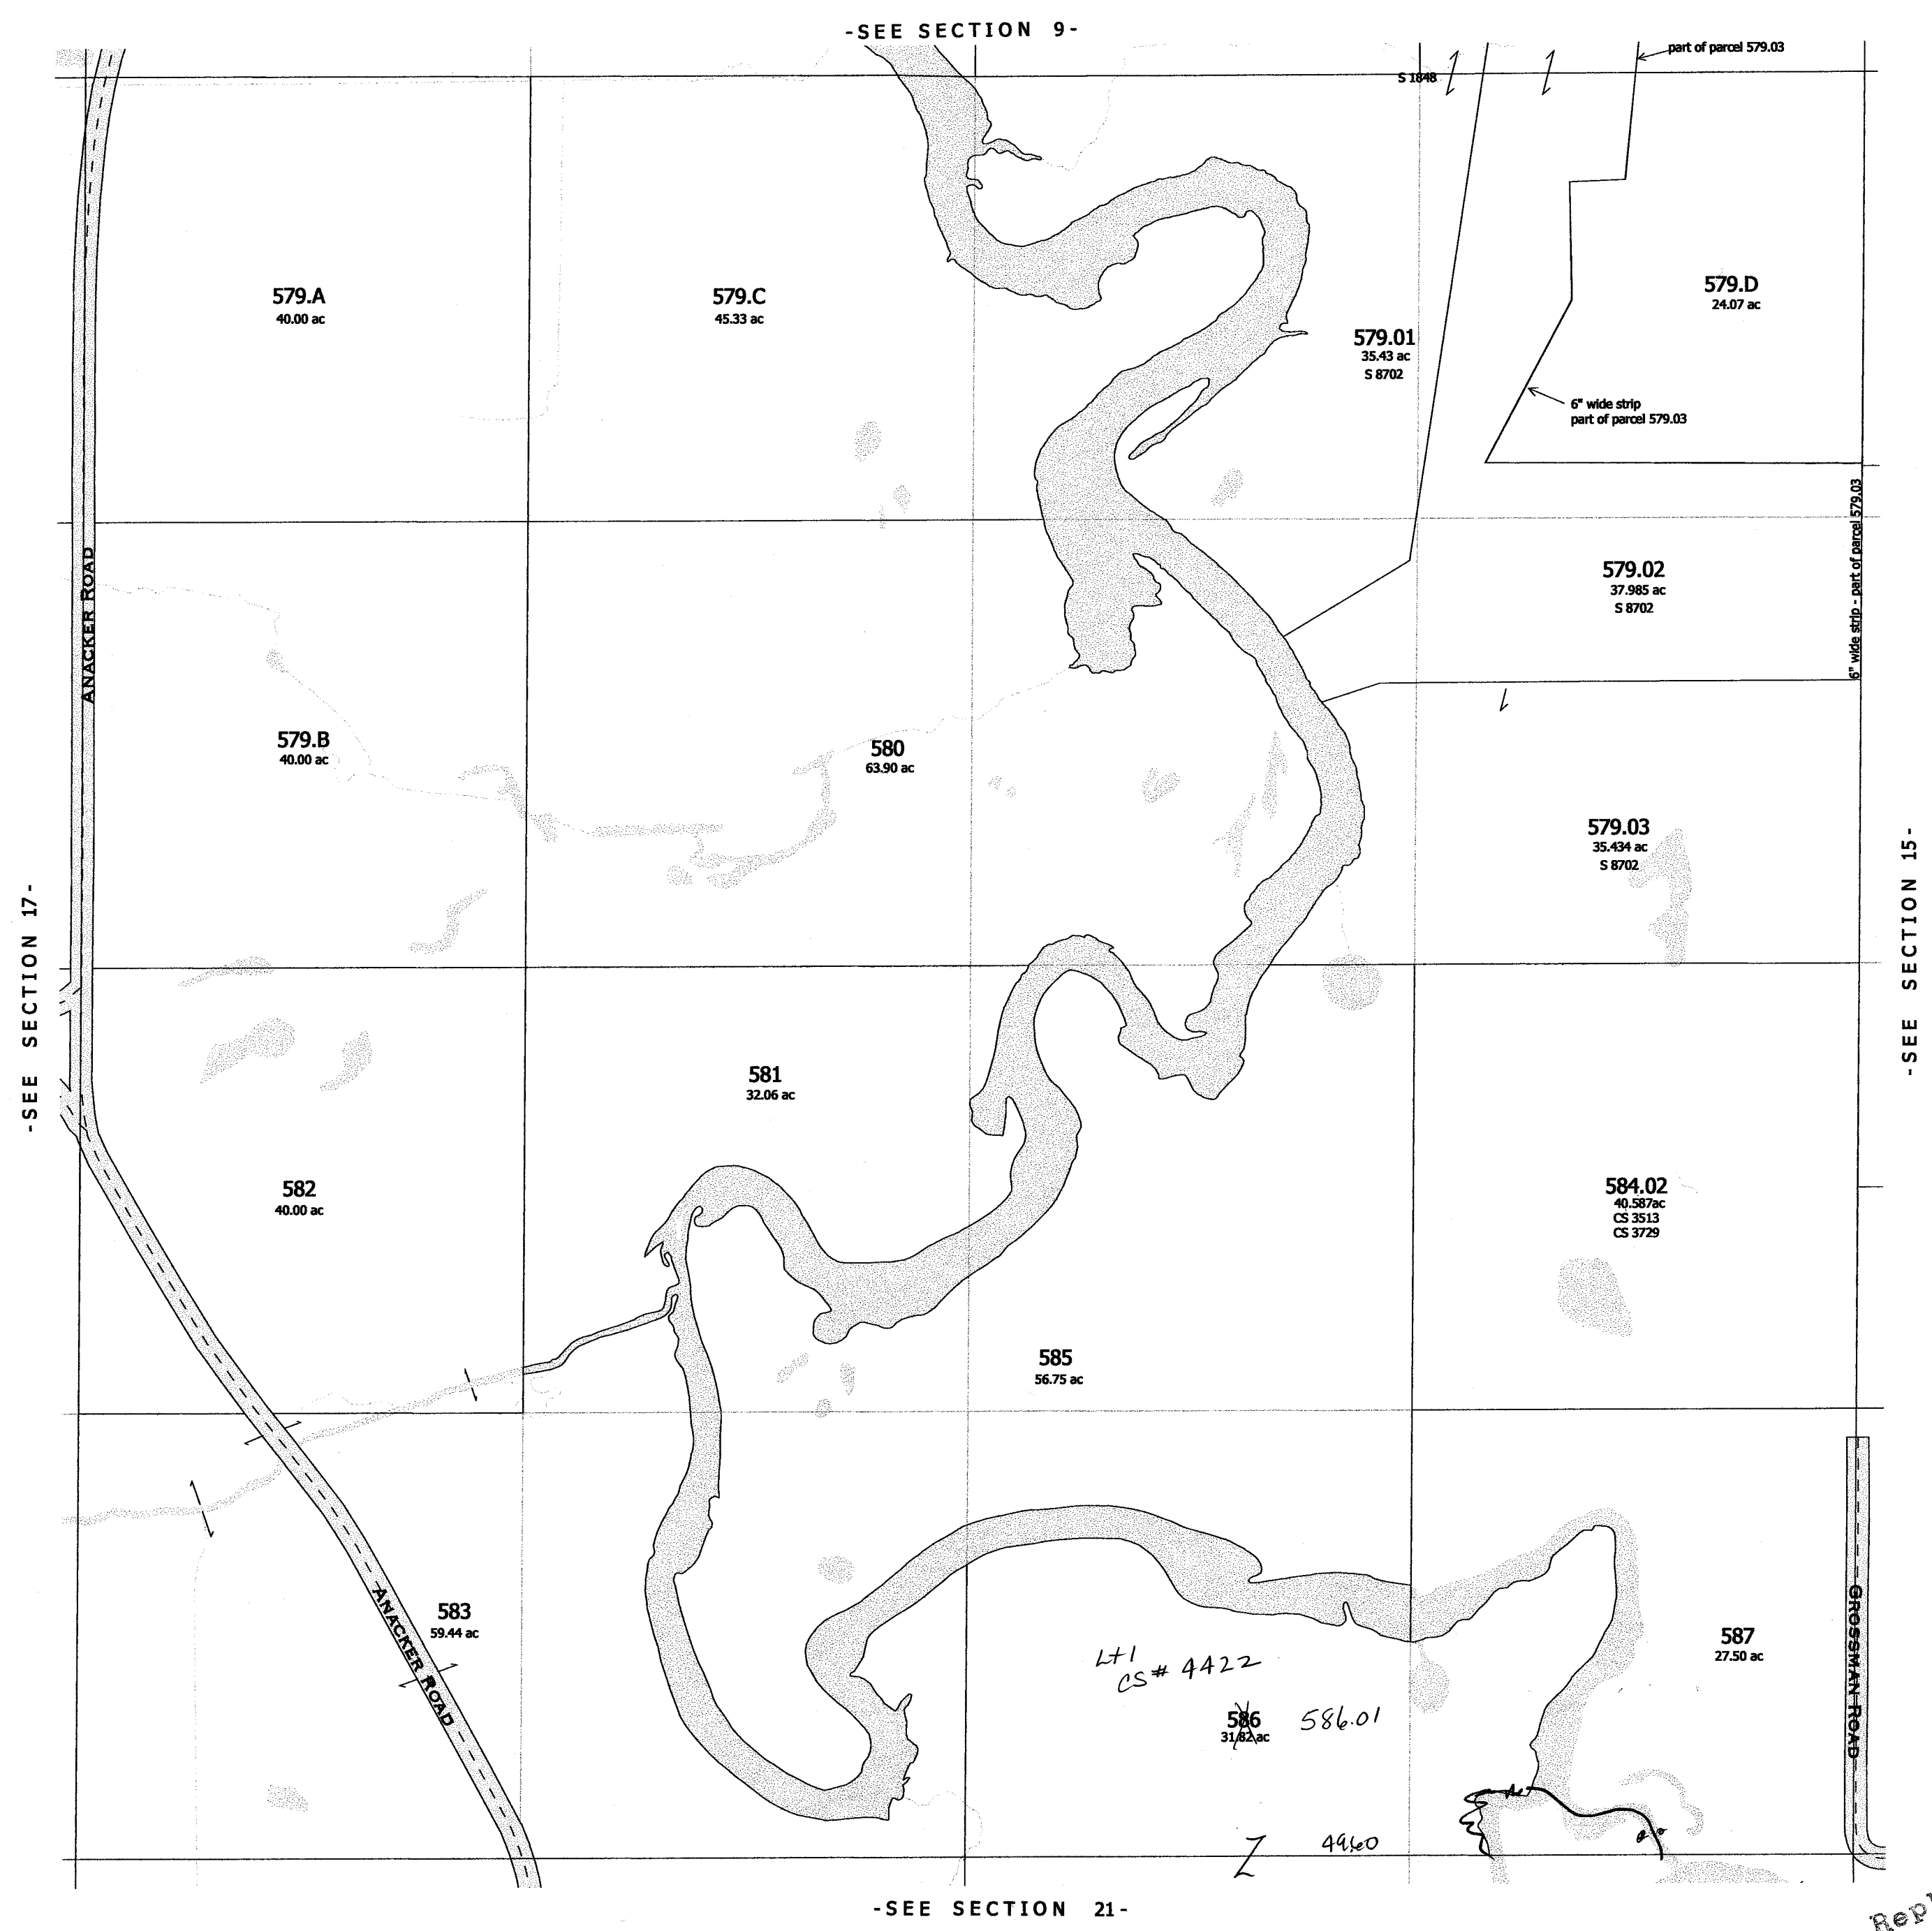


Replaced
2006

-SECTION 16-

Replaced
2002

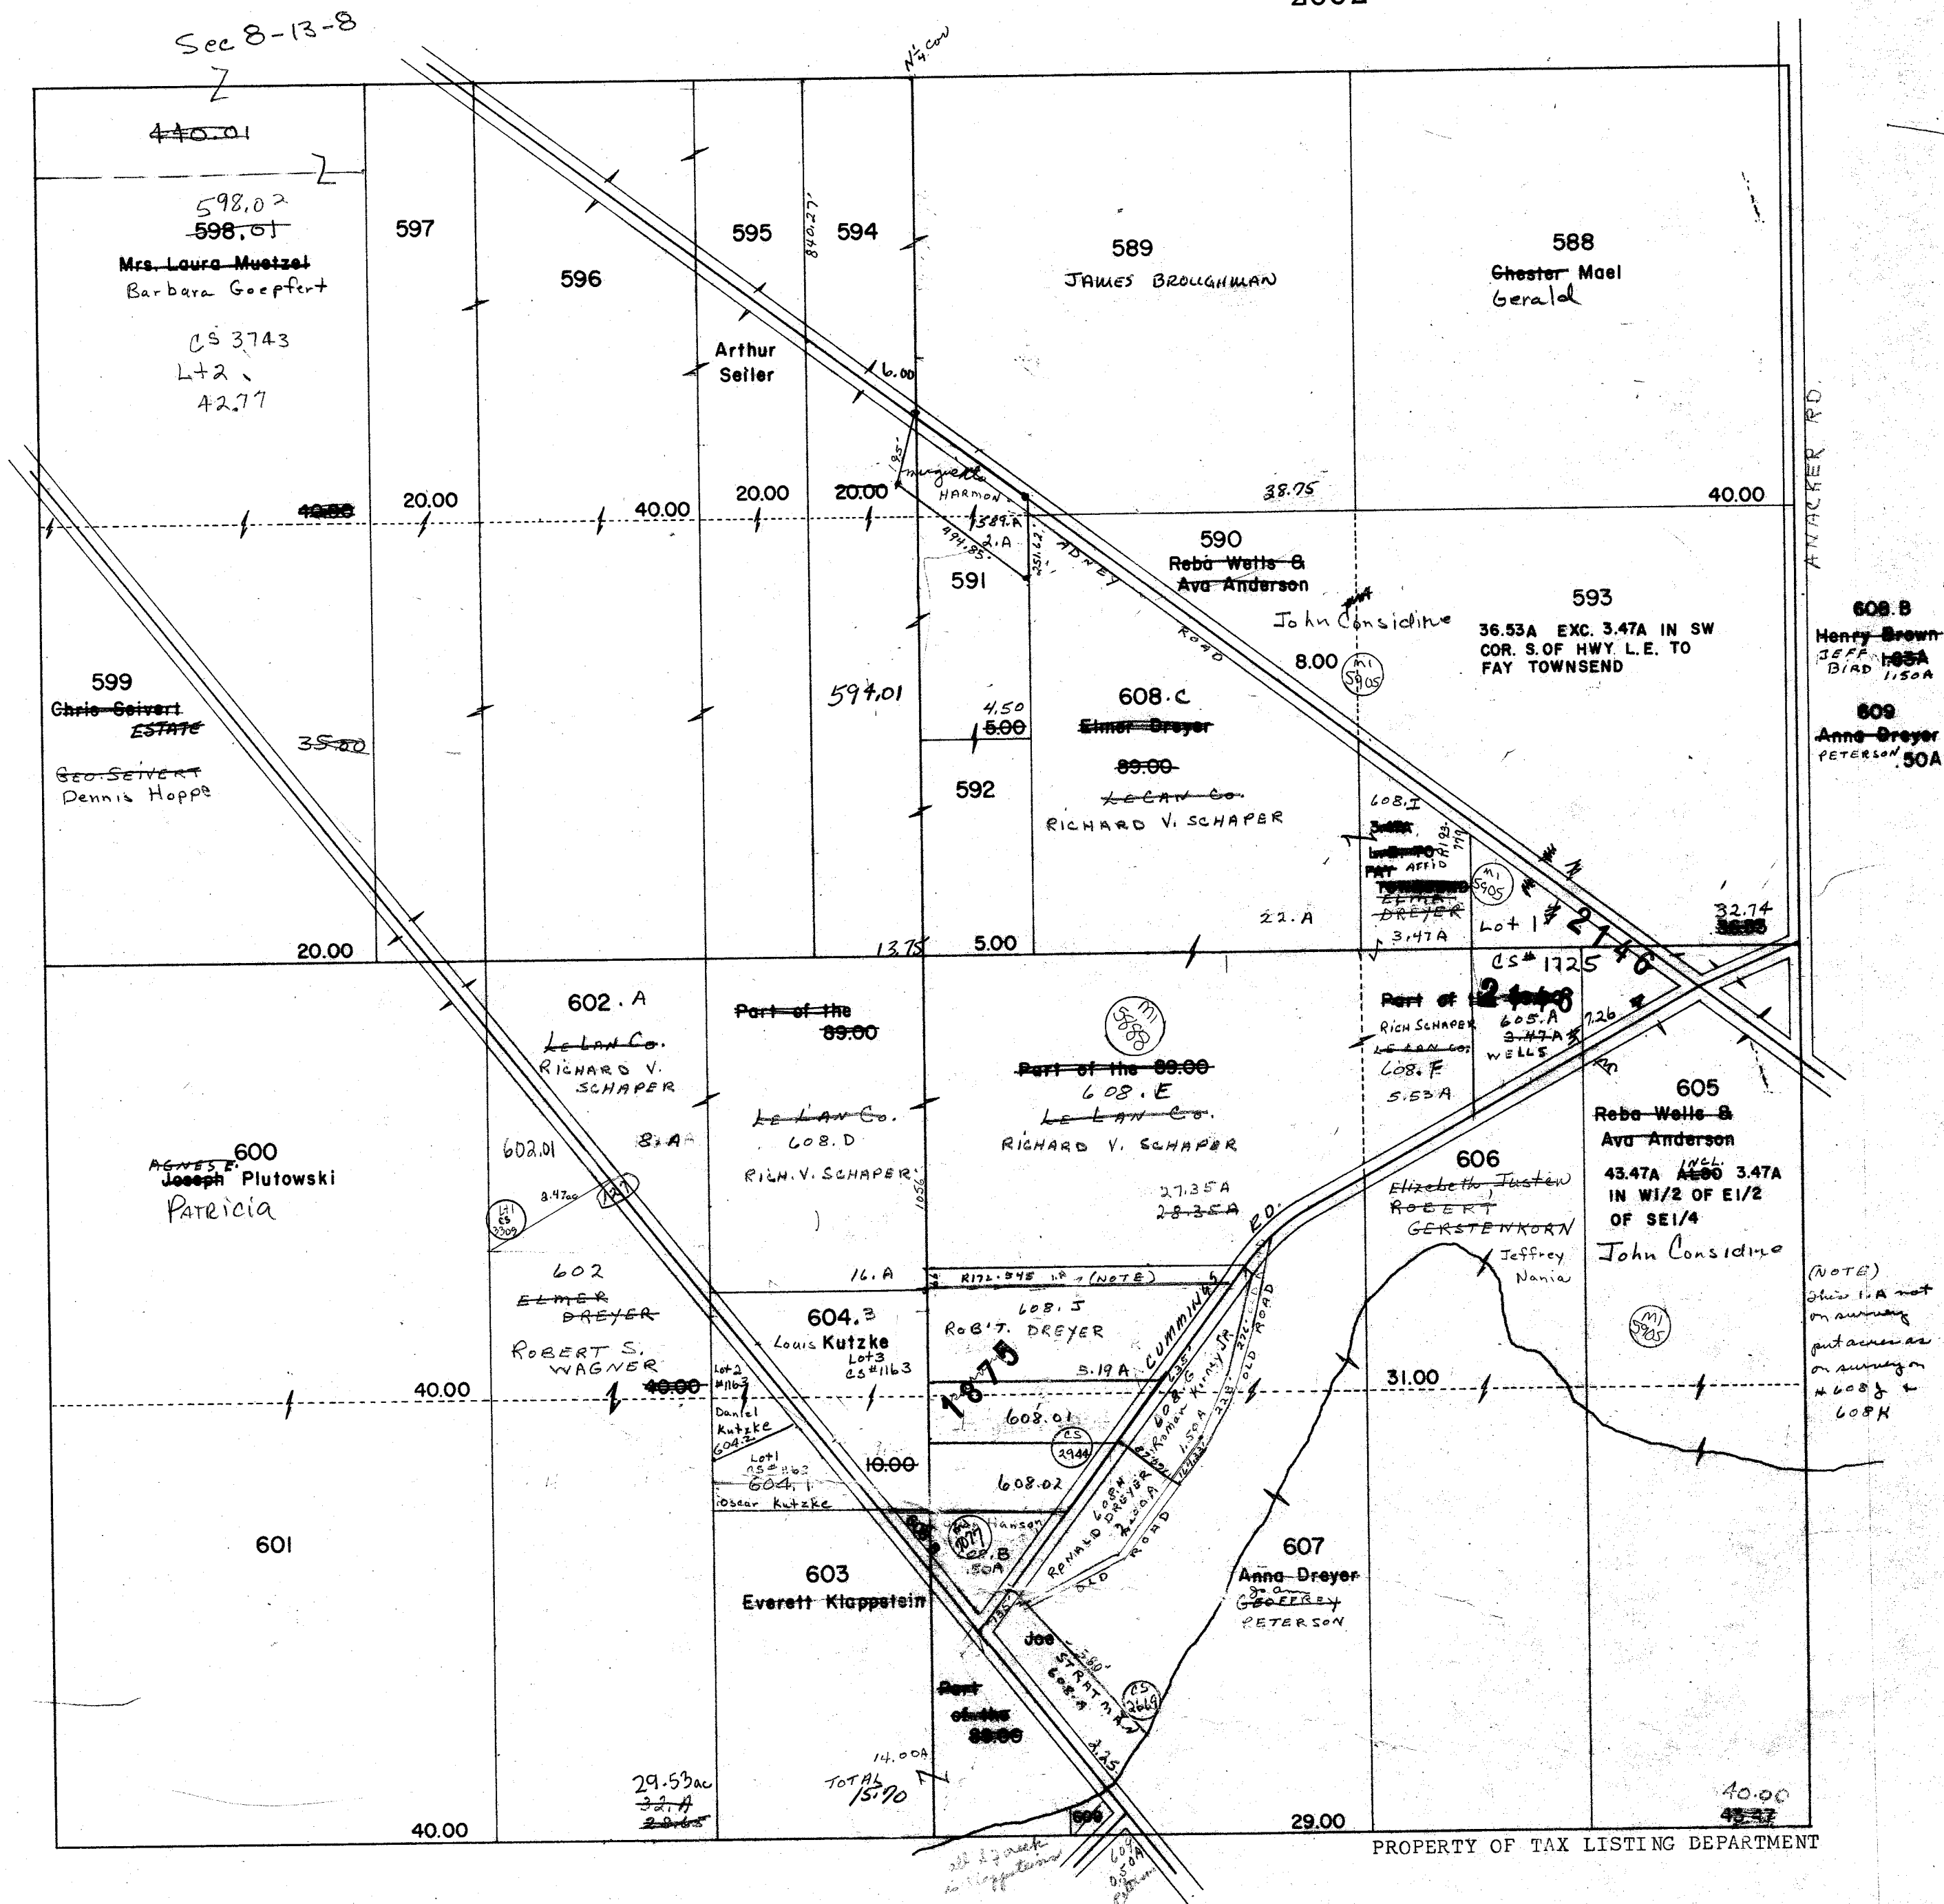

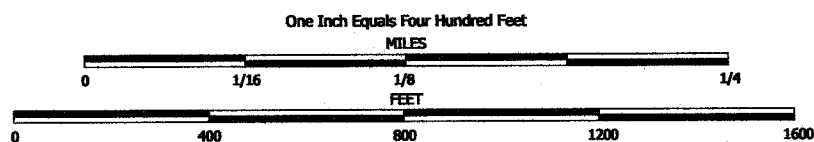



NOTE: This map was prepared for assessment use in accordance with the Wis. Stat. Chap. 70.09. All information contained herein is advisory only. Map accuracy is limited to the quality of data obtained from other Public Records. This map is not intended to be a substitute for an actual field survey. Public Land Survey Base is derived from U.S.G.S. Topographic maps unless otherwise noted. Other sources of the Land Base may be actual survey data. Base map data is from the April 1995 County Digital Orthophotos and/or U.S.G.S. 1:24,000 scale Topographic series. The user is responsible for the improper use of the data contained herein.

Created by The Columbia County Land Information Office -GIS Section. VMB.
September 2002.


TAX PARCEL MAP

TOWN of LEWISTON

TOWN 13 NORTH RANGE 8 EAST
COLUMBIA COUNTY, WISCONSIN

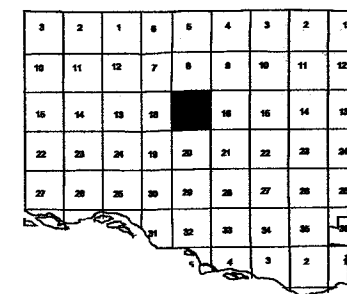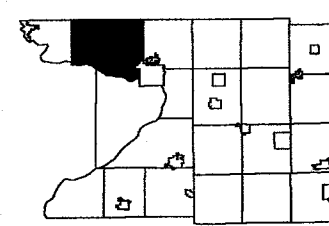

Replaced
2005

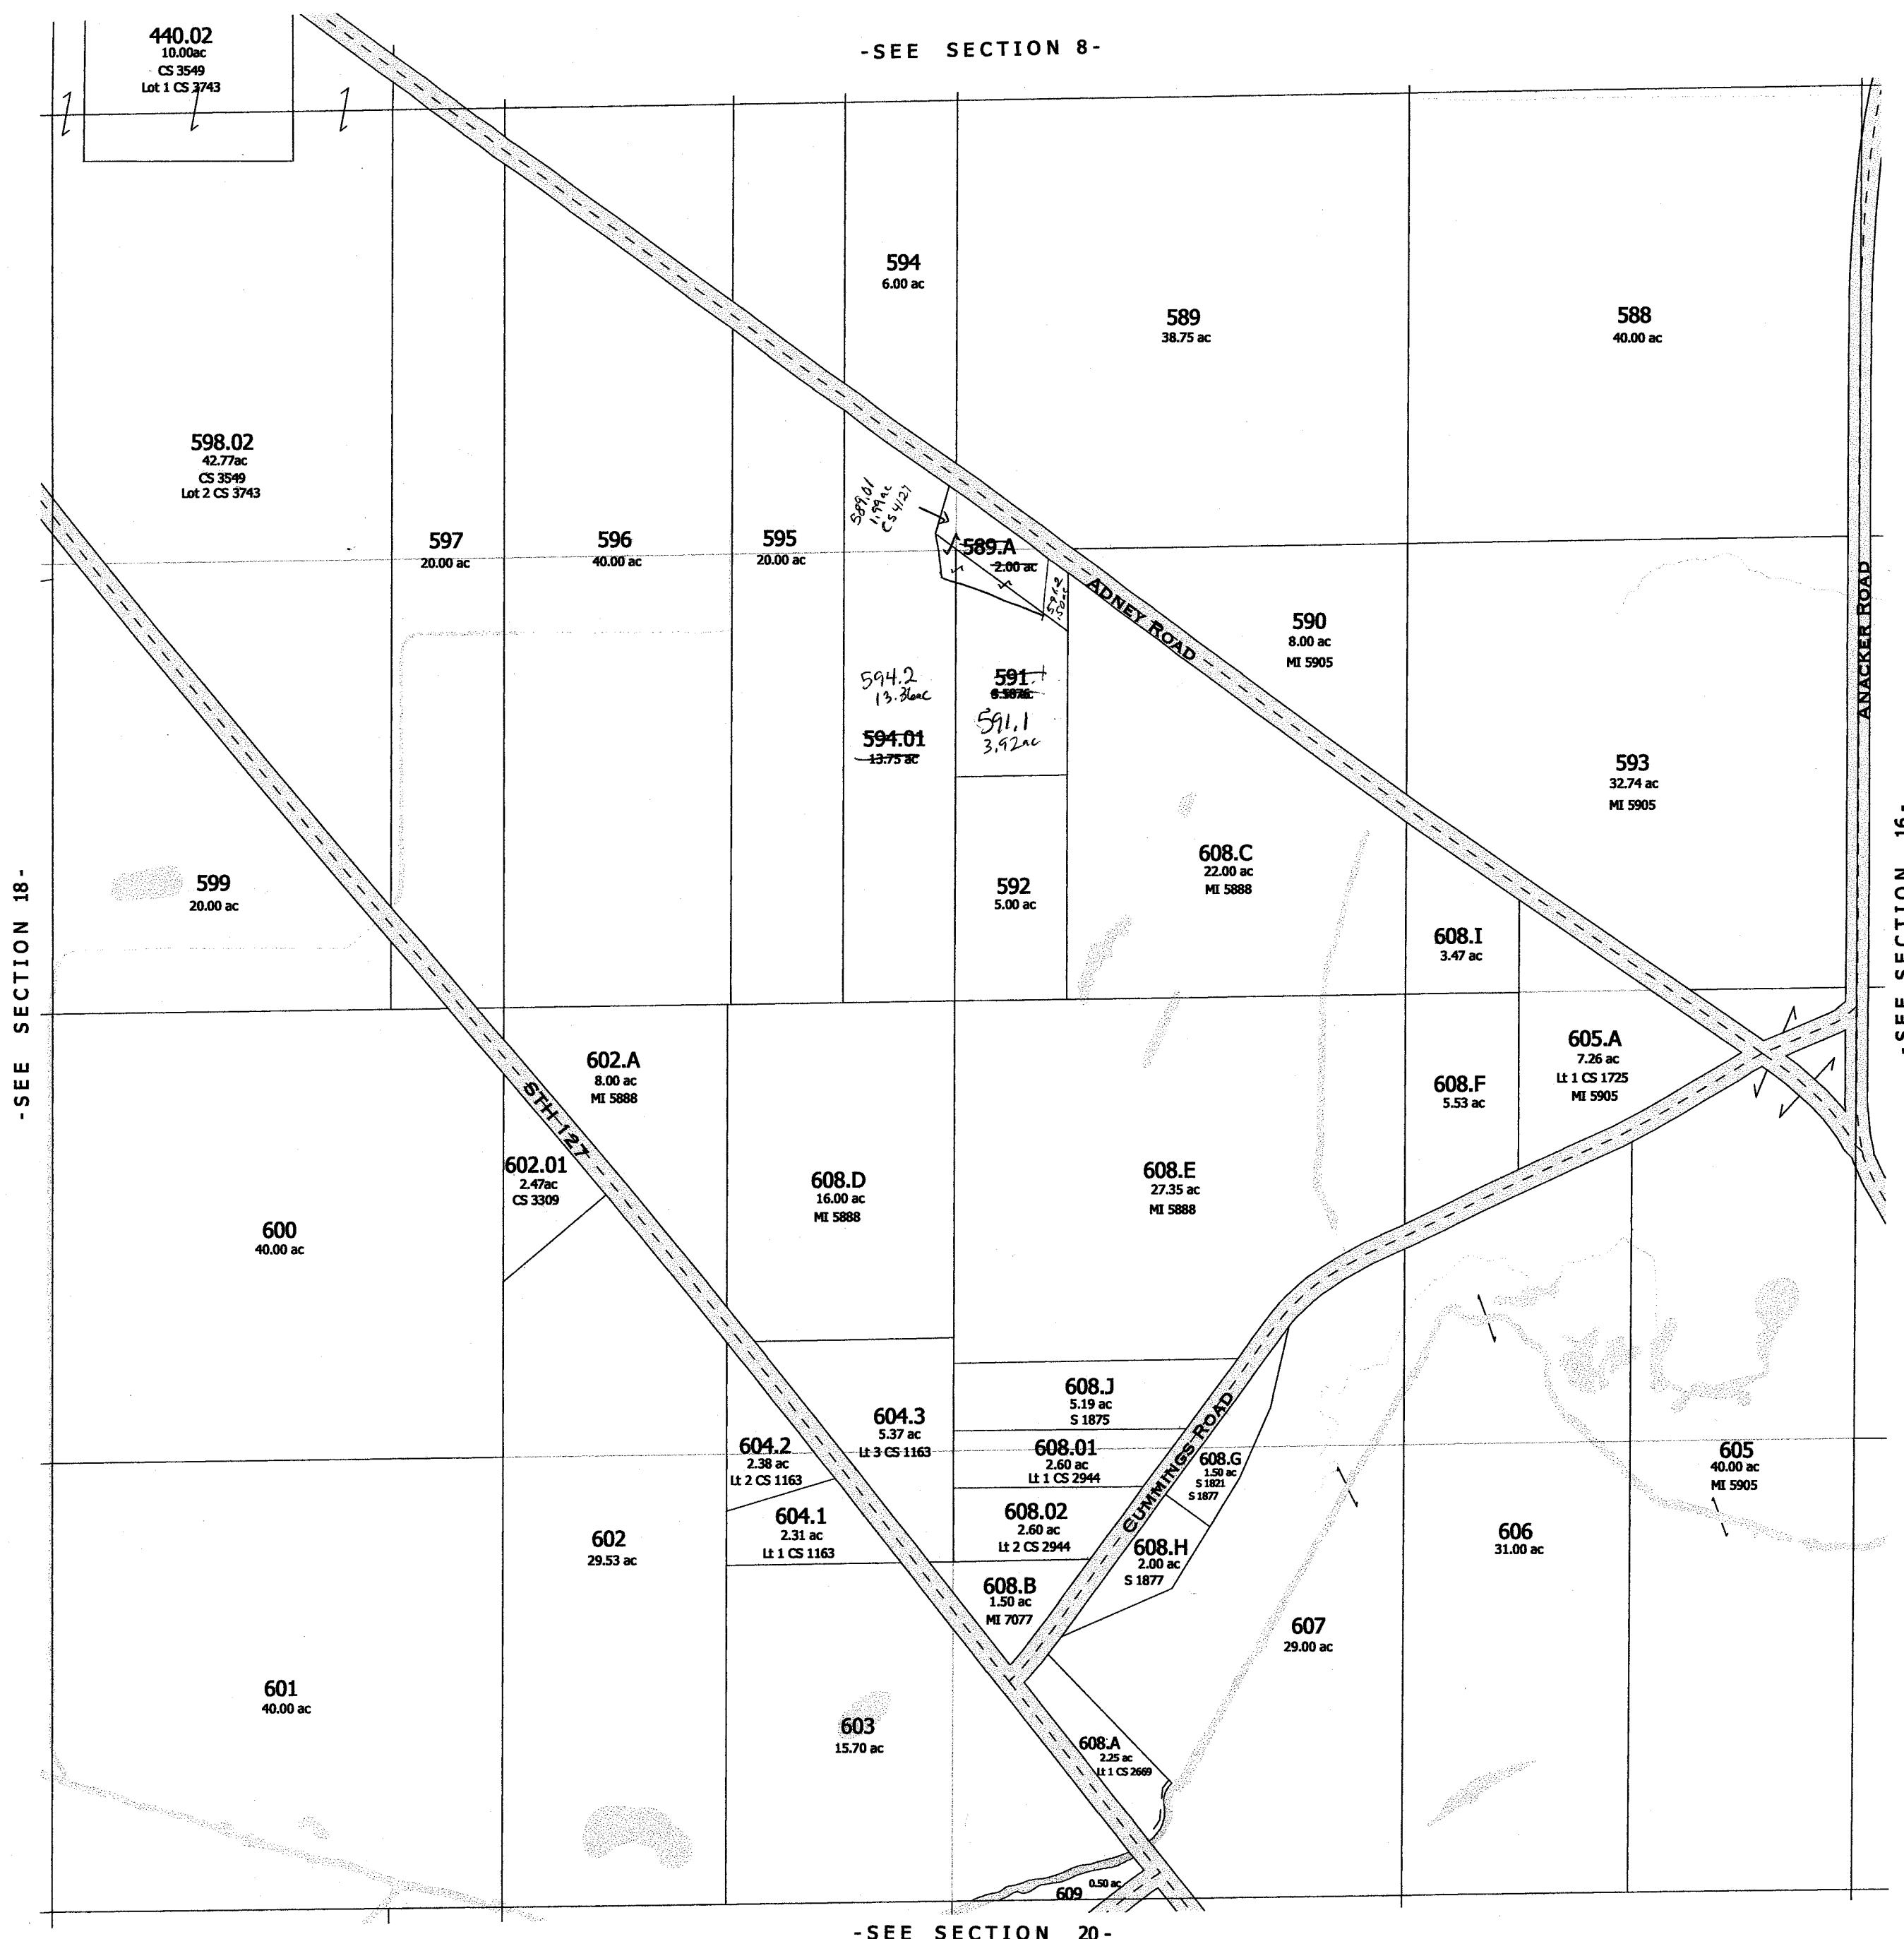

- SEE SECTION 16 -

2005


-SECTION 17-

One Inch Equals Four Hundred Feet
MILES
0 1/16 1/8 1/4
FEET
0 400 800 1200 1600


NOTE: This map was prepared for assessment use in accordance with the Wis. St. Stat. Chap. 70.09. All information contained herein is advisory only. Map accuracy is limited to the quality of data obtained from other Public Records. This map is not intended to be a substitute for an actual field survey. Public Land Survey Base is derived from U.S.G.S. Topographic maps unless otherwise noted. Other sources of the Land Base may be actual survey data. Base map data is from the April 1995 County Digital Orthophotos and/or U.S.G.S. 1:24,000 scale Topographic series. The user is responsible for the improper use of the data contained herein.

Created by The Columbia County Land Information Office -GIS Section. VMB.
February 2005.

TAX PARCEL MAP
TOWN of LEWISTON
TOWN 13 NORTH RANGE 8 EAST
COLUMBIA COUNTY, WISCONSIN

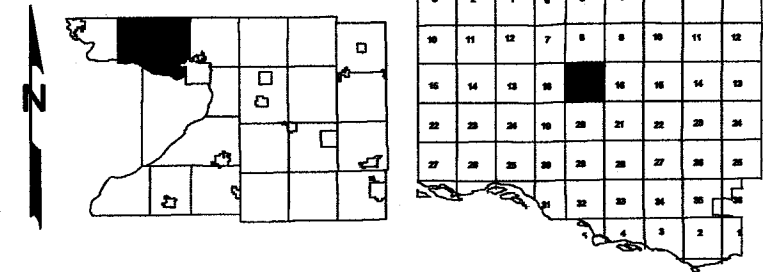

Replaced
2006

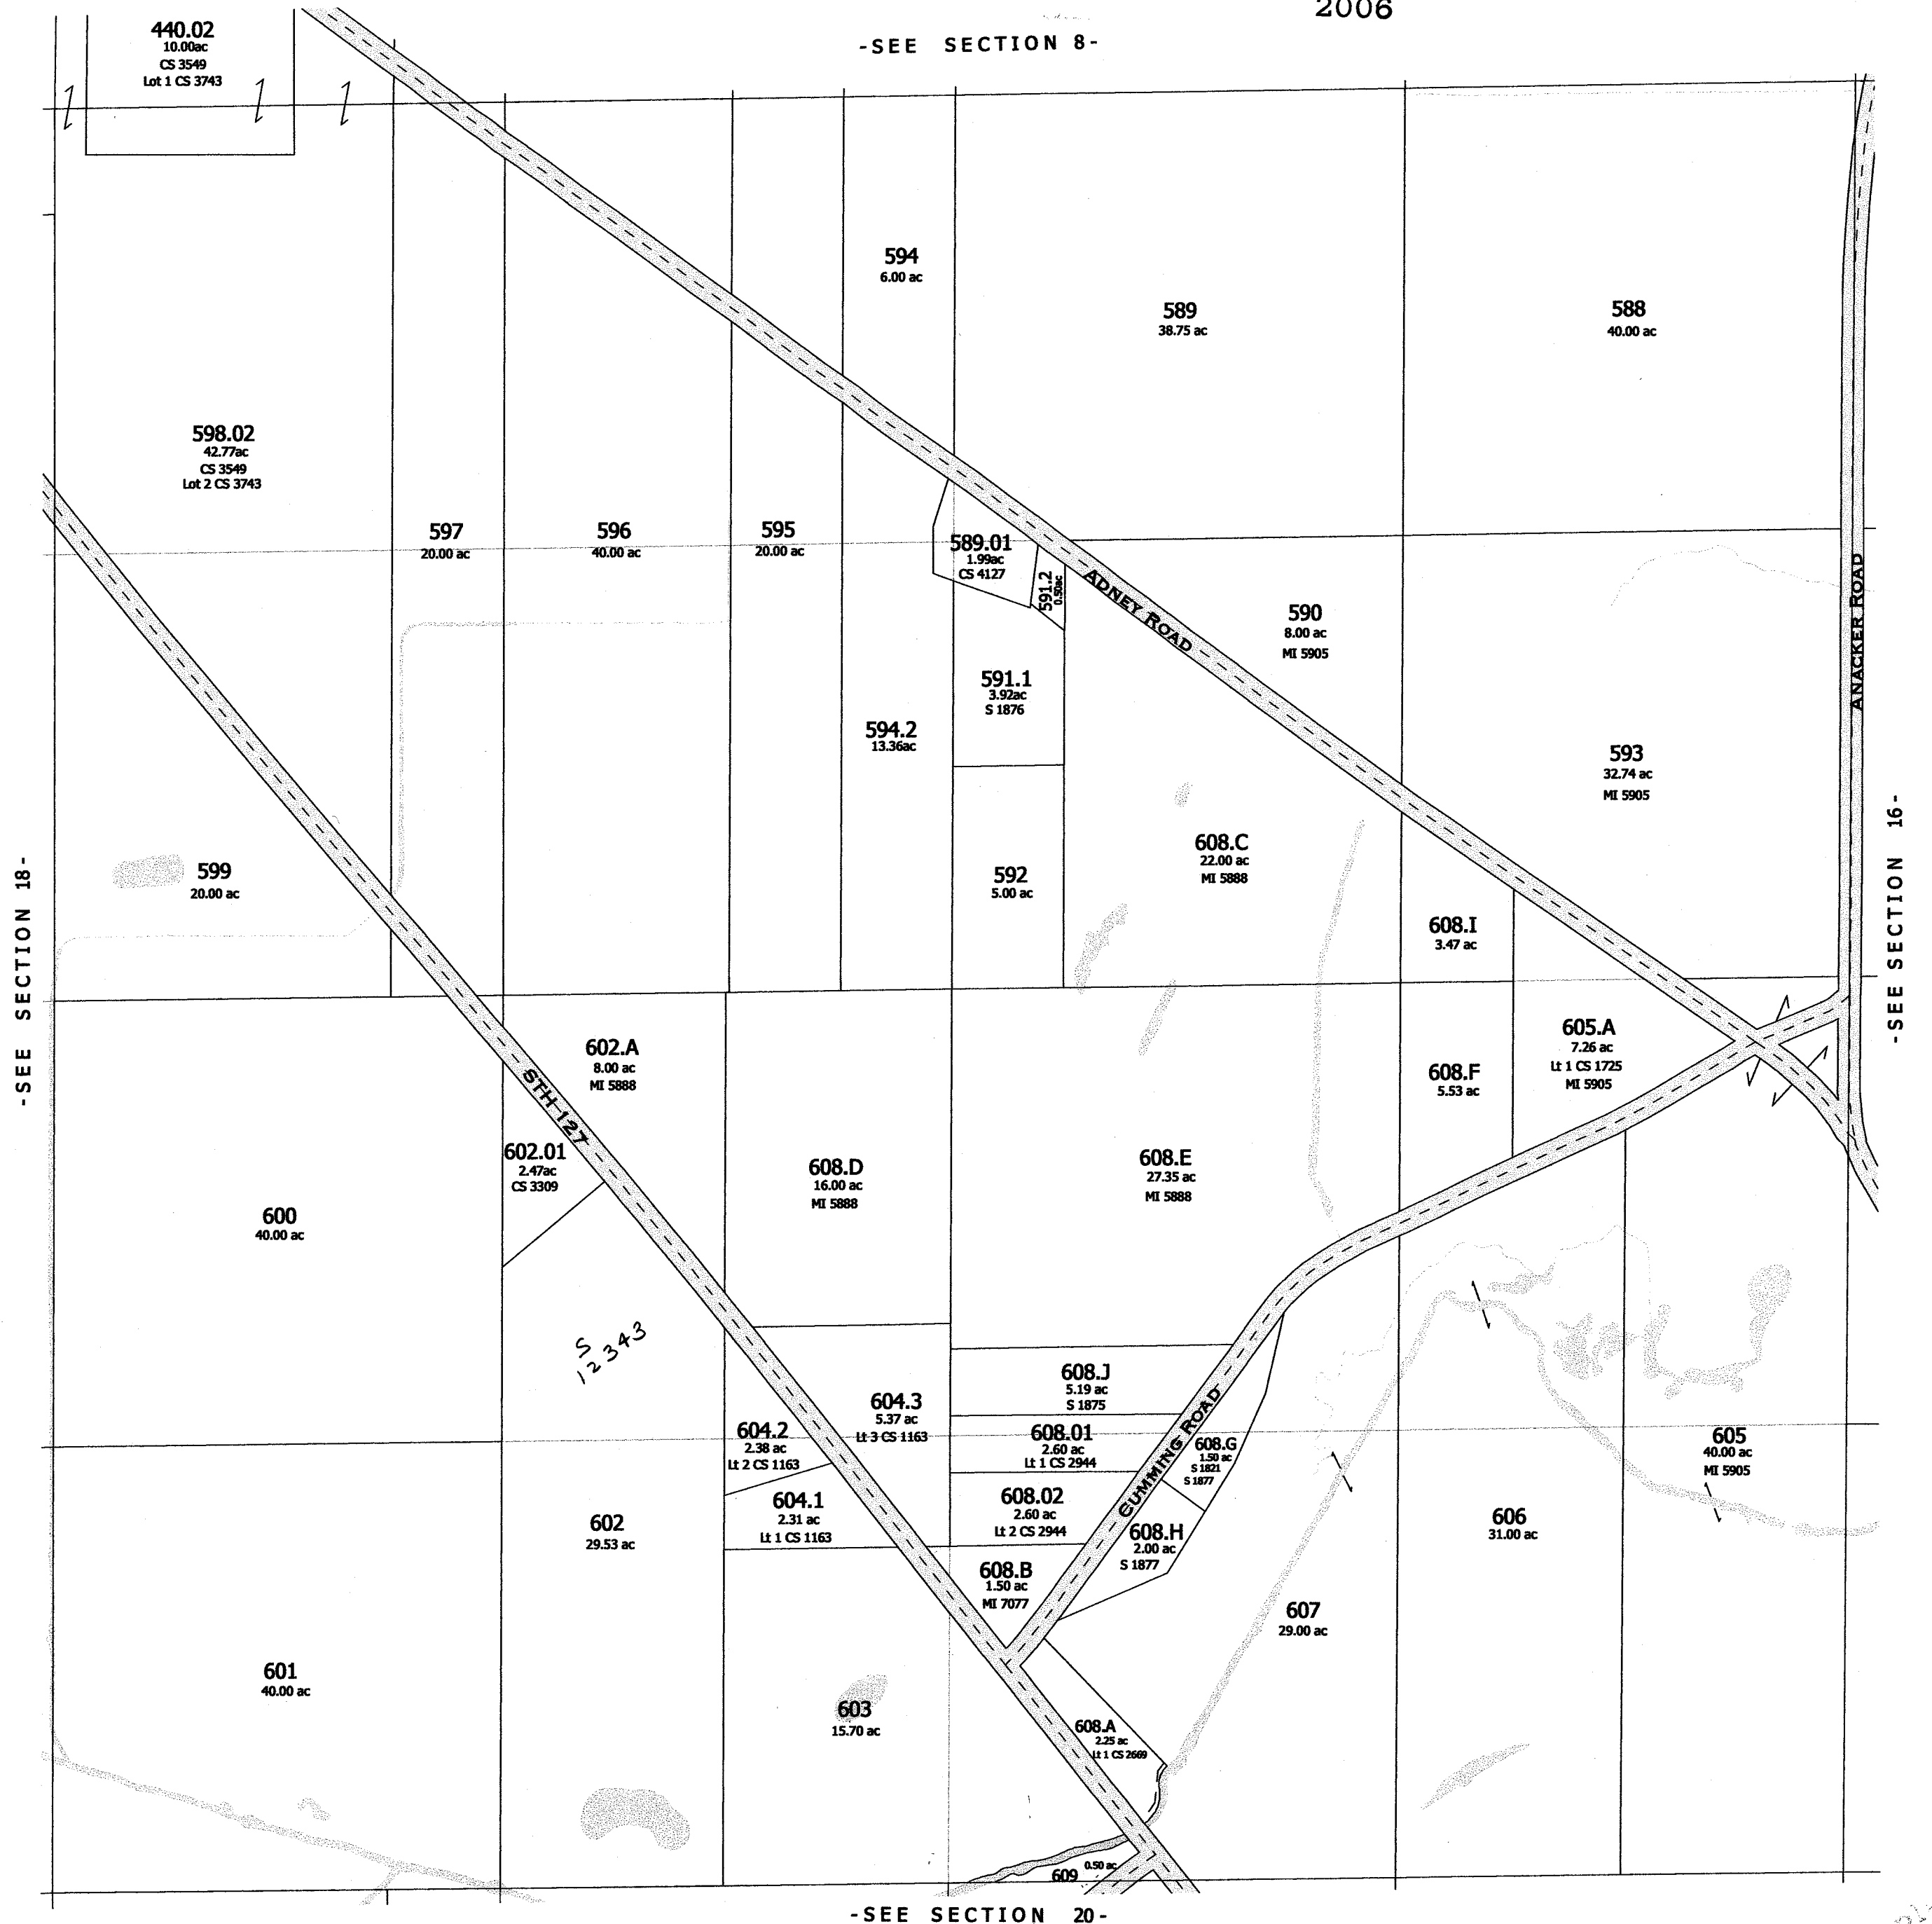

Replaced
2006

-SECTION 17-

One Inch Equals Four Hundred Feet
MILES
0 1/16 1/8 1/4
FEET
0 400 800 1200 1600


NOTE: This map was prepared for assessment use in accordance with the Wis. St. Stat. Chap. 70.09. All information contained herein is advisory only. Map accuracy is limited to the quality of data obtained from other Public Records. This map is not intended to be a substitute for an actual field survey. Public Land Survey Base is derived from U.S.G.S Topographic maps unless otherwise noted. Other sources of the Land Base may be actual survey data. Base map data is from the April 1995 County Digital Orthophotos and/or U.S.G.S 1:24,000 scale Topographic series. The user is responsible for the improper use of the data contained herein.

Created by The Columbia County Land Information Office -GIS Section. VMB.
February 2006.


TAX PARCEL MAP

TOWN of LEWISTON

TOWN 13 NORTH RANGE 8 EAST
COLUMBIA COUNTY, WISCONSIN

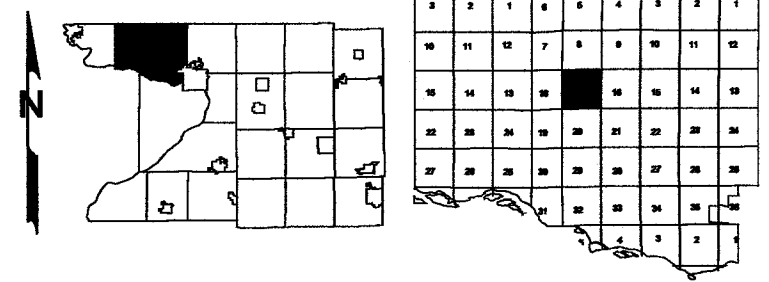


Replaced
2007

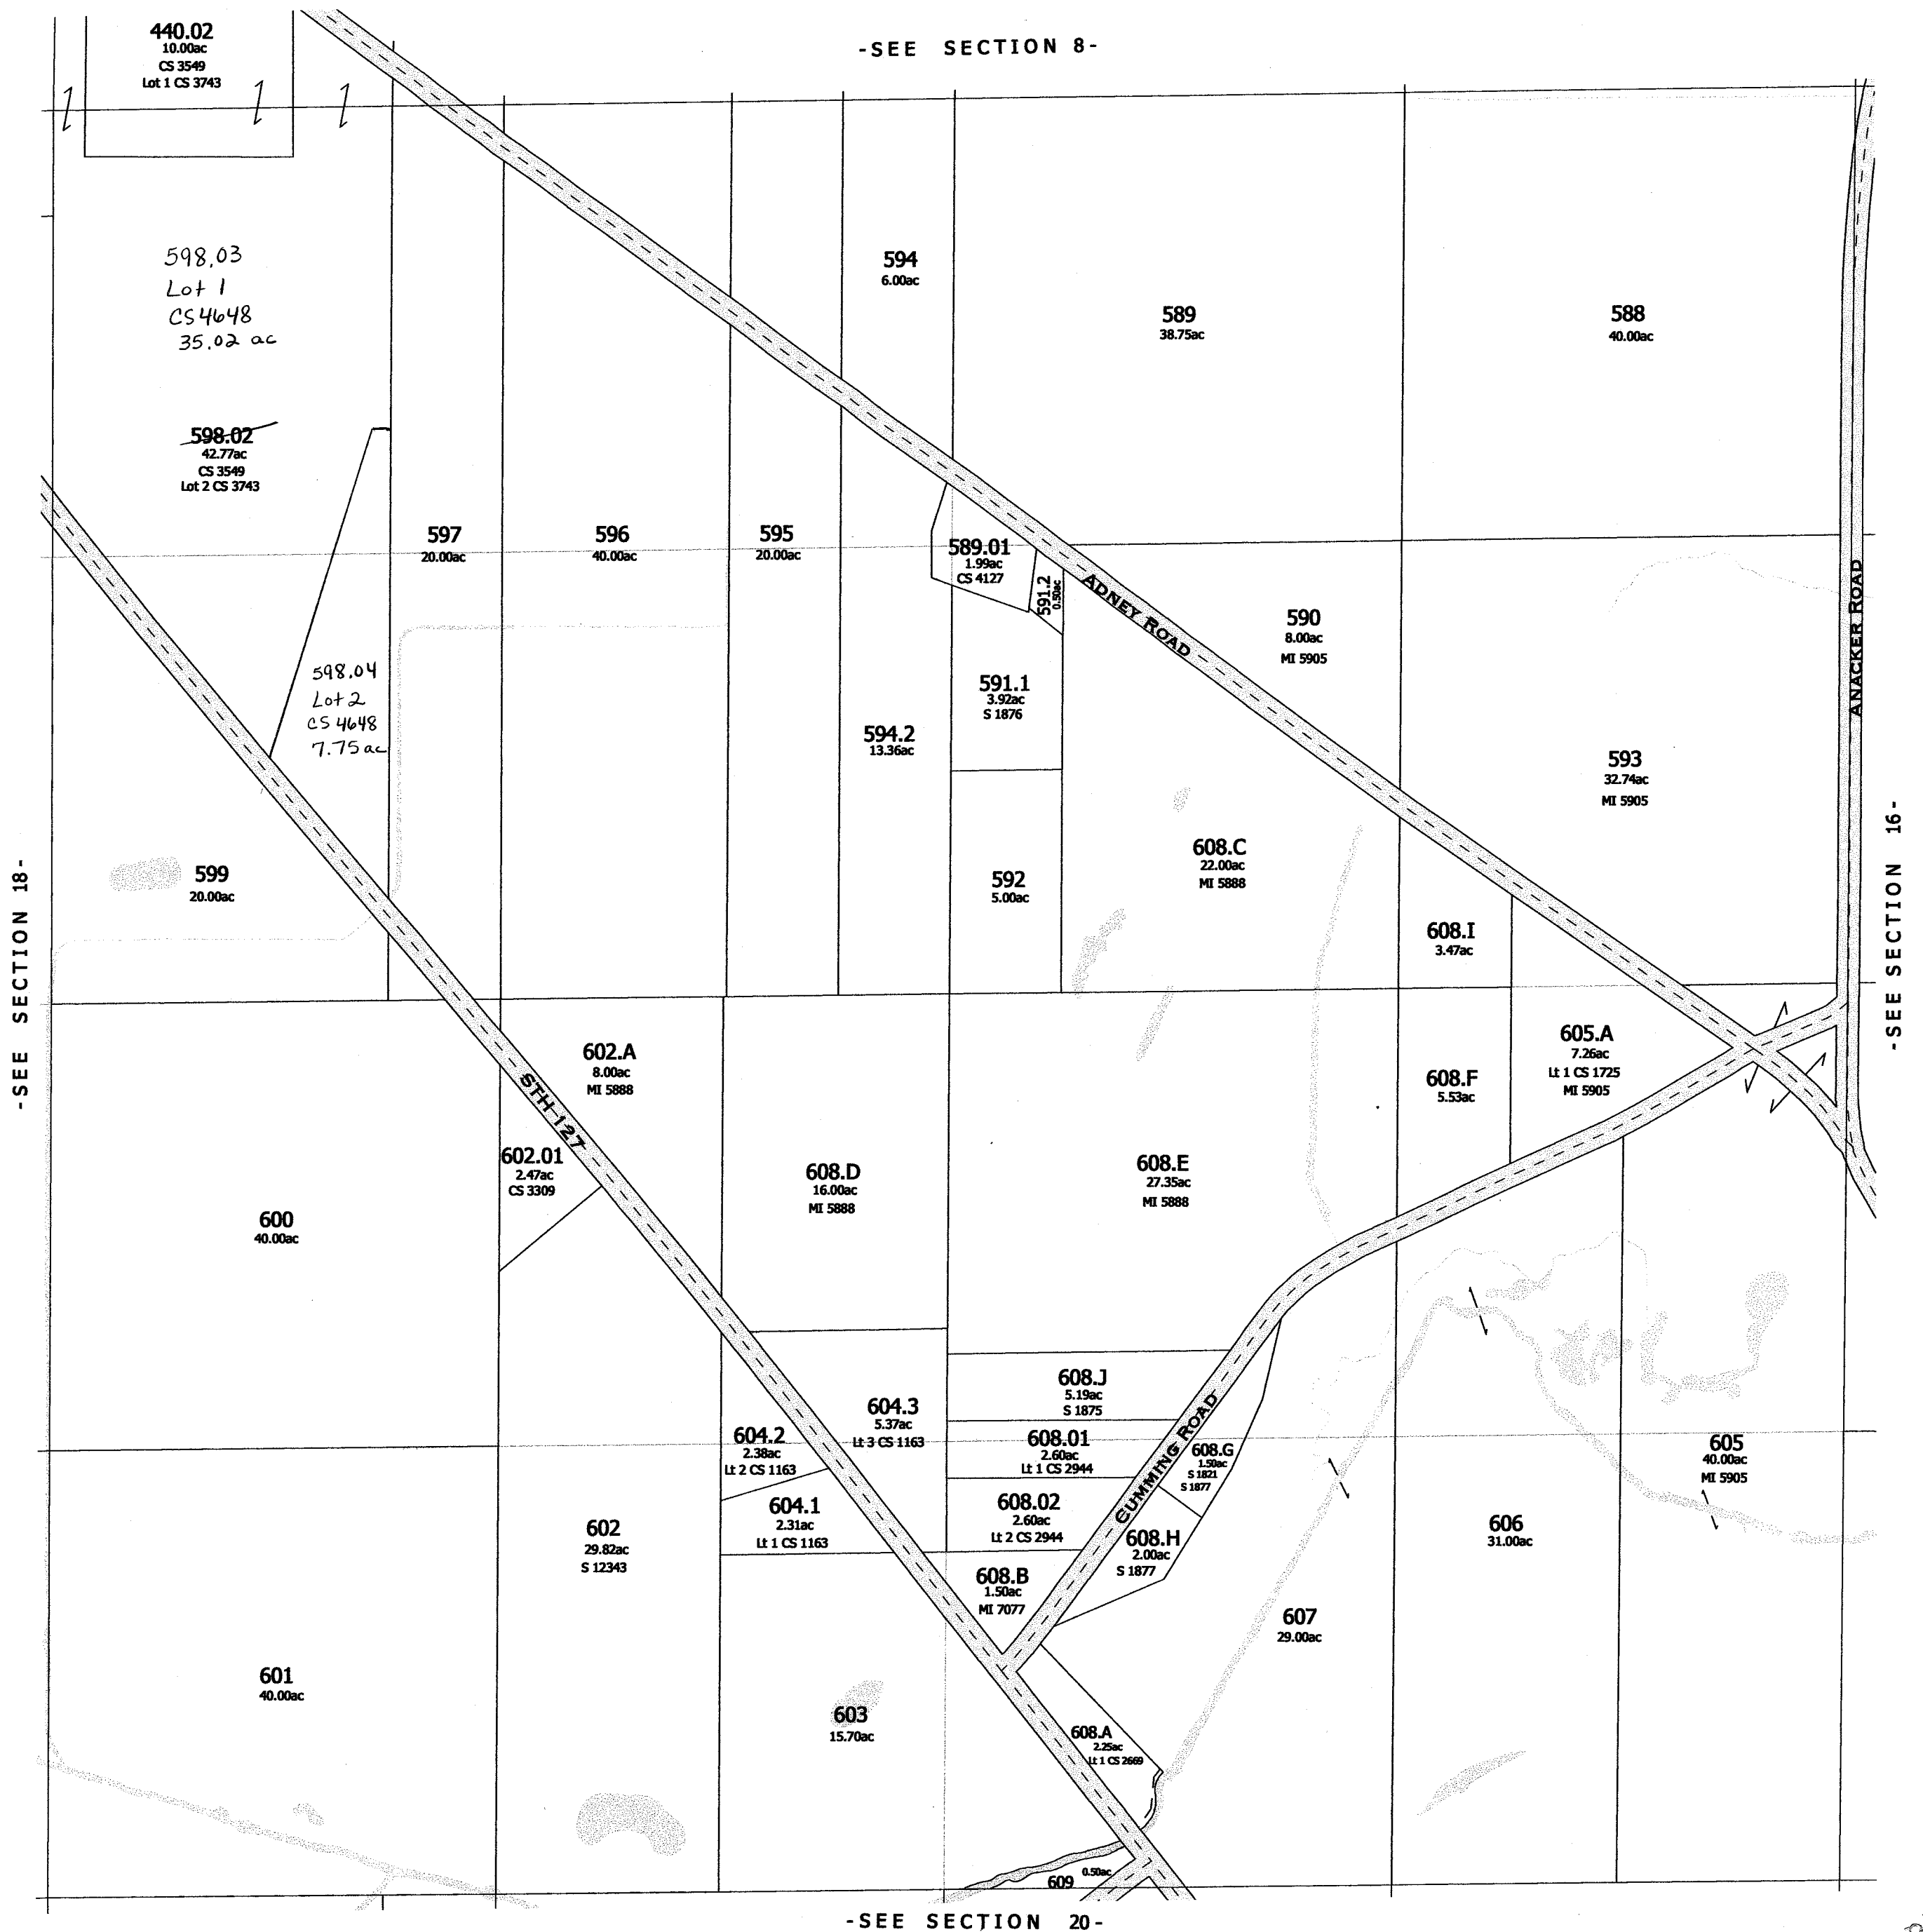


Replaced
2007

LEWISTON
SEC. 18 T13N R8E

Replaced
2002

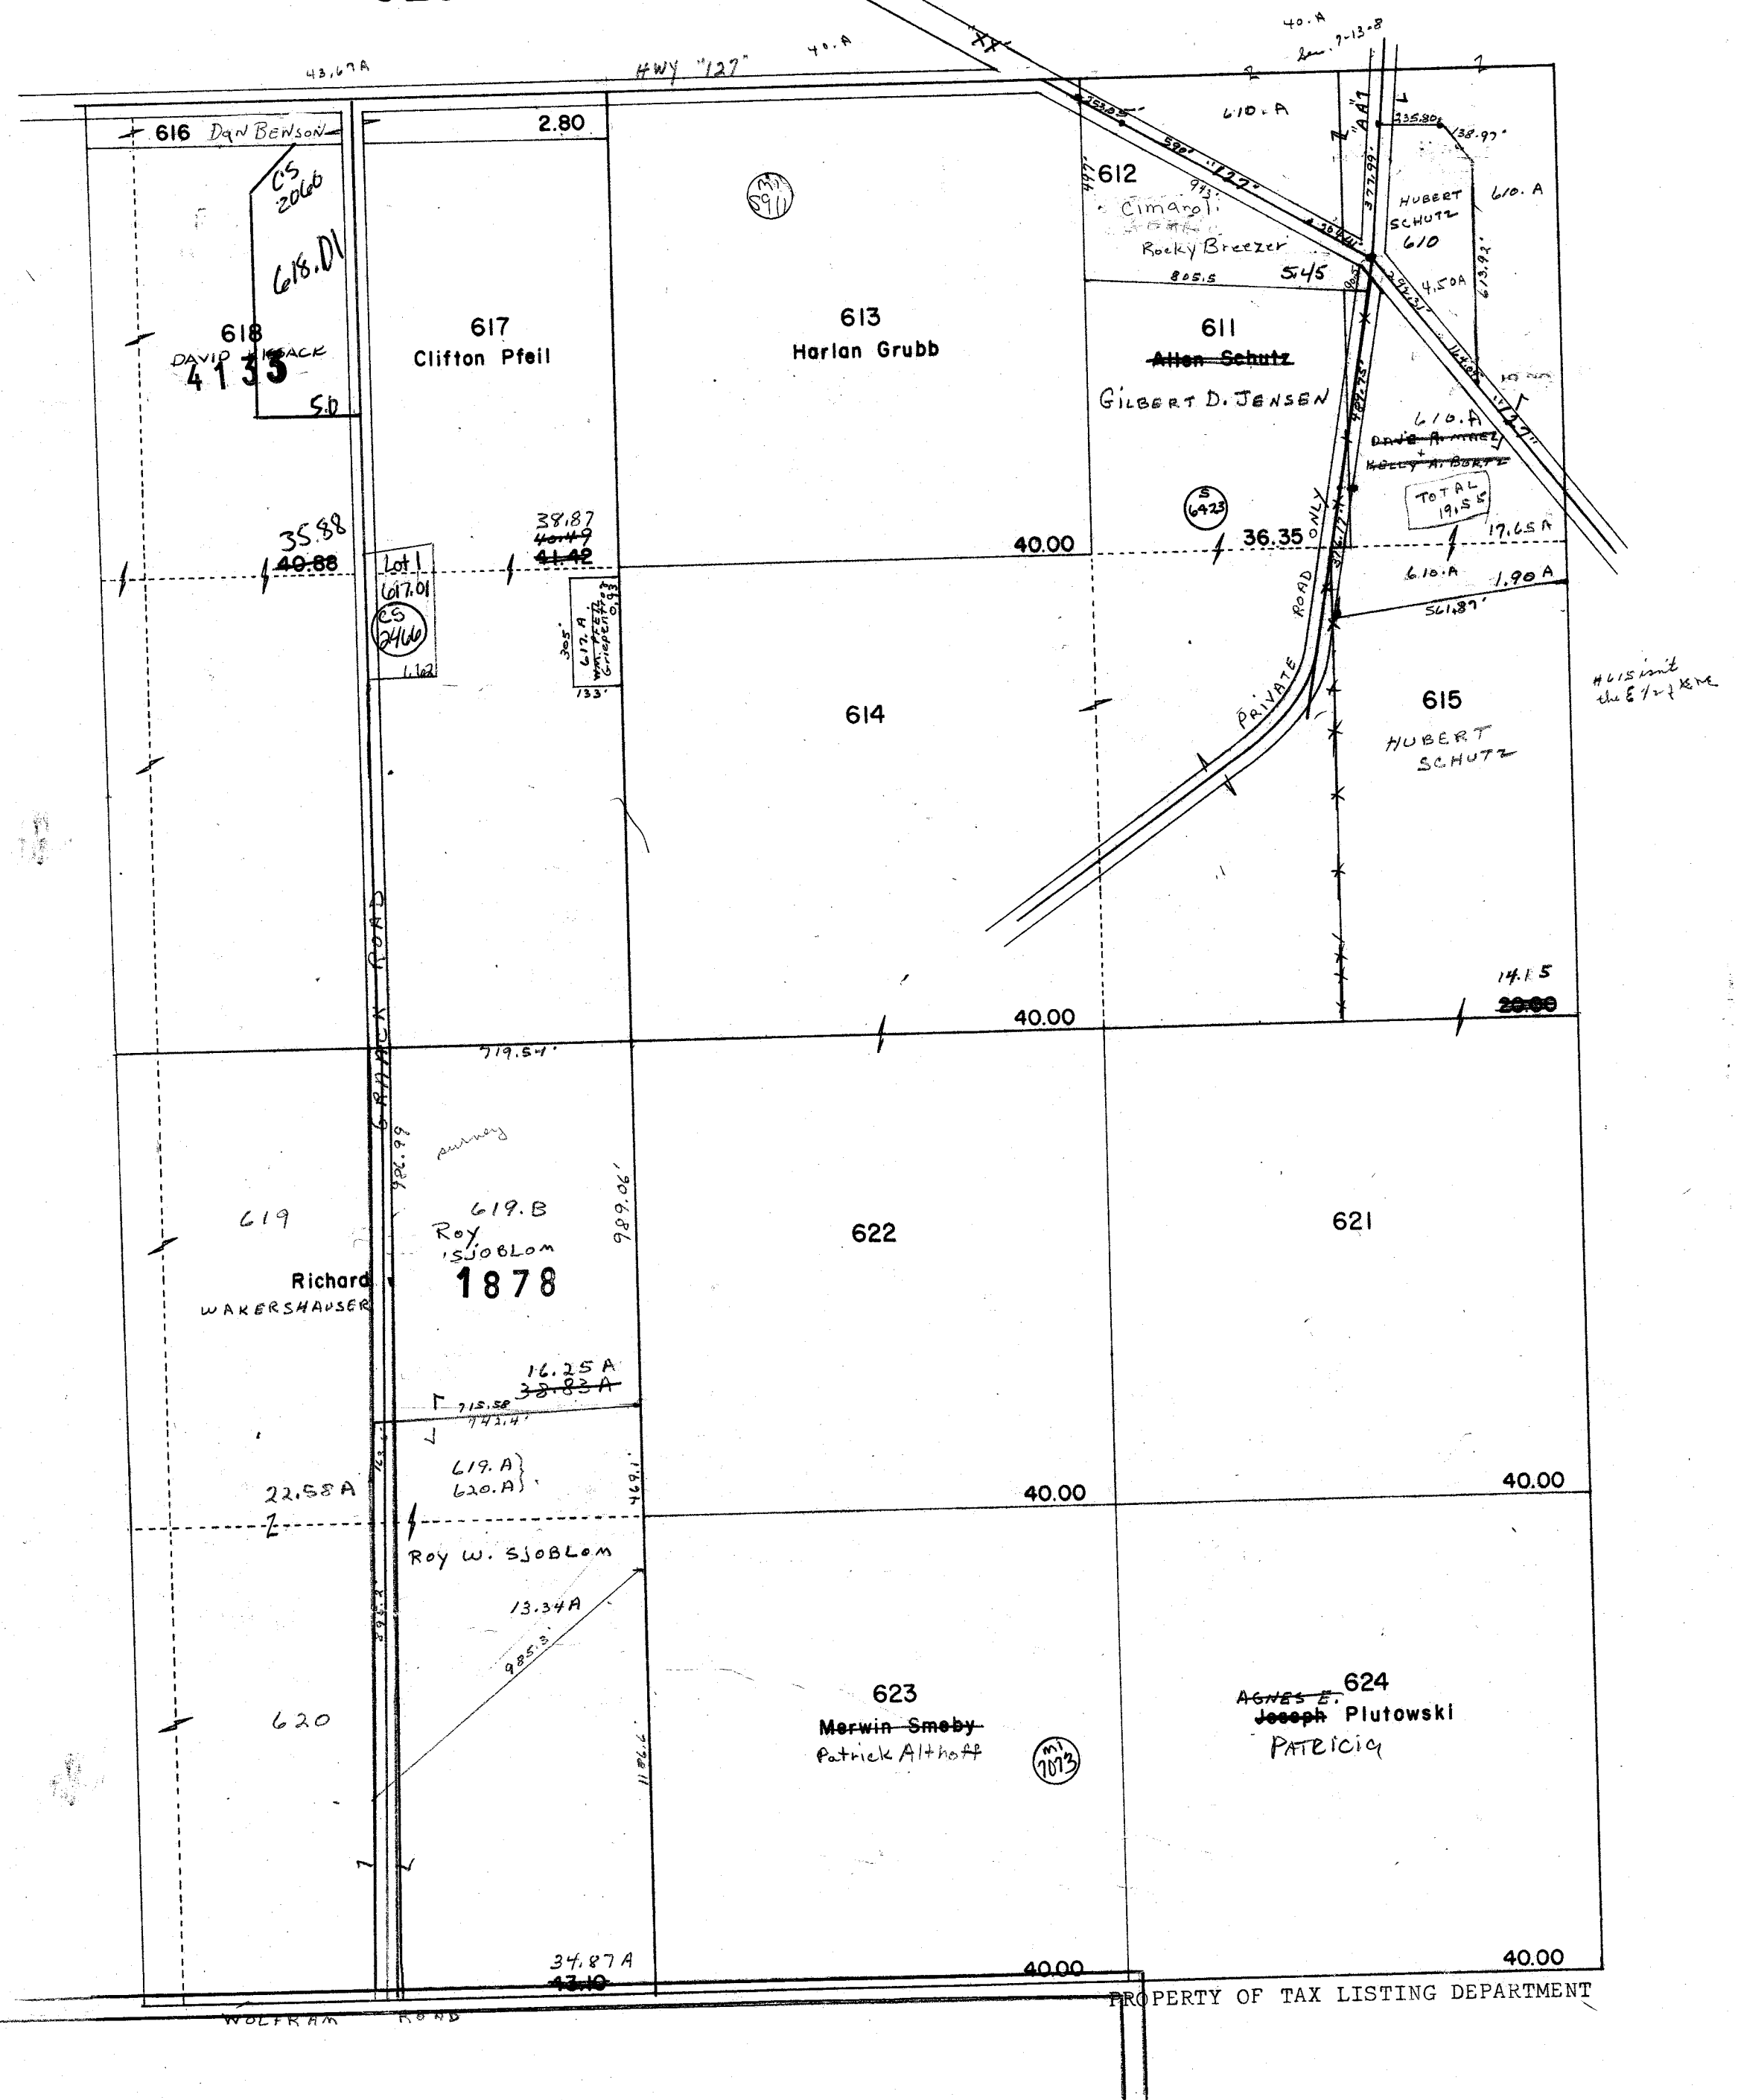

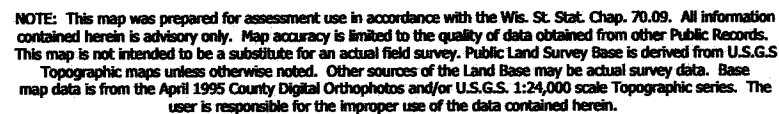


NOTE: This map was prepared for assessment use in accordance with the Wis. St. Stat. Chap. 70.09. All information contained herein is advisory only. Map accuracy is limited to the quality of data obtained from other Public Records. This map is not intended to be a substitute for an actual field survey. Public Land Survey Base is derived from U.S.G.S Topographic maps unless otherwise noted. Other sources of the Land Base may be actual survey data. Base map data is from the April 1995 County Digital Orthophotos and/or U.S.G.S. 1:24,000 scale Topographic series. The user is responsible for the improper use of the data contained herein.

Created by The Columbia County Land Information Office -GIS Section. VMB.
September 2002.

TOWN of LEWISTON

TOWN 13 NORTH RANGE 8 EAST
COLUMBIA COUNTY, WISCONSIN

Replaced
2005

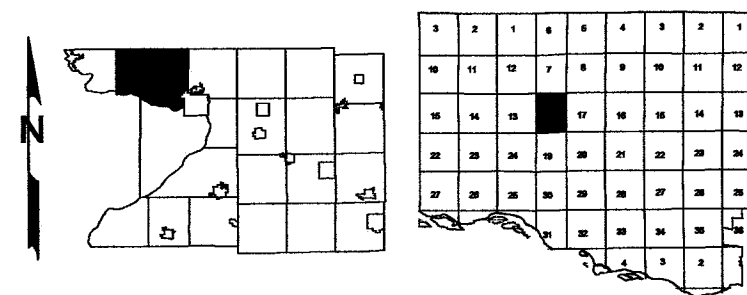

Parcel Data:

Parcel ID	Acreage	Notes/References
616	2.80 ac	
617	38.87 ac	
617.01	1.62 ac	LT 1 CS 2466
617.A	0.88 ac	S 571
618	35.88 ac	
618.01	5.00 ac	LT 1 CS 2060
619	22.58 ac	
619.B	16.25 ac	S 1878
619.A	13.34 ac	
620	34.87 ac	
621	40.00 ac	
622	40.00 ac	
623	40.00 ac	MI 7073
624	40.00 ac	
611	36.35 ac	S 6423
612	5.45 ac	
613	40.00 ac	MI 5911
614	40.00 ac	
615	14.15 ac	
615	9.50 ac	
610.A	19.55 ac	

Handwritten Notes:

- LT 3 CS #4153
- 610.03
- 16.79A
- LT 2 CS #4153
- 12.79
- 610.01
- 71.56
- LT 1 CS #4153
- 610.02


Roads: STH 127, GRAACK ROAD, WOLFRAM ROAD

Section References: -SEE SECTION 13 T1, -SEE SECTION 17-, -SEE SECTION 19-

- SEE SECTION 19 -

-SECTION 18-


2005

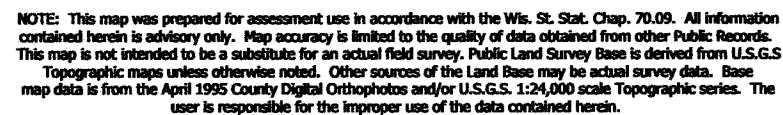

Created by The Columbia County Land Information Office -GIS Section. VMB.
February 2005.


TOWN of LEWISTON

TOWN 13 NORTH RANGE 8 EAST
COLUMBIA COUNTY, WISCONSIN

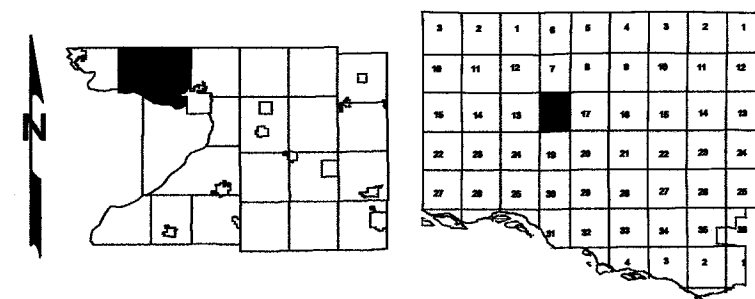

Replaced
2006

-SEE SECTION 7-

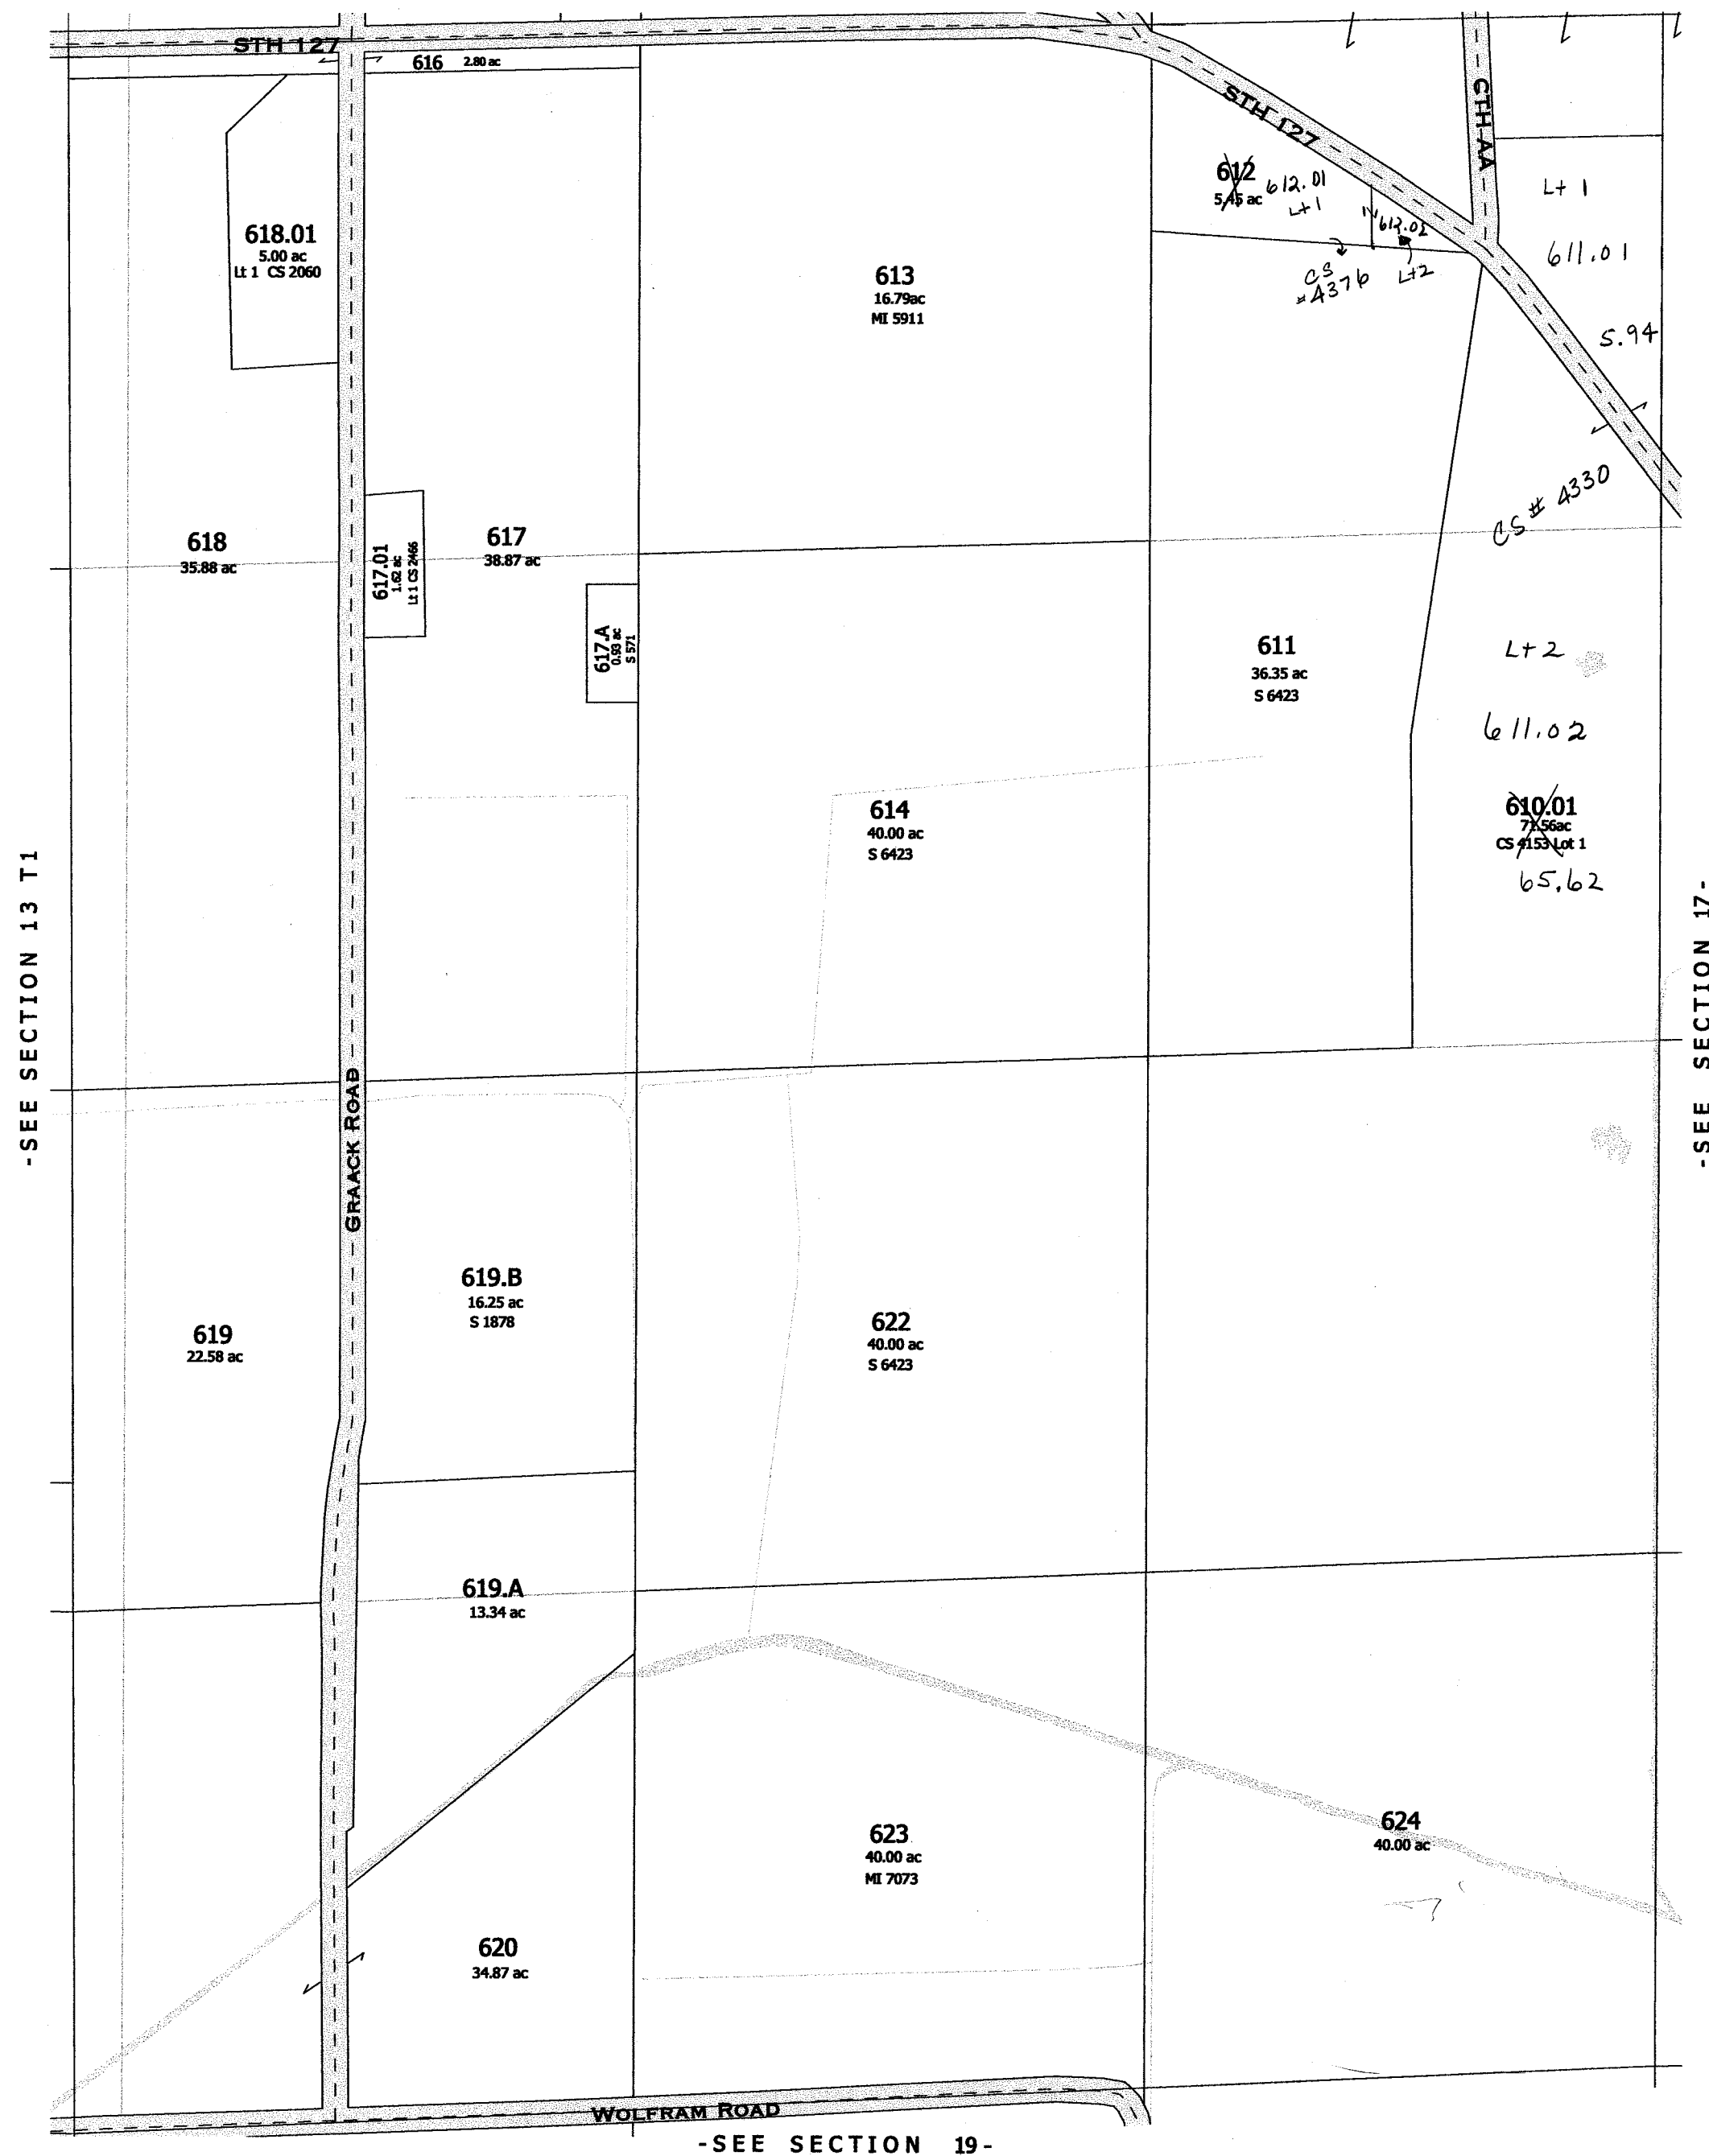



- SEE SECTION 19 -

2006

- SECTION 18 -

Replaced
2002

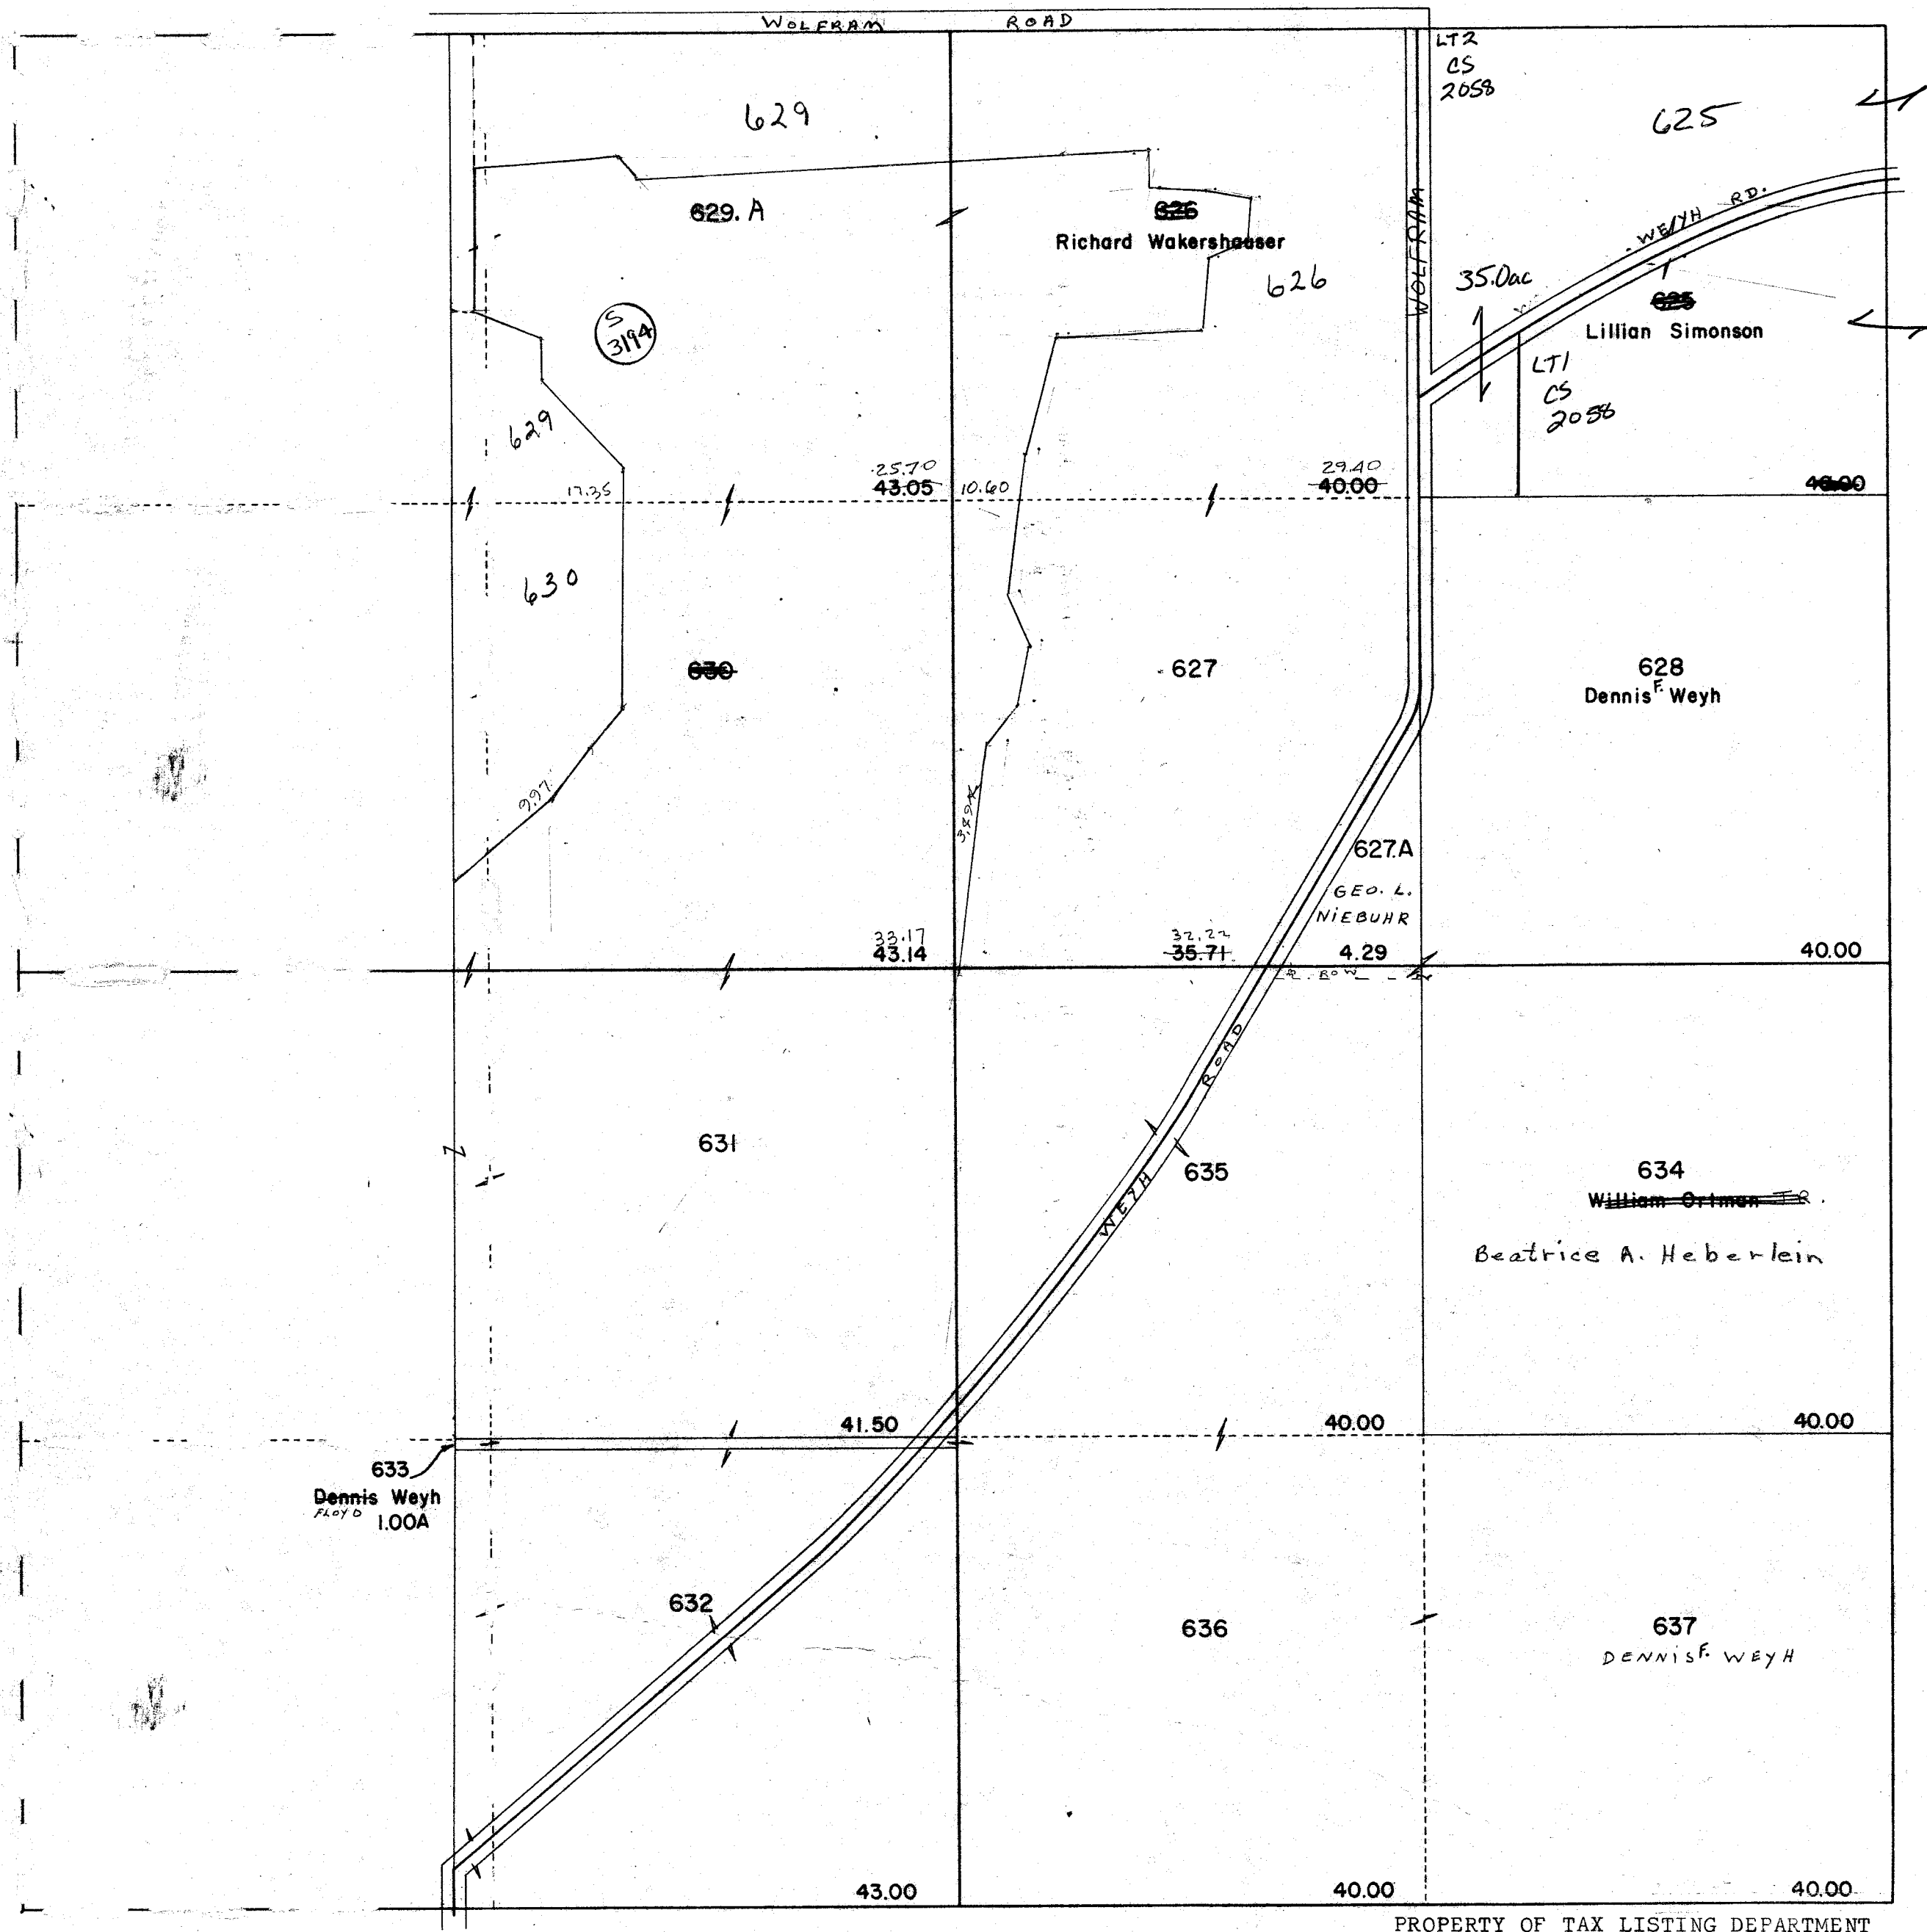

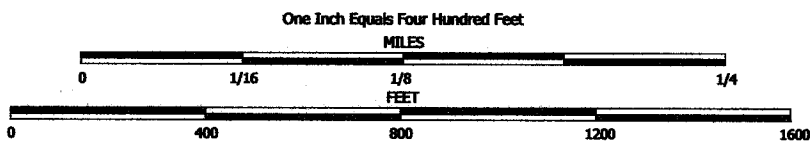



NOTE: This map was prepared for assessment use in accordance with the Wis. St. Stat. Chap. 70.09. All information contained herein is advisory only. Map accuracy is limited to the quality of data obtained from other Public Records. This map is not intended to be a substitute for an actual field survey. Public Land Survey Base is derived from U.S.G.S. Topographic maps unless otherwise noted. Other sources of the Land Base may be actual survey data. Base map data is from the April 1995 County Digital Orthophotos and/or U.S.G.S. 1:24,000 scale Topographic series. The user is responsible for the improper use of the data contained herein.

Created by The Columbia County Land Information Office -GIS Section. VMB.
September 2002.

TAX PARCEL MAP


TOWN of LEWISTON

TOWN 13 NORTH RANGE 8 EAST
COLUMBIA COUNTY, WISCONSIN

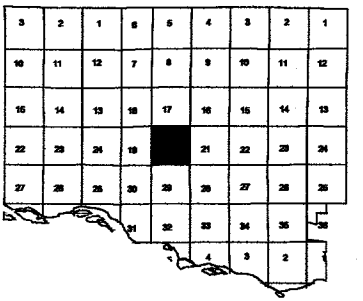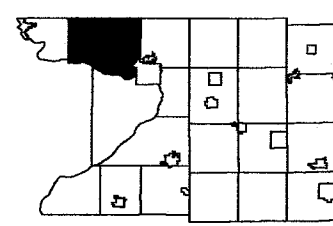

Replaced
2007

-SEE SECTION 17-

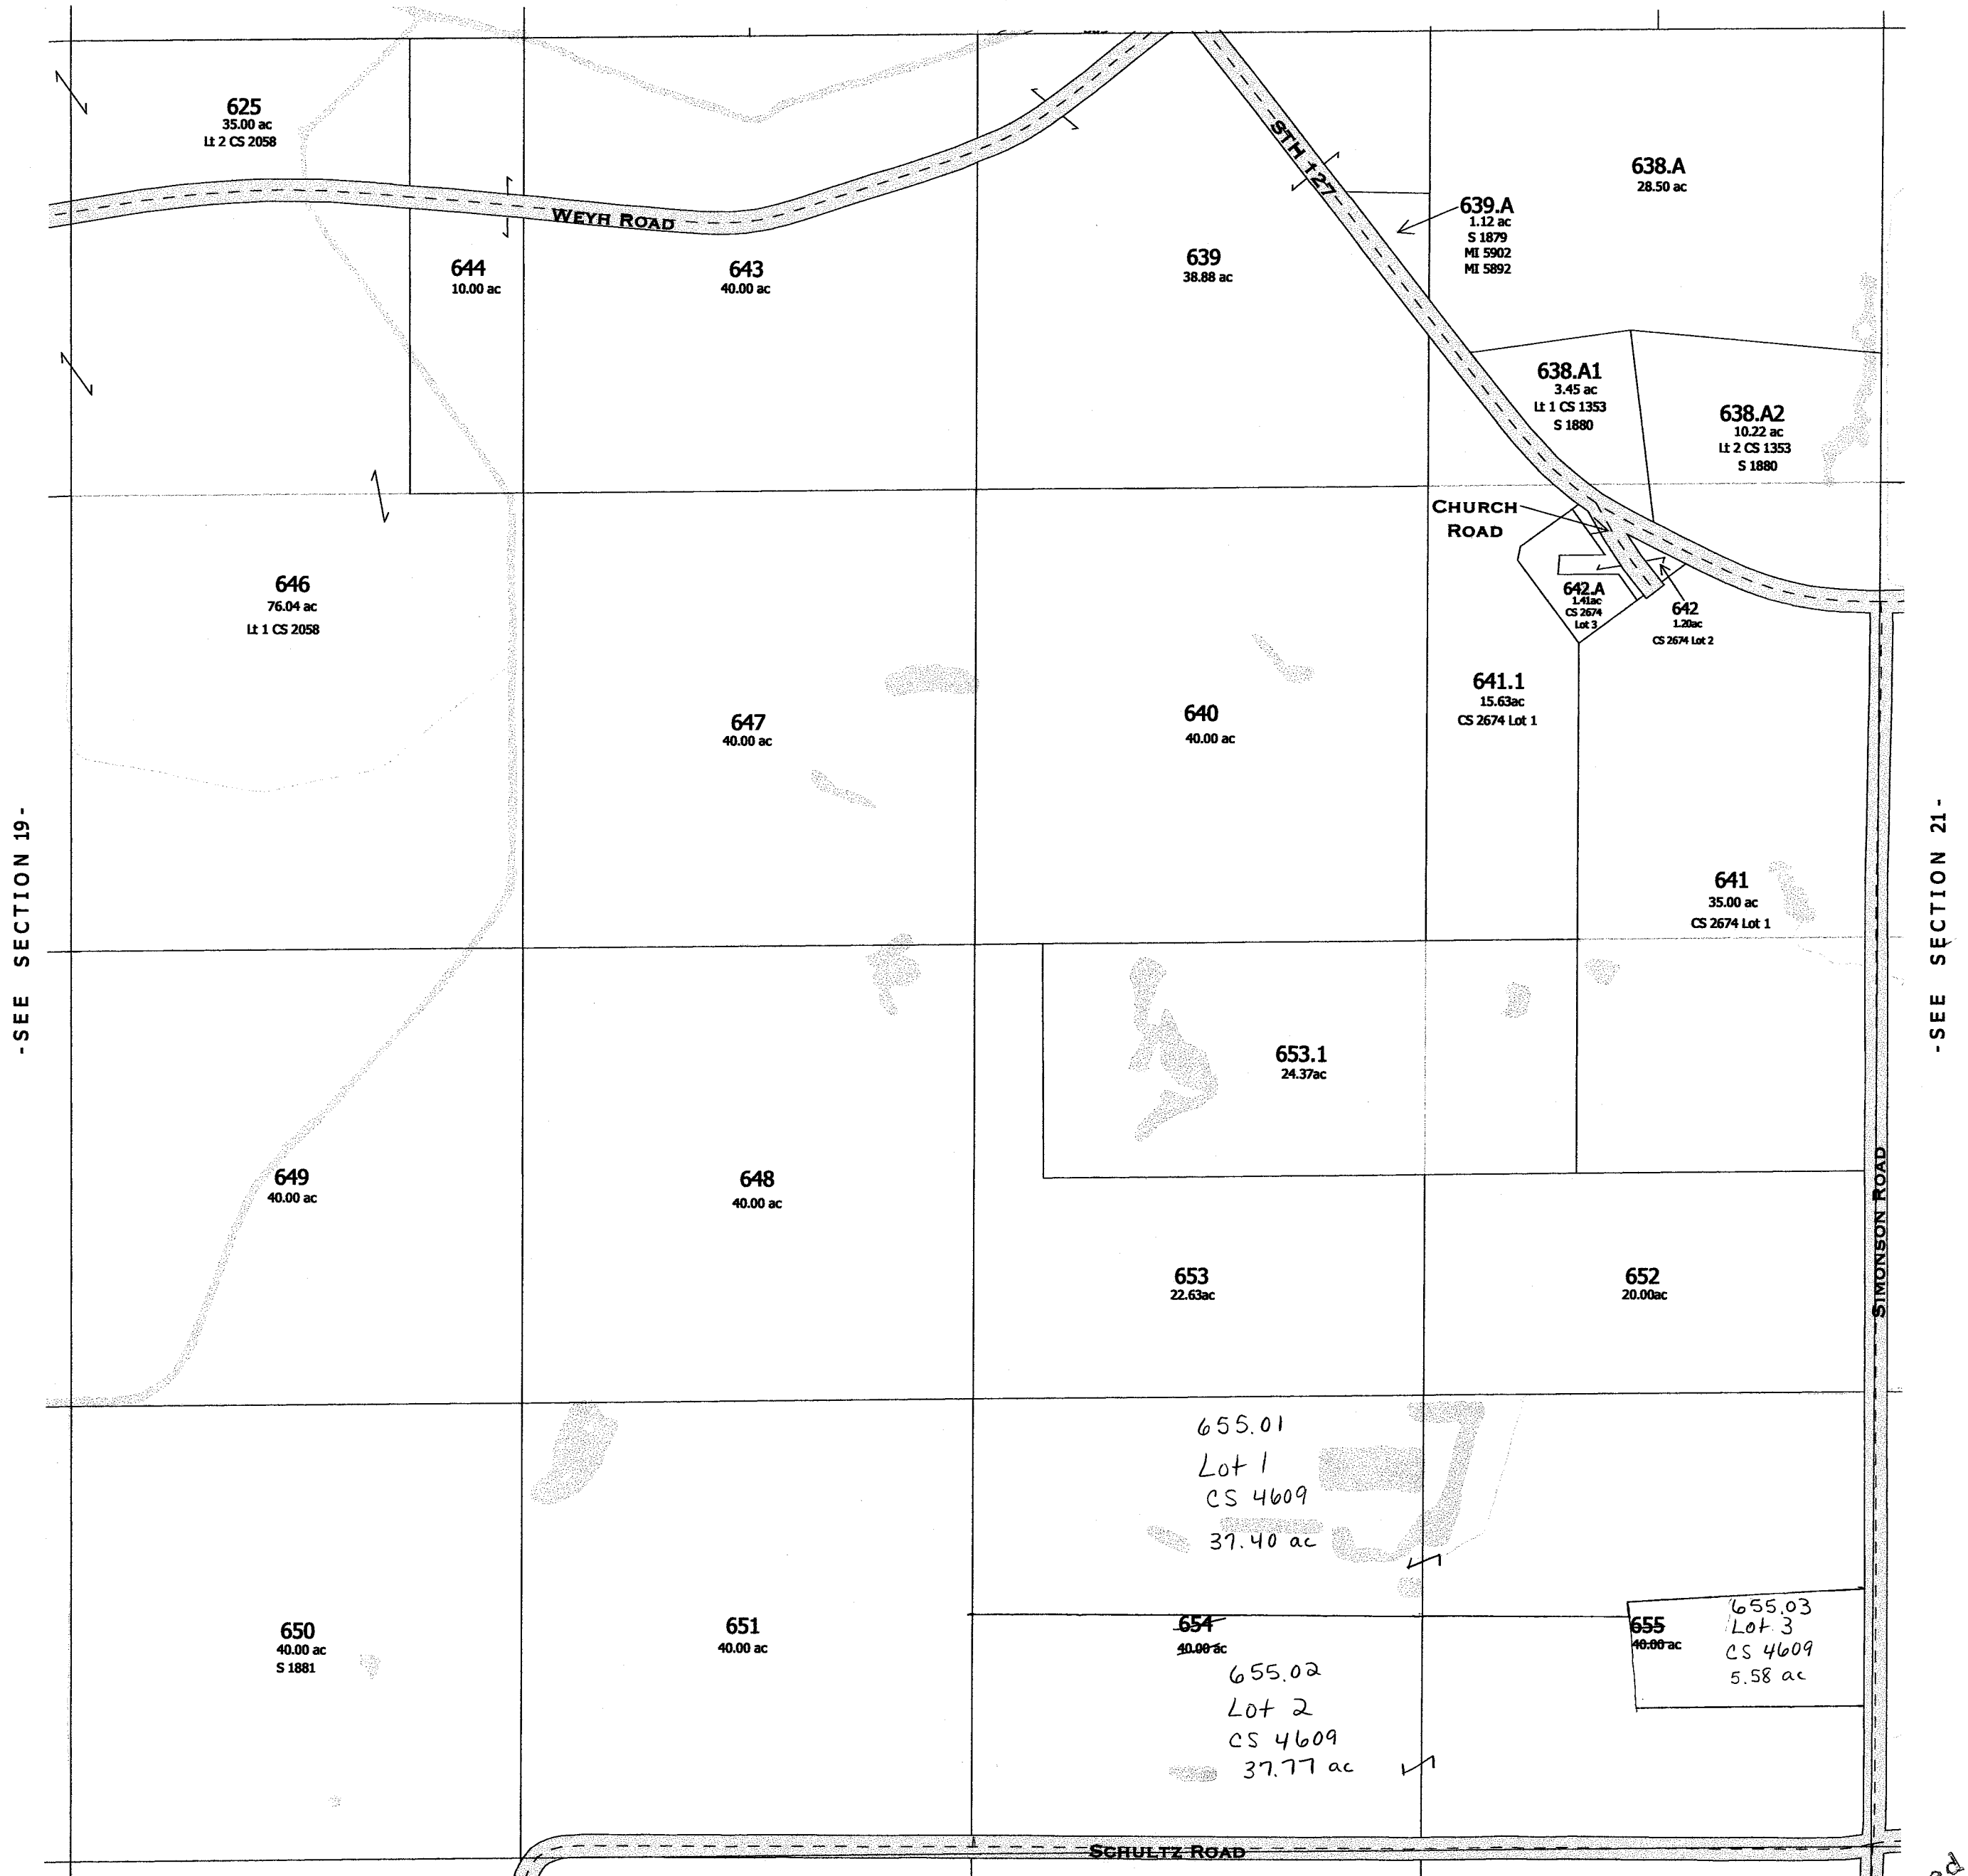

-SEE SECTION 19-


-SEE SECTION 21-

-SEE SECTION 29-

Replaced
2007

-SECTION 20-


Replaced
2002

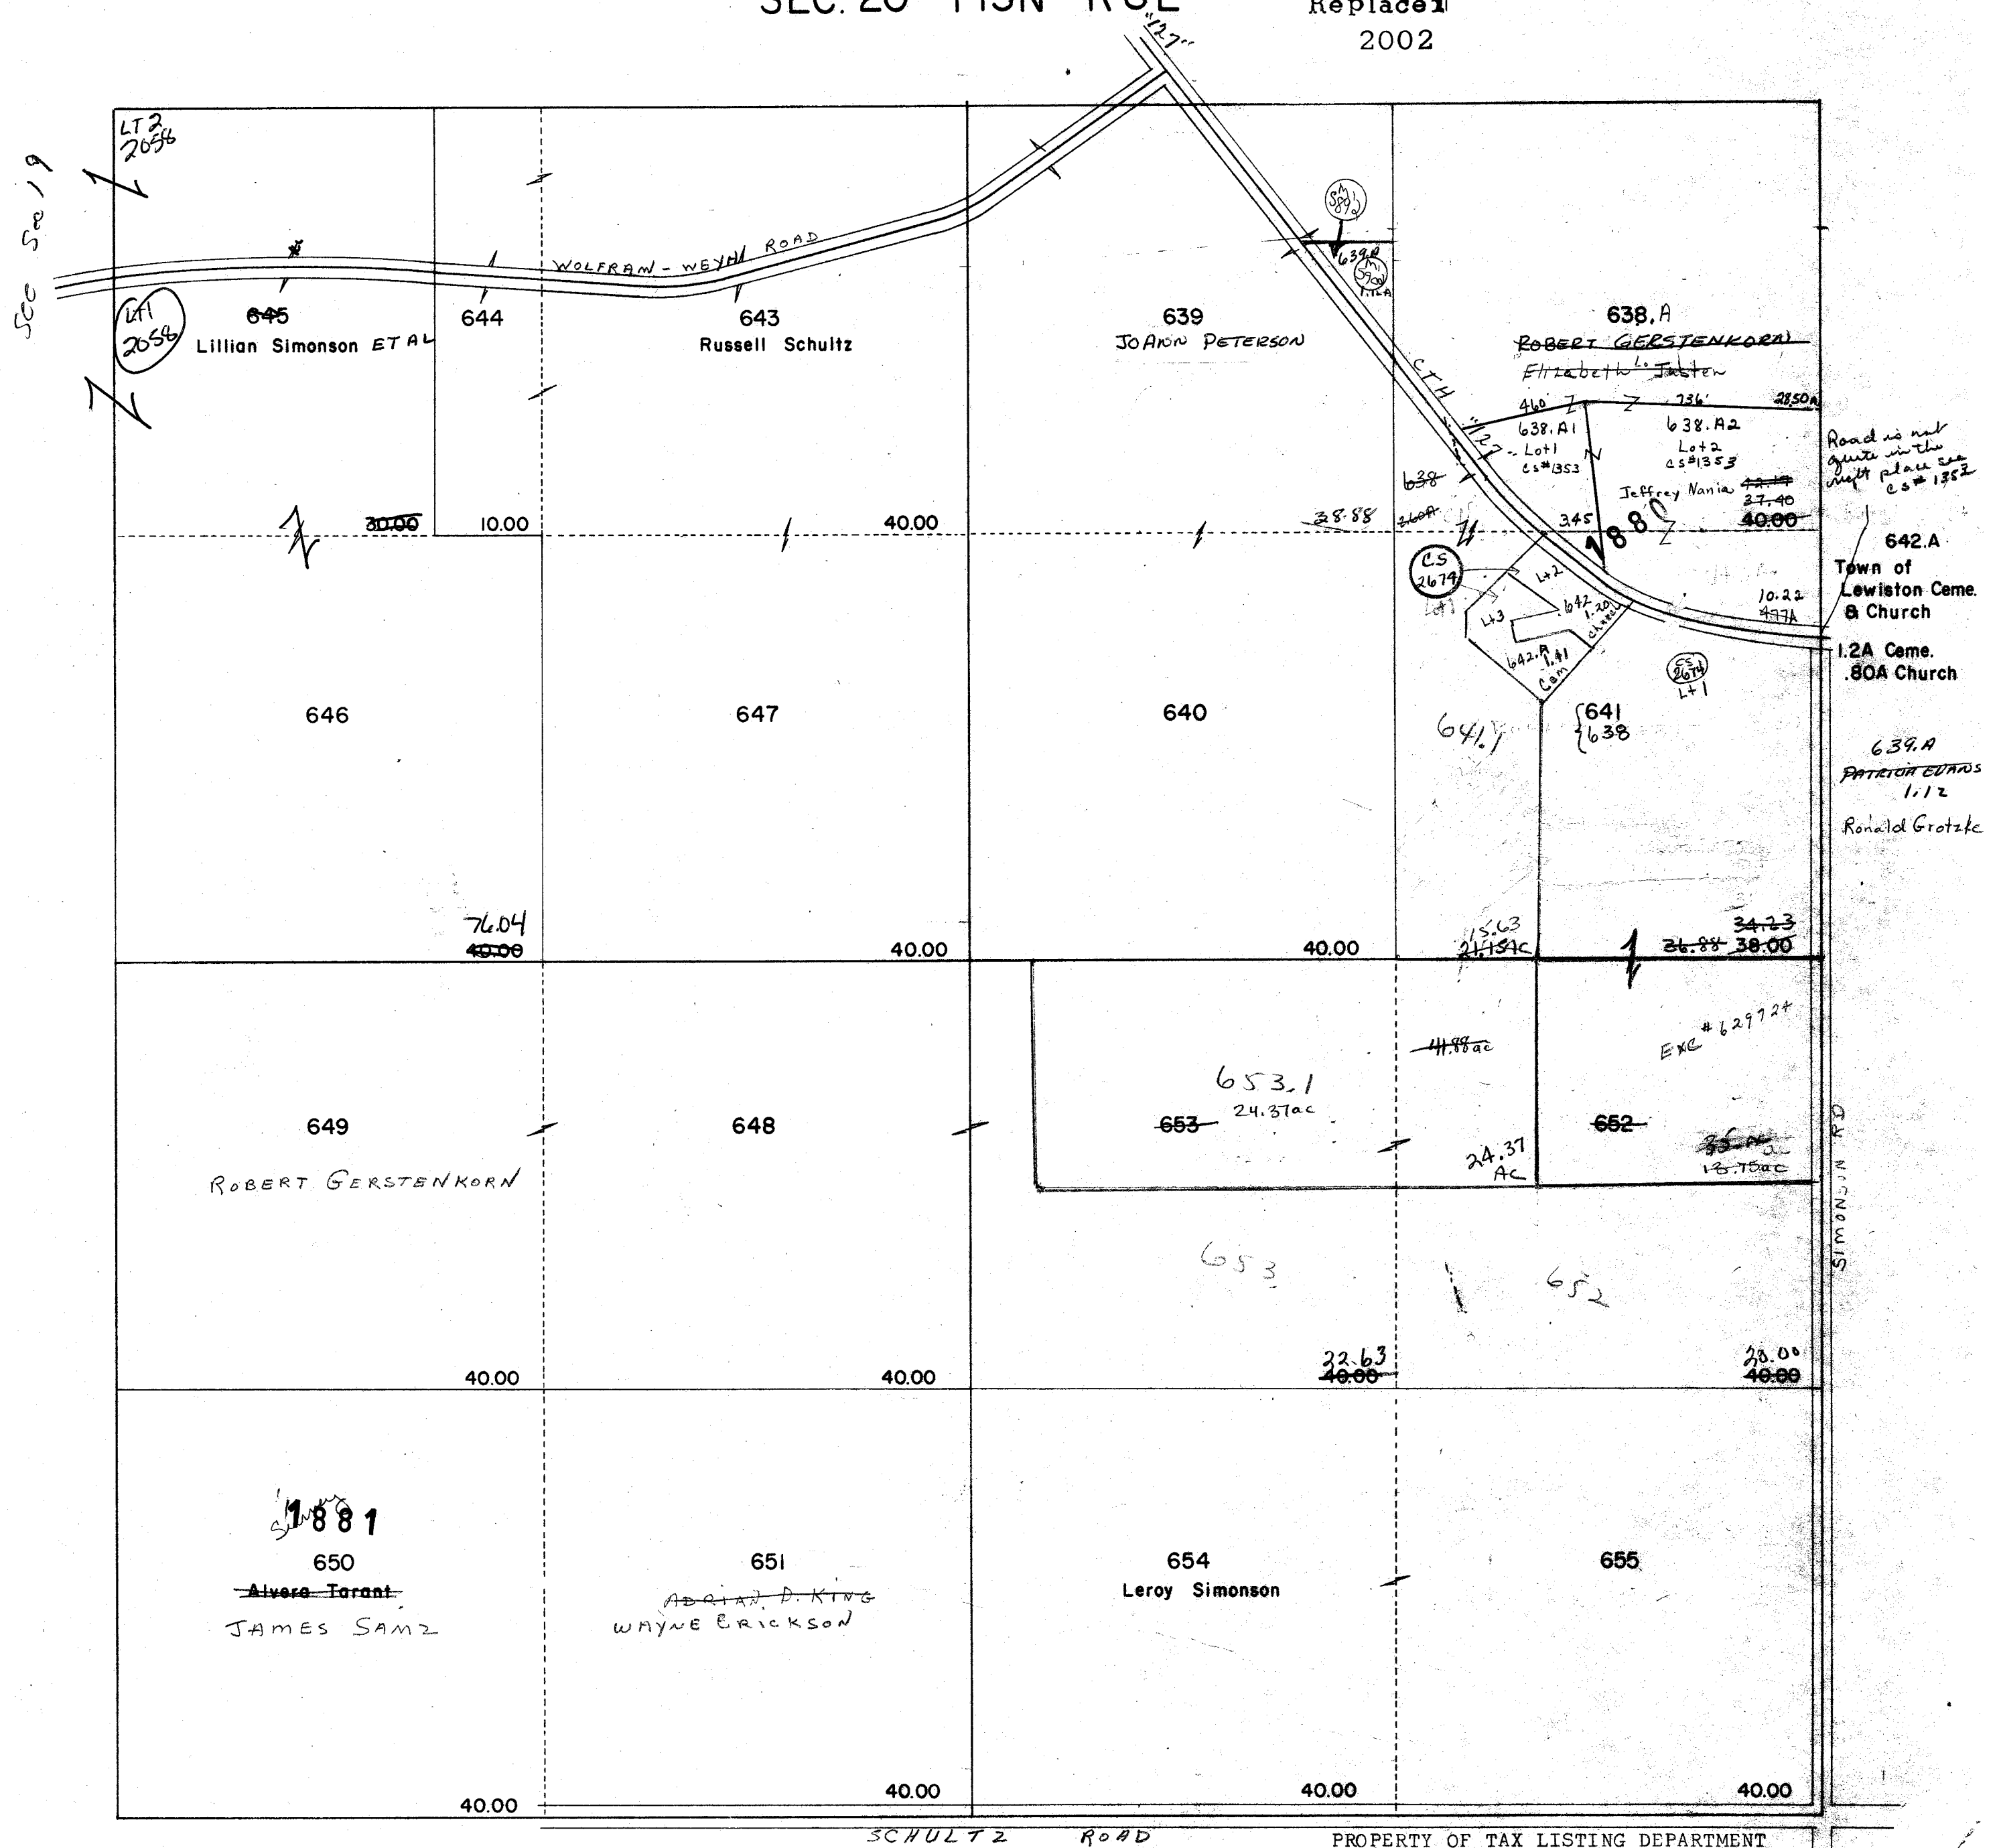

Replaced


2002

SECTION 21 T. 13 N R. 8 E

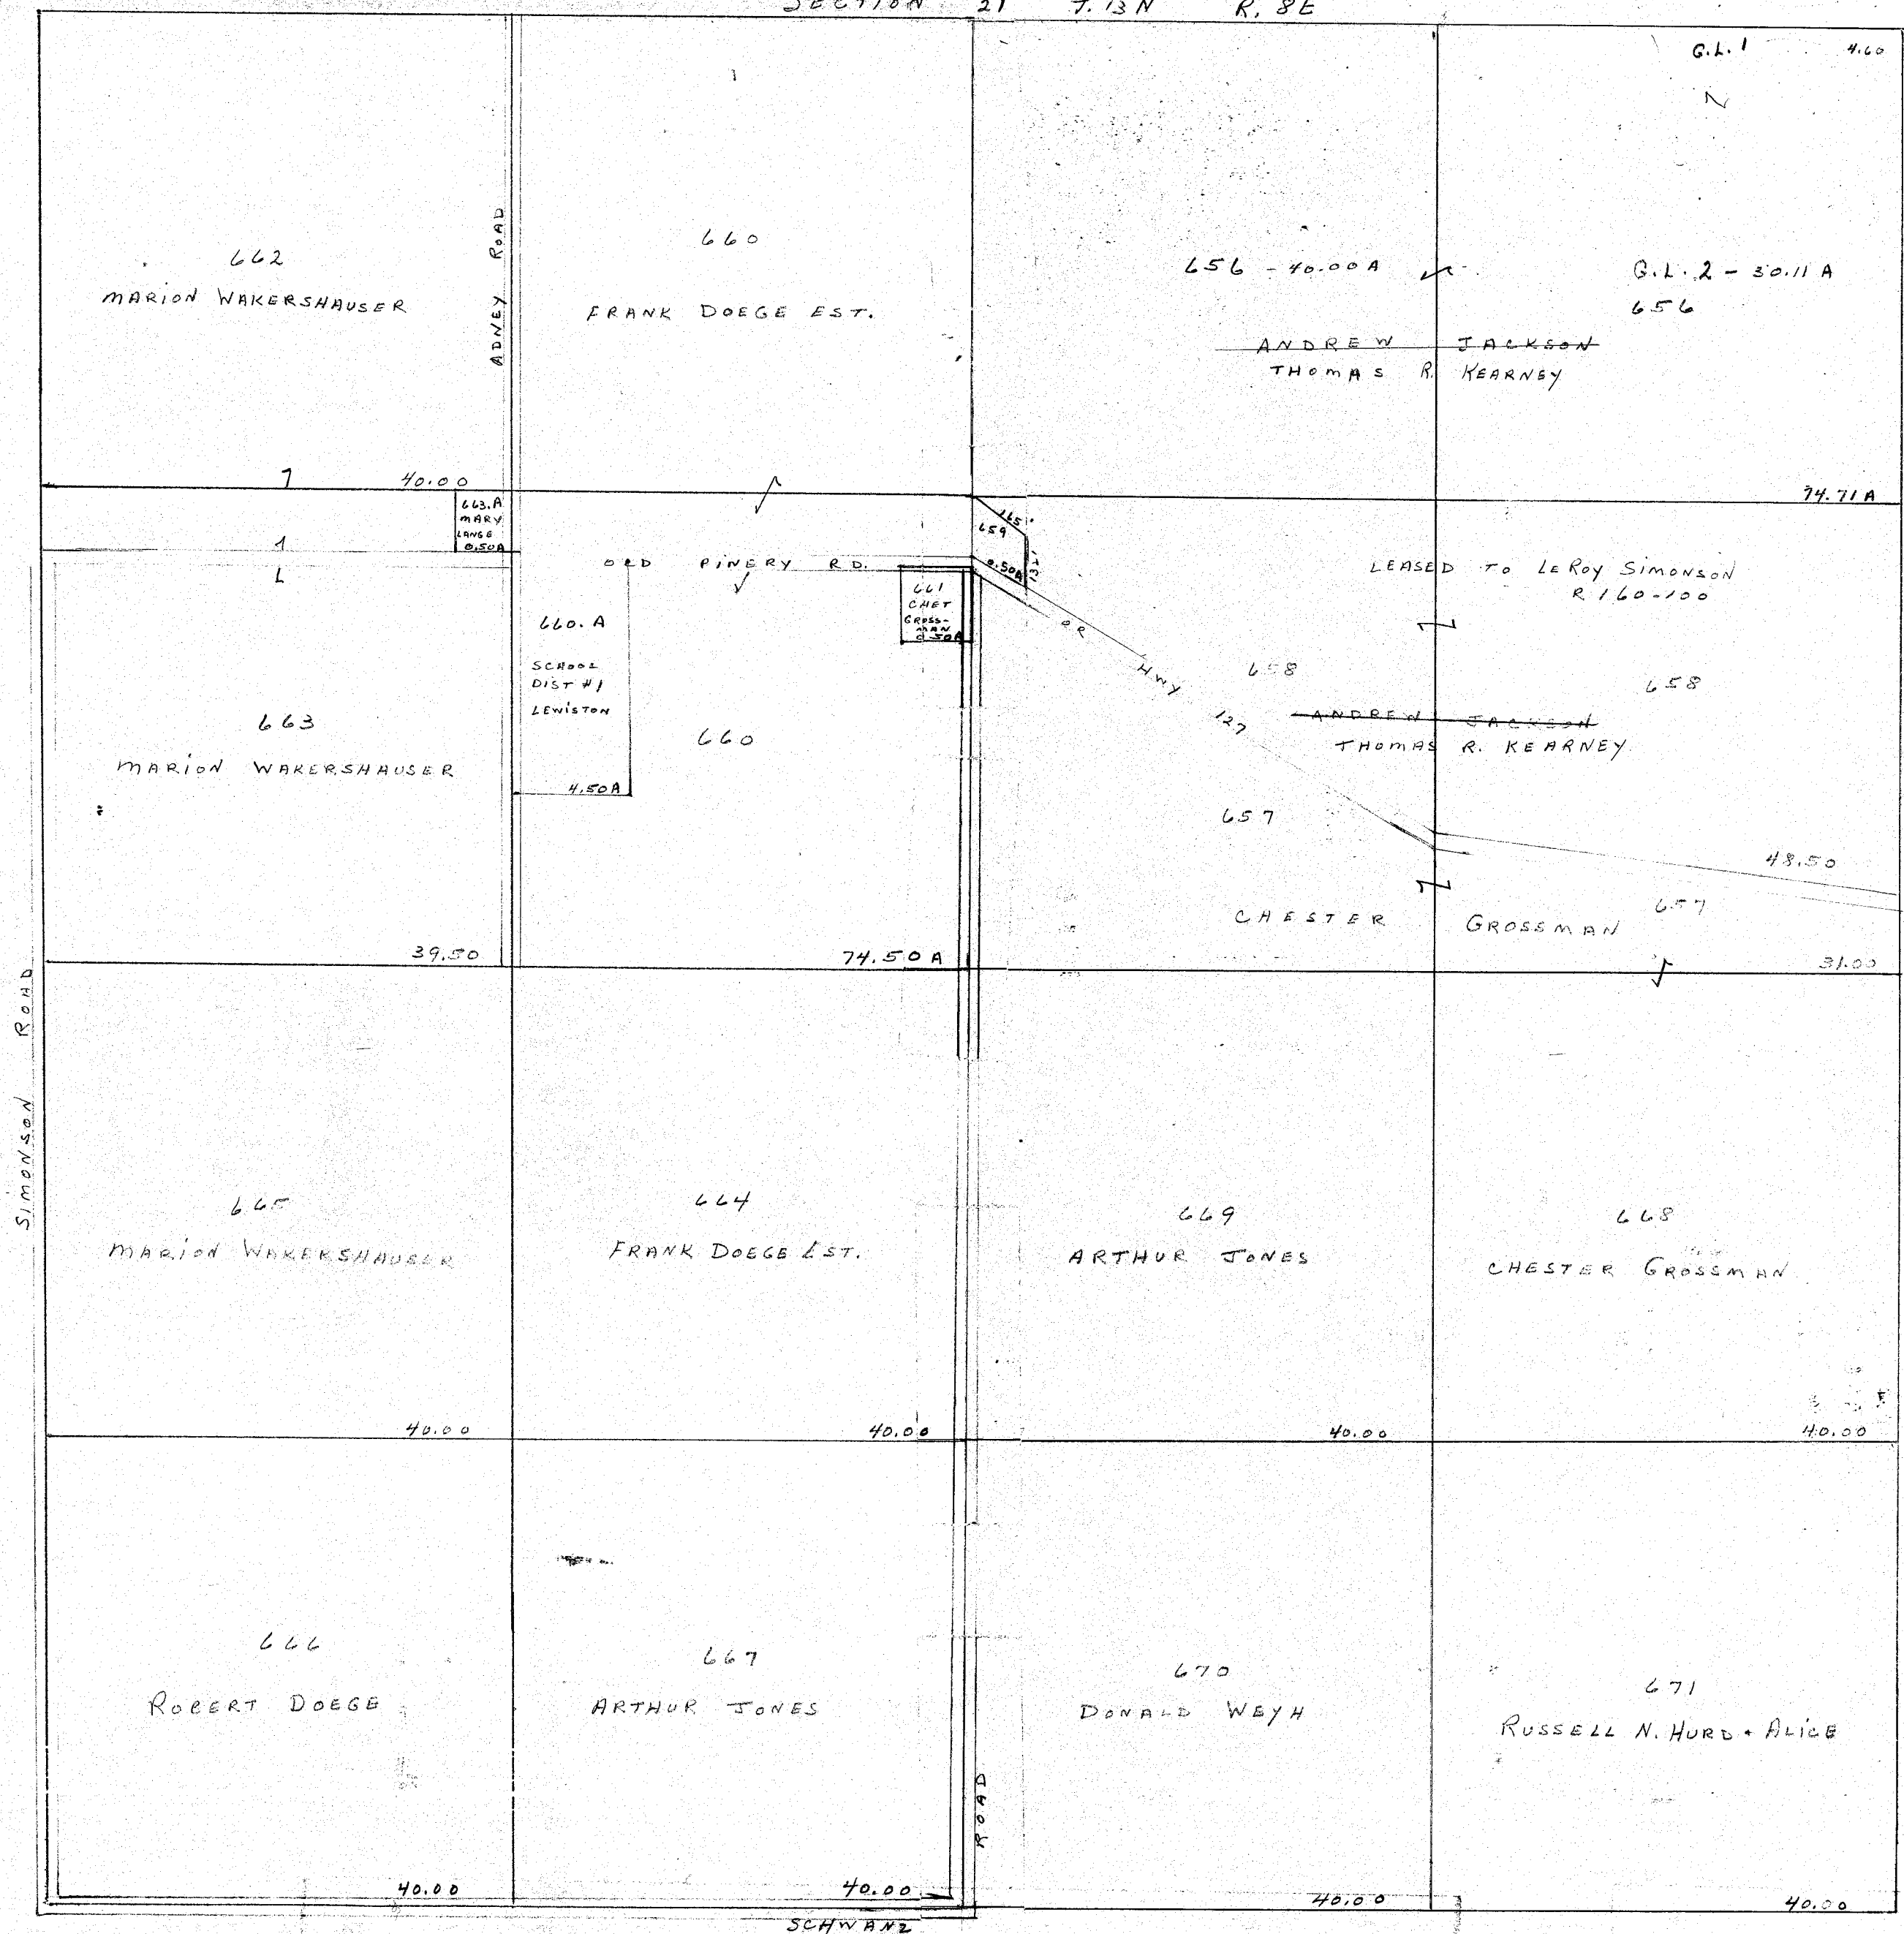

SEC. 21 T13N R8E

Replaced
2002

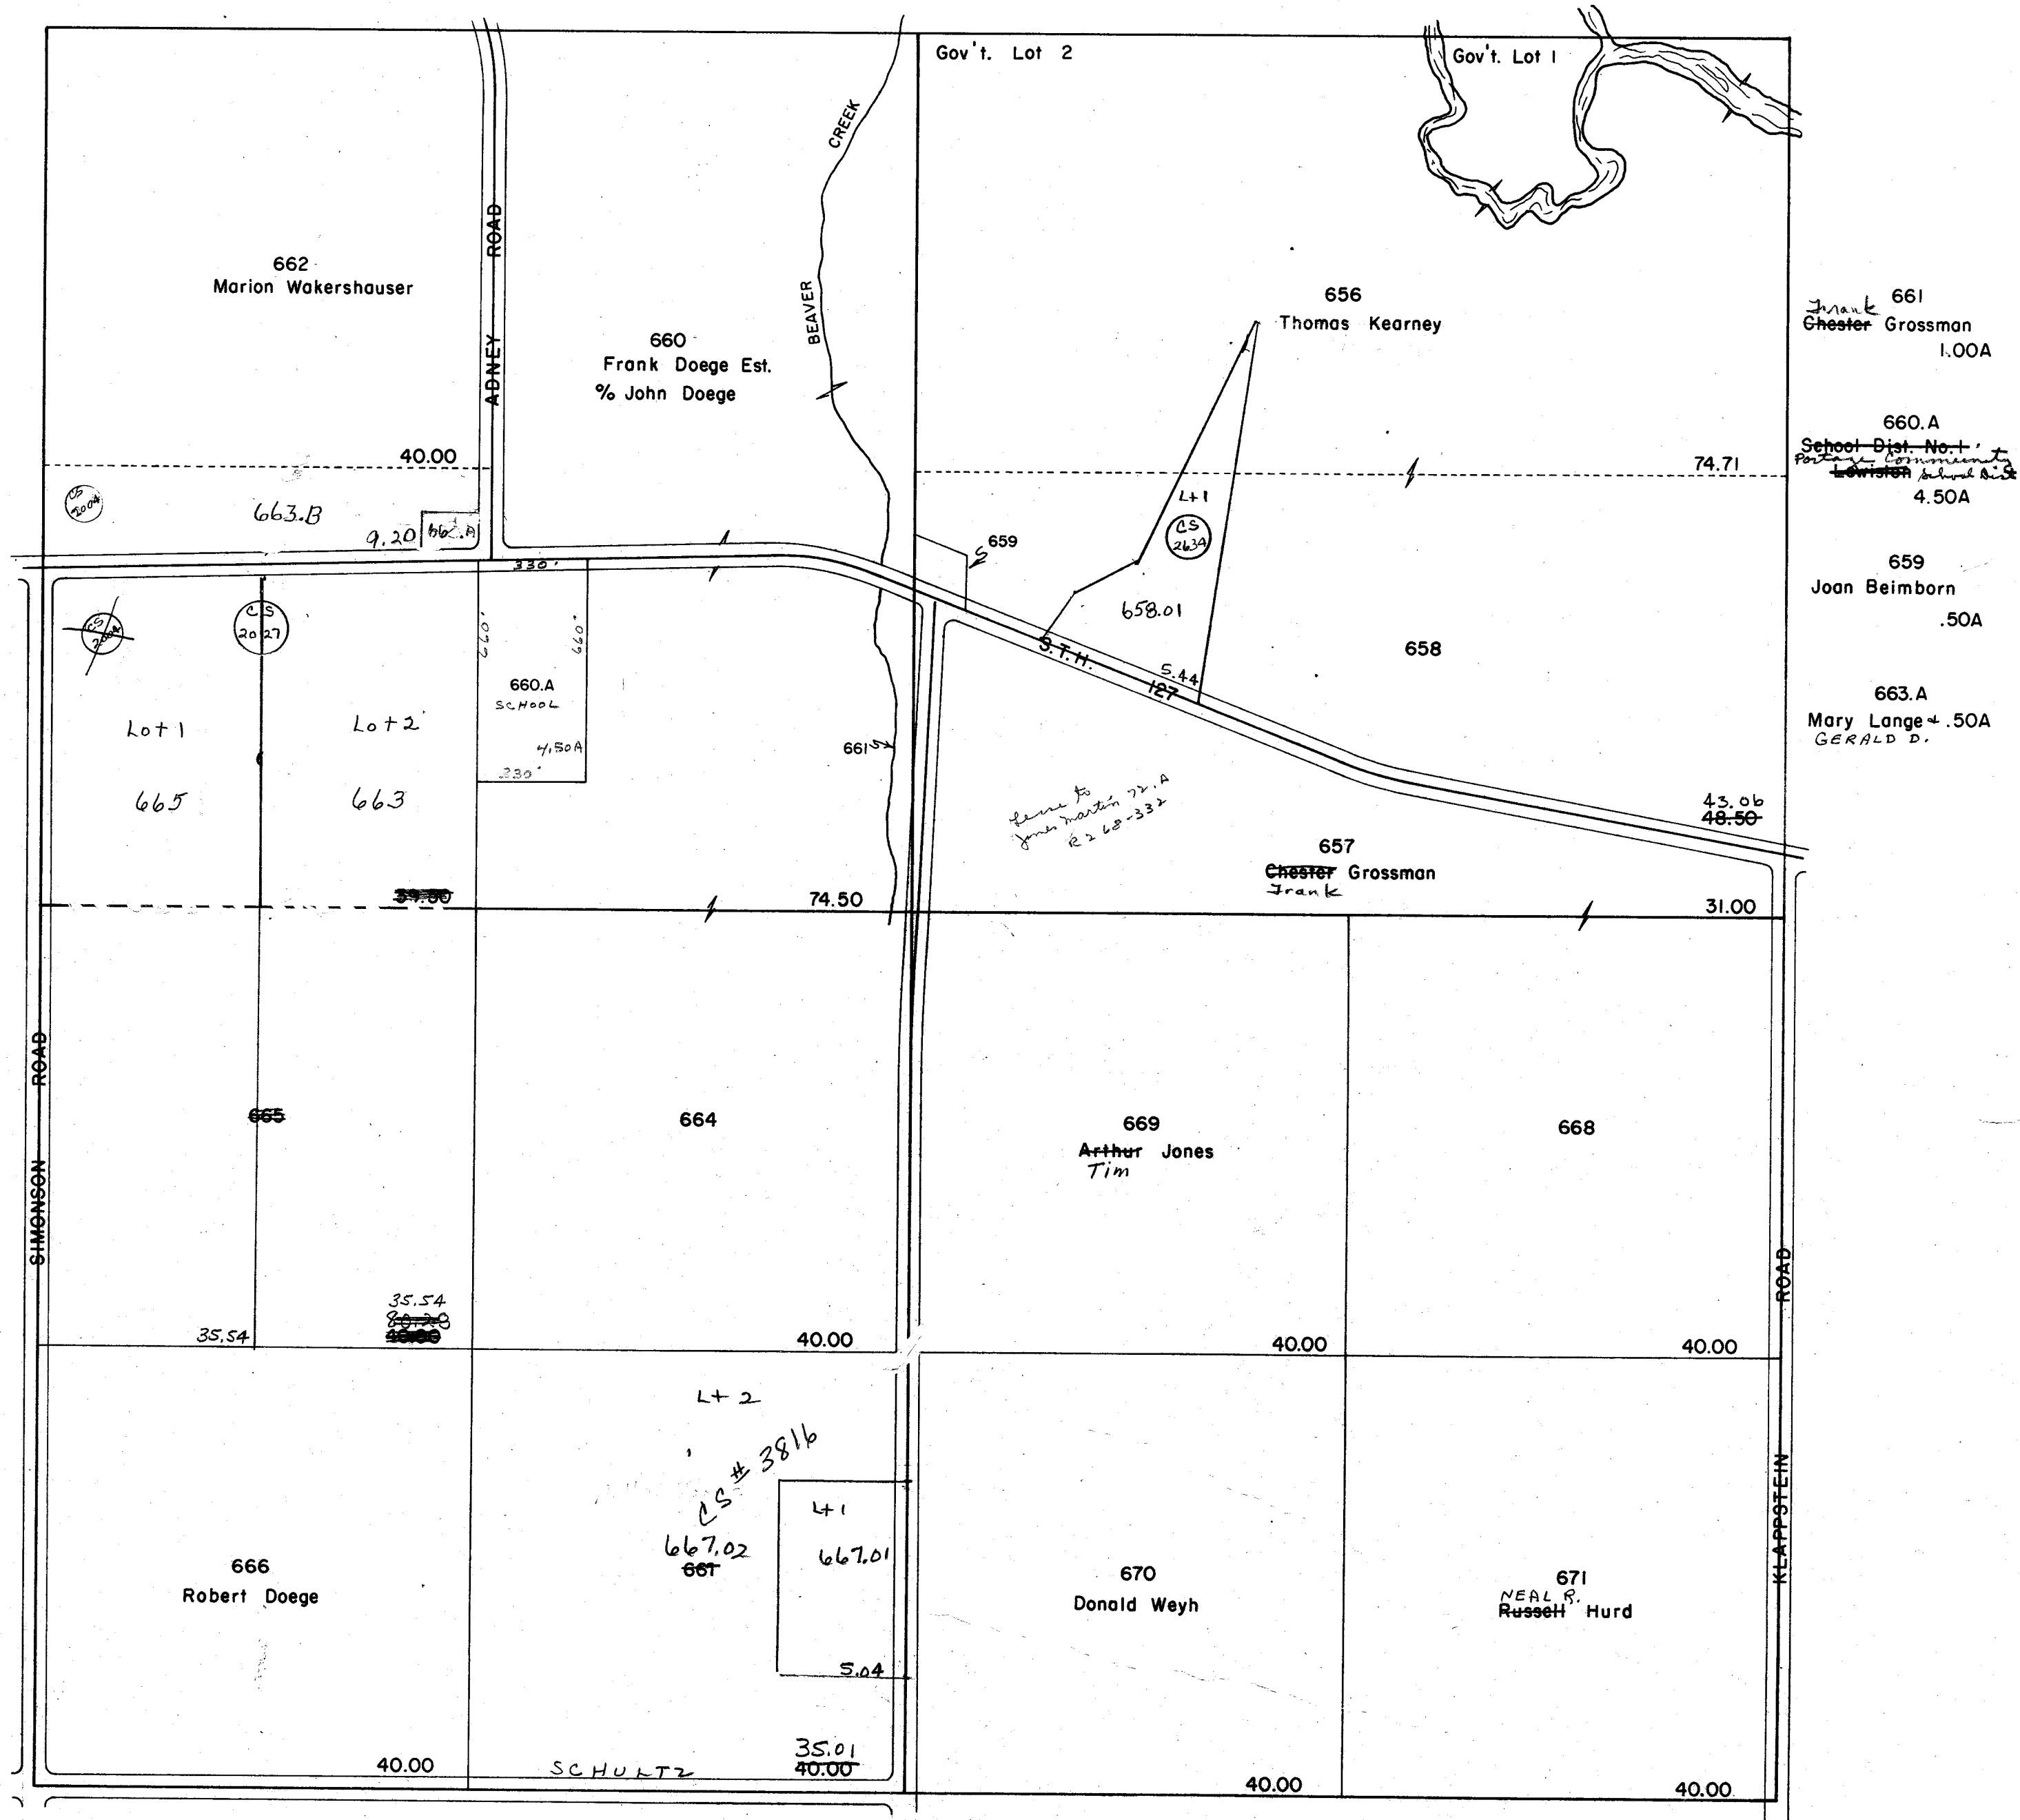

One Inch Equals Four Hundred Feet
MILES
0 1/16 1/8 1/4
FEET
0 400 800 1200 1600


NOTE: This map was prepared for assessment use in accordance with the Wis. St. Stat. Chap. 70.09. All information contained herein is advisory only. Map accuracy is limited to the quality of data obtained from other Public Records. This map is not intended to be a substitute for an actual field survey. Public Land Survey Base is derived from U.S.G.S. Topographic maps unless otherwise noted. Other sources of the land base may be actual survey data. Base map data is from the April 1995 County Digital Orthophotos and/or U.S.G.S. 1:24,000 scale Topographic series. The user is responsible for the improper use of the data contained herein.

Created by The Columbia County Land Information Office -GIS Section. VMB.
September 2002.

TAX PARCEL MAP

TOWN of LEWISTON

TOWN 13 NORTH RANGE 8 EAST
COLUMBIA COUNTY, WISCONSIN

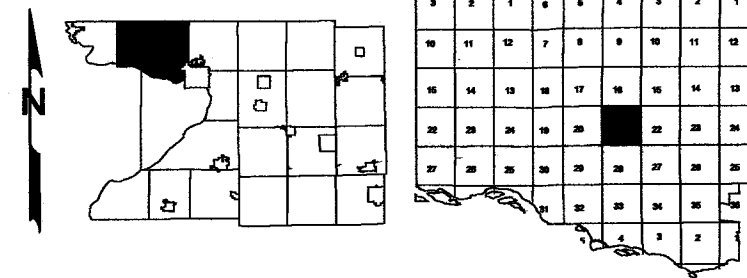

Replaced
2004

-SEE SECTION 16-



-SEE SECTION 28-

replaced 2004
-SECTION 21-


One Inch Equals Four Hundred Feet
MILES
0 1/16 1/8 1/4
FEET
0 400 800 1200 1600

NOTE: This map was prepared for assessment use in accordance with the Wis. St. Stat. Chap. 70.09. All information contained herein is advisory only. Map accuracy is limited to the quality of data obtained from other Public Records. This map is not intended to be a substitute for an actual field survey. Public Land Survey Base is derived from U.S.G.S. Topographic maps unless otherwise noted. Other sources of the Land Base may be actual survey data. Base map data is from the April 1995 County Digital Orthophotos and/or U.S.G.S. 1:24,000 scale Topographic series. The user is responsible for the improper use of the data contained herein.

Created by The Columbia County Land Information Office -GIS Section. VMB.
March 2004.


TAX PARCEL MAP
TOWN of LEWISTON

TOWN 13 NORTH RANGE 8 EAST
COLUMBIA COUNTY, WISCONSIN

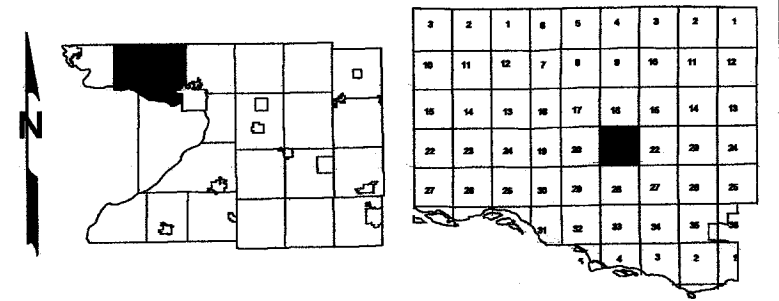

Replaced
2005

-SEE SECTION 16-

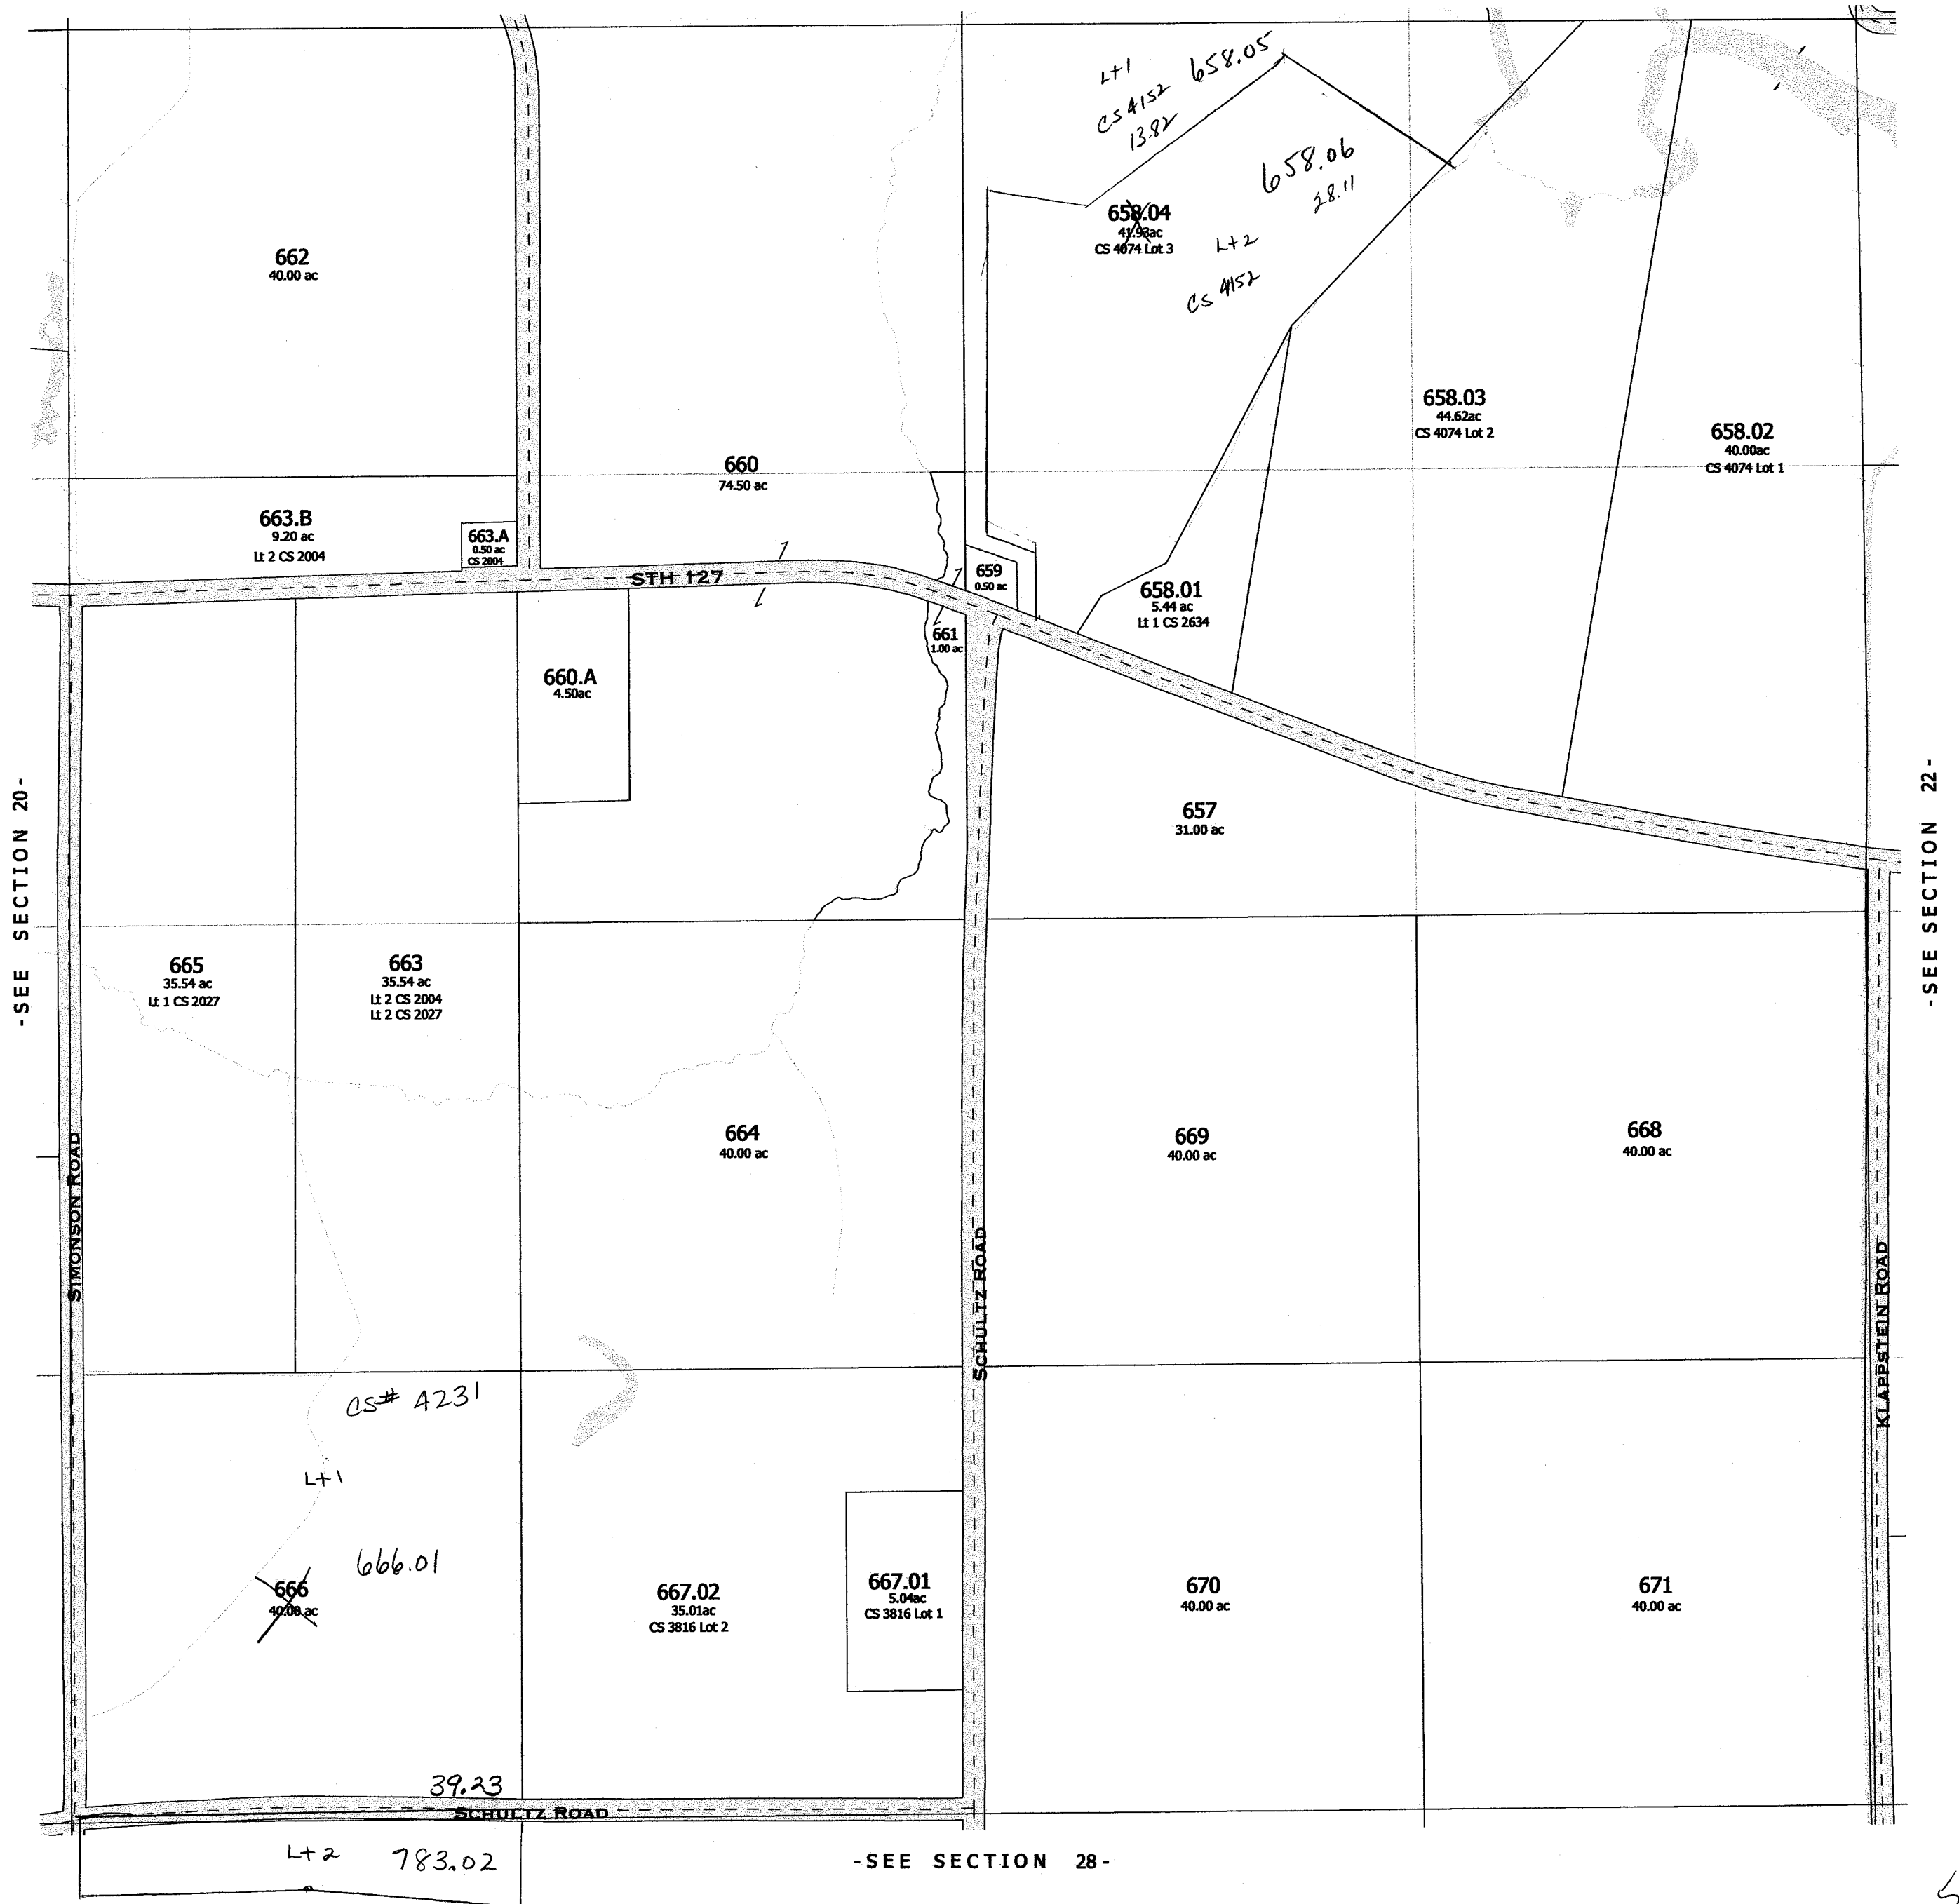

-SEE SECTION 28-

-SEE SECTION 22-

2005
-SECTION 21-

One Inch Equals Four Hundred Feet

MILES
0 1/16 1/8 1/4
FEET
0 400 800 1200 1600


NOTE: This map was prepared for assessment use in accordance with the Wis. St. Stat. Chap. 70.05. All information contained herein is advisory only. Map accuracy is limited to the quality of data obtained from other Public Records. This map is not intended to be a substitute for an actual field survey. Public Land Survey Base is derived from U.S.G.S Topographic maps unless otherwise noted. Other sources of the Land Base may be actual survey data. Base map data is from the April 1995 County Digital Orthophotos and/or U.S.G.S. 1:24,000 scale Topographic series. The user is responsible for the improper use of the data contained herein.

Created by The Columbia County Land Information Office -GIS Section. VMB.
February 2005.


TAX PARCEL MAP

TOWN of LEWISTON

TOWN 13 NORTH RANGE 8 EAST
COLUMBIA COUNTY, WISCONSIN

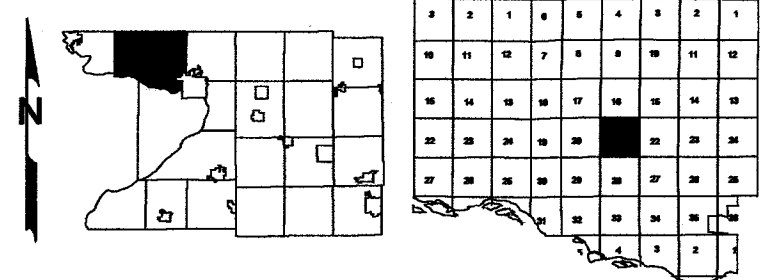


Replaced
2006

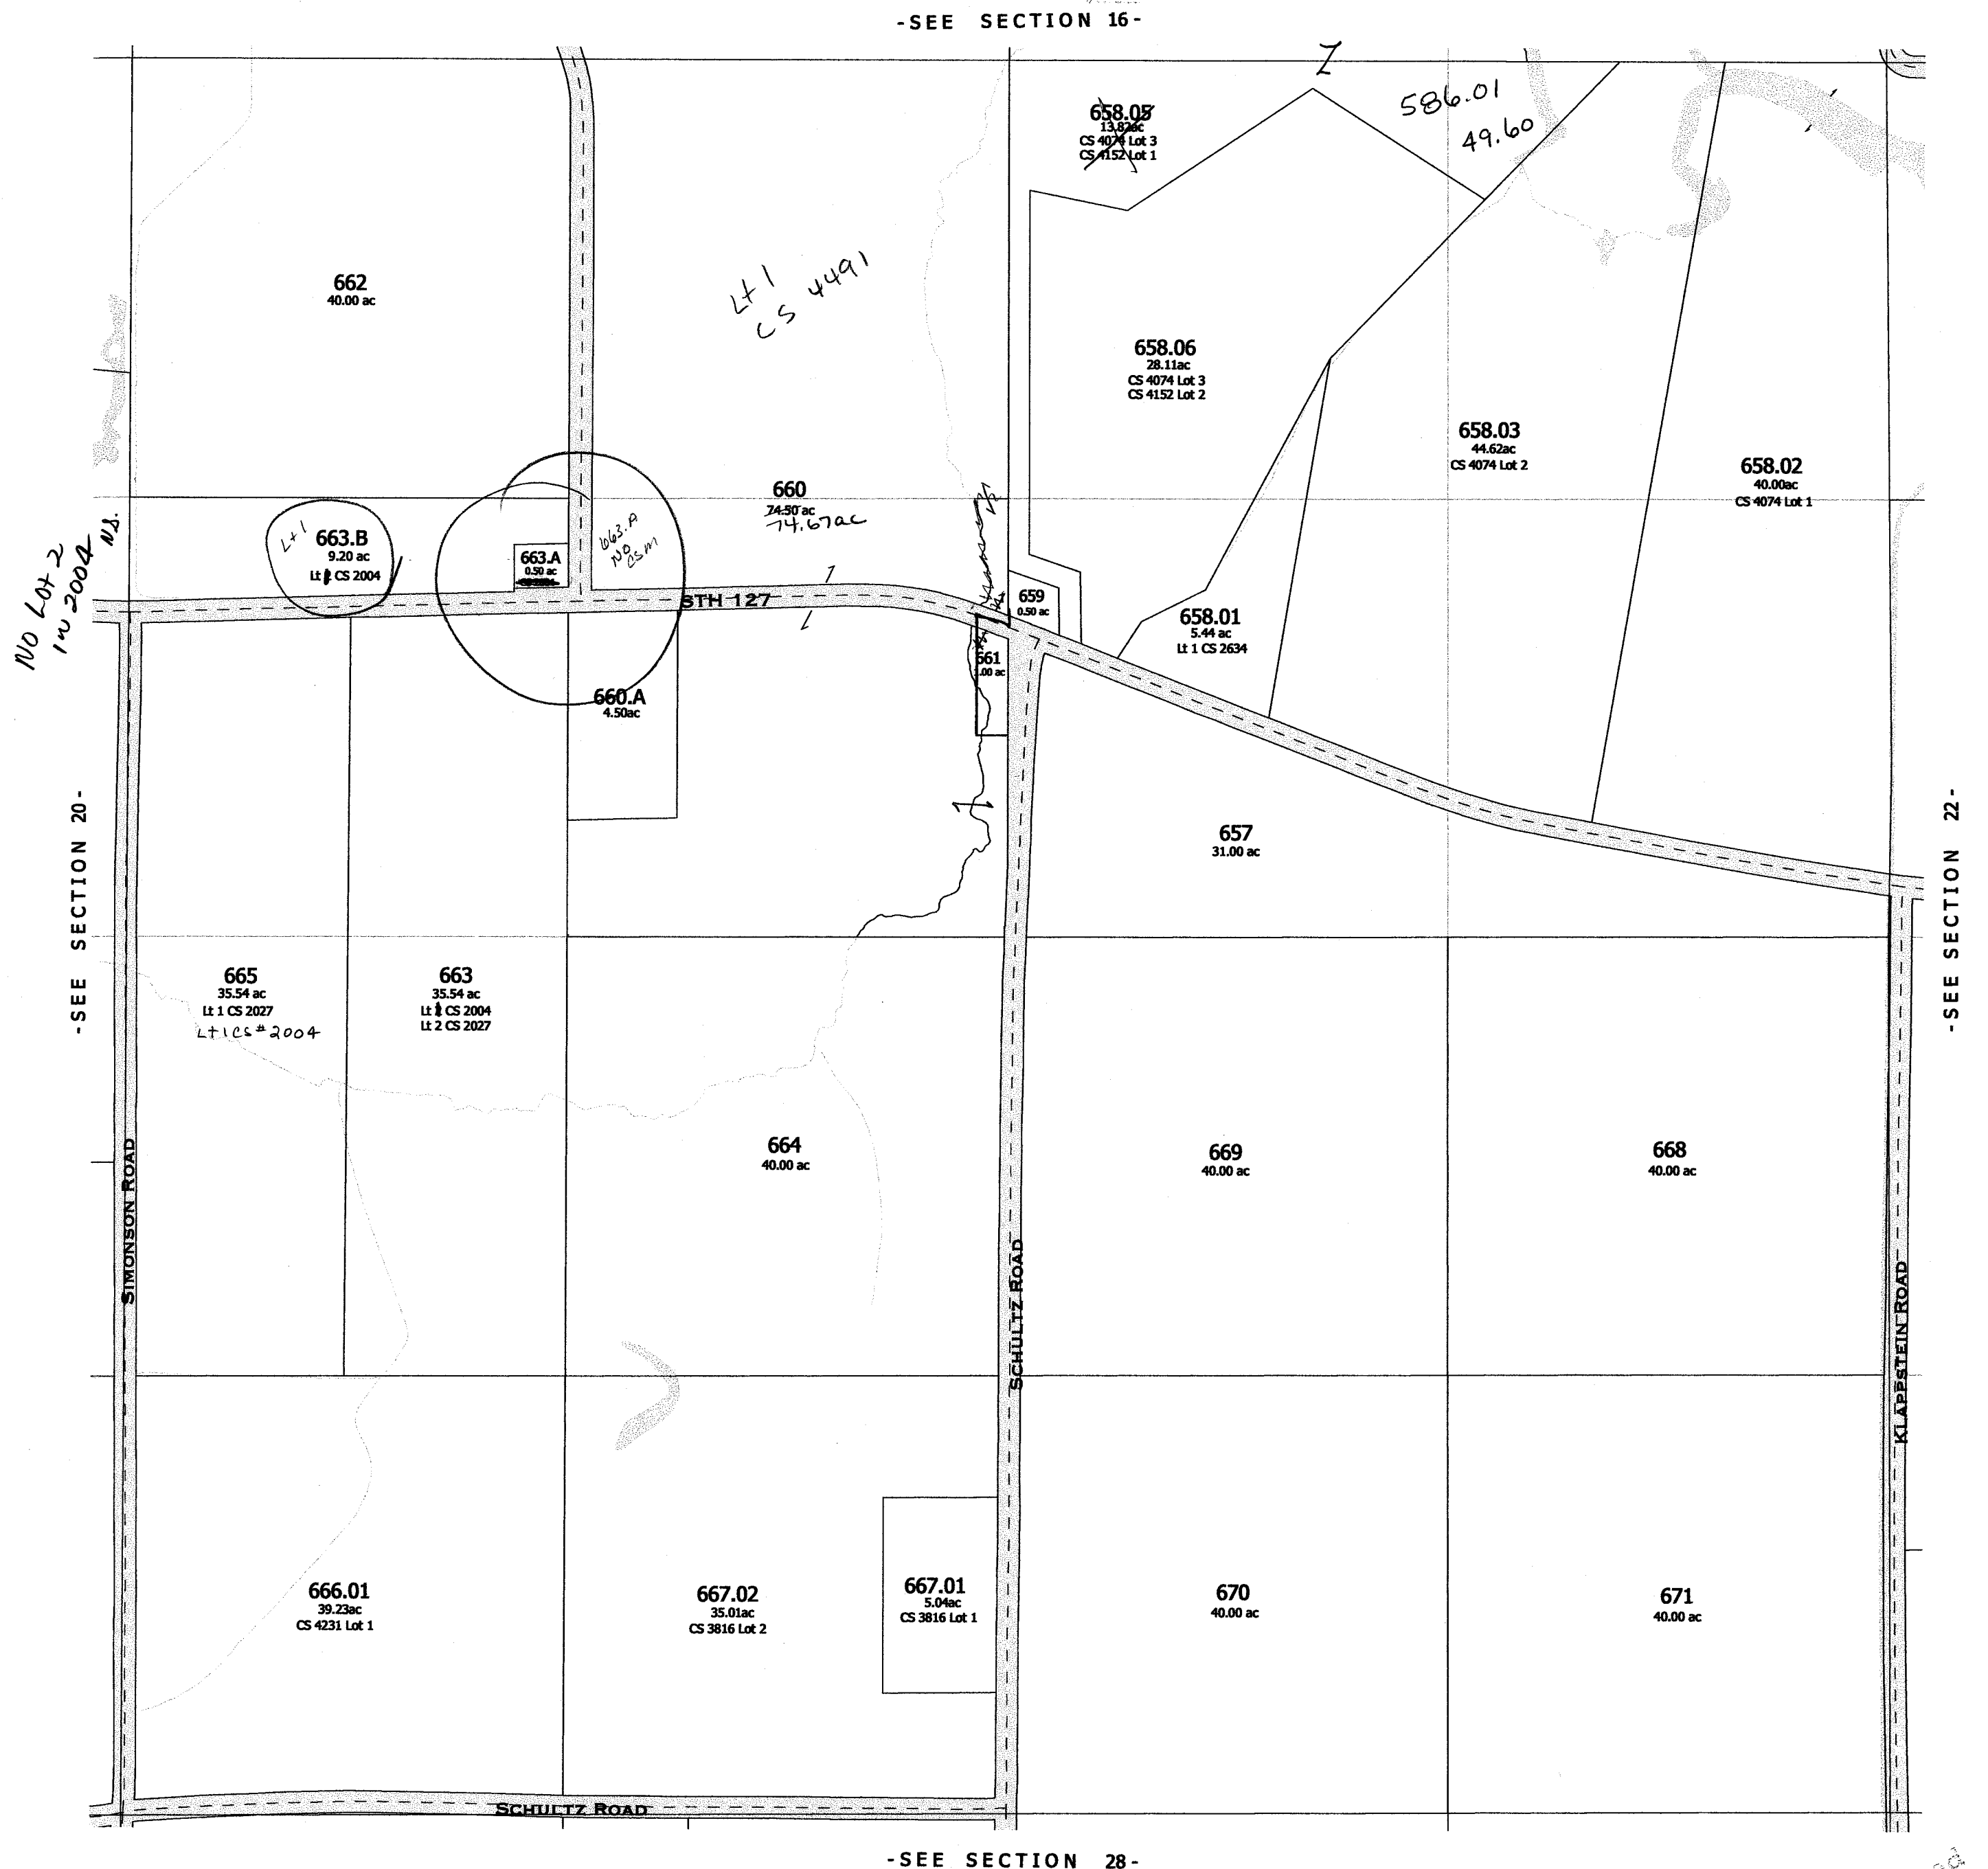


Replaced
2006

-SECTION 21-

Replaced
2002

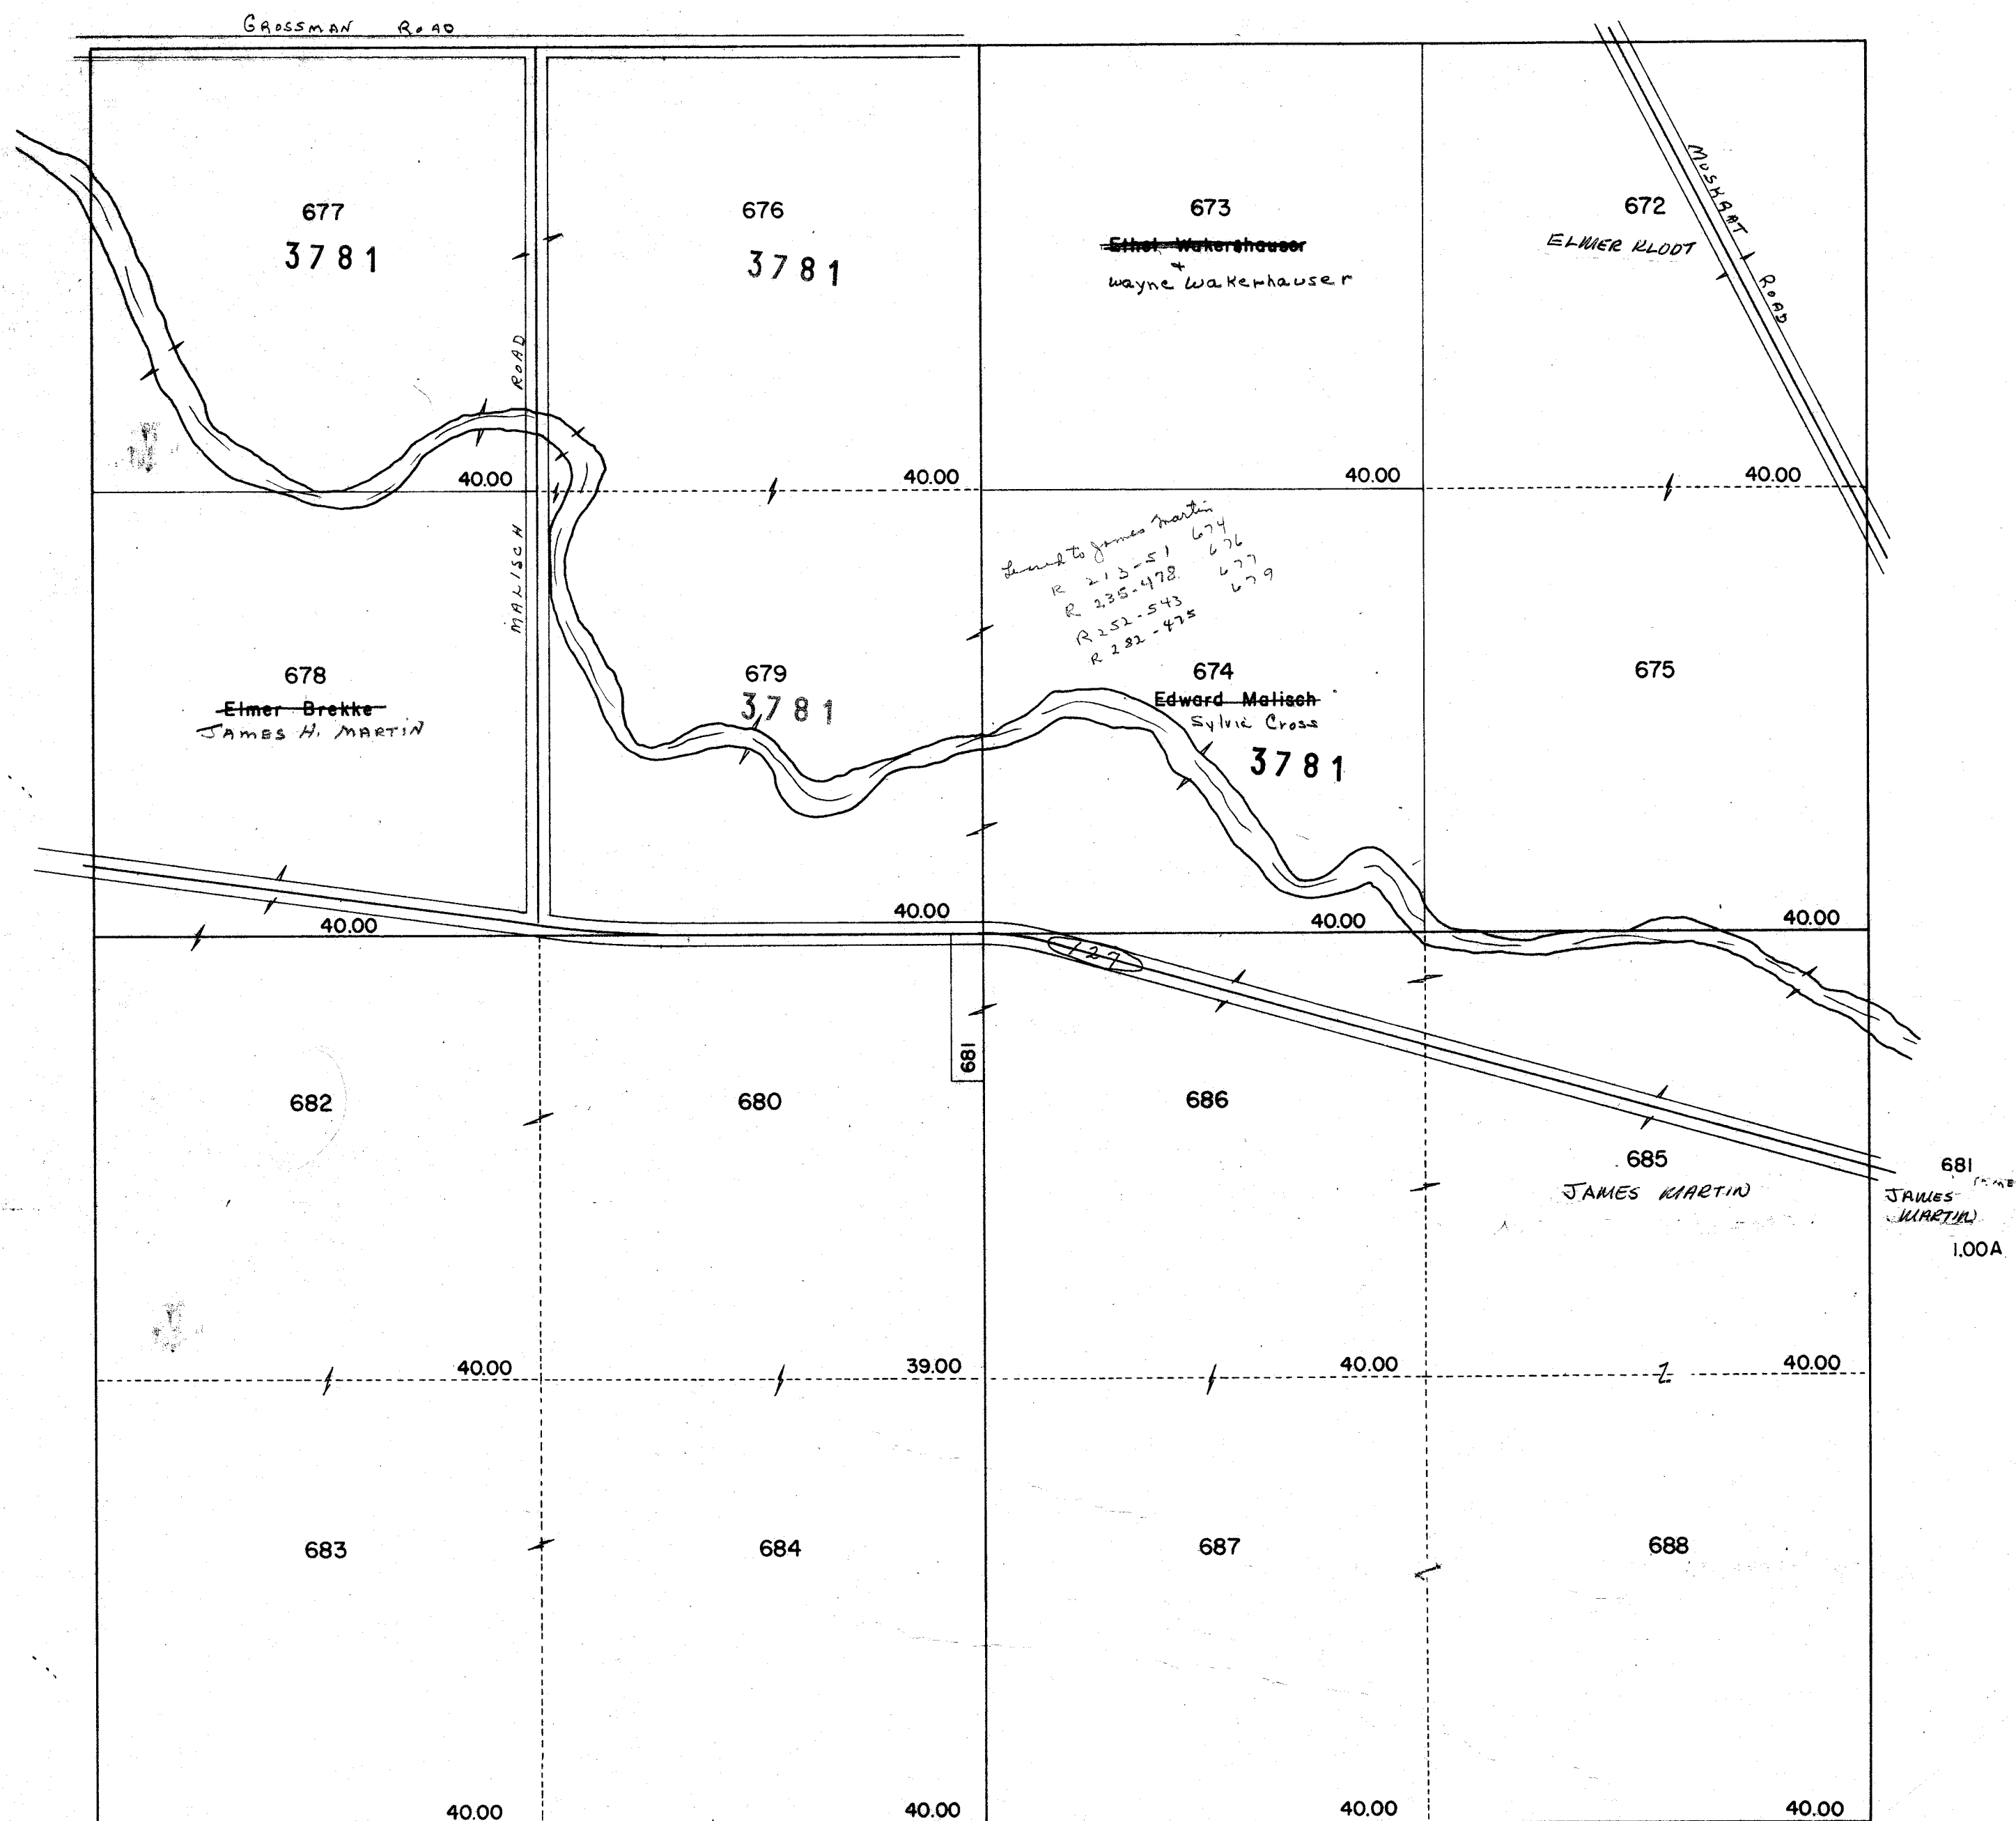

PROPERTY OF TAX LISTING DEPARTMENT

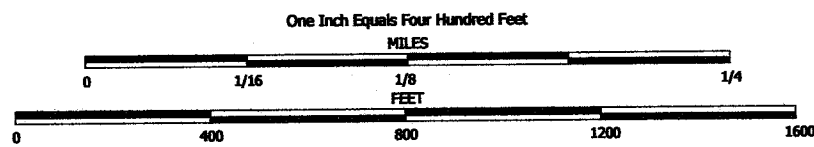


NOTE: This map was prepared for assessment use in accordance with the Wis. St. Stat. Chap. 70.09. All information contained herein is advisory only. Map accuracy is limited to the quality of data obtained from other Public Records. This map is not intended to be a substitute for an actual field survey. Public Land Survey Base is derived from U.S.G.S. Topographic maps unless otherwise noted. Other sources of the Land Base may be actual survey data. Base map data is from the April 1995 County Digital Orthophotos and/or U.S.G.S. 1:25,000 scale Topographic series. The user is responsible for the improper use of the data contained herein.

Created by The Columbia County Land Information Office -GIS Section. VMB.
September 2002.

TAX PARCEL MAP


TOWN of LEWISTON

TOWN 13 NORTH RANGE 8 EAST
COLUMBIA COUNTY, WISCONSIN

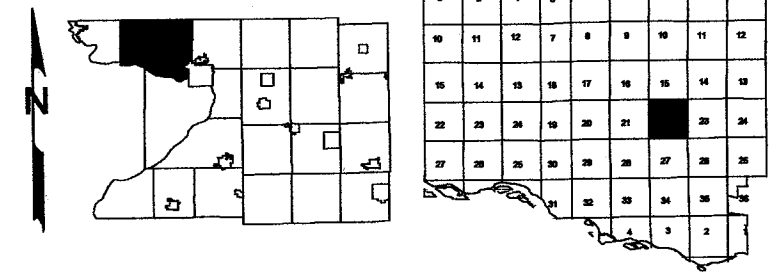


Replaced
2004

-SEE SECTION 15-

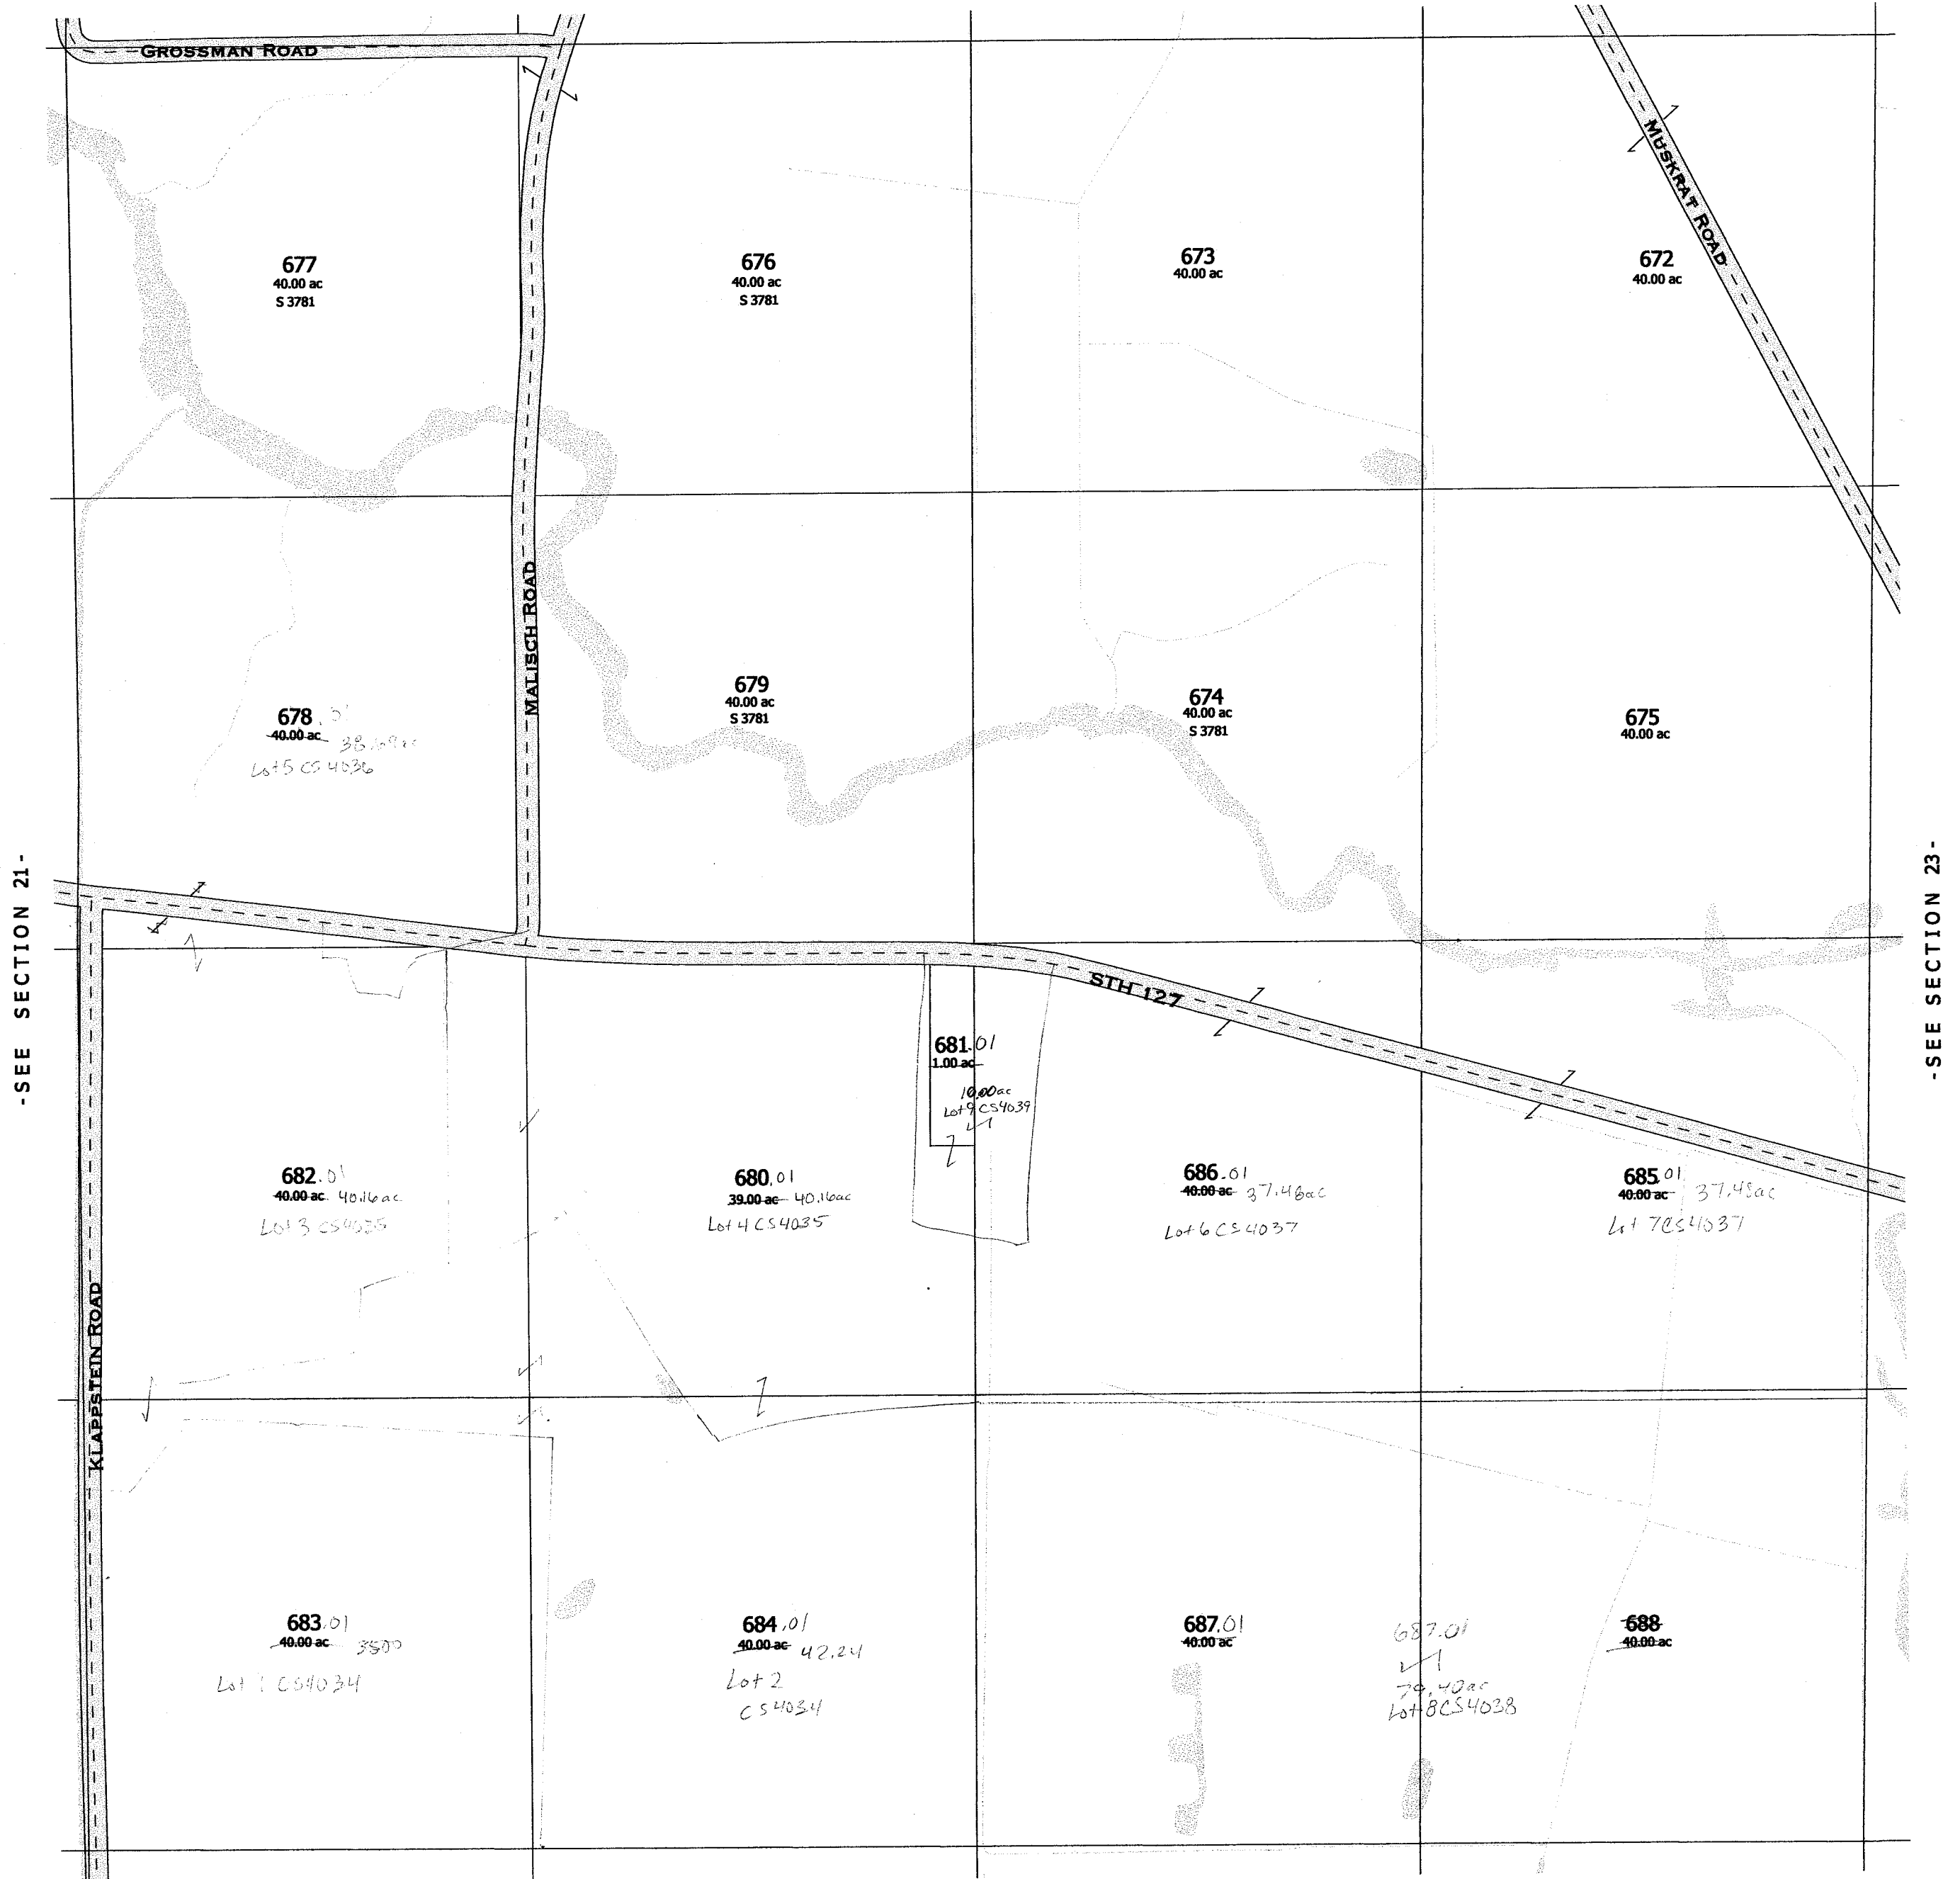

-SEE SECTION 27-

replaced 2004
-SECTION 22-

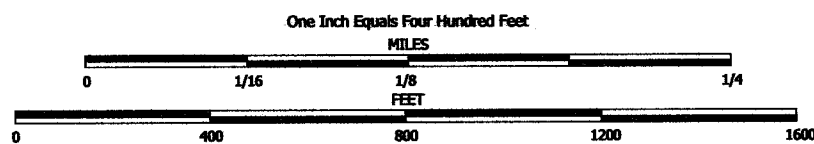



NOTE: This map was prepared for assessment use in accordance with the Wis. St. Stat. Chap. 70.09. All information contained herein is advisory only. Map accuracy is limited to the quality of data obtained from other Public Records. This map is not intended to be a substitute for an actual field survey. Public Land Survey Base is derived from U.S.G.S. Topographic maps unless otherwise noted. Other sources of the Land Base may be actual survey data. Base map data is from the April 1995 County Digital Orthophotos and/or U.S.G.S. 1:24,000 scale Topographic series. The user is responsible for the improper use of the data contained herein.

Created by The Columbia County Land Information Office -GIS Section. VMB.
March 2004.

TAX PARCEL MAP


TOWN of LEWISTON

TOWN 13 NORTH RANGE 8 EAST
COLUMBIA COUNTY, WISCONSIN

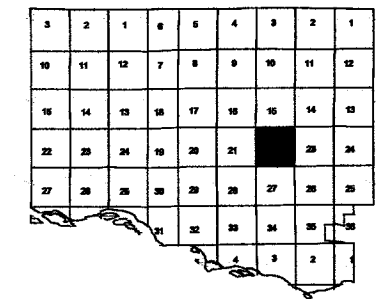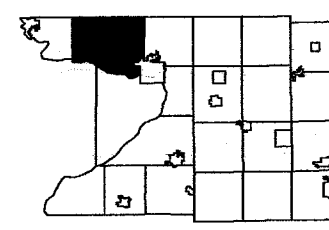

Replaced
2005

-SEE SECTION 15-

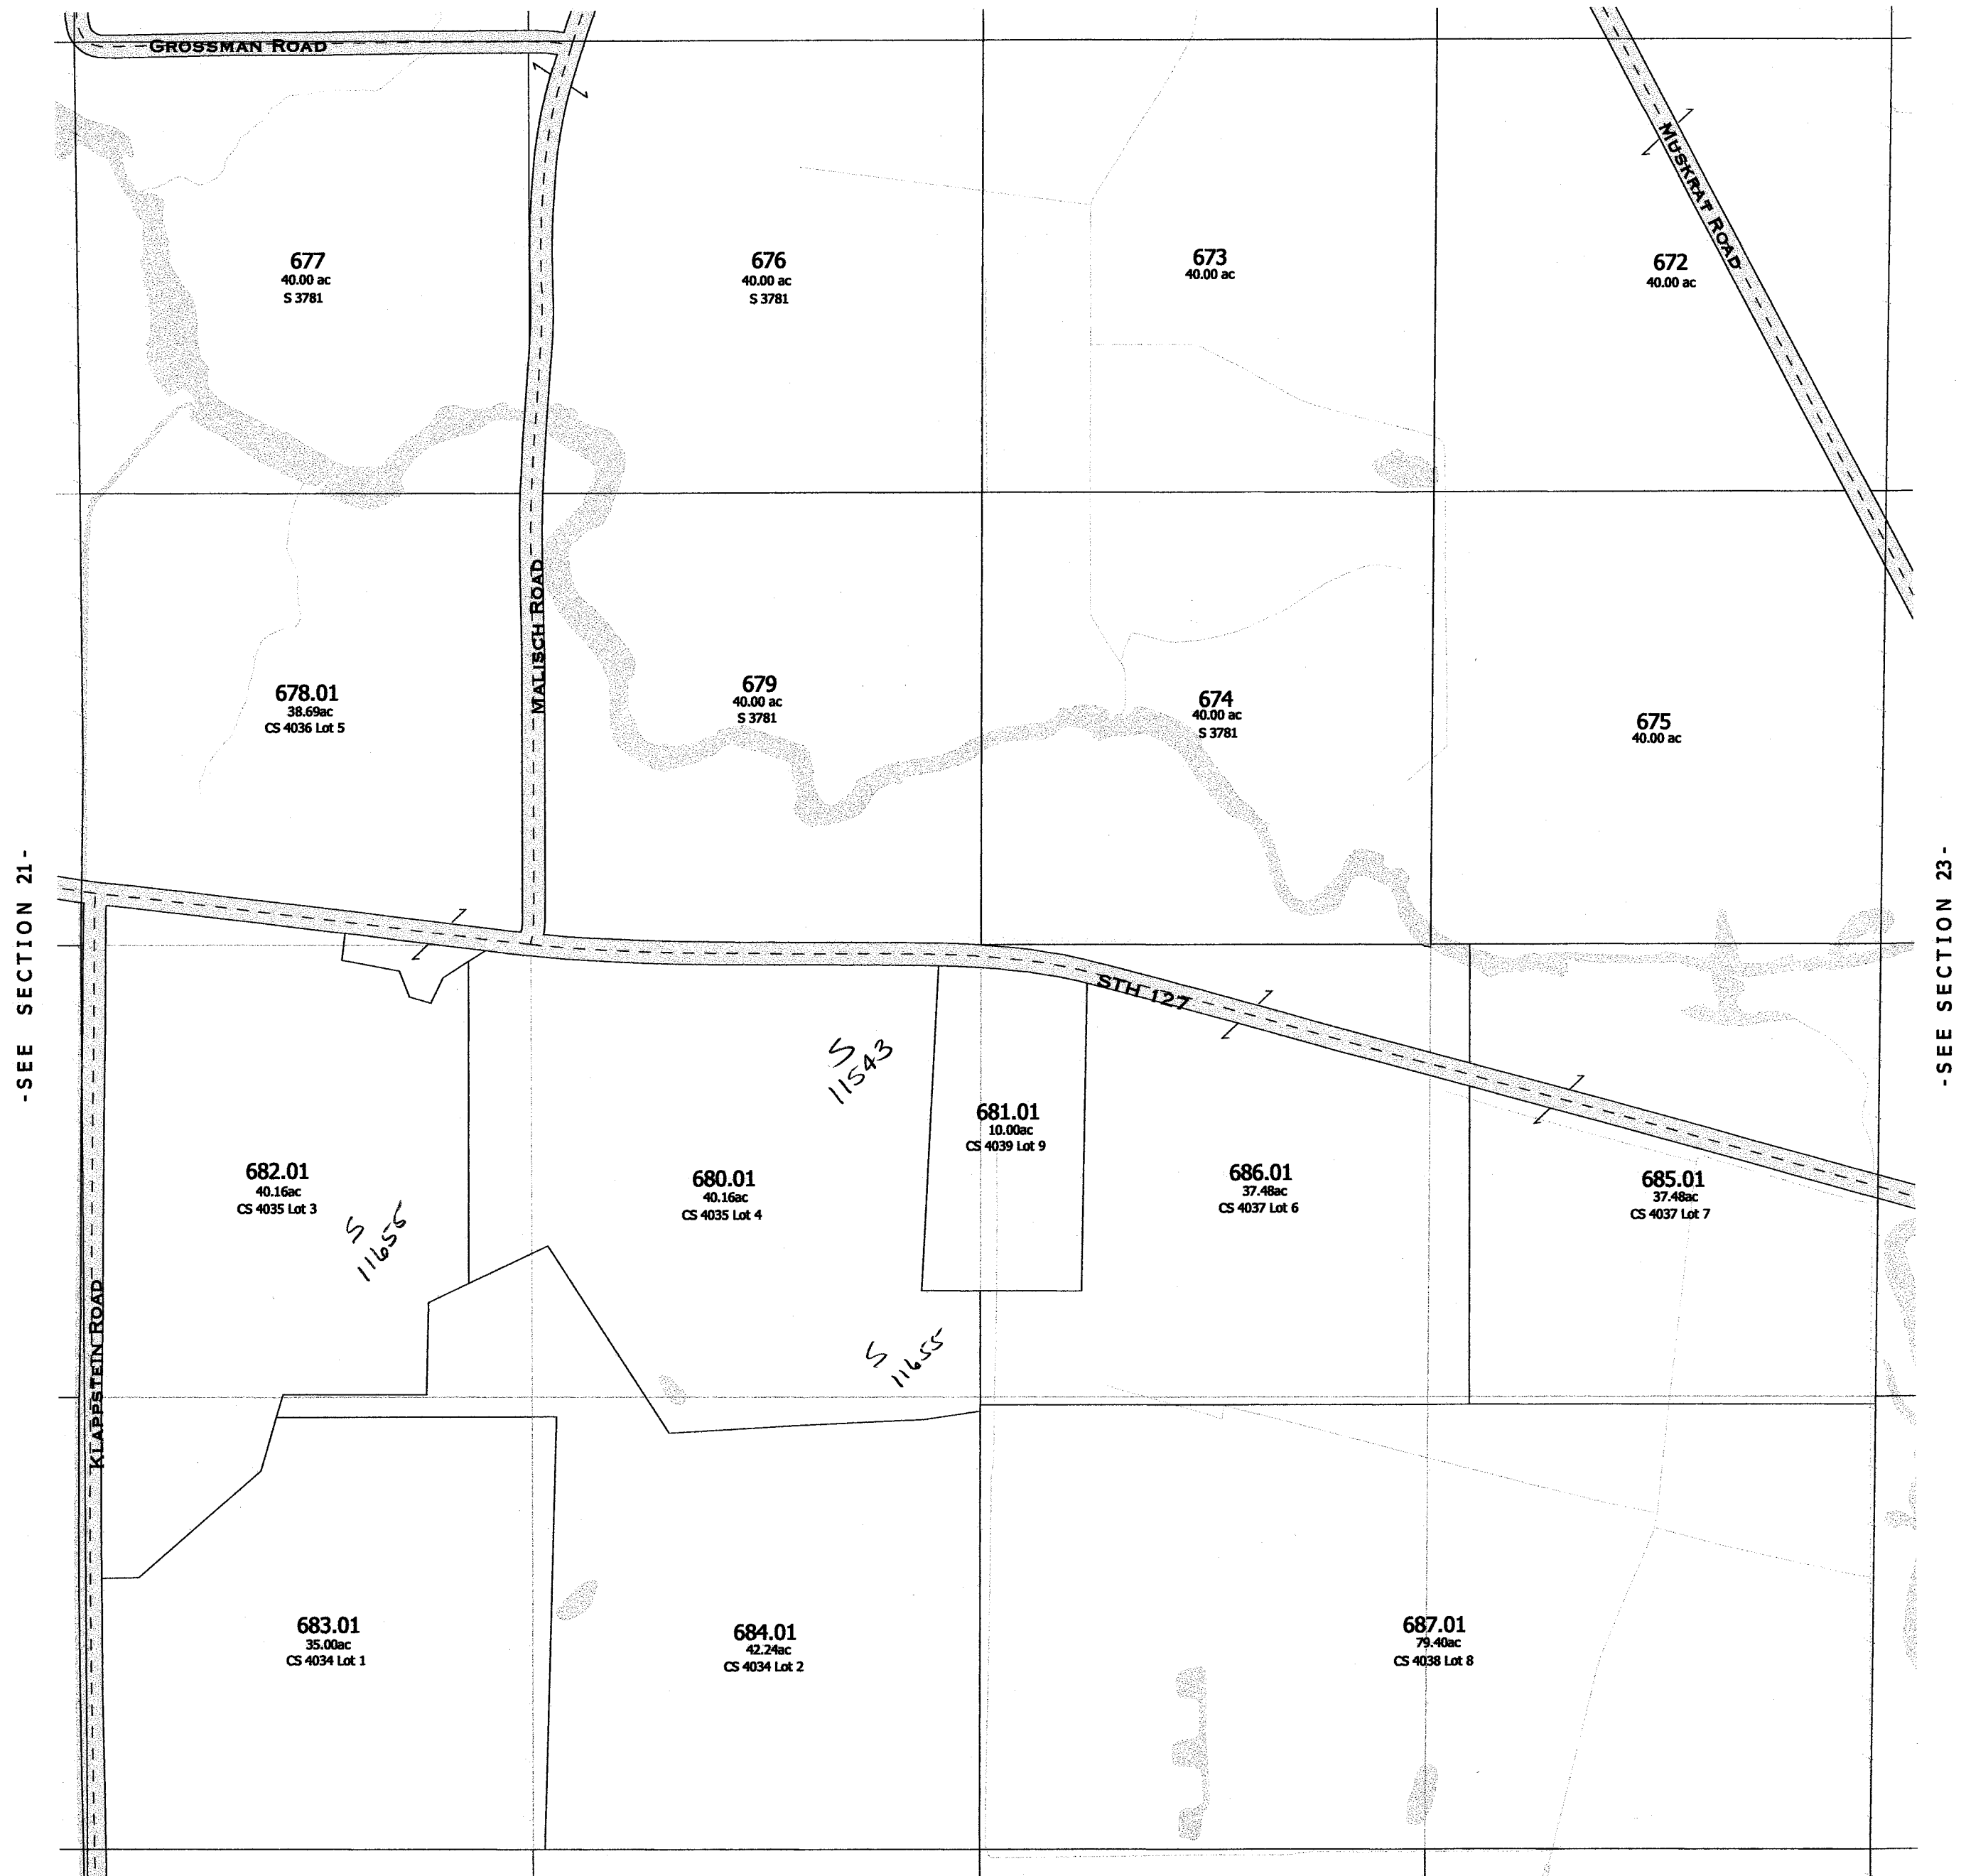

-SEE SECTION 27-

2005
-SECTION 22-

One Inch Equals Four Hundred Feet

0 1/16 1/8 1/4

0 400 800 1200 1600

FEET


NOTE: This map was prepared for assessment use in accordance with the Wis. St. Stat. Chap. 70.09. All information contained herein is advisory only. Map accuracy is limited to the quality of data obtained from other Public Records. This map is not intended to be a substitute for an actual field survey. Public Land Survey Base is derived from U.S.G.S. Topographic maps unless otherwise noted. Other sources of the Land Base may be actual survey data. Base map data is from the April 1995 County Digital Orthophotos and/or U.S.G.S. 1:24,000 scale Topographic series. The user is responsible for the improper use of the data contained herein.

Created by The Columbia County Land Information Office -GIS Section. VMB.
February 2005.

TAX PARCEL MAP


TOWN of LEWISTON

TOWN 13 NORTH RANGE 8 EAST
COLUMBIA COUNTY, WISCONSIN

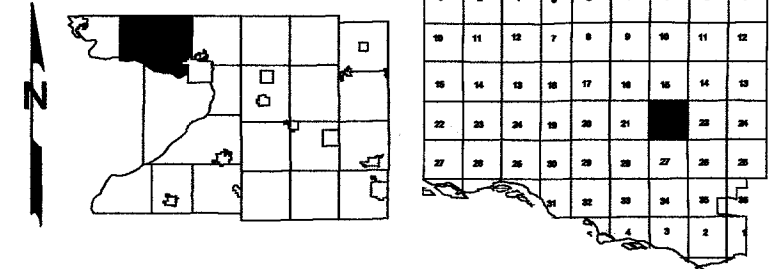

Replaced
2006

-SEE SECTION 15-

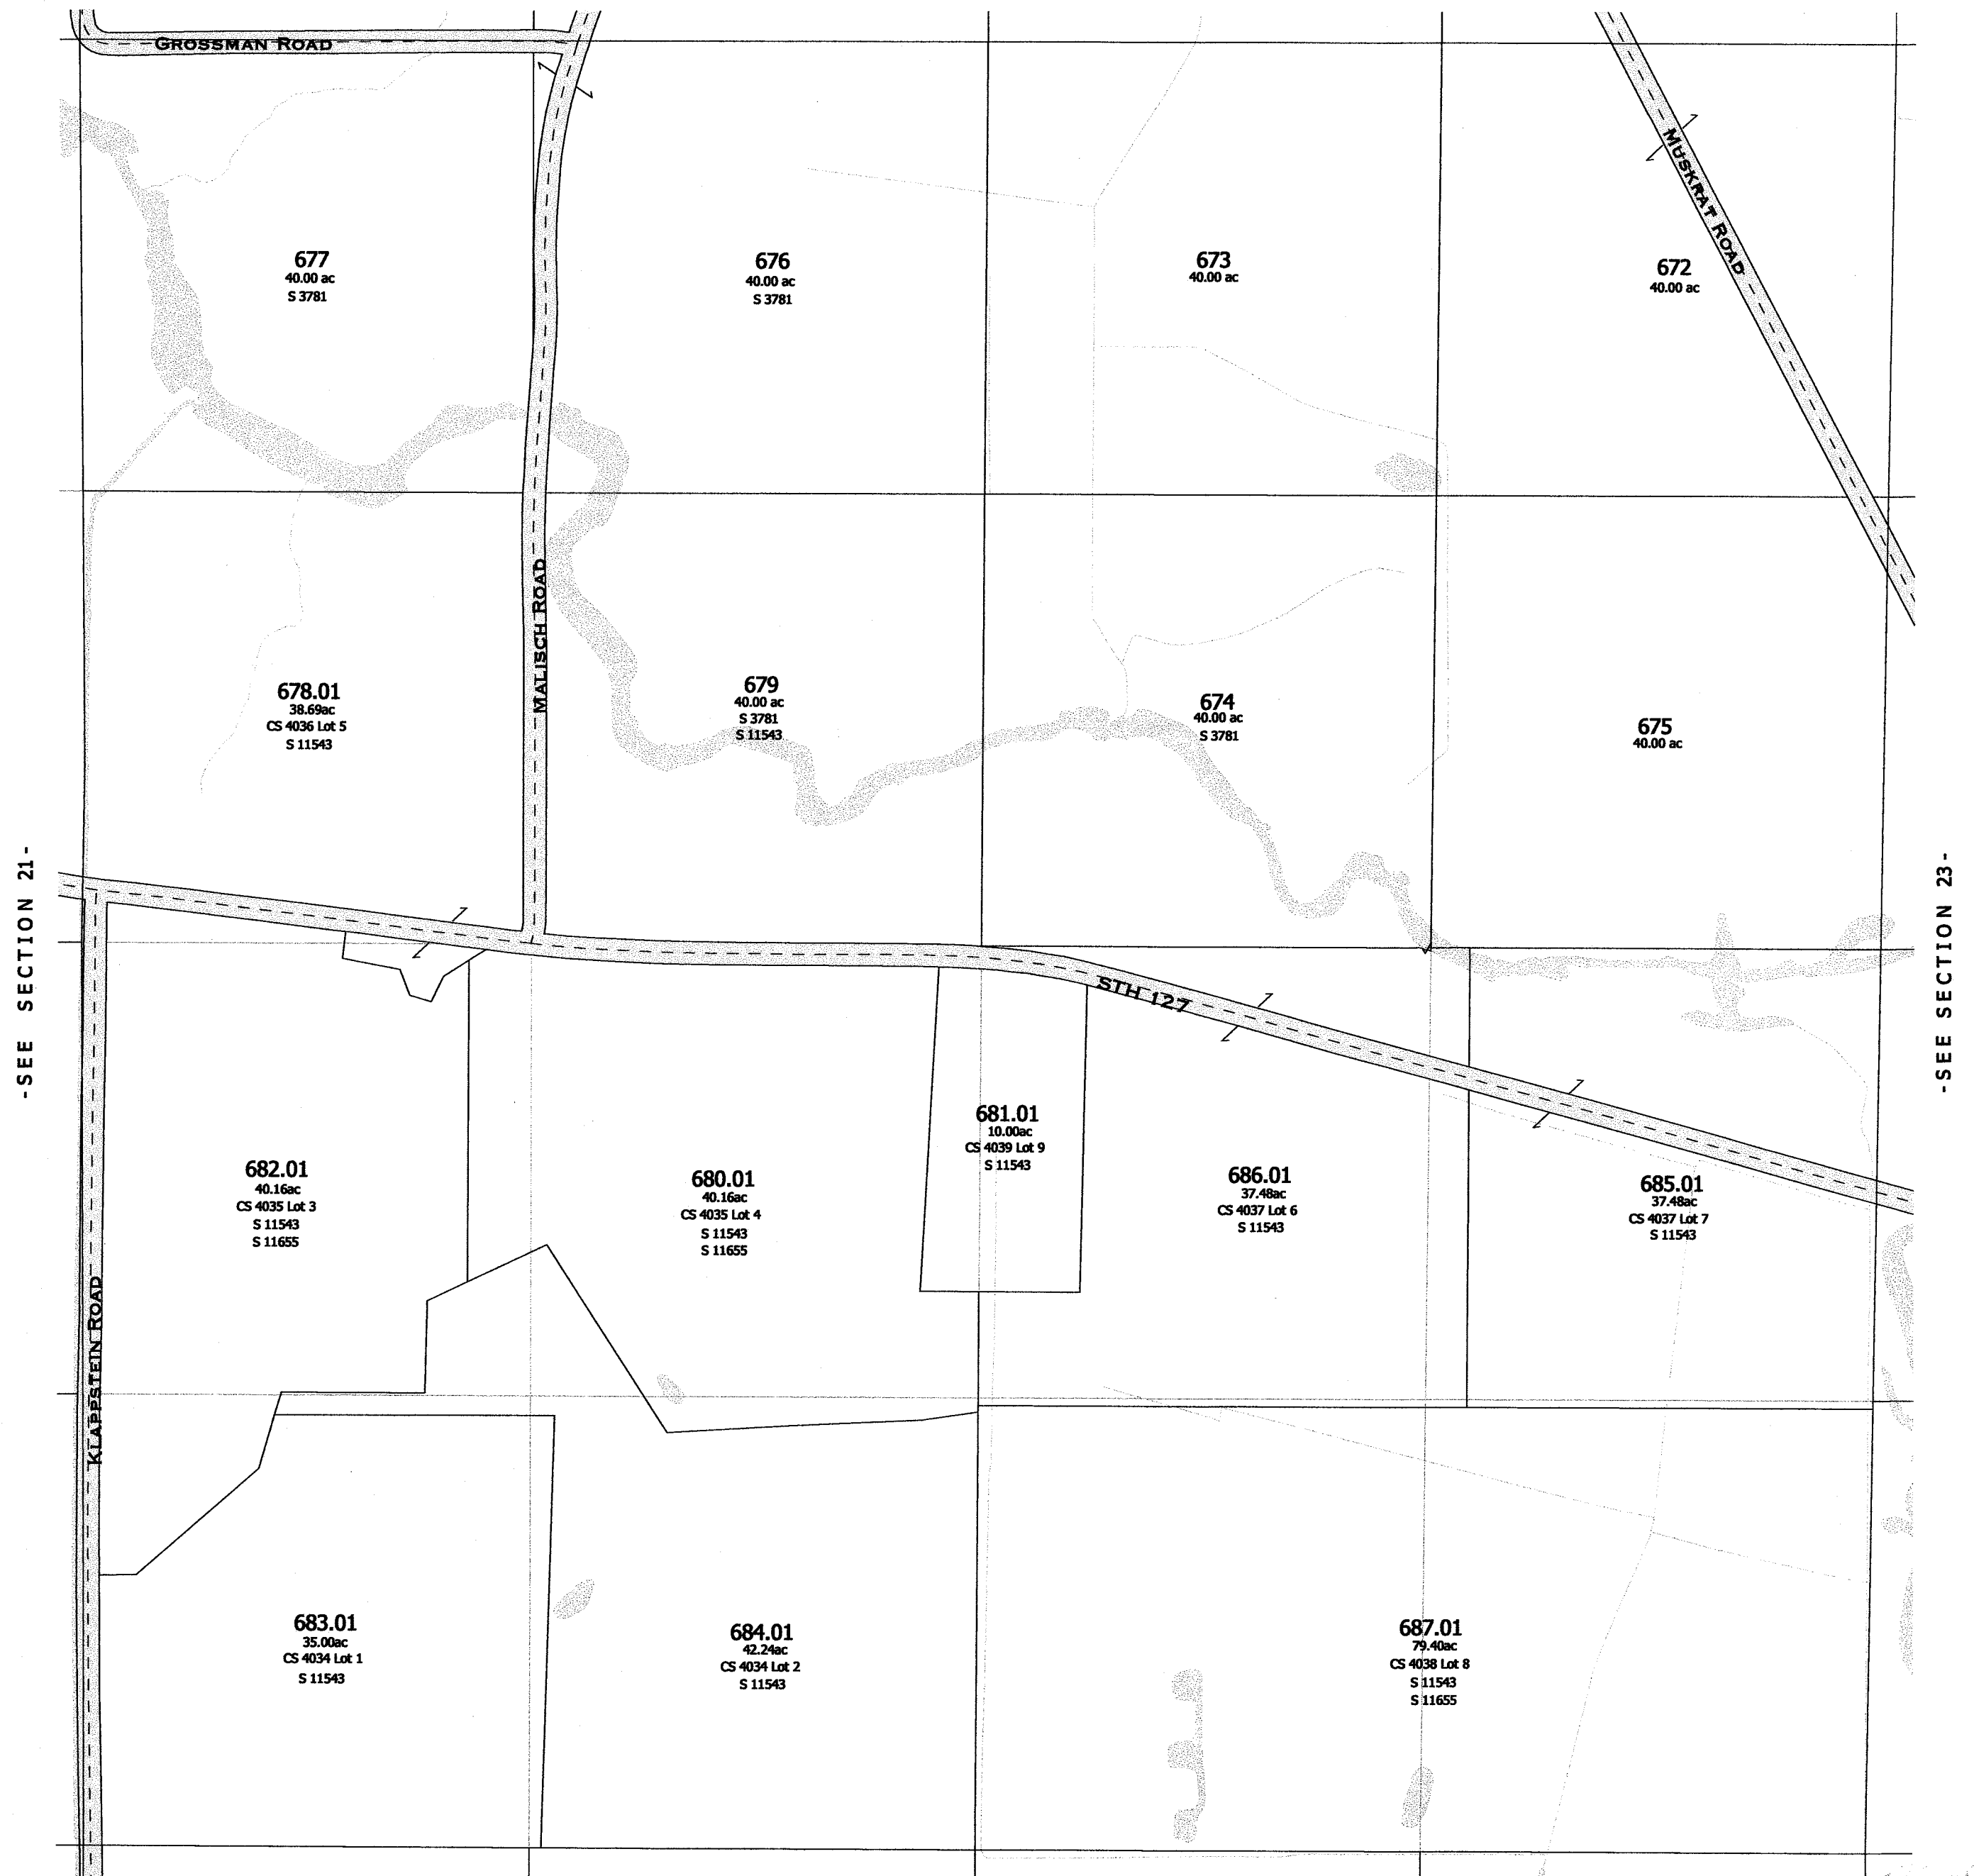


-SEE SECTION 27-


-SECTION 22-


LEWISTON
SEC. 23 T13N R8E

Replaced
2002

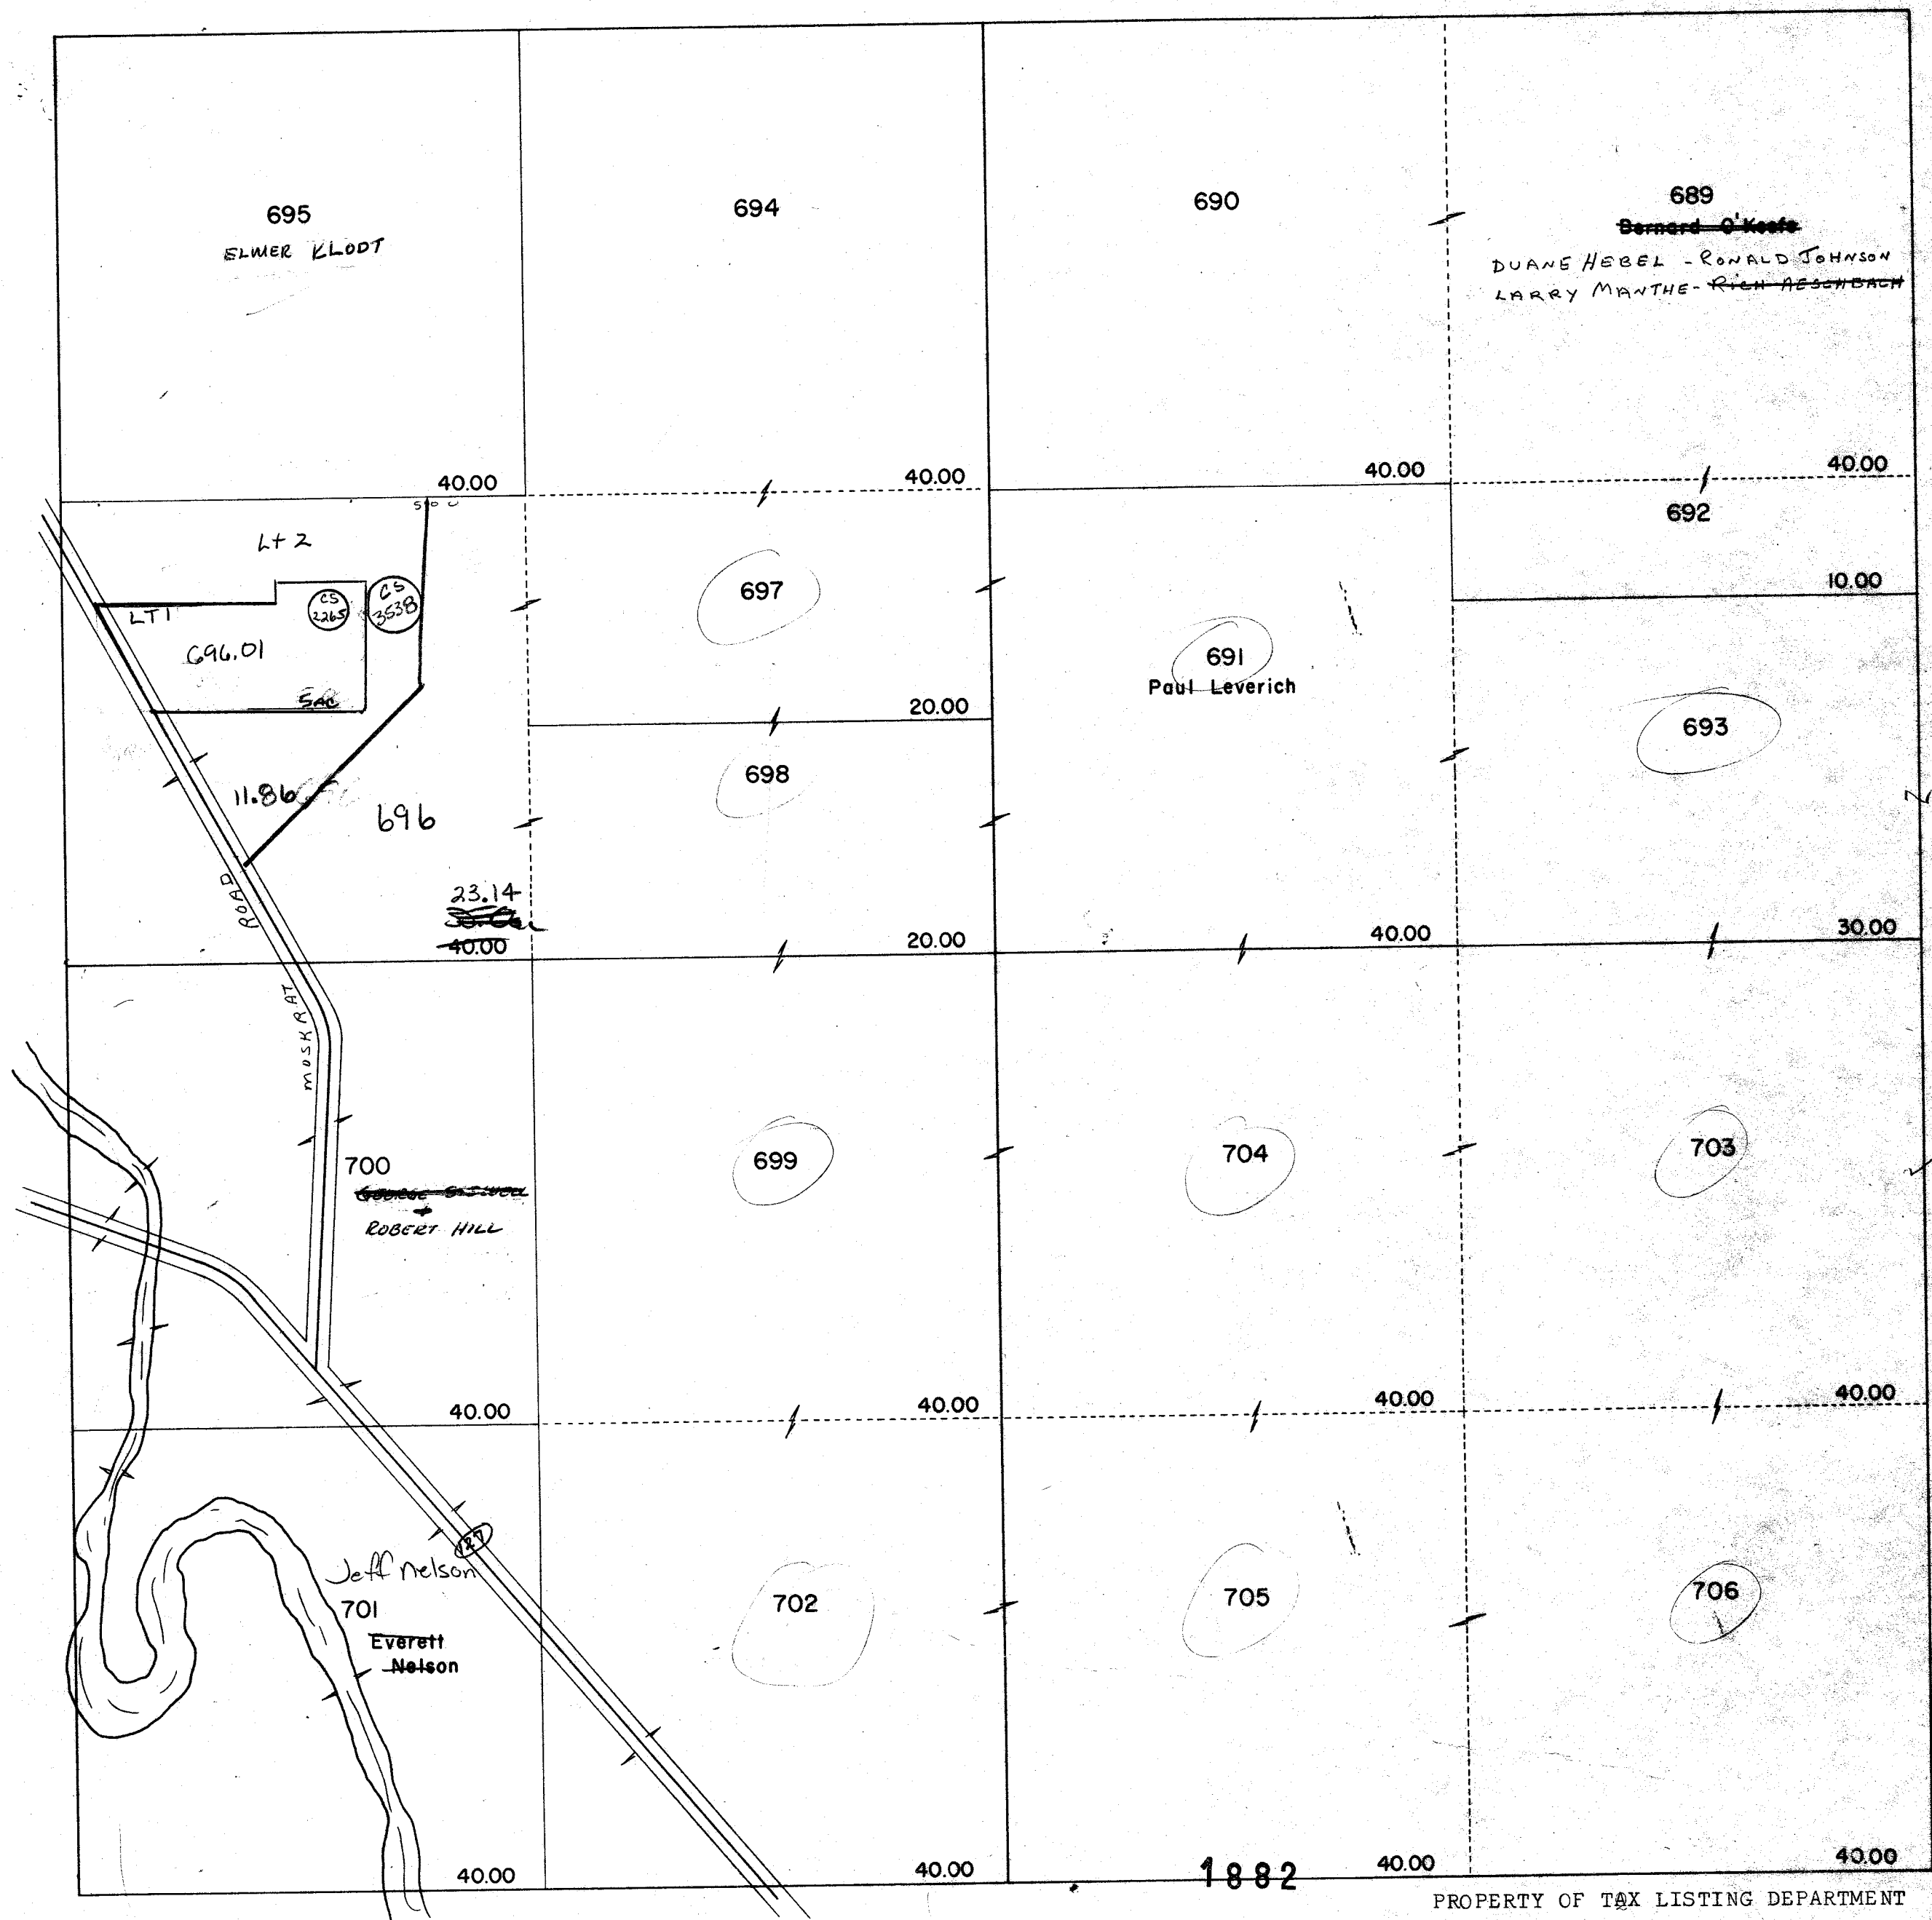

Replaced
2002

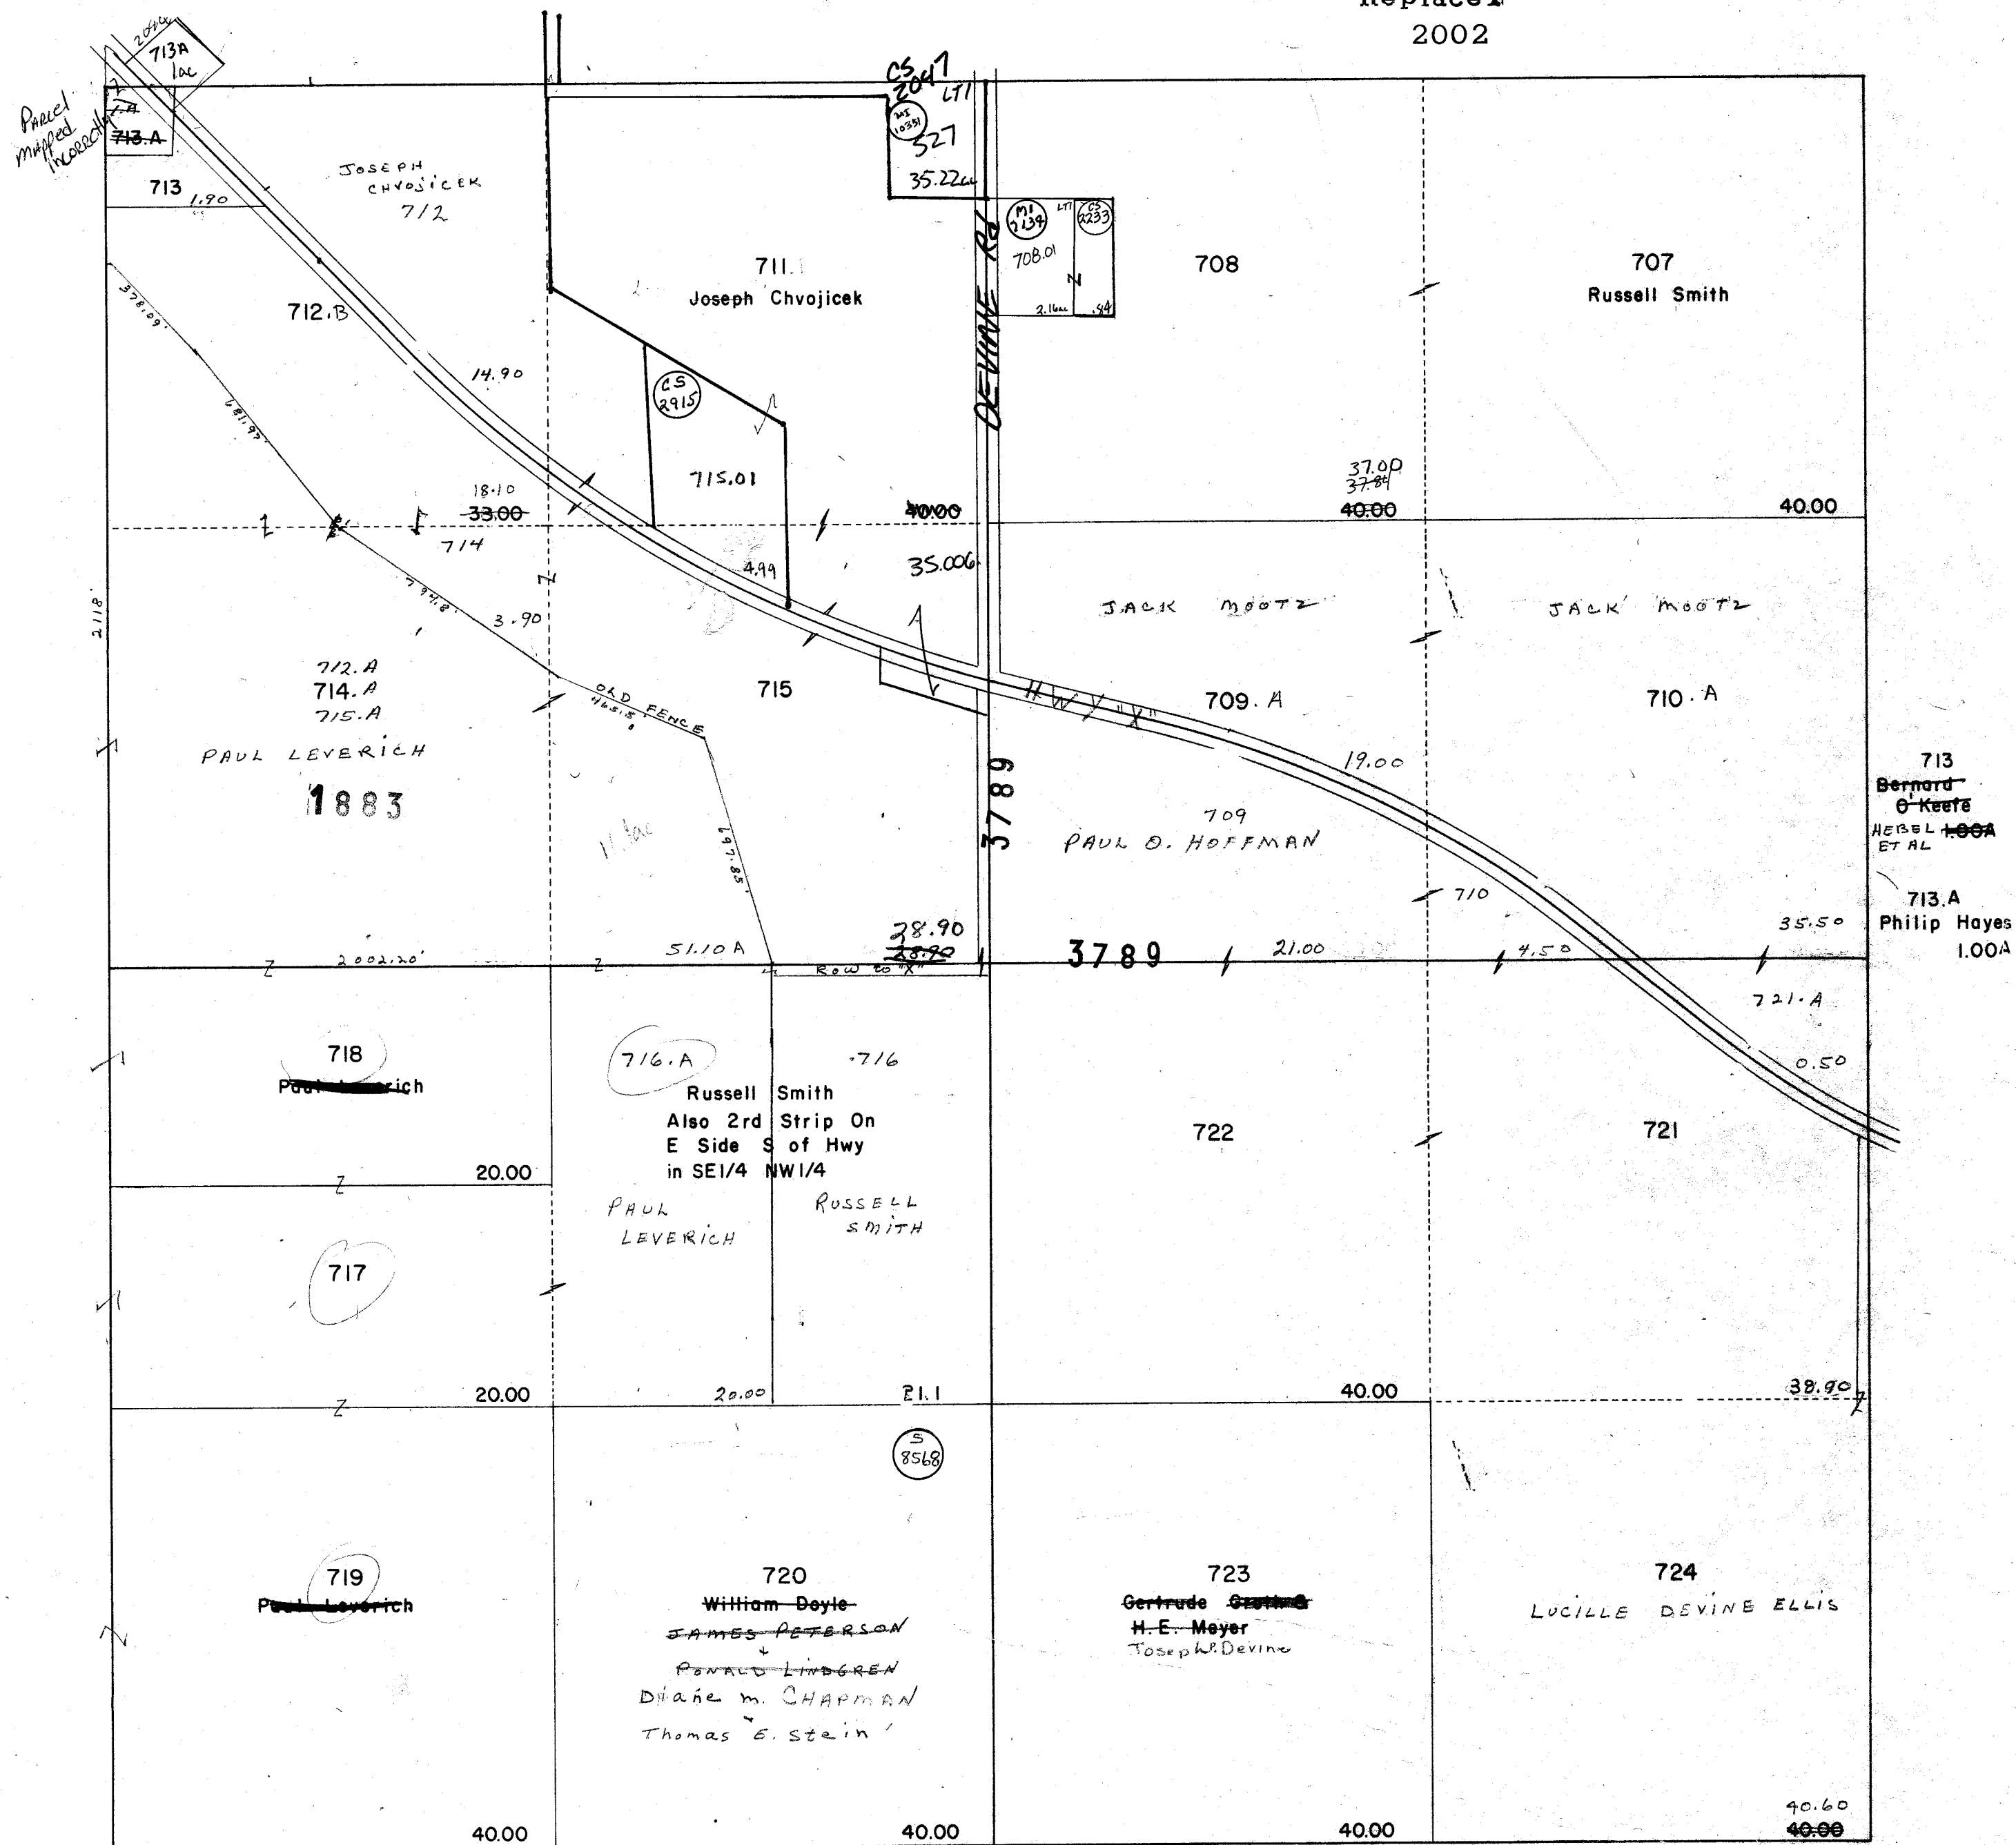

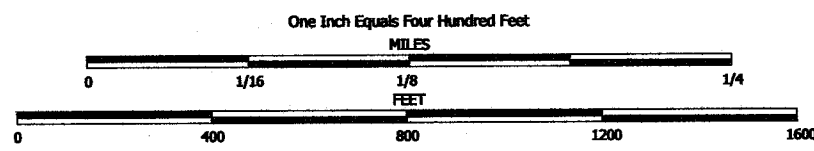


NOTE: This map was prepared for assessment use in accordance with the Wis. St. Stat. Chap. 70.09. All information contained herein is advisory only. Map accuracy is limited to the quality of data obtained from other Public Records. This map is not intended to be a substitute for an actual field survey. Public Land Survey Base is derived from U.S.G.S. Topographic maps unless otherwise noted. Other sources of the Land Base may be actual survey data. Base map data is from the April 1995 County Digital Orthophotos and/or U.S.G.S. 1:24,000 scale Topographic series. The user is responsible for the improper use of the data contained herein.

Created by The Columbia County Land Information Office -GIS Section. VMB.
September 2002.

TAX PARCEL MAP

TOWN of LEWISTON


TOWN 13 NORTH RANGE 8 EAST
COLUMBIA COUNTY, WISCONSIN

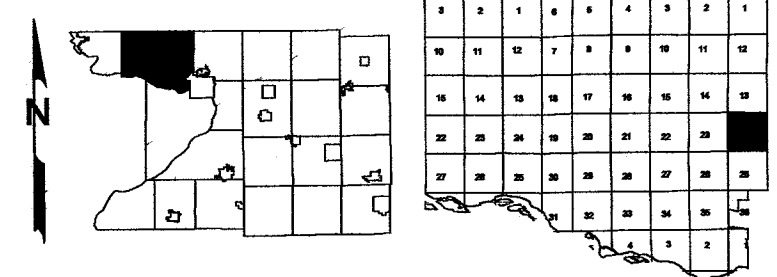

Replaced
2004



replaced 2004
-SECTION 24-

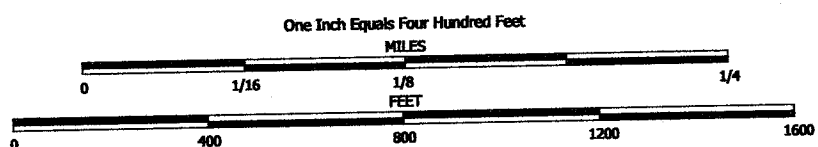



NOTE: This map was prepared for assessment use in accordance with the Wis. St. Stat. Chap. 70.09. All information contained herein is advisory only. Map accuracy is limited to the quality of data obtained from other Public Records. This map is not intended to be a substitute for an actual field survey. Public Land Survey Base is derived from U.S.G.S. Topographic maps unless otherwise noted. Other sources of the Land Base may be actual survey data. Base map data is from the April 1995 County Digital Orthophotos and/or U.S.G.S. 1:24,000 scale Topographic series. The user is responsible for the improper use of the data contained herein.

Created by The Columbia County Land Information Office -GIS Section. VMB.
March 2004.


TAX PARCEL MAP

TOWN of LEWISTON

TOWN 13 NORTH RANGE 8 EAST
COLUMBIA COUNTY, WISCONSIN

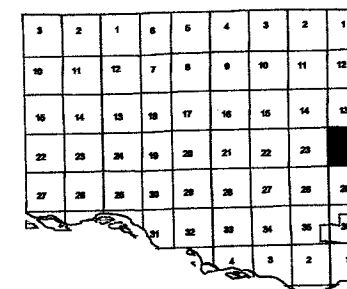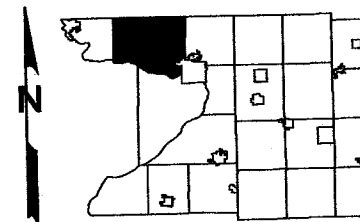

Replaced
2005

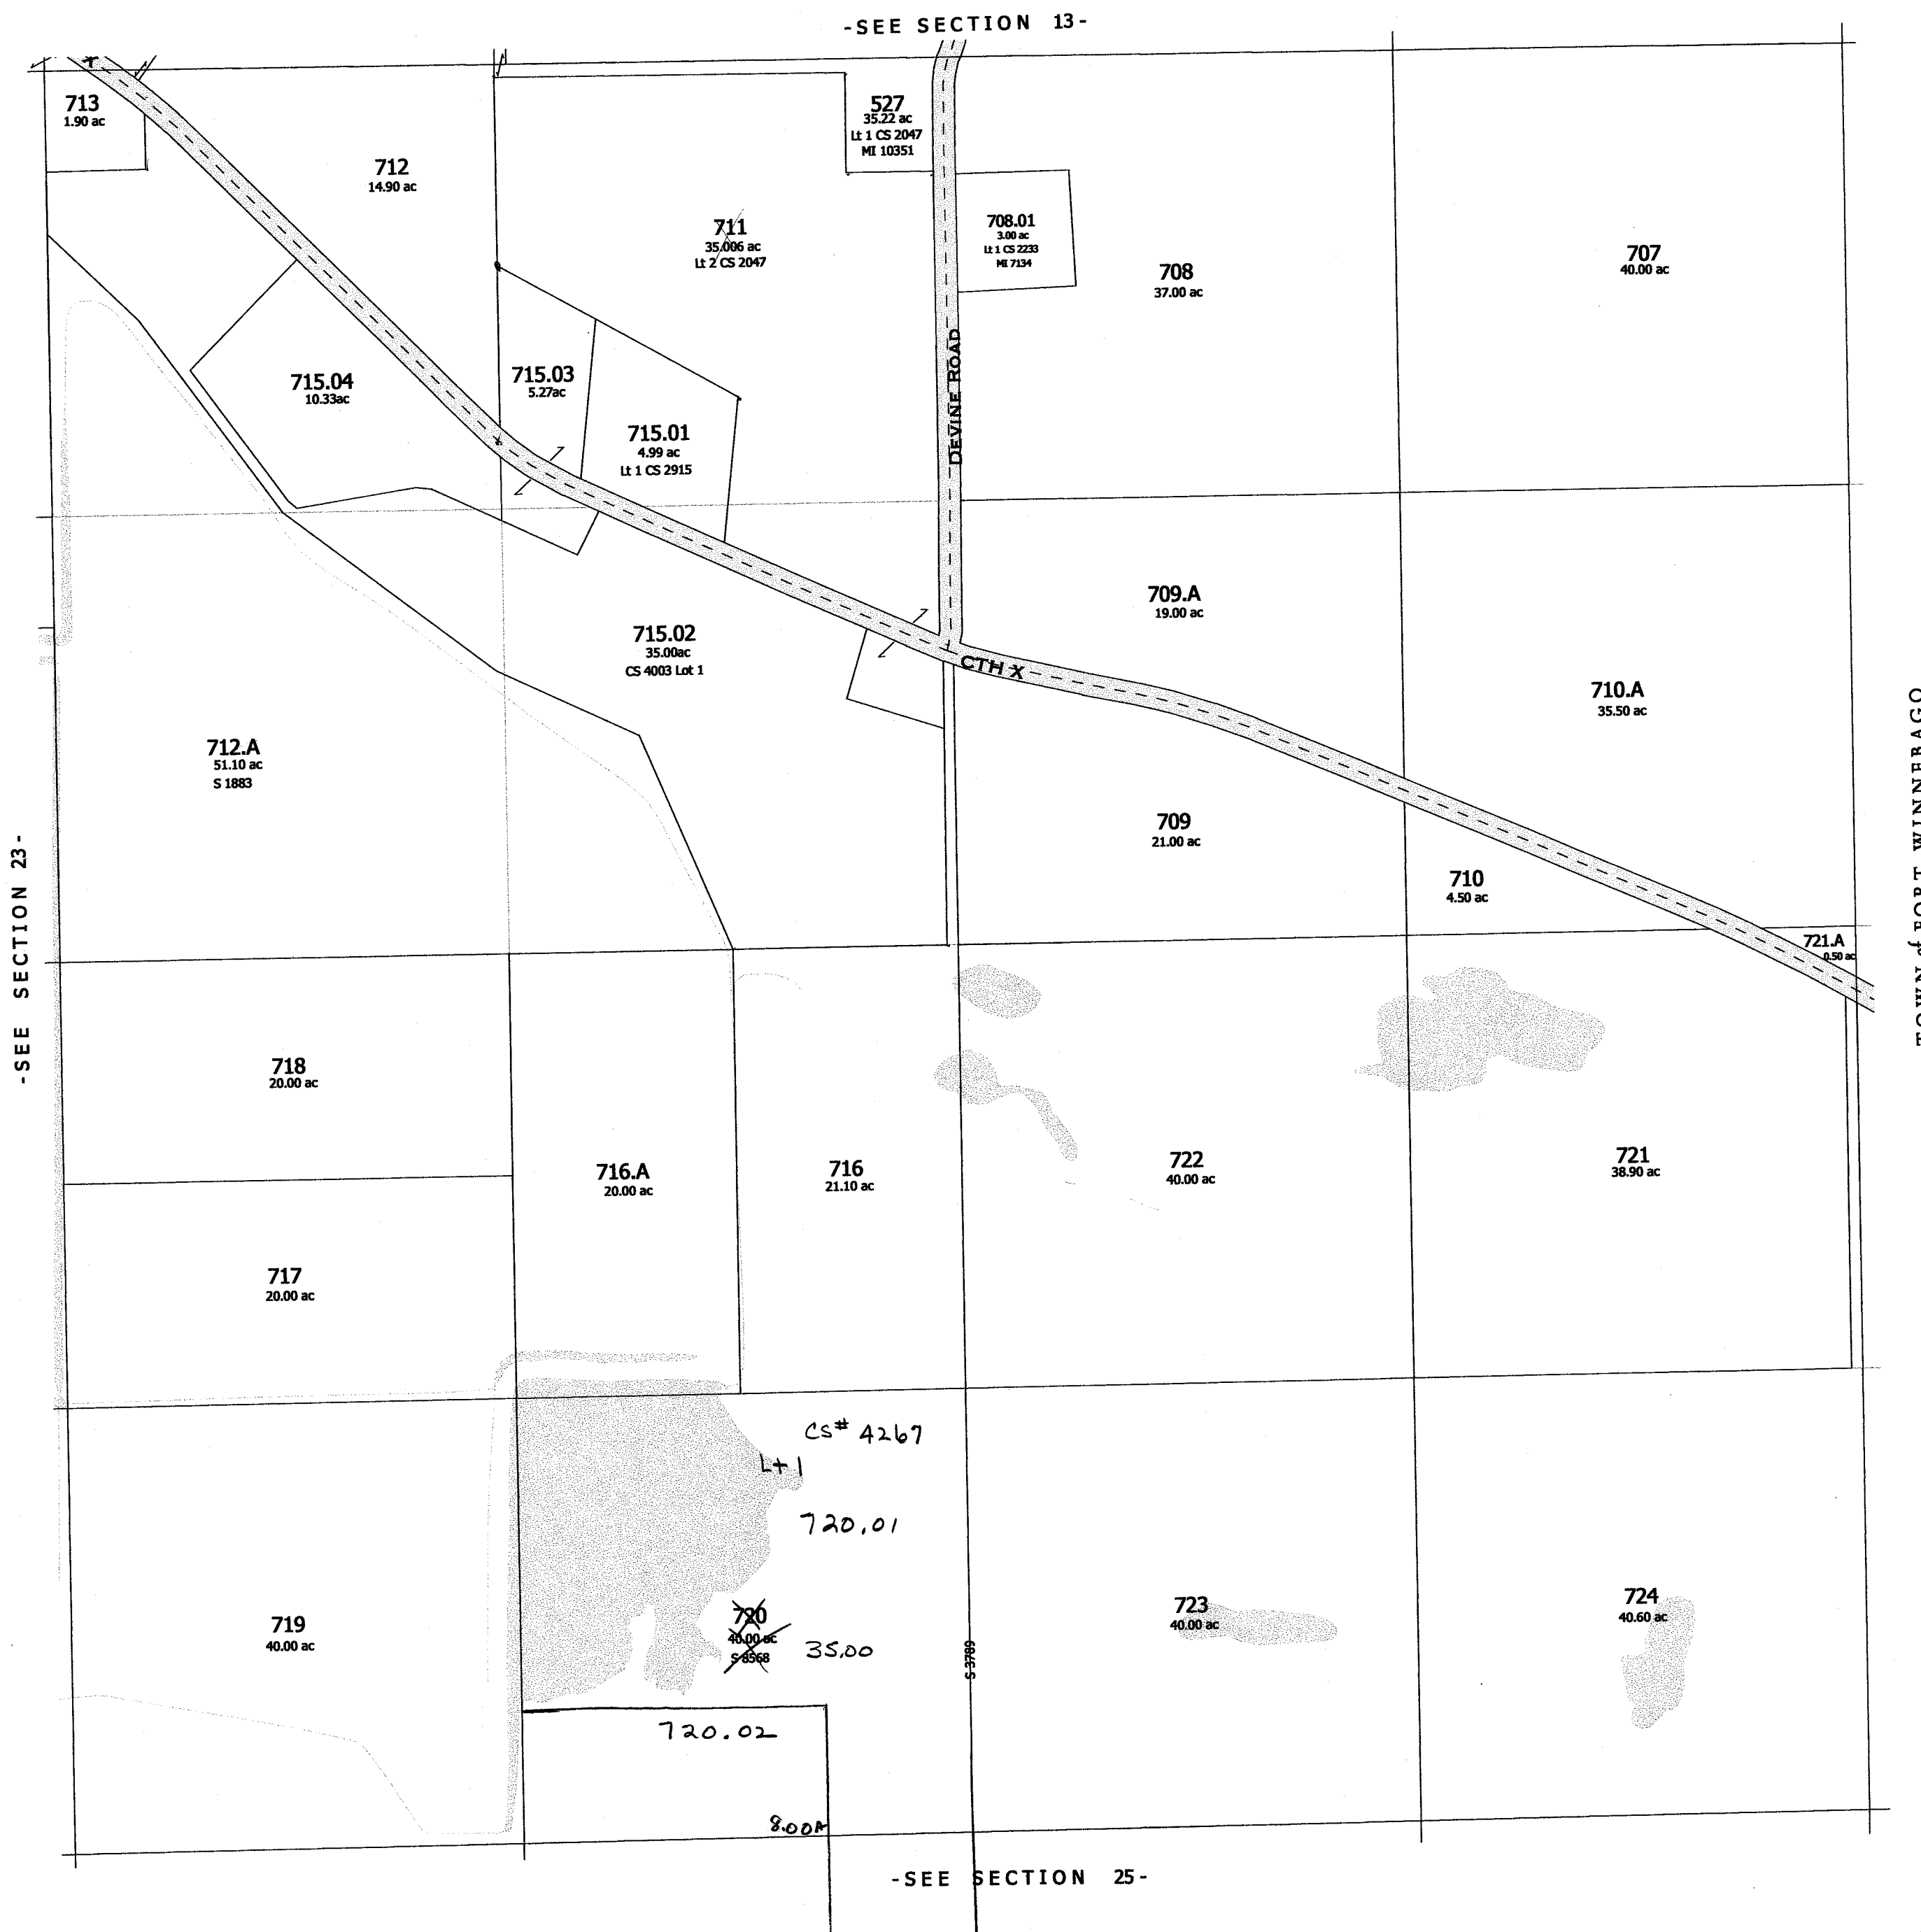

One Inch Equals Four Hundred Feet
MILES
0 1/16 1/8 1/4
FEET
0 400 800 1200 1600


NOTE: This map was prepared for assessment use in accordance with the Wis. St. Stat. Chap. 70.09. All information contained herein is advisory only. Map accuracy is limited to the quality of data obtained from other Public Records. This map is not intended to be a substitute for an actual field survey. Public Land Survey Base is derived from U.S.G.S Topographic maps unless otherwise noted. Other sources of the Land Base may be actual survey data. Base map data is from the April 1995 County Digital Orthophotos and/or U.S.G.S. 1:24,000 scale Topographic series. The user is responsible for the improper use of the data contained herein.

Created by The Columbia County Land Information Office -GIS Section. VMB.
February 2005.

TAX PARCEL MAP

TOWN of LEWISTON

TOWN 13 NORTH RANGE 8 EAST
COLUMBIA COUNTY, WISCONSIN

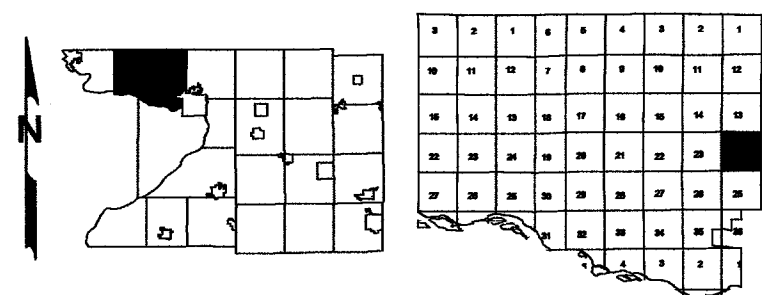

Replaced
2006




Replaced
2006

-SECTION 24-

SEC. 25 T13N R8E

2002

1884. Resolution by Town Board to extend Balgrieen Rd.
1.0 mi (518') to be improved, the former Town Road
Standards. Dated 6/27/77 (copy in survey file).

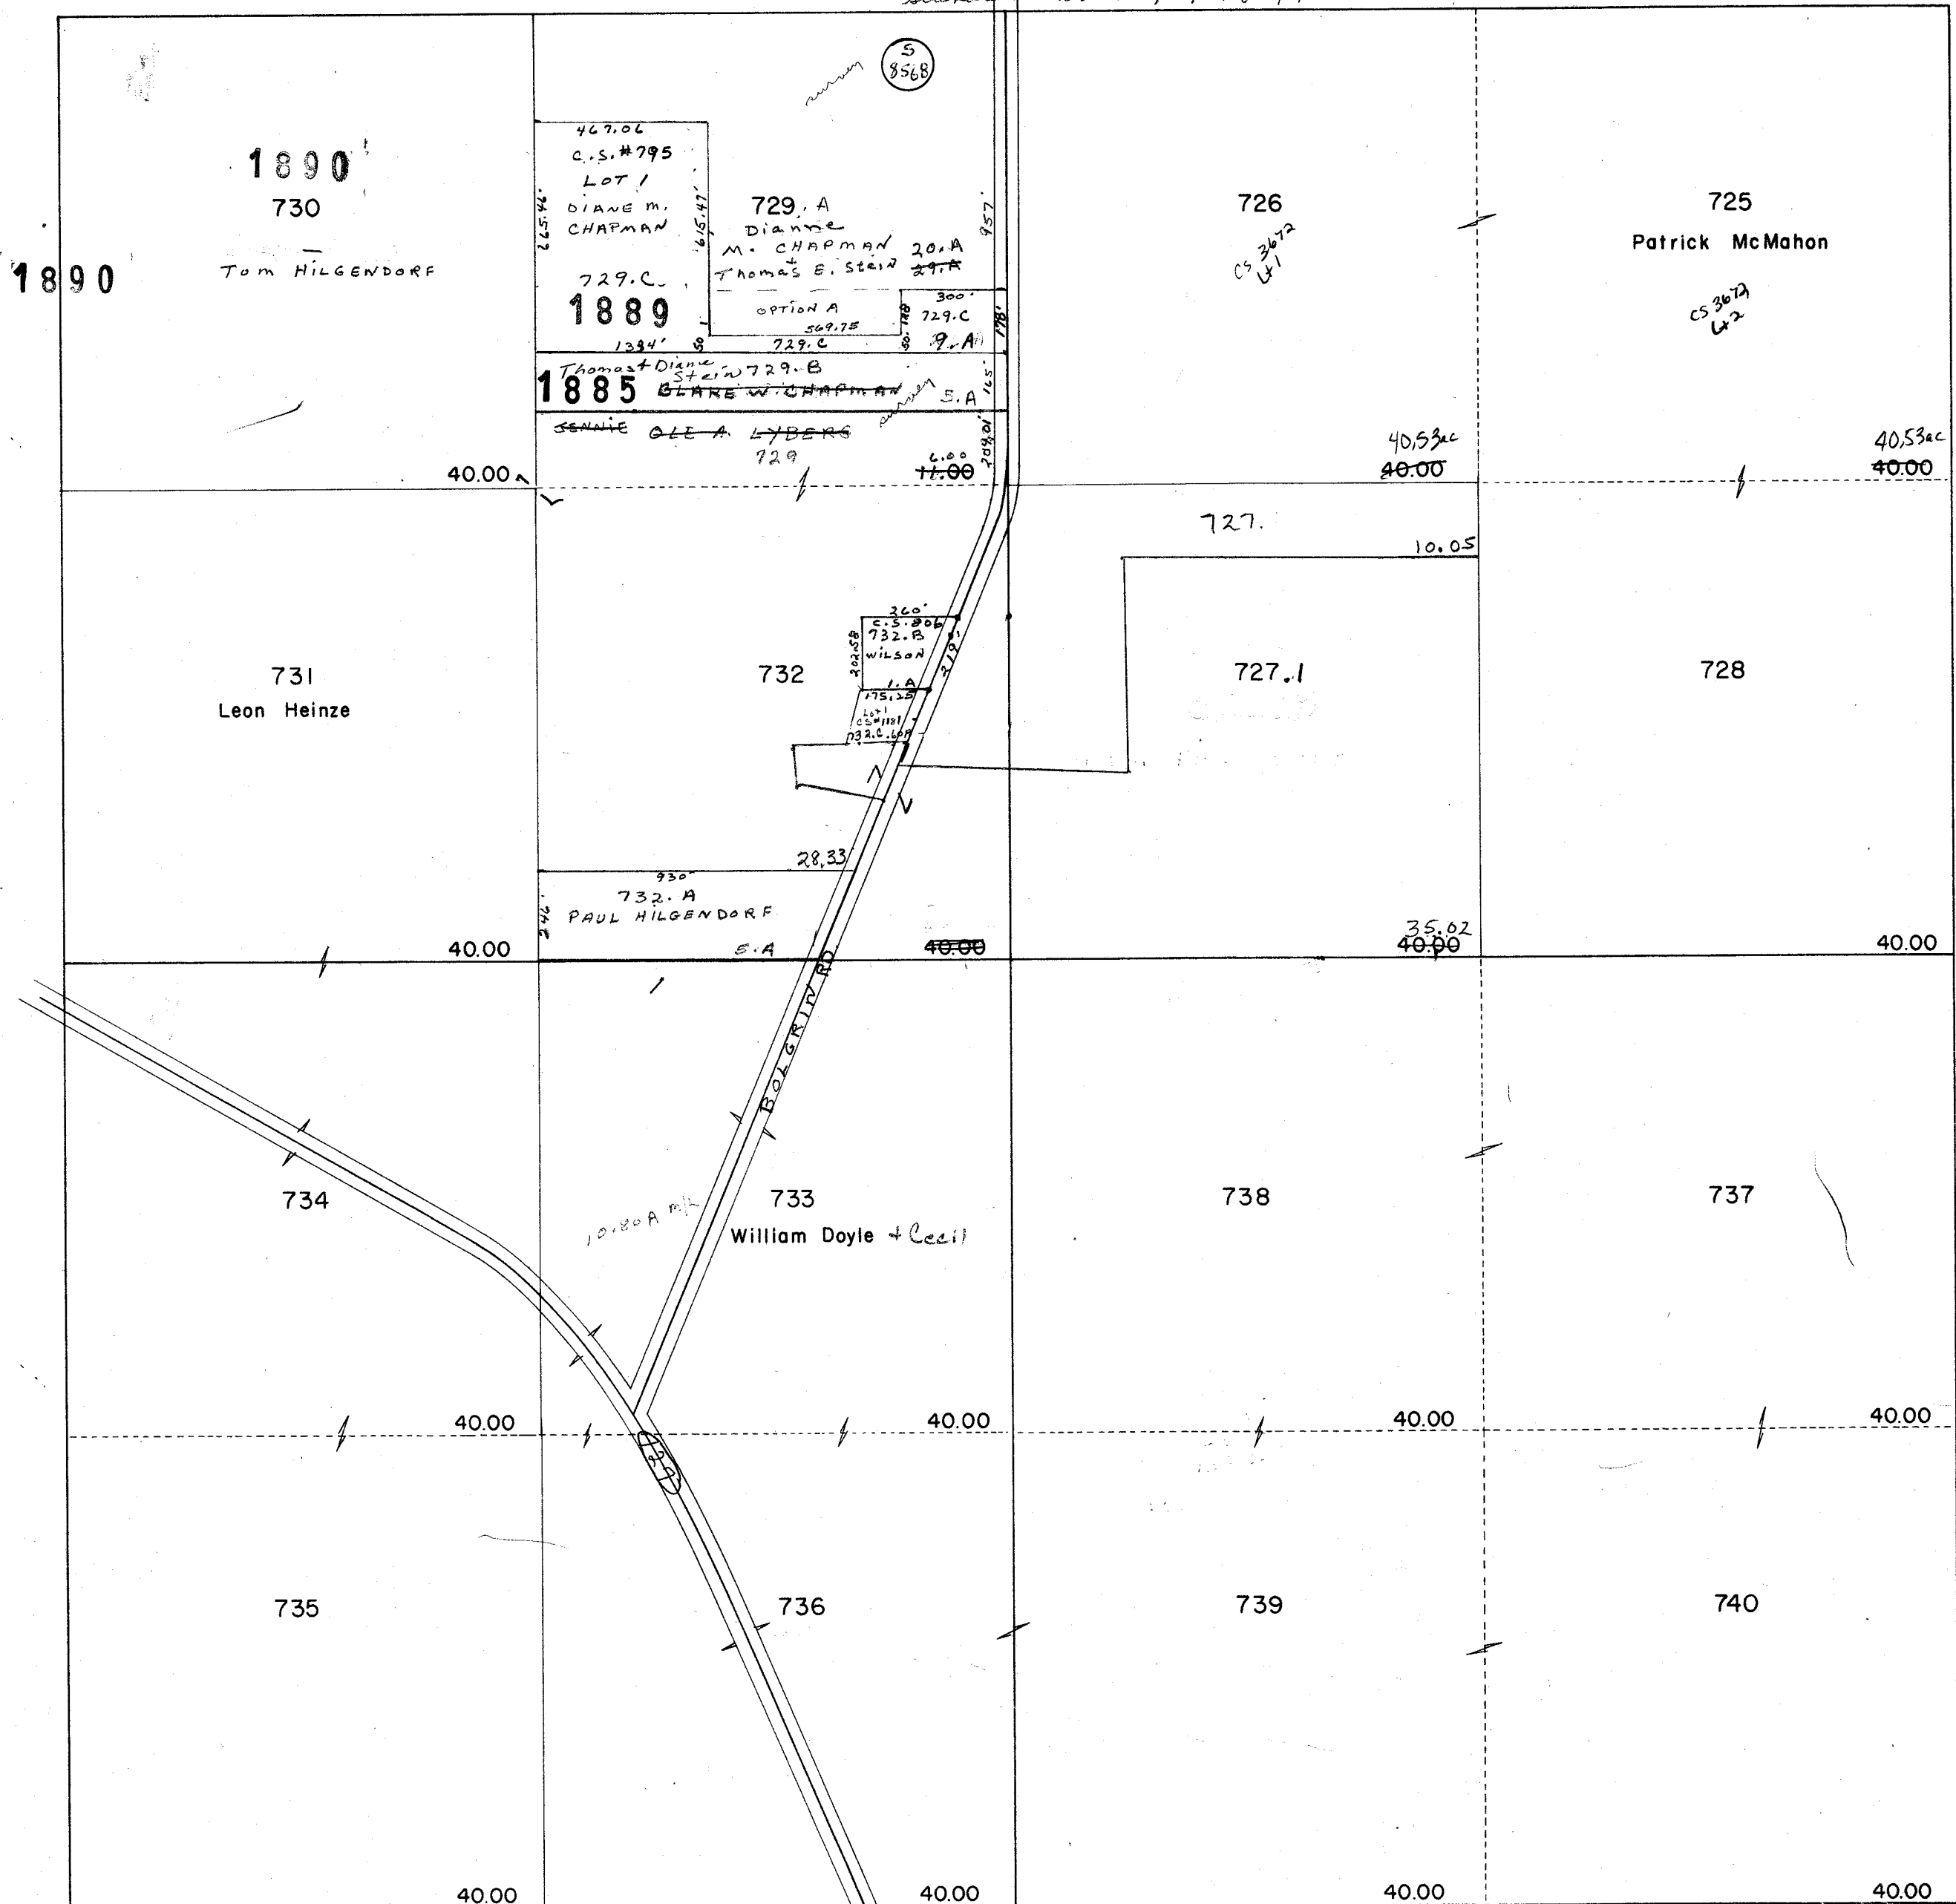

PROPERTY OF TAX LISTING DEPARTMENT

One Inch Equals Four Hundred Feet
MILES
0 1/16 1/8 1/4
FEET
0 400 800 1200 1600


NOTE: This map was prepared for assessment use in accordance with the Wis. St. Stat. Chap. 70.09. All information contained herein is advisory only. Map accuracy is limited to the quality of data obtained from other Public Records. This map is not intended to be a substitute for an actual field survey. Public Land Survey Base is derived from U.S.G.S. Topographic maps unless otherwise noted. Other sources of the Land Base may be actual survey data. Base map data is from the April 1995 County Digital Orthophotos and/or U.S.G.S. 1:24,000 scale Topographic series. The user is responsible for the improper use of the data contained herein.

Created by The Columbia County Land Information Office -GIS Section. VMB.
September 2002.


TAX PARCEL MAP
TOWN of LEWISTON

TOWN 13 NORTH RANGE 8 EAST
COLUMBIA COUNTY, WISCONSIN

Replaced
2004

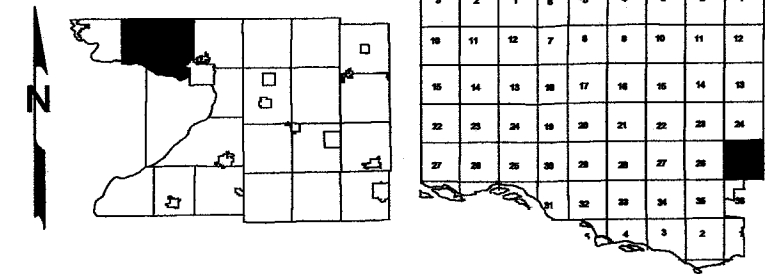

-SEE SECTION 24-

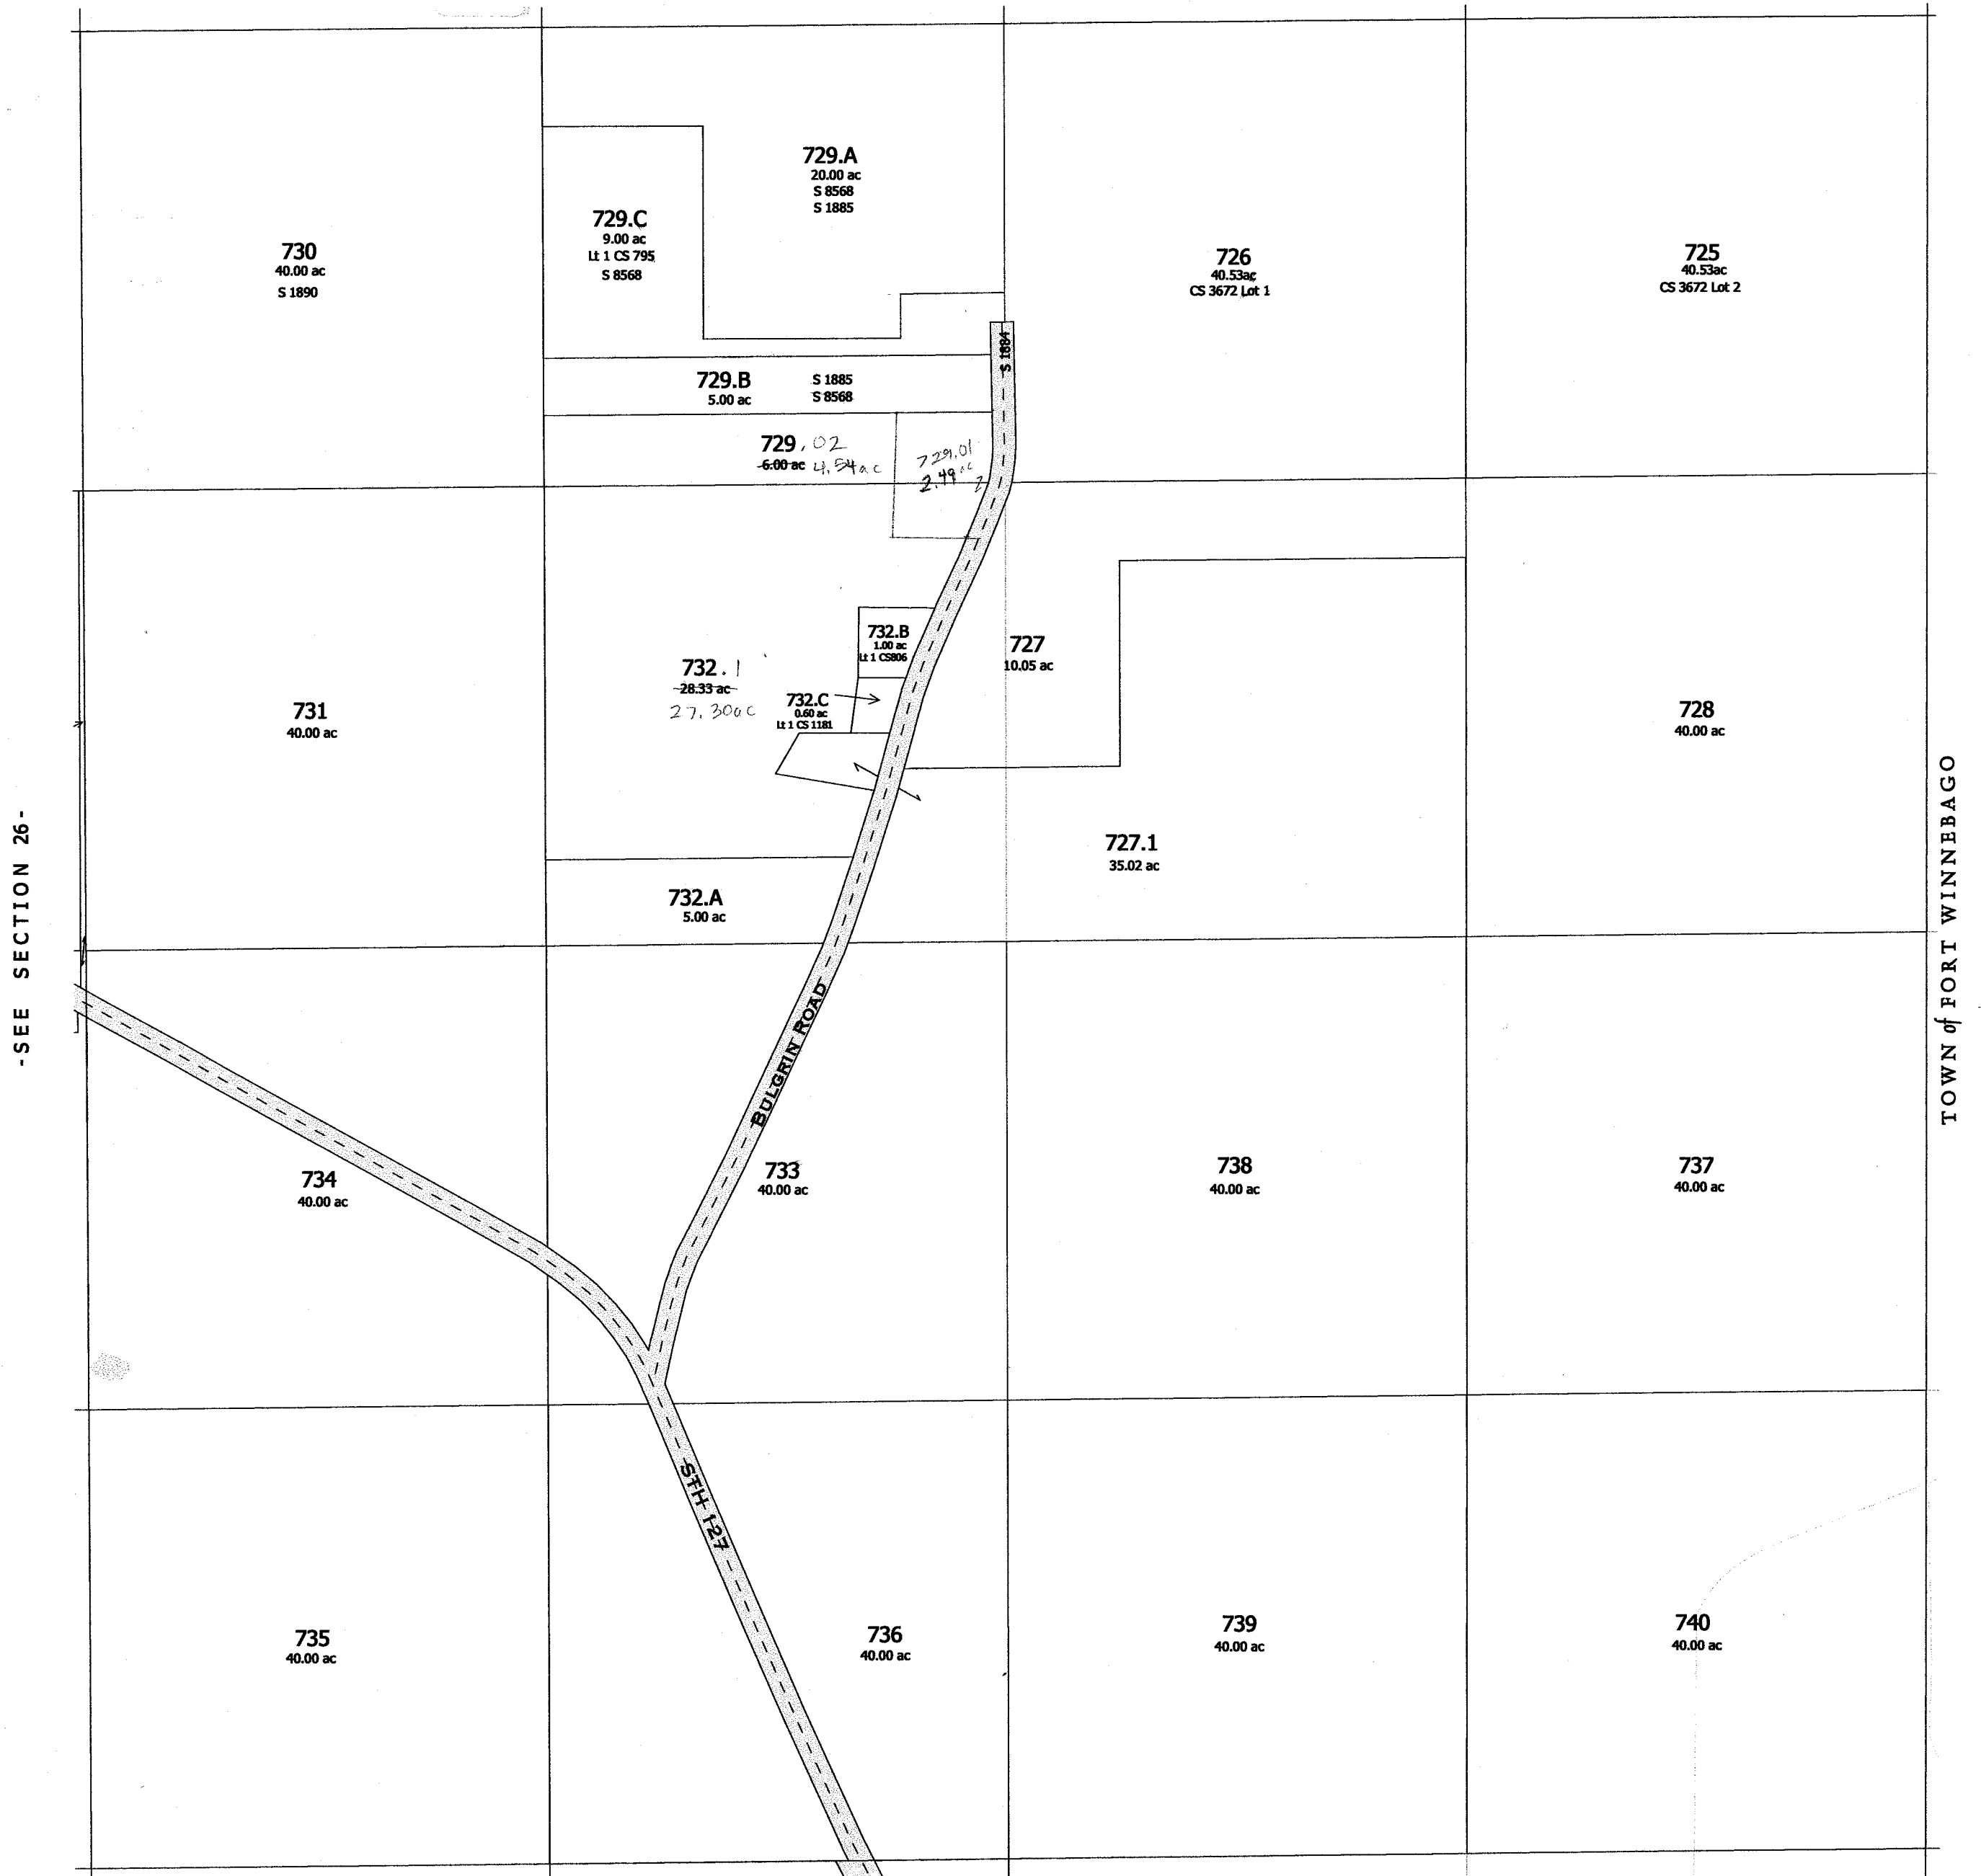

-SEE SECTION 26-

TOWN of FORT WINNEBAGO

-SEE SECTION 36-

replaced 2004

-SECTION 25-

One Inch Equals Four Hundred Feet

MILES

0 1/16 1/8 1/4

FEET

0 400 800 1200 1600


NOTE: This map was prepared for assessment use in accordance with the Wis. St. Stat. Chap. 70.09. All information contained herein is advisory only. Map accuracy is limited to the quality of data obtained from other Public Records. This map is not intended to be a substitute for an actual field survey. Public Land Survey Base is derived from U.S.G.S. Topographic maps unless otherwise noted. Other sources of the Land Base may be actual survey data. Base map data is from the April 1995 County Digital Orthophotos and/or U.S.G.S. 1:24,000 scale Topographic series. The user is responsible for the improper use of the data contained herein.

Created by The Columbia County Land Information Office -GIS Section. VMB.
March 2004.

TAX PARCEL MAP


TOWN of LEWISTON

TOWN 13 NORTH RANGE 8 EAST
COLUMBIA COUNTY, WISCONSIN

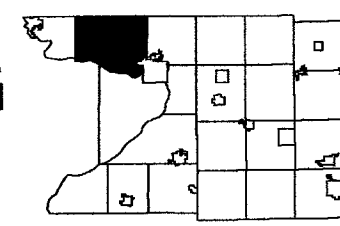

1	2	3	4	5	6	7	8	9	10
11	12	13	14	15	16	17	18	19	20
21	22	23	24	25	26	27	28	29	30
31	32	33	34	35	36	37	38	39	40
41	42	43	44	45	46	47	48	49	50
51	52	53	54	55	56	57	58	59	60
61	62	63	64	65	66	67	68	69	70
71	72	73	74	75	76	77	78	79	80
81	82	83	84	85	86	87	88	89	90
91	92	93	94	95	96	97	98	99	100

Replaced
2005

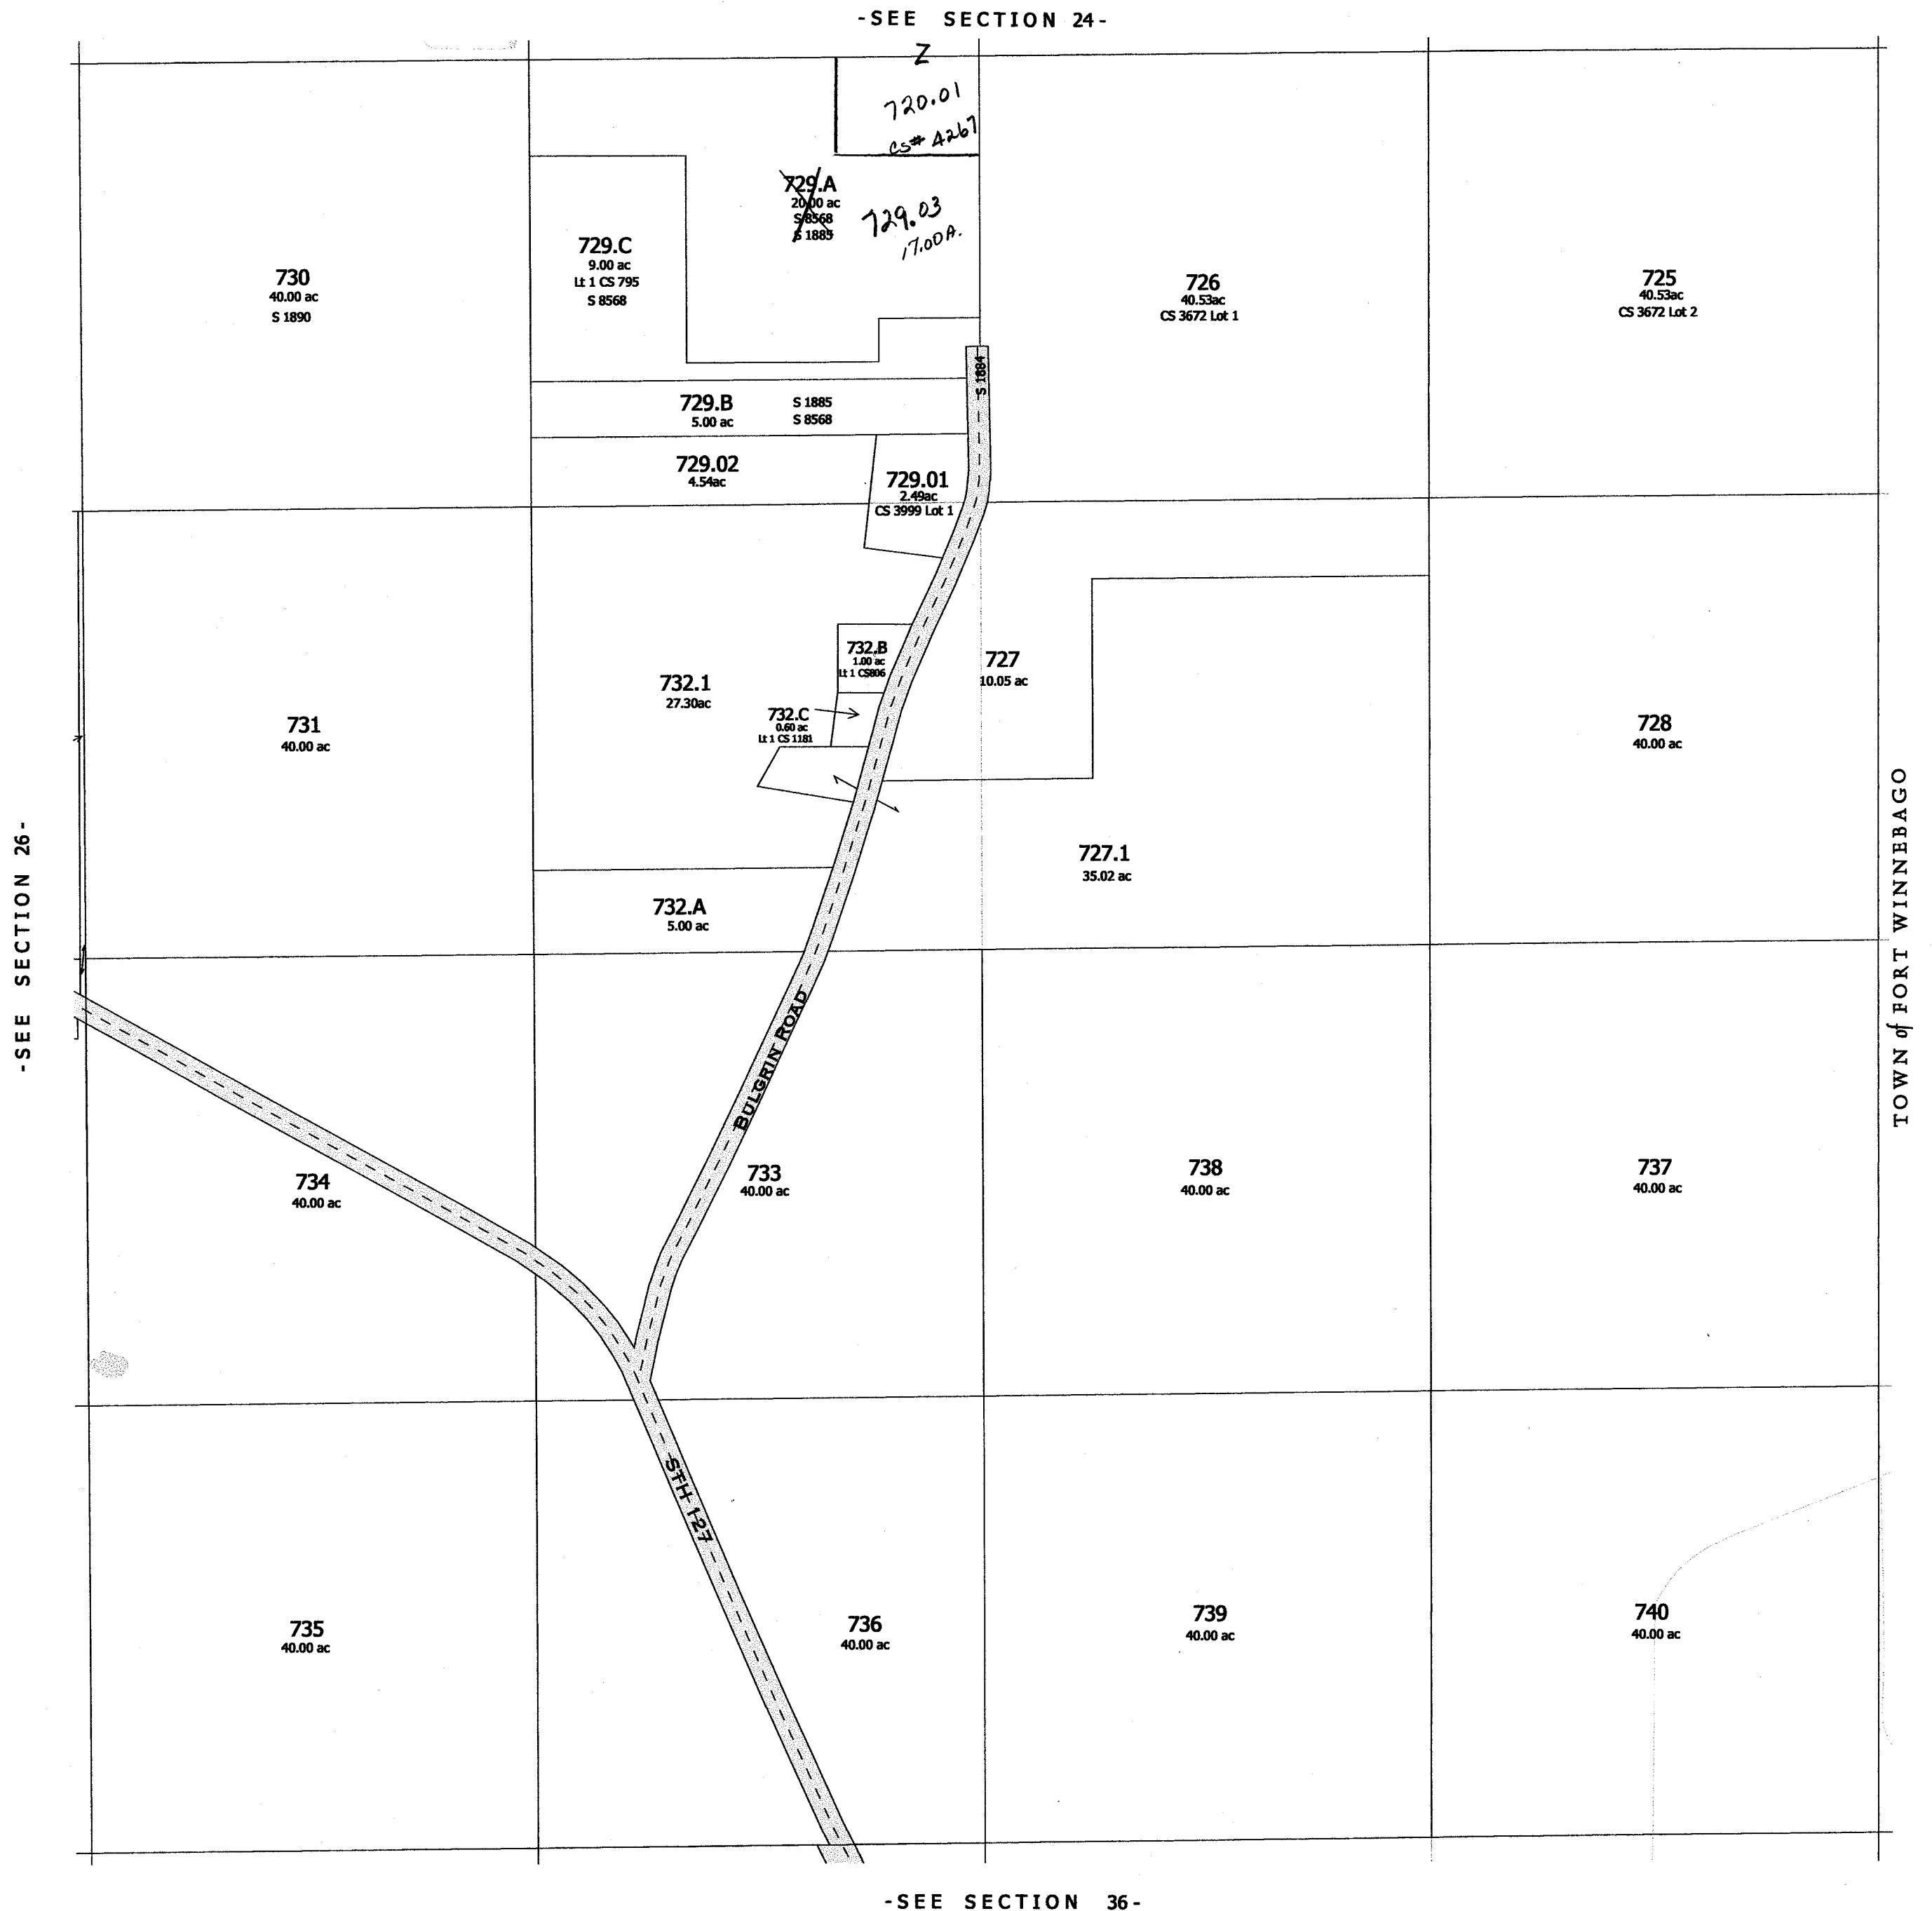

One Inch Equals Four Hundred Feet

MILES
0 1/16 1/8 1/4

FEET
0 400 800 1200 1600


NOTE: This map was prepared for assessment use in accordance with the Wis. St. Stat. Chap. 70.09. All information contained herein is advisory only. Map accuracy is limited to the quality of data obtained from other Public Records. This map is not intended to be a substitute for an actual field survey. Public Land Survey Base is derived from U.S.G.S Topographic maps unless otherwise noted. Other sources of the Land Base may be actual survey data. Base map data is from the April 1995 County Digital Orthophotos and/or U.S.G.S 1:24,000 scale Topographic series. The user is responsible for the improper use of the data contained herein.

Created by The Columbia County Land Information Office -GIS Section. VMB.
February 2005.

TAX PARCEL MAP

TOWN of LEWISTON


TOWN 13 NORTH RANGE 8 EAST
COLUMBIA COUNTY, WISCONSIN

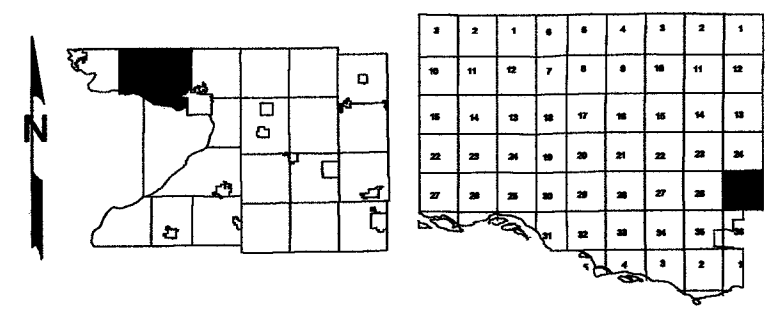

Replaced
2006



Replaced
2006

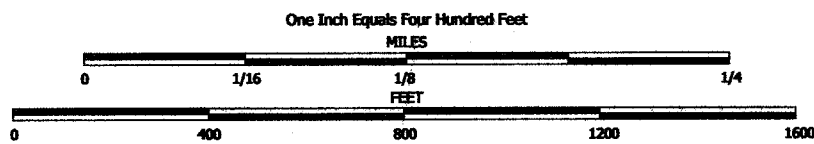



NOTE: This map was prepared for assessment use in accordance with the Wis. St. Stat. Chap. 70.09. All information contained herein is advisory only. Map accuracy is limited to the quality of data obtained from other Public Records. This map is not intended to be a substitute for an actual field survey. Public Land Survey Base is derived from U.S.G.S Topographic maps unless otherwise noted. Other sources of the Land Base may be actual survey data. Base map data is from the April 1995 County Digital Orthophotos and/or U.S.G.S. 1:24,000 scale Topographic series. The user is responsible for the improper use of the data contained herein.

Created by The Columbia County Land Information Office -GIS Section. VMB.
February 2006.


TAX PARCEL MAP

TOWN of LEWISTON

TOWN 13 NORTH RANGE 8 EAST
COLUMBIA COUNTY, WISCONSIN

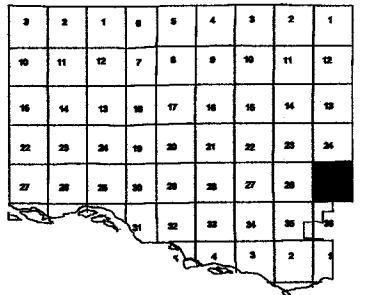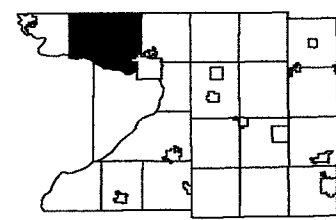

Replaced
2007

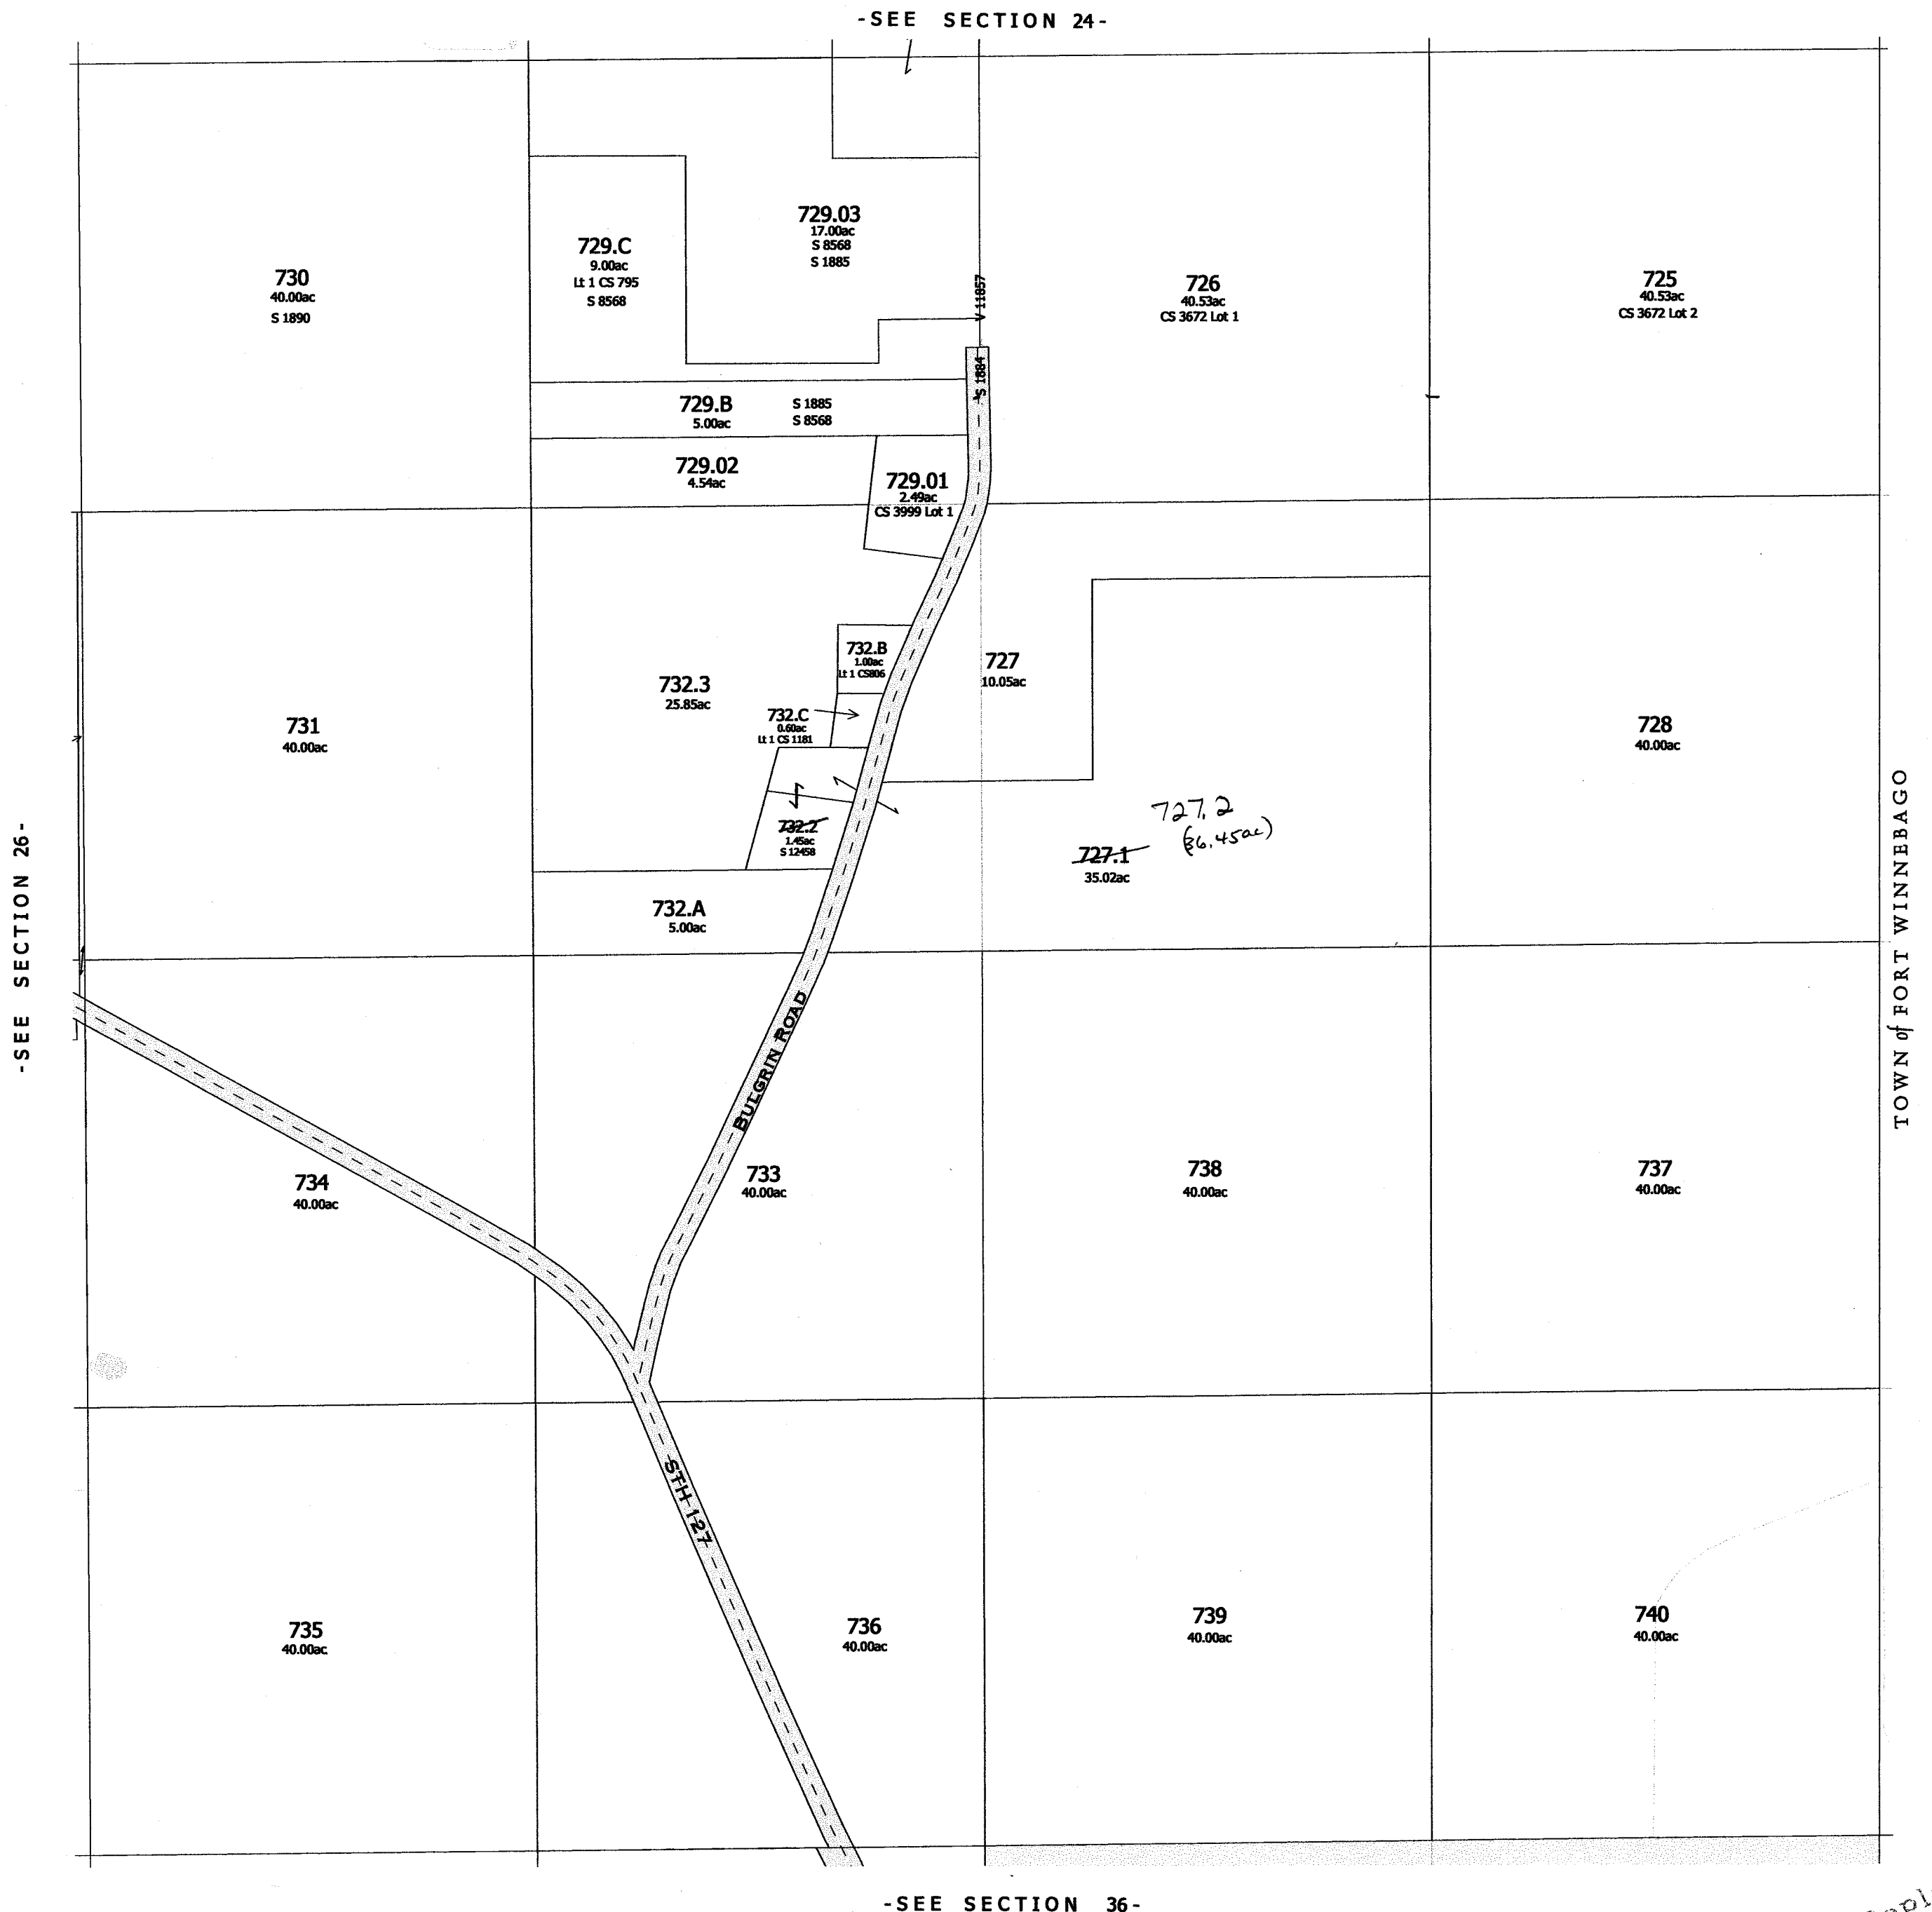


Replaced
2007

-SECTION 25-

LEWISTON
SEC. 26 T13N R8E


Replaced
2002

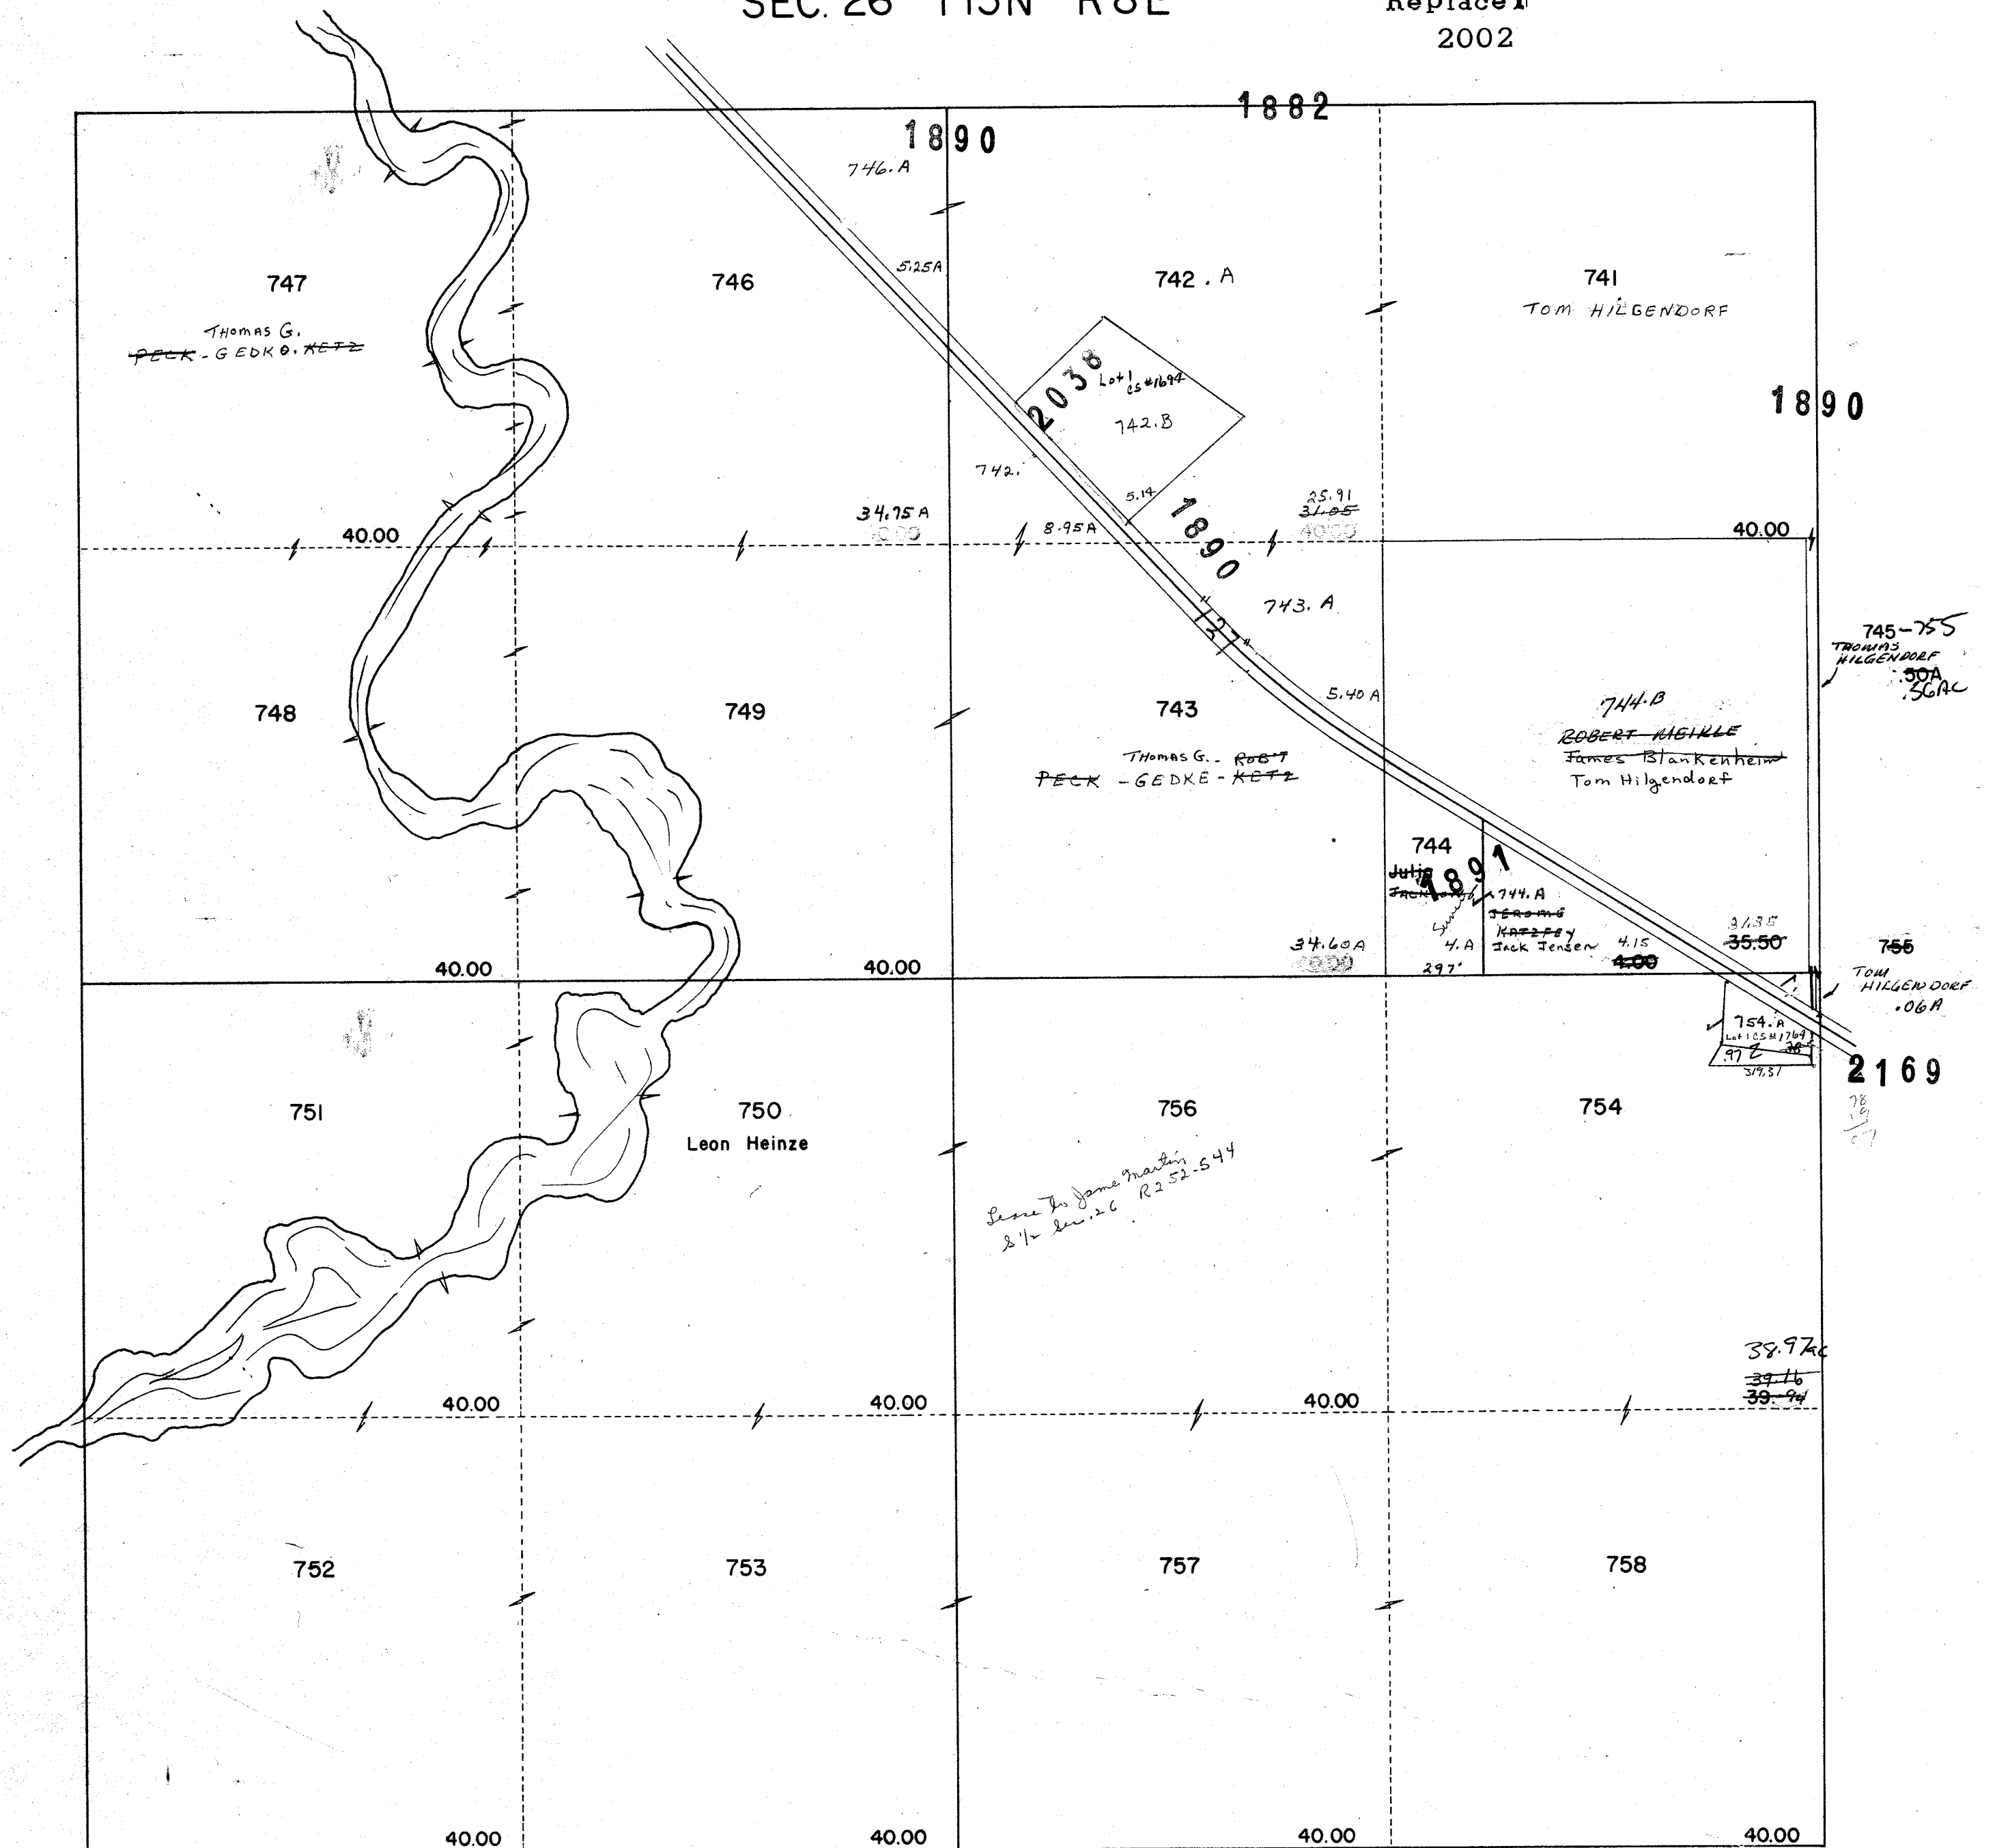


PROPERTY OF TAX LISTING DEPARTMENT

LEWISTON
SEC. 27 T13N R8E

Replaced
2002

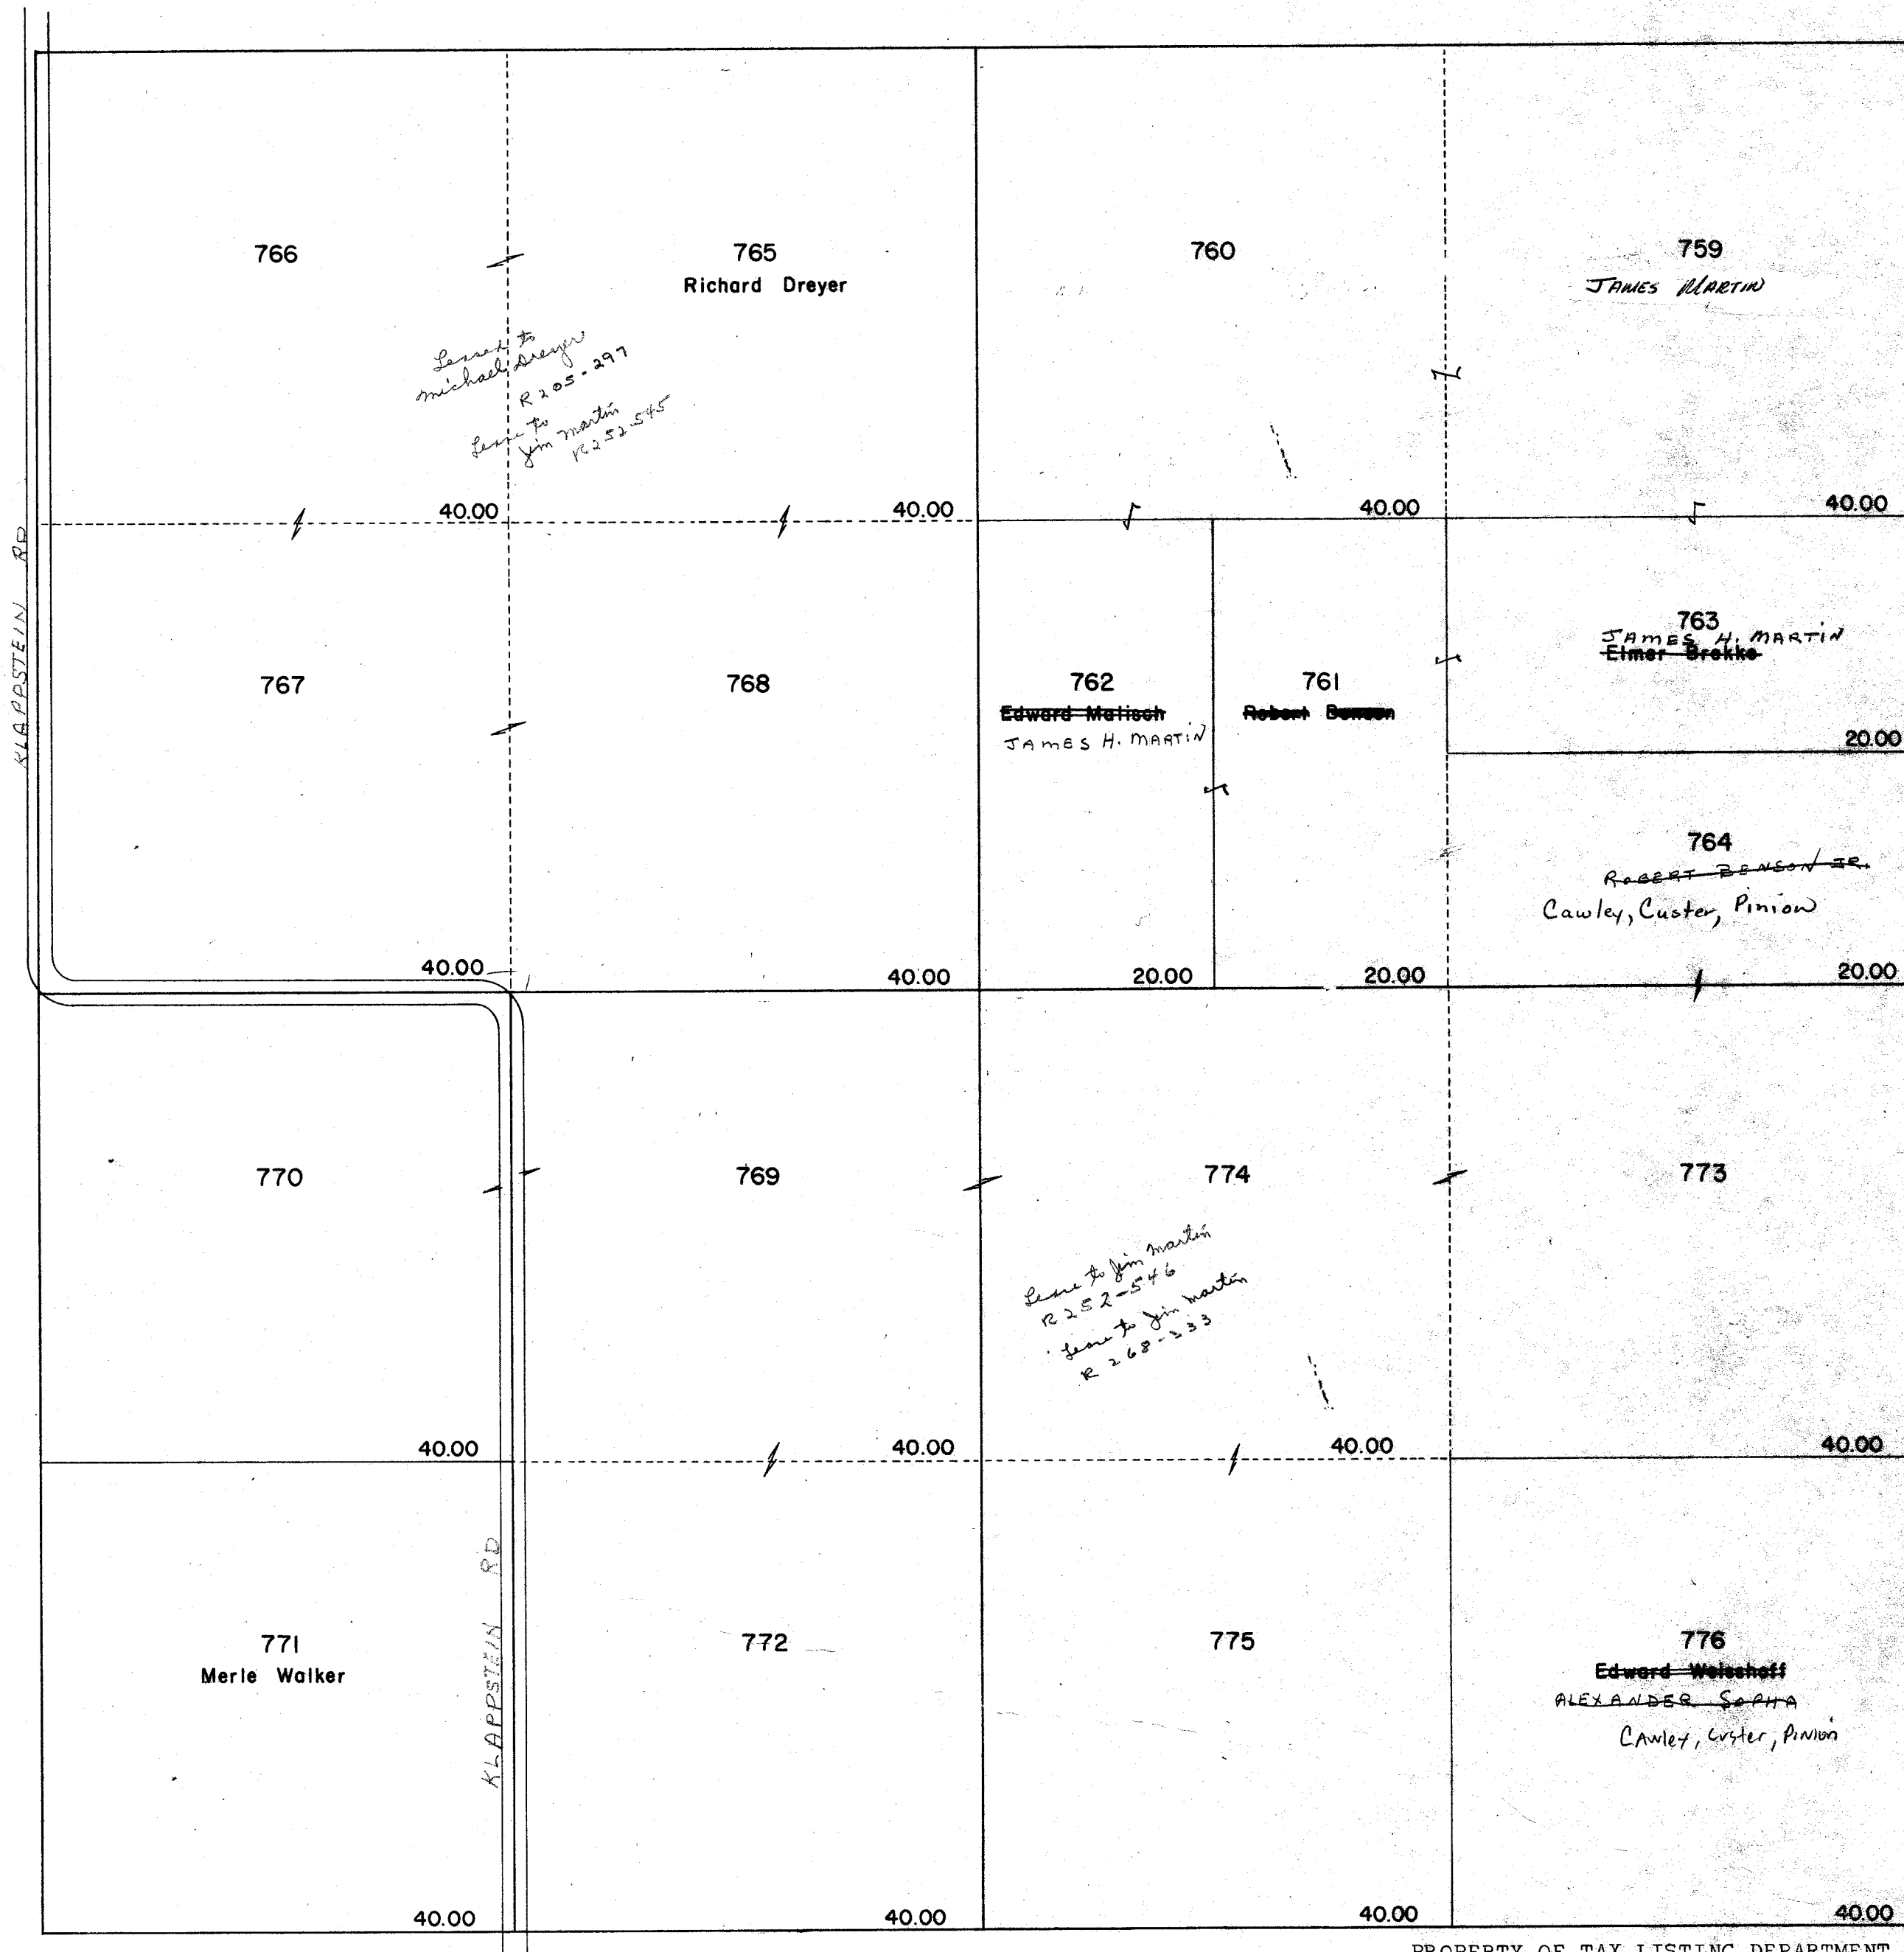

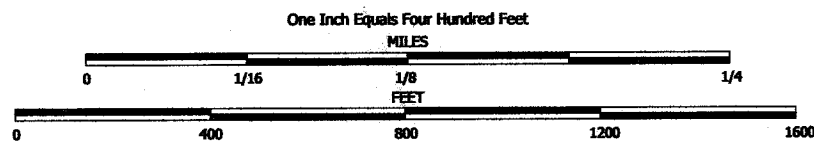


NOTE: This map was prepared for assessment use in accordance with the Wis. St. Stat. Chap. 70.09. All information contained herein is advisory only. Map accuracy is limited to the quality of data obtained from other Public Records. This map is not intended to be a substitute for an actual field survey. Public Land Survey Base is derived from U.S.G.S. Topographic maps unless otherwise noted. Other sources of the Land Base may be actual survey data. Base map data is from the April 1995 County Digital Orthophotos and/or U.S.G.S. 1:24,000 scale Topographic series. The user is responsible for the improper use of the data contained herein.

Created by The Columbia County Land Information Office -GIS Section. VMB.
September 2002.

TAX PARCEL MAP

TOWN of LEWISTON

TOWN 13 NORTH RANGE 8 EAST
COLUMBIA COUNTY, WISCONSIN

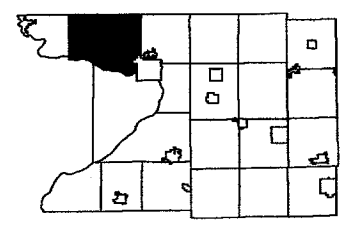

3	2	1	8	5	4	3	2	1
10	11	12	7	6	5	10	11	12
15	14	13	16	17	18	15	14	13
20	21	22	19	20	21	22	23	24
27	28	29	30	31	32	33	34	35

Replaced
2005

-SEE SECTION 22-




-SEE SECTION 34-

2005
-SECTION 27-


LEWISTON
SEC. 28 T13N R8E

Replaced
2 02

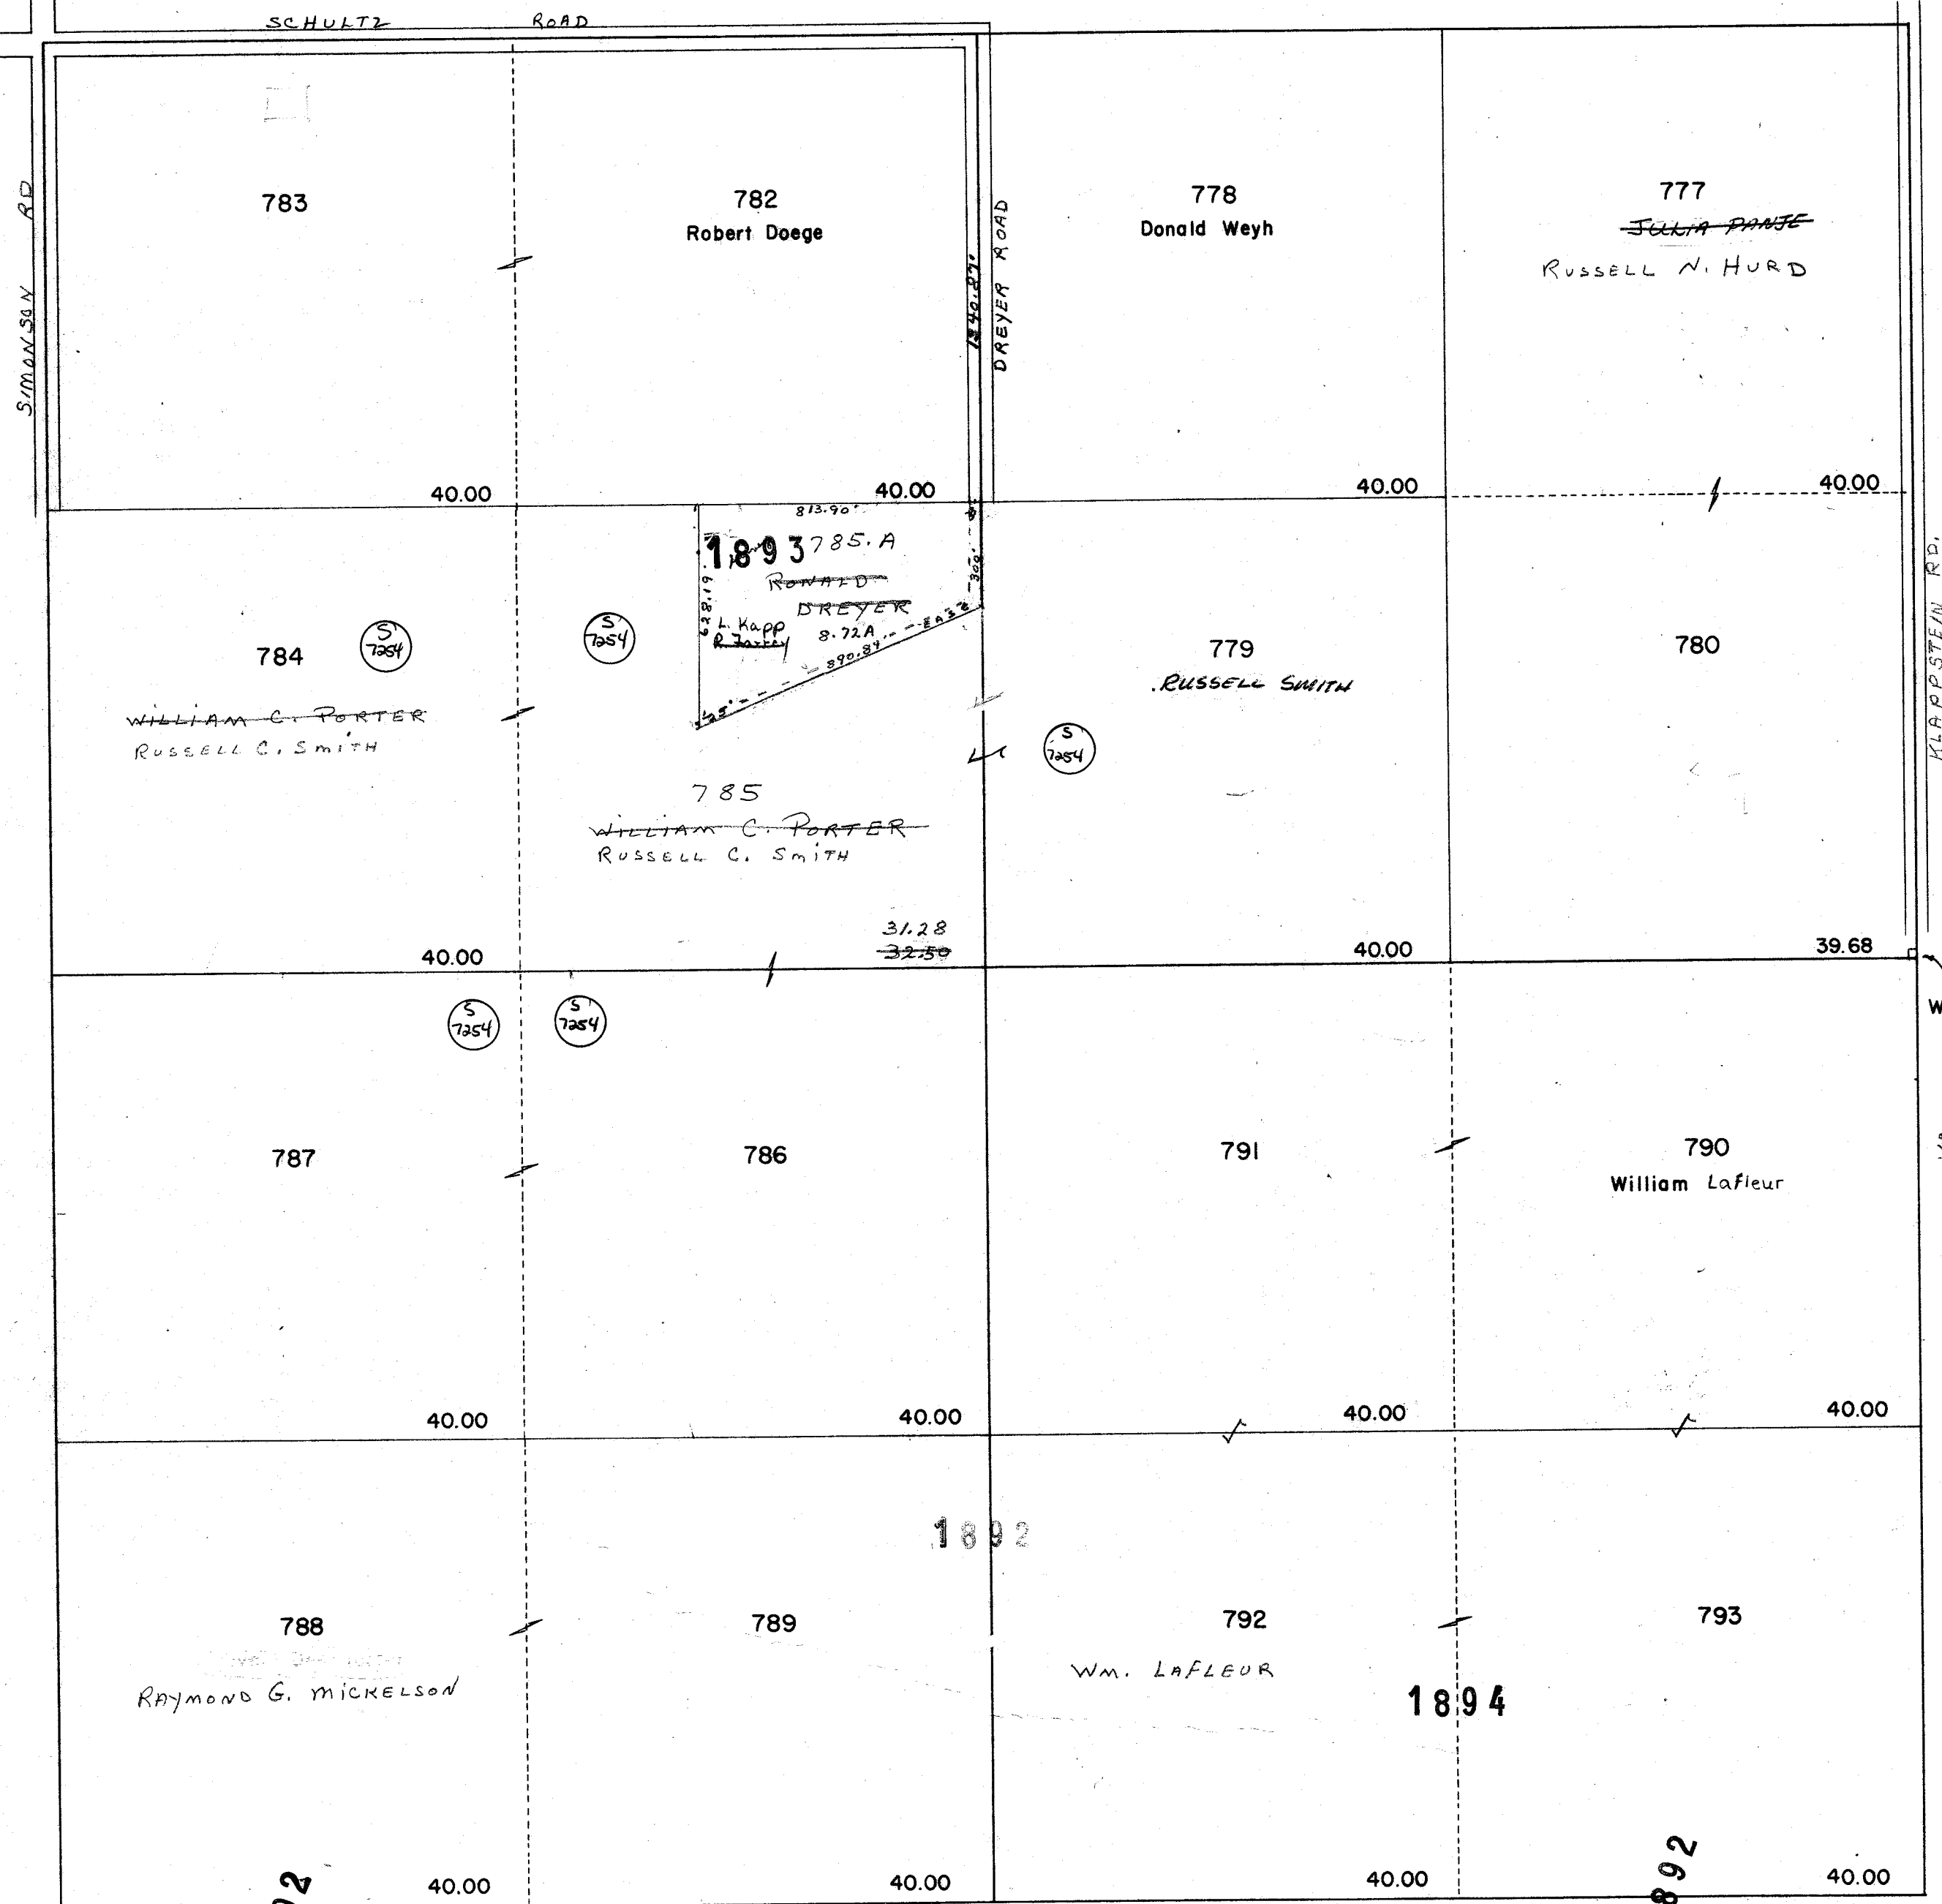

SURVEY

PROPERTY OF TAX LISTING DEPARTMENT

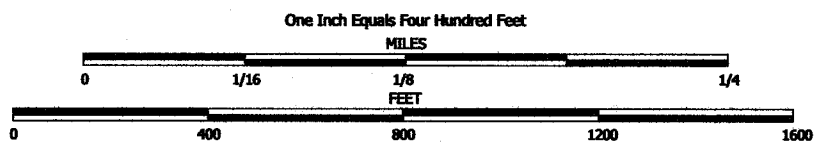


NOTE: This map was prepared for assessment use in accordance with the Wis. St. Stat. Chap. 70.09. All information contained herein is advisory only. Map accuracy is limited to the quality of data obtained from other Public Records. This map is not intended to be a substitute for an actual field survey. Public Land Survey Base is derived from U.S.G.S. Topographic maps unless otherwise noted. Other sources of the Land Base may be actual survey data. Base map data is from the April 1995 County Digital Orthophotos and/or U.S.G.S. 1:24,000 scale Topographic series. The user is responsible for the improper use of the data contained herein.

Created by The Columbia County Land Information Office -GIS Section. VMB.
September 2002.

TAX PARCEL MAP

TOWN of LEWISTON

TOWN 13 NORTH RANGE 8 EAST
COLUMBIA COUNTY, WISCONSIN

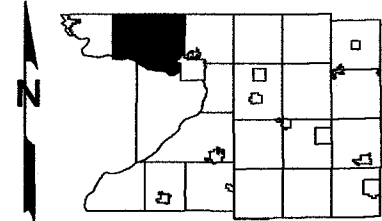

3	2	1	6	5	4	3	2	1
10	11	12	7	8	9	10	11	12
15	14	13	18	17	16	15	14	13
20	21	22	19	20	21	22	23	24
25	26	27	28	29	30	31	32	33
34	35	36	37	38	39	40	41	42
43	44	45	46	47	48	49	50	51
52	53	54	55	56	57	58	59	60

Replaced
2005

-SEE SECTION 21-




-SEE SECTION 33-

-SECTION 28-

2005


LEWISTON
SEC. 29 T13N R8E

Replaced
2002

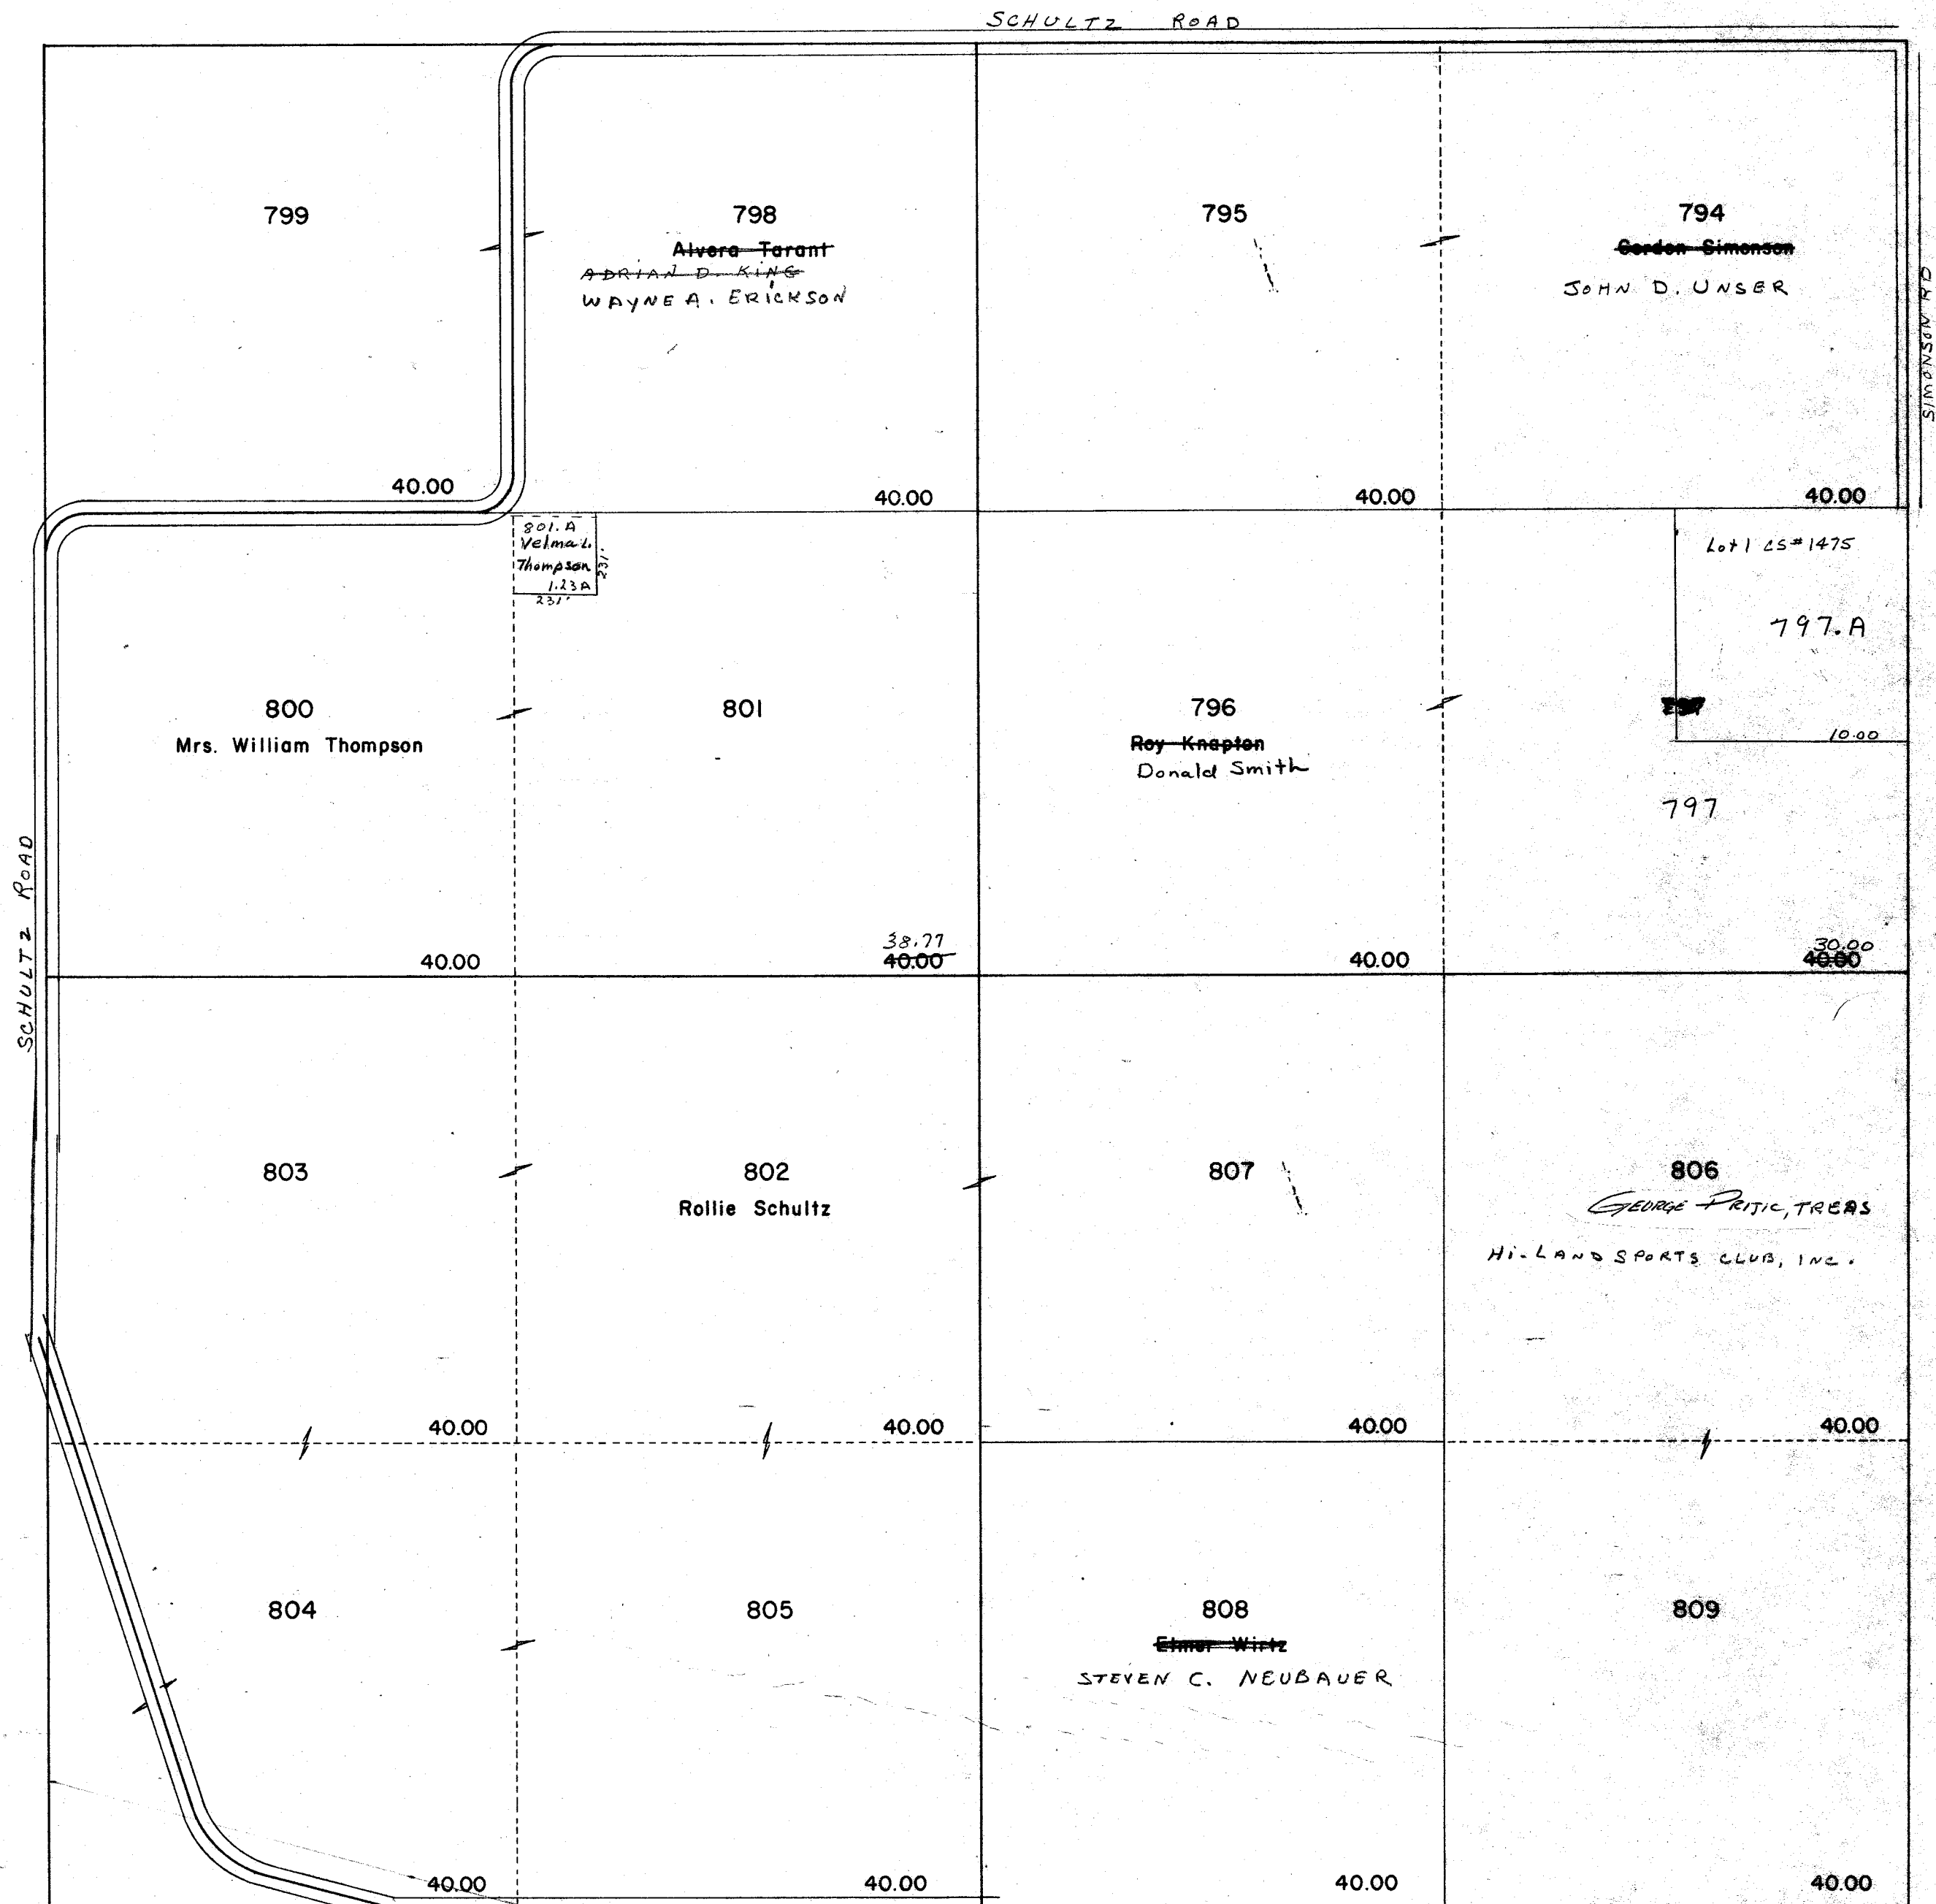


PROPERTY OF TAX LISTING DEPARTMENT


Replaced
2002

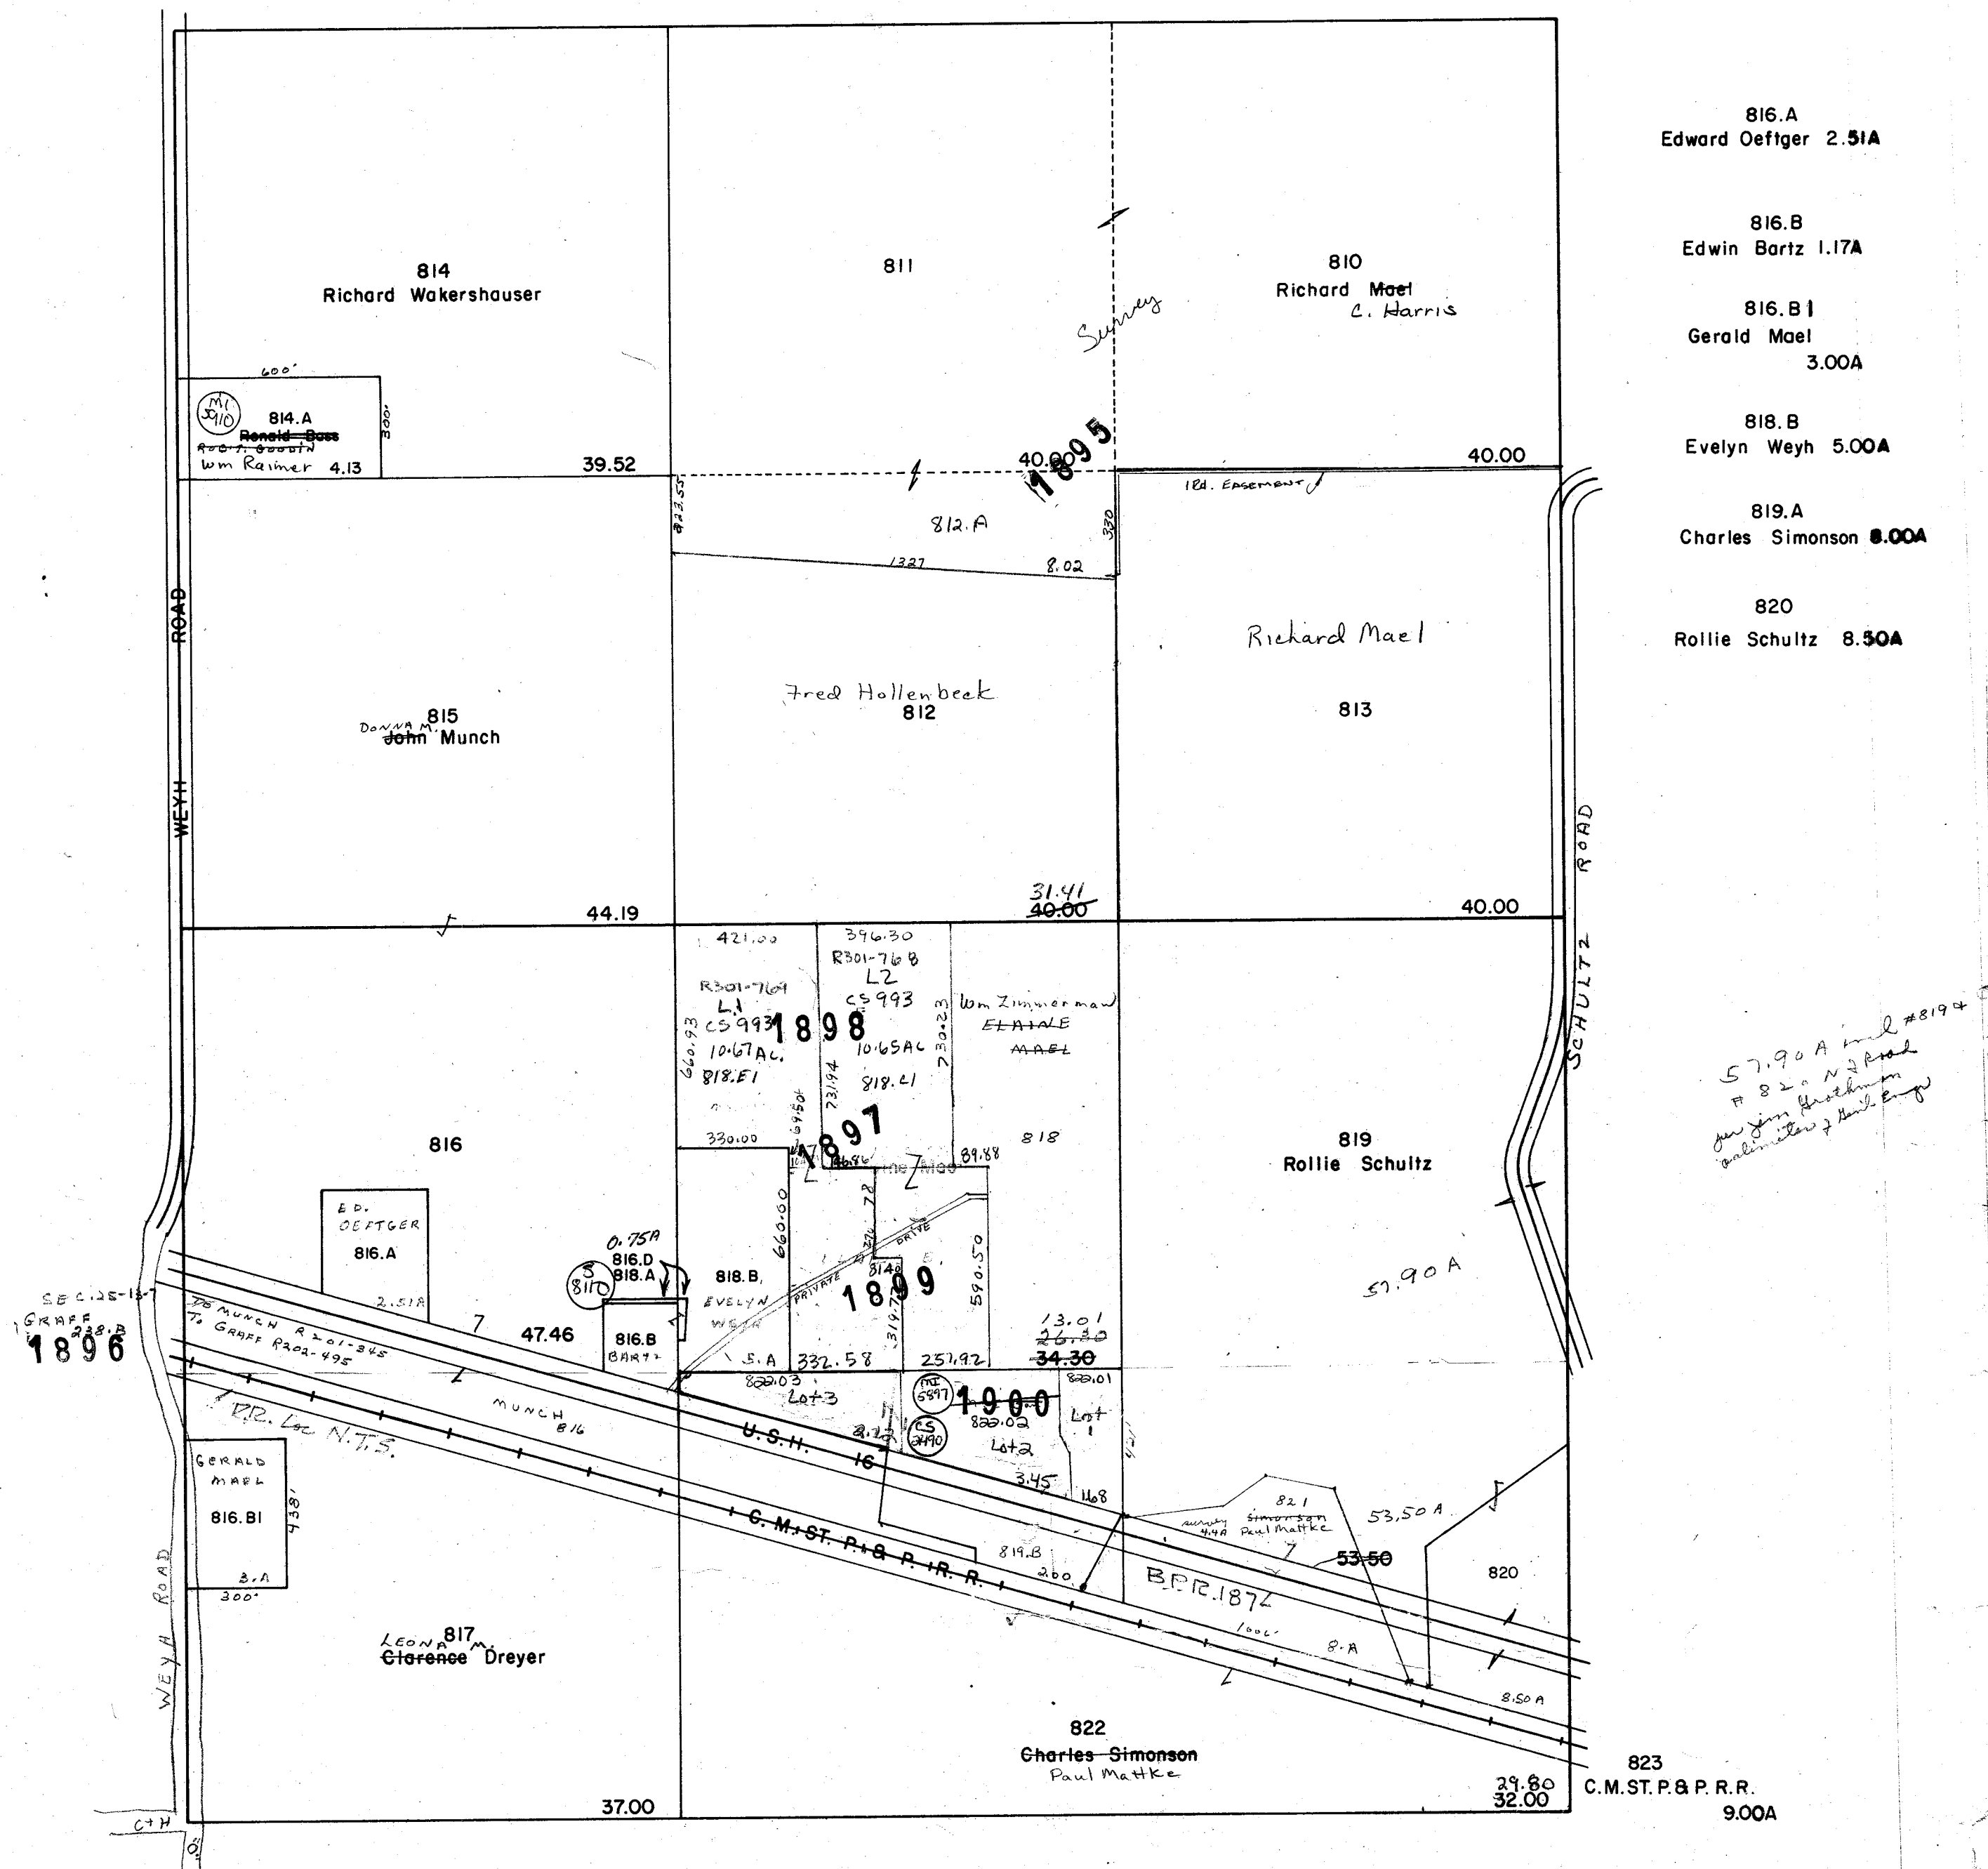

LEWISTON
SEC. 31 T13N R8E

Replaced
2002

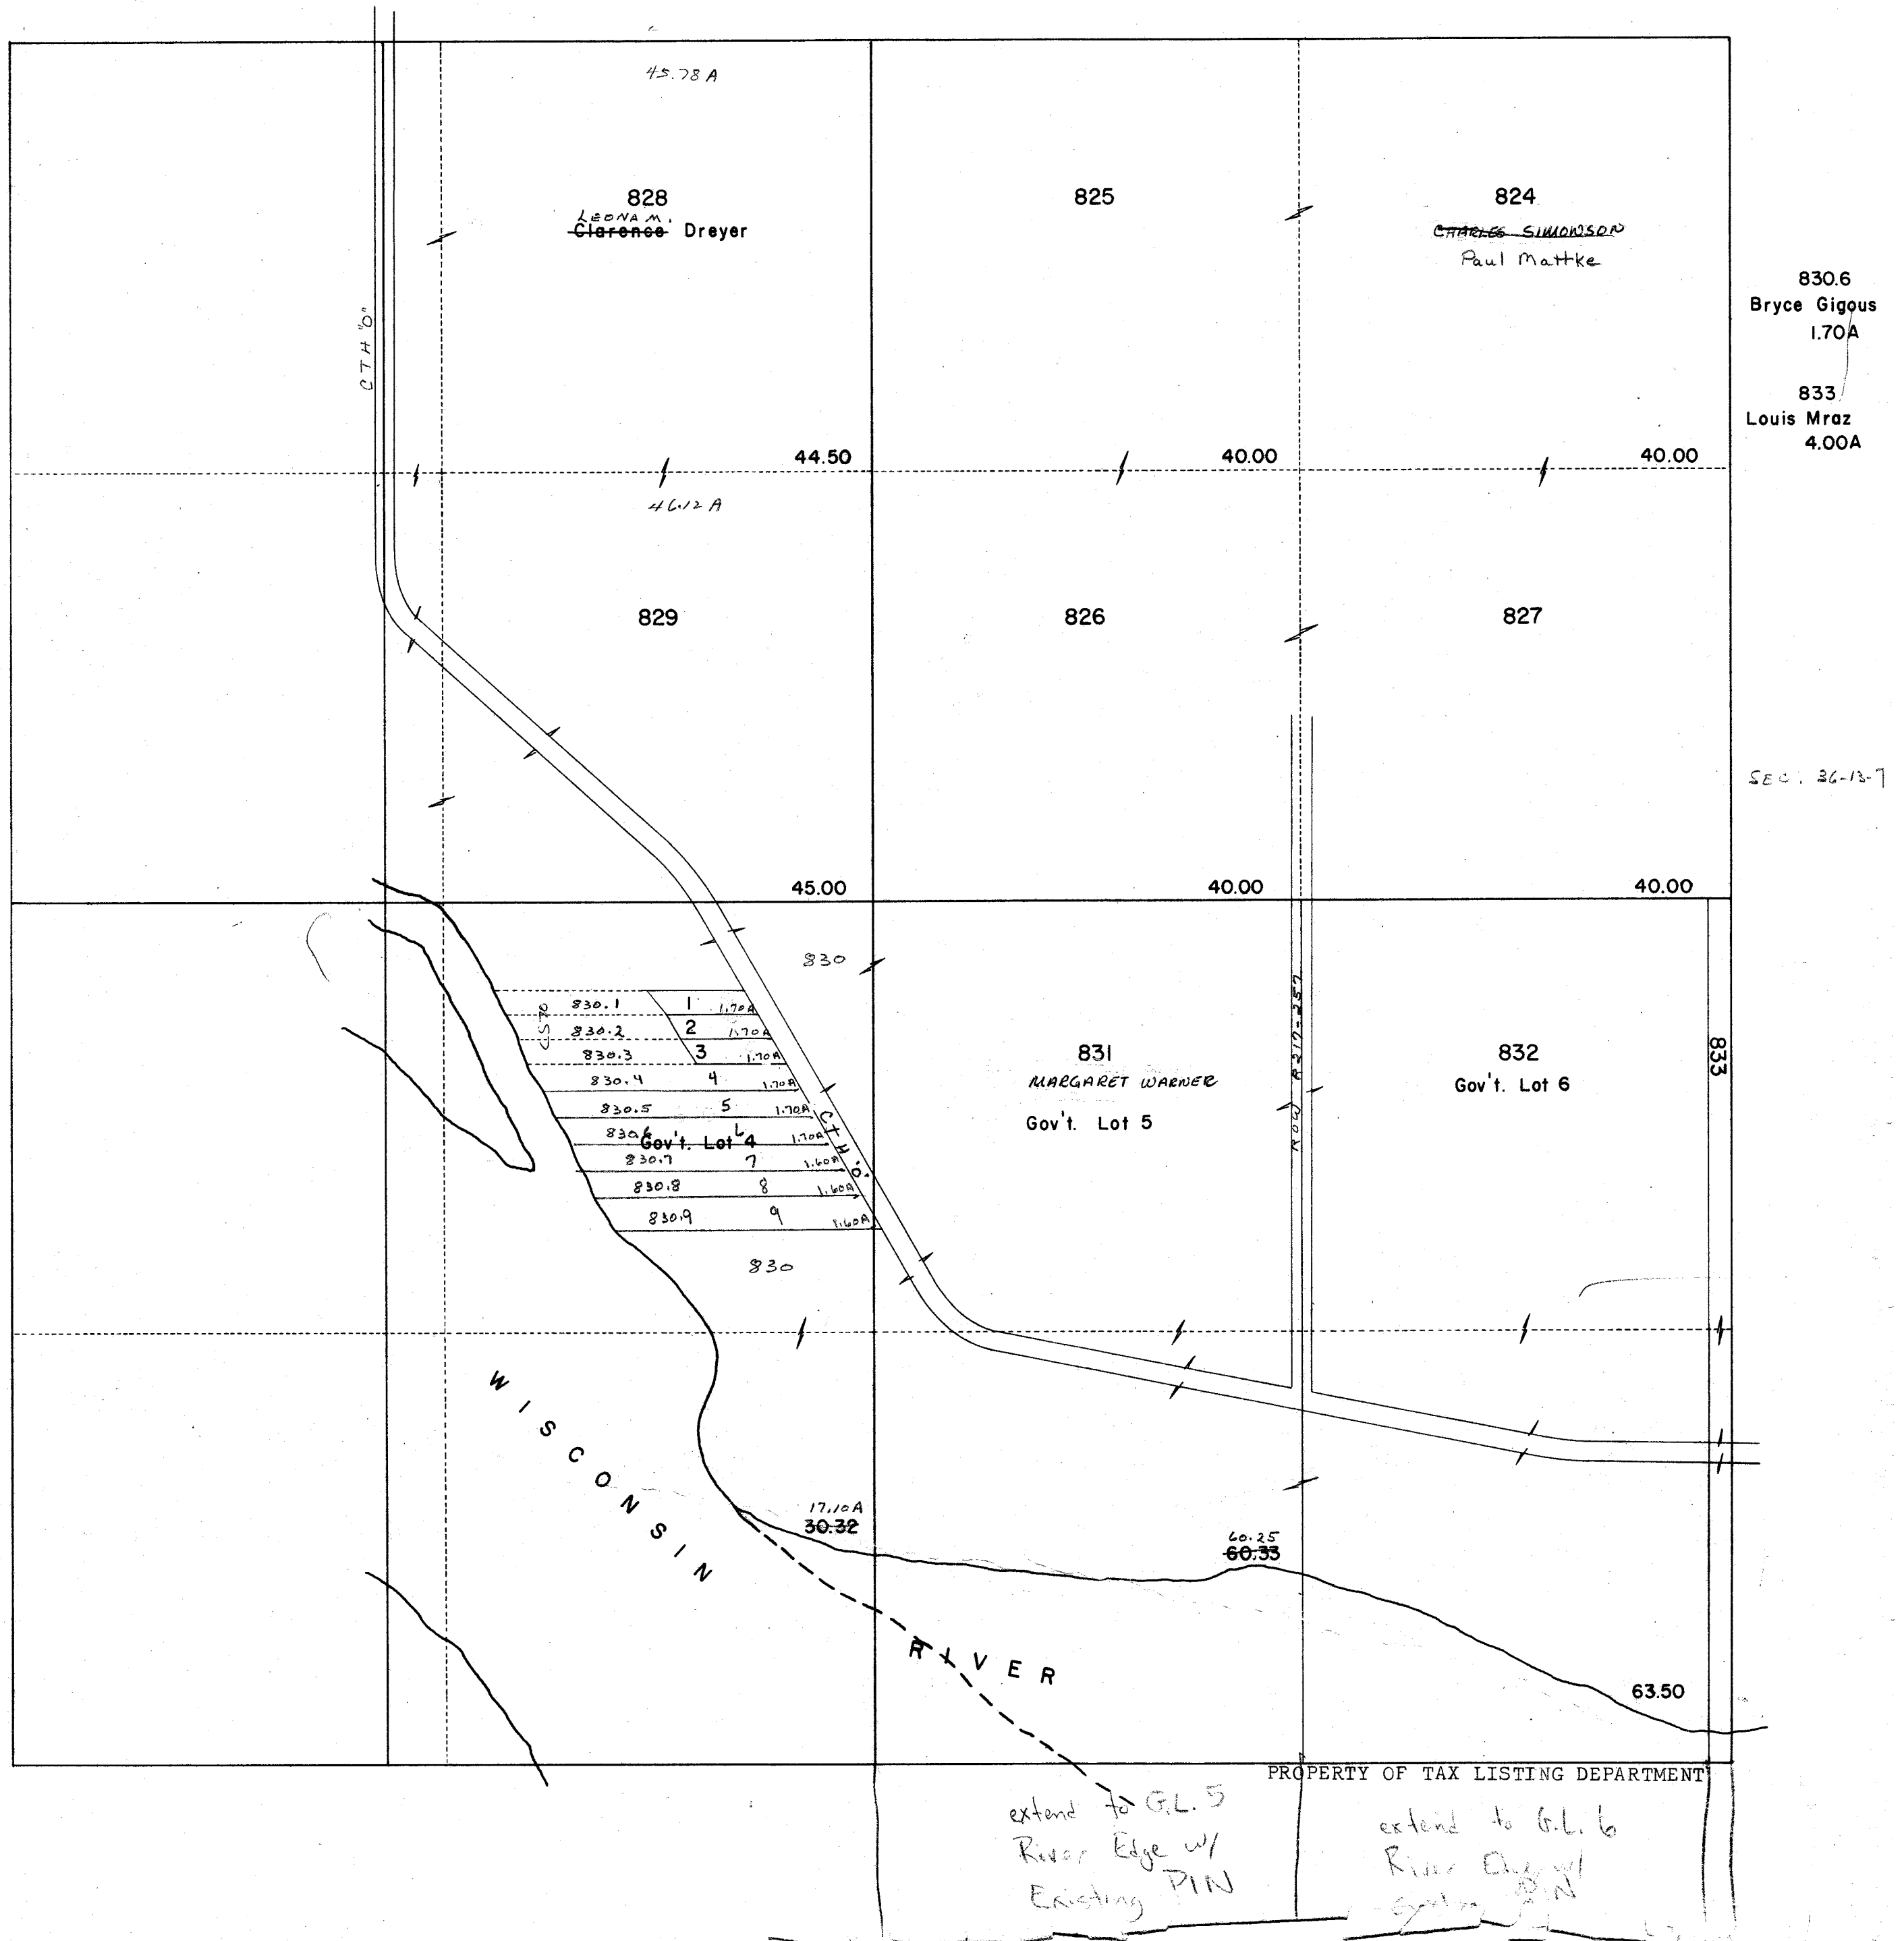

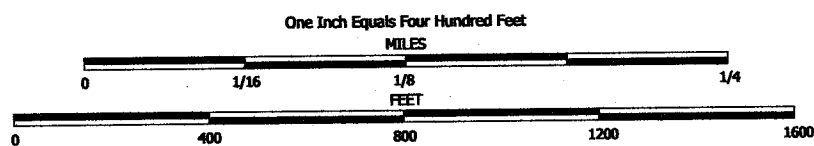



NOTE: This map was prepared for assessment use in accordance with the Wis. Stat. Chap. 70.09. All information contained herein is advisory only. Map accuracy is limited to the quality of data obtained from other Public Records. This map is not intended to be a substitute for an actual field survey. Public Land Survey Base is derived from U.S.G.S. Topographic maps unless otherwise noted. Other sources of the Land Base may be actual survey data. Base map data is from the April 1995 County Digital Orthophotos and/or U.S.G.S. 1:24,000 scale Topographic series. The user is responsible for the improper use of the data contained herein.

Created by The Columbia County Land Information Office -GIS Section. VMB.
September 2002.

TAX PARCEL MAP

TOWN of LEWISTON

TOWN 13 NORTH RANGE 8 EAST
COLUMBIA COUNTY, WISCONSIN

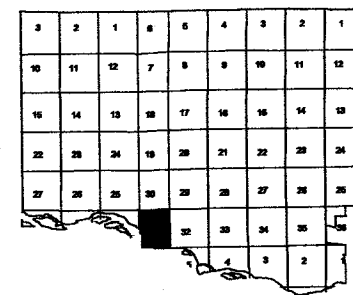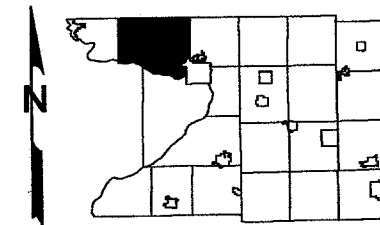

Replaced
2004

-SEE SECTION 30-

-SEE SECTION 36 T13N R7E-

-SEE SECTION 32-



TOWN of CALEDONIA

844.01 2.75 ac 41CS4096


replaced 2004

-SECTION 31-

LEWISTON

SEC. 32 T13N R8E

Replaced
2002

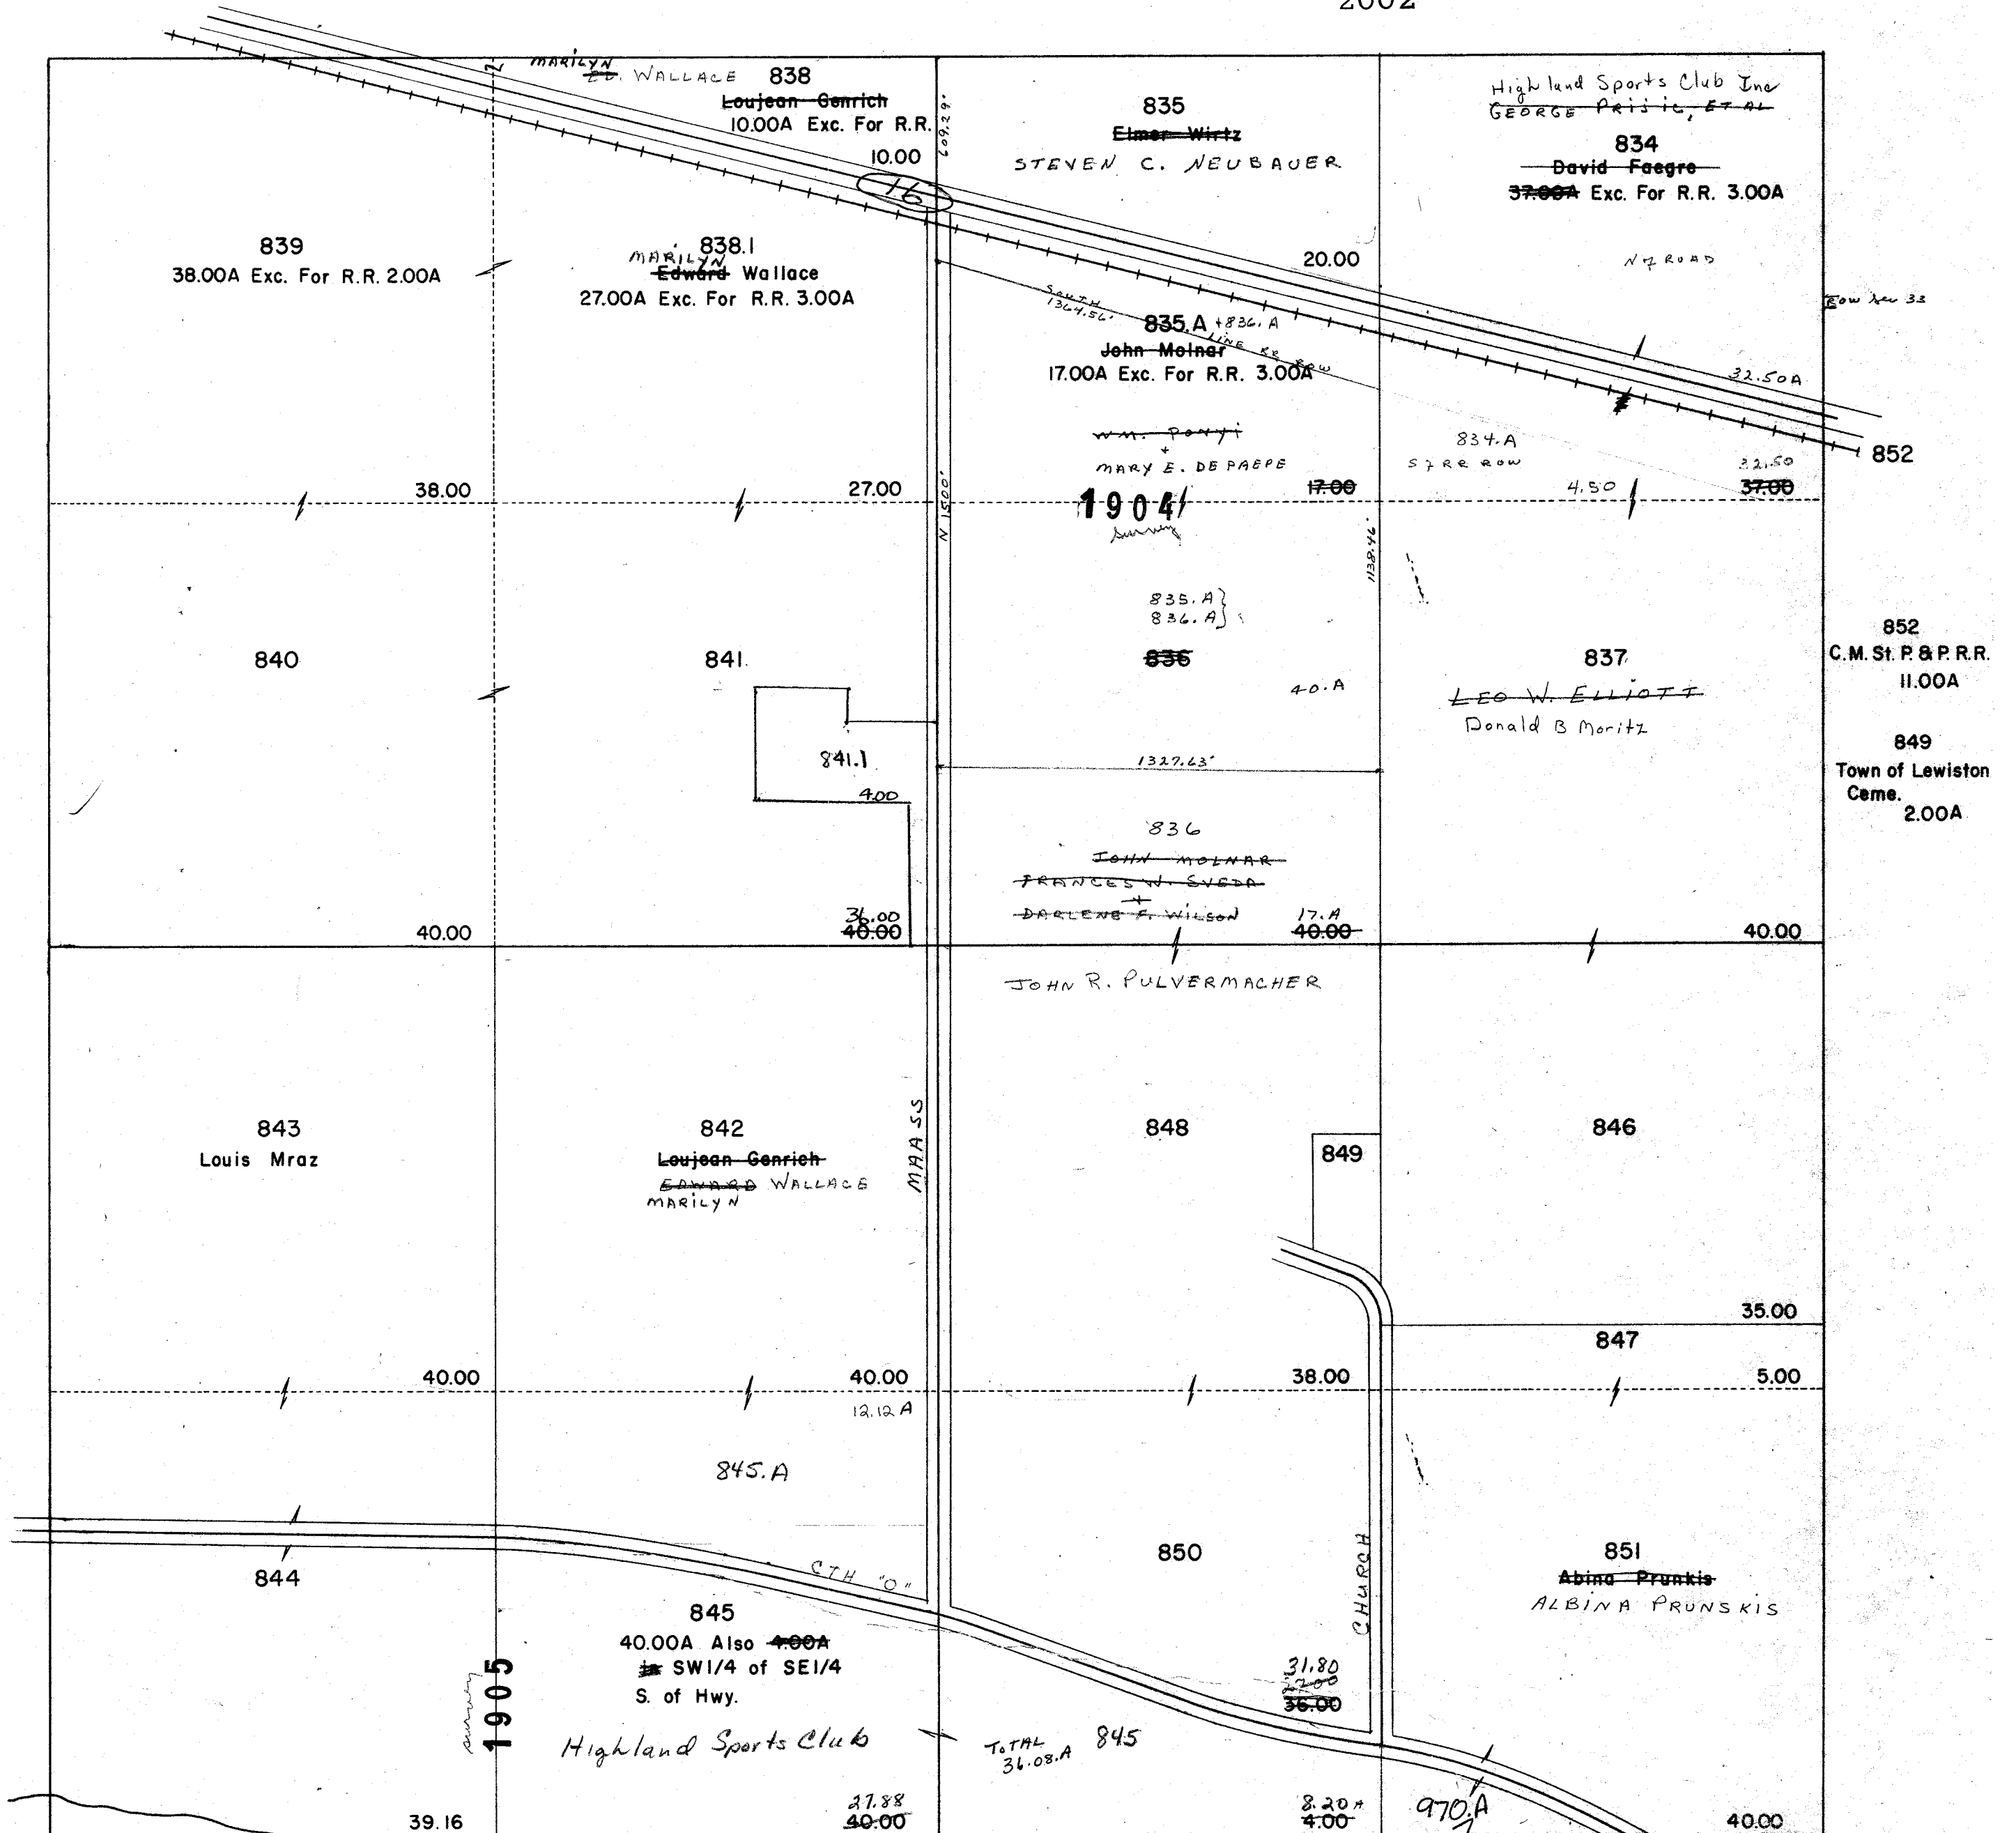


PROPERTY OF TAX LISTING DEPARTMENT

If this parcel is on it
according to R231-120
it belongs to T.J. Benay from legal
none.

On #851 - R32-13-8 it says
Prunkis et al


845 } acreage change
845.A } with platonic used
850 } 3/18/88 Y13.

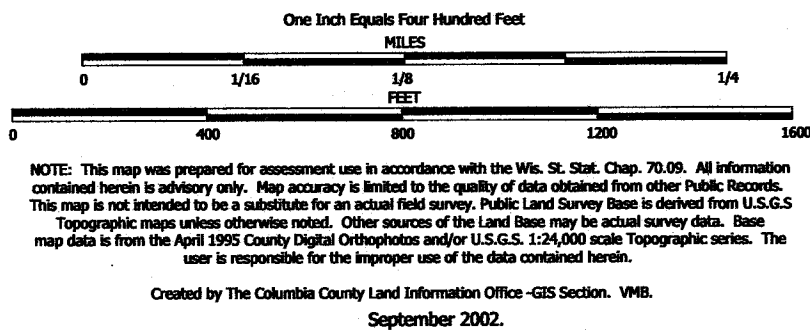

TAX PARCEL MAP


TOWN of LEWISTON

TOWN 13 NORTH RANGE 8 EAST
COLUMBIA COUNTY, WISCONSIN

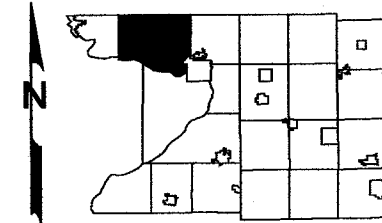


1	2	3	4	5	6	7	8	9	10	11	12
13	14	15	16	17	18	19	20	21	22	23	24
25	26	27	28	29	30	31	32	33	34	35	36
37	38	39	40	41	42	43	44	45	46	47	48
49	50	51	52	53	54	55	56	57	58	59	60
61	62	63	64	65	66	67	68	69	70	71	72
73	74	75	76	77	78	79	80	81	82	83	84
85	86	87	88	89	90	91	92	93	94	95	96
97	98	99	100	101	102	103	104	105	106	107	108
109	110	111	112	113	114	115	116	117	118	119	120

Replaced
2004

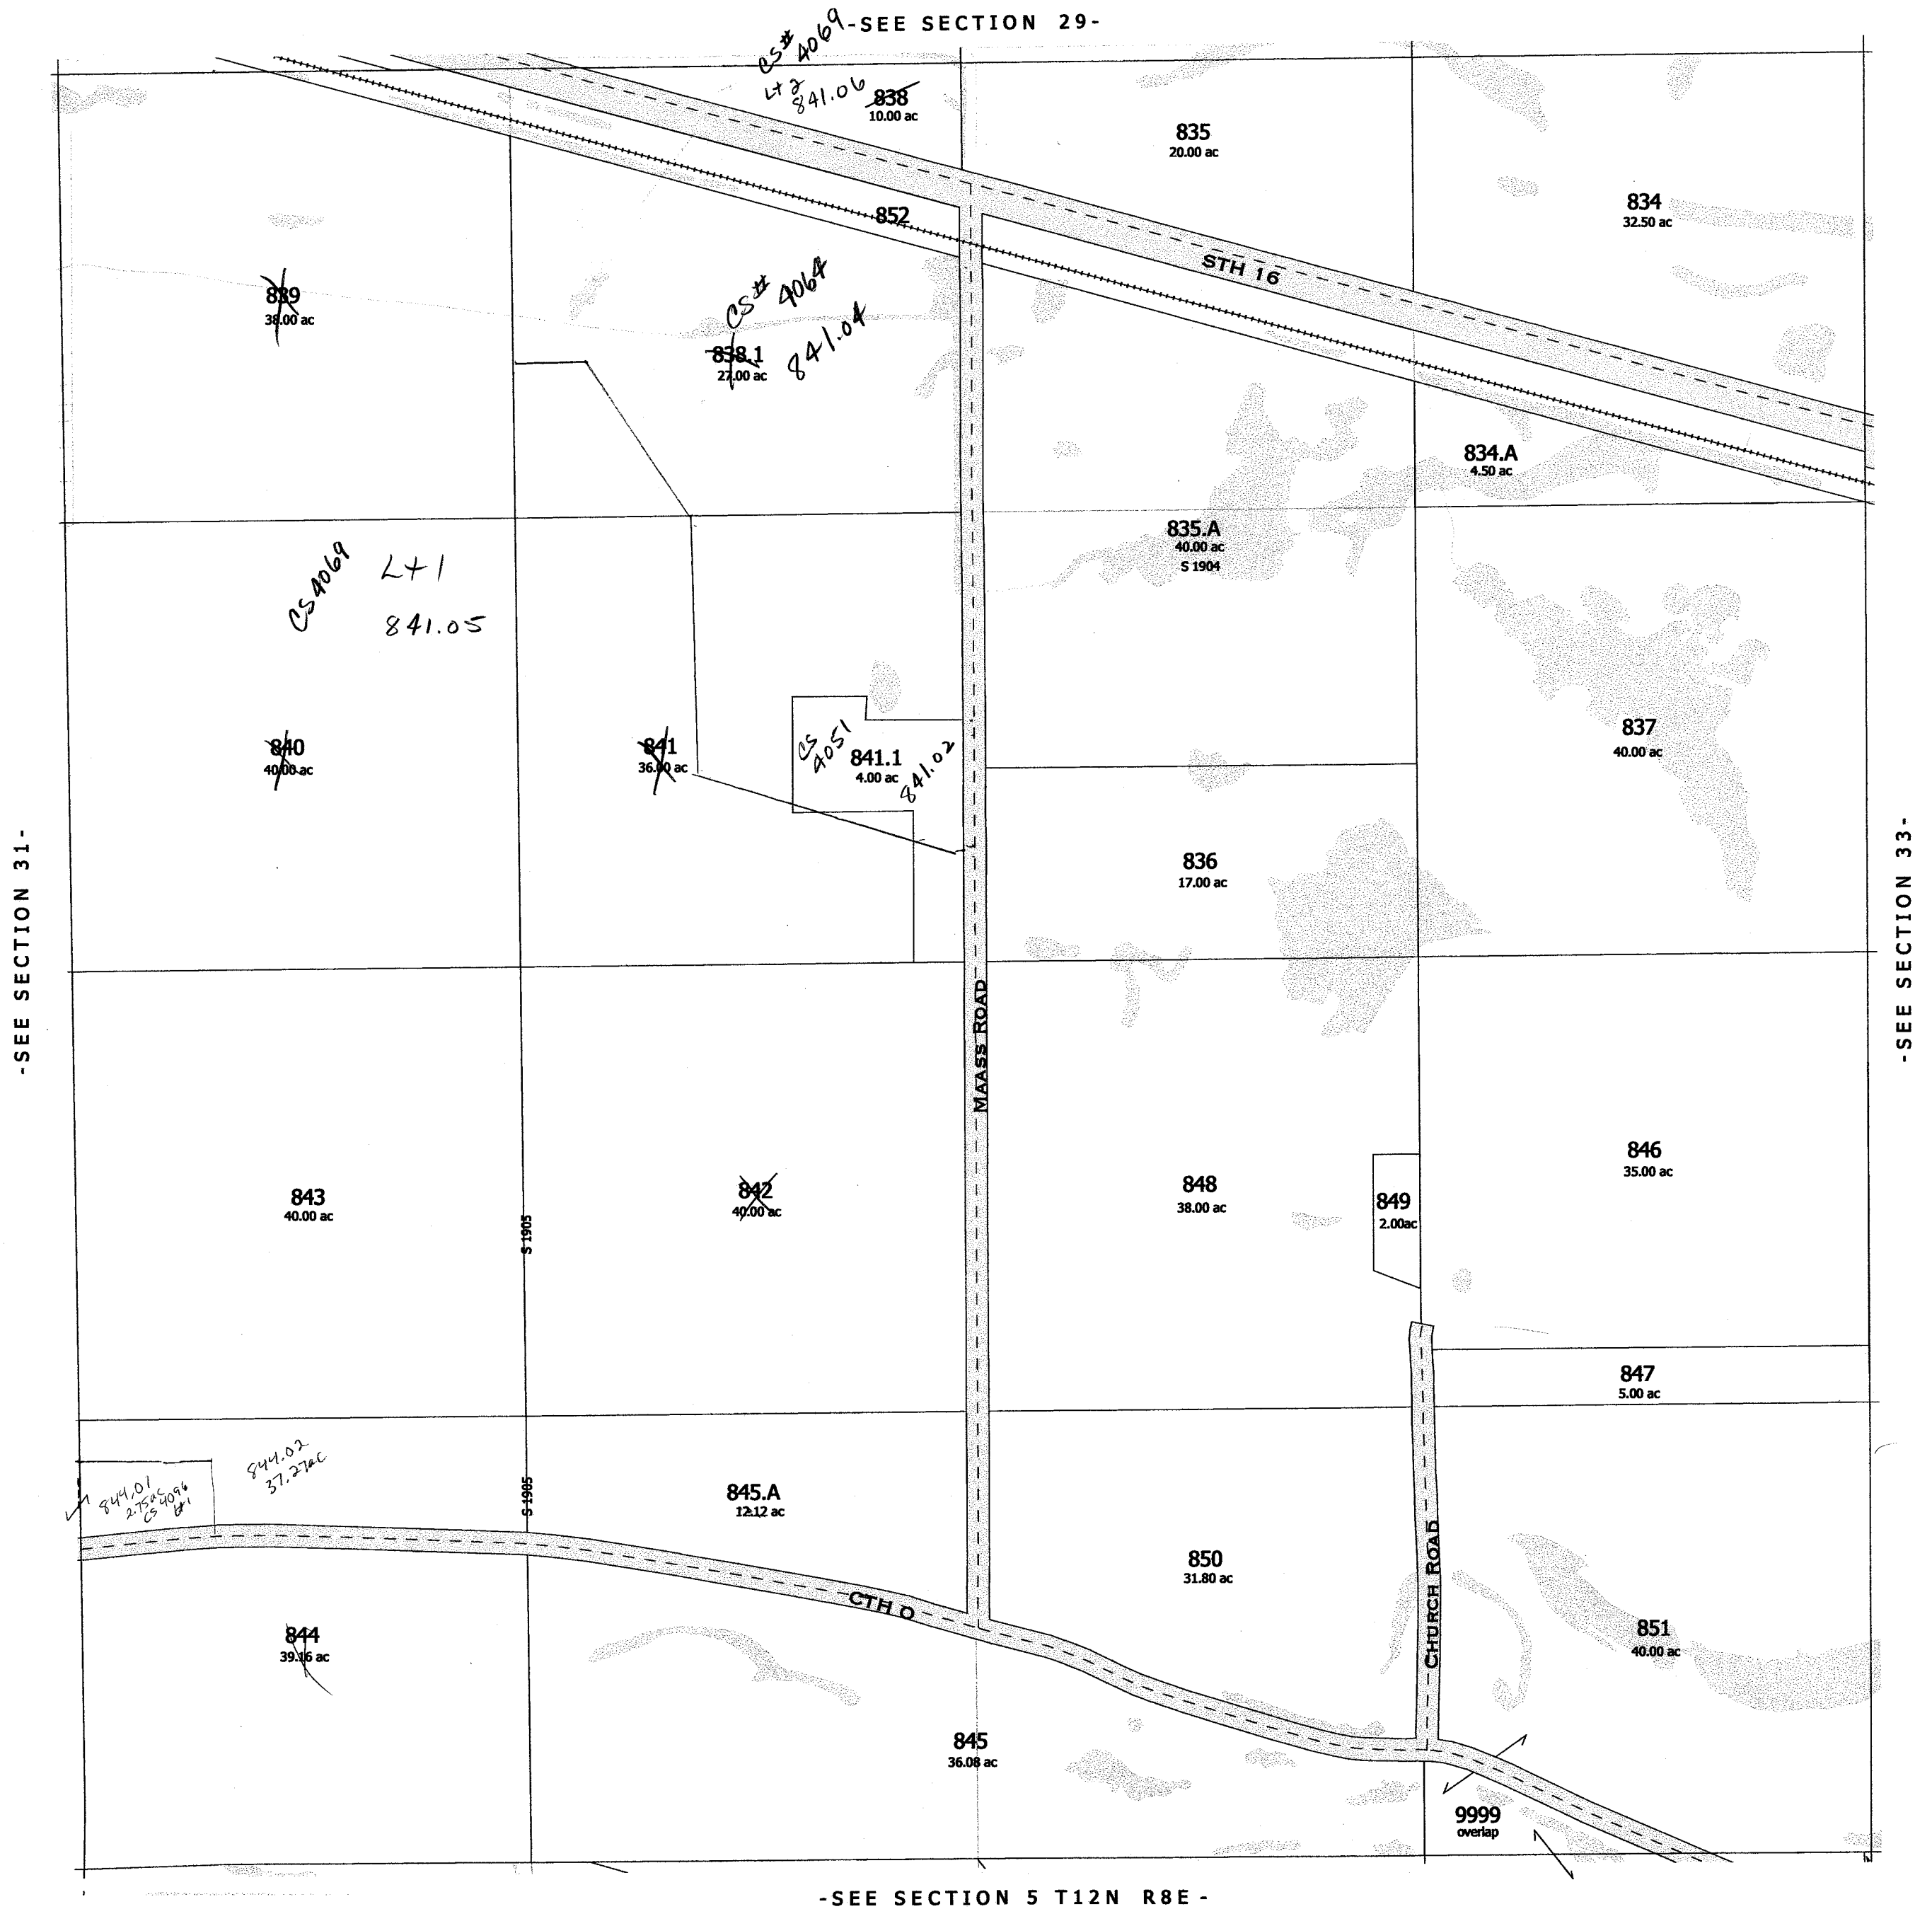

-SEE SECTION 5 T12N R8E-

Replaced 2004
-SECTION 32-

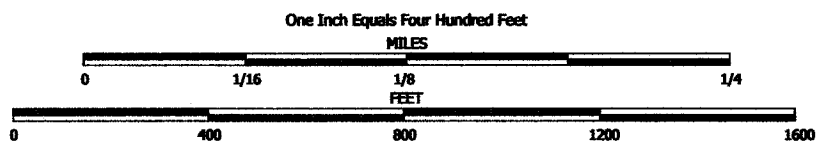


NOTE: This map was prepared for assessment use in accordance with the Wis. St. Stat. Chap. 70.09. All information contained herein is advisory only. Map accuracy is limited to the quality of data obtained from other Public Records. This map is not intended to be a substitute for an actual field survey. Public Land Survey Base is derived from U.S.G.S. Topographic maps unless otherwise noted. Other sources of the Land Base may be actual survey data. Base map data is from the April 1995 County Digital Orthophotos and/or U.S.G.S. 1:24,000 scale Topographic series. The user is responsible for the improper use of the data contained herein.

Created by The Columbia County Land Information Office -GIS Section. VMB.
February 2006.

TAX PARCEL MAP

TOWN of LEWISTON

TOWN 13 NORTH RANGE 8 EAST
COLUMBIA COUNTY, WISCONSIN

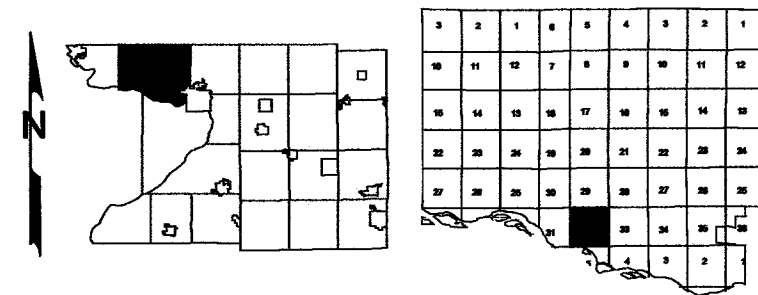

Replaced
2007

-SEE SECTION 29-



-SEE SECTION 5 T12N R8E -

Replaced
2007

-SECTION 32-

One Inch Equals Four Hundred Feet

0 1/16 1/8 1/4
0 400 800 1200 1600
MILES
FEET


NOTE: This map was prepared for assessment use in accordance with the Wis. St. Stat. Chap. 70.09. All information contained herein is advisory only. Map accuracy is limited to the quality of data obtained from other Public Records. This map is not intended to be a substitute for an actual field survey. Public Land Survey Base is derived from U.S.G.S. Topographic maps unless otherwise noted. Other sources of the Land Base may be actual survey data. Base map data is from the April 1995 County Digital Orthophotos and/or U.S.G.S. 1:24,000 scale Topographic series. The user is responsible for the improper use of the data contained herein.

Created by The Columbia County Land Information Office -GIS Section- VMB.
March 2004.

TAX PARCEL MAP

TOWN of LEWISTON

TOWN 13 NORTH RANGE 8 EAST
COLUMBIA COUNTY, WISCONSIN

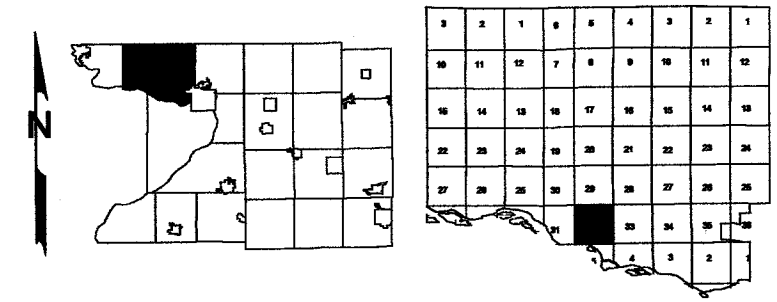

Replaced
2007

-SEE SECTION 29-



-SEE SECTION 31-


-SEE SECTION 33-

-SEE SECTION 5 T12N R8E -

Replaced
2007

-SECTION 32-

R144-362
 R146-391
 R149-49

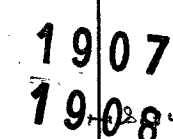

One Inch Equals Four Hundred Feet

MILES

0 1/16 1/8 1/4

FEET

0 400 800 1200 1600


NOTE: This map was prepared for assessment use in accordance with the Wis. St. Stat. Chap. 70.09. All information contained herein is advisory only. Map accuracy is limited to the quality of data obtained from other Public Records. This map is not intended to be a substitute for an actual field survey. Public Land Survey Base is derived from U.S.G.S. Topographic maps unless otherwise noted. Other sources of the Land Base may be actual survey data. Base map data is from the April 1995 County Digital Orthophotos and/or U.S.G.S. 1:24,000 scale Topographic series. The user is responsible for the improper use of the data contained herein.

Created by The Columbia County Land Information Office -GIS Section, VMB.
September 2002.


TAX PARCEL MAP


TOWN of LEWISTON

TOWN 13 NORTH RANGE 8 EAST
COLUMBIA COUNTY, WISCONSIN

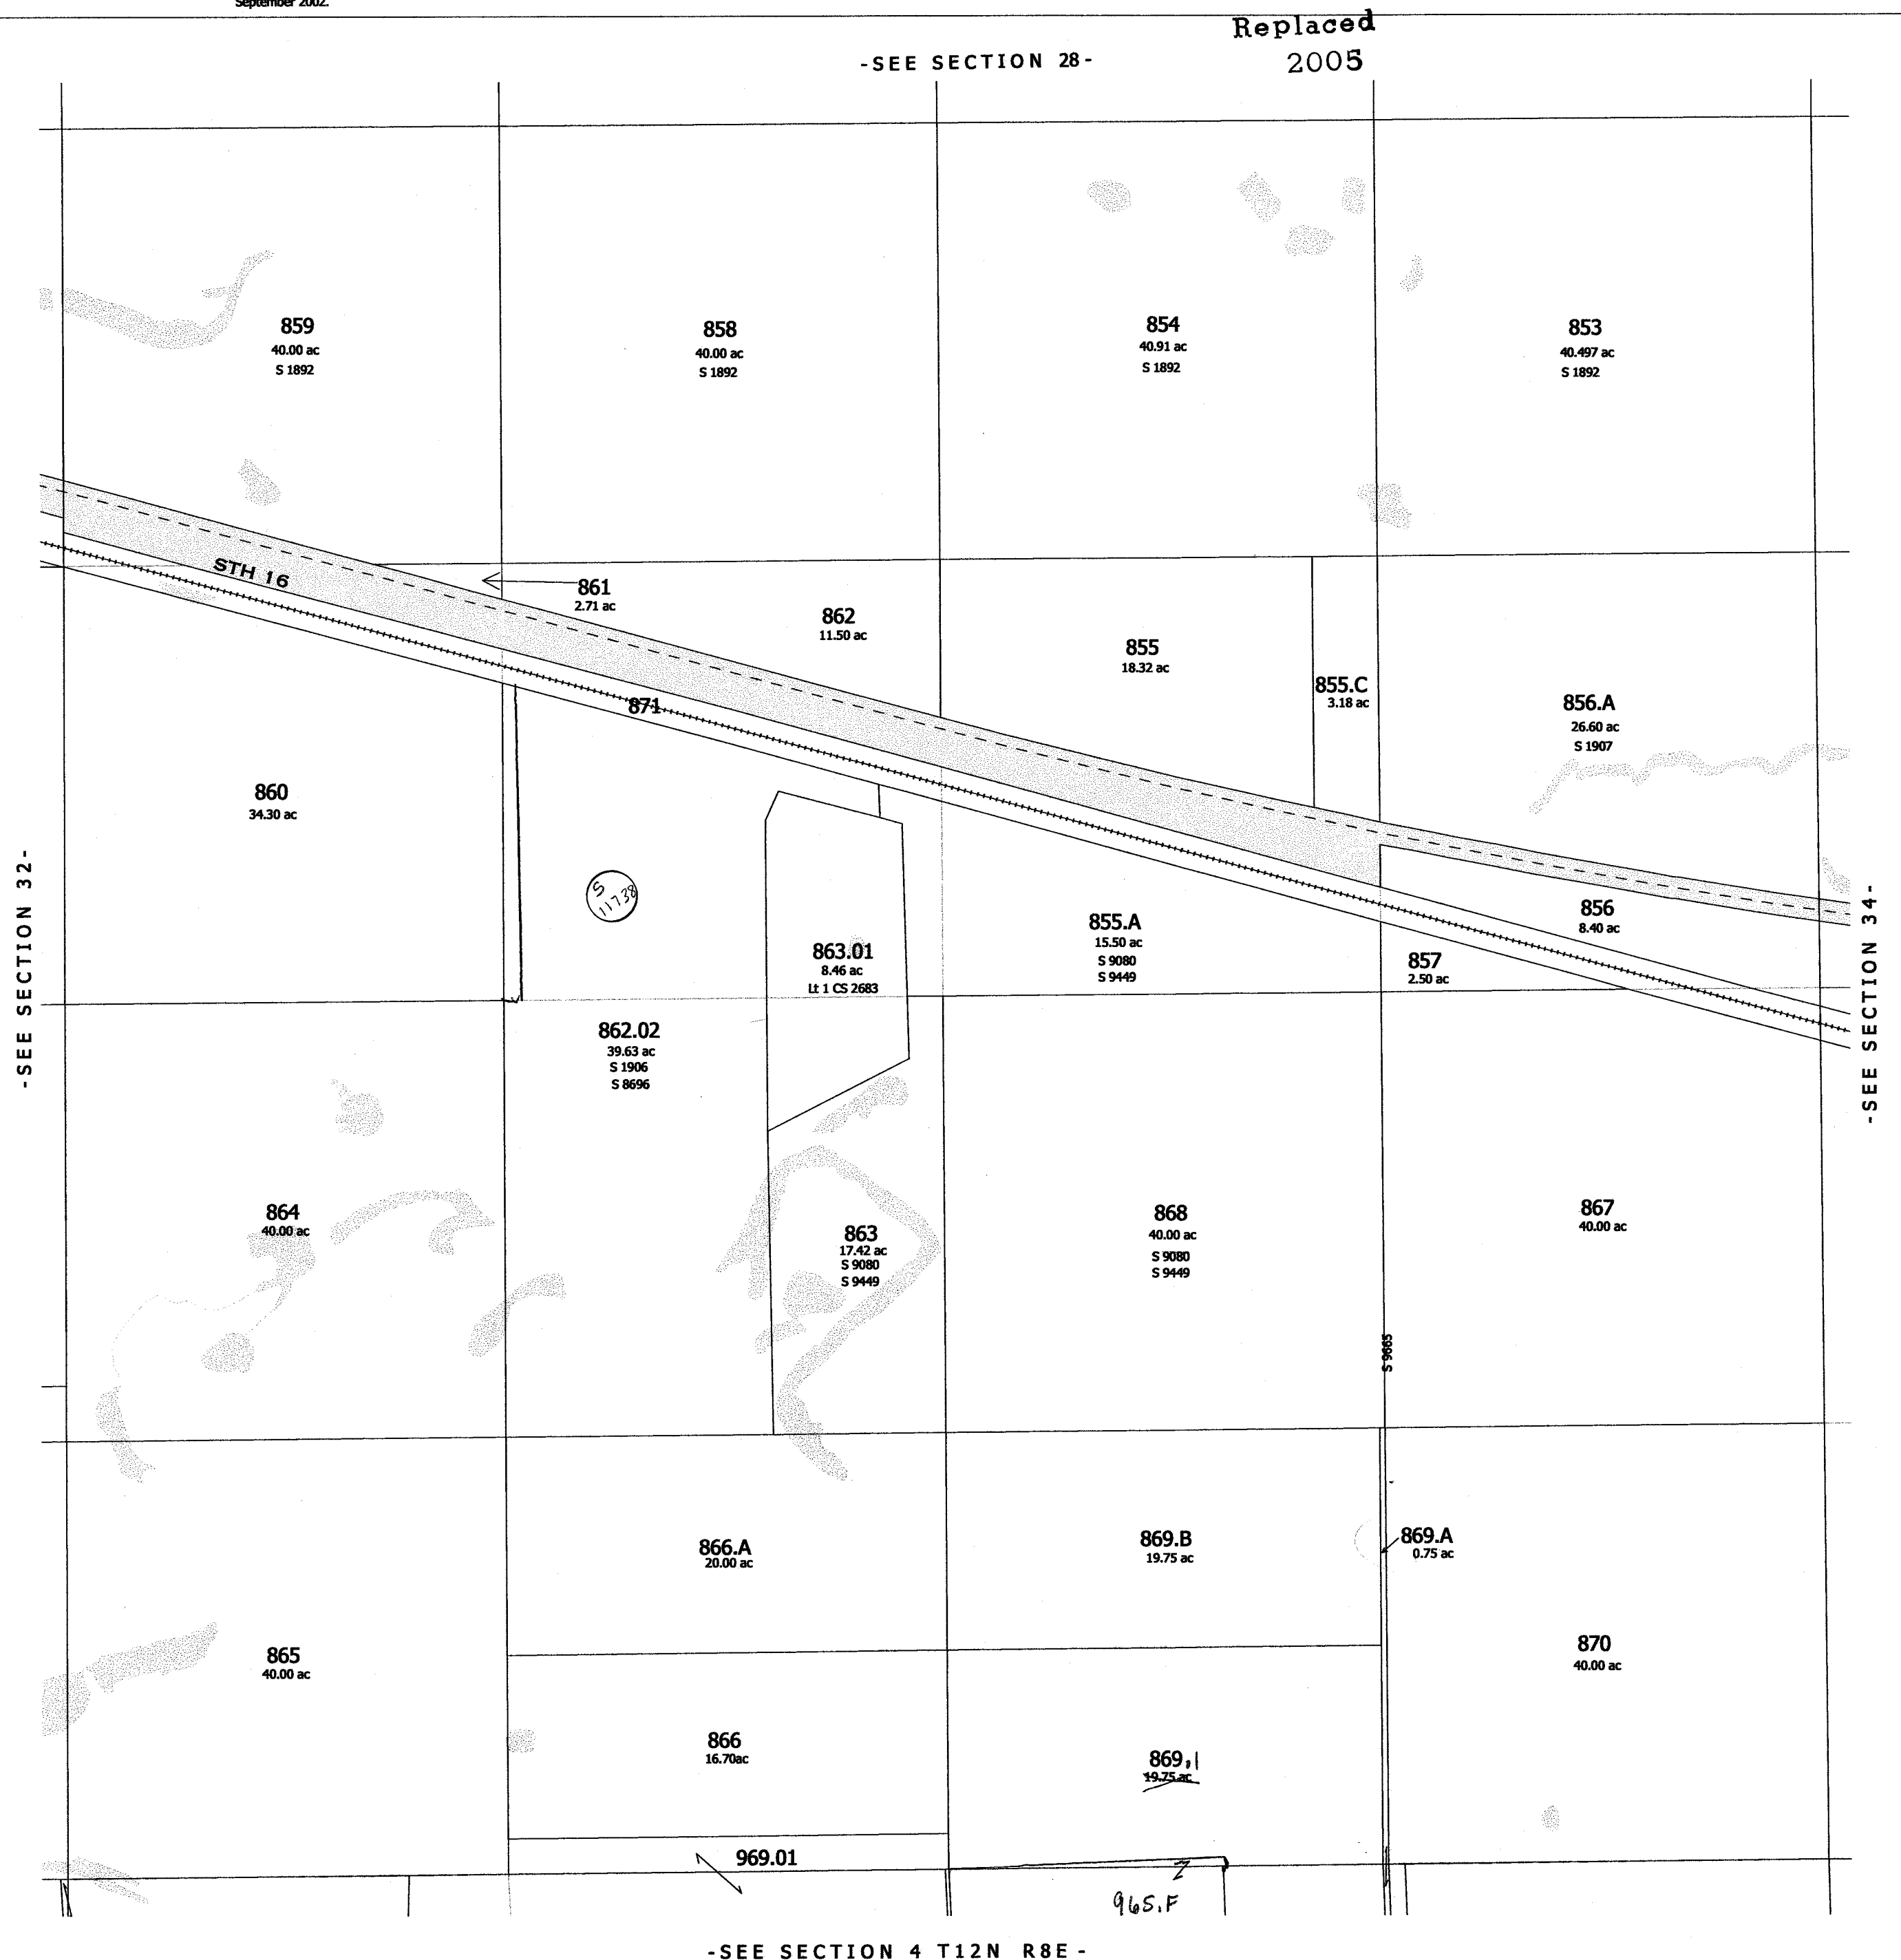

Replaced
2002

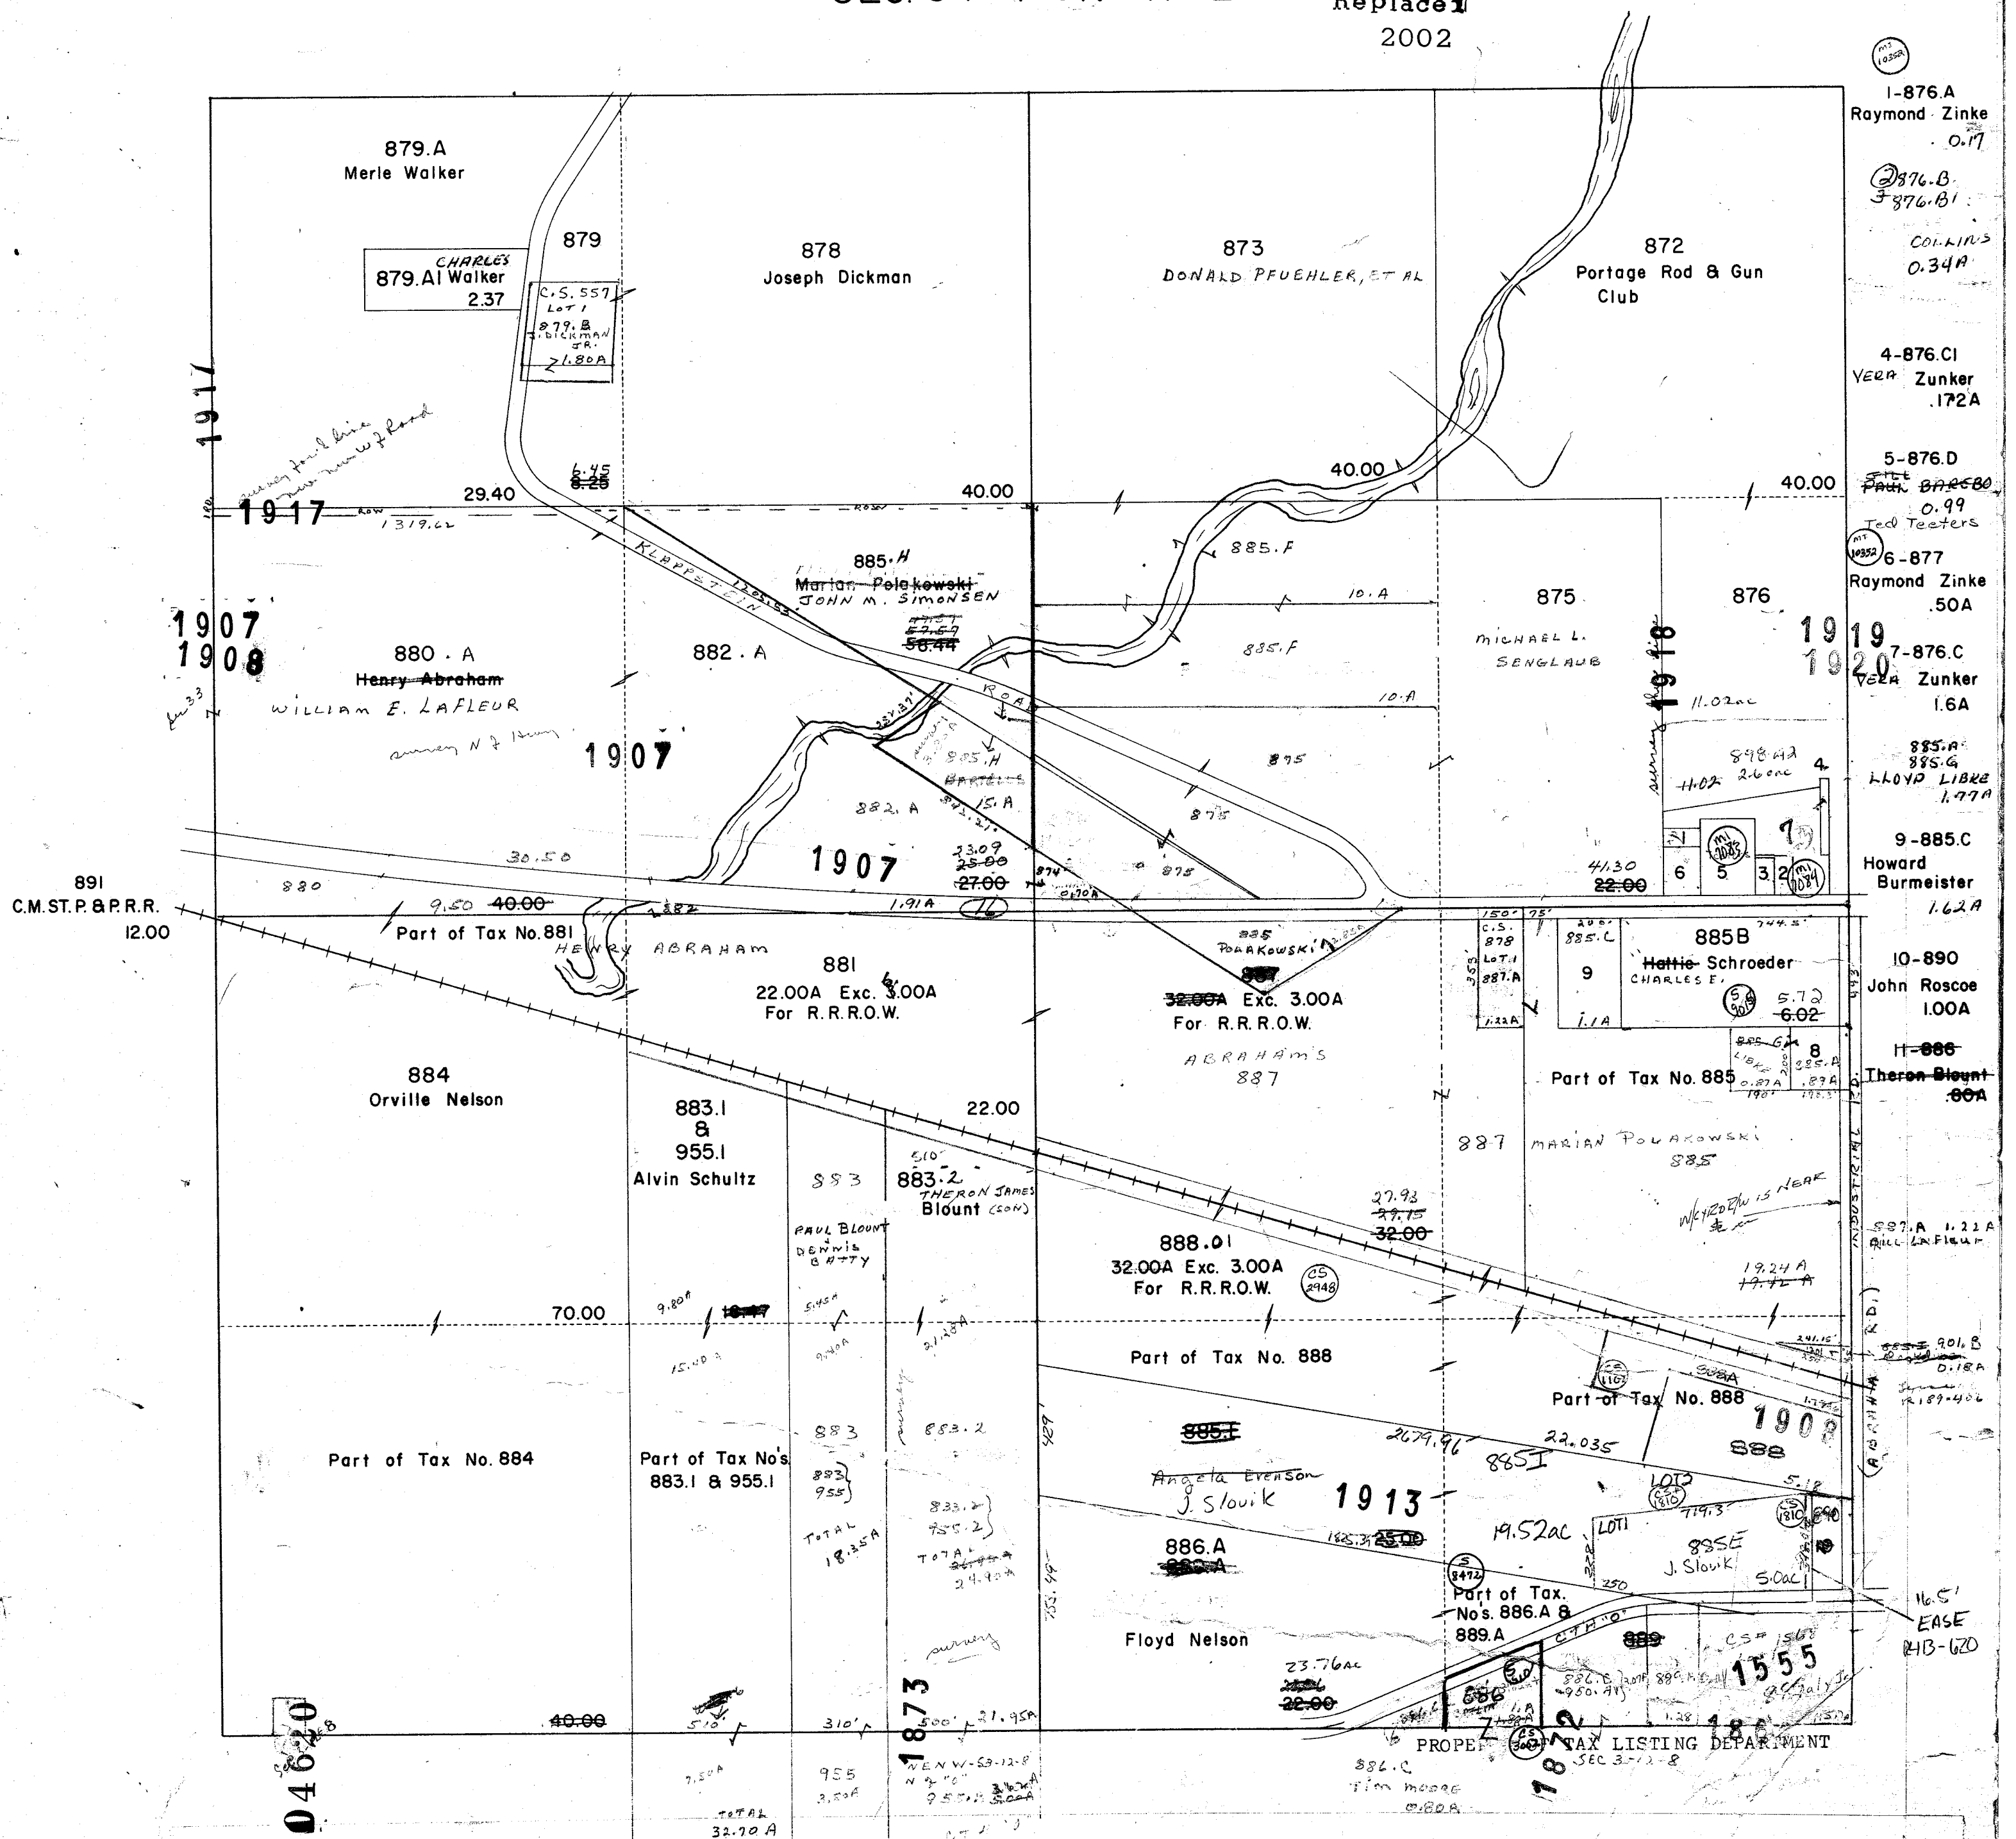

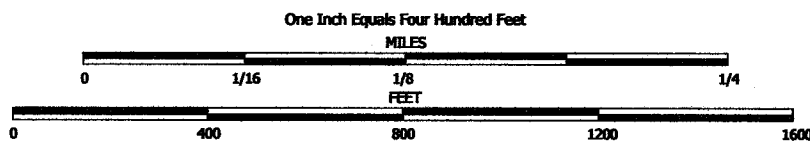



NOTE: This map was prepared for assessment use in accordance with the Wis. St. Stat. Chap. 70.09. All information contained herein is advisory only. Map accuracy is limited to the quality of data obtained from other Public Records. This map is not intended to be a substitute for an actual field survey. Public Land Survey Base is derived from U.S.G.S Topographic maps unless otherwise noted. Other sources of the Land Base may be actual survey data. Base map data is from the April 1995 County Digital Orthophotos and/or U.S.G.S 1:24,000 scale Topographic series. The user is responsible for the improper use of the data contained herein.

Created by The Columbia County Land Information Office -GIS Section. VMB.
September 2002.

TAX PARCEL MAP


TOWN of LEWISTON

TOWN 13 NORTH RANGE 8 EAST
COLUMBIA COUNTY, WISCONSIN

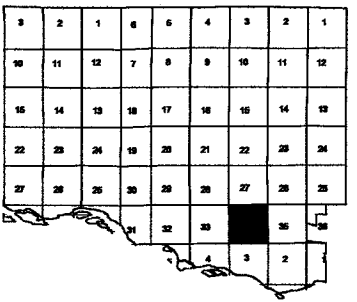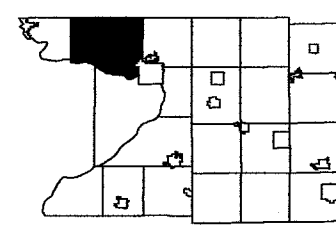

Replaced
2004

-SEE SECTION 27-

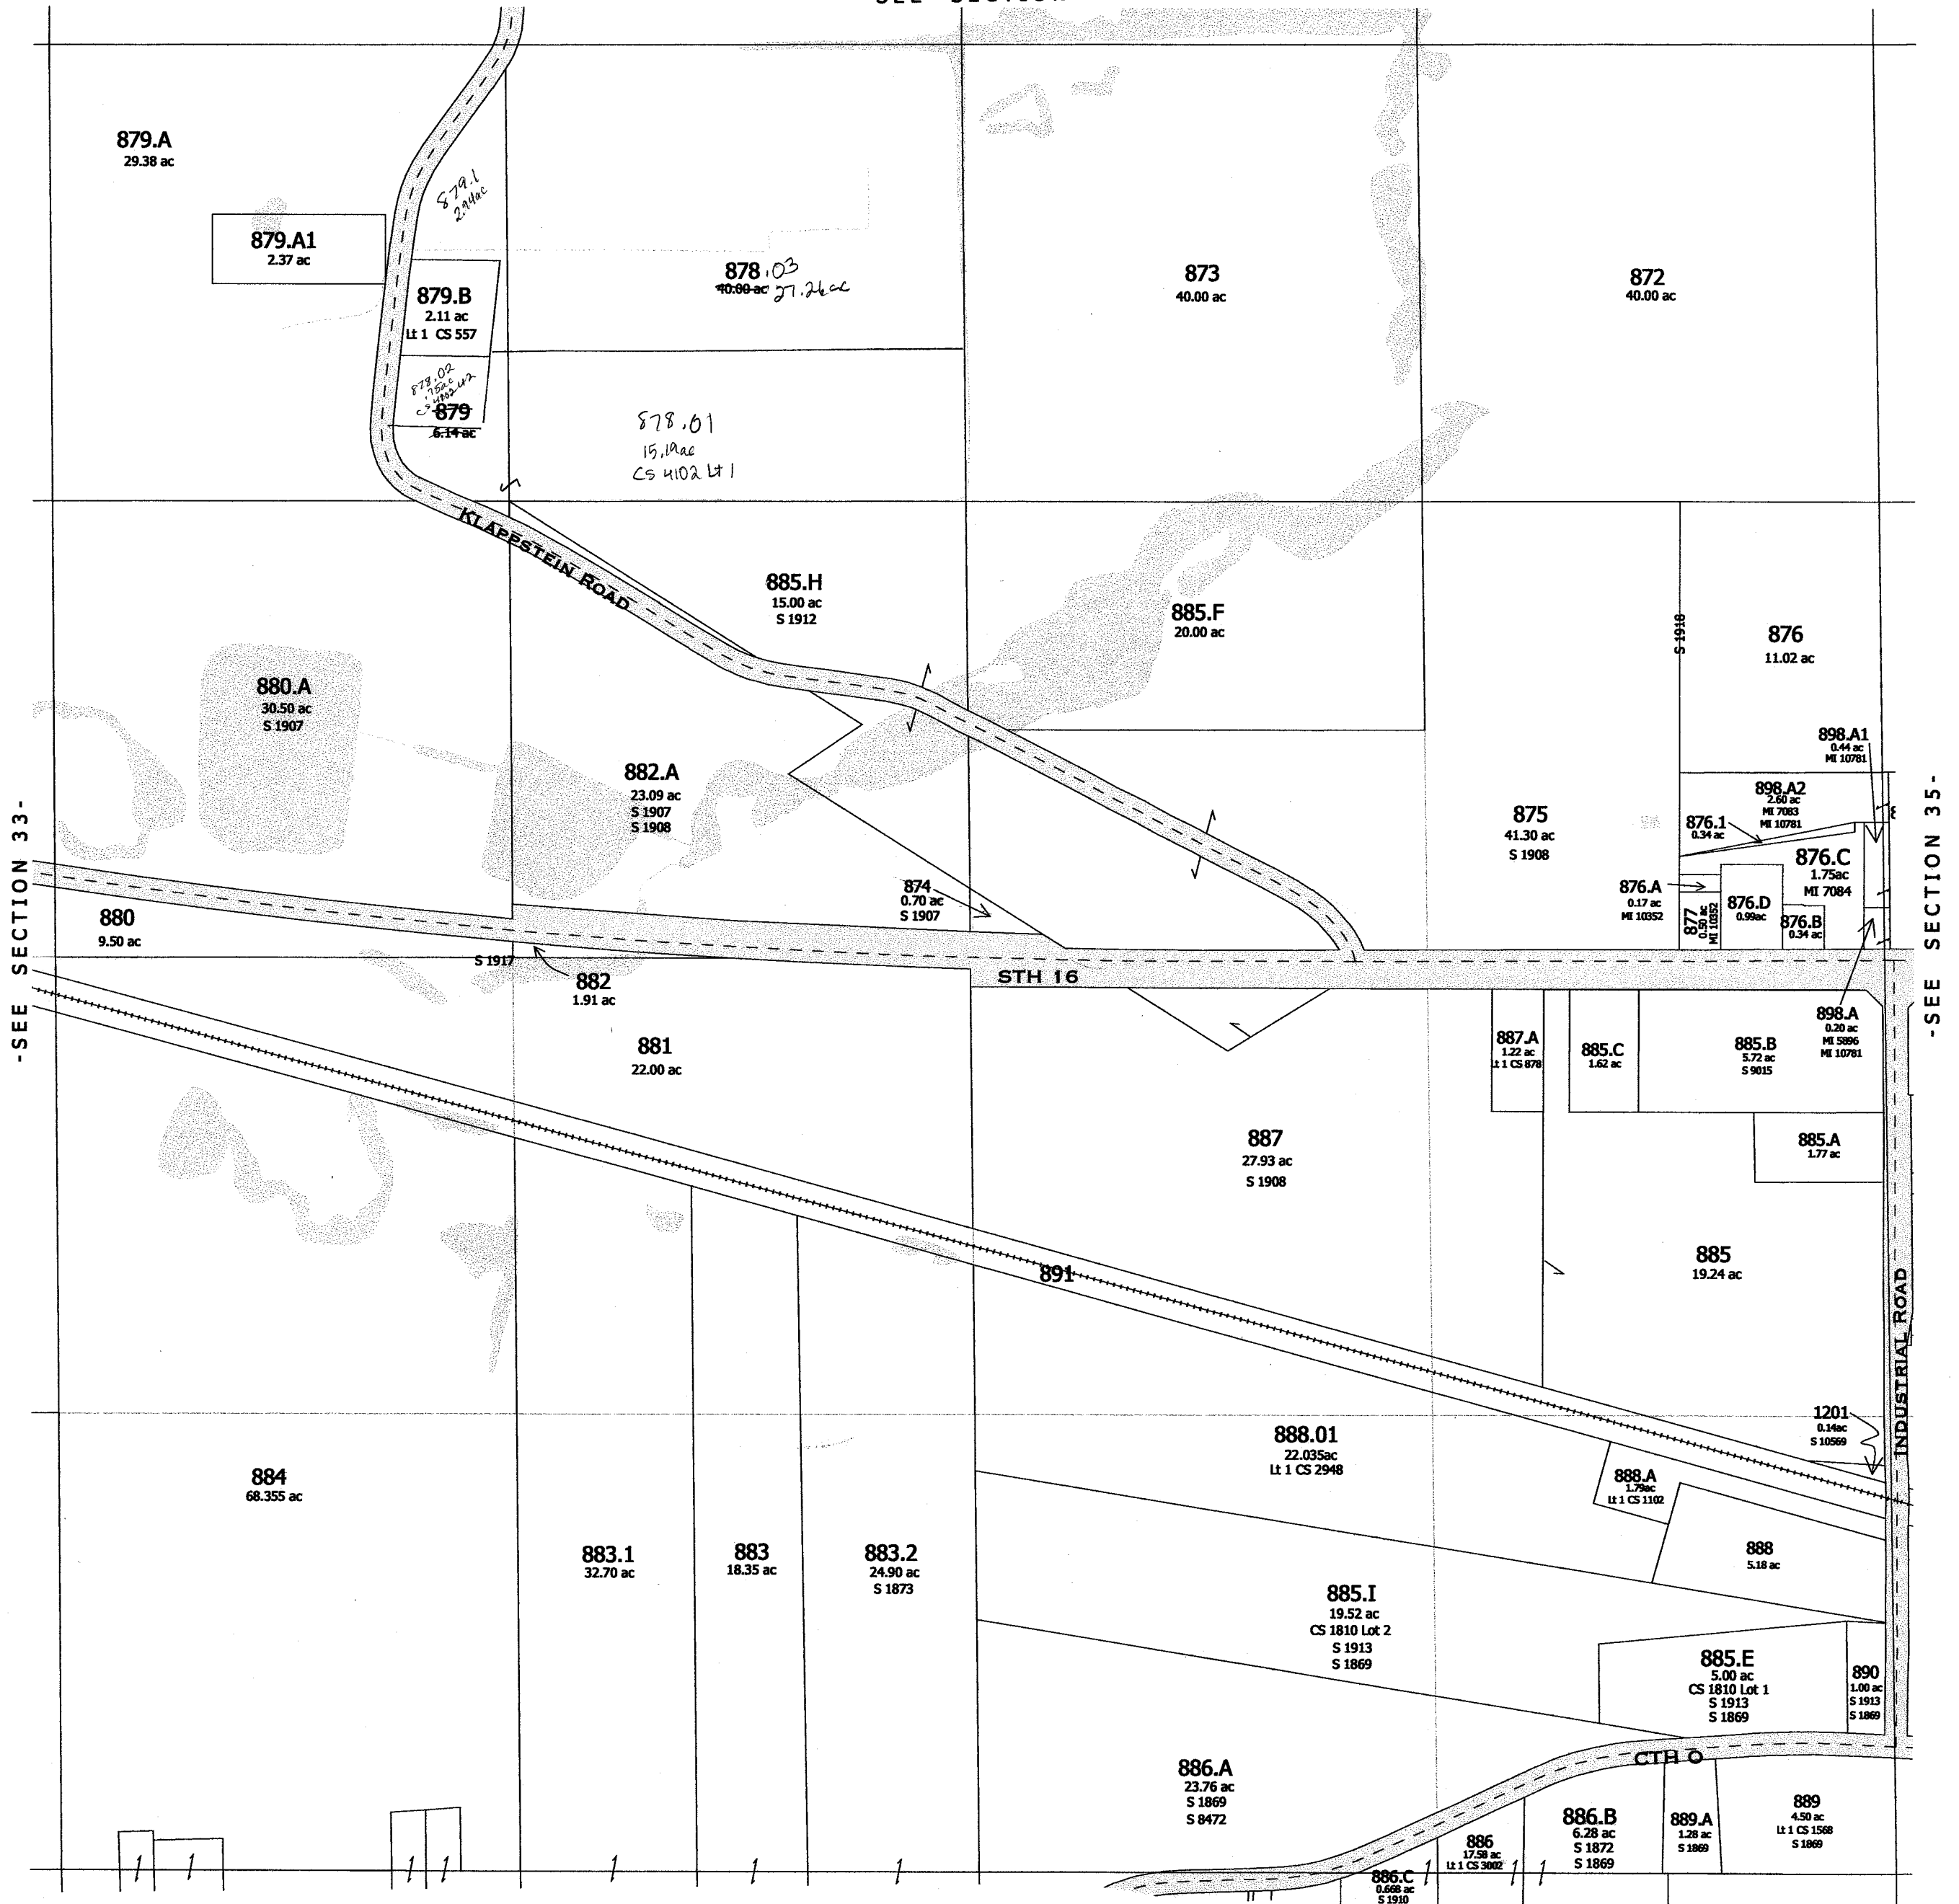


-SEE SECTION 33-

-SEE SECTION 35-

-SEE SECTION 3 T12N R8E -

PLAT PLAN (ALONG STH 16) - S 1920
- S 1919


replaced 2004
-SECTION 34-

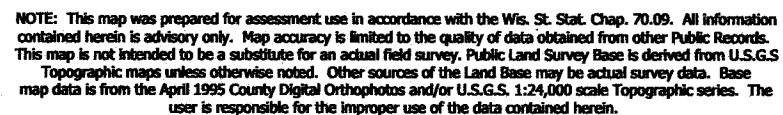

Created by The Columbia County Land Information Office -GIS Section. VMB.
March 2004.


TOWN of LEWISTON

TOWN 13 NORTH RANGE 8 EAST
COLUMBIA COUNTY, WISCONSIN

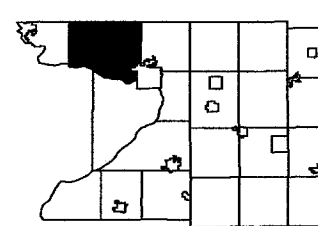

~~Replaced~~
2005

-SEE SECTION 27-

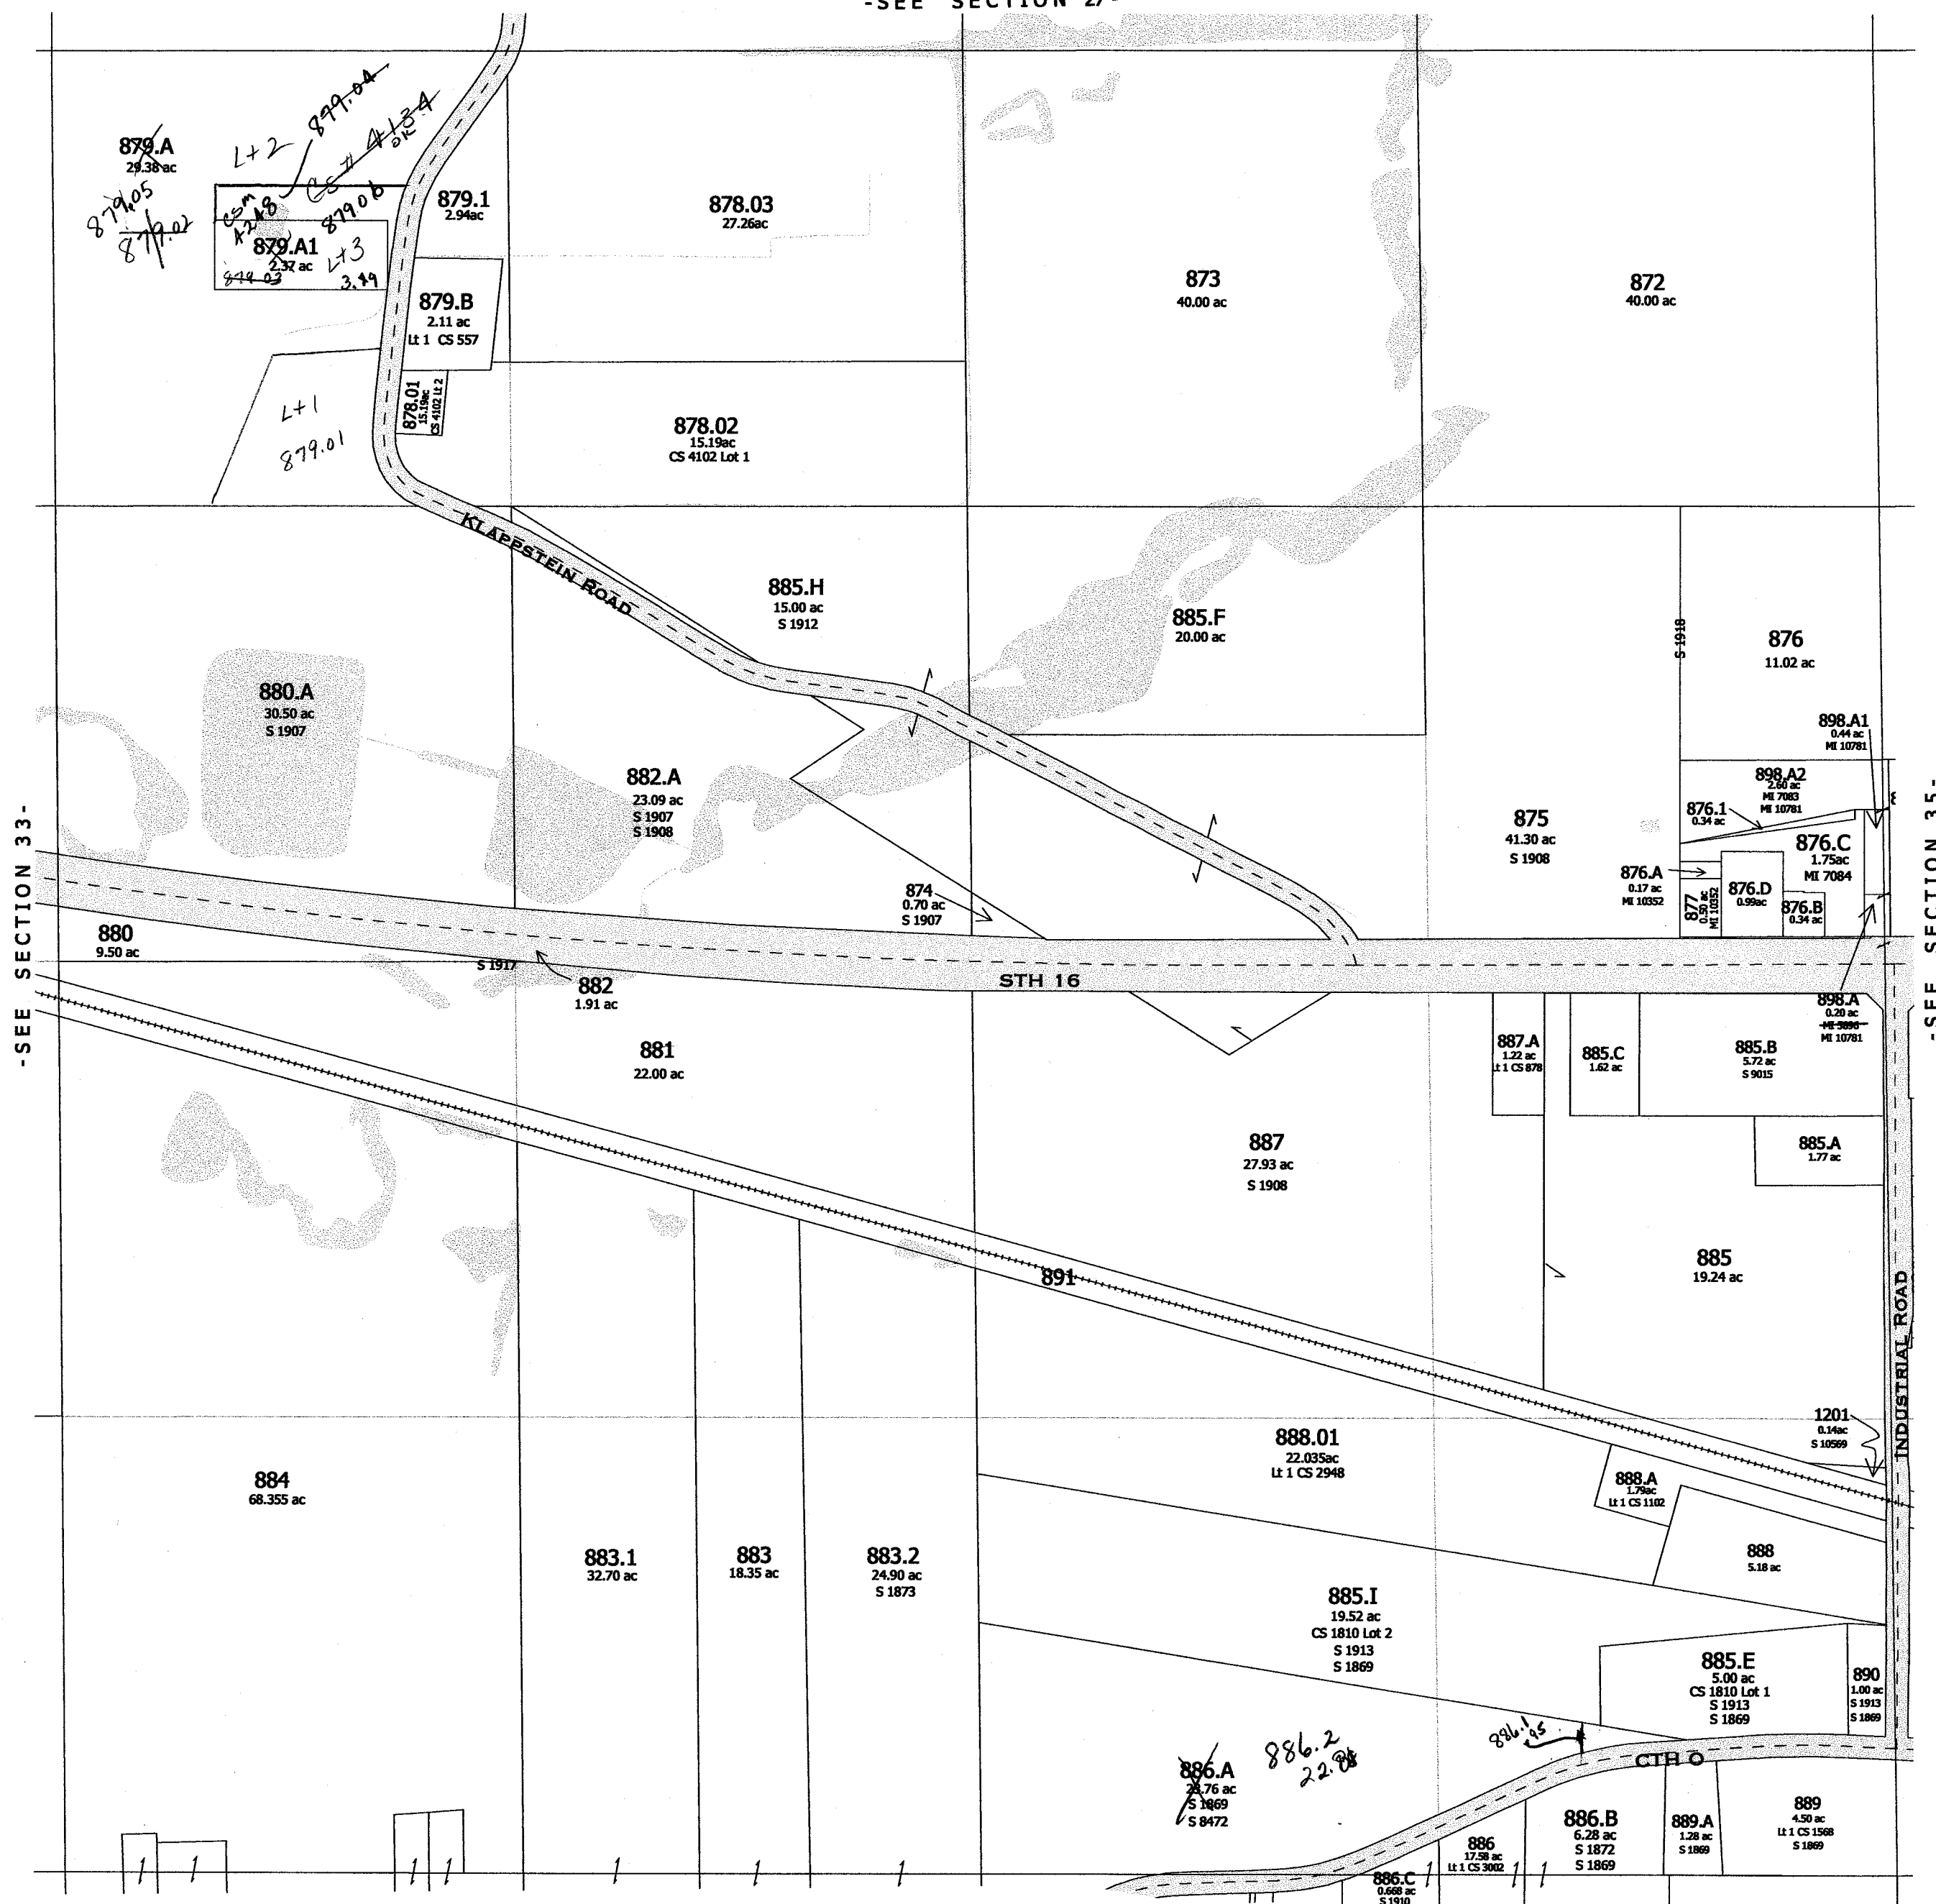

SEE SECTION 35-

INDUSTRIAL BOARD


-SEE SECTION 3 T12N R8E -


PLAT PLAN (ALONG STH 16) - S 1920
- S 1919

-SECTION 34-

2005

Replaced
2002

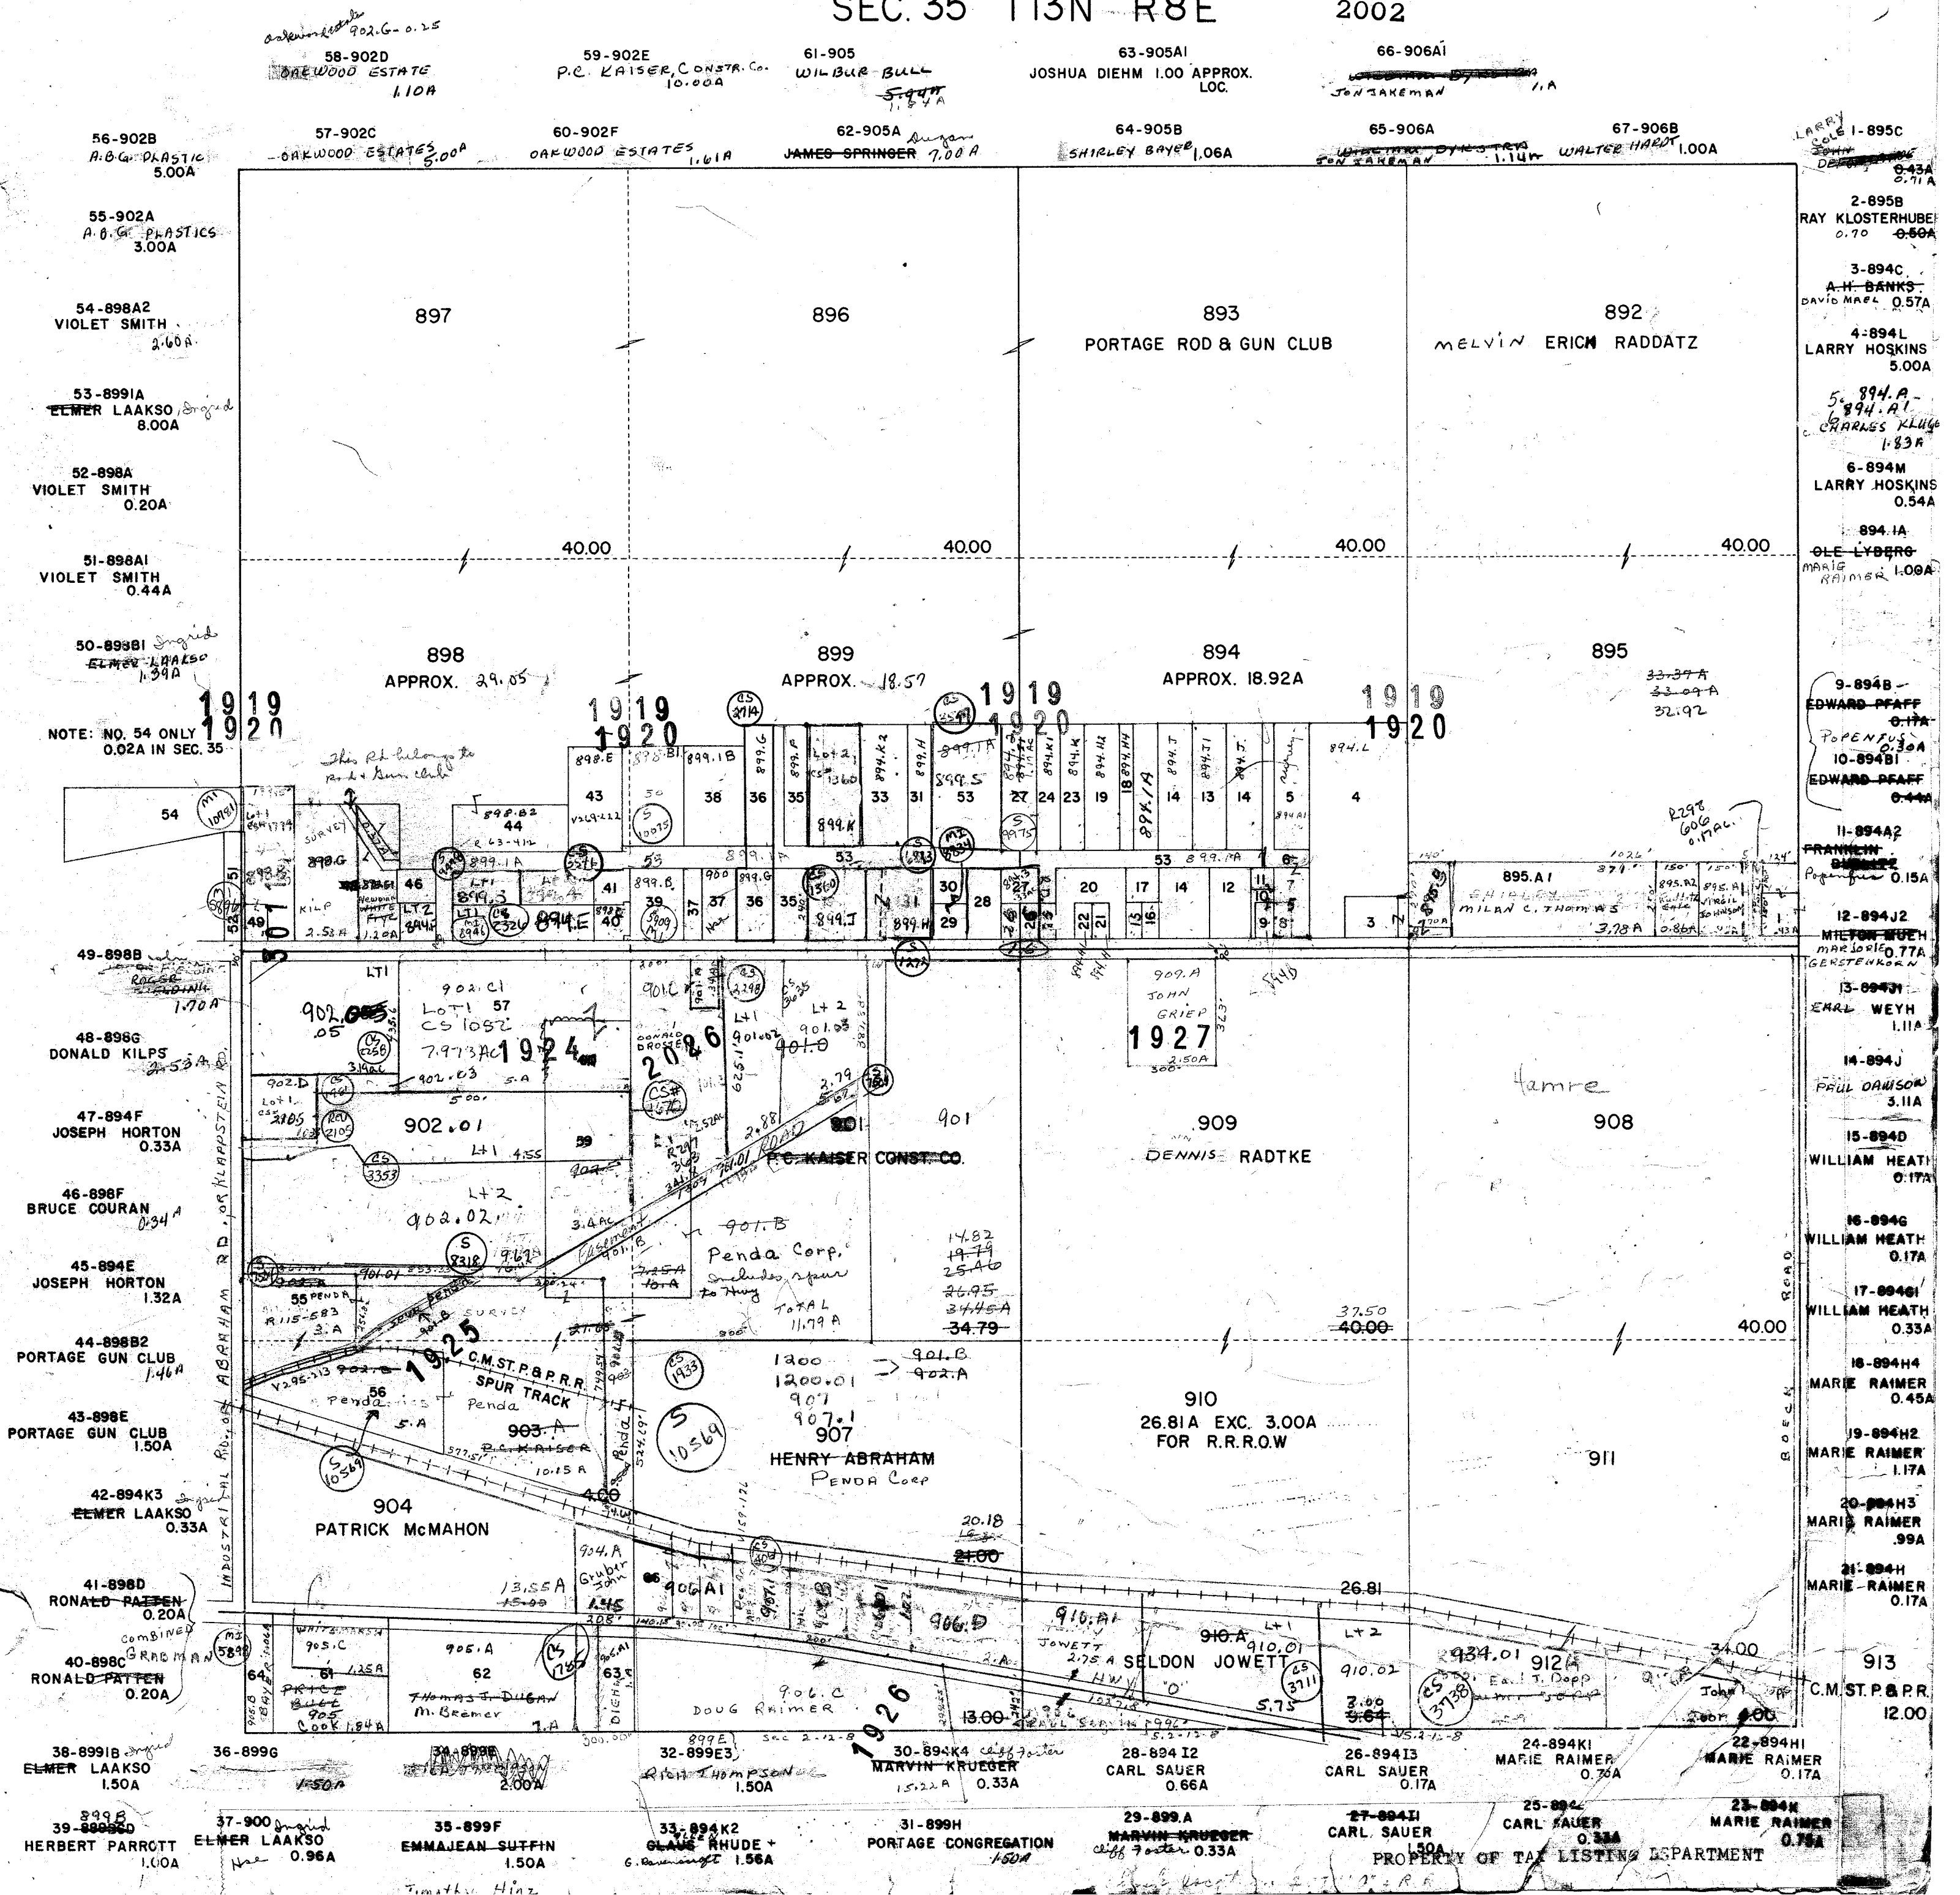


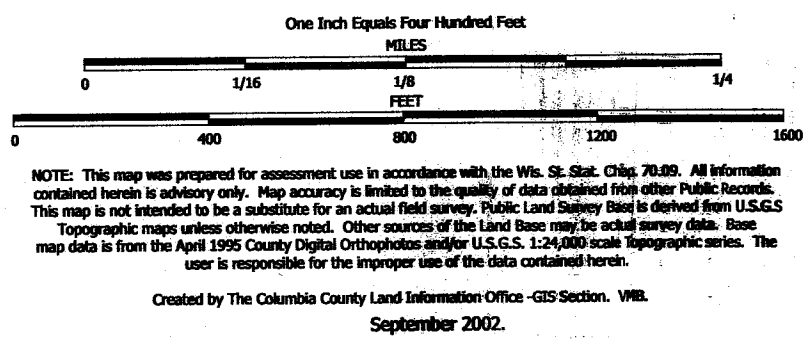

TAX PARCEL MAP

TOWN of LEWISTON

TOWN 13 NORTH RANGE 8 EAST
COLUMBIA COUNTY, WISCONSIN

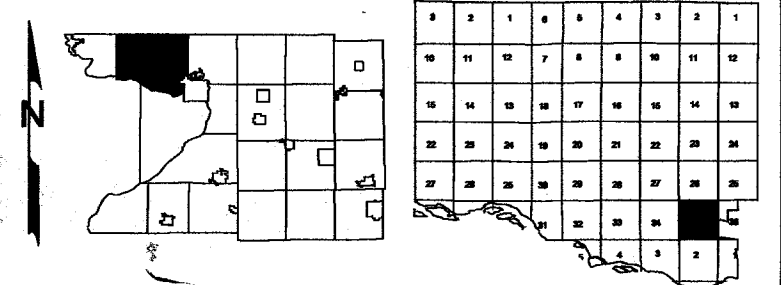

Replaced
2003

-SEE SECTION 26-




-SEE SECTION 34-

-SEE SECTION 36-

-SEE SECTION 2 T12N R8E-

PLAT PLAN (ALONG STH 16) - S 1920
- S 1919

replaced 2003
-SECTION 35-

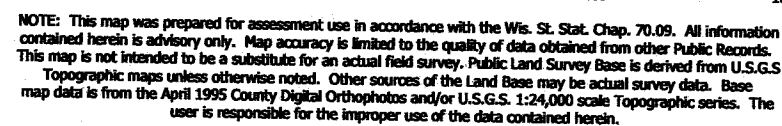


NOTE: This map was prepared for assessment use in accordance with the Wis. St. Stat. Chap. 70.09. All information contained herein is advisory only. Map accuracy is limited to the quality of data obtained from other Public Records. This map is not intended to be a substitute for an actual field survey. Public Land Survey Base is derived from U.S.G.S. Topographic maps unless otherwise noted. Other sources of the Land Base may be actual survey data. Base map data is from the April 1995 County Digital Orthophotos and/or U.S.G.S. 1:24,000 scale Topographic series. The user is responsible for the improper use of the data contained herein.

Created by The Columbia County Land Information Office -GIS Section. VMB.
February 2003.


TOWN of LEWISTON

TOWN 13 NORTH RANGE 8 EAST
COLUMBIA COUNTY, WISCONSIN

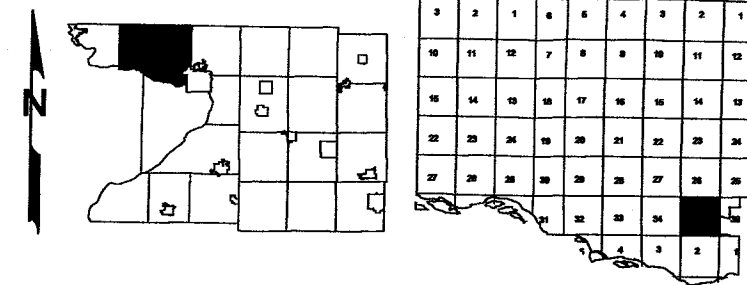

Replaced
2004

-SEE SECTION 26-

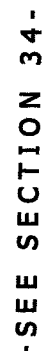



- SFF SECTION 36 -

-SEE SECTION 2 T12N R8E -

PLAT PLAN (ALONG STH 16) - S 1920
- S 1919


replaced 2004

-SECTION 35

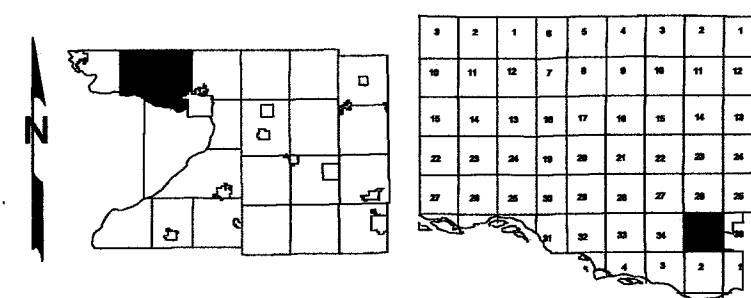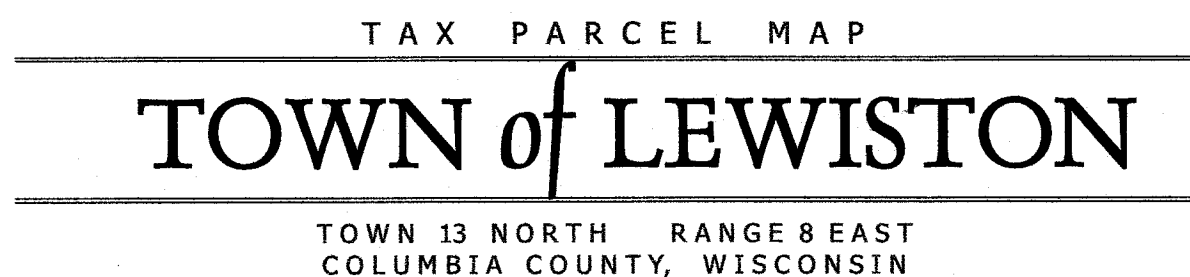

~~Replaced~~
2005


-SEE SECTION 26-

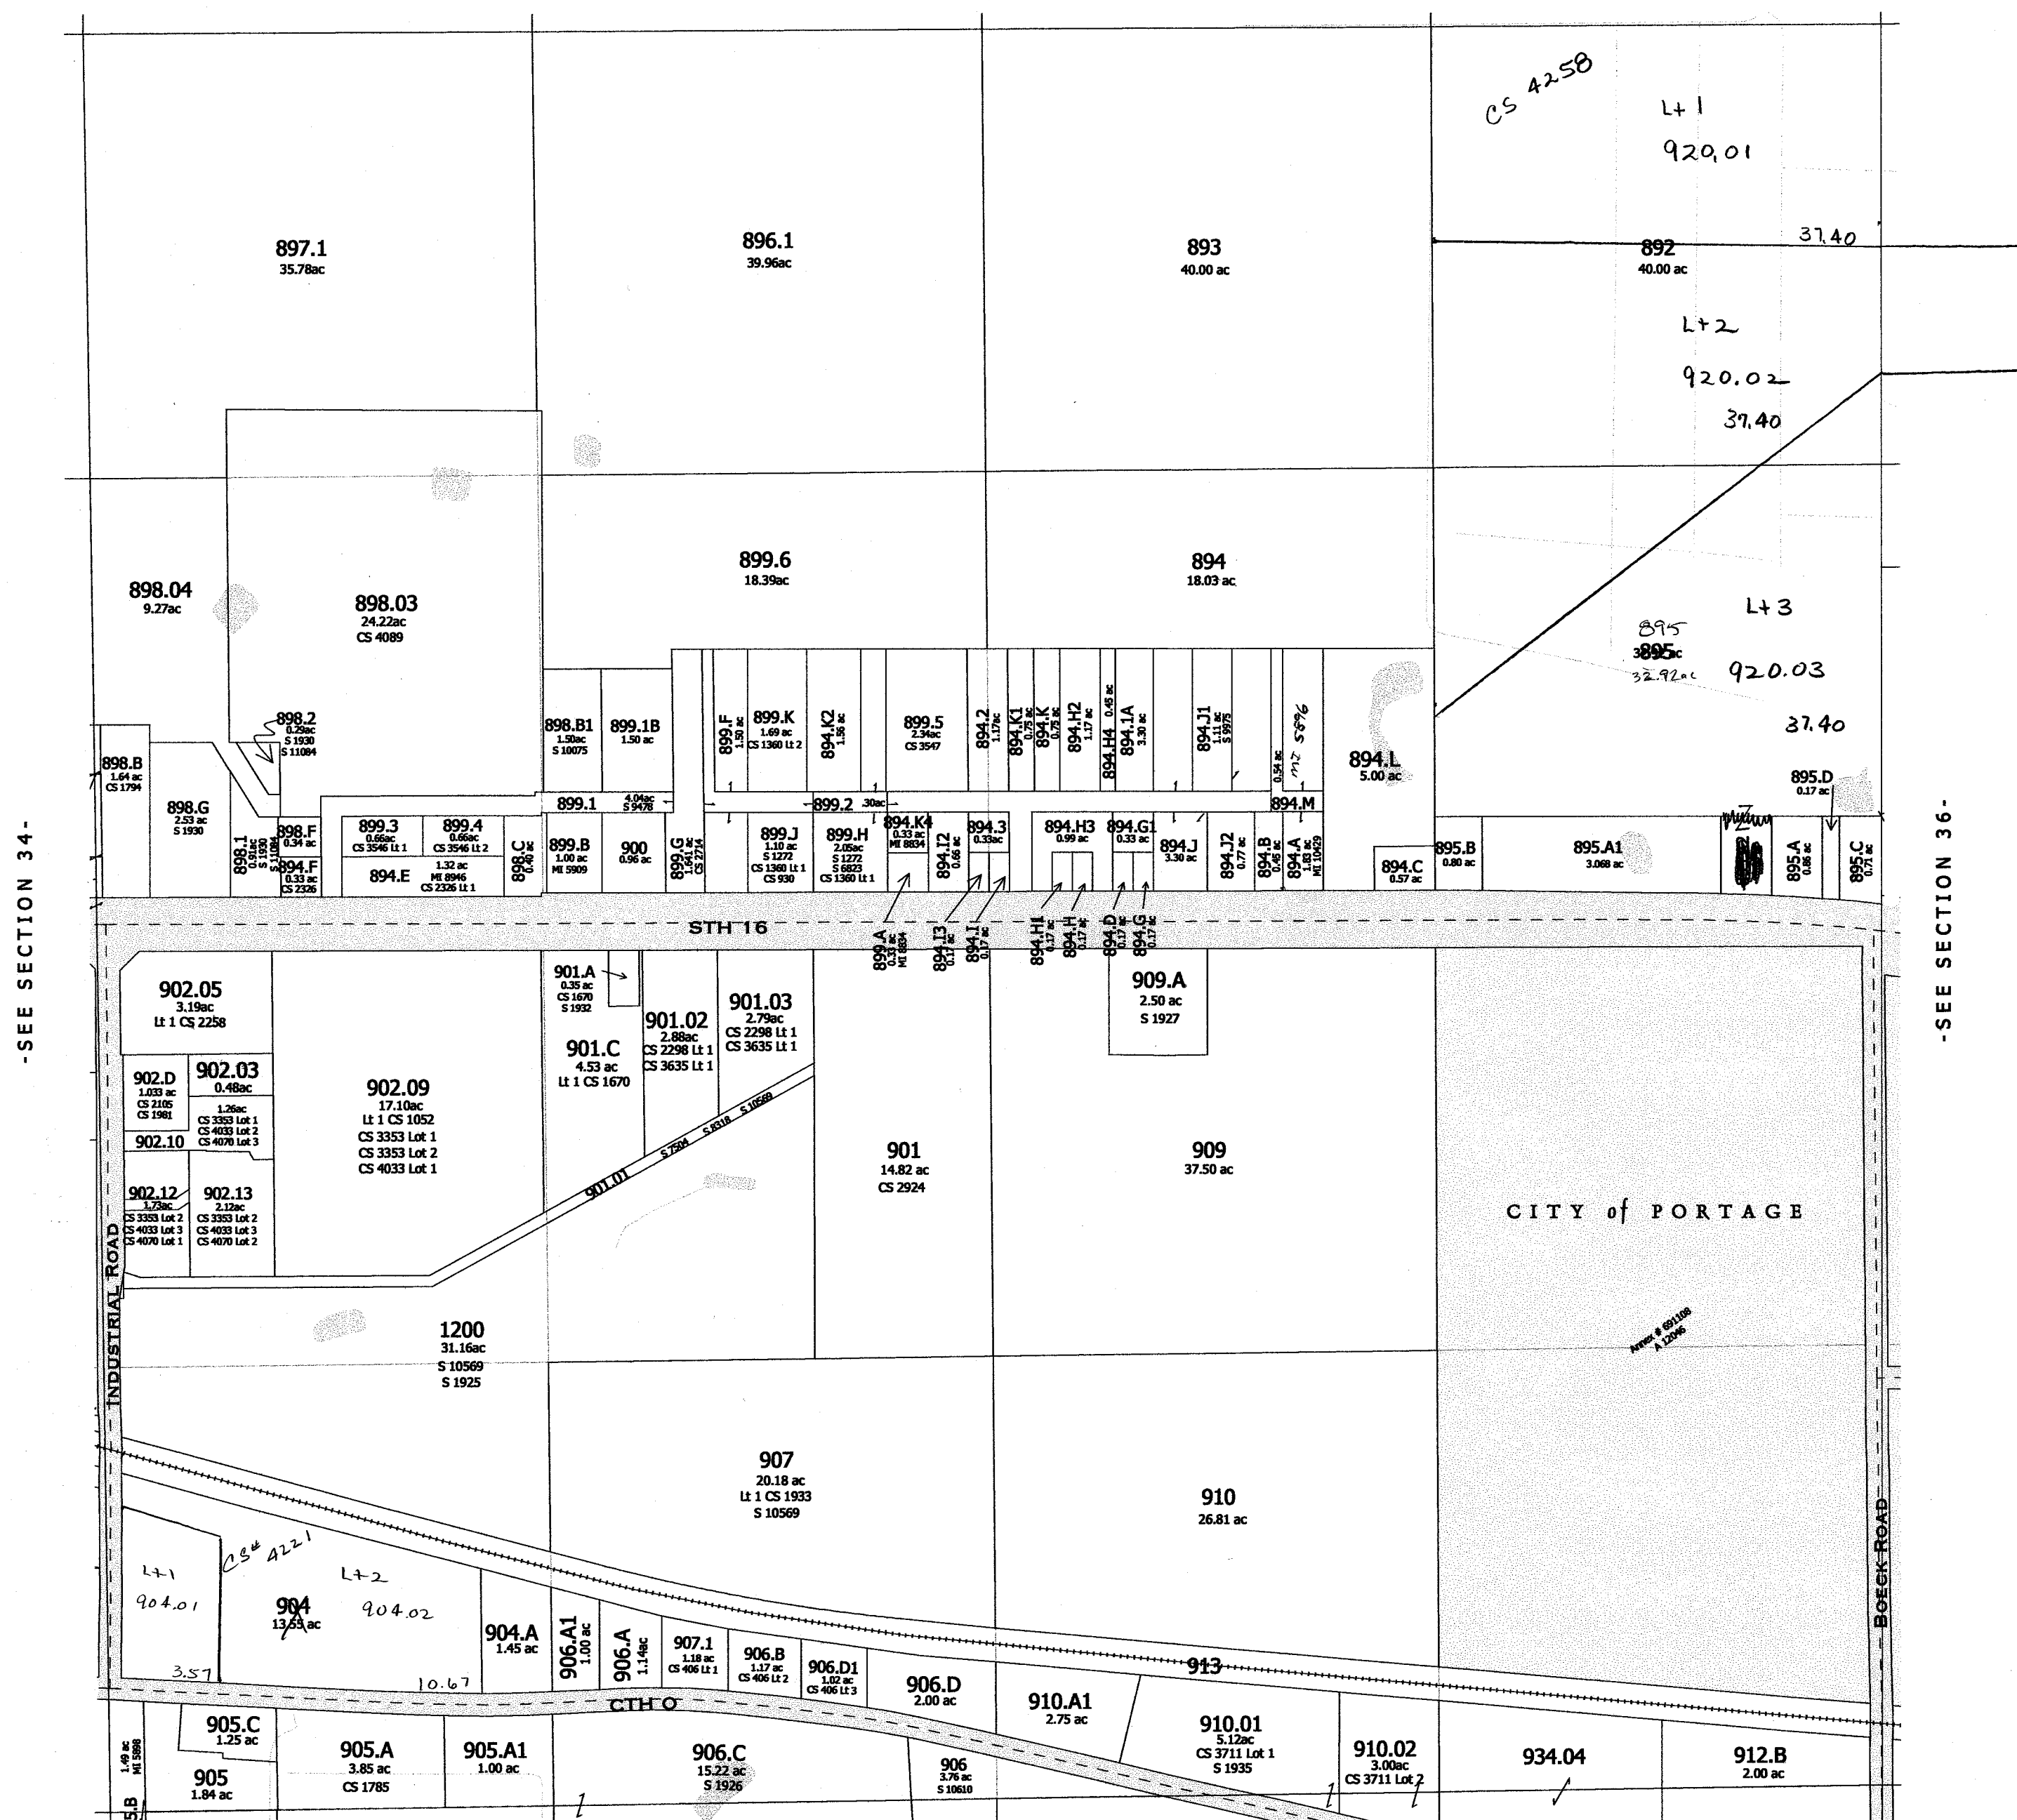

-SEE SECTION 2 T12N R8E -

PLAT PLAN (ALONG STH 16) - S 1920
- S 1919


-SECTION 35-

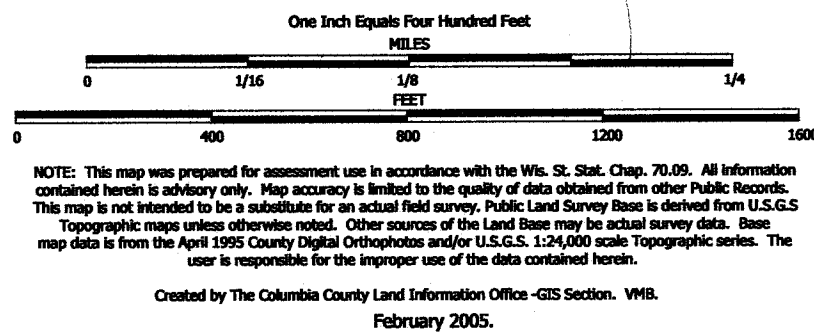

TAX PARCEL MAP


TOWN of LEWISTON

TOWN 13 NORTH RANGE 8 EAST
COLUMBIA COUNTY, WISCONSIN

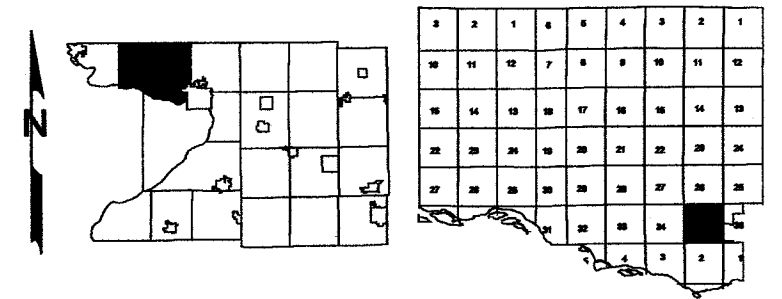


Replaced
2006


-SEE SECTION 26-

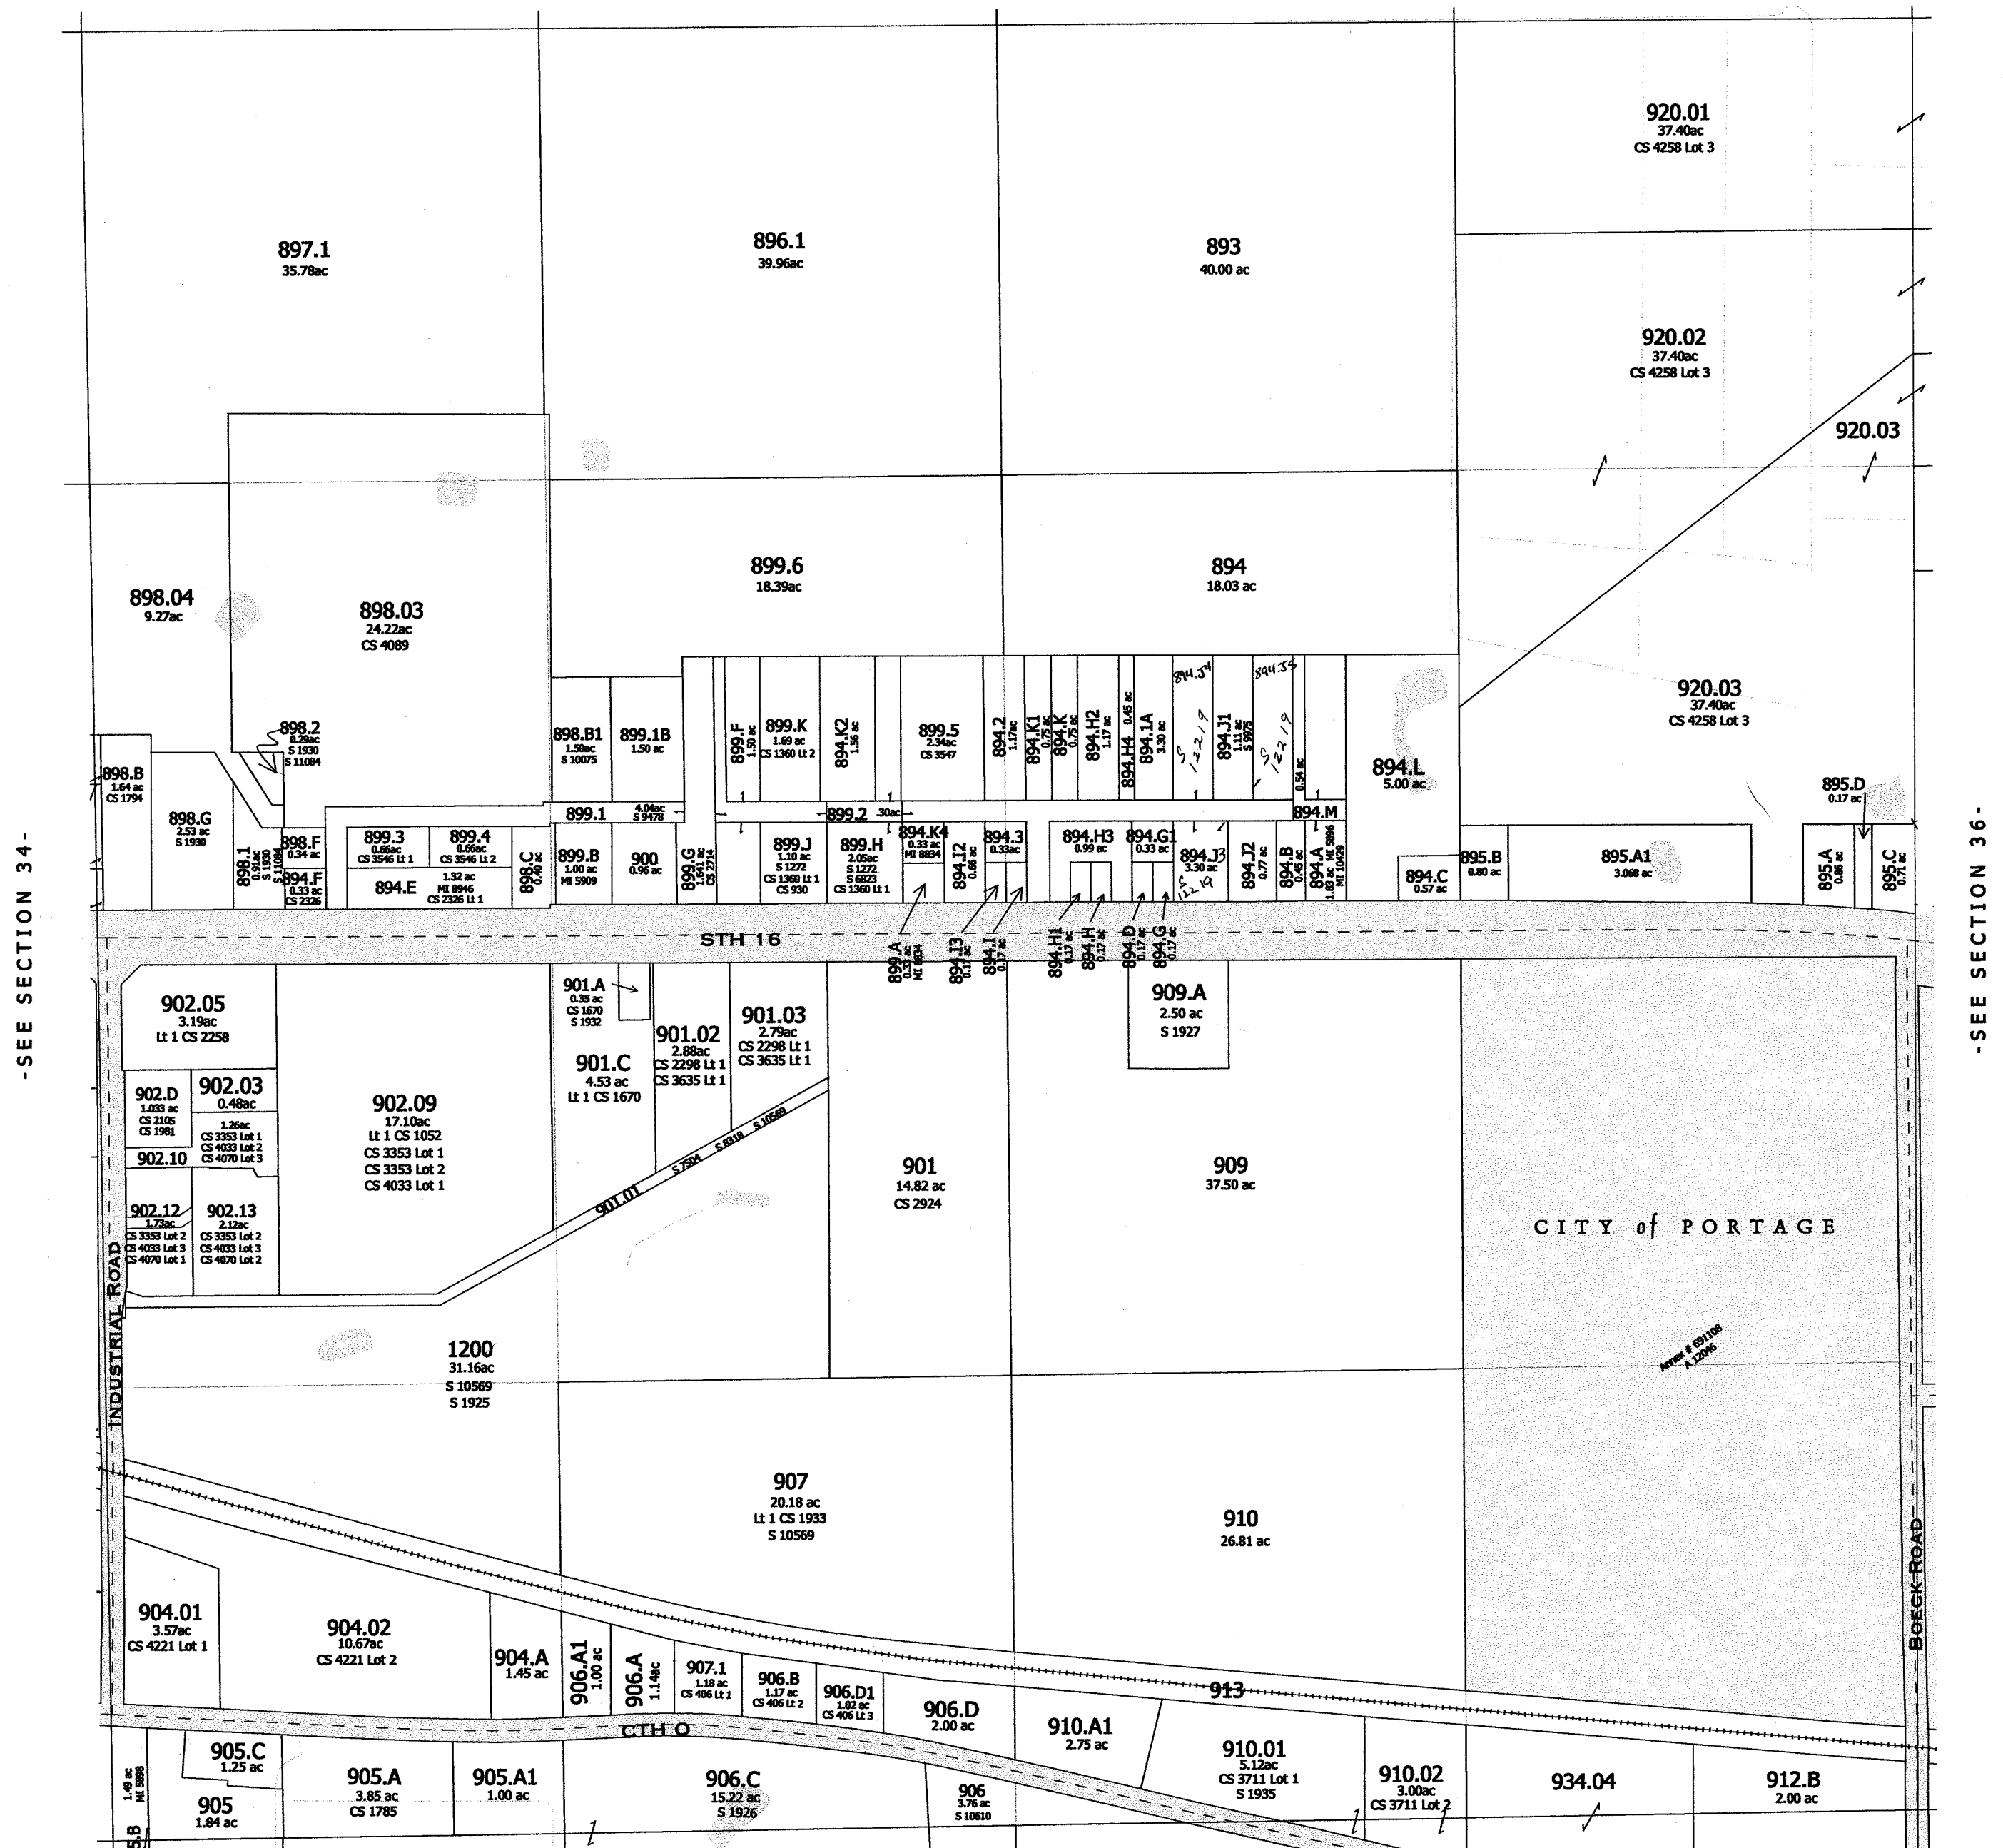

LEWISTON
SEC. 36 T13N R8E

Replaced
2002

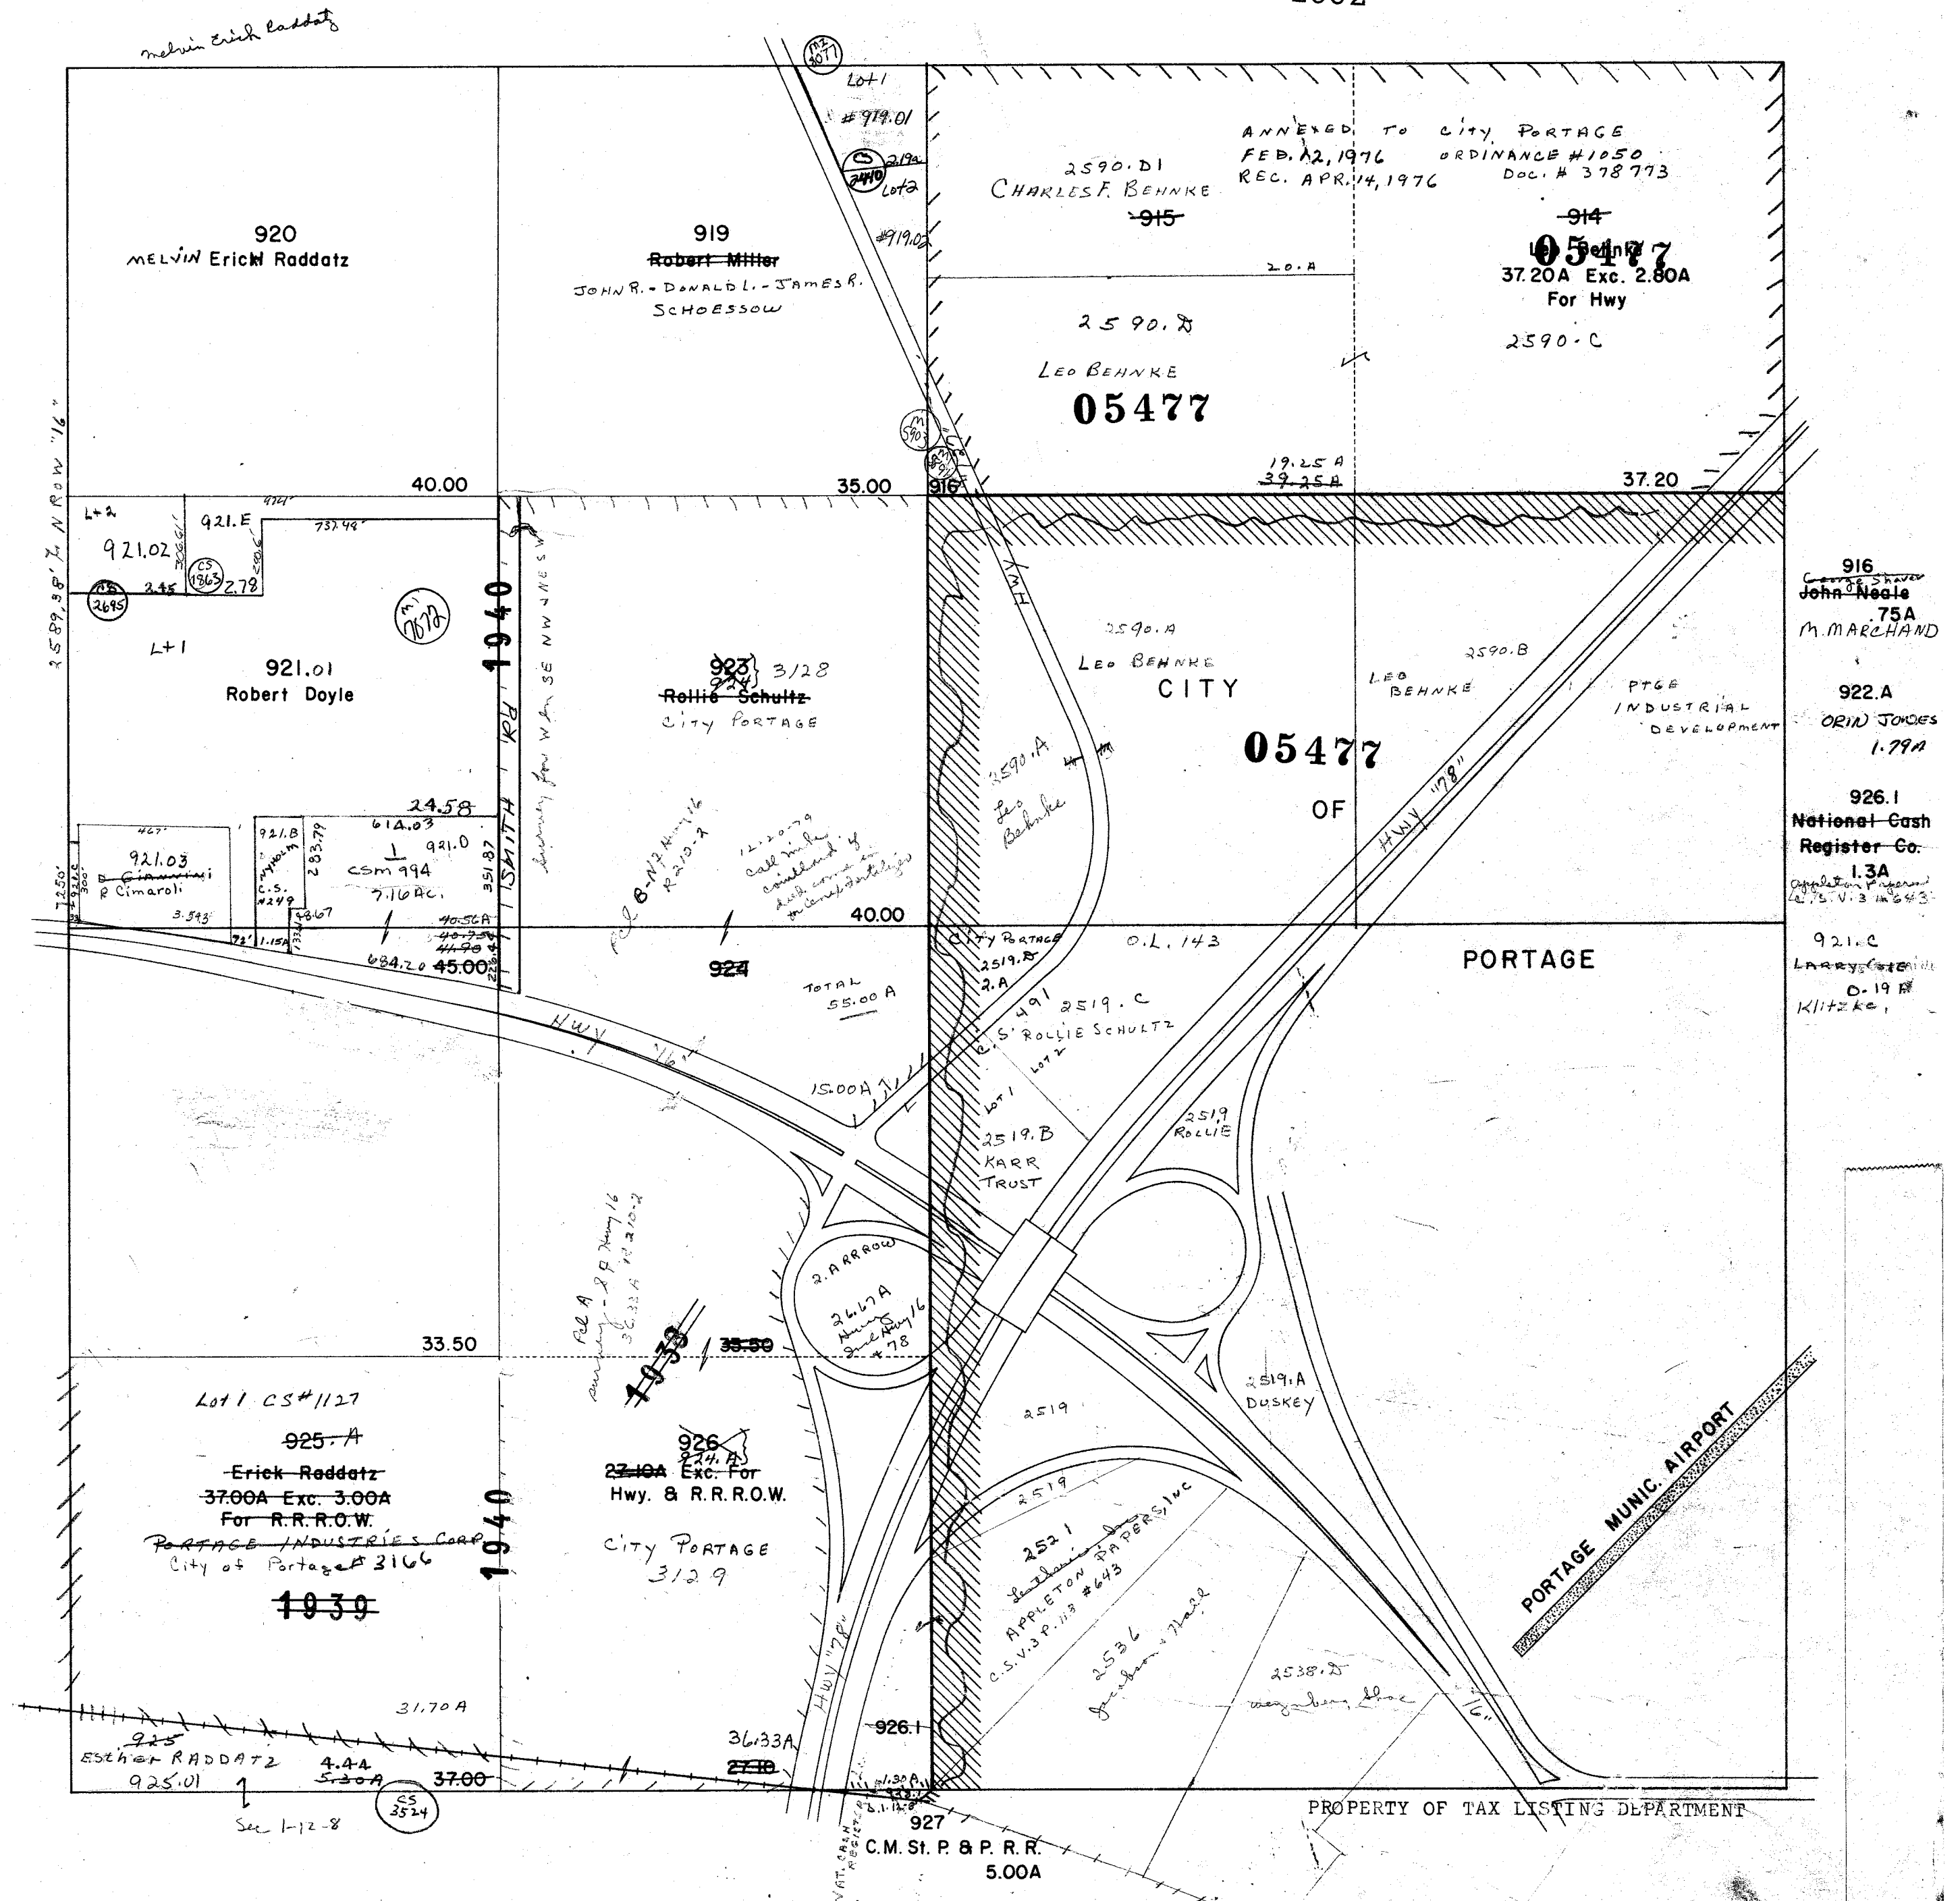

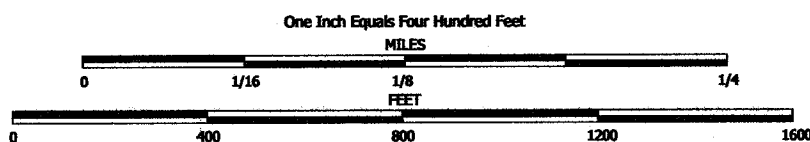


NOTE: This map was prepared for assessment use in accordance with the Wis. St. Stat. Chap. 70.09. All information contained herein is advisory only. Map accuracy is limited to the quality of data obtained from other Public Records. This map is not intended to be a substitute for an actual field survey. Public Land Survey Base is derived from U.S.G.S. Topographic maps unless otherwise noted. Other sources of the Land Base may be actual survey data. Base map data is from the April 1995 County Digital Orthophotos and/or U.S.G.S. 1:24,000 scale Topographic series. The user is responsible for the improper use of the data contained herein.

Created by The Columbia County Land Information Office -GIS Section. VMB.
September 2002.

TAX PARCEL MAP


TOWN of LEWISTON

TOWN 13 NORTH RANGE 8 EAST
COLUMBIA COUNTY, WISCONSIN

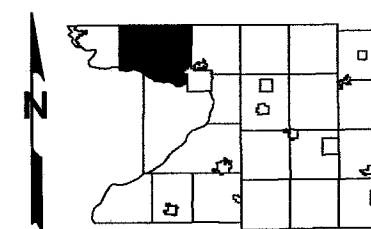


3	2	1	6	5	4	3	2	1																																																																																																																																																																																																																																																																																																																																																																																																																																																																																																																																																																																																																																																																																																																																																																																																																																																																																																																																																																																																																																																																																																																																																																																																																																																																																																																																																																																																																																																												</
---	---	---	---	---	---	---	---	---	--	--	----

Replaced
2004

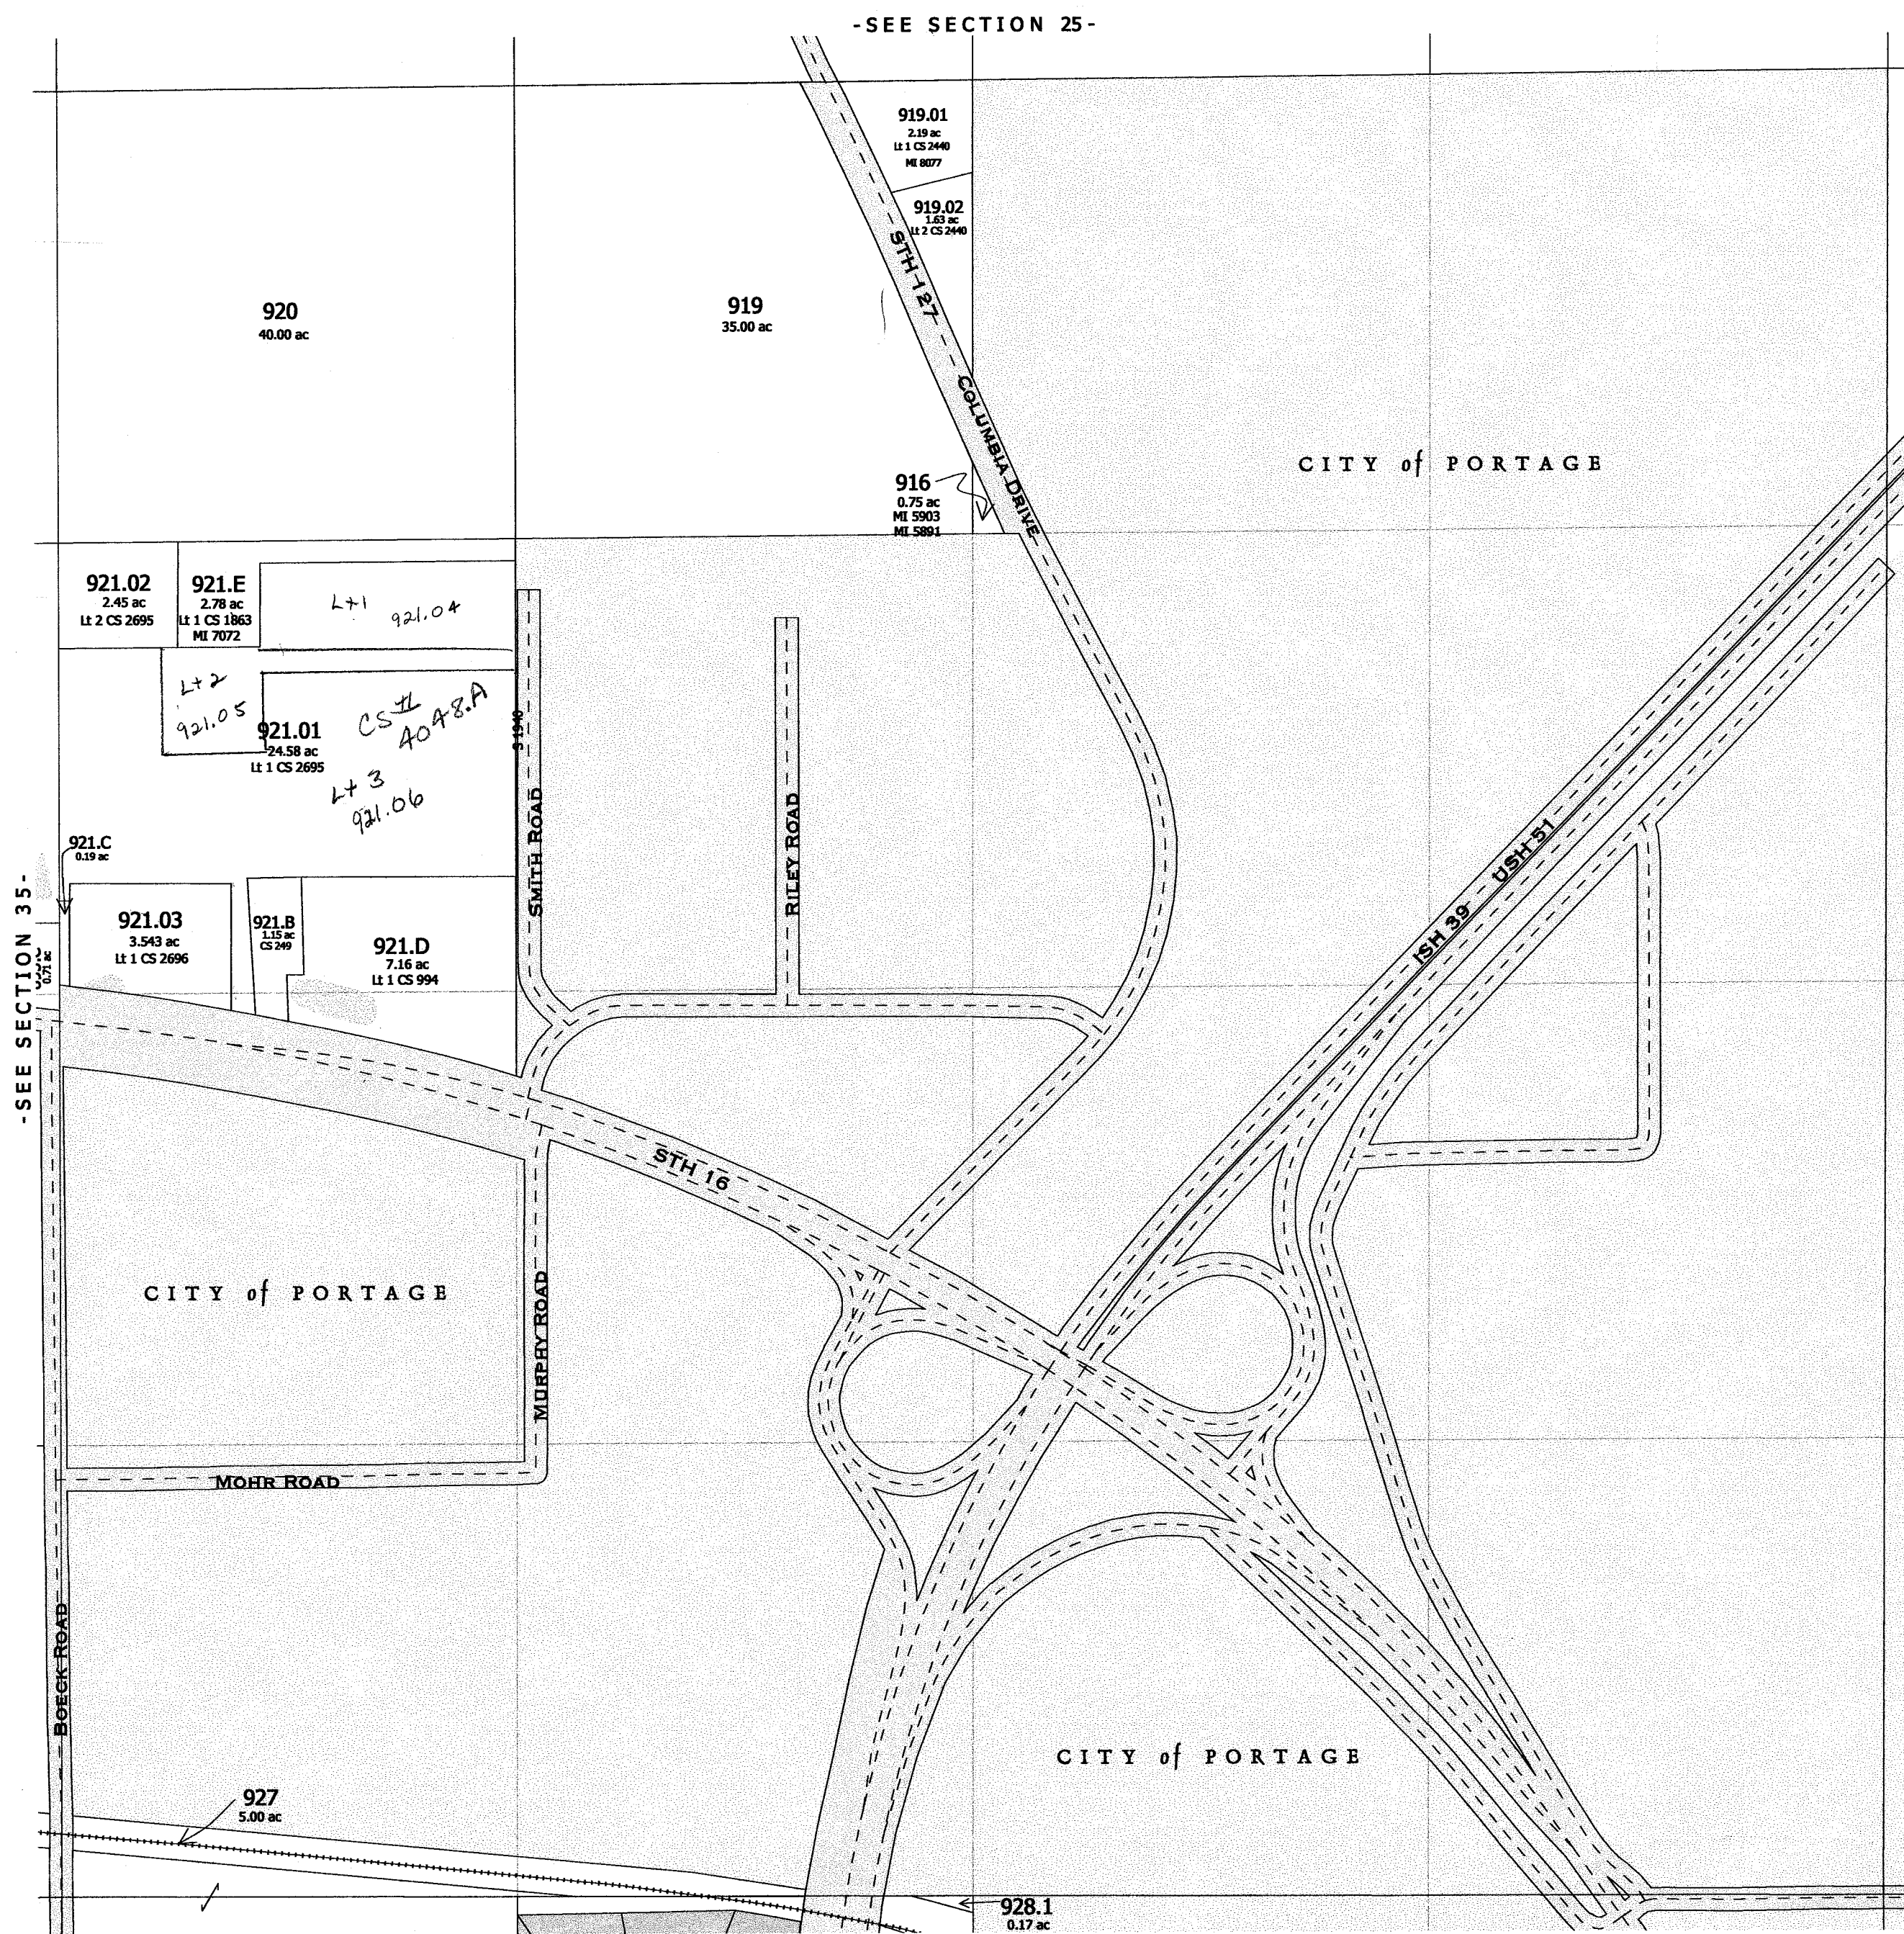

-SEE SECTION 1 T12N R8E-

replaced 2004
SECTION 36-

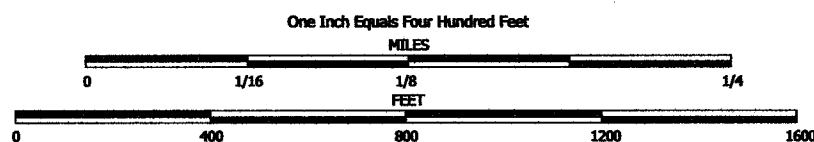



NOTE: This map was prepared for assessment use in accordance with the Wis. St. Stat. Chap. 70.09. All information contained herein is advisory only. Map accuracy is limited to the quality of data obtained from other Public Records. This map is not intended to be a substitute for an actual field survey. Public Land Survey Base is derived from U.S.G.S. Topographic maps unless otherwise noted. Other sources of the Land Base may be actual survey data. Base map data is from the April 1995 County Digital Orthophotos and/or U.S.G.S. 1:24,000 scale Topographic series. The user is responsible for the improper use of the data contained herein.

Created by The Columbia County Land Information Office -GIS Section. VMB.
March 2004.

TAX PARCEL MAP

TOWN of LEWISTON

TOWN 13 NORTH RANGE 8 EAST
COLUMBIA COUNTY, WISCONSIN

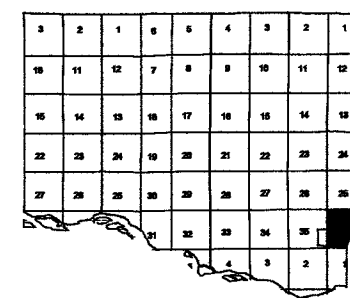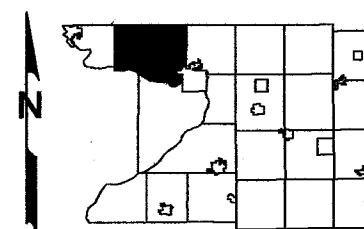


Replaced

Replaced

2005

-SEE SECTION 25-

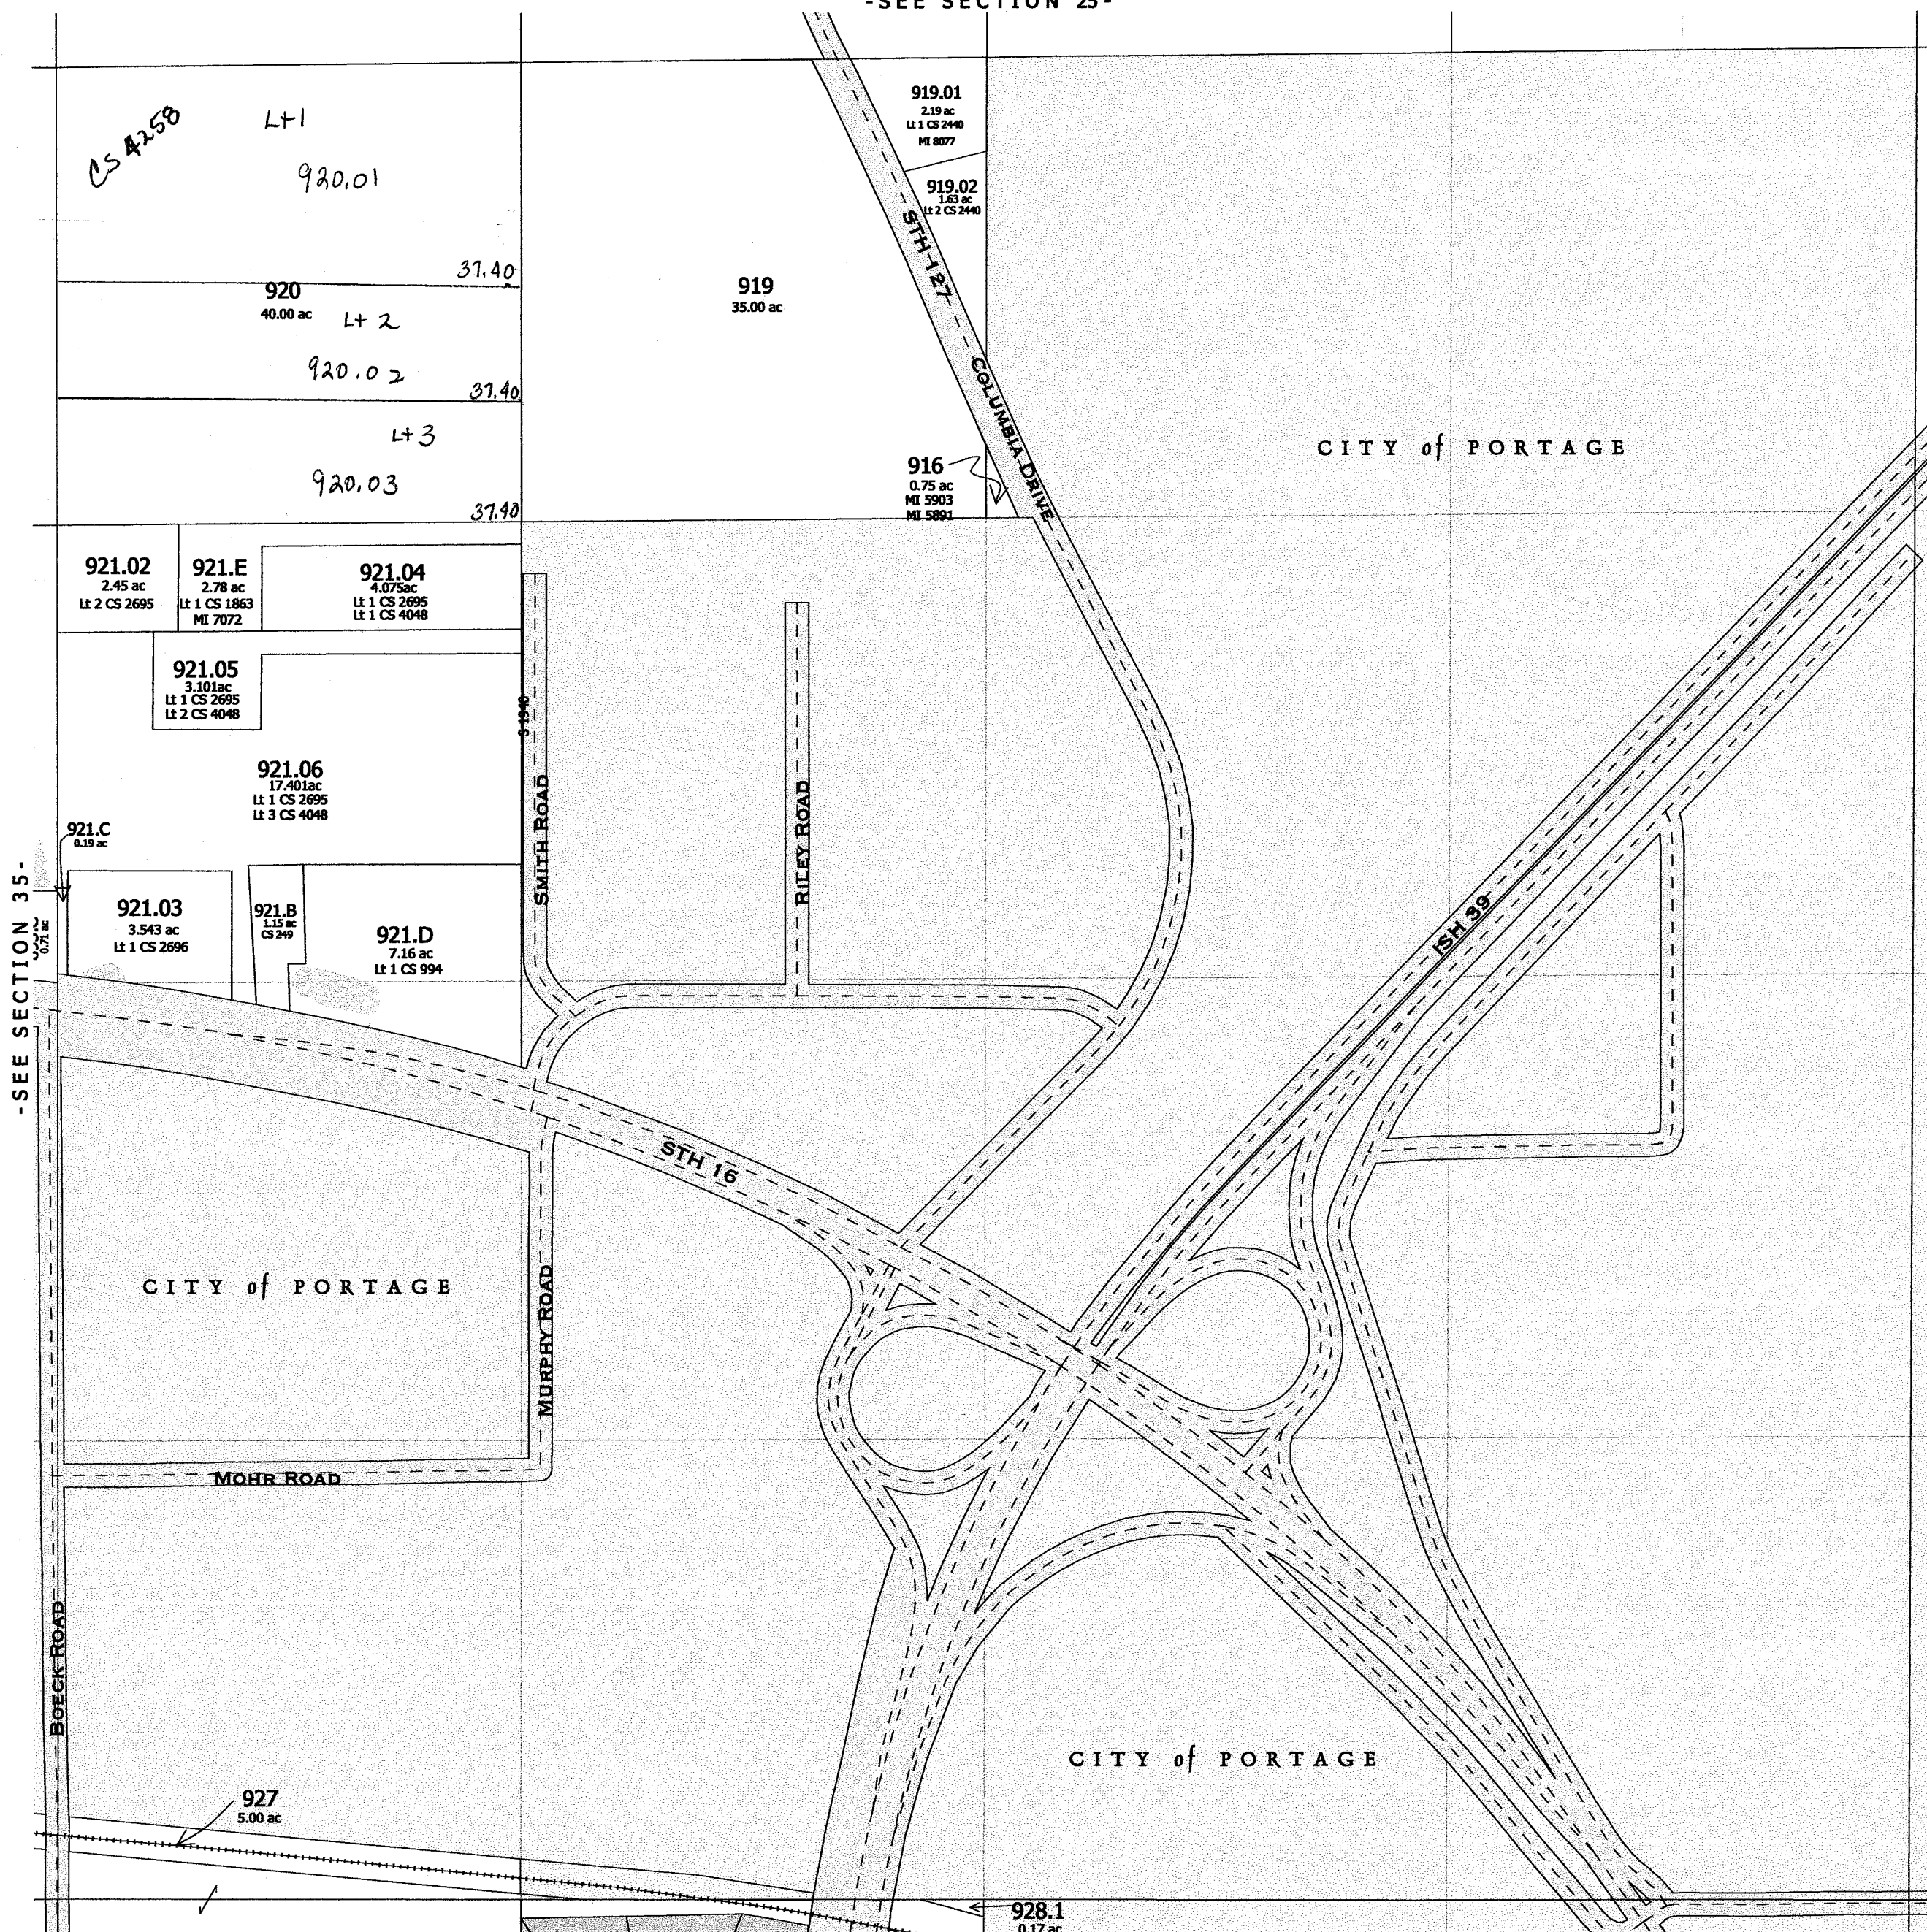


-SEE SECTION 35-

-SEE SECTION 1 T12N R8E-

Replaced
2005


-SECTION 36-

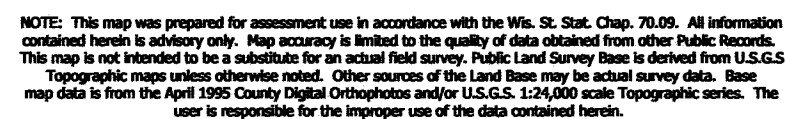


Created by The Columbia County Land Information Office -GIS Section. VMB.
February 2005.

TOWN of LEWISTON

TOWN 13 NORTH RANGE 8 EAST
COLUMBIA COUNTY, WISCONSIN

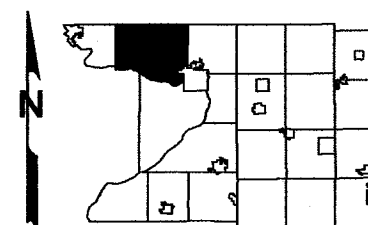


~~Replaced~~
2006

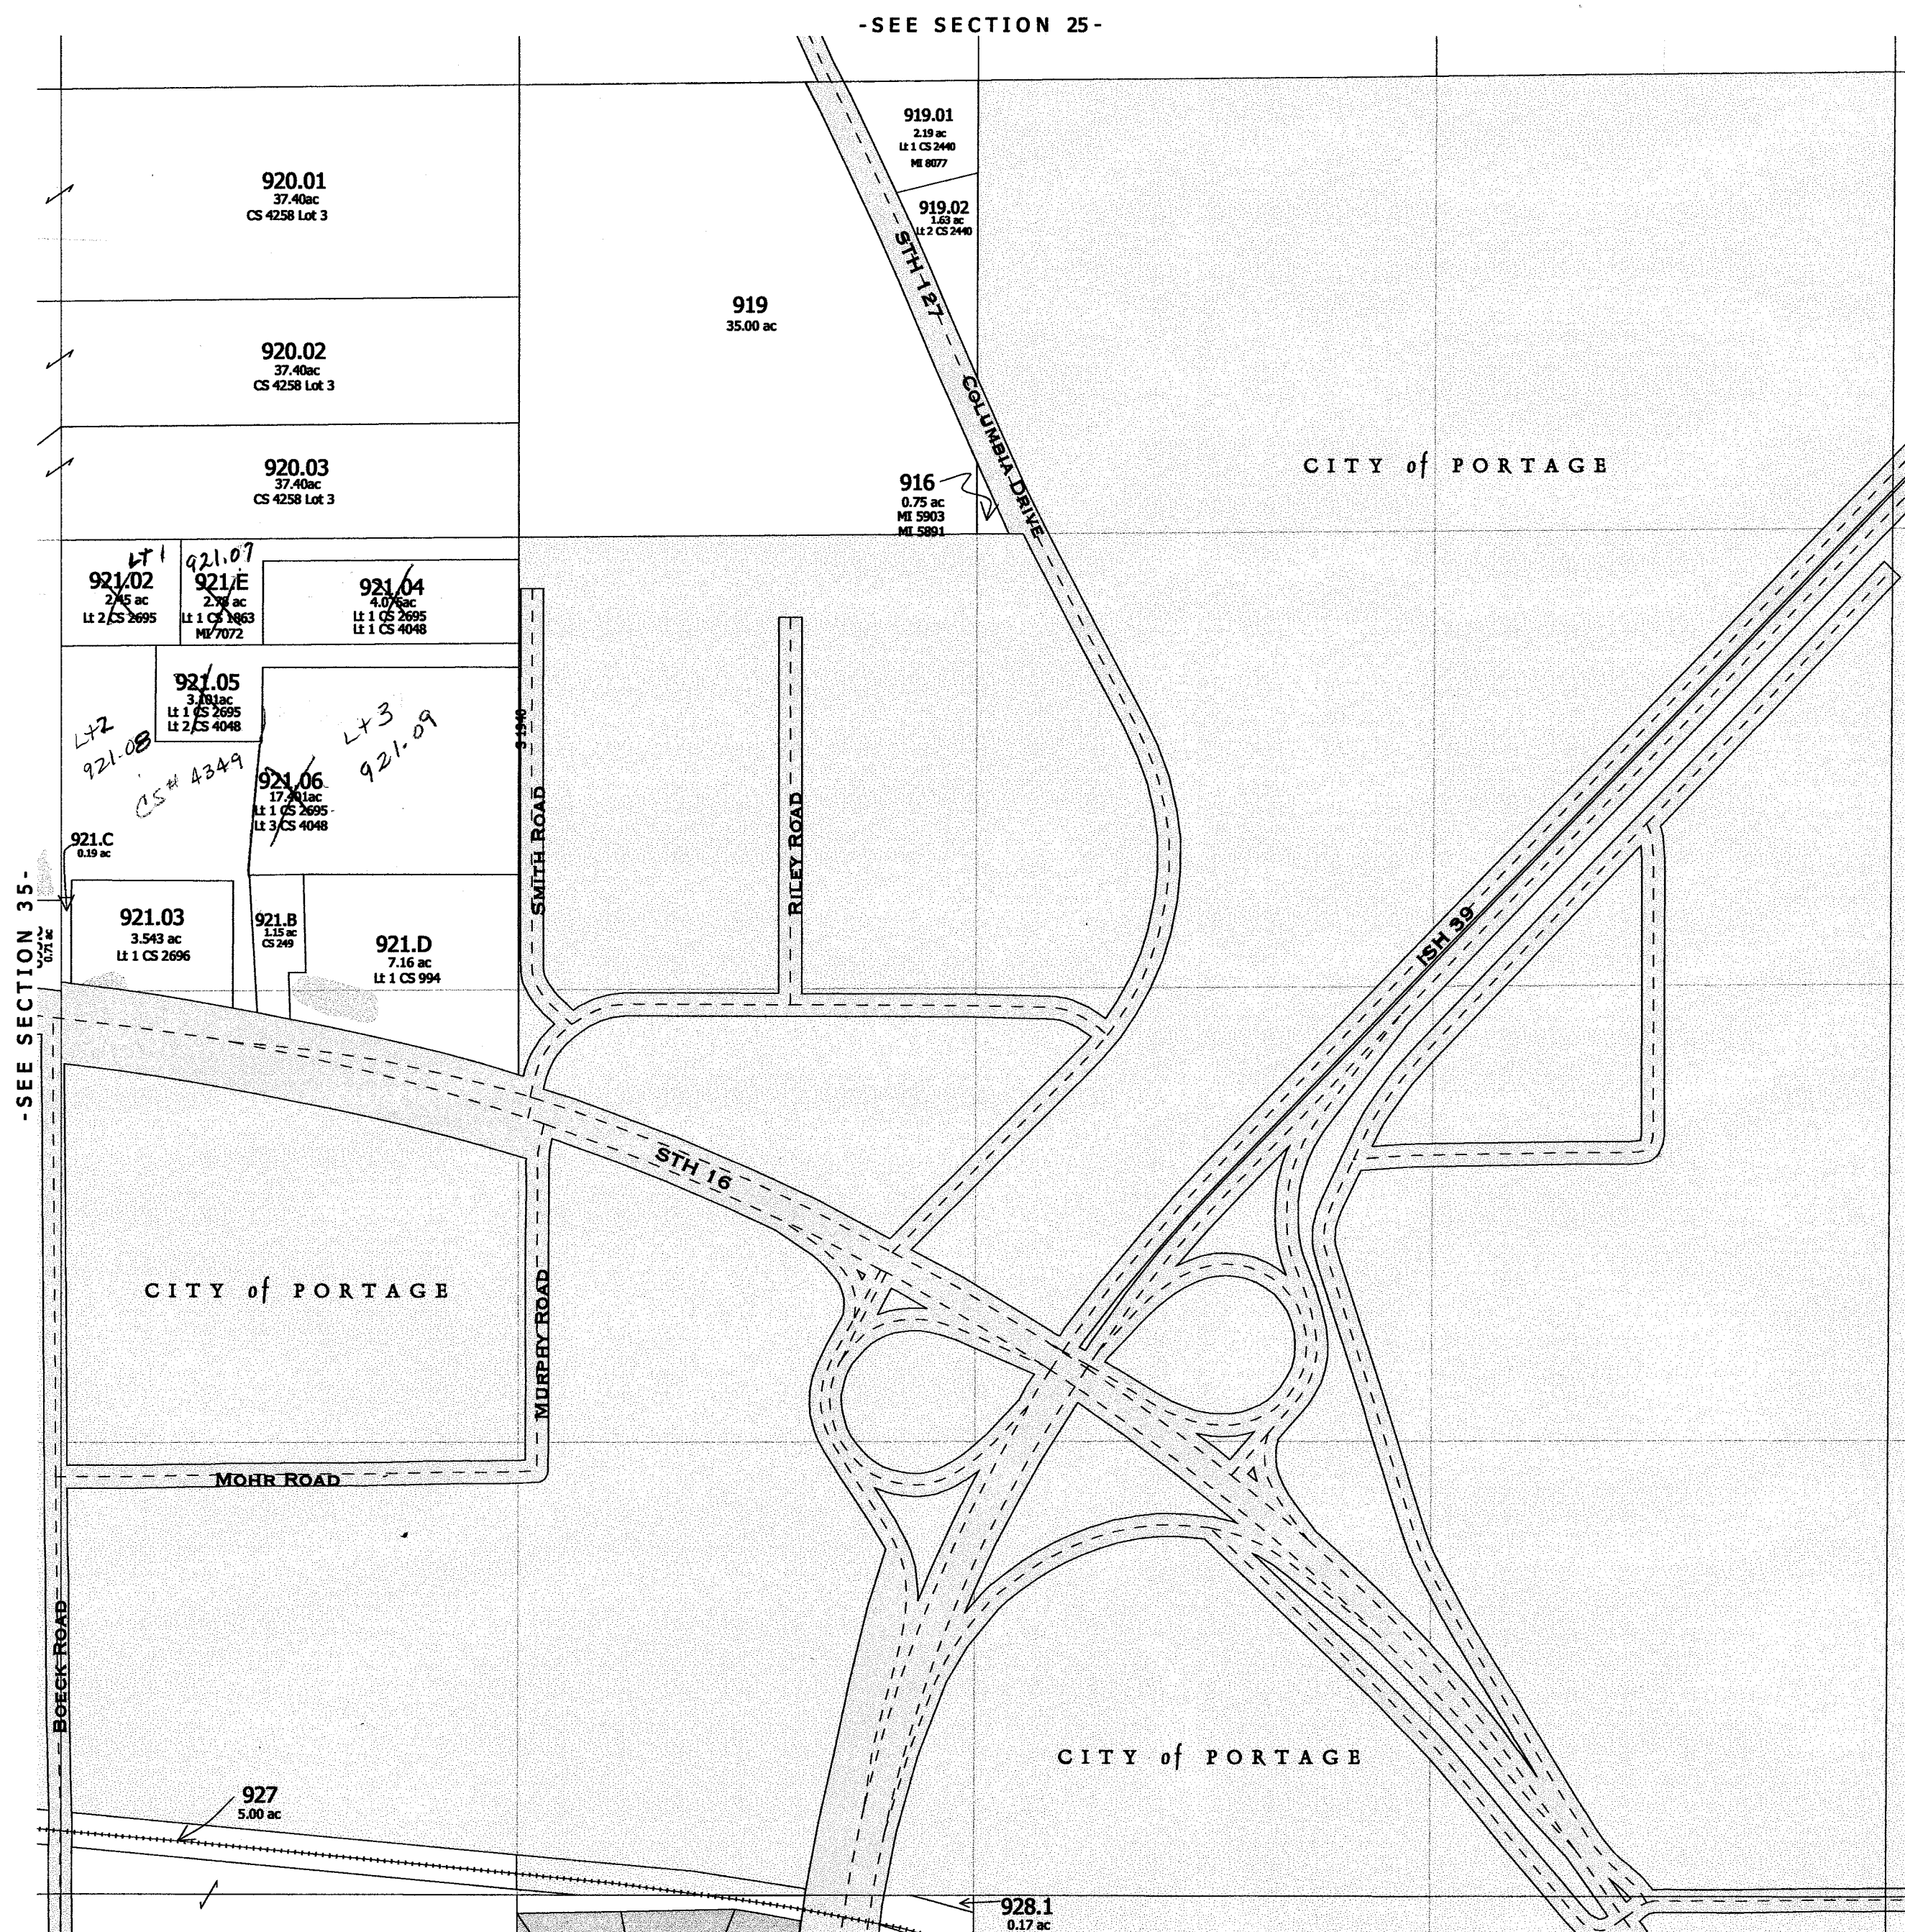

-SEE SECTION 1 T12N R8E -

Replaced
200


- SECTION 36 -

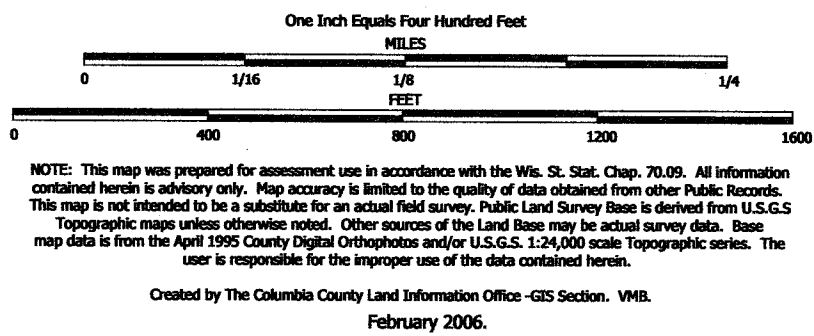

TAX PARCEL MAP


TOWN of LEWISTON


TOWN 13 NORTH RANGE 8 EAST
COLUMBIA COUNTY, WISCONSIN

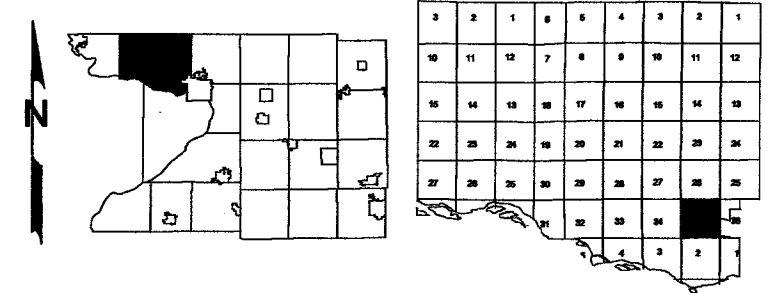

Replaced
2009

-SEE SECTION 26-

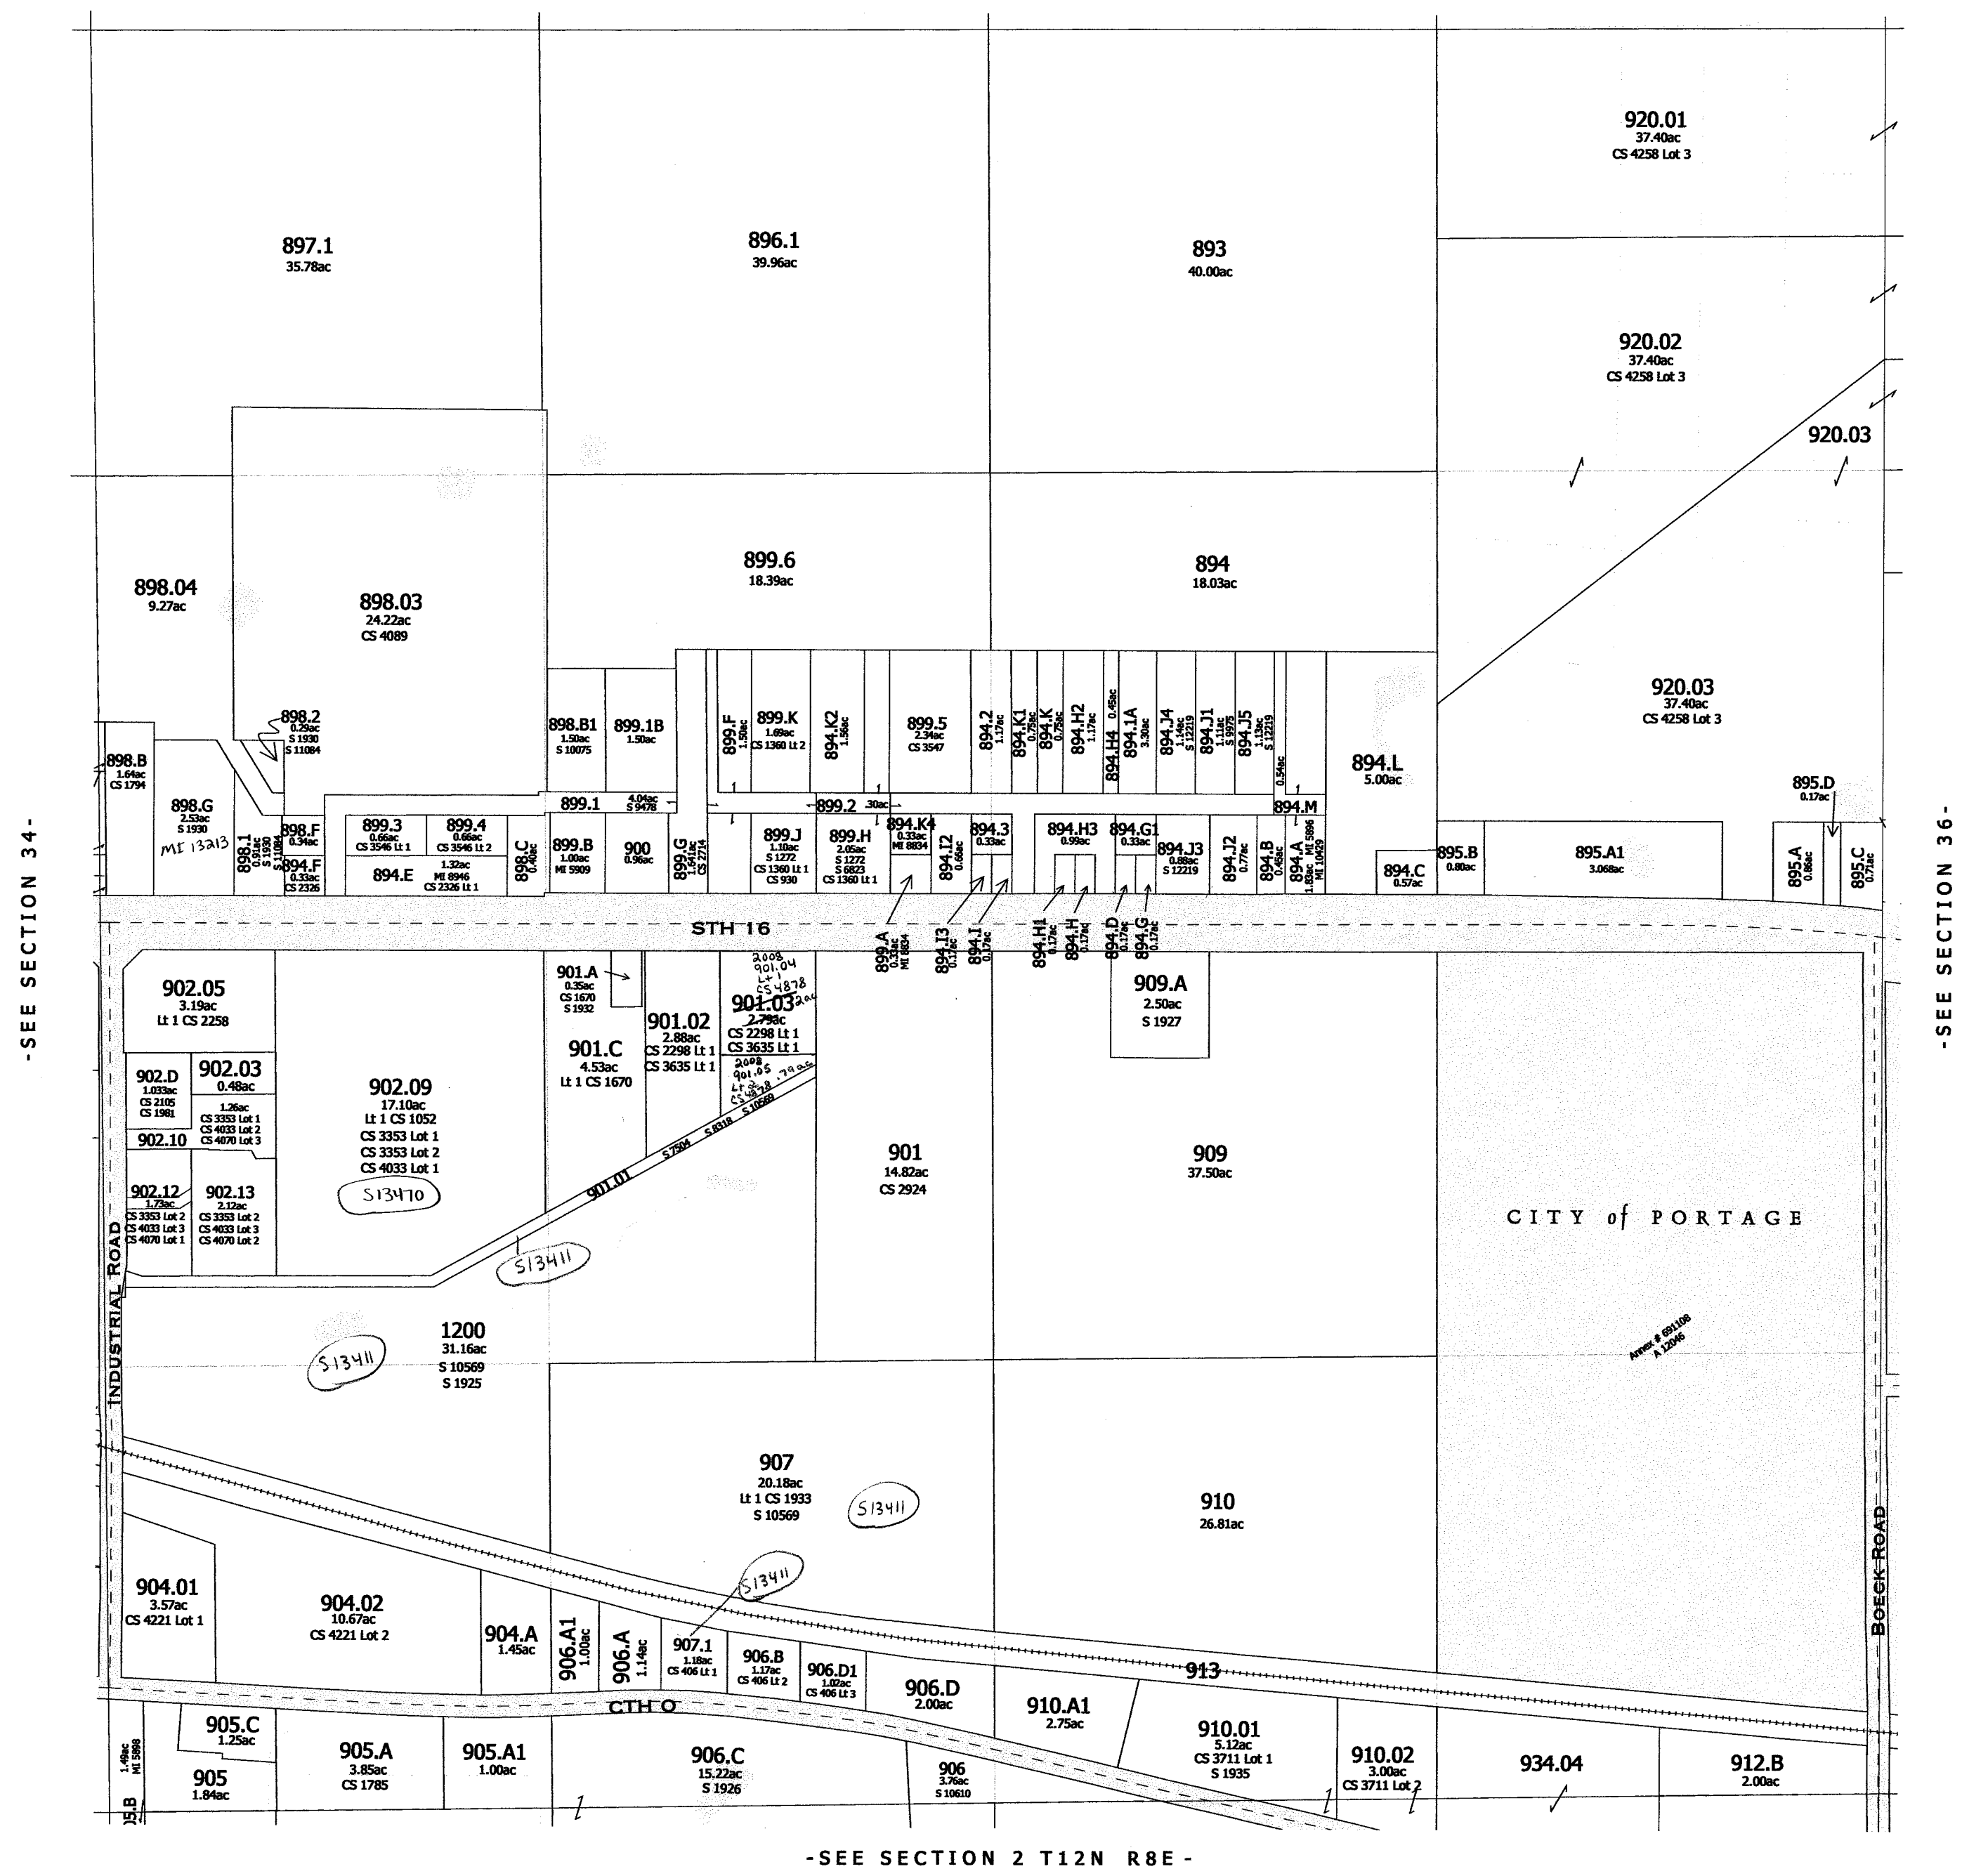


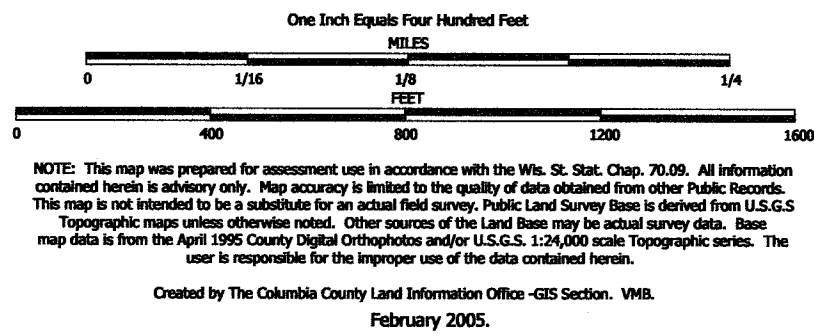


TAX PARCEL MAP

TOWN of LEWISTON

TOWN 13 NORTH RANGE 8 EAST
COLUMBIA COUNTY, WISCONSIN

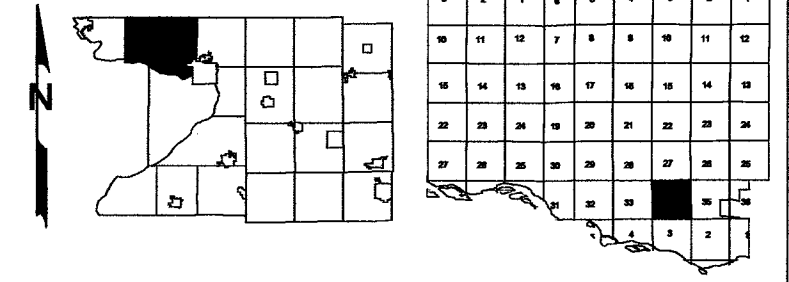

Replaced
2009

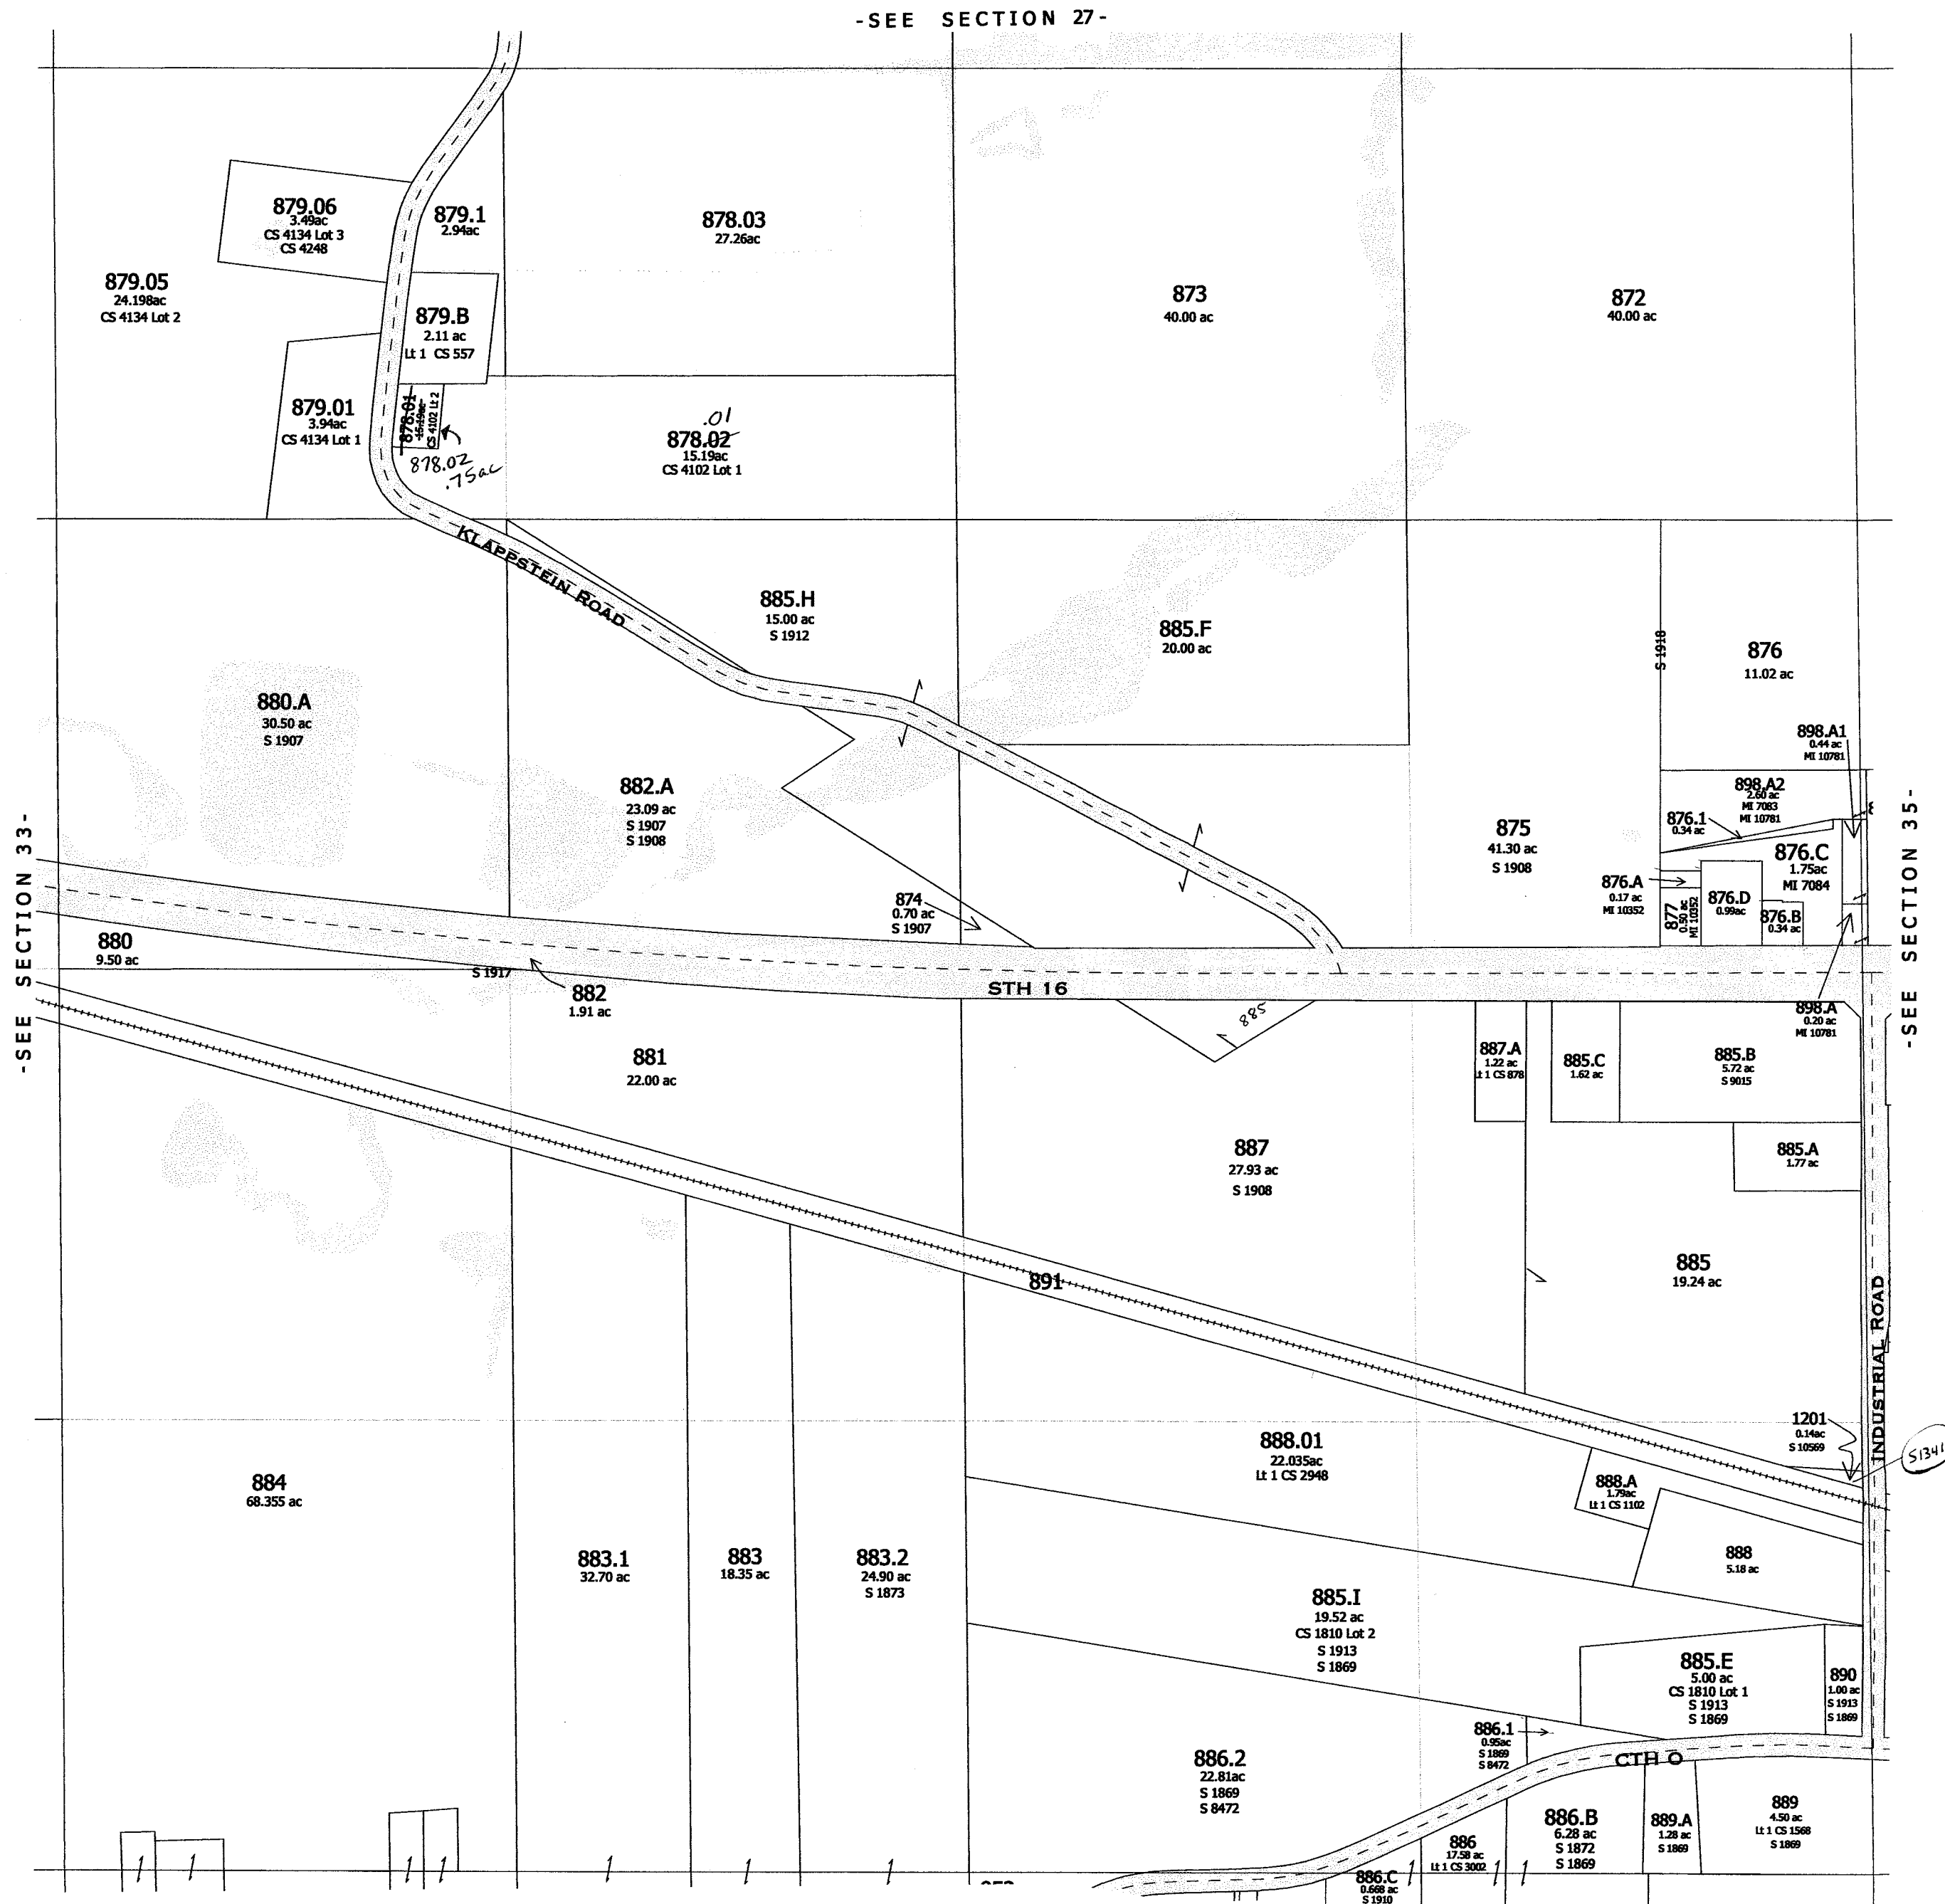

-SEE SECTION 3 T12N R8E -

PLAT PLAN (ALONG STH 16) - S 1920
- S 1919

-SECTION 34-

One Inch Equals Four Hundred Feet
MILES
0 1/16 1/8 1/4
FEET
0 400 800 1200 1600



NOTE: This map was prepared for assessment use in accordance with the Wis. St. Stat. Chap. 70.09. All information contained herein is advisory only. Map accuracy is limited to the quality of data obtained from other Public Records. This map is not intended to be a substitute for an actual field survey. Public Land Survey Base is derived from U.S.G.S. Topographic maps unless otherwise noted. Other sources of the Land Base may be actual survey data. Base map data is from the April 1995 County Digital Orthophotos and/or U.S.G.S. 1:24,000 scale Topographic series. The user is responsible for the improper use of the data contained herein.


Created by The Columbia County Land Information Office -GIS Section. VMB.
February 2005.

TAX PARCEL MAP

TOWN of LEWISTON

TOWN 13 NORTH RANGE 8 EAST
COLUMBIA COUNTY, WISCONSIN

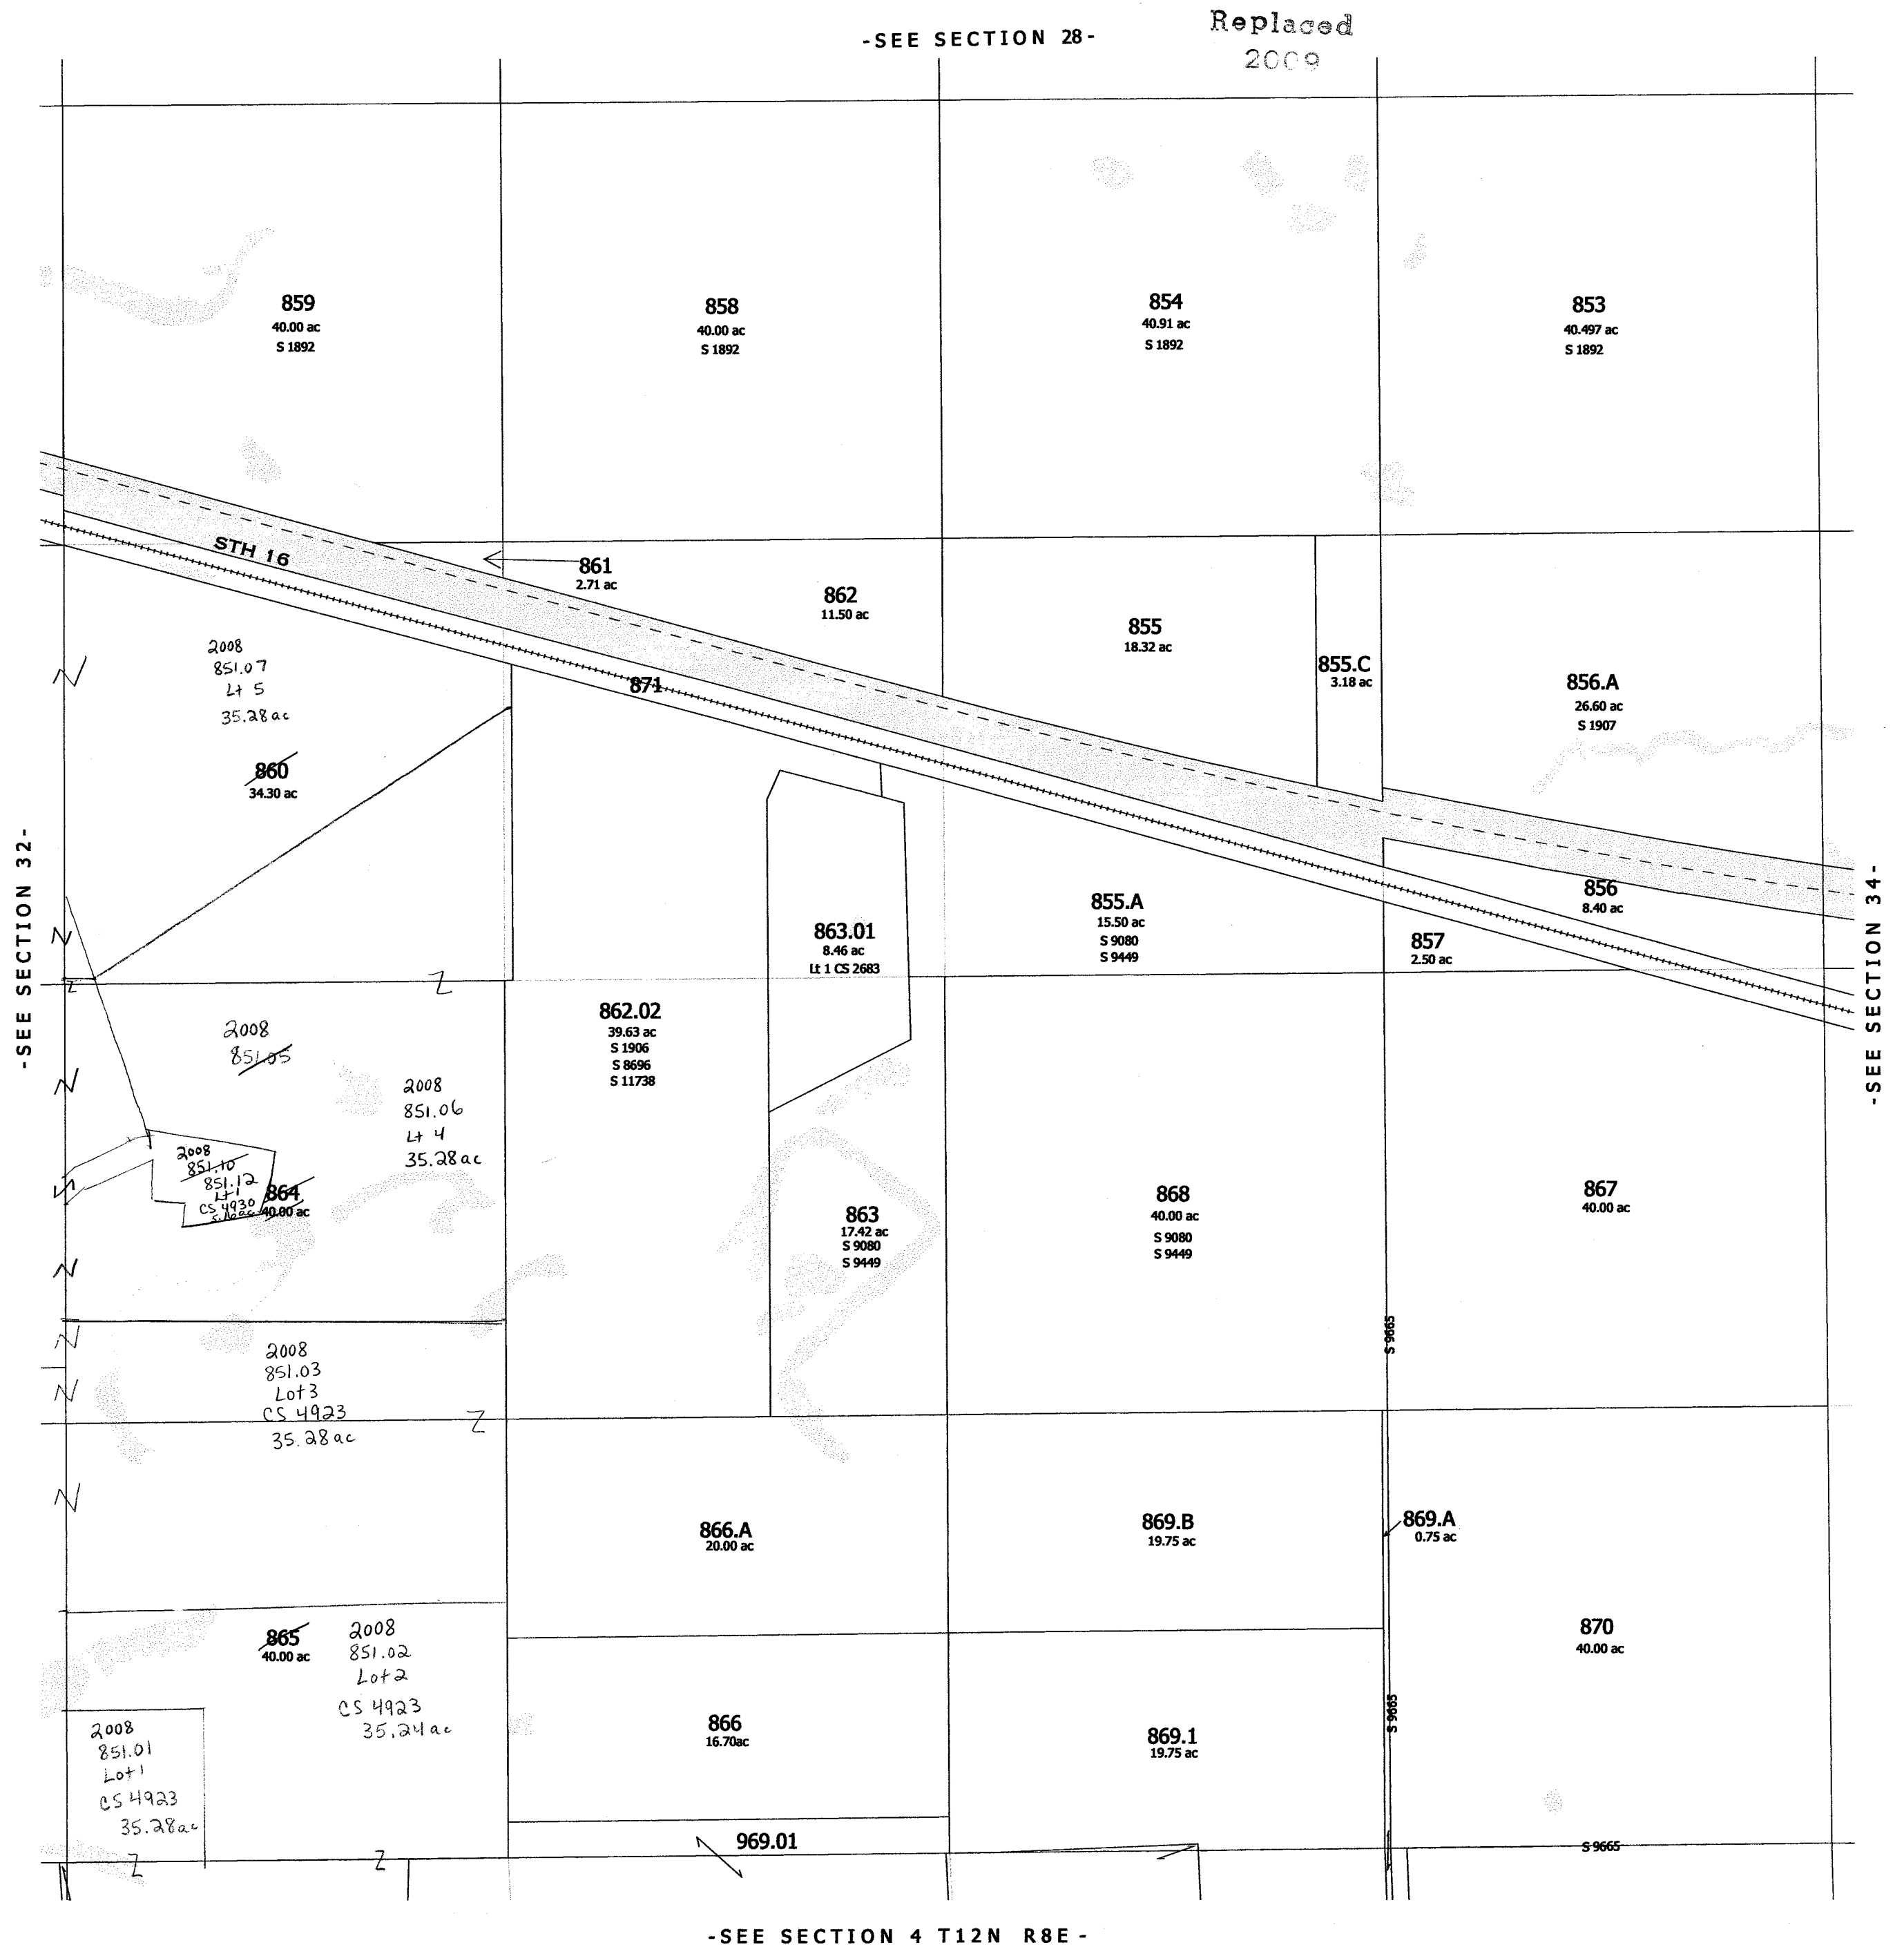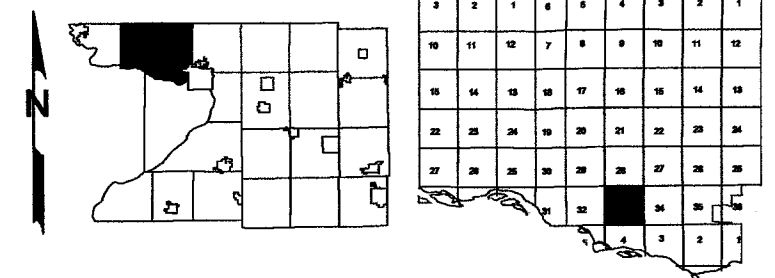


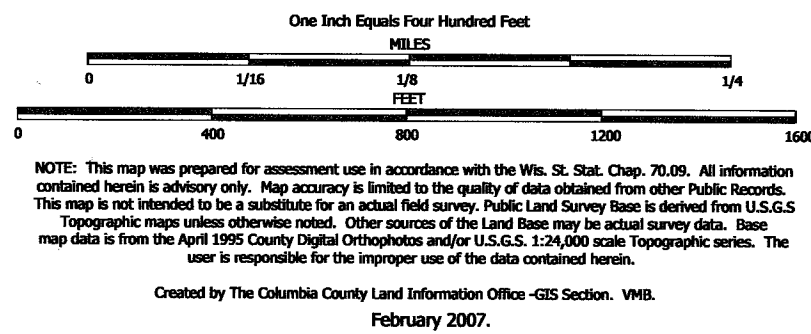

TAX PARCEL MAP

TOWN of LEWISTON

TOWN 13 NORTH RANGE 8 EAST
COLUMBIA COUNTY, WISCONSIN

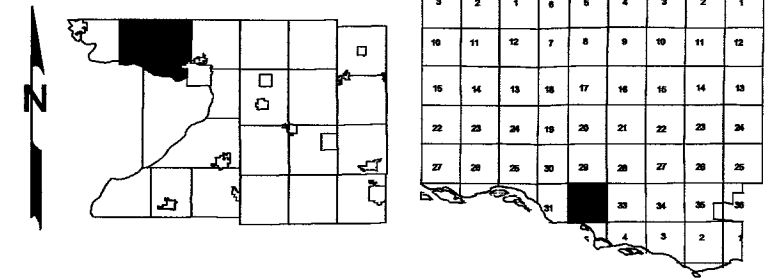

Replaced
2009

-SEE SECTION 29-



-SEE SECTION 5 T12N R8E-

-SECTION 32-

Also
2008

One Inch Equals Four Hundred Feet

MILES
0 1/16 1/8 1/4

FEET
0 400 800 1200 1600


NOTE: This map was prepared for assessment use in accordance with the Wis. St. Stat. Chap. 70.09. All information contained herein is advisory only. Map accuracy is limited to the quality of data obtained from other Public Records. This map is not intended to be a substitute for an actual field survey. Public Land Survey Base is derived from U.S.G.S. Topographic maps unless otherwise noted. Other sources of the Land Base may be actual survey data. Base map data is from the April 1995 County Digital Orthophotos and/or U.S.G.S. 1:24,000 scale Topographic series. The user is responsible for the improper use of the data contained herein.

Created by The Columbia County Land Information Office -GIS Section. VMB.
March 2004.

TAX PARCEL MAP


TOWN of LEWISTON

TOWN 13 NORTH RANGE 8 EAST
COLUMBIA COUNTY, WISCONSIN

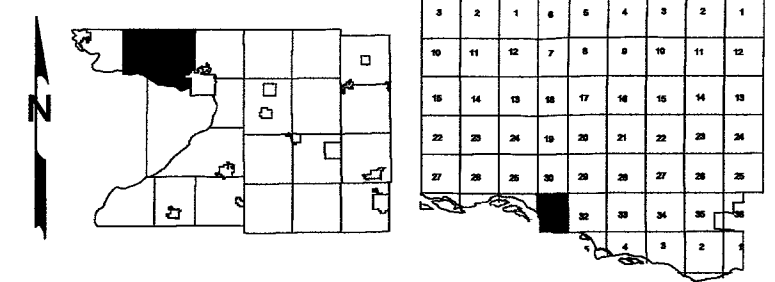

Replaced
2009

-SEE SECTION 30-

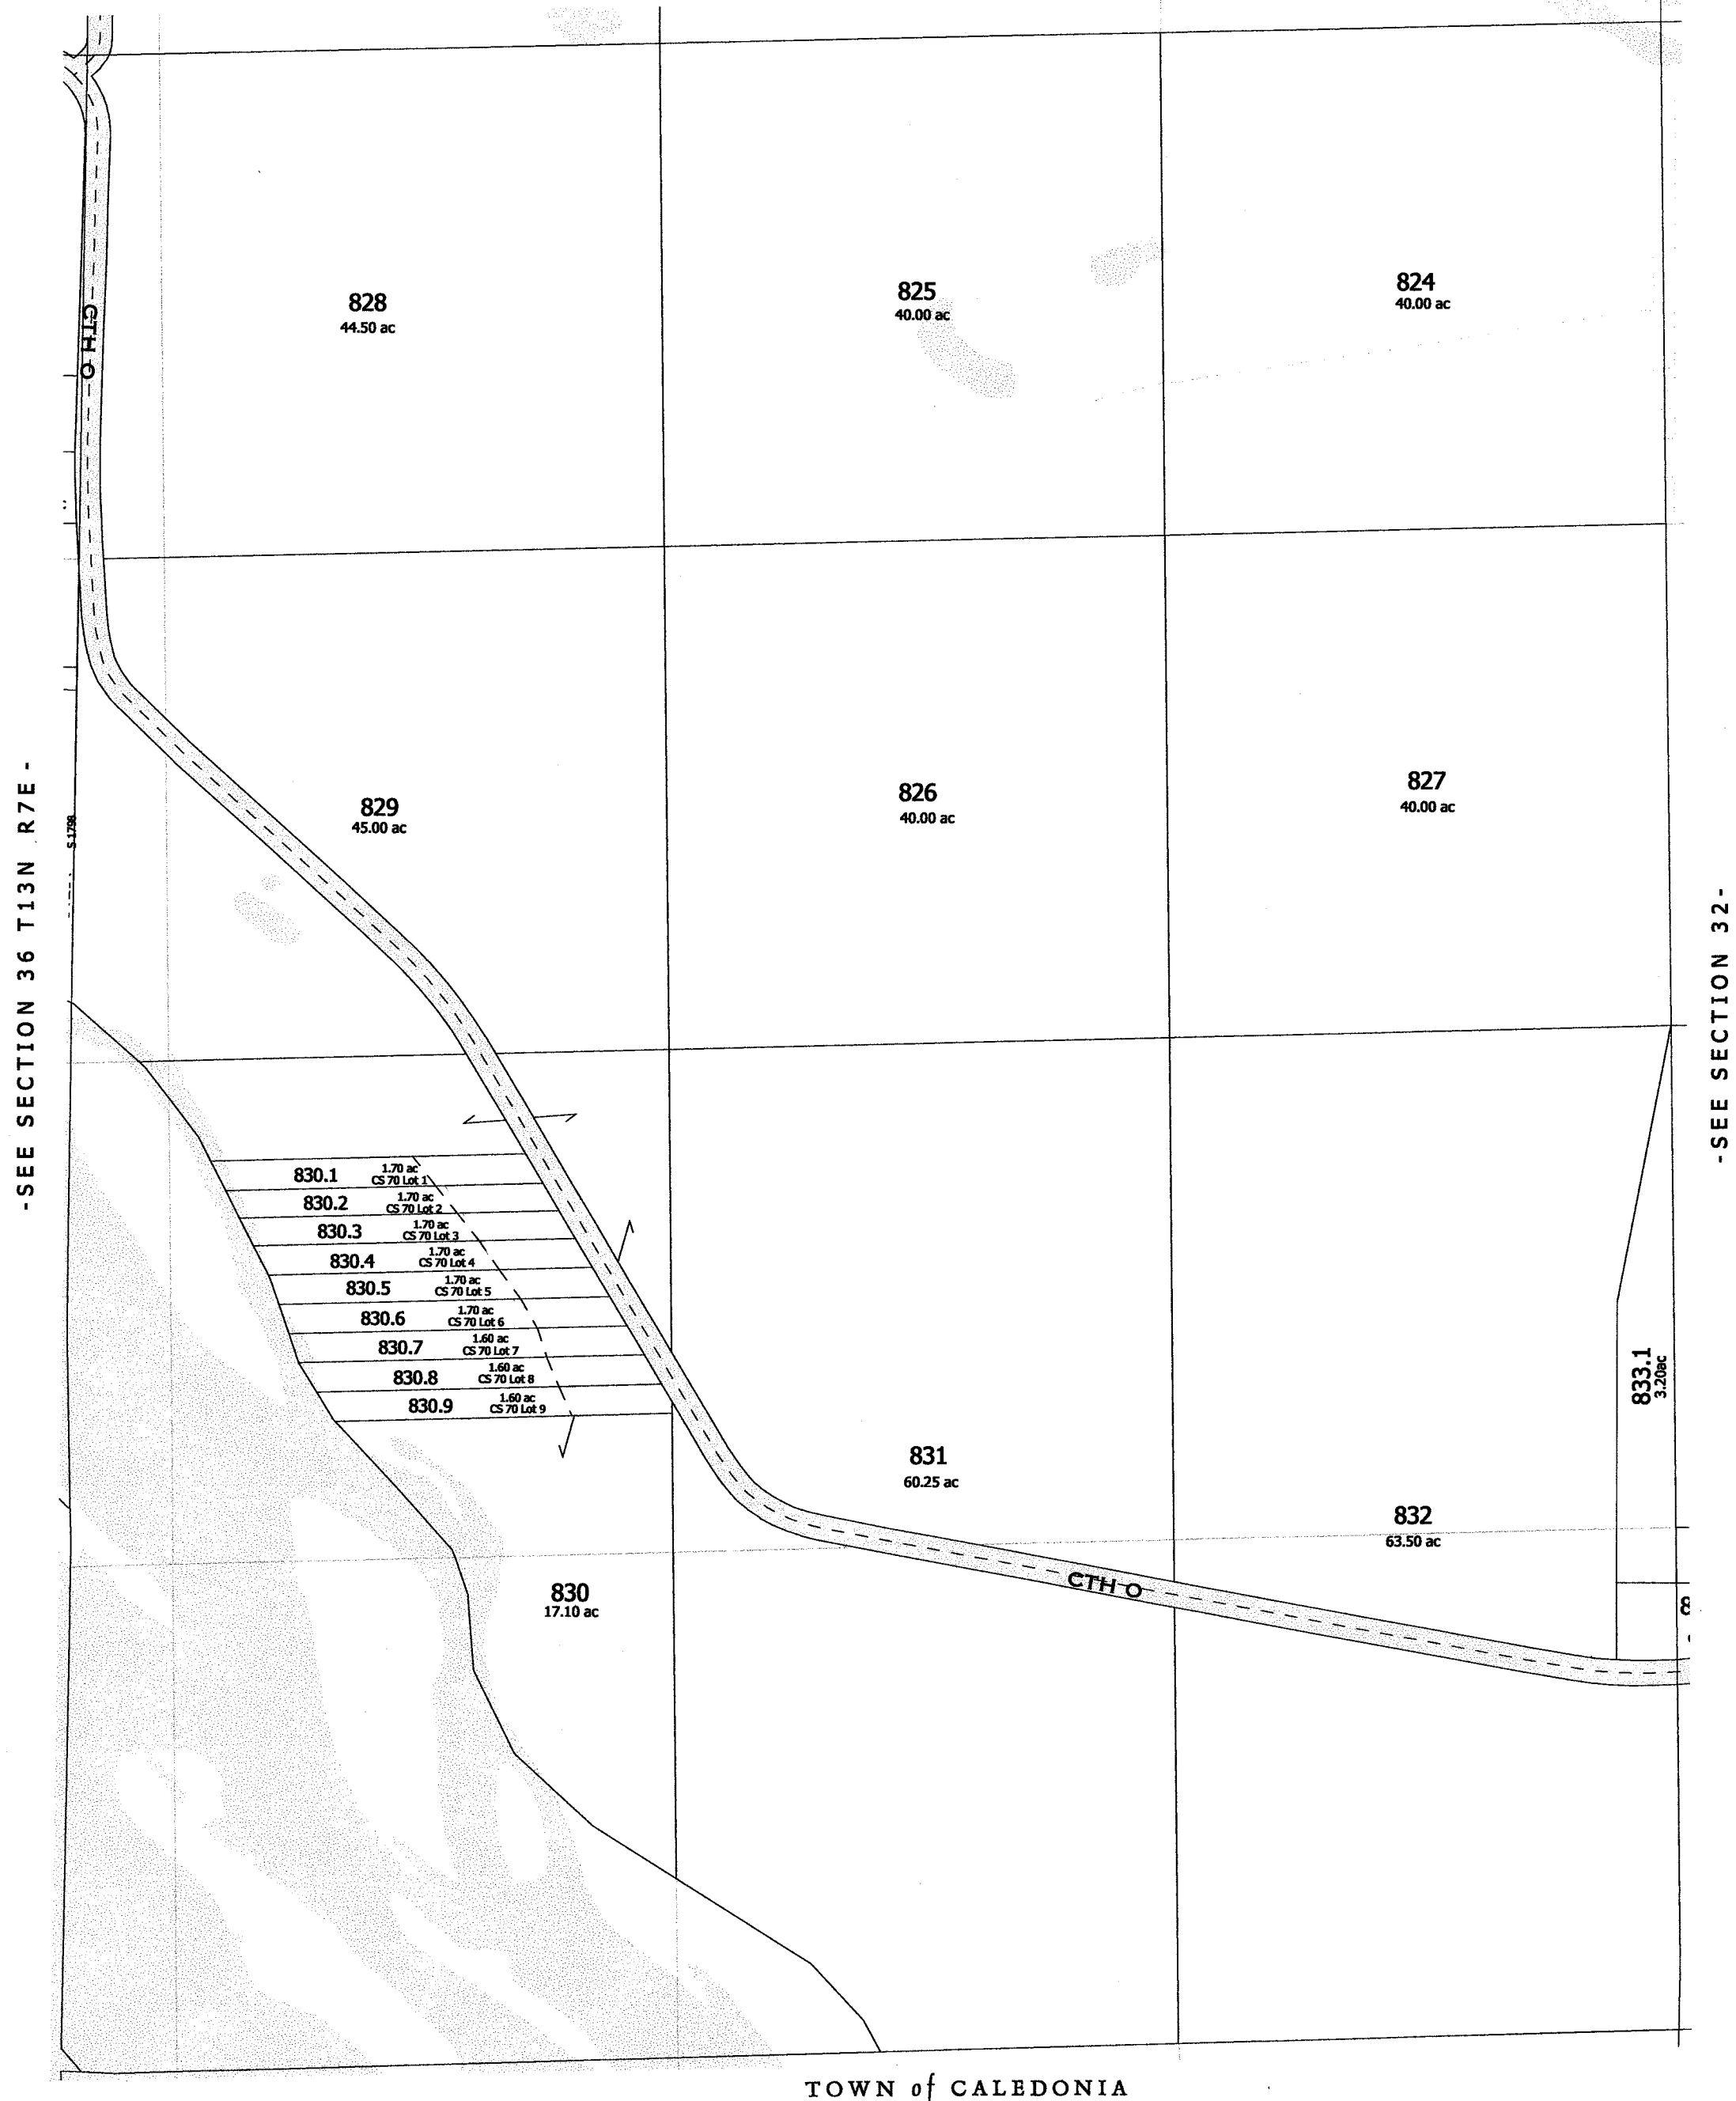

-SECTION 31-

One Inch Equals Four Hundred Feet

MILES
0 1/16 1/8 1/4

FEET
0 400 800 1200 1600


NOTE: This map was prepared for assessment use in accordance with the Wis. St. Stat. Chap. 70.09. All information contained herein is advisory only. Map accuracy is limited to the quality of data obtained from other Public Records. This map is not intended to be a substitute for an actual field survey. Public Land Survey Base is derived from U.S.G.S. Topographic maps unless otherwise noted. Other sources of the Land Base may be actual survey data. Base map data is from the April 1995 County Digital Orthophotos and/or U.S.G.S. 1:24,000 scale Topographic series. The user is responsible for the improper use of the data contained herein.

Created by The Columbia County Land Information Office -GIS Section. VMB.
September 2002.

TAX PARCEL MAP

TOWN of LEWISTON


TOWN 13 NORTH RANGE 8 EAST
COLUMBIA COUNTY, WISCONSIN

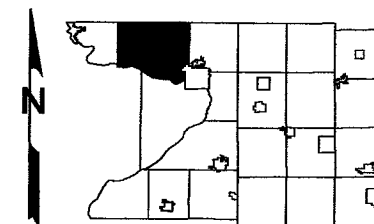

1	2	3	4	5	6	7	8	9	10	11	12
13	14	15	16	17	18	19	20	21	22	23	24
25	26	27	28	29	30	31	32	33	34	35	36
37	38	39	40	41	42	43	44	45	46	47	48

Replaced
2009

-SEE SECTION 19-

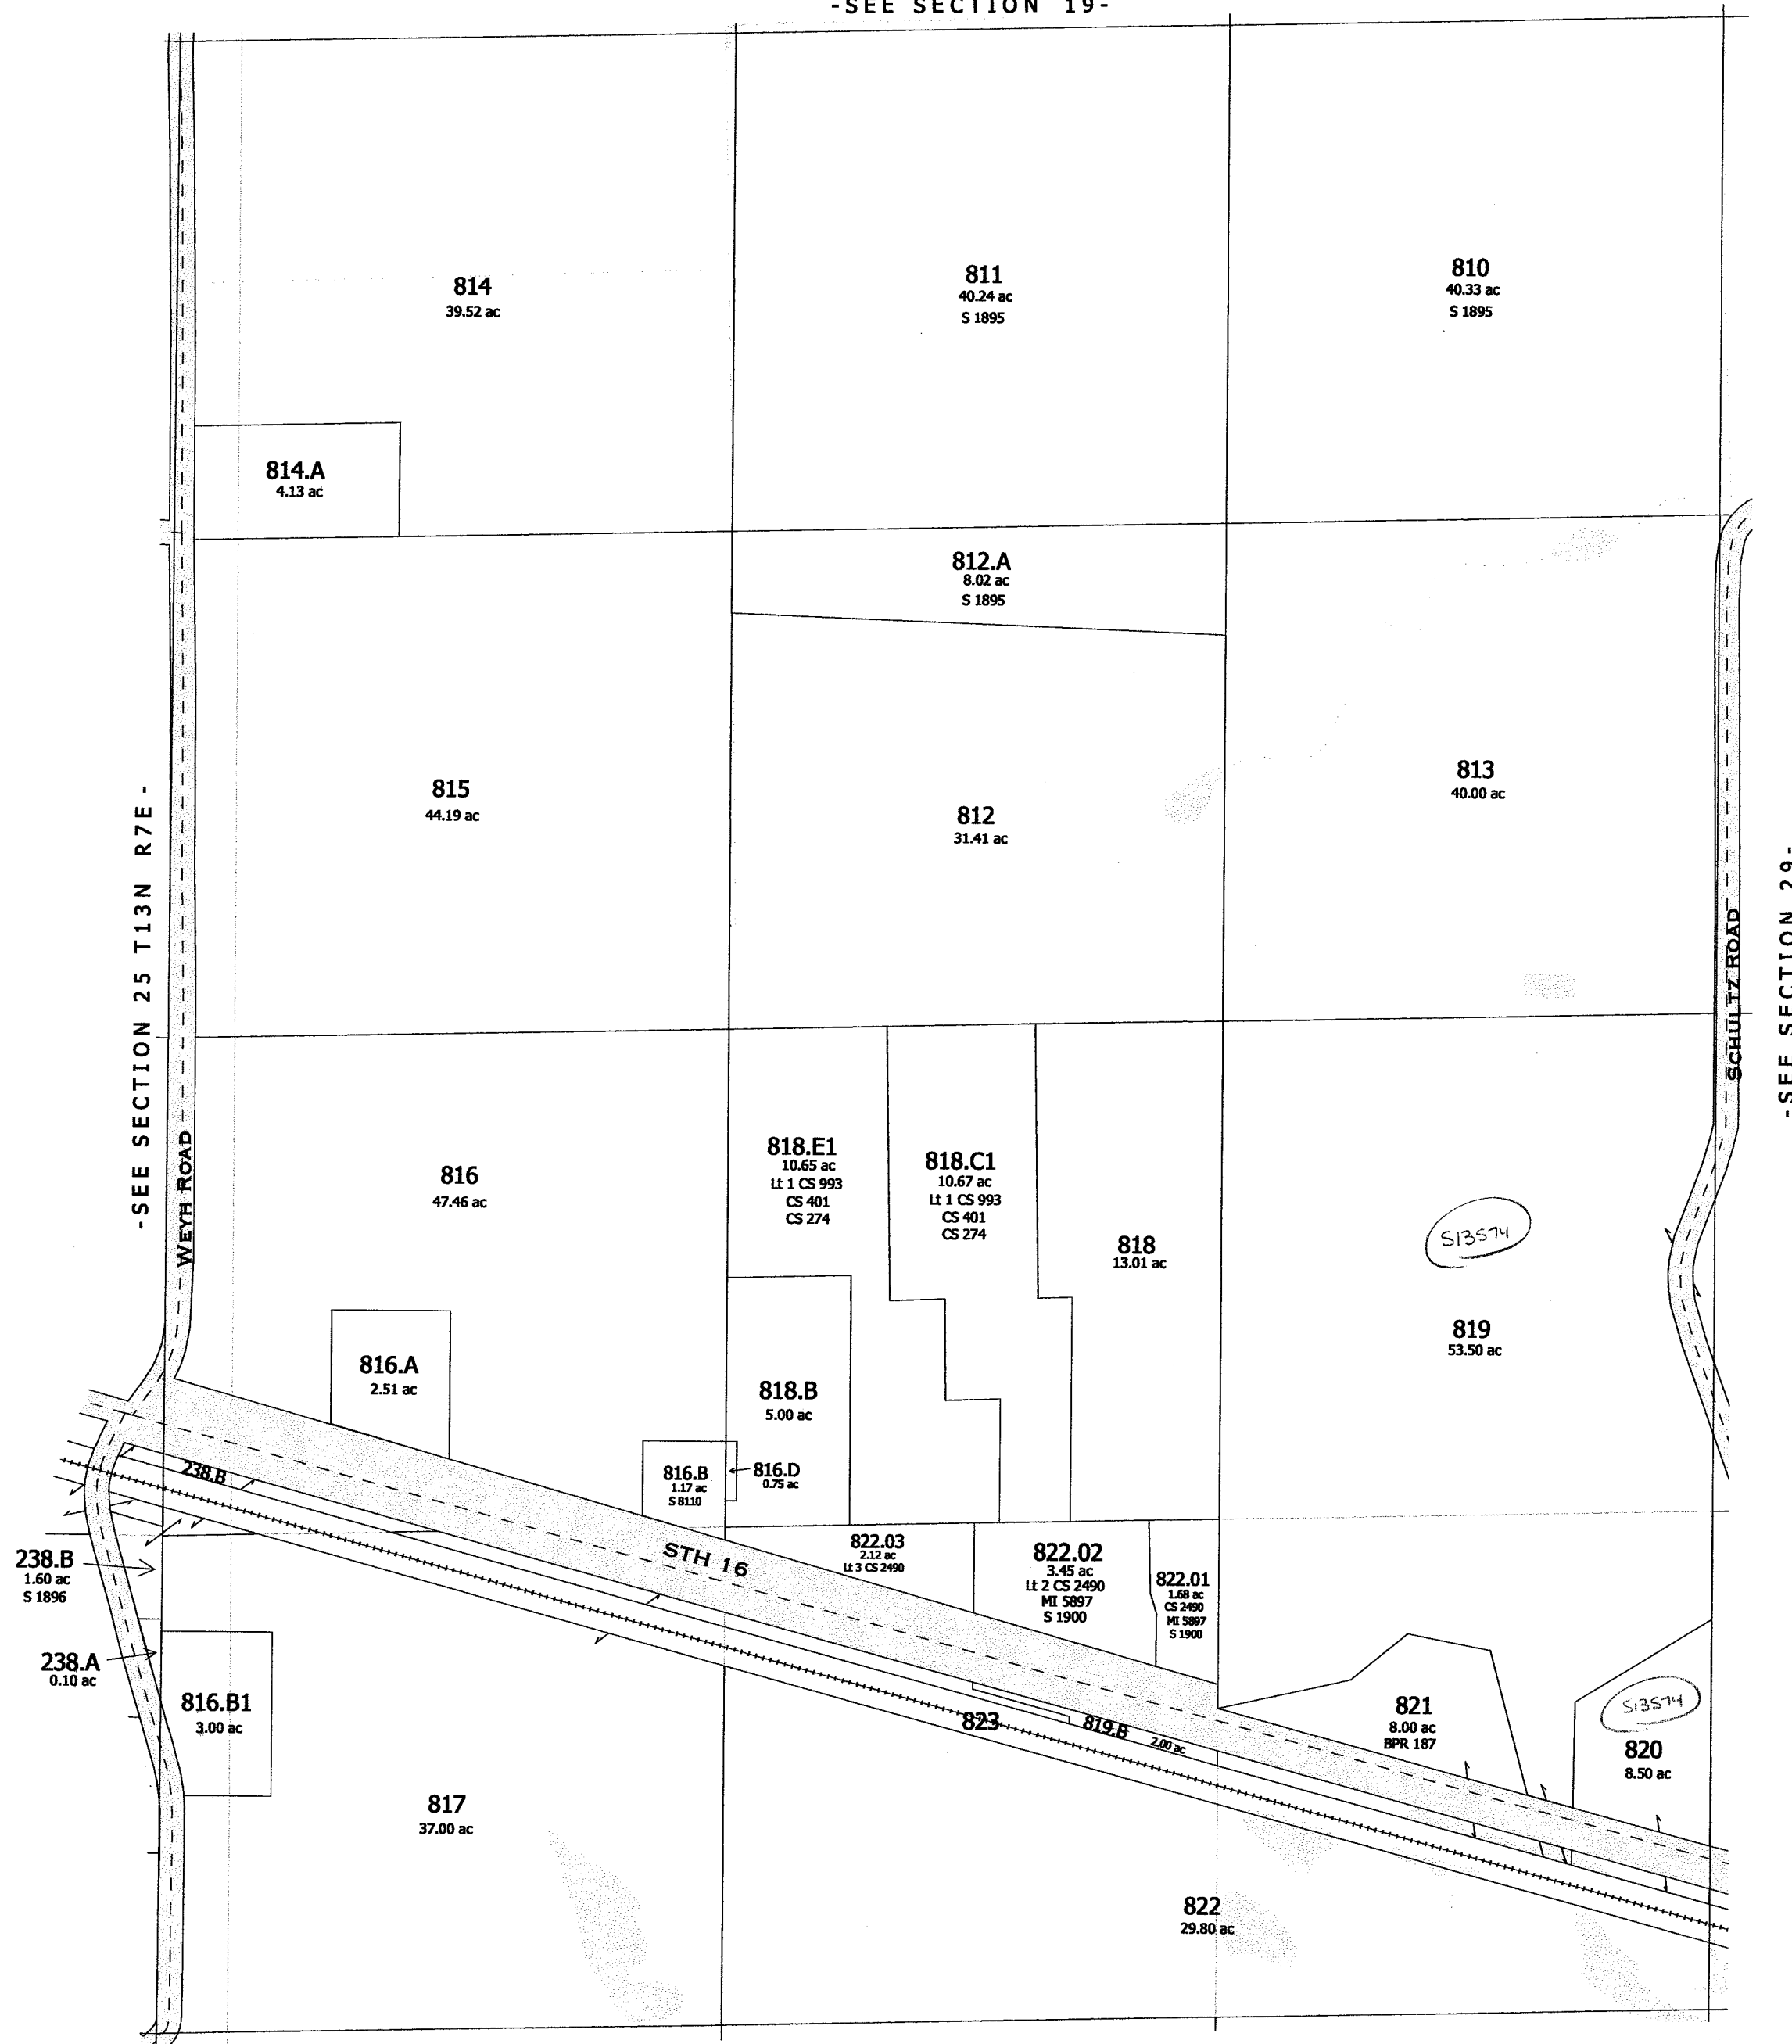

-SEE SECTION 29-

-SEE SECTION 31-

One Inch Equals Four Hundred Feet
MILES
0 1/16 1/8 1/4
FEET
0 400 800 1200 1600


NOTE: This map was prepared for assessment use in accordance with the Wis. St. Stat. Chap. 70.09. All information contained herein is advisory only. Map accuracy is limited to the quality of data obtained from other Public Records. This map is not intended to be a substitute for an actual field survey. Public Land Survey Base is derived from U.S.G.S. Topographic maps unless otherwise noted. Other sources of the Land Base may be actual survey data. Base map data is from the April 1995 County Digital Orthophotos and/or U.S.G.S. 1:24,000 scale Topographic series. The user is responsible for the improper use of the data contained herein.

Created by The Columbia County Land Information Office -GIS Section. VMB.
September 2002.

TAX PARCEL MAP

TOWN of LEWISTON

TOWN 13 NORTH RANGE 8 EAST
COLUMBIA COUNTY, WISCONSIN

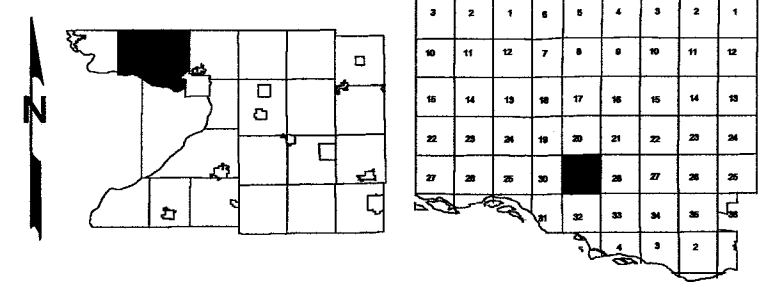

-SEE SECTION 32-

Also 2008
-SECTION 29-

One Inch Equals Four Hundred Feet
MILES
0 1/16 1/8 1/4
FEET
0 400 800 1200 1600



NOTE: This map was prepared for assessment use in accordance with the Wis. St. Stat. Chap. 70.09. All information contained herein is advisory only. Map accuracy is limited to the quality of data obtained from other Public Records. This map is not intended to be a substitute for an actual field survey. Public Land Survey Base is derived from U.S.G.S. Topographic maps unless otherwise noted. Other sources of the Land Base may be actual survey data. Base map data is from the April 1995 County Digital Orthophotos and/or U.S.G.S. 1:24,000 scale Topographic series. The user is responsible for the improper use of the data contained herein.

Created by The Columbia County Land Information Office -GIS Section. VMB.
February 2005.

TAX PARCEL MAP

TOWN of LEWISTON

TOWN 13 NORTH RANGE 8 EAST
COLUMBIA COUNTY, WISCONSIN

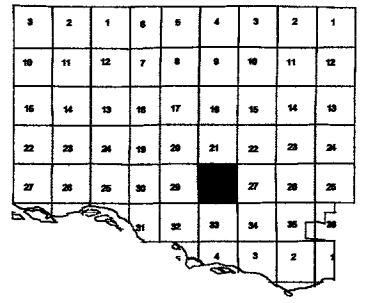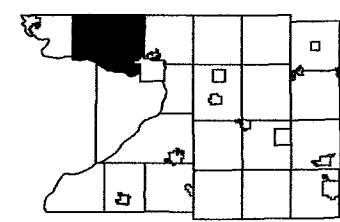

One Inch Equals Four Hundred Feet
MILES
0 1/16 1/8 1/4
FEET
0 400 800 1200 1600


NOTE: This map was prepared for assessment use in accordance with the Wis. St. Stat. Chap. 70.09. All information contained herein is advisory only. Map accuracy is limited to the quality of data obtained from other Public Records. This map is not intended to be a substitute for an actual field survey. Public Land Survey Base is derived from U.S.G.S. Topographic maps unless otherwise noted. Other sources of the Land Base may be actual survey data. Base map data is from the April 1995 County Digital Orthophotos and/or U.S.G.S. 1:24,000 scale Topographic series. The user is responsible for the improper use of the data contained herein.

Created by The Columbia County Land Information Office -GIS Section. VMB.
February 2005.

TAX PARCEL MAP

TOWN of LEWISTON

TOWN 13 NORTH RANGE 8 EAST
COLUMBIA COUNTY, WISCONSIN

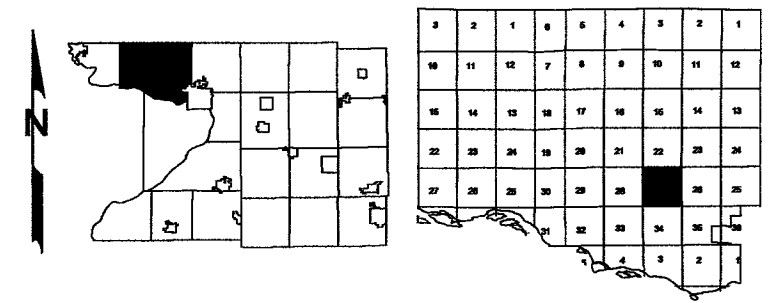


-SEE SECTION 22-

Replaced
2009



-SEE SECTION 34-

Also
2008
-SECTION 27-

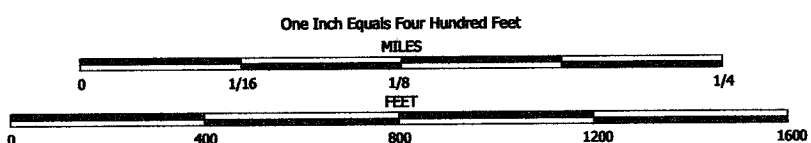


NOTE: This map was prepared for assessment use in accordance with the Wis. St. Stat. Chap. 70.09. All information contained herein is advisory only. Map accuracy is limited to the quality of data obtained from other Public Records. This map is not intended to be a substitute for an actual field survey. Public Land Survey Base is derived from U.S.G.S. Topographic maps unless otherwise noted. Other sources of the Land Base may be actual survey data. Base map data is from the April 1995 County Digital Orthophotos and/or U.S.G.S. 1:24,000 scale Topographic series. The user is responsible for the improper use of the data contained herein.

Created by The Columbia County Land Information Office -GIS Section. VMB.
September 2002.

TAX PARCEL MAP

TOWN of LEWISTON

TOWN 13 NORTH RANGE 8 EAST
COLUMBIA COUNTY, WISCONSIN

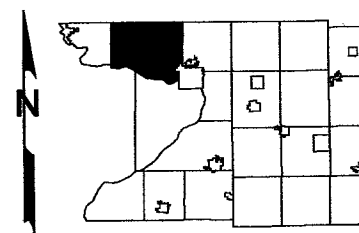

3	2	1	6	5	4	3	2	1
10	11	12	7	8	9	10	11	12
15	14	13	18	17	16	15	14	13
22	23	24	19	20	21	22	23	24
27	28	29	26	25	26	27	28	29

Replaced
2009

-SEE SECTION 23-



-SEE SECTION 27-

-SEE SECTION 25-

-SEE SECTION 35-

-SECTION 26-

One Inch Equals Four Hundred Feet
MILES
0 1/16 1/8 1/4
FEET
0 400 800 1200 1600



NOTE: This map was prepared for assessment use in accordance with the Wis. St. Stat. Chap. 70.09. All information contained herein is advisory only. Map accuracy is limited to the quality of data obtained from other Public Records. This map is not intended to be a substitute for an actual field survey. Public Land Survey Base is derived from U.S.G.S. Topographic maps unless otherwise noted. Other sources of the Land Base may be actual survey data. Base map data is from the April 1995 County Digital Orthophotos and/or U.S.G.S. 1:24,000 scale Topographic series. The user is responsible for the improper use of the data contained herein.


Created by The Columbia County Land Information Office -GIS Section. VMB.
February 2007.

TAX PARCEL MAP

TOWN of LEWISTON

TOWN 13 NORTH RANGE 8 EAST
COLUMBIA COUNTY, WISCONSIN

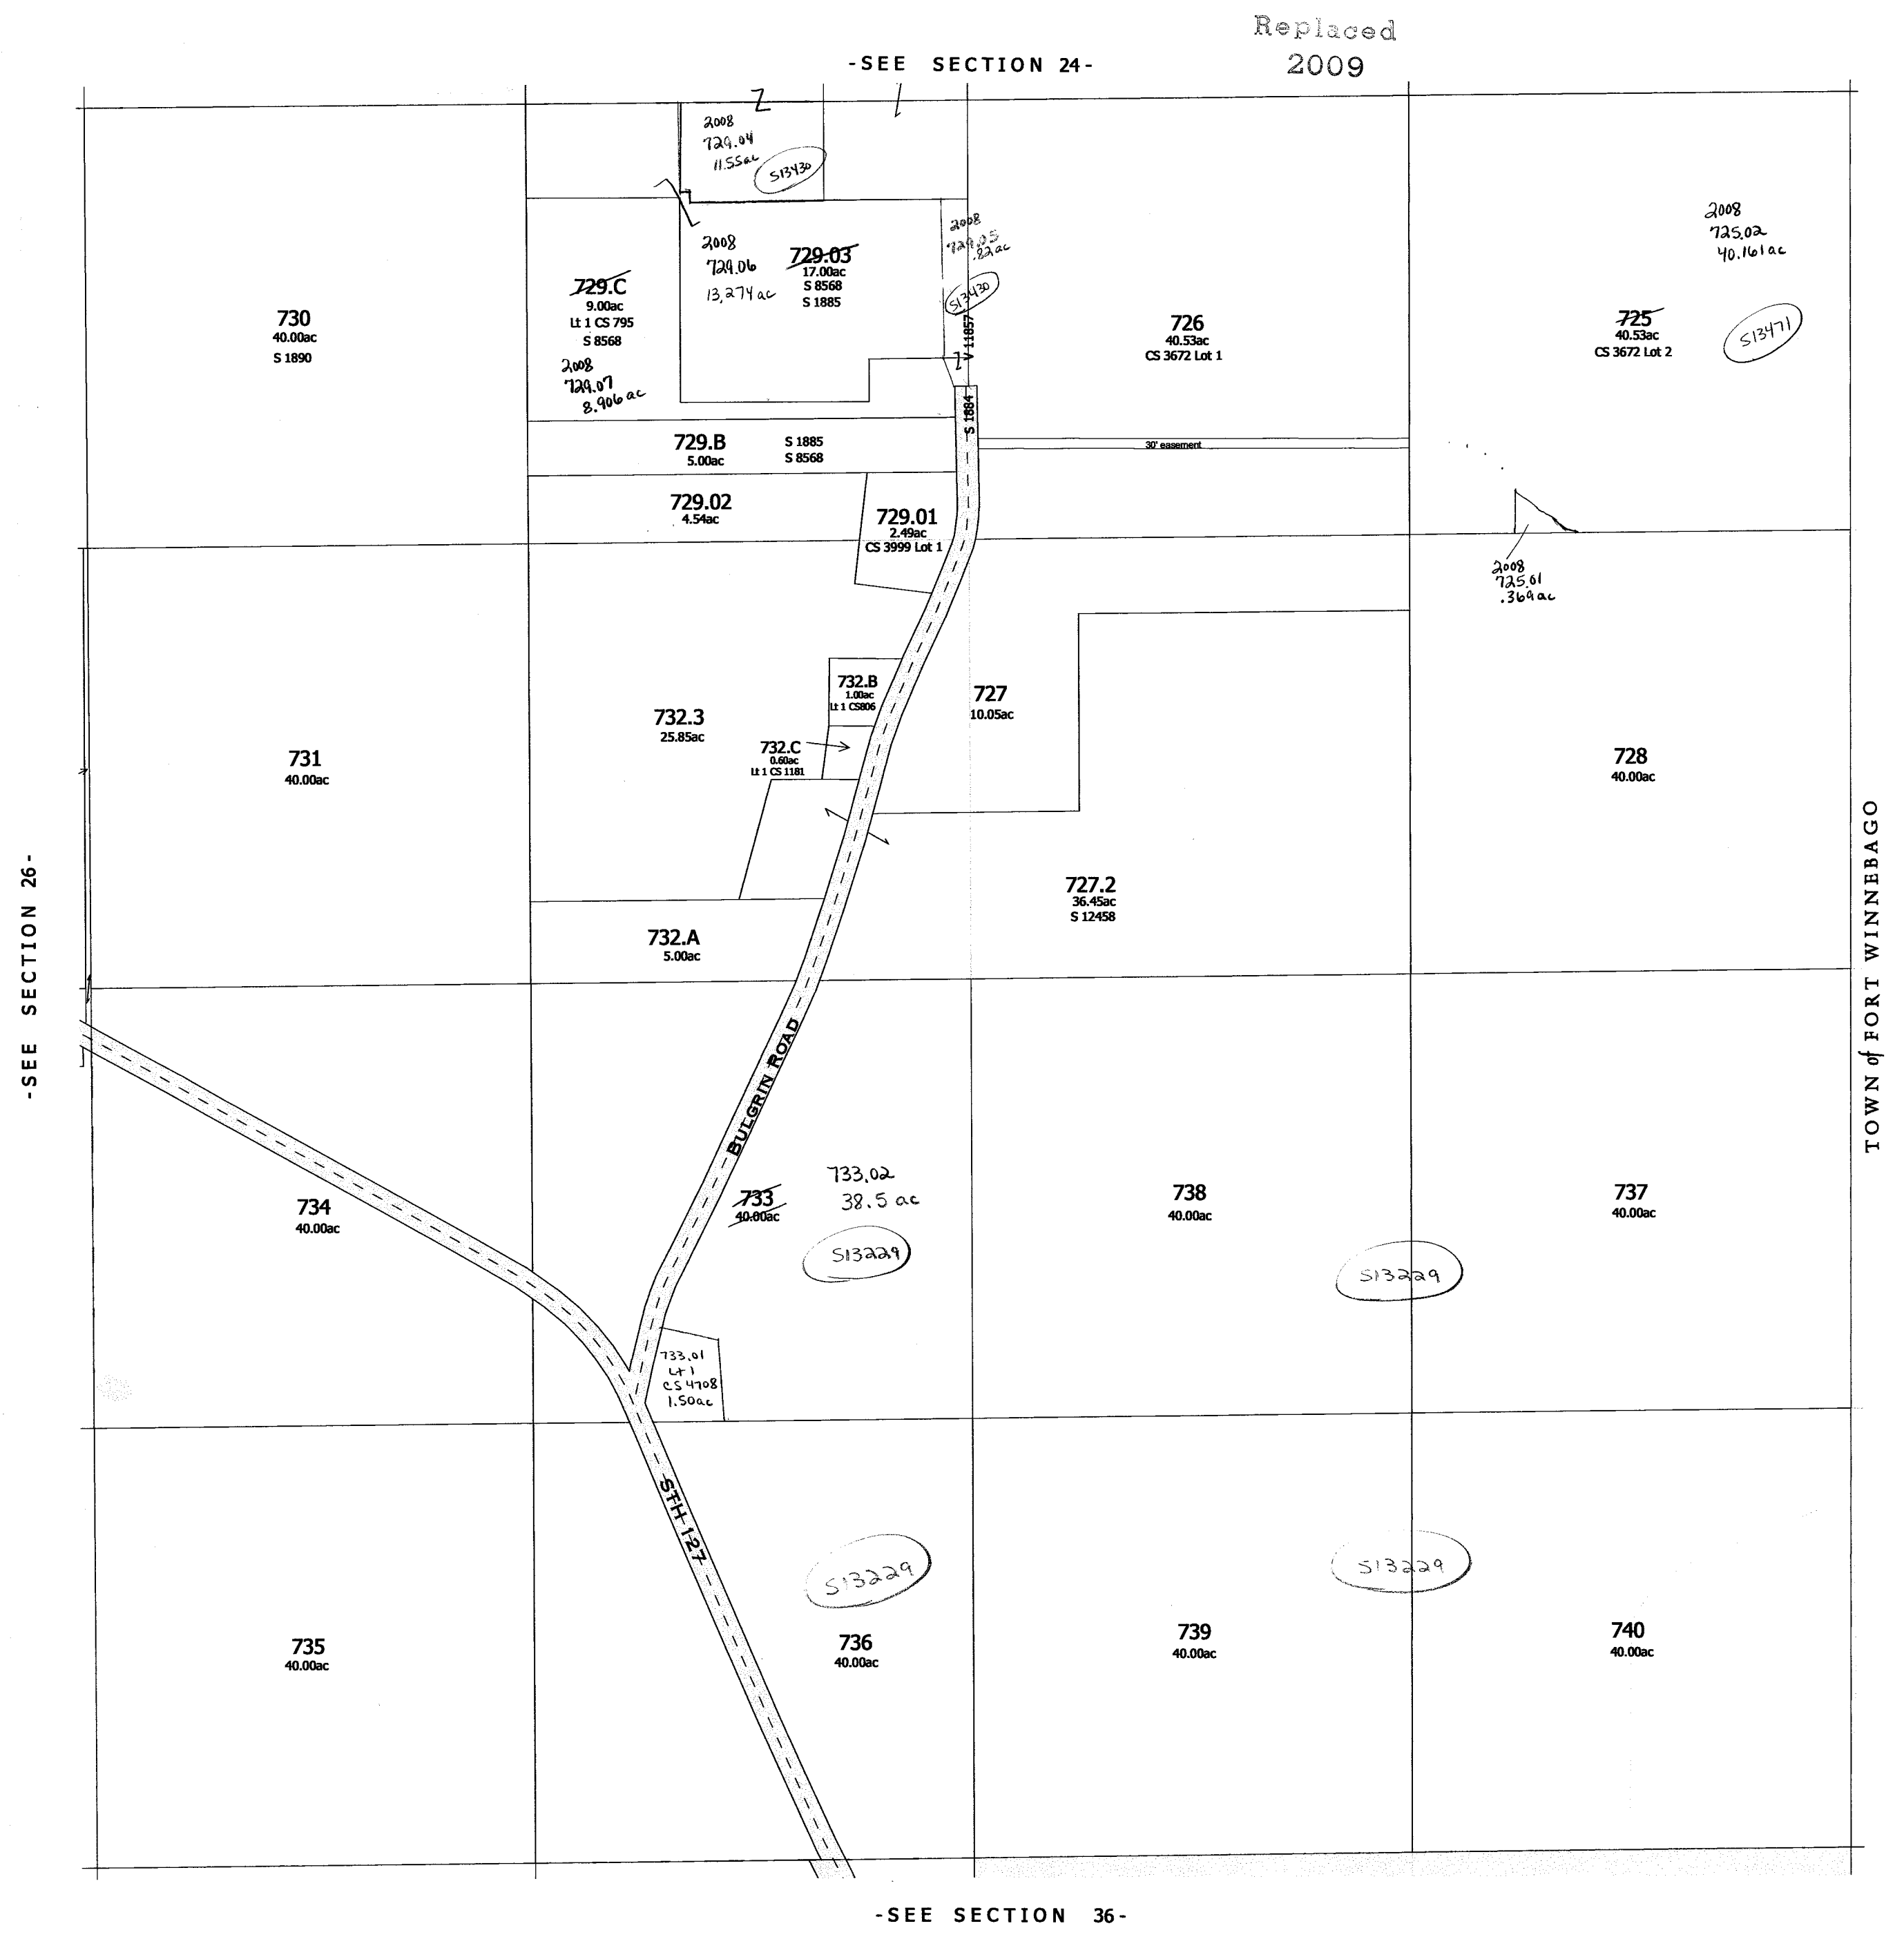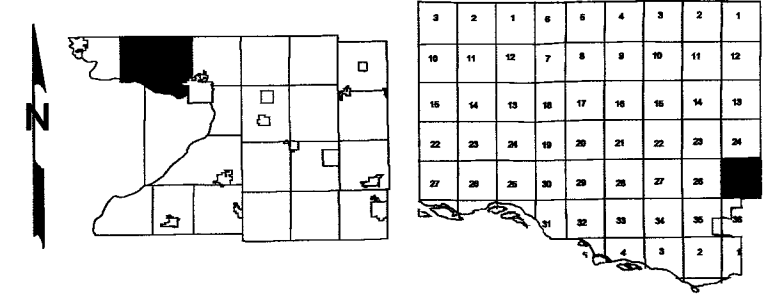

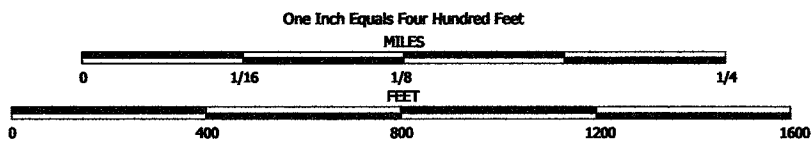




NOTE: This map was prepared for assessment use in accordance with the Wis. St. Stat. Chap. 70.09. All information contained herein is advisory only. Map accuracy is limited to the quality of data obtained from other Public Records. This map is not intended to be a substitute for an actual field survey. Public Land Survey Base is derived from U.S.G.S. Topographic maps unless otherwise noted. Other sources of the Land Base may be actual survey data. Base map data is from the April 1995 County Digital Orthophotos and/or U.S.G.S. 1:24,000 scale Topographic series. The user is responsible for the improper use of the data contained herein.


Created by The Columbia County Land Information Office -GIS Section. VMB.
February 2006.

TAX PARCEL MAP

TOWN of LEWISTON

TOWN 13 NORTH RANGE 8 EAST
COLUMBIA COUNTY, WISCONSIN

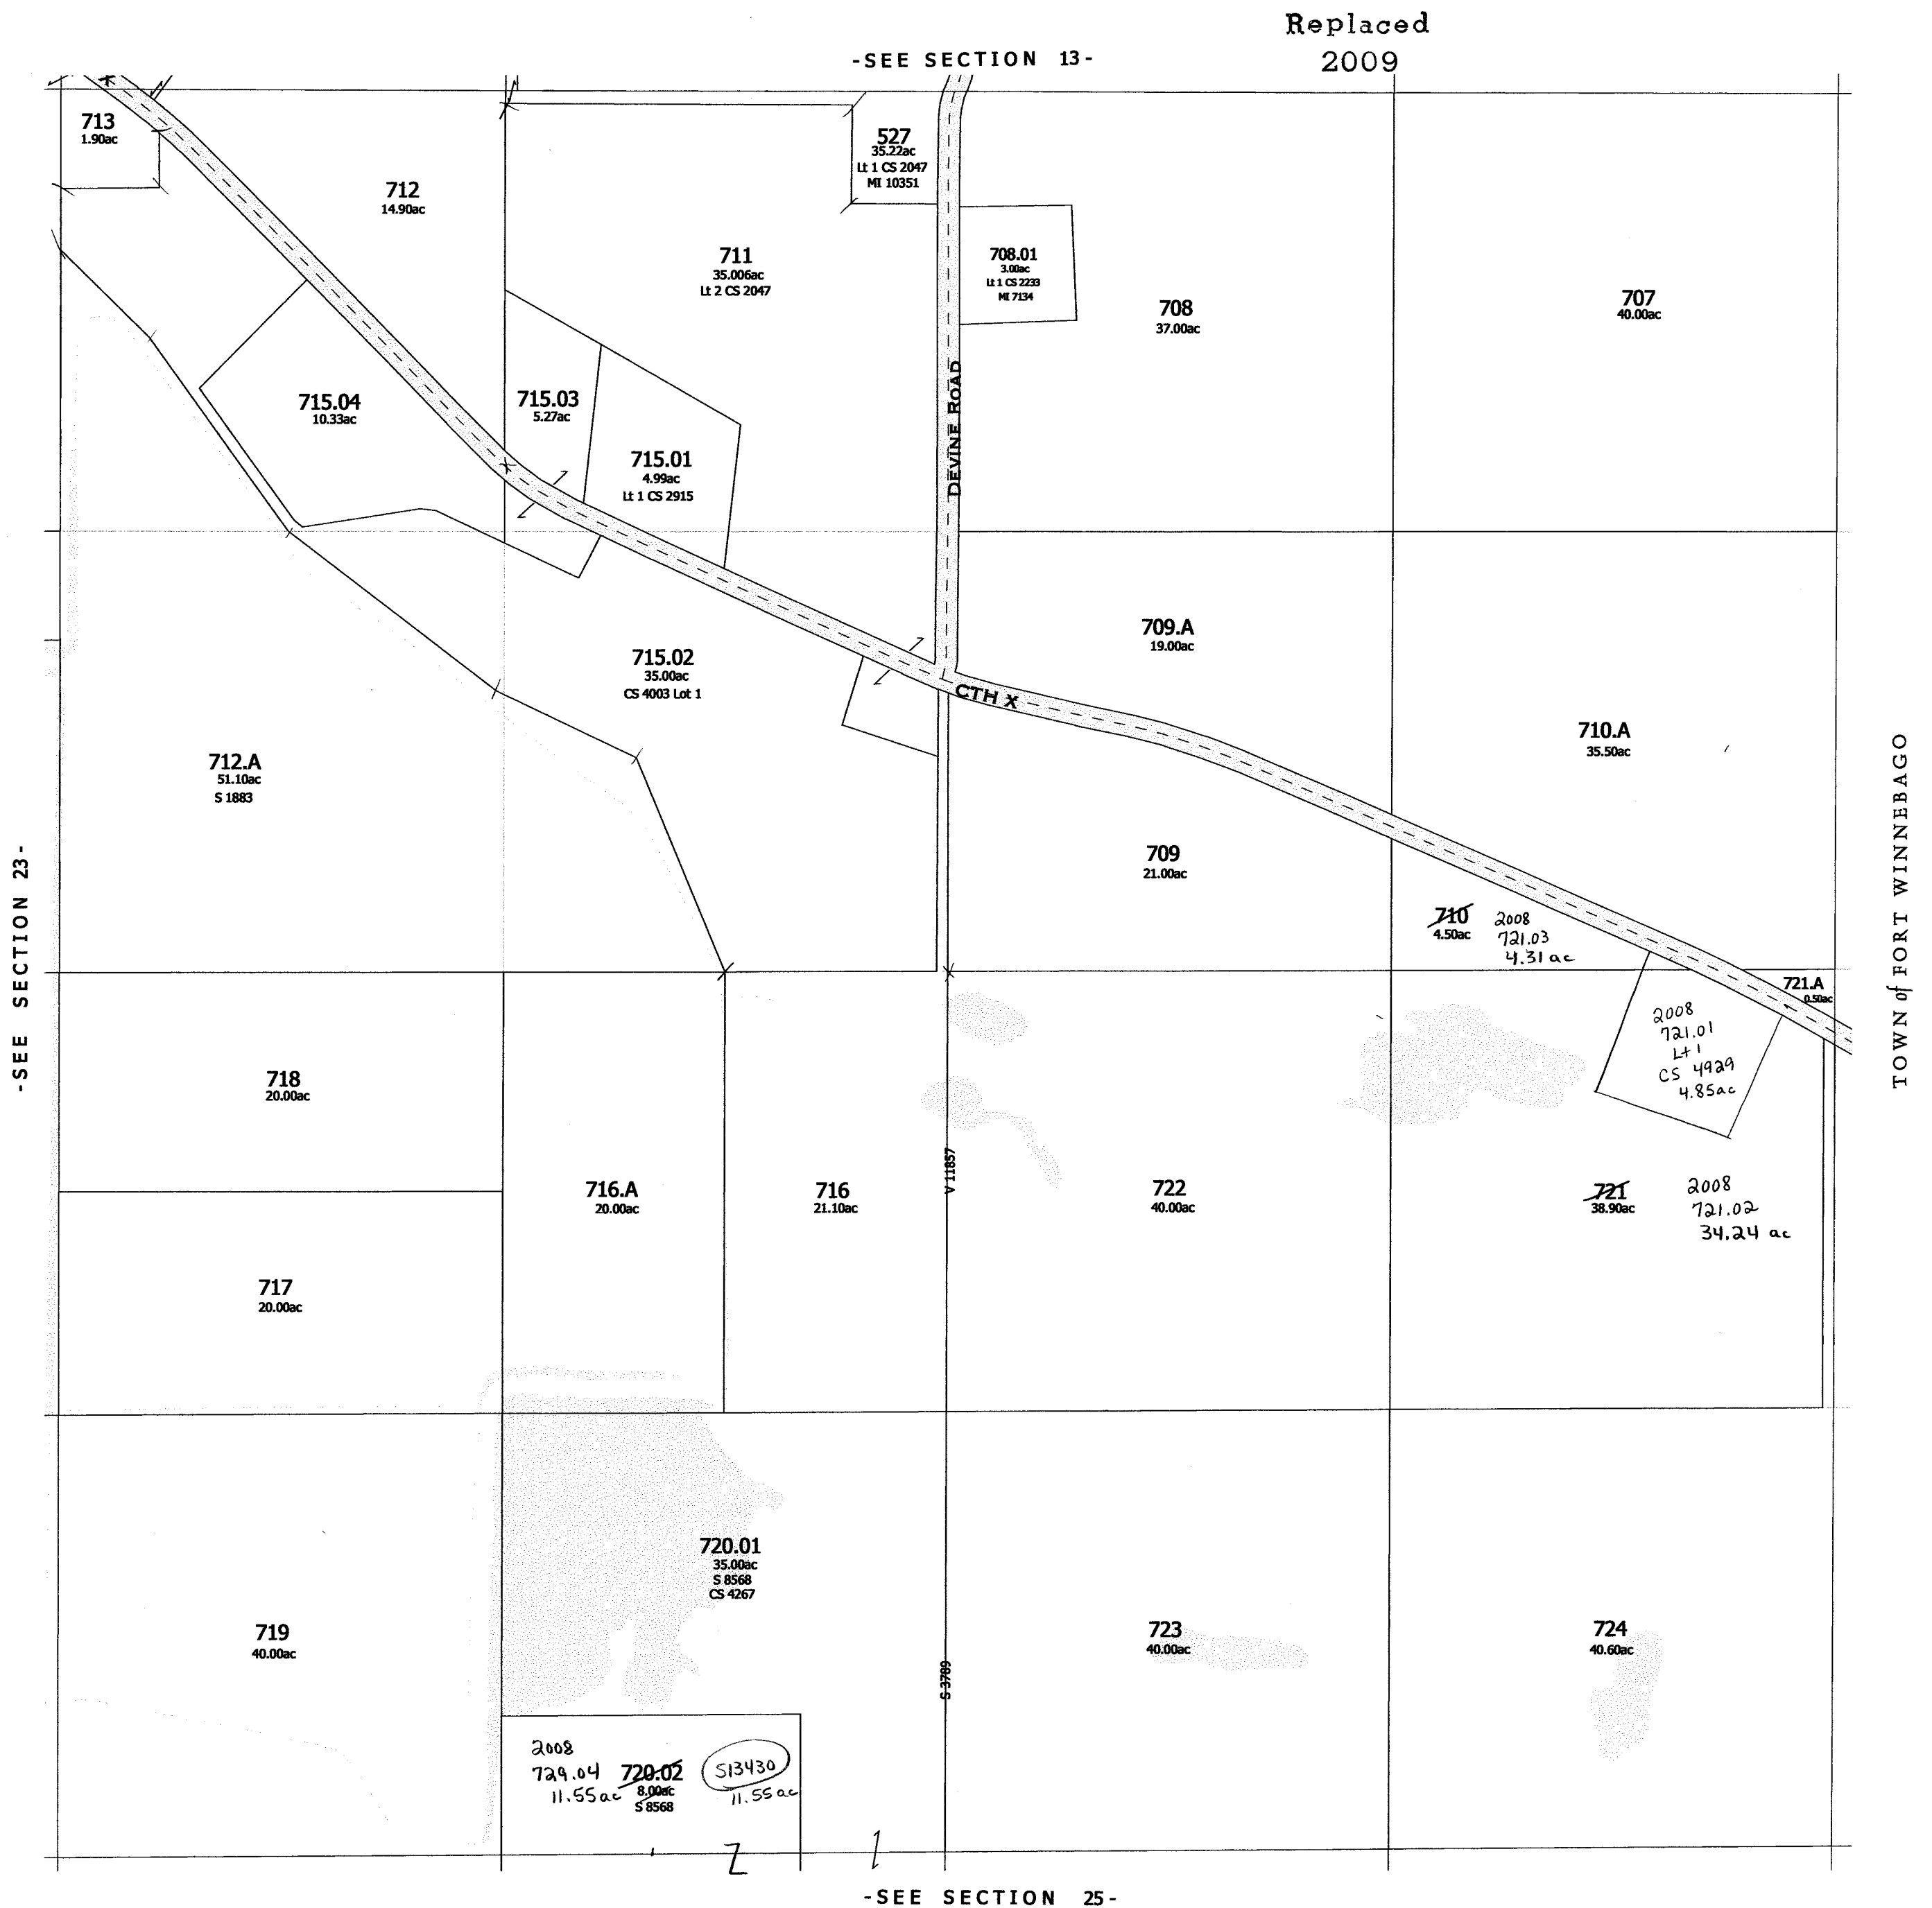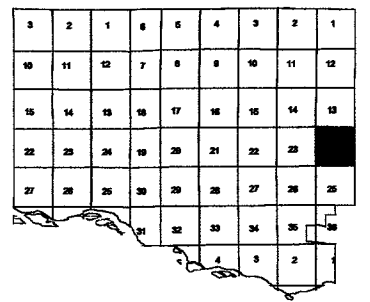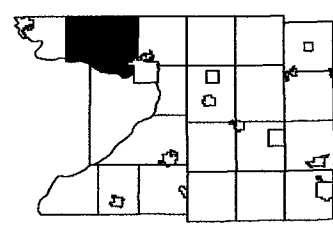

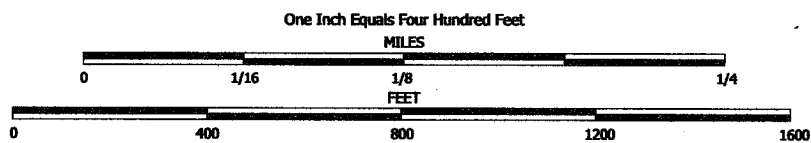



NOTE: This map was prepared for assessment use in accordance with the Wis. Stat. Chap. 70.09. All information contained herein is advisory only. Map accuracy is limited to the quality of data obtained from other Public Records. This map is not intended to be a substitute for an actual field survey. Public Land Survey Base is derived from U.S.G.S Topographic maps unless otherwise noted. Other sources of the Land Base may be actual survey data. Base map data is from the April 1995 County Digital Orthophotos and/or U.S.G.S 1:24,000 scale Topographic series. The user is responsible for the improper use of the data contained herein.


Created by The Columbia County Land Information Office -GIS Section. VMB.
September 2002.

TAX PARCEL MAP

TOWN of LEWISTON

TOWN 13 NORTH RANGE 8 EAST
COLUMBIA COUNTY, WISCONSIN

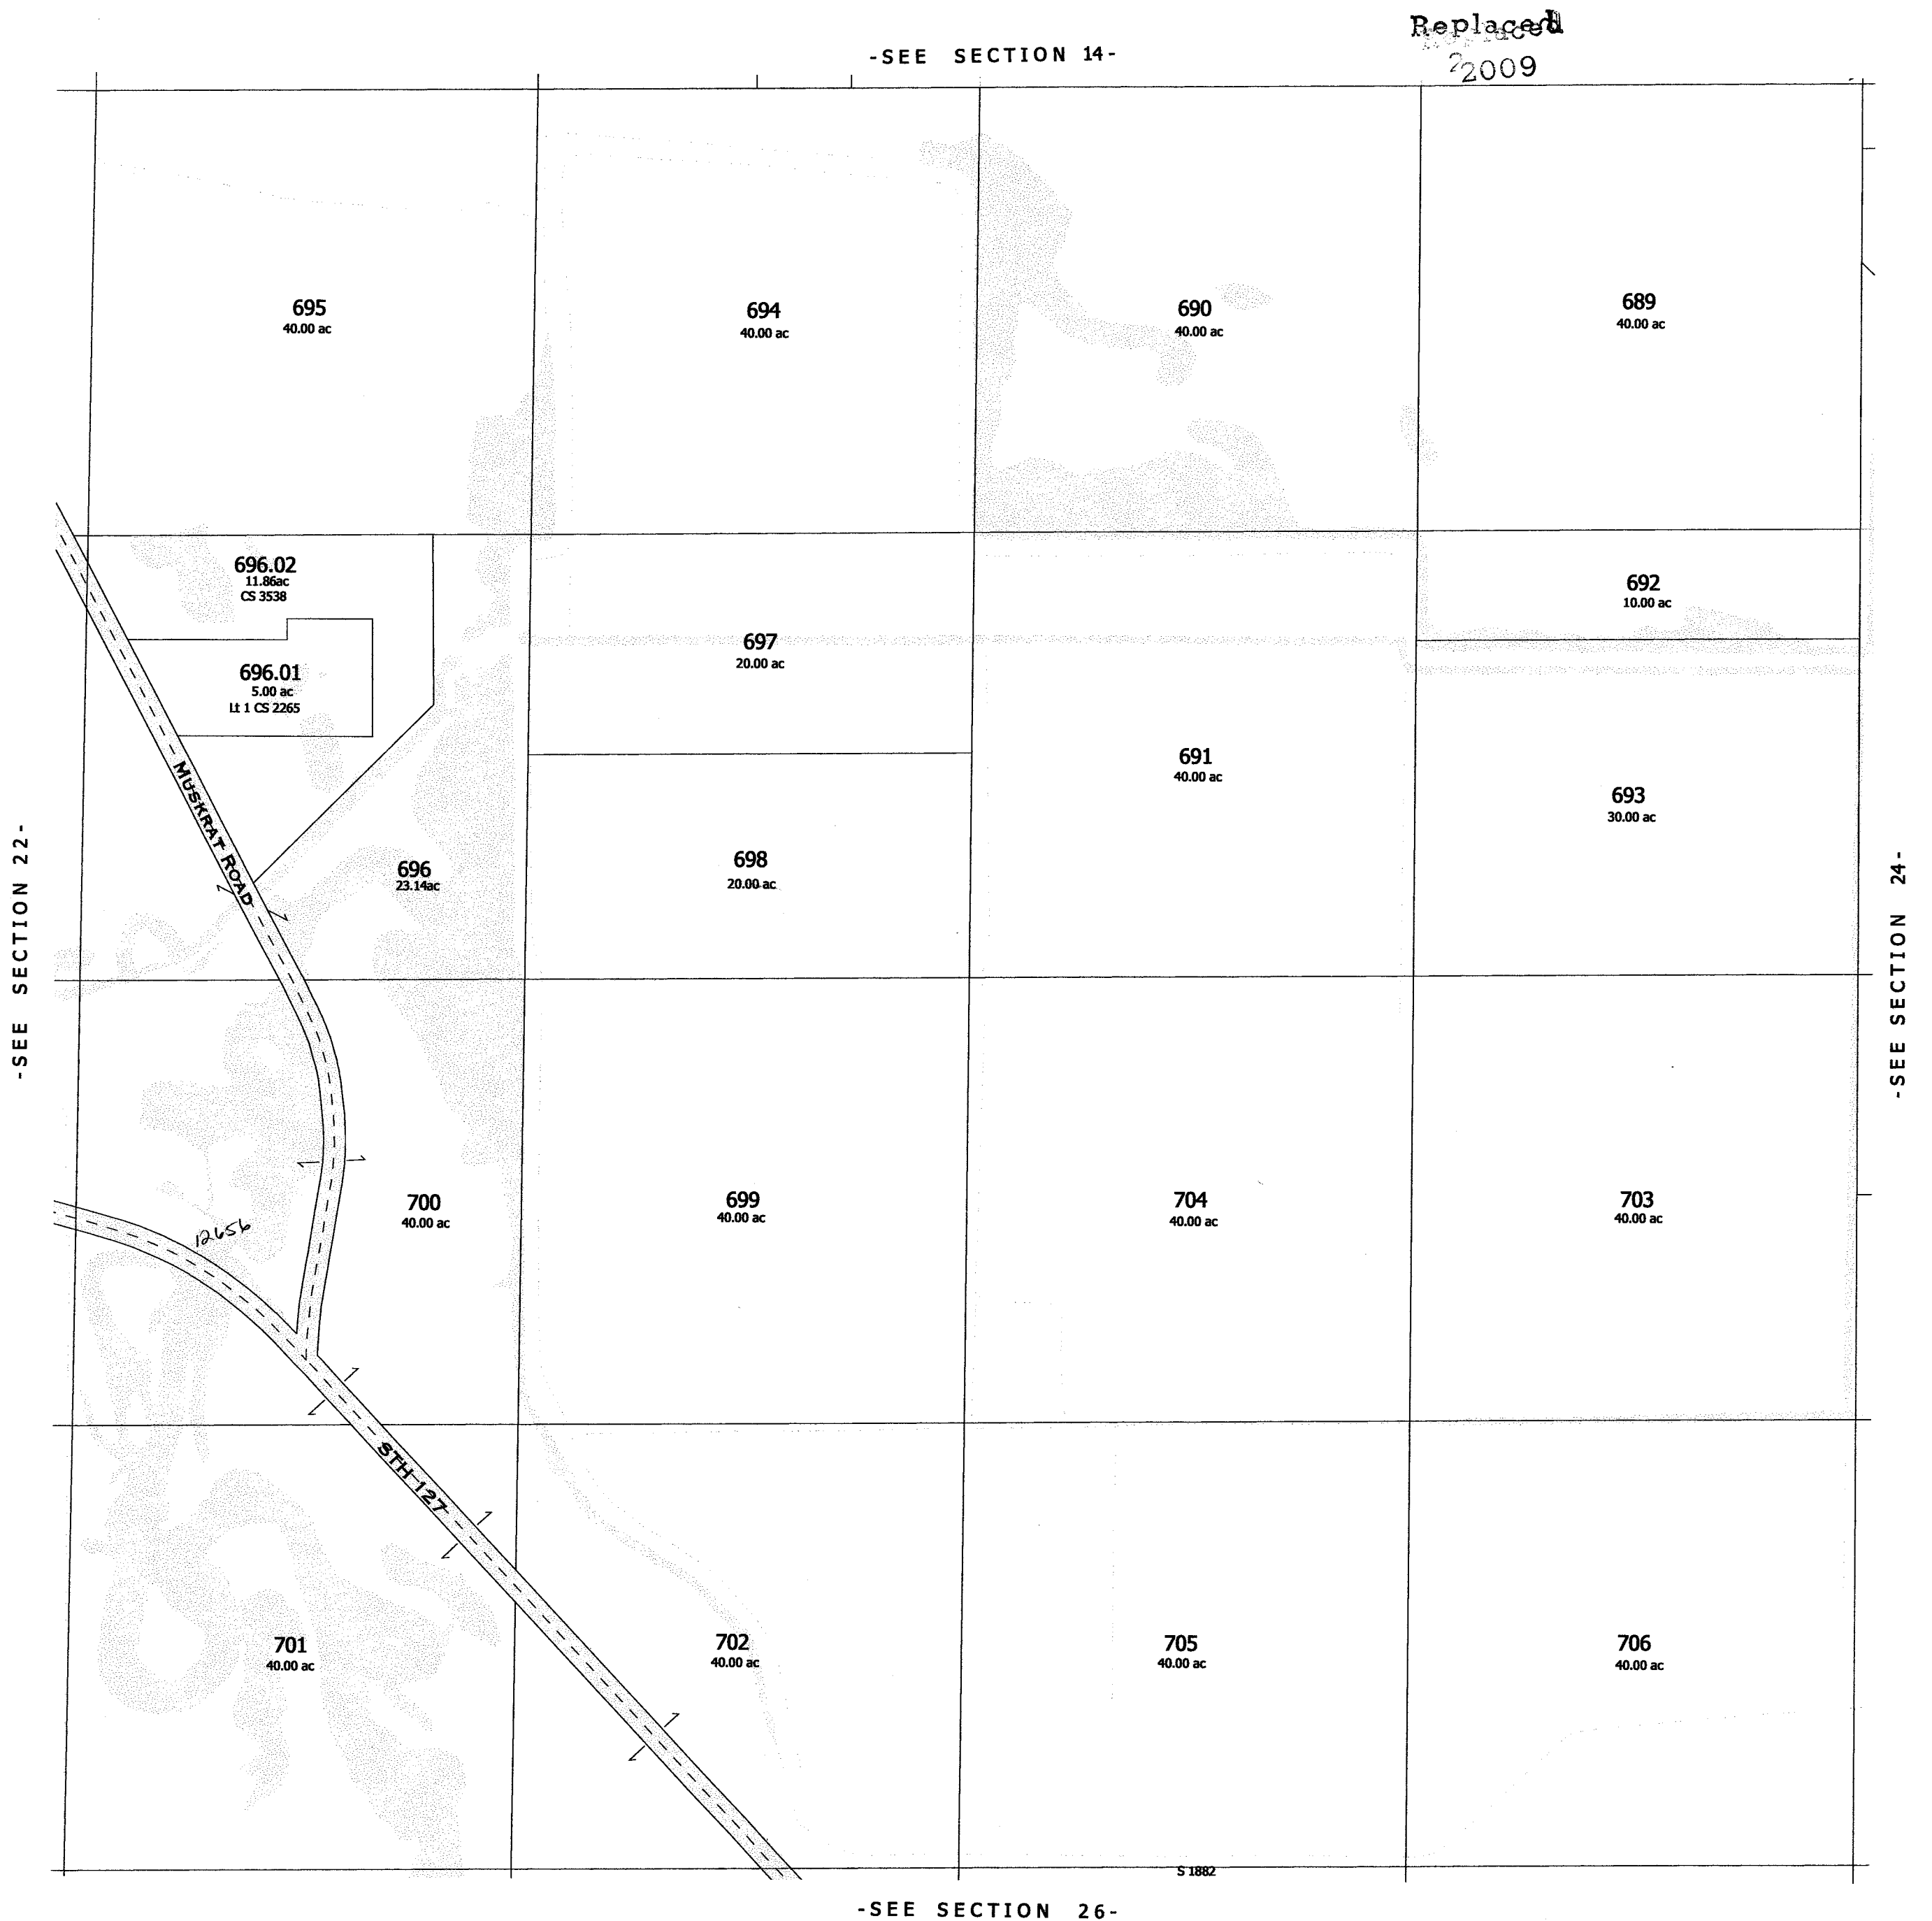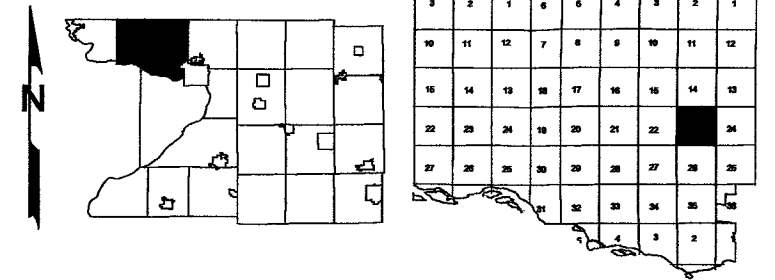


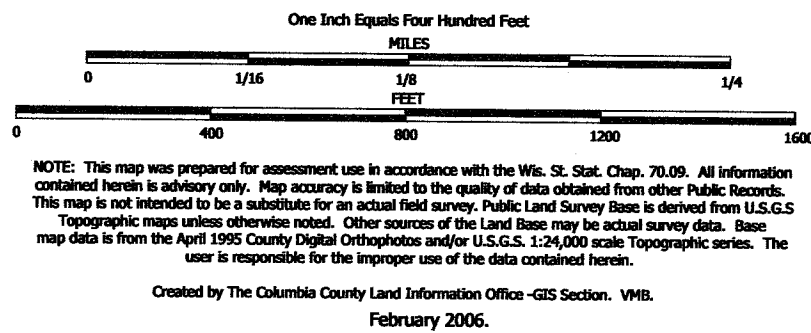

TAX PARCEL MAP

TOWN of LEWISTON

TOWN 13 NORTH RANGE 8 EAST
COLUMBIA COUNTY, WISCONSIN

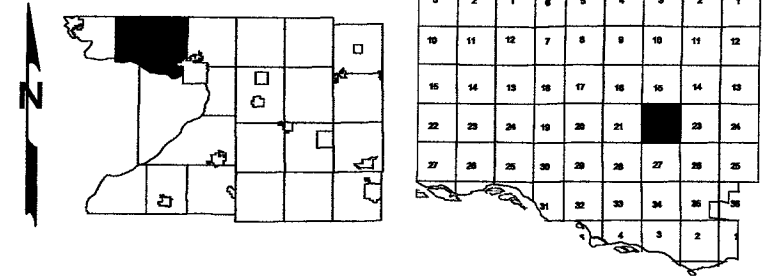

One Inch Equals Four Hundred Feet

MILES

0 1/16 1/8 1/4

FEET

0 400 800 1200 1600

NOTE: This map was prepared for assessment use in accordance with the Wis. St. Stat. Chap. 70.09. All information contained herein is advisory only. Map accuracy is limited to the quality of data obtained from other Public Records. This map is not intended to be a substitute for an actual field survey. Public Land Survey Base is derived from U.S.G.S. Topographic maps unless otherwise noted. Other sources of the Land Base may be actual survey data. Base map data is from the April 1995 County Digital Orthophotos and/or U.S.G.S. 1:24,000 scale Topographic series. The user is responsible for the improper use of the data contained herein.


Created by The Columbia County Land Information Office -GIS Section- VMB.

February 2007.


TAX PARCEL MAP

TOWN of LEWISTON

TOWN 13 NORTH RANGE 8 EAST
COLUMBIA COUNTY, WISCONSIN

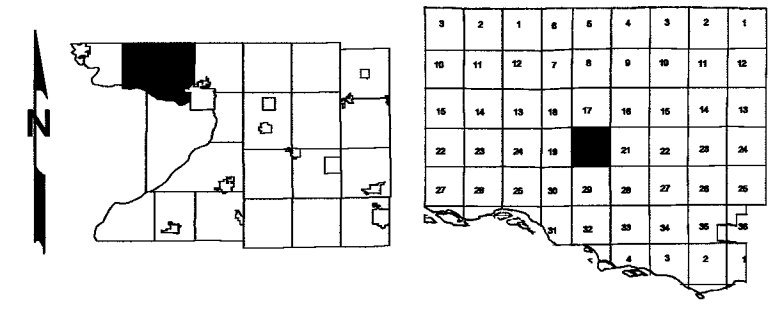

Replaced
2009

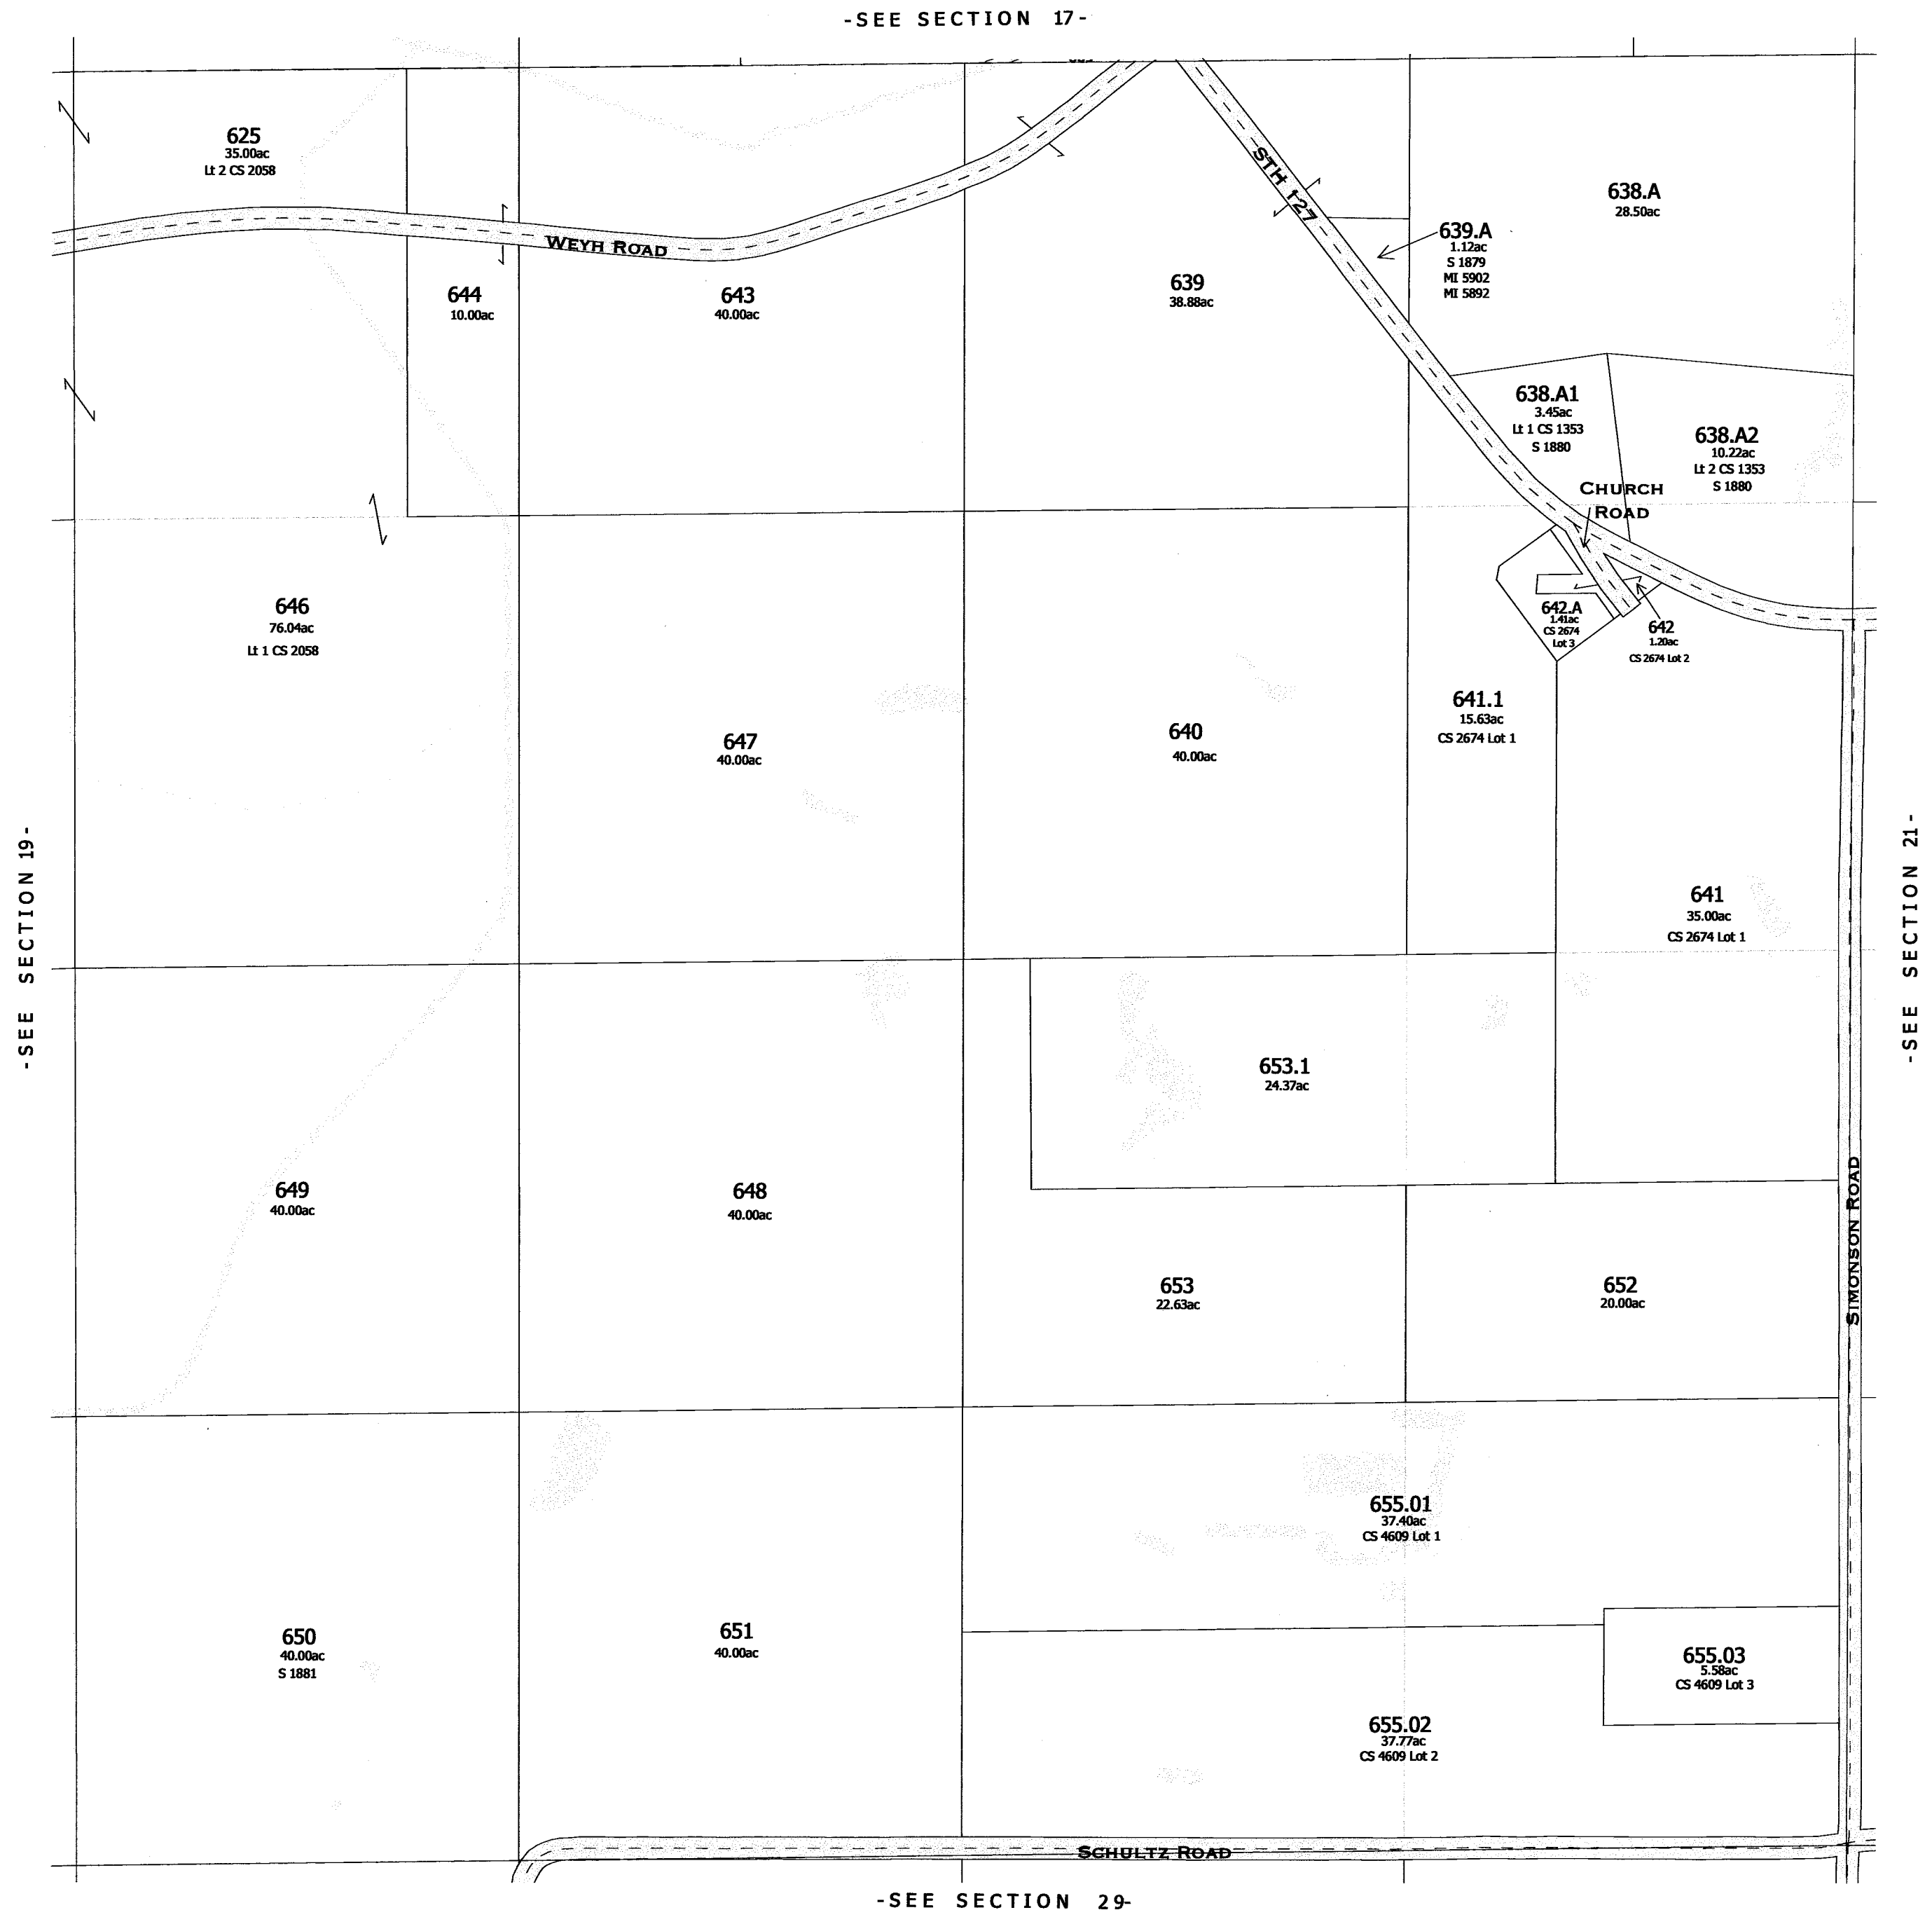

One Inch Equals Four Hundred Feet
MILES
0 1/16 1/8 1/4
FEET
0 400 800 1200 1600


NOTE: This map was prepared for assessment use in accordance with the Wis. St. Stat. Chap. 70.09. All information contained herein is advisory only. Map accuracy is limited to the quality of data obtained from other Public Records. This map is not intended to be a substitute for an actual field survey. Public Land Survey Base is derived from U.S.G.S. Topographic maps unless otherwise noted. Other sources of the Land Base may be actual survey data. Base map data is from the April 1995 County Digital Orthophotos and/or U.S.G.S. 1:24,000 scale Topographic series. The user is responsible for the improper use of the data contained herein.

Created by The Columbia County Land Information Office -GIS Section. VMB.
September 2002.


TAX PARCEL MAP


TOWN of LEWISTON

TOWN 13 NORTH RANGE 8 EAST
COLUMBIA COUNTY, WISCONSIN

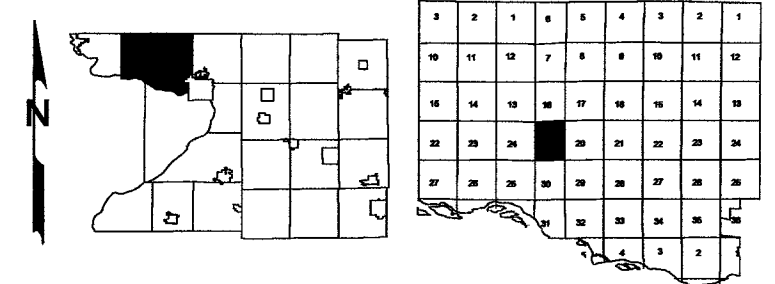

Replaced
2009

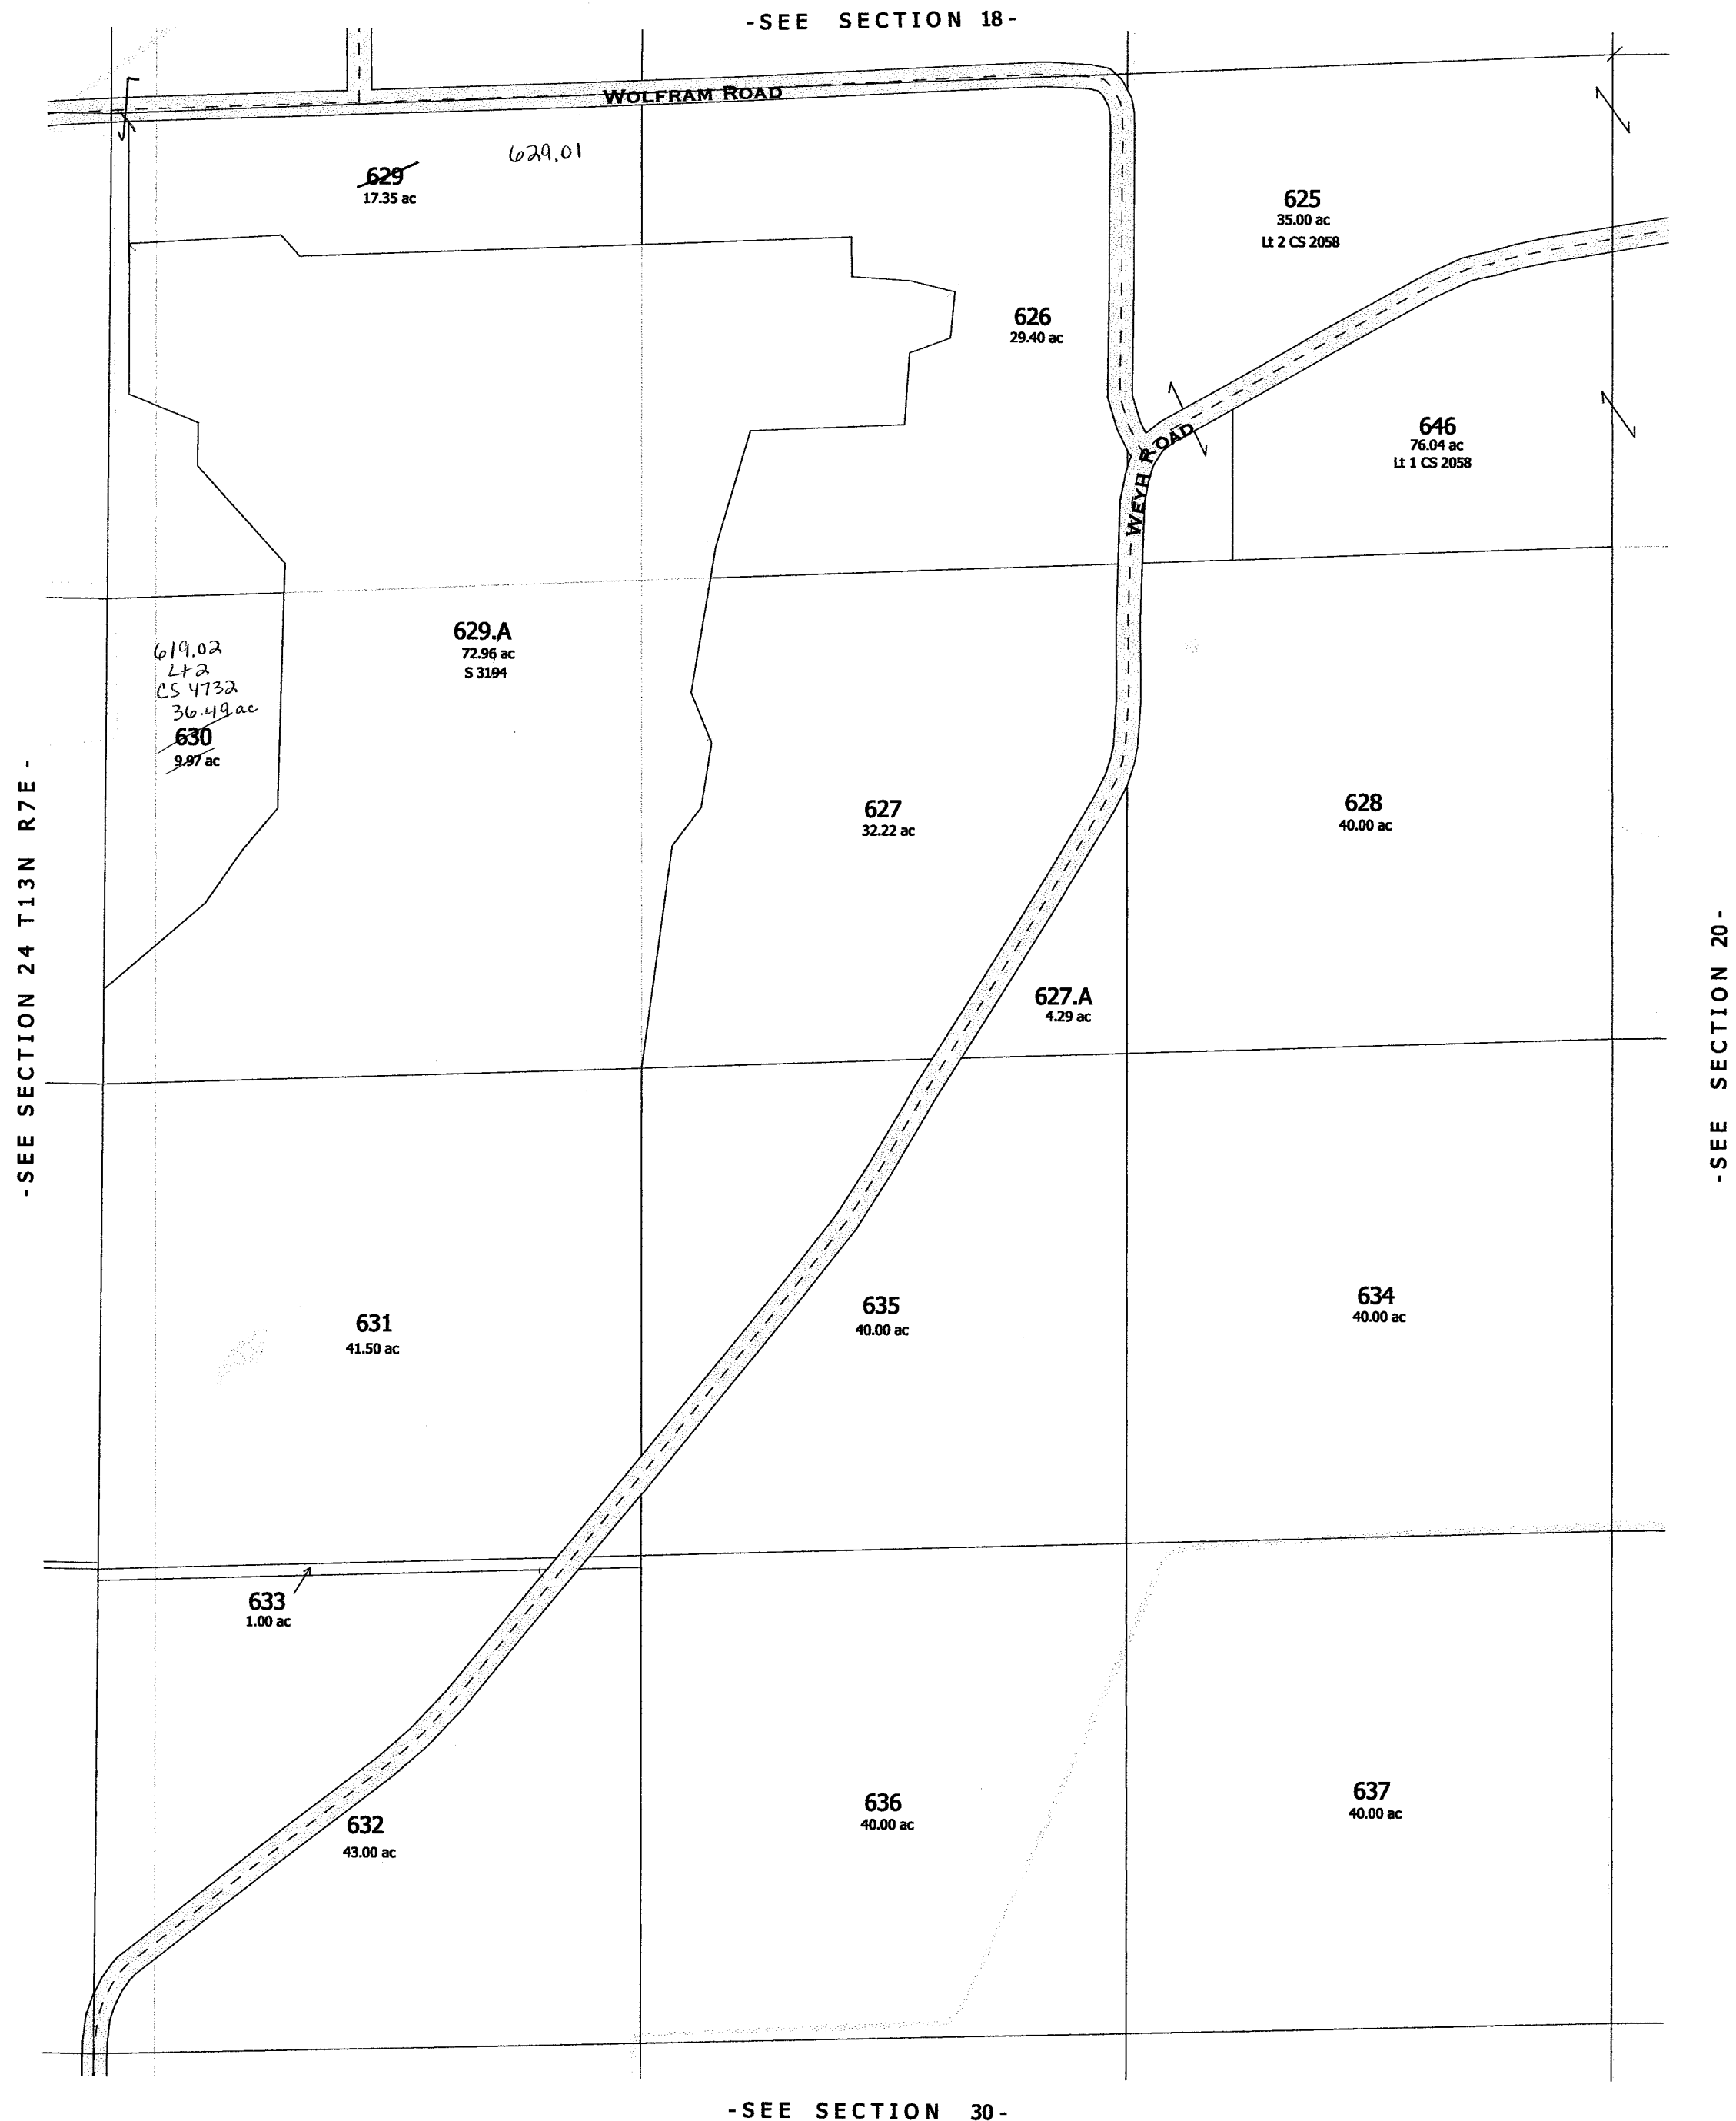

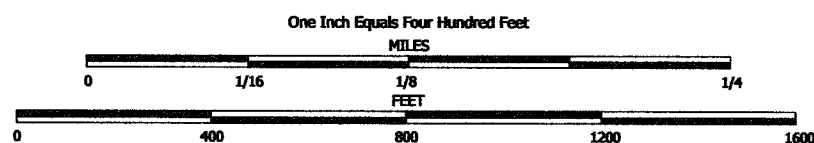



NOTE: This map was prepared for assessment use in accordance with the Wis. St. Stat. Chap. 70.09. All information contained herein is advisory only. Map accuracy is limited to the quality of data obtained from other Public Records. This map is not intended to be a substitute for an actual field survey. Public Land Survey Base is derived from U.S.G.S. Topographic maps unless otherwise noted. Other sources of the Land Base may be actual survey data. Base map data is from the April 1995 County Digital Orthophotos and/or U.S.G.S. 1:24,000 scale Topographic series. The user is responsible for the improper use of the data contained herein.

Created by The Columbia County Land Information Office -GIS Section. VMB.
February 2006.

TAX PARCEL MAP


TOWN of LEWISTON

TOWN 13 NORTH RANGE 8 EAST
COLUMBIA COUNTY, WISCONSIN

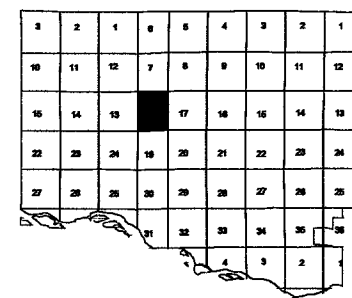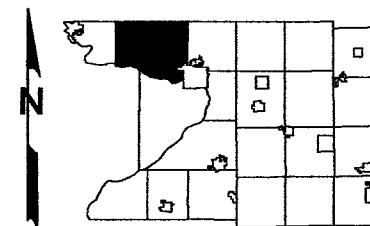

Replaced
2009

-SEE SECTION 7-

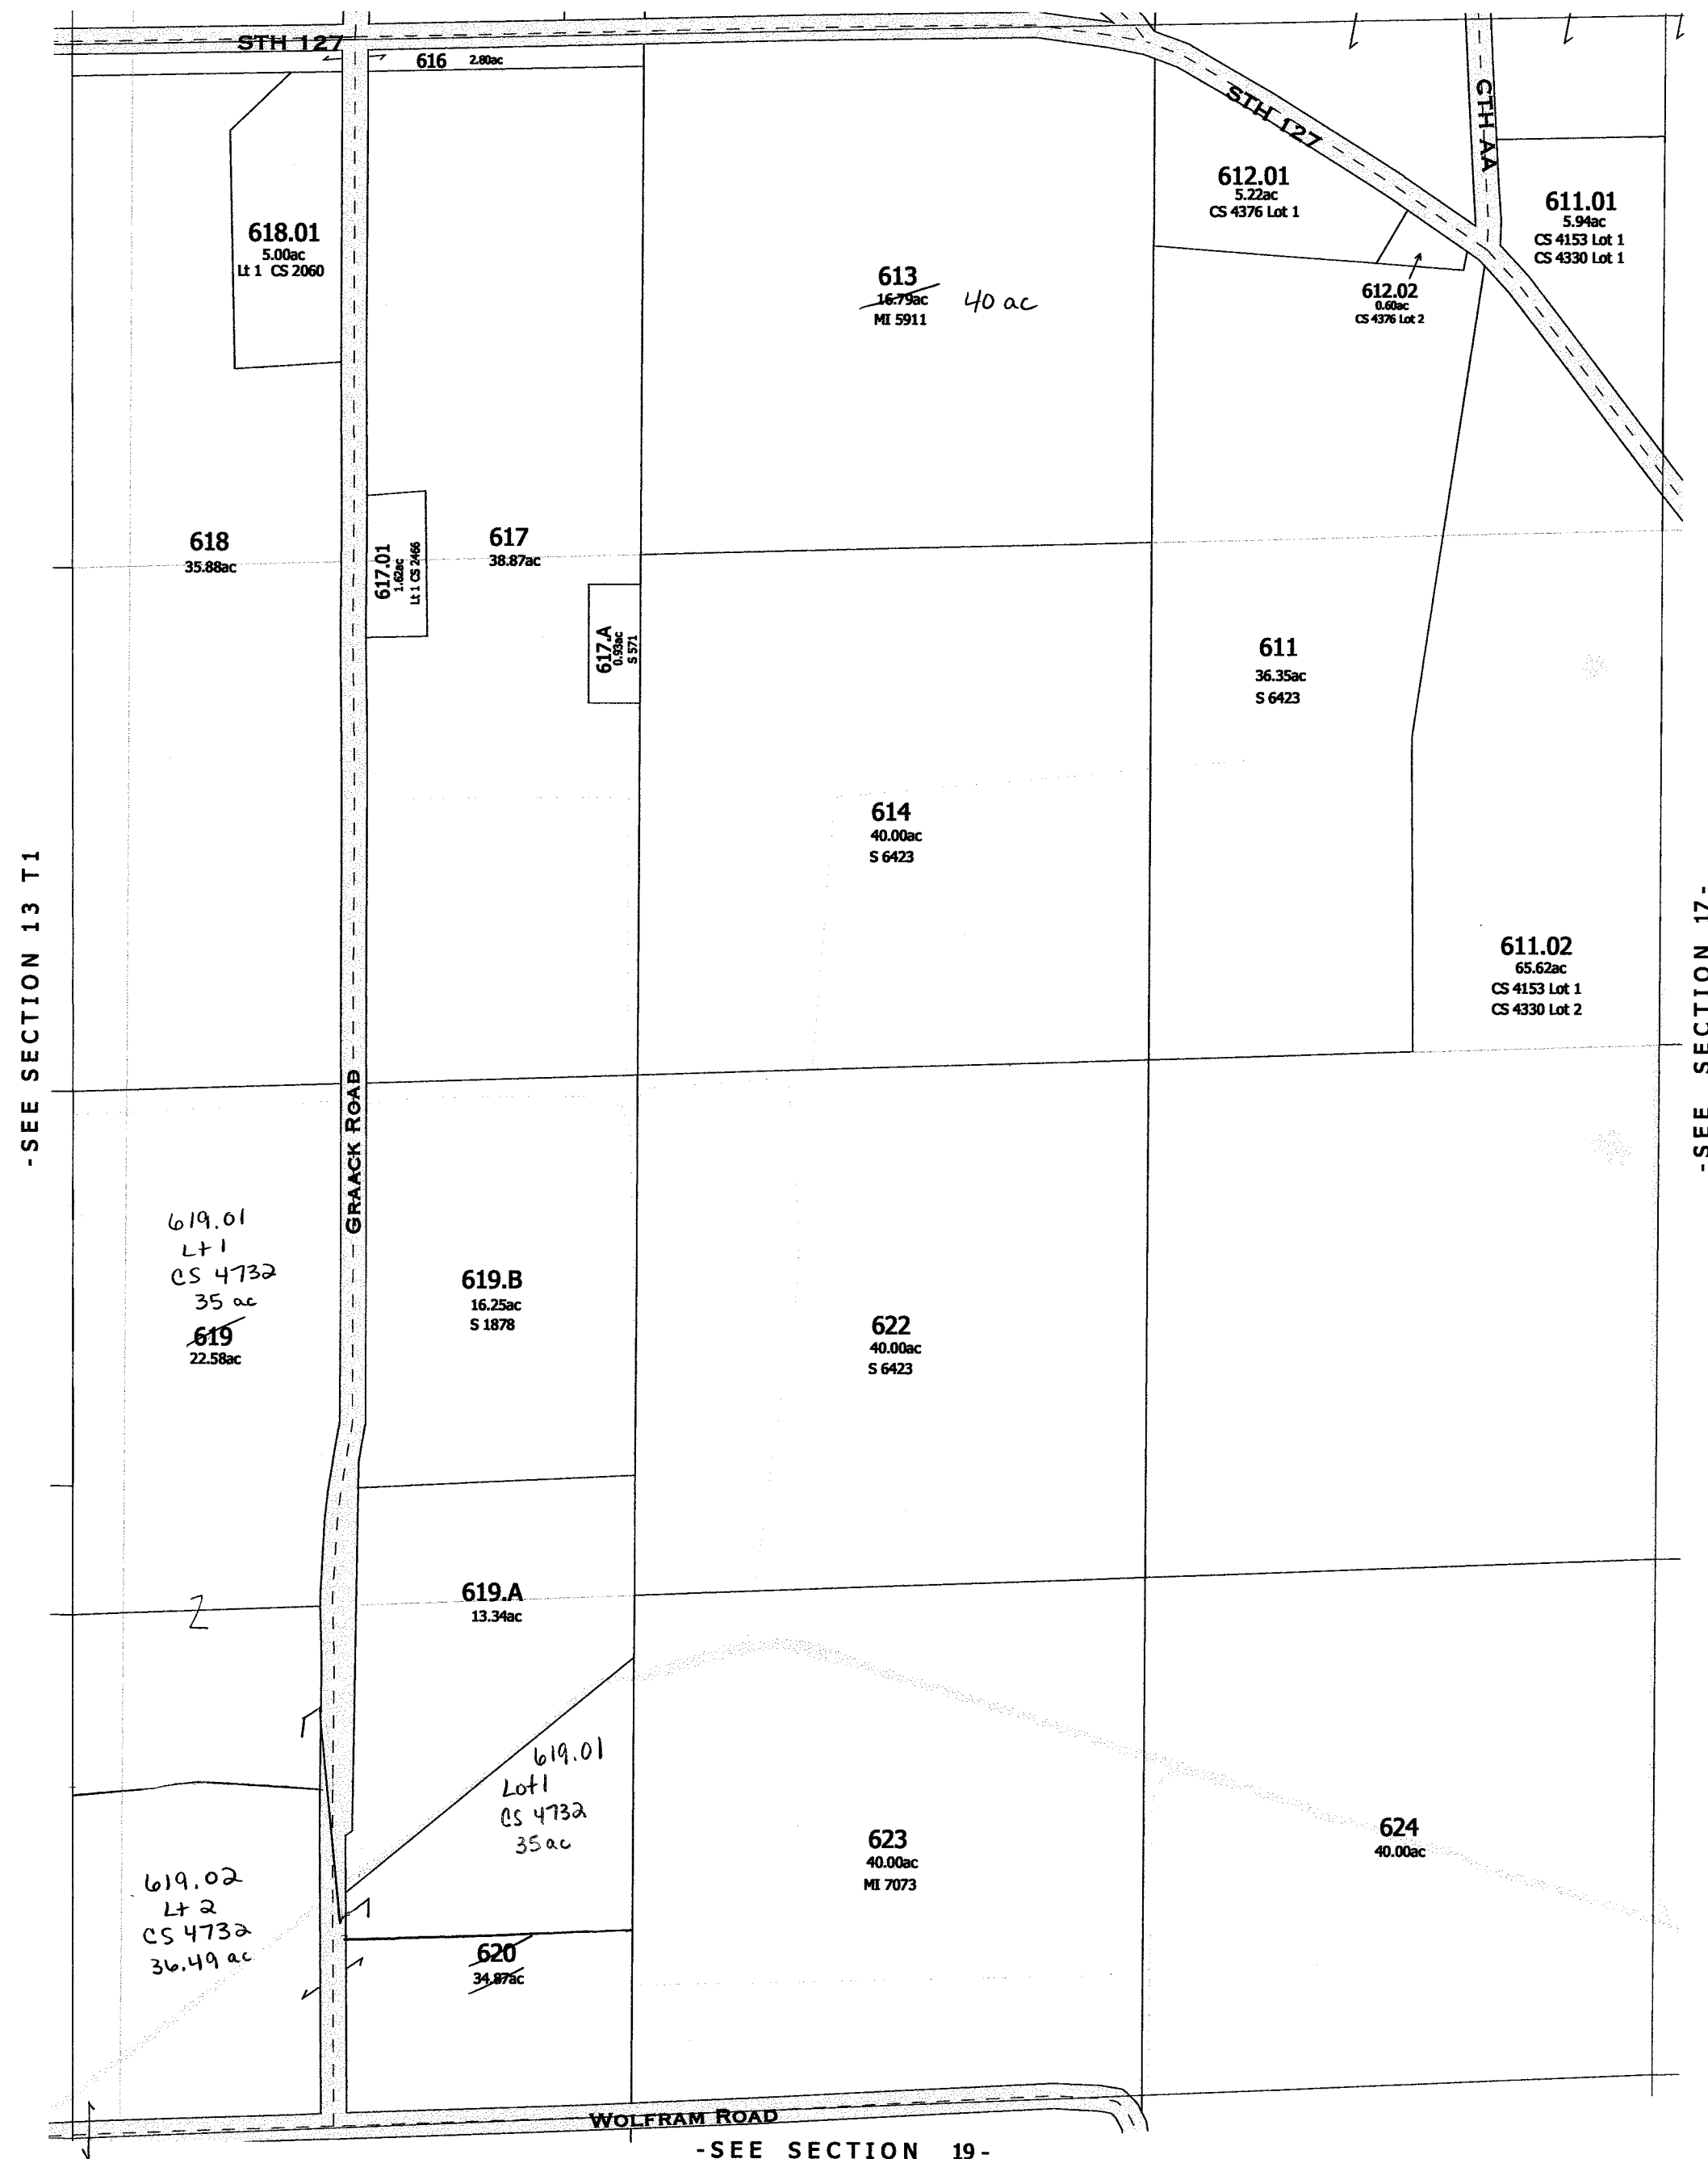

-SECTION 18-

One Inch Equals Four Hundred Feet
MILES
0 1/16 1/8 1/4
FEET
0 400 800 1200 1600


NOTE: This map was prepared for assessment use in accordance with the Wis. St. Stat. Chap. 70.09. All information contained herein is advisory only. Map accuracy is limited to the quality of data obtained from other Public Records. This map is not intended to be a substitute for an actual field survey. Public Land Survey Base is derived from U.S.G.S. Topographic maps unless otherwise noted. Other sources of the Land Base may be actual survey data. Base map data is from the April 1995 County Digital Orthophotos and/or U.S.G.S. 1:24,000 scale Topographic series. The user is responsible for the improper use of the data contained herein.

Created by The Columbia County Land Information Office -GIS Section. VMB.
February 2007.


TAX PARCEL MAP

TOWN of LEWISTON

TOWN 13 NORTH RANGE 8 EAST
COLUMBIA COUNTY, WISCONSIN

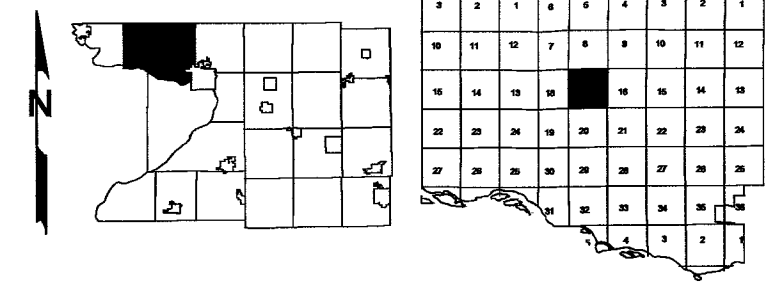


Replaced
2009

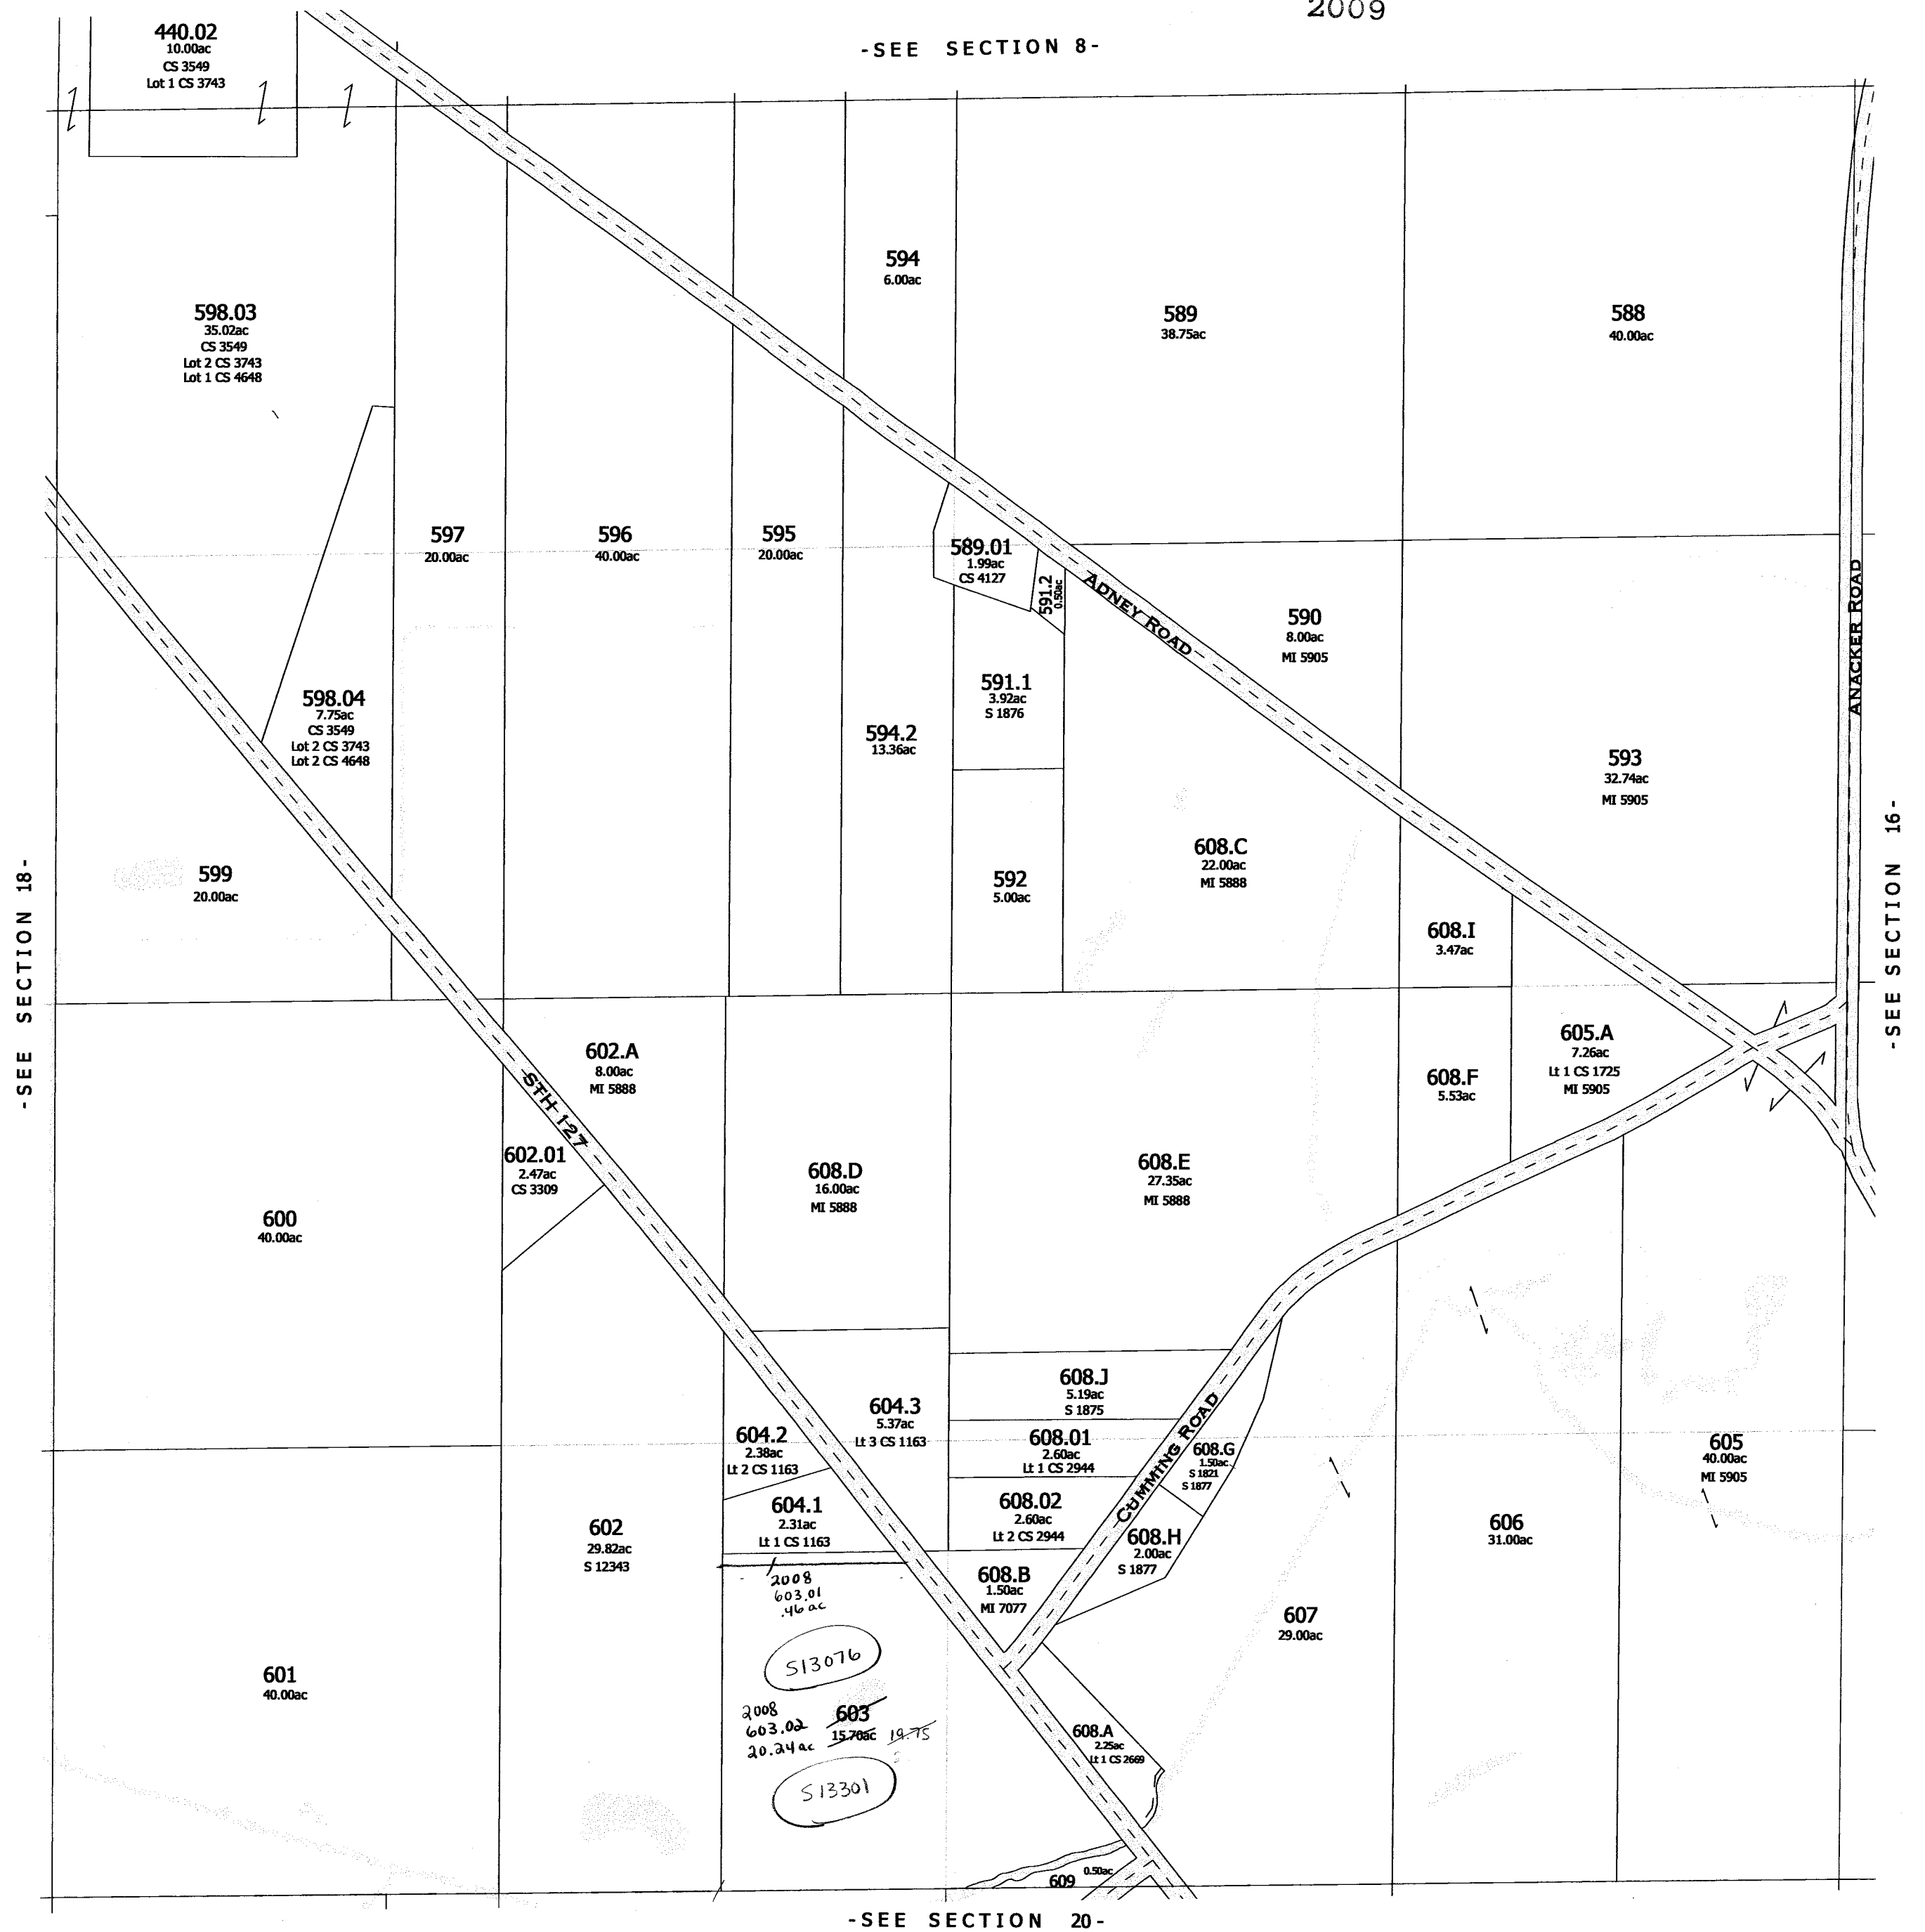

Also
2008

-SECTION 17-

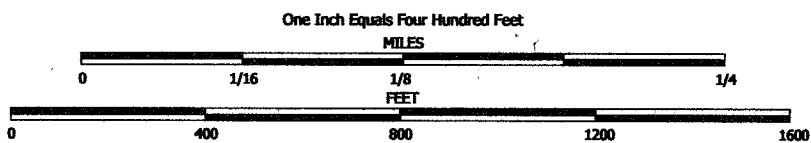



NOTE: This map was prepared for assessment use in accordance with the Wis. St. Stat. Chap. 70.09. All information contained herein is advisory only. Map accuracy is limited to the quality of data obtained from other Public Records. This map is not intended to be a substitute for an actual field survey. Public Land Survey Base is derived from U.S.G.S. Topographic maps unless otherwise noted. Other sources of the Land Base may be actual survey data. Base map data is from the April 1995 County Digital Orthophotos and/or U.S.G.S. 1:24,000 scale Topographic series. The user is responsible for the improper use of the data contained herein.

Created by The Columbia County Land Information Office -GIS Section. VMB.
February 2006.


TAX PARCEL MAP

TOWN of LEWISTON

TOWN 13 NORTH RANGE 8 EAST
COLUMBIA COUNTY, WISCONSIN

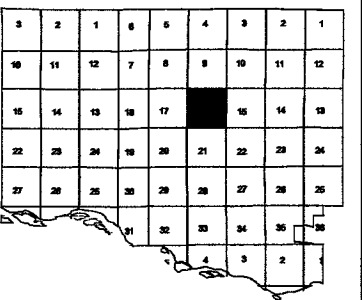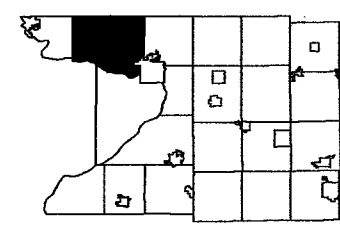

Replaced
2009

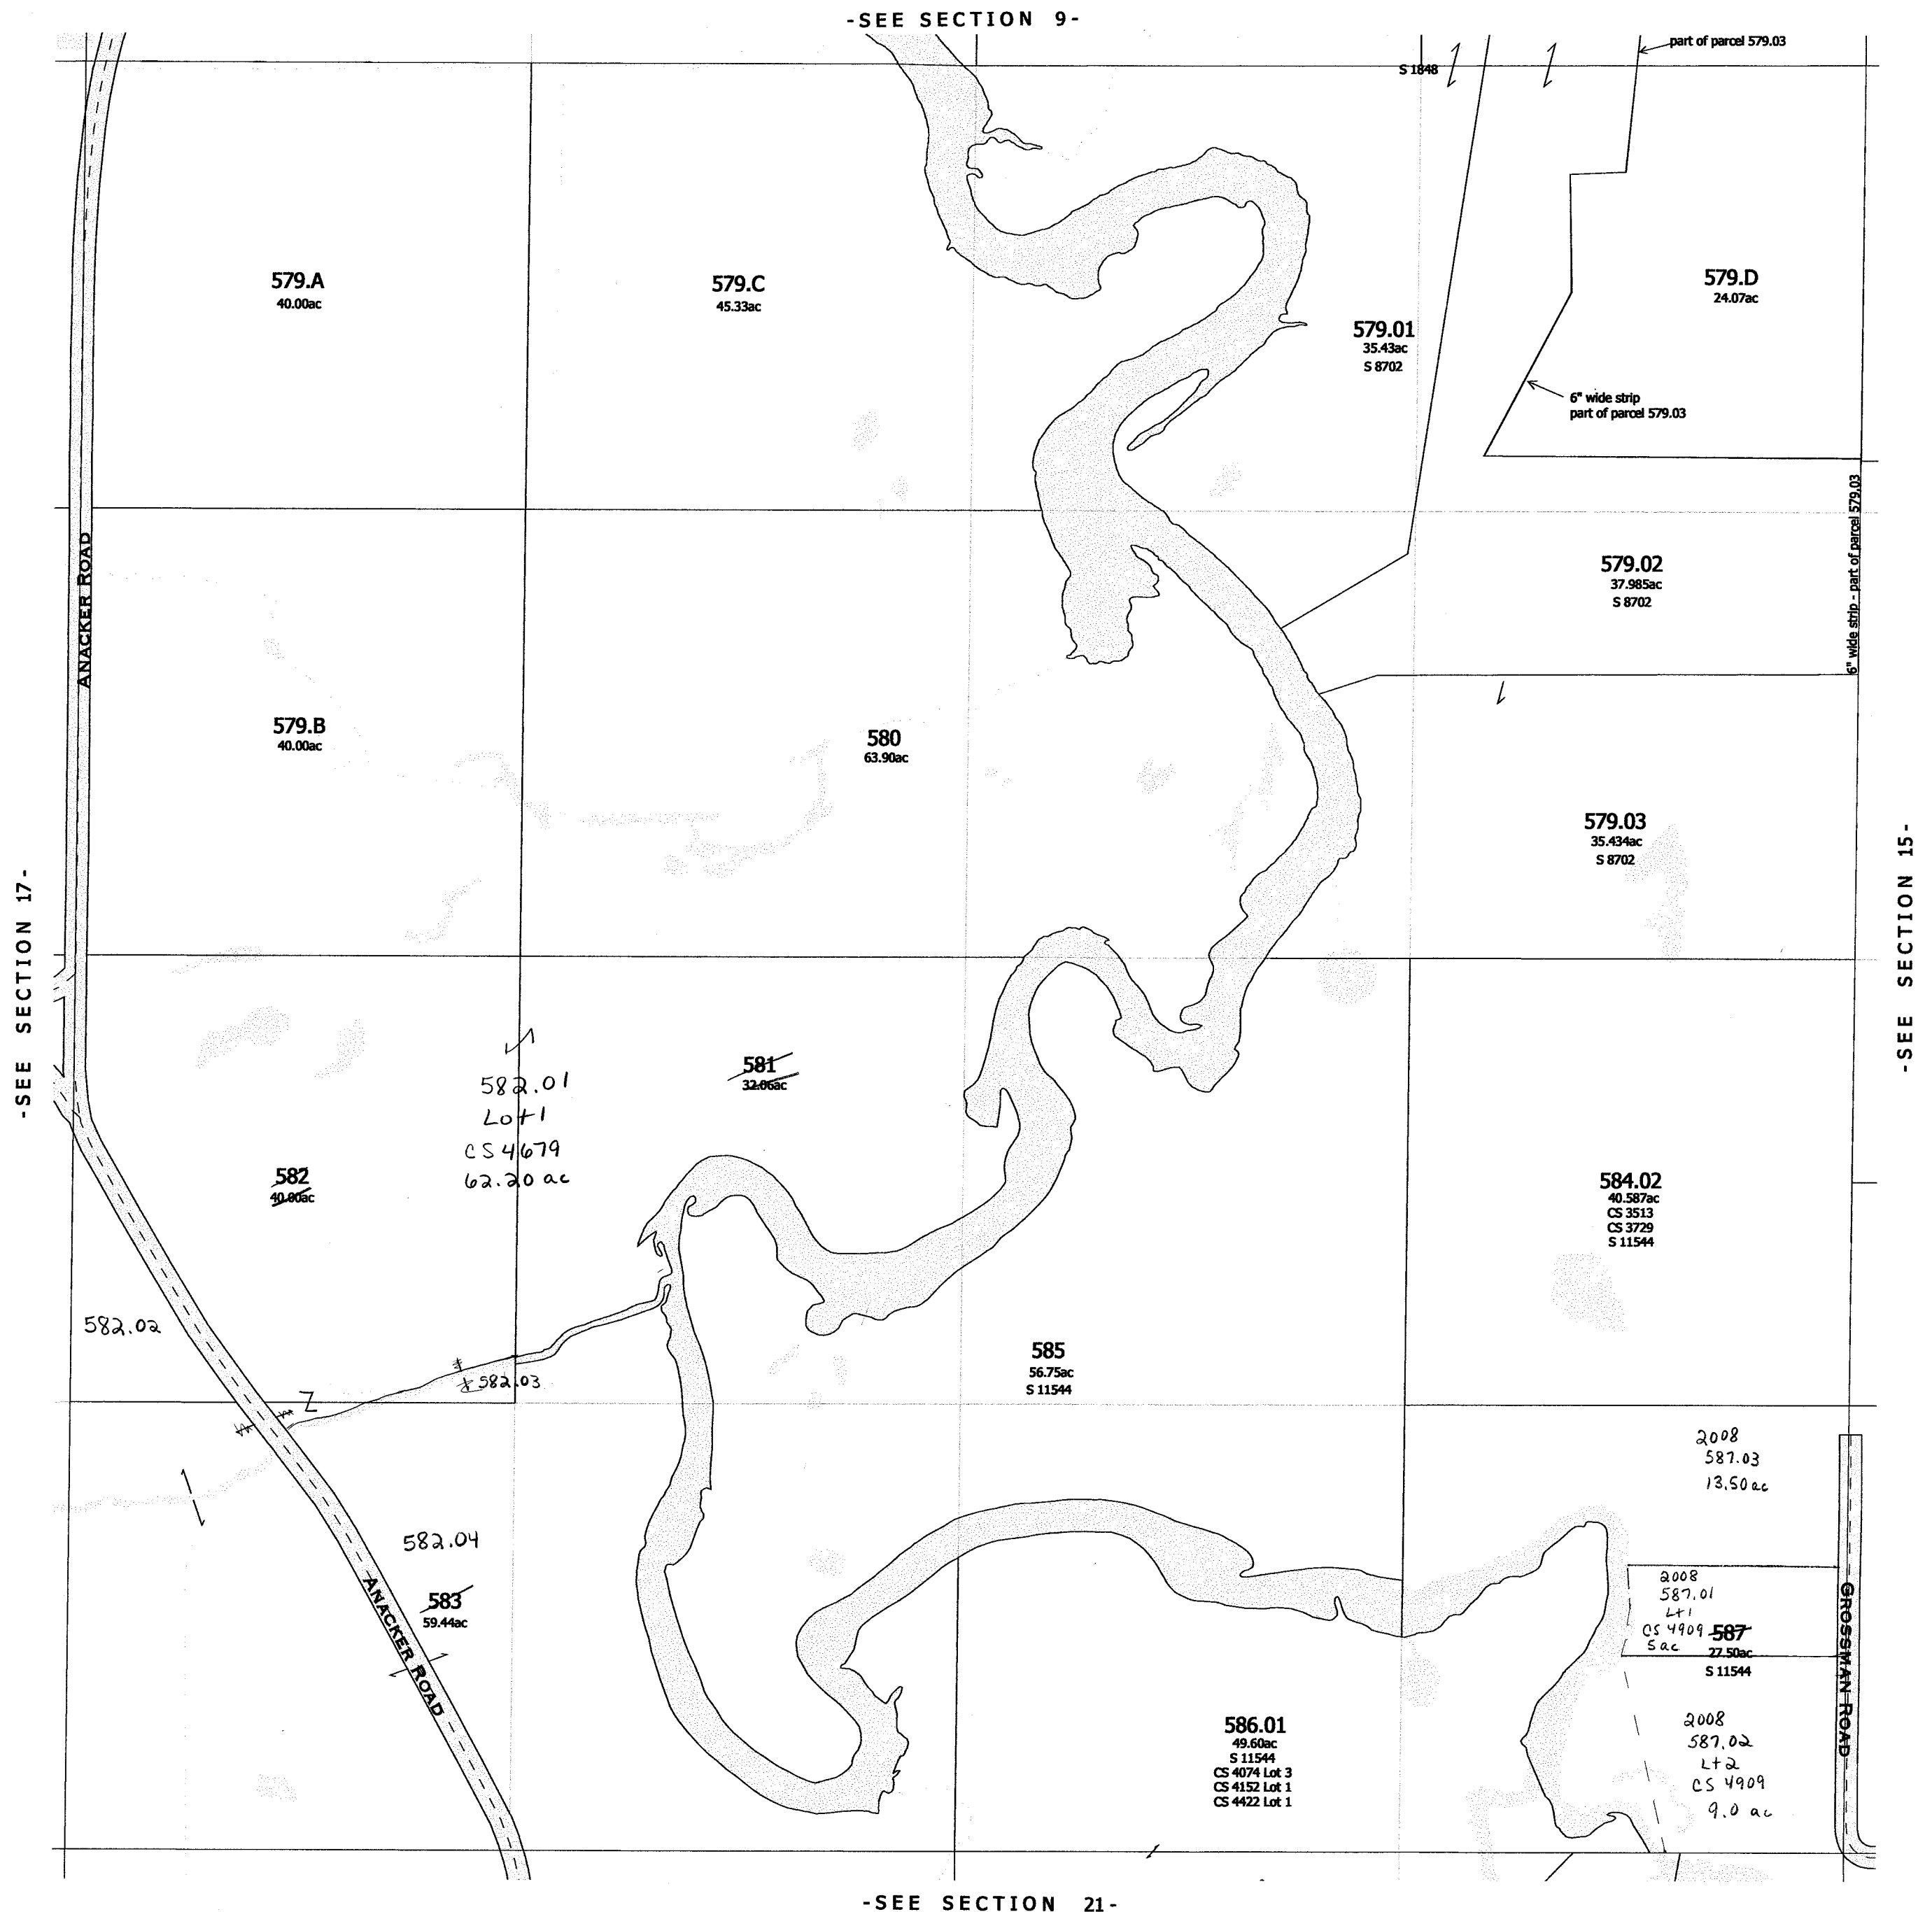

-SEE SECTION 21-

-SECTION 16-

Also
2008

One Inch Equals Four Hundred Feet
MILES
0 1/16 1/8 1/4
FEET
0 400 800 1200 1600


NOTE: This map was prepared for assessment use in accordance with the Wis. St. Stat. Chap. 70.09. All information contained herein is advisory only. Map accuracy is limited to the quality of data obtained from other Public Records. This map is not intended to be a substitute for an actual field survey. Public Land Survey Base is derived from U.S.G.S Topographic maps unless otherwise noted. Other sources of the Land Base may be actual survey data. Base map data is from the April 1995 County Digital Orthophotos and/or U.S.G.S 1:24,000 scale Topographic series. The user is responsible for the improper use of the data contained herein.

Created by The Columbia County Land Information Office -GIS Section. VMB.
February 2006.


TAX PARCEL MAP

TOWN of LEWISTON

TOWN 13 NORTH RANGE 8 EAST
COLUMBIA COUNTY, WISCONSIN

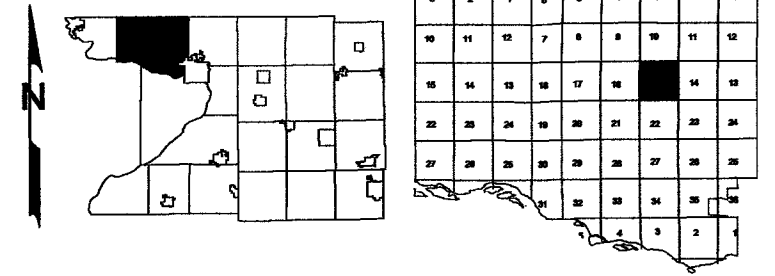

Replaced
2009

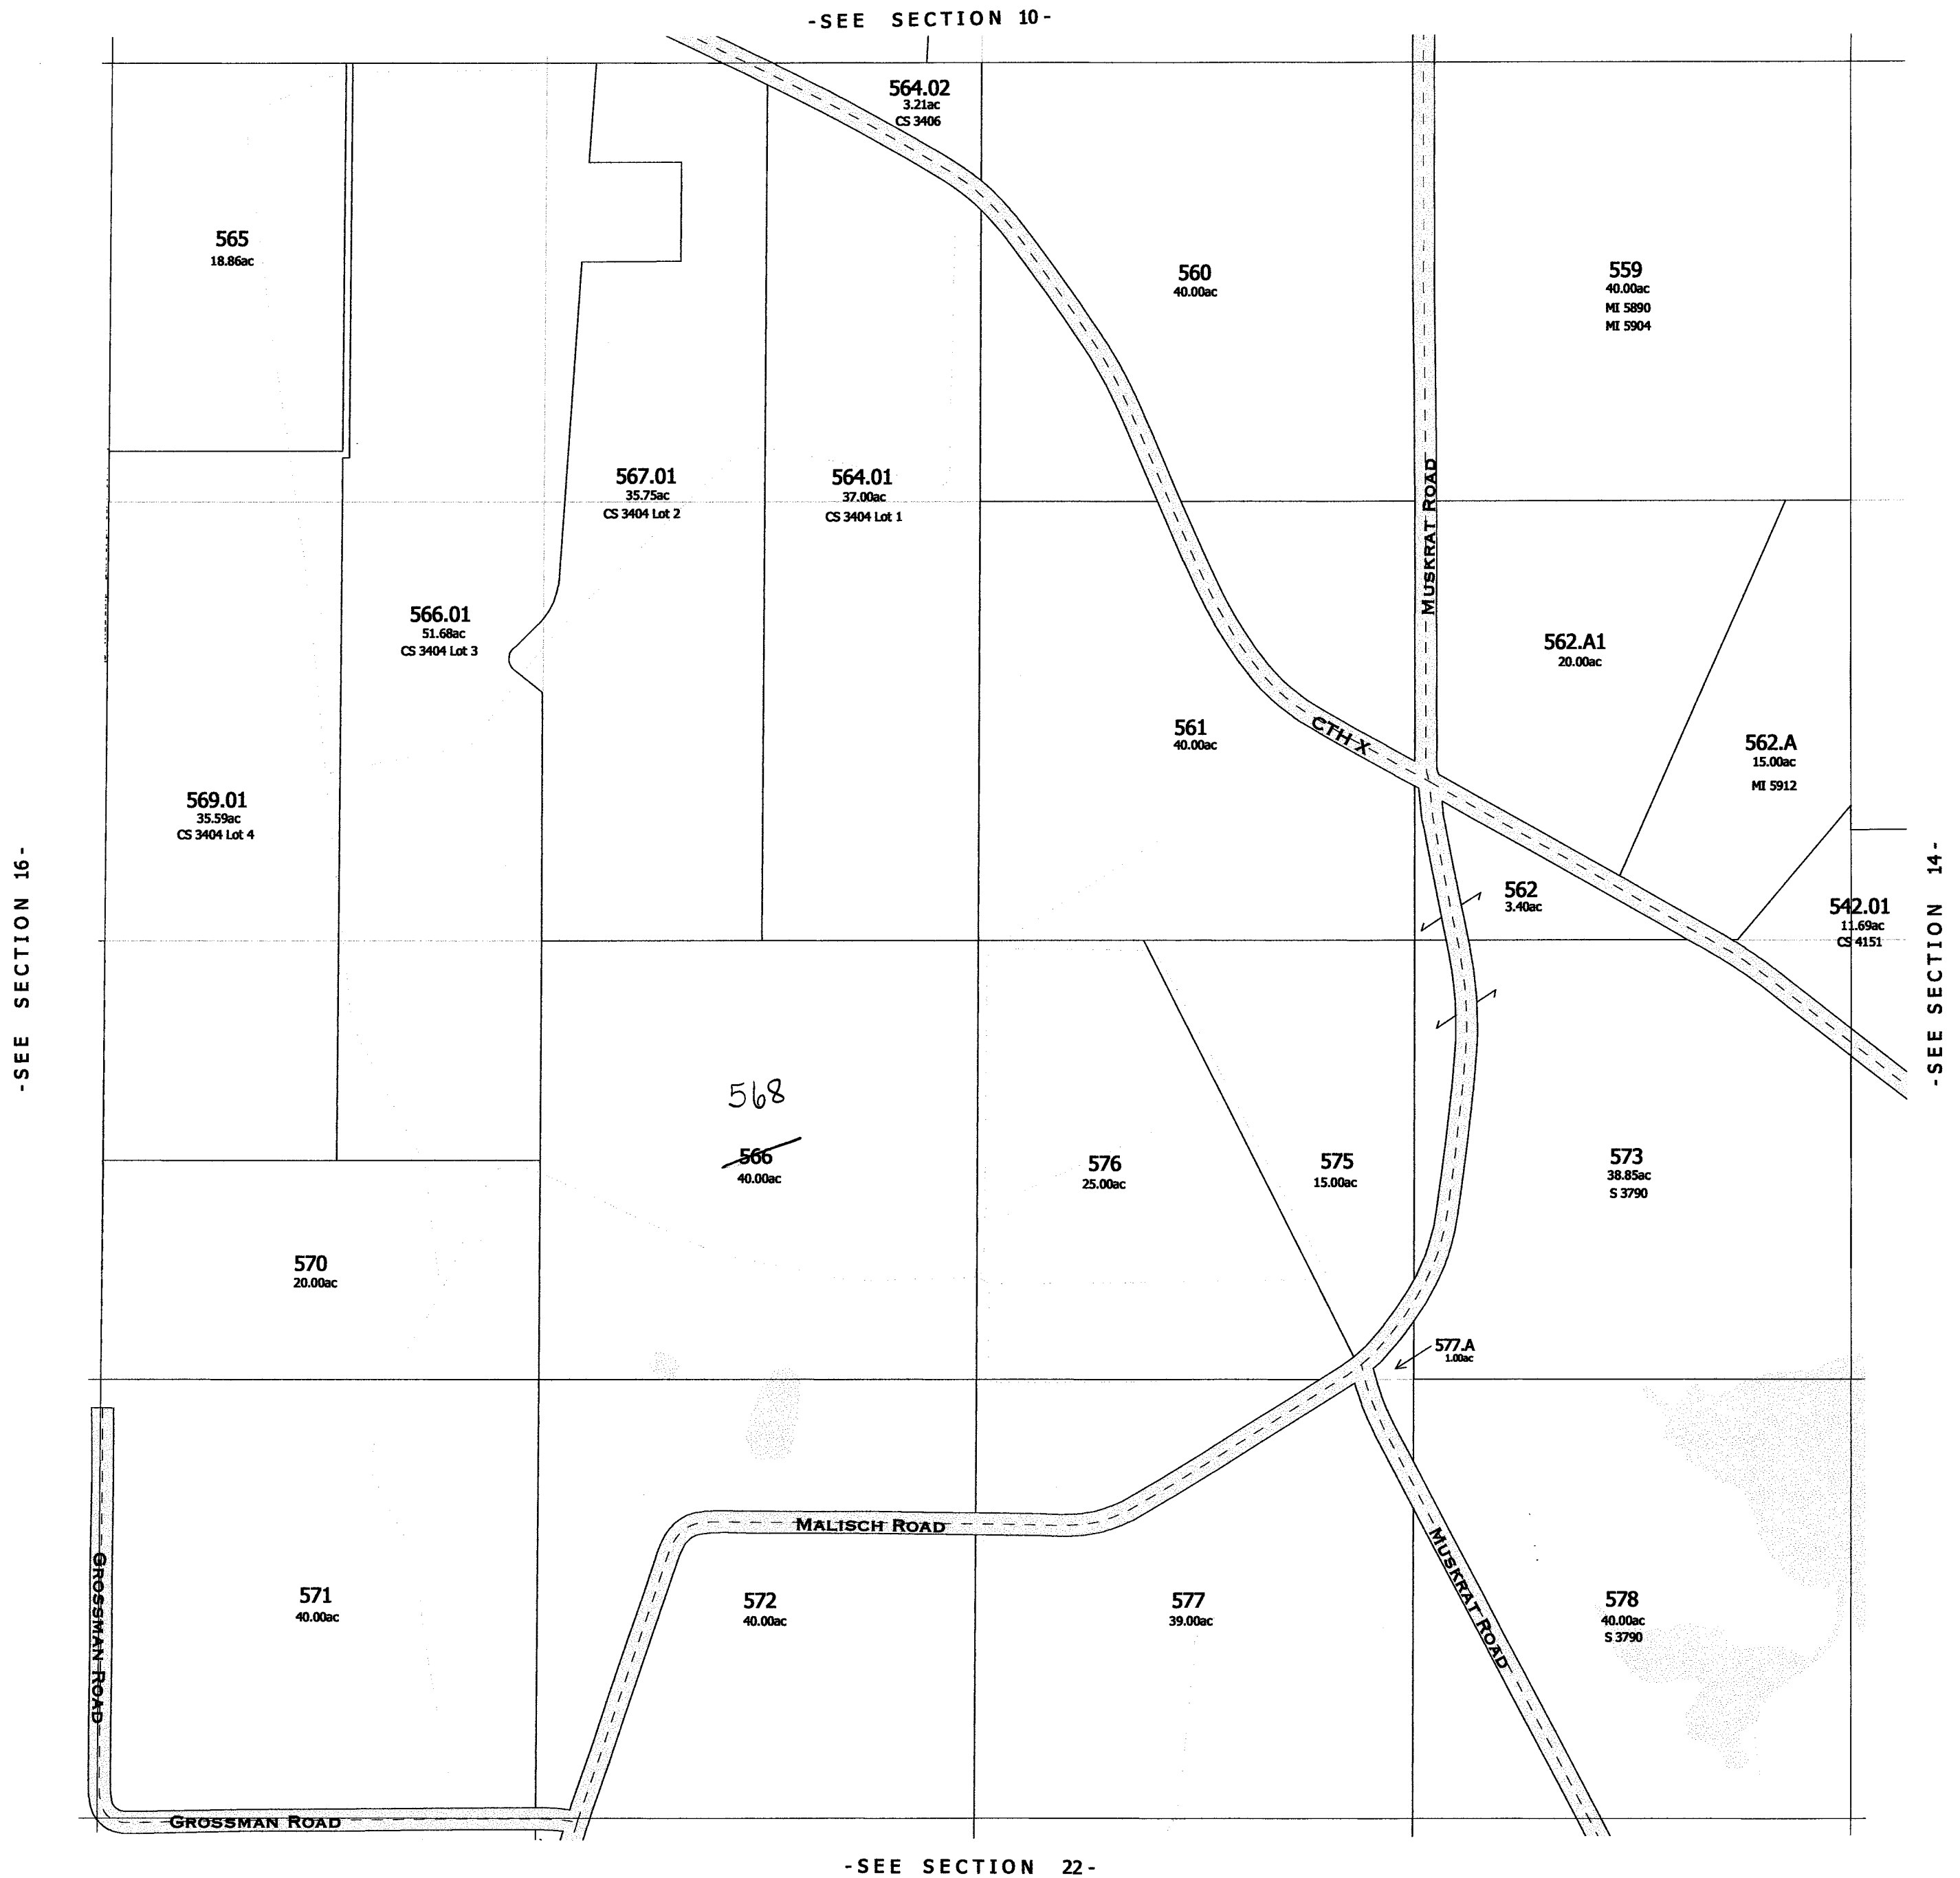

One Inch Equals Four Hundred Feet

MILES
0 1/16 1/8 1/4

FEET
0 400 800 1200 1600



NOTE: This map was prepared for assessment use in accordance with the Wis. St. Stat. Chap. 70.09. All information contained herein is advisory only. Map accuracy is limited to the quality of data obtained from other Public Records. This map is not intended to be a substitute for an actual field survey. Public Land Survey Base is derived from U.S.G.S. Topographic maps unless otherwise noted. Other sources of the Land Base may be actual survey data. Base map data is from the April 1995 County Digital Orthophotos and/or U.S.G.S. 1:24,000 scale Topographic series. The user is responsible for the improper use of the data contained herein.

Created by The Columbia County Land Information Office -GIS Section. VMB.
February 2007.


TAX PARCEL MAP

TOWN of LEWISTON

TOWN 13 NORTH RANGE 8 EAST
COLUMBIA COUNTY, WISCONSIN

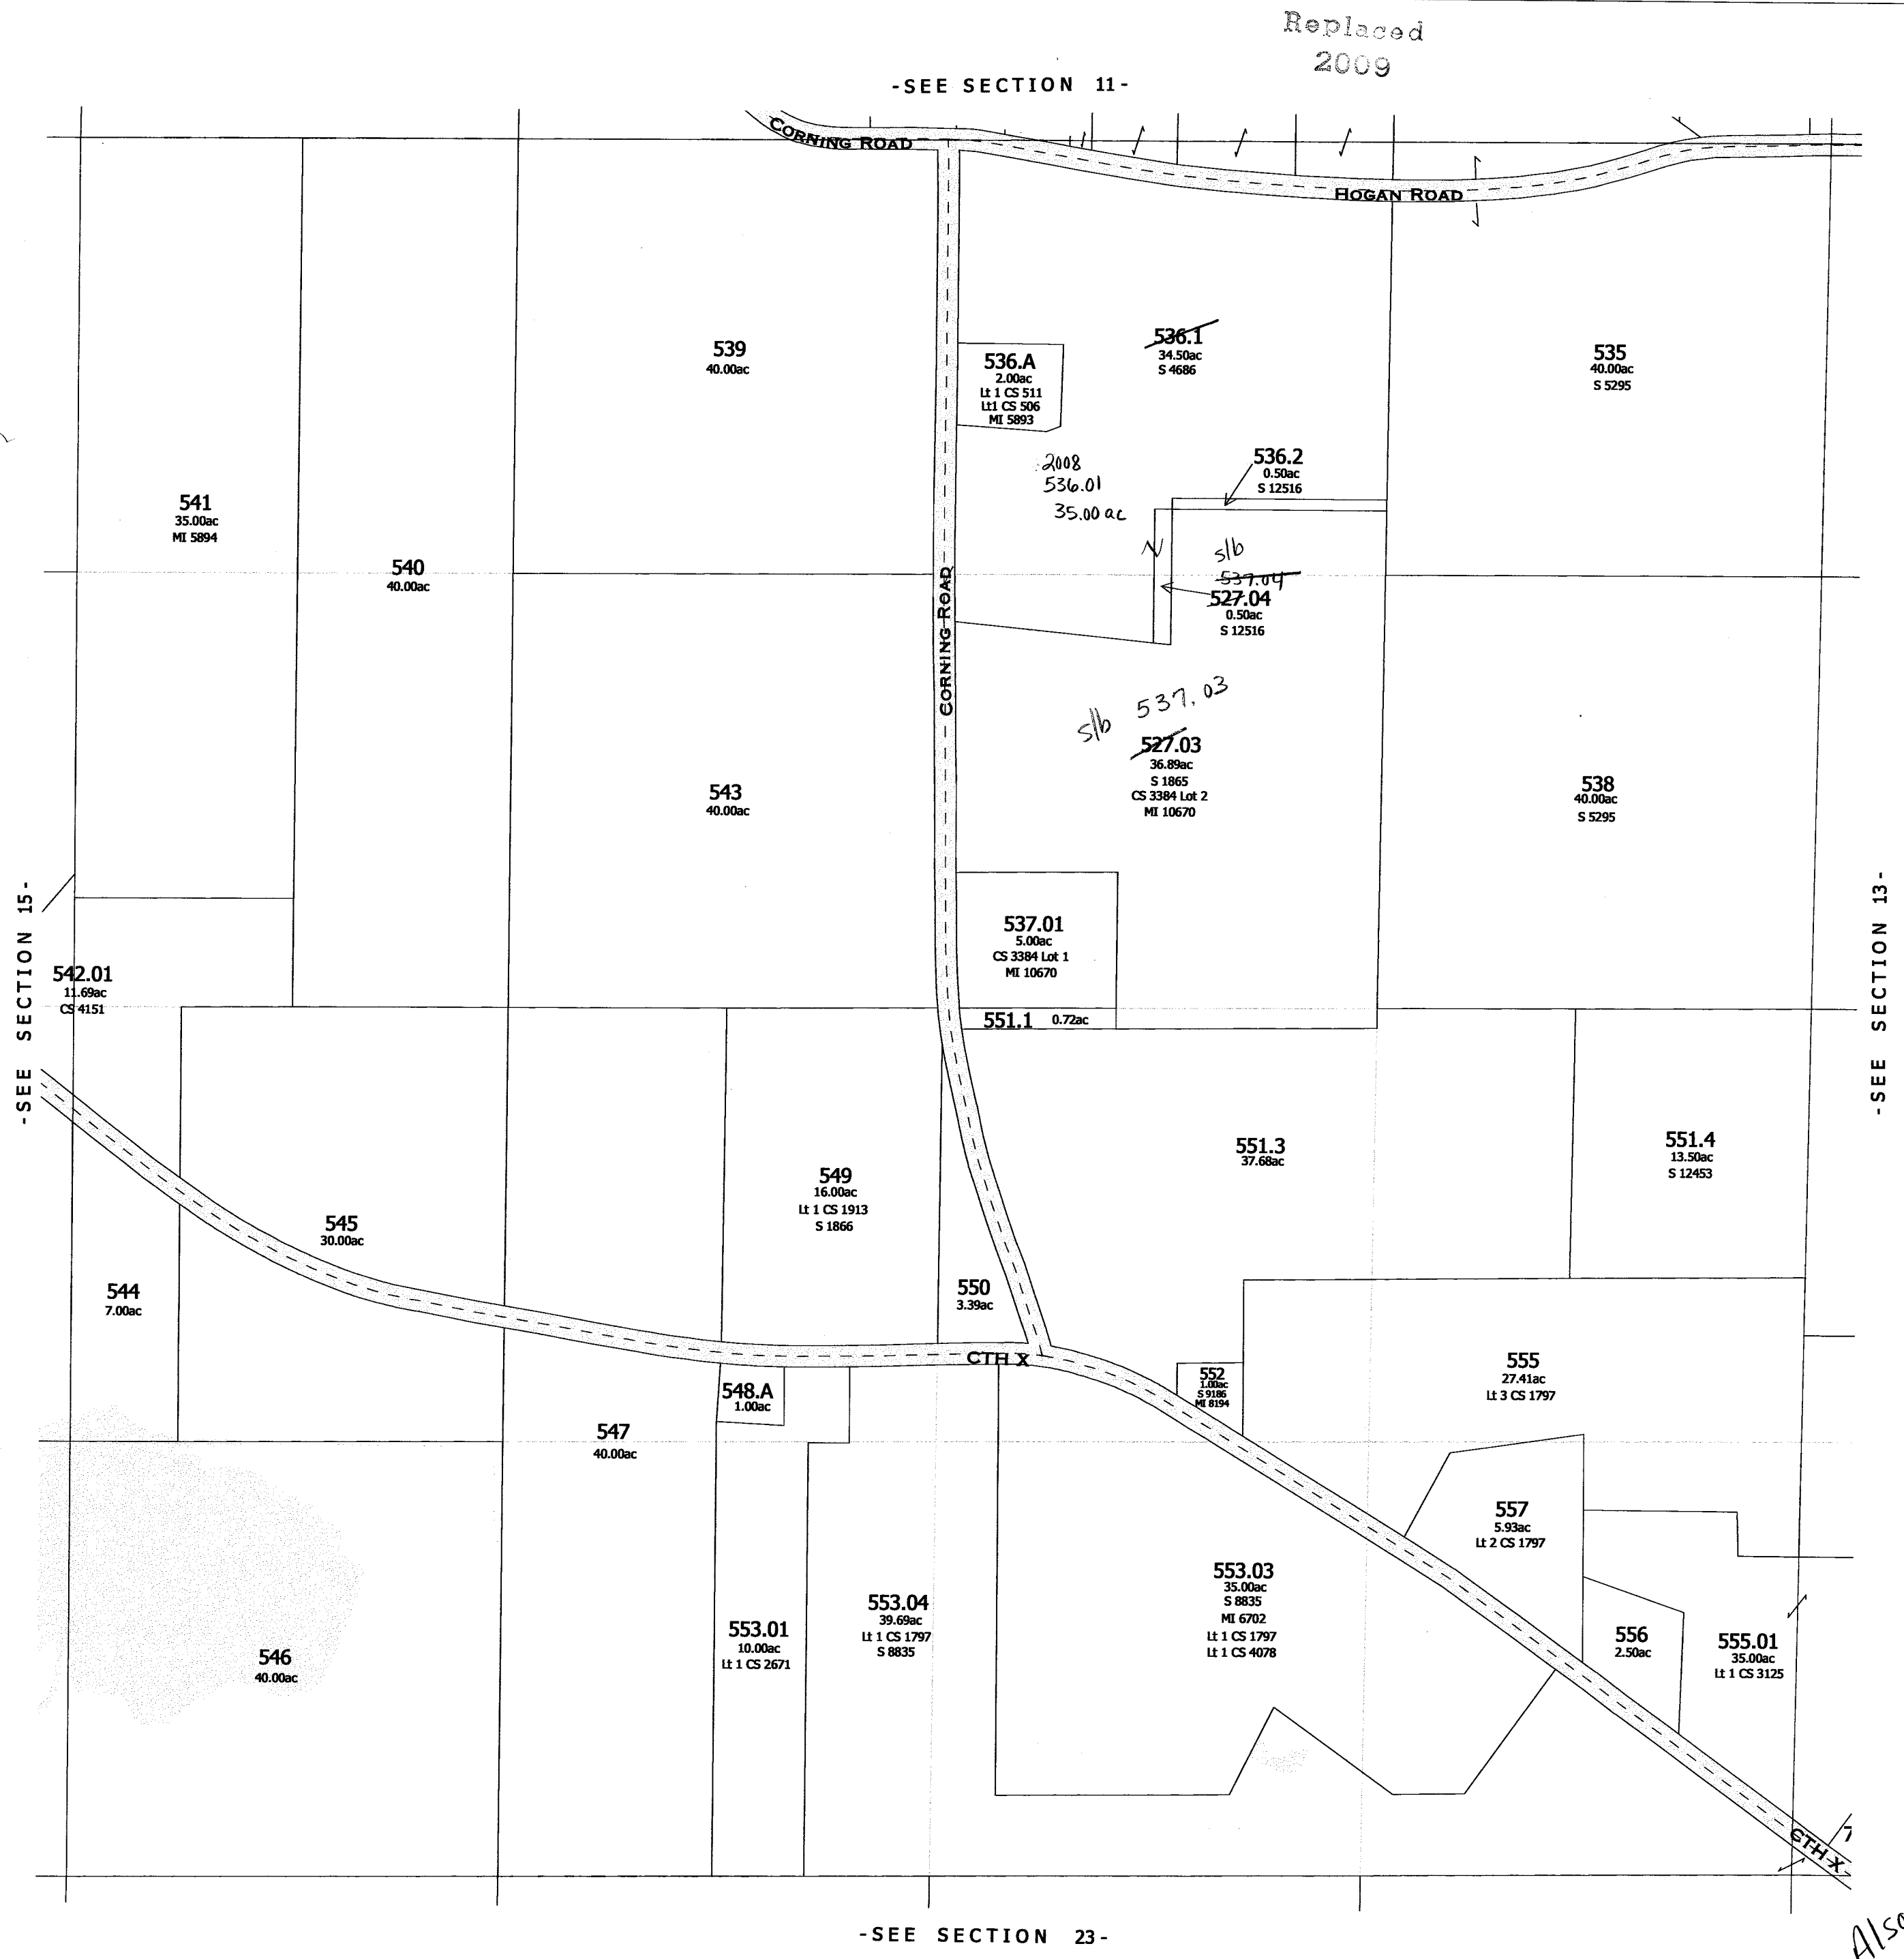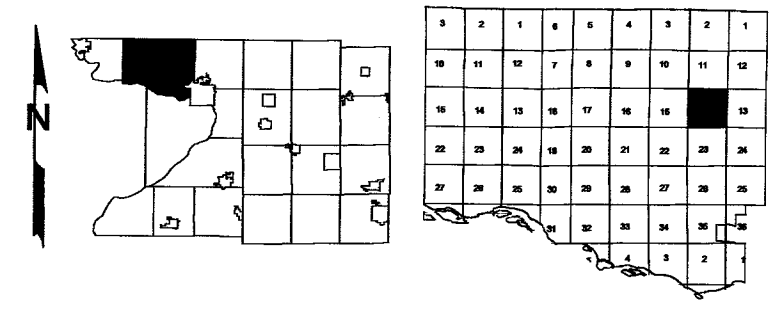

Also 2008

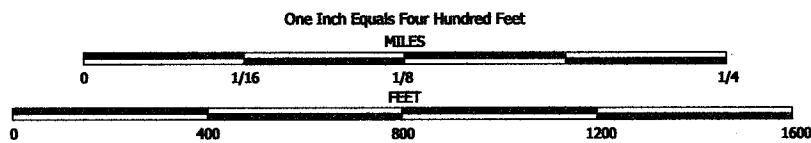



NOTE: This map was prepared for assessment use in accordance with the Wis. St. Stat. Chap. 70.09. All information contained herein is advisory only. Map accuracy is limited to the quality of data obtained from other Public Records. This map is not intended to be a substitute for an actual field survey. Public Land Survey Base is derived from U.S.G.S. Topographic maps unless otherwise noted. Other sources of the Land Base may be actual survey data. Base map data is from the April 1995 County Digital Orthophotos and/or U.S.G.S. 1:24,000 scale Topographic series. The user is responsible for the improper use of the data contained herein.

Created by The Columbia County Land Information Office -GIS Section. VMB.
February 2006.

TAX PARCEL MAP


TOWN of LEWISTON

TOWN 13 NORTH RANGE 8 EAST
COLUMBIA COUNTY, WISCONSIN

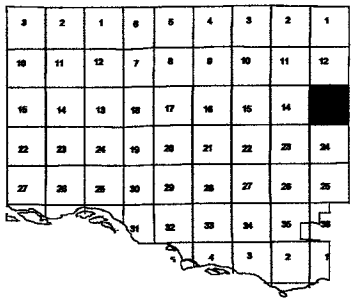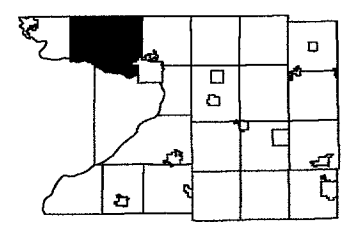


Replaced
2009

-SEE SECTION 12-

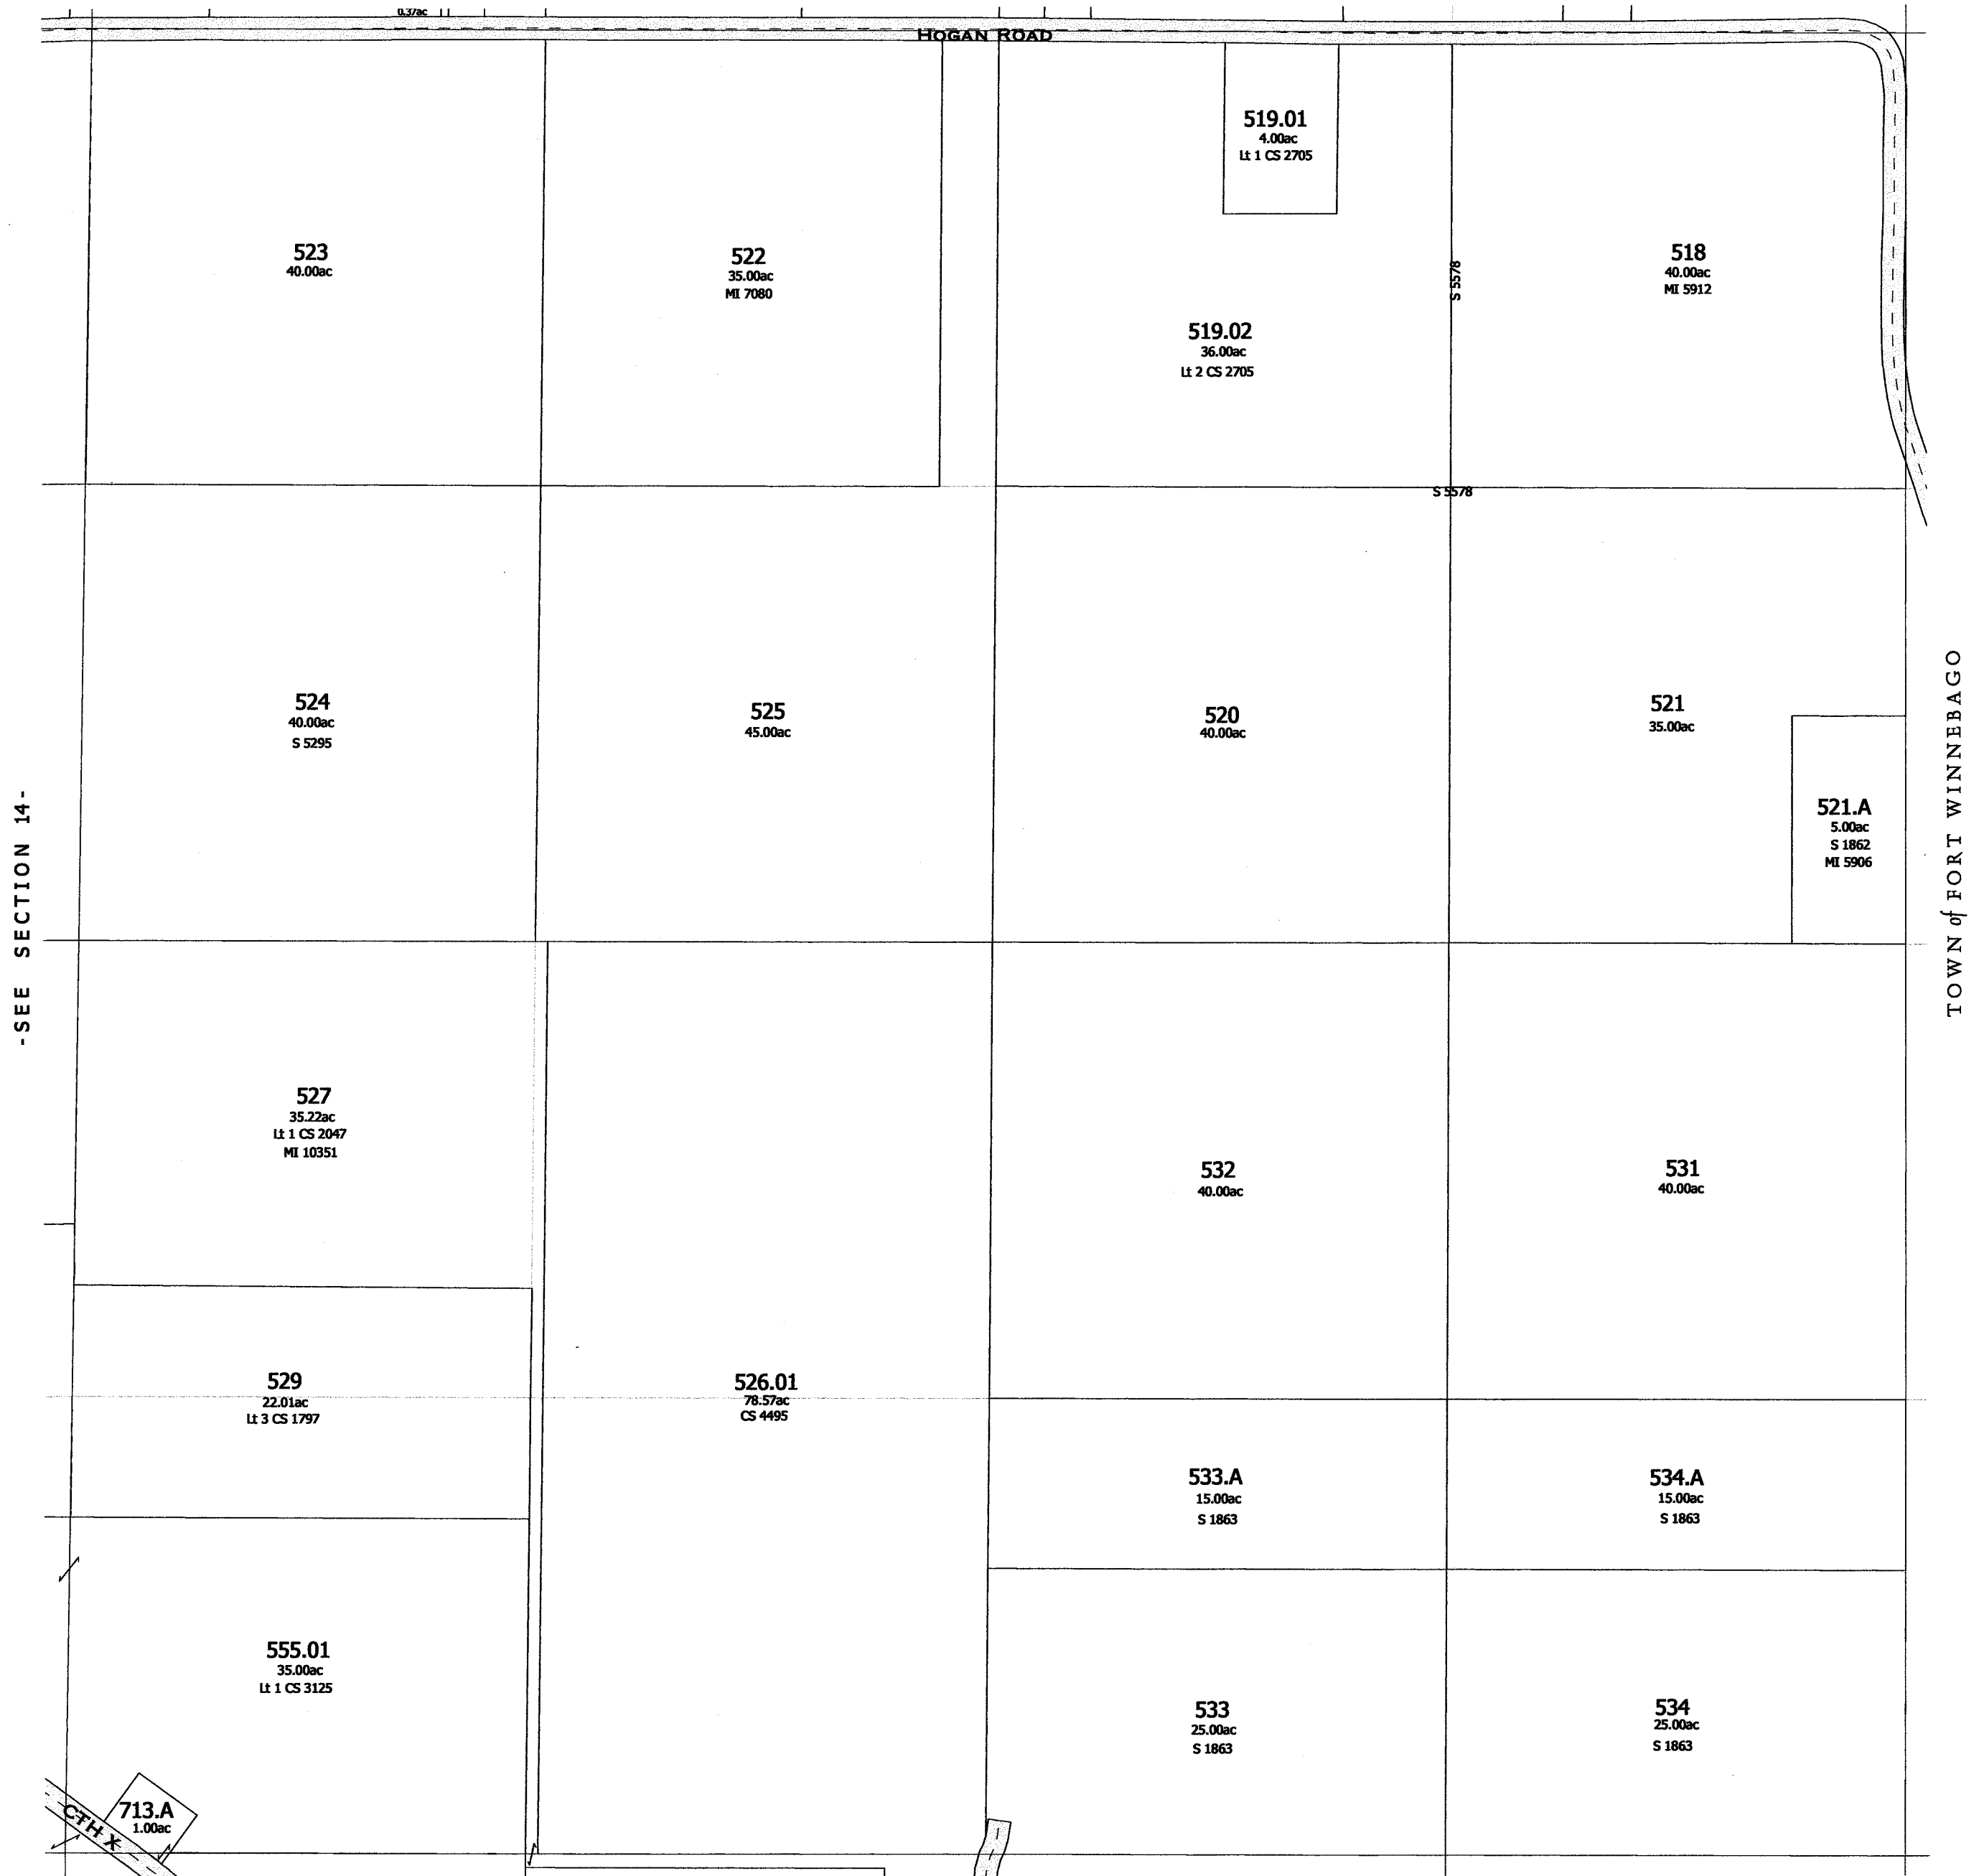

-SEE SECTION 24-

-SECTION 13-

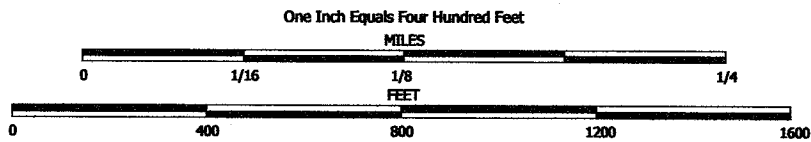



NOTE: This map was prepared for assessment use in accordance with the Wis. Stat. Chap. 70.09. All information contained herein is advisory only. Map accuracy is limited to the quality of data obtained from other Public Records. This map is not intended to be a substitute for an actual field survey. Public Land Survey Base is derived from U.S.G.S Topographic maps unless otherwise noted. Other sources of the Land Base may be actual survey data. Base map data is from the April 1995 County Digital Orthophotos and/or U.S.G.S. 1:24,000 scale Topographic series. The user is responsible for the improper use of the data contained herein.

Created by The Columbia County Land Information Office -GIS Section. VMB.
February 2003.

TAX PARCEL MAP

TOWN of LEWISTON

TOWN 13 NORTH RANGE 8 EAST
COLUMBIA COUNTY, WISCONSIN

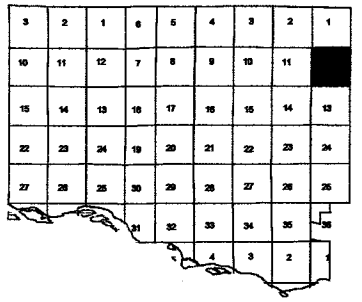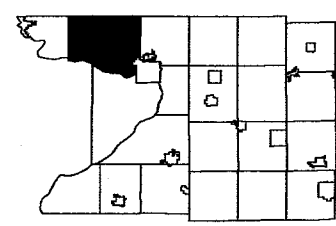

Replaced
2009

-SEE SECTION 1-



-SEE SECTION 13-

-SECTION 12-

One Inch Equals Four Hundred Feet

MILES
0 1/16 1/8 1/4
FEET
0 400 800 1200 1600



NOTE: This map was prepared for assessment use in accordance with the Wis. St. Stat. Chap. 70.09. All information contained herein is advisory only. Map accuracy is limited to the quality of data obtained from other Public Records. This map is not intended to be a substitute for an actual field survey. Public Land Survey Base is derived from U.S.G.S. Topographic maps unless otherwise noted. Other sources of the Land Base may be actual survey data. Base map data is from the April 1995 County Digital Orthophotos and/or U.S.G.S. 1:24,000 scale Topographic series. The user is responsible for the improper use of the data contained herein.


Created by The Columbia County Land Information Office -GIS Section. VMB.
February 2005.

TAX PARCEL MAP

TOWN of LEWISTON

TOWN 13 NORTH RANGE 8 EAST
COLUMBIA COUNTY, WISCONSIN

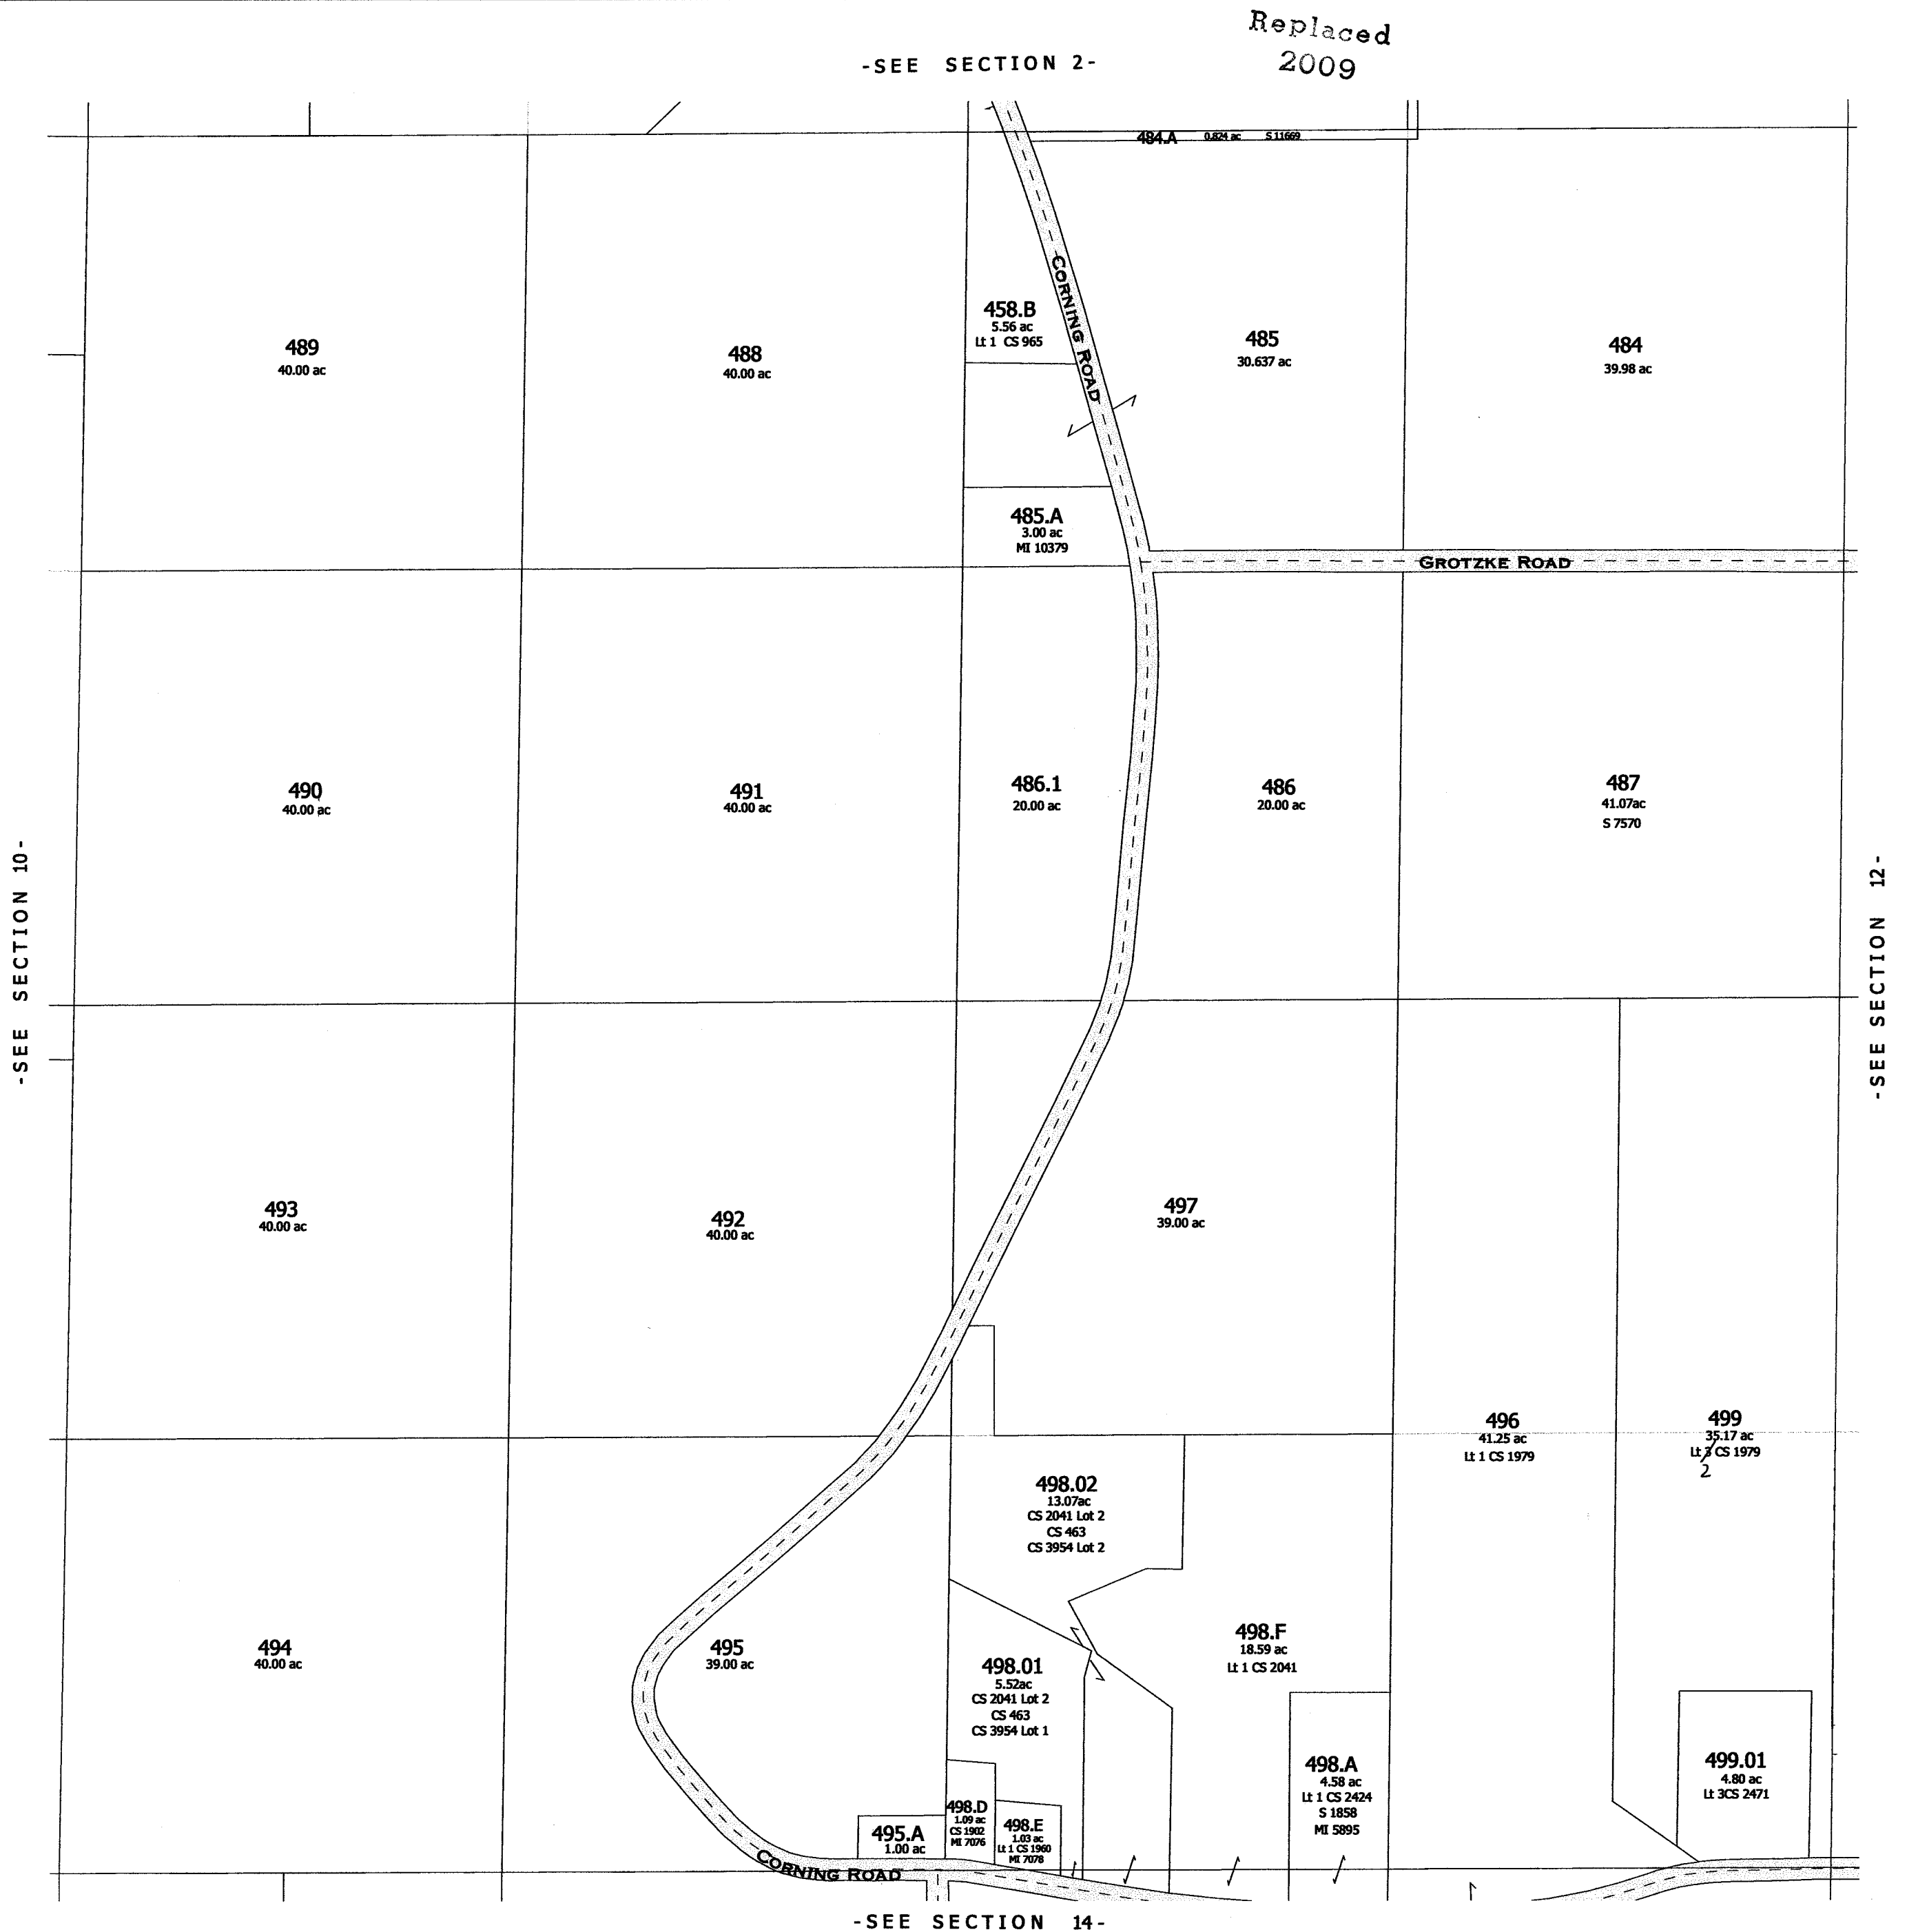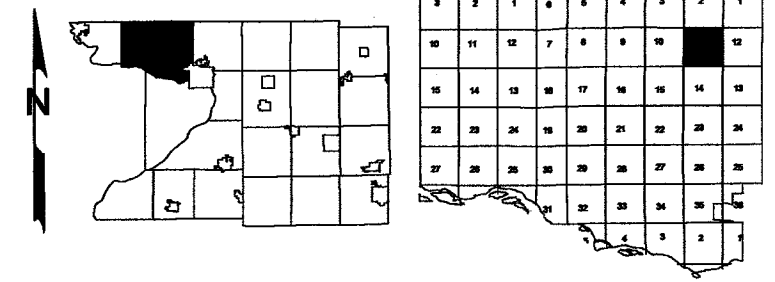

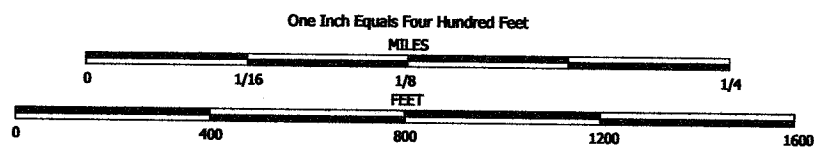


NOTE: This map was prepared for assessment use in accordance with the Wis. St. Stat. Chap. 70.09. All information contained herein is advisory only. Map accuracy is limited to the quality of data obtained from other Public Records. This map is not intended to be a substitute for an actual field survey. Public Land Survey Base is derived from U.S.G.S. Topographic maps unless otherwise noted. Other sources of the Land Base may be actual survey data. Base map data is from the April 1995 County Digital Orthophotos and/or U.S.G.S. 1:24,000 scale Topographic series. The user is responsible for the improper use of the data contained herein.

Created by The Columbia County Land Information Office -GIS Section, VMB.
February 2006.

TAX PARCEL MAP

TOWN of LEWISTON

TOWN 13 NORTH RANGE 8 EAST
COLUMBIA COUNTY, WISCONSIN

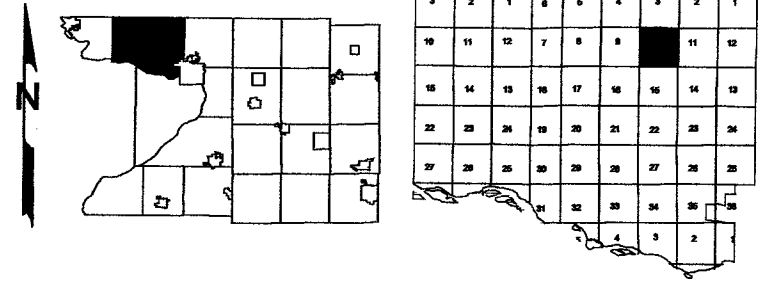

Also
2008

-SECTION 10-

One Inch Equals Four Hundred Feet
MILES
0 1/16 1/8 1/4
FEET
0 400 800 1200 1600



NOTE: This map was prepared for assessment use in accordance with the Wis. St. Stat. Chap. 70.09. All information contained herein is advisory only. Map accuracy is limited to the quality of data obtained from other Public Records. This map is not intended to be a substitute for an actual field survey. Public Land Survey Base is derived from U.S.G.S. Topographic maps unless otherwise noted. Other sources of the land base may be actual survey data. Base map data is from the April 1995 County Digital Orthophotos and/or U.S.G.S. 1:24,000 scale Topographic series. The user is responsible for the improper use of the data contained herein.


Created by The Columbia County Land Information Office -GIS Section. VMB.
February 2006.

TAX PARCEL MAP

TOWN of LEWISTON

TOWN 13 NORTH RANGE 8 EAST
COLUMBIA COUNTY, WISCONSIN

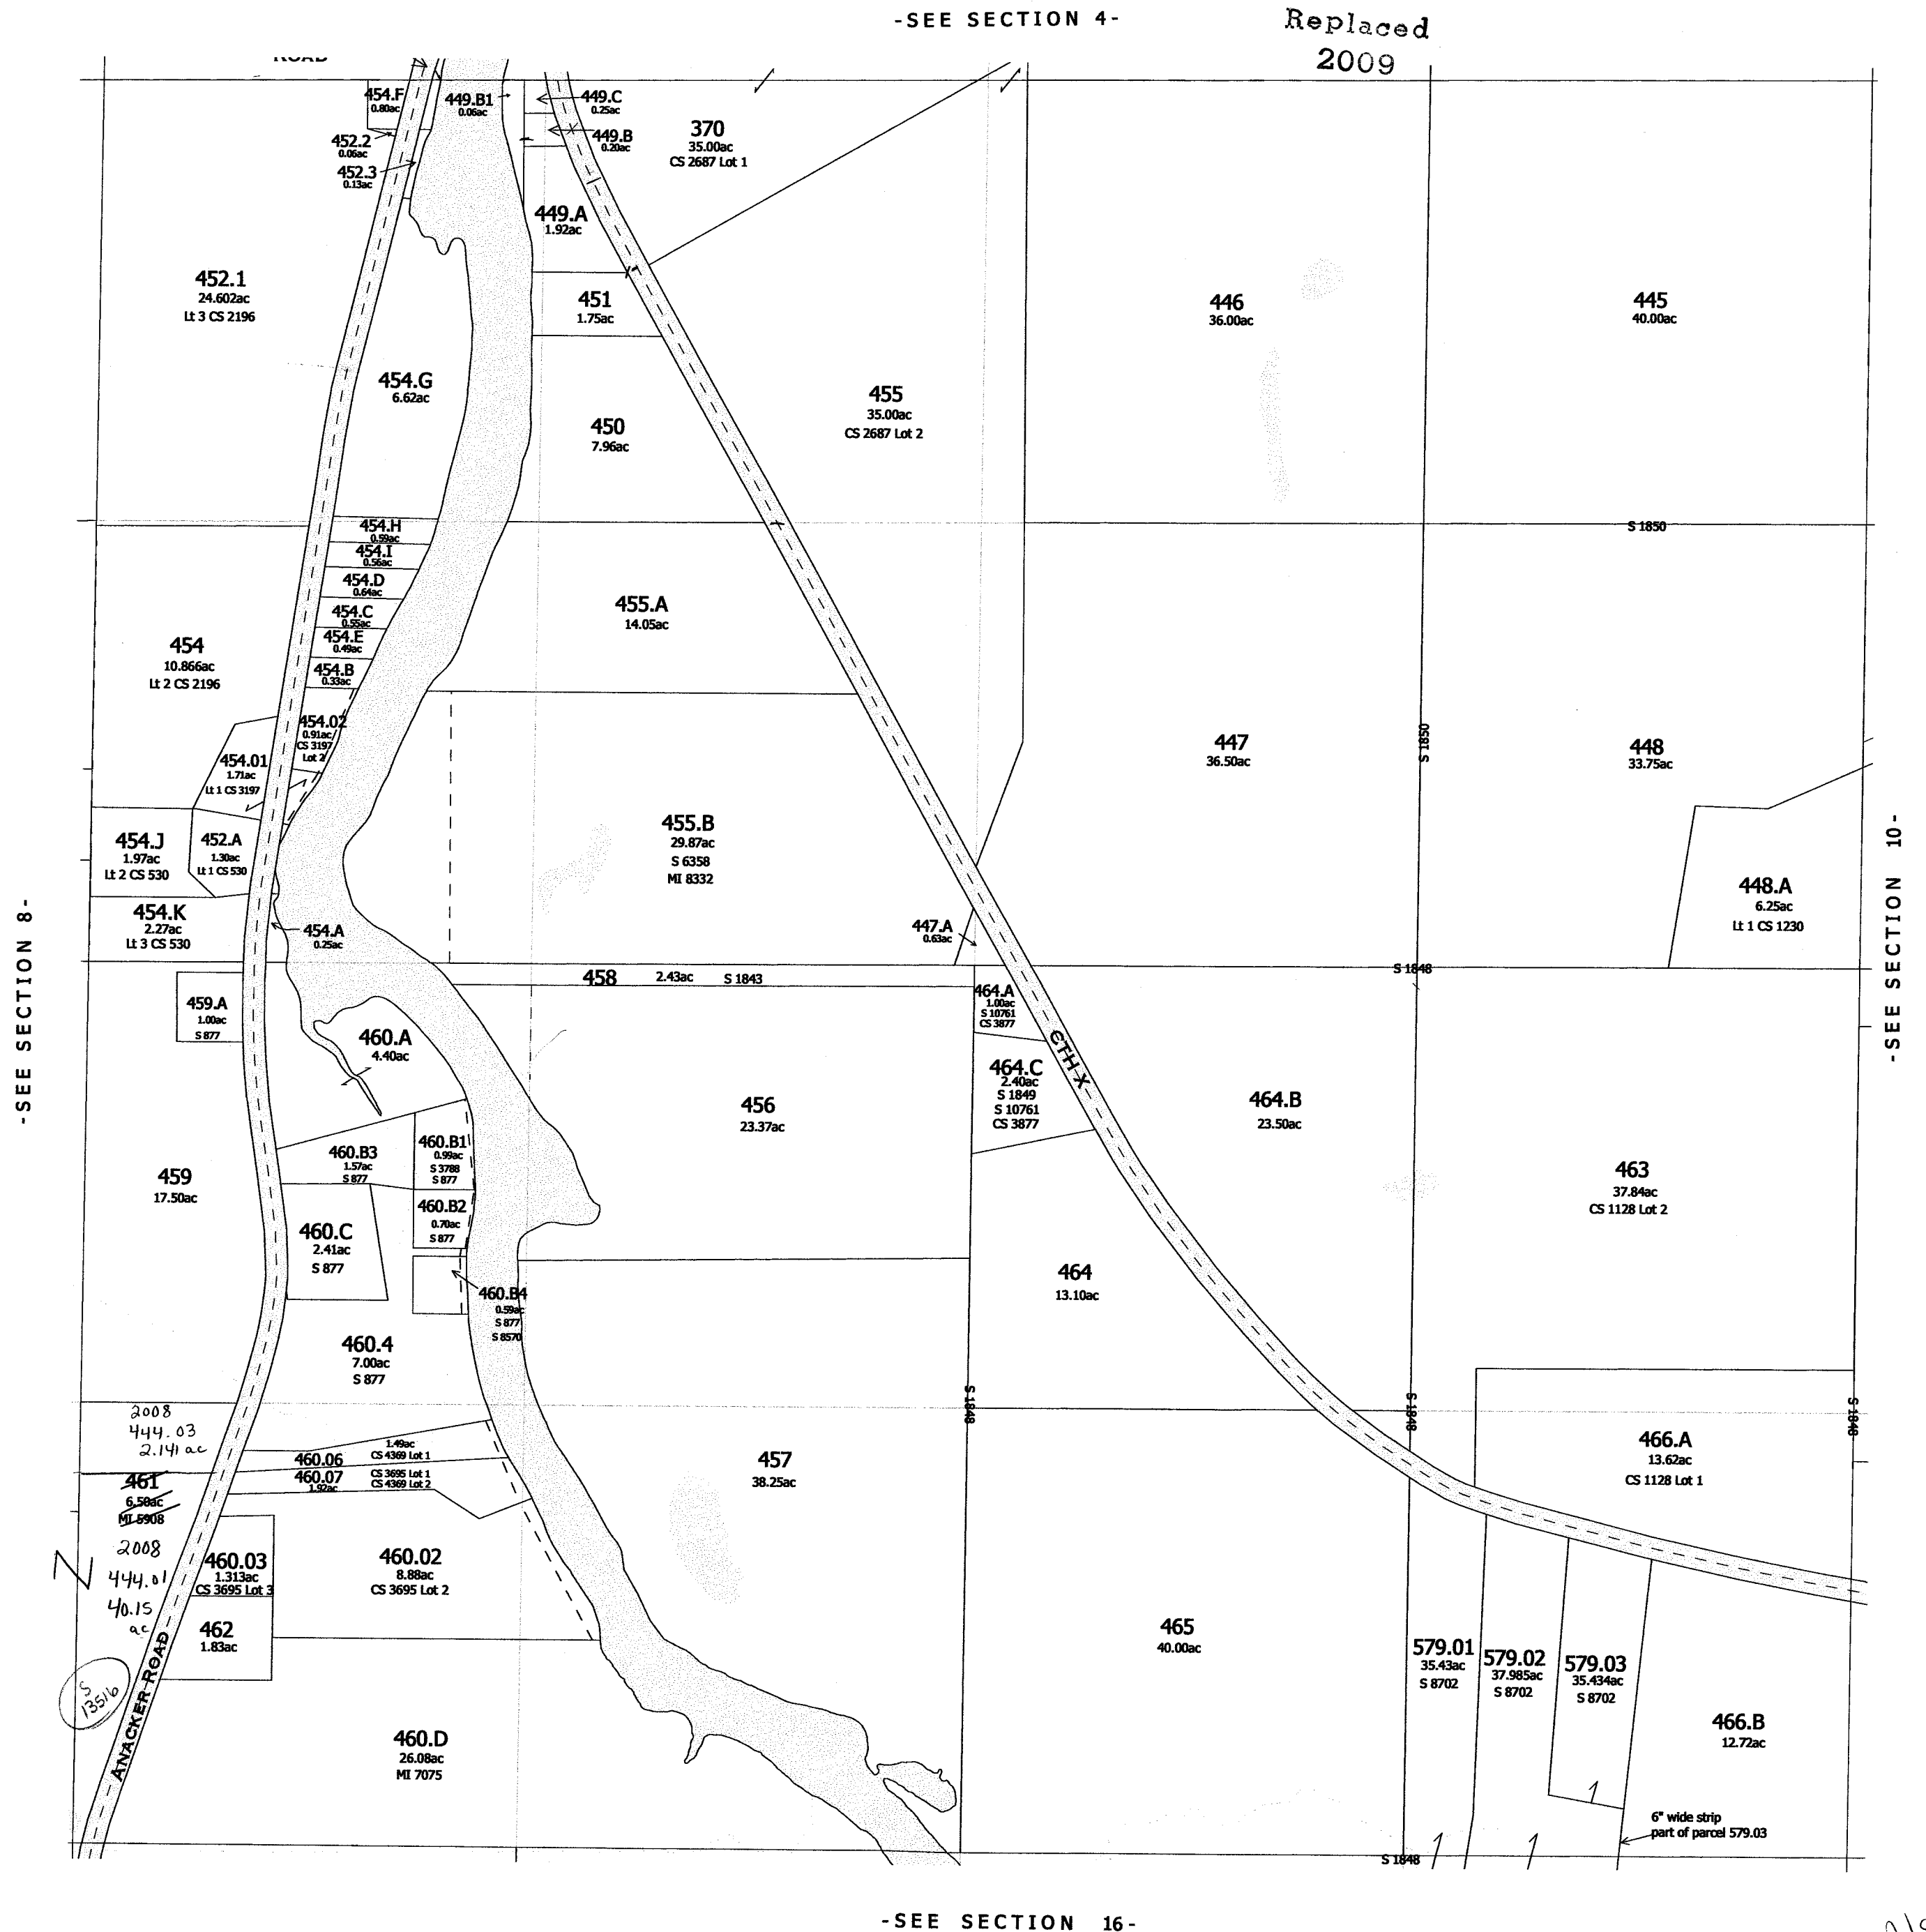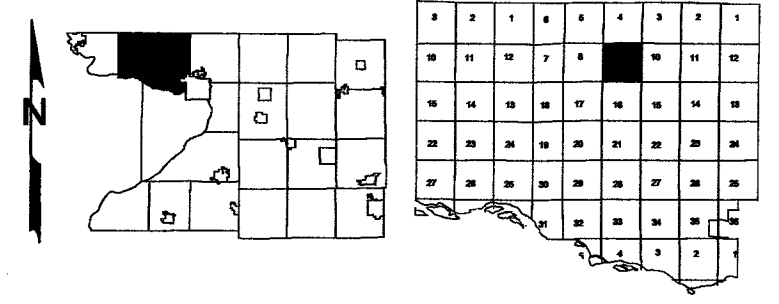

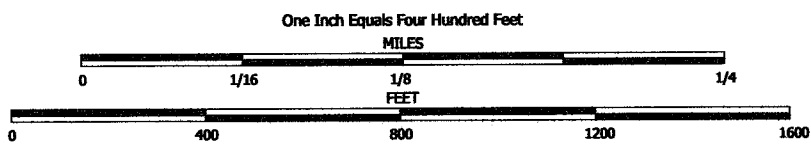


NOTE: This map was prepared for assessment use in accordance with the Wis. St. Stat. Chap. 70.09. All information contained herein is advisory only. Map accuracy is limited to the quality of data obtained from other Public Records. This map is not intended to be a substitute for an actual field survey. Public Land Survey Base is derived from U.S.G.S. Topographic maps unless otherwise noted. Other sources of the Land Base may be actual survey data. Base map data is from the April 1995 County Digital Orthophotos and/or U.S.G.S. 1:24,000 scale Topographic series. The user is responsible for the improper use of the data contained herein.

Created by The Columbia County Land Information Office -GIS Section. VMB.
February 2003.

TAX PARCEL MAP

TOWN of LEWISTON

TOWN 13 NORTH RANGE 8 EAST
COLUMBIA COUNTY, WISCONSIN

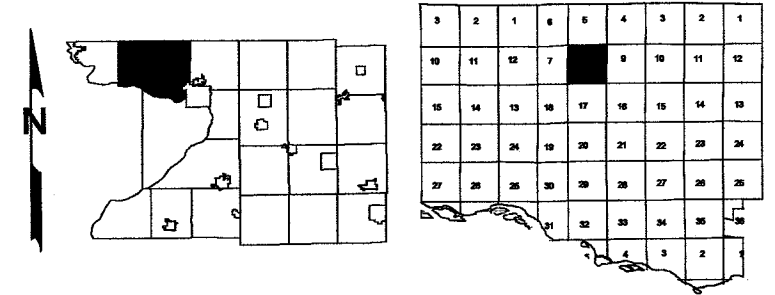

-SEE SECTION 5-

Replaced
2008



-SEE SECTION 17-

-SEE SECTION 9-

-SECTION 8-

Also
2008

One Inch Equals Four Hundred Feet
MILES
0 1/16 1/8 1/4
FEET
0 400 800 1200 1600



NOTE: This map was prepared for assessment use in accordance with the Wis. St. Stat. Chap. 70.09. All information contained herein is advisory only. Map accuracy is limited to the quality of data obtained from other Public Records. This map is not intended to be a substitute for an actual field survey. Public Land Survey Base is derived from U.S.G.S. Topographic maps unless otherwise noted. Other sources of the Land Base may be actual survey data. Base map data is from the April 1995 County Digital Orthophotos and/or U.S.G.S. 1:24,000 scale Topographic series. The user is responsible for the improper use of the data contained herein.

Created by The Columbia County Land Information Office -GIS Section. VMB.
February 2007.


TAX PARCEL MAP

TOWN of LEWISTON

TOWN 13 NORTH RANGE 8 EAST
COLUMBIA COUNTY, WISCONSIN

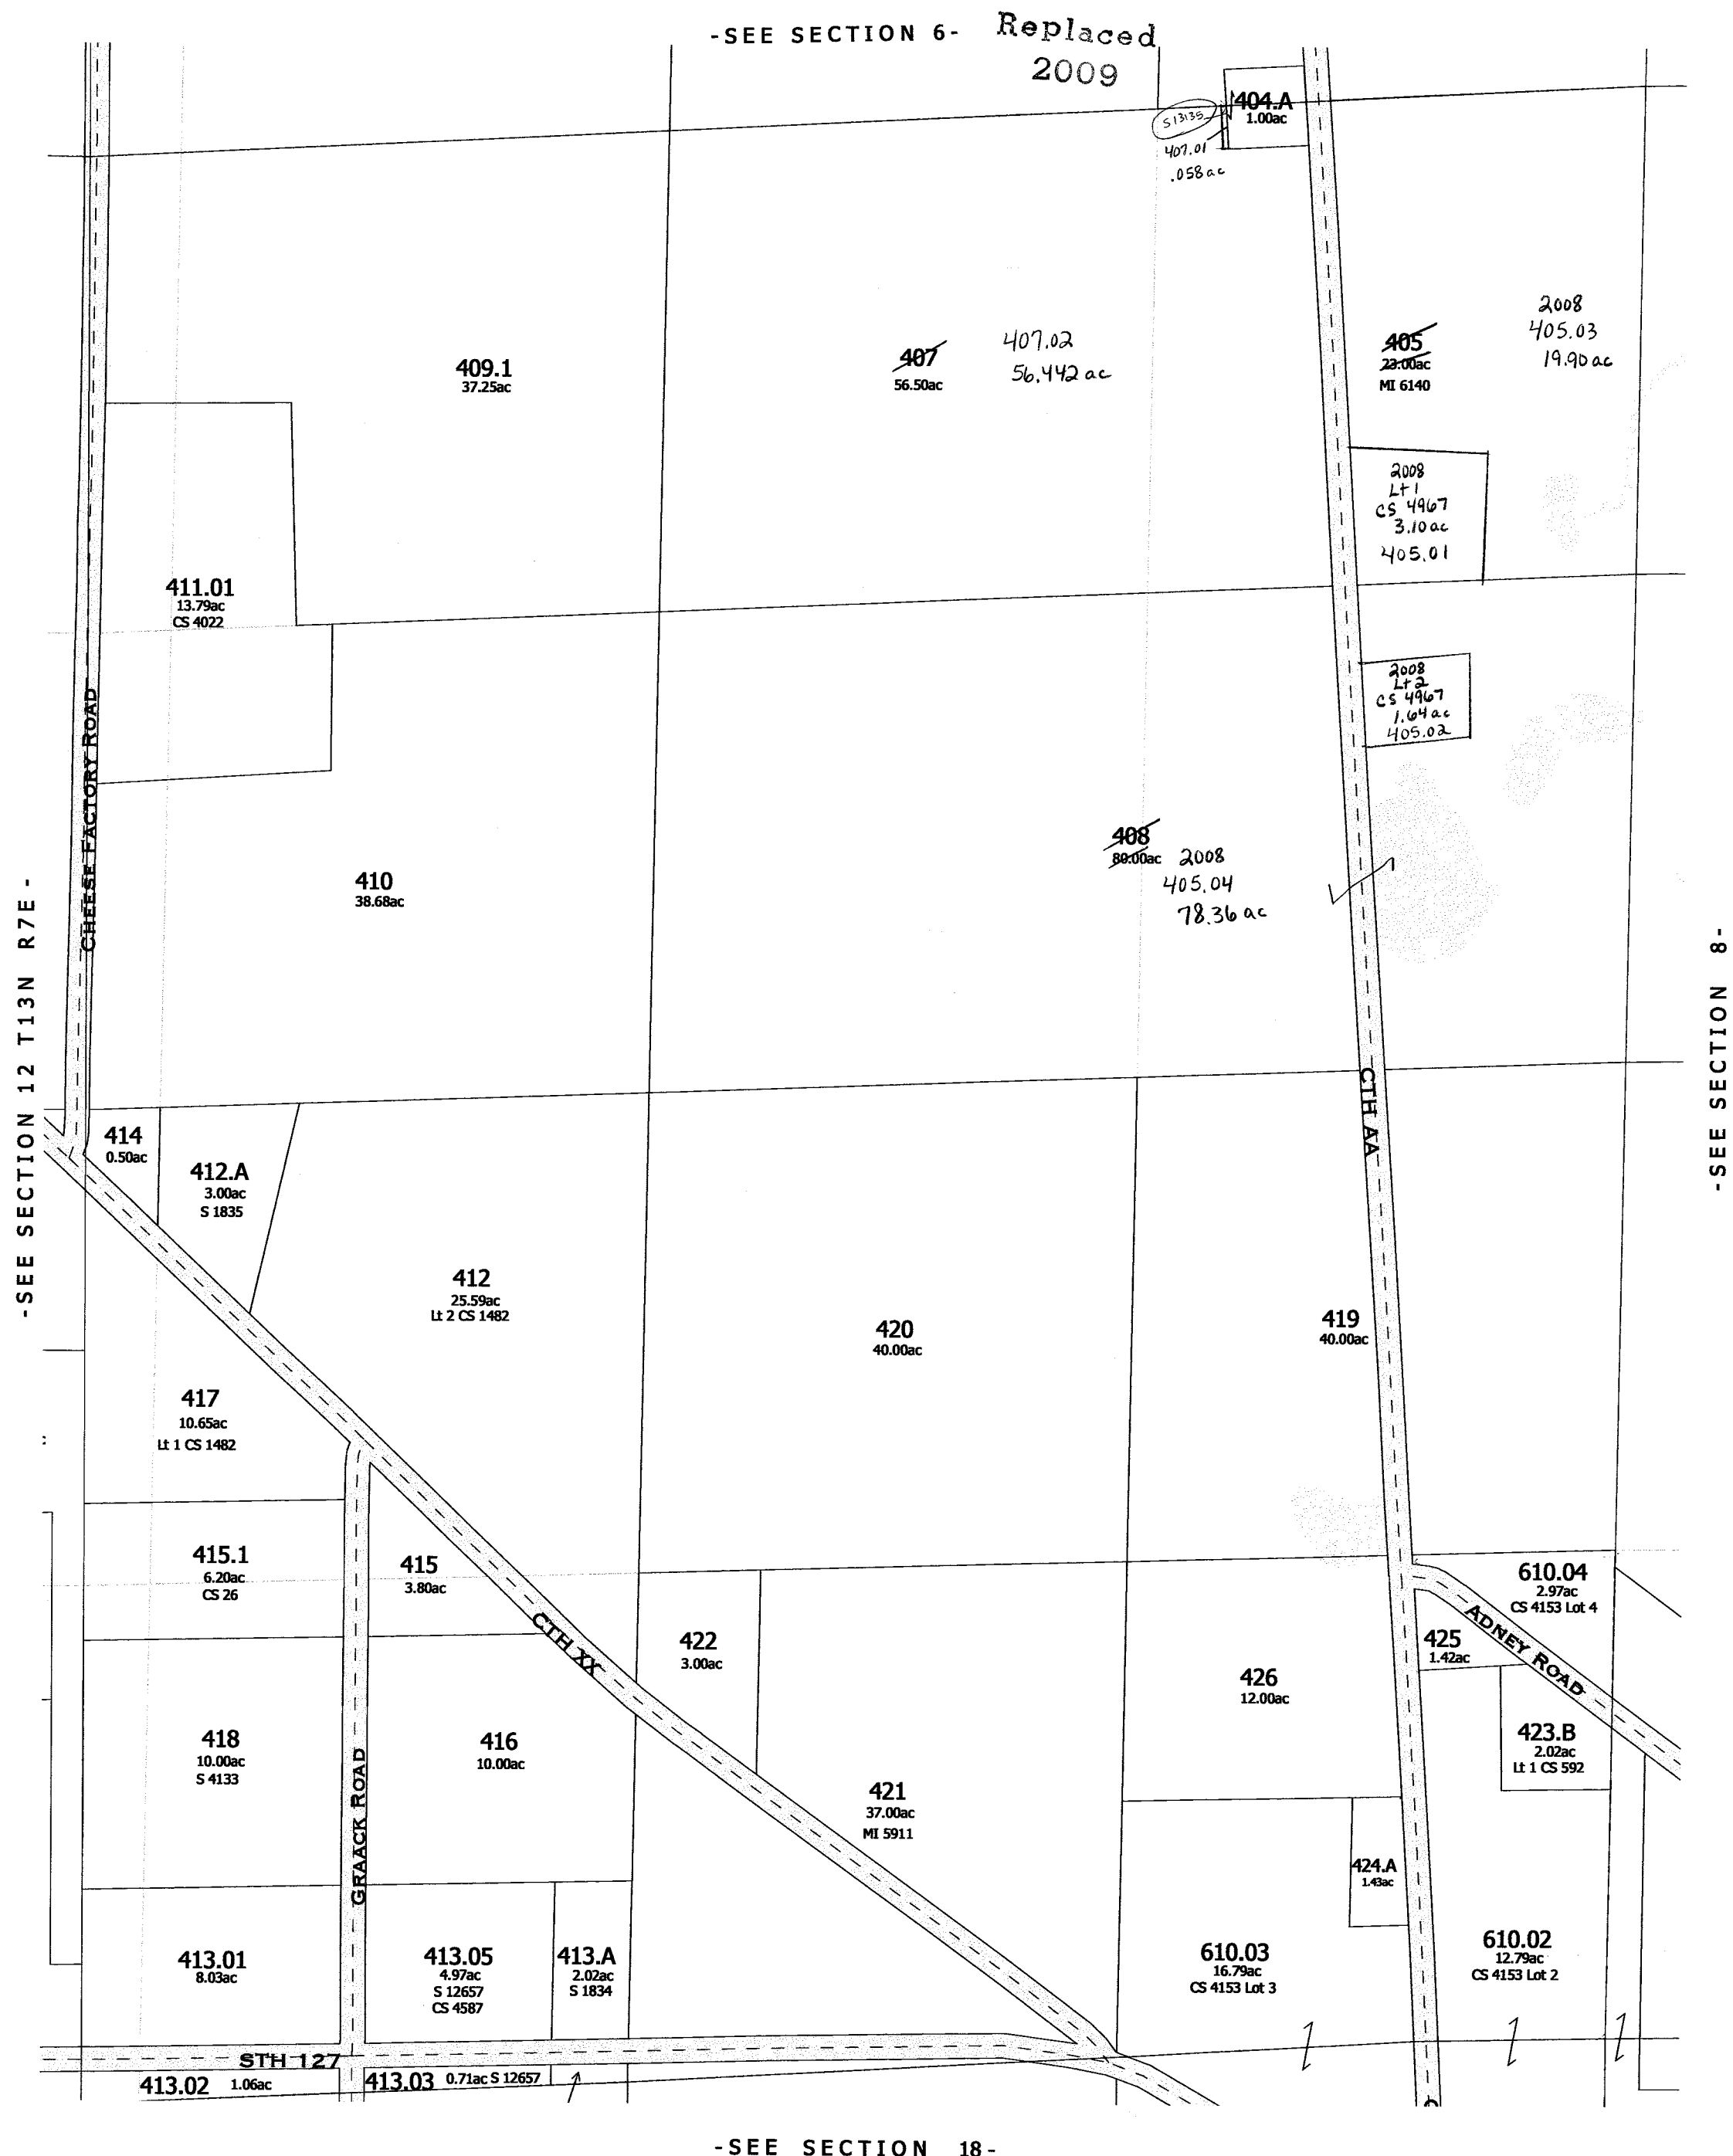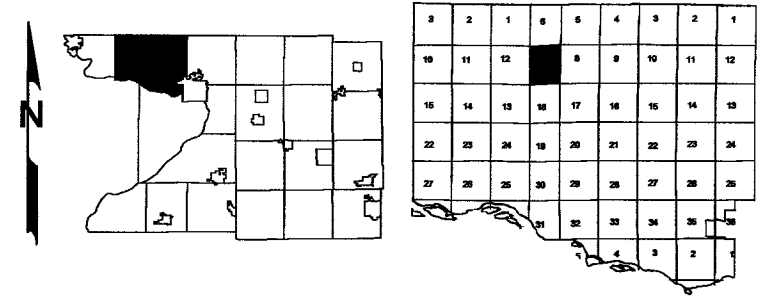

Also
2008

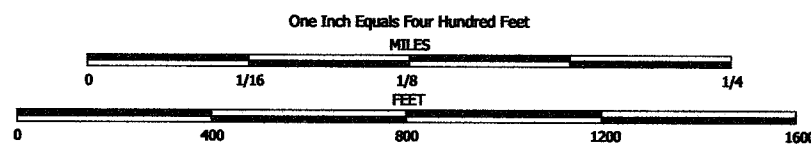




NOTE: This map was prepared for assessment use in accordance with the Wis. St. Stat. Chap. 70.09. All information contained herein is advisory only. Map accuracy is limited to the quality of data obtained from other Public Records. This map is not intended to be a substitute for an actual field survey. Public Land Survey Base is derived from U.S.G.S. Topographic maps unless otherwise noted. Other sources of the Land Base may be actual survey data. Base map data is from the April 1995 County Digital Orthophotos and/or U.S.G.S. 1:24,000 scale Topographic series. The user is responsible for the improper use of the data contained herein.


Created by The Columbia County Land Information Office -GIS Section- VMB.
February 2006.

TAX PARCEL MAP

TOWN of LEWISTON

TOWN 13 NORTH RANGE 8 EAST
COLUMBIA COUNTY, WISCONSIN

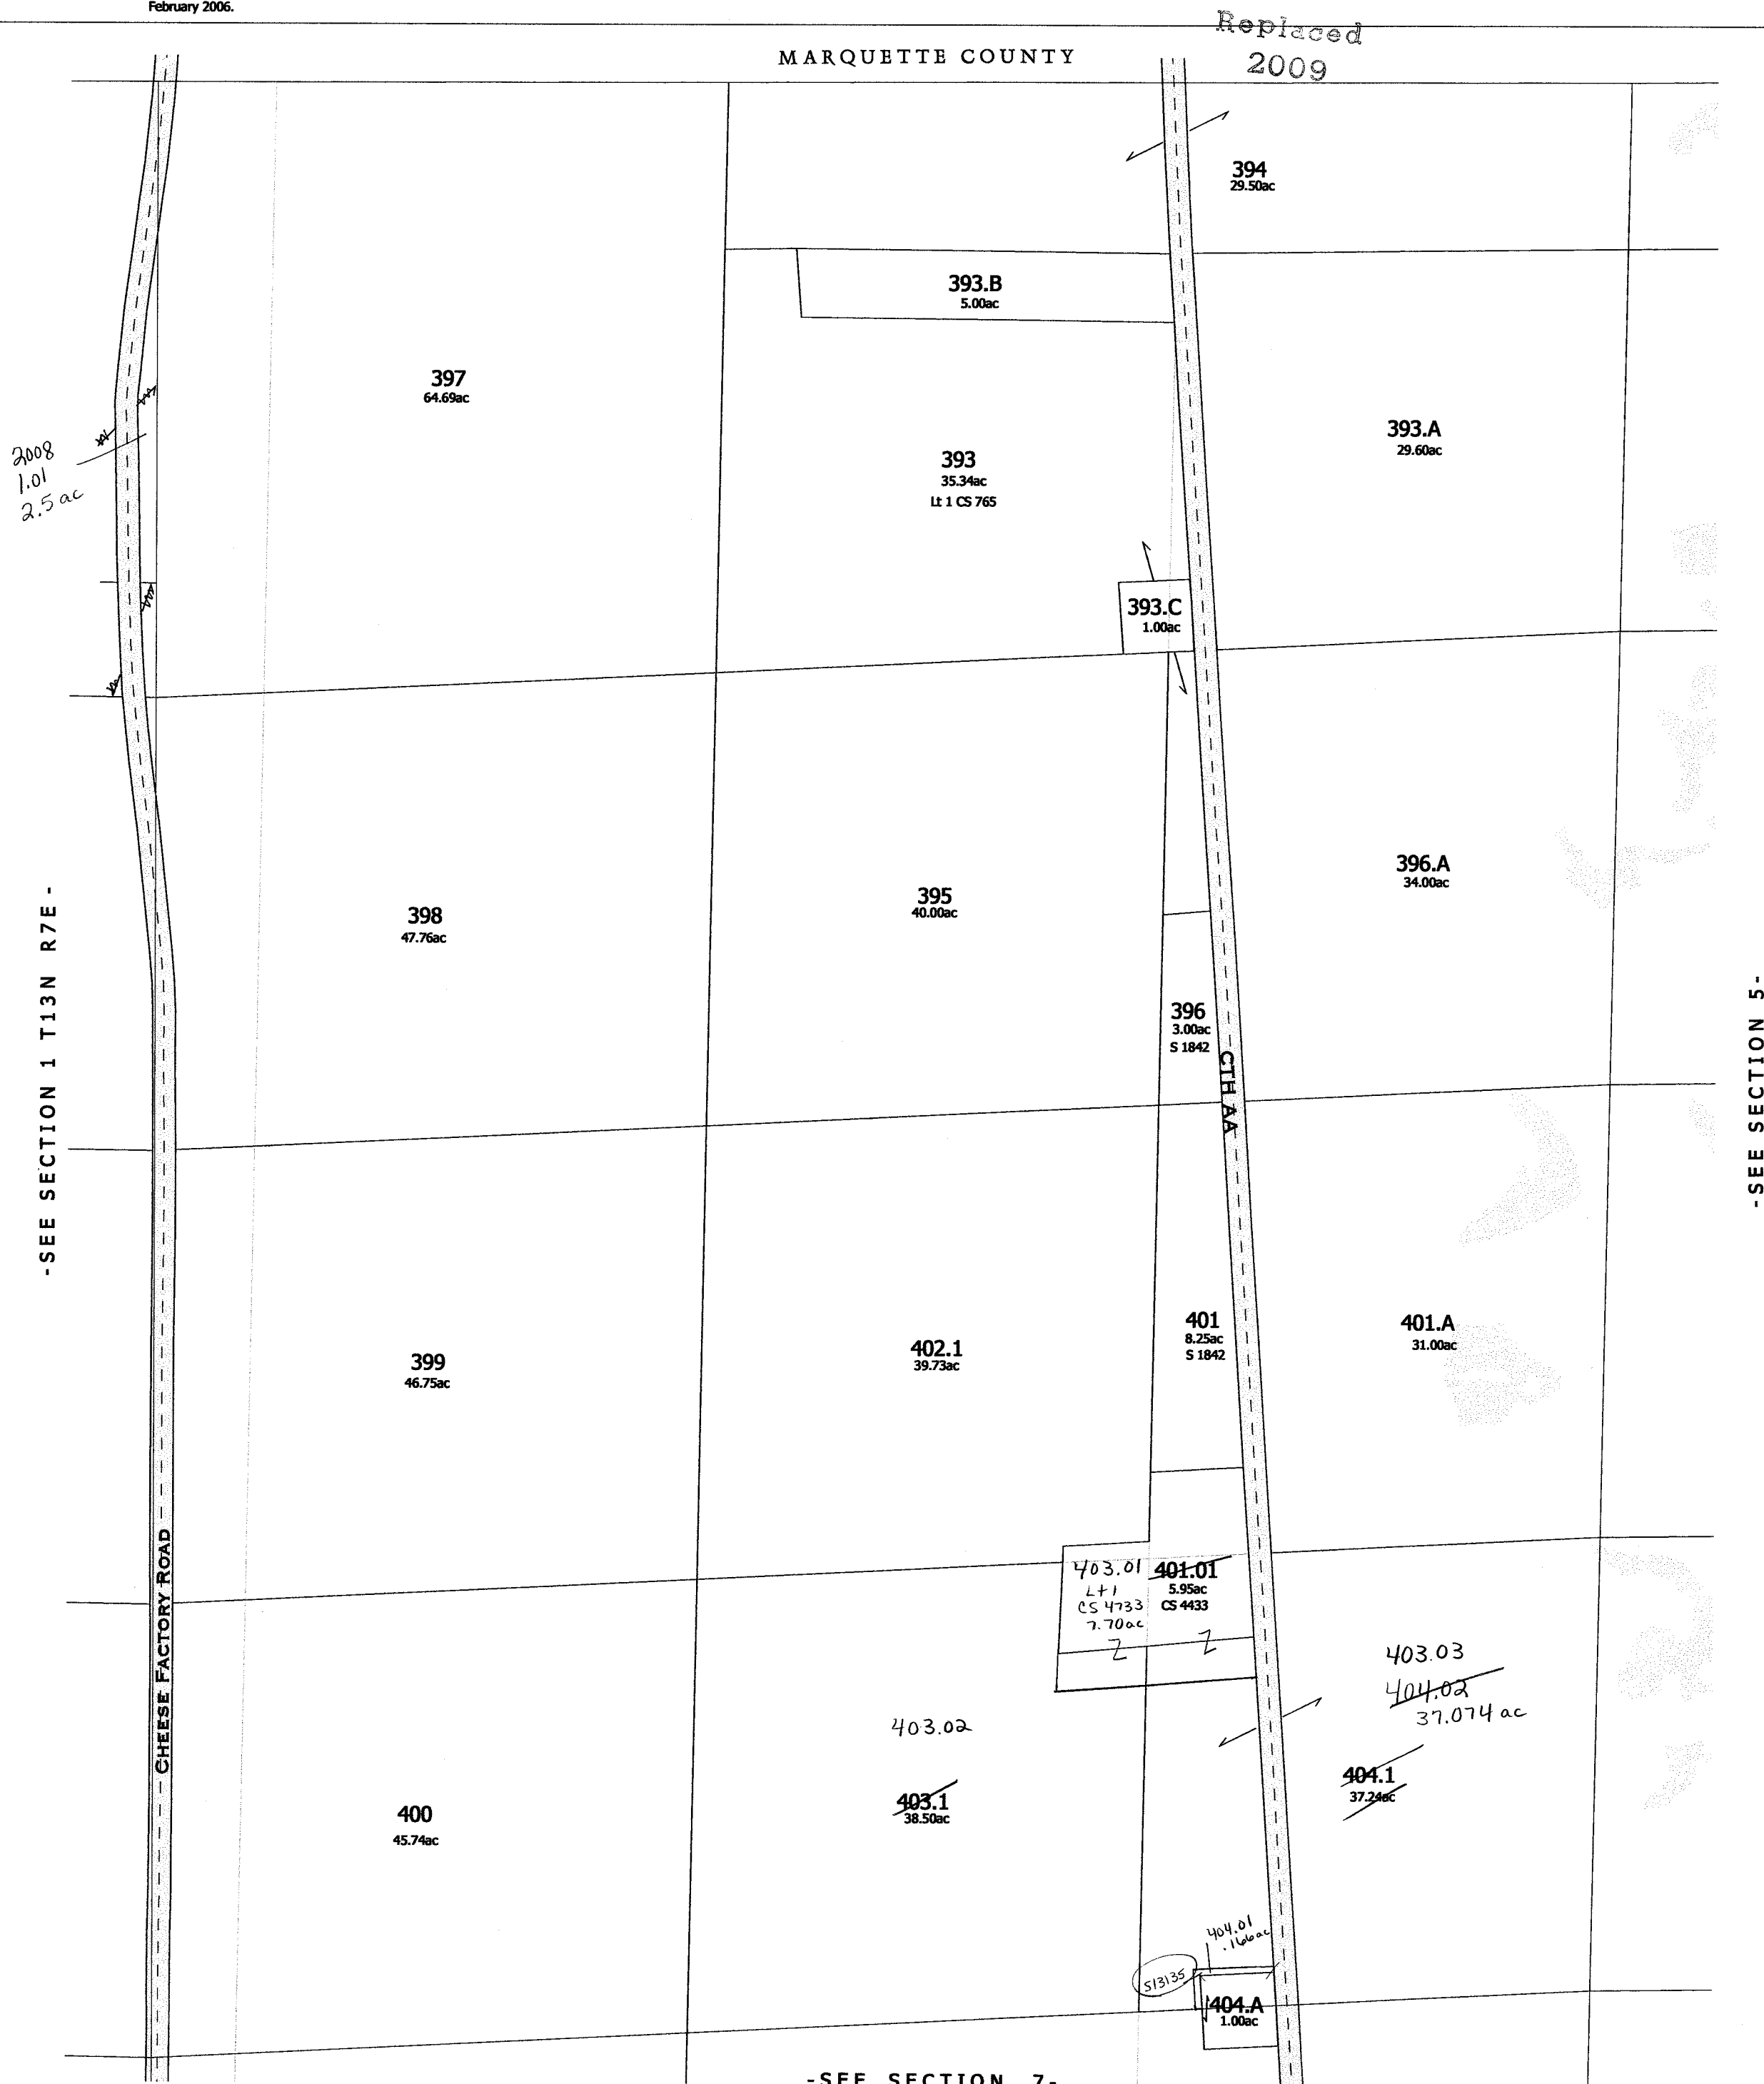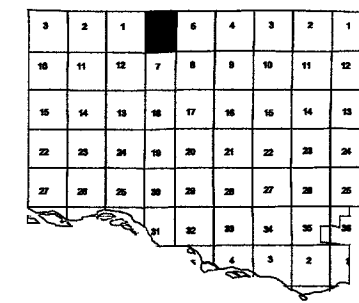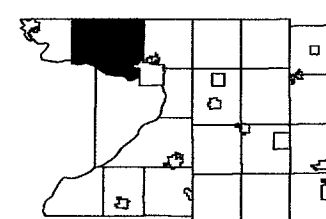


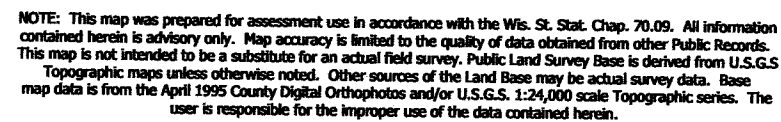

TAX PARCEL MAP

TOWN of LEWISTON


TOWN 13 NORTH RANGE 8 EAST
COLUMBIA COUNTY, WISCONSIN

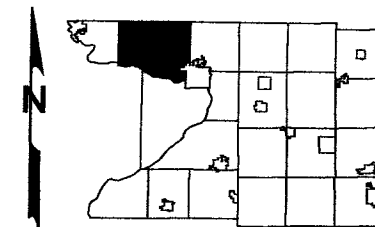

8	2	1	6		4	3	2	1
10	11	12	7	5	9	10	11	12
15	14	13	16	17	18	15	14	13
22	23	24	19	20	21	22	23	24
27	28	25	30	29	26	27	28	25
			31	32	33	34	35	36
					4	3	2	

Replaced
2009

MARQUETTE COUNTY

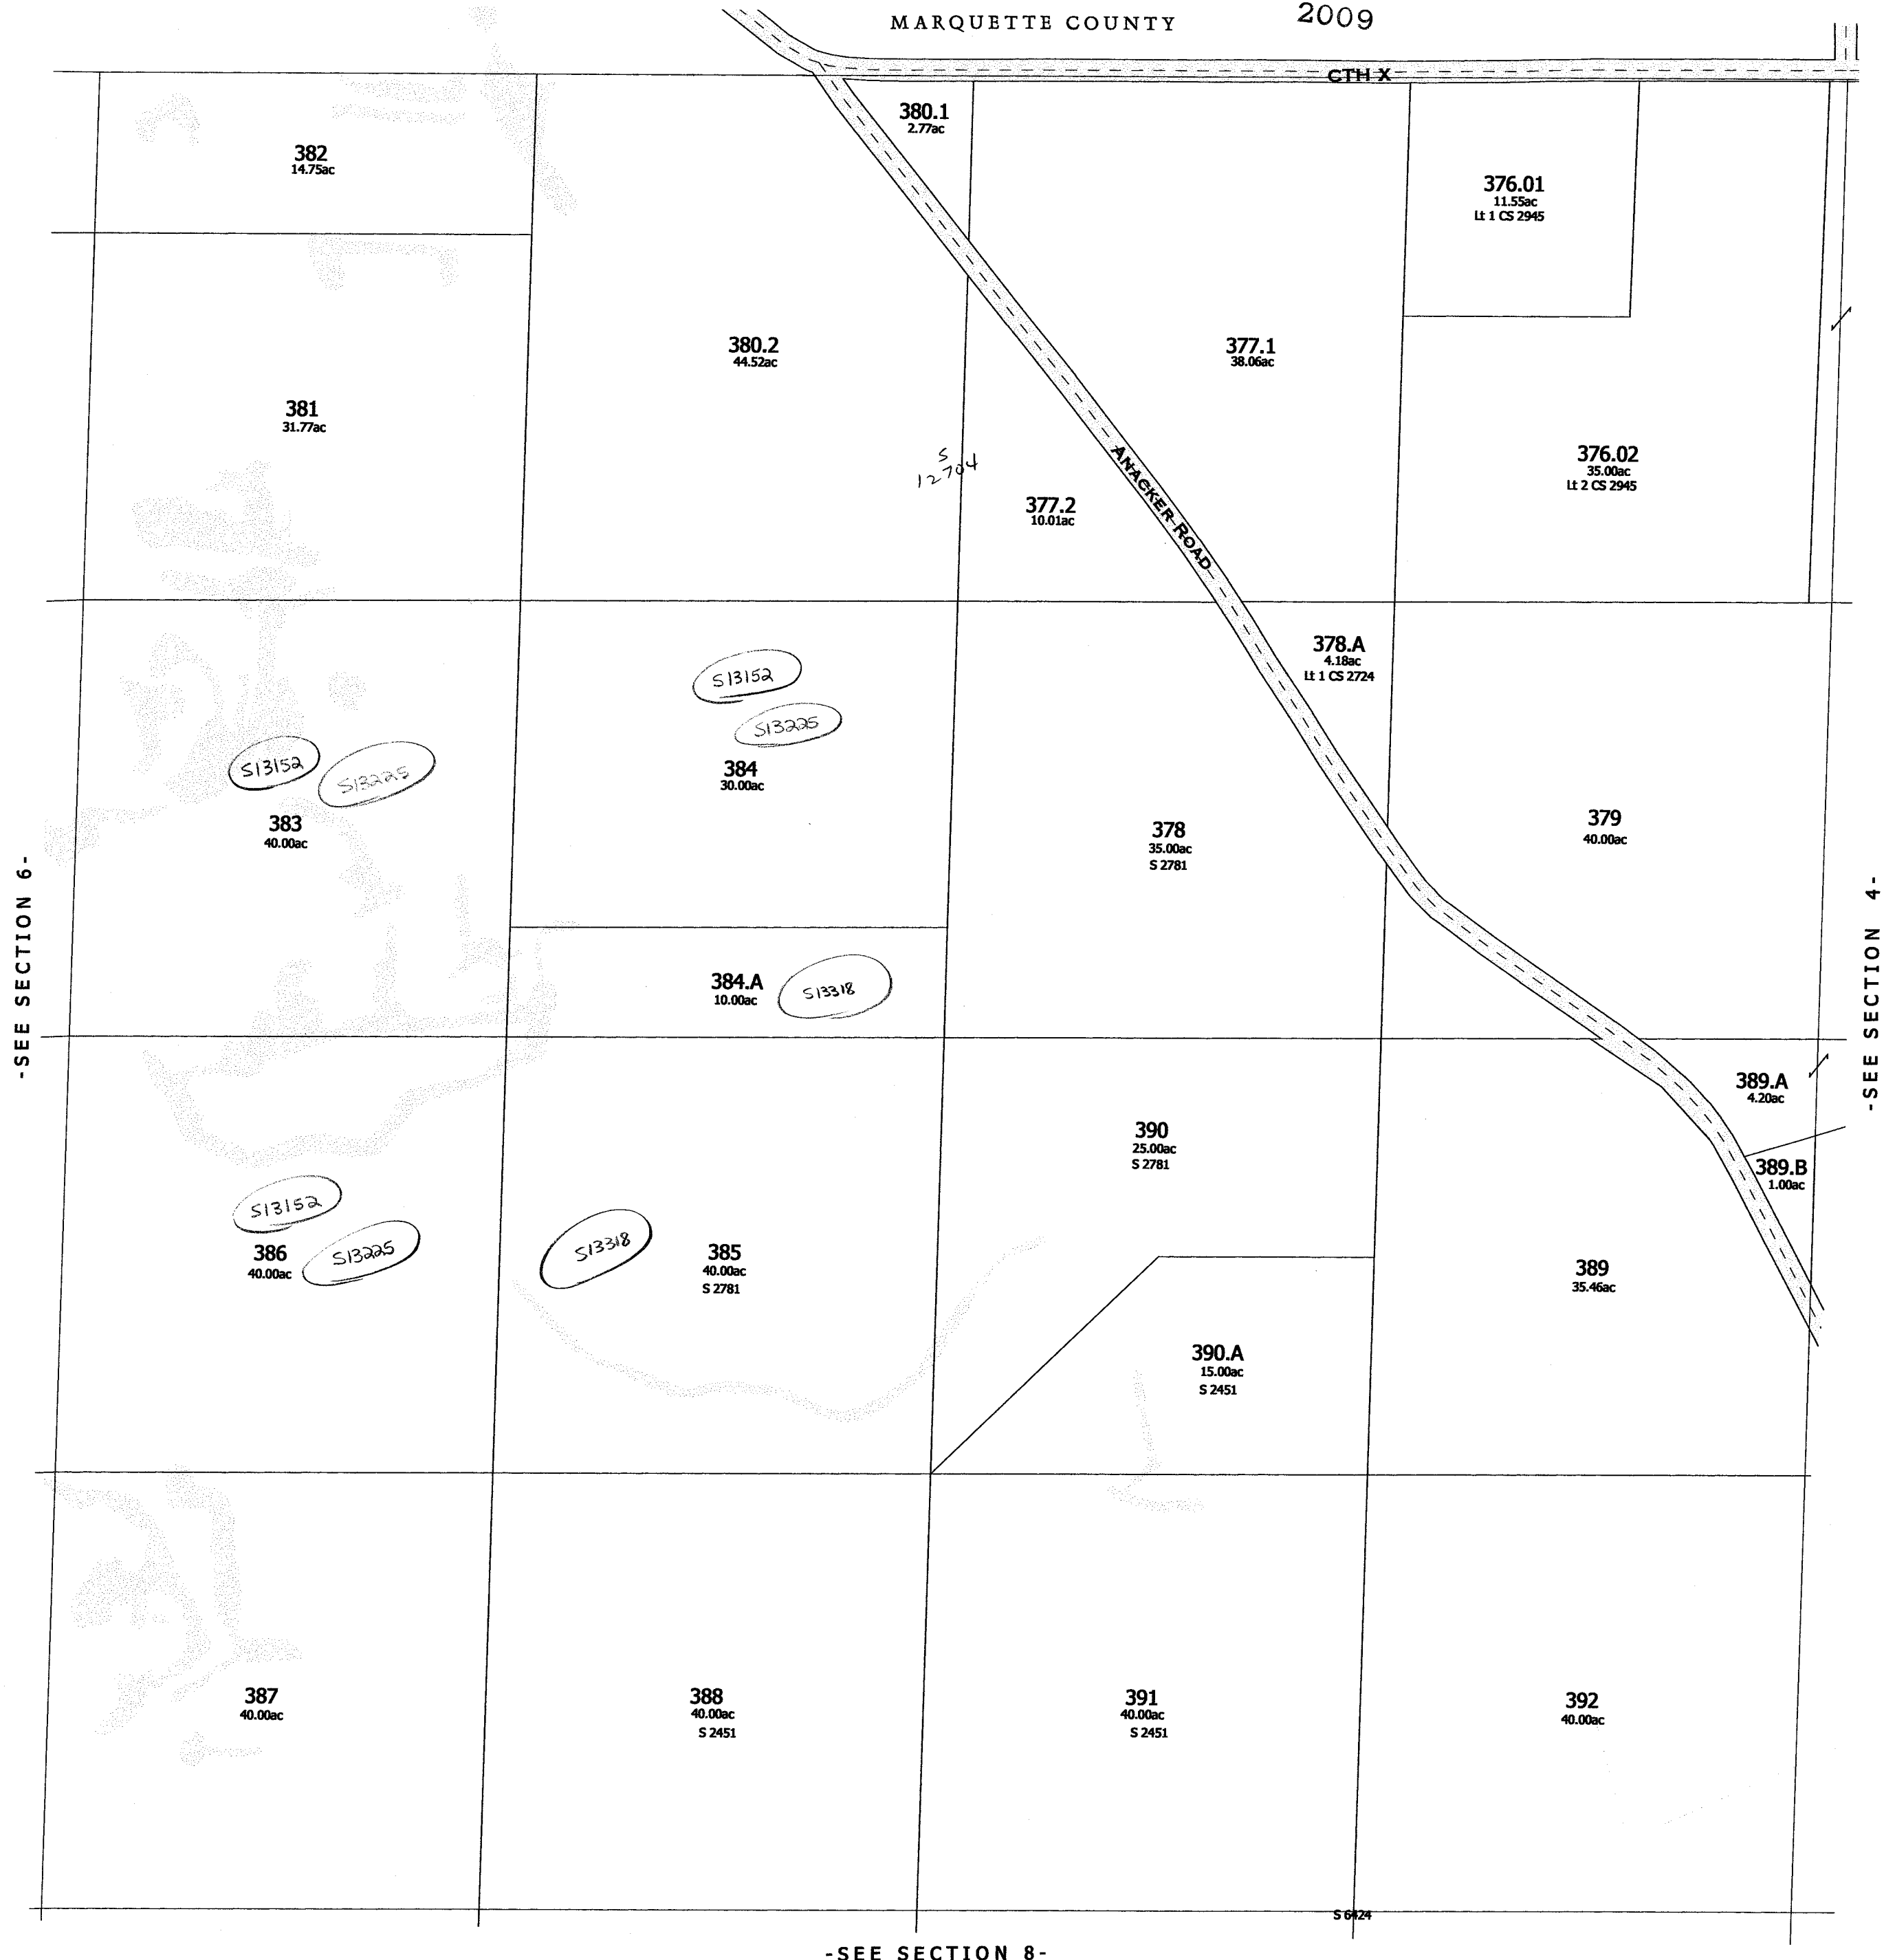

-SEE SECTION 8-

-SECTION 5-

1 inch = 200 feet

NOTE: This map was prepared for assessment use in accordance with the Wis. St. Stat. Chap. 70.09. All information contained herein is advisory only. Map accuracy is limited to the quality of data obtained from other Public Records. This map is not intended to be a substitute for an actual field survey. Public Land Survey Base is derived from U.S.G.S. Topographic maps unless otherwise noted. Other sources of the Land Base may be actual survey data. Base map data is from the April 1995 County Digital Orthophotos and/or U.S.G.S. 1:24,000 scale Topographic series. The user is responsible for the improper use of the data contained herein.


Created by The Columbia County Land Information Office -GIS Section. VMB.

September 2002.


TAX PARCEL MAP

TOWN of LEWISTON


TOWN 13 NORTH RANGE 8 EAST
COLUMBIA COUNTY, WISCONSIN

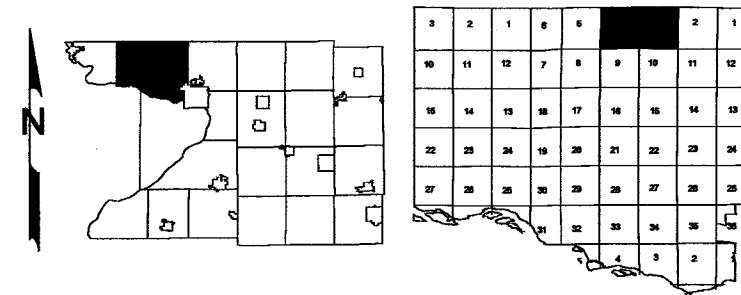

Replaced
2009

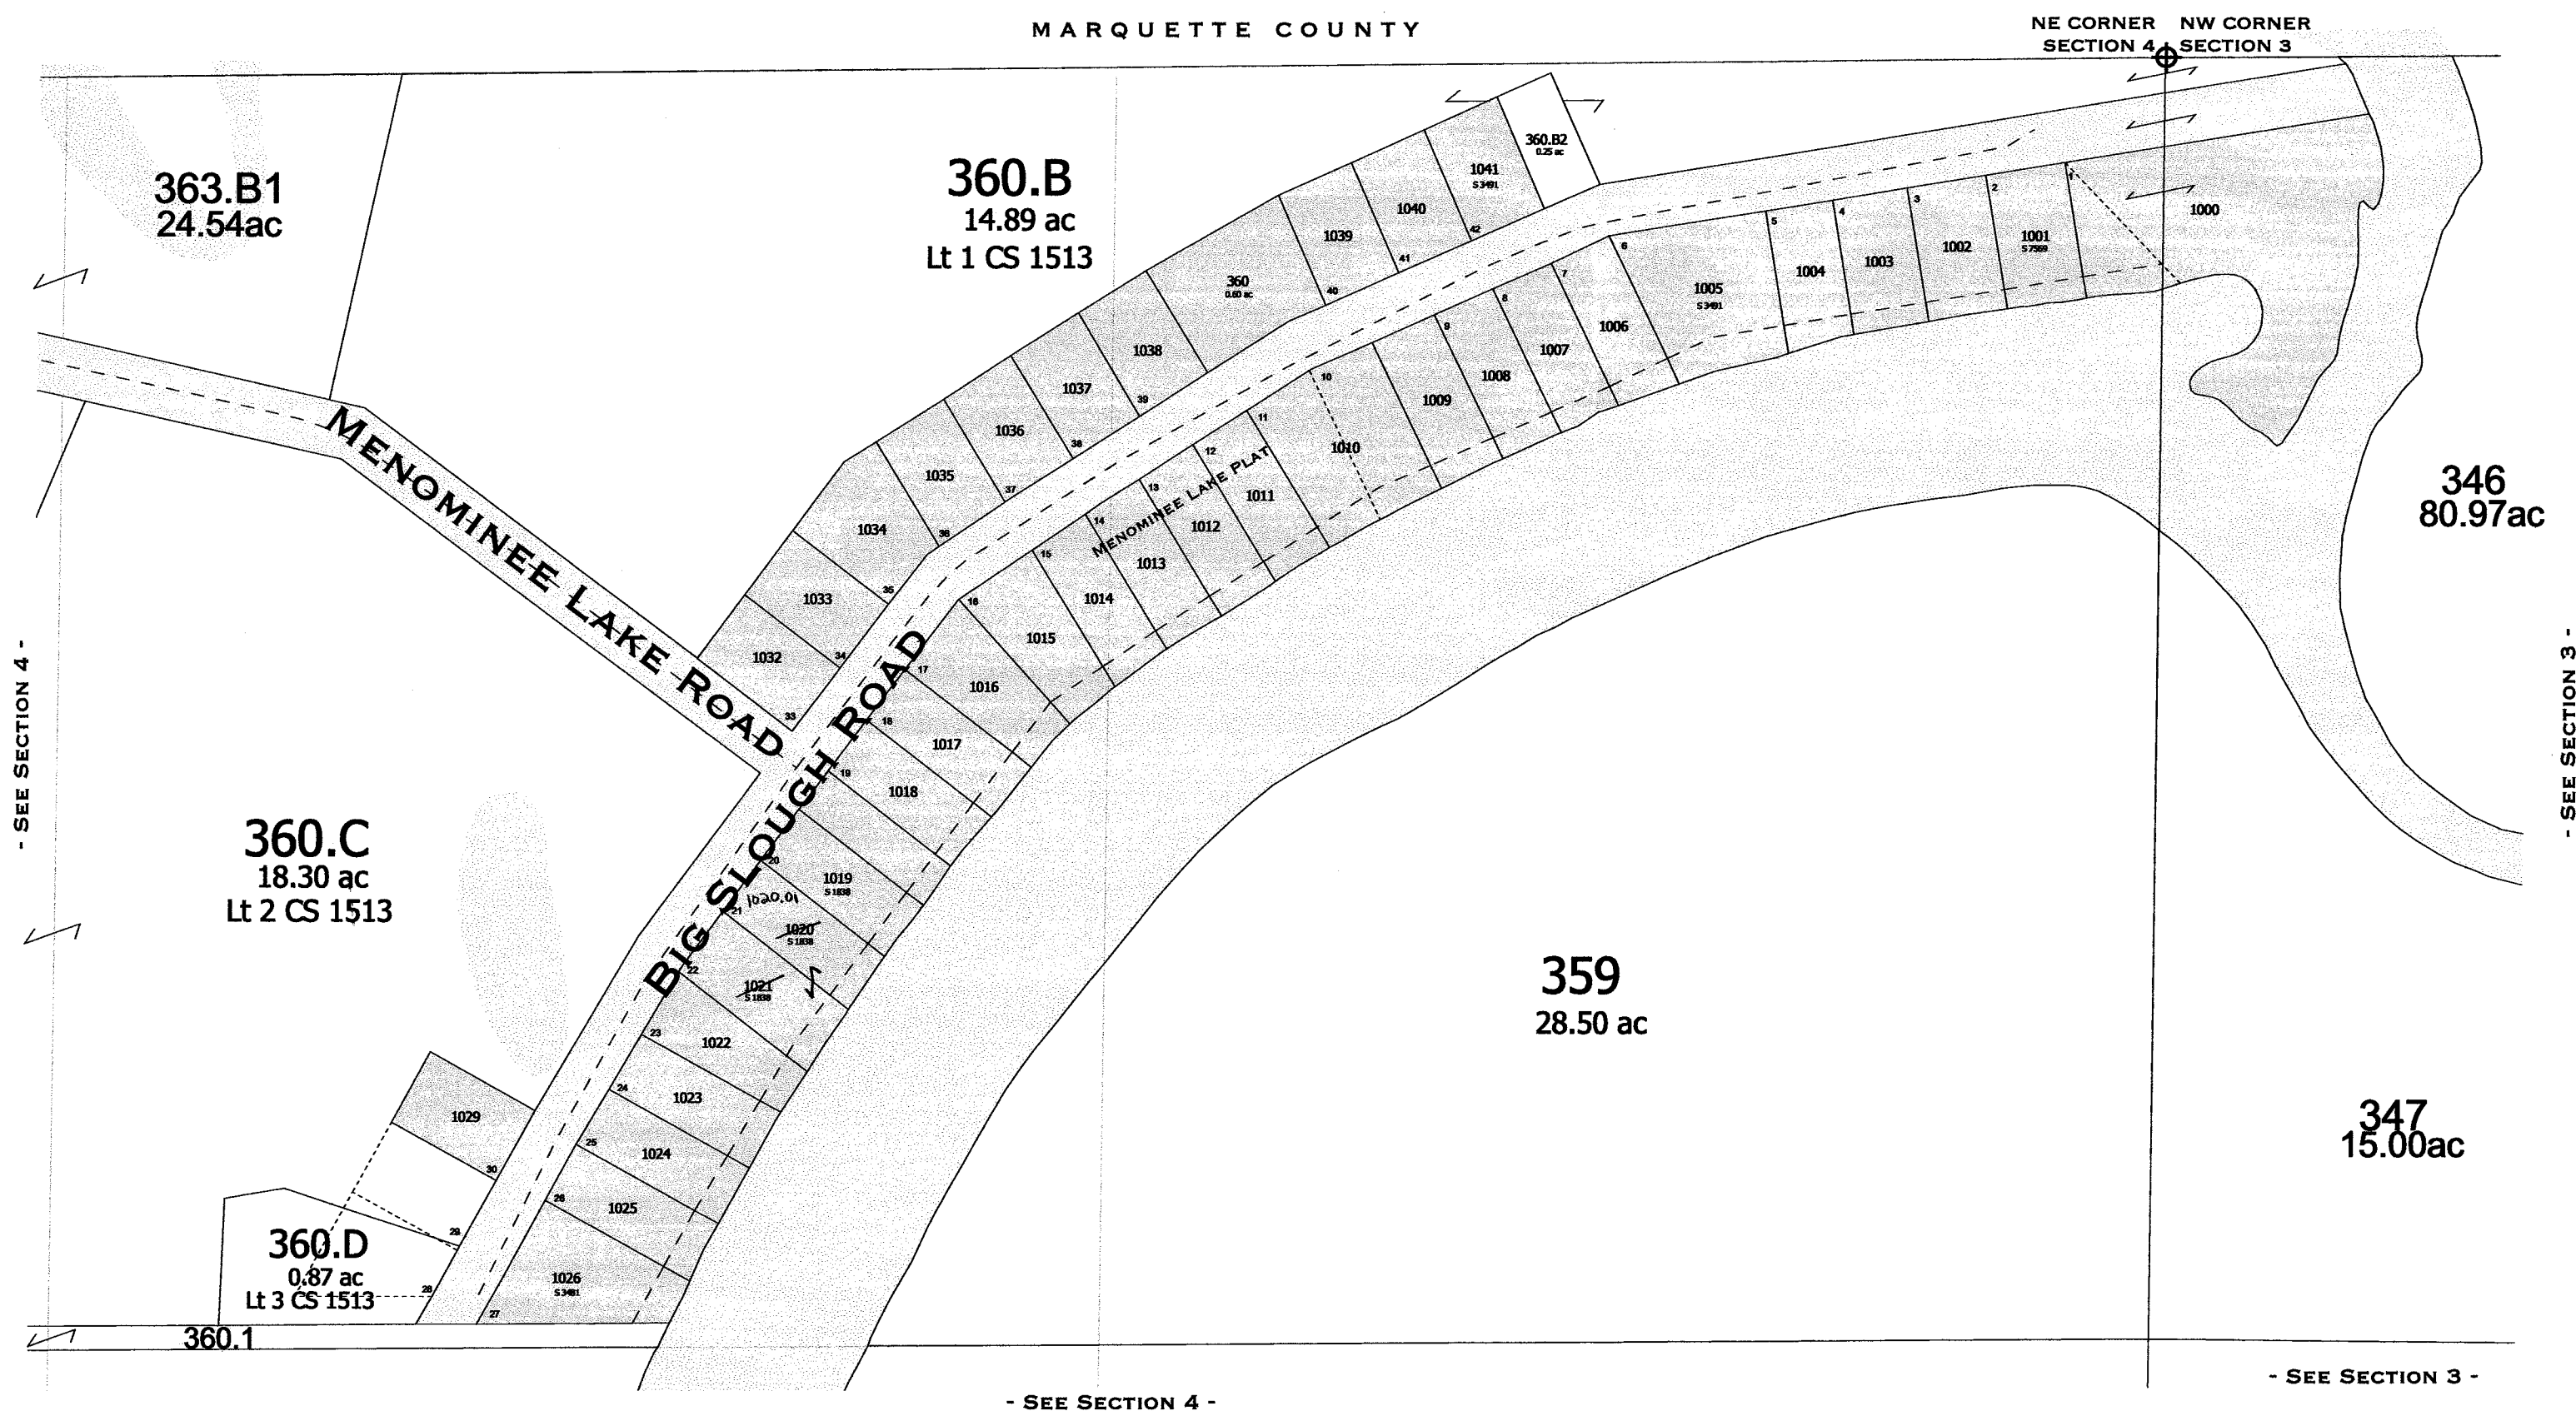

	Menominee Lake	S 3491
--	----------------	--------

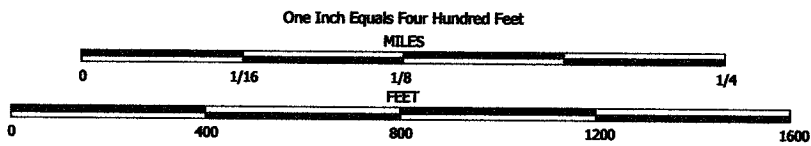


NOTE: This map was prepared for assessment use in accordance with the Wis. St. Stat. Chap. 70.09. All information contained herein is advisory only. Map accuracy is limited to the quality of data obtained from other Public Records. This map is not intended to be a substitute for an actual field survey. Public Land Survey Base is derived from U.S.G.S. Topographic maps unless otherwise noted. Other sources of the Land Base may be actual survey data. Base map data is from the April 1995 County Digital Orthophotos and/or U.S.G.S. 1:24,000 scale Topographic series. The user is responsible for the improper use of the data contained herein.

Created by The Columbia County Land Information Office -GIS Section- VMB.
February 2005.

TAX PARCEL MAP

TOWN of LEWISTON

TOWN 13 NORTH RANGE 8 EAST
COLUMBIA COUNTY, WISCONSIN

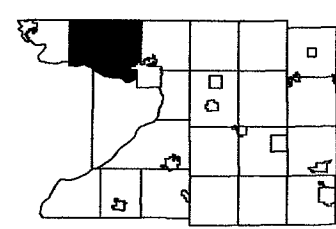

1	2	3	4	5	6	7	8	9	10	11	12
13	14	15	16	17	18	19	20	21	22	23	24
25	26	27	28	29	30	31	32	33	34	35	36
37	38	39	40	41	42	43	44	45	46	47	48

Replaced
2009

MARQUETTE COUNTY



-SEE SECTION 5-

-SEE SECTION 3-

-SEE SECTION 9-

-SEE THE FOLLOWING PAGE FOR DETAILED MAP OF SUBDIVISION-

-SECTION 4-

One Inch Equals Four Hundred Feet

MILES

0 1/16 1/8 1/4

FEET

0 400 800 1200 1600



NOTE: This map was prepared for assessment use in accordance with the Wis. St. Stat. Chap. 70.09. All information contained herein is advisory only. Map accuracy is limited to the quality of data obtained from other Public Records. This map is not intended to be a substitute for an actual field survey. Public Land Survey Base is derived from U.S.G.S Topographic maps unless otherwise noted. Other sources of the Land Base may be actual survey data. Base map data is from the April 1995 County Digital Orthophotos and/or U.S.G.S. 1:24,000 scale Topographic series. The user is responsible for the improper use of the data contained herein.

Created by The Columbia County Land Information Office -GIS Section. VMB.
February 2006.

TAX PARCEL MAP

TOWN of LEWISTON

TOWN 13 NORTH RANGE 8 EAST
COLUMBIA COUNTY, WISCONSIN

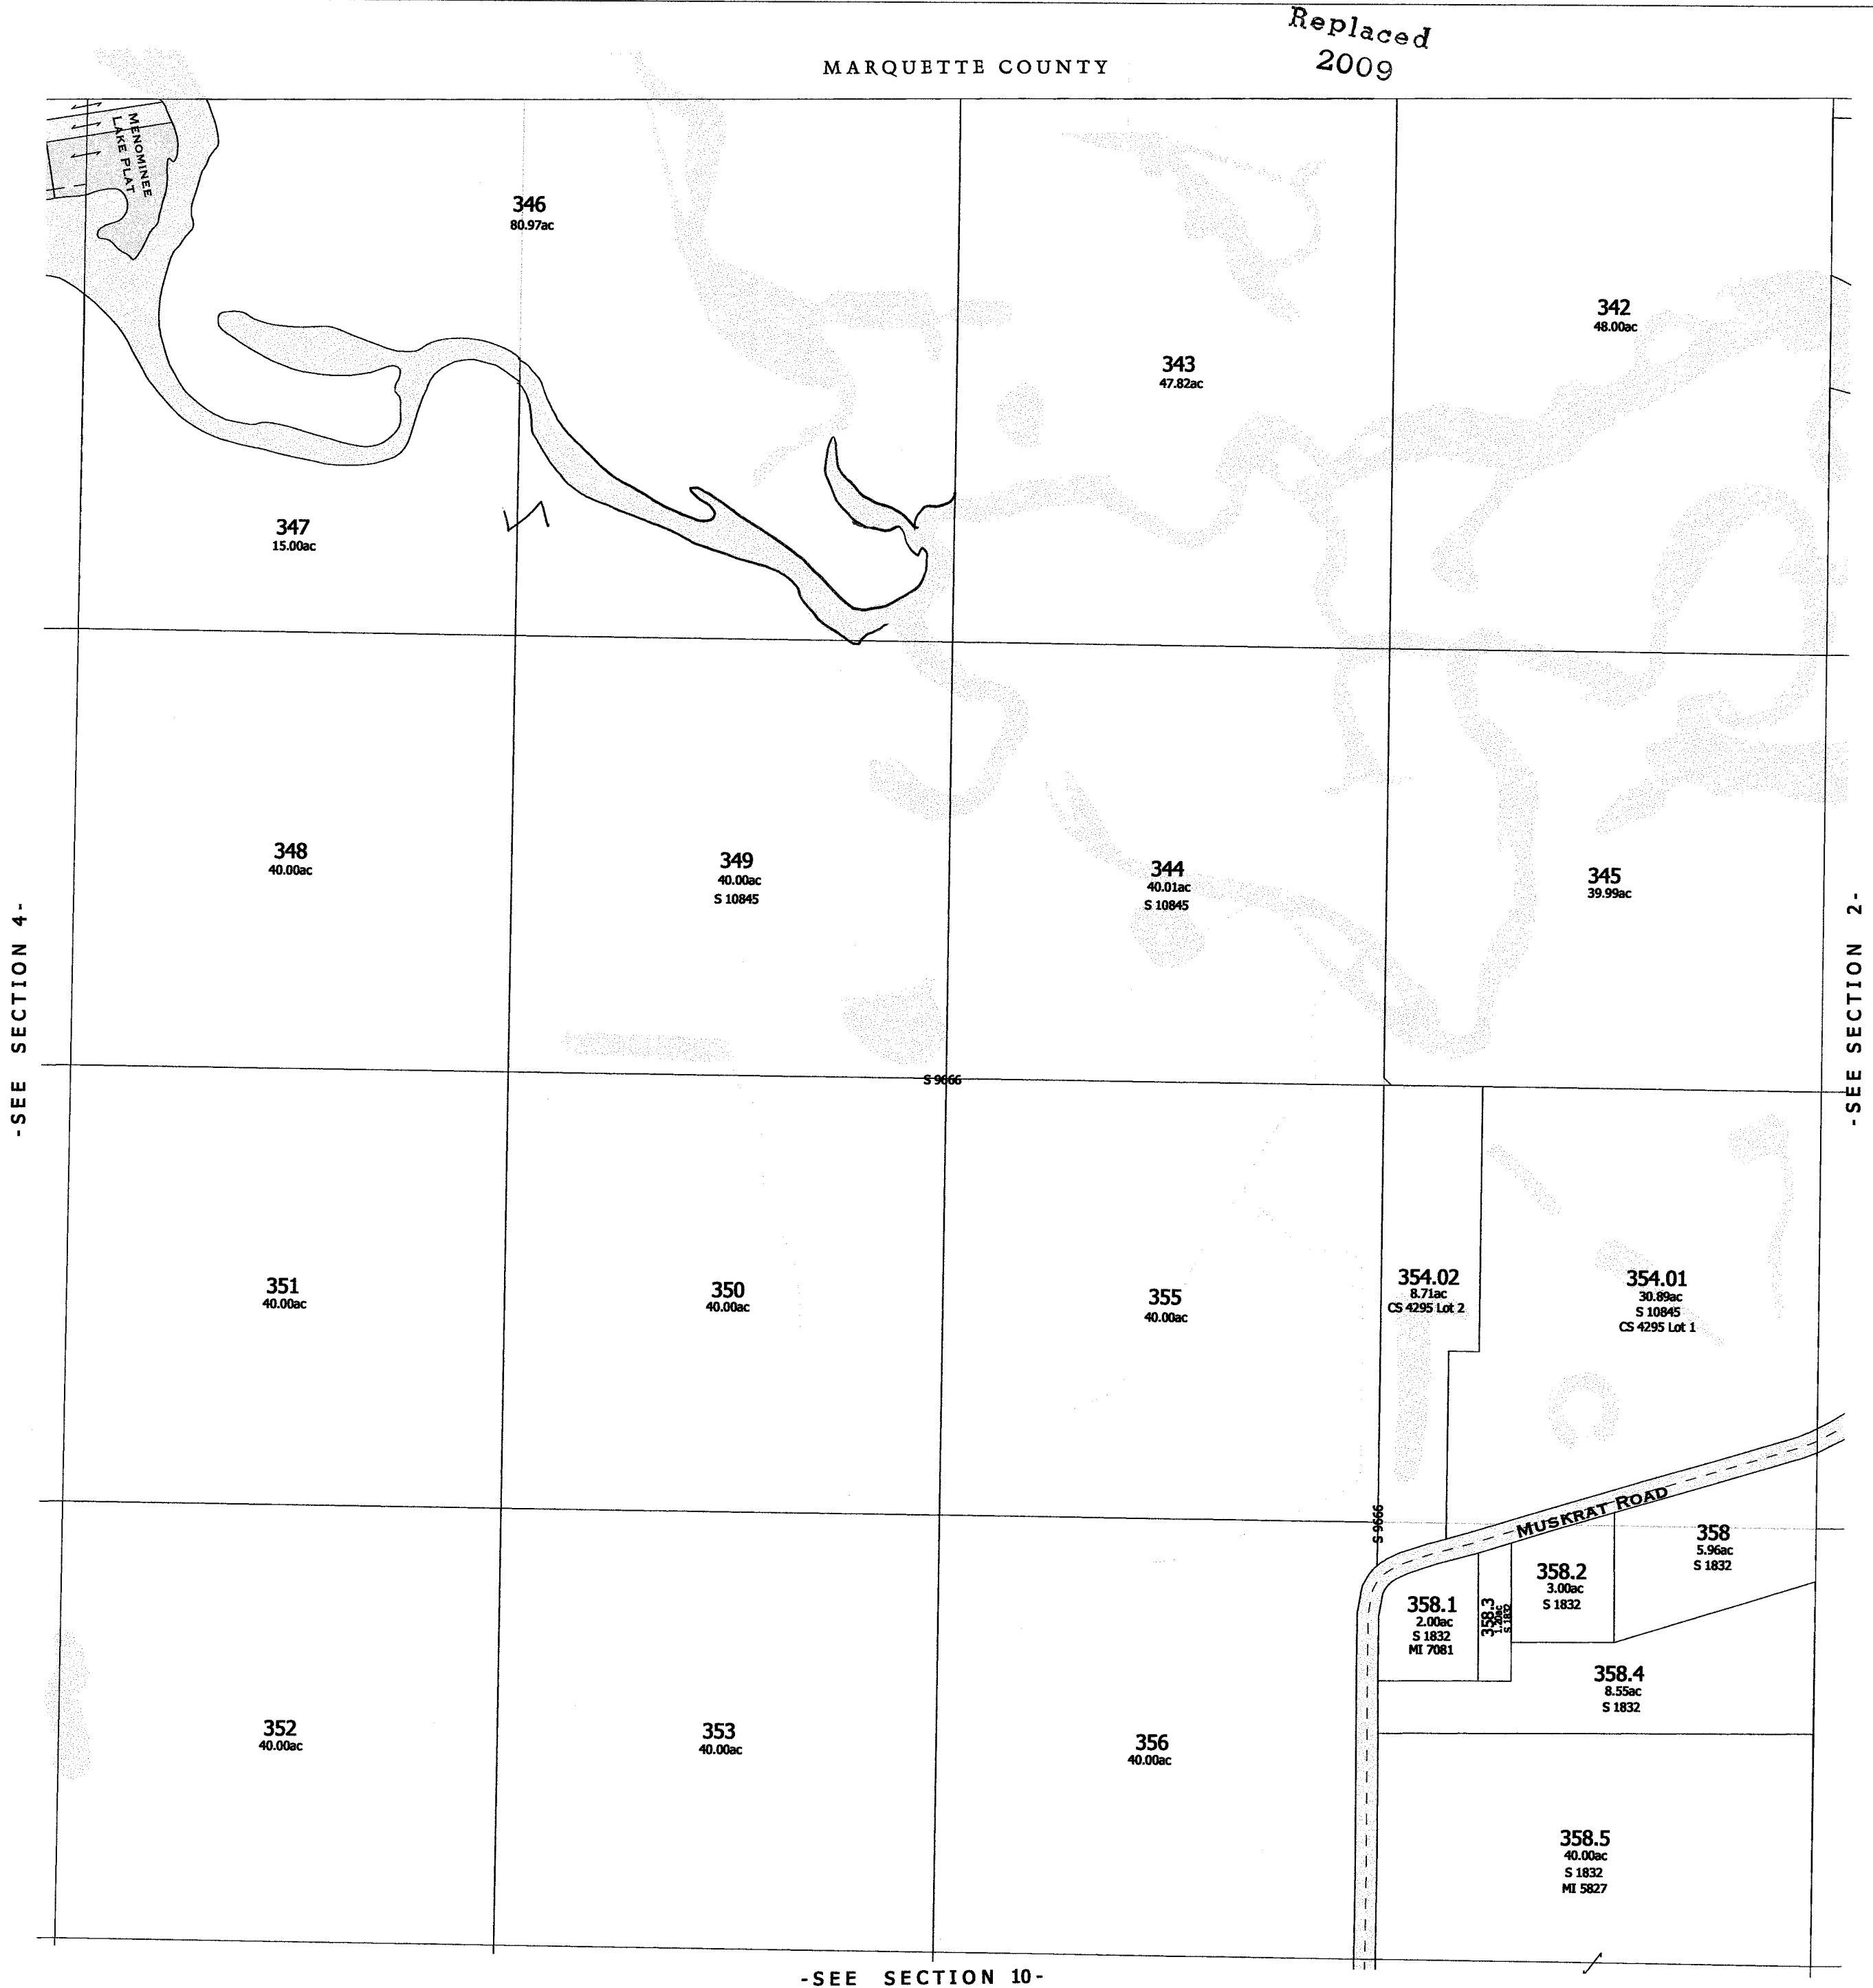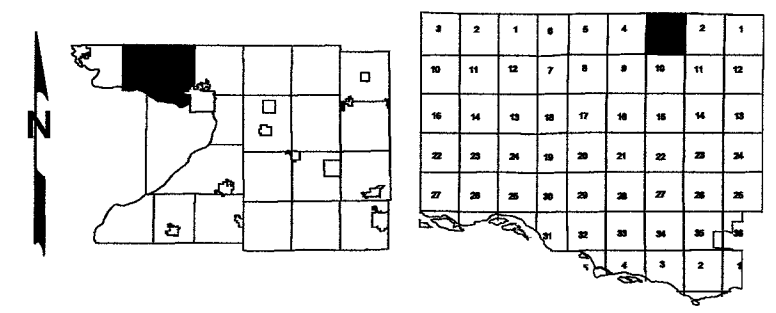

-SEE SECTION 4-

-SEE SECTION 2-

-SEE SECTION 10-

- SEE THE FOLLOWING PAGES FOR DETAILED MAP OF SUBDIVISION -

-SECTION 3-

One Inch Equals Four Hundred Feet

MILES

0 1/16 1/8 1/4

FEET

0 400 800 1200 1600


NOTE: This map was prepared for assessment use in accordance with the Wis. St. Stat. Chap. 70.09. All information contained herein is advisory only. Map accuracy is limited to the quality of data obtained from other Public Records. This map is not intended to be a substitute for an actual field survey. Public Land Survey Base is derived from U.S.G.S. Topographic maps unless otherwise noted. Other sources of the Land Base may be actual survey data. Base map data is from the April 1995 County Digital Orthophotos and/or U.S.G.S. 1:24,000 scale Topographic series. The user is responsible for the improper use of the data contained herein.

Created by The Columbia County Land Information Office -GIS Section. VMB.
February 2005.

TAX PARCEL MAP

TOWN of LEWISTON

TOWN 13 NORTH RANGE 8 EAST
COLUMBIA COUNTY, WISCONSIN

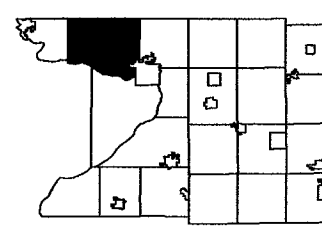

1	2	3	4	5	6	7	8	9	10	11	12
13	14	15	16	17	18	19	20	21	22	23	24
25	26	27	28	29	30	31	32	33	34	35	36
37	38	39	40	41	42	43	44	45	46	47	48


Replaced
2009




One Inch Equals Four Hundred Feet
MILES
0 1/16 1/8 1/4
0 400 800 1200 1600
FET
NOTE: This map was prepared for assessment use in accordance with the Wis. St. Stat. Chap. 70.09. All information contained herein is advisory only. Map accuracy is limited to the quality of data obtained from other Public Records. This map is not intended to be a substitute for an actual field survey. Public Land Survey Base is derived from U.S.G.S. Topographic maps unless otherwise noted. Other sources of the Land Base may be actual survey data. Base map data is from the April 1995 County Digital Orthophotos and/or U.S.G.S. 1:24,000 scale Topographic series. The user is responsible for the improper use of the data contained herein.
Created by The Columbia County Land Information Office -GIS Section, VMB.
March 2004.

TAX PARCEL MAP
TOWN of LEWISTON

TOWN 13 NORTH RANGE 8 EAST
COLUMBIA COUNTY, WISCONSIN

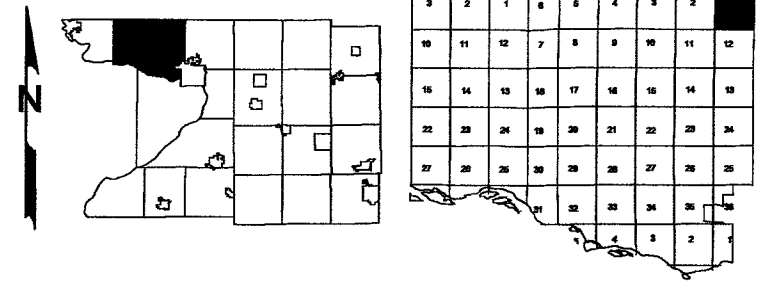


Replaced
2009

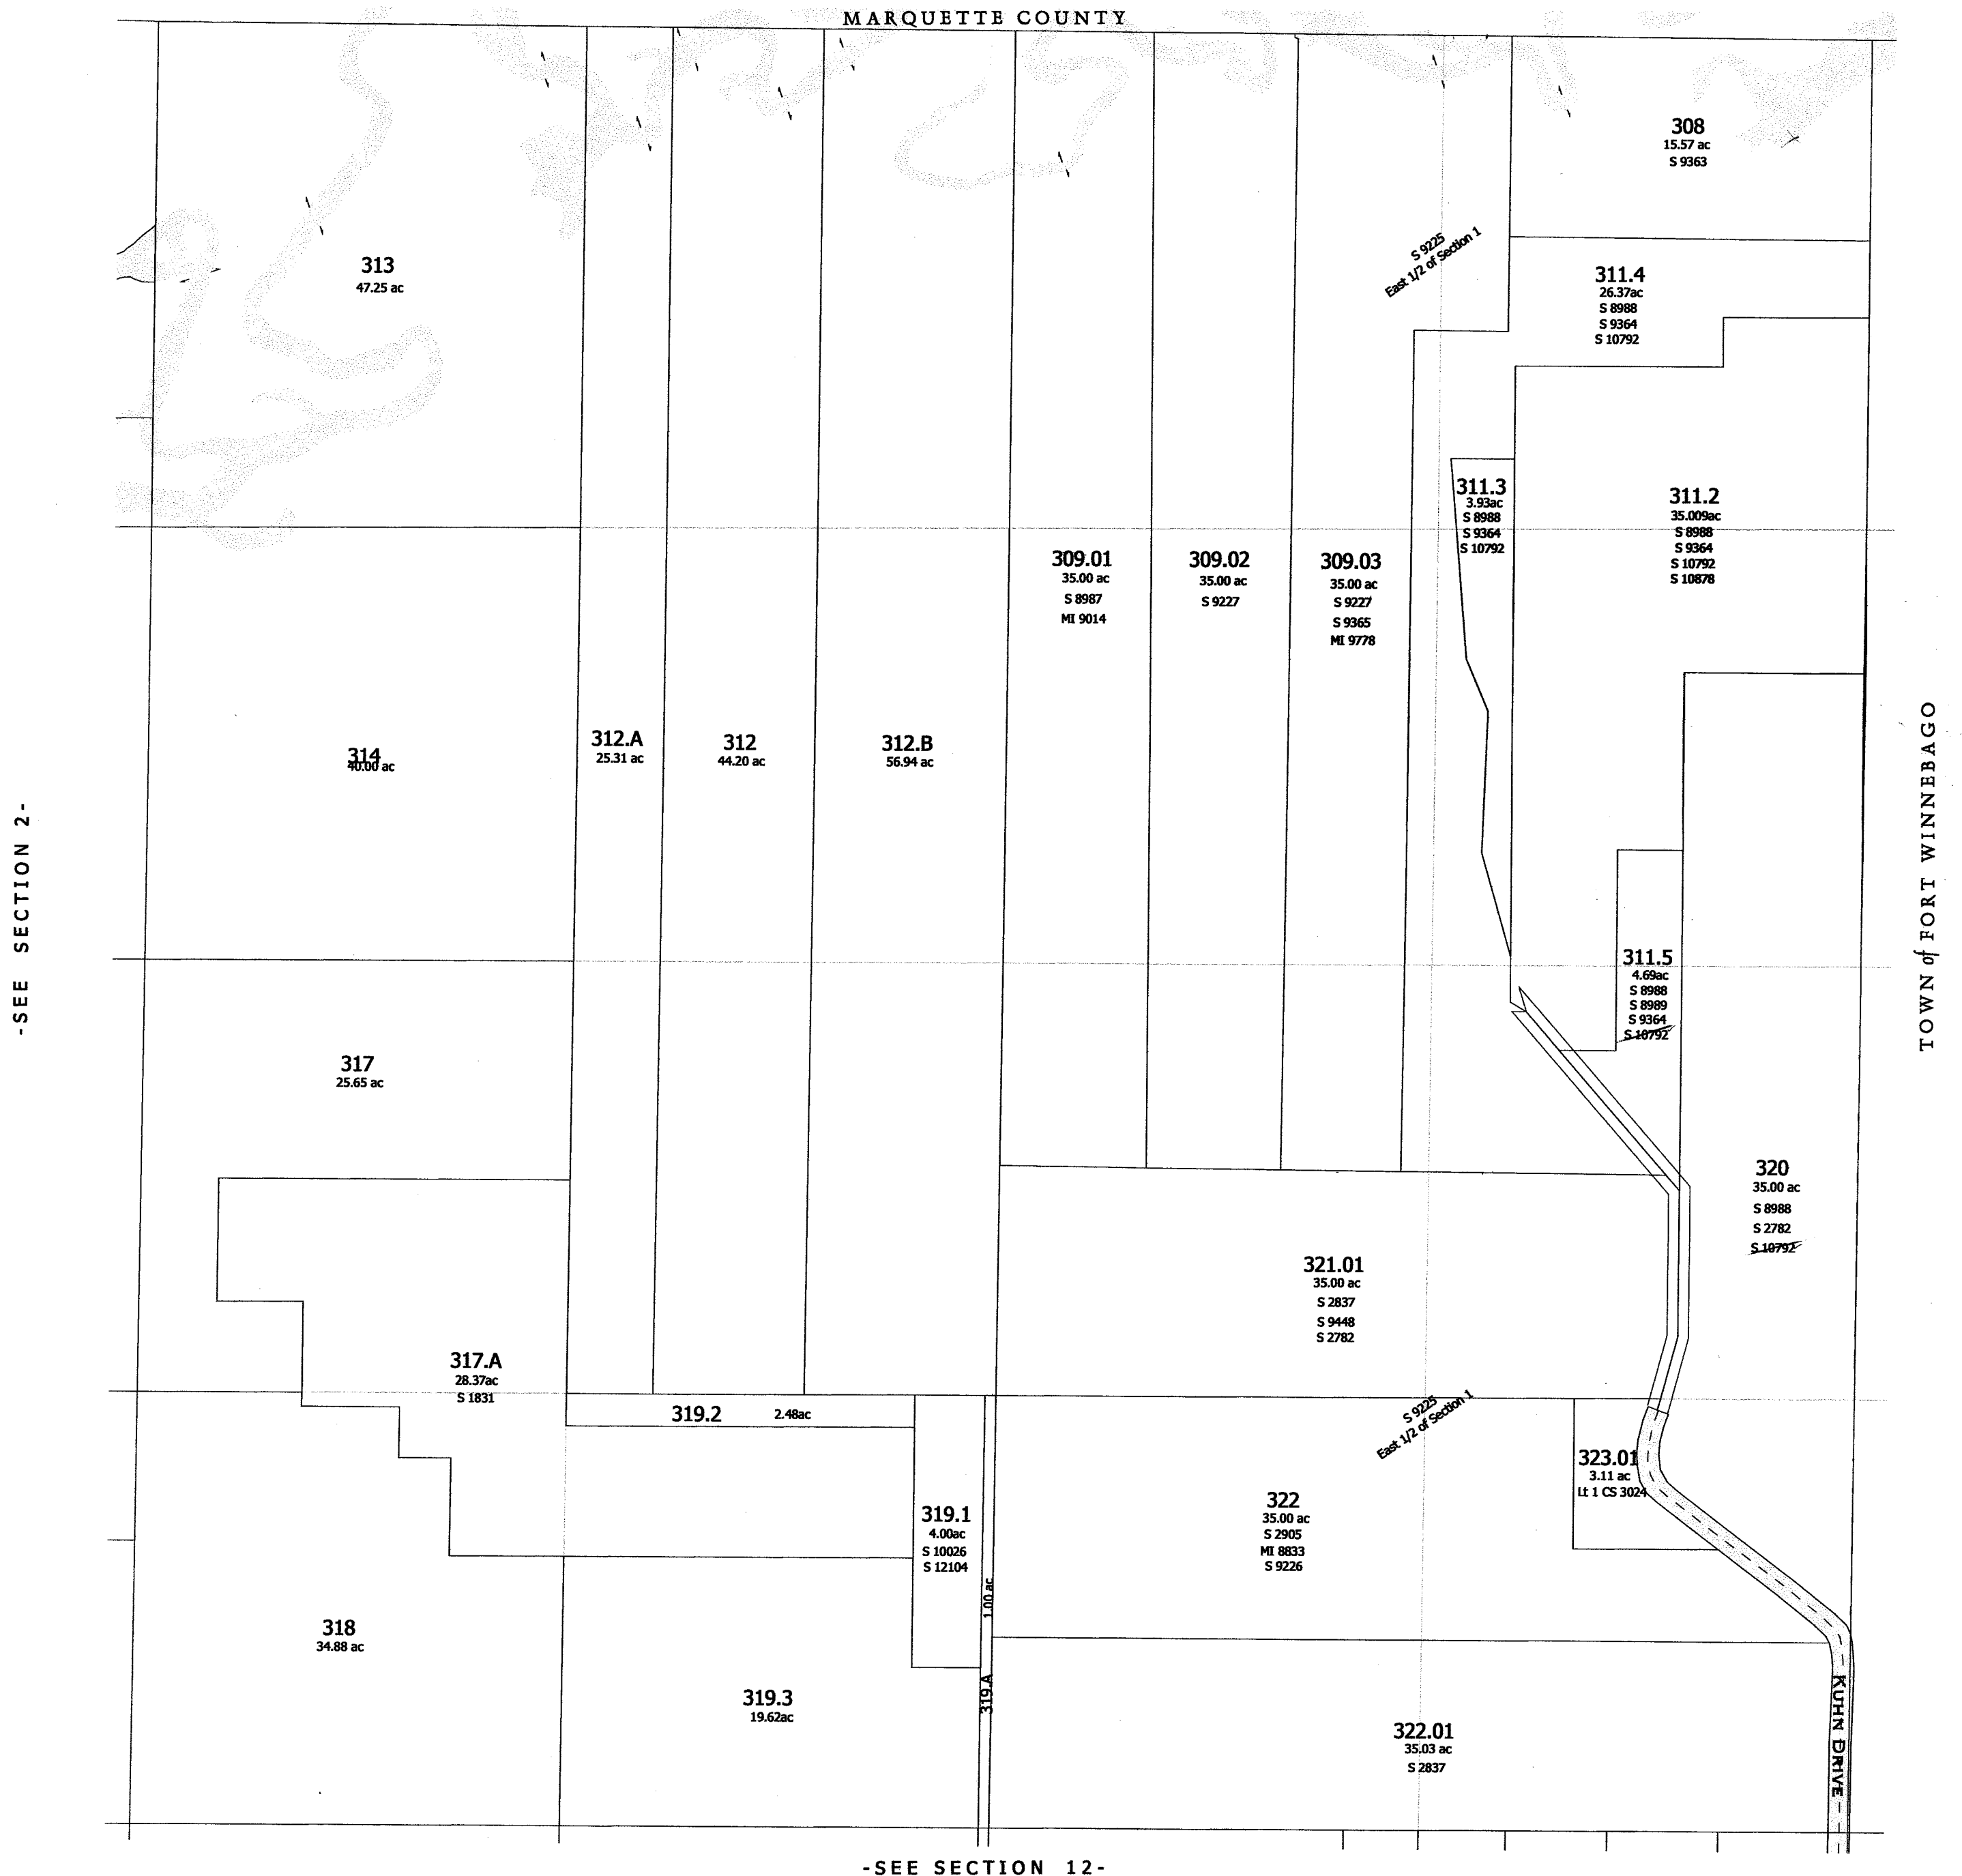

-SEE SECTION 12-

-SECTION 1-

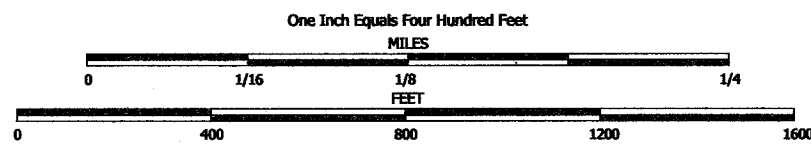



NOTE: This map was prepared for assessment use in accordance with the Wis. St. Stat. Chap. 70.09. All information contained herein is advisory only. Map accuracy is limited to the quality of data obtained from other Public Records. This map is not intended to be a substitute for an actual field survey. Public Land Survey Base is derived from U.S.G.S. Topographic maps unless otherwise noted. Other sources of the Land Base may be actual survey data. Base map data is from the April 1995 County Digital Orthophotos and/or U.S.G.S. 1:24,000 scale Topographic series. The user is responsible for the improper use of the data contained herein.

Created by The Columbia County Land Information Office -GIS Section. VMB.
September 2002.

TAX PARCEL MAP

TOWN of LEWISTON


TOWN 13 NORTH RANGE 7 EAST
COLUMBIA COUNTY, WISCONSIN

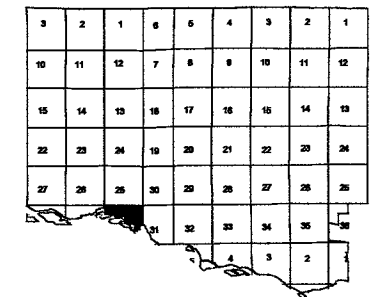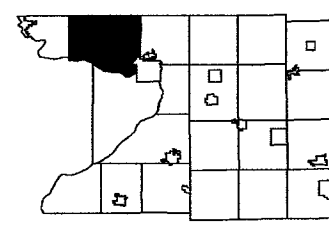

Replaced
2009


- SEE SECTION 25 -

- SEE SECTION 35 -

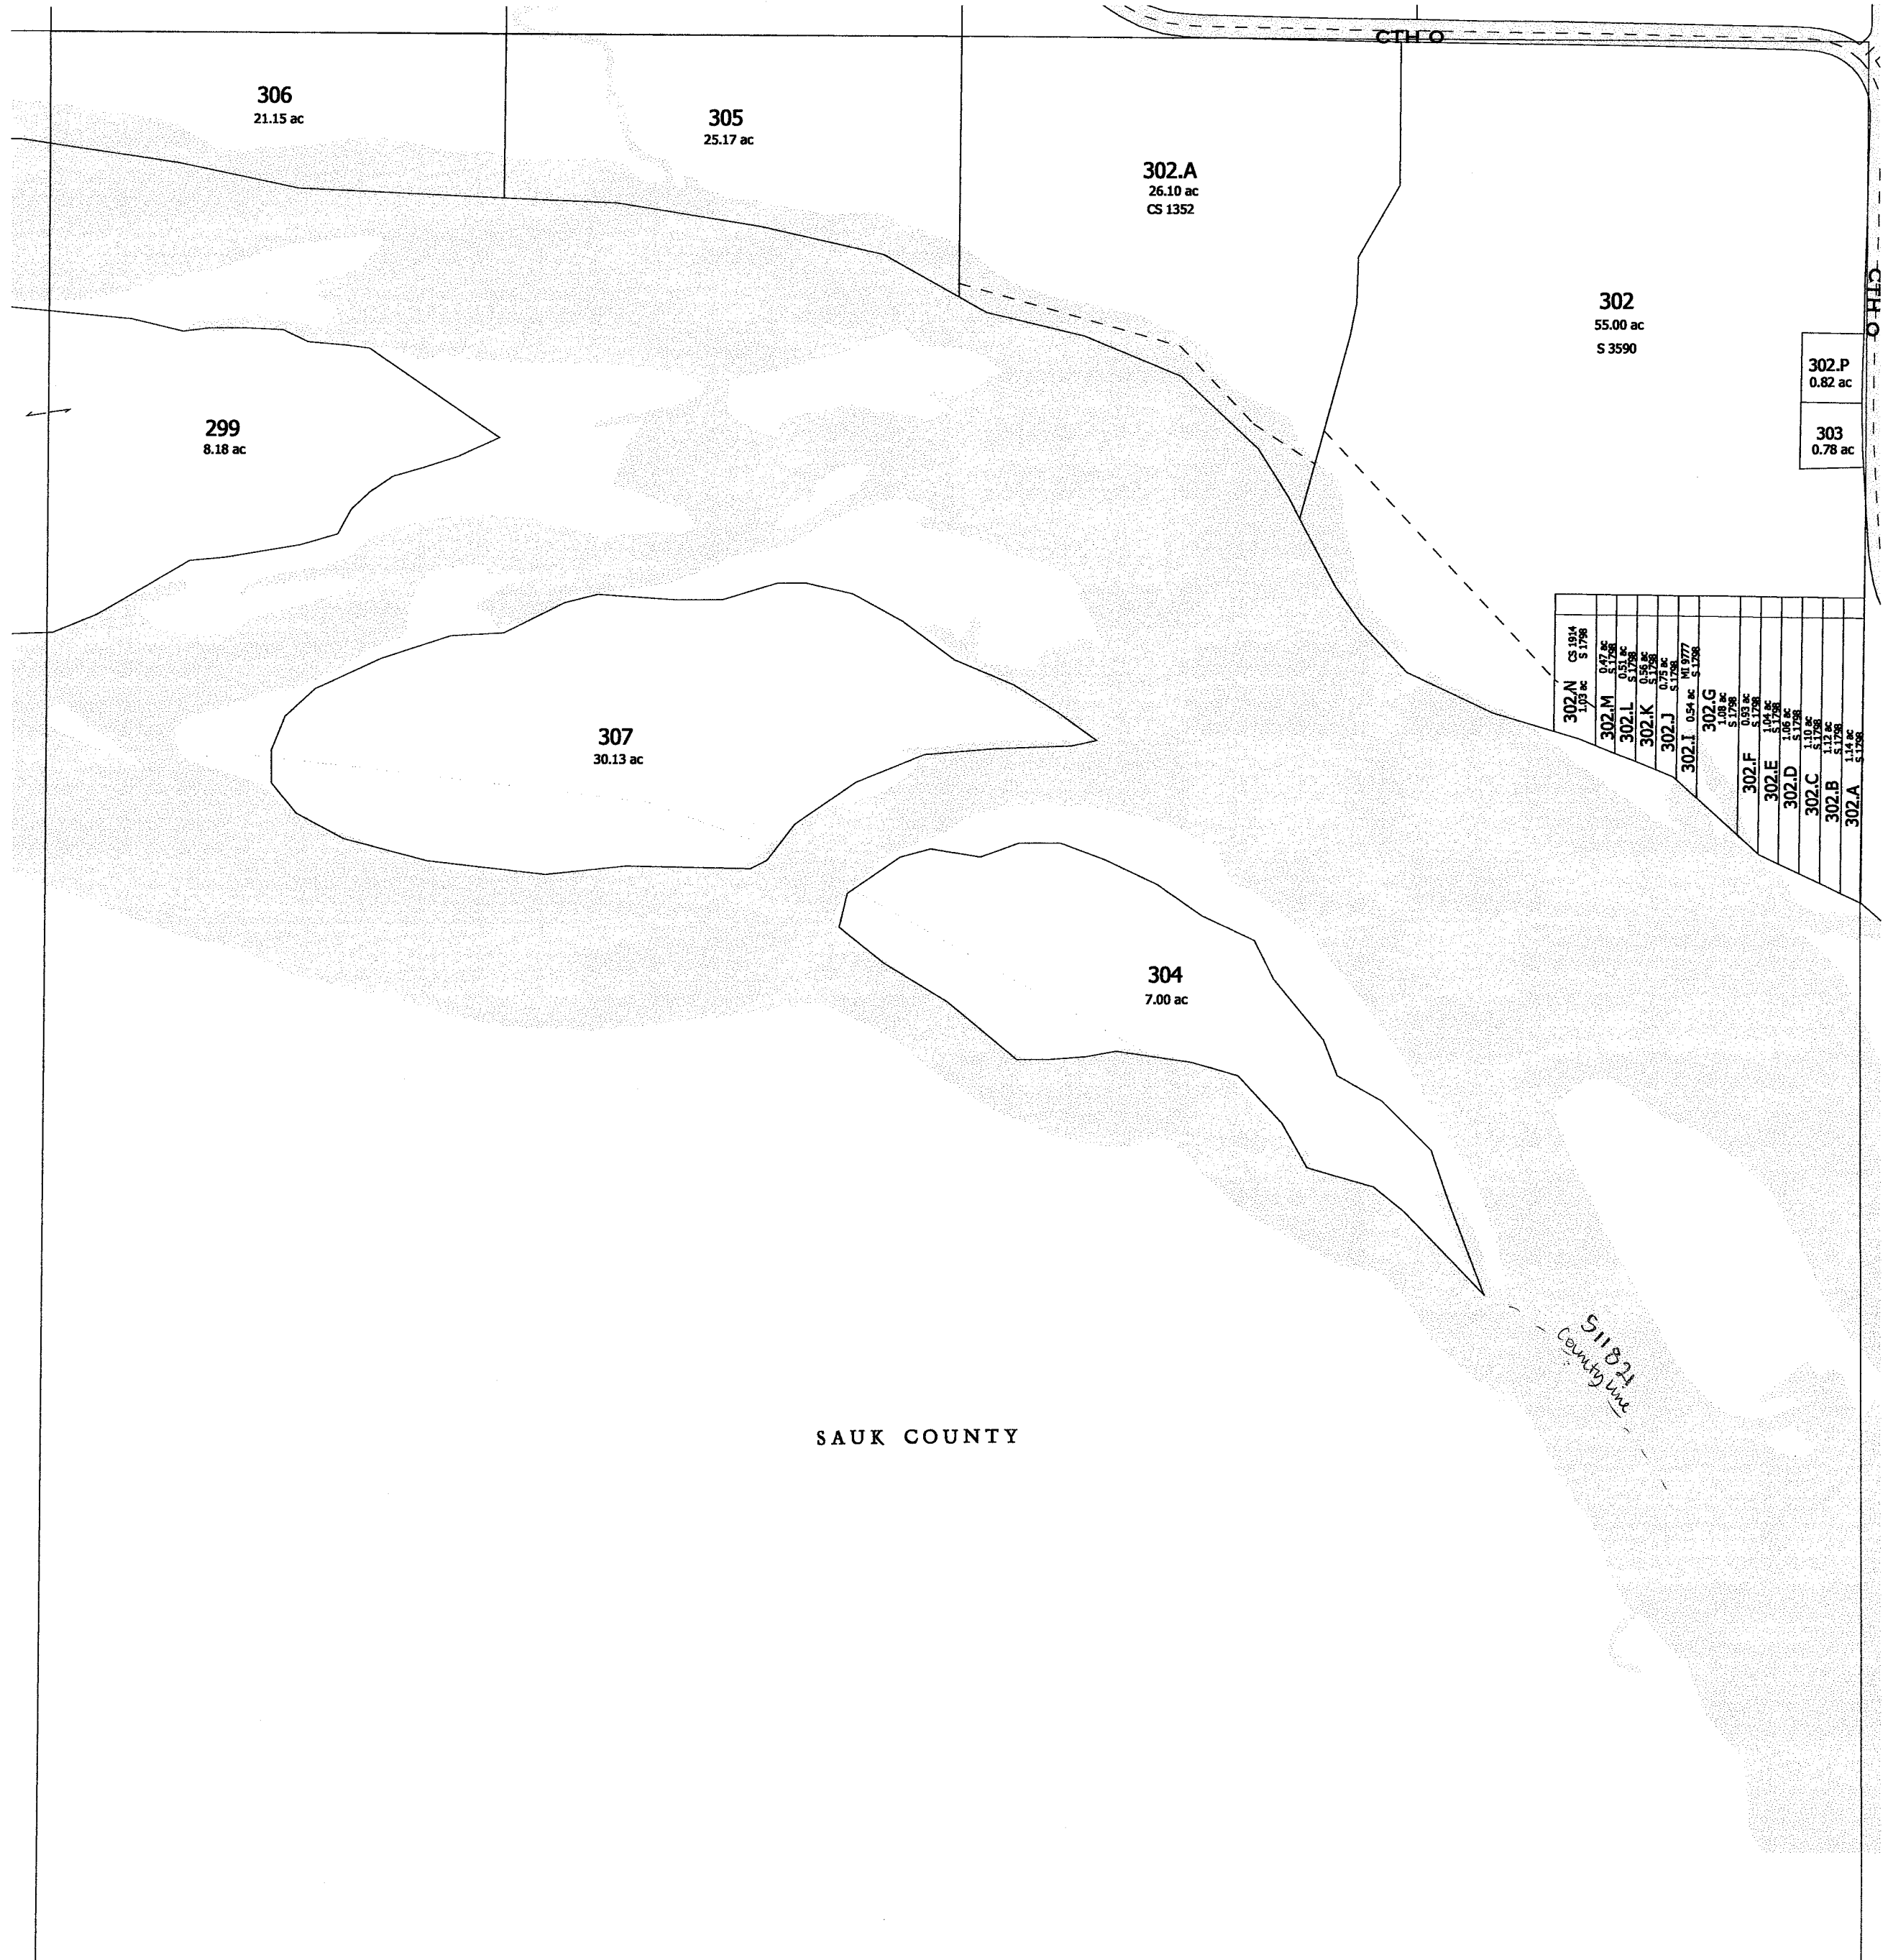

- SEE SECTION 31 T 13 N

- SECTION 36 -

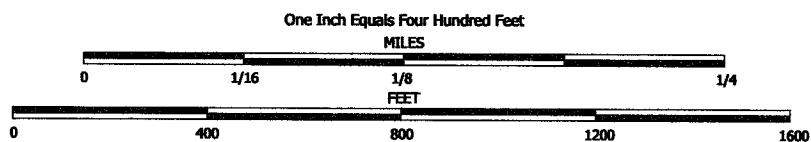


NOTE: This map was prepared for assessment use in accordance with the Wis. St. Stat. Chap. 70.09. All information contained herein is advisory only. Map accuracy is limited to the quality of data obtained from other Public Records. This map is not intended to be a substitute for an actual field survey. Public Land Survey Base is derived from U.S.G.S. Topographic maps unless otherwise noted. Other sources of the Land Base may be actual survey data. Base map data is from the April 1995 County Digital Orthophotos and/or U.S.G.S. 1:24,000 scale Topographic series. The user is responsible for the improper use of the data contained herein.

Created by The Columbia County Land Information Office -GIS Section. VMB.
September 2002.

TAX PARCEL MAP

TOWN of LEWISTON


TOWN 13 NORTH RANGE 7 EAST
COLUMBIA COUNTY, WISCONSIN

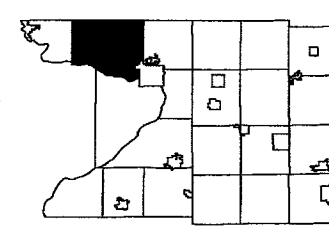


3	2	1	8	5	4	3	2	1
10	11	12	7	6	9	10	11	12
15	14	13	16	17	18	15	14	13
22	23	24	19	20	21	22	23	24
27	28	25	26	29	28	27	26	25
32	33	34	30	31	32	33	34	35
36	37	38	39	40	41	42	43	44

Replaced
2009

-SEE SECTION 26 -

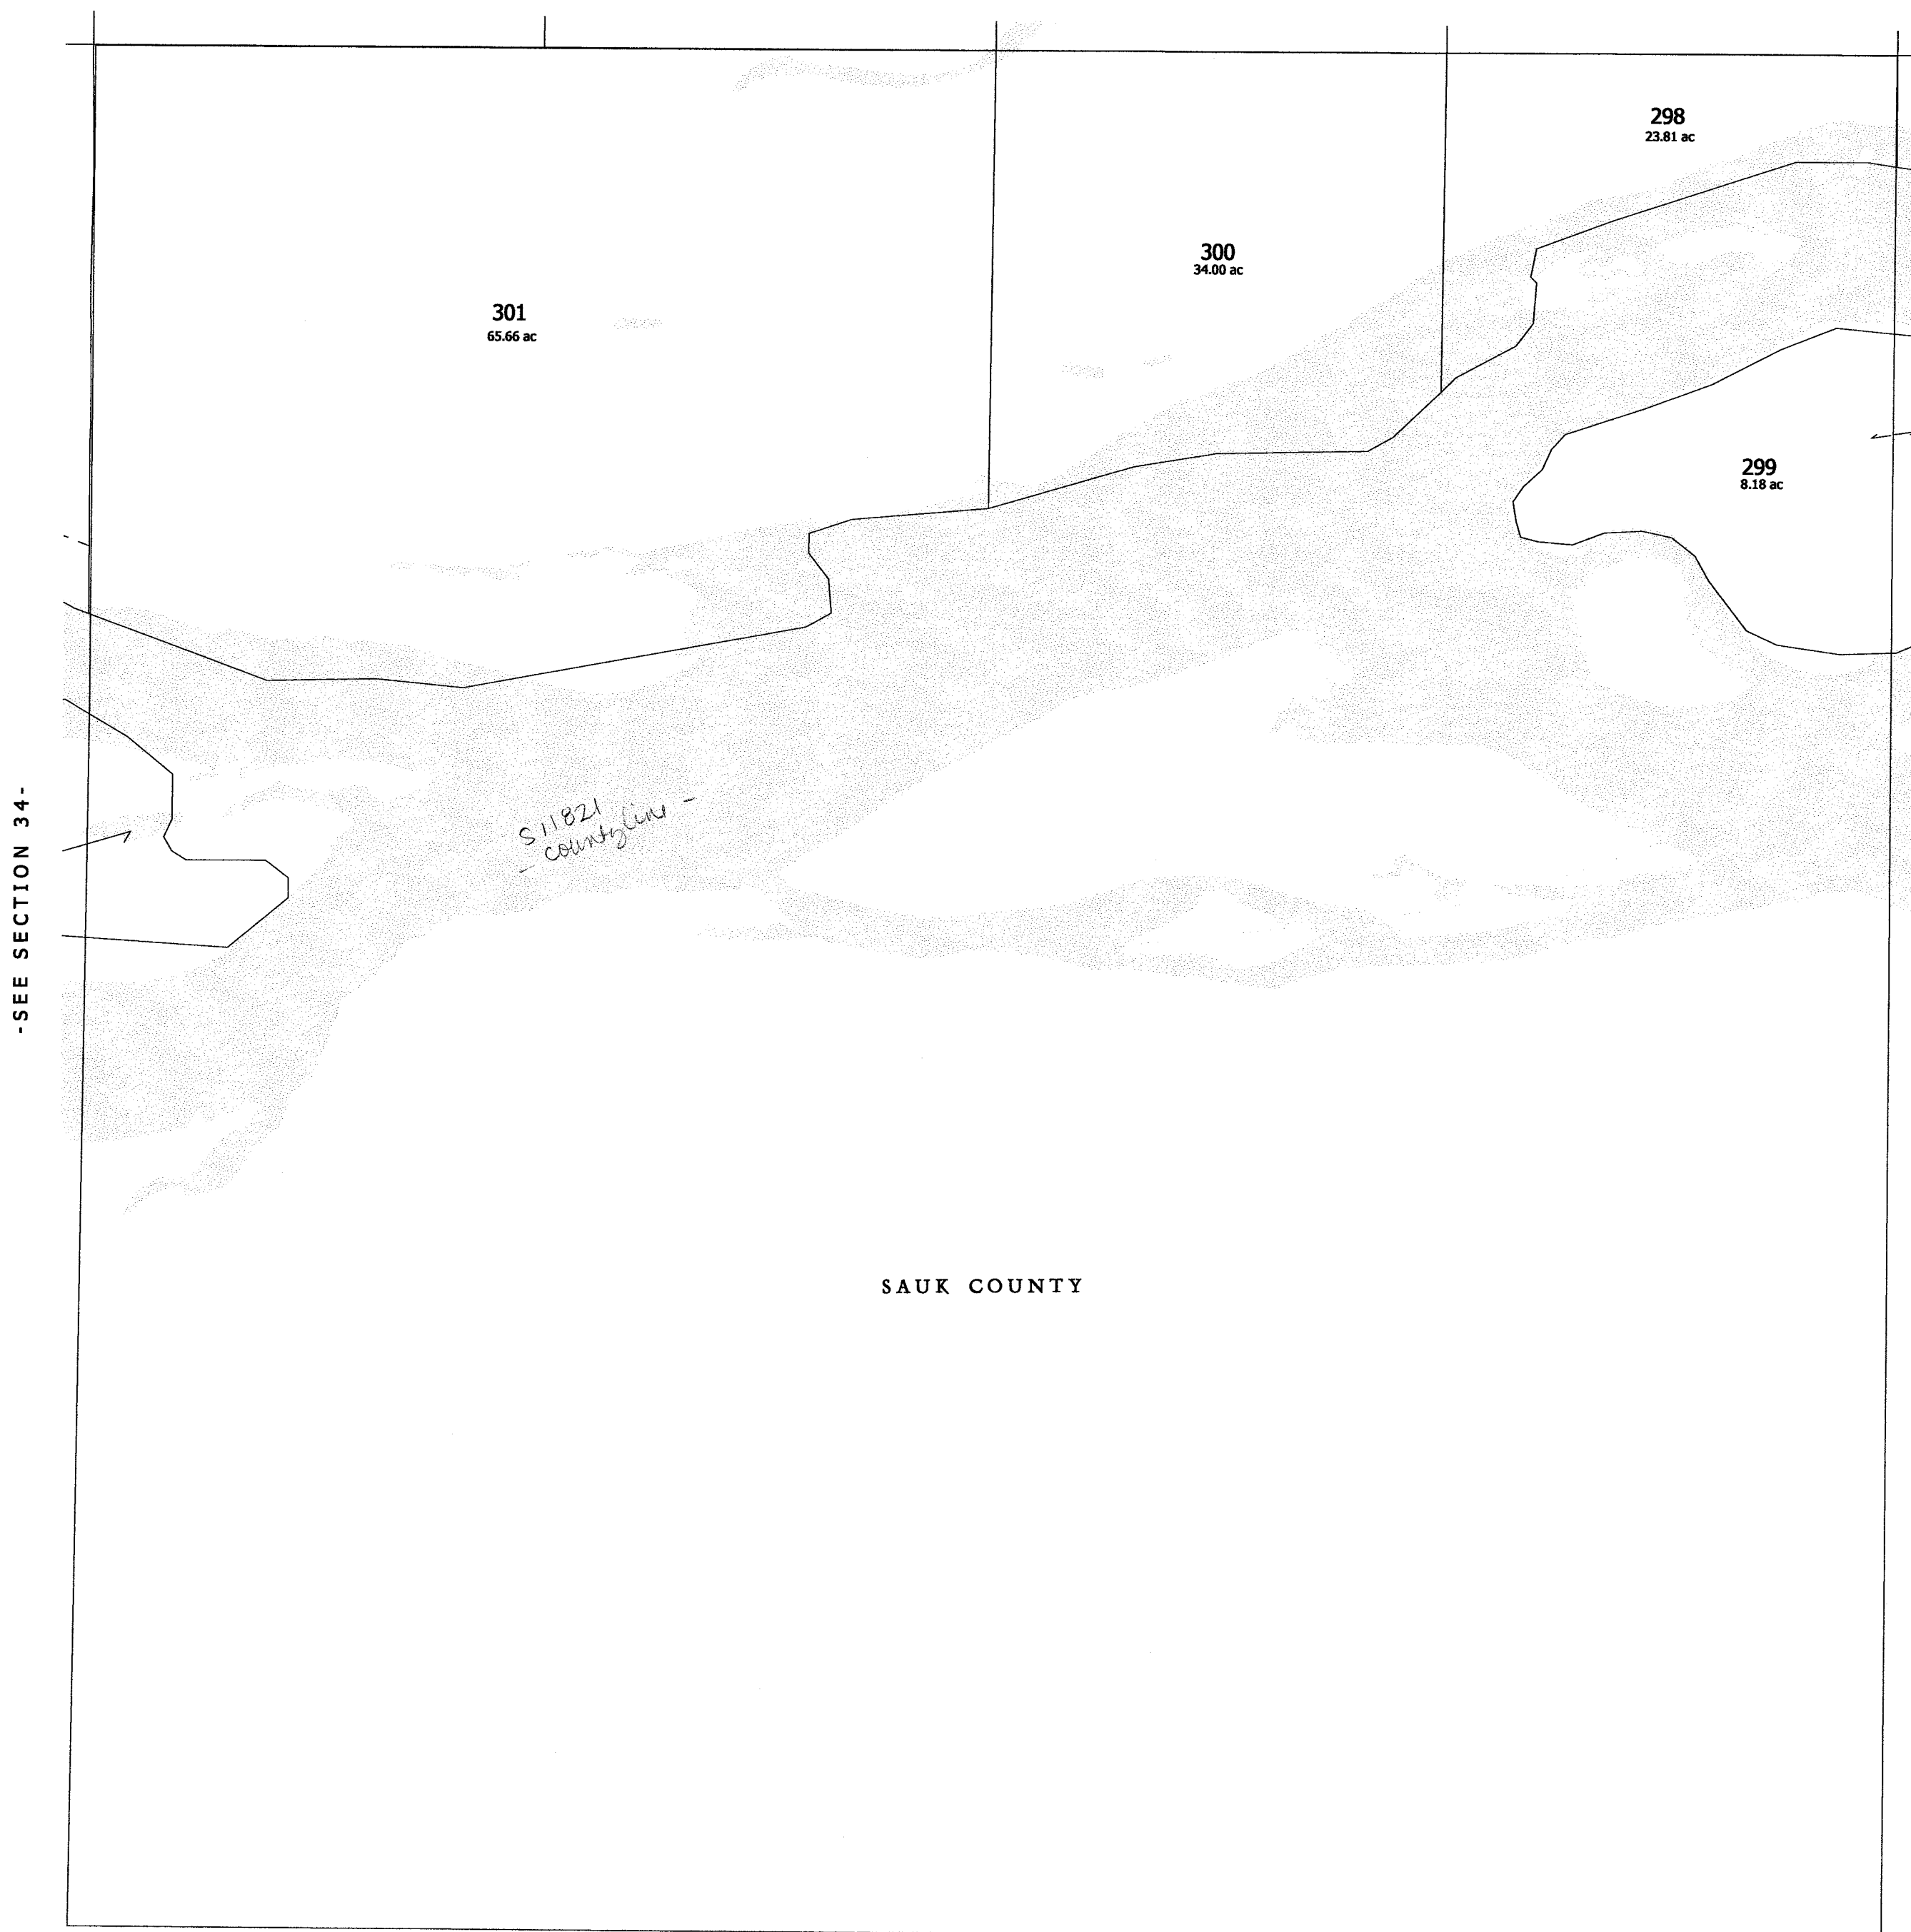

-SECTION 35-

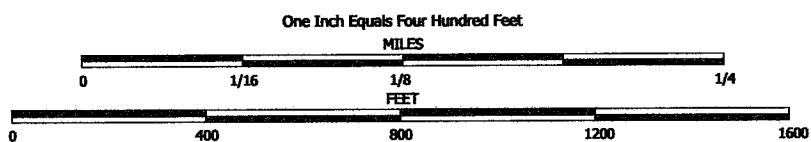


NOTE: This map was prepared for assessment use in accordance with the Wis. St. Stat. Chap. 70.09. All information contained herein is advisory only. Map accuracy is limited to the quality of data obtained from other Public Records. This map is not intended to be a substitute for an actual field survey. Public Land Survey Base is derived from U.S.G.S. Topographic maps unless otherwise noted. Other sources of the Land Base may be actual survey data. Base map data is from the April 1995 County Digital Orthophotos and/or U.S.G.S. 1:24,000 scale Topographic series. The user is responsible for the improper use of the data contained herein.

Created by The Columbia County Land Information Office -GIS Section. VMB.
September 2002.

TAX PARCEL MAP

TOWN of LEWISTON


TOWN 13 NORTH RANGE 7 EAST
COLUMBIA COUNTY, WISCONSIN

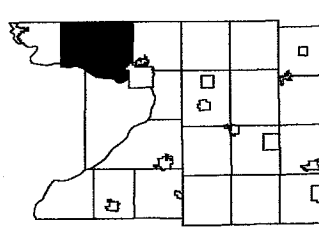

3	2	1	6	5	4	3	2	1
10	11	12	7	8	9	10	11	12
13	14	15	16	17	18	19	20	21
22	23	24	19	20	21	22	23	24
27	28	29	30	31	32	33	34	35

Replaced
2009


-SEE SECTION 27-

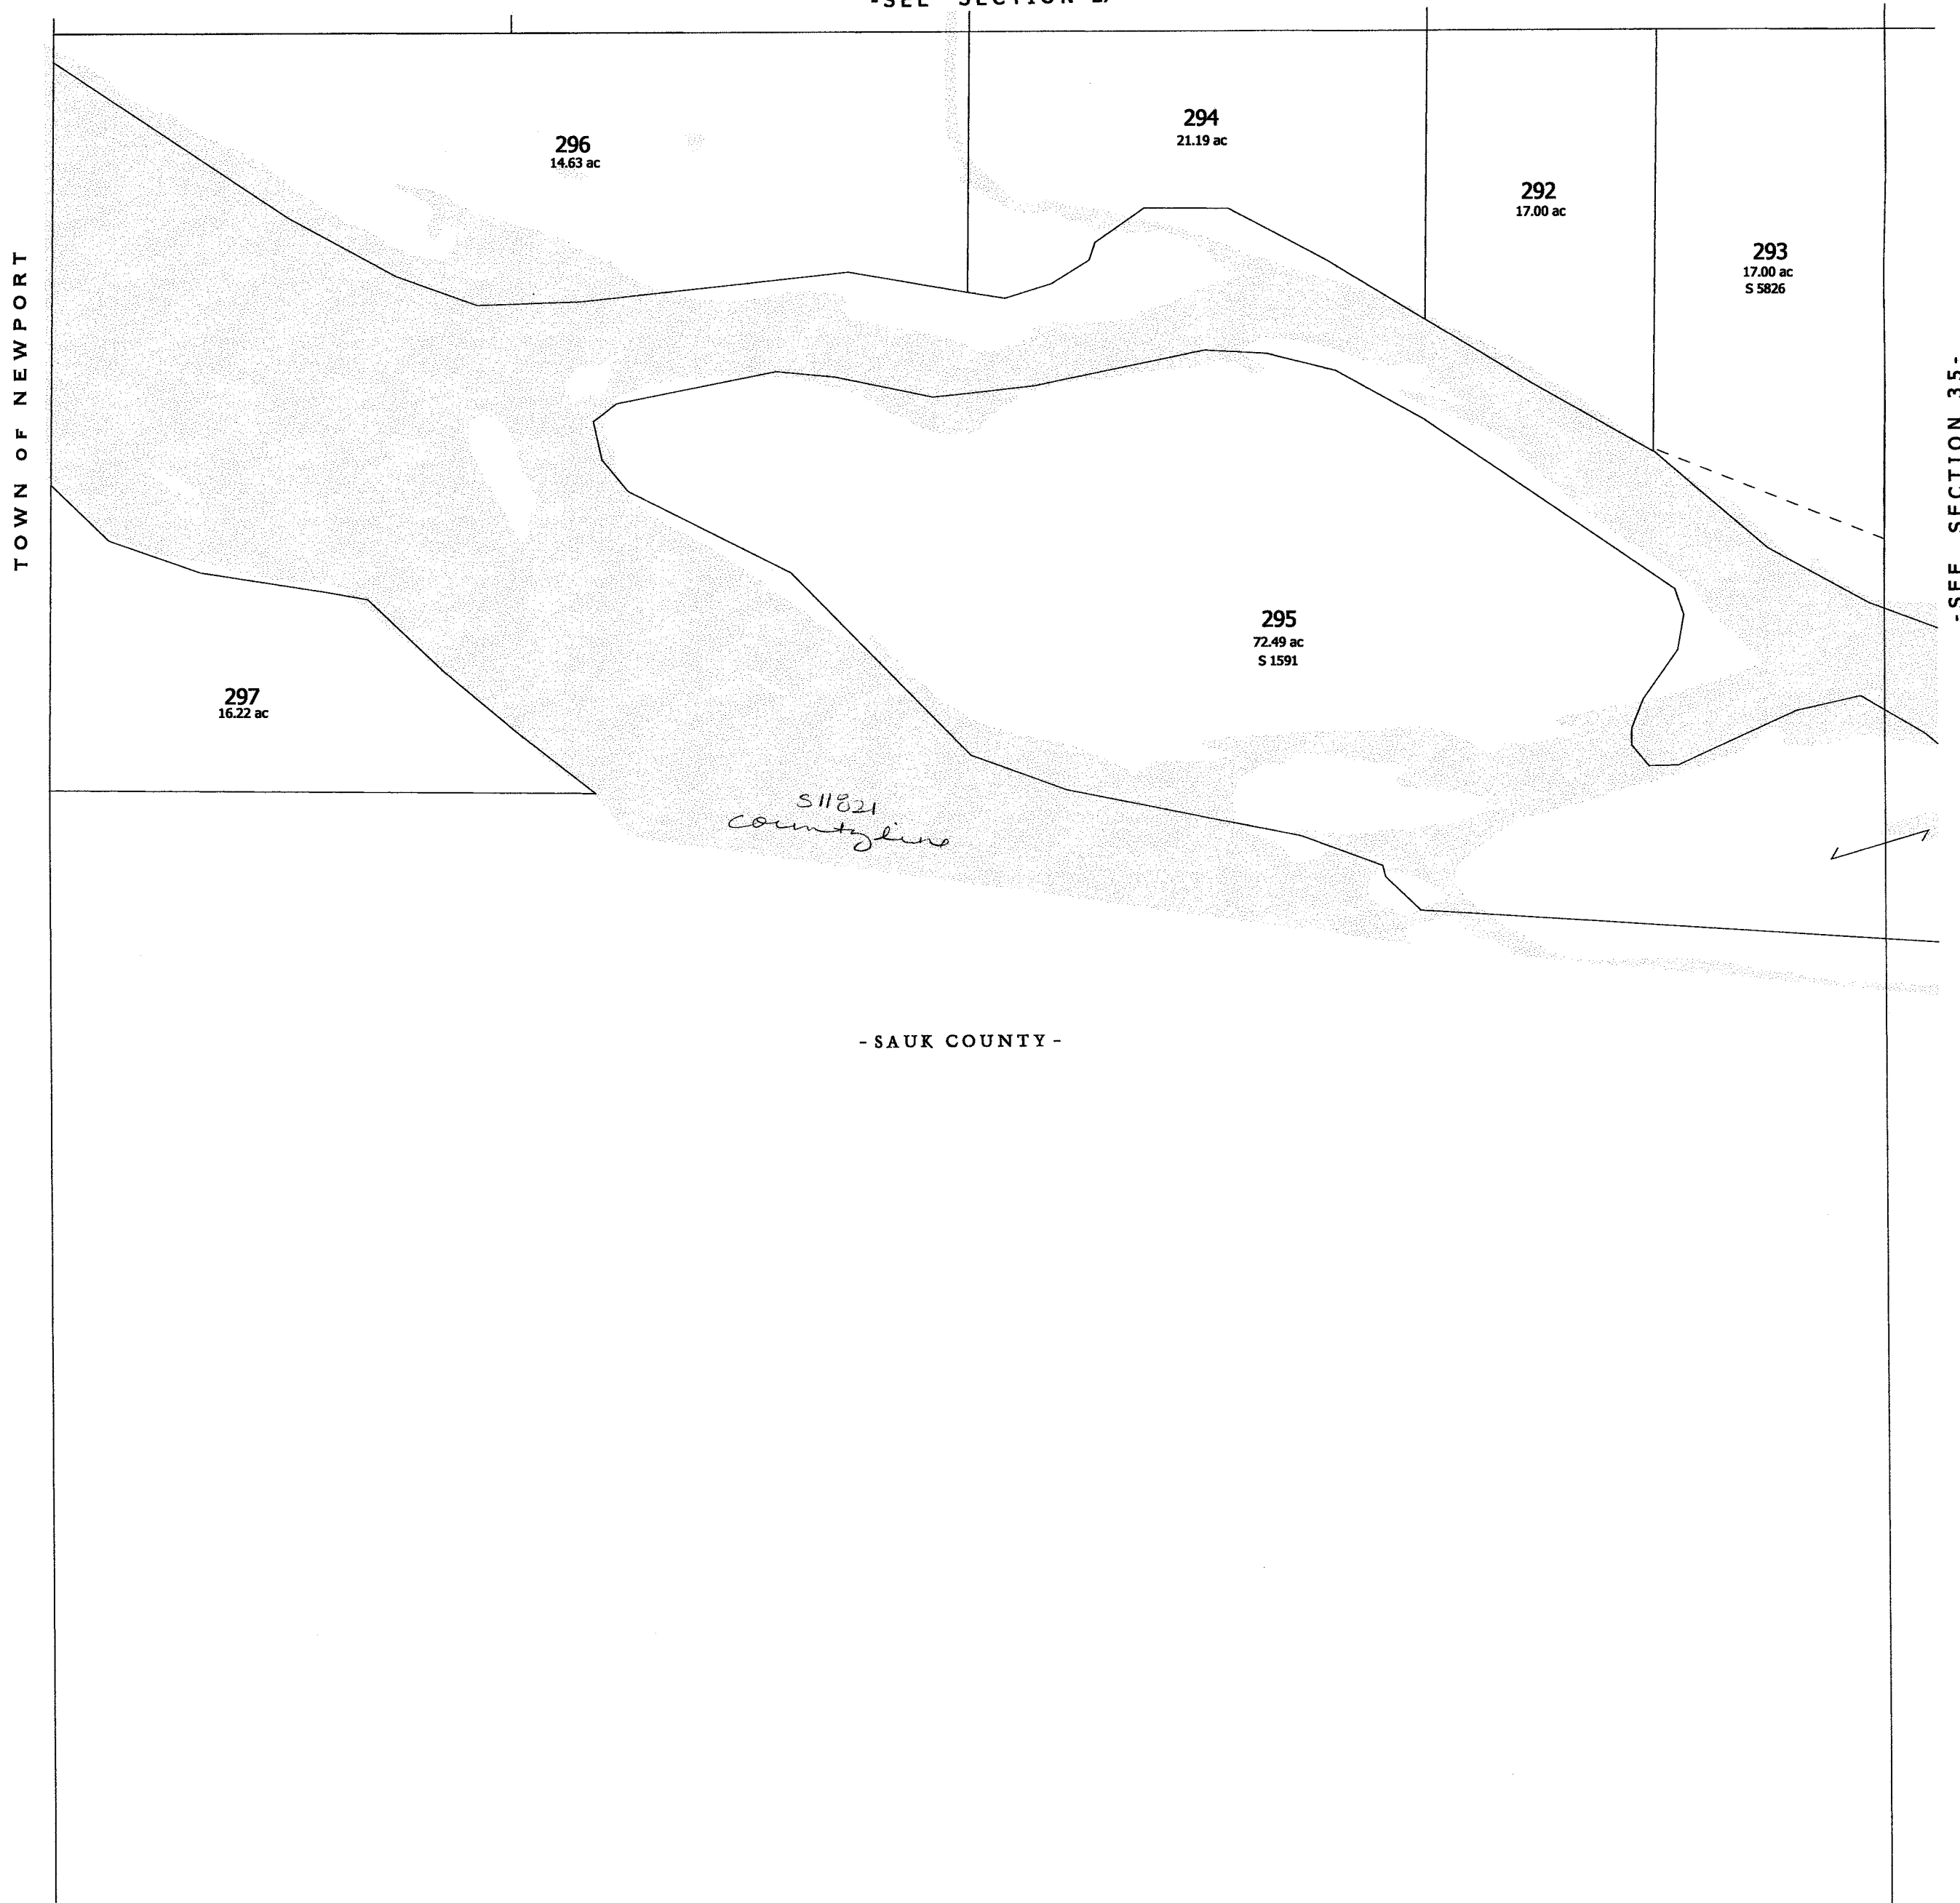

-SEE SECTION 35-

-SAUK COUNTY-

-SECTION 34-

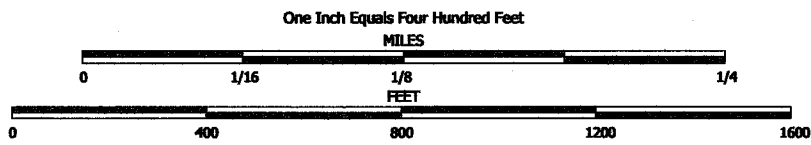

NOTE: This map was prepared for assessment use in accordance with the Wis. St. Stat. Chap. 70.09. All information contained herein is advisory only. Map accuracy is limited to the quality of data obtained from other Public Records. This map is not intended to be a substitute for an actual field survey. Public Land Survey Base is derived from U.S.G.S. Topographic maps unless otherwise noted. Other sources of the Land Base may be actual survey data. Base map data is from the April 1995 County Digital Orthophotos and/or U.S.G.S. 1:24,000 scale Topographic series. The user is responsible for the improper use of the data contained herein.


Created by The Columbia County Land Information Office -GIS Section. VMB.
February 2006.

TAX PARCEL MAP


TOWN of LEWISTON

TOWN 13 NORTH RANGE 7 EAST
COLUMBIA COUNTY, WISCONSIN

Replaced
2009

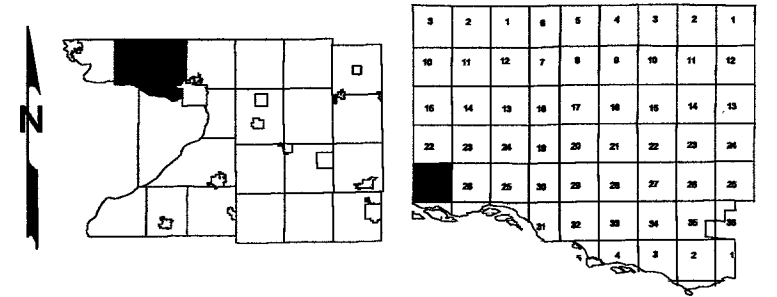

-SECTION 27-

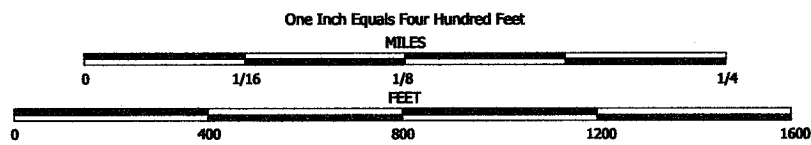


NOTE: This map was prepared for assessment use in accordance with the Wis. St. Stat. Chap. 70.09. All information contained herein is advisory only. Map accuracy is limited to the quality of data obtained from other Public Records. This map is not intended to be a substitute for an actual field survey. Public Land Survey Base is derived from U.S.G.S. Topographic maps unless otherwise noted. Other sources of the Land Base may be actual survey data. Base map data is from the April 1995 County Digital Orthophotos and/or U.S.G.S. 1:24,000 scale Topographic series. The user is responsible for the improper use of the data contained herein.

Created by The Columbia County Land Information Office -GIS Section. VMB.
September 2002.

TAX PARCEL MAP

TOWN of LEWISTON


TOWN 13 NORTH RANGE 7 EAST
COLUMBIA COUNTY, WISCONSIN

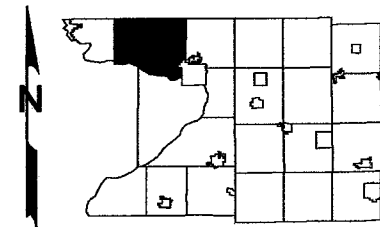

3	2	1	8	5	4	3	2	1
10	11	12	7	6	9	10	11	12
15	14	13	16	17	18	19	14	13
22	23	24	19	20	21	22	23	24
27	28	29	30	25	26	27	28	29
34	35	36	31	32	33	34	35	36
41	42	43	38	39	40	41	42	43
48	49	50	45	46	47	48	49	50

Replaced
2009

-SEE SECTION 23-

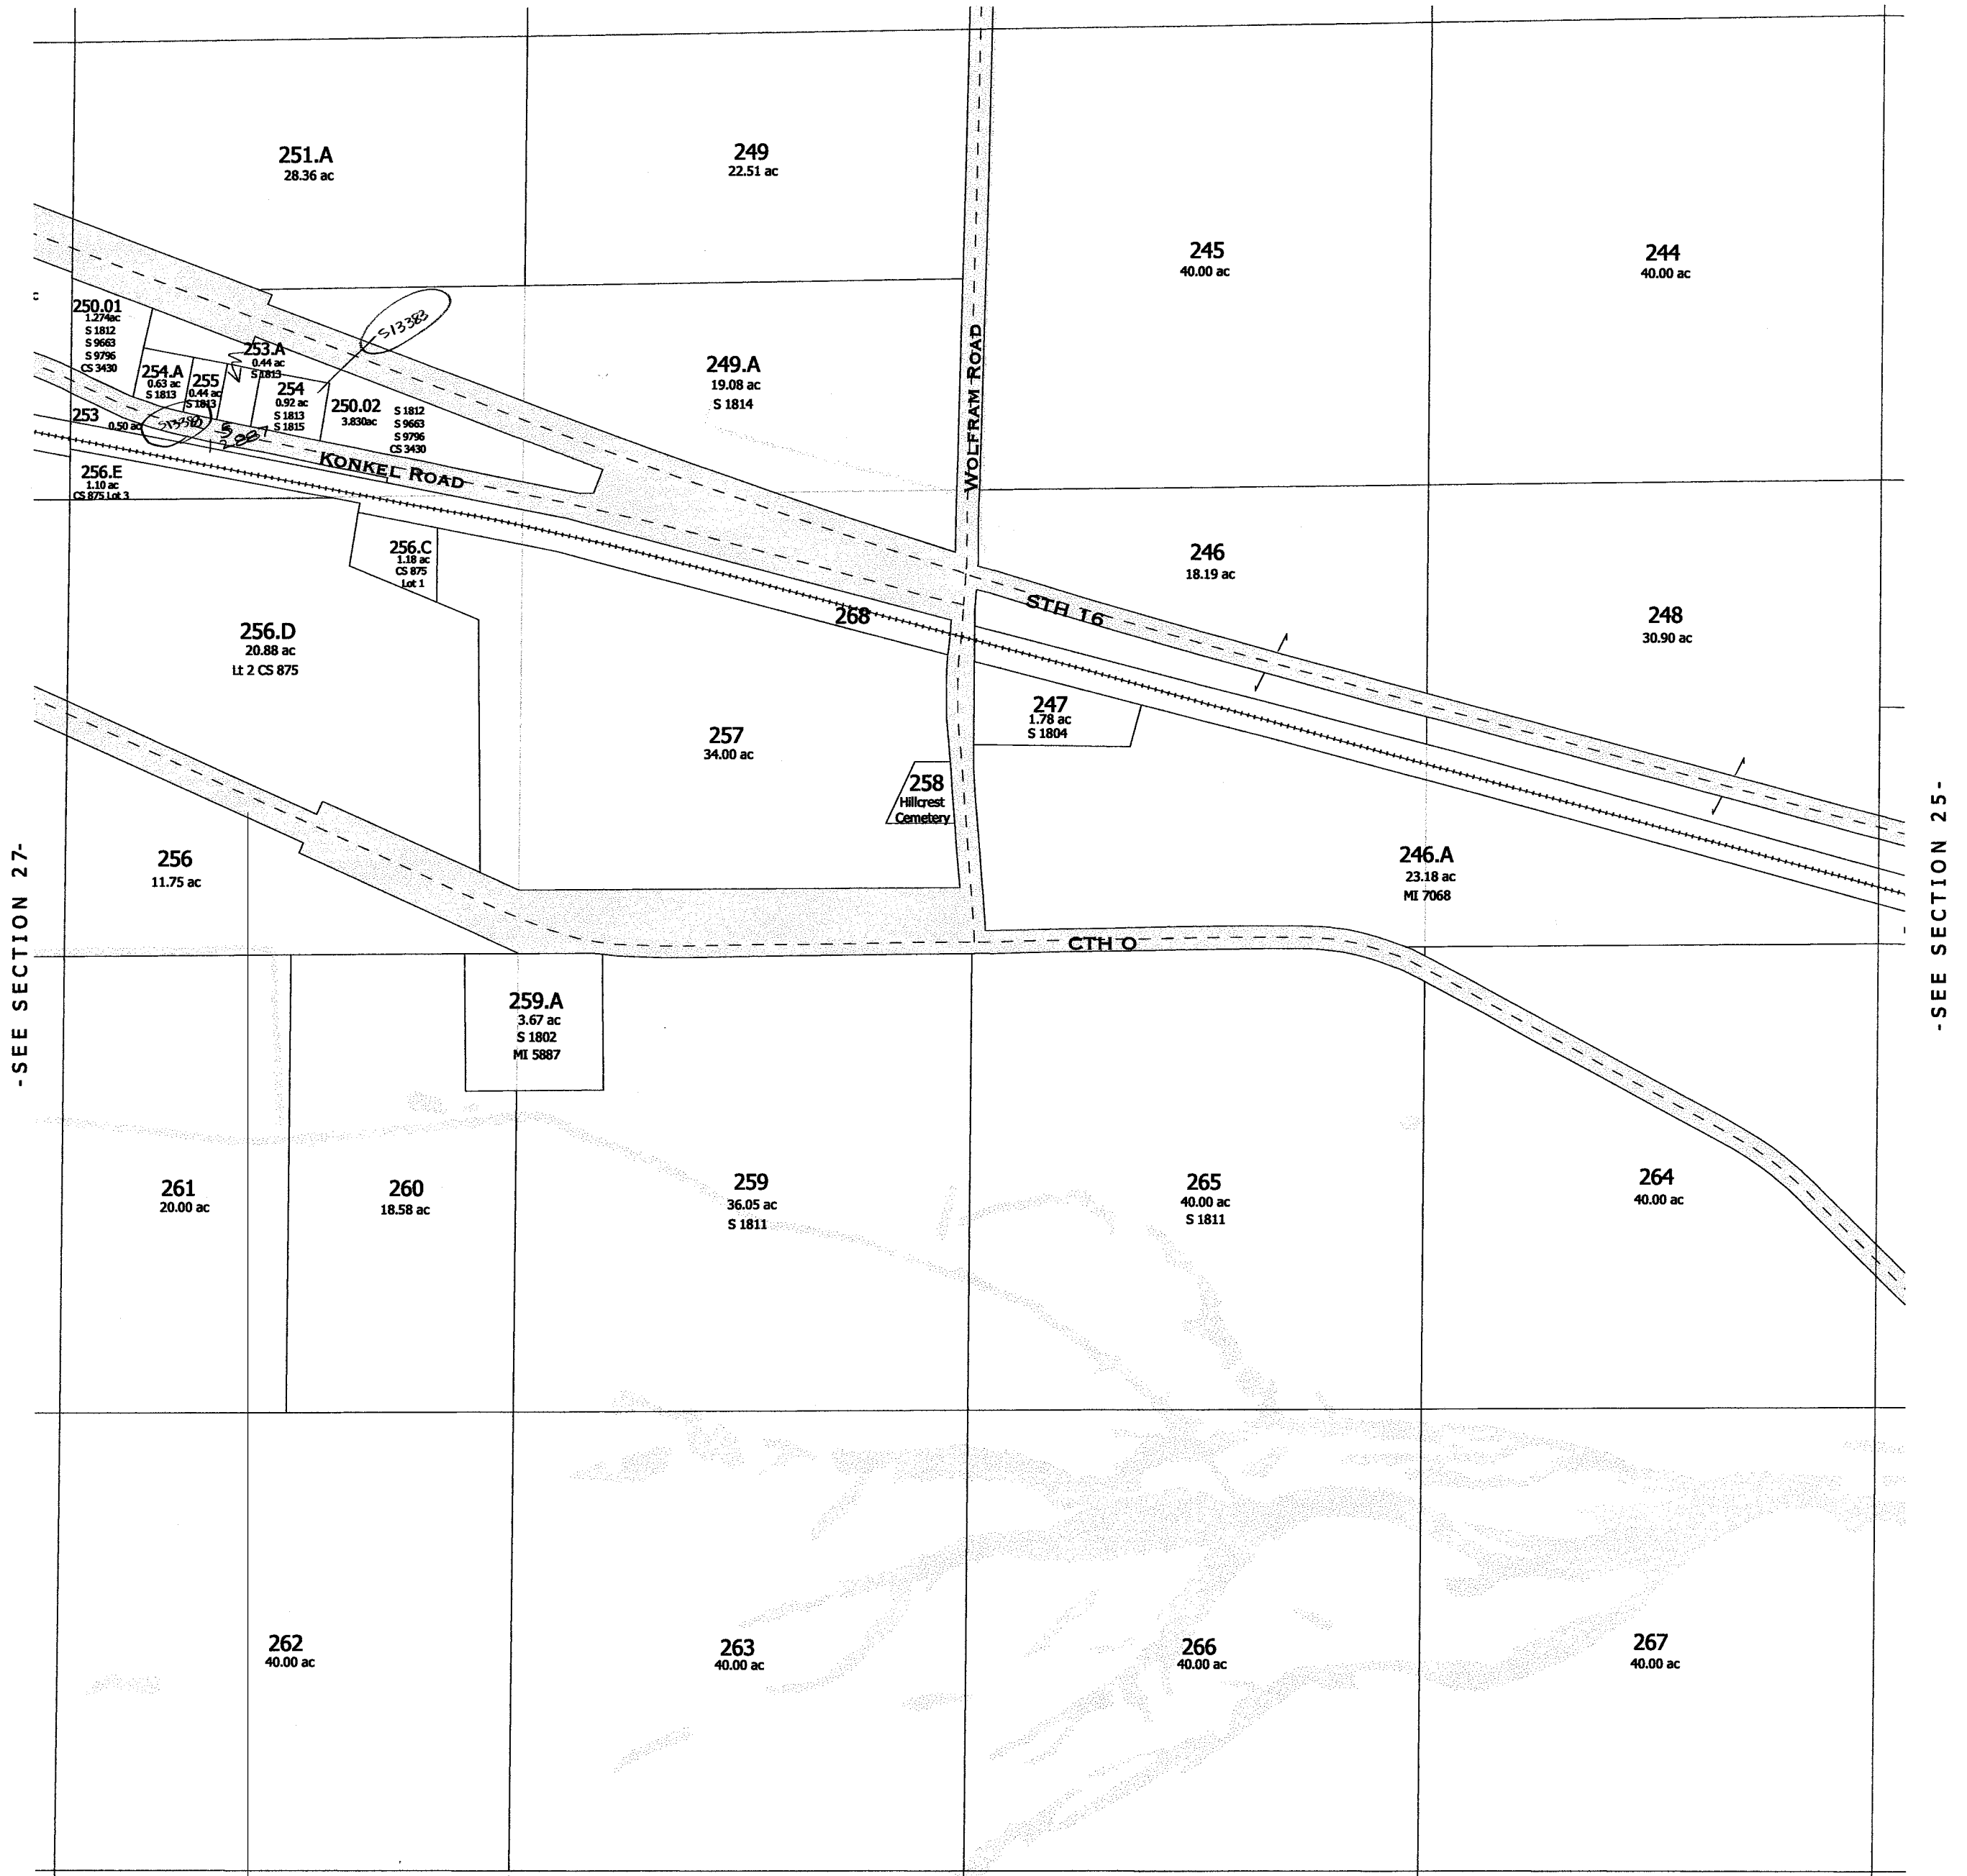


-SEE SECTION 27-

-SEE SECTION 25-

-SEE SECTION 35-

-SECTION 26-

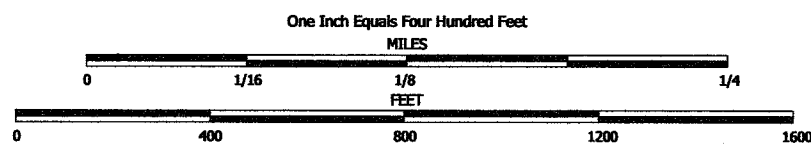


NOTE: This map was prepared for assessment use in accordance with the Wis. St. Stat. Chap. 70.09. All information contained herein is advisory only. Map accuracy is limited to the quality of data obtained from other Public Records. This map is not intended to be a substitute for an actual field survey. Public Land Survey Base is derived from U.S.G.S. Topographic maps unless otherwise noted. Other sources of the Land Base may be actual survey data. Base map data is from the April 1995 County Digital Orthophotos and/or U.S.G.S. 1:24,000 scale Topographic series. The user is responsible for the improper use of the data contained herein.

Created by The Columbia County Land Information Office -GIS Section. VMB.
September 2002.

TAX PARCEL MAP


TOWN of LEWISTON

TOWN 13 NORTH RANGE 7 EAST
COLUMBIA COUNTY, WISCONSIN

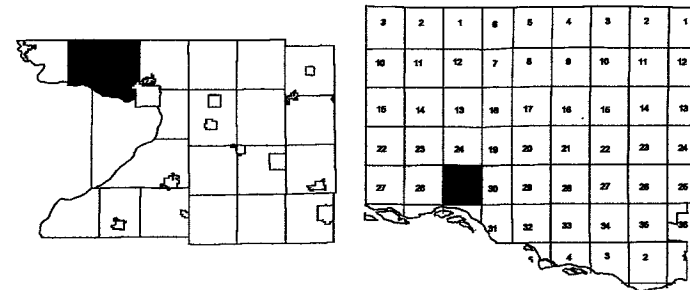

Replaced
2009


-SEE SECTION 24-

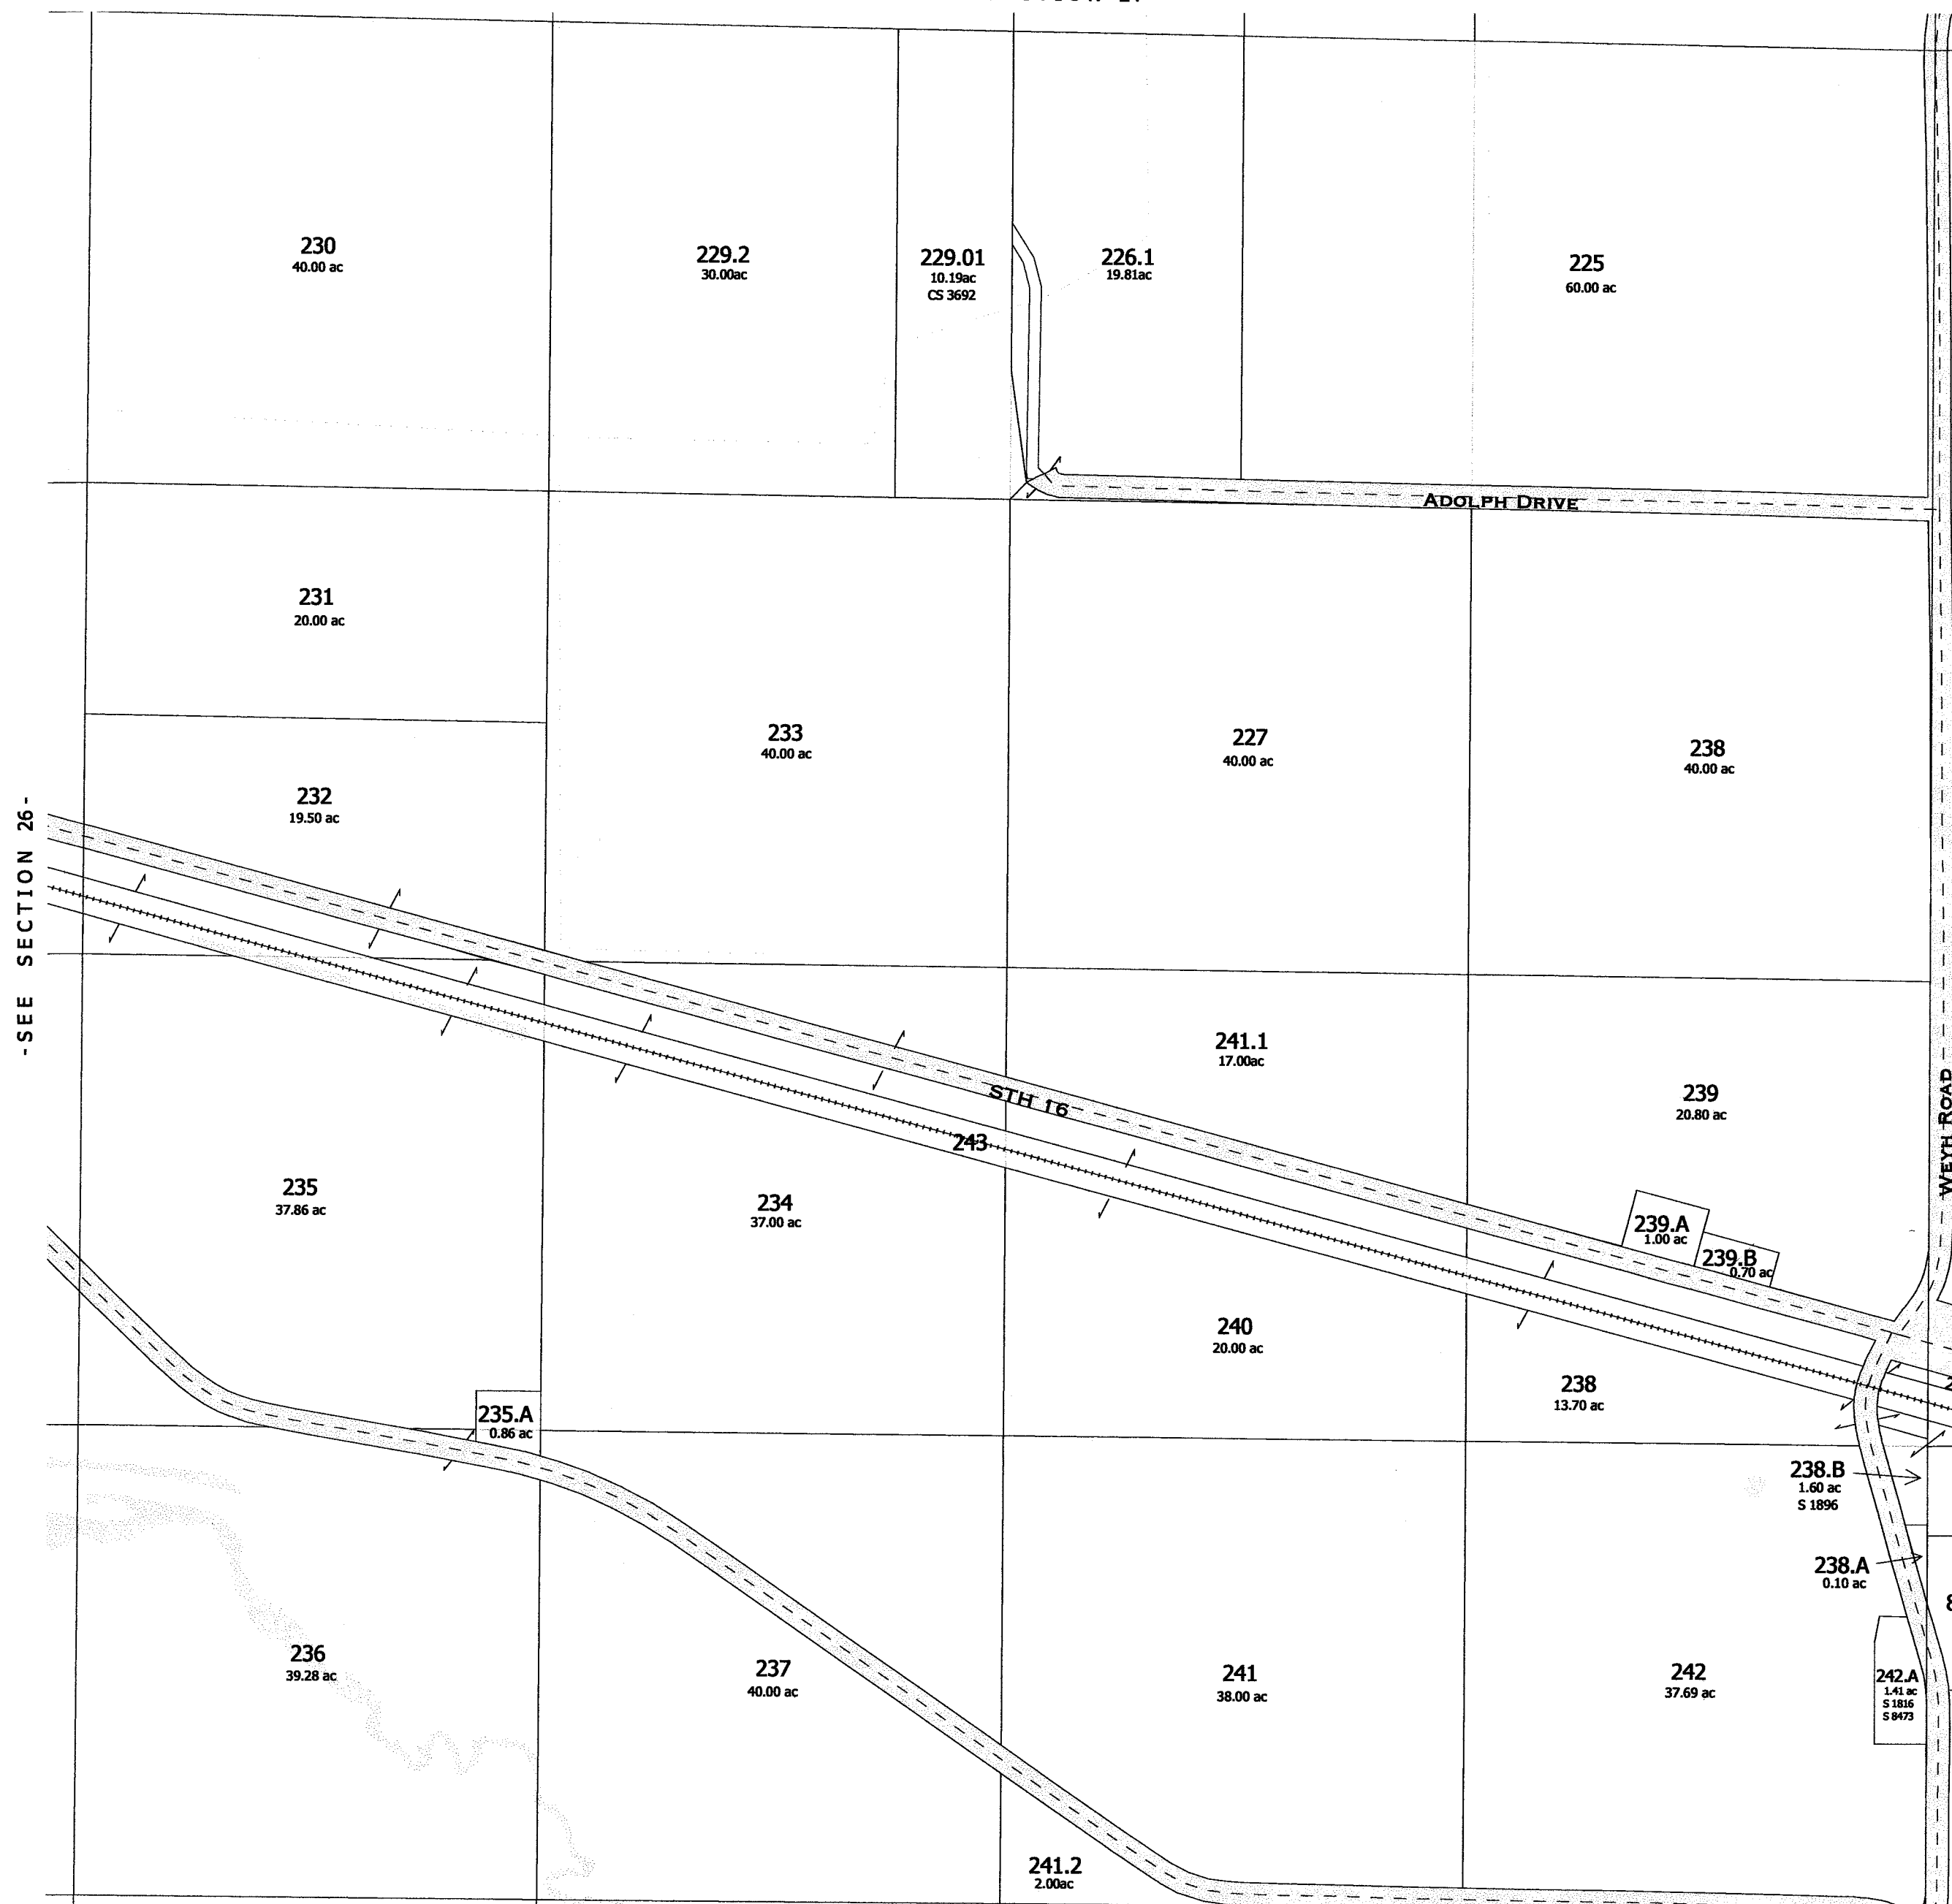

-SEE SECTION 30 T 13N R 8E-

-SEE SECTION 36-

-SECTION 25-

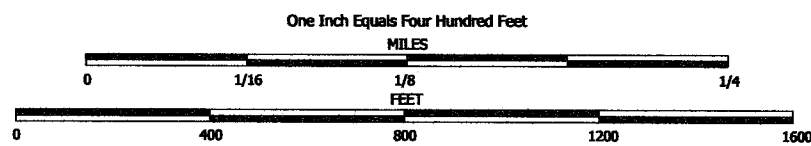


NOTE: This map was prepared for assessment use in accordance with the Wis. St. Stat. Chap. 70.09. All information contained herein is advisory only. Map accuracy is limited to the quality of data obtained from other Public Records. This map is not intended to be a substitute for an actual field survey. Public Land Survey Base is derived from U.S.G.S. Topographic maps unless otherwise noted. Other sources of the Land Base may be actual survey data. Base map data is from the April 1995 County Digital Orthophotos and/or U.S.G.S. 1:24,000 scale Topographic series. The user is responsible for the improper use of the data contained herein.


Created by The Columbia County Land Information Office -GIS Section. VMB.
September 2002.

TAX PARCEL MAP

TOWN of LEWISTON

TOWN 13 NORTH RANGE 7 EAST
COLUMBIA COUNTY, WISCONSIN

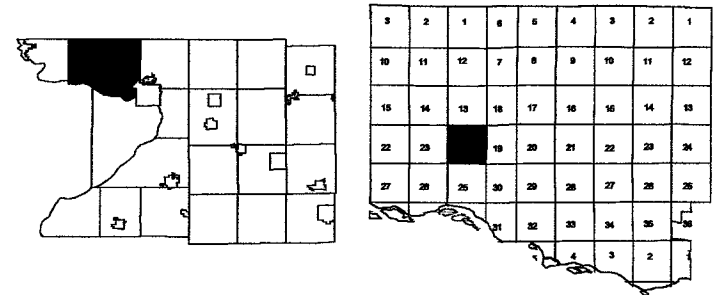

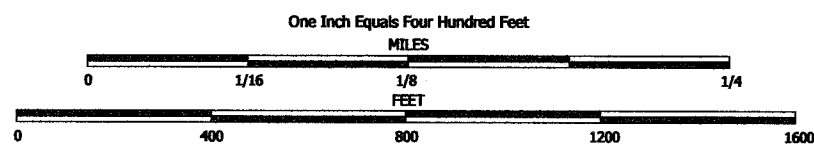



NOTE: This map was prepared for assessment use in accordance with the Wis. St. Stat. Chap. 70.09. All information contained herein is advisory only. Map accuracy is limited to the quality of data obtained from other Public Records. This map is not intended to be a substitute for an actual field survey. Public Land Survey Base is derived from U.S.G.S. Topographic maps unless otherwise noted. Other sources of the Land Base may be actual survey data. Base map data is from the April 1995 County Digital Orthophotos and/or U.S.G.S. 1:24,000 scale Topographic series. The user is responsible for the improper use of the data contained herein.

Created by The Columbia County Land Information Office -GIS Section. VMB.
March 2004.

TAX PARCEL MAP

TOWN of LEWISTON

TOWN 13 NORTH RANGE 7 EAST
COLUMBIA COUNTY, WISCONSIN

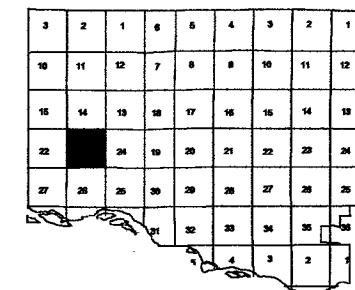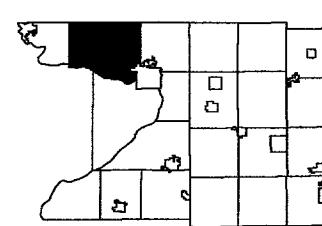

Replaced
2009

-SEE SECTION 14-




-SEE SECTION 22-

-SEE SECTION 24-

-SEE SECTION 26-

-SECTION 23-

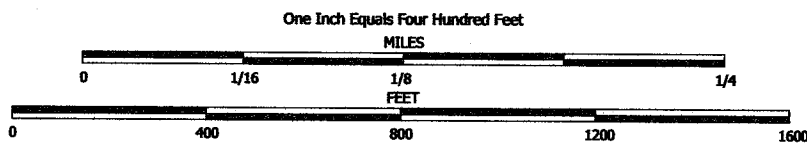


NOTE: This map was prepared for assessment use in accordance with the Wis. St. Stat. Chap. 70.09. All information contained herein is advisory only. Map accuracy is limited to the quality of data obtained from other Public Records. This map is not intended to be a substitute for an actual field survey. Public Land Survey Base is derived from U.S.G.S. Topographic maps unless otherwise noted. Other sources of the Land Base may be actual survey data. Base map data is from the April 1995 County Digital Orthophotos and/or U.S.G.S. 1:24,000 scale Topographic series. The user is responsible for the improper use of the data contained herein.

Created by The Columbia County Land Information Office -GIS Section. VMB.
September 2002.

TAX PARCEL MAP

TOWN of LEWISTON

TOWN 13 NORTH RANGE 7 EAST
COLUMBIA COUNTY, WISCONSIN

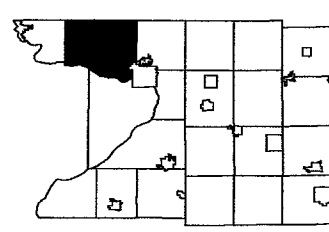

3	2	1	8	6	4	3	2	1
10	11	12	7	5	9	10	11	12
15	14	13	18	17	16	15	14	13
20	21	22	23	24	25	26	27	28
29	30	31	32	33	34	35	36	37
38	39	40	41	42	43	44	45	46

Replaced
2009


-SEE SECTION 15-



-SEE SECTION 27-

-SECTION 22-

2009

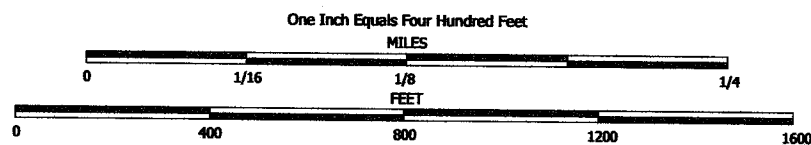


NOTE: This map was prepared for assessment use in accordance with the Wis. St. Stat. Chap. 70.09. All information contained herein is advisory only. Map accuracy is limited to the quality of data obtained from other Public Records. This map is not intended to be a substitute for an actual field survey. Public Land Survey Base is derived from U.S.G.S. Topographic maps unless otherwise noted. Other sources of the Land Base may be actual survey data. Base map data is from the April 1995 County Digital Orthophotos and/or U.S.G.S. 1:24,000 scale Topographic series. The user is responsible for the improper use of the data contained herein.

Created by The Columbia County Land Information Office -GIS Section. VMB.
September 2002.

TAX PARCEL MAP

TOWN of LEWISTON


TOWN 13 NORTH RANGE 7 EAST
COLUMBIA COUNTY, WISCONSIN

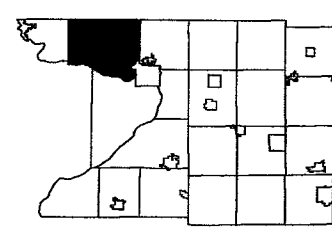

1	2	3	4	5	6	7	8	9	10	11	12
13	14	15	16	17	18	19	20	21	22	23	24
25	26	27	28	29	30	31	32	33	34	35	36


-SEE SECTION 10-

Replaced
2009

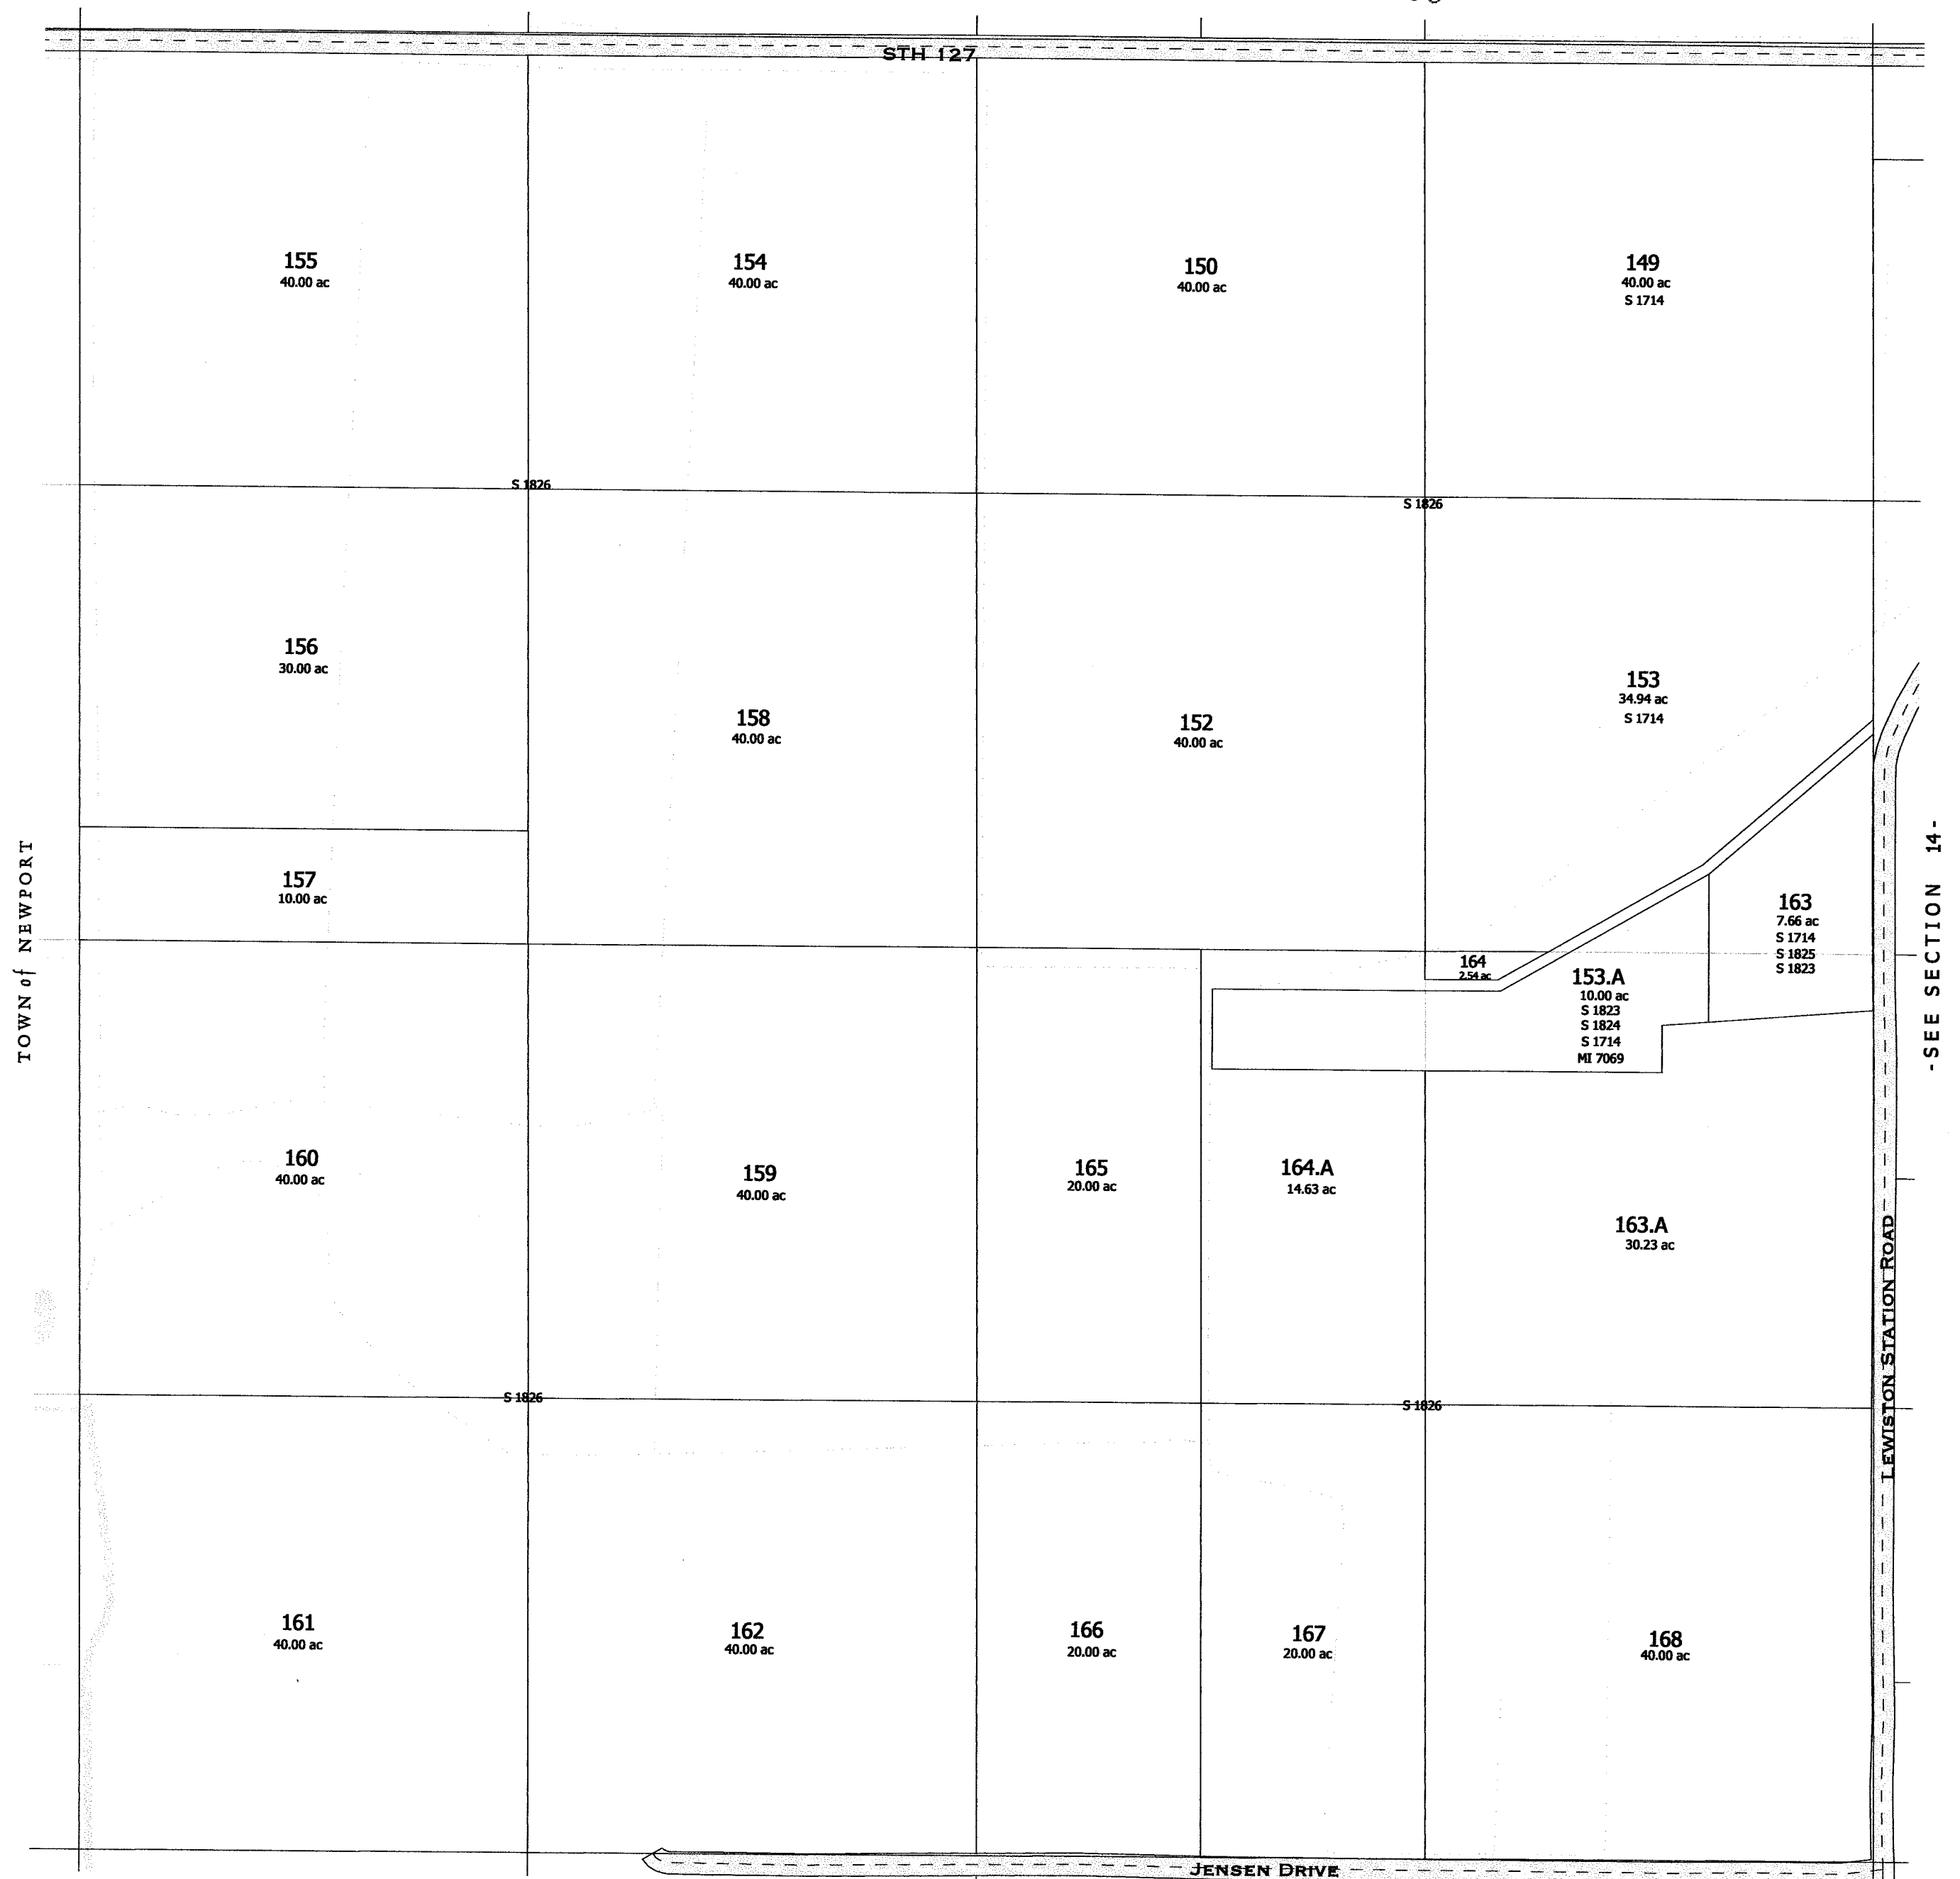

-SEE SECTION 22-

-SECTION 15-

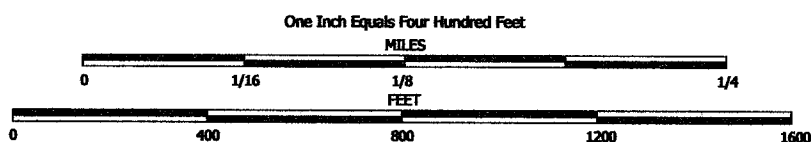


NOTE: This map was prepared for assessment use in accordance with the Wis. St. Stat. Chap. 70.09. All information contained herein is advisory only. Map accuracy is limited to the quality of data obtained from other Public Records. This map is not intended to be a substitute for an actual field survey. Public Land Survey Base is derived from U.S.G.S. Topographic maps unless otherwise noted. Other sources of the Land Base may be actual survey data. Base map data is from the April 1995 County Digital Orthophotos and/or U.S.G.S. 1:24,000 scale Topographic series. The user is responsible for the improper use of the data contained herein.

Created by The Columbia County Land Information Office -GIS Section. VMB.
February 2006.

TAX PARCEL MAP

TOWN of LEWISTON

TOWN 13 NORTH RANGE 7 EAST
COLUMBIA COUNTY, WISCONSIN

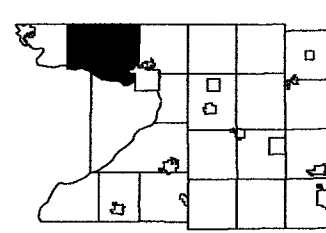

3	2	1	8	6	4	3	2	1
10	11	12	7	5	9	10	11	12
15	16	17	18	17	16	15	14	13
22	23	24	19	20	21	22	23	24
27	28	29	30	29	28	27	26	25
32	33	34	35	36	37	38	39	40

Replaced
2009

-SEE SECTION 11-




-SEE SECTION 15-

-SEE SECTION 13-

-SEE SECTION 23-

-SECTION 14-

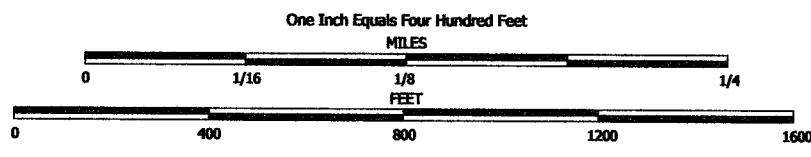


NOTE: This map was prepared for assessment use in accordance with the Wis. Stat. Chap. 70.09. All information contained herein is advisory only. Map accuracy is limited to the quality of data obtained from other Public Records. This map is not intended to be a substitute for an actual field survey. Public Land Survey Base is derived from U.S.G.S. Topographic maps unless otherwise noted. Other sources of the Land Base may be actual survey data. Base map data is from the April 1995 County Digital Orthophotos and/or U.S.G.S. 1:24,000 scale Topographic series. The user is responsible for the improper use of the data contained herein.

Created by The Columbia County Land Information Office -GIS Section. VMB.
February 2006.

TAX PARCEL MAP


TOWN of LEWISTON

TOWN 13 NORTH RANGE 7 EAST
COLUMBIA COUNTY, WISCONSIN

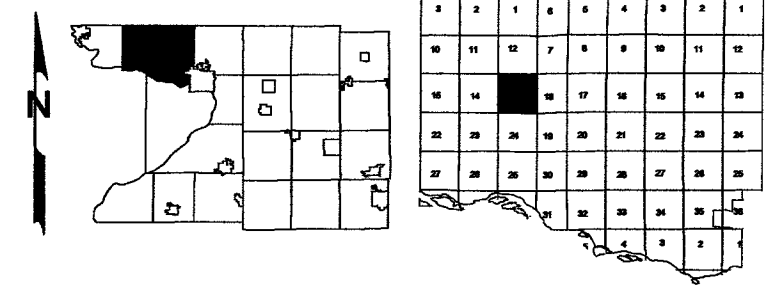

Replaced
2009

-SEE SECTION 12-

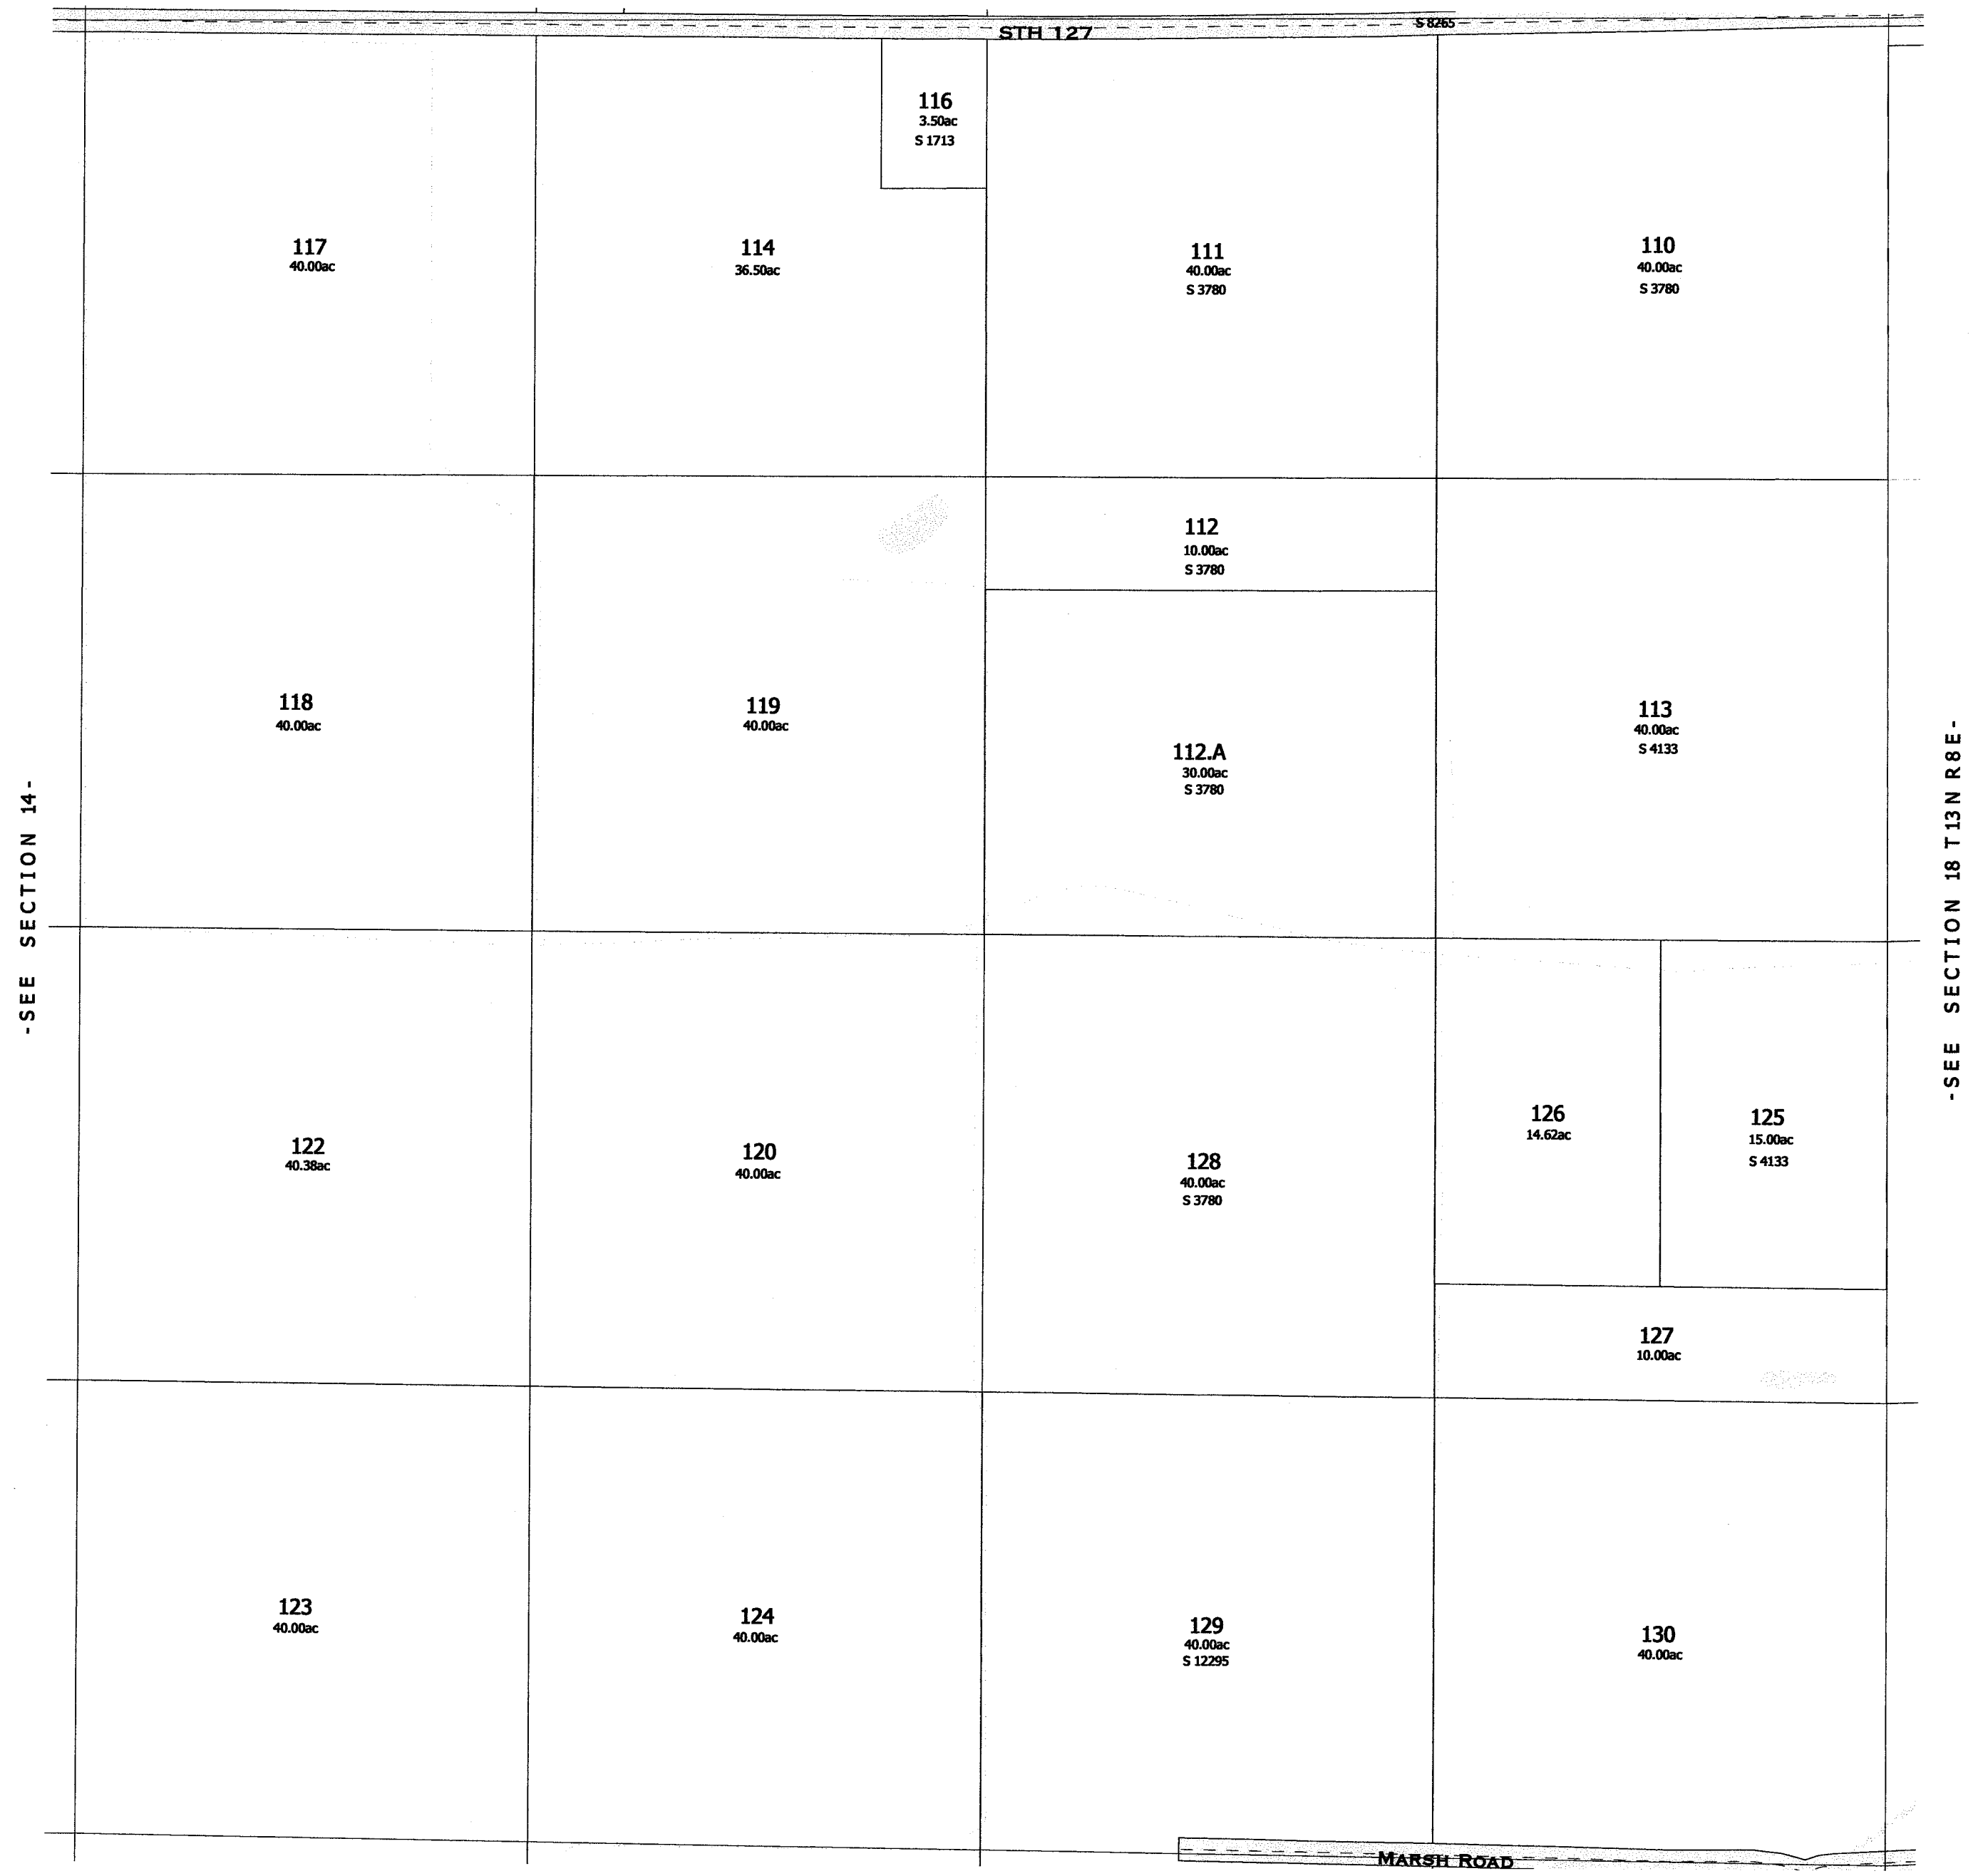


-SEE SECTION 14-

-SEE SECTION 18 T 13N R 8E-

-SEE SECTION 24-

-SECTION 13-

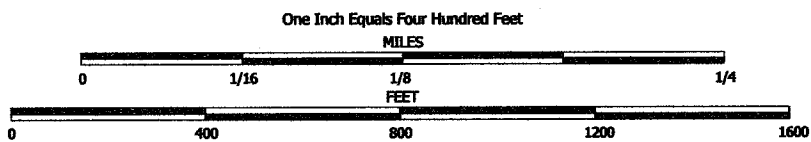



NOTE: This map was prepared for assessment use in accordance with the Wis. St. Stat. Chap. 70.09. All information contained herein is advisory only. Map accuracy is limited to the quality of data obtained from other Public Records. This map is not intended to be a substitute for an actual field survey. Public Land Survey Base is derived from U.S.G.S. Topographic maps unless otherwise noted. Other sources of the Land Base may be actual survey data. Base map data is from the April 1995 County Digital Orthophotos and/or U.S.G.S. 1:24,000 scale Topographic series. The user is responsible for the improper use of the data contained herein.

Created by The Columbia County Land Information Office -GIS Section. VMB.
March 2004.

TAX PARCEL MAP


TOWN of LEWISTON

TOWN 13 NORTH RANGE 7 EAST
COLUMBIA COUNTY, WISCONSIN

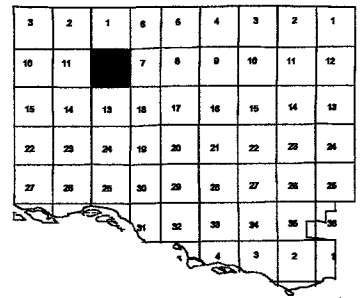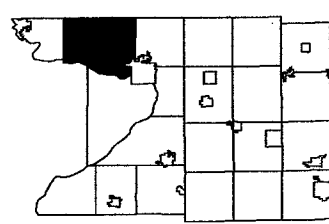

Replaced
2009


-SEE SECTION 1-

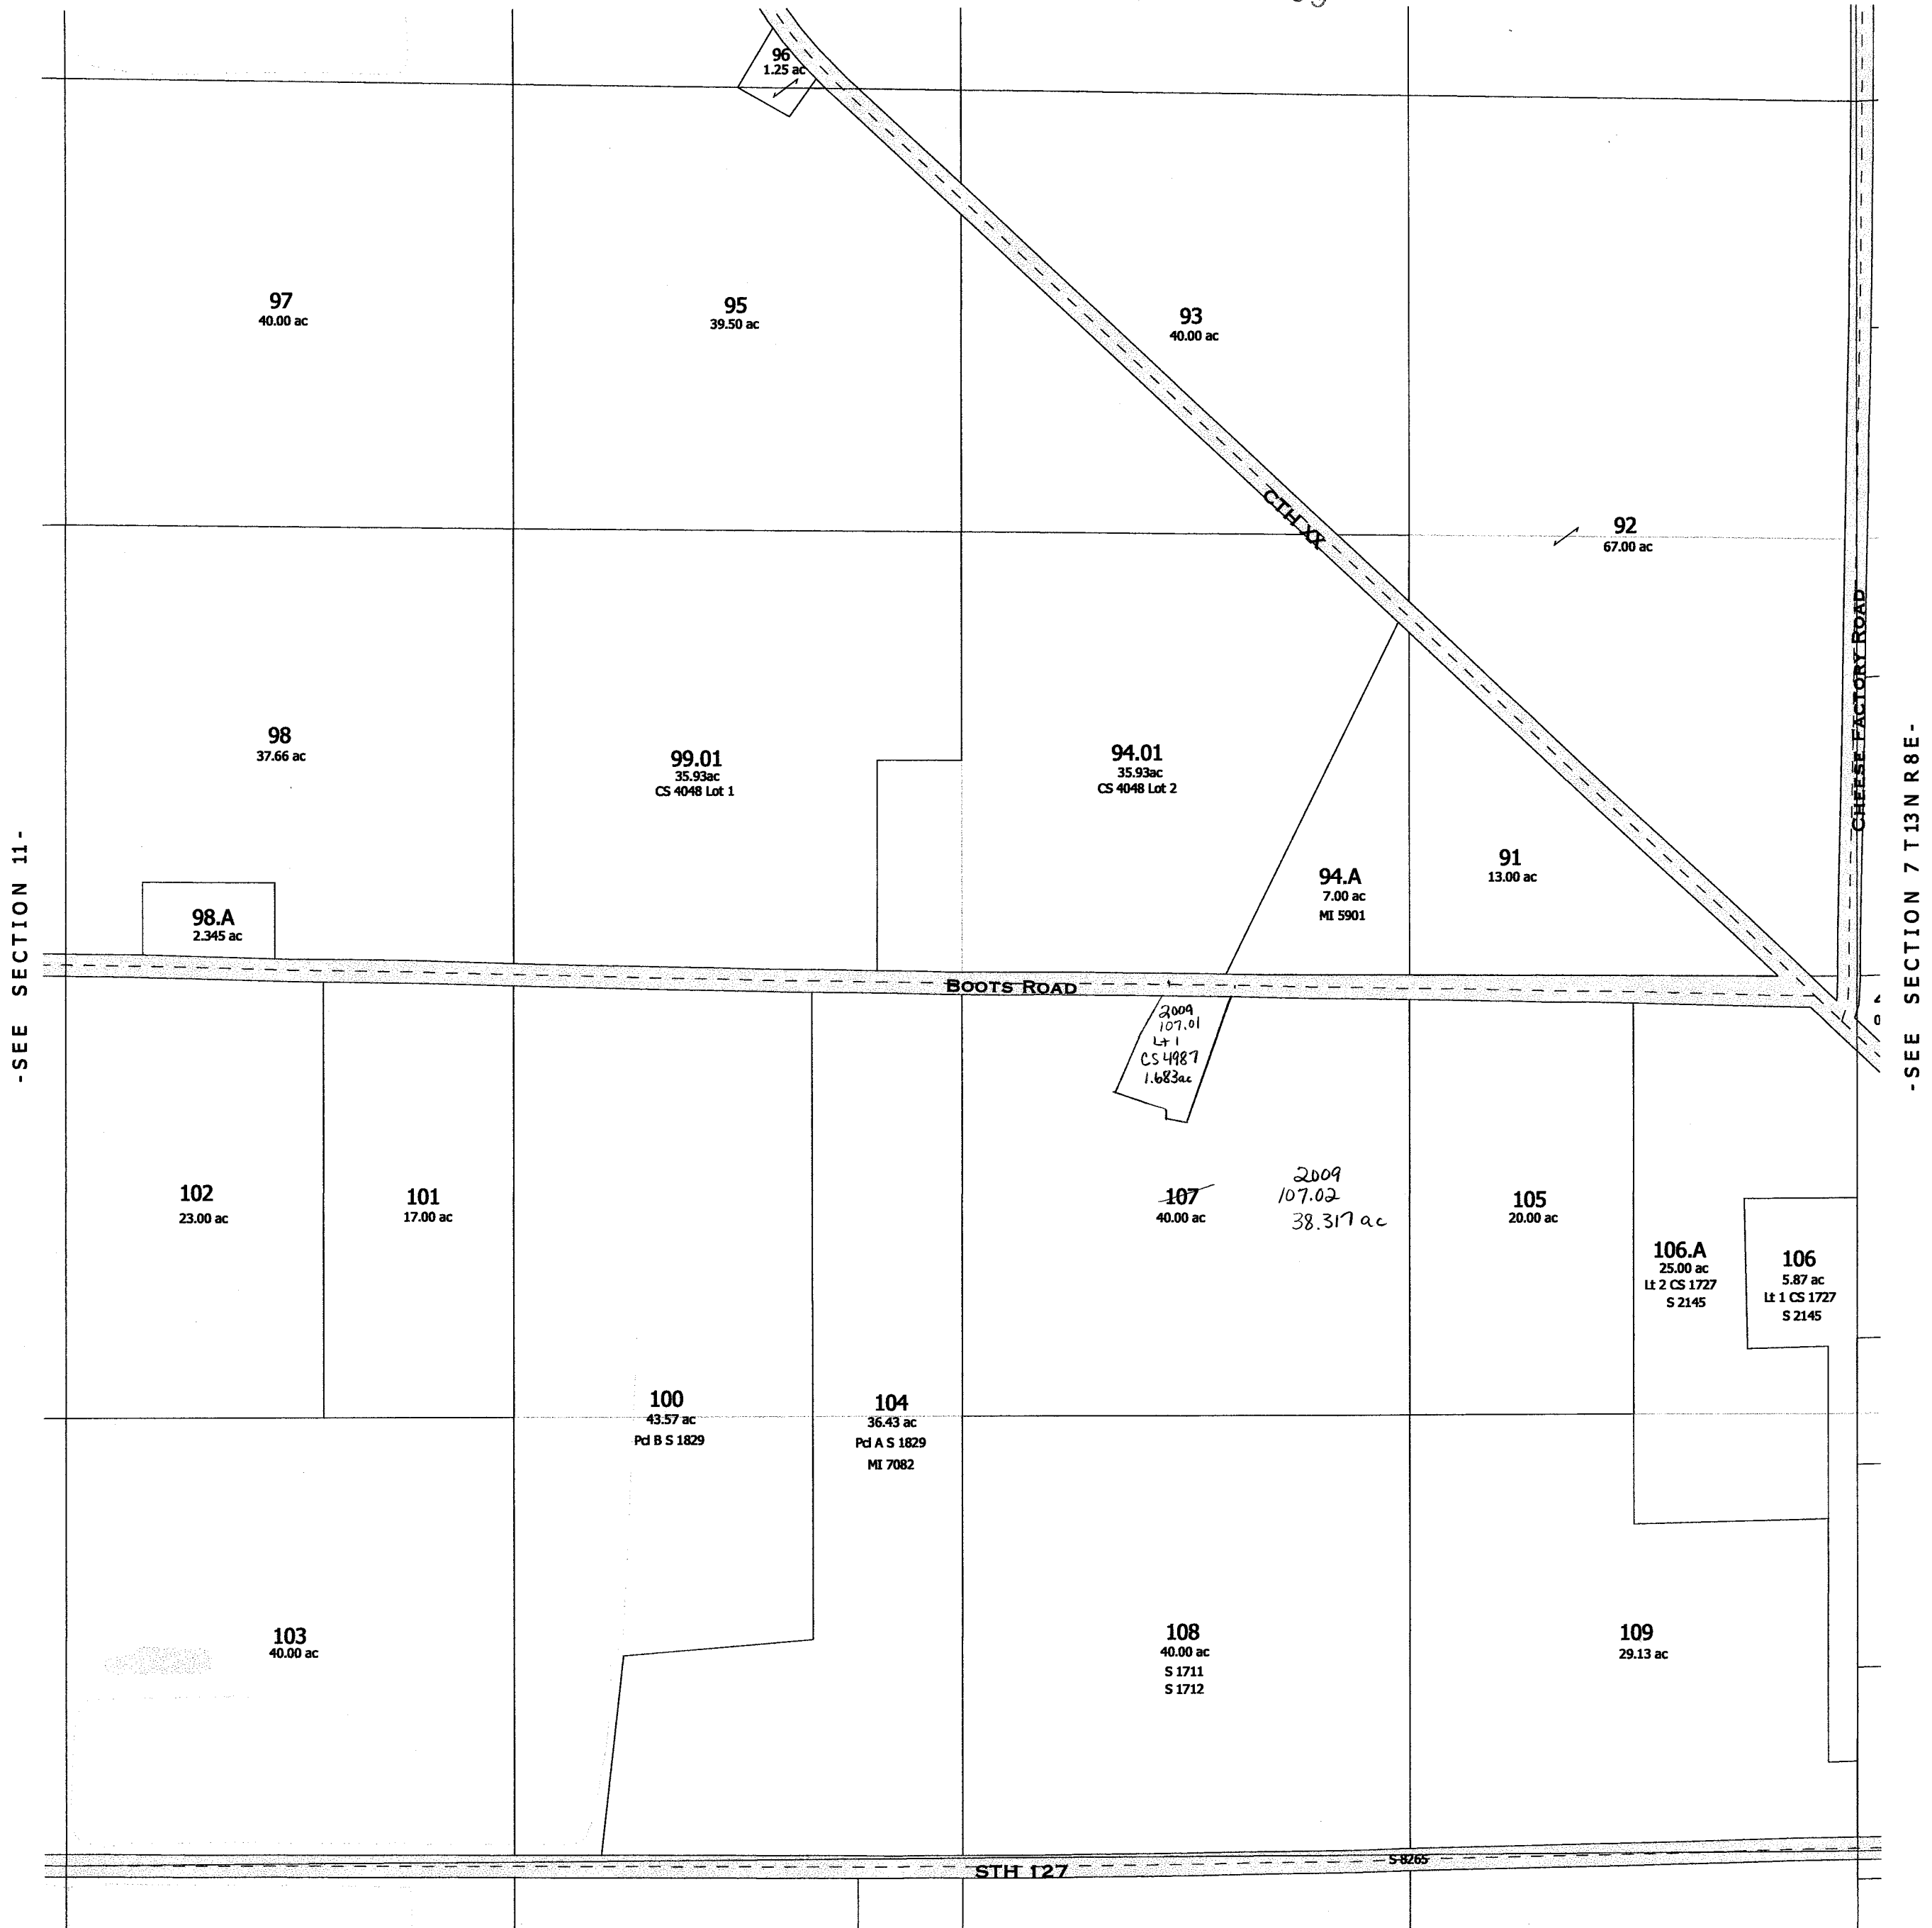

-SEE SECTION 13-

-SECTION 12-

2009

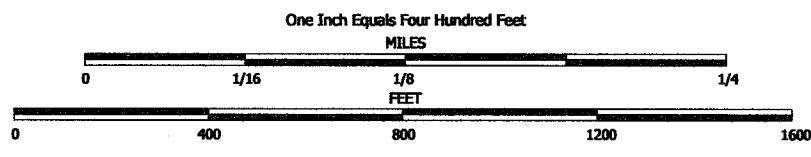


NOTE: This map was prepared for assessment use in accordance with the Wis. Stat. Chap. 70.09. All information contained herein is advisory only. Map accuracy is limited to the quality of data obtained from other Public Records. This map is not intended to be a substitute for an actual field survey. Public Land Survey Base is derived from U.S.G.S. Topographic maps unless otherwise noted. Other sources of the Land Base may be actual survey data. Base map data is from the April 1995 County Digital Orthophotos and/or U.S.G.S. 1:24,000 scale Topographic series. The user is responsible for the improper use of the data contained herein.

Created by The Columbia County Land Information Office -GIS Section. VMB.
September 2002.

TAX PARCEL MAP

TOWN of LEWISTON

TOWN 13 NORTH RANGE 7 EAST
COLUMBIA COUNTY, WISCONSIN

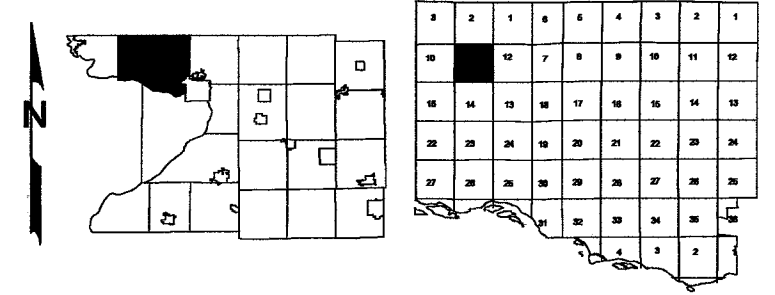


Replaced
2009

-SEE SECTION 2-



-SEE SECTION 14-

-SECTION 11-

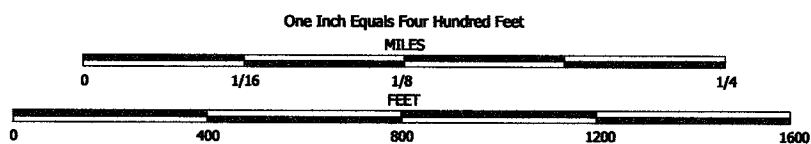


NOTE: This map was prepared for assessment use in accordance with the Wis. St. Stat. Chap. 70.09. All information contained herein is advisory only. Map accuracy is limited to the quality of data obtained from other Public Records. This map is not intended to be a substitute for an actual field survey. Public Land Survey Base is derived from U.S.G.S. Topographic maps unless otherwise noted. Other sources of the Land Base may be actual survey data. Base map data is from the April 1995 County Digital Orthophotos and/or U.S.G.S. 1:24,000 scale Topographic series. The user is responsible for the improper use of the data contained herein.

Created by The Columbia County Land Information Office -GIS Section. VMB.
September 2002.

TAX PARCEL MAP

TOWN of LEWISTON


TOWN 13 NORTH RANGE 7 EAST
COLUMBIA COUNTY, WISCONSIN

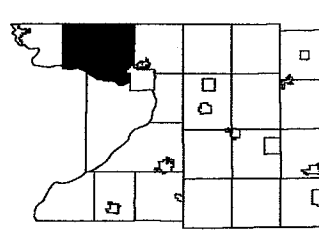

3	2	1	8	5	4	3	2	1
11	12	7	6	9	10	11	12	
15	16	13	14	17	18	19	14	13
22	23	24	19	20	21	22	23	24
27	28	25	26	29	28	27	26	25

Replaced
2009

-SEE SECTION 3-

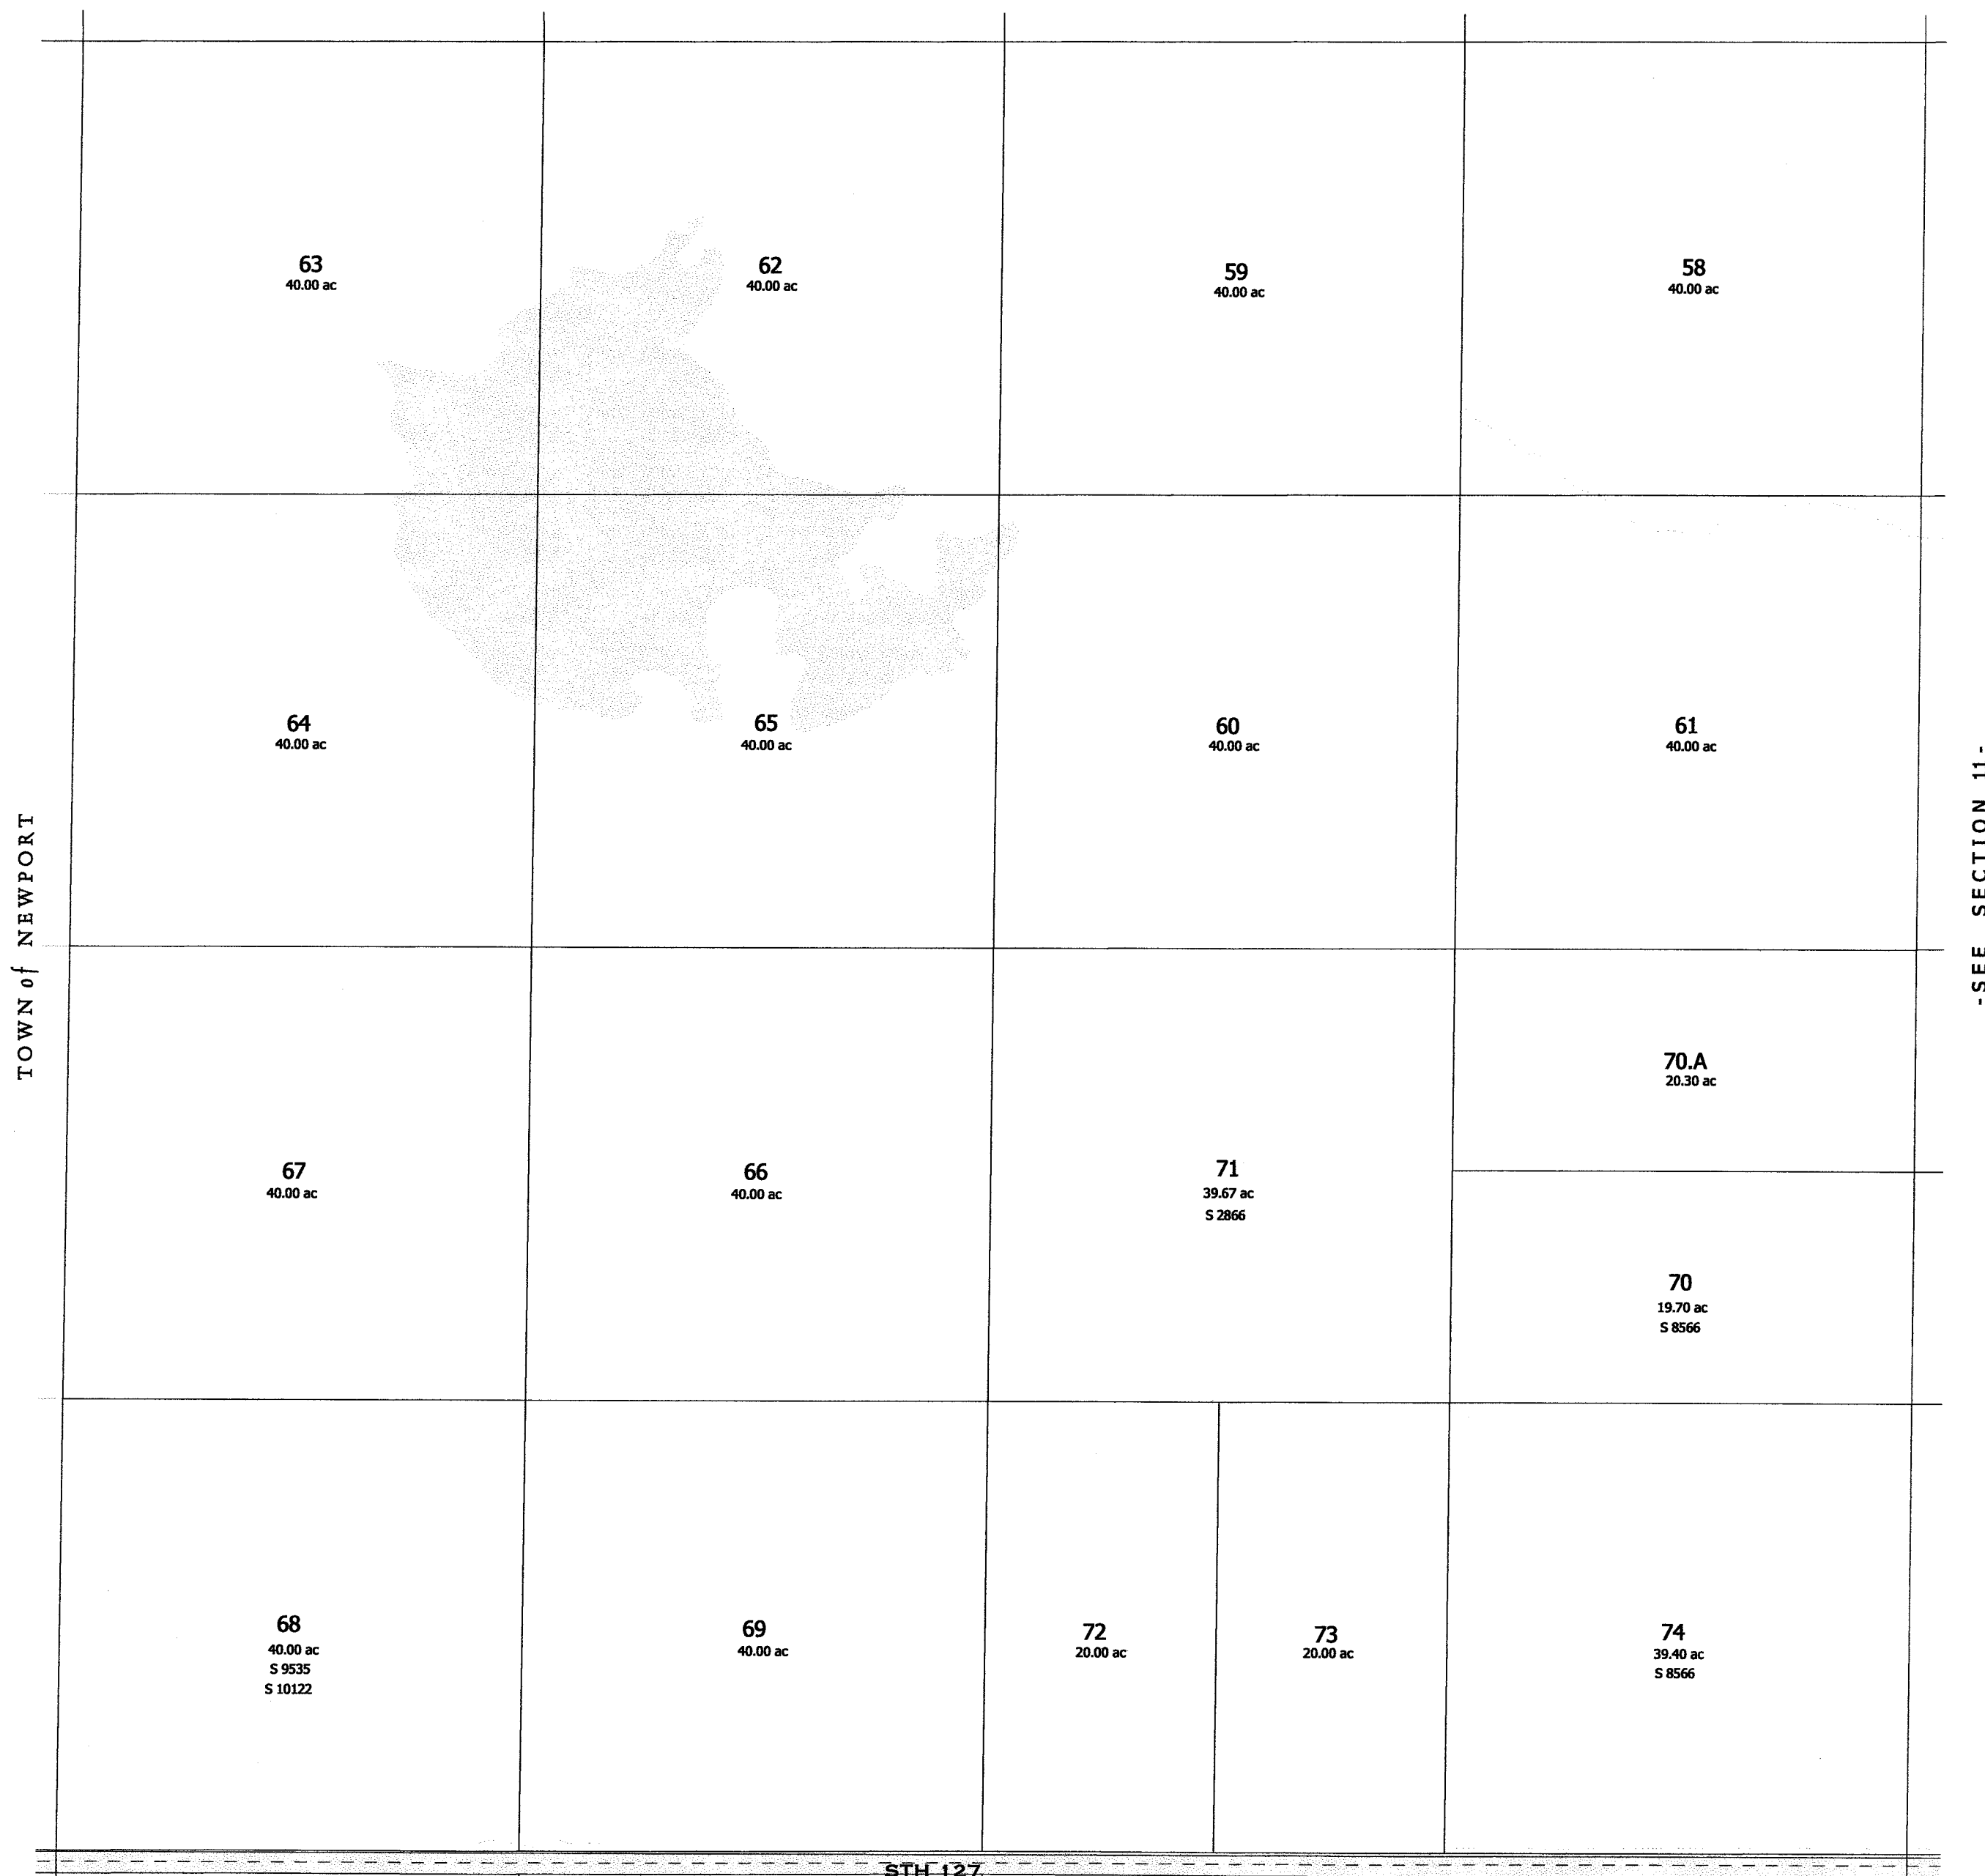


-SEE SECTION 11-

STH 127

-SEE SECTION 15-

-SECTION 10-

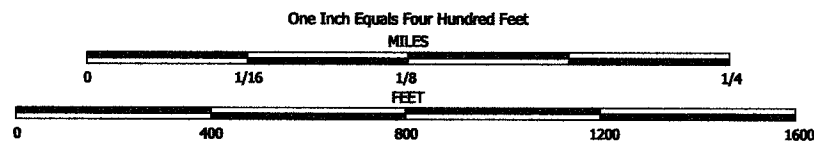


NOTE: This map was prepared for assessment use in accordance with the Wis. St. Stat. Chap. 70.09. All information contained herein is advisory only. Map accuracy is limited to the quality of data obtained from other Public Records. This map is not intended to be a substitute for an actual field survey. Public Land Survey Base is derived from U.S.G.S. Topographic maps unless otherwise noted. Other sources of the Land Base may be actual survey data. Base map data is from the April 1995 County Digital Orthophotos and/or U.S.G.S. 1:24,000 scale Topographic series. The user is responsible for the improper use of the data contained herein.

Created by The Columbia County Land Information Office -GIS Section. VMB.
February 2005.

TAX PARCEL MAP


TOWN of LEWISTON

TOWN 13 NORTH RANGE 7 EAST
COLUMBIA COUNTY, WISCONSIN

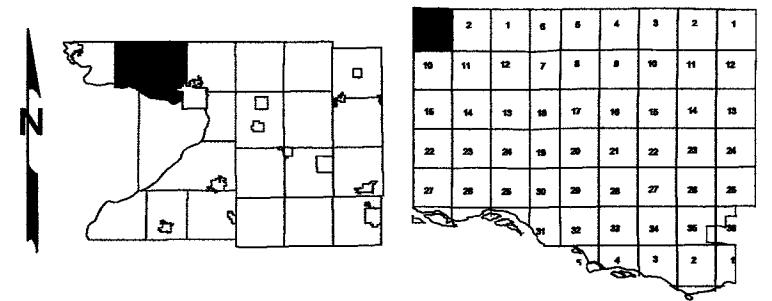

Replaced
2009



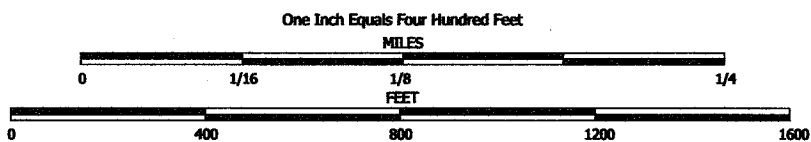



NOTE: This map was prepared for assessment use in accordance with the Wis. St. Stat. Chap. 70.09. All information contained herein is advisory only. Map accuracy is limited to the quality of data obtained from other Public Records. This map is not intended to be a substitute for an actual field survey. Public Land Survey Base is derived from U.S.G.S Topographic maps unless otherwise noted. Other sources of the Land Base may be actual survey data. Base map data is from the April 1995 County Digital Orthophotos and/or U.S.G.S. 1:24,000 scale Topographic series. The user is responsible for the improper use of the data contained herein.

Created by The Columbia County Land Information Office -GIS Section. VMB.
February 2006.

TAX PARCEL MAP


TOWN of LEWISTON

TOWN 13 NORTH RANGE 7 EAST
COLUMBIA COUNTY, WISCONSIN

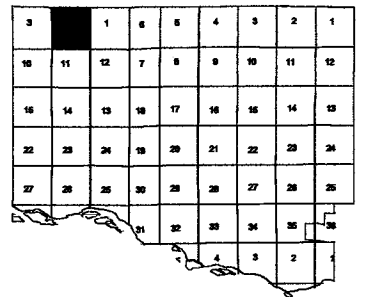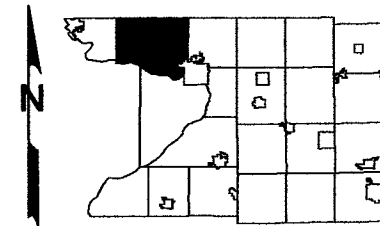

Replaced
2009

ADAMS COUNTY

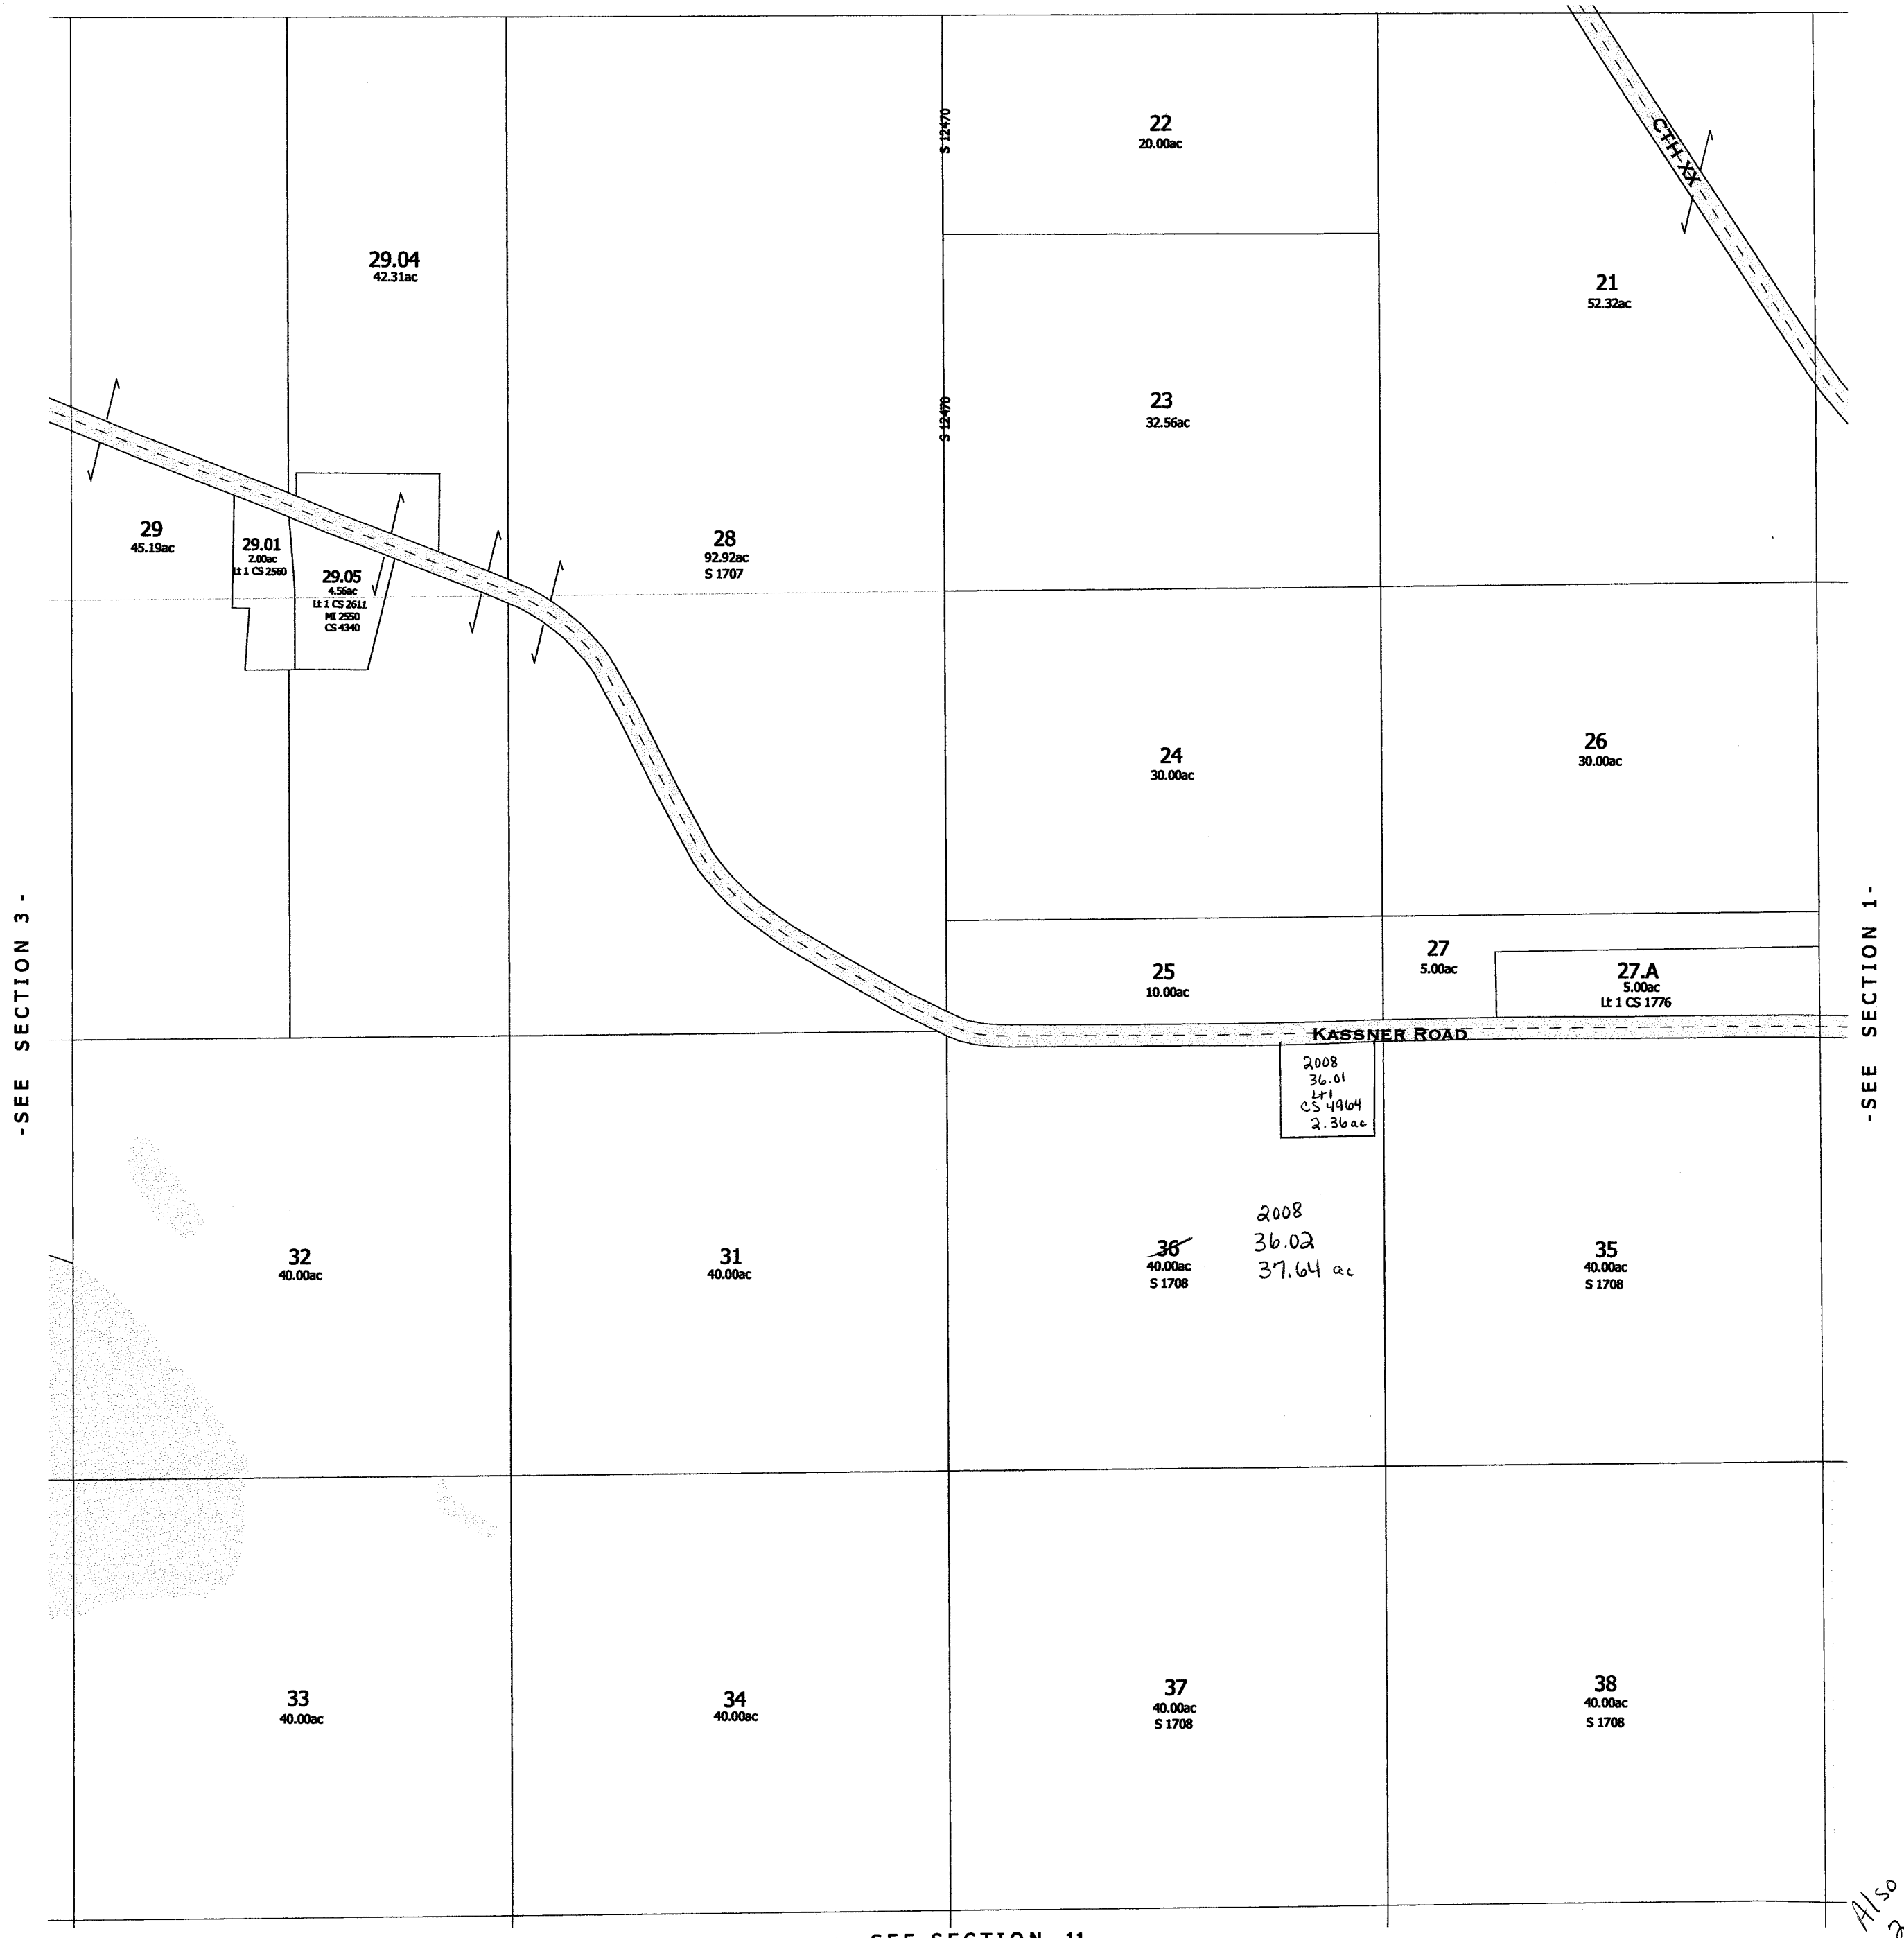

Also
2008

-SECTION 2-

One Inch Equals Four Hundred Feet
MILES
0 1/16 1/8 1/4
FEET
0 400 800 1200 1600


NOTE: This map was prepared for assessment use in accordance with the Wis. Stat. Chap. 70.09. All information contained herein is advisory only. Map accuracy is limited to the quality of data obtained from other Public Records. This map is not intended to be a substitute for an actual field survey. Public Land Survey Base is derived from U.S.G.S. Topographic maps unless otherwise noted. Other sources of the Land Base may be actual survey data. Base map data is from the April 1995 County Digital Orthophotos and/or U.S.G.S. 1:24,000 scale Topographic series. The user is responsible for the improper use of the data contained herein.

Created by The Columbia County Land Information Office -GIS Section. VMB.
September 2002.

TAX PARCEL MAP

TOWN of LEWISTON

TOWN 13 NORTH RANGE 7 EAST
COLUMBIA COUNTY, WISCONSIN

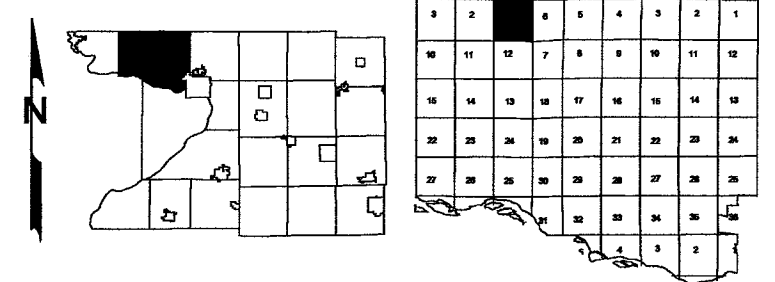


Adams ~~MARQUETTE~~ COUNTY

Replaced
2009



Also
2008

-SECTION 1-

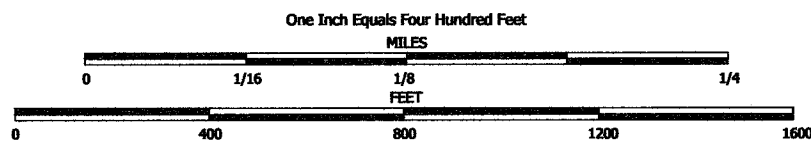


NOTE: This map was prepared for assessment use in accordance with the Wis. St. Stat. Chap. 70.09. All information contained herein is advisory only. Map accuracy is limited to the quality of data obtained from other Public Records. This map is not intended to be a substitute for an actual field survey. Public Land Survey Base is derived from U.S.G.S. Topographic maps unless otherwise noted. Other sources of the Land Base may be actual survey data. Base map data is from the April 1995 County Digital Orthophotos and/or U.S.G.S. 1:24,000 scale Topographic series. The user is responsible for the improper use of the data contained herein.

Created by The Columbia County Land Information Office -GIS Section. VMB.
March 2004.

TAX PARCEL MAP

TOWN of LEWISTON

TOWN 12 NORTH RANGE 8 EAST
COLUMBIA COUNTY, WISCONSIN

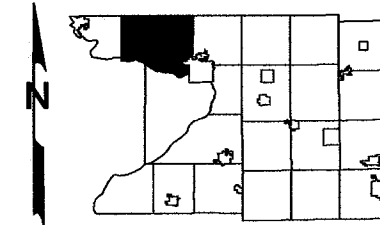

3	2	1	6	5	4	3	2	1
10	11	12	7	8	9	10	11	12
16	14	13	15	17	16	14	13	15
22	23	24	25	26	27	28	29	30
27	28	29	30	31	32	33	34	35
36	37	38	39	40	41	42	43	44

Replaced
2009

-SEE SECTION 1-



-SEE SECTION 11-

-SEE SECTION 13-

-SECTION 12-

One Inch Equals Four Hundred Feet

MILES
0 1/16 1/8 1/4
FEET
0 400 800 1200 1600


NOTE: This map was prepared for assessment use in accordance with the Wis. St. Stat. Chap. 70.09. All information contained herein is advisory only. Map accuracy is limited to the quality of data obtained from other Public Records. This map is not intended to be a substitute for an actual field survey. Public Land Survey Base is derived from U.S.G.S Topographic maps unless otherwise noted. Other sources of the Land Base may be actual survey data. Base map data is from the April 1995 County Digital Orthophotos and/or U.S.G.S. 1:24,000 scale Topographic series. The user is responsible for the improper use of the data contained herein.

Created by The Columbia County Land Information Office -GIS Section. VMB.
February 2003.

TAX PARCEL MAP


TOWN of LEWISTON

TOWN 12 NORTH RANGE 8 EAST
COLUMBIA COUNTY, WISCONSIN

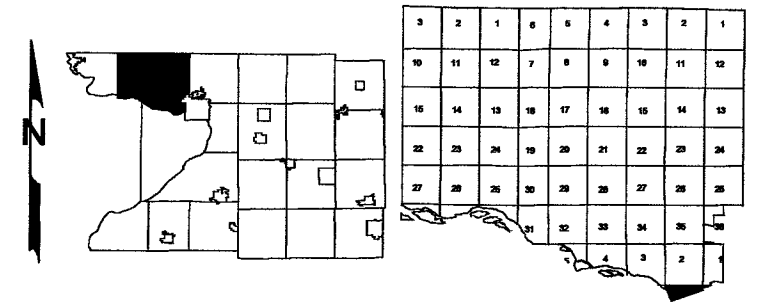

-SEE SECTION 2-

Replaced
2009

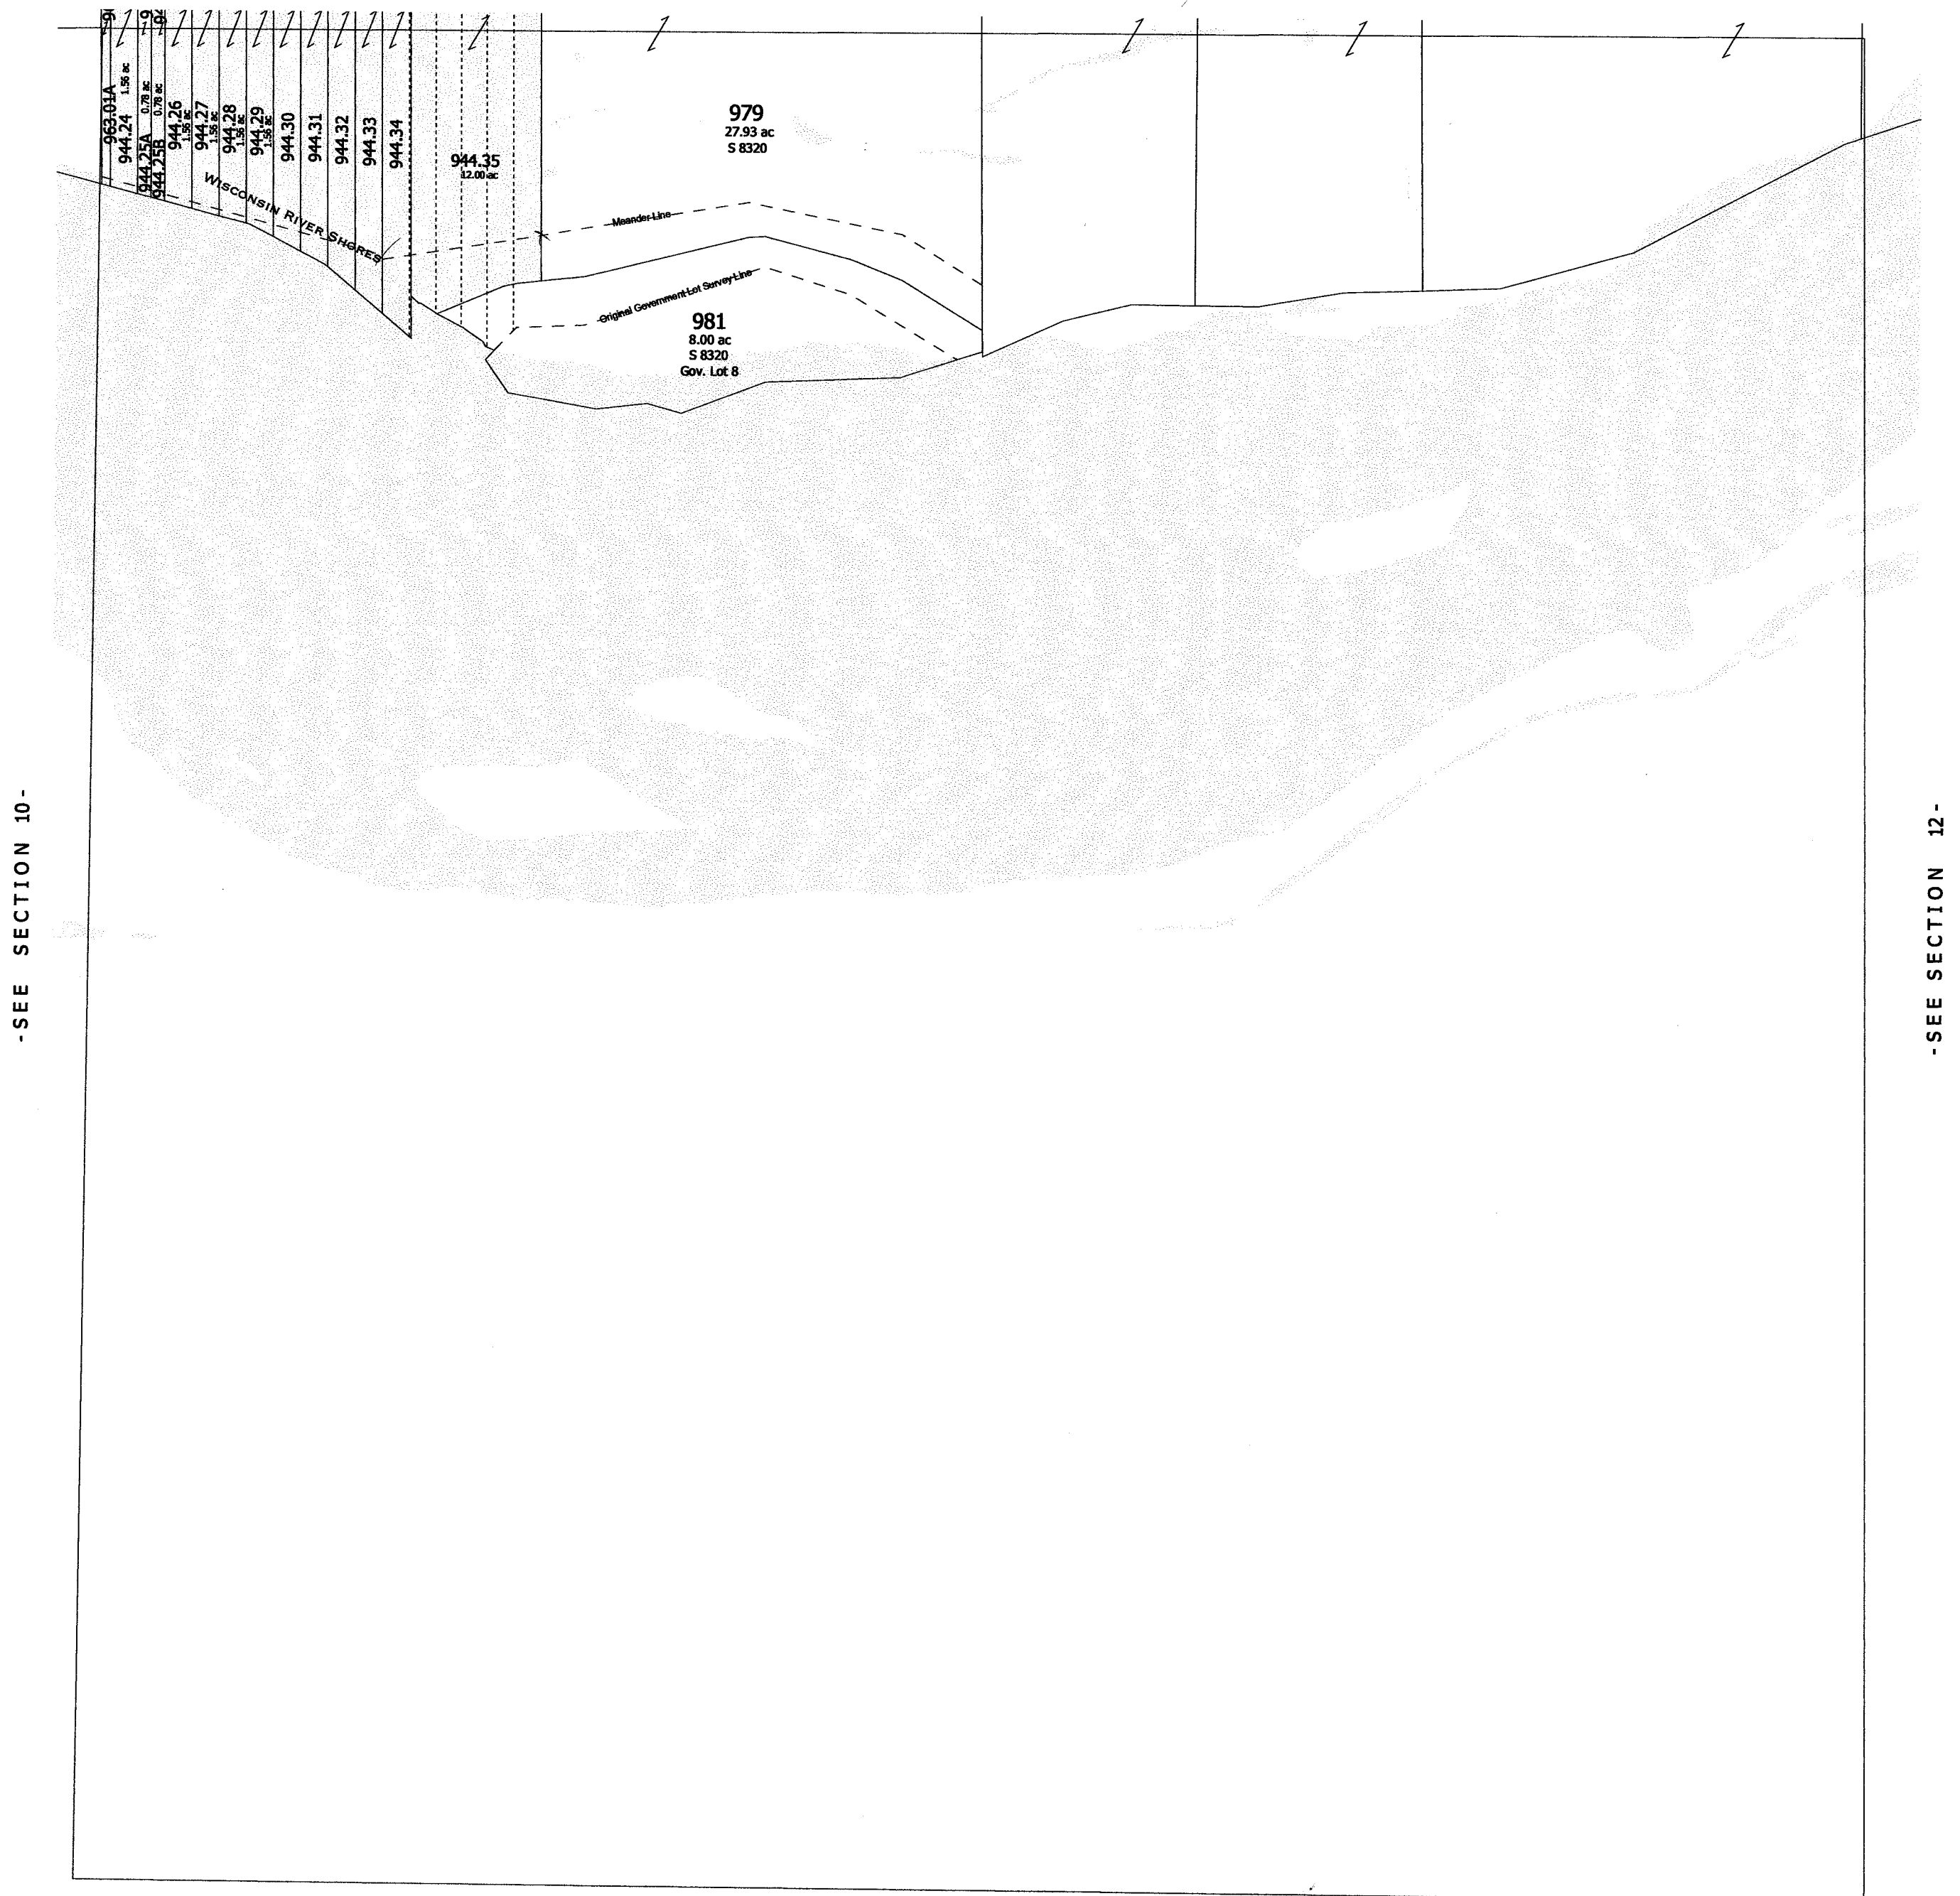


-SEE SECTION 10-

-SEE SECTION 12-

TOWN of CALEDONIA

-SECTION 11-

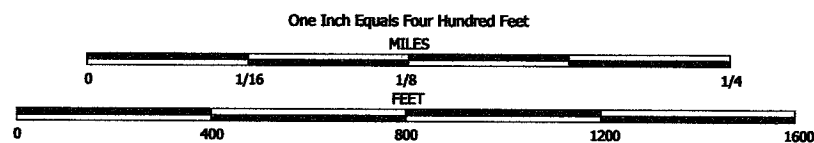


NOTE: This map was prepared for assessment use in accordance with the Wis. St. Stat. Chap. 70.09. All information contained herein is advisory only. Map accuracy is limited to the quality of data obtained from other Public Records. This map is not intended to be a substitute for an actual field survey. Public Land Survey Base is derived from U.S.G.S Topographic maps unless otherwise noted. Other sources of the Land Base may be actual survey data. Base map data is from the April 1995 County Digital Orthophotos and/or U.S.G.S. 1:24,000 scale Topographic series. The user is responsible for the improper use of the data contained herein.

Created by The Columbia County Land Information Office -GIS Section. VMB.
February 2003.

TAX PARCEL MAP

TOWN of LEWISTON

TOWN 12 NORTH RANGE 8 EAST
COLUMBIA COUNTY, WISCONSIN

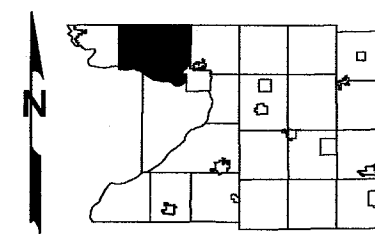

3	2	1	8	5	4	3	2	1
10	11	12	7	6	5	4	3	2
19	14	13	18	17	16	15	14	13
22	23	24	19	20	21	22	23	24
27	28	29	25	26	27	28	29	30
33	34	35	30	31	32	33	34	35


Replaced
2009

-SEE SECTION 3-

980
1.62 ac
S 1869
S 1705

TOWN of CALEDONIA

-SEE SECTION 11-

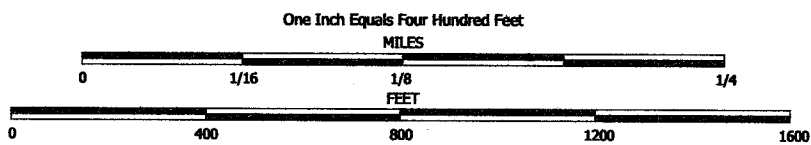


NOTE: This map was prepared for assessment use in accordance with the Wis. St. Stat. Chap. 70.09. All information contained herein is advisory only. Map accuracy is limited to the quality of data obtained from other Public Records. This map is not intended to be a substitute for an actual field survey. Public Land Survey Base is derived from U.S.G.S. Topographic maps unless otherwise noted. Other sources of the Land Base may be actual survey data. Base map data is from the April 1995 County Digital Orthophotos and/or U.S.G.S. 1:24,000 scale Topographic series. The user is responsible for the improper use of the data contained herein.

Created by The Columbia County Land Information Office -GIS Section. VMB.
February 2003.

TAX PARCEL MAP


TOWN of LEWISTON

TOWN 12 NORTH RANGE 8 EAST
COLUMBIA COUNTY, WISCONSIN

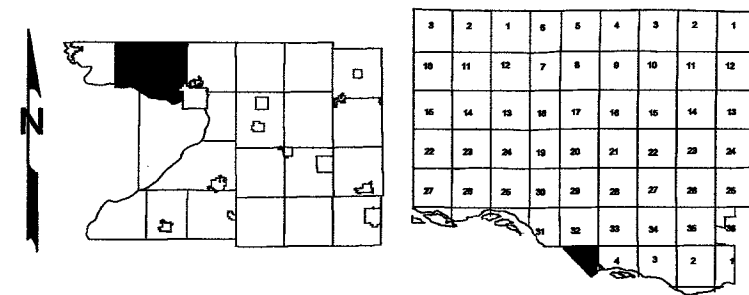

Replaced
2009

-SEE SECTION 32 T13N R8E-

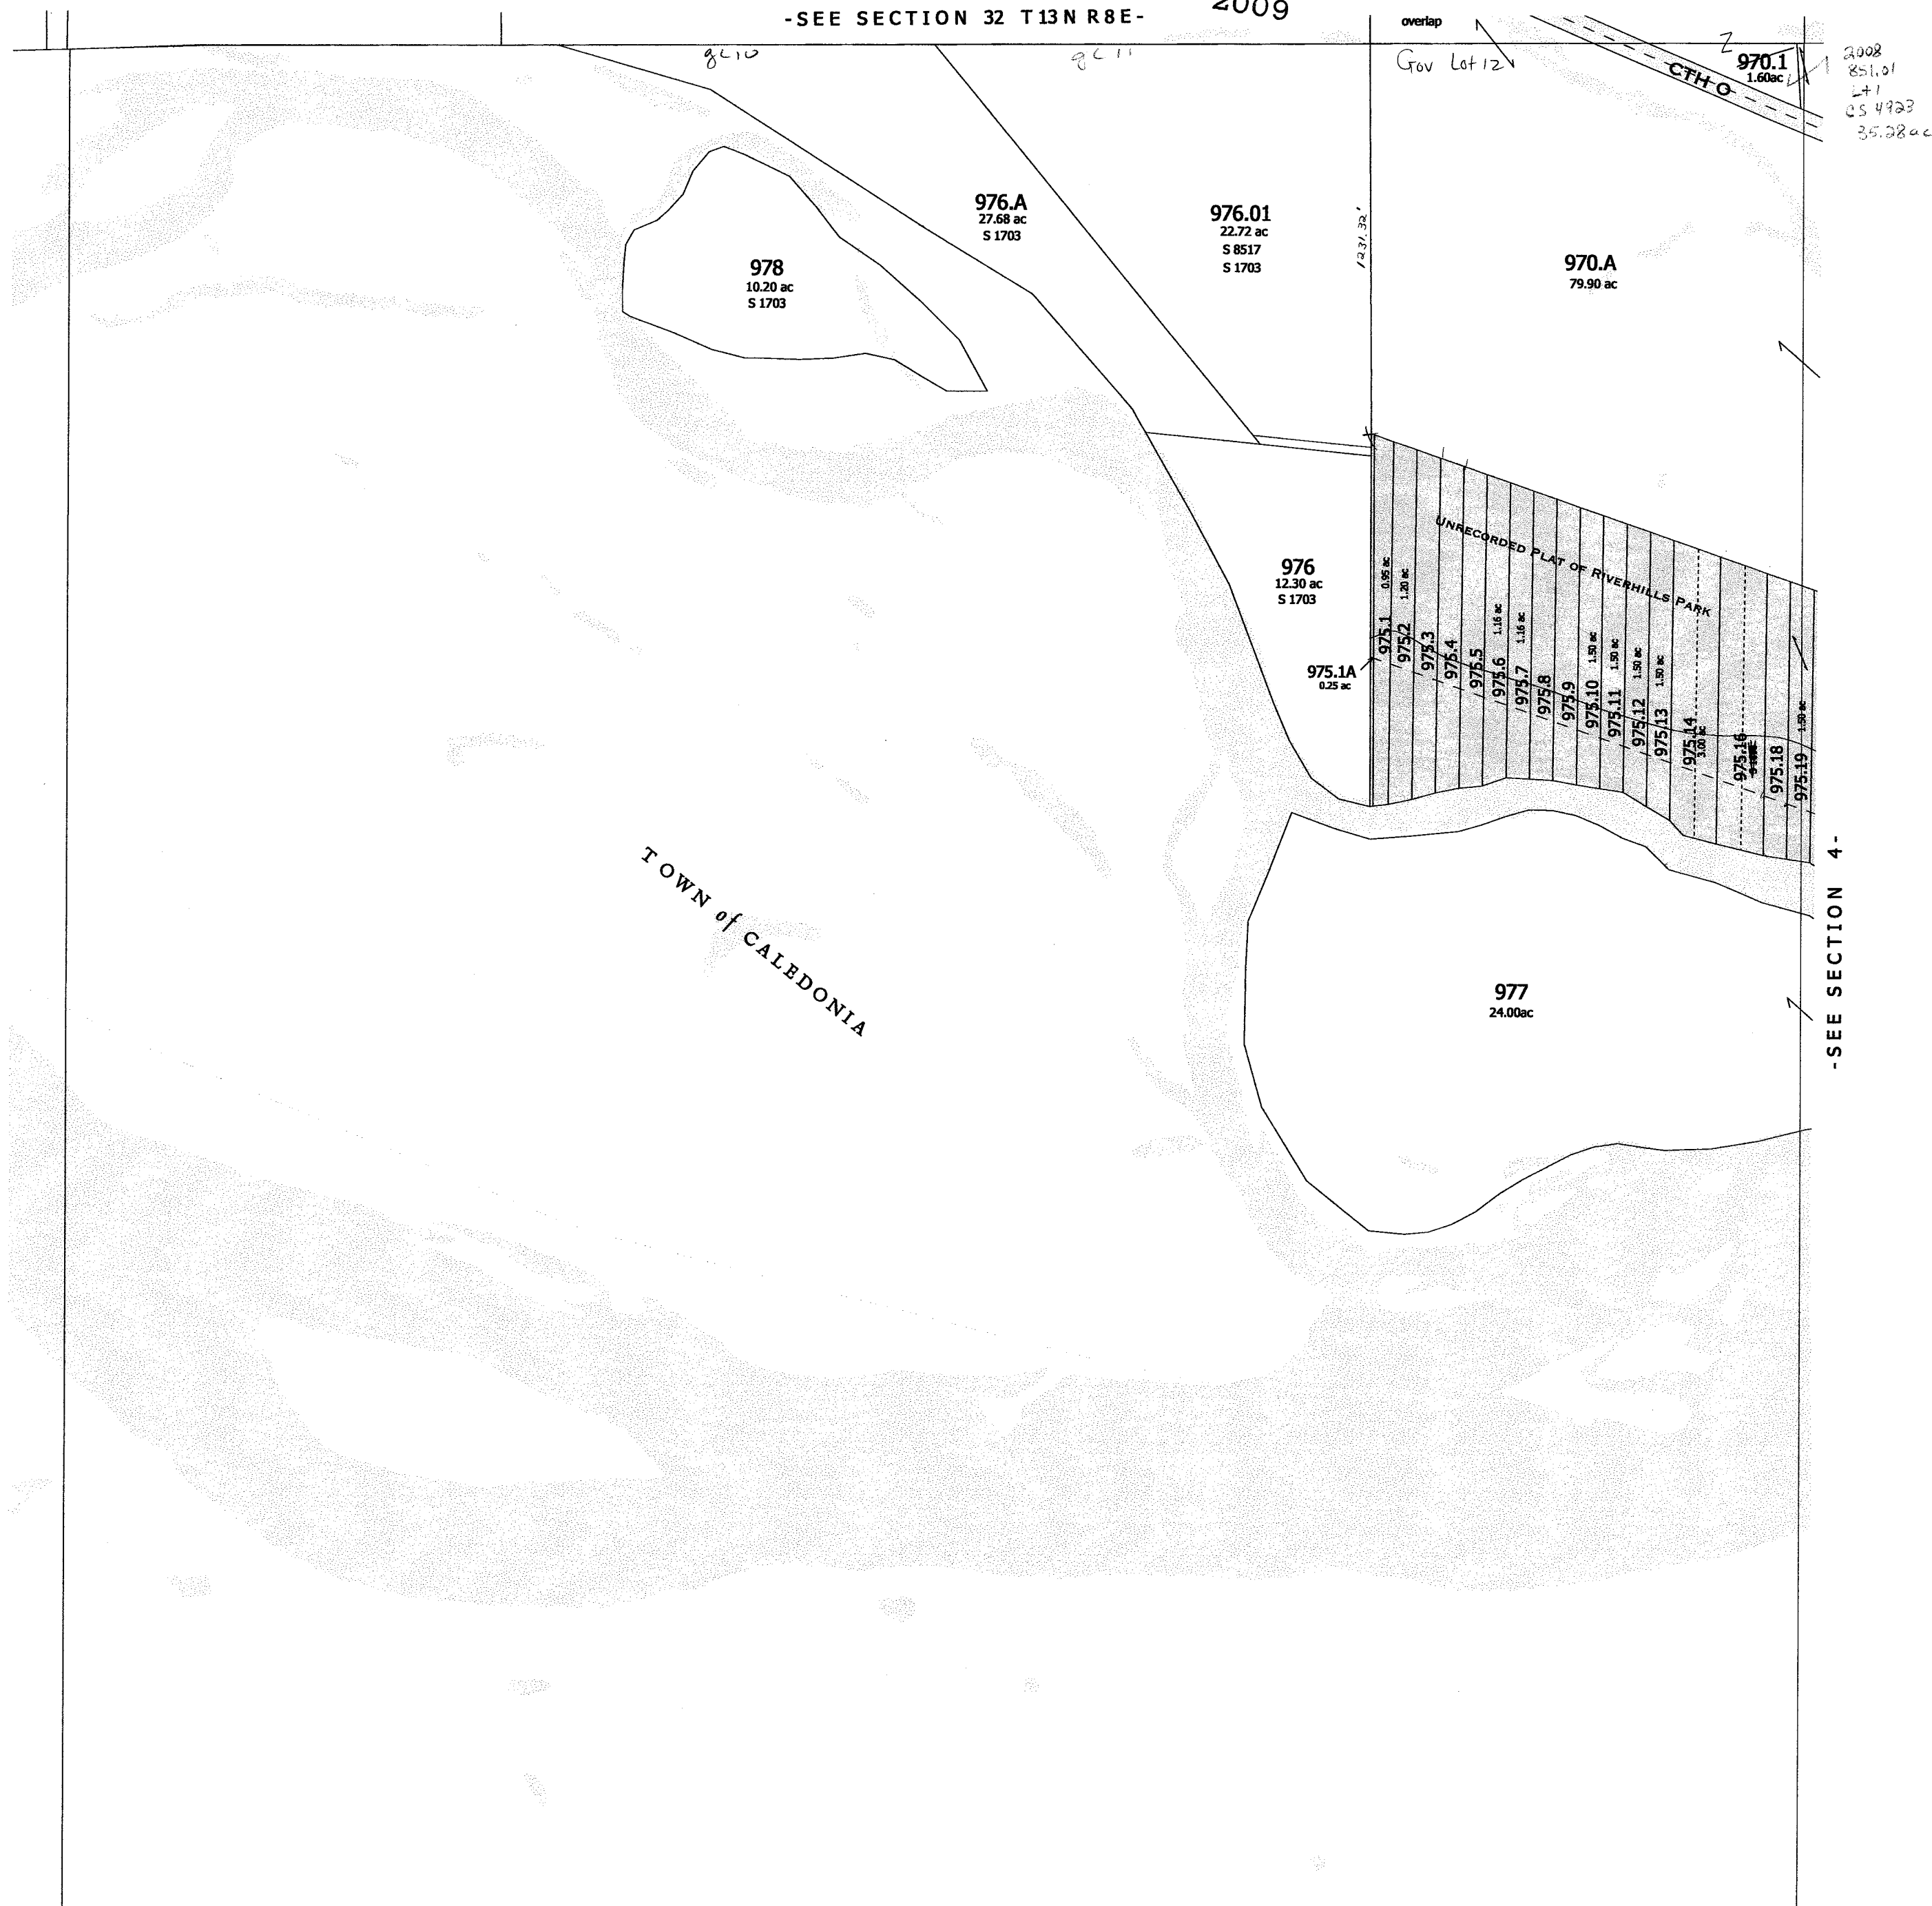


-SEE SECTION 4-

2008
851.01
L+1
CS 4923
35.28 ac

Also
2008

-SECTION 5-

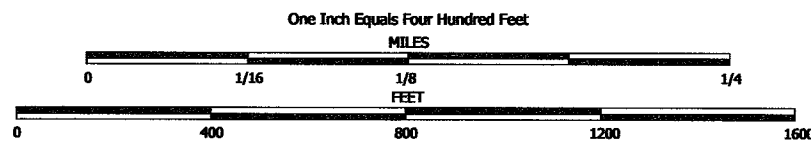


NOTE: This map was prepared for assessment use in accordance with the Wis. St. Stat. Chap. 70.09. All information contained herein is advisory only. Map accuracy is limited to the quality of data obtained from other Public Records. This map is not intended to be a substitute for an actual field survey. Public Land Survey Base is derived from U.S.G.S. Topographic maps unless otherwise noted. Other sources of the Land Base may be actual survey data. Base map data is from the April 1995 County Digital Orthophotos and/or U.S.G.S. 1:24,000 scale Topographic series. The user is responsible for the improper use of the data contained herein.

Created by The Columbia County Land Information Office -GIS Section. VMB.
February 2007.

TAX PARCEL MAP


TOWN of LEWISTON

TOWN 12 NORTH RANGE 8 EAST
COLUMBIA COUNTY, WISCONSIN

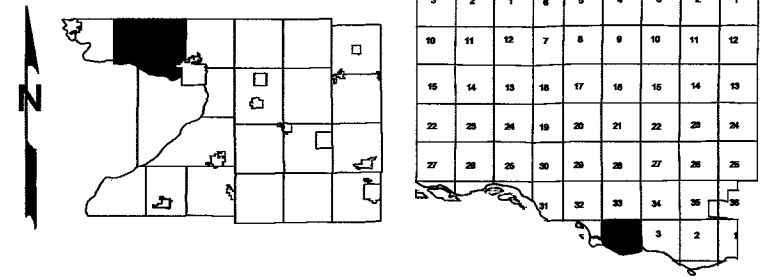

Replaced
2009

-SEE SECTION 33 T13N R8E-

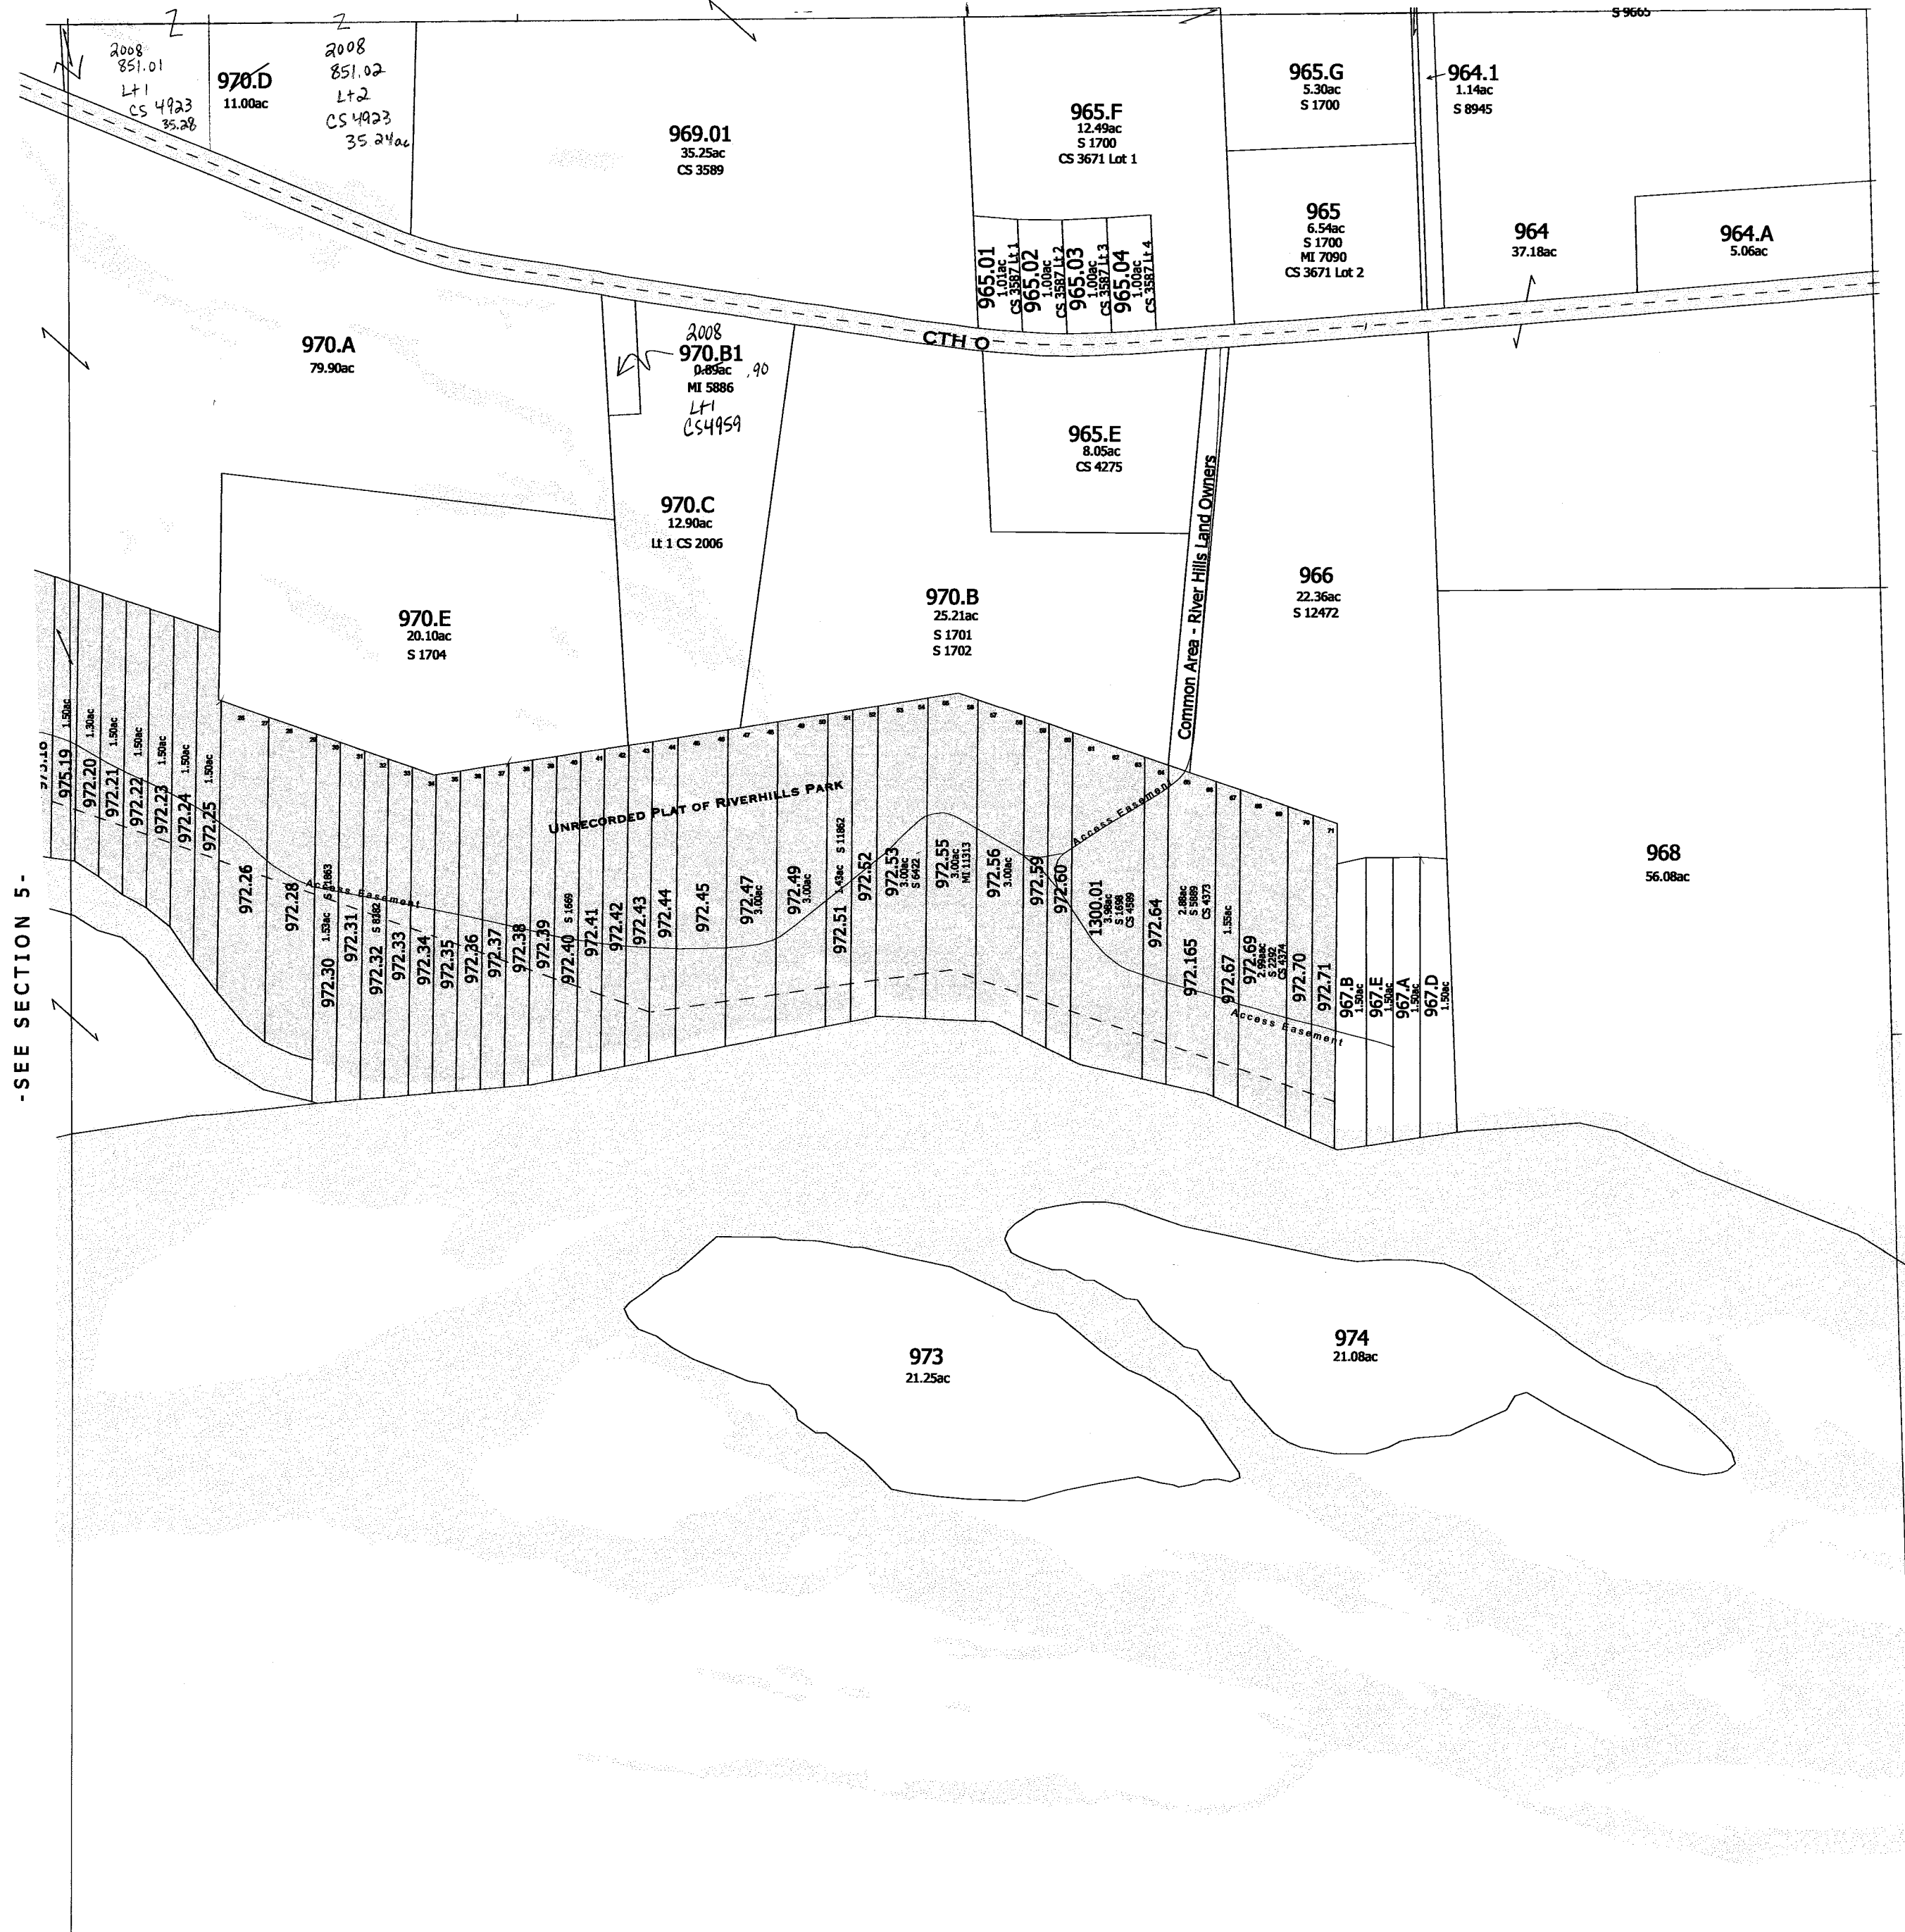


-SEE SECTION 5-

-SEE SECTION 3-

-SEE SECTION 9-

-SECTION 4-

Also
2008

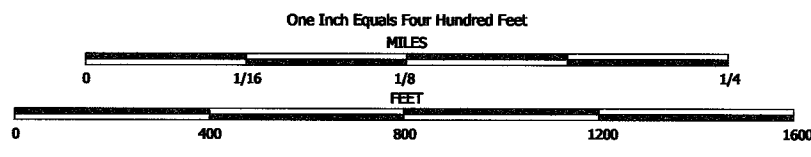


NOTE: This map was prepared for assessment use in accordance with the Wis. St. Stat. Chap. 70.09. All information contained herein is advisory only. Map accuracy is limited to the quality of data obtained from other Public Records. This map is not intended to be a substitute for an actual field survey. Public Land Survey Base is derived from U.S.G.S. Topographic maps unless otherwise noted. Other sources of the Land Base may be actual survey data. Base map data is from the April 1995 County Digital Orthophotos and/or U.S.G.S. 1:24,000 scale Topographic series. The user is responsible for the improper use of the data contained herein.

Created by The Columbia County Land Information Office -GIS Section. VMB.
February 2007.


TAX PARCEL MAP

TOWN of LEWISTON

TOWN 12 NORTH RANGE 8 EAST
COLUMBIA COUNTY, WISCONSIN

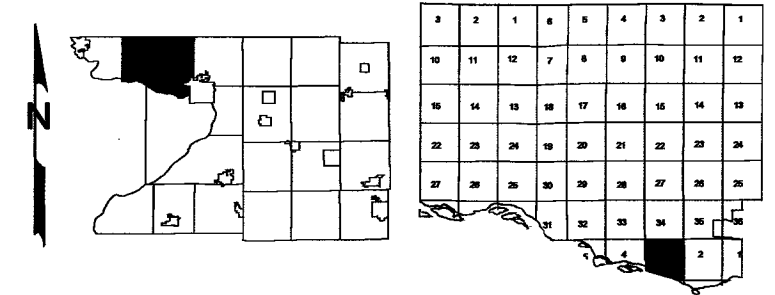

Replaced
2009

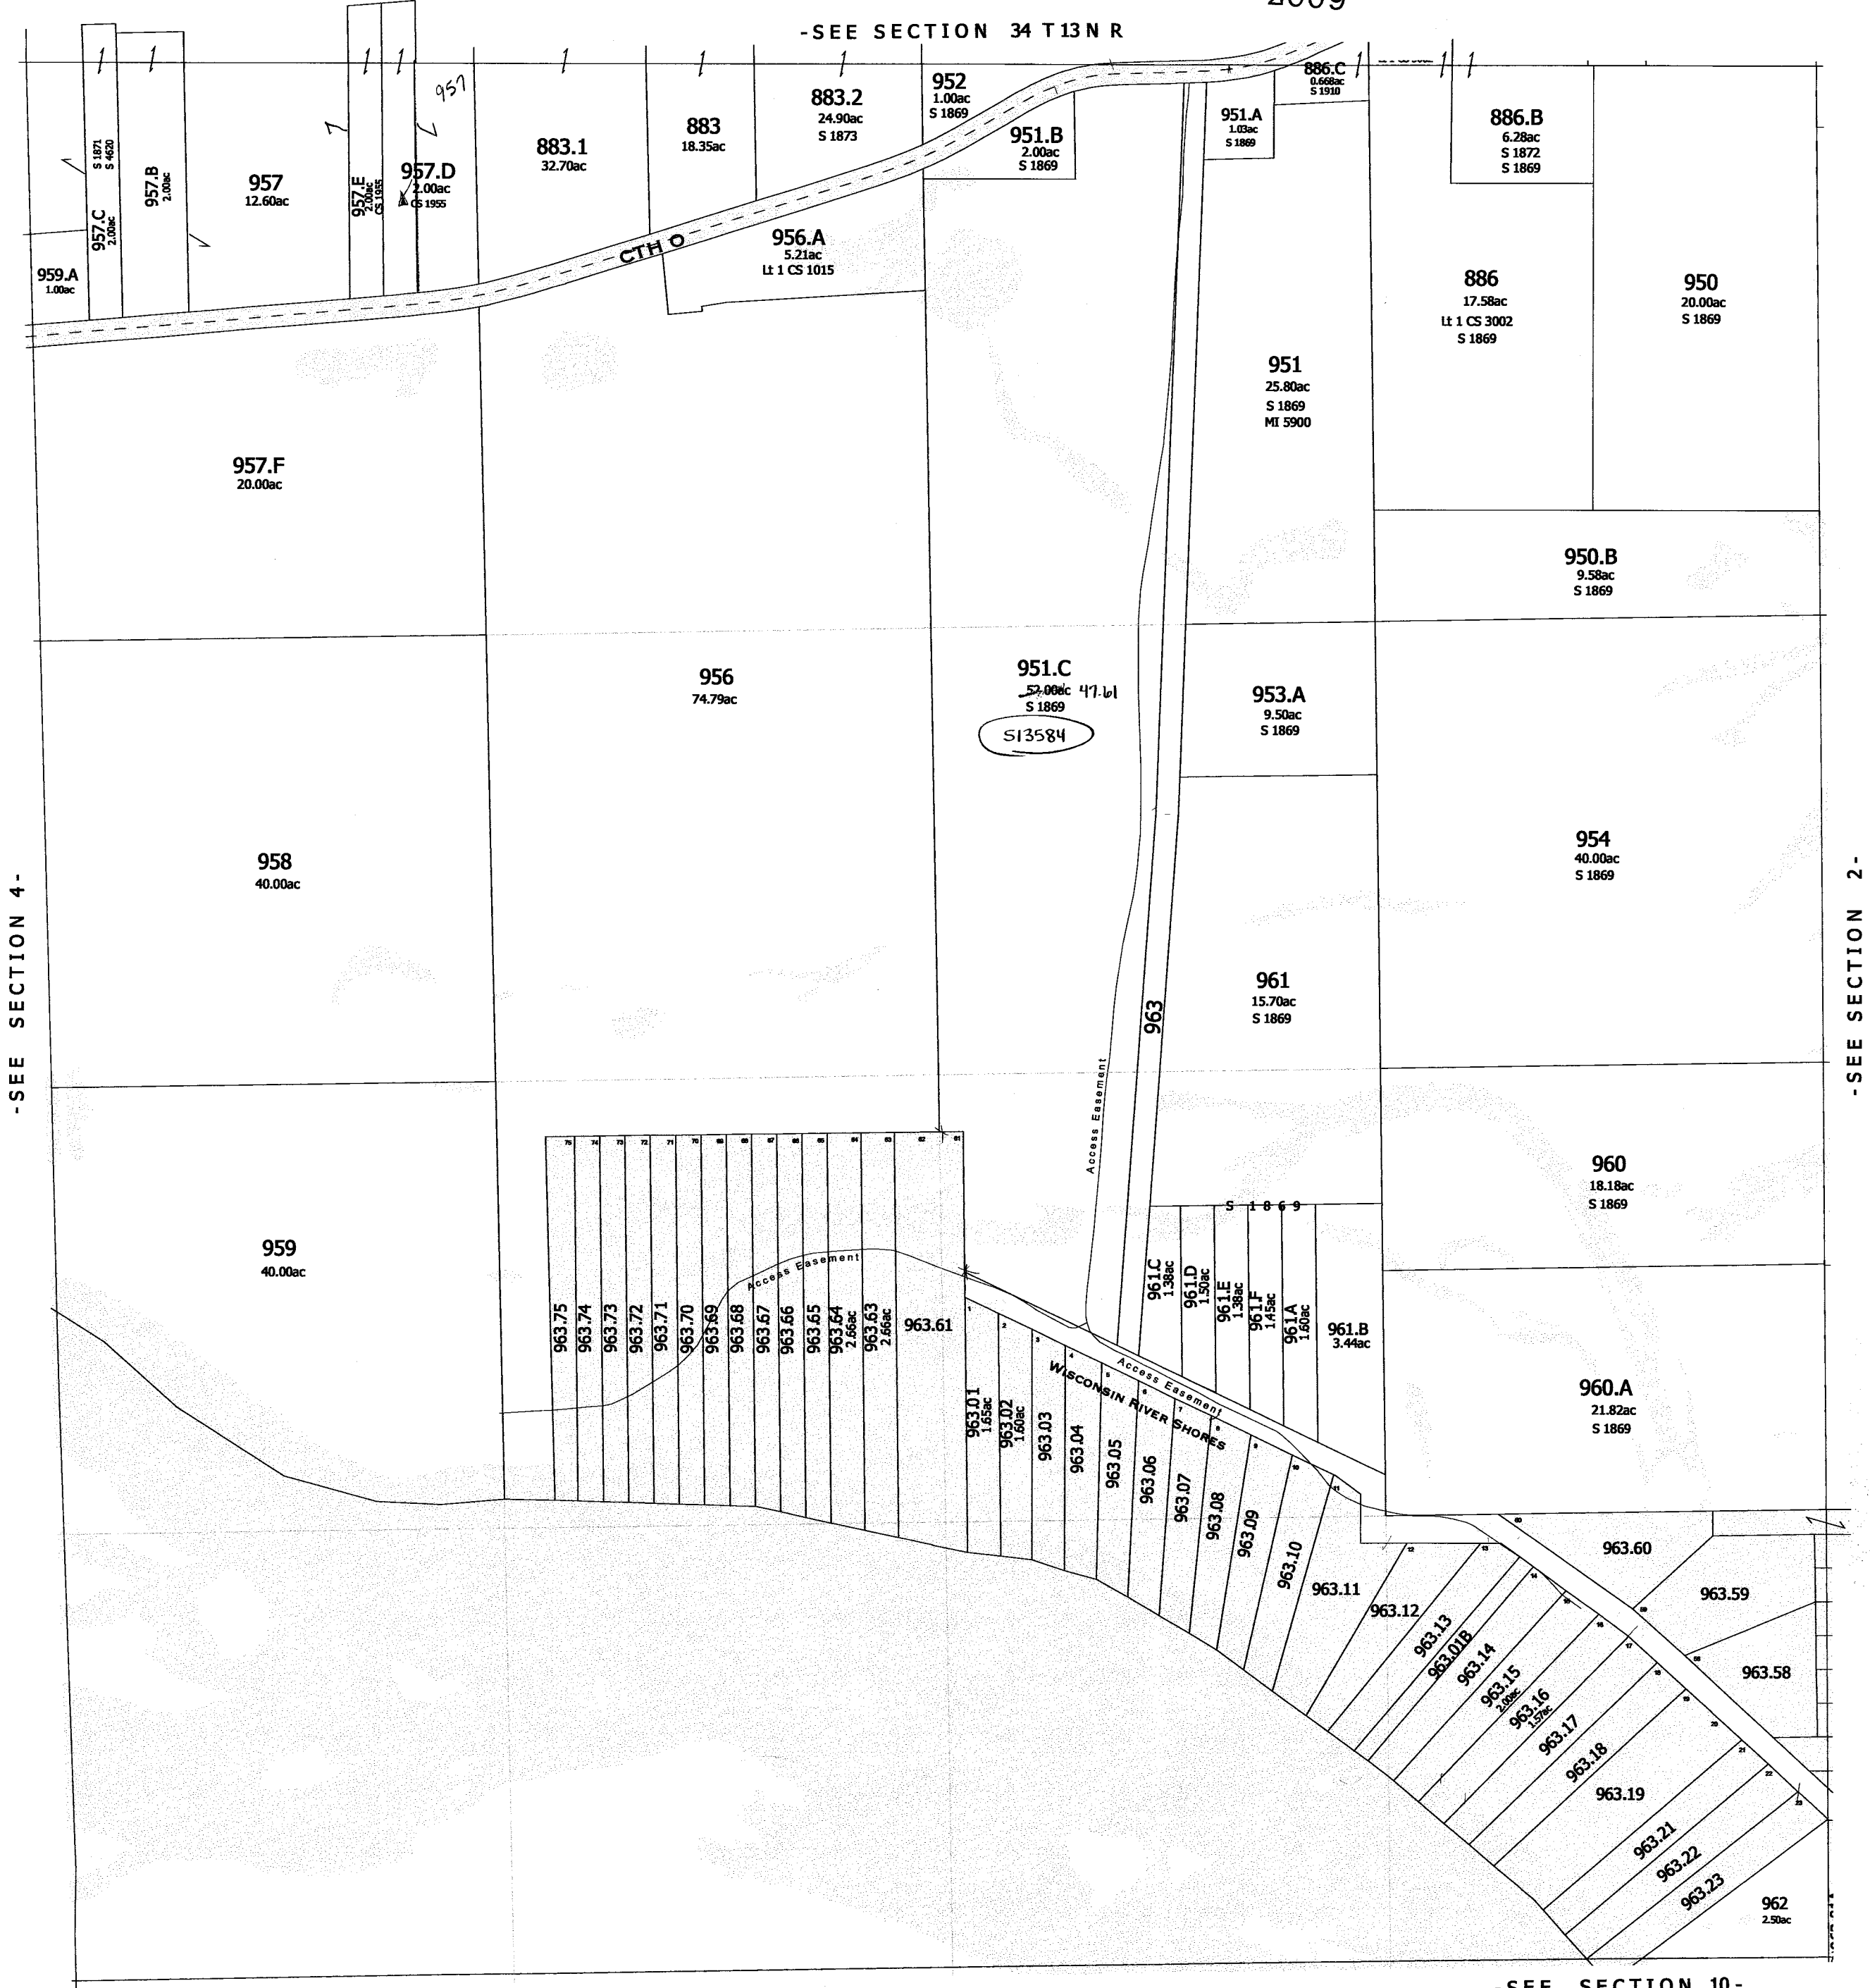

-SEE SECTION 4-

-SEE SECTION 2-

TOWN of CALEDONIA

-SEE SECTION 10-

-SECTION 3-

One Inch Equals Four Hundred Feet

MILES
0 1/16 1/8 1/4
0 400 800 1200 1600

FEET


NOTE: This map was prepared for assessment use in accordance with the Wis. Stat. Chap. 70.09. All information contained herein is advisory only. Map accuracy is limited to the quality of data obtained from other Public Records. This map is not intended to be a substitute for an actual field survey. Public Land Survey Base is derived from U.S.G.S. Topographic maps unless otherwise noted. Other sources of the Land Base may be actual survey data. Base map data is from the April 1995 County Digital Orthophotos and/or U.S.G.S. 1:24,000 scale Topographic series. The user is responsible for the improper use of the data contained herein.

Created by The Columbia County Land Information Office -GIS Section. VMB.
February 2007.

TAX PARCEL MAP


TOWN of LEWISTON

TOWN 12 NORTH RANGE 8 EAST
COLUMBIA COUNTY, WISCONSIN

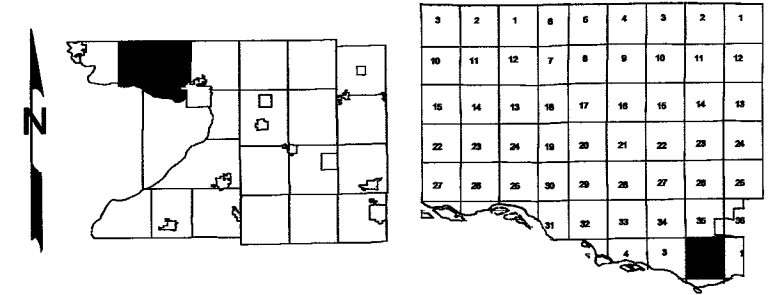

-SEE SECTION 35 T¹²N R8E -

Replaced
2009

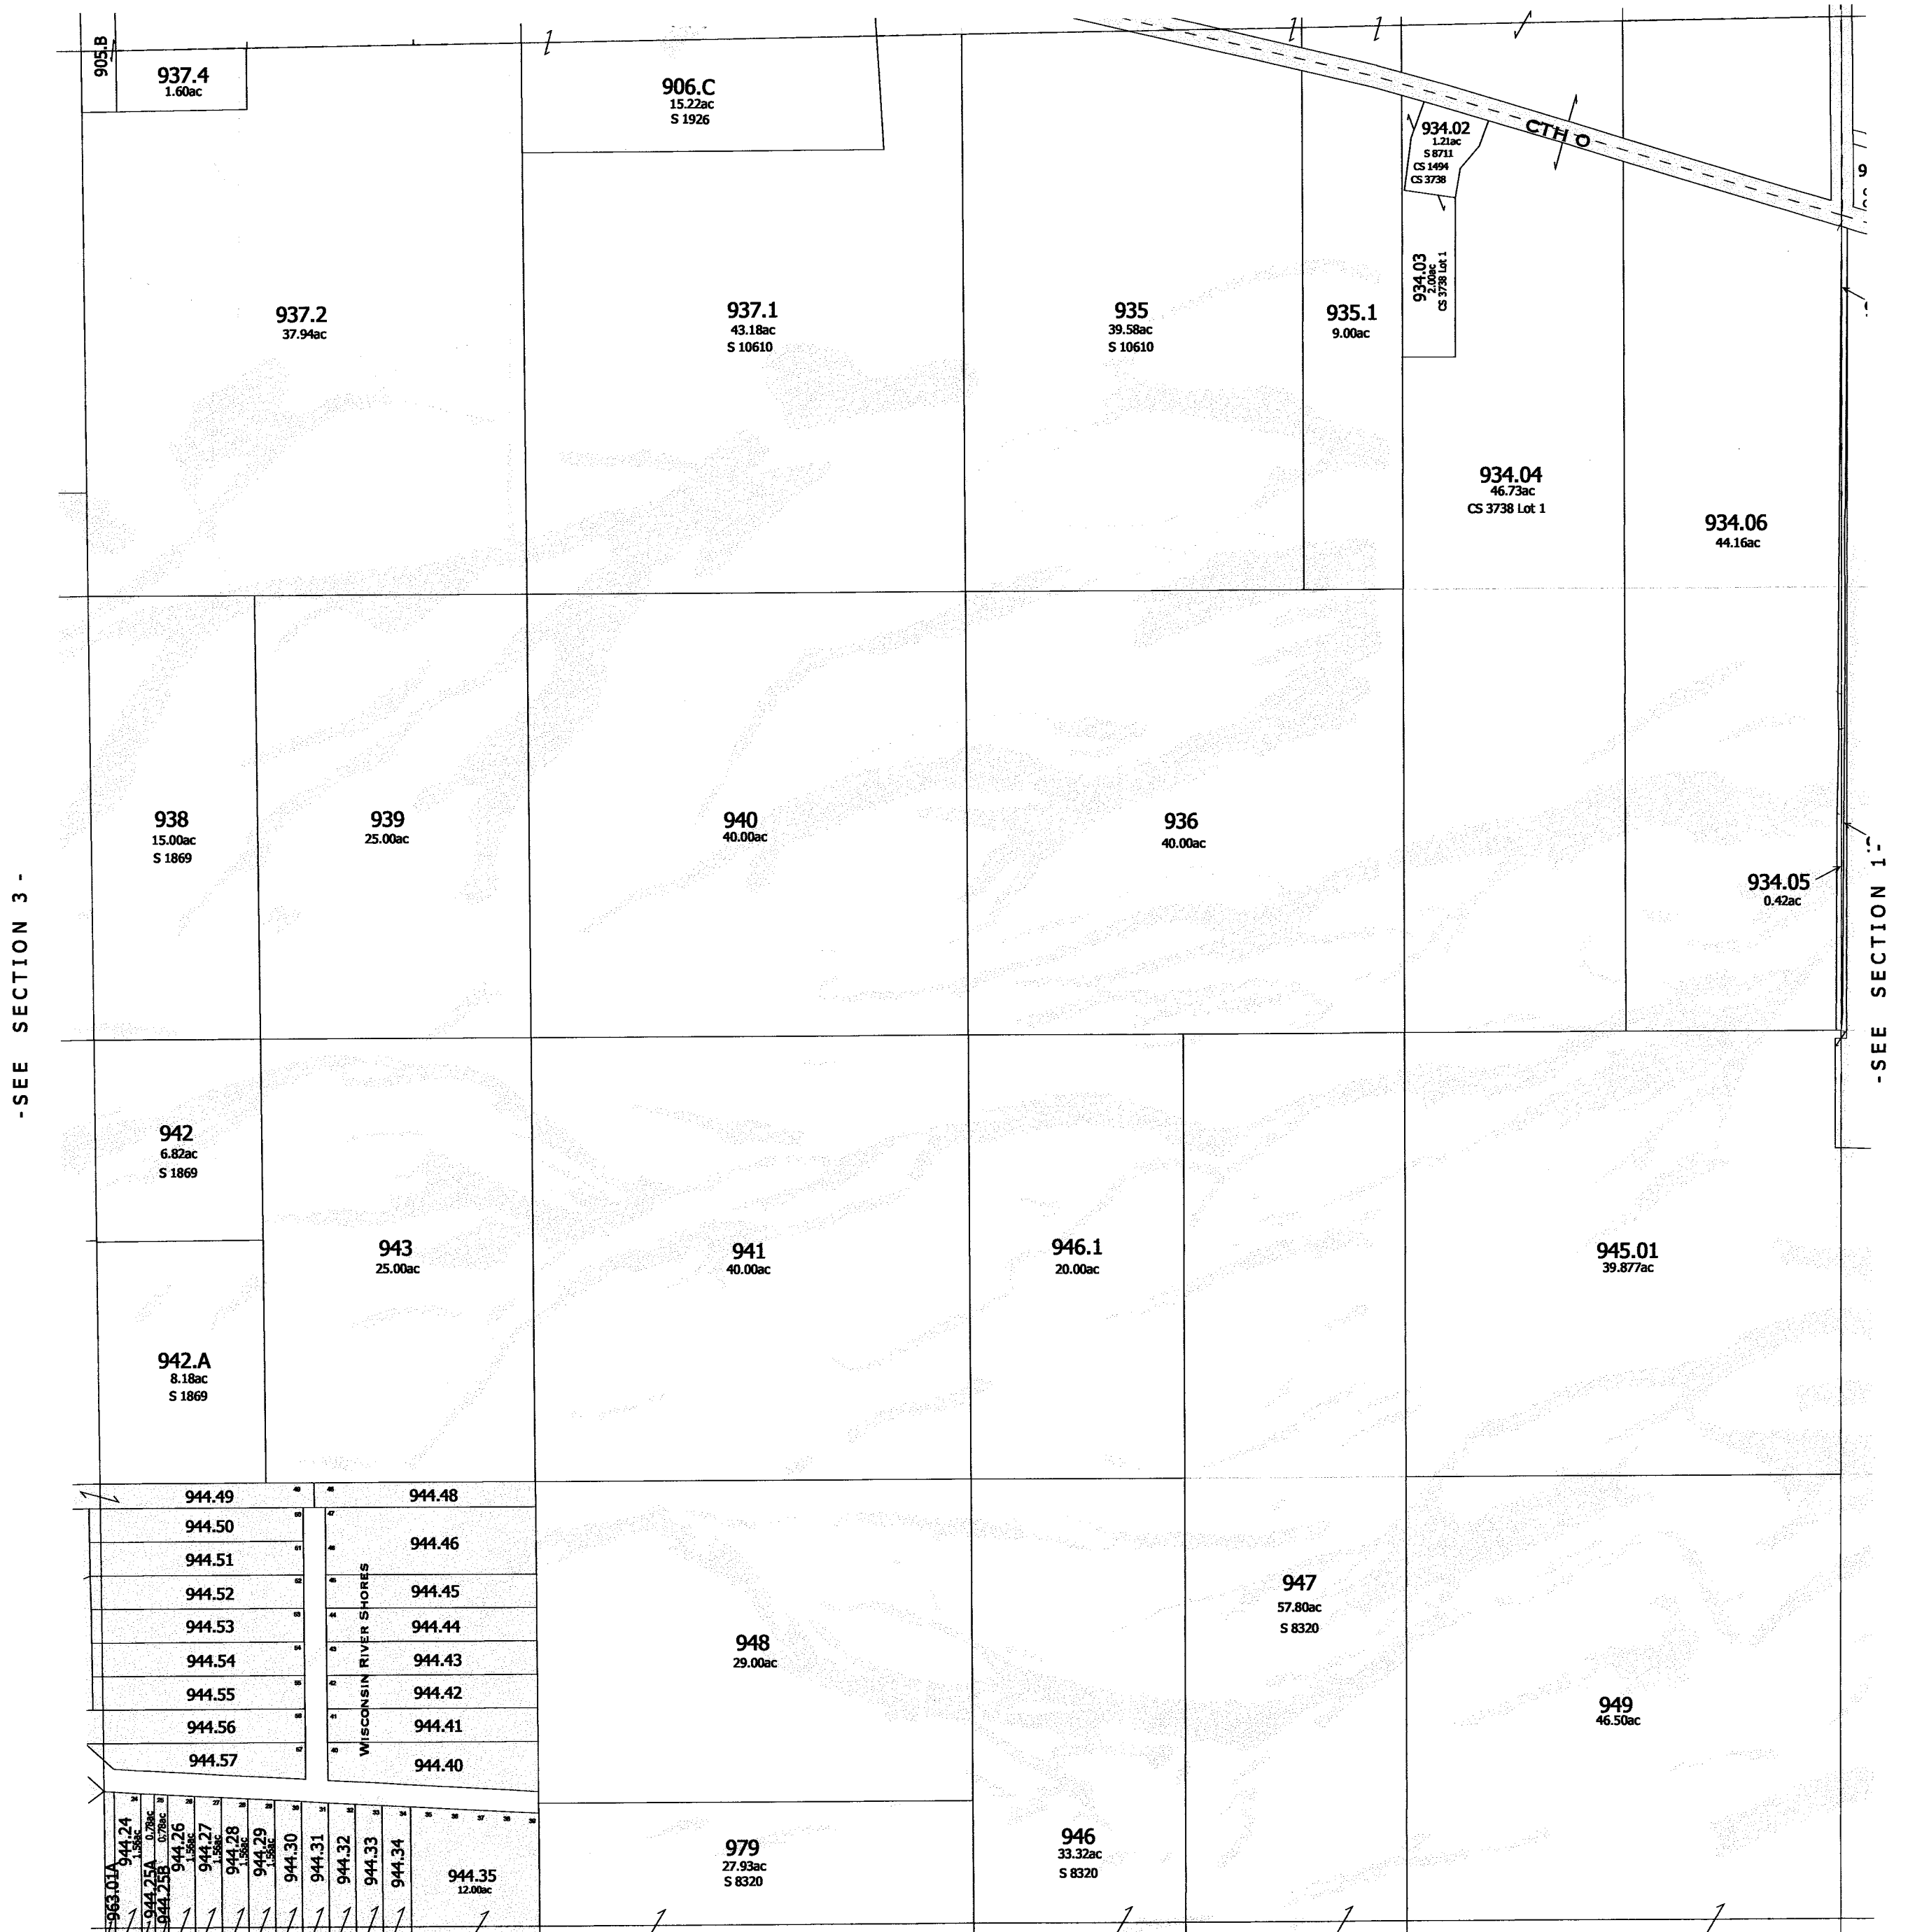

-SEE SECTION 11-

-SECTION 2-

One Inch Equals Four Hundred Feet
MILES
0 1/16 1/8 1/4
FEET
0 400 800 1200 1600


NOTE: This map was prepared for assessment use in accordance with the Wis. St. Stat. Chap. 70.09. All information contained herein is advisory only. Map accuracy is limited to the quality of data obtained from other Public Records. This map is not intended to be a substitute for an actual field survey. Public Land Survey Base is derived from U.S.G.S. Topographic maps unless otherwise noted. Other sources of the Land Base may be actual survey data. Base map data is from the April 1995 County Digital Orthophotos and/or U.S.G.S. 1:24,000 scale Topographic series. The user is responsible for the improper use of the data contained herein.

Created by The Columbia County Land Information Office -GIS Section. VMB.
February 2007.


TAX PARCEL MAP

TOWN of LEWISTON

TOWN 12 NORTH RANGE 8 EAST
COLUMBIA COUNTY, WISCONSIN

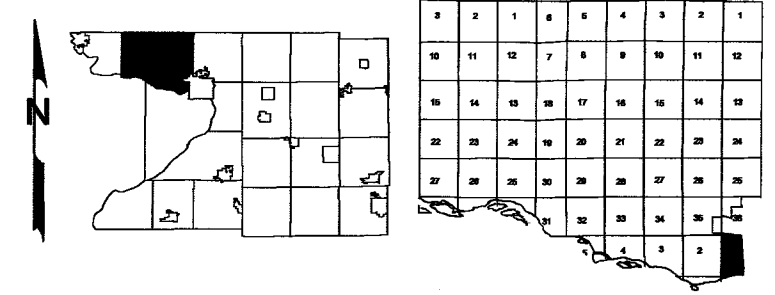

Replaced
2009

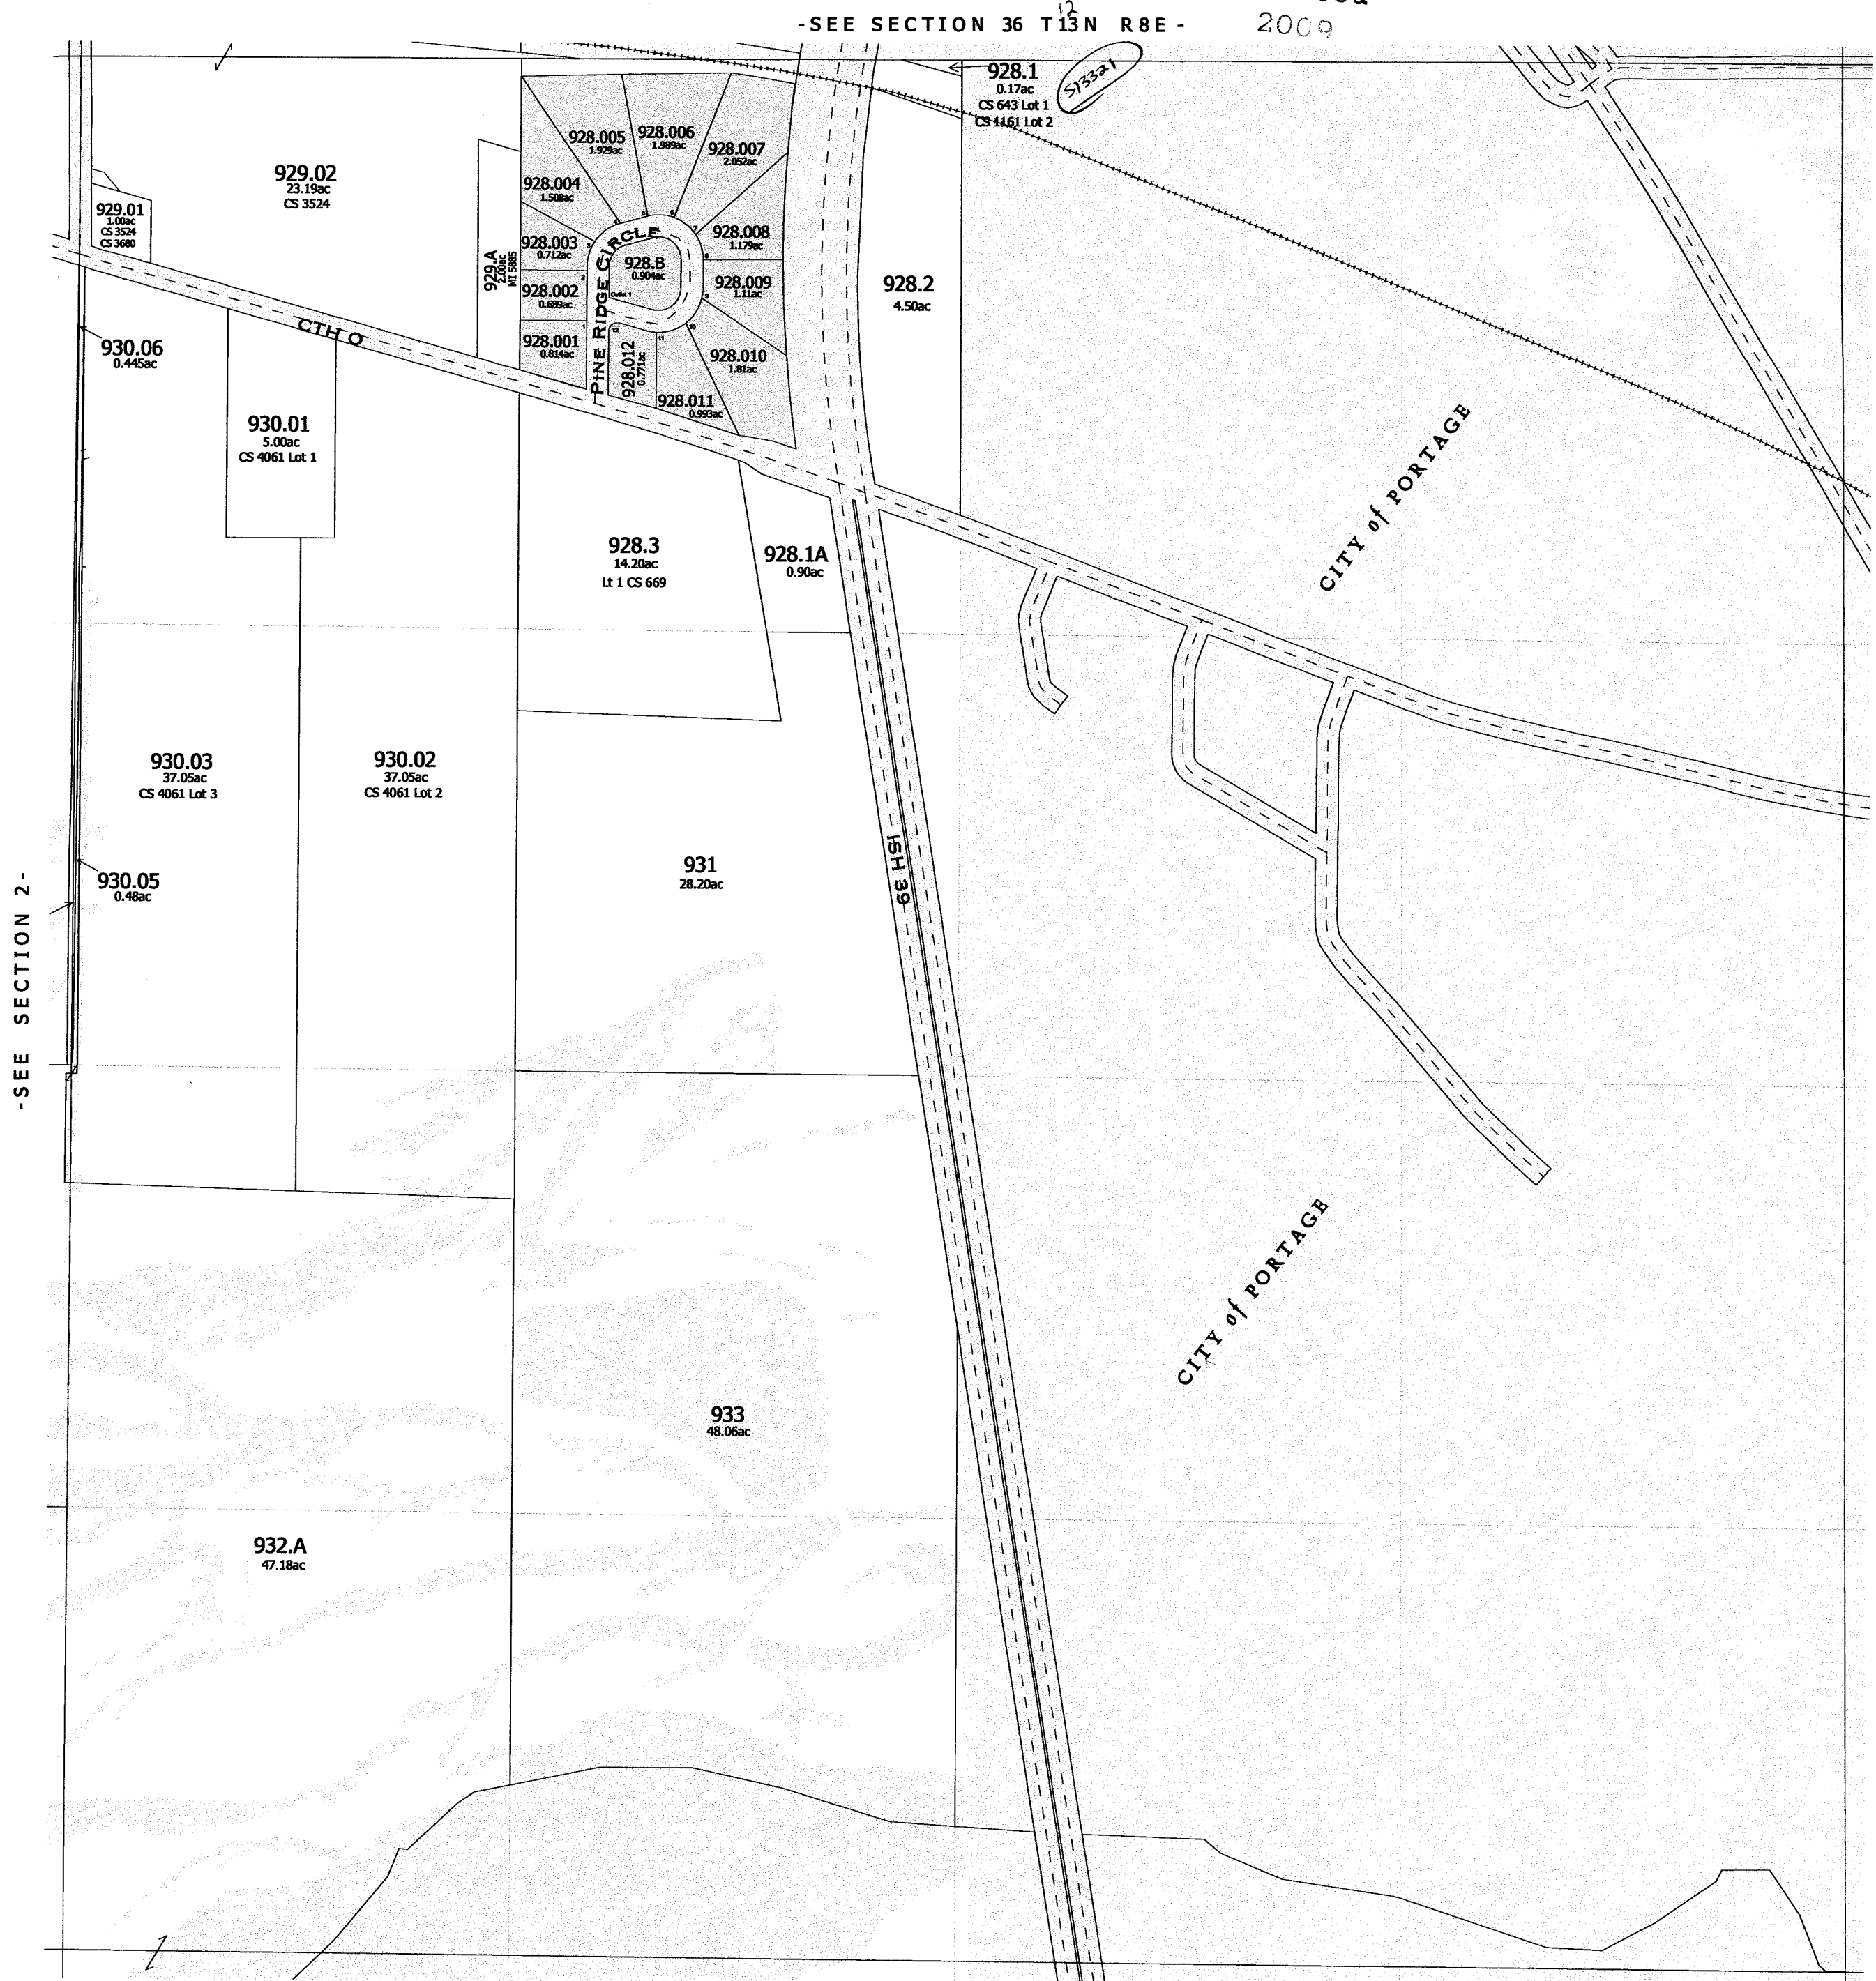

-SEE SECTION 12-

-SECTION 1-


NOTE: This map was prepared for assessment use in accordance with the Wis. St. Stat. Chap. 70.09. All information contained herein is advisory only. Map accuracy is limited to the quality of data obtained from other Public Records. This map is not intended to be a substitute for an actual field survey. Public Land Survey Base is derived from U.S.G.S. Topographic maps unless otherwise noted. Other sources of the Land Base may be actual survey data. Base map data is from the April 1995 County Digital Orthophotos and/or U.S.G.S. 1:24,000 scale Topographic series. The user is responsible for the improper use of the data contained herein.

Created by The Columbia County Land Information Office -GIS Section. VMB.
February 2007.

TAX PARCEL MAP


TOWN of LEWISTON

TOWN 12 NORTH RANGE 8 EAST TOWN 13 NORTH RANGE 7 EAST TOWN 13 NORTH RANGE 8 EAST
COLUMBIA COUNTY, WISCONSIN

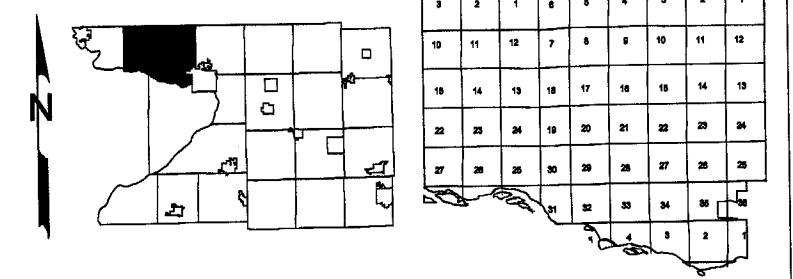

Replaced
2009


MARQUETTE COUNTY

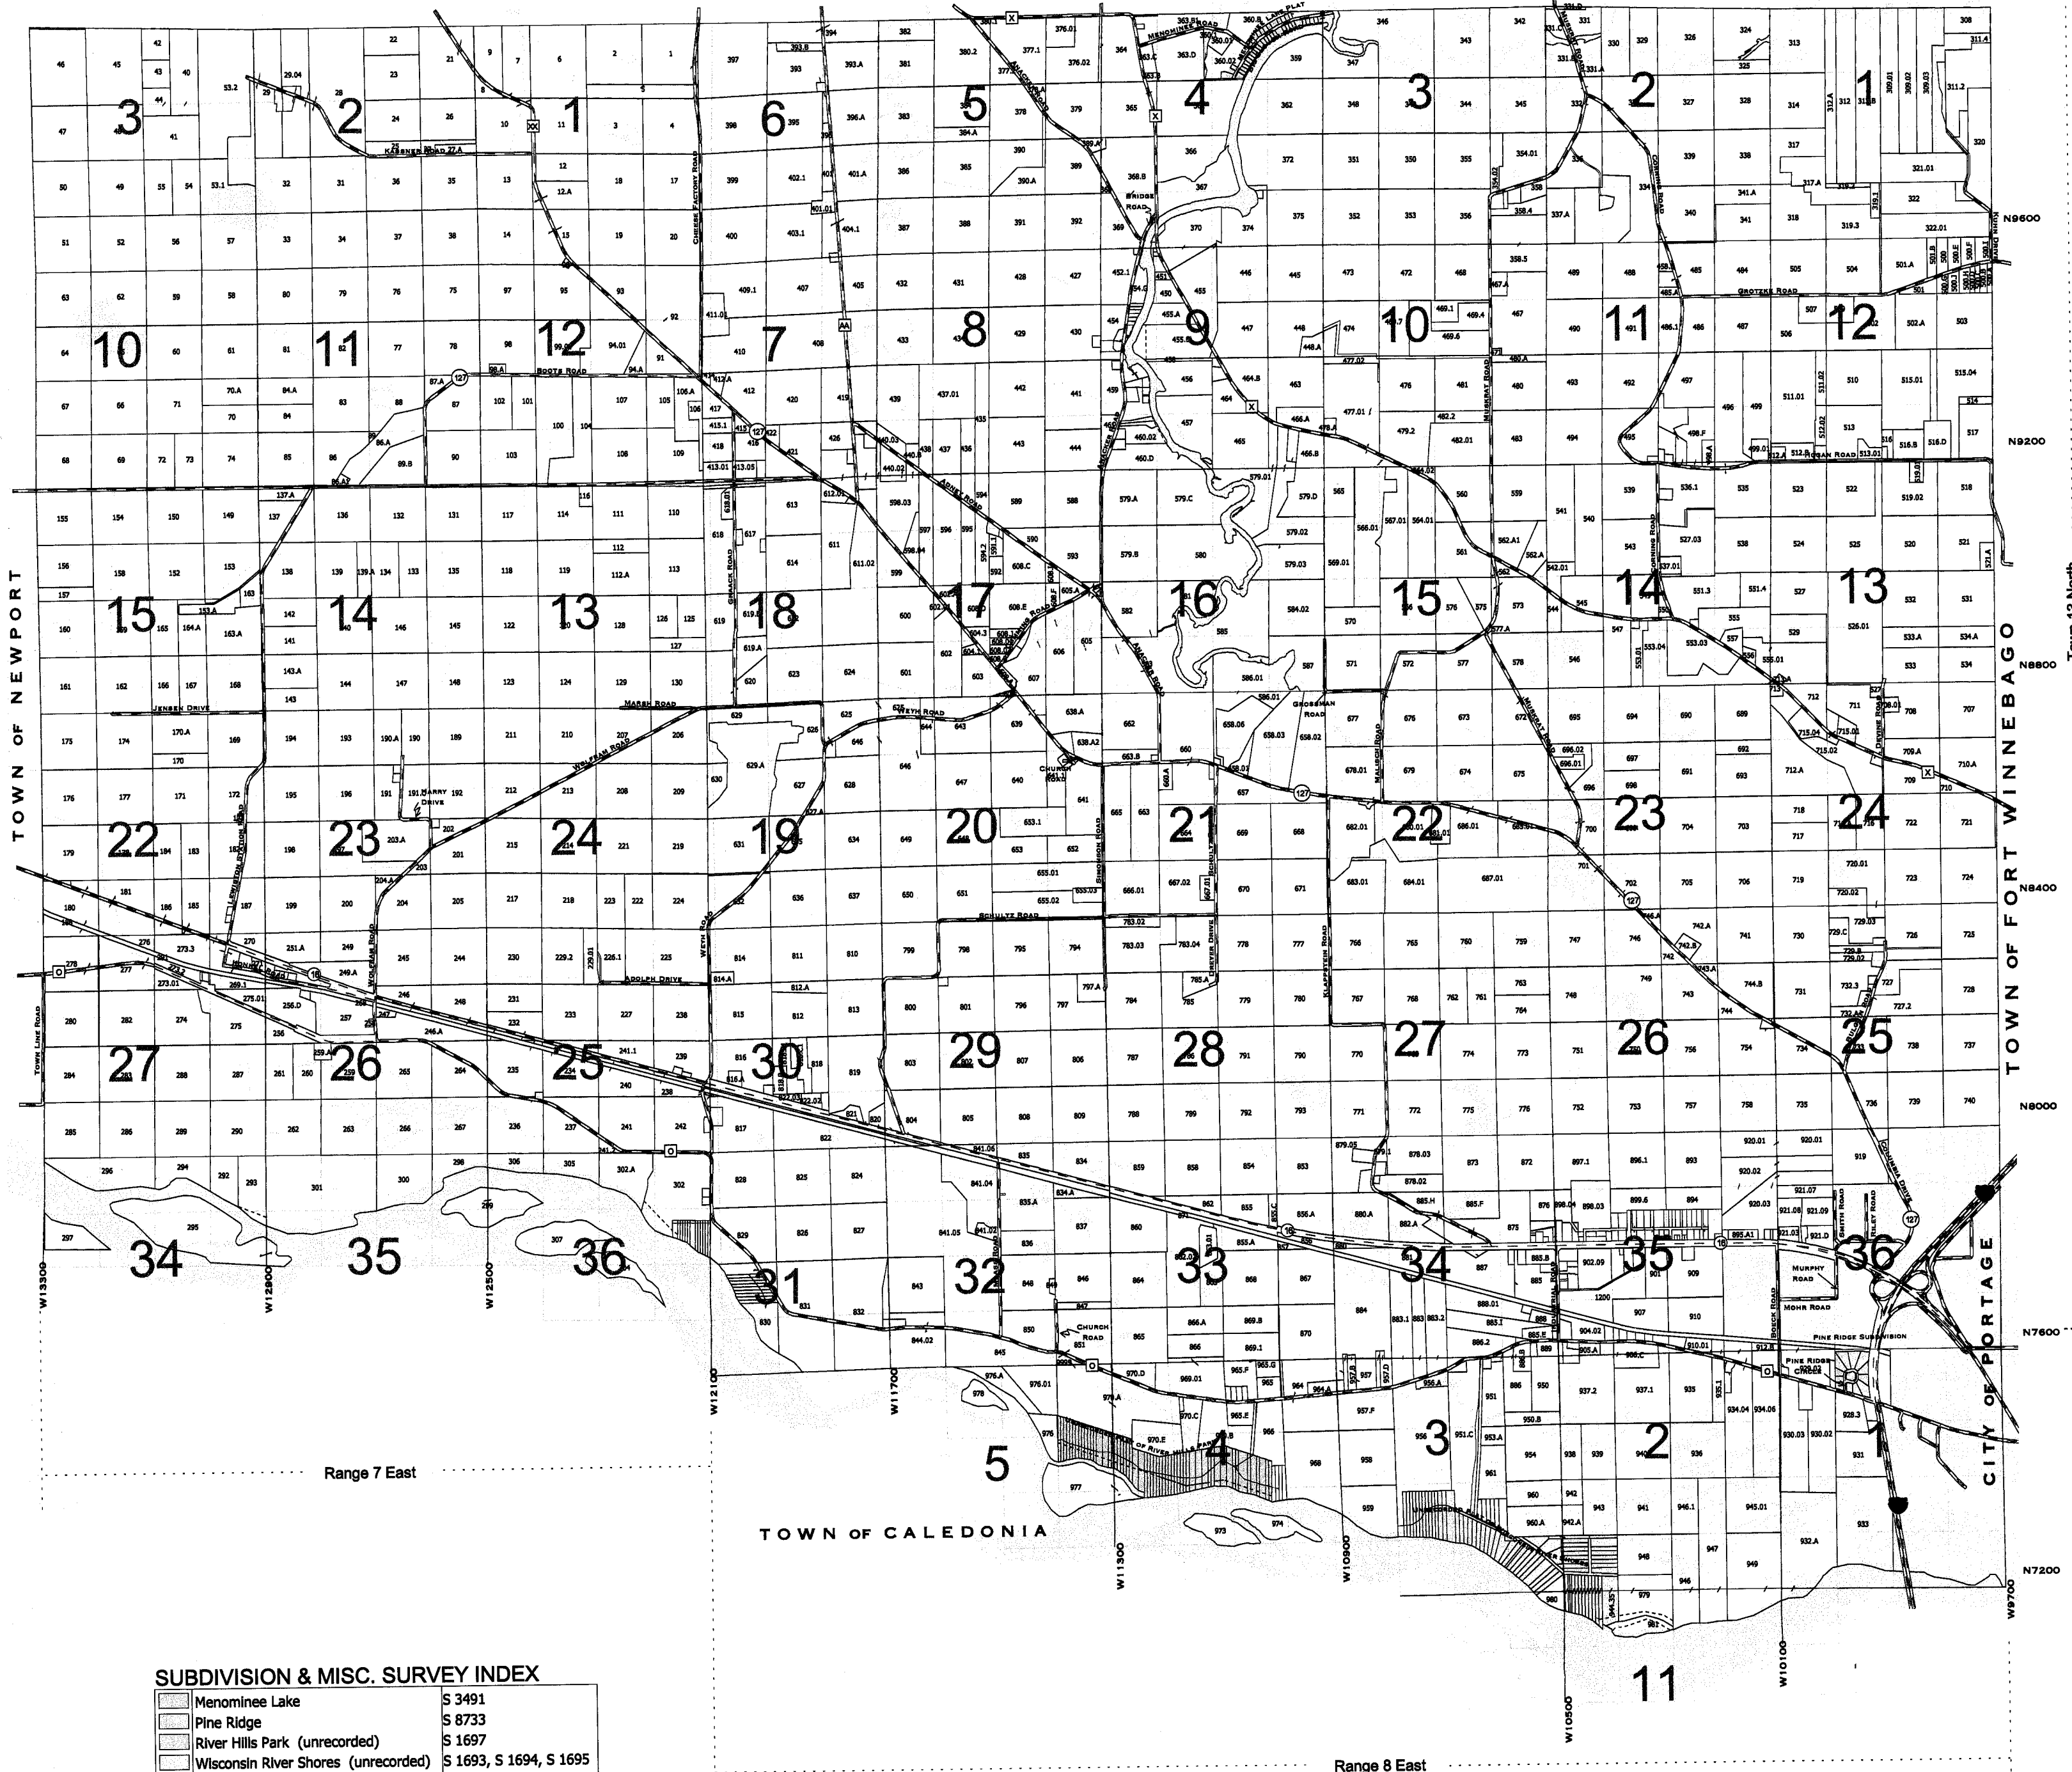

SUBDIVISION & MISC. SURVEY INDEX

Menominee Lake	S 3491
Pine Ridge	S 8733
River Hills Park (unrecorded)	S 1697
Wisconsin River Shores (unrecorded)	S 1693, S 1694, S 1695
County Boundary Survey	S 11821

Range 8 East

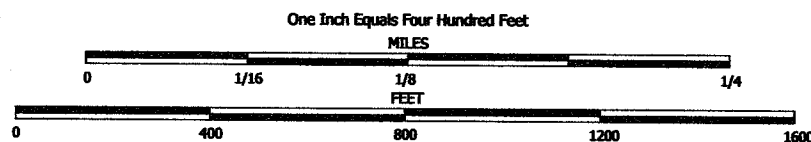



NOTE: This map was prepared for assessment use in accordance with the Wis. St. Stat. Chap. 70.09. All information contained herein is advisory only. Map accuracy is limited to the quality of data obtained from other Public Records. This map is not intended to be a substitute for an actual field survey. Public Land Survey Base is derived from U.S.G.S. Topographic maps unless otherwise noted. Other sources of the Land Base may be actual survey data. Base map data is from the April 1995 County Digital Orthophotos and/or U.S.G.S. 1:24,000 scale Topographic series. The user is responsible for the improper use of the data contained herein.

Created by The Columbia County Land Information Office -GIS Section. VMB.
February 2006.


TAX PARCEL MAP

TOWN of LEWISTON

TOWN 13 NORTH RANGE 8 EAST
COLUMBIA COUNTY, WISCONSIN

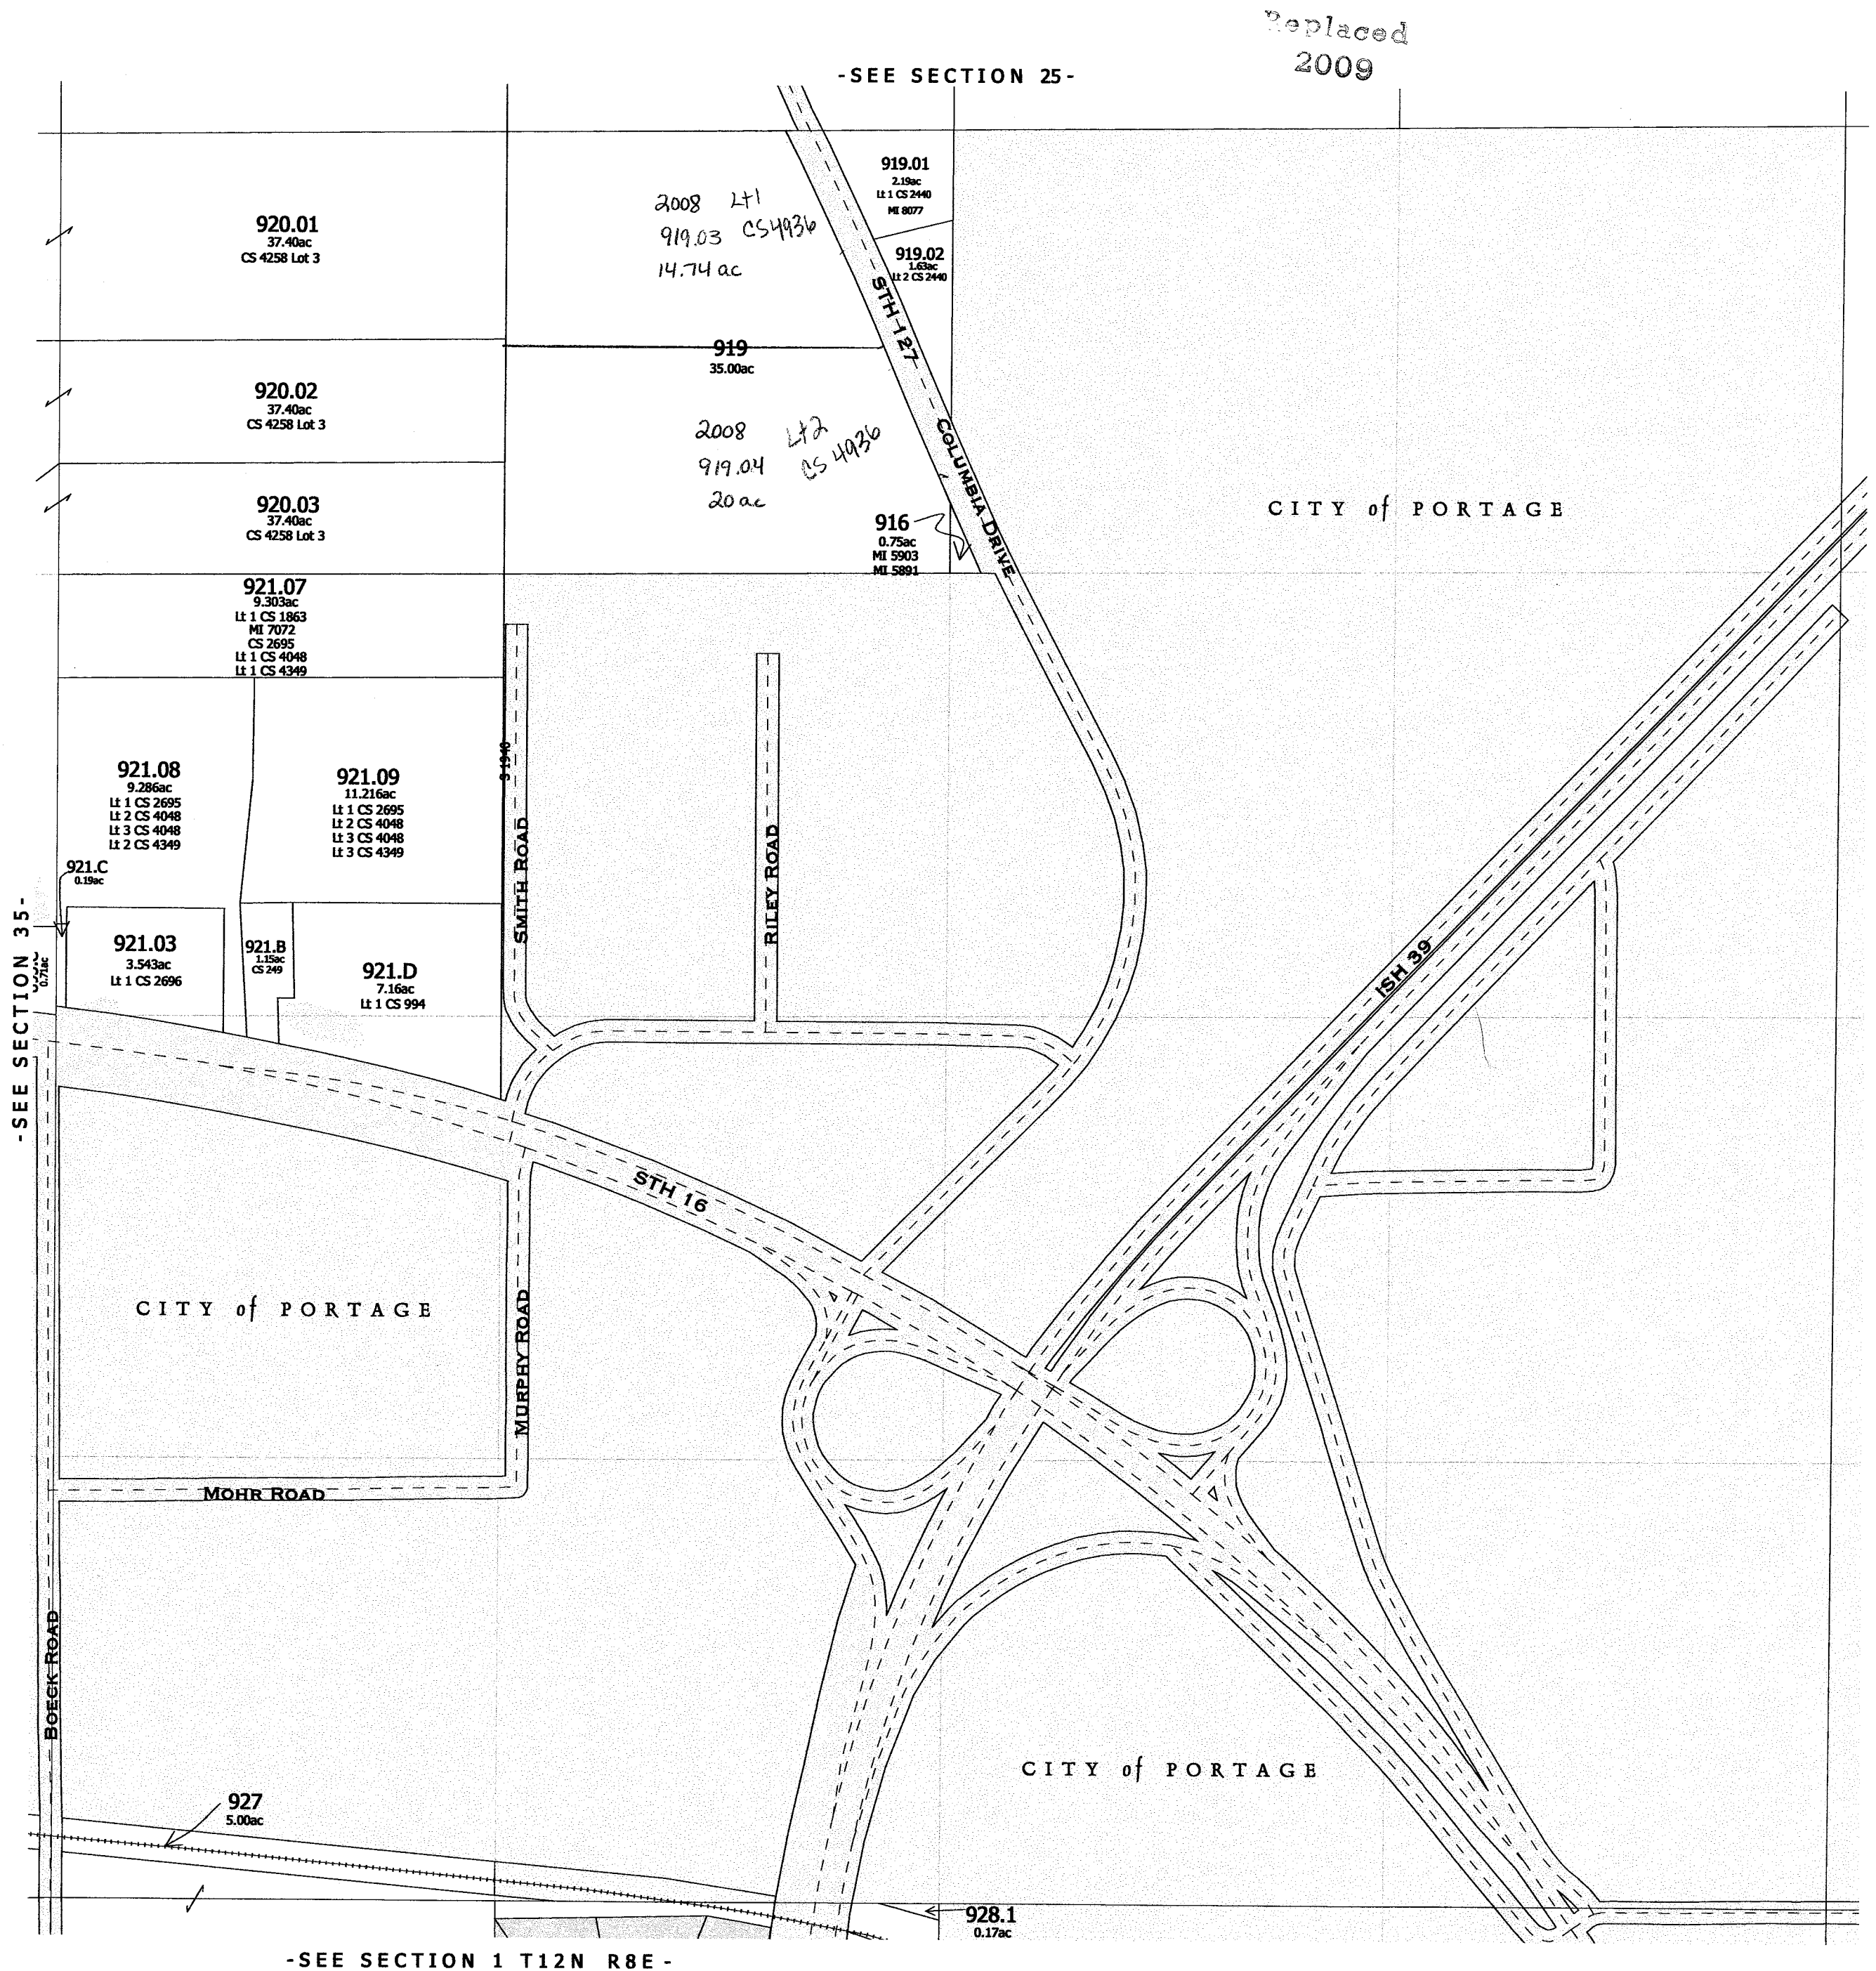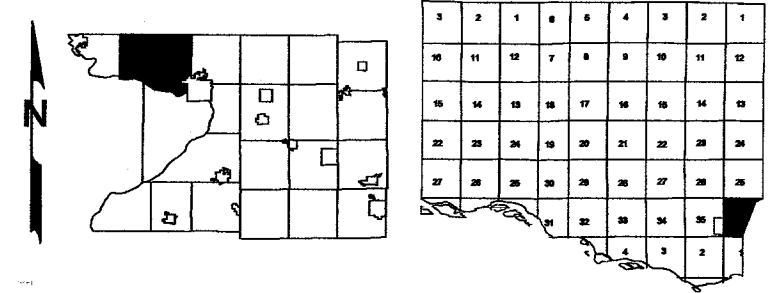

1 inch = 400 feet 1:4,800

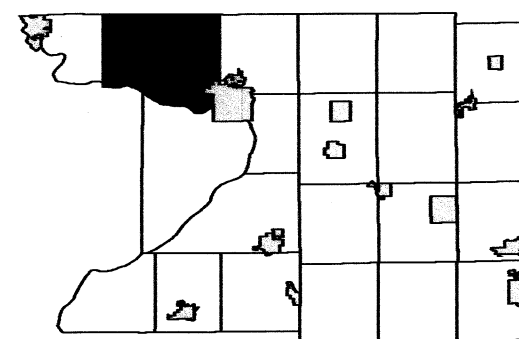

R7E				R8E							
3	2	1	6	5	4	3	2	1			
10	11	12	7	8	9	10	11	12			
15	14	13	18	17	16	15	14	13			
22	23	24	19	20	21	22	23	24			T13N
27	26	25	30	29	28	27	26	25			
34	33	32	31	32		34	35	36			
				5	4	3	2				T12N
						10	11	12			

SEE SECTION 32 TOWN OF LEWISTON

SEE SECTION 34 TOWN OF LEWISTON

Replaced
2010

February 12, 2009
Columbia County Land Information


Section 33
T13N R8E

TOWN OF LEWISTON


SECTION 32 T13N R8E

1 inch = 400 feet 1:4,800

SEE SECTION 29 TOWN OF LEWISTON

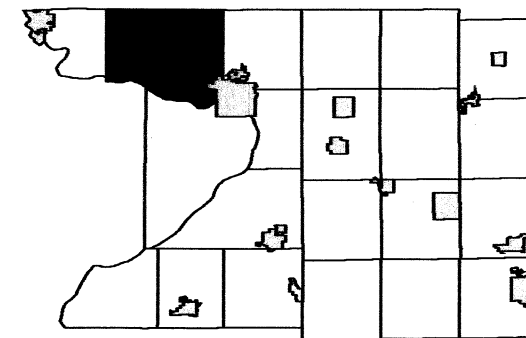

The diagram shows a 6x12 grid of cells. The top row is labeled 'R7E' and 'R8E'. The grid contains numbers 1 through 36. Cells 31, 32, 33, 34, 35, and 36 are shaded black. The grid is bounded by T12N and T12N lines, and R7E and R8E lines. A small inset shows a 3x3 grid of numbers 10, 11, 12.

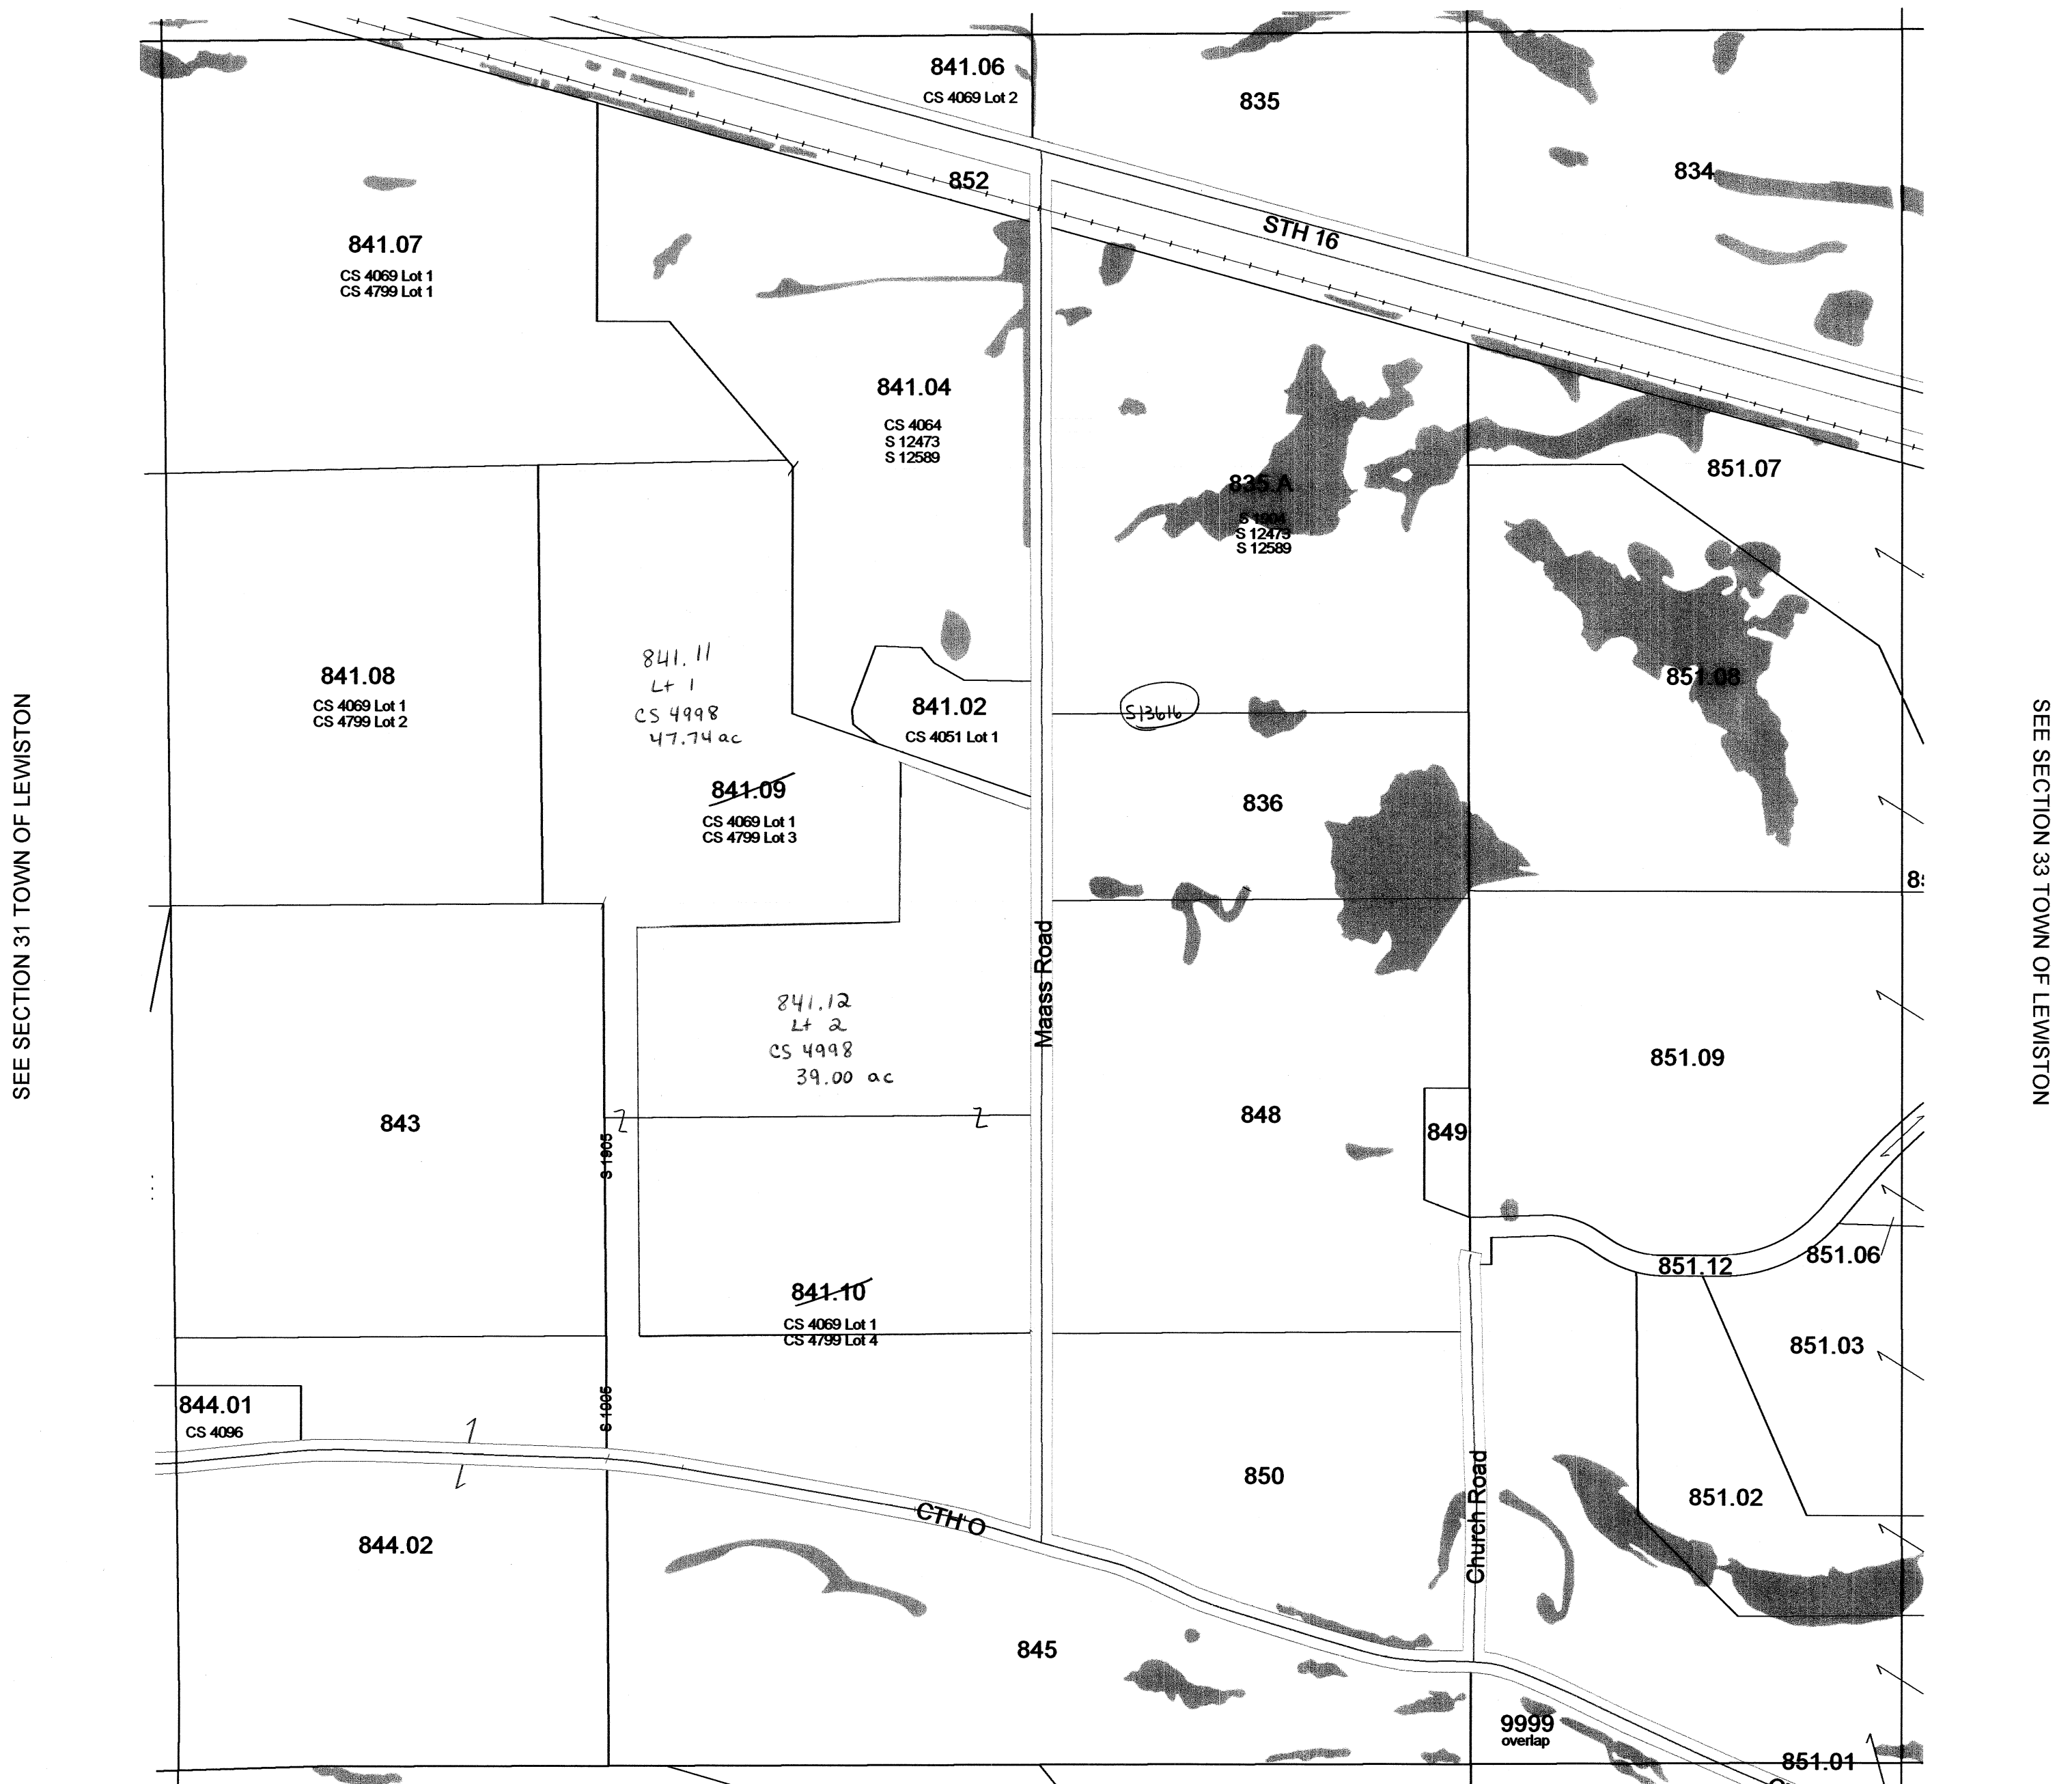

February 12, 2009
Columbia County Land Information

SEE SECTION 05 TOWN OF LEWISTON


Replaced
2010

Section 32
T13N R8E

TOWN OF LEWISTON

SECTION 29 T13N R8E


1 inch = 400 feet 1:4,800

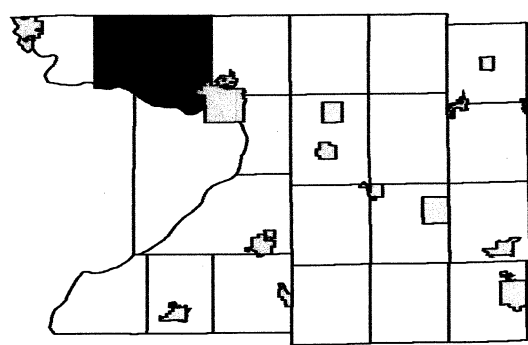

R7E						R8E					
3	2	1	6	5	4	3	2	1			
10	11	12	7	8	9	10	11	12			
15	14	13	18	17	16	15	14	13			
22	23	24	19	20	21	22	23	24			
27	26	25	30	28	27	26	25	24			
34	33	32	31	32	33	34	35	36			
				5	4	3	2				
				10	11	12					

SEE SECTION 20 TOWN OF LEWISTON

SEE SECTION 30 TOWN OF LEWISTON

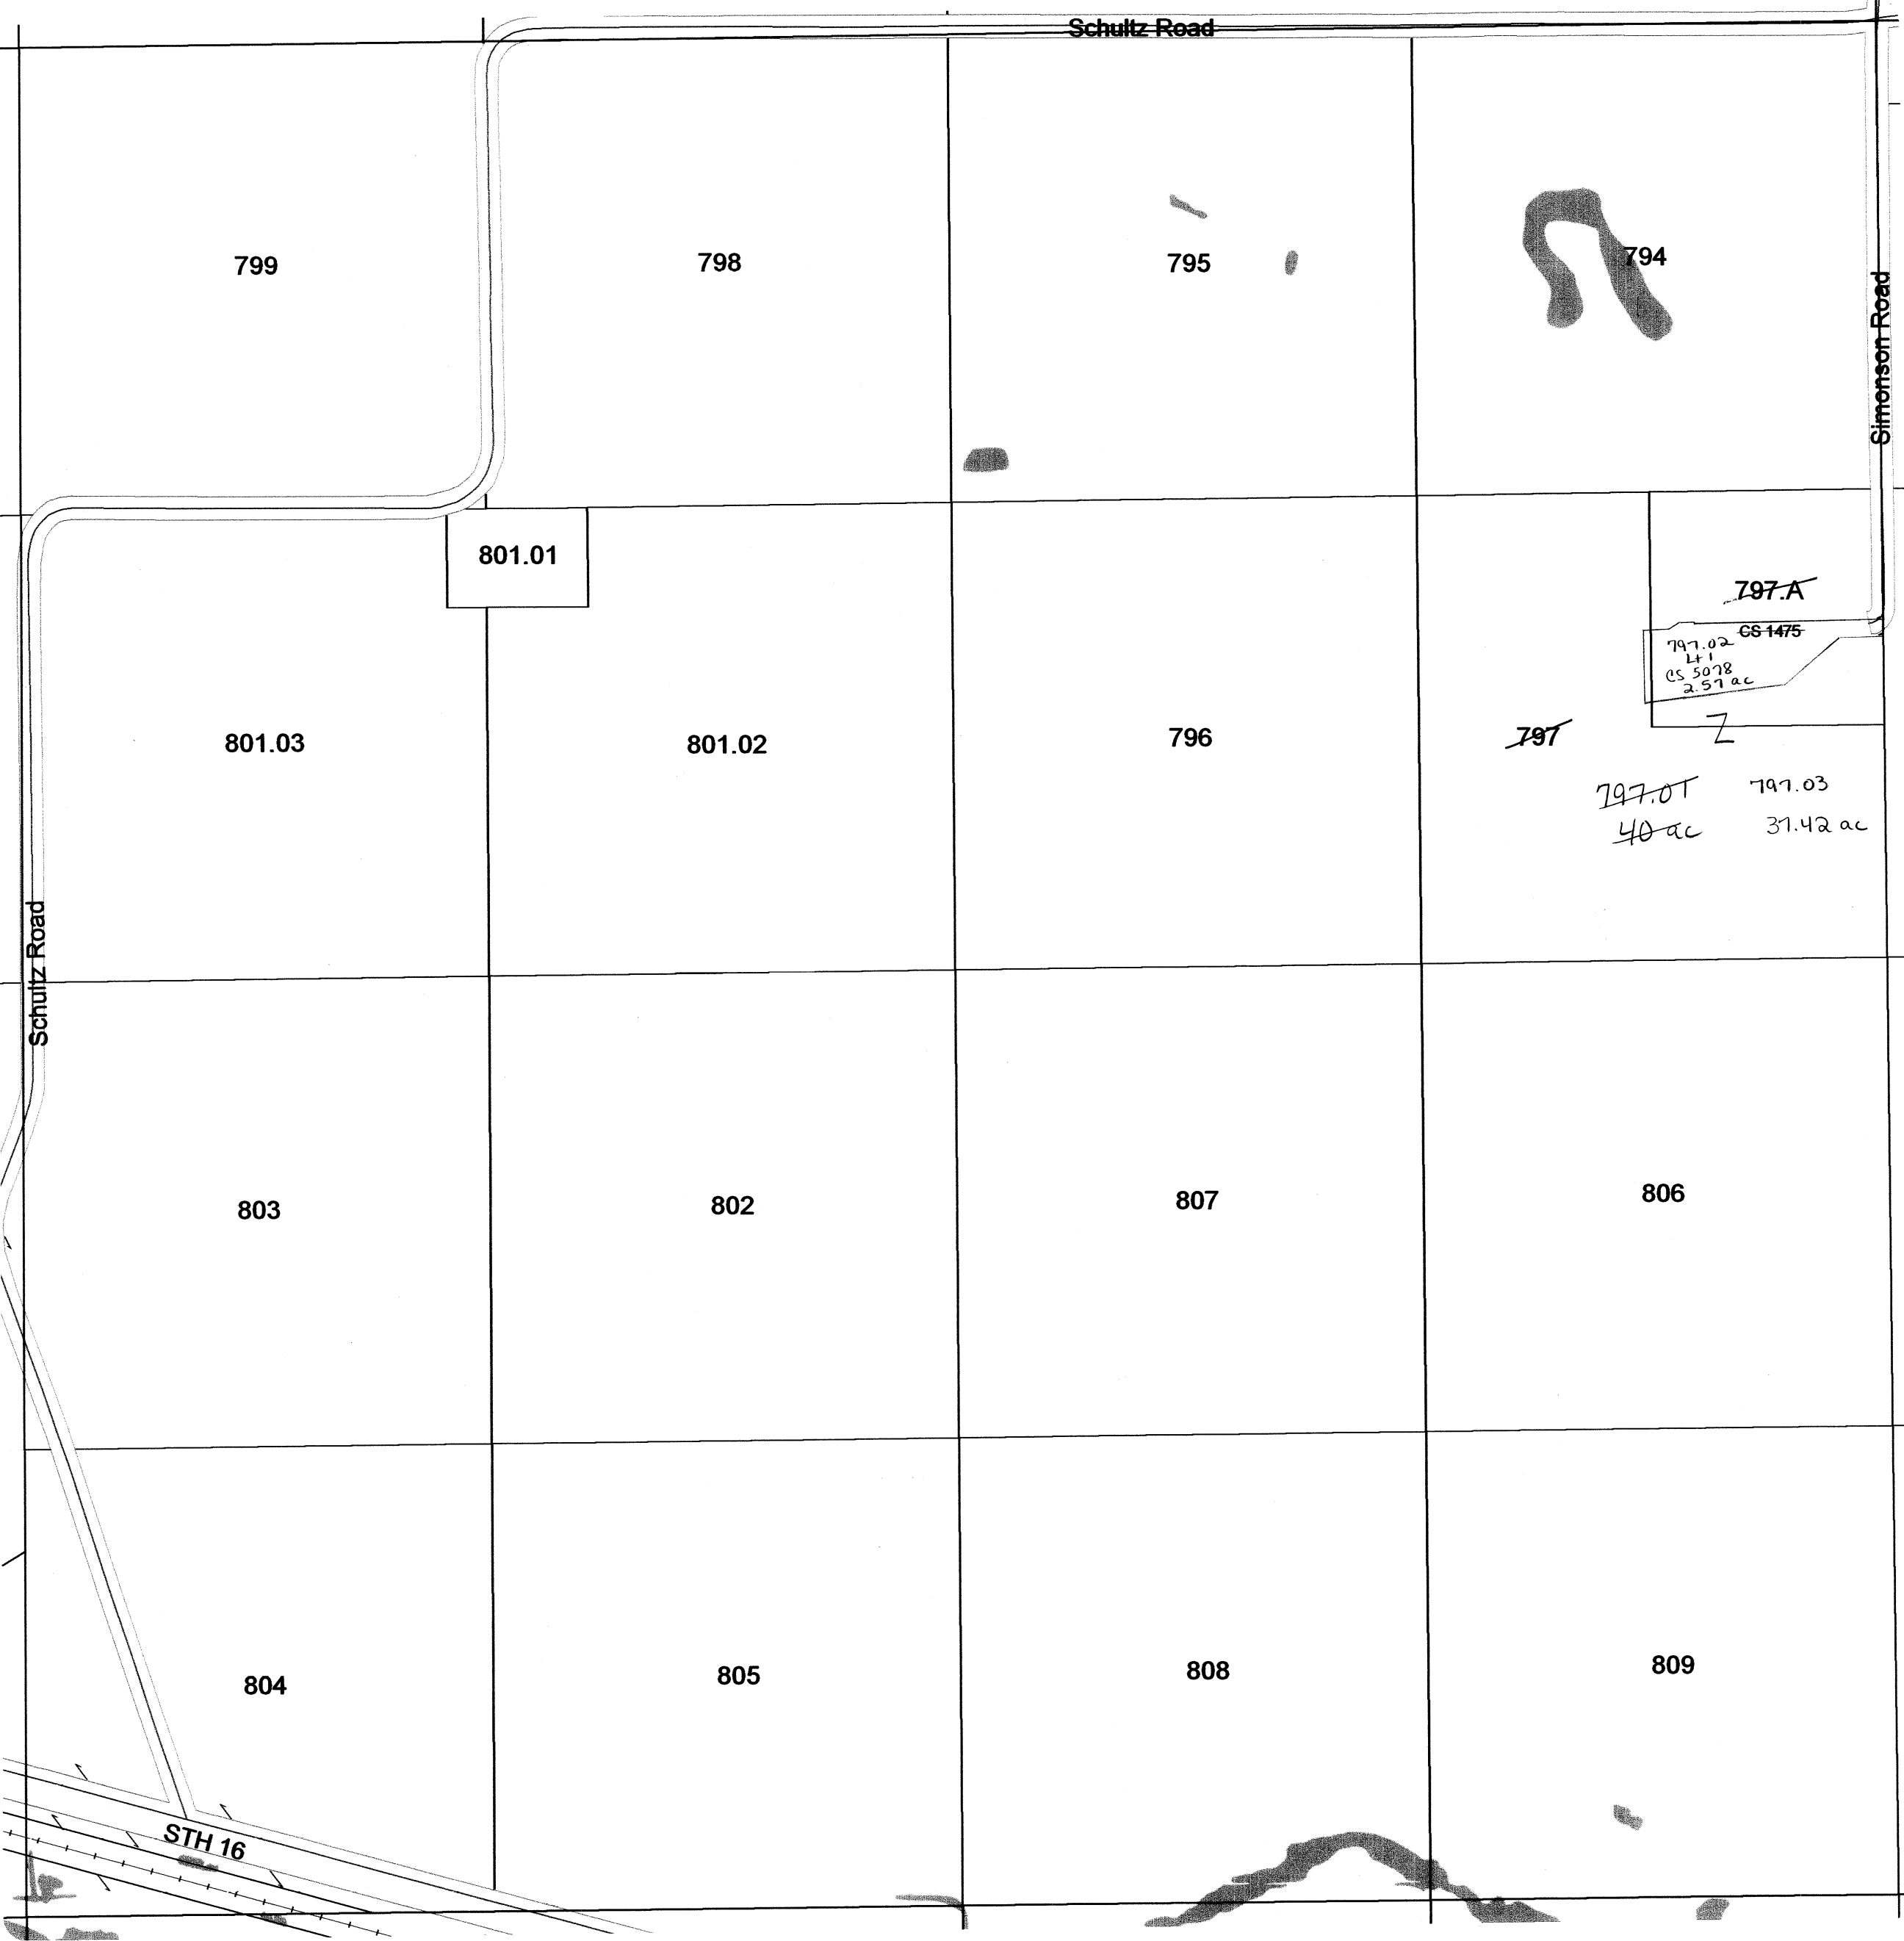


SEE SECTION 28 TOWN OF LEWISTON

SEE SECTION 32 TOWN OF LEWISTON


TOWN OF LEWISTON

SECTION 26 T13N R8E

1 inch = 400 feet 1:4,800

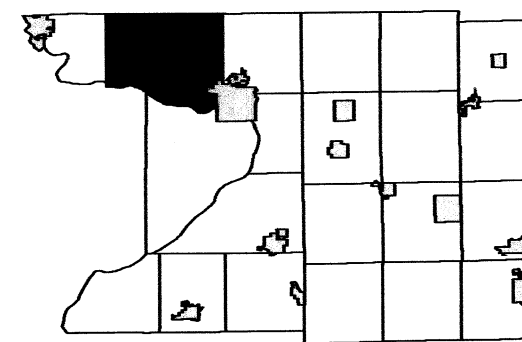

SEE SECTION 23 TOWN OF LEWISTON

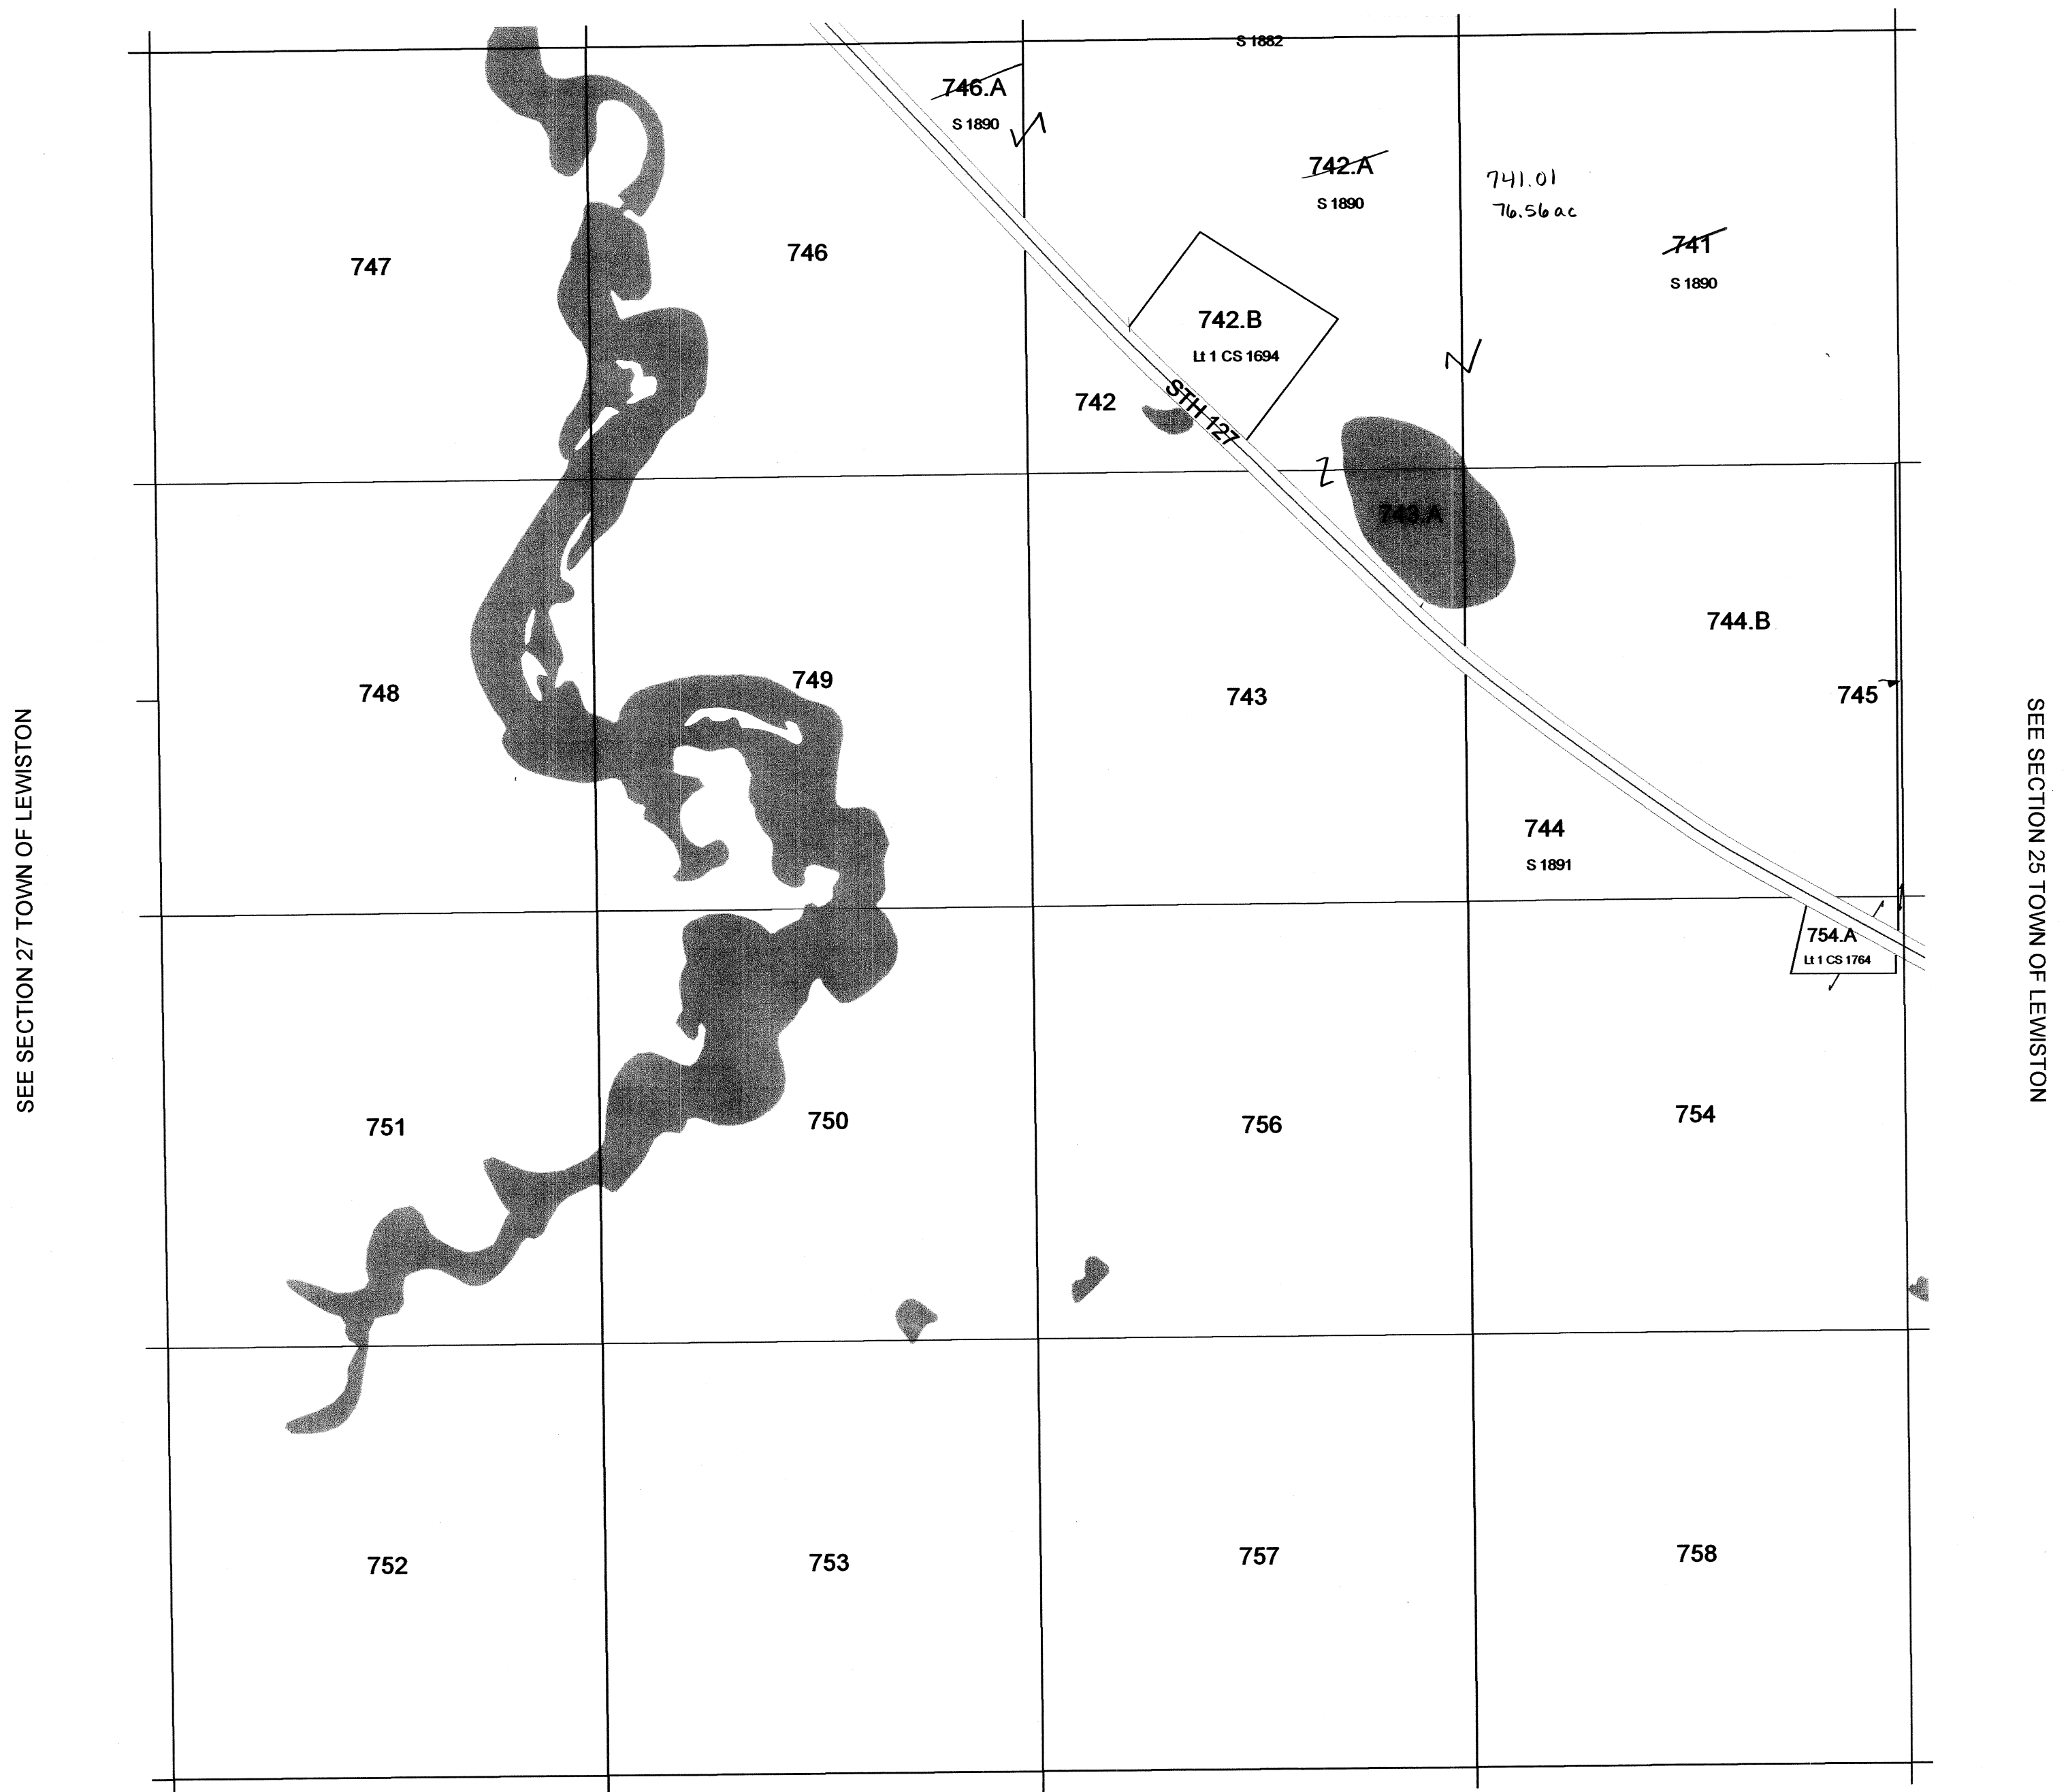

SEE SECTION 35 TOWN OF LEWISTON


Replaced
2010

Section 26
T13N R8E

TOWN OF LEWISTON

SECTION 22 T13N R8E

1 inch = 400 feet 1:4,800

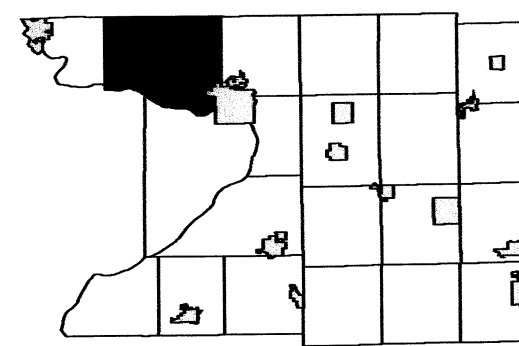


R7E					R8E				
3	2	1	6	5	4	3	2	1	
10	11	12	7	8	9	10	11	12	
15	14	13	18	17	16	15	14	13	T13N
22	23	24	19	20	21	22	23	24	
27	26	25	30	29	28	27	26	25	
34	33	32	31	32	33	34	35	36	T12N

SEE SECTION 15 TOWN OF LEWISTON


SEE SECTION 21 TOWN OF LEWISTON

SEE SECTION 23 TOWN OF LEWISTON

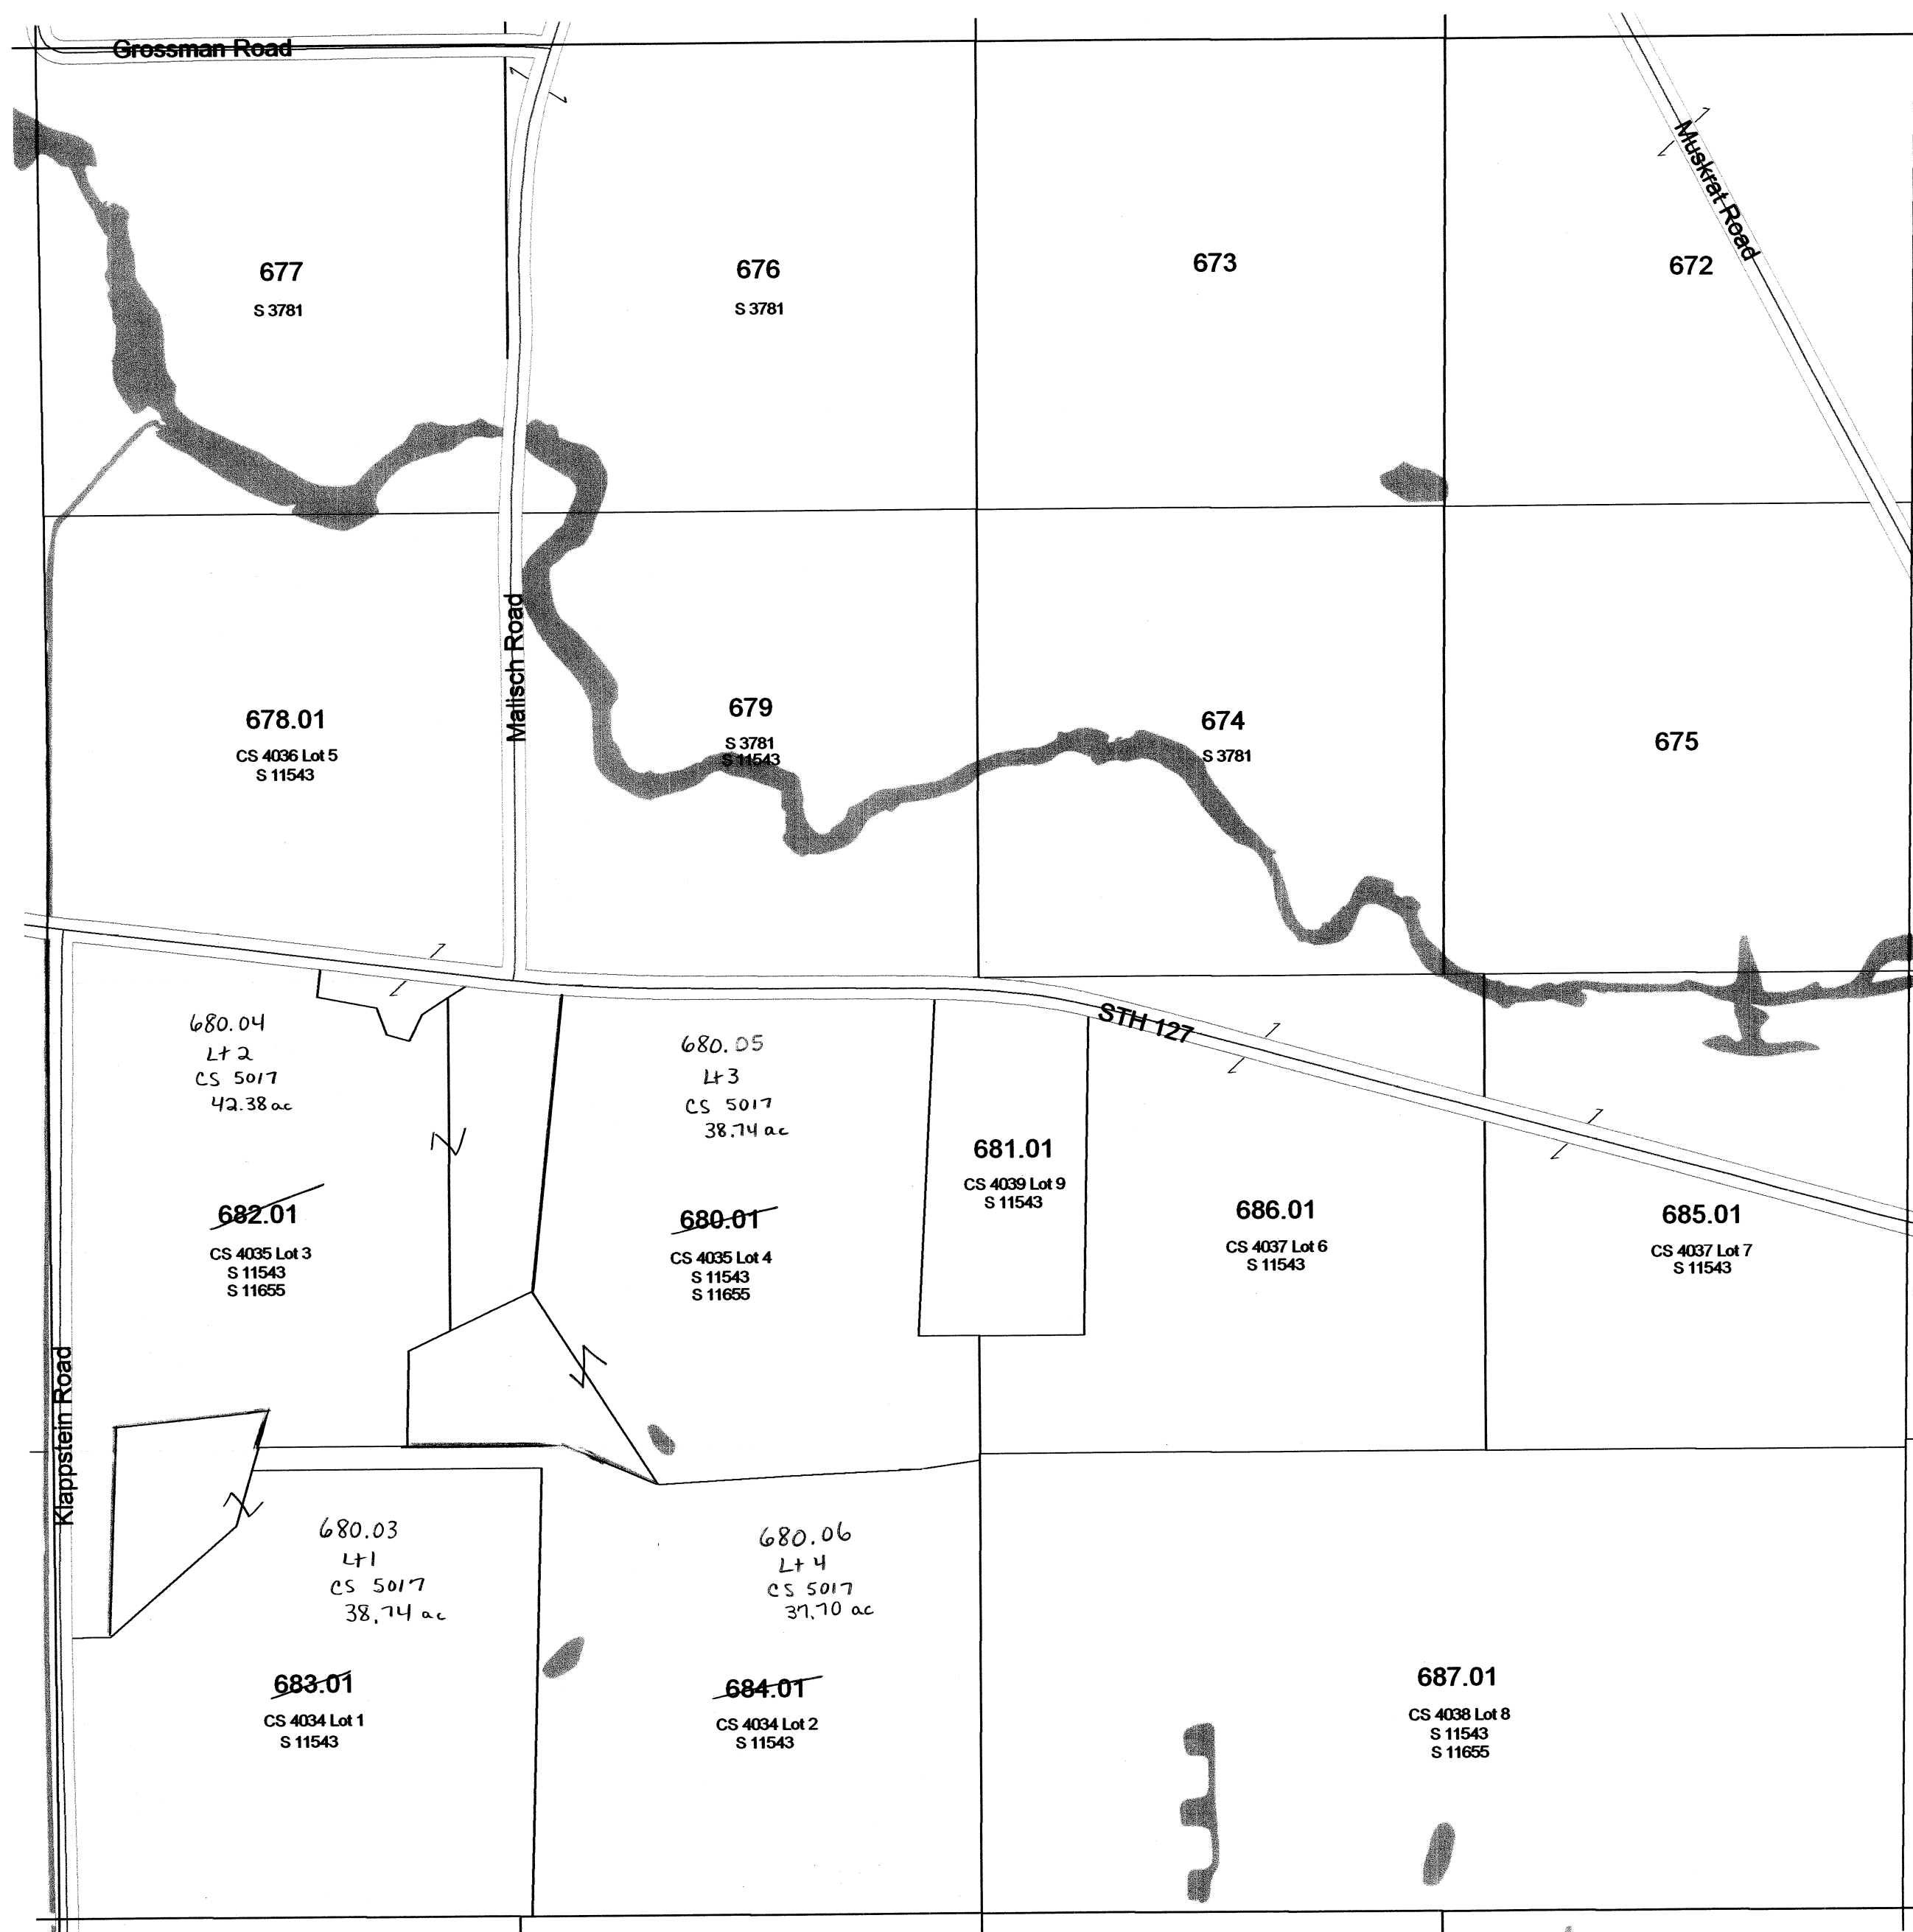


SEE SECTION 27 TOWN OF LEWISTON

1 inch = 400 feet 1:4,800

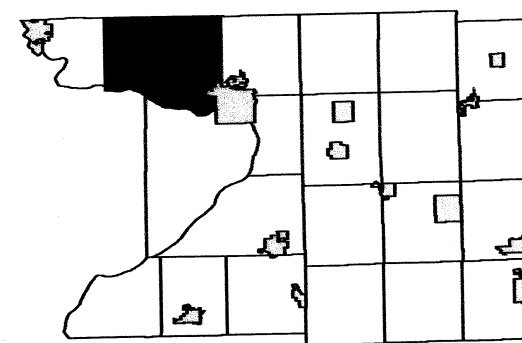

SEE SECTION 16 TOWN OF LEWISTON

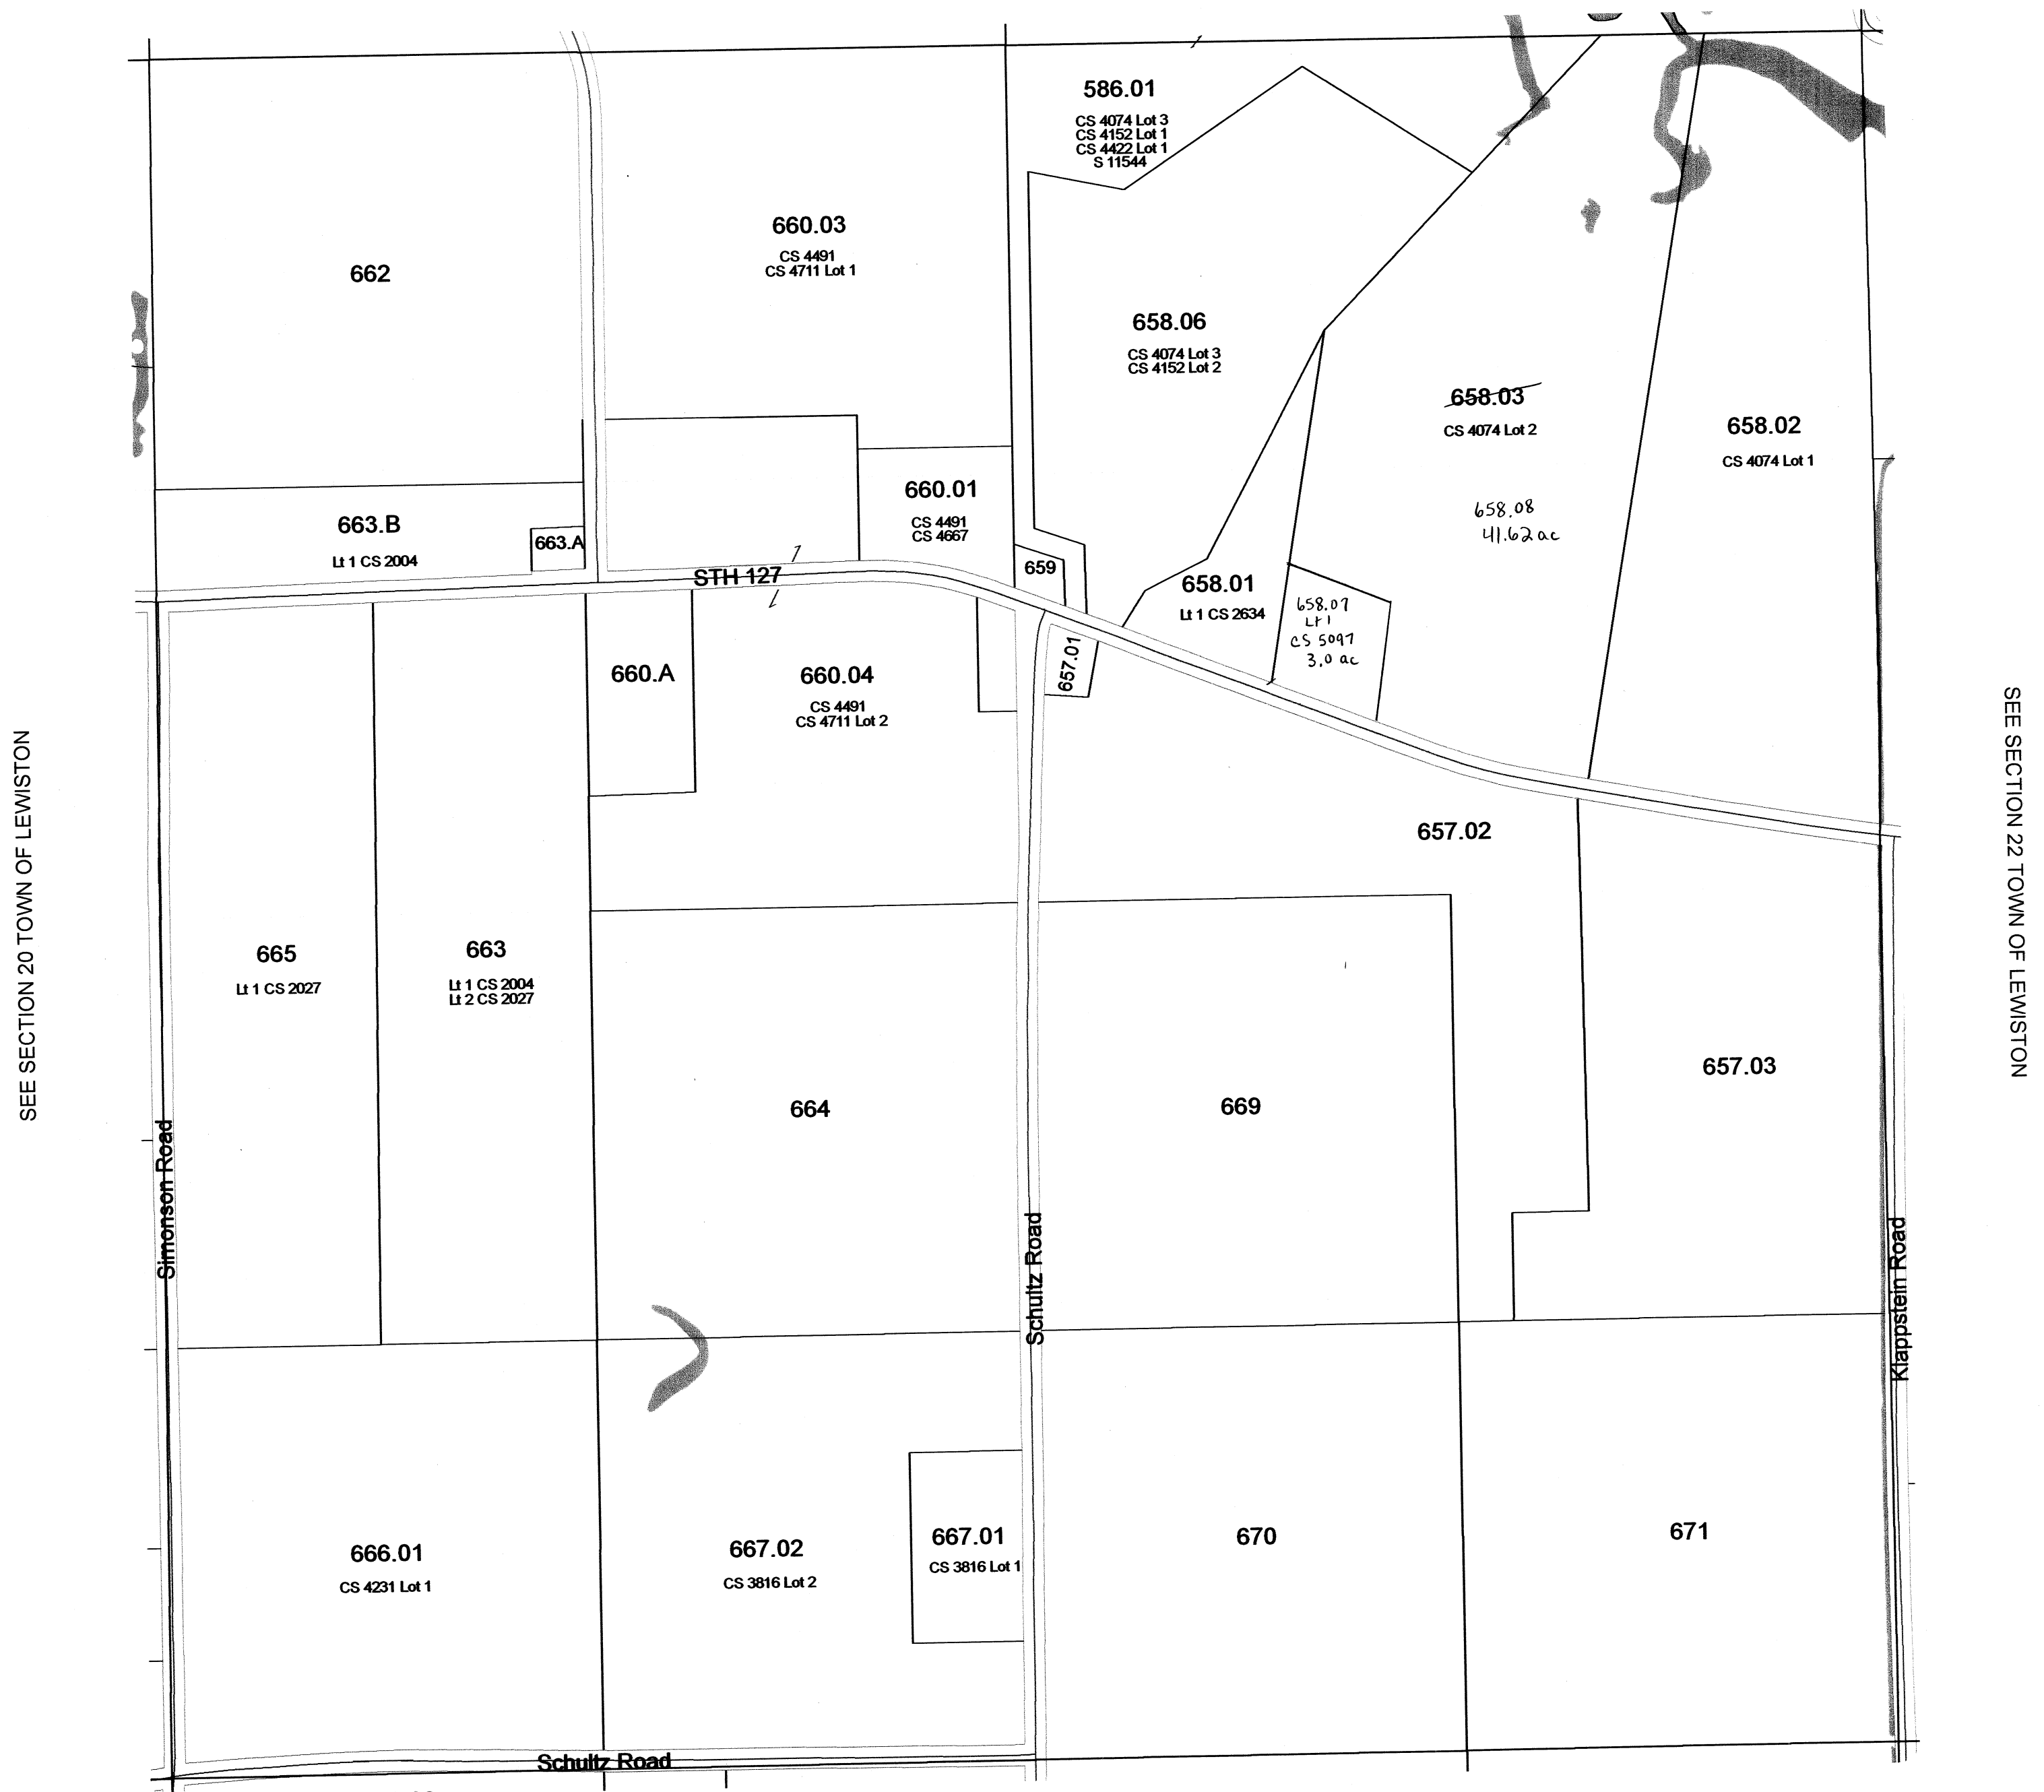

SEE SECTION 28 TOWN OF LEWISTON


Replaced
2010

Section 21
T13N R8E

TOWN OF LEWISTON

SECTION 14 T13N R8E

1 inch = 400 feet 1:4,800

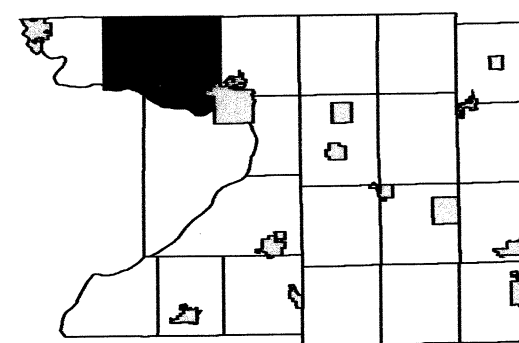


R7E			R8E			R9E		
3	2	1	6	5	4	3	2	1
10	11	12	7	8	9	10	11	12
15	14	13	18	17	16	15		13
22	23	24	19	20	21	22	23	24
27	26	25	30	29	28	27	26	25
34	35	36	31	32	33	34	35	36

TOWN OF LEWISTON

SECTION 4 T13N R8E


1 inch = 200 feet 1:2,400

SEE MARQUETTE COUNTY

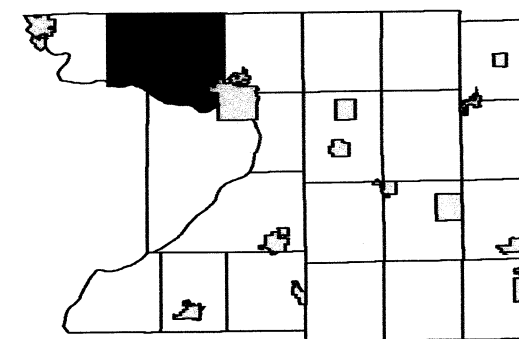

3	2	1	6	5	3	2	1
10	11	12	7	8	9	10	11
15	14	13	18	17	16	15	14
22	23	24	19	20	21	22	23
27	26	25	30	29	28	27	26
34	33	32	31	32	33	34	35
				5	4	3	2
						10	11


SEE SECTION 04 TOWN OF LEWISTON

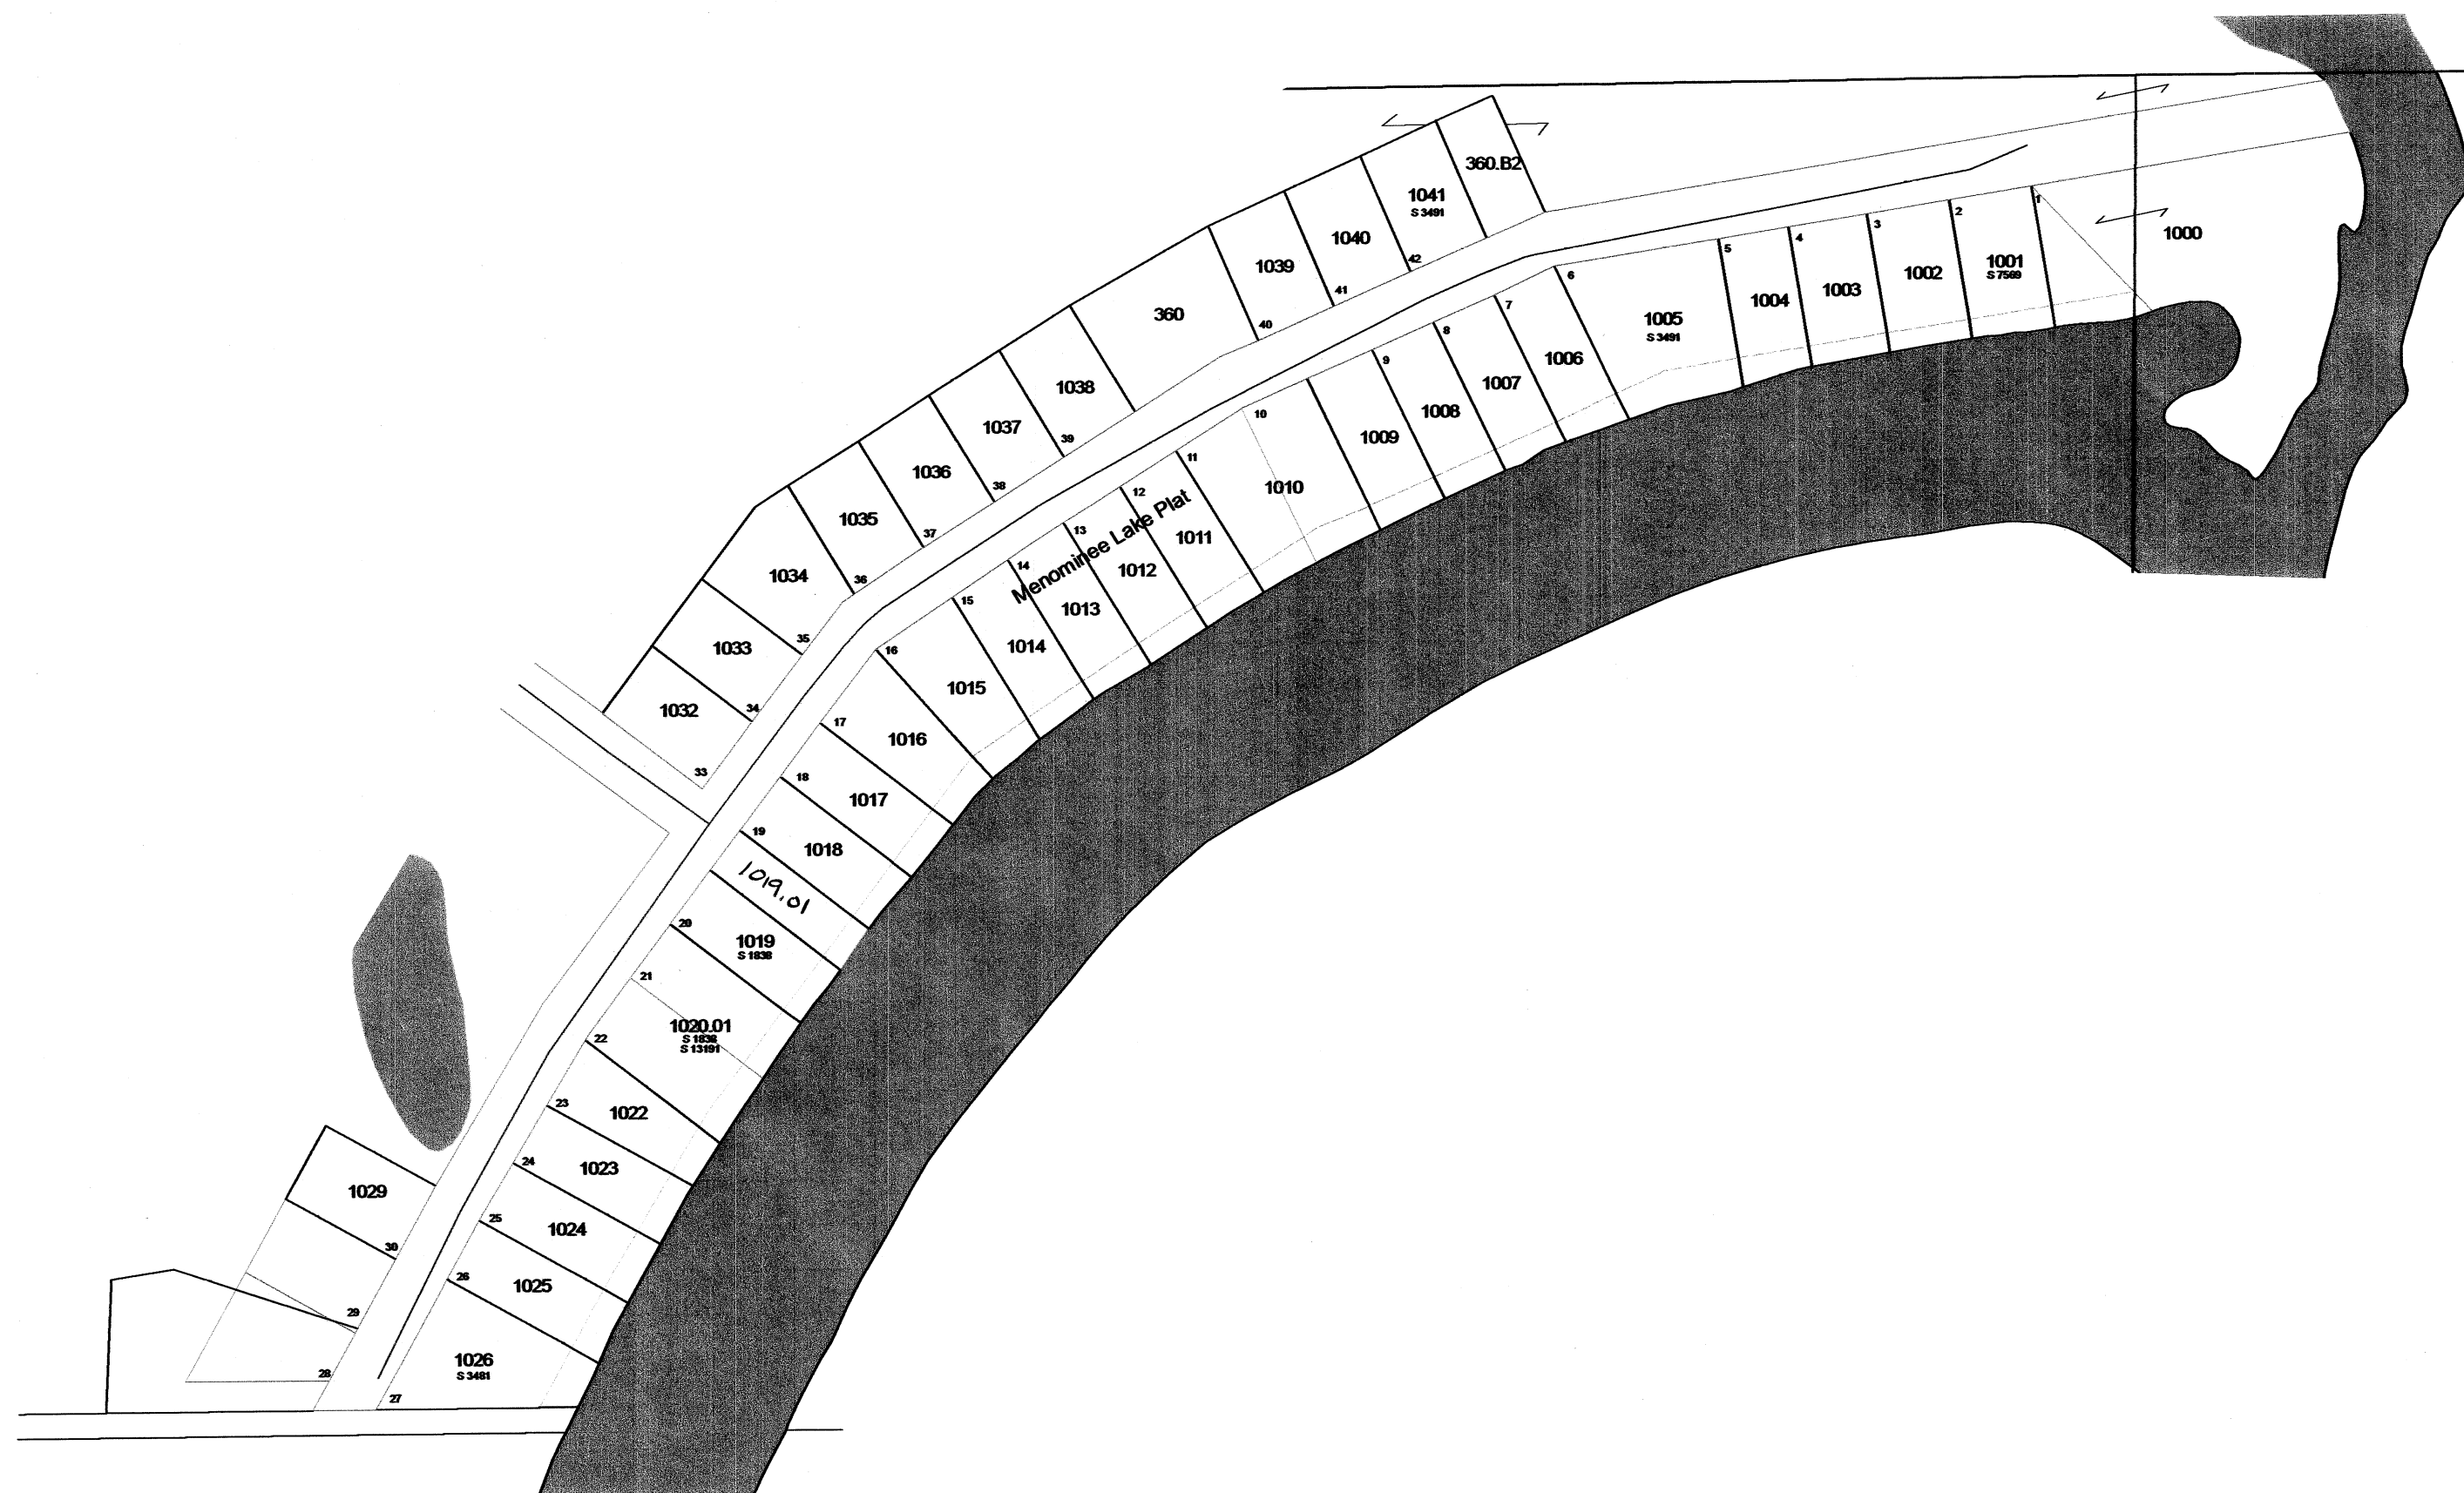

SEE SECTION 03 TOWN OF LEWISTON

SEE SECTION 04 TOWN OF LEWISTON

1 inch = 400 feet 1:4,800

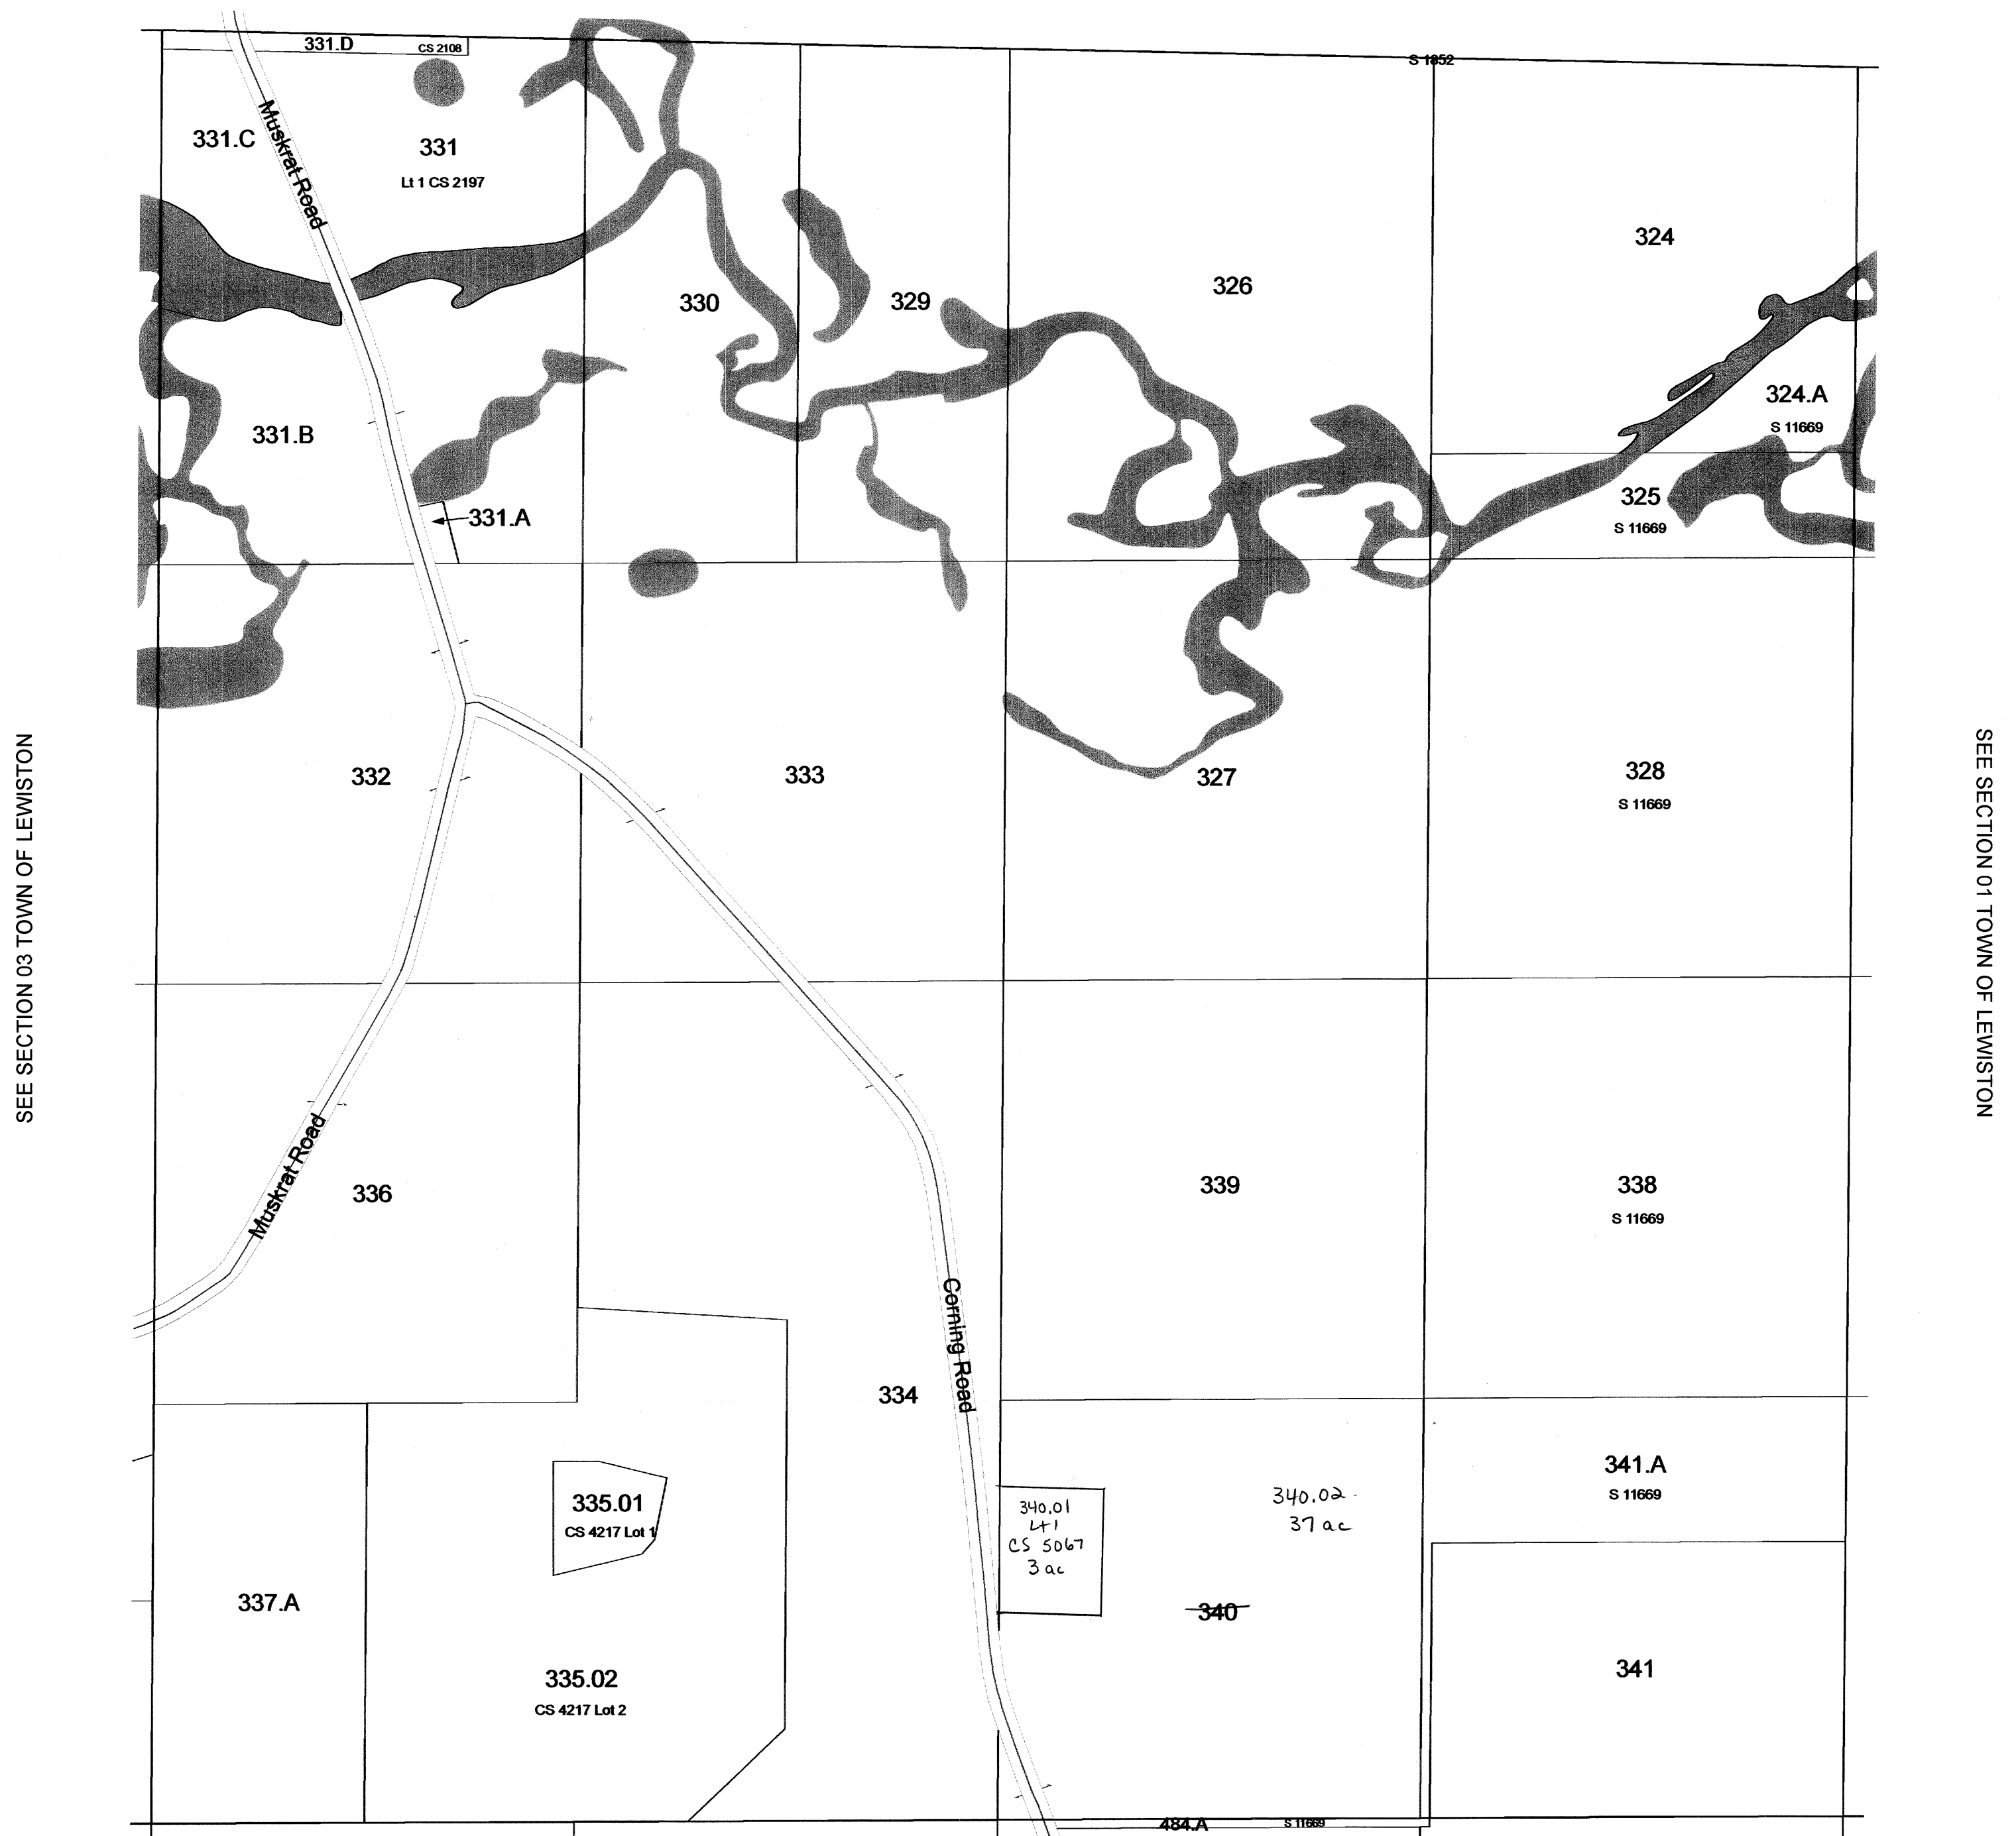


Section 02
T13N R8E

TOWN OF LEWISTON

SECTION 1 T13N R8E

1 inch = 400 feet 1:4,800

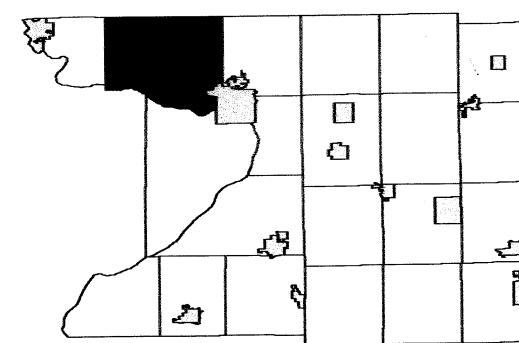


R7E						R8E					
3	2	1	6	5	4	3	2	1	6	5	4
10	11	12	7	8	9	10	11	12	1	2	3
15	14	13	18	17	16	15	14	13	24	23	22
22	23	24	19	20	21	22	23	24	31	30	29
27	26	25	30	29	28	27	26	25	36	35	34
34	35	36	31	32	33	34	35	36	4	3	2
									10	11	12

SEE MARQUETTE COUNTY

SEE SECTION 02 TOWN OF LEWISTON

SEE SECTION 06 TOWN OF FORT WINNEBAGO

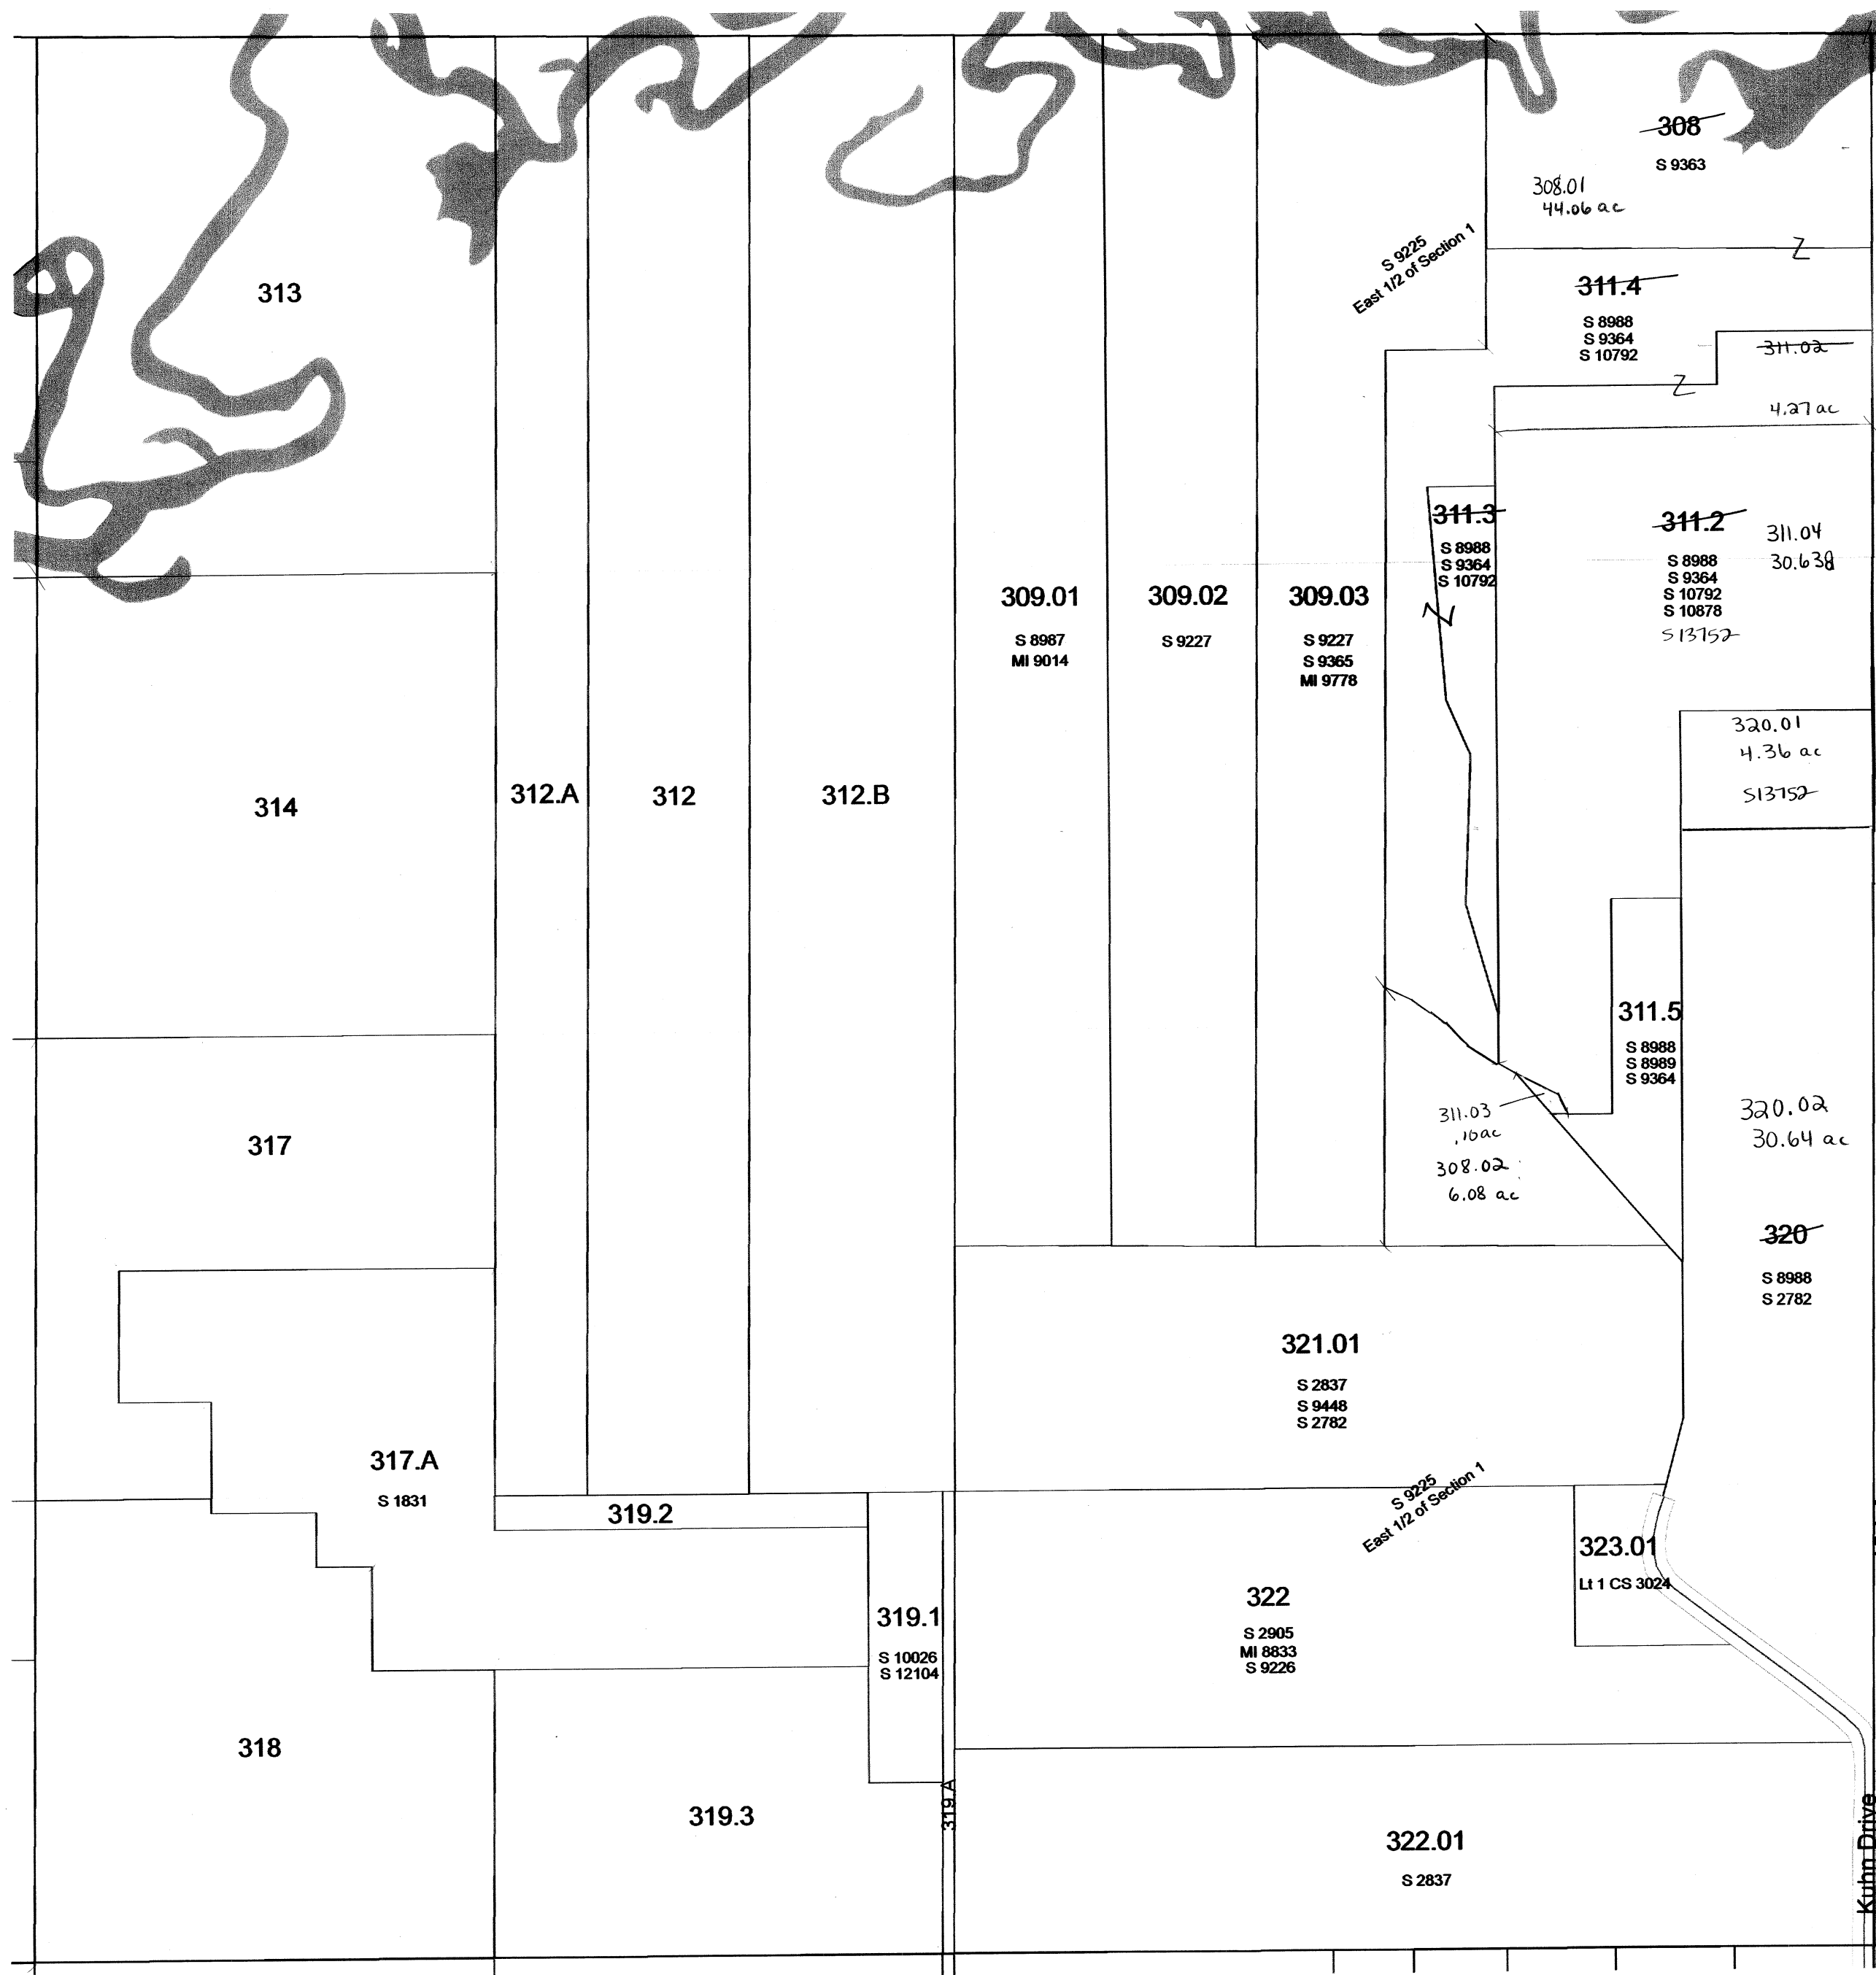


SEE SECTION 12 TOWN OF LEWISTON

Replaced
2010

TOWN OF LEWISTON

SECTION 25 T13N R7E


1 inch = 400 feet 1:4,800

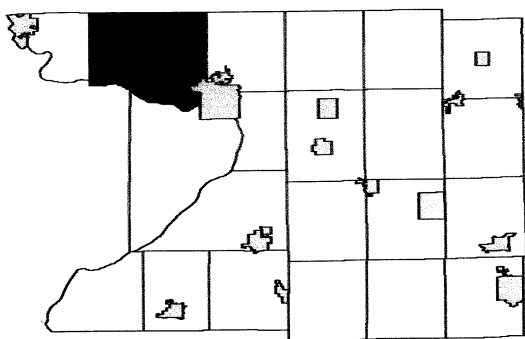

R7E						R8E					
3	2	1	6	5	4	3	2	1			
10	11	12	7	8	9	10	11	12			
15	14	13	18	17	16	15	14	13			
22	23	24	19	20	21	22	23	24			
27	26	25	30	29	28	27	26	25			
34	35	36	31	32	33	34	35	36			

SEE SECTION 24 TOWN OF LEWISTON

SEE SECTION 26 TOWN OF LEWISTON

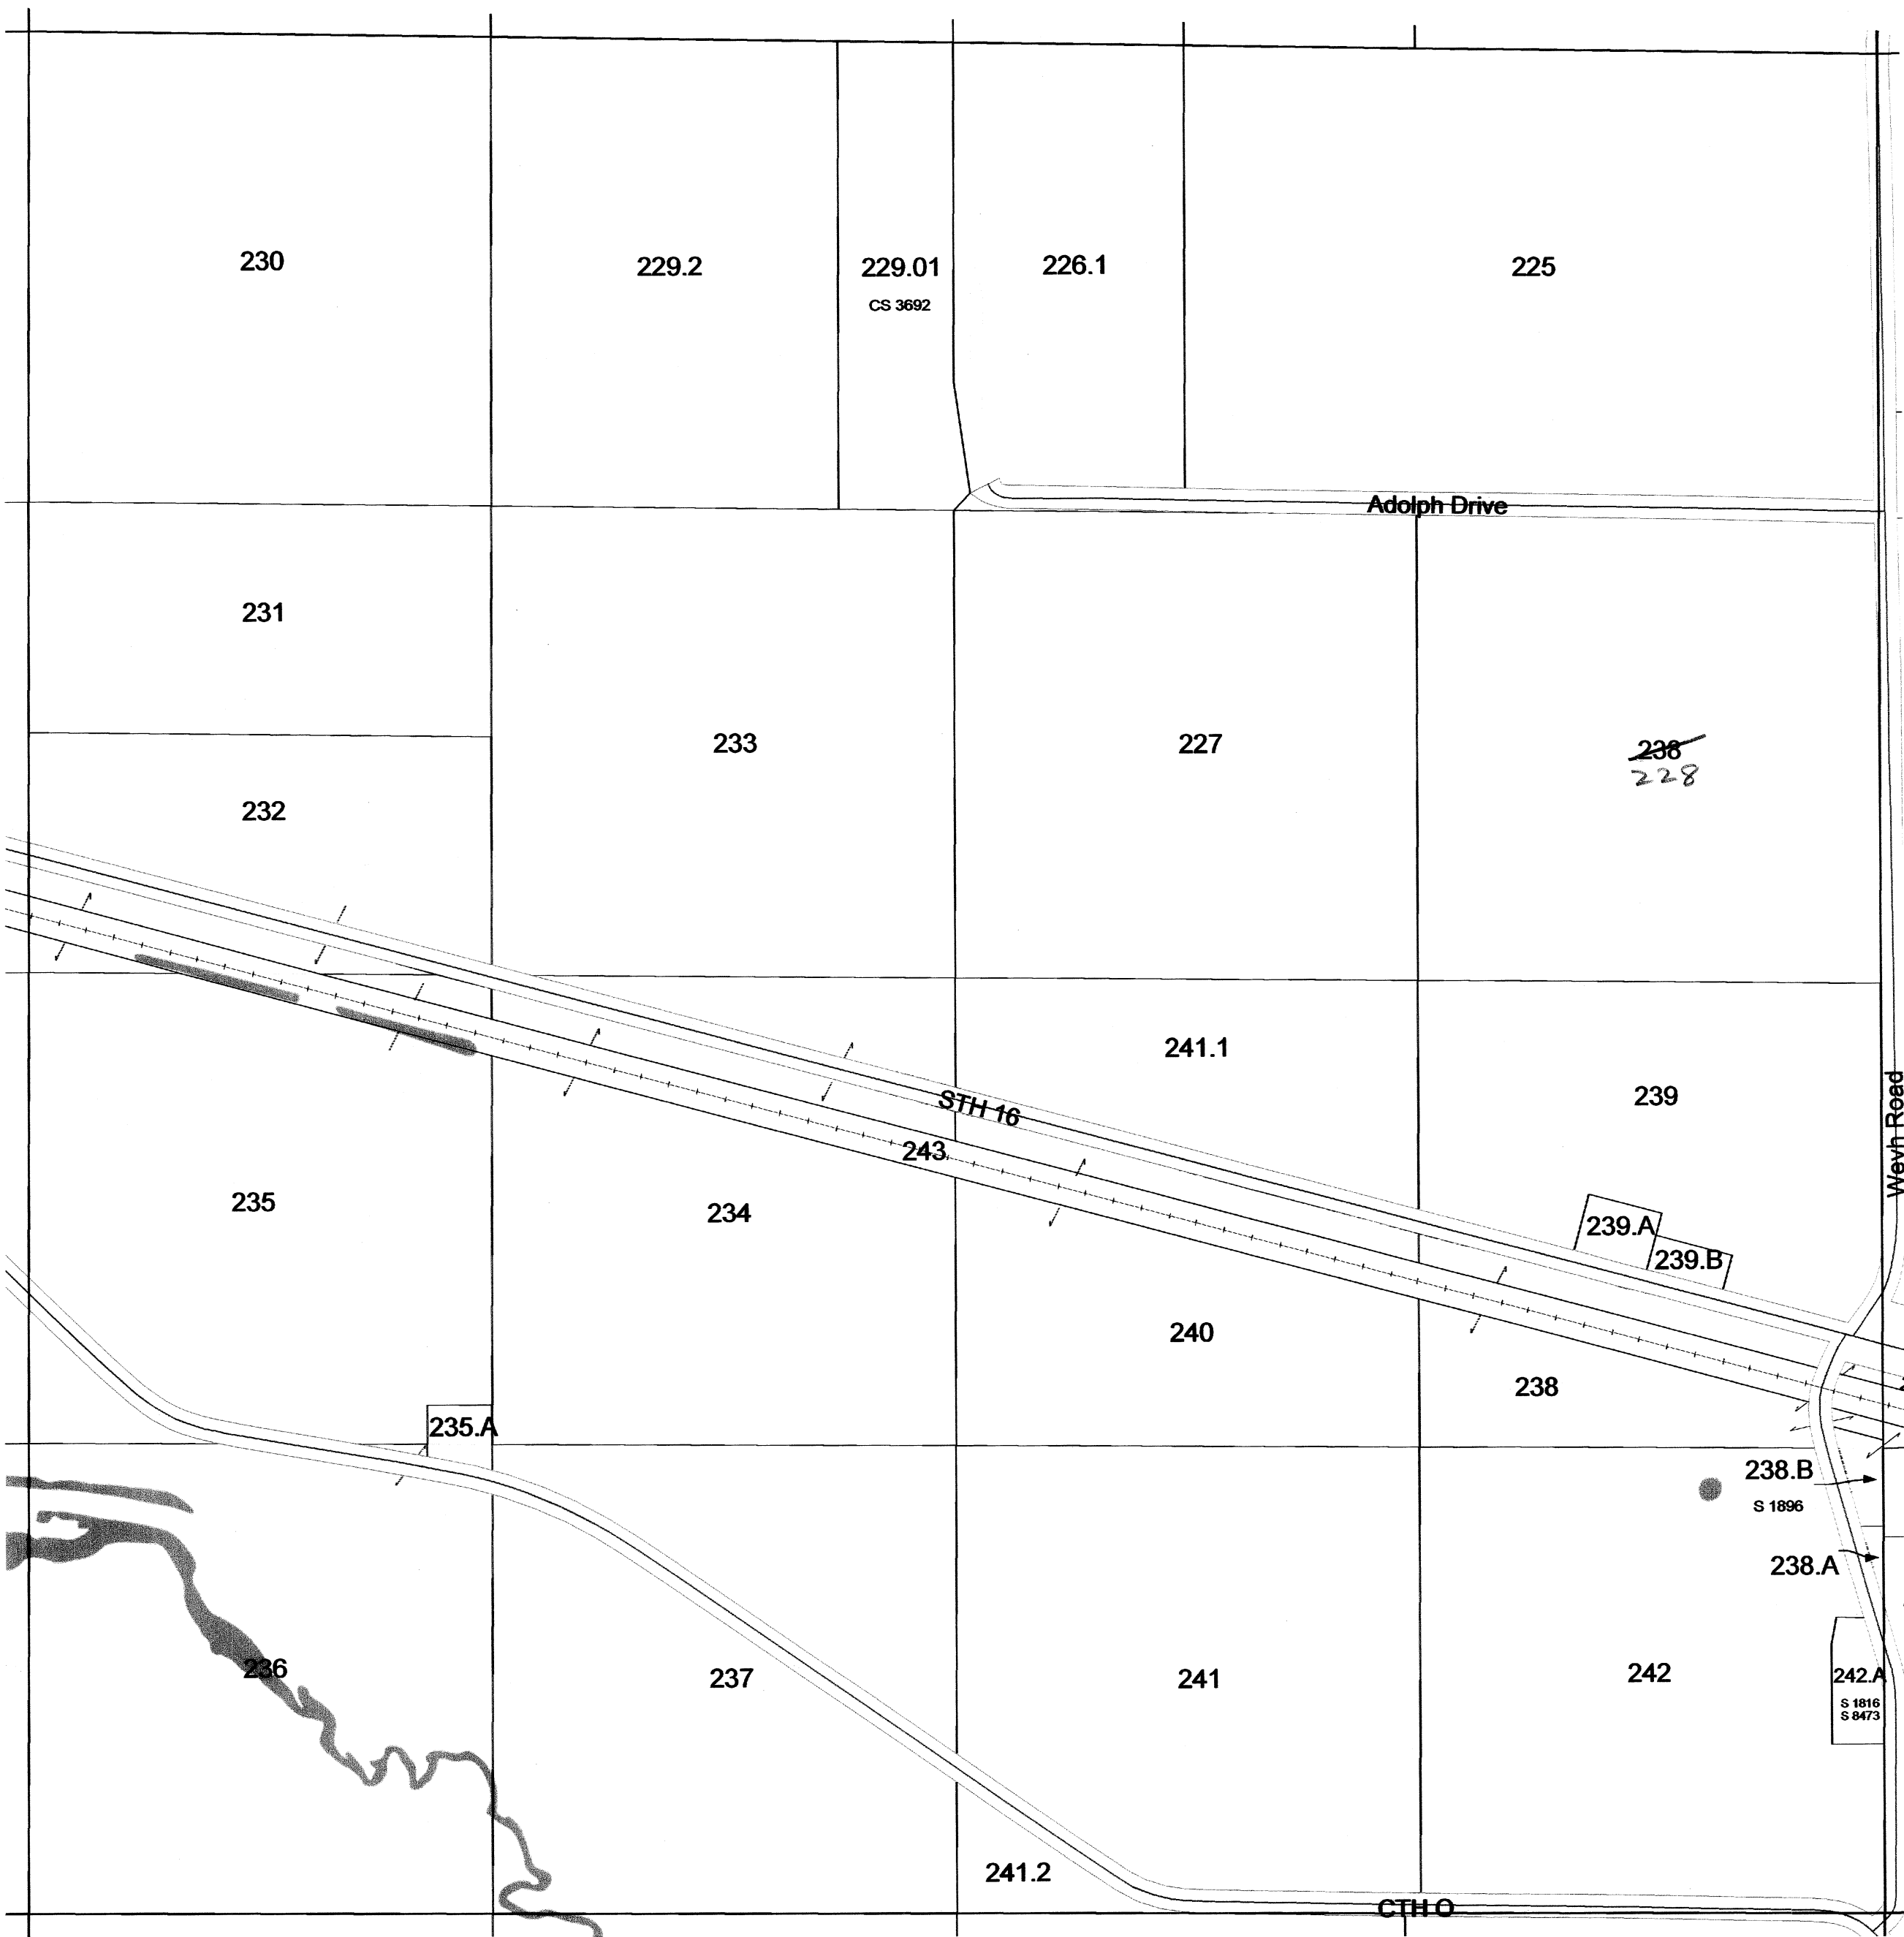


SEE SECTION 30 TOWN OF LEWISTON

SEE SECTION 36 TOWN OF LEWISTON

TOWN OF LEWISTON

SECTION 22 T13N R7E

1 inch = 400 feet 1:4,800

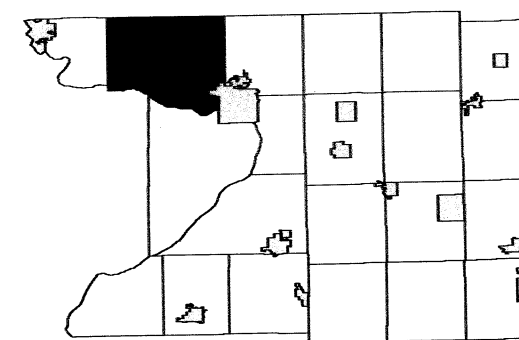

R7E						R8E					
3	2	1	6	5	4	3	2	1			
10	11	12	7	8	9	10	11	12			
15	14	13	18	17	16	15	14	13			
	23	24	19	20	21	22	23	24	T13N		
27	26	25	30	29	28	27	26	25			
34	35	36	31	32	33	34	35	36			
									T12N		
									10	11	12

SEE SECTION 15 TOWN OF LEWISTON

SEE SECTION 21 TOWN OF NEWPORT

SEE SECTION 23 TOWN OF LEWISTON




SEE SECTION 27 TOWN OF LEWISTON

Replaced
2010

TOWN OF LEWISTON

SECTION 12 T13N R7E

1 inch = 400 feet 1:4,800

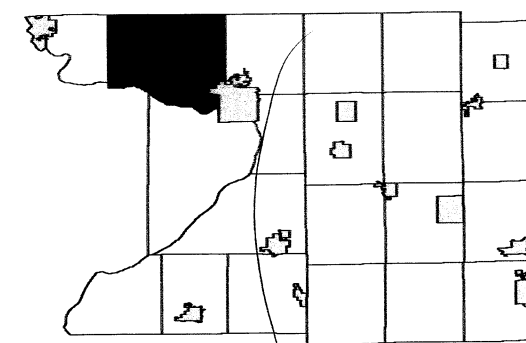


R7E					R8E				
3	2	1	6	5	4	3	2	1	
10	11		7	8	9	10	11	12	
15	14	13	18	17	16	15	14	13	
22	23	24	19	20	21	22	23	24	T13N
27	26	25	30	29	28	27	26	25	
34	35	36	31	32	33	34	35	36	
									T12N

SEE SECTION 01 TOWN OF LEWISTON

SEE SECTION 11 TOWN OF LEWISTON

SEE SECTION 07 TOWN OF LEWISTON

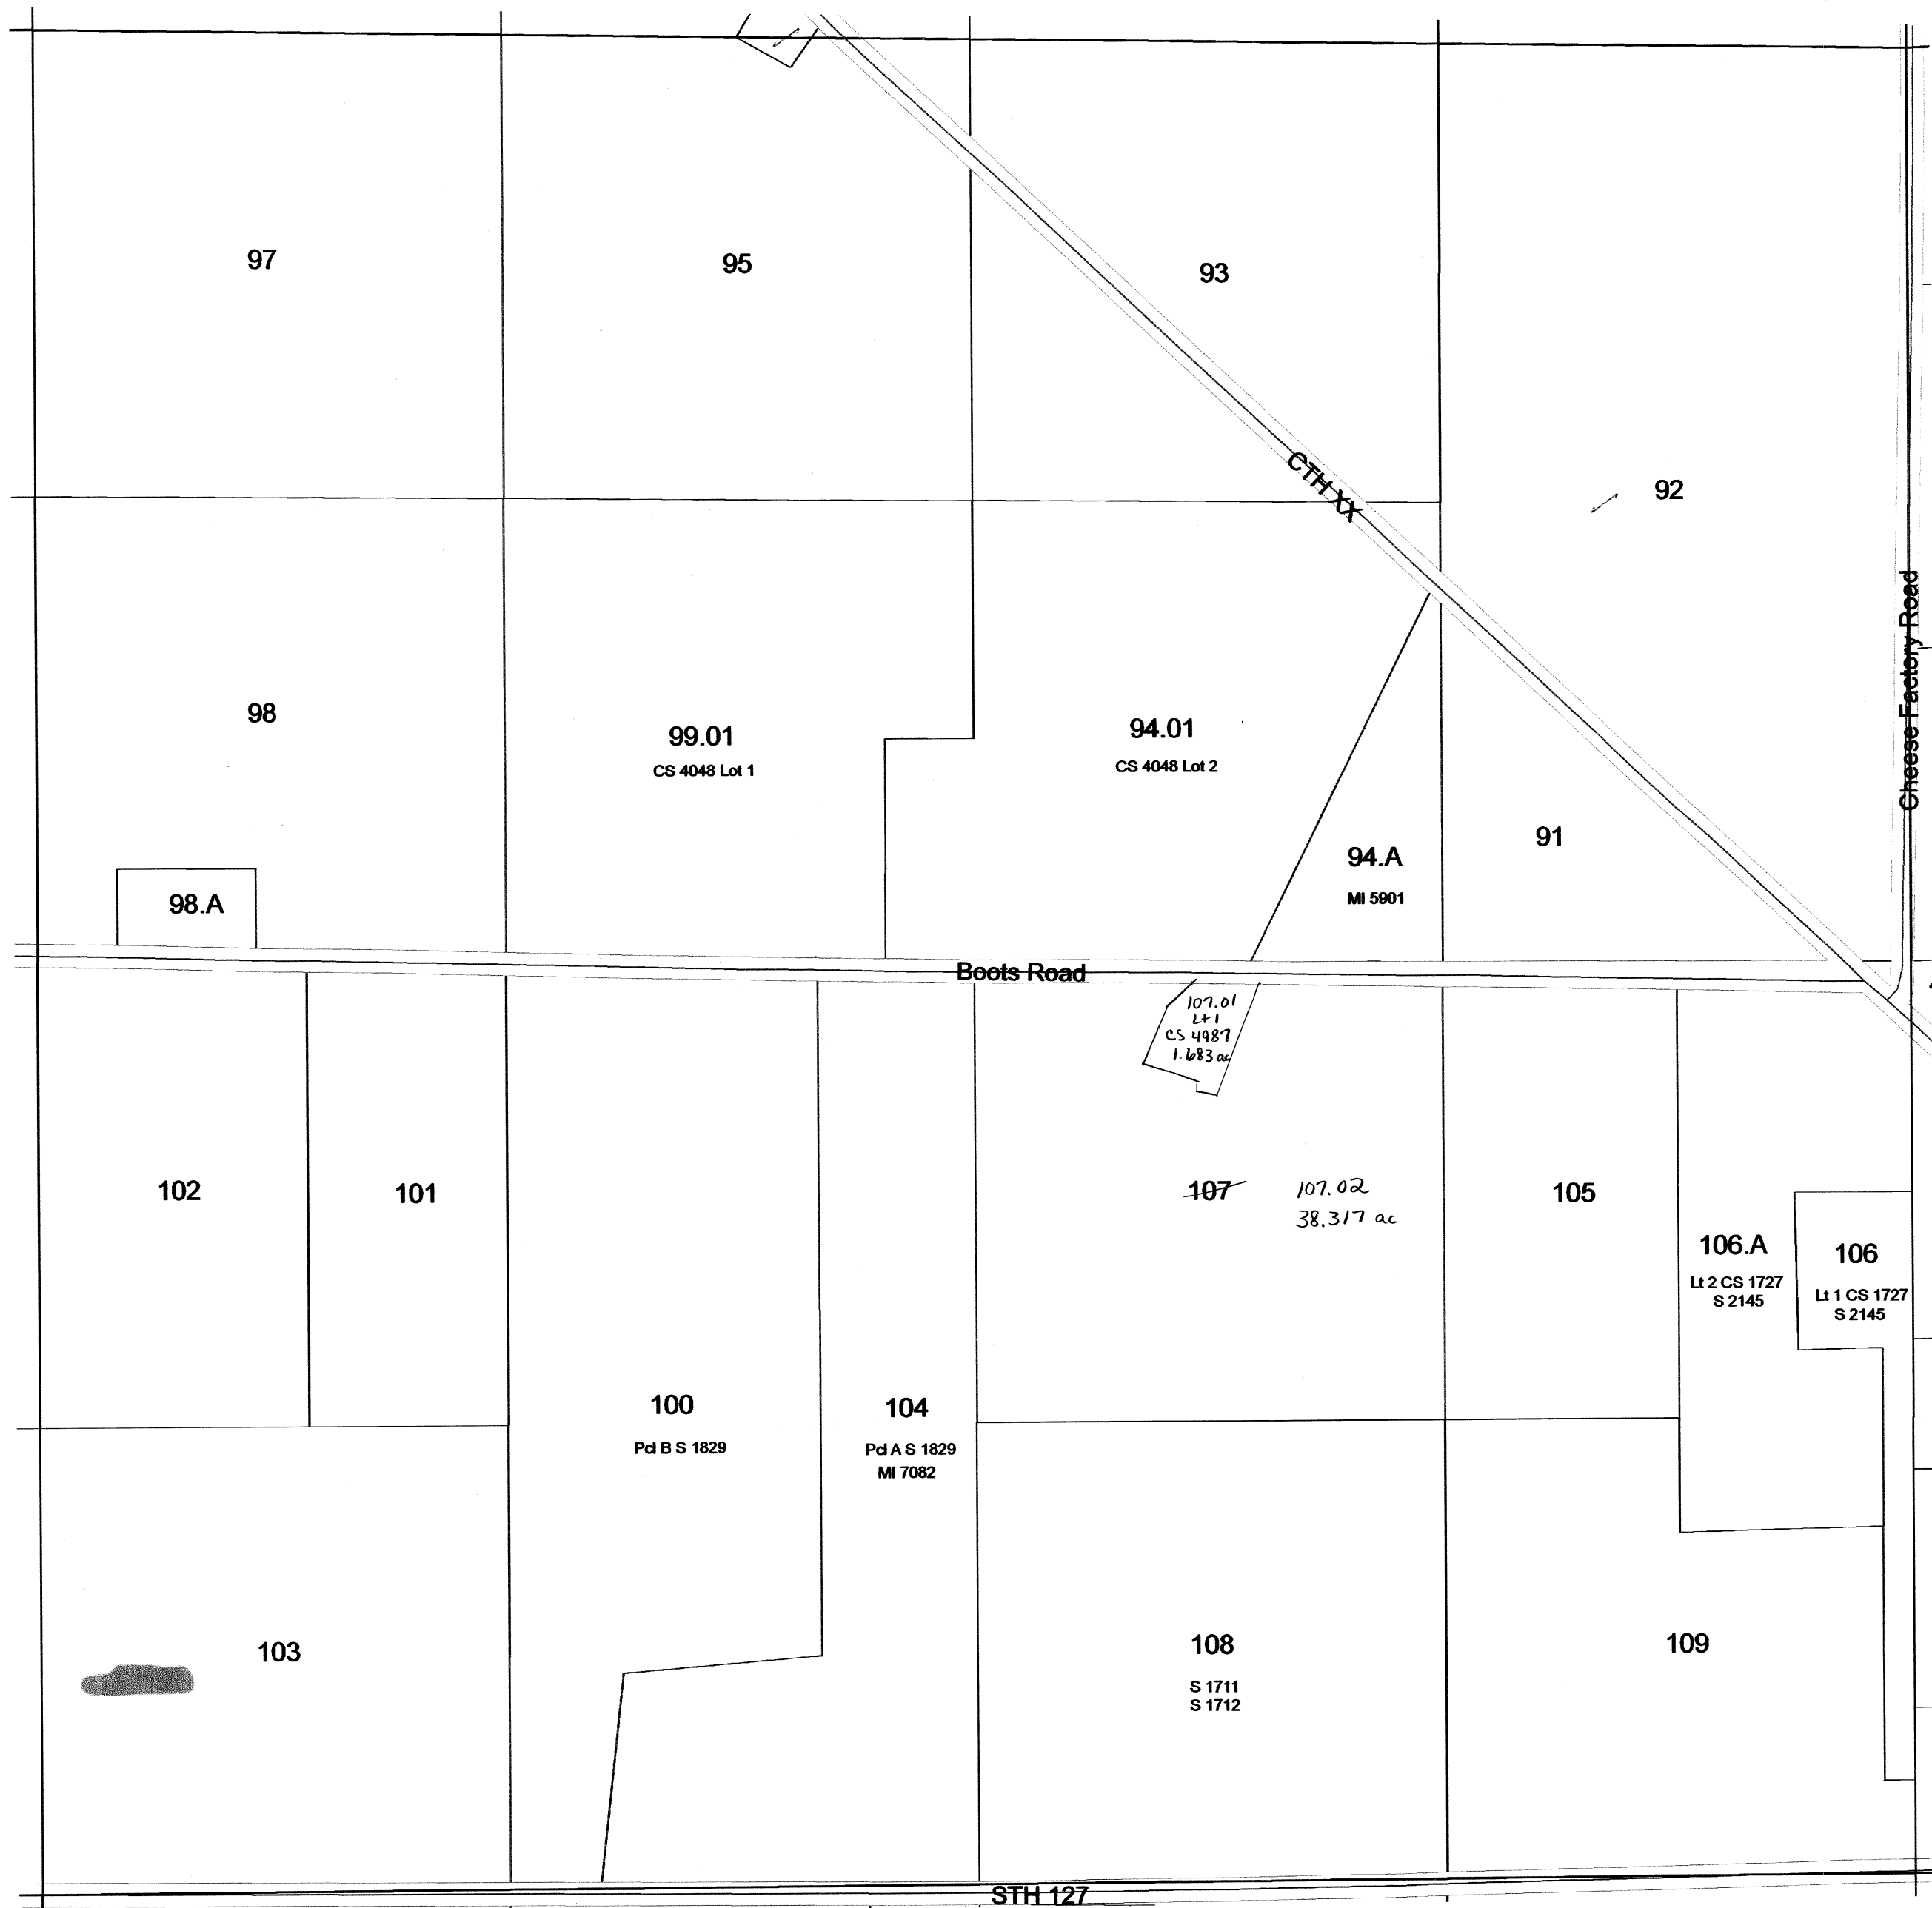

SEE SECTION 13 TOWN OF LEWISTON


1 inch = 400 feet 1:4,800

3	2	1	6	5	4	3	2	1
10	11	12	7	8	9	10	11	12
15	14	13	18	17	16	15	14	13
22	23	24	19	20	21	22	23	24
27	26	25	30	29	28	27	26	25
34	35	36	31	32	33	34	35	36
				5		3	2	1
						10	11	12




1 inch = 400 feet 1:4,800

1 inch = 400 feet 1:4,800

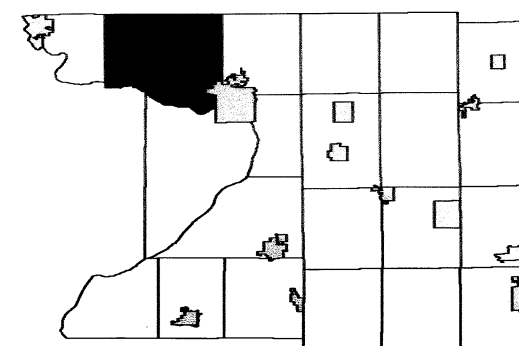

3	2	1	6	5	4	3	2
10	11	12	7	8	9	10	11
15	14	13	18	17	16	15	14
22	23	24	19	20	21	22	23
27	26	25	30	29	28	27	26
34	35	36	31	32	33	34	35
				5	4	3	2

SEE CITY OF PORTAGE

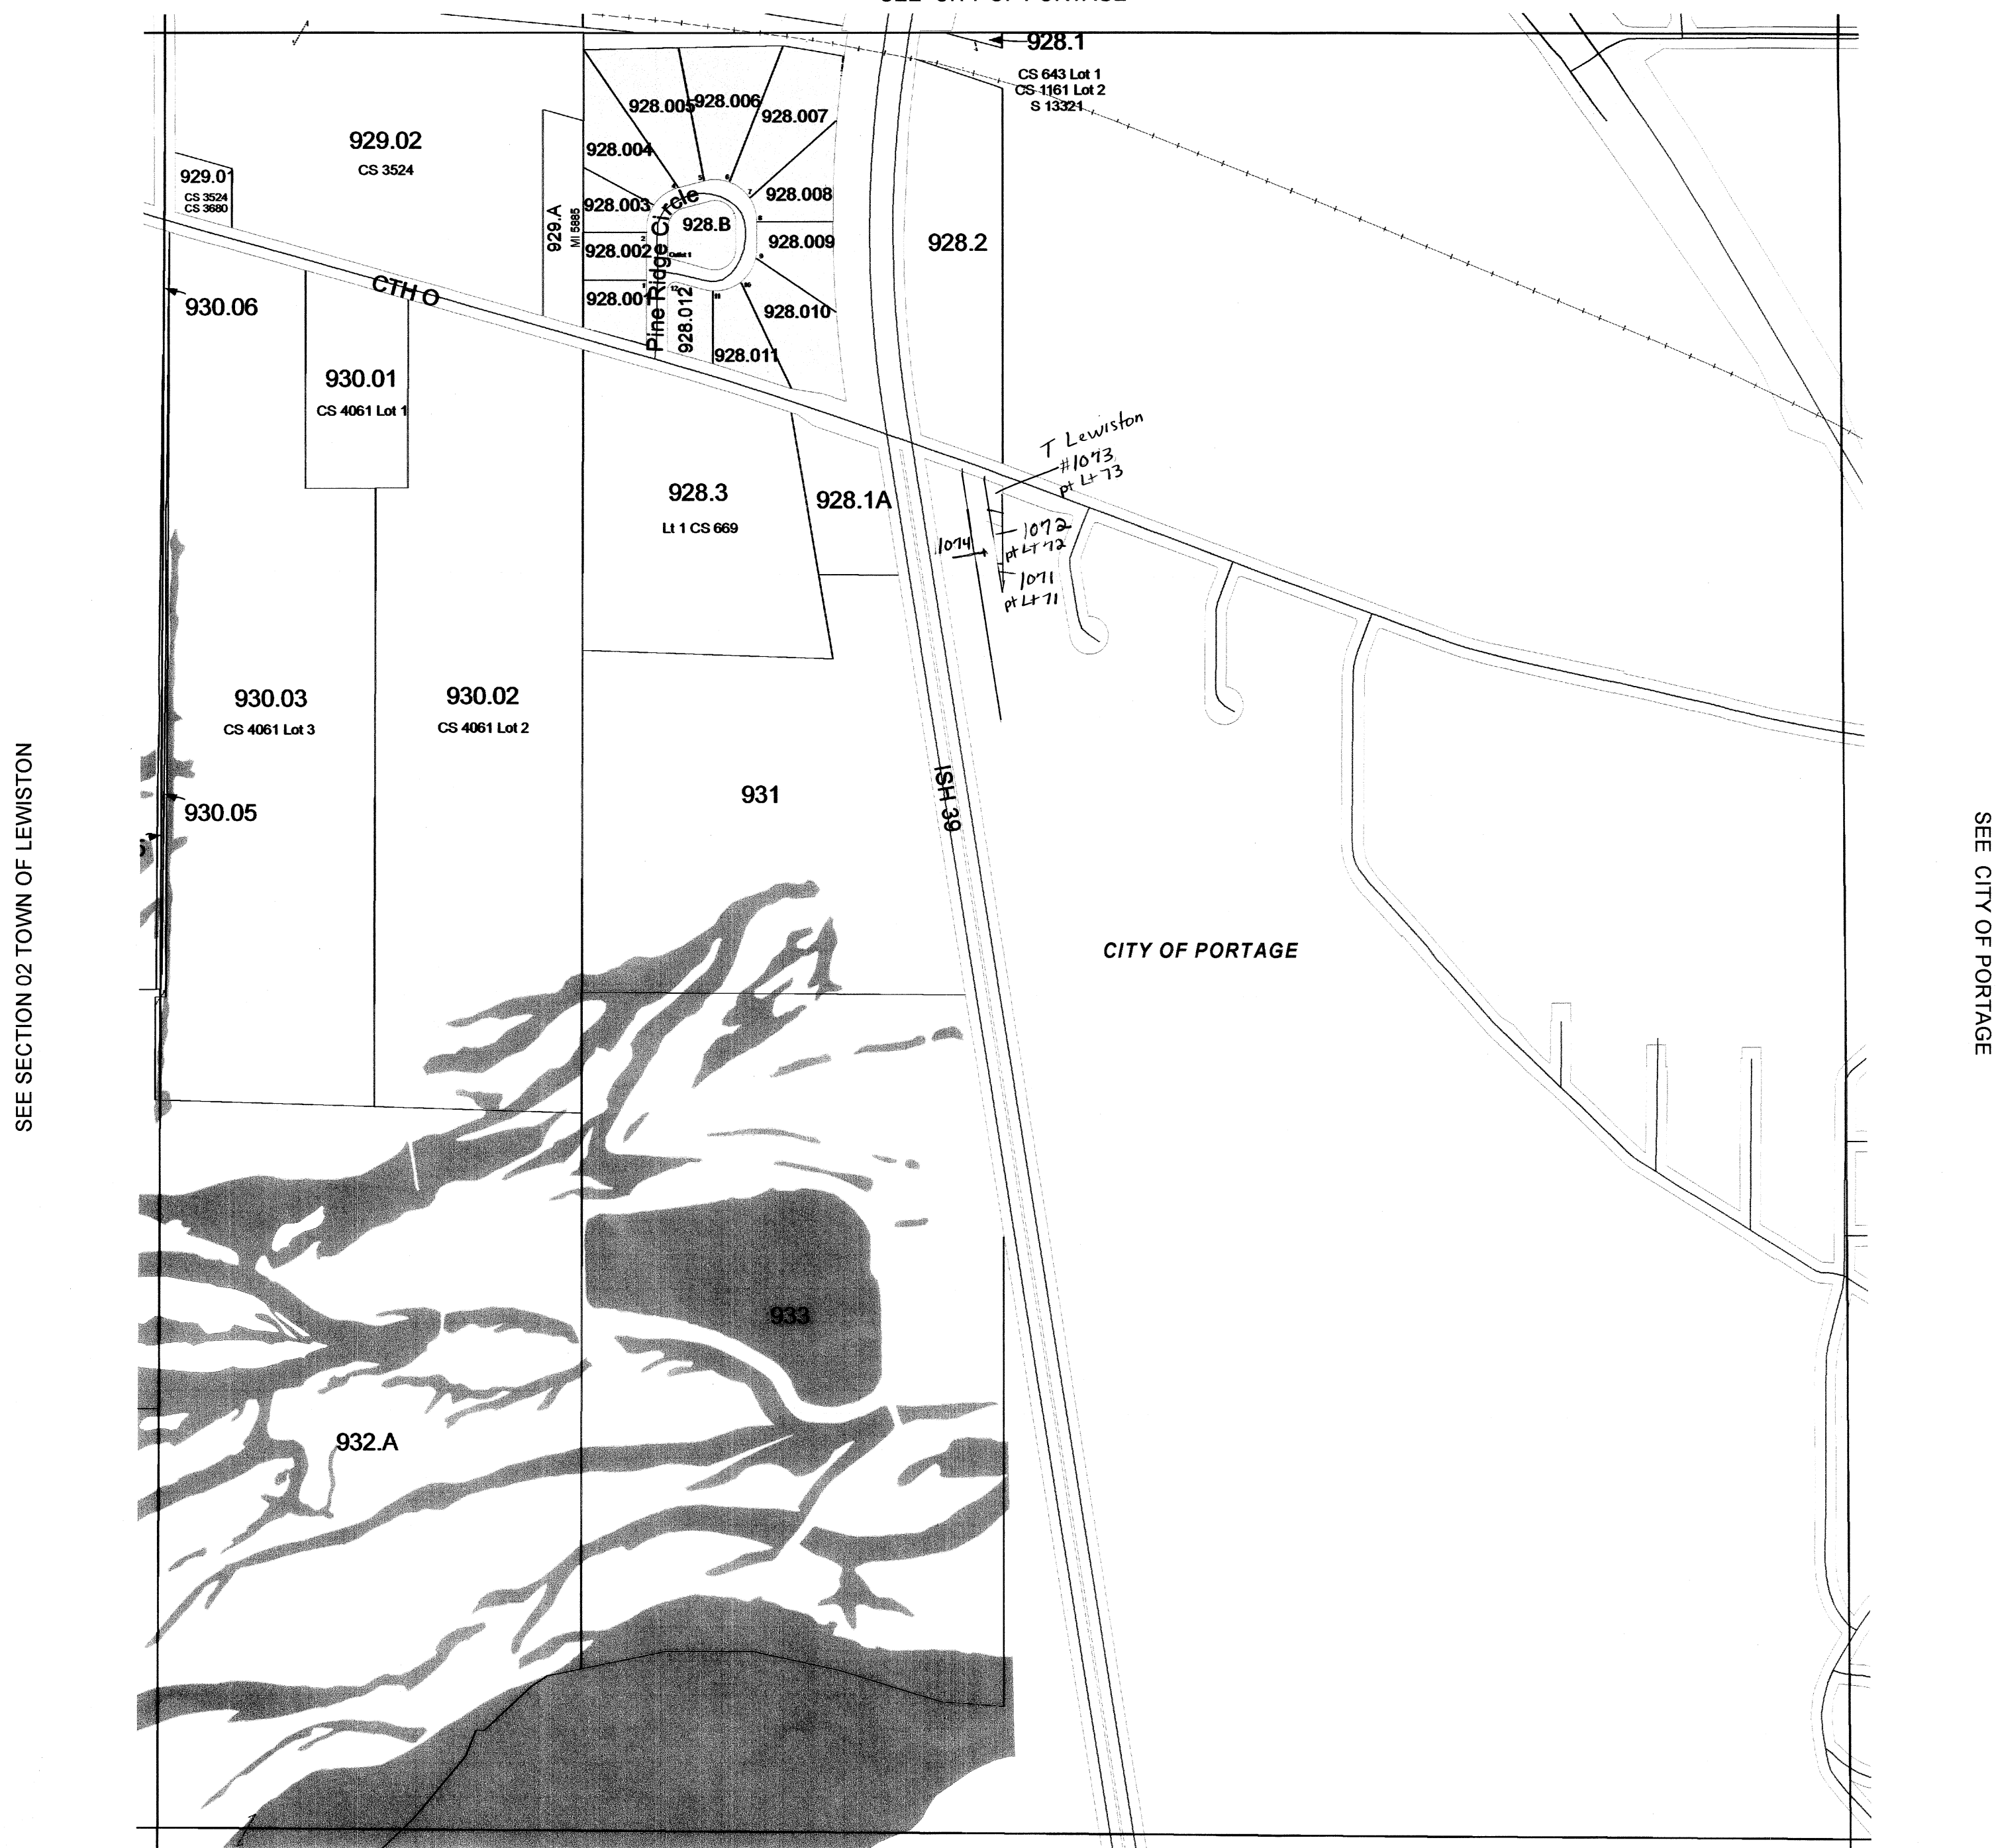

SEE SECTION 02 TOWN OF LEWISTON

SEE CITY OF PORTAGE

SEE SECTION 12 TOWN OF CALEDONIA


February 06, 2009
Columbia County Land Information

Replaced
2010


Section 01
T12N R8E

TOWN OF LEWISTON

T12N R8E T13N R7E T13N R8E

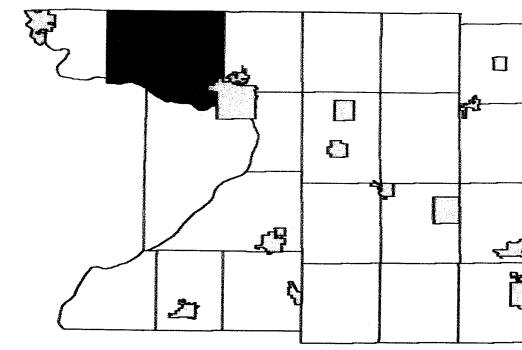


3	2	1	6	5	4	3
10	11	12	7	8	9	10
15	14	13	18	17	16	15
22	23	24	19	20	21	22
27	26	25	30	29	28	27
34	35	36	31	32	33	34
			5	4	3	2
			10	11	12	

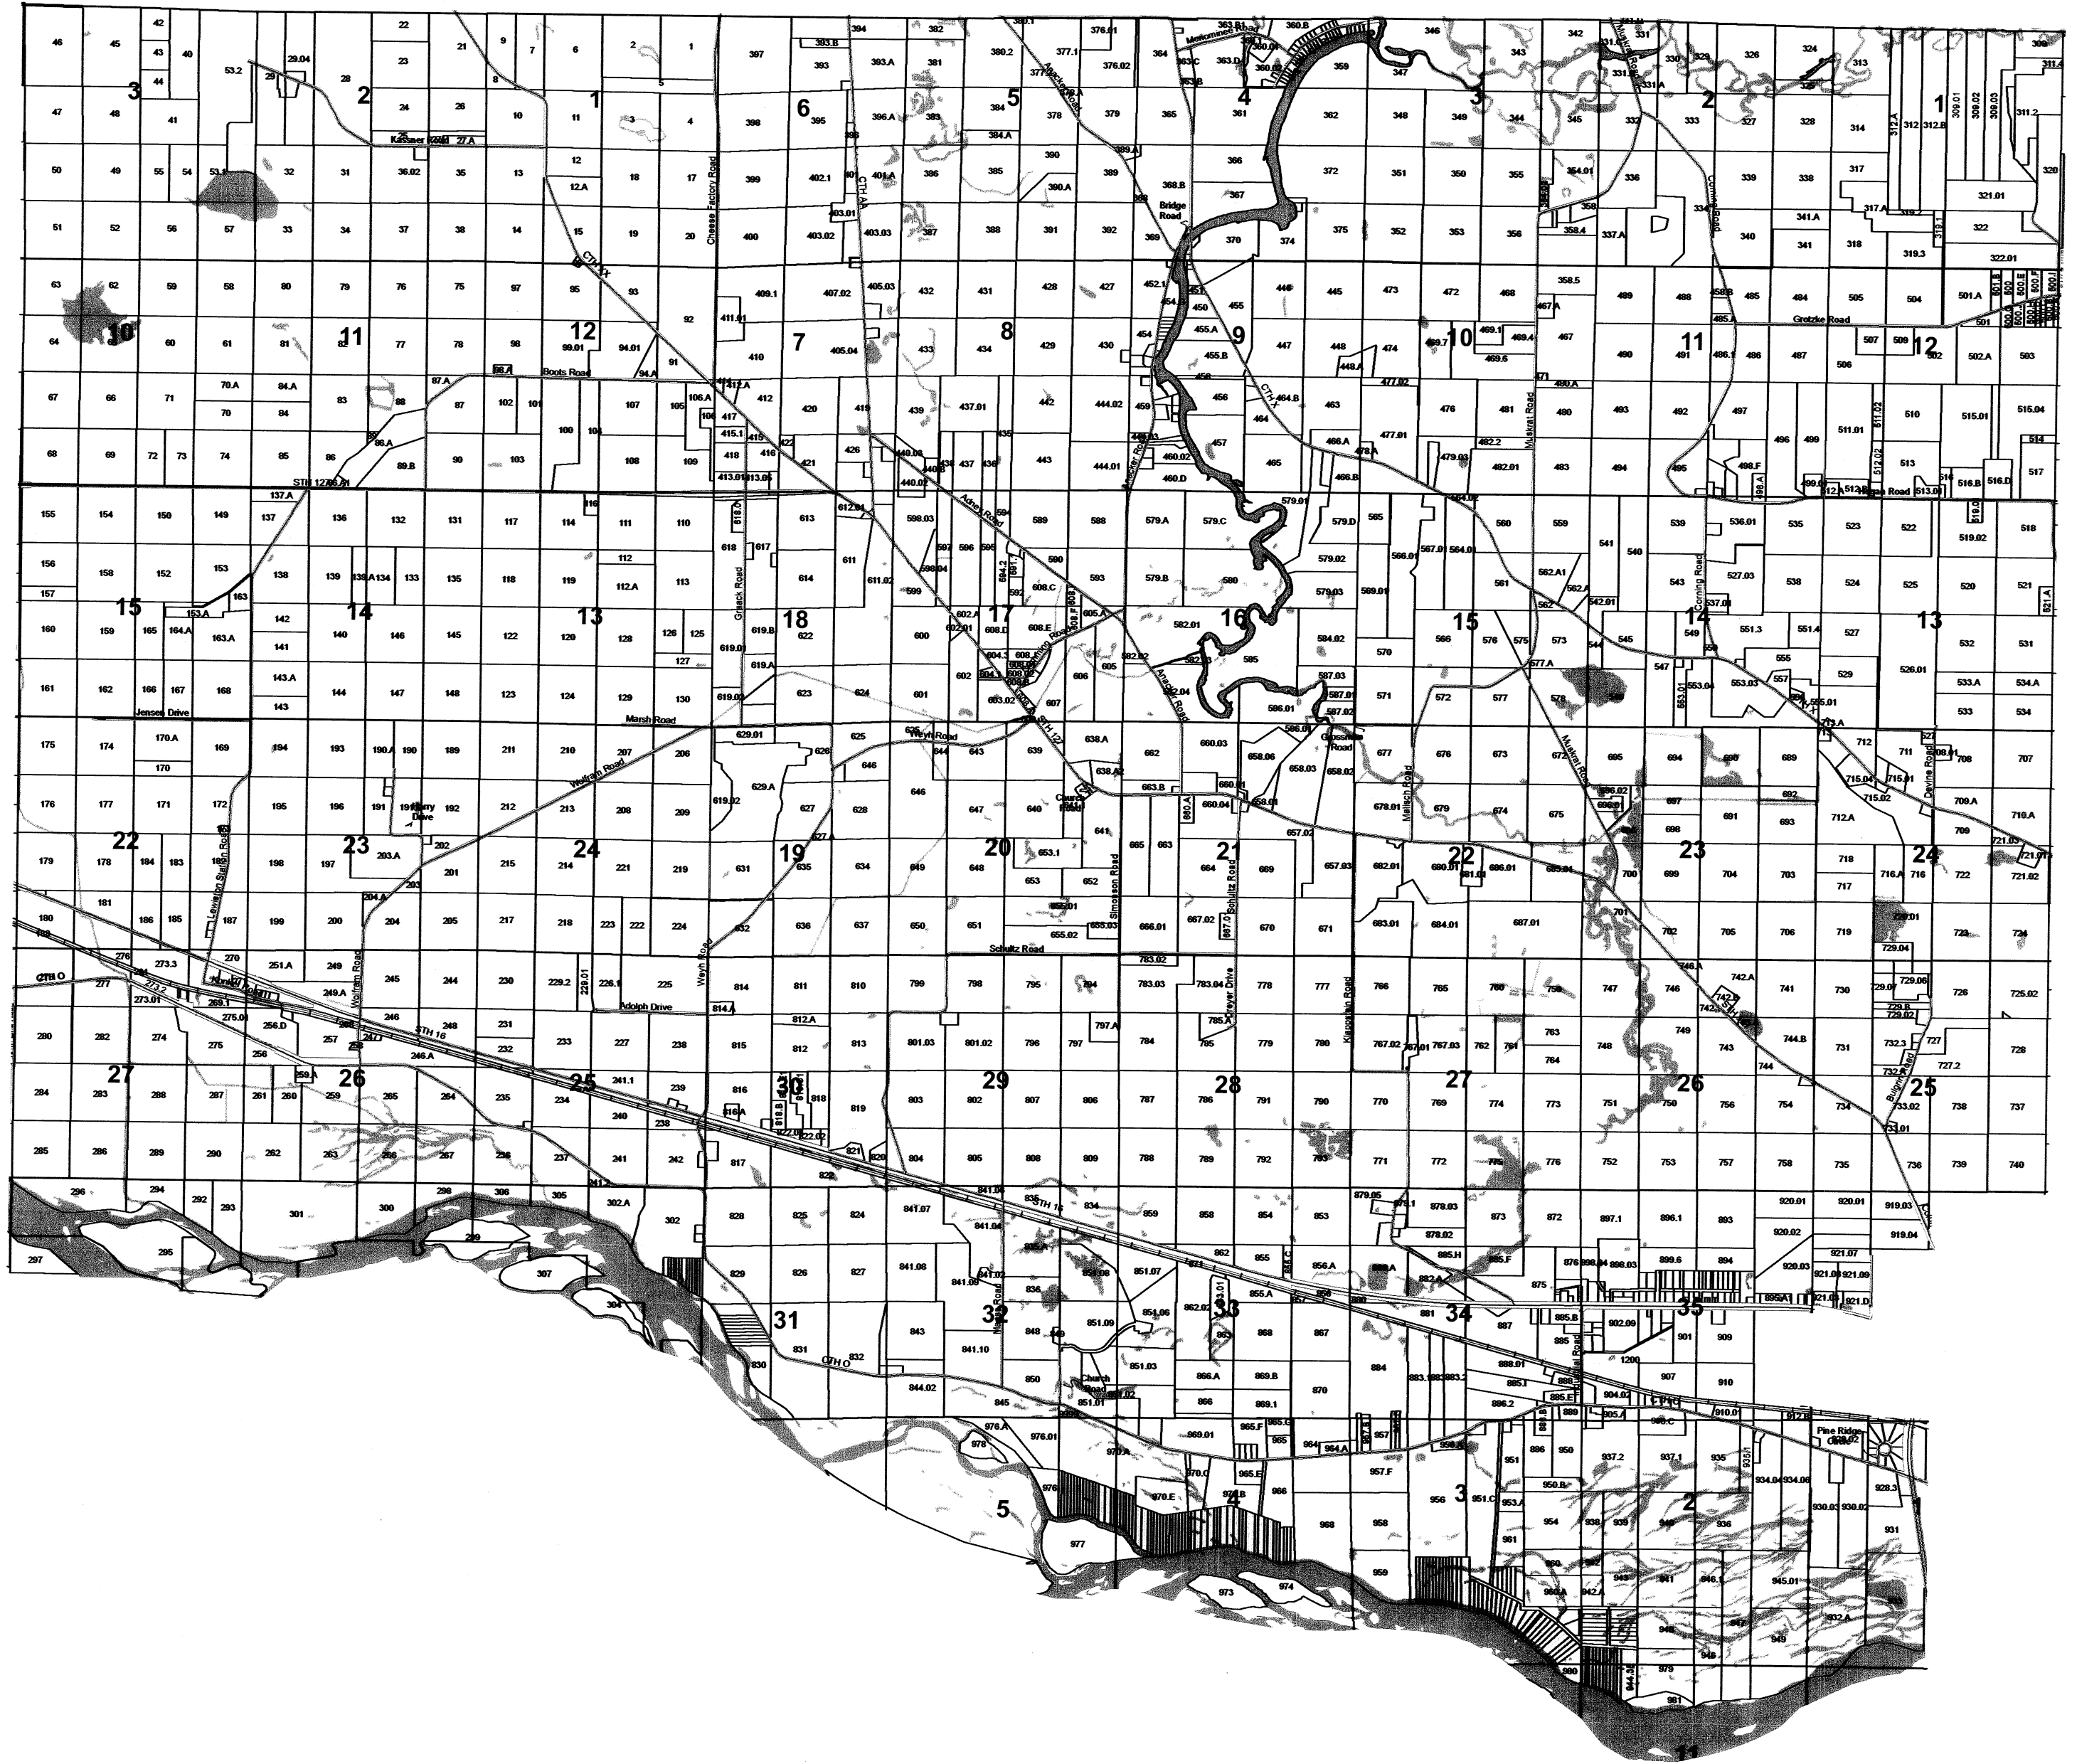

1 inch = 400 feet 1:4,800

A map of the United States with a grid overlay. The Pacific Northwest region, including Washington, Oregon, and Idaho, is highlighted in black. Within this black area, a specific region in central Washington is outlined in white, indicating the study area. Small squares are scattered across the grid, likely representing other locations or data points.

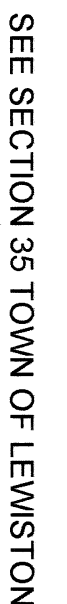

Section 34
T13N R8E

1 inch = 400 feet 1:4,800

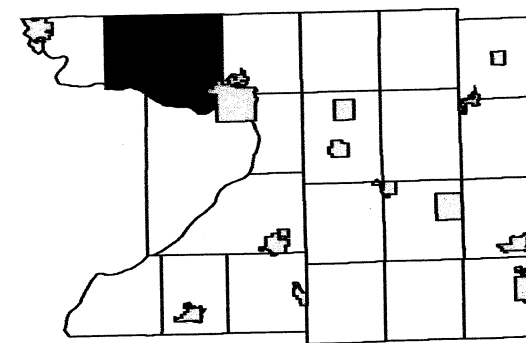


Figure 1 shows a 6x12 grid representing a 2D lattice. The top row is labeled 'R7E' and 'R8E'. The right side is labeled 'T13N' and 'T12N'. The grid contains numbers 1 through 36, with some cells shaded black. A curved line separates the bottom-left portion of the grid from the rest. The numbers are arranged in a specific pattern across the grid.

SEE SECTION 19 TOWN OF LEWISTON



SEE SECTION 31 TOWN OF LEWISTON


Replaced
2011

Section 30
T13N R8E

TOWN OF LEWISTON

SECTION 29 T13N R8E


1 inch = 400 feet 1:4,800

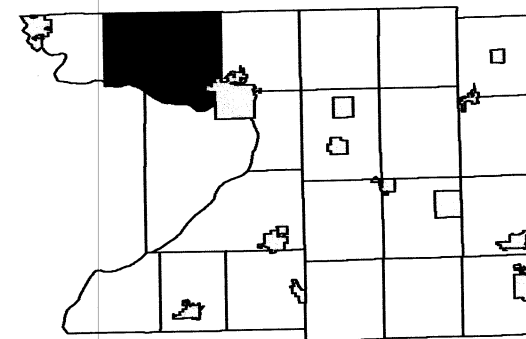

R7E					R8E				
3	2	1	6	5	4	3	2	1	
10	11	12	7	8	9	10	11	12	
15	14	13	18	17	16	15	14	13	T13N
22	23	24	19	20	21	22	23	24	
27	26	25	30	28	27	26	25	24	
34	33	32	31	32	33	34	35	36	T12N

SEE SECTION 20 TOWN OF LEWISTON

SEE SECTION 30 TOWN OF LEWISTON

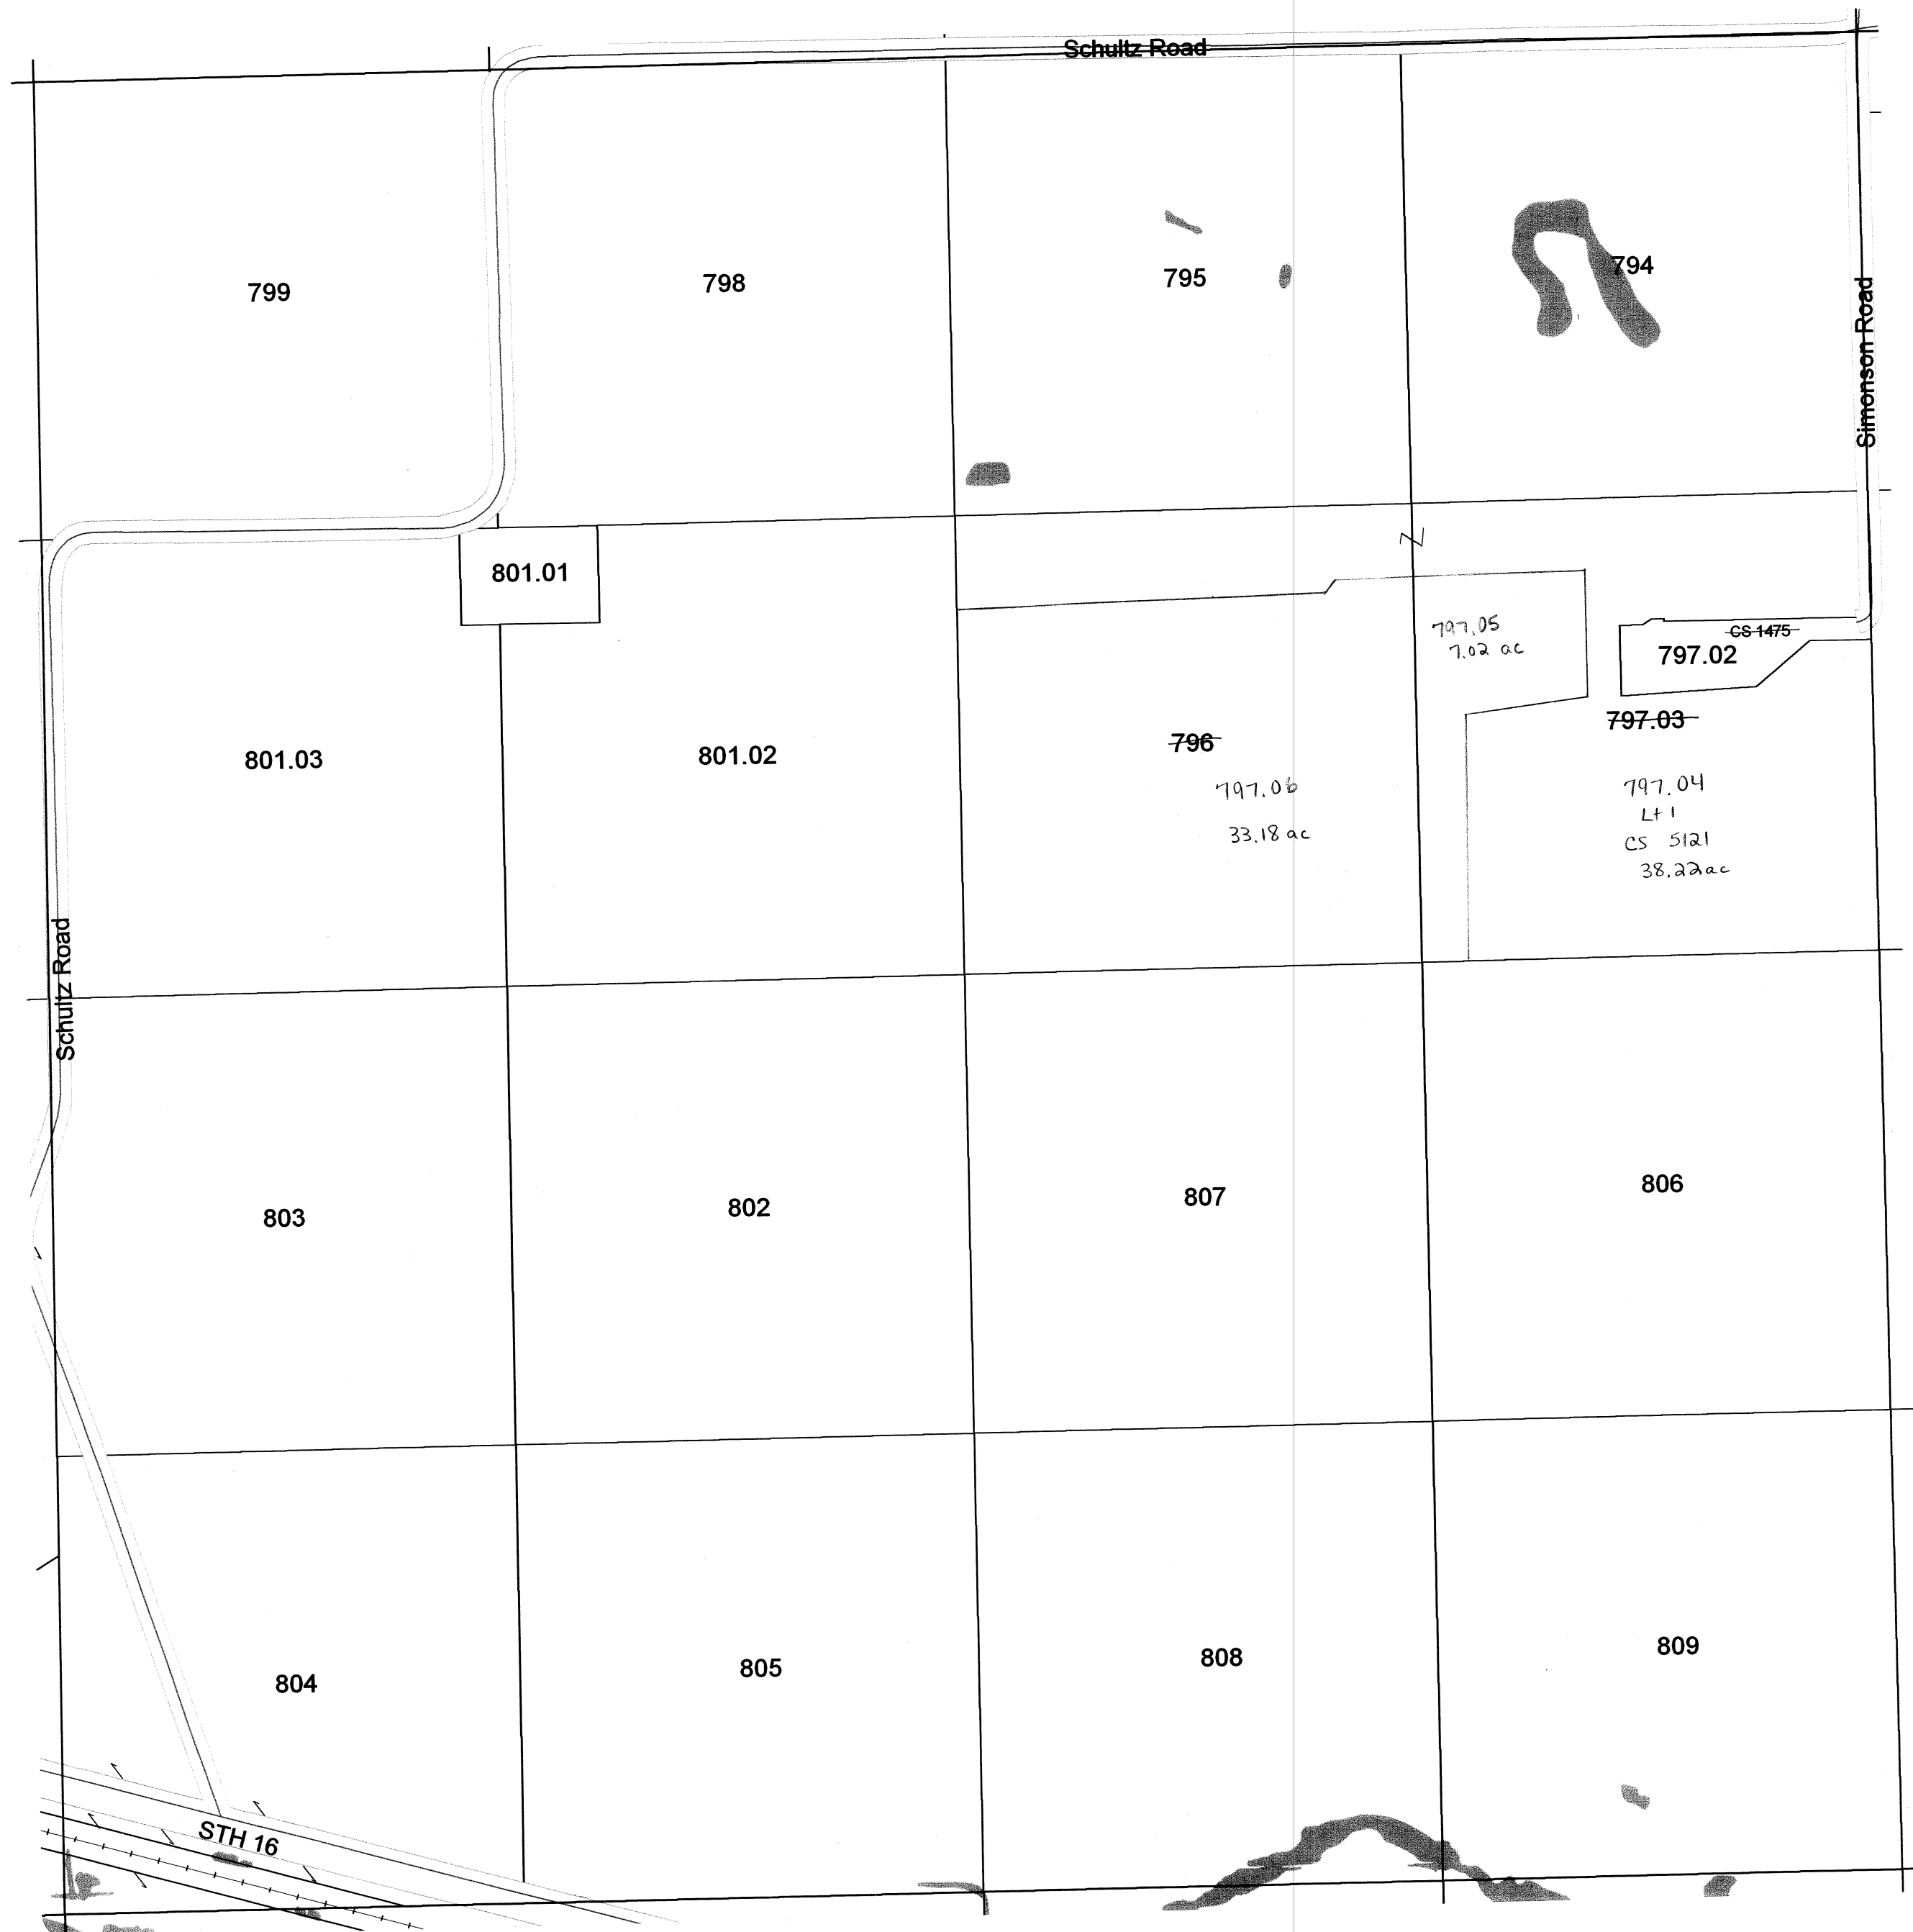

SEE SECTION 28 TOWN OF LEWISTON

SEE SECTION 32 TOWN OF LEWISTON


Replaced
2011

Section 29
T13N R8E

TOWN OF LEWISTON

SECTION 19 T13N R8E

1 inch = 400 feet 1:4,800

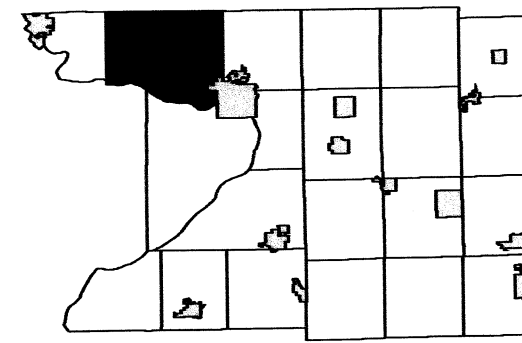


R7E					R8E				
3	2	1	6	5	4	3	2	1	
10	11	12	7	8	9	10	11	12	
15	14	13	18	17	16	15	14	13	T13N
22	23	24	20	21	22	23	24		
27	26	25	30	29	28	27	26	25	
34	35	36	31	32	33	34	35	36	
					5	4	3	2	T12N
									10 11 12

SEE SECTION 18 TOWN OF LEWISTON

SEE SECTION 24 TOWN OF LEWISTON

SEE SECTION 20 TOWN OF LEWISTON

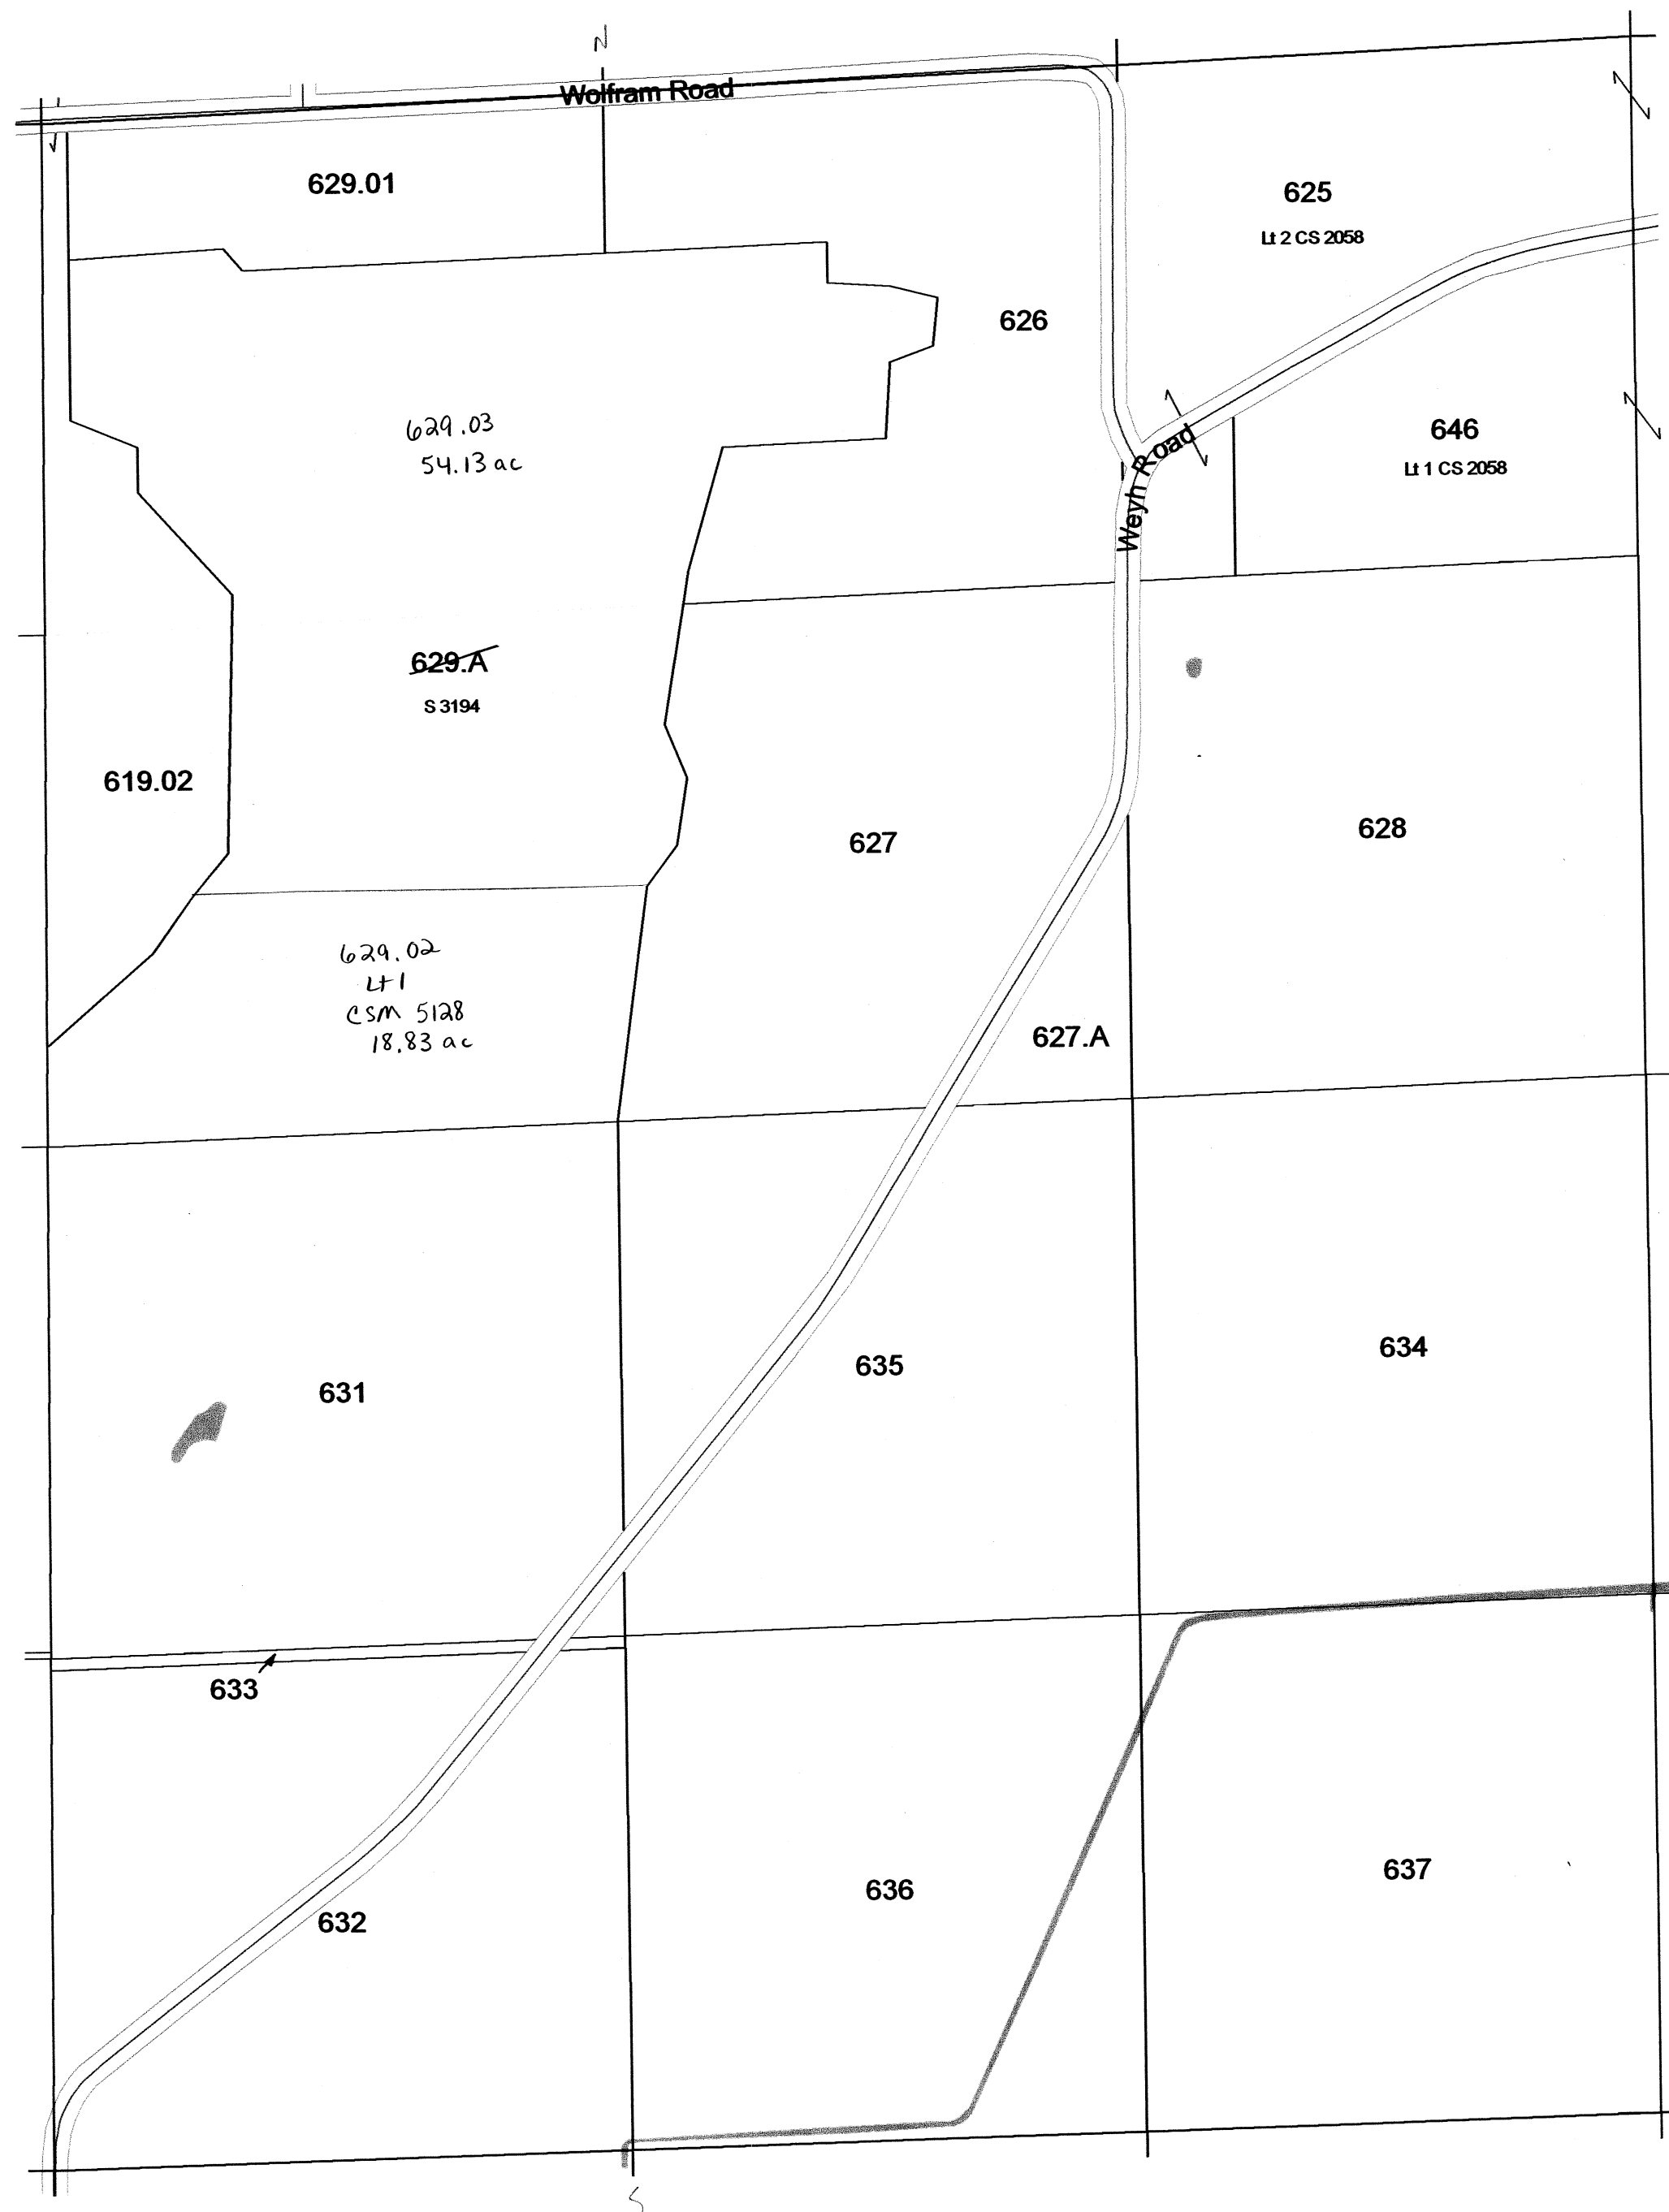

SEE SECTION 30 TOWN OF LEWISTON


Replaced
2011

Section 19
T13N R8E

TOWN OF LEWISTON

SECTION 16 T13N R8E

1 inch = 400 feet 1:4,800

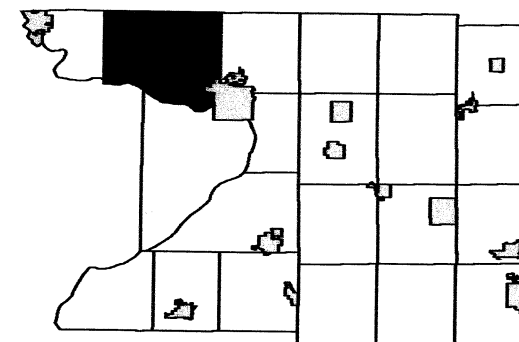


R7E						R8E					
3	2	1	6	5	4	3	2	1			
10	11	12	7	8	9	10	11	12			
15	14	13	18	17	16	15	14	13			
22	23	24	19	20	21	22	23	24			
27	26	25	30	29	28	27	26	25			
34	35	36	31	32	33	34	35	36			

SEE SECTION 09 TOWN OF LEWISTON

SEE SECTION 17 TOWN OF LEWISTON

SEE SECTION 15 TOWN OF LEWISTON

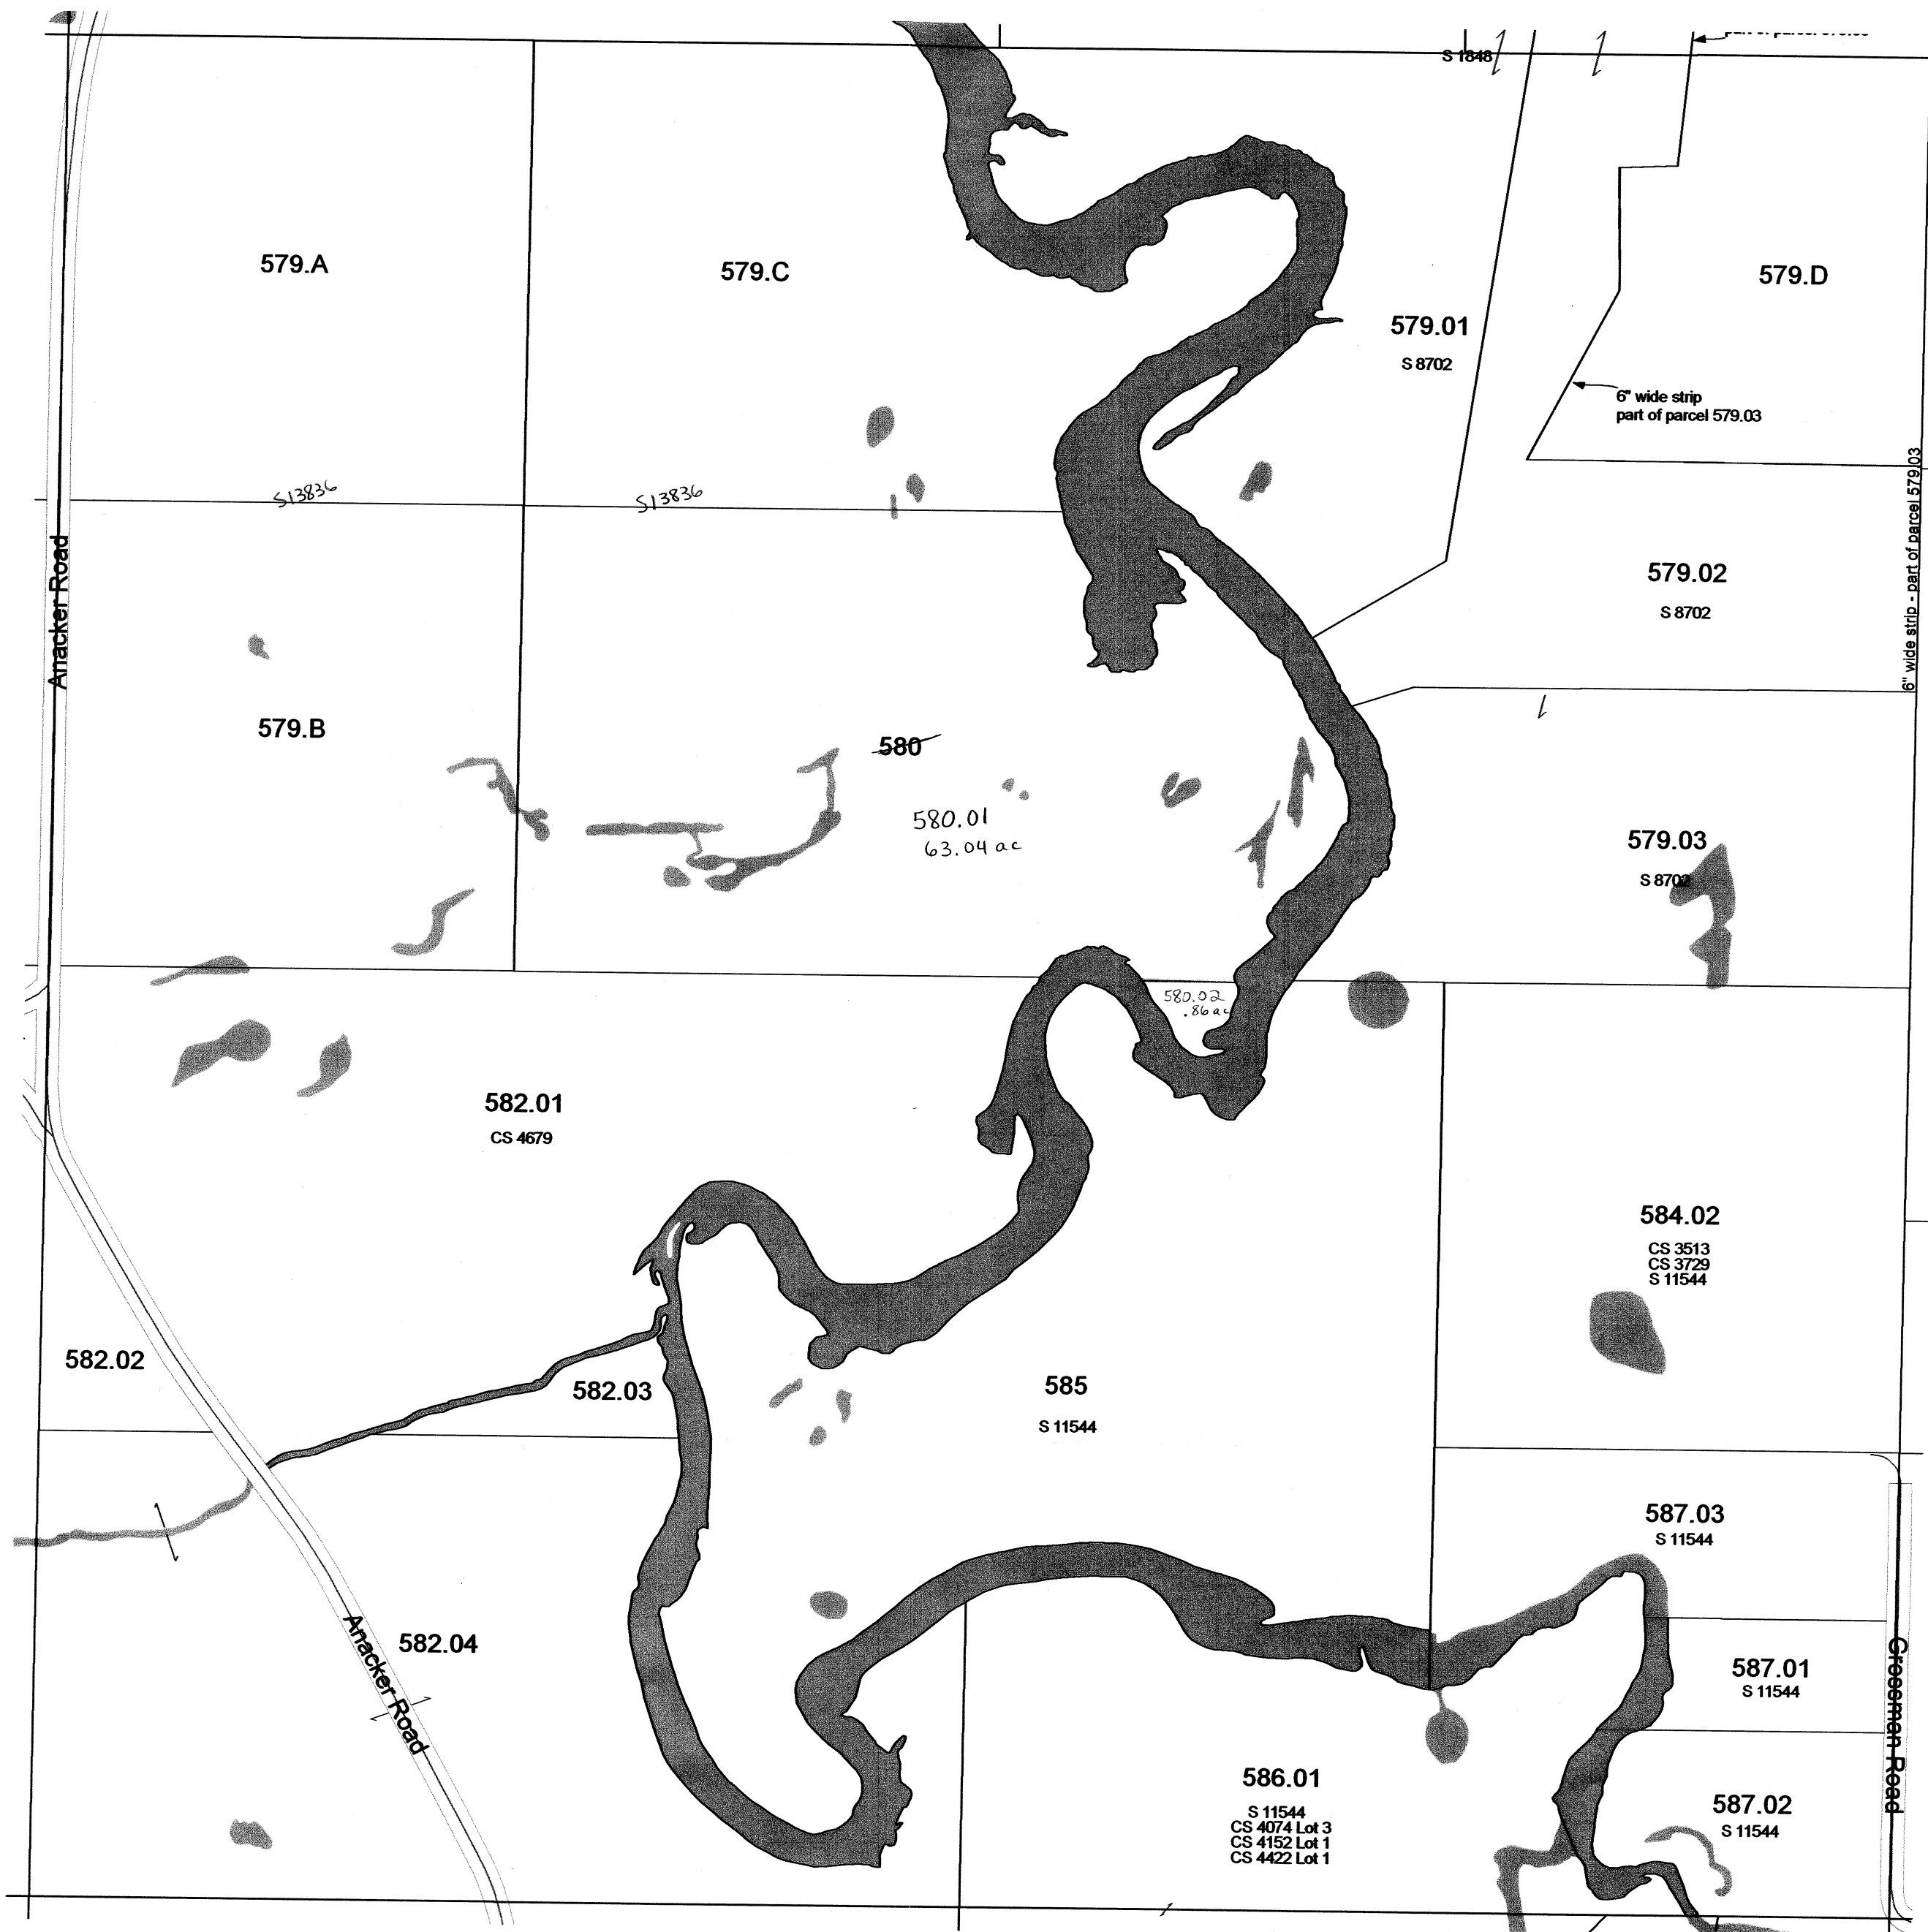


SEE SECTION 21 TOWN OF LEWISTON

TOWN OF LEWISTON

SECTION 14 T13N R8E

1 inch = 400 feet 1:4,800

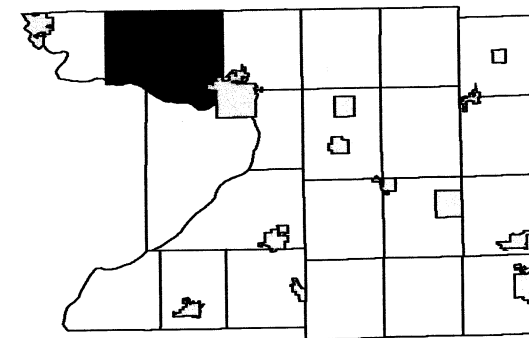


R7E			R8E			R9E		
3	2	1	6	5	4	3	2	1
10	11	12	7	8	9	10	11	12
15	14	13	18	17	16	15	14	13
22	23	24	19	20	21	22	23	24
27	26	25	30	29	28	27	26	25
34	33	32	31	32	33	34	35	36
			5	4	3	2	1	
			10	11	12			

SEE SECTION 11 TOWN OF LEWISTON

SEE SECTION 15 TOWN OF LEWISTON

SEE SECTION 13 TOWN OF LEWISTON

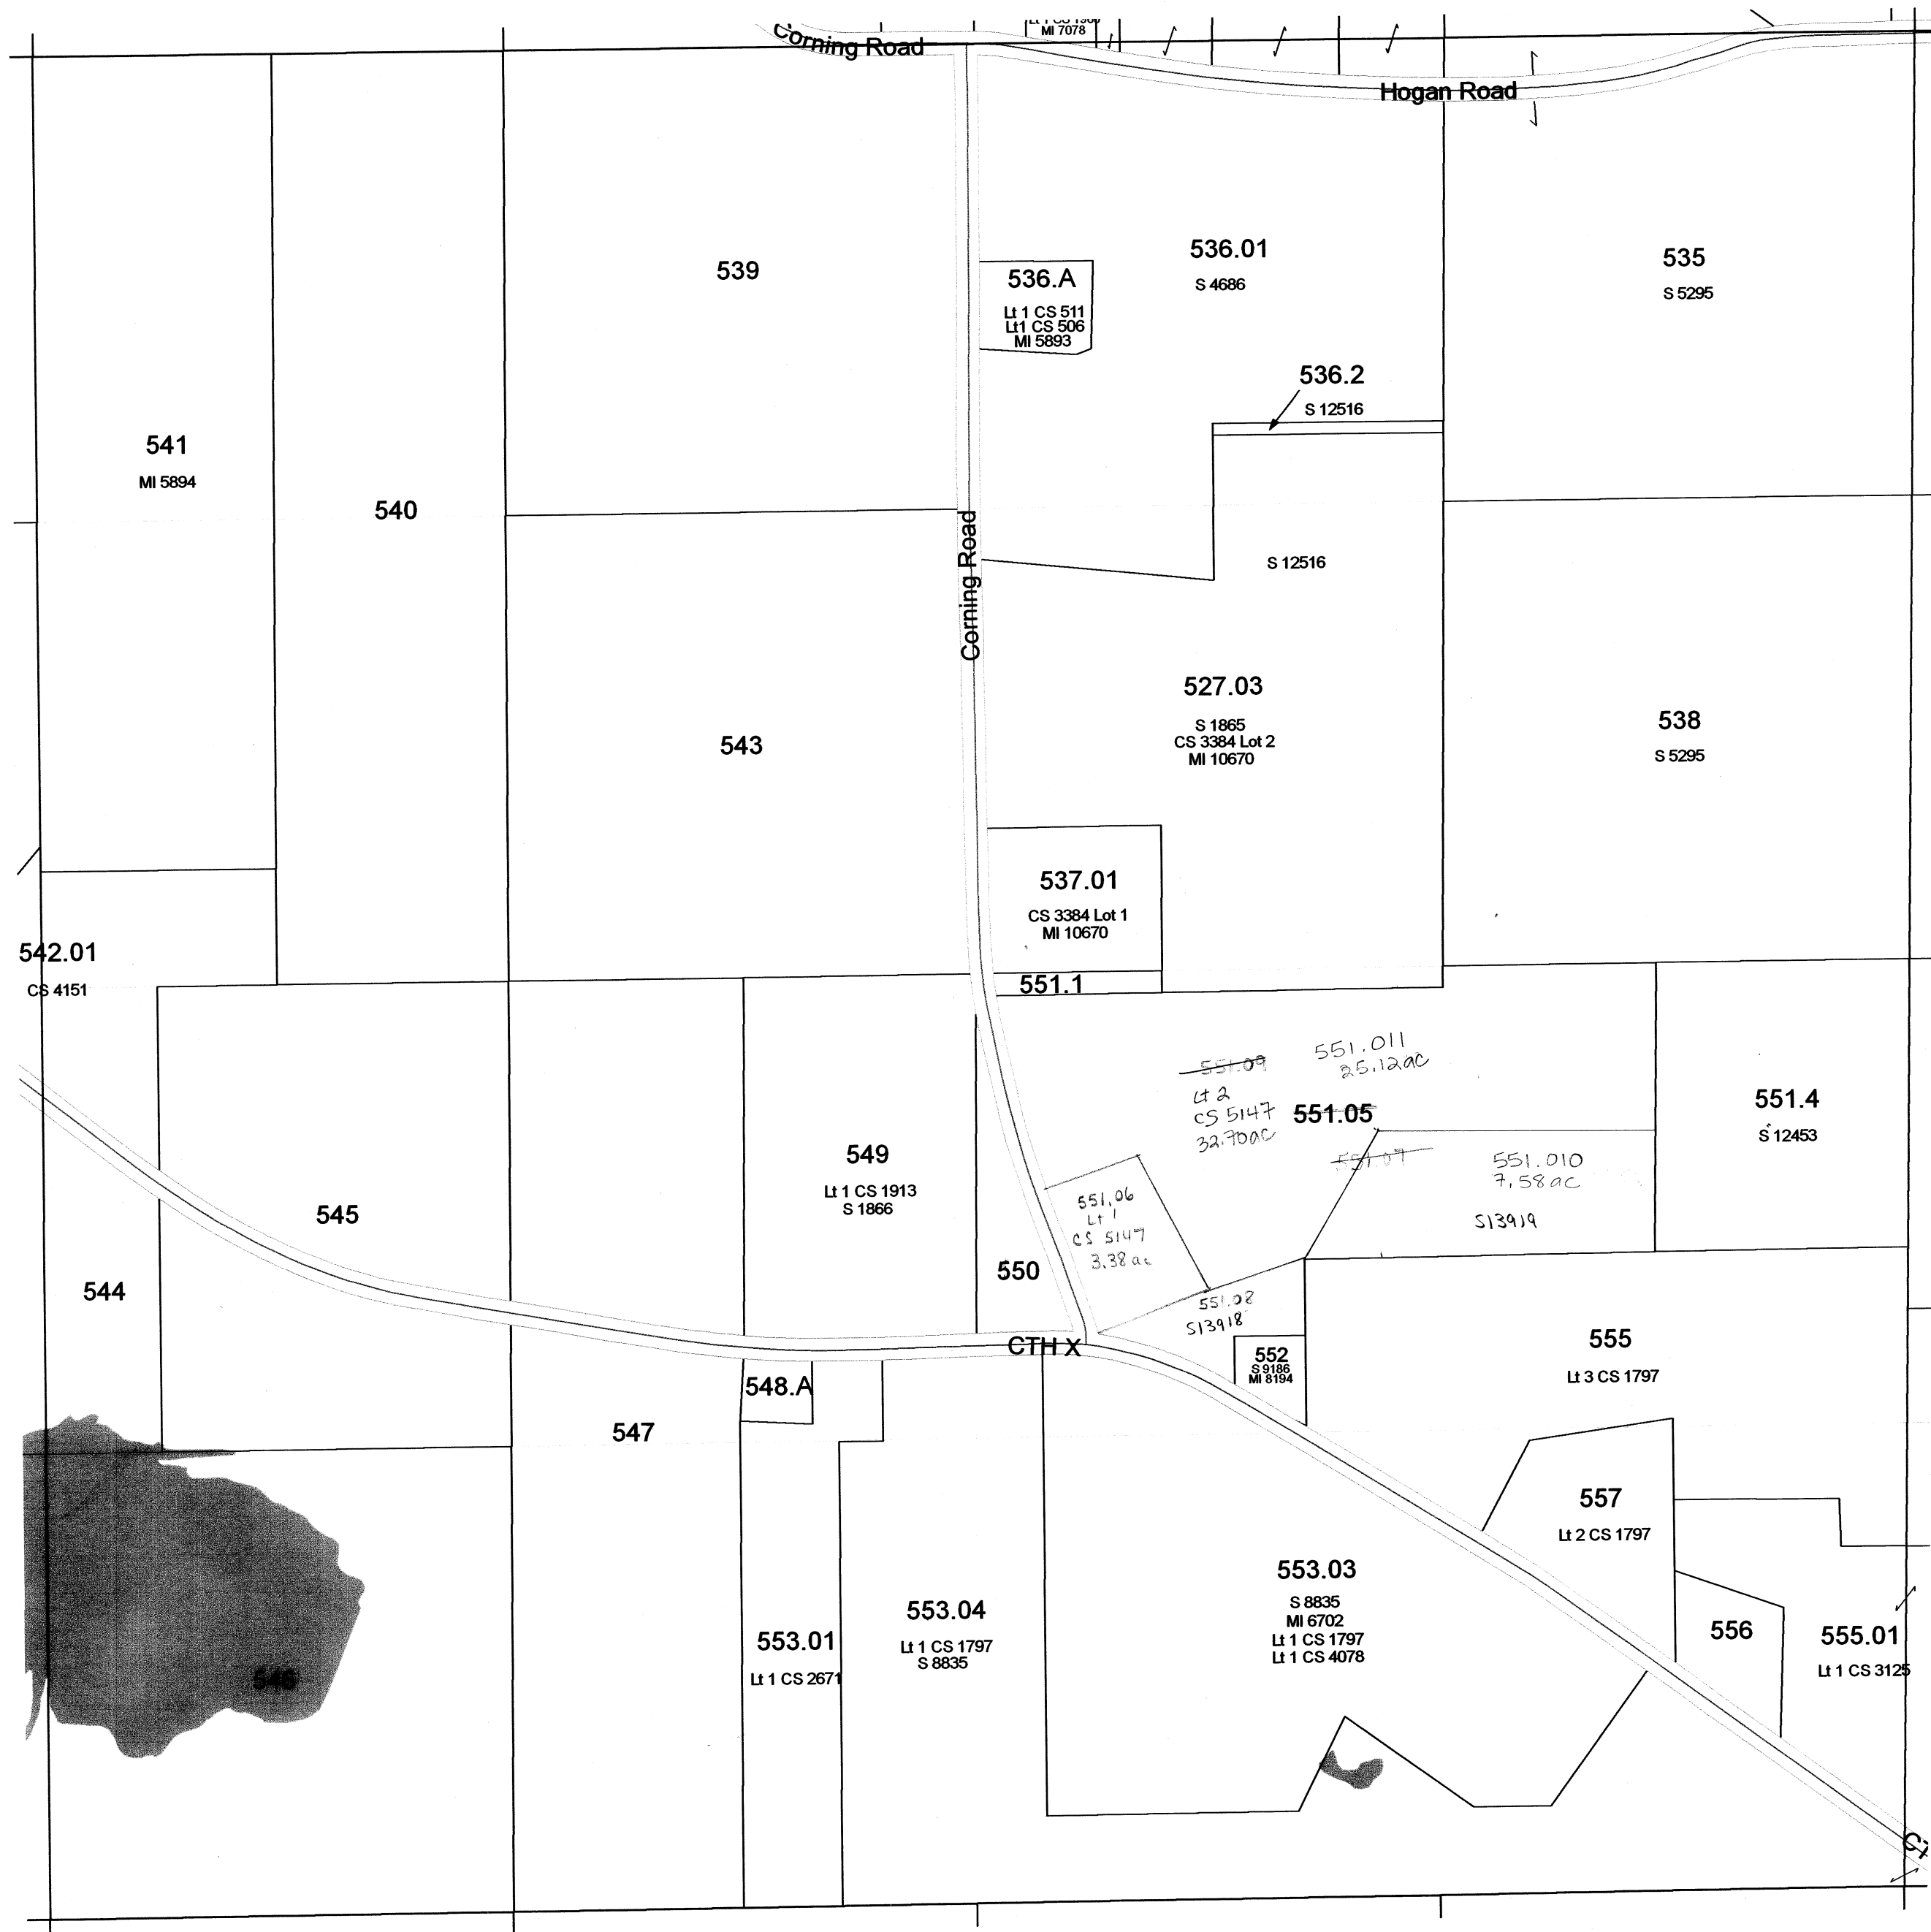

SEE SECTION 23 TOWN OF LEWISTON


Replaced
2011

Section 14
T13N R8E

TOWN OF LEWISTON

SECTION 9 T13N R8E

1 inch = 400 feet 1:4,800

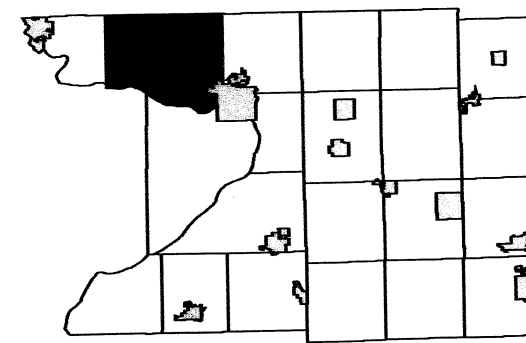


R7E			R8E			R9E		
3	2	1	6	5	4	3	2	1
10	11	12	7	8	9	10	11	12
15	14	13	18	17	16	15	14	13
22	23	24	19	20	21	22	23	24
27	26	25	30	29	28	27	26	25
34	33	32	31	32	33	34	35	36

TOWN OF LEWISTON

SECTION 23 T13N R7E

1 inch = 400 feet 1:4,800

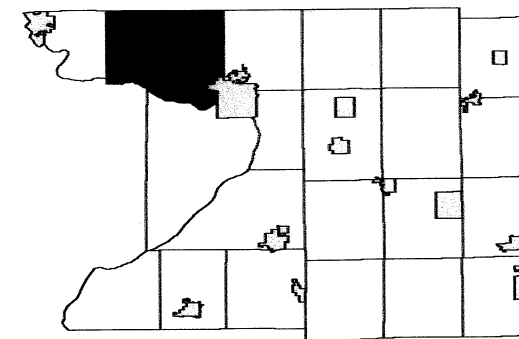


R7E									R8E											
3	2	1	6	5	4	3	2	1												
10	11	12	7	8	9	10	11	12												
15	14	13	18	17	16	15	14	13												
22		24	19	20	21	22	23	24	T13N											
27	26	25	30	29	28	27	26	25												
34	35	36	31	32	33	34	35	36												
									5	4	3	2	1	T12N						
																		10	11	12

SEE SECTION 14 TOWN OF LEWISTON

SEE SECTION 22 TOWN OF LEWISTON

SEE SECTION 24 TOWN OF LEWISTON

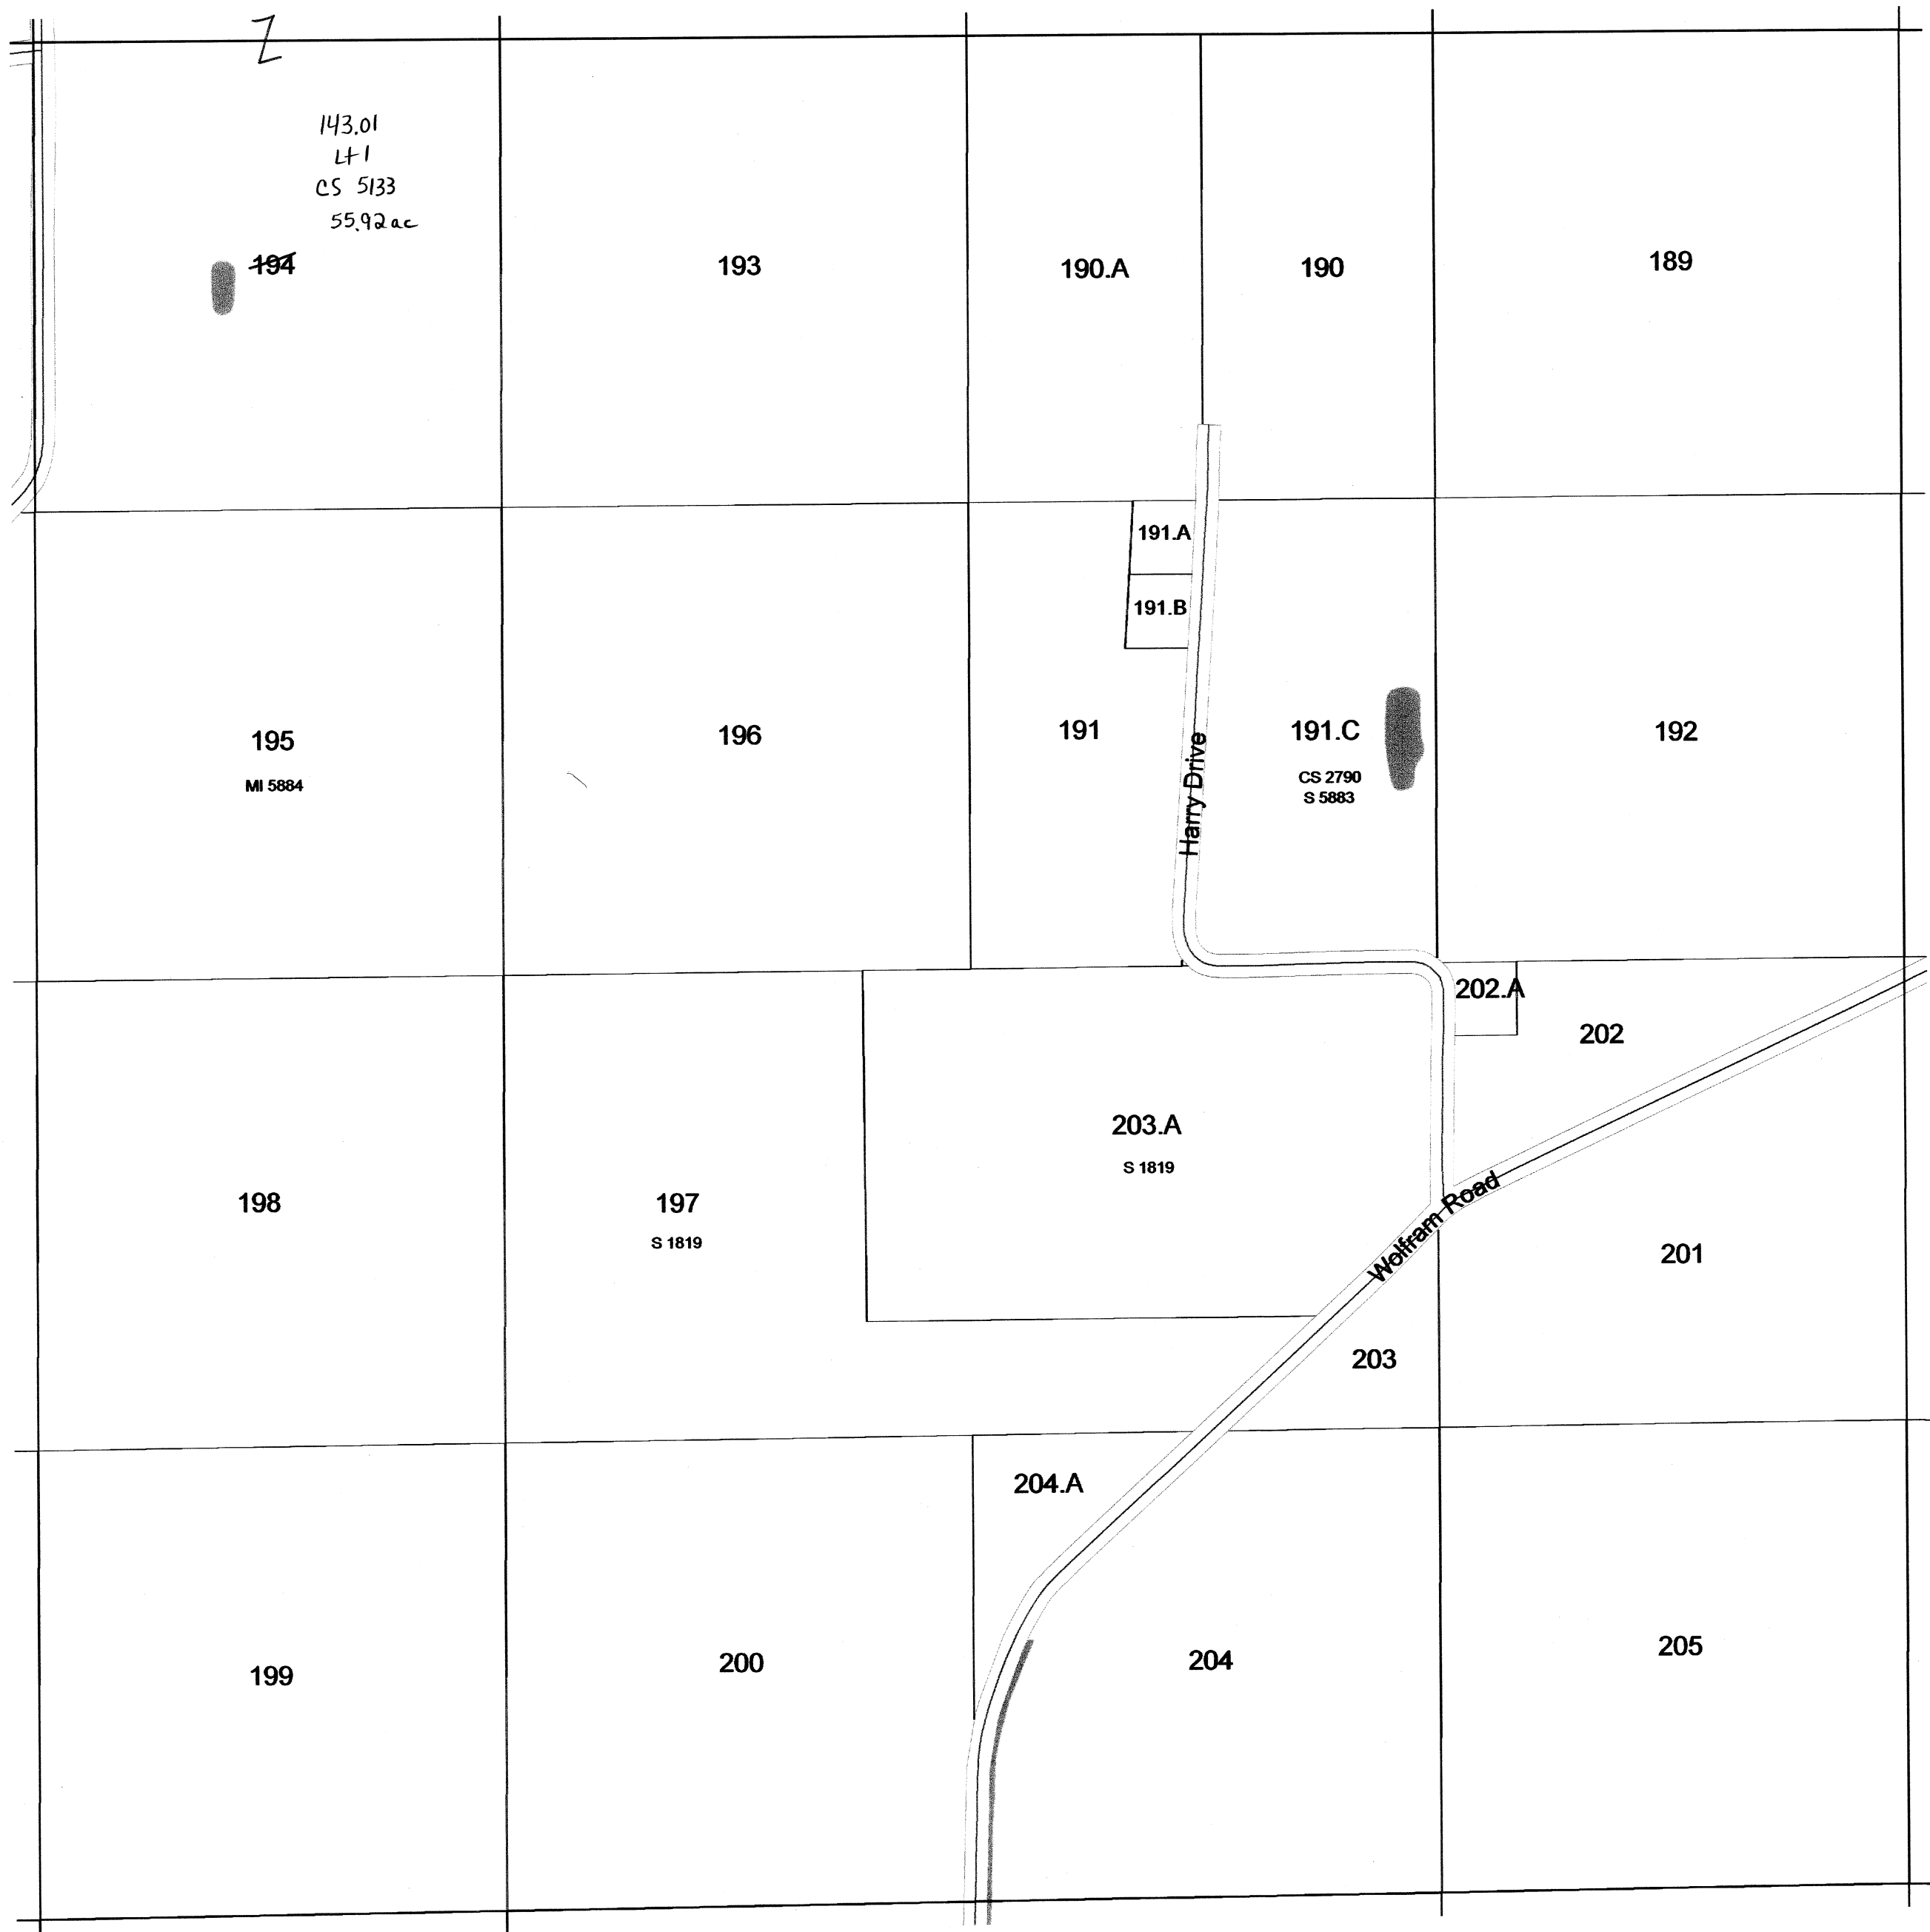


SEE SECTION 26 TOWN OF LEWISTON

Replaced
2011

TOWN OF LEWISTON

SECTION 22 T13N R7E

1 inch = 400 feet 1:4,800

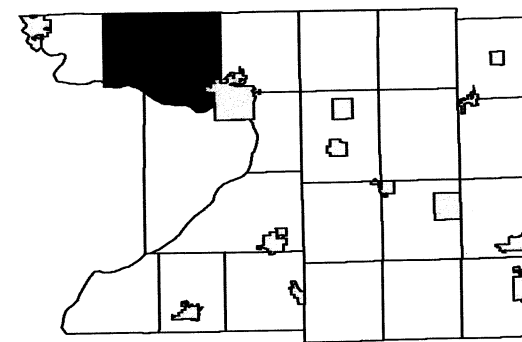


R7E						R8E					
3	2	1	6	5	4	3	2	1			
10	11	12	7	8	9	10	11	12			
15	14	13	18	17	16	15	14	13			
23	24	19	20	21	22	23	24	25			
27	26	25	30	29	28	27	26	25			
34	35	36	31	32	33	34	35	36			
						5	4	3	2	1	
						10	11	12			

SEE SECTION 15 TOWN OF LEWISTON

SEE SECTION 21 TOWN OF NEWPORT

SEE SECTION 23 TOWN OF LEWISTON

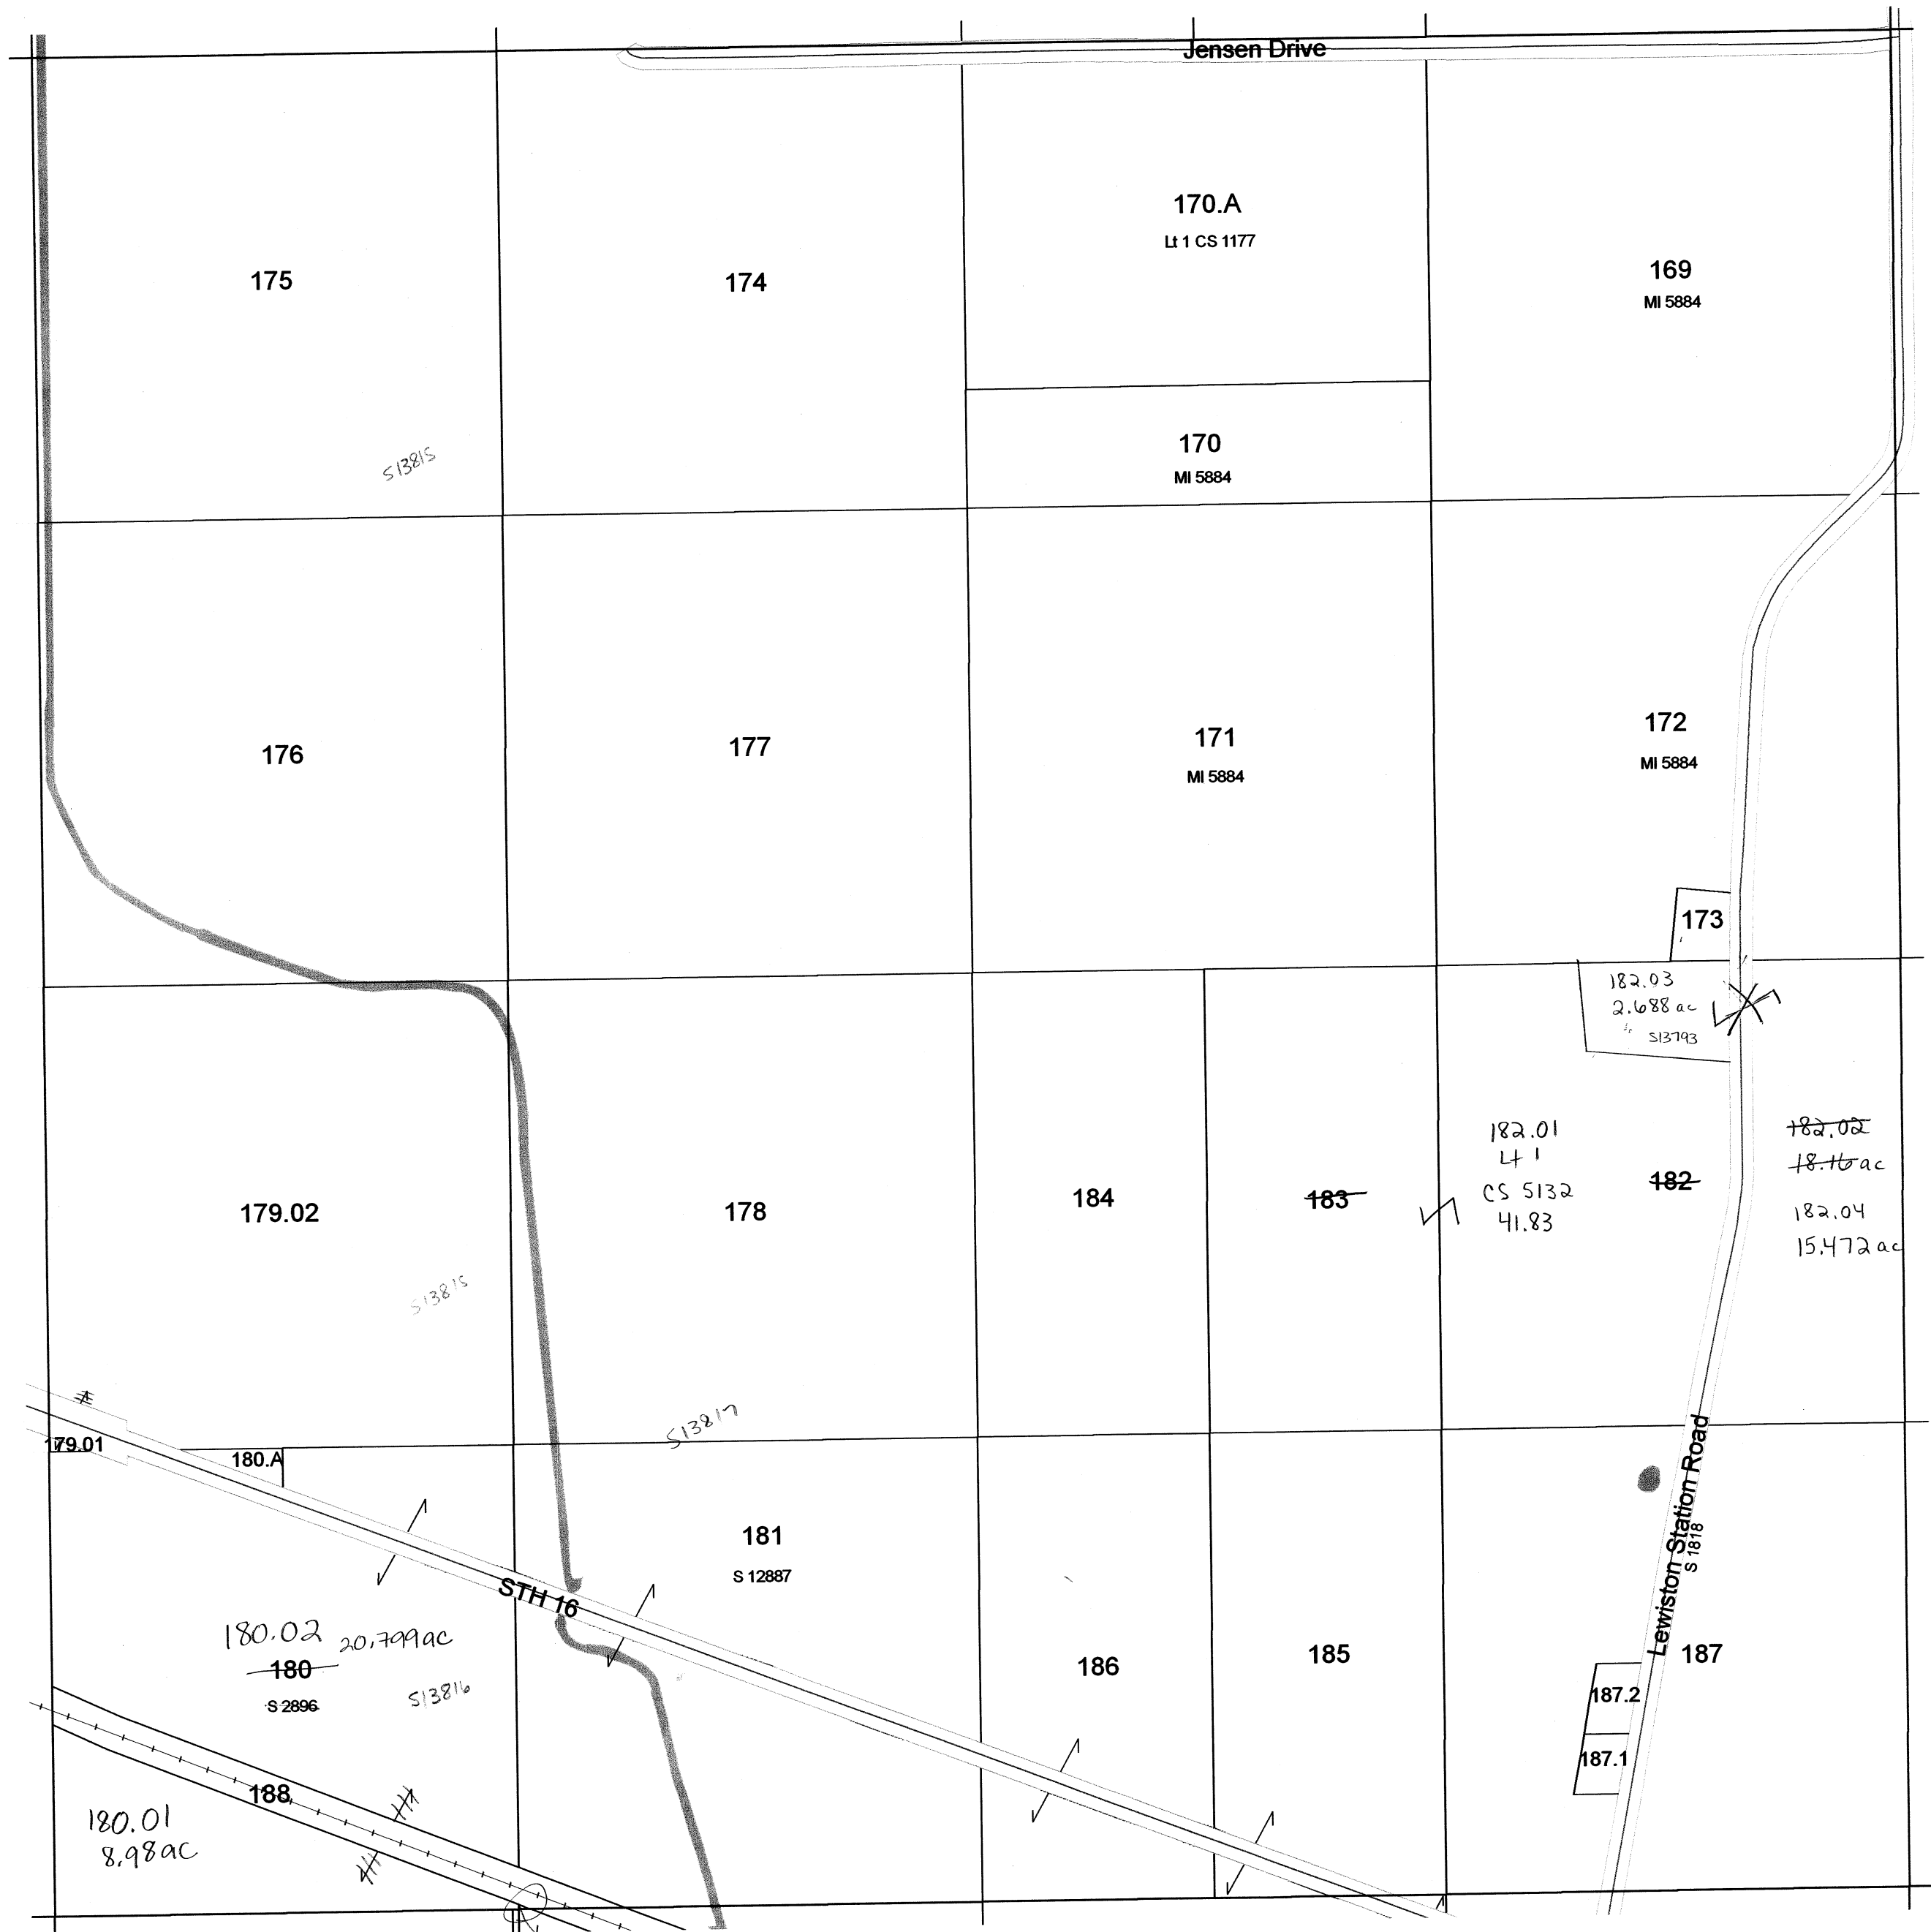

SEE SECTION 27 TOWN OF LEWISTON

Replaced
2011

TOWN OF LEWISTON

SECTION 14 T13N R7E

1 inch = 400 feet 1:4,800


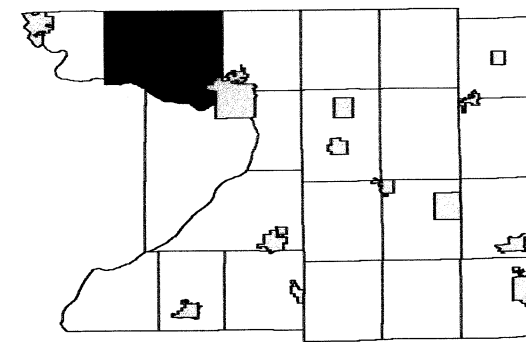


Figure 1 shows a 12x12 grid of sampling points. The grid is divided into four quadrants by a central vertical line. The top-left quadrant is labeled 'R7E' and the top-right 'R8E'. The bottom-right quadrant is labeled 'T12N'. The bottom-left quadrant is labeled 'T12N' and '10 11 12'. The grid contains numbers 1 through 120, with some cells shaded black. A curved line separates the bottom-left quadrant from the others.

SEE SECTION 11 TOWN OF LEWISTON

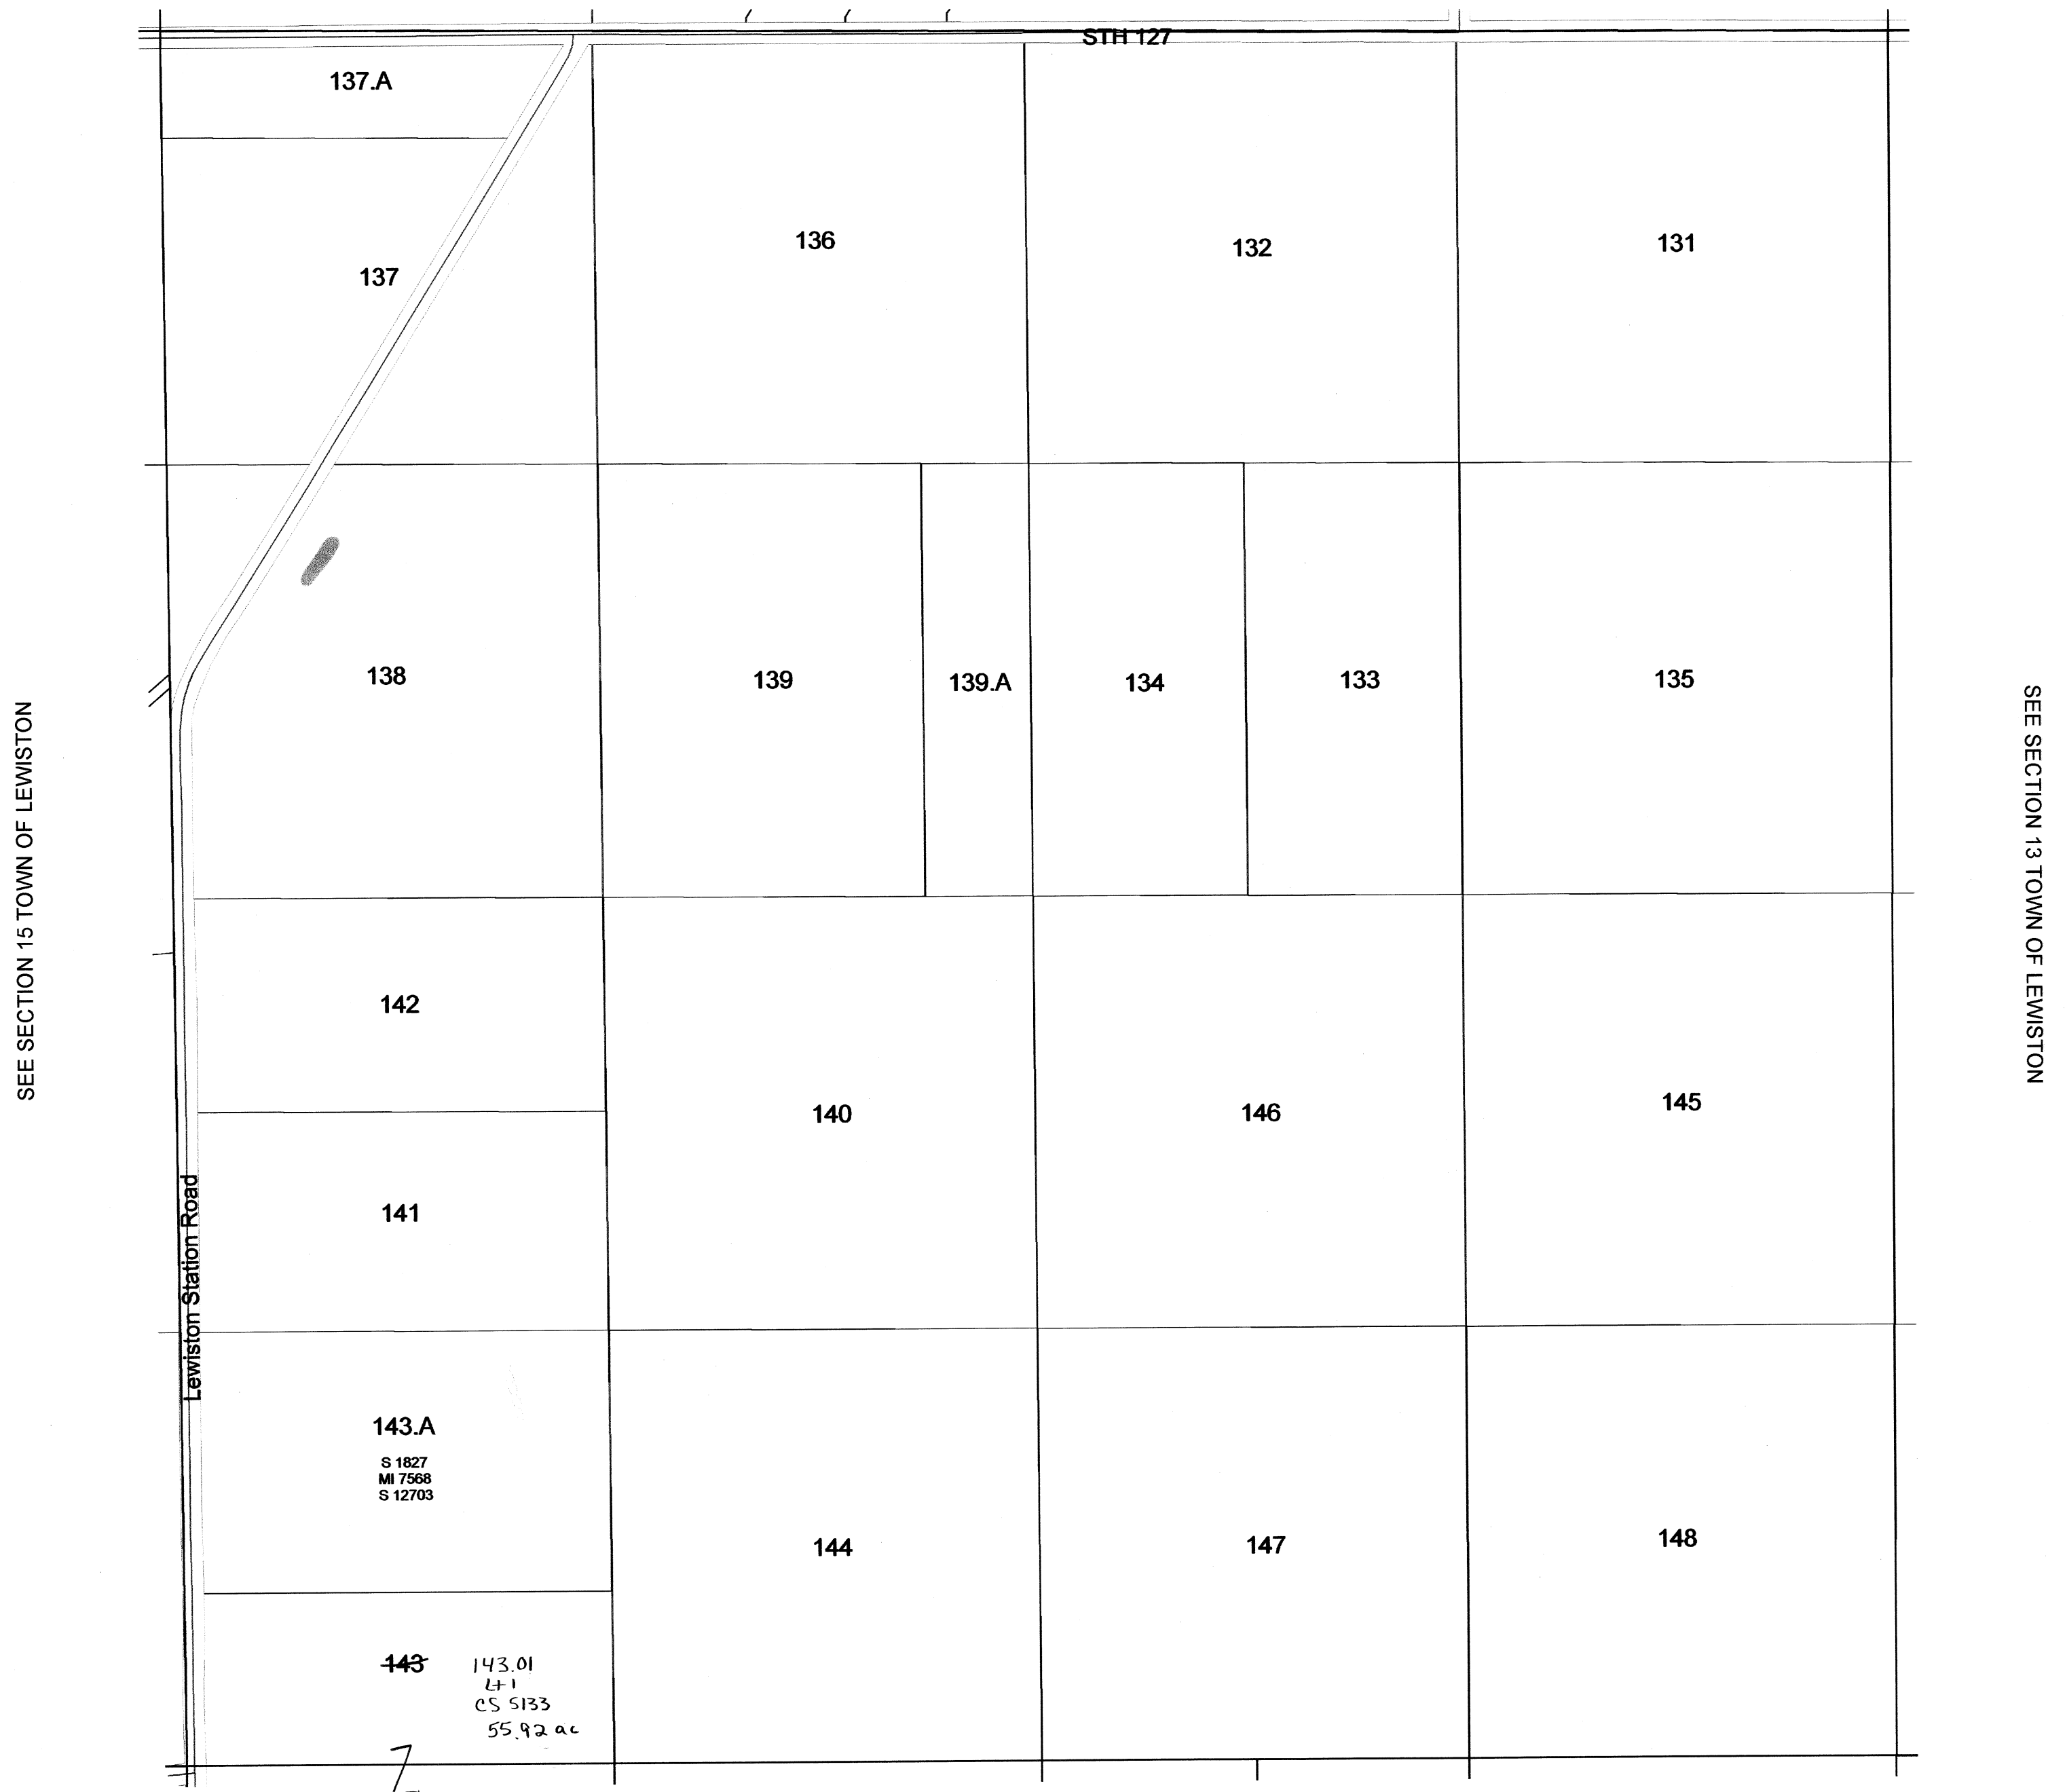


SEE SECTION 23 TOWN OF LEWISTON

Replaced
2011

Section 14
T13N R7E

TOWN OF LEWISTON

T12N R8E T13N R7E T13N R8E

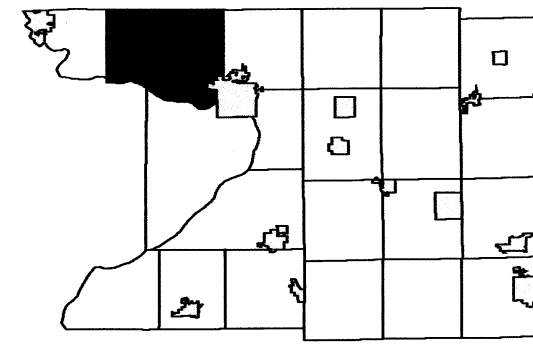


3	2	1	6	5	4	3	2	1
10	11	12	7	8	9	10	11	12
15	14	13	18	17	16	15	14	13
22	23	24	19	20	21	22	23	24
27	26	25	30	29	28	27	26	25
34	35	36	31	32	33	34	35	36
41	42	43	38	37	36	35	34	33
48	47	46	43	42	41	40	39	38
55	54	53	50	49	48	47	46	45
62	61	60	57	56	55	54	53	52
1119	1118	1117	1114	1113	1112	1111	1110	1109
1126</								

TOWN OF LEWISTON

SECTION 22 T13N R8E

1 inch = 400 feet 1:4,800

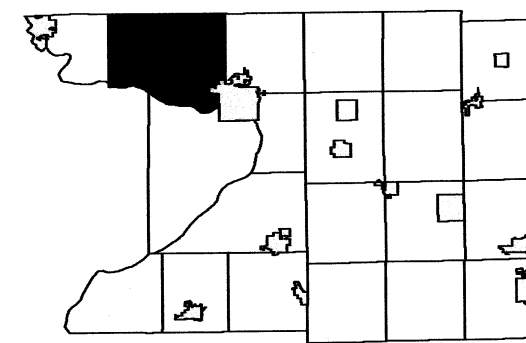


R7E					R8E				
3	2	1	6	5	4	3	2	1	
10	11	12	7	8	9	10	11	12	
15	14	13	18	17	16	15	14	13	T13N
22	23	24	19	20	21	22	23	24	
27	26	25	30	29	28	27	26	25	
34	33	32	31	32	33	34	35	36	T12N

SEE SECTION 15 TOWN OF LEWISTON

SEE SECTION 21 TOWN OF LEWISTON

SEE SECTION 23 TOWN OF LEWISTON

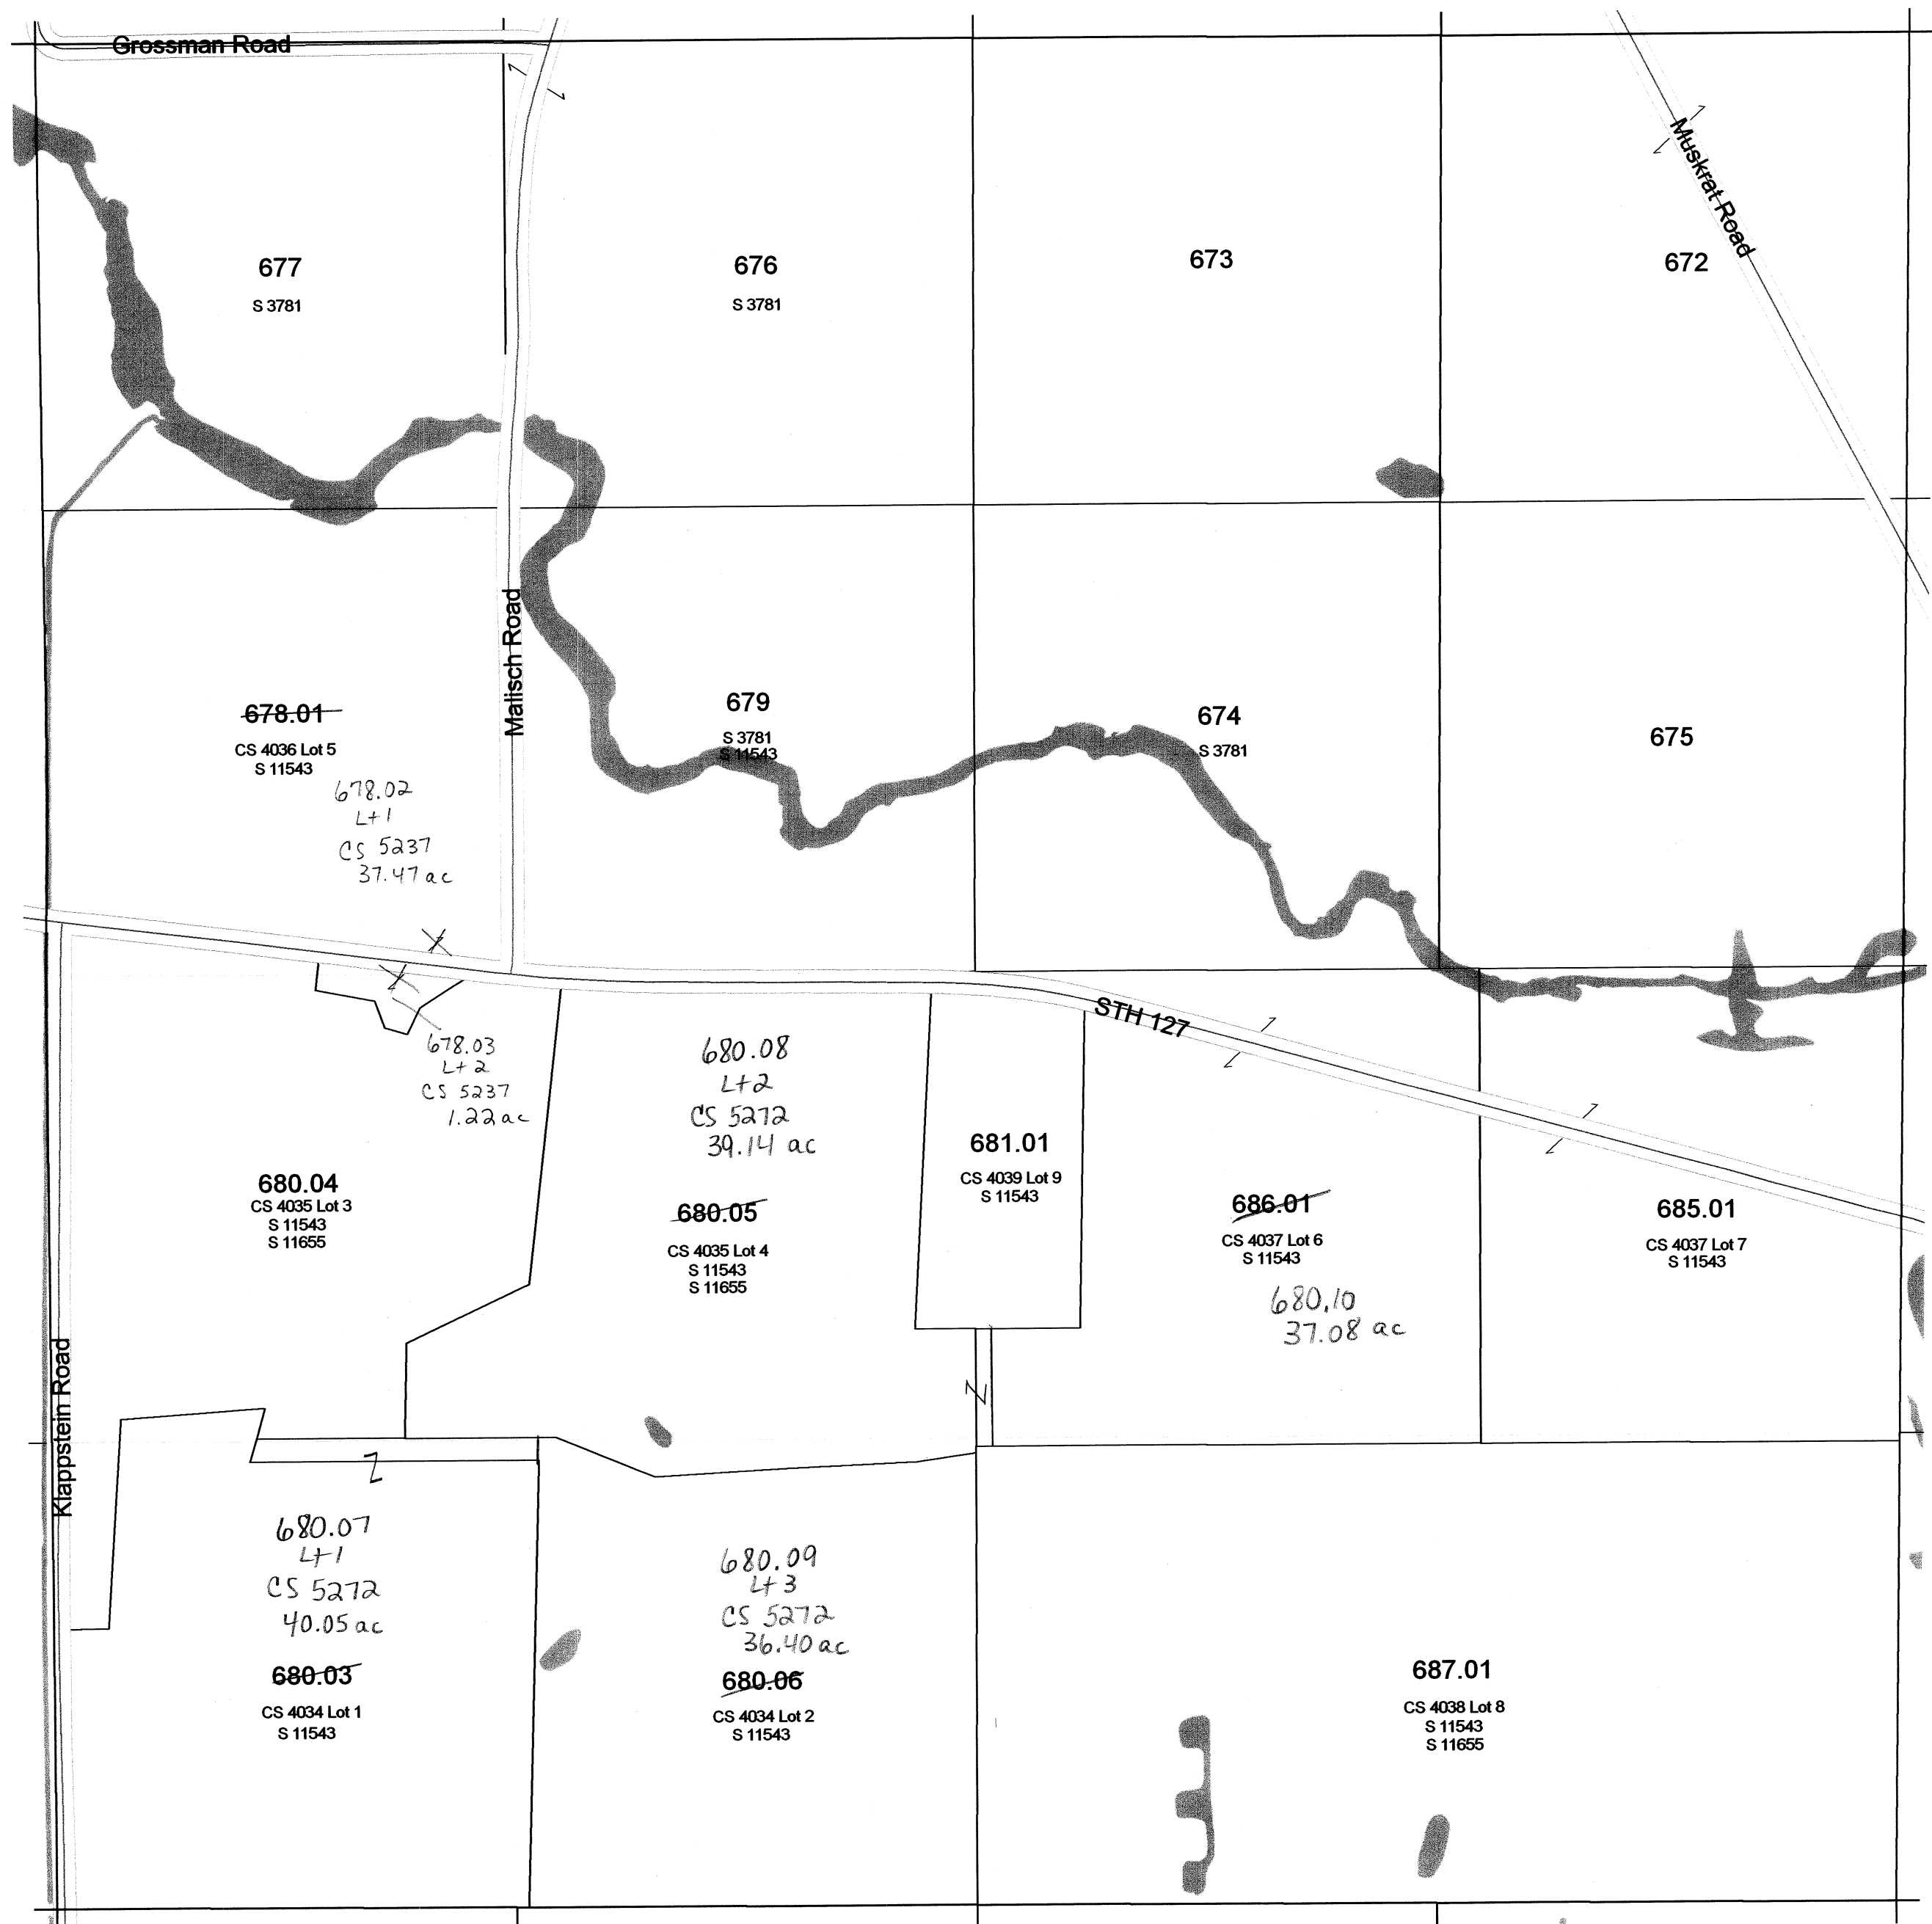


SEE SECTION 27 TOWN OF LEWISTON

TOWN OF LEWISTON

SECTION 14 T13N R8E

1 inch = 400 feet 1:4,800

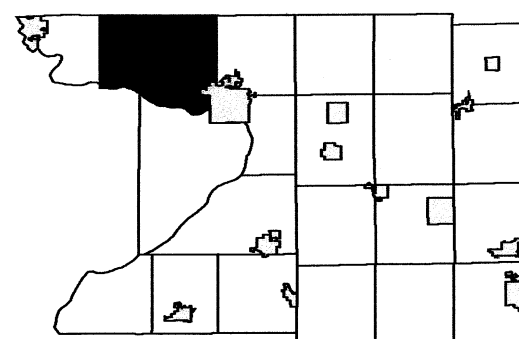


R7E			R8E			R9E		
3	2	1	6	5	4	3	2	1
10	11	12	7	8	9	10	11	12
15	14	13	18	17	16	15	14	13
22	23	24	19	20	21	22	23	24
27	26	25	30	29	28	27	26	25
34	35	36	31	32	33	34	35	36

TOWN OF LEWISTON

SECTION 13 T13N R8E

1 inch = 400 feet 1:4,800

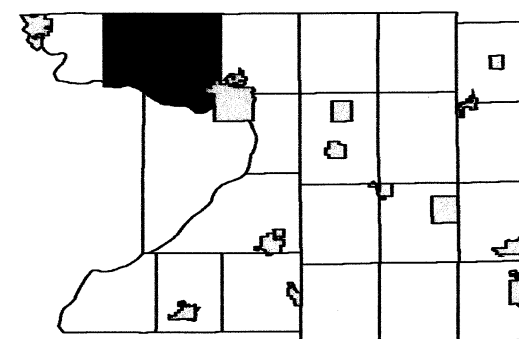


R7E			R8E			R9E		
3	2	1	6	5	4	3	2	1
10	11	12	7	8	9	10	11	12
15	14	13	18	17	16	15	14	13
22	23	24	19	20	21	22	23	24
27	26	25	30	29	28	27	26	25
34	33	32	31	32	33	34	35	36

TOWN OF LEWISTON

SECTION 1 T13N R8E

1 inch = 400 feet 1:4,800

SEE MARQUETTE COUNTY

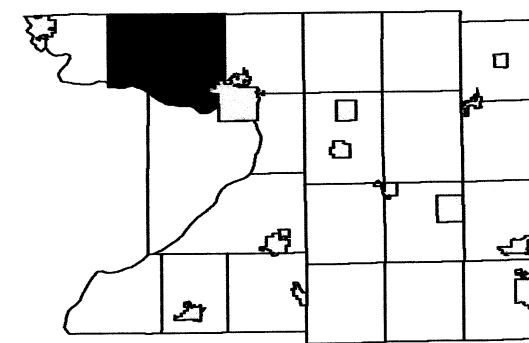


R7E				R8E								
3	2	1	6	5	4	3	2					
10	11	12	7	8	9	10	11	12				
15	14	13	18	17	16	15	14	13				
22	23	24	19	20	21	22	23	24	T13N			
27	26	25	30	29	28	27	26	25				
34	33	32	31	32	33	34	35	36				

TOWN OF LEWISTON


SECTION 36 T13N R7E

1 inch = 400 feet 1:4,800

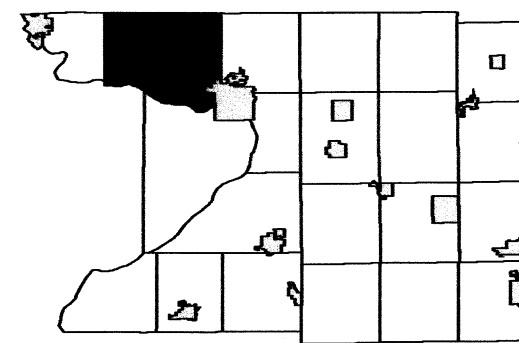

R7E						R8E					
3	2	1	6	5	4	3	2	1			
10	11	12	7	8	9	10	11	12			
15	14	13	18	17	16	15	14	13			
22	23	24	19	20	21	22	23	24			
27	26	25	30	29	28	27	26	25			
34	33	32	31	32	33	34	35	36			
						5	4	3	2	1	
						10	11	12			

SEE SECTION 25 TOWN OF LEWISTON

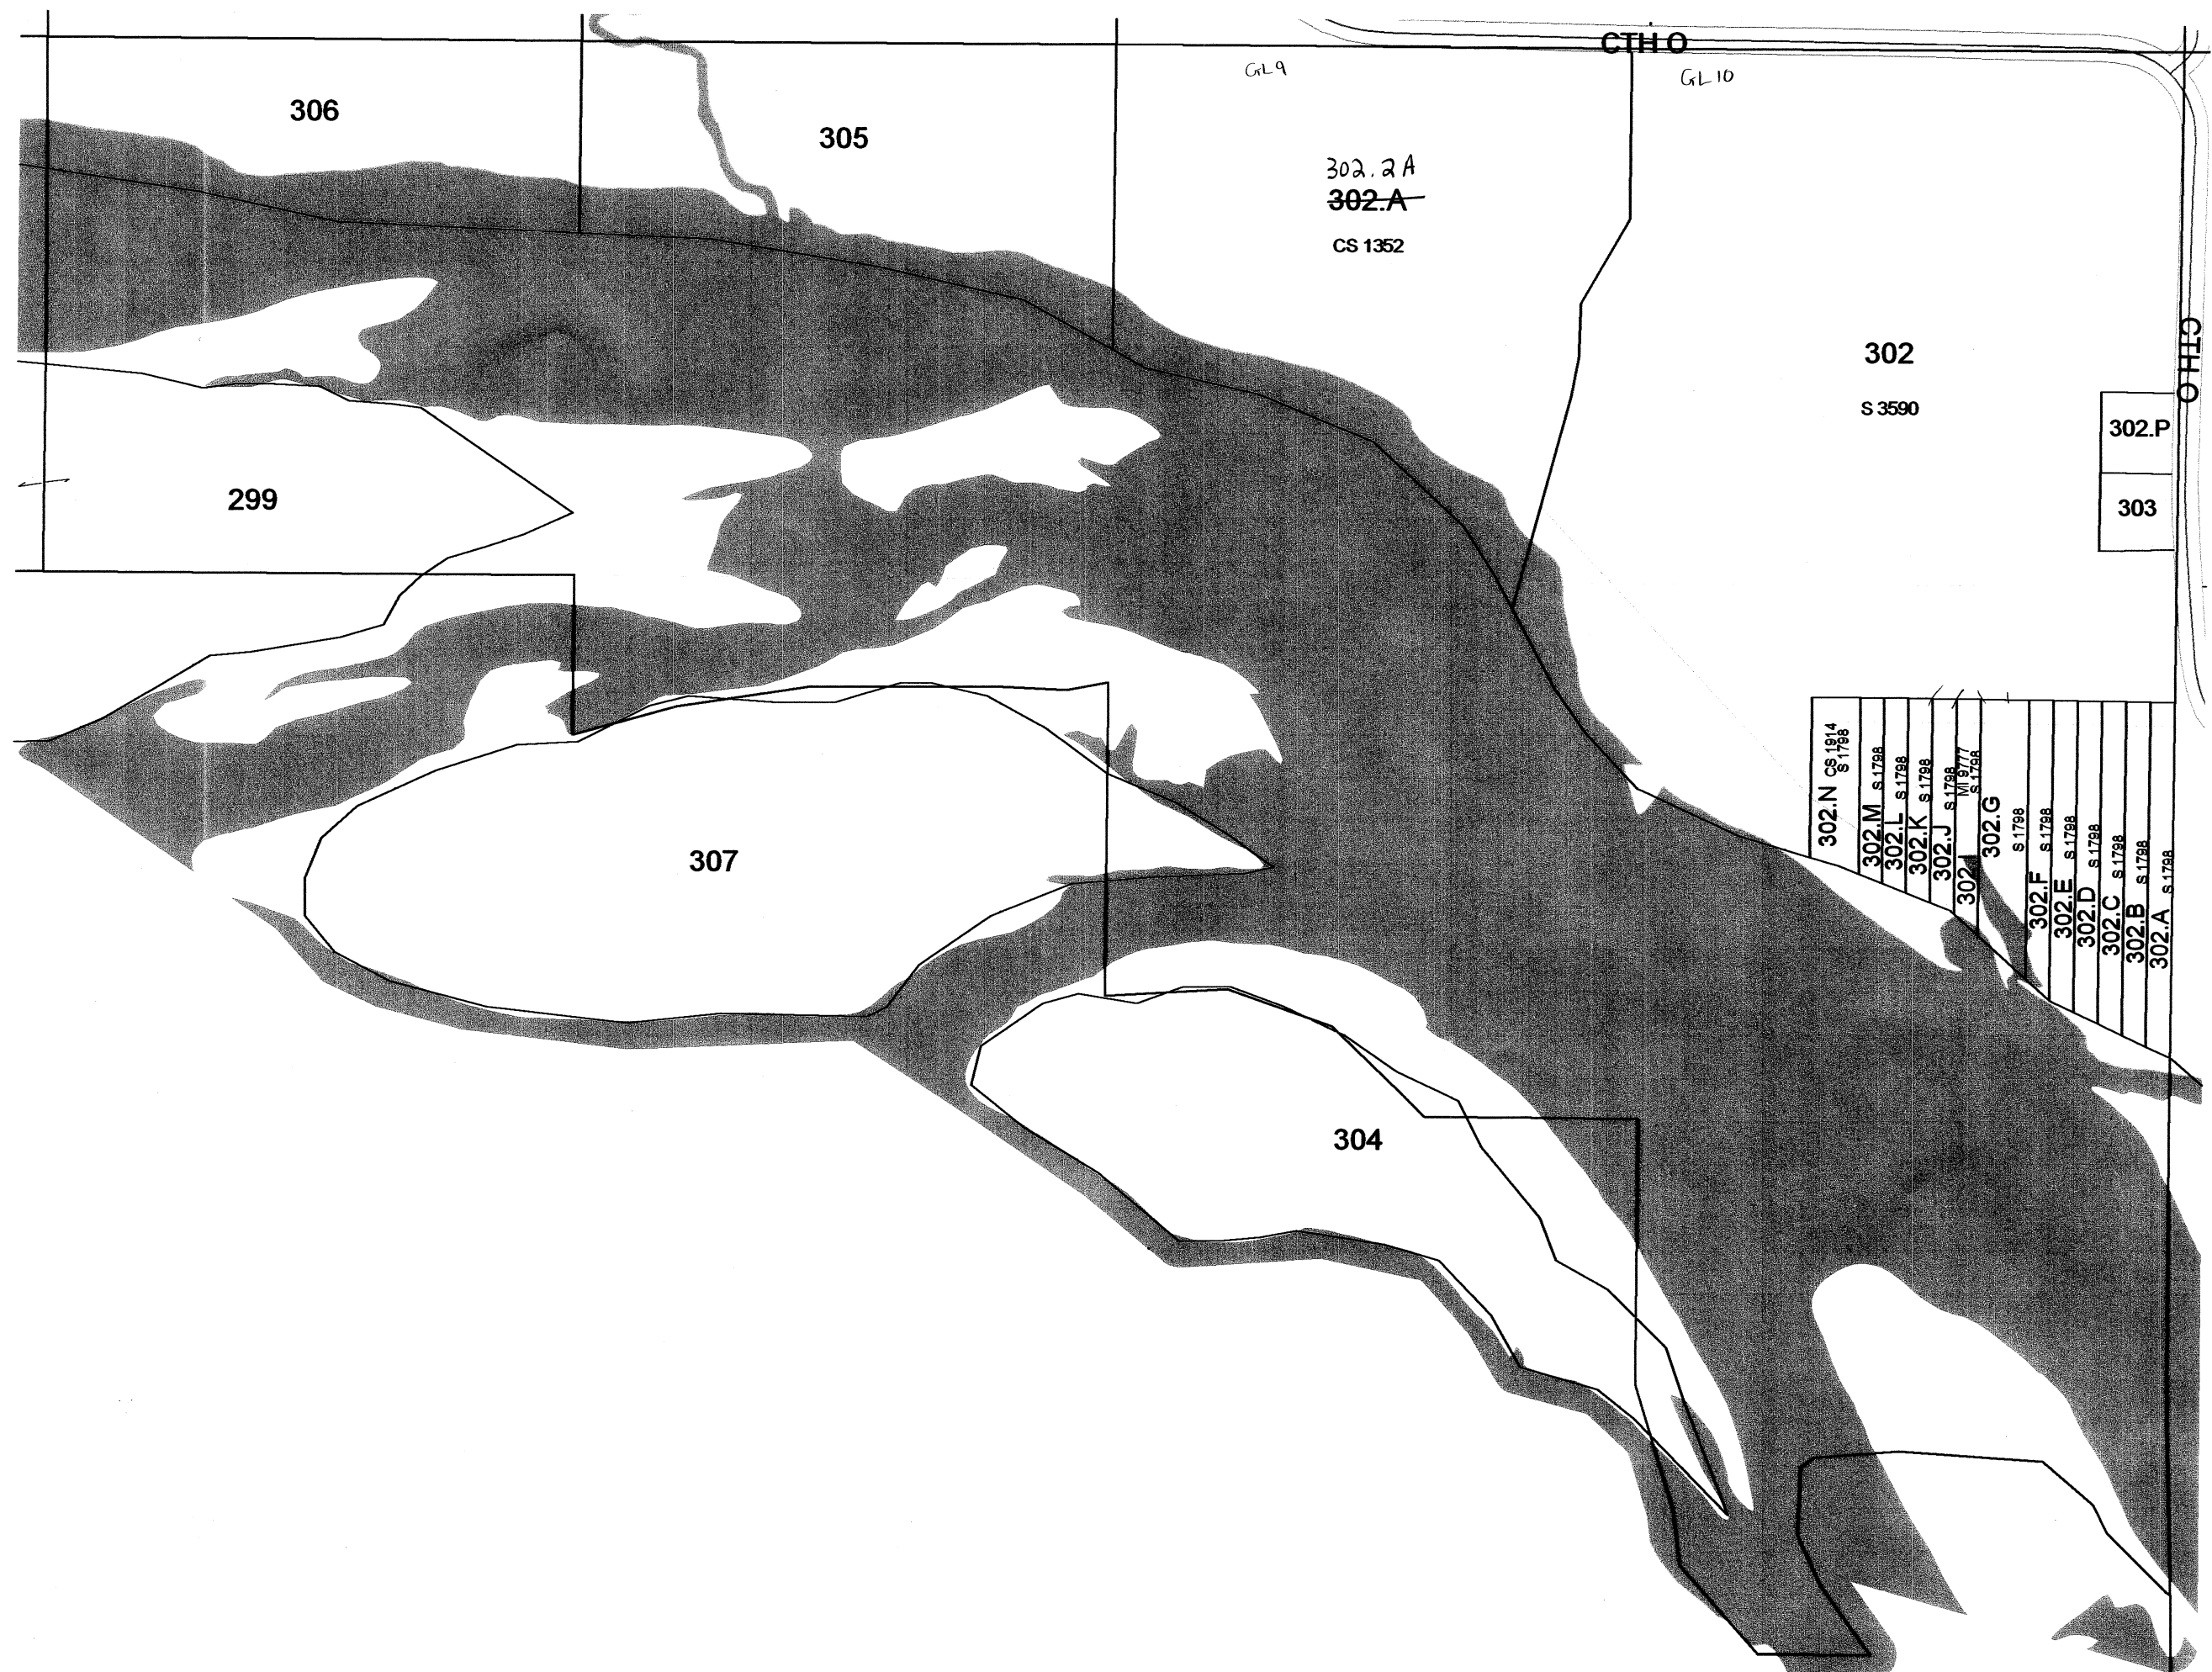

SEE SAUK COUNTY

SEE SECTION 31 TOWN OF LEWISTON


SEE SAUK COUNTY

Scanned
2012


TOWN OF LEWISTON

SECTION 27 T13N R7E

1 inch = 400 feet 1:4,800

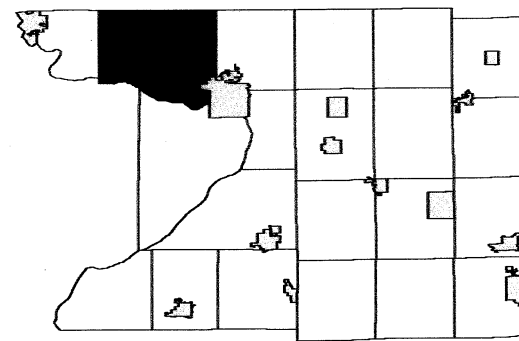

SEE SECTION 22 TOWN OF LEWISTON

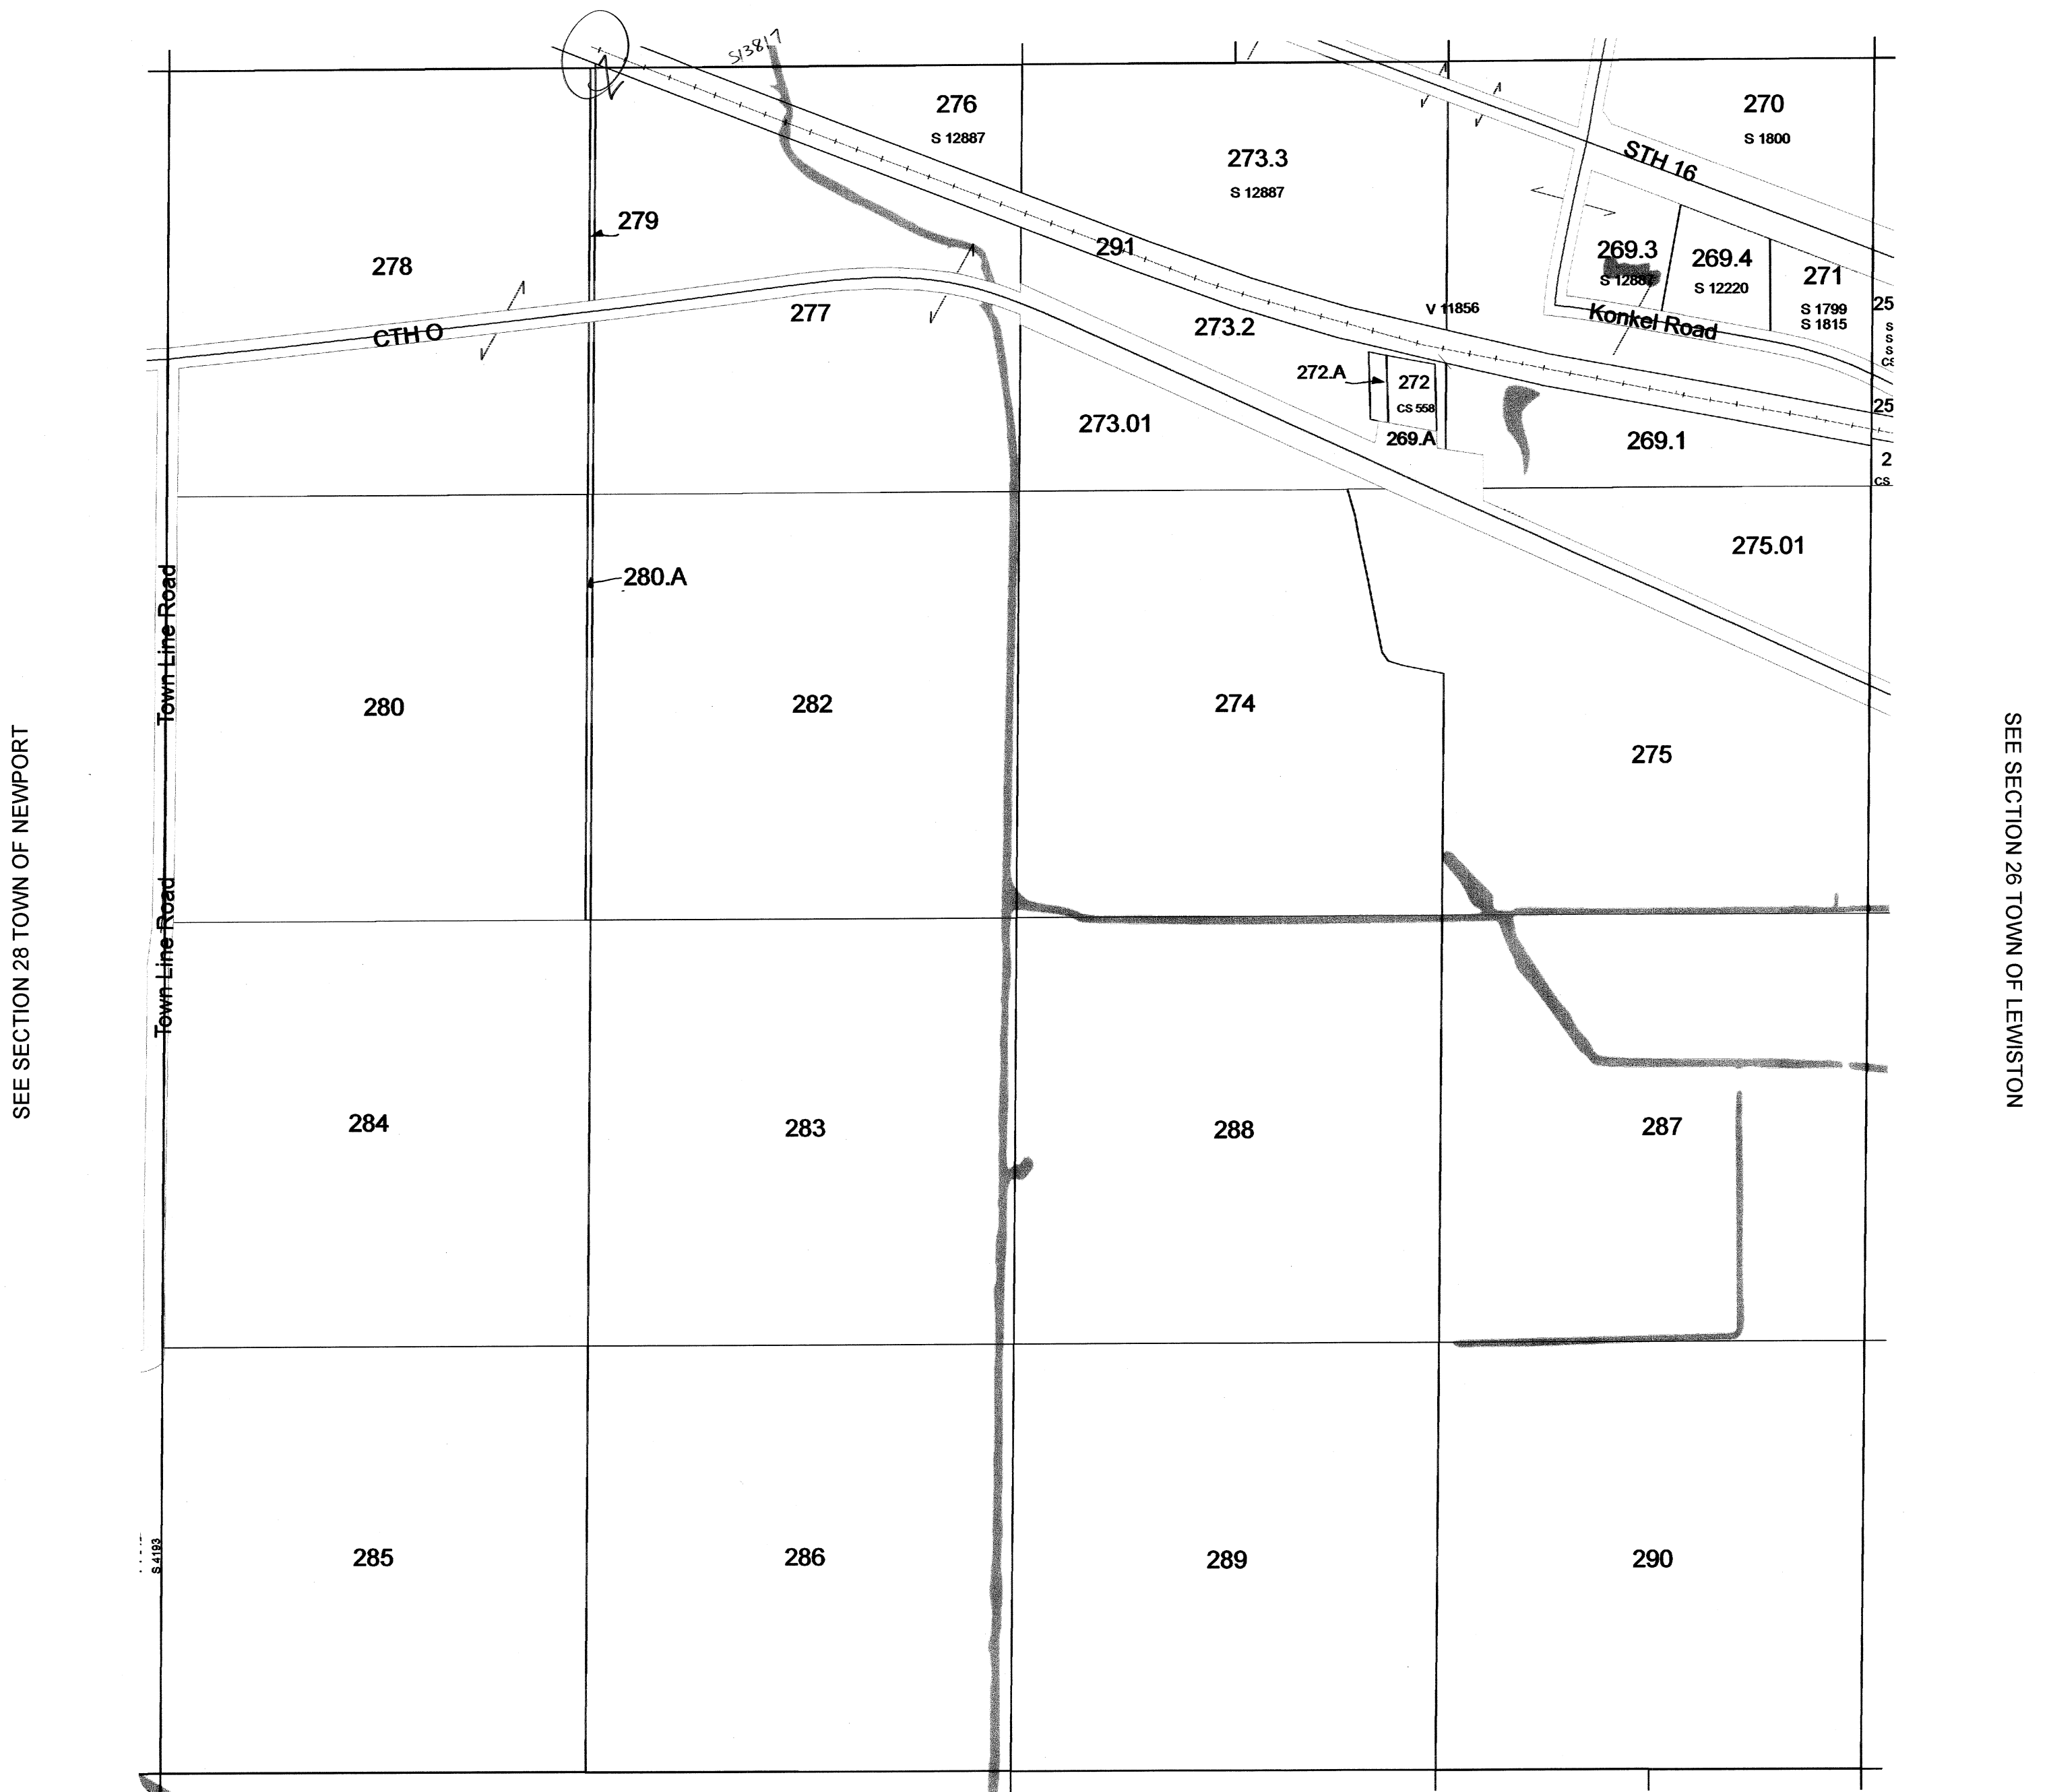

SEE SECTION 34 TOWN OF LEWISTON

Scanned
2012


February 06, 2009
Columbia County Land Information

Section 27
T13N R7E

TOWN OF LEWISTON

SECTION 22 T13N R7E

1 inch = 400 feet 1:4,800

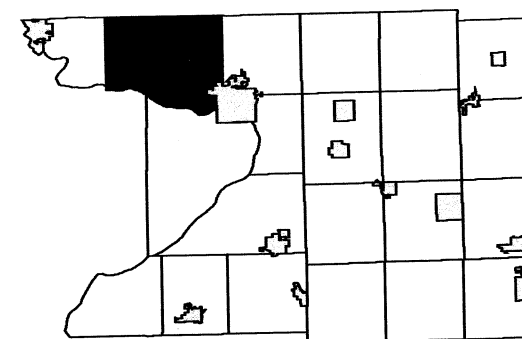


R7E						R8E					
3	2	1	6	5	4	3	2	1			
10	11	12	7	8	9	10	11	12			
15	14	13	18	17	16	15	14	13			
	23	24	19	20	21	22	23	24			
27	26	25	30	29	28	27	26	25			
34	35	36	31	32	33	34	35	36			

SEE SECTION 15 TOWN OF LEWISTON

SEE SECTION 21 TOWN OF NEWPORT

SEE SECTION 23 TOWN OF LEWISTON

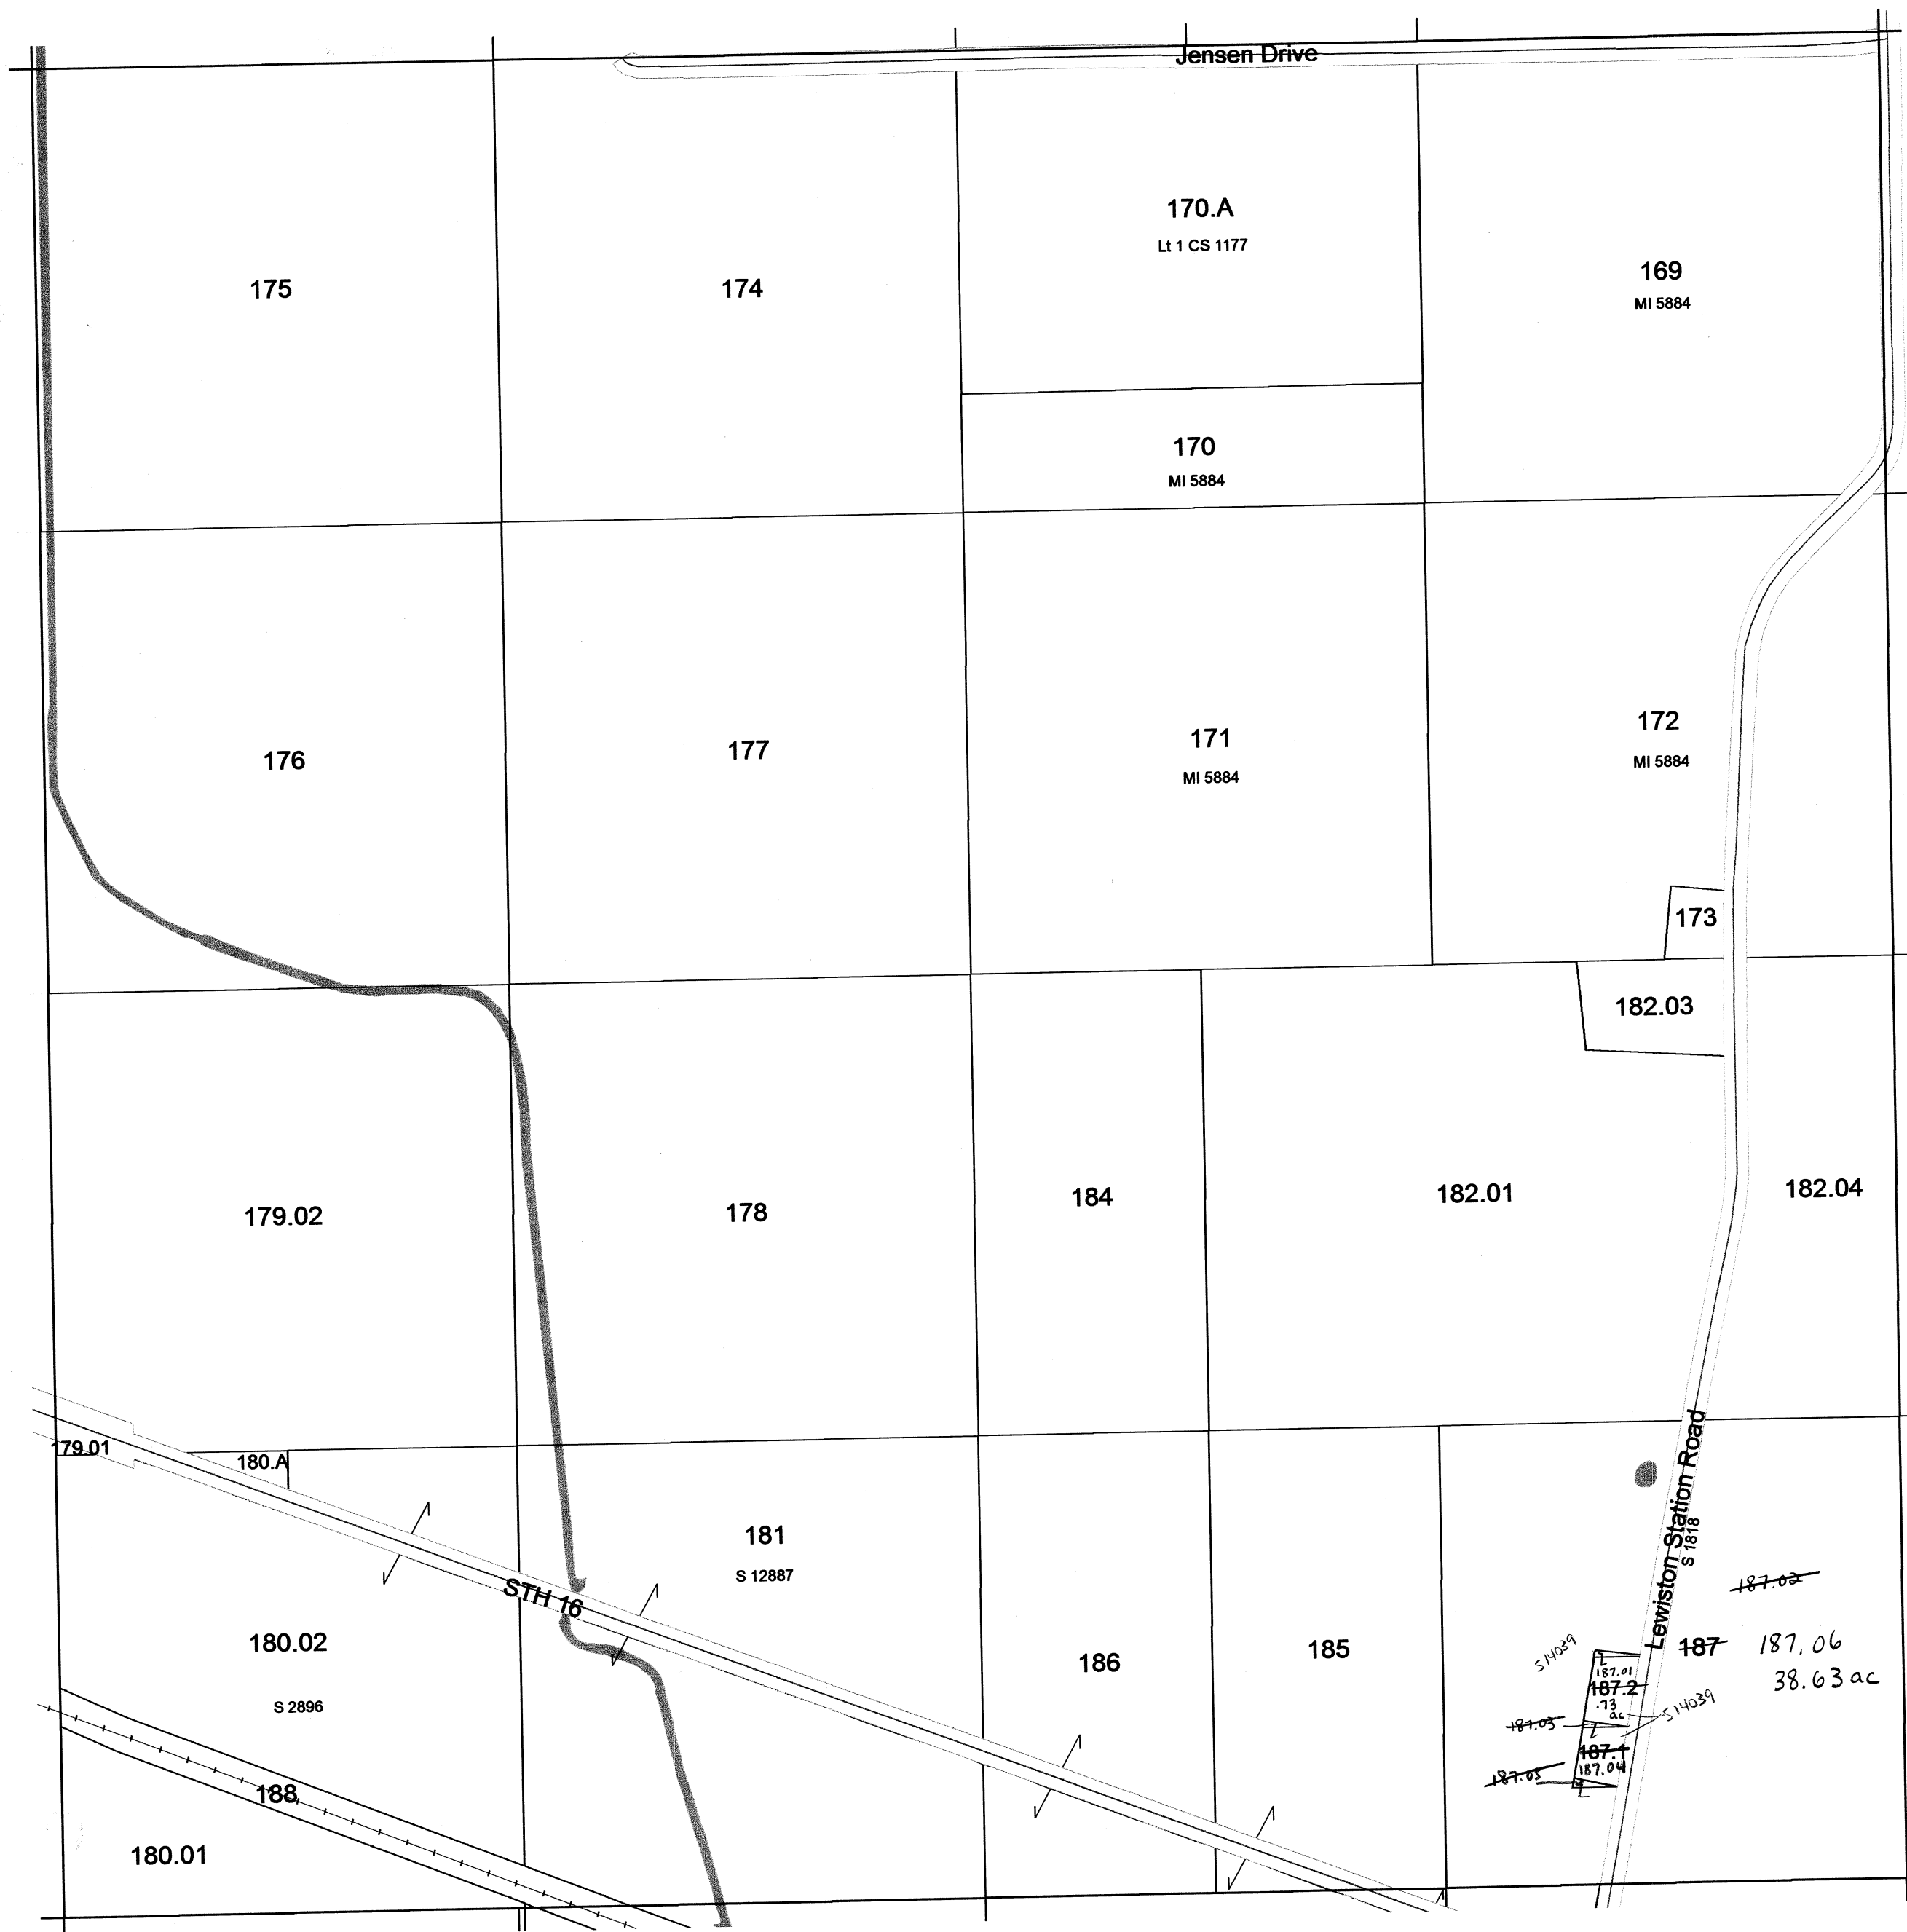

SEE SECTION 27 TOWN OF LEWISTON

Scanned
2012

1 inch = 400 feet 1:4,800

R7E

3	[shaded]	1	6	5	4	3	2	1
10	11	12	7	8	9	10	11	12
15	14	13	18	17	16	15	14	13
22	23	24	19	20	21	22	23	24
27	26	25	30	29	28	27	26	25
34	35	36	31	32	33	34	35	36

T13N

5	4	3	2	1
10	11	12		

T12N



SEE SECTION 01 TOWN OF LEWISTON


Scanned
2012

February 06, 2009
Columbia County Land Information


Section 02
T13N R7E

TOWN OF LEWISTON

T12N R8E T13N R7E T13N R8E

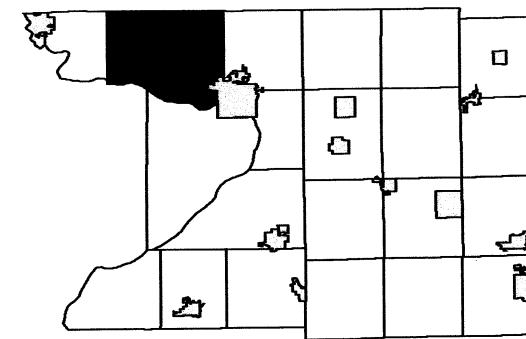

3	2	1	6	5	4	3	2	1
10	11	12	7	8	9	10	11	12
15	14	13	18	17	16	15	14	13
22	23	24	19	20	21	22	23	24
27	26	25	30	29	28	27	26	25
34	35	36	31	32	33	34	35	36
			5	4	3	2	1	
						10	11	12

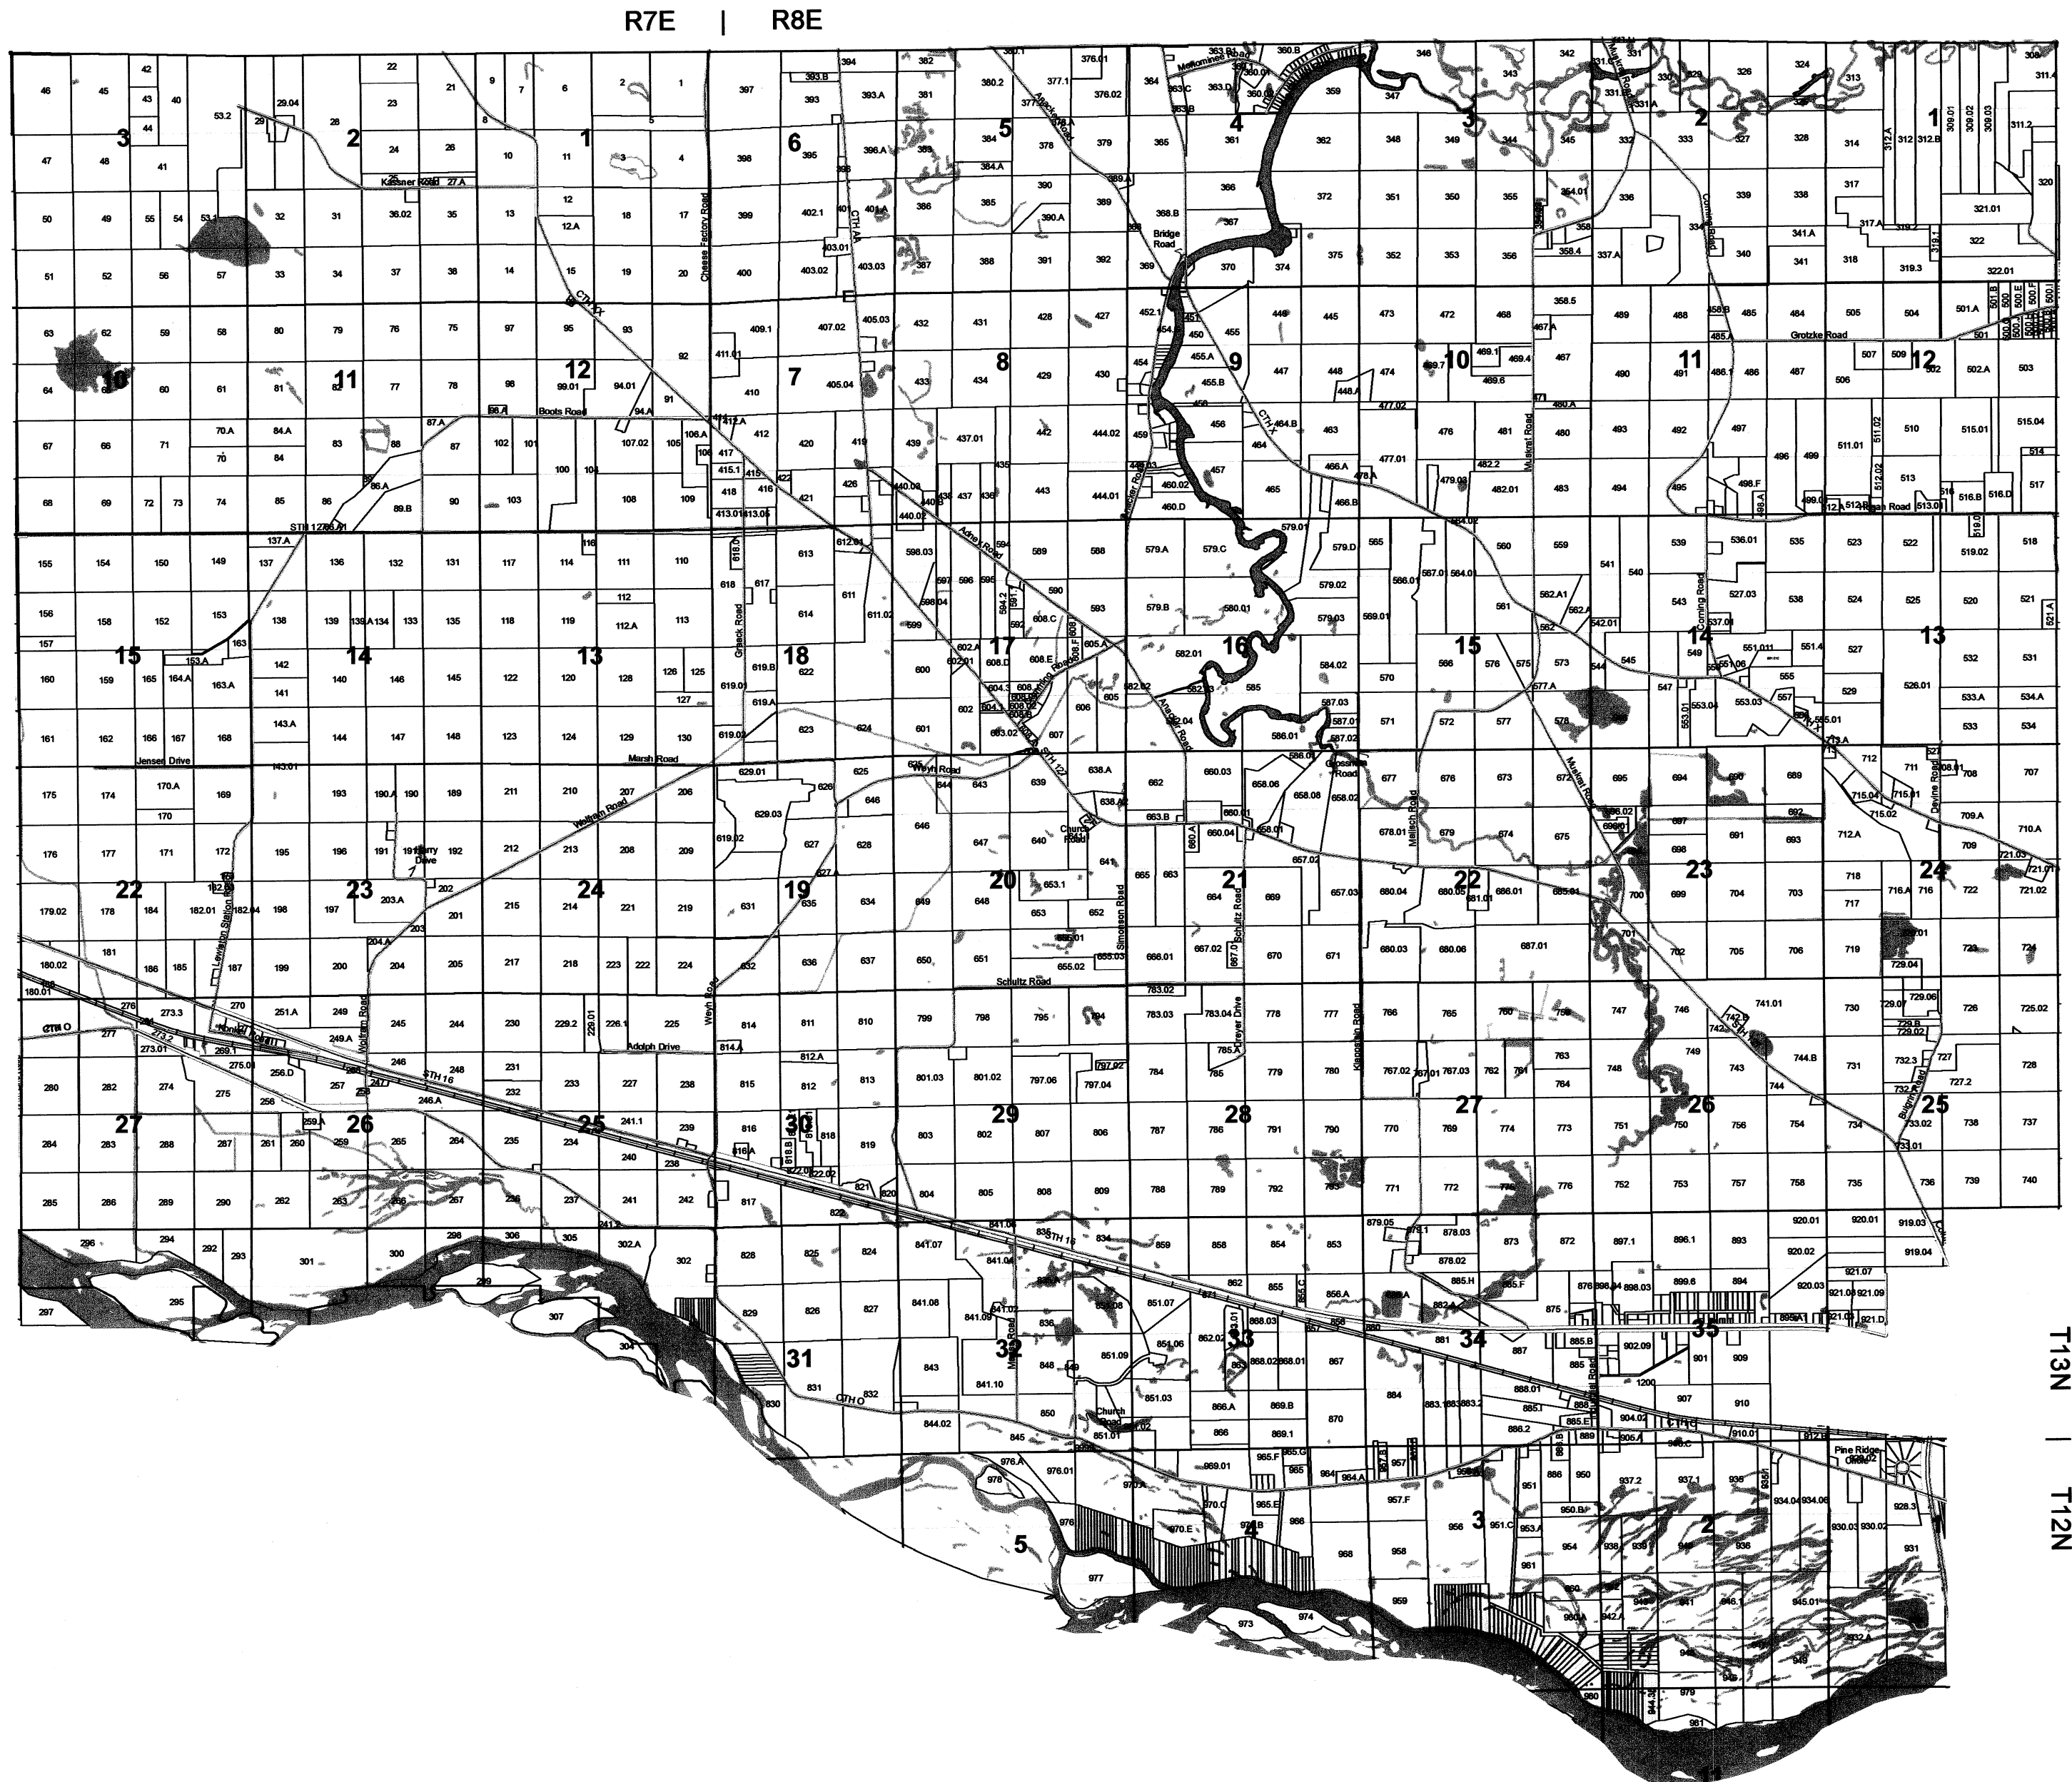


T13N
|
T12N


Scanned
2012

TOWN OF LEWISTON

T12N R8E T13N R7E T13N R8E

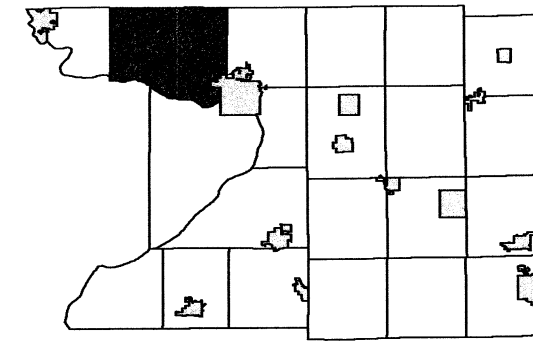


3	2	1	6	5	4	3	2	1
10	11	12	7	8	9	10	11	12
15	14	13	18	17	16	15	14	13
22	23	24	19	20	21	22	23	24
27	26	25	30	29	28	27	26	25
34	35	36	31	32	33	34	35	36
			5	4	3	2		
			10	11	12			

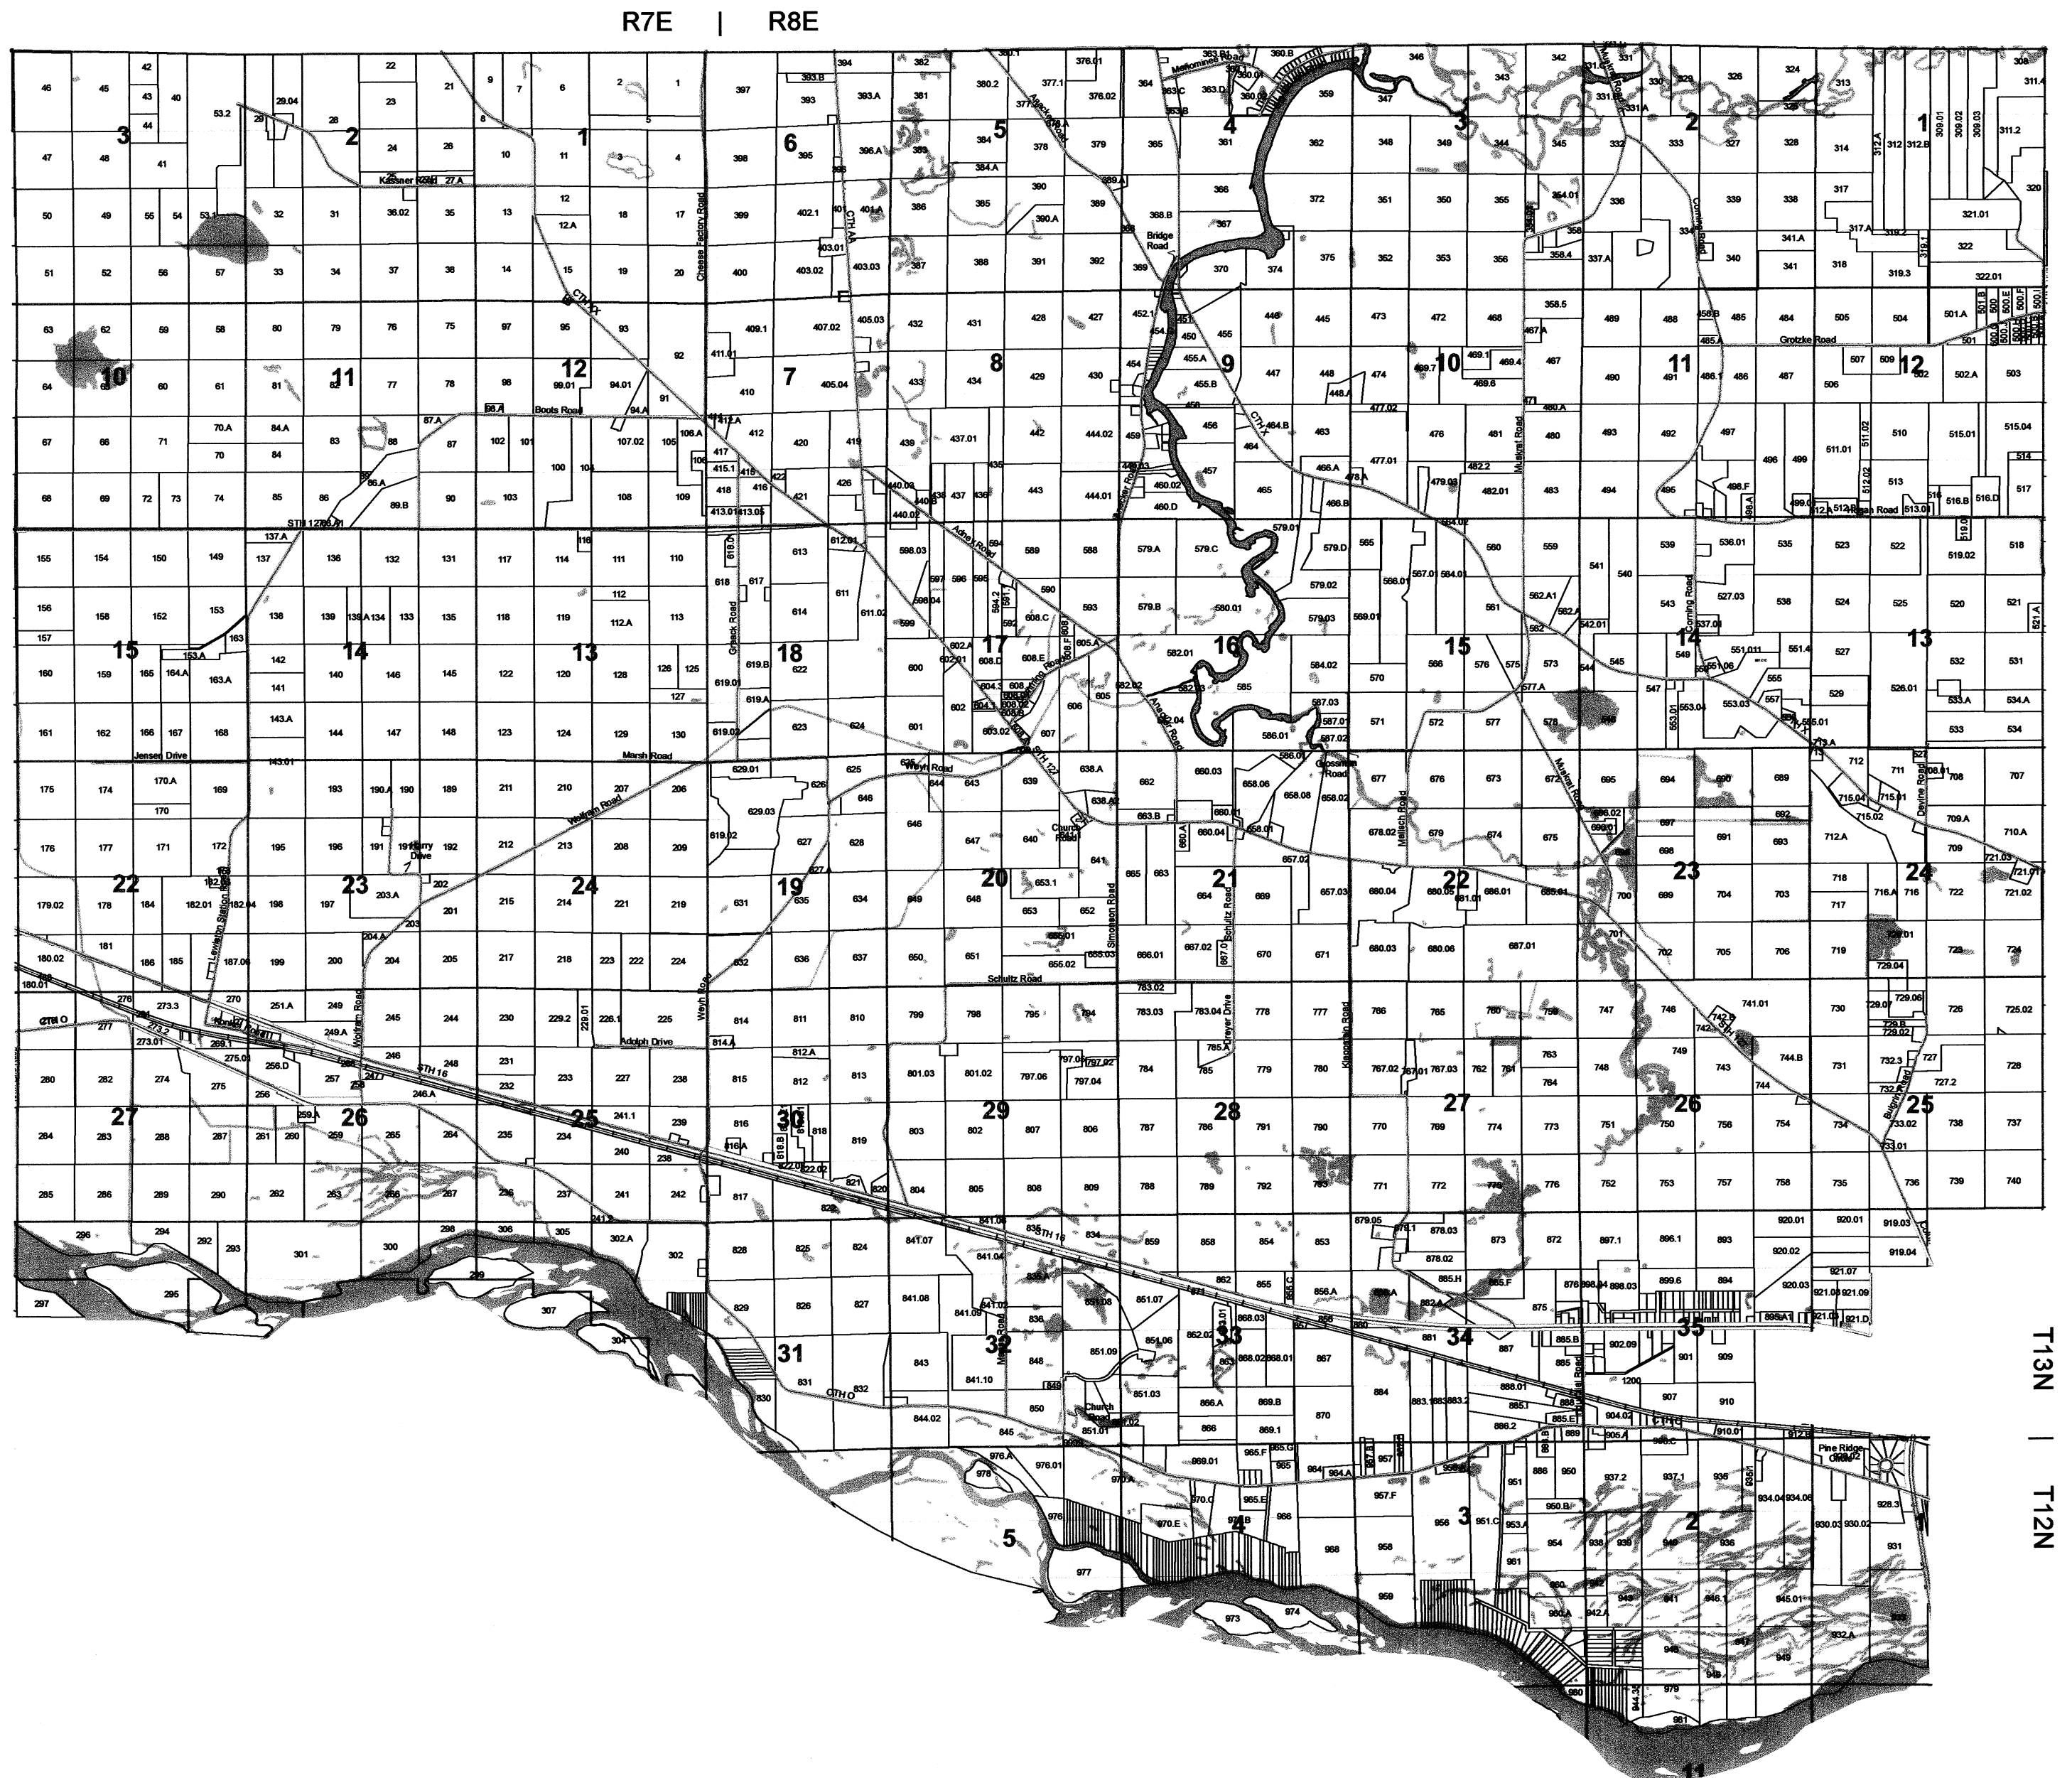


T13N
|
T12N

1 inch = 400 feet 1:4,800

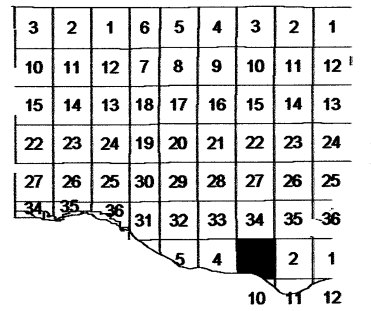

SEE SECTION 04 TOWN OF LEWISTON

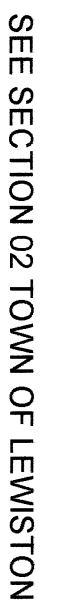

February 06, 2009
Columbia County Land Information


Scanned
2013

Section 03
T12N R8E

TOWN OF LEWISTON

SECTION 4 T12N R8E


1 inch = 400 feet 1:4,800

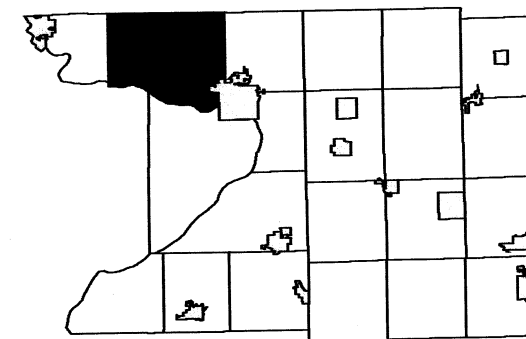

3	2	1	6	5	4	3	2	1
10	11	12	7	8	9	10	11	12
15	14	13	18	17	16	15	14	13
22	23	24	19	20	21	22	23	24
27	26	25	30	29	28	27	26	25
34	33	32	31	32	33	34	35	36
41	40	39	44	43	42	41	40	39
48	47	46	51	50	49	48	47	46
55	54	53	58	57	56	55	54	53
993	992	991	996	995	994	993	992	991
1000	999	998	1005	1004	1003	1000	999	998
1007	1006	1005	1010	1009	1008	1007	1006	1005
1014	1013	1012	1017	1016	1015	1014	1013	1012
1021	1020	1019	1024	1023	1022	1021	1020	1019
1028	1027	1026	1031	1030	1029	1028	1027	1026
1035	1034	1033	1038	1037	1036	1035	1034	1033
1042	1041	1040	1045	1044	1043	1042	1041	1040
1049	1048	1047	1052	1051	1050	1049	1048	1047
1056	1055	1054	1059	1058	1057	1056	1055	1054
1063	1062	1061	1066	1065	1064	1063	1062	1061
1070	1069	1068	1073	1072	1071	1070	1069	1068
1077	1076	1075	1080	1079	1078	1077	1076	1075
1084	1083	1082	1087	1086	1085	1084	1083	1082
1091	1090	1089	1094	1093	1092	1091	1090	1089
1098	1097	1096	1101	1100	1099	1098	1097	1096
1105	1104	1103	1108	1107	1106	1105	1104	1103
1112	1111	1110	1115	1114	1113	1112	1111	1110
1119								

1 inch = 400 feet 1:4,800

The diagram shows a 6x12 grid of road segments. The columns are labeled R7E (left) and R8E (right). The rows are labeled T13N (top) and T12N (bottom). The grid contains numbers representing road segments. A thick black line highlights a specific path starting from the intersection of R7E and T13N, moving right to the intersection of R7E and T12N, then down to the intersection of R8E and T12N, and finally right to the intersection of R8E and T13N. The path is highlighted in black.

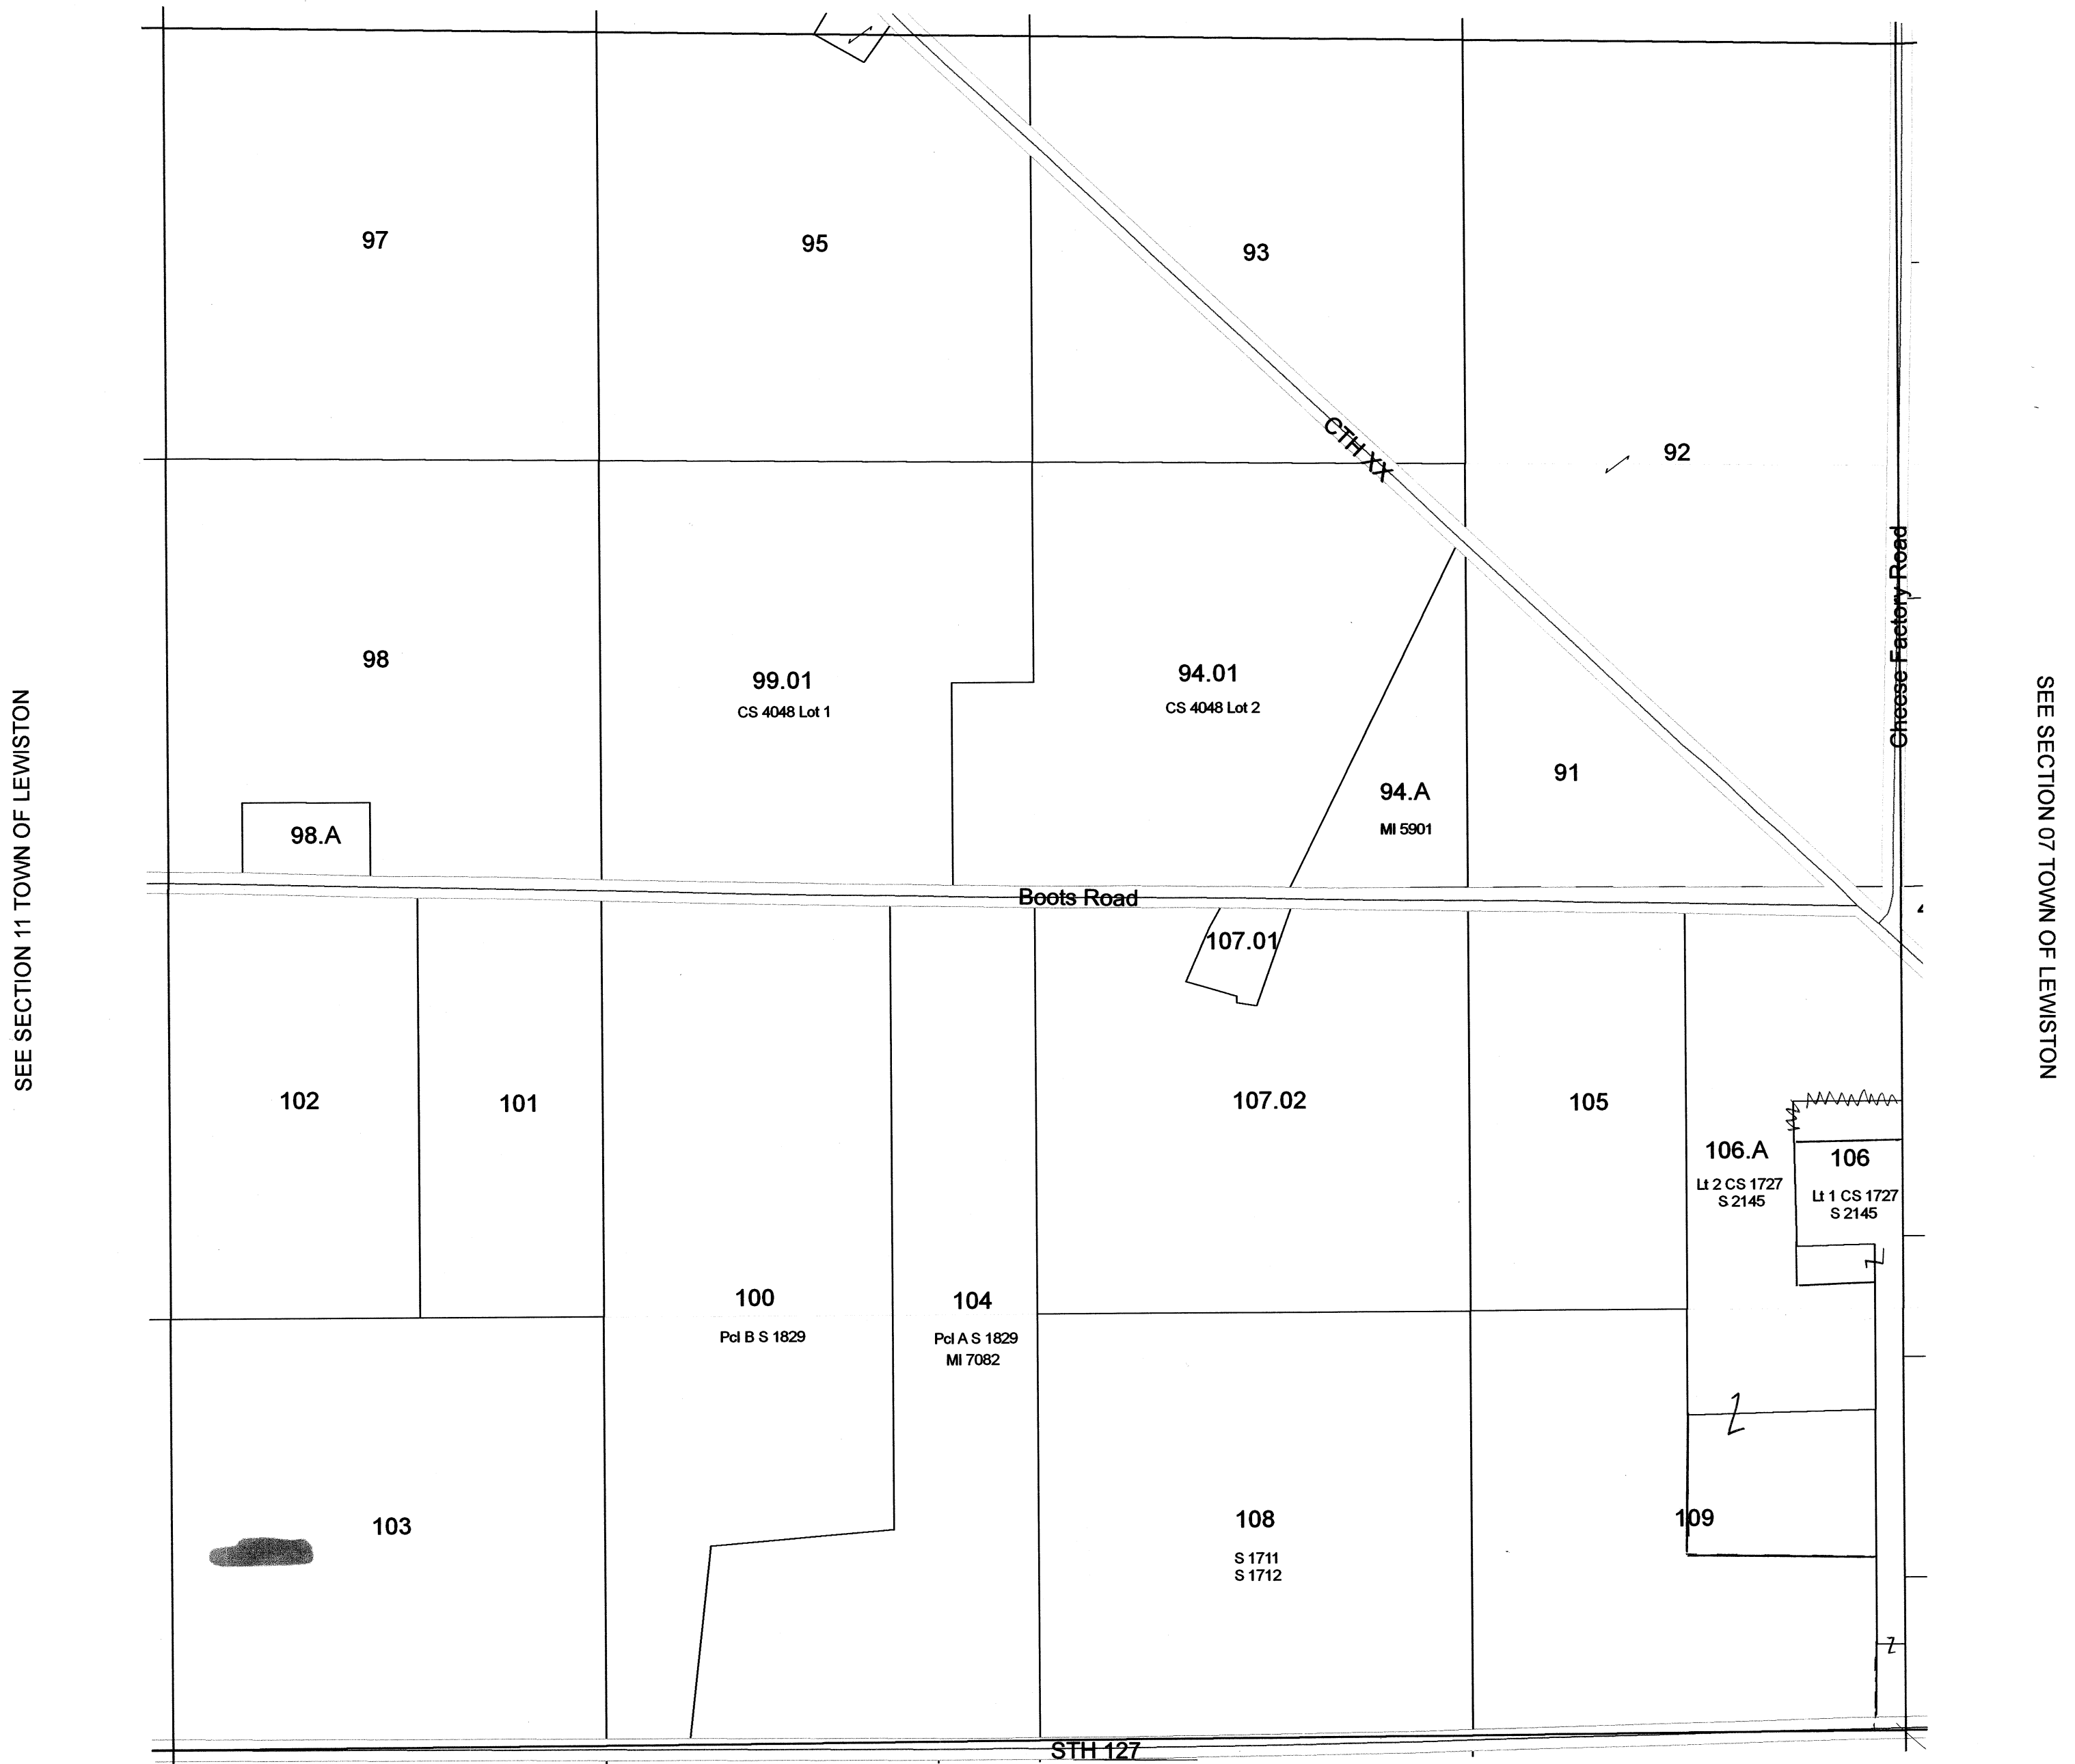

Scanned
2013


Section 12
T13N R7E

TOWN OF LEWISTON

SECTION 2 T13N R8E

1 inch = 400 feet 1:4,800

SEE MARQUETTE COUNTY

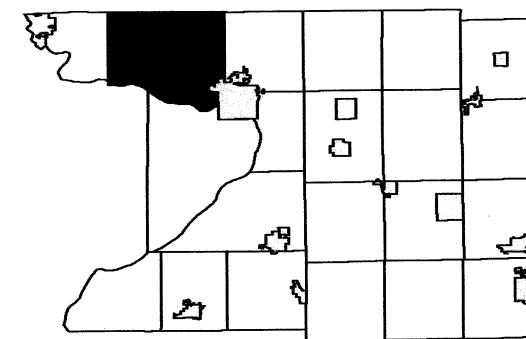


R7E				R8E								
3	2	1	6	5	4	3		1				
10	11	12	7	8	9	10	11	12				
15	14	13	18	17	16	15	14	13				
22	23	24	19	20	21	22	23	24				
27	26	25	30	29	28	27	26	25				
34	35	36	31	32	33	34	35	36				

TOWN OF LEWISTON


SECTION 6 T13N R8E

1 inch = 400 feet 1:4,800

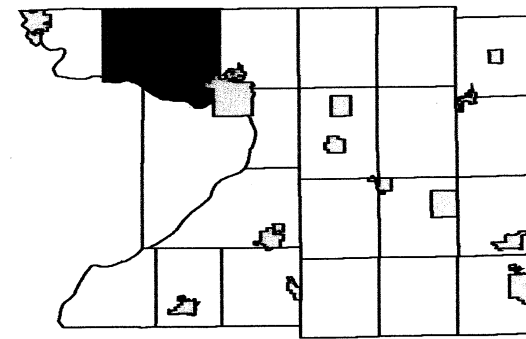

R7E				R8E			
3	2	1	5	4	3	2	1
10	11	12	7	8	9	10	11
15	14	13	18	17	16	15	14
22	23	24	19	20	21	22	23
27	26	25	30	29	28	27	26
34	35	36	31	32	33	34	35
				5	4	3	2
				10	11	12	

SEE MARQUETTE COUNTY

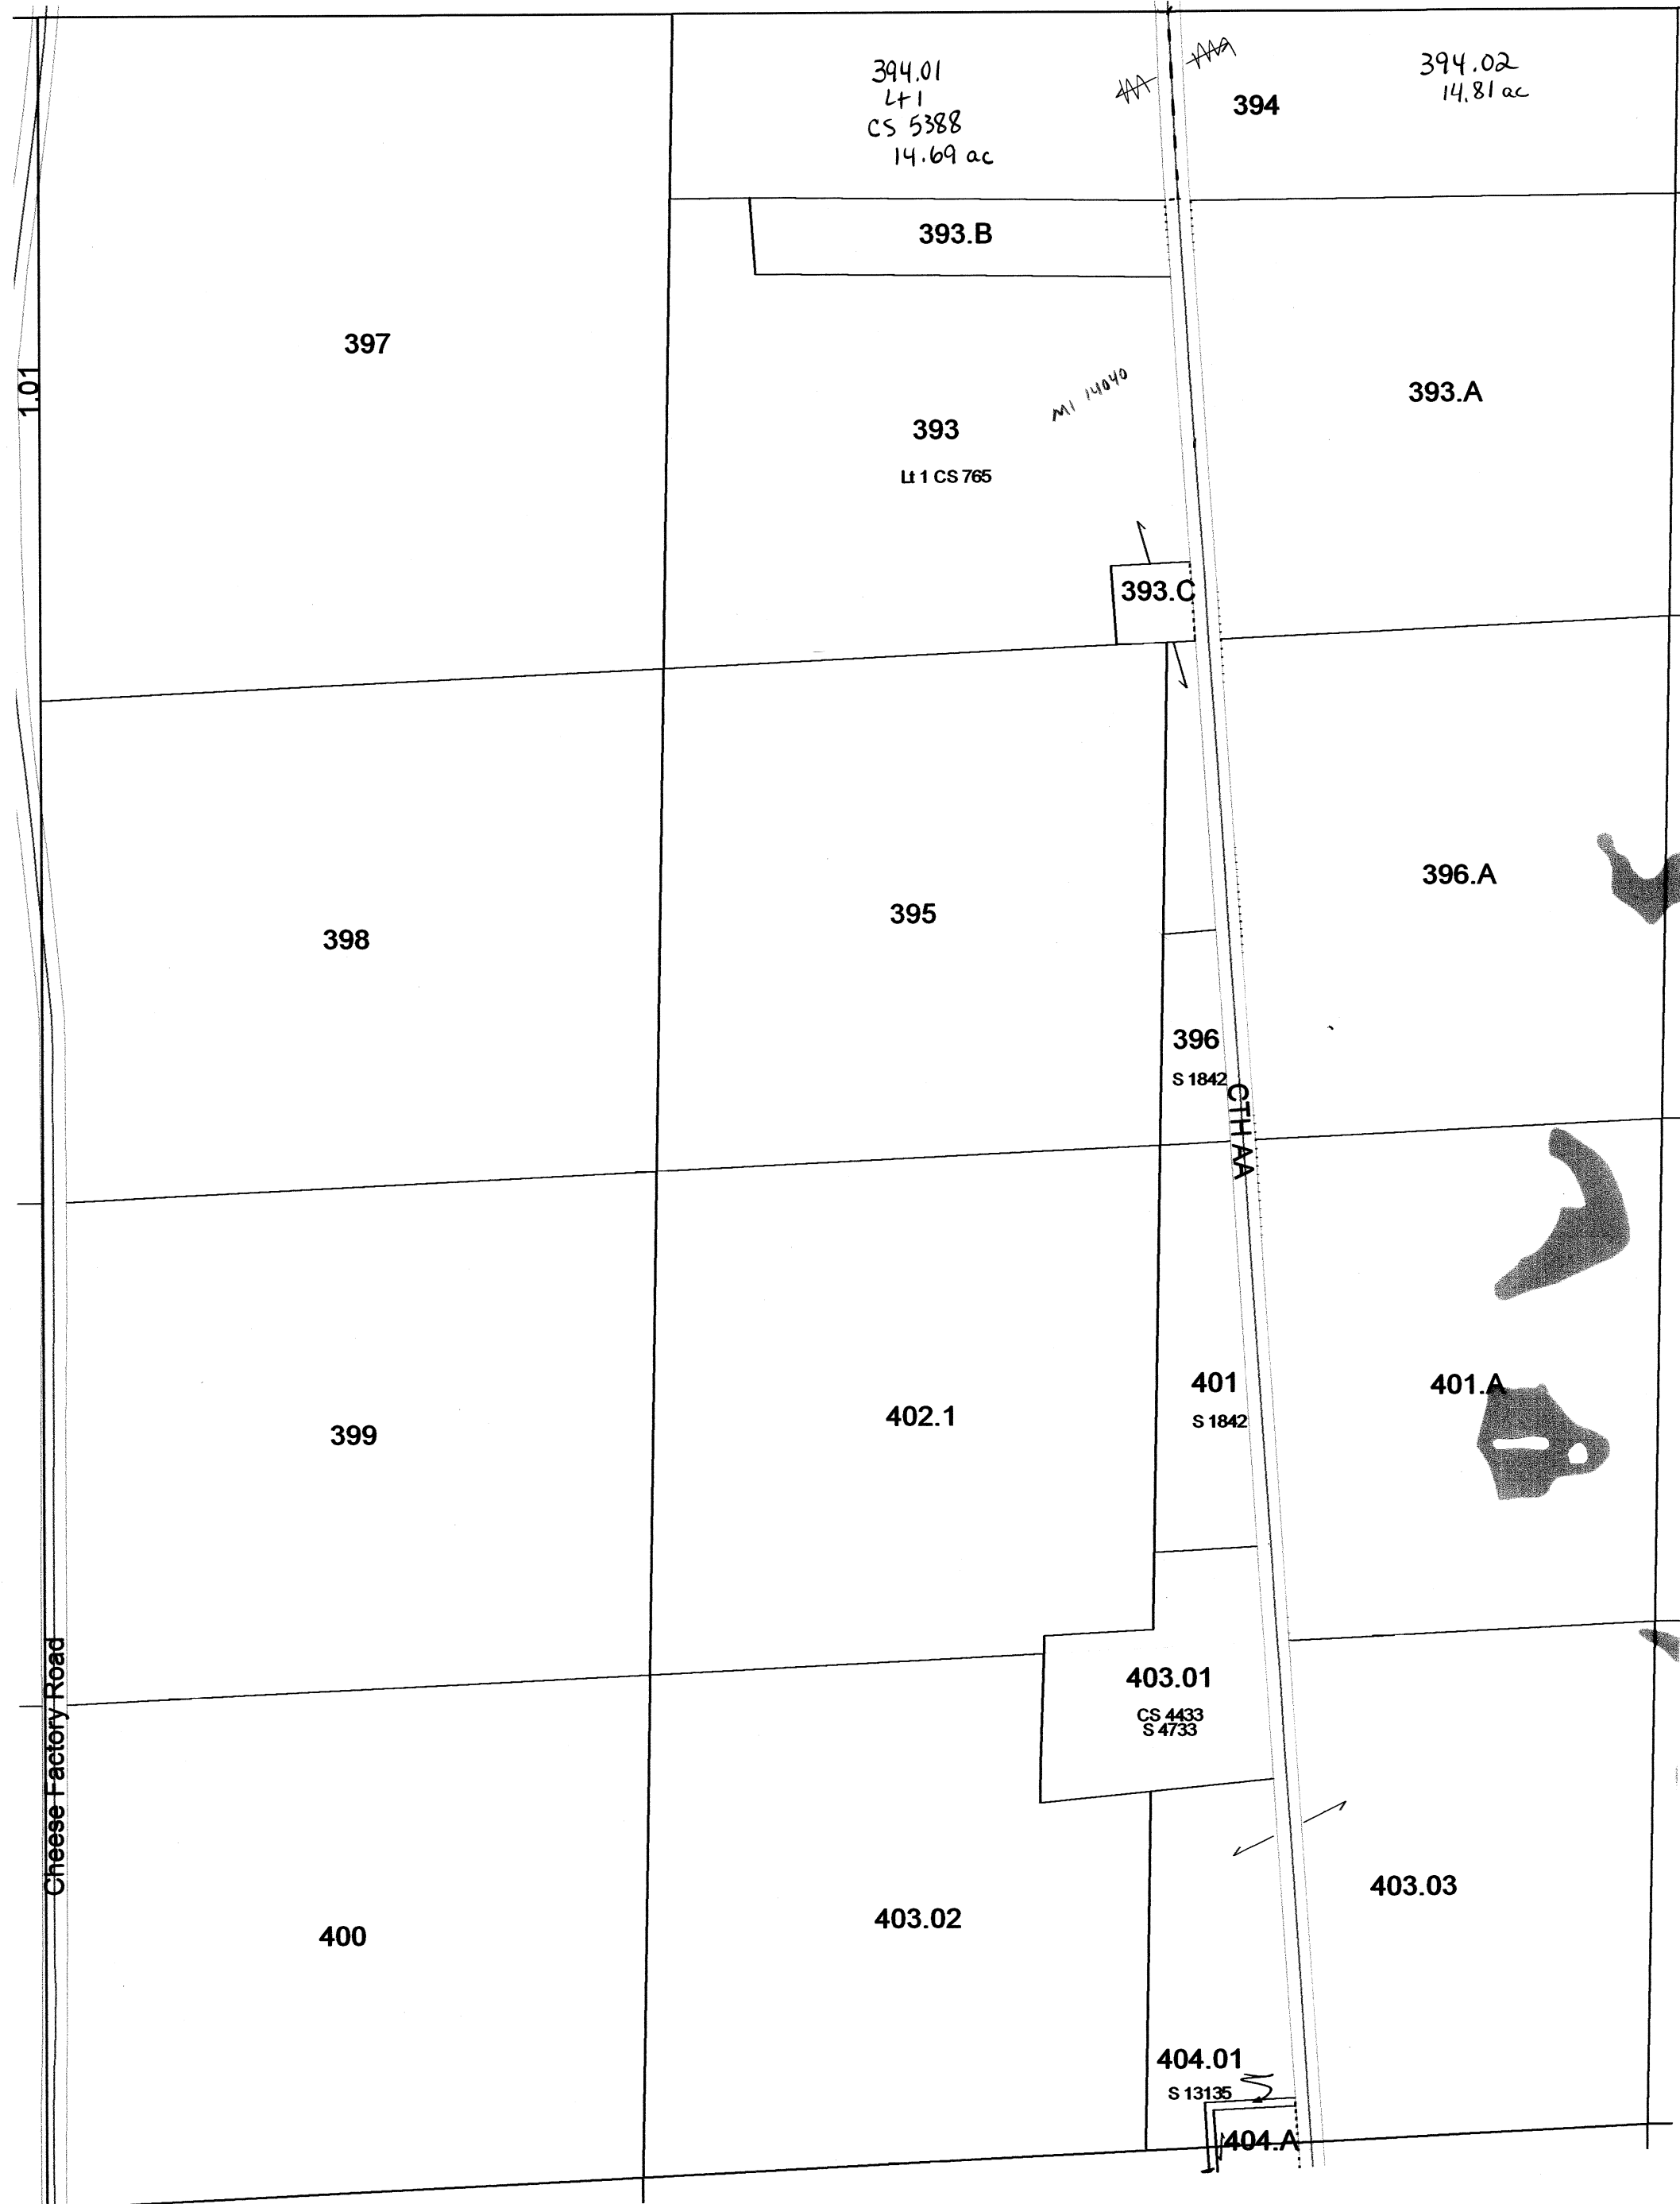

SEE SECTION 01 TOWN OF LEWISTON


SEE SECTION 05 TOWN OF LEWISTON

SEE SECTION 07 TOWN OF LEWISTON

TOWN OF LEWISTON

SECTION 13 T13N R8E

1 inch = 400 feet 1:4,800

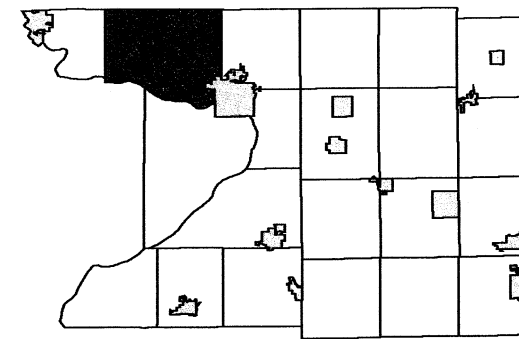

R7E				R8E			
3	2	1	6	5	4	3	2
10	11	12	7	8	9	10	11
15	14	13	18	17	16	15	14
22	23	24	19	20	21	22	23
27	28	25	30	29	28	27	26
34	35	36	31	32	33	34	35
				5	4	3	2
				10	11	12	

SEE SECTION 12 TOWN OF LEWISTON

SEE SECTION 14 TOWN OF LEWISTON

SEE SECTION 18 TOWN OF FORT WINNEBAGO




SEE SECTION 24 TOWN OF LEWISTON

TOWN OF LEWISTON

SECTION 15 T13N R8E

1 inch = 400 feet 1:4,800

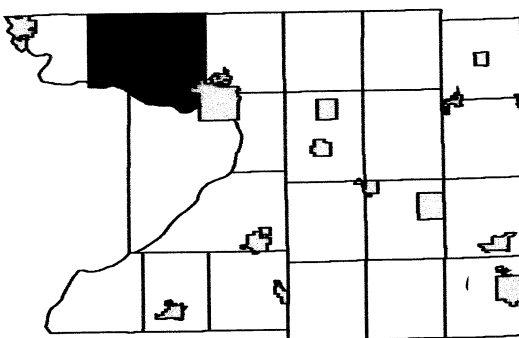


R7E						R8E					
3	2	1	6	5	4	3	2	1			
10	11	12	7	8	9	10	11	12			
15	14	13	18	17	16	15	14	13			
22	23	24	19	20	21	22	23	24			
27	26	25	30	29	28	27	26	25			
34	33	32	31	30	29	28	27	26			

SEE SECTION 10 TOWN OF LEWISTON

SEE SECTION 16 TOWN OF LEWISTON

SEE SECTION 14 TOWN OF LEWISTON

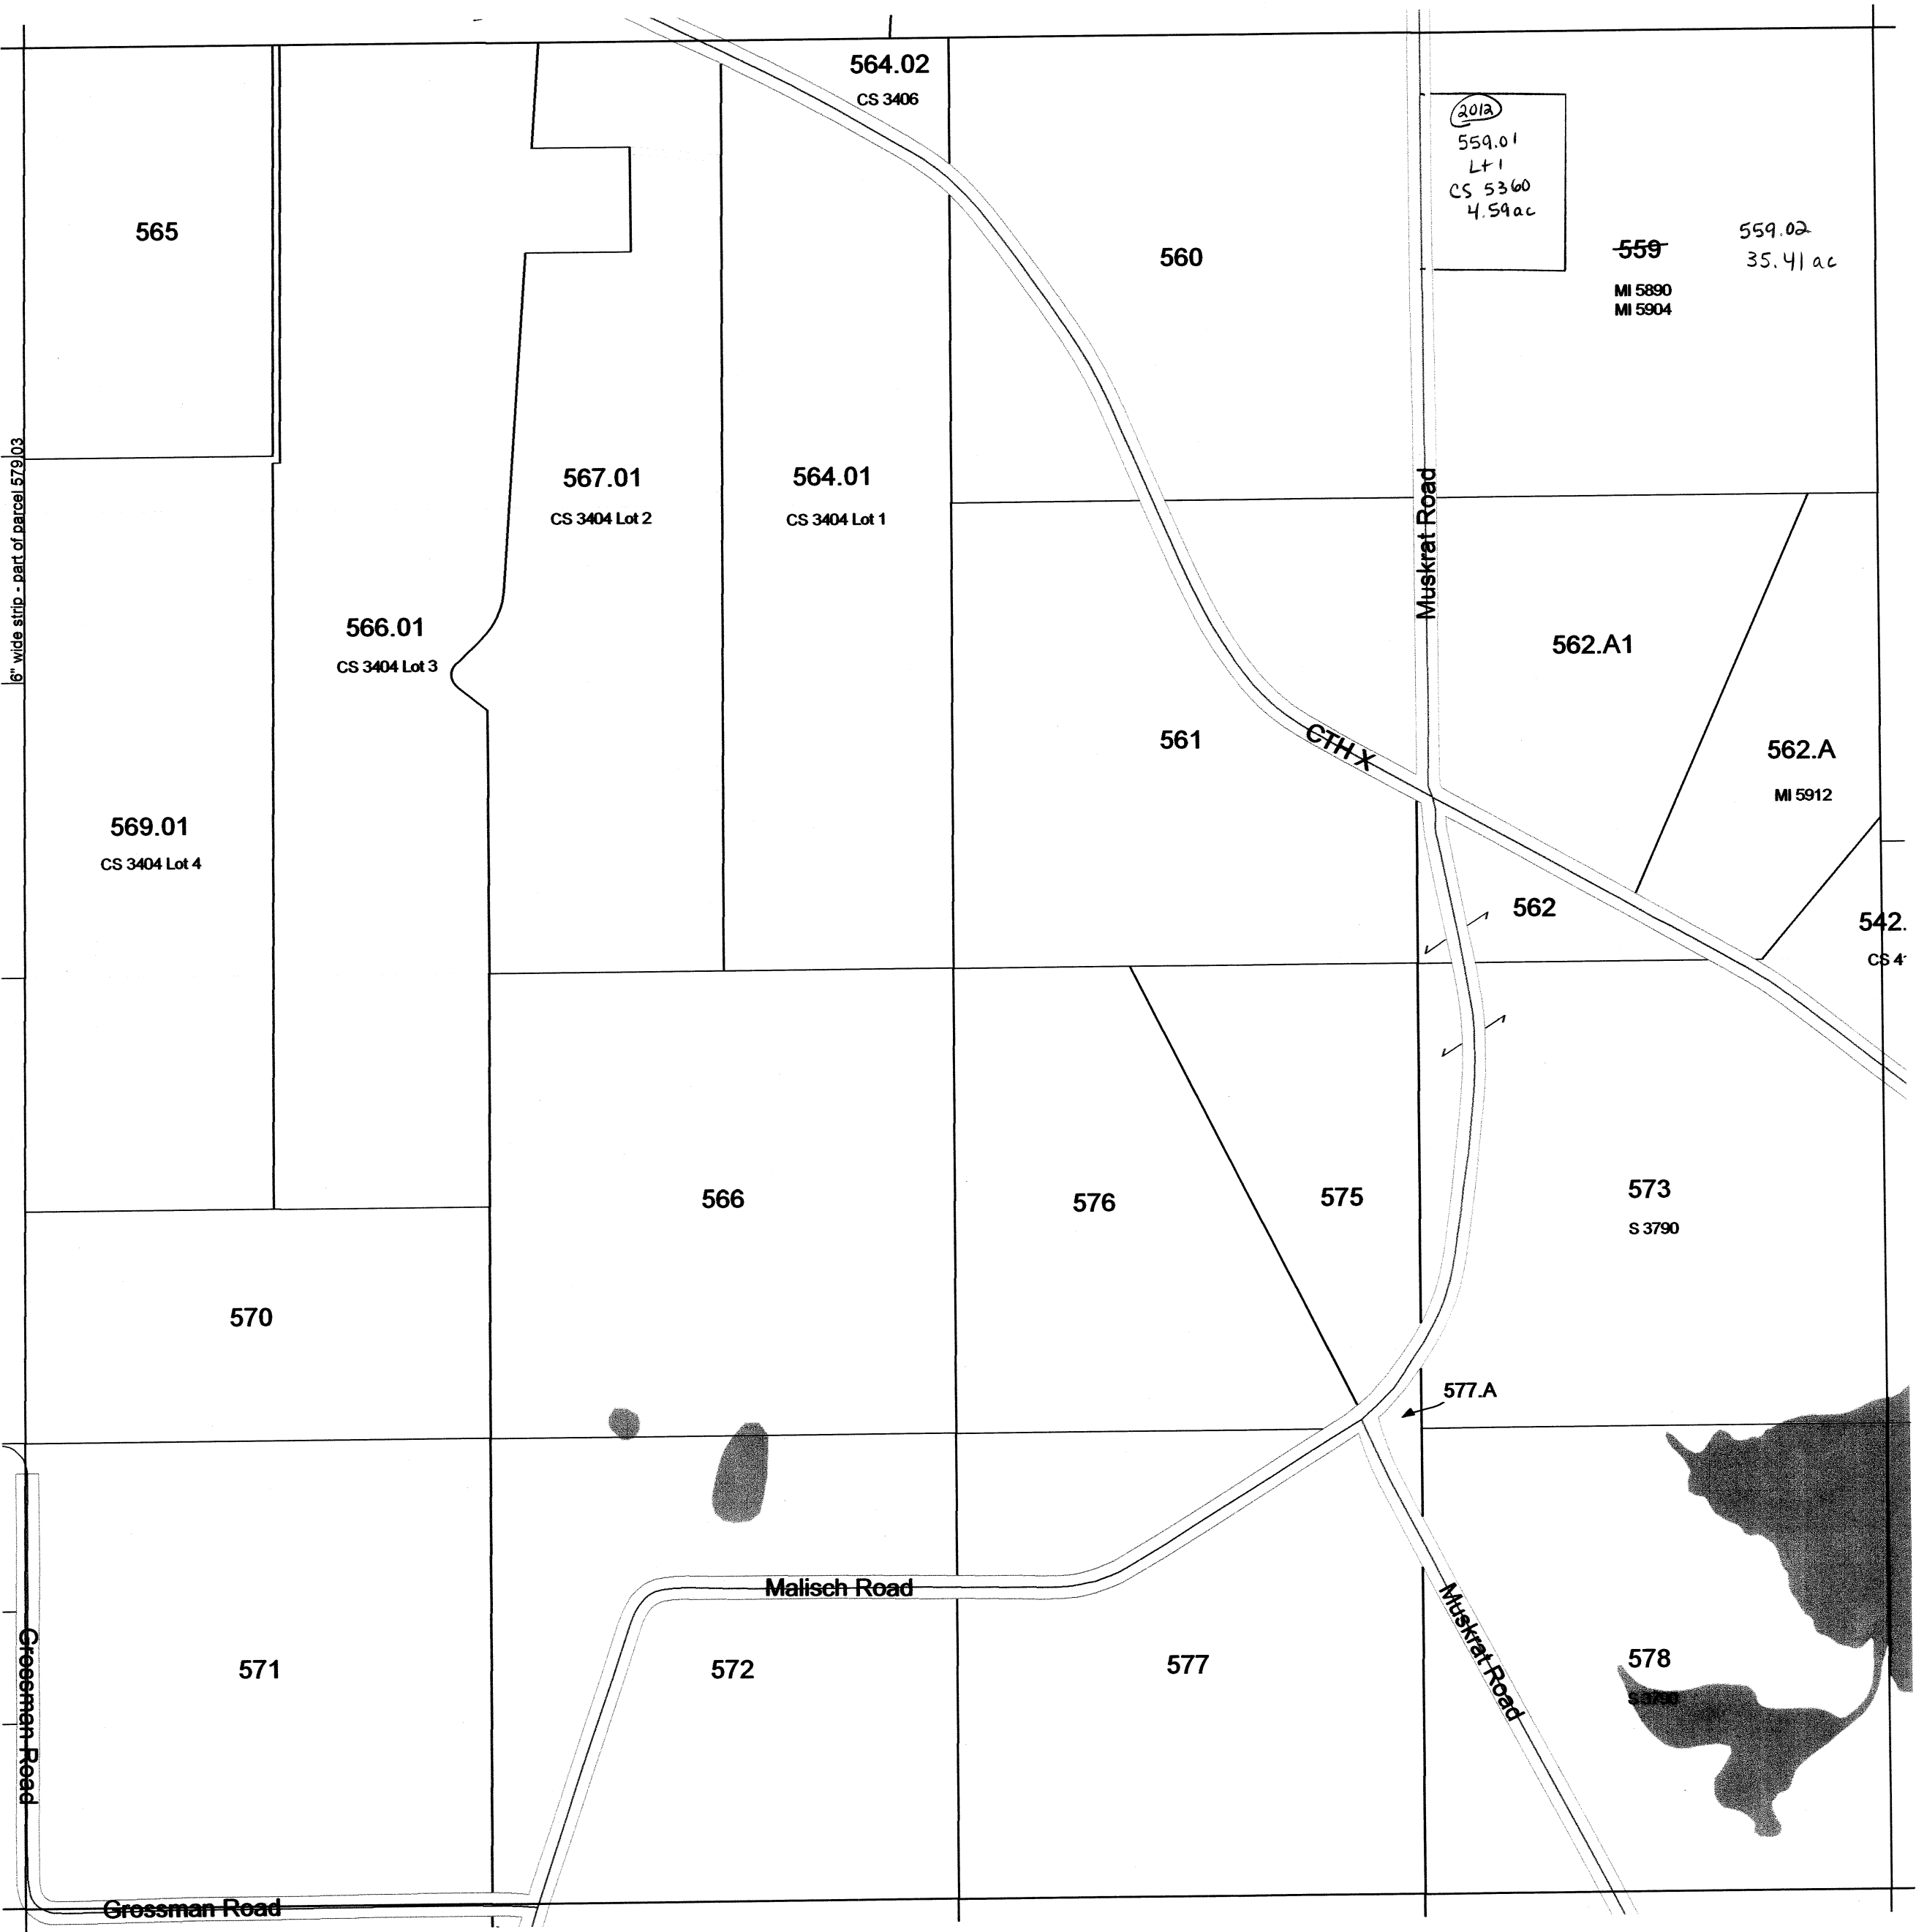

SEE SECTION 22 TOWN OF LEWISTON


Scanned
2013

Section 15
T13N R8E

TOWN OF LEWISTON

SECTION 16 T13N R8E

1 inch = 400 feet 1:4,800

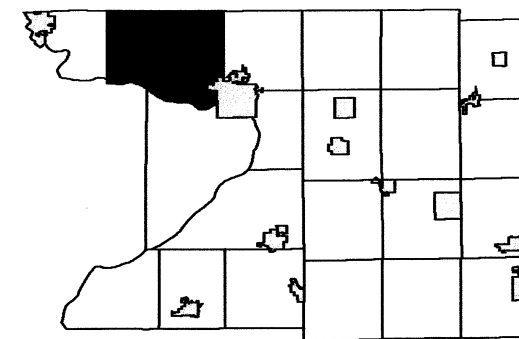


R7E					R8E									
3	2	1	6	5	4	3	2	1						
10	11	12	7	8	9	10	11	12						
15	14	13	18	17	16	15	14	13						
22	23	24	19	20	21	22	23	24						
27	26	25	30	29	28	27	26	25						
34	33	32	31	32	33	34	35	36						

TOWN OF LEWISTON


SECTION 18 T13N R8E

1 inch = 400 feet 1:4,800

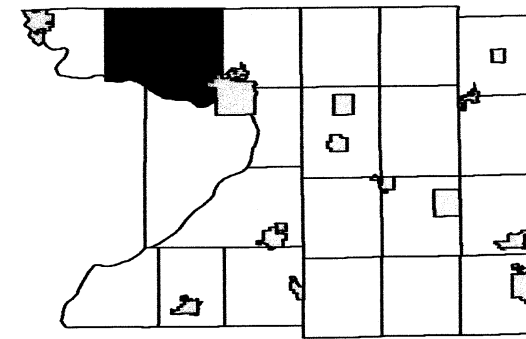

R7E			R8E		
3	2	1	6	5	4
10	11	12	7	8	9
15	14	13	17	16	15
22	23	24	19	20	21
27	26	25	30	29	28
34	33	32	31	32	33
				5	4
				3	2
				10	11
				12	

SEE SECTION 07 TOWN OF LEWISTON

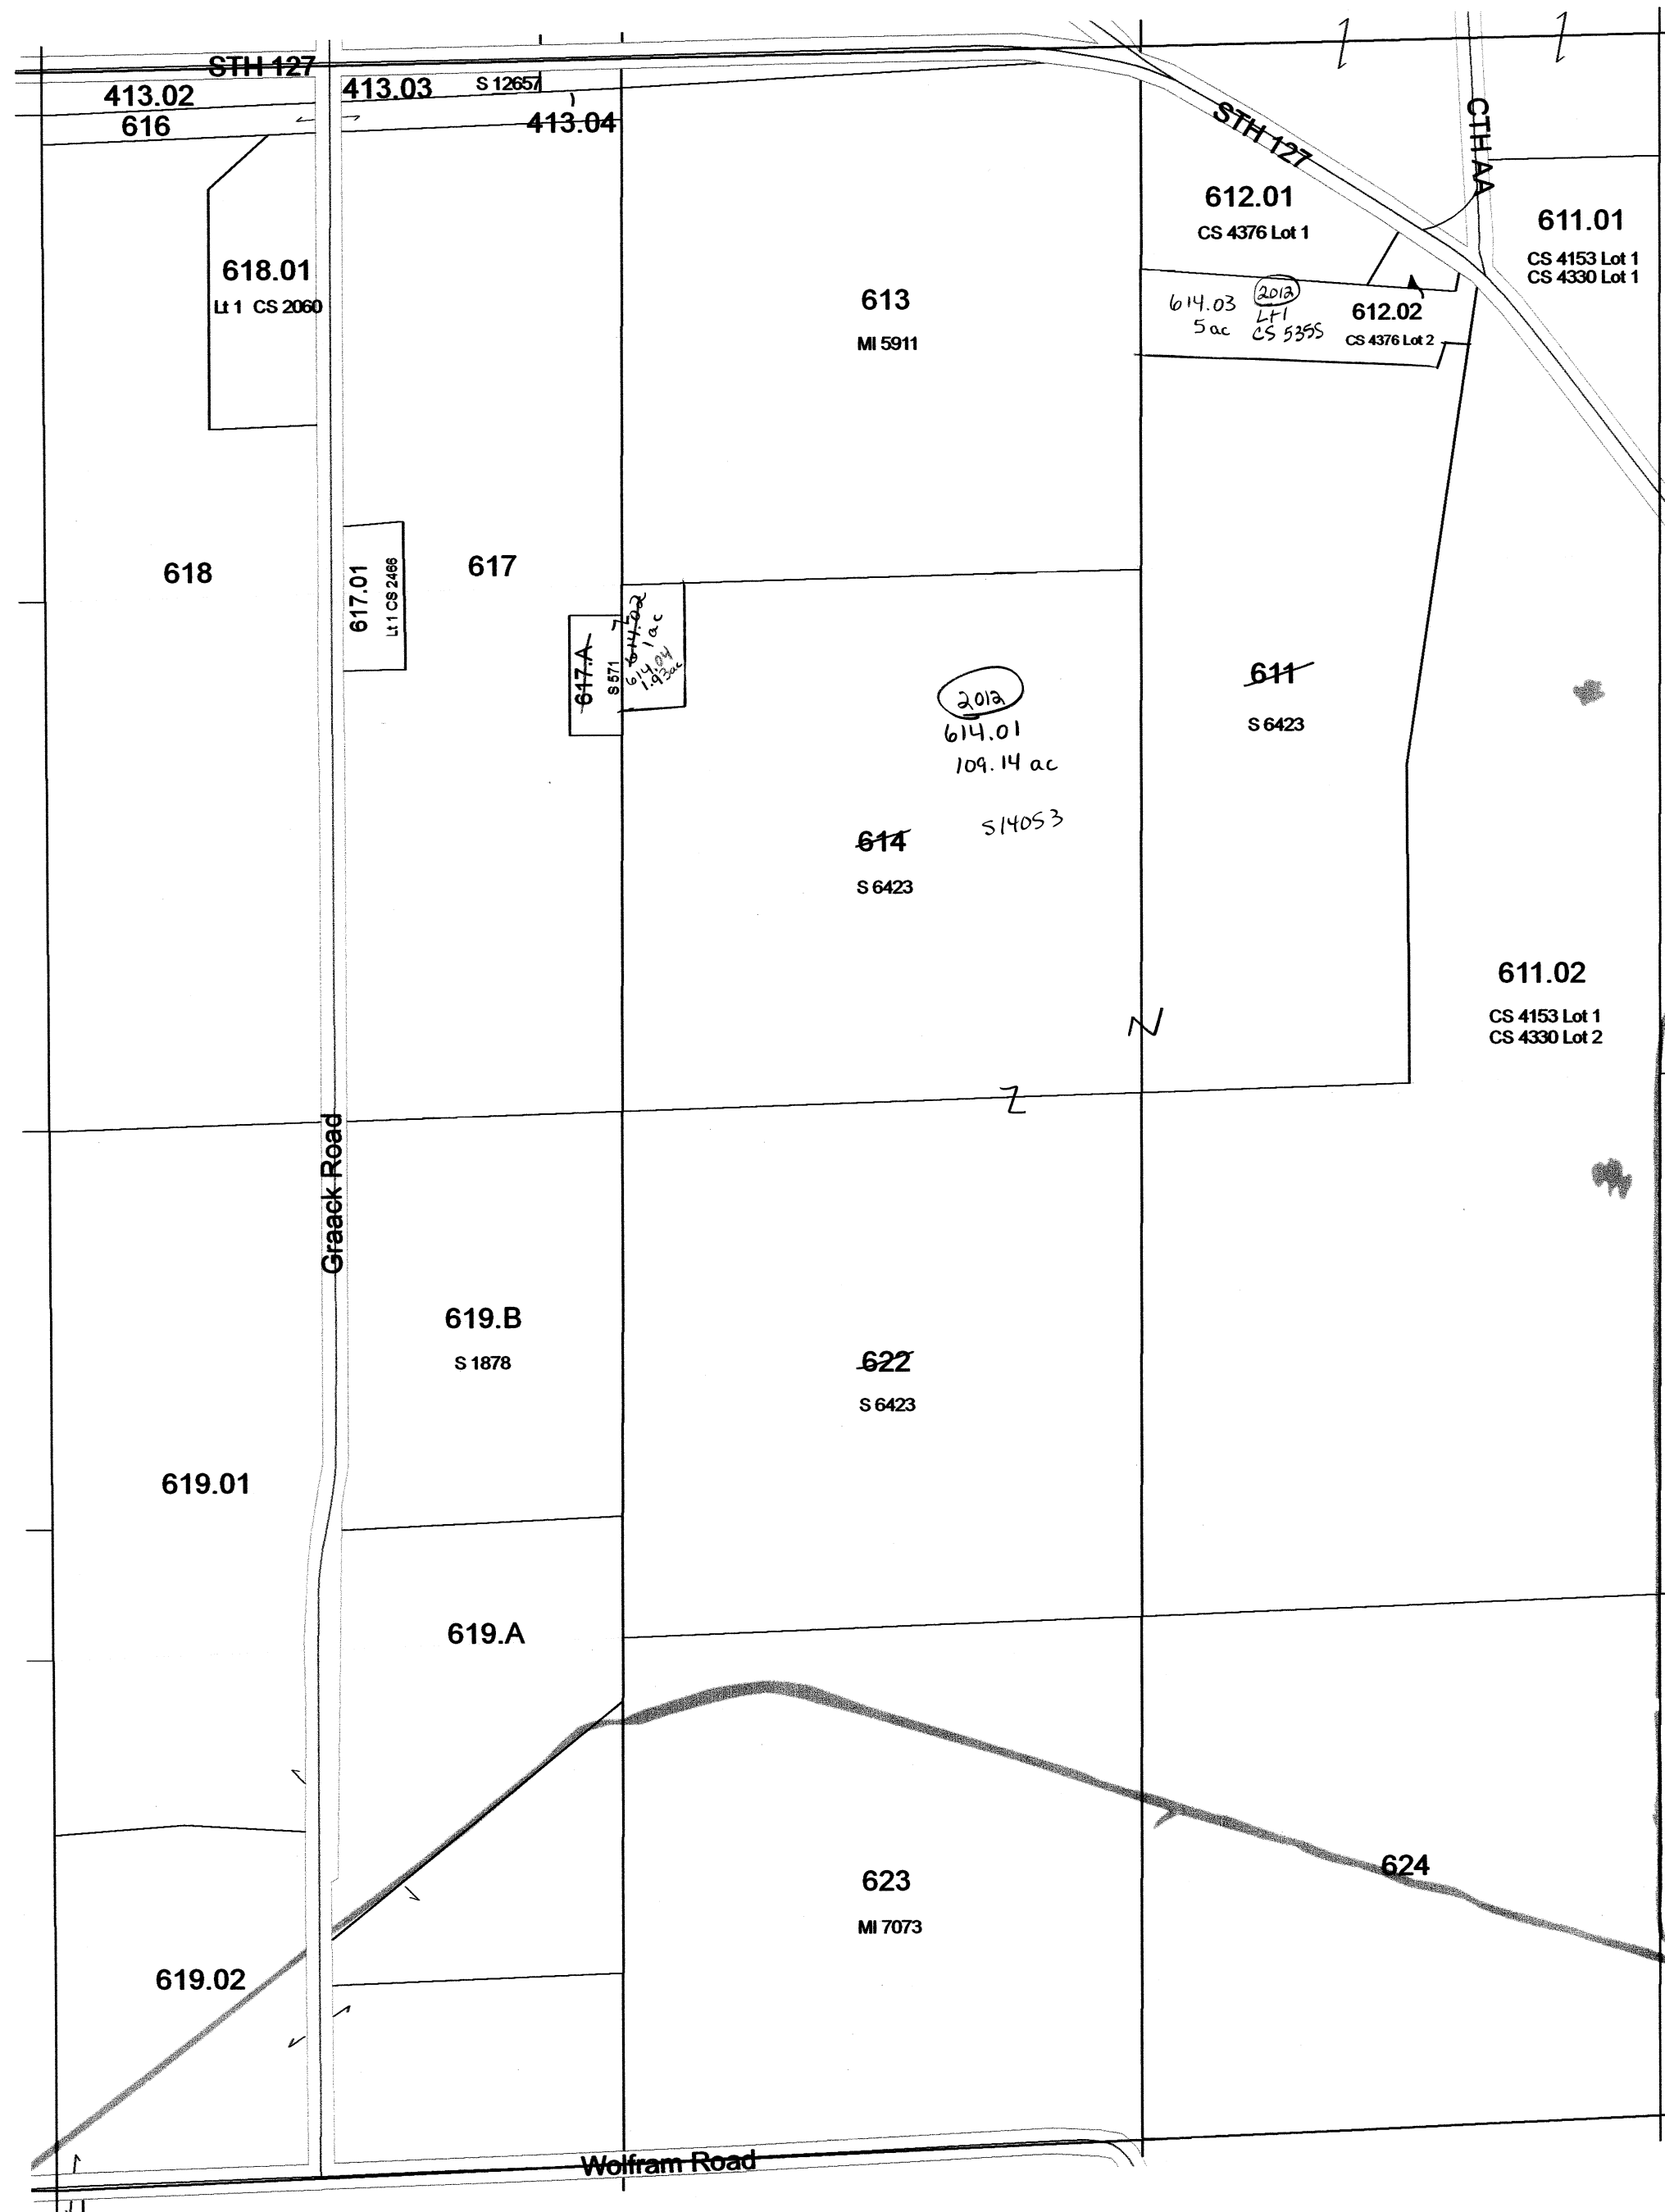

SEE SECTION 13 TOWN OF LEWISTON


SEE SECTION 17 TOWN OF LEWISTON

SEE SECTION 19 TOWN OF LEWISTON

TOWN OF LEWISTON


SECTION 19 T13N R8E

1 inch = 400 feet 1:4,800

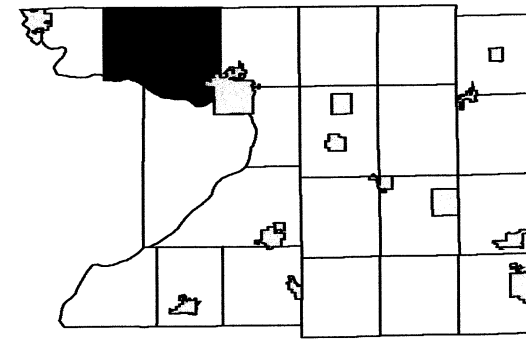

R7E						R8E					
3	2	1	6	5	4	3	2	1			
10	11	12	7	8	9	10	11	12			
15	14	13	18	17	16	15	14	13			
22	23	24	19	20	21	22	23	24	T13N		
27	28	25	30	29	28	27	26	25			
34	35	36	31	32	33	34	35	36			
									T12N		
									10	11	12

SEE SECTION 18 TOWN OF LEWISTON

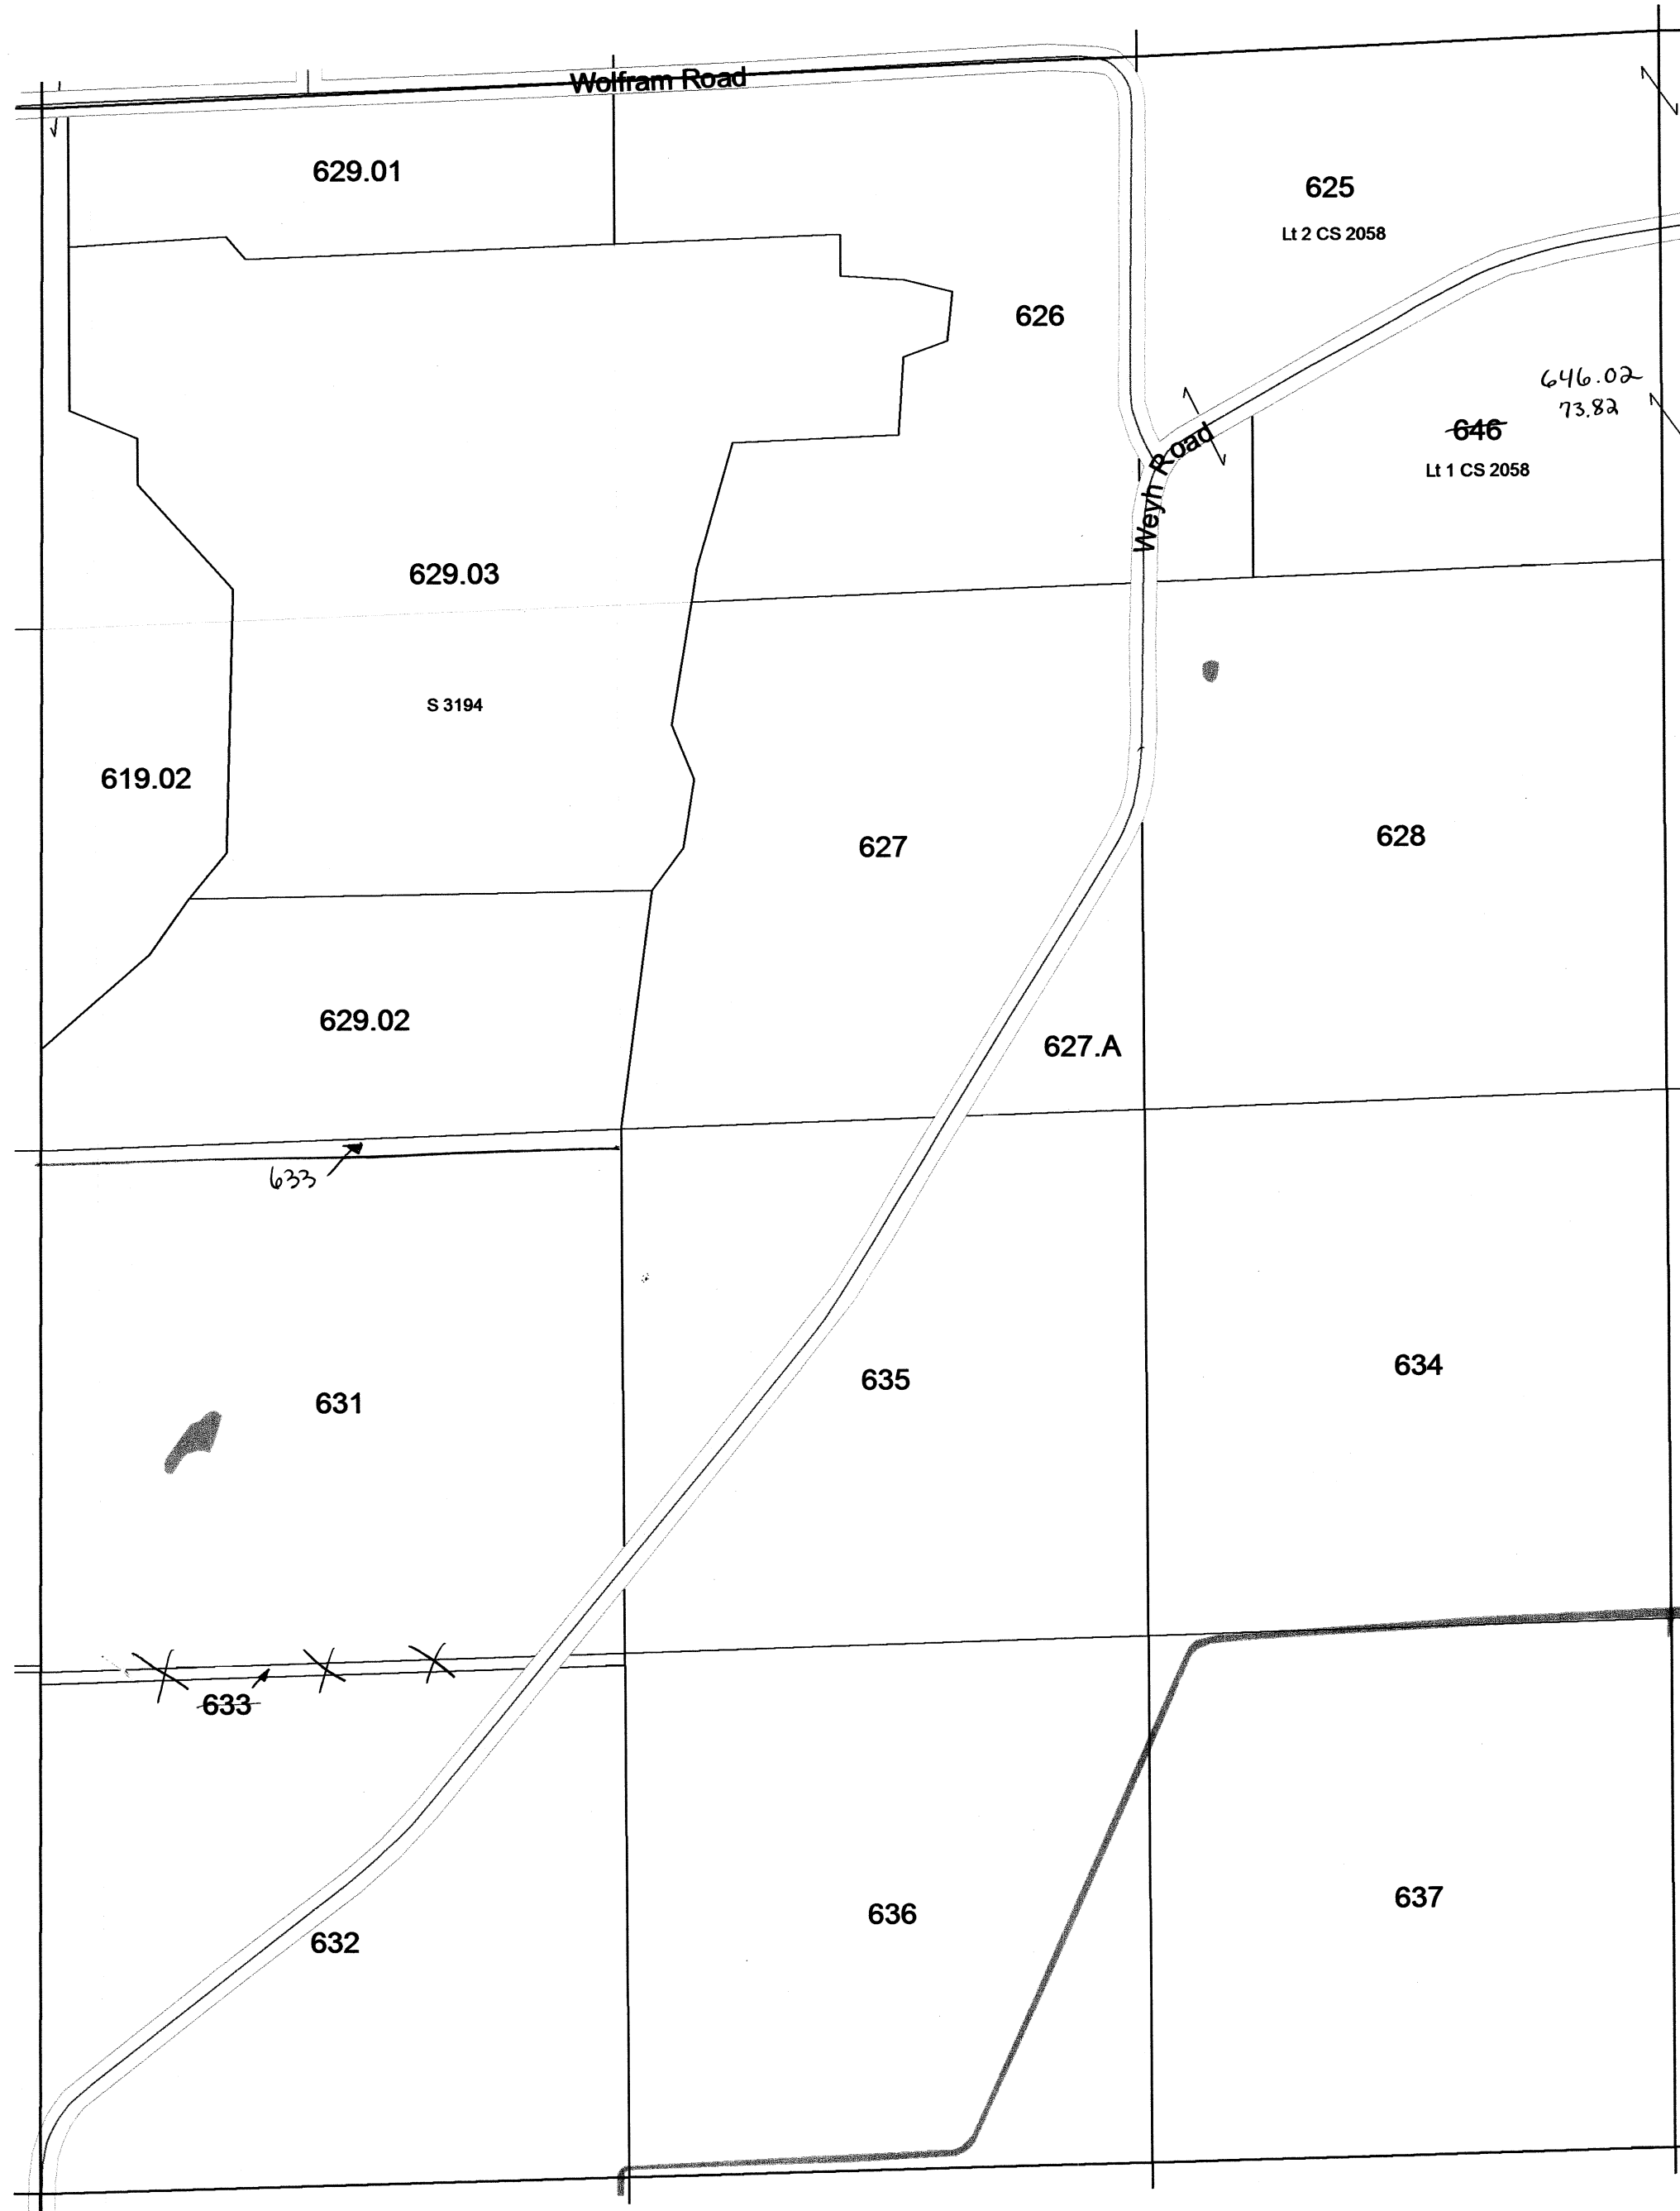

SEE SECTION 24 TOWN OF LEWISTON


SEE SECTION 20 TOWN OF LEWISTON

SEE SECTION 30 TOWN OF LEWISTON

TOWN OF LEWISTON

SECTION 20 T13N R8E

1 inch = 400 feet 1:4,800

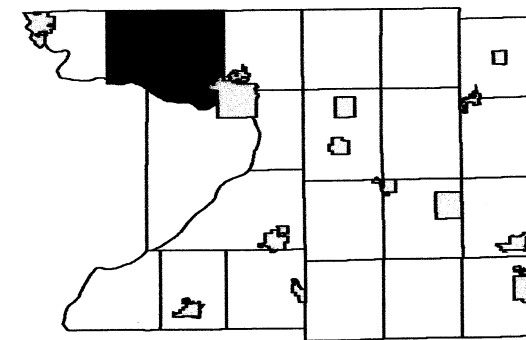


R7E			R8E		
3	2	1	6	5	4
10	11	12	7	8	9
15	14	13	18	17	16
22	23	24	19	21	22
27	26	25	30	29	28
34	33	32	31	32	33
41	40	39	38	37	36
48	47	46	45	44	43
55	54	53	52	51	50
1567	1566	1565	1564	1563	1562
1574	15				

TOWN OF LEWISTON

SECTION 21 T13N R8E

1 inch = 400 feet 1:4,800

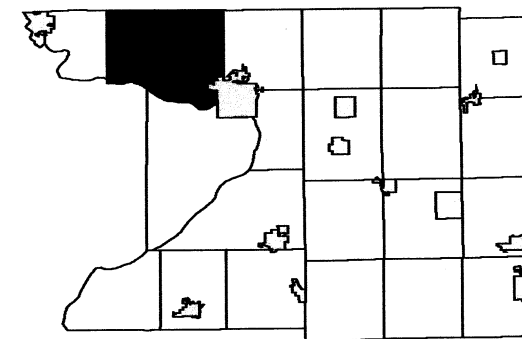


R7E			R8E			R9E		
3	2	1	6	5	4	3	2	1
10	11	12	7	8	9	10	11	12
15	14	13	18	17	16	15	14	13
22	23	24	19	20	21	22	23	24
27	26	25	30	29	28	27	26	25
34	33	32	31	32	33	34	35	36

TOWN OF LEWISTON

SECTION 32 T13N R8E

1 inch = 400 feet 1:4,800

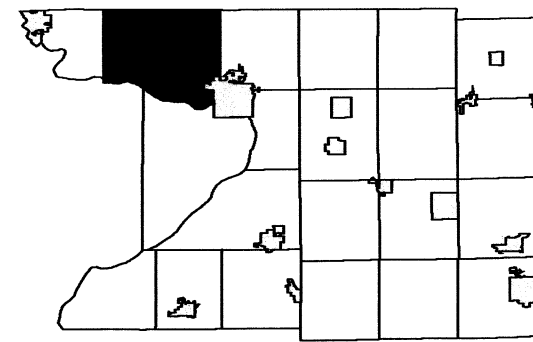


R7E			R8E			R9E		
3	2	1	6	5	4	3	2	1
10	11	12	7	8	9	10	11	12
15	14	13	18	17	16	15	14	13
22	23	24	19	20	21	22	23	24
27	26	25	30	29	28	27	26	25
34	35	36	31	32	33	34	35	36

TOWN OF LEWISTON

SECTION 34 T13N R8E


1 inch = 400 feet 1:4,800

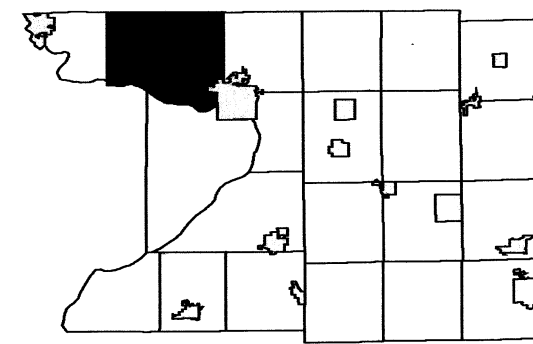

R7E			R8E			R9E		
3	2	1	6	5	4	3	2	1
10	11	12	7	8	9	10	11	12
15	14	13	18	17	16	15	14	13
22	23	24	19	20	21	22	23	24
27	26	25	30	29	28	27	26	25
34	35	36	31	32	33	34	35	36

TOWN OF LEWISTON

T12N R8E T13N R7E T13N R8E

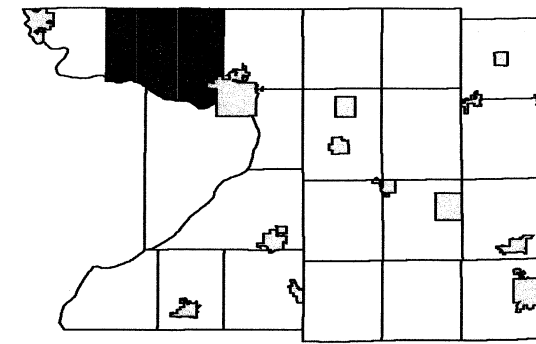


3	2	1	6	5	4	3	2	1
10	11	12	7	8	9	10	11	12
15	14	13	18	17	16	15	14	13
22	23	24	19	20	21	22	23	24
27	26	25	30	29	28	27	26	25
34	35	36	31	32	33	34	35	36
			5	4	3	2		

TOWN OF LEWISTON

SECTION 23 T13N R7E

1 inch = 400 feet 1:4,800

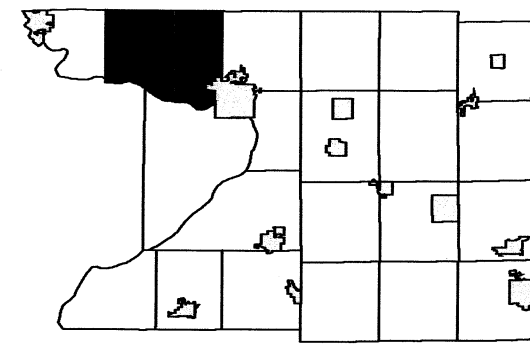

R7E						R8E					
3	2	1	6	5	4	3	2	1			
10	11	12	7	8	9	10	11	12			
15	14	13	18	17	16	15	14	13			
22	24	19	20	21	22	23	24	25			
27	26	25	30	29	28	27	26	25			
34	35	36	31	32	33	34	35	36			

T13N

T12N

SEE SECTION 14 TOWN OF LEWISTON

SEE SECTION 22 TOWN OF LEWISTON

SEE SECTION 24 TOWN OF LEWISTON




SEE SECTION 26 TOWN OF LEWISTON

REPLACED
2014

SECTION 24 T13N R7E
1 inch = 400 feet 1:4,800

SEE SECTION 13 TOWN OF LEWISTON

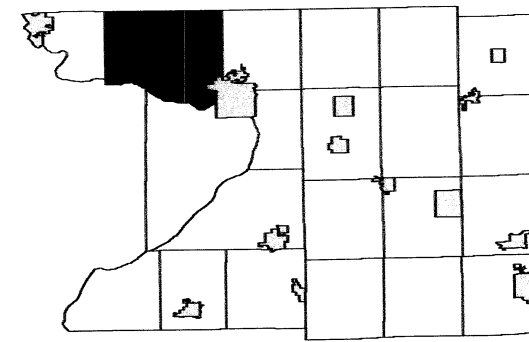


R7E

3	2	1	6	5	4	3	2	1
10	11	12	7	8	9	10	11	12
15	14	13	18	17	16	15	14	13
22	23		19	20	21	22	23	24
27	26	25	30	29	28	27	26	25
34	35	36	31	32	33	34	35	36
				5	4	3	2	1
						10	11	12

R8F

T13N

T12N

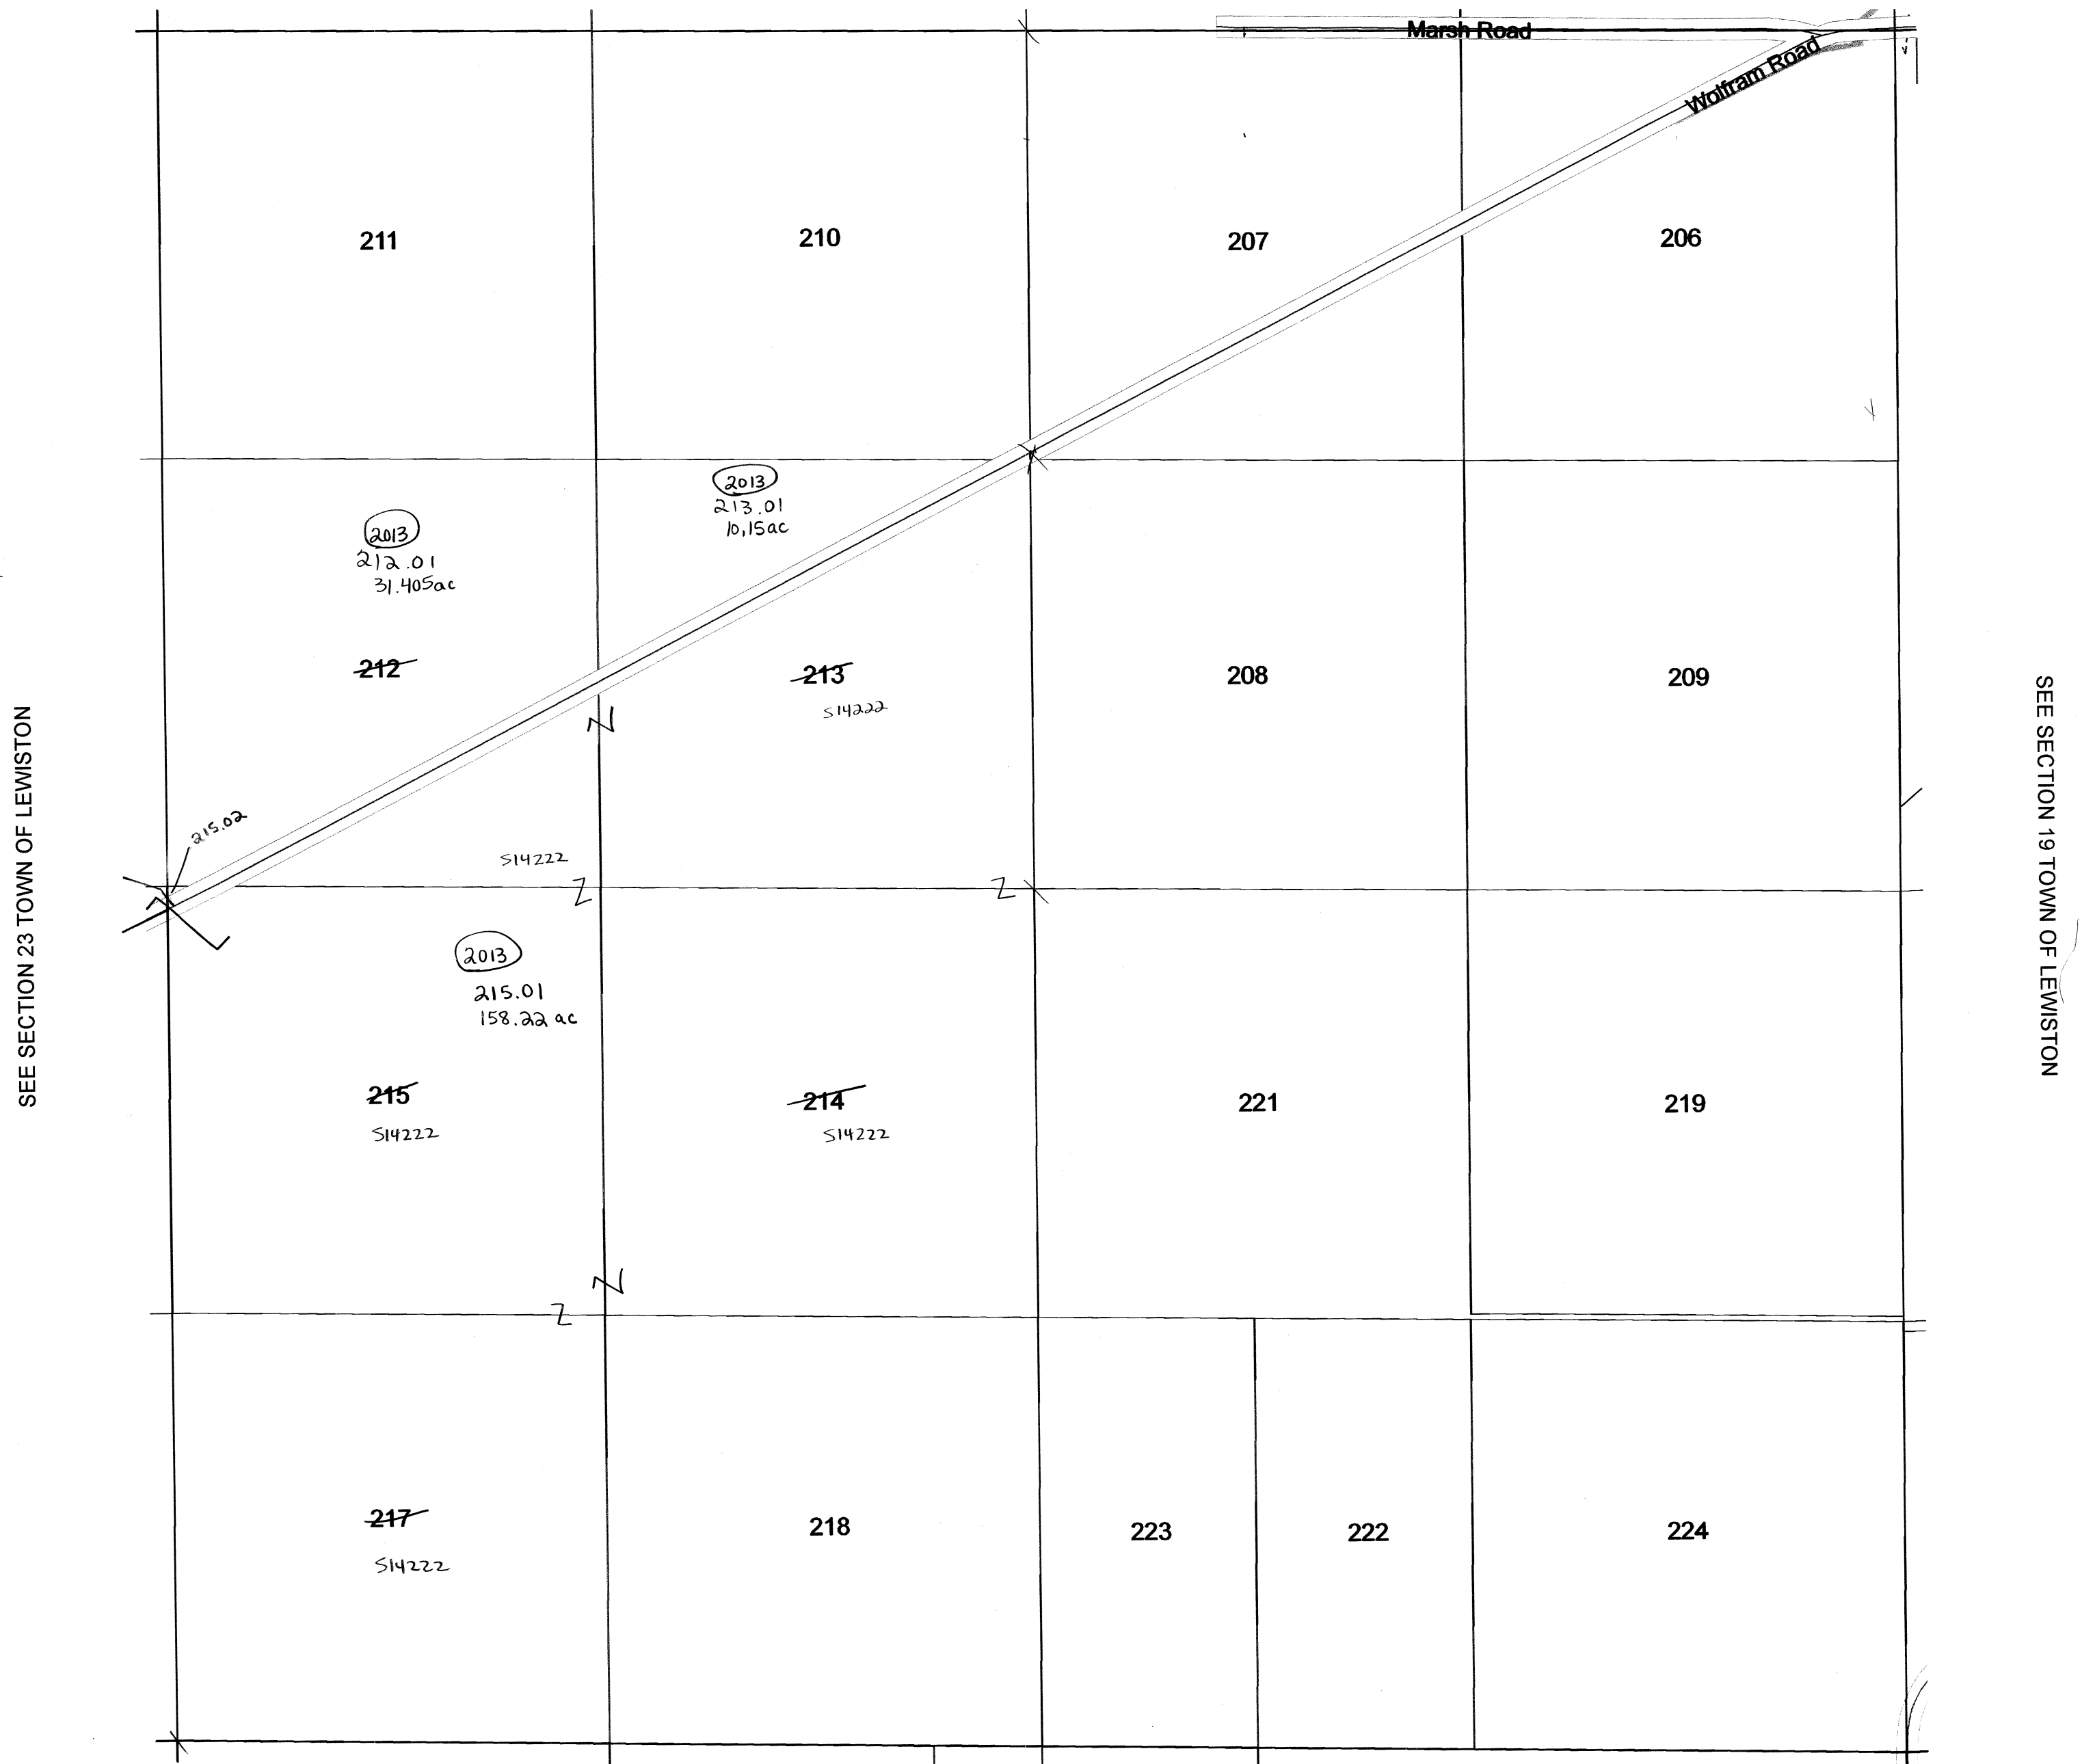REPLACED
2014

SEE SECTION 25 TOWN OF LEWISTON

February 06, 2009
Columbia County Land Information


Section 24
T13N R7E

1 inch = 400 feet 1:4,800

The diagram shows a 6x6 grid of cells. The top row is labeled 'R7E' and 'R8E'. The cells contain the following values:


3	2	1	6	5	3	2	1	
10	11	12	7	8	9	10	11	12
15	14	13	18	17	16	15	14	13
22	23	24	19	20	21	22	23	24
27	26	25	30	29	28	27	26	25
34	35	36	31	32	33	34	35	36

The grid is labeled with 'T13N' and 'T12N' on the right side. A coastline is indicated by a line separating the grid from the ocean. The grid is labeled with 'R7E' and 'R8E' at the top.

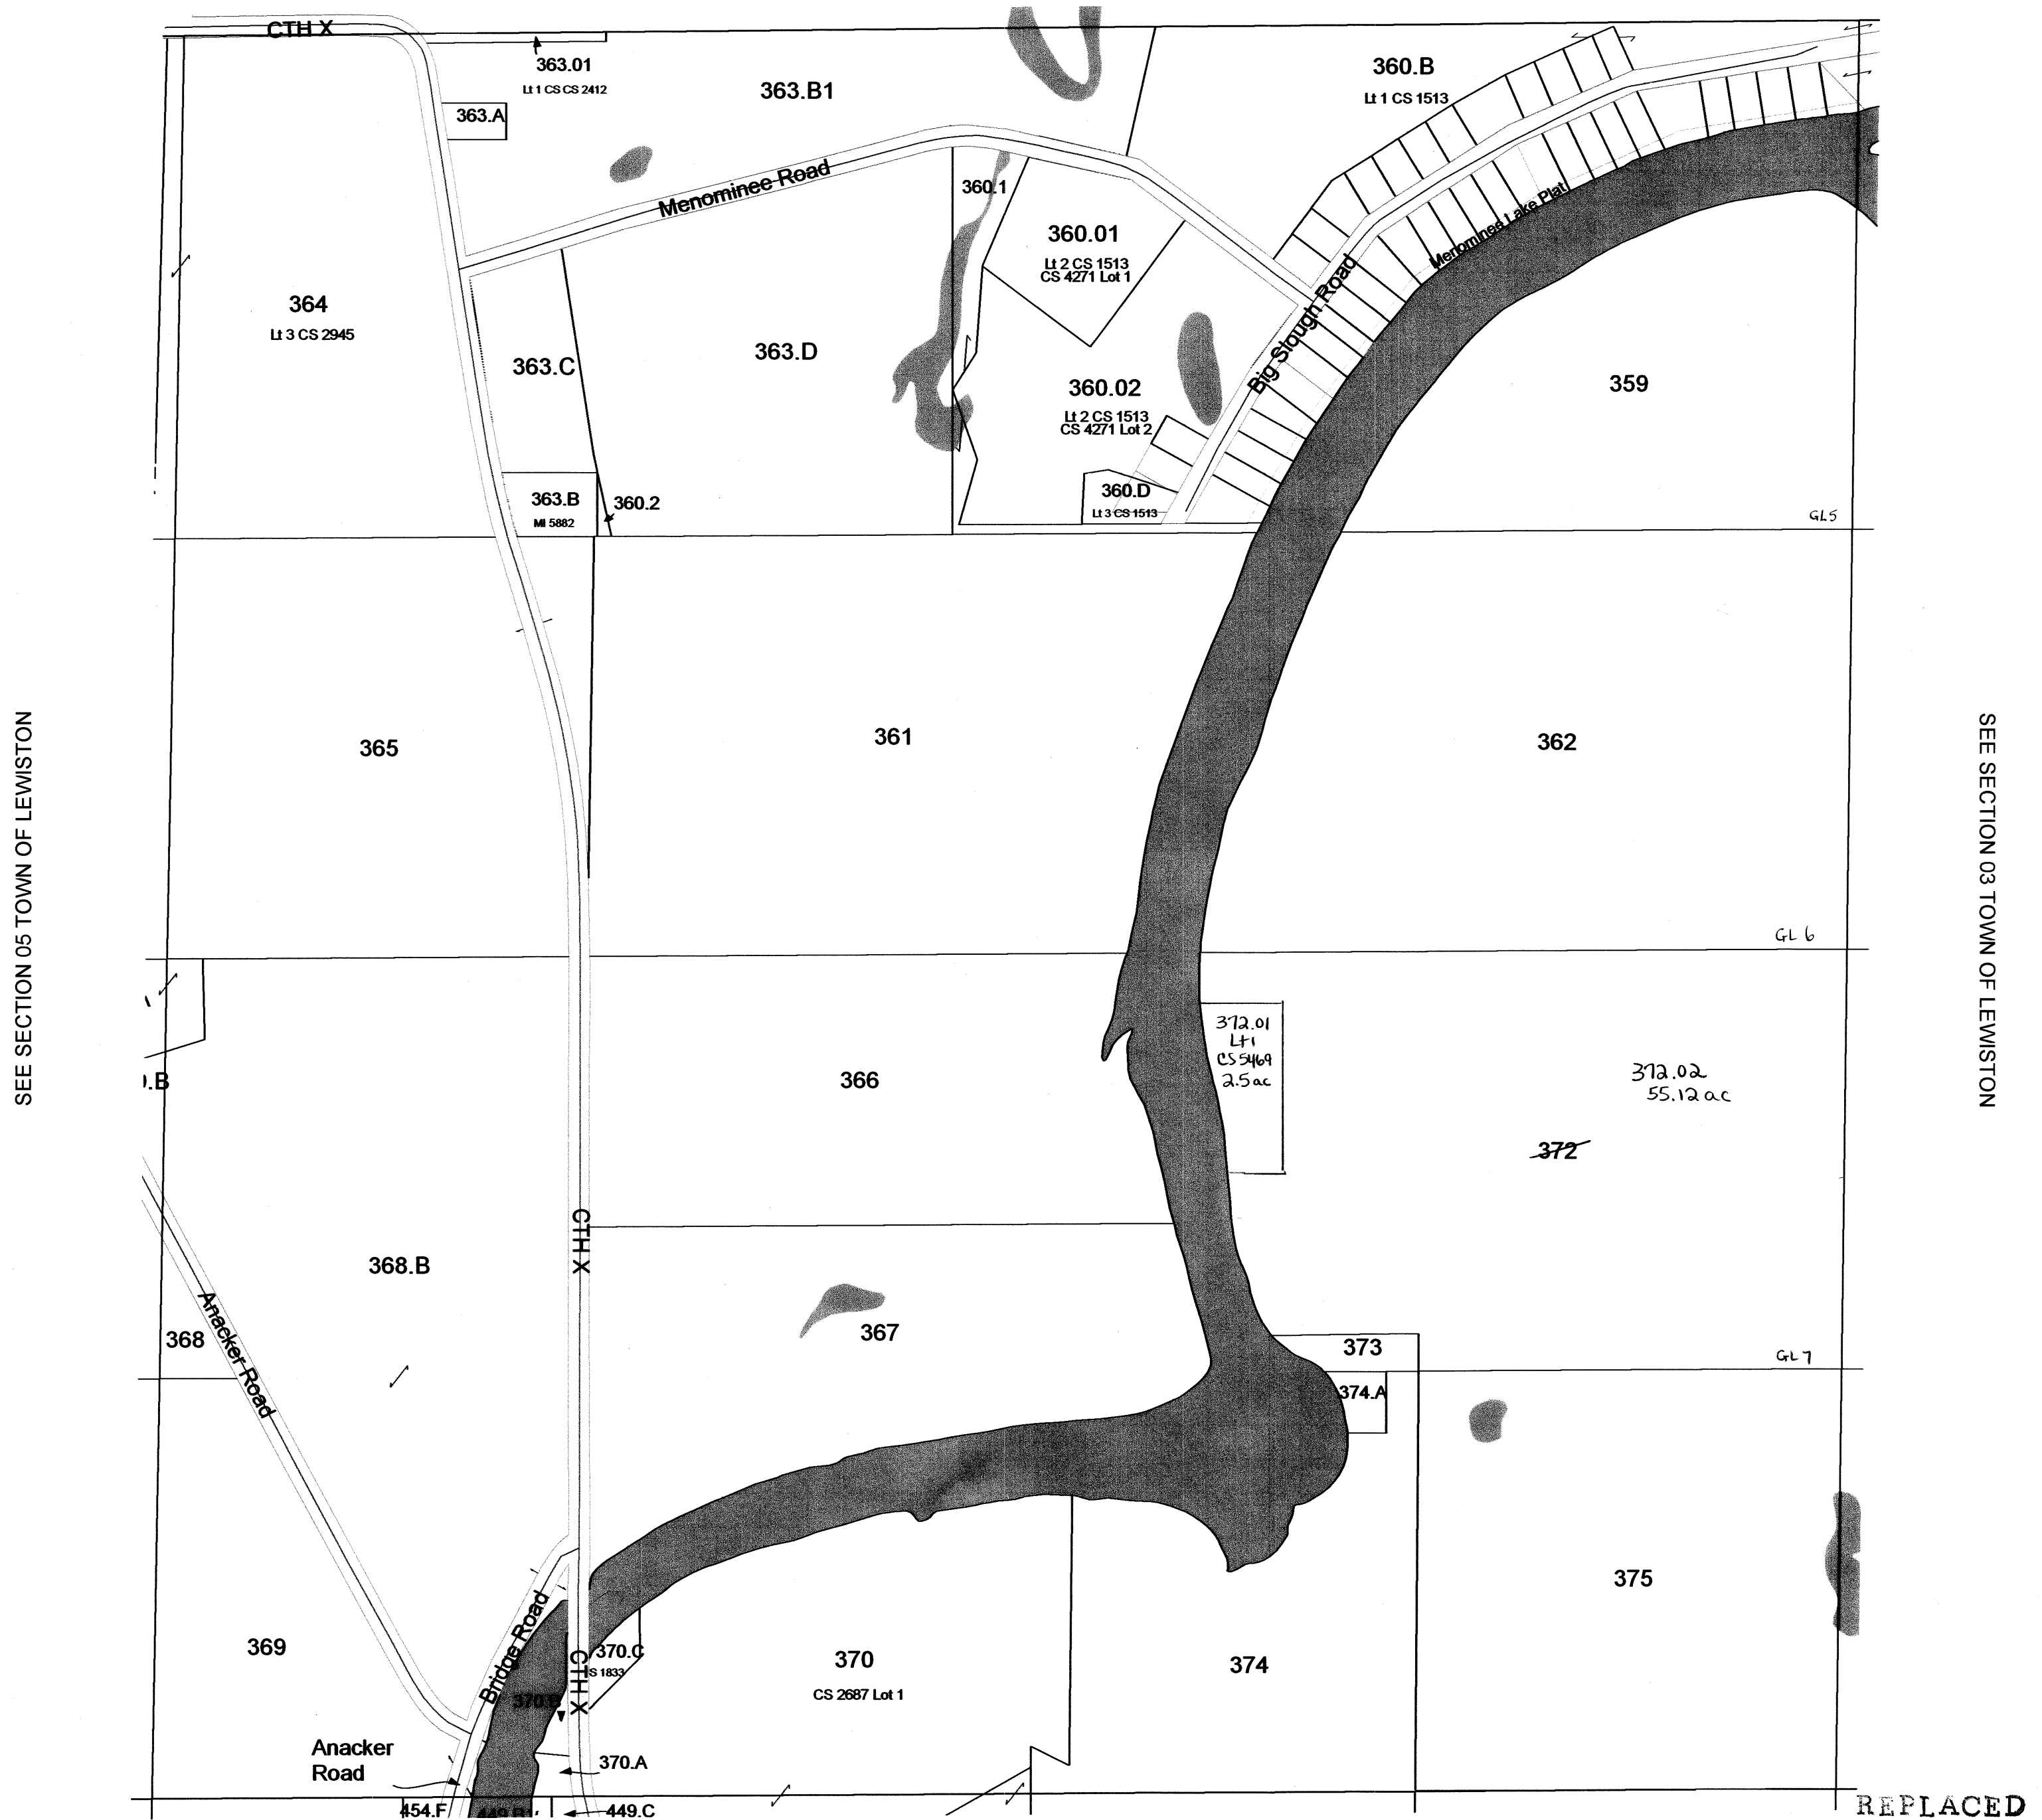

REPLACED
2014

1 inch = 400 feet 1:4,800

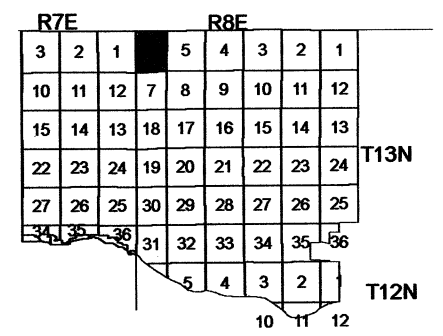

SEE SECTION 05 TOWN OF LEWISTON




REPLACED
2014

TOWN OF LEWISTON

SECTION 9 T13N R8E

1 inch = 400 feet 1:4,800

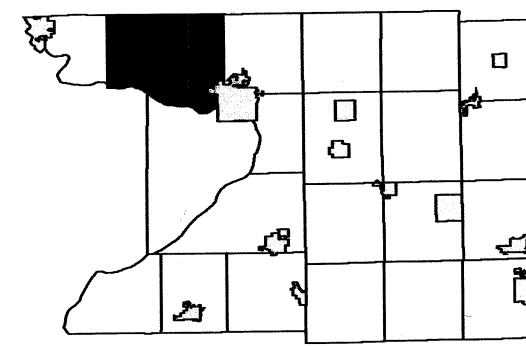


R7E						R8E					
3	2	1	6	5	4	3	2	1			
10	11	12	7	8	9	10	11	12			
15	14	13	18	17	16	15	14	13			
22	23	24	19	20	21	22	23	24			
27	26	25	30	29	28	27	26	25			
34	35	36	31	32	33	34	35	36			
						5	4	3	2	1	
						10	11	12			

SEE SECTION 04 TOWN OF LEWISTON

SEE SECTION 08 TOWN OF LEWISTON

SEE SECTION 10 TOWN OF LEWISTON

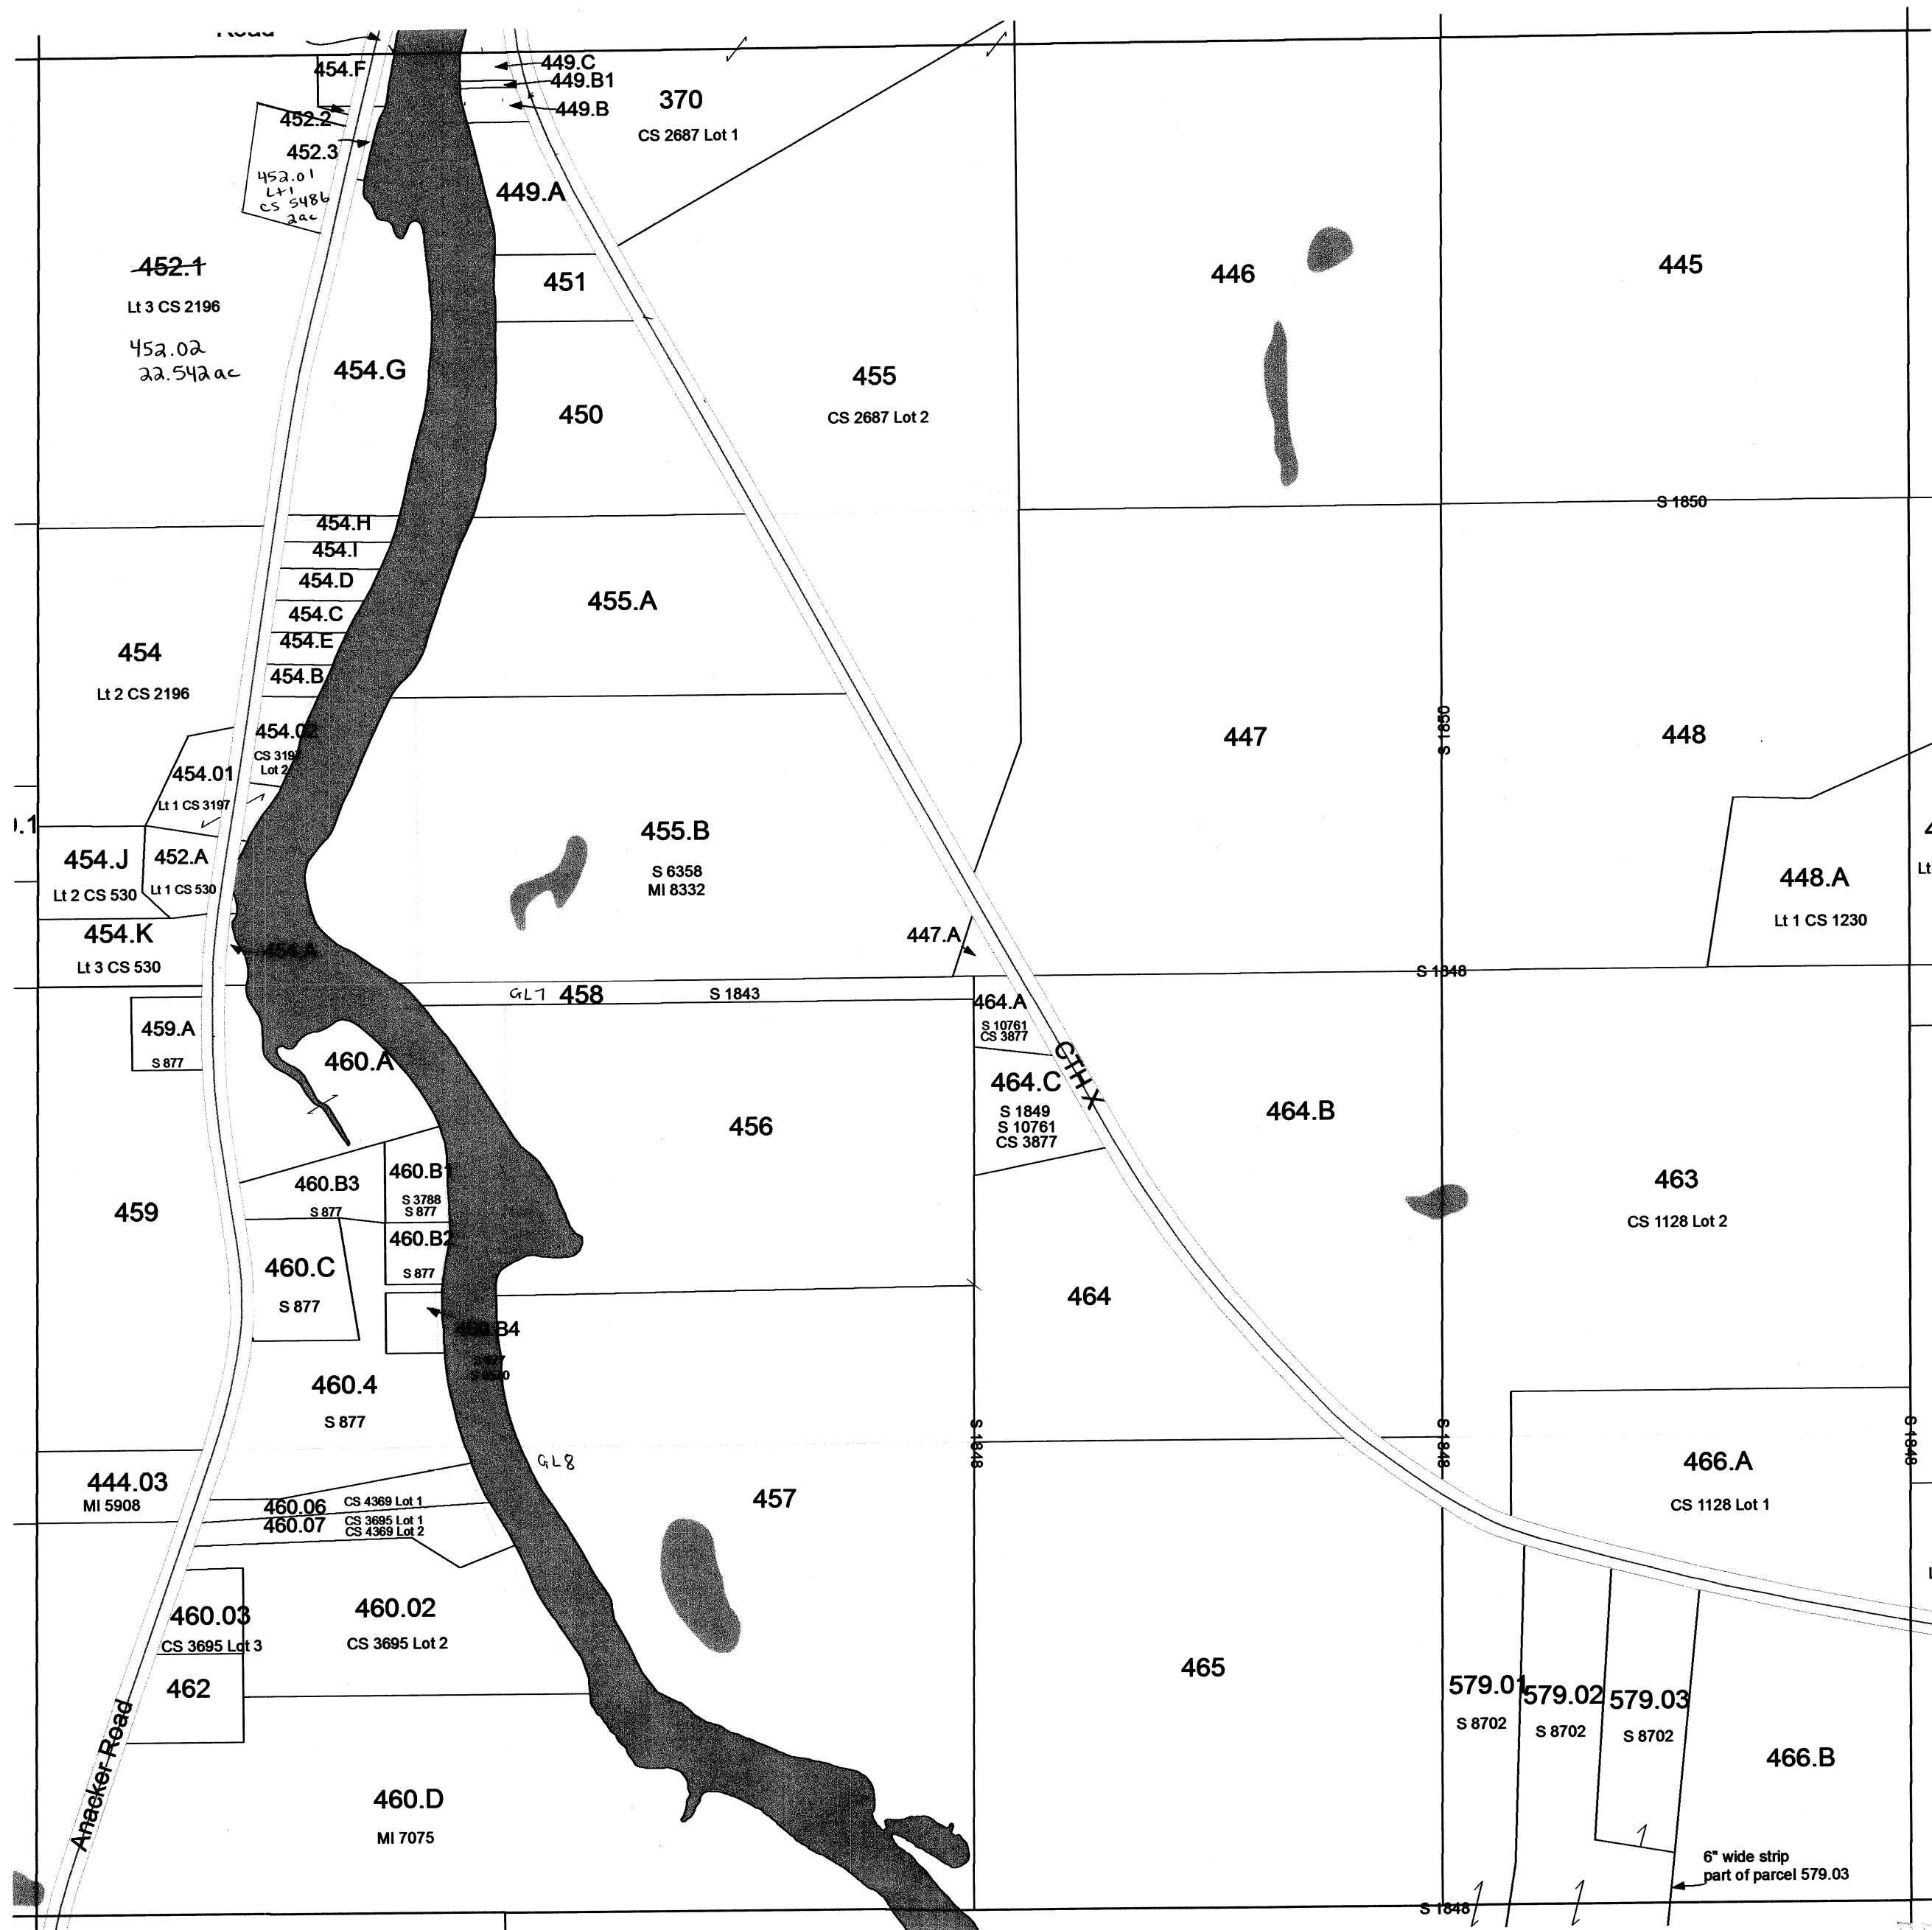


SEE SECTION 16 TOWN OF LEWISTON

REPLACED
2014

1 inch = 400 feet 1:4,800

The diagram shows a 6x12 grid of road segments. The top half is labeled 'R7E' and the bottom half 'R8E'. The grid contains numbers 1 through 36. A thick black square is at the intersection of the 4th row and 10th column, labeled 'T13N'. A thick black line runs vertically through the 10th column, labeled 'T12N'. The bottom boundary is irregular, with a gap in the 10th column.

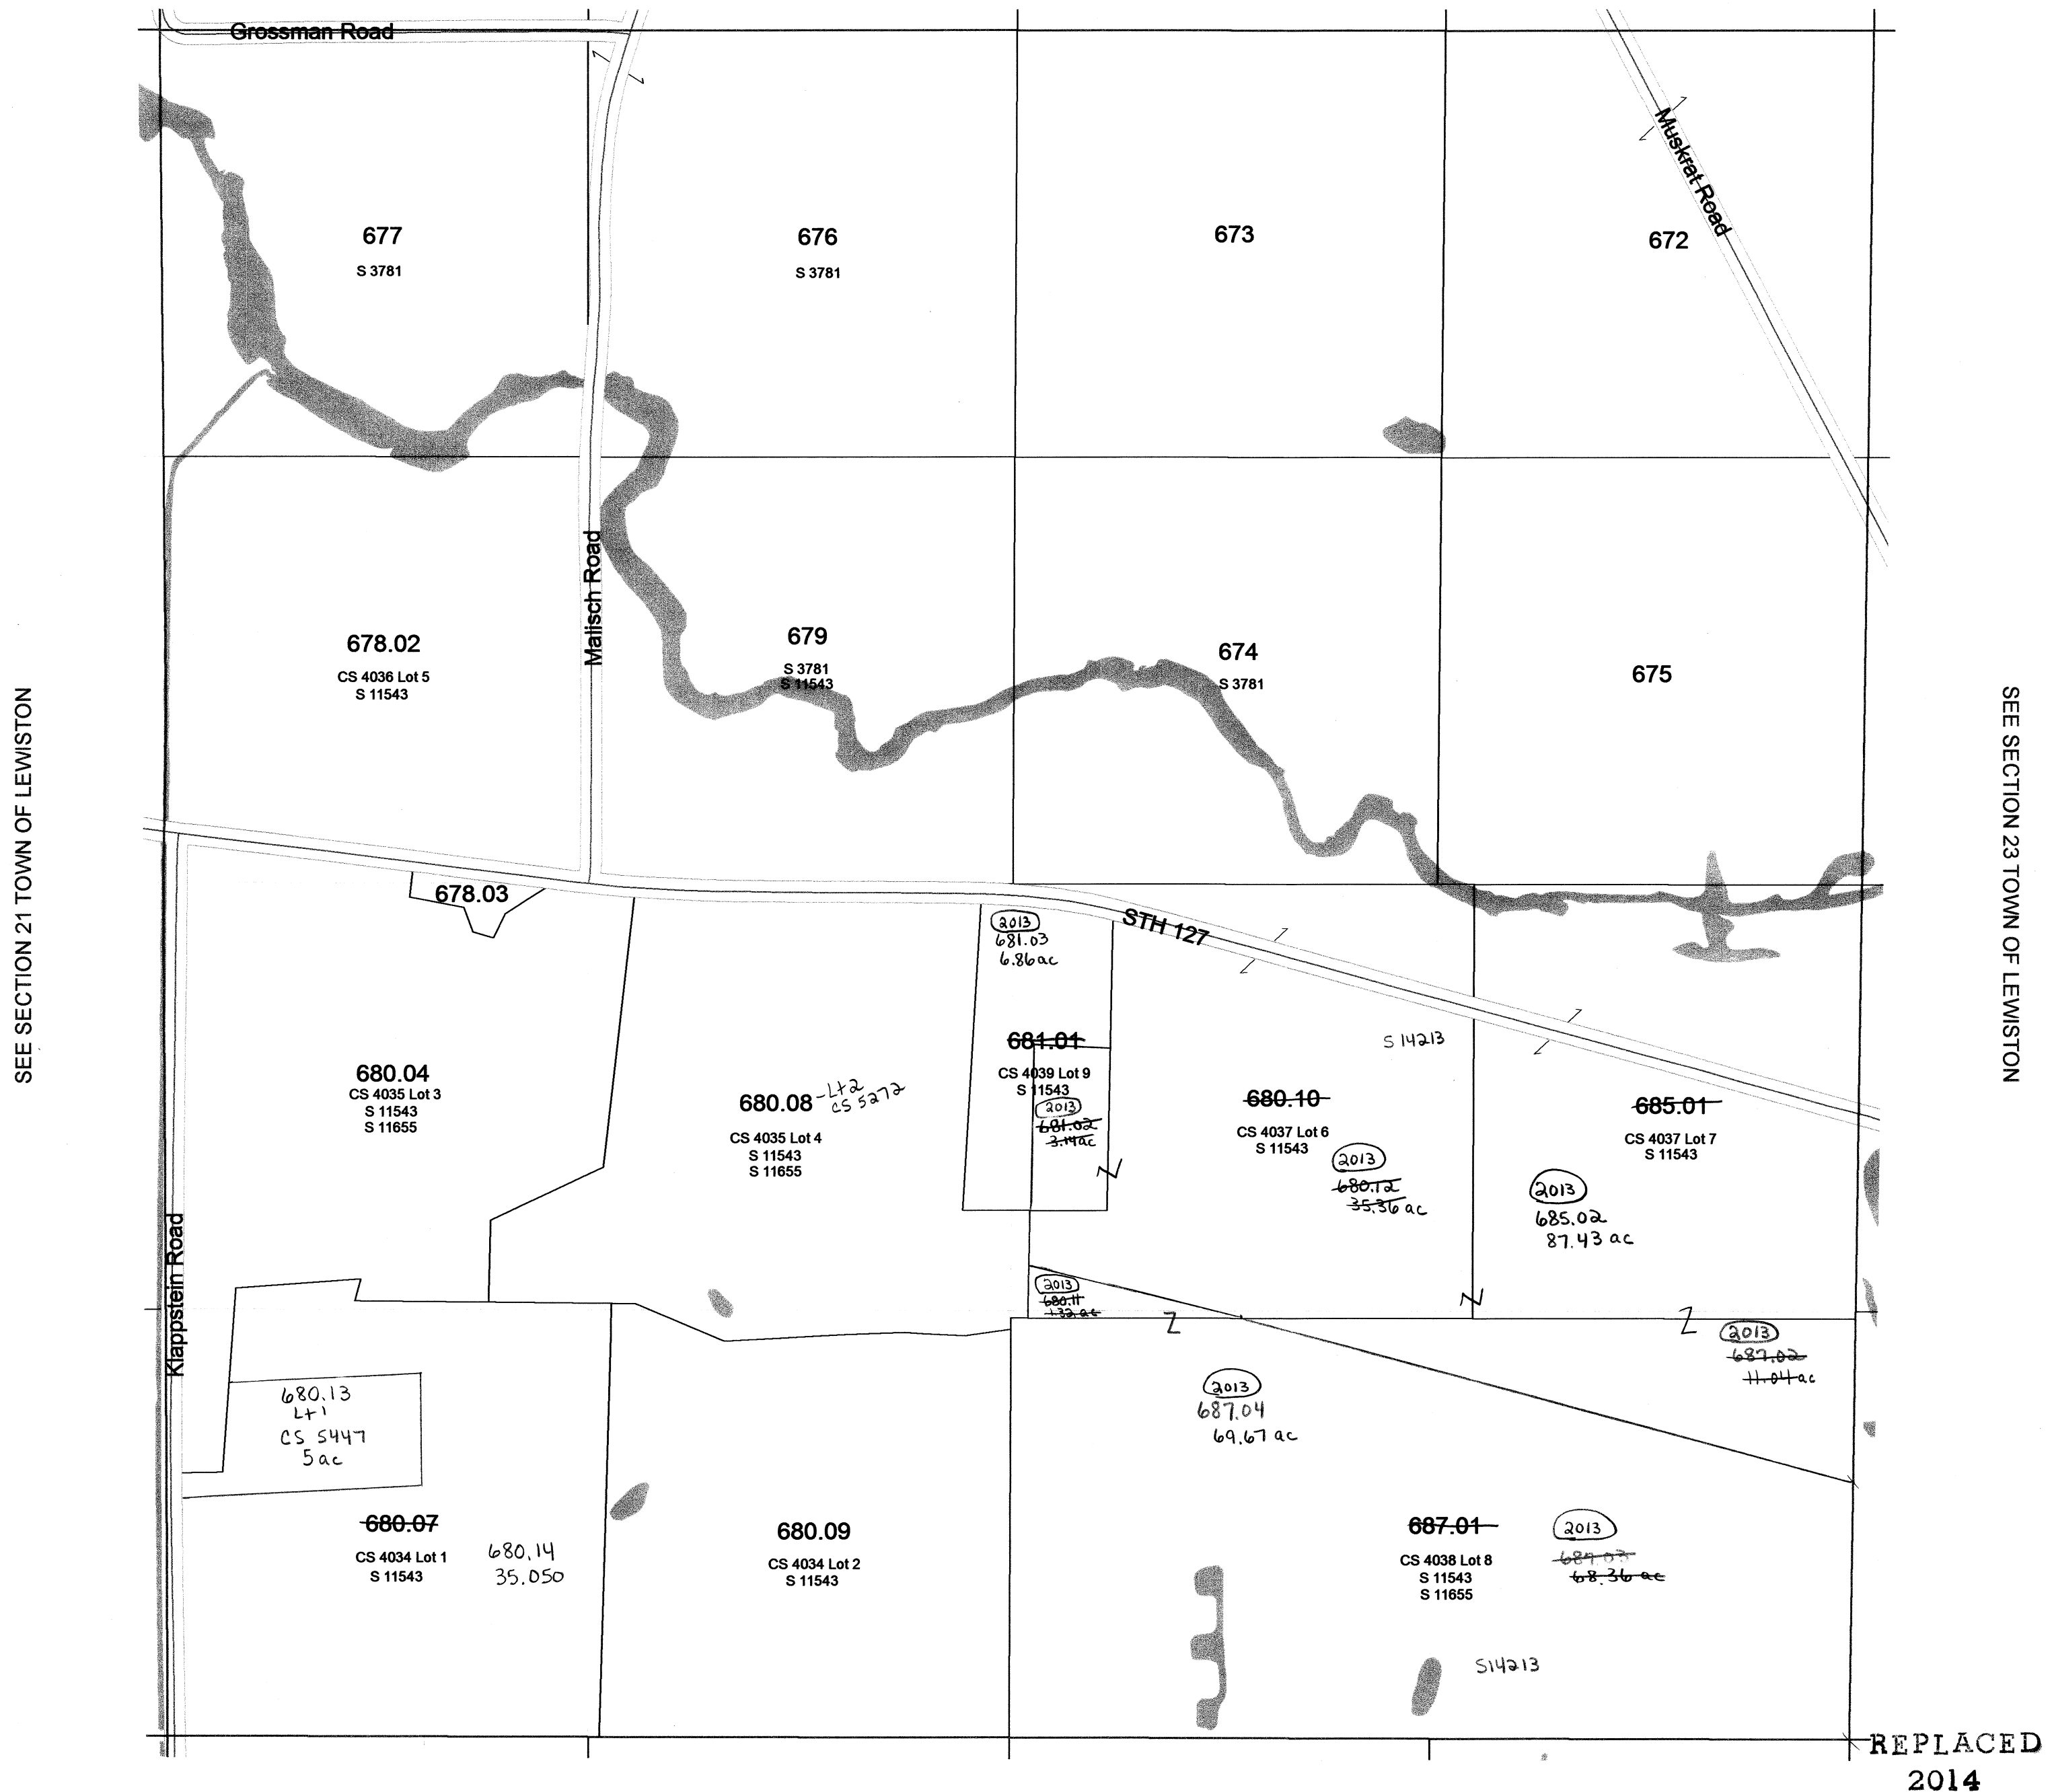Section 22
T13N R8E

1 inch = 400 feet 1:4,800

[illegible]Section 35
T13N R8E