


TOWN OF FORT WINNEBAGO


Replaced
2005

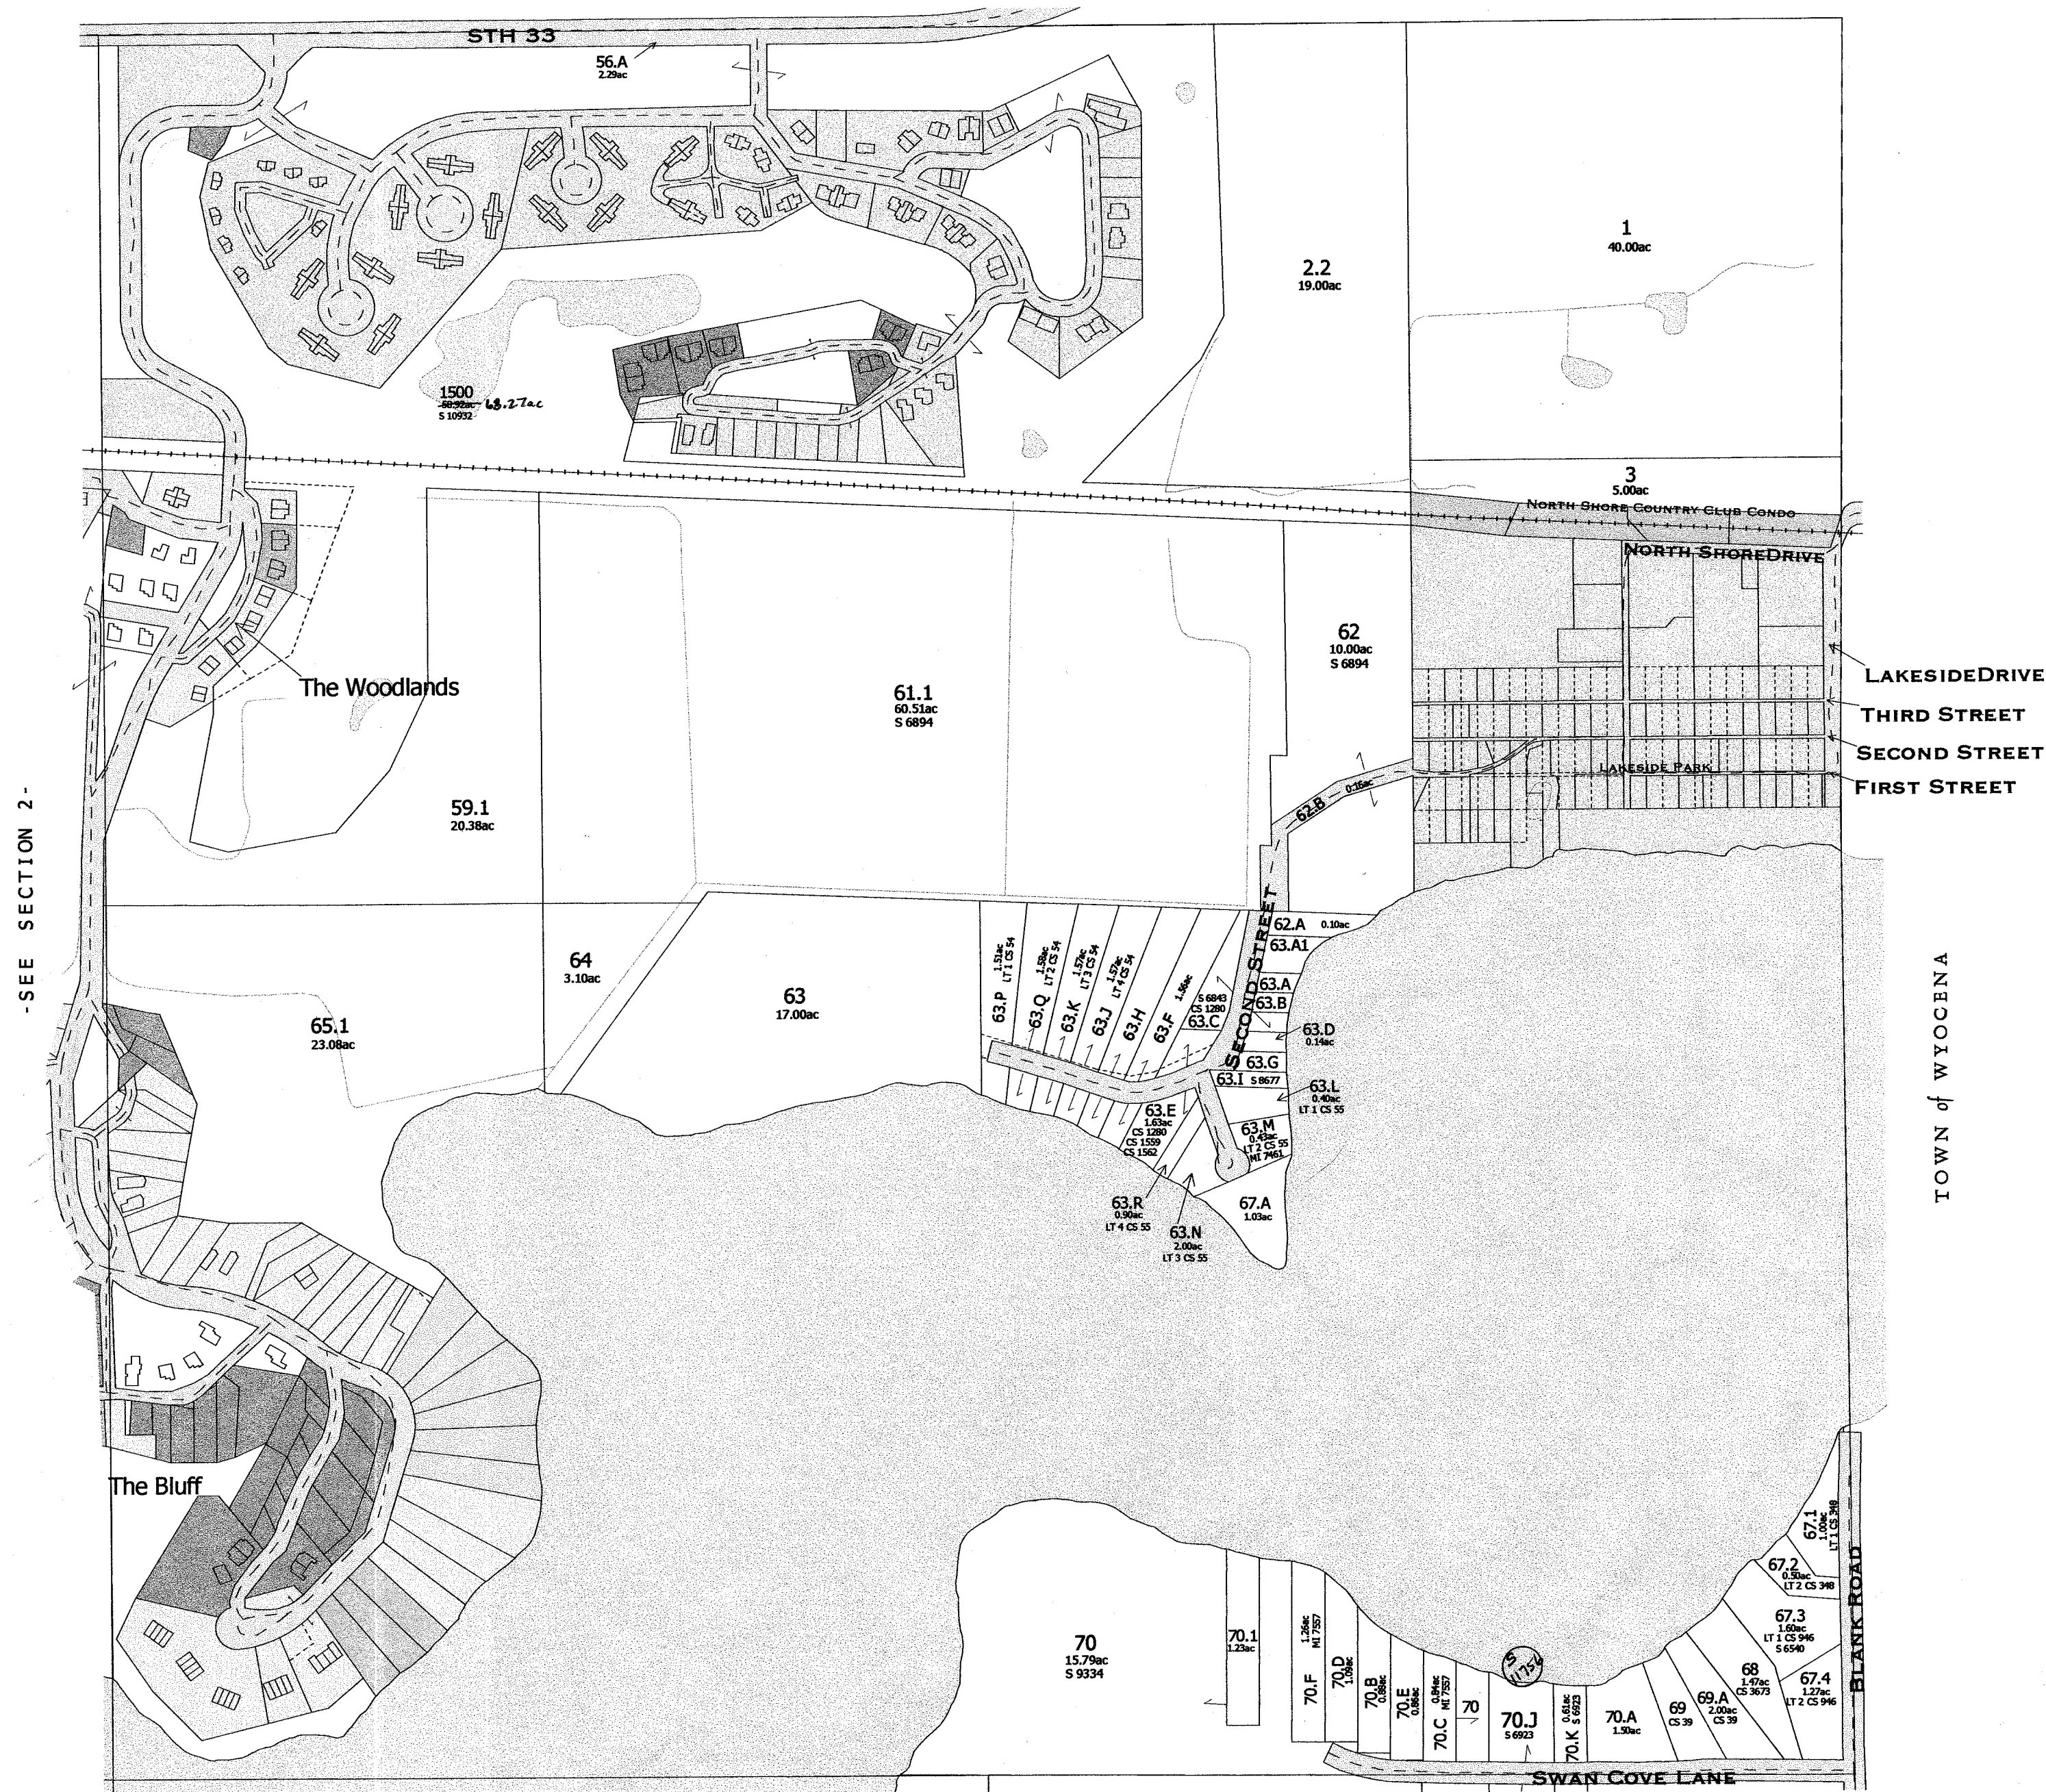


-SEE SECTION 12-

FOR DETAILED MAP OF SUBDIVISIONS, SEE THE FOLLOWING PAGES.

Replaced
204

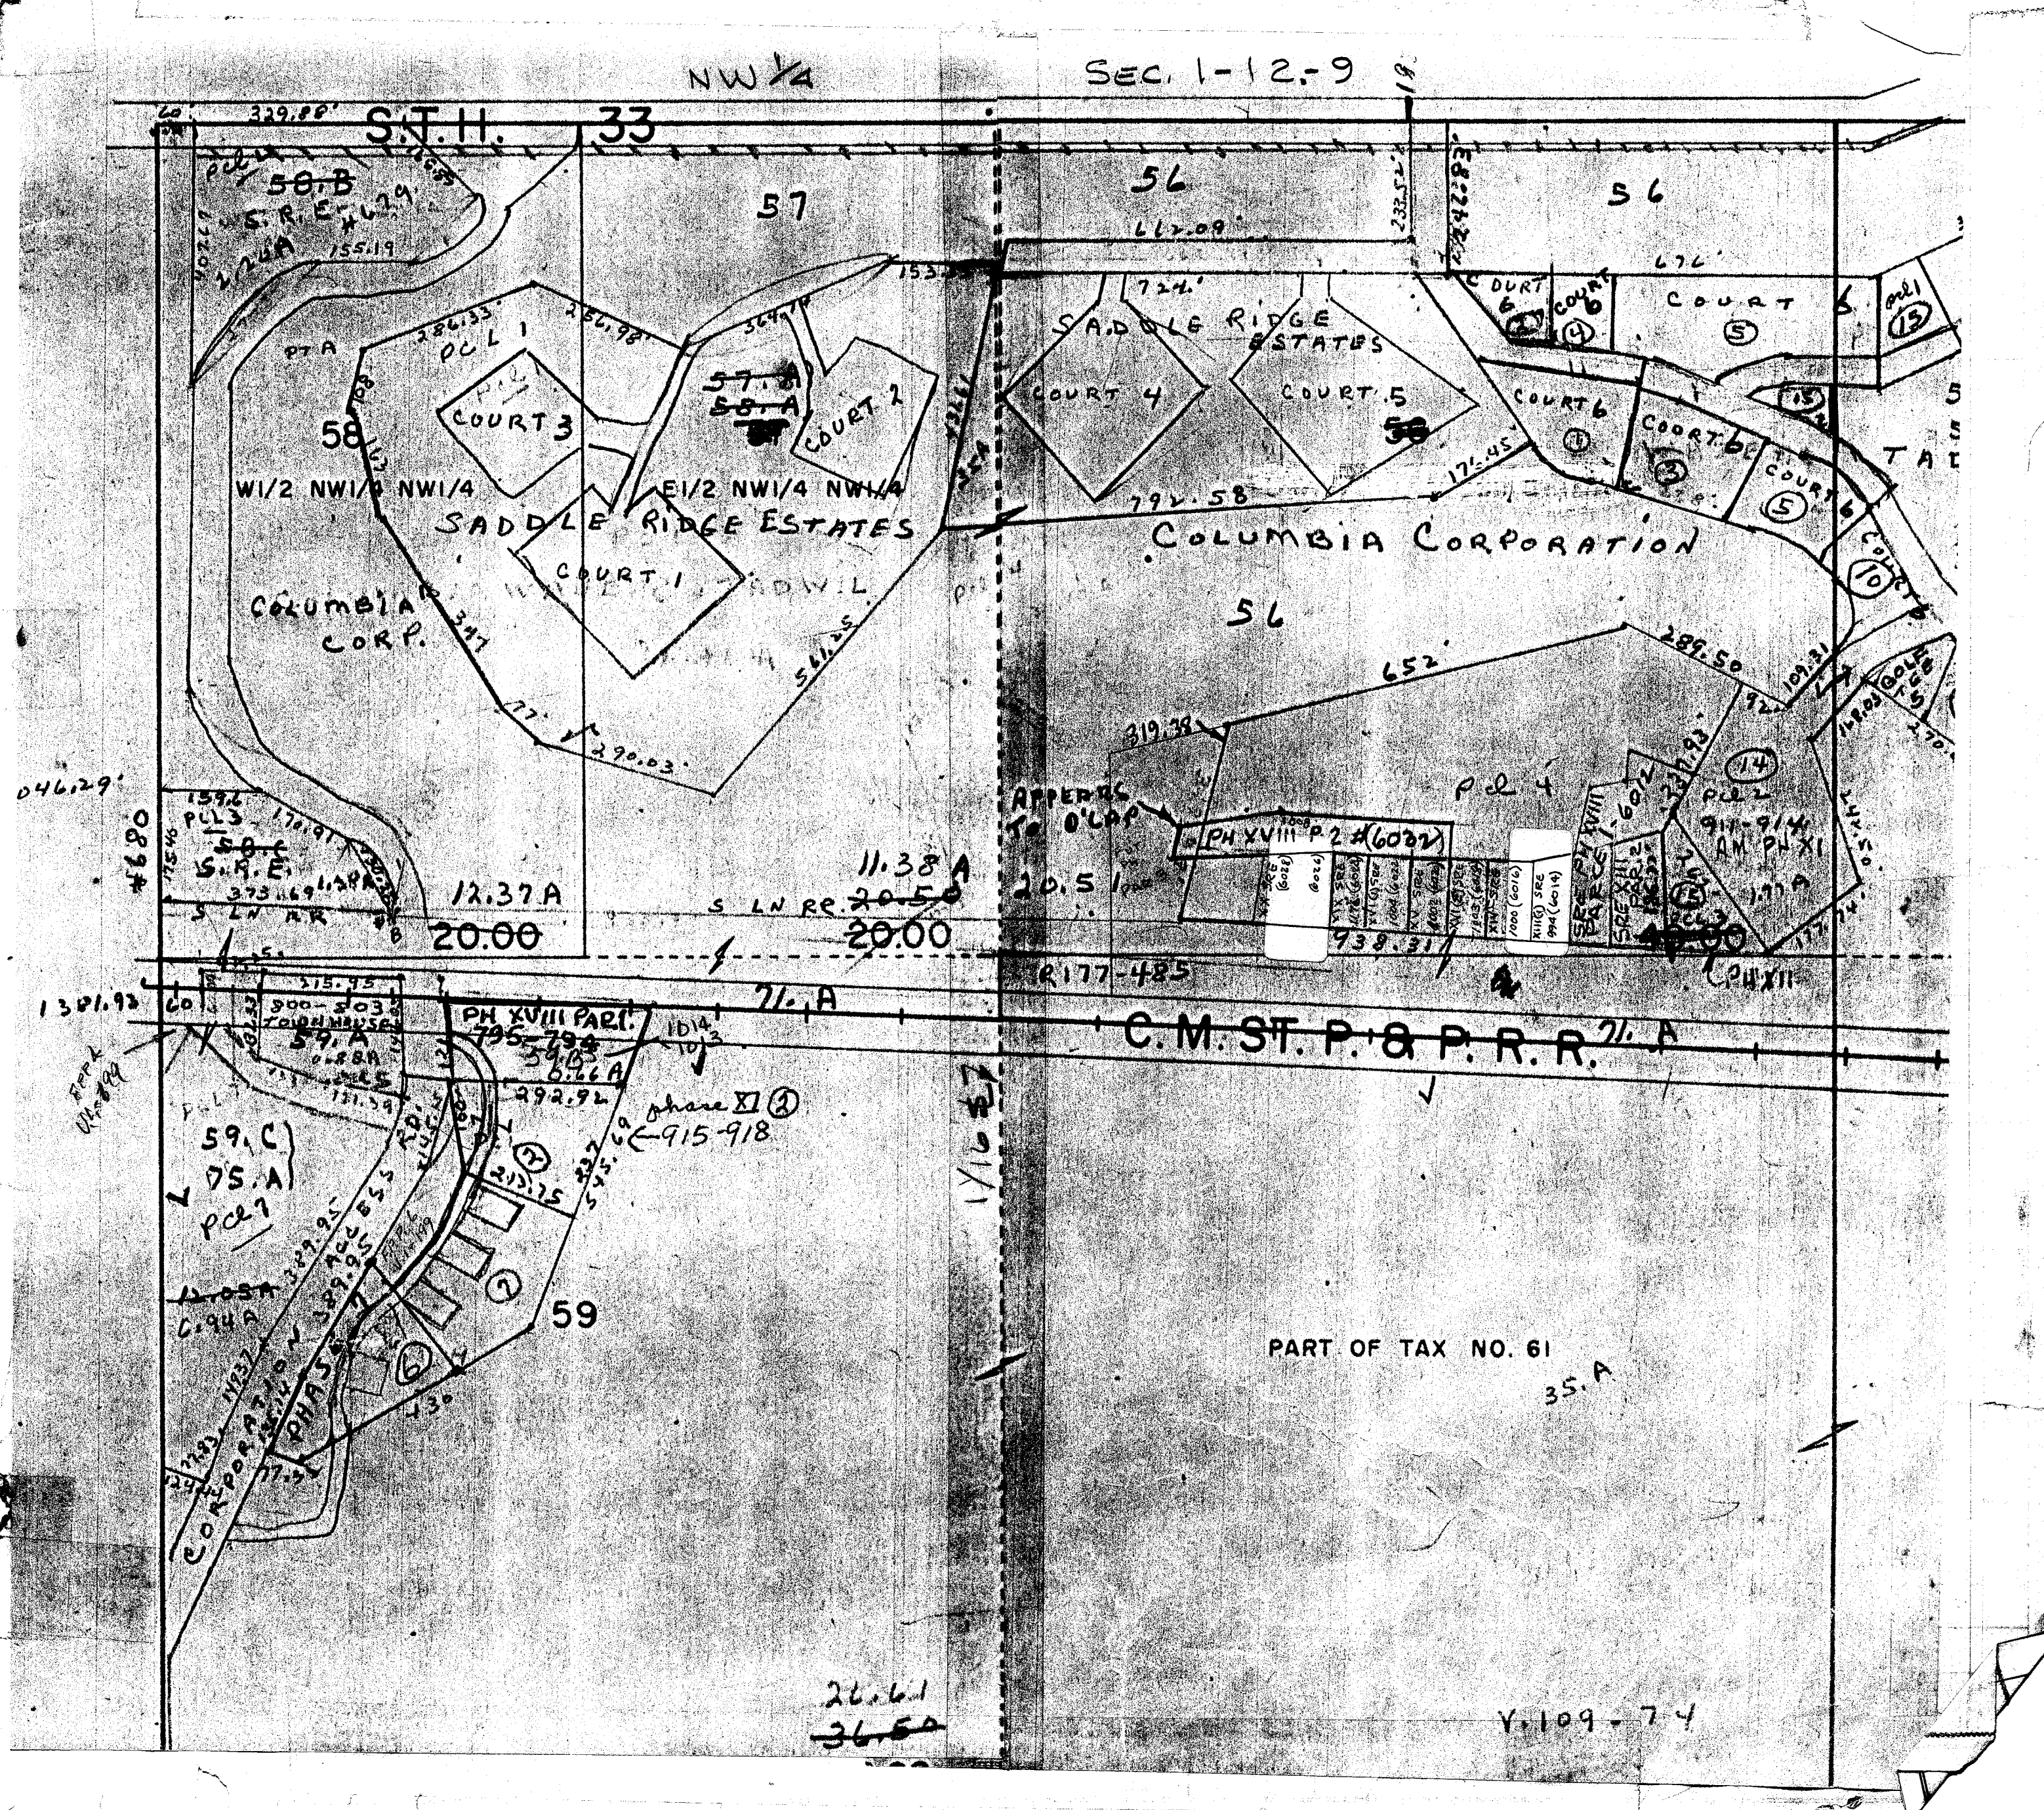

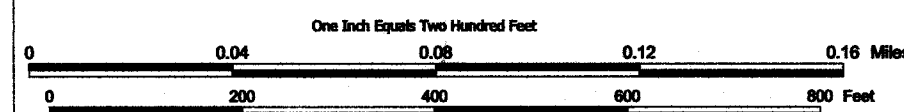


NOTE: This map was prepared for assessment use in accordance with the Wis. St. Stat. Chap. 70.09. All information contained herein is advisory only. Map accuracy is limited to the quality of data obtained from other public records. This map is not intended to be a substitute for an actual field survey. Public Land Survey Base is derived from U.S.G.S. Topographic maps unless otherwise noted. Other sources of the Land Base may be actual survey data. Base map data is from the April 1995 County Digital Orthophoto and/or U.S.G.S. 1:24,000 scale Topographic series. The user is responsible for the improper use of the data contained herein.

Created by The Columbia County Land Information Office -GIS Section, VMB, February 2005.

TAX PARCEL MAP

TOWN of PACIFIC


TOWN 12 NORTH RANGE 9 EAST
COLUMBIA COUNTY, WISCONSIN

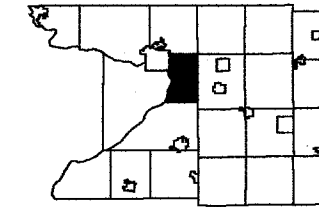

3	2	
10	11	12
16	14	13
22	23	24
28	27	25
33	34	35

Replaced
2007

-TOWN of FORT WINNEBAGO-

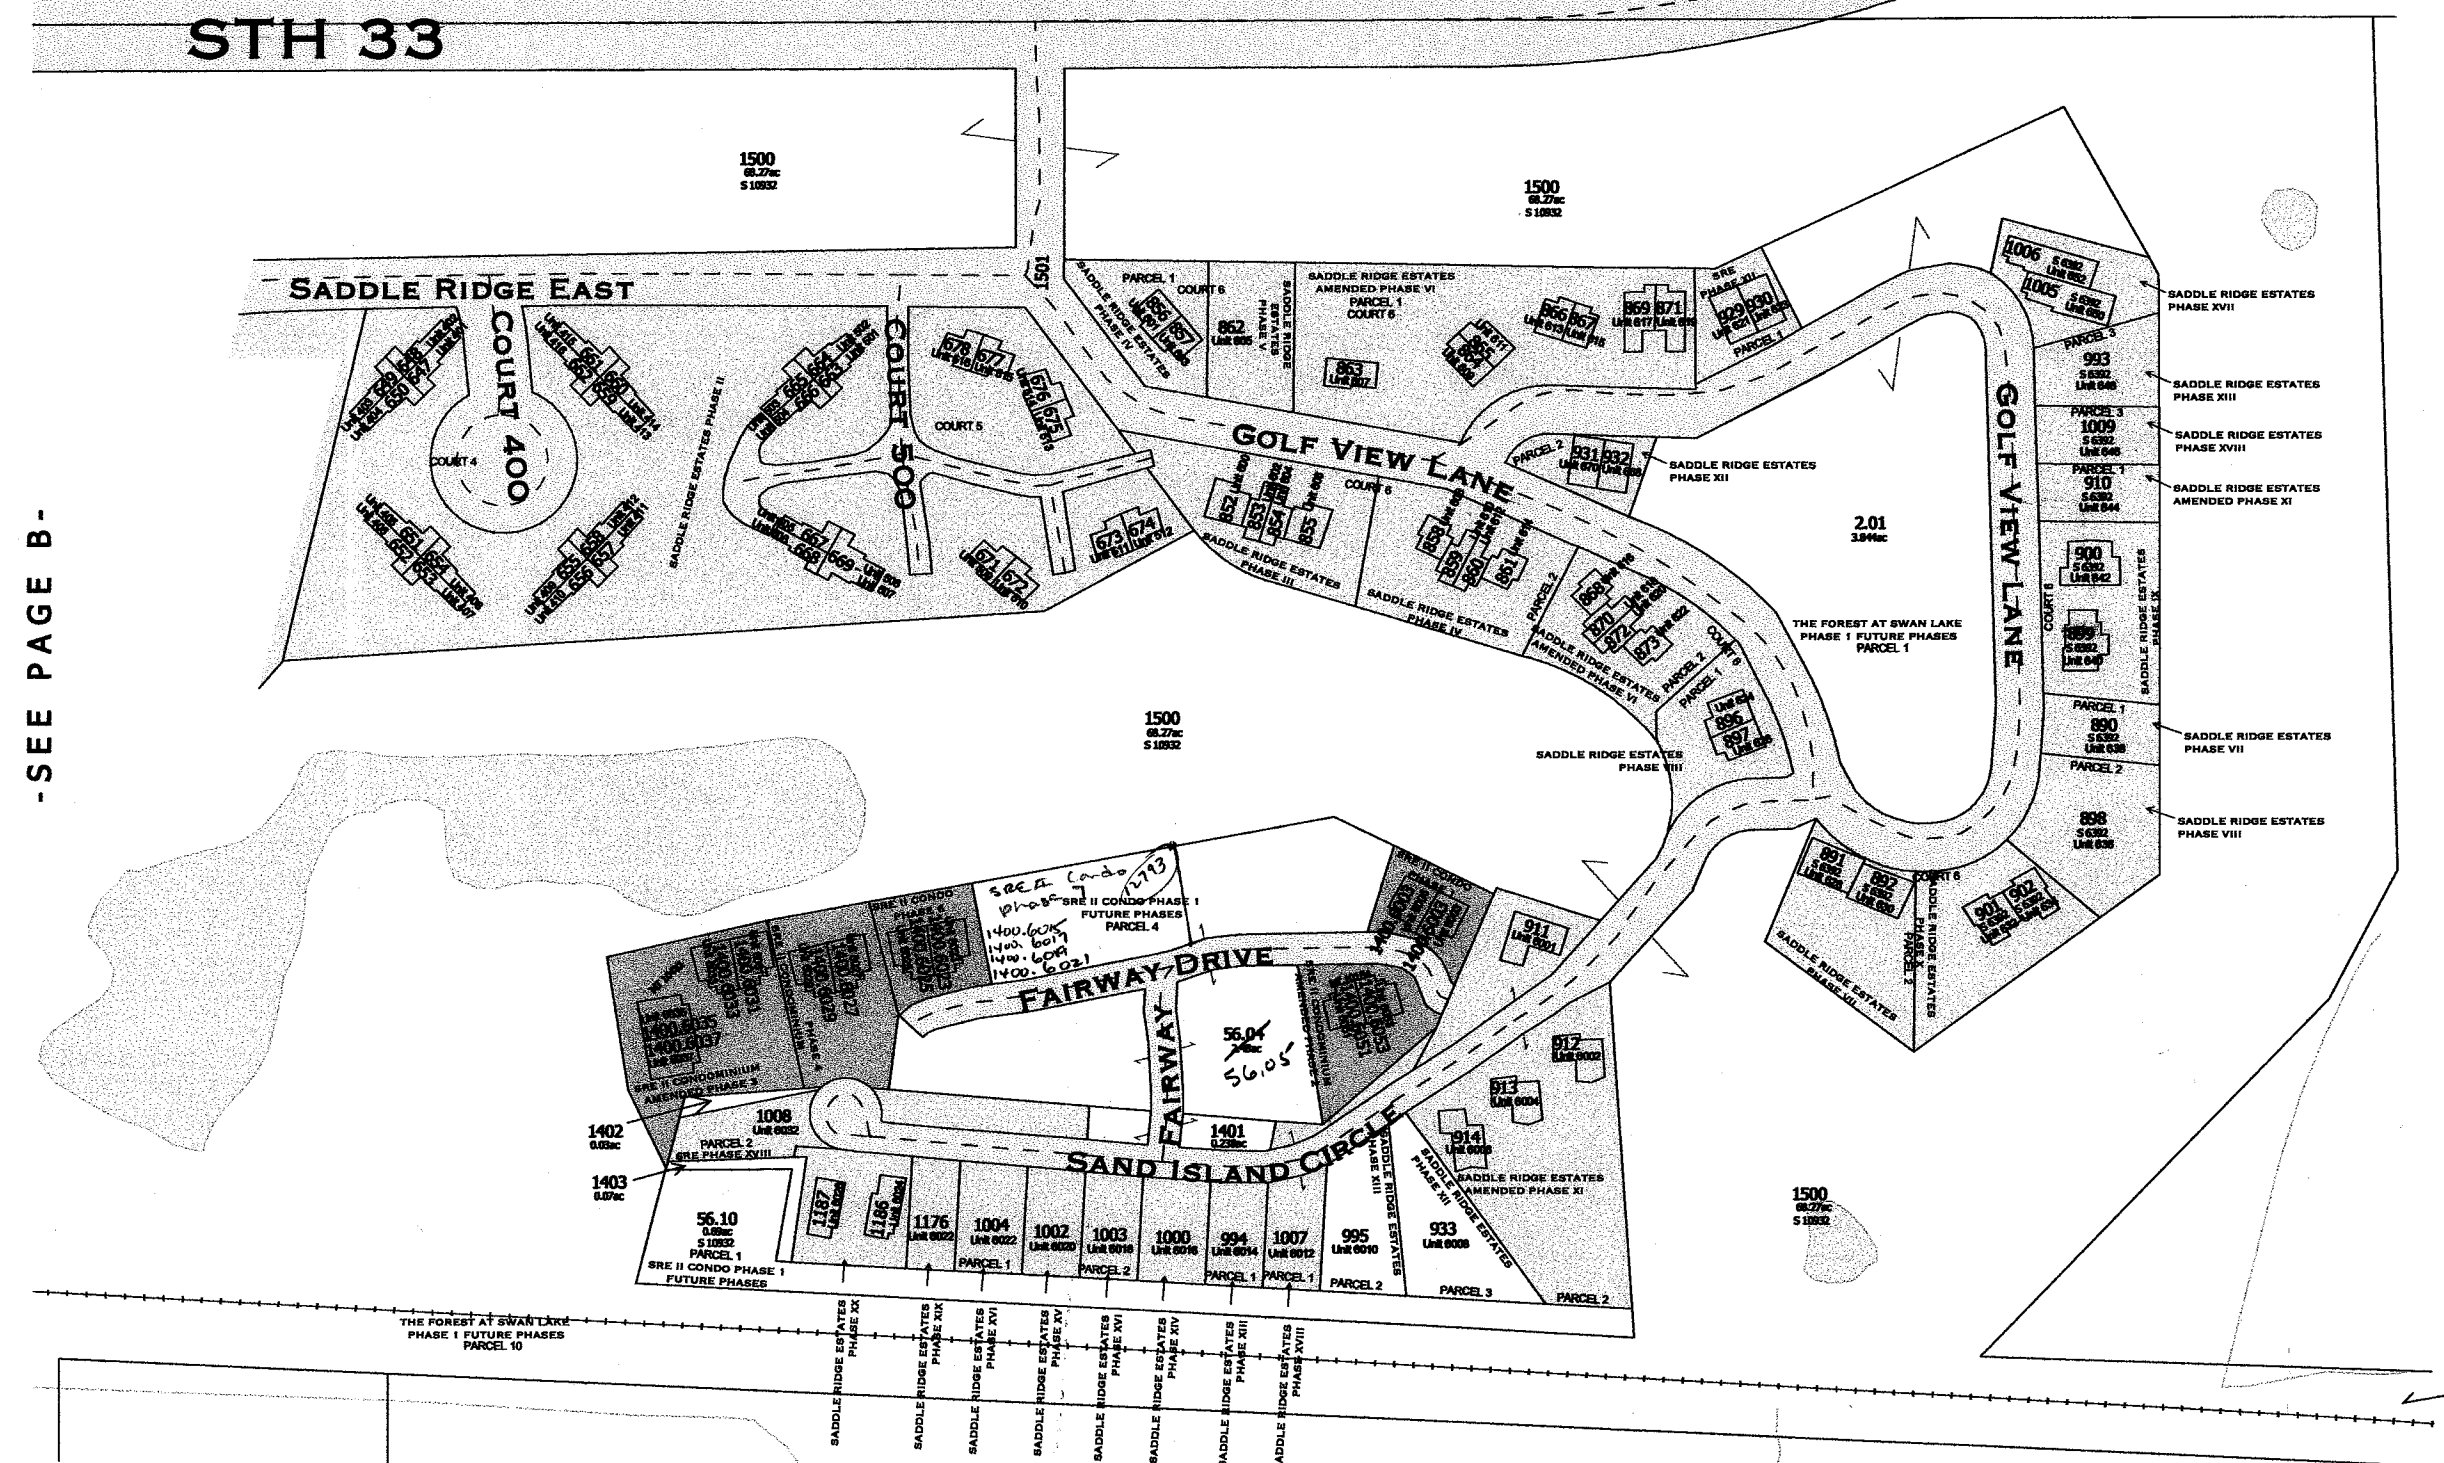

-SEE PAGE B-

-SEE SECTION 1-

-SEE SECTION 1-


SURVEY INDEX

THE FOREST AT SWAN LAKE - PHASE 1	S6123
SRE II PHASE I	9943
SRE II AMENDED PHASE I	10280
SRE II PHASE II	10090
SRE II AMENDED PHASE II	10661
SRE II PHASE III	10261
SRE II AMENDED PHASE III	10662
SRE II PHASE IV	10733
SRE II PHASE VI	12185

ADDITIONAL SURVEYS

CONDO PLAT OF SWAN LAKE VILLAGE GOLF & TENNIS CONDO C	5673
SADDLE RIDGE (UNDEVELOPED SUBDIVISION PLAT)	6556
SRE EXHIBIT C	6562
SWAN LAKE RESORT(UNDEVELOPED)	6541

Replaced
2007

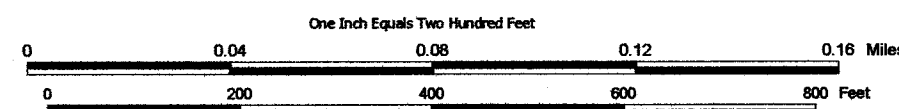


NOTE: This map was prepared for assessment use in accordance with the Wis. St. Stat. Chap. 70.09. All information contained herein is advisory only. Map accuracy is limited to the quality of data obtained from other Public Records. This map is not intended to be a substitute for an actual field survey. Public Land Survey Base is derived from U.S.G.S Topographic maps unless otherwise noted. Other sources of the Land Base may be actual survey data. Base map data is from the April 1995 County Digital Orthophotos and/or U.S.G.S. 1:24,000 scale Topographic series. The user is responsible for the improper use of the data contained herein.

Created by The Columbia County Land Information Office -GIS Section. VMS. July 2004.

TAX PARCEL MAP

TOWN of PACIFIC


TOWN 12 NORTH RANGE 9 EAST
COLUMBIA COUNTY, WISCONSIN

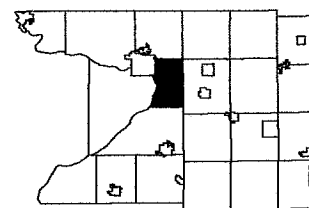

3	2	
10	11	12
15	14	13
22	23	24
27	26	25
30	29	28

Replaced
2005

-TOWN of FORT WINNEBAGO-

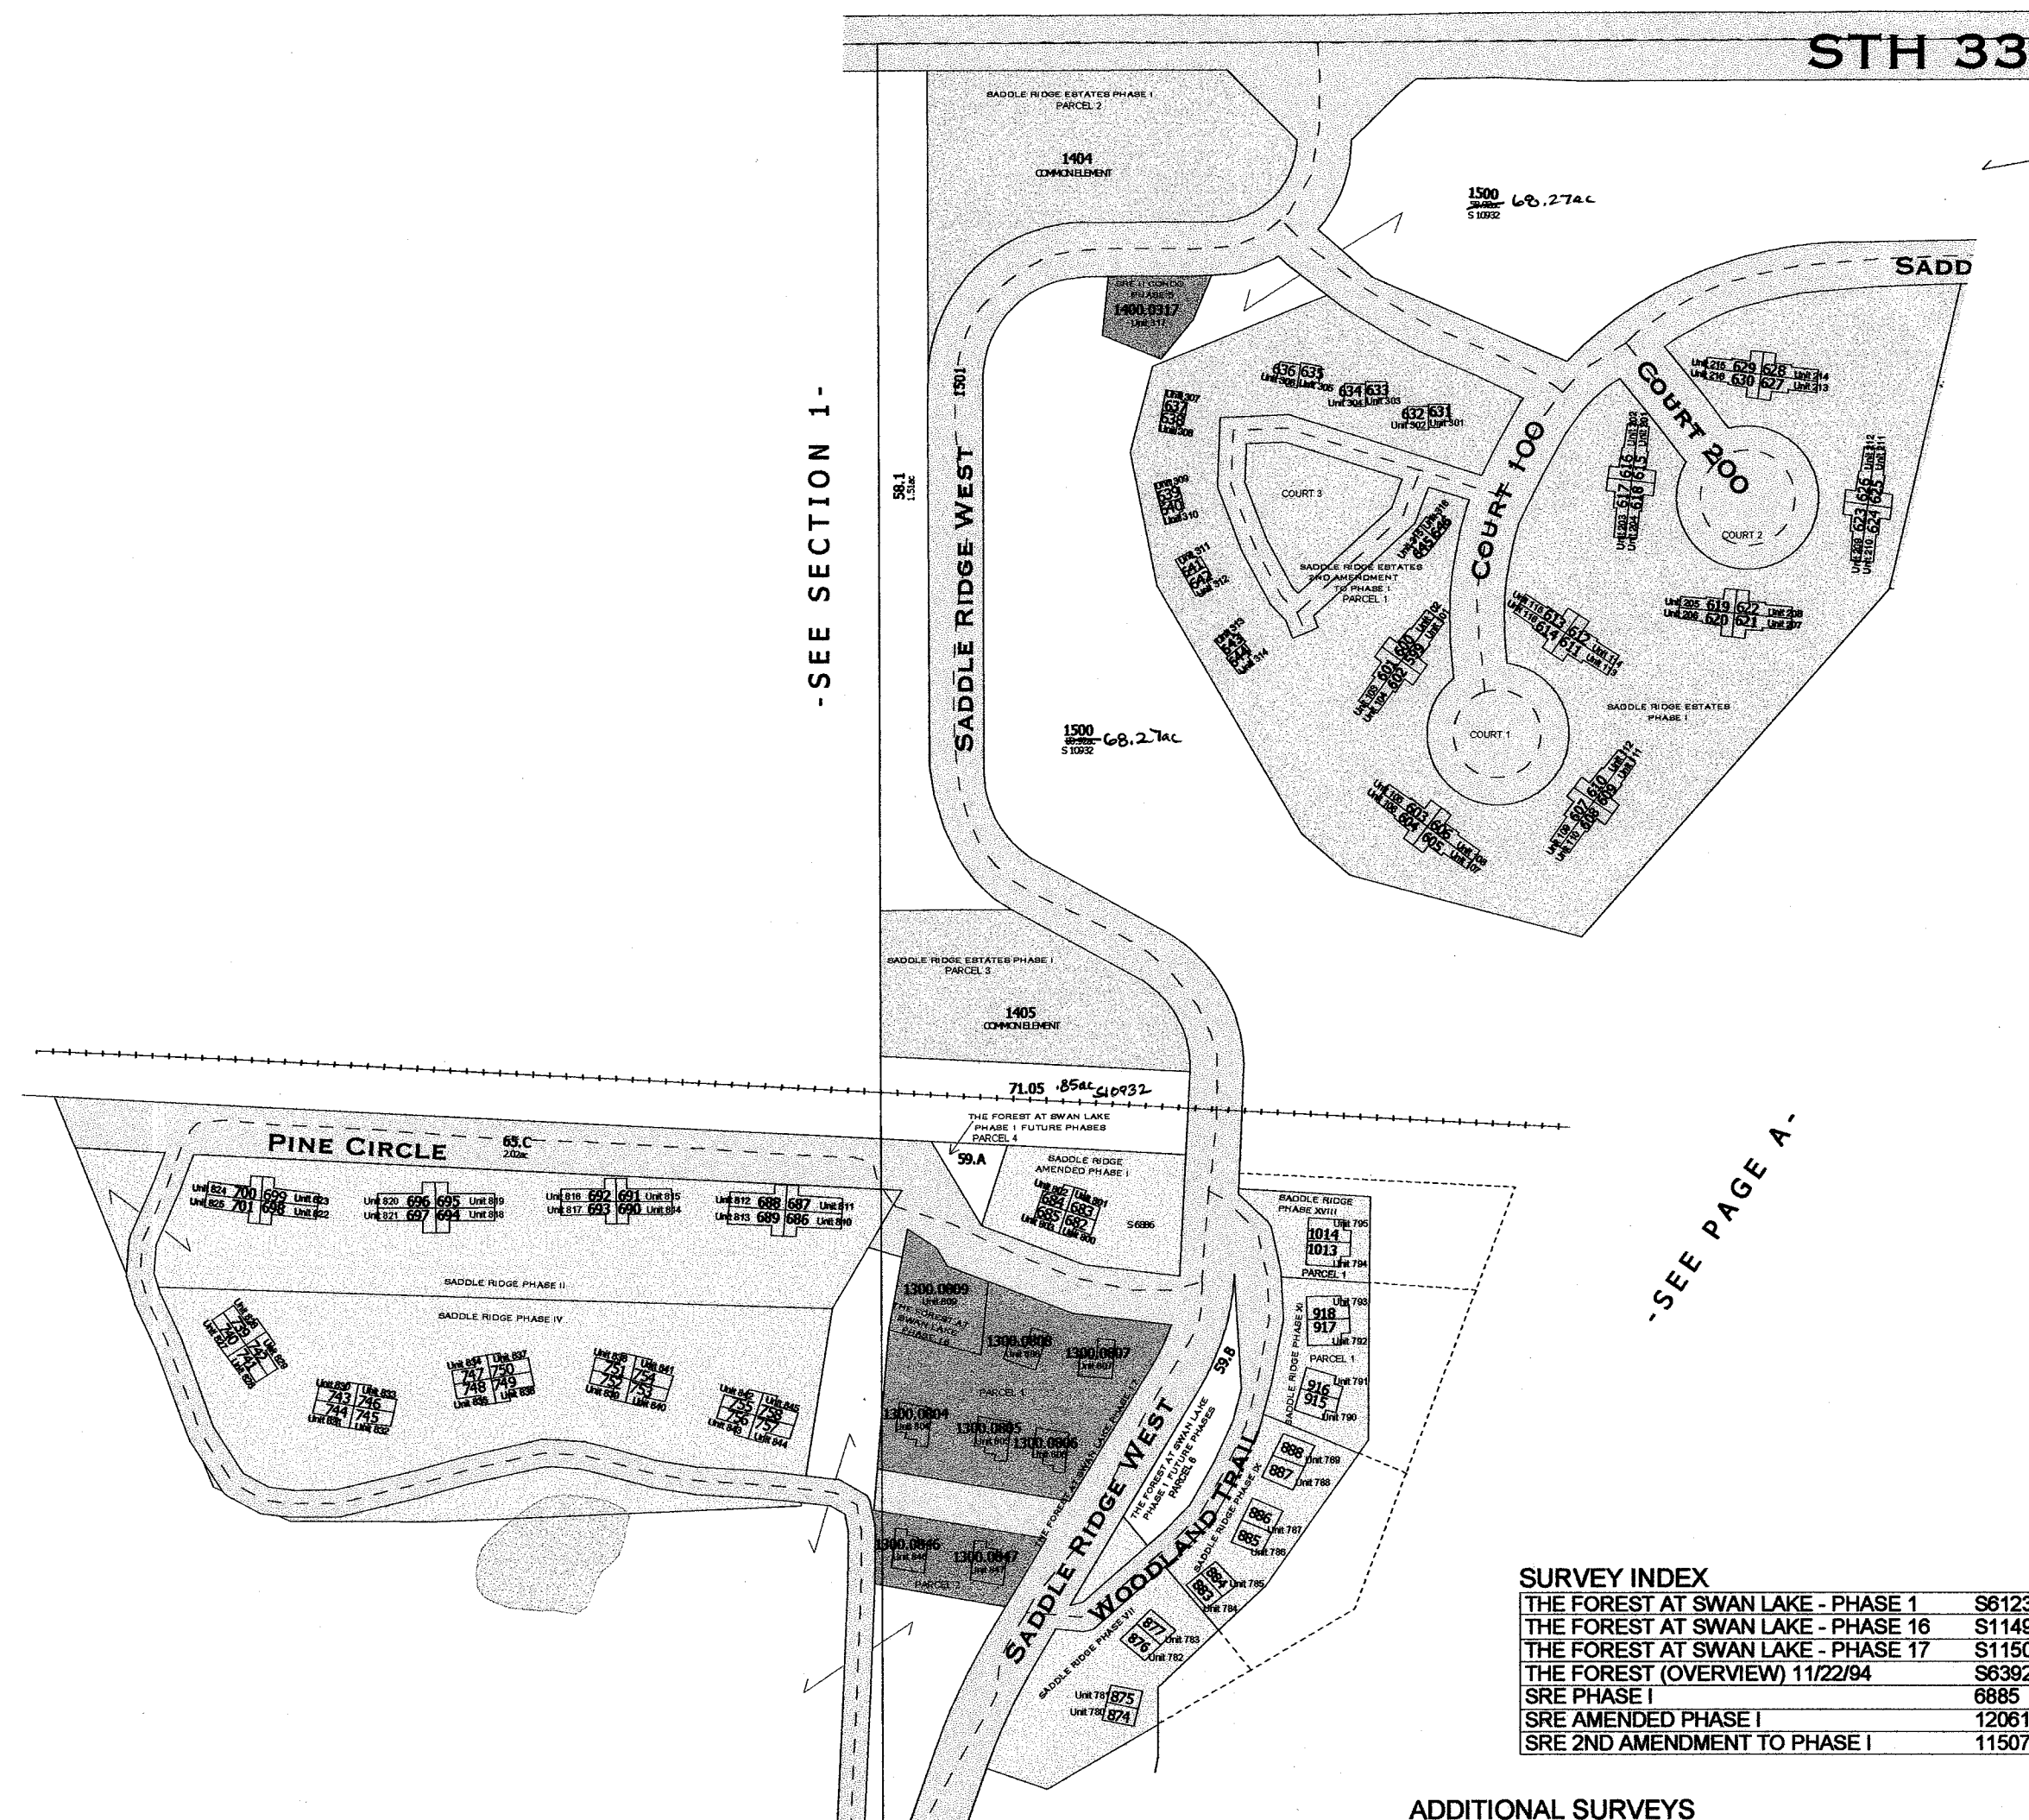

SURVEY INDEX


THE FOREST AT SWAN LAKE - PHASE 1	S6123
THE FOREST AT SWAN LAKE - PHASE 16	S11498
THE FOREST AT SWAN LAKE - PHASE 17	S11503
THE FOREST (OVERVIEW) 11/22/94	S6392
SRE PHASE I	6685
SRE AMENDED PHASE I	12061
SRE 2ND AMENDMENT TO PHASE I	11507

ADDITIONAL SURVEYS

CONDO PLAT OF SWAN LAKE VILLAGE	GOLF & TENNIS CONDO C	5673
SADDLE RIDGE (UNDEVELOPED SUBDIVISION PLAT)		6556
SRE EXHIBIT C		6562
SWAN LAKE RESORT (UNDEVELOPED)		6541

-SEE PAGE C-

2005

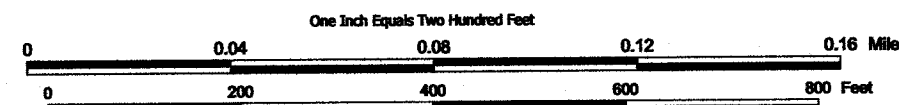


NOTE: This map was prepared for assessment use in accordance with the Wis. St. Stat. Chap. 70.09. All information contained herein is advisory only. Map accuracy is limited to the quality of data obtained from other Public Records. This map is not intended to be a substitute for an actual field survey. Public Land Survey Base is derived from U.S.G.S. Topographic maps unless otherwise noted. Other sources of the Land Base may be actual survey data. Base map data is from the April 1995 County Digital Orthophotos and/or U.S.G.S. 1:24,000 scale Topographic series. The user is responsible for the proper use of the data contained herein.

Created by The Columbia County Land Information Office -GIS Section. V4B. February 2005.

TAX PARCEL MAP

TOWN of PACIFIC


TOWN 12 NORTH RANGE 9 EAST
COLUMBIA COUNTY, WISCONSIN

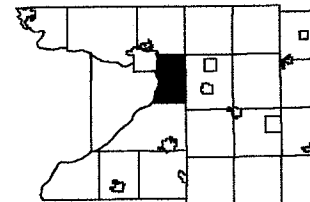

3	2	
10	11	12
15	14	13
22	23	24
29	27	26
33	34	35

Replaced
2007

-TOWN of FORT WINNEBAGO-

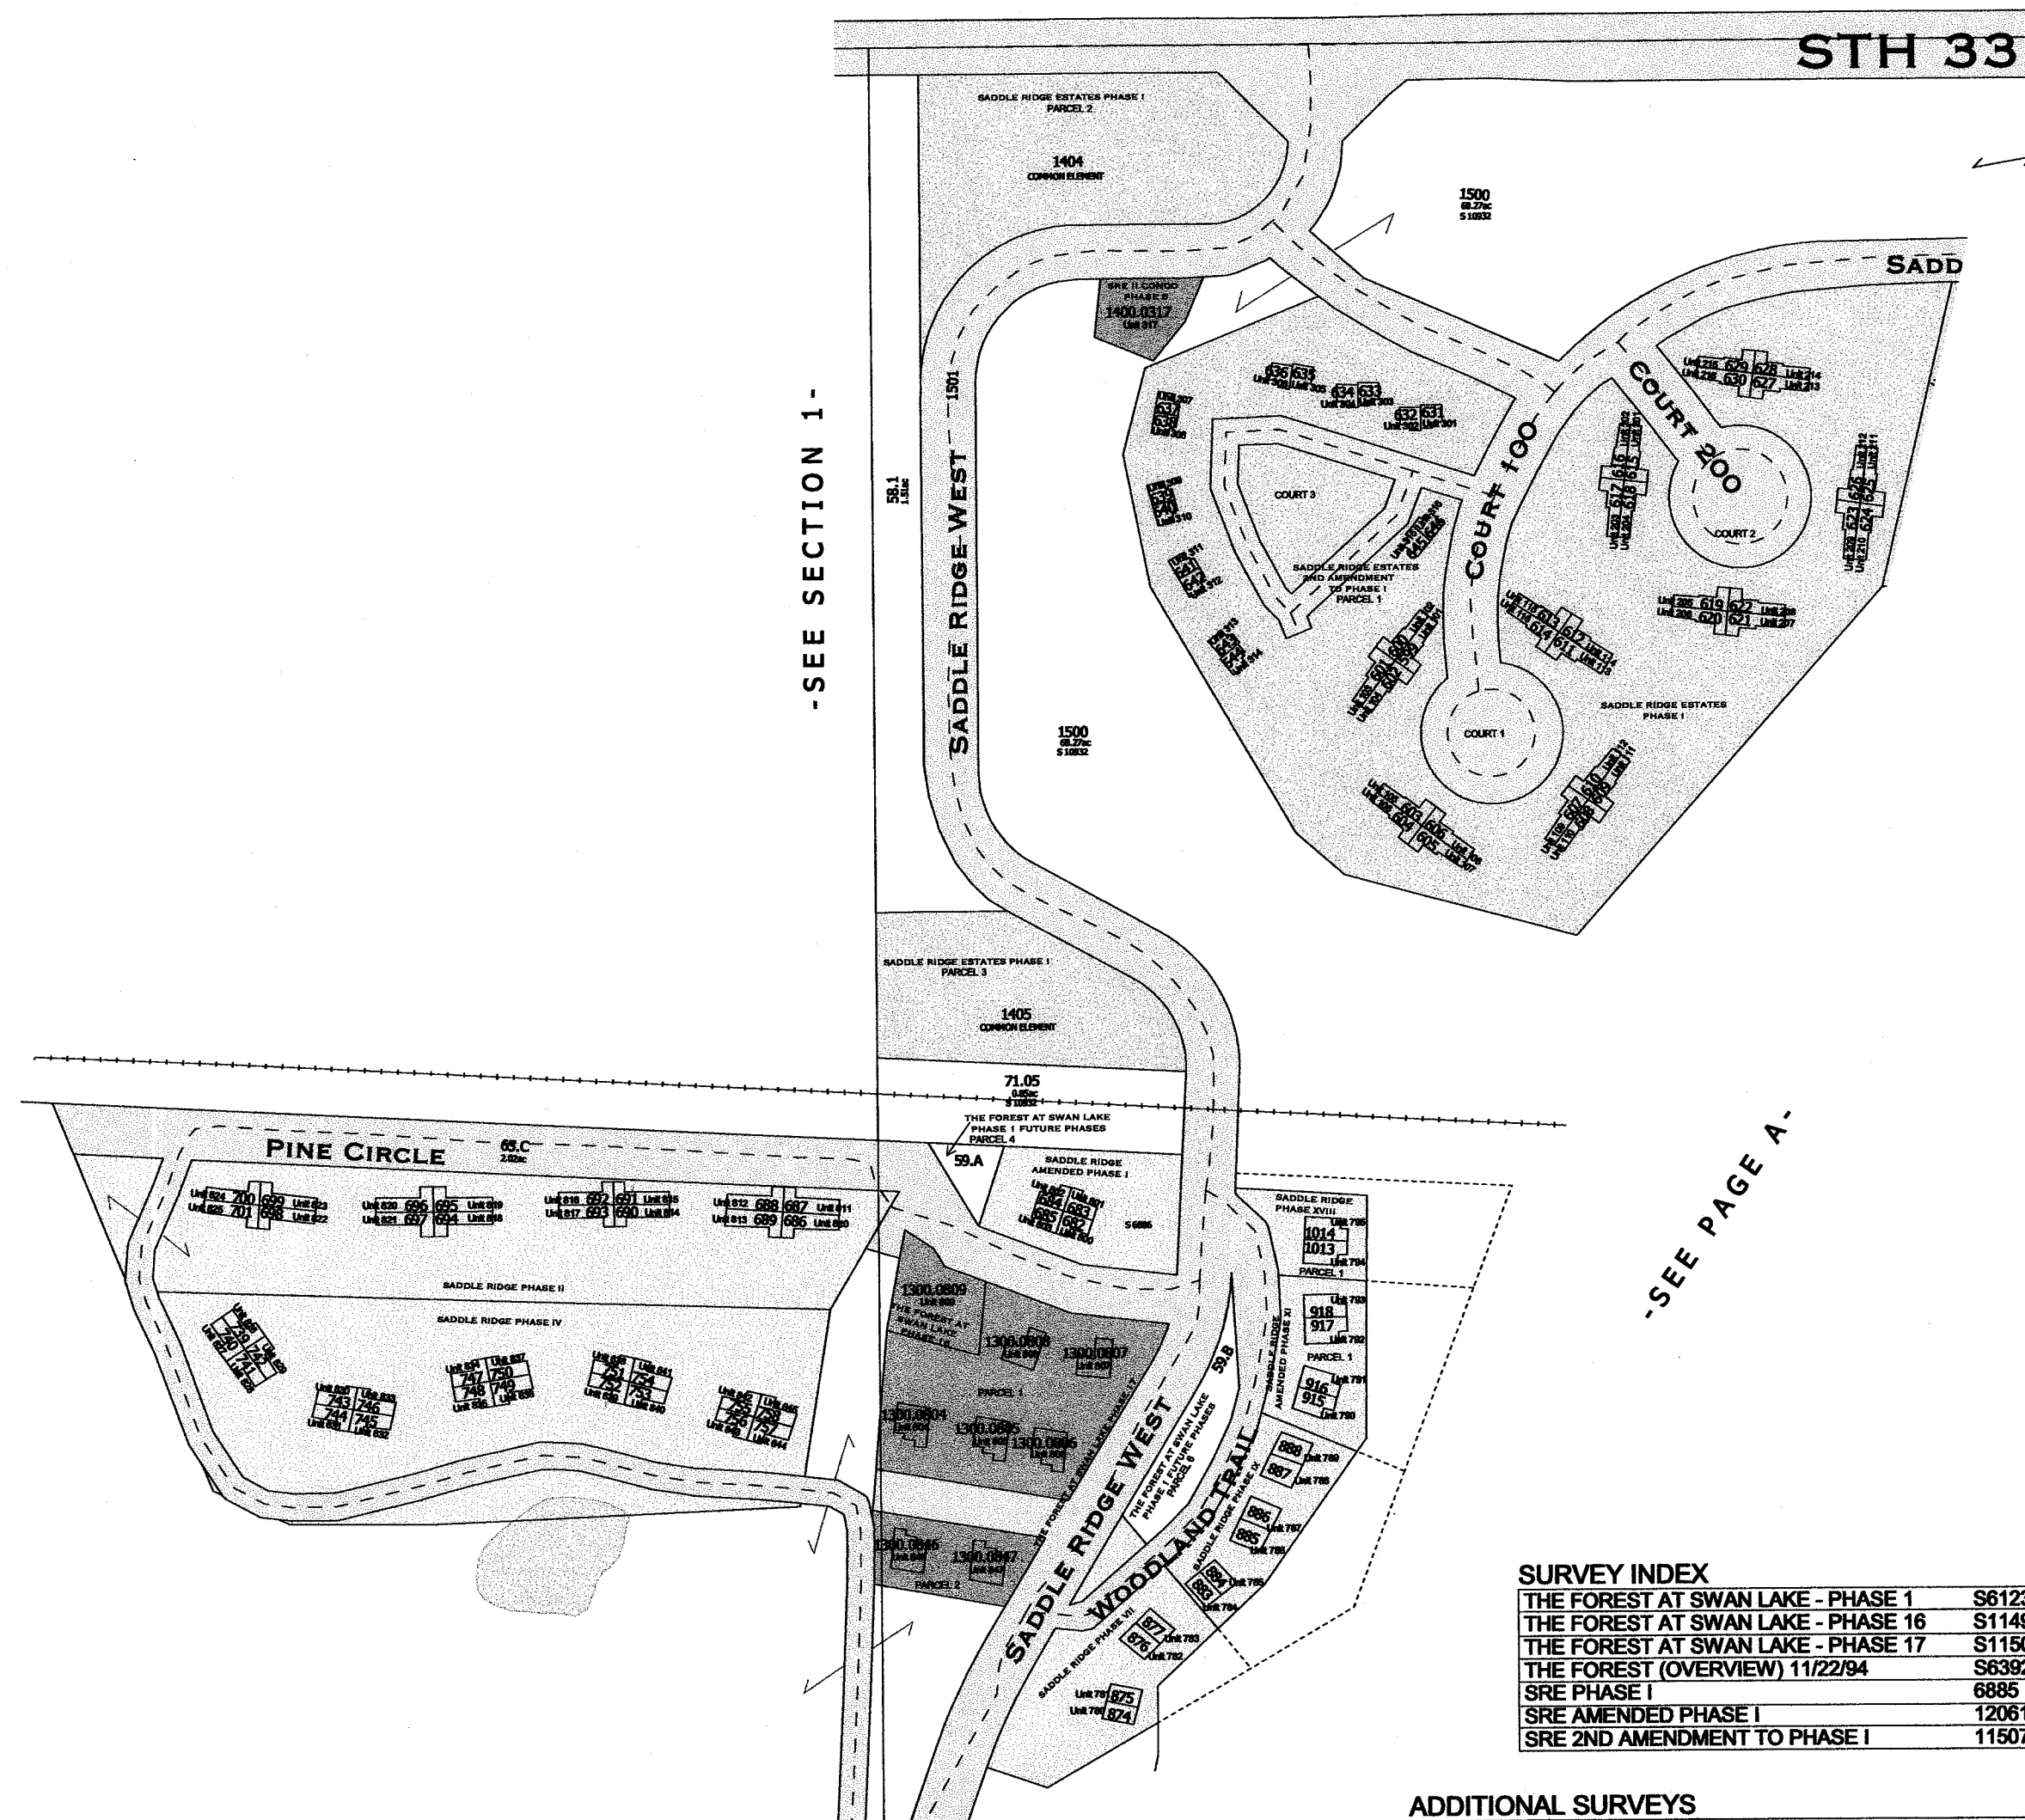

-SEE SECTION 1-

-SEE PAGE A-

-SEE PAGE C-

SURVEY INDEX

THE FOREST AT SWAN LAKE - PHASE 1	S6123
THE FOREST AT SWAN LAKE - PHASE 16	S11498
THE FOREST AT SWAN LAKE - PHASE 17	S11503
THE FOREST (OVERVIEW) 11/22/94	S6392
SRE PHASE I	6885
SRE AMENDED PHASE I	12061
SRE 2ND AMENDMENT TO PHASE I	11507


ADDITIONAL SURVEYS


CONDO PLAT OF SWAN LAKE VILLAGE	GOLF & TENNIS CONDO C	5673
SADDLE RIDGE (UNDEVELOPED SUBDIVISION PLAT)		6556
SRE EXHIBIT C		6562
SWAN LAKE RESORT(UNDEVELOPED)		6541

Replaced
2007

- SADDLE RIDGE B -

Replaced
2004
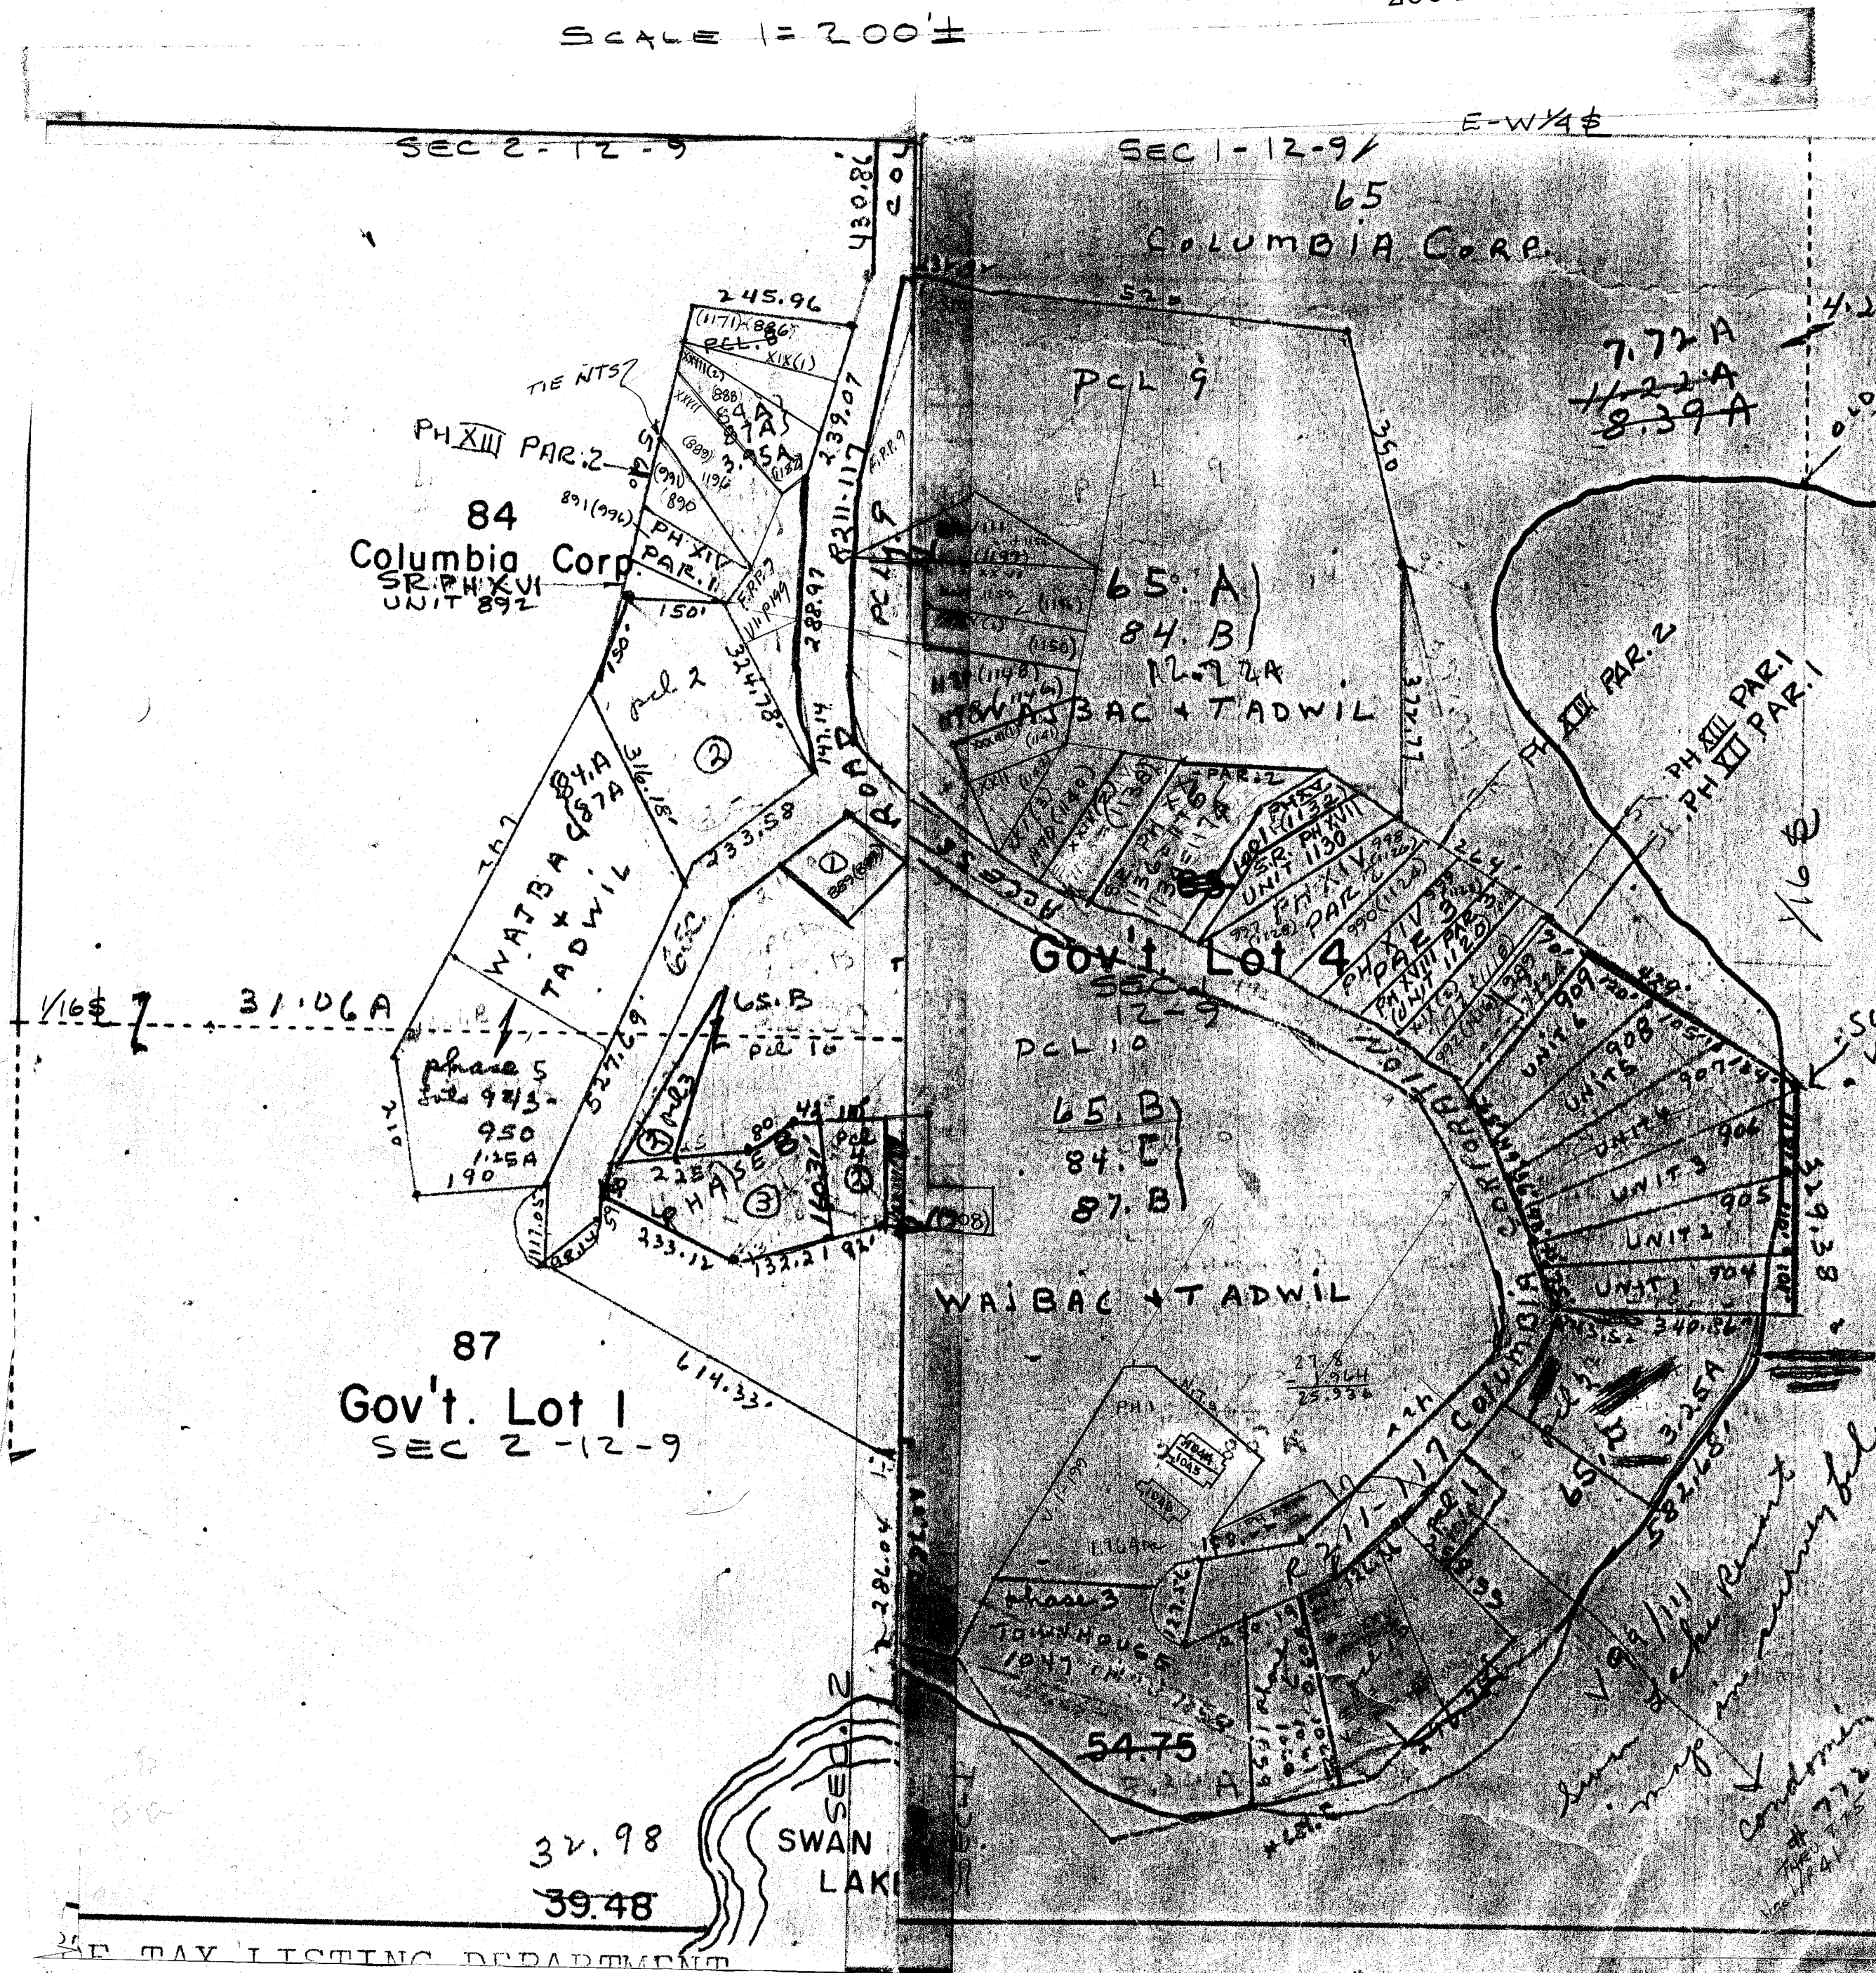
$$S_{CAL} = 1 = 200' \pm$$

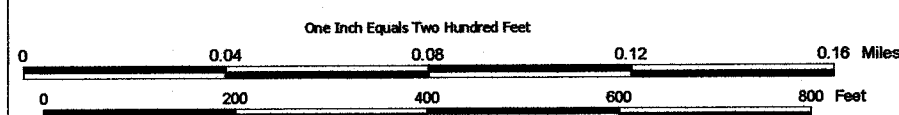


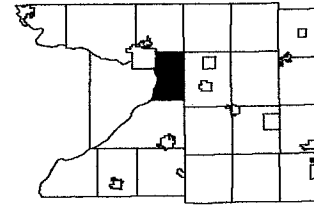
NOTE: This map was prepared for assessment use in accordance with the Wis. St. Stat. Chap. 70.09. All information contained herein is advisory only. Map accuracy is limited to the quality of data obtained from other Public Records. This map is not intended to be a substitute for an actual field survey. Public Land Survey Base is derived from U.S.G.S Topographic maps unless otherwise noted. Other sources of the Land Base may be actual survey data. Base map data is from the April 1995 County Digital Orthophotos and/or U.S.G.S. 1:24,000 scale Topographic series. The user is responsible for the improper use of the data contained herein.

Created by The Columbia County Land Information Office -GIS Section, VMB, July 2004.

TAX PARCEL MAP

TOWN of PACIFIC

TOWN 12 NORTH RANGE 9 EAST
COLUMBIA COUNTY, WISCONSIN



3	2
10	11
15	14
22	23
27	26
33	34

Replaced
2005

-SEE PAGE B-

-SEE SECTION 1-

MEADOW COURT

ADDITIONAL SURVEYS	
CONDO PLAT OF SWAN LAKE VILLAGE GOLF & TENNIS CONDO C	5673
SADDLE RIDGE (UNDEVELOPED SUBDIVISION PLAT)	6556
SRE EXHIBIT C	6562
SWAN LAKE RESORT(UNDEVELOPED)	6541

SURVEY INDEX

THE FOREST AT SWAN LAKE - PHASE 1	S8123
THE FOREST AT SWAN LAKE - PHASE 2	S8440-S8413
THE FOREST AT SWAN LAKE - PHASE 3	S8439
THE FOREST AT SWAN LAKE - AMENDED PHASE 4	S8975
THE FOREST AT SWAN LAKE - PHASE 5	S8976
THE FOREST AT SWAN LAKE - AMENDED PHASE 5	S10663
THE FOREST AT SWAN LAKE - 2ND AMENDMENT TO PHASE 5	S11506
THE FOREST AT SWAN LAKE - PHASE 7	S9812
THE FOREST AT SWAN LAKE - PHASE 8	S9854
THE FOREST AT SWAN LAKE - PHASE 9	S12114
THE FOREST AT SWAN LAKE - AMENDED PHASE 10	S10259
THE FOREST AT SWAN LAKE - PHASE 11	S10700
THE FOREST AT SWAN LAKE - PHASE 12	S10912
THE FOREST AT SWAN LAKE - PHASE 13	S10911
THE FOREST AT SWAN LAKE - PHASE 14	S11149
THE FOREST AT SWAN LAKE - PHASE 15	S12186
THE FOREST AT SWAN LAKE - PHASE 16	S11498
THE FOREST AT SWAN LAKE - PHASE 17	S11503
THE FOREST (OVERVIEW) 11/22/94	S6392

-SEE SECTION 1-


-SEE SECTION 11-

-SEE SECTION 12-

- SADDLE RIDGE

C-

2005

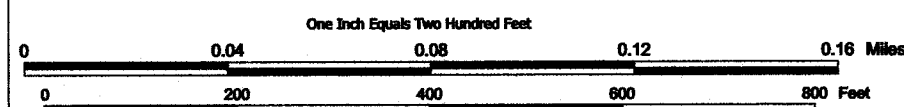


NOTE: This map was prepared for assessment use in accordance with the Wis. Stat. Chap. 70.09. All information contained herein is advisory only. Map accuracy is limited to the quality of data obtained from other Public Records. This map is not intended to be a substitute for an actual field survey. Public Land Survey Base is derived from U.S.G.S. Topographic maps unless otherwise noted. Other sources of the Land Base may be actual survey data. Base map data is from the April 1995 County Digital Orthophotos and/or U.S.G.S. 1:24,000 scale Topographic series. The user is responsible for the improper use of the data contained herein.

Created by The Columbia County Land Information Office -GIS Section, VMB, February 2005.

TAX PARCEL MAP

TOWN of PACIFIC

TOWN 12 NORTH RANGE 9 EAST
COLUMBIA COUNTY, WISCONSIN

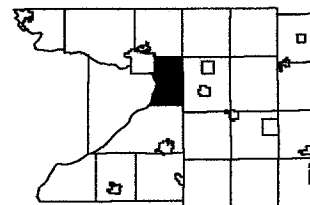

3	2
10	11
15	14
22	23
27	26
33	34

Replaced
2006

-SEE PAGE B-

-SEE SECTION 1-

MEADOW COURT

ADDITIONAL SURVEYS

CONDO PLAT OF SWAN LAKE VILLAGE	GOLF & TENNIS CONDO C	5673
SADDLE RIDGE (UNDEVELOPED SUBDIVISION PLAT)		6556
SRE EXHIBIT C		6562
SWAN LAKE RESORT(UNDEVELOPED)		6541

SURVEY INDEX

THE FOREST AT SWAN LAKE - PHASE 1	S8123
THE FOREST AT SWAN LAKE - PHASE 2	S8440-S8413
THE FOREST AT SWAN LAKE - PHASE 3	S8439
THE FOREST AT SWAN LAKE - AMENDED PHASE 4	S8975
THE FOREST AT SWAN LAKE - PHASE 5	S8976
THE FOREST AT SWAN LAKE - AMENDED PHASE 5	S10663
THE FOREST AT SWAN LAKE - 2ND AMENDMENT TO PHASE 5	S11506 ~ 512540 (raised)
THE FOREST AT SWAN LAKE - AMENDED PHASE 6	S11636
THE FOREST AT SWAN LAKE - PHASE 7	S9812
THE FOREST AT SWAN LAKE - PHASE 8	S9854
THE FOREST AT SWAN LAKE - PHASE 9	S12114
THE FOREST AT SWAN LAKE - AMENDED PHASE 10	S10259
THE FOREST AT SWAN LAKE - PHASE 11	S10700
THE FOREST AT SWAN LAKE - PHASE 12	S10912
THE FOREST AT SWAN LAKE - PHASE 13	S10811
THE FOREST AT SWAN LAKE - PHASE 14	S11149
THE FOREST AT SWAN LAKE - PHASE 15	S12186
THE FOREST AT SWAN LAKE - PHASE 16	S11498
THE FOREST AT SWAN LAKE - PHASE 17 (Amended 5/25/39)	S11503
THE FOREST (OVERVIEW) 11/22/94	S6392
SADDLE RIDGE - AMENDED PHASE XXI	S11634
SADDLE RIDGE - AMENDED PHASE XXV	S11635

-SEE SECTION 1-

-SEE SECTION 11-

-SEE SECTION 12-

- SADDLE RIDGE C -

SEC. 1 T.12N. R.9E.

LAKE SIDE PARK

Replaced
2004

(P)
5673

FUTURE PHASE

CM ST P P P R R

SW. 1/4 Sec. 1, T. 12 N., R. 9 E., CONDO C

781

RAILROAD STREET Northshore Dr

NORTH SHORE DR

LAKE STREET

SWAN LAKE

SCALE 1"=100'

41.A
Mrs. Jessie Watson
JAMES WATSON
BLOCK "D"

41.2
DEBRA JO WATSON

41.3
W. M. KAYHART


Lot 1
53.1


John Abell

Lot 2
53.2

55
Leon Veith

55.B
Clayton Dumke

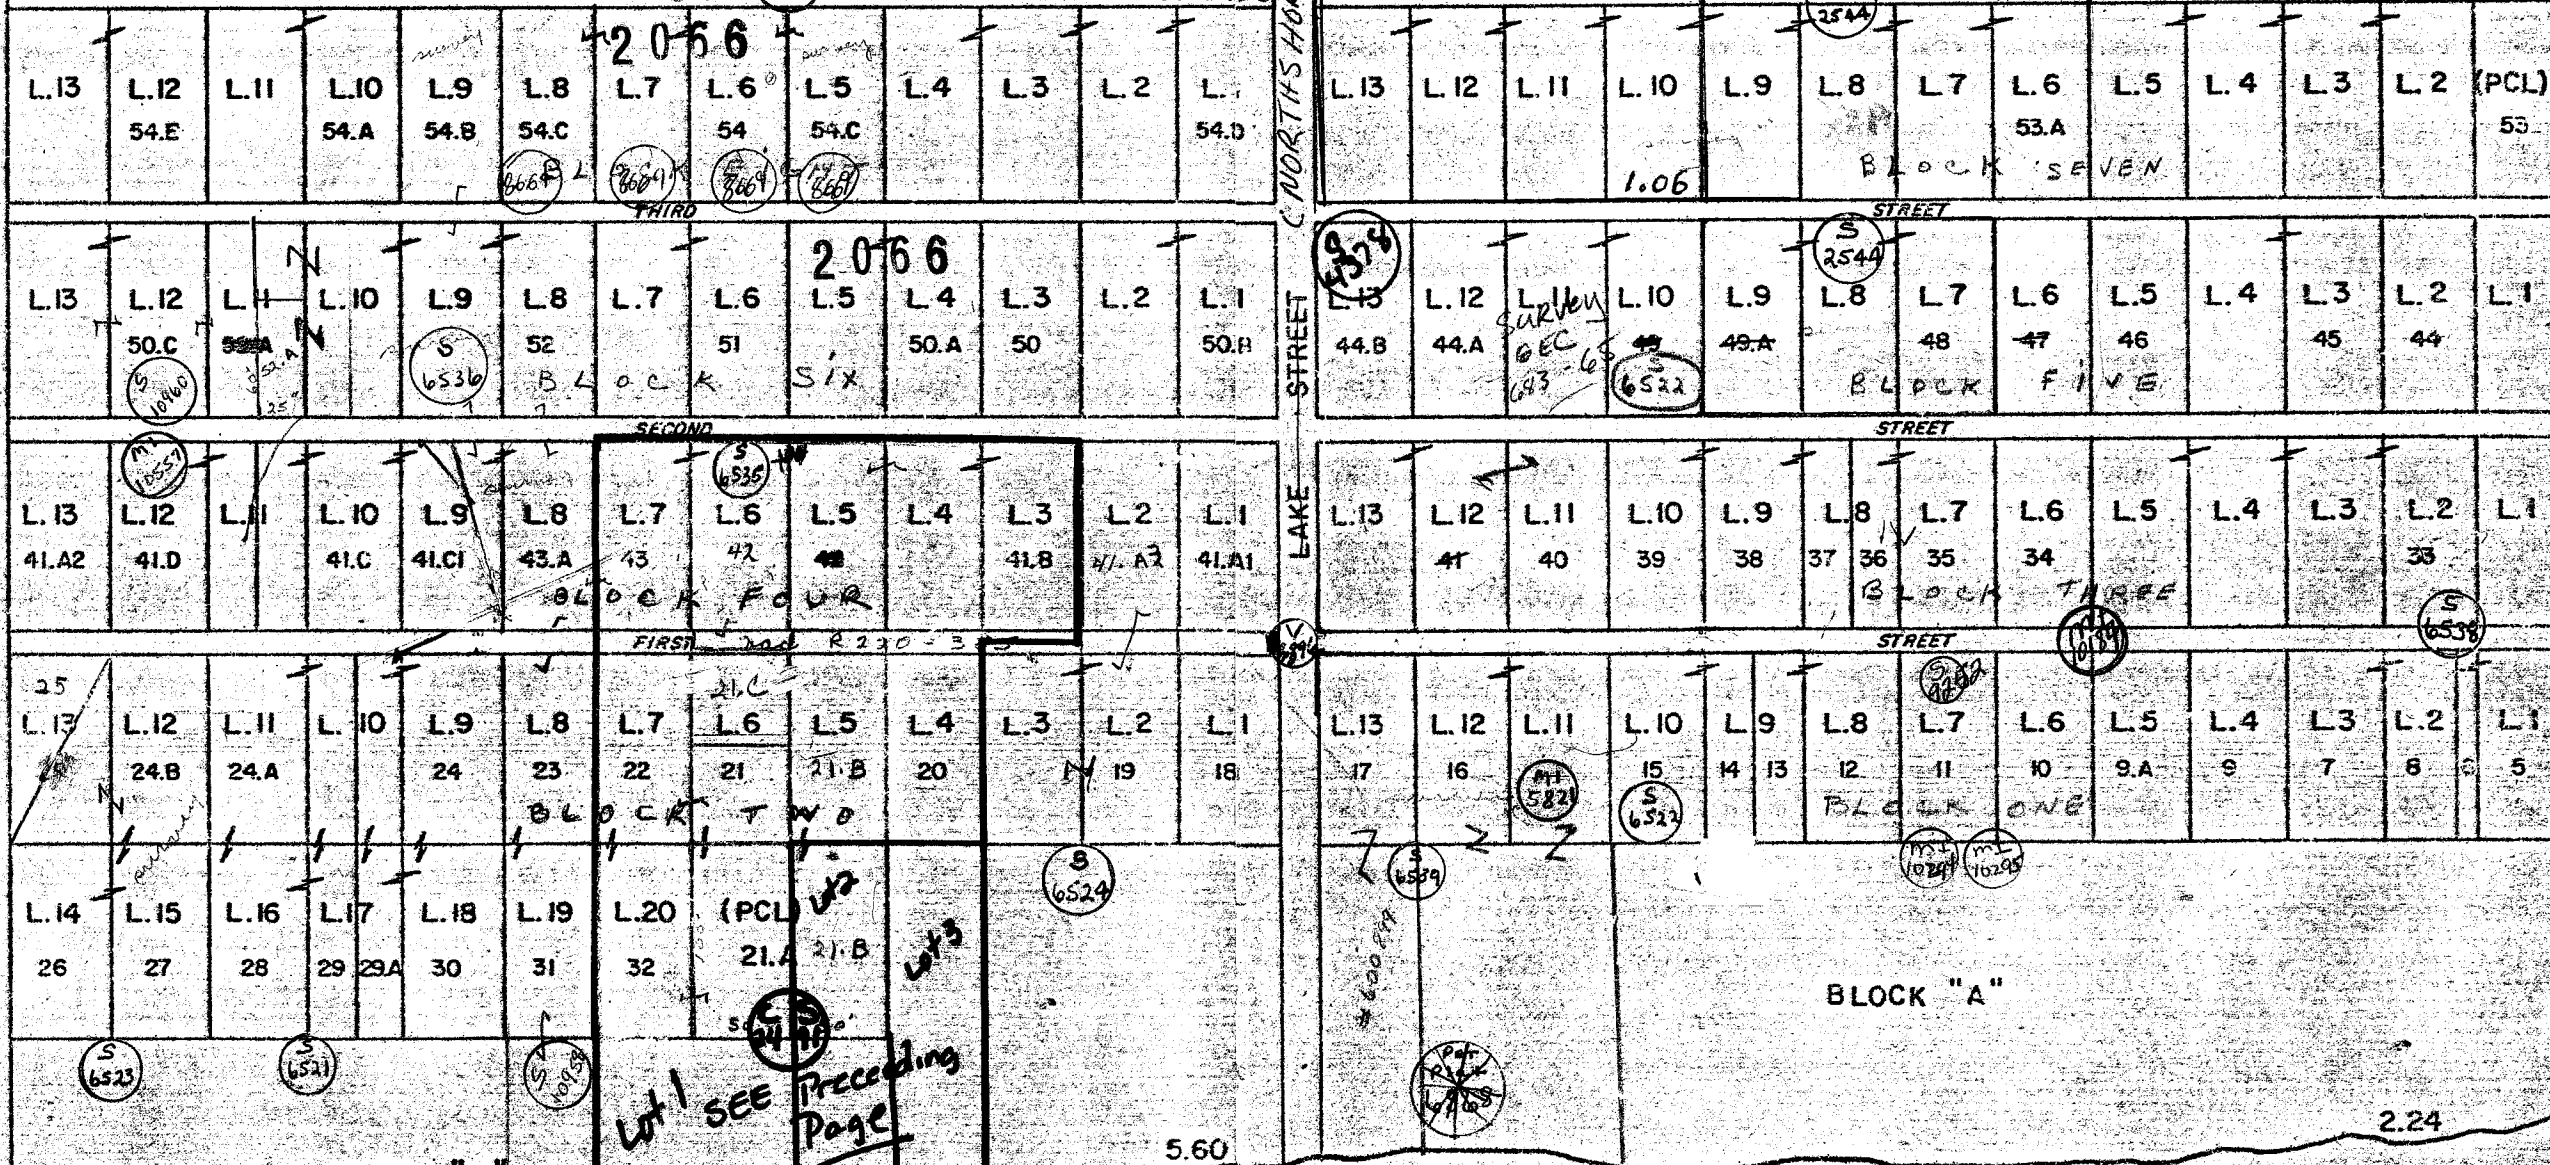

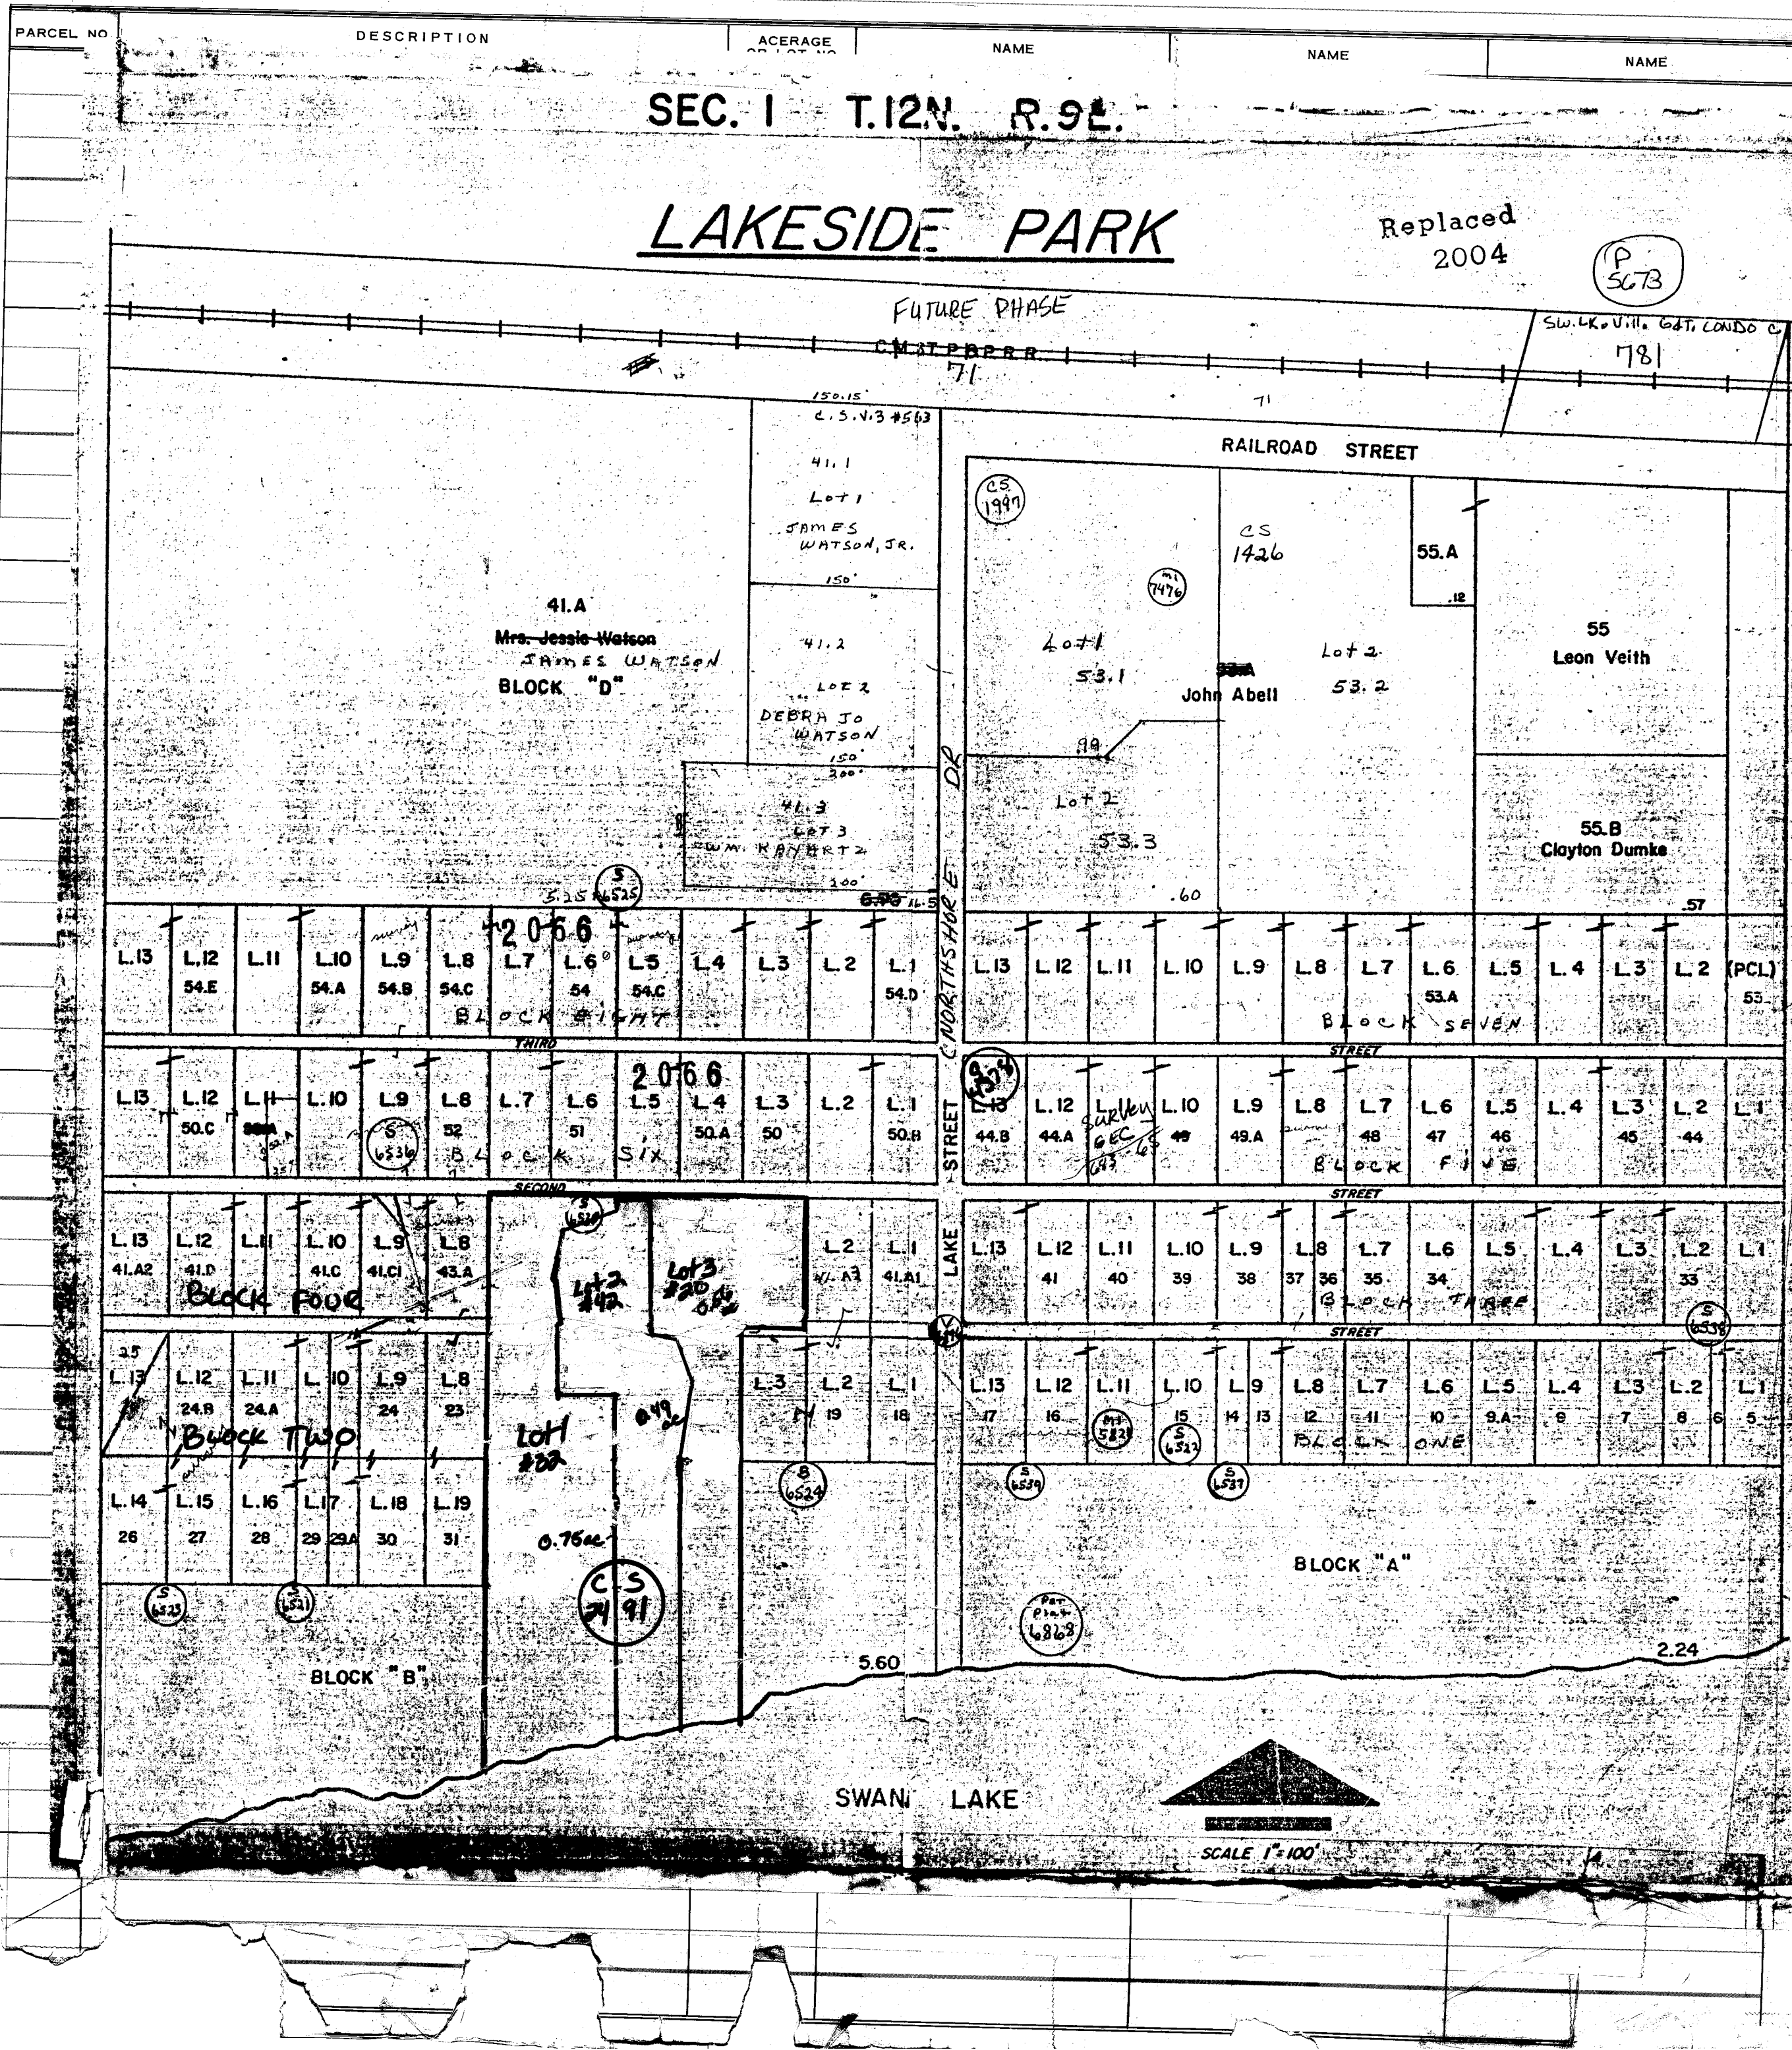

H.C. Miller Company
Mapmakers & Surveyors
Chicago, Illinois

One Inch Equals Two Hundred Feet

0 0.04 0.08 0.12 0.16 Miles

0 200 400 600 800 Feet

NOTE: This map was prepared for assessment use in accordance with the Wis. St. Stat. Chap. 70.09. All information contained herein is advisory only. Map accuracy is limited to the quality of data obtained from other Public Records. This map is not intended to be a substitute for an actual field survey. Public Land Survey Base is derived from U.S.G.S Topographic maps unless otherwise noted. Other sources of the Land Base may be actual survey data. Base map data is from the April 1995 County Digital Orthophotos and/or U.S.G.S. 1:24,000 scale Topographic series. The user is responsible for the improper use of the data contained herein.

Created by The Columbia County Land Information Office -GIS Section. VMB. July 2004.


TAX PARCEL MAP

TOWN of PACIFIC

TOWN 12 NORTH RANGE 9 EAST
COLUMBIA COUNTY, WISCONSIN

3	2
10	11
15	14
22	23
27	26
33	34

Replaced
2 05

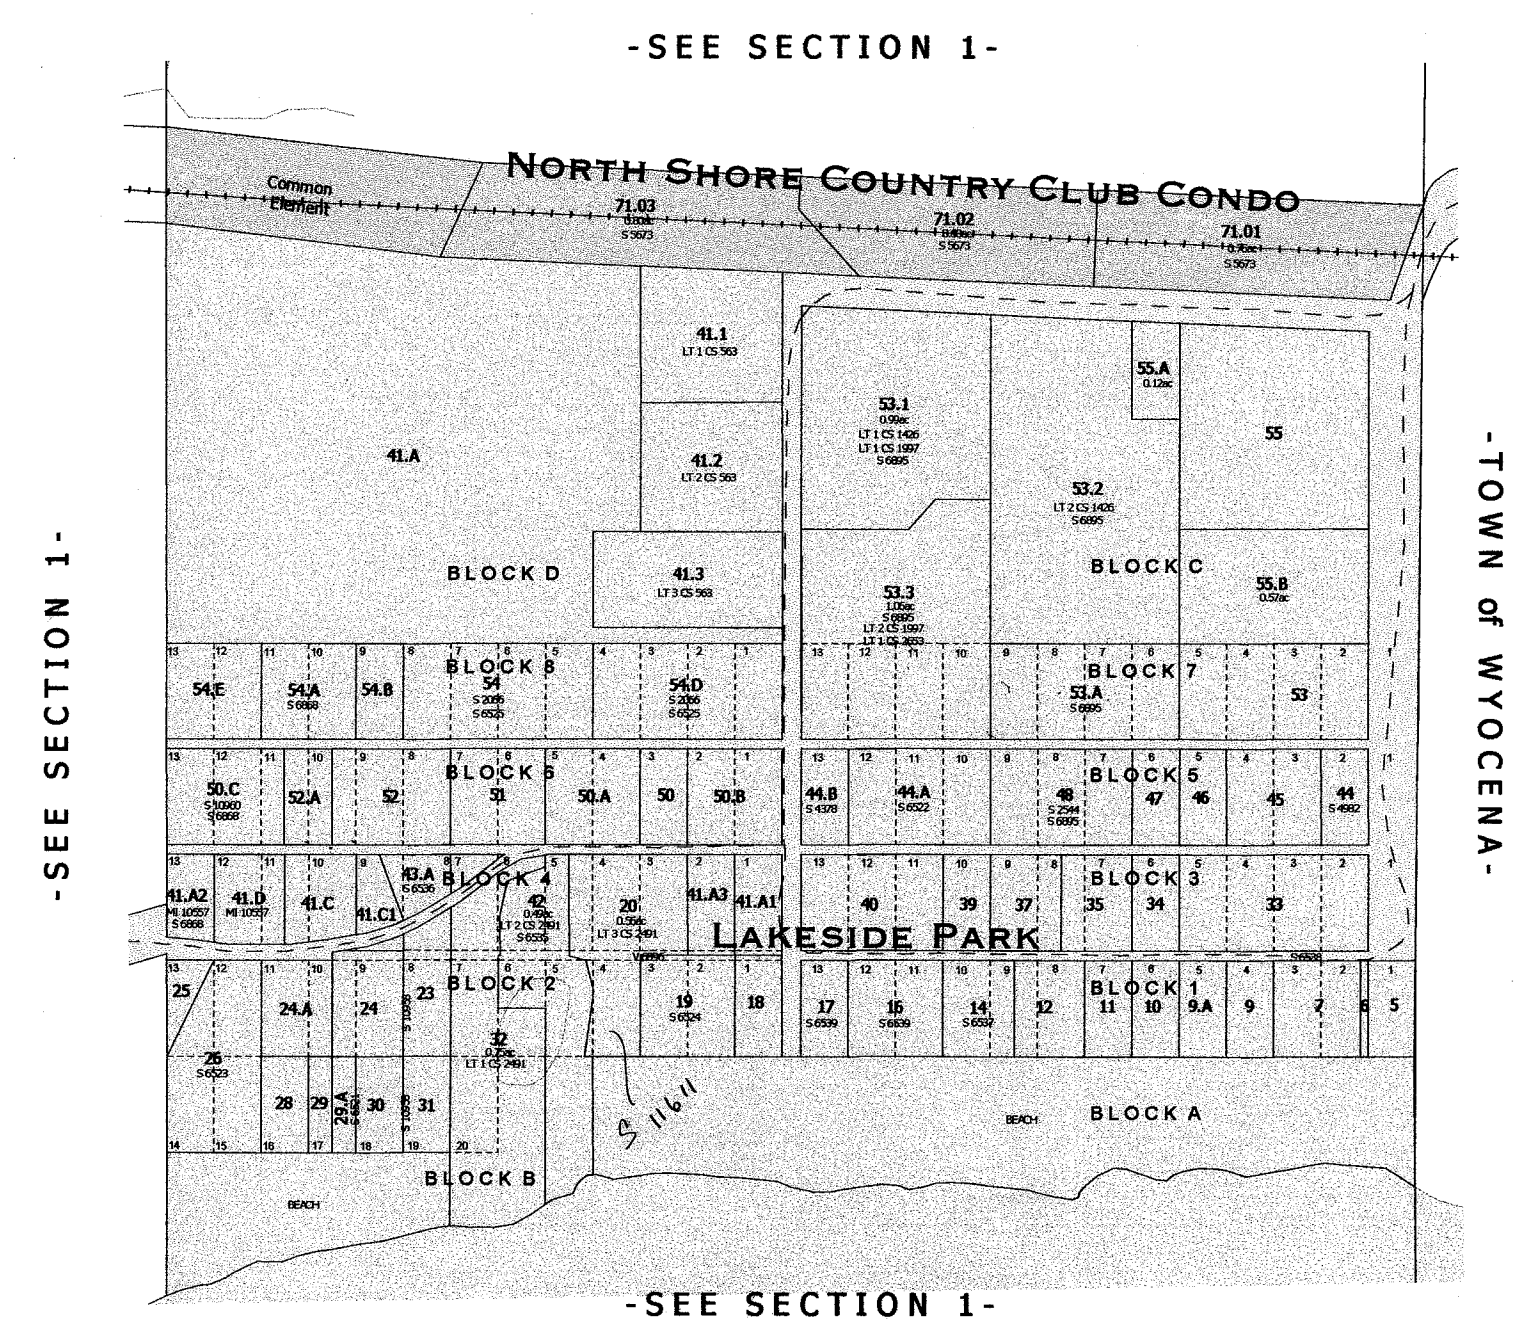


SURVEY INDEX


LAKEVIEW PARK ELEVATIONS	6926
NORTH SHORE COUNTRY CLUB	8957

① phase 10 - model unit 899 fuel# 889
② phase 11 - amended unit 893 - 898 903-907 190-793 #915 thru 928
③ phase 8 - unit 900 thru 904 fuel# 878-882 Amended

Replaced
2004

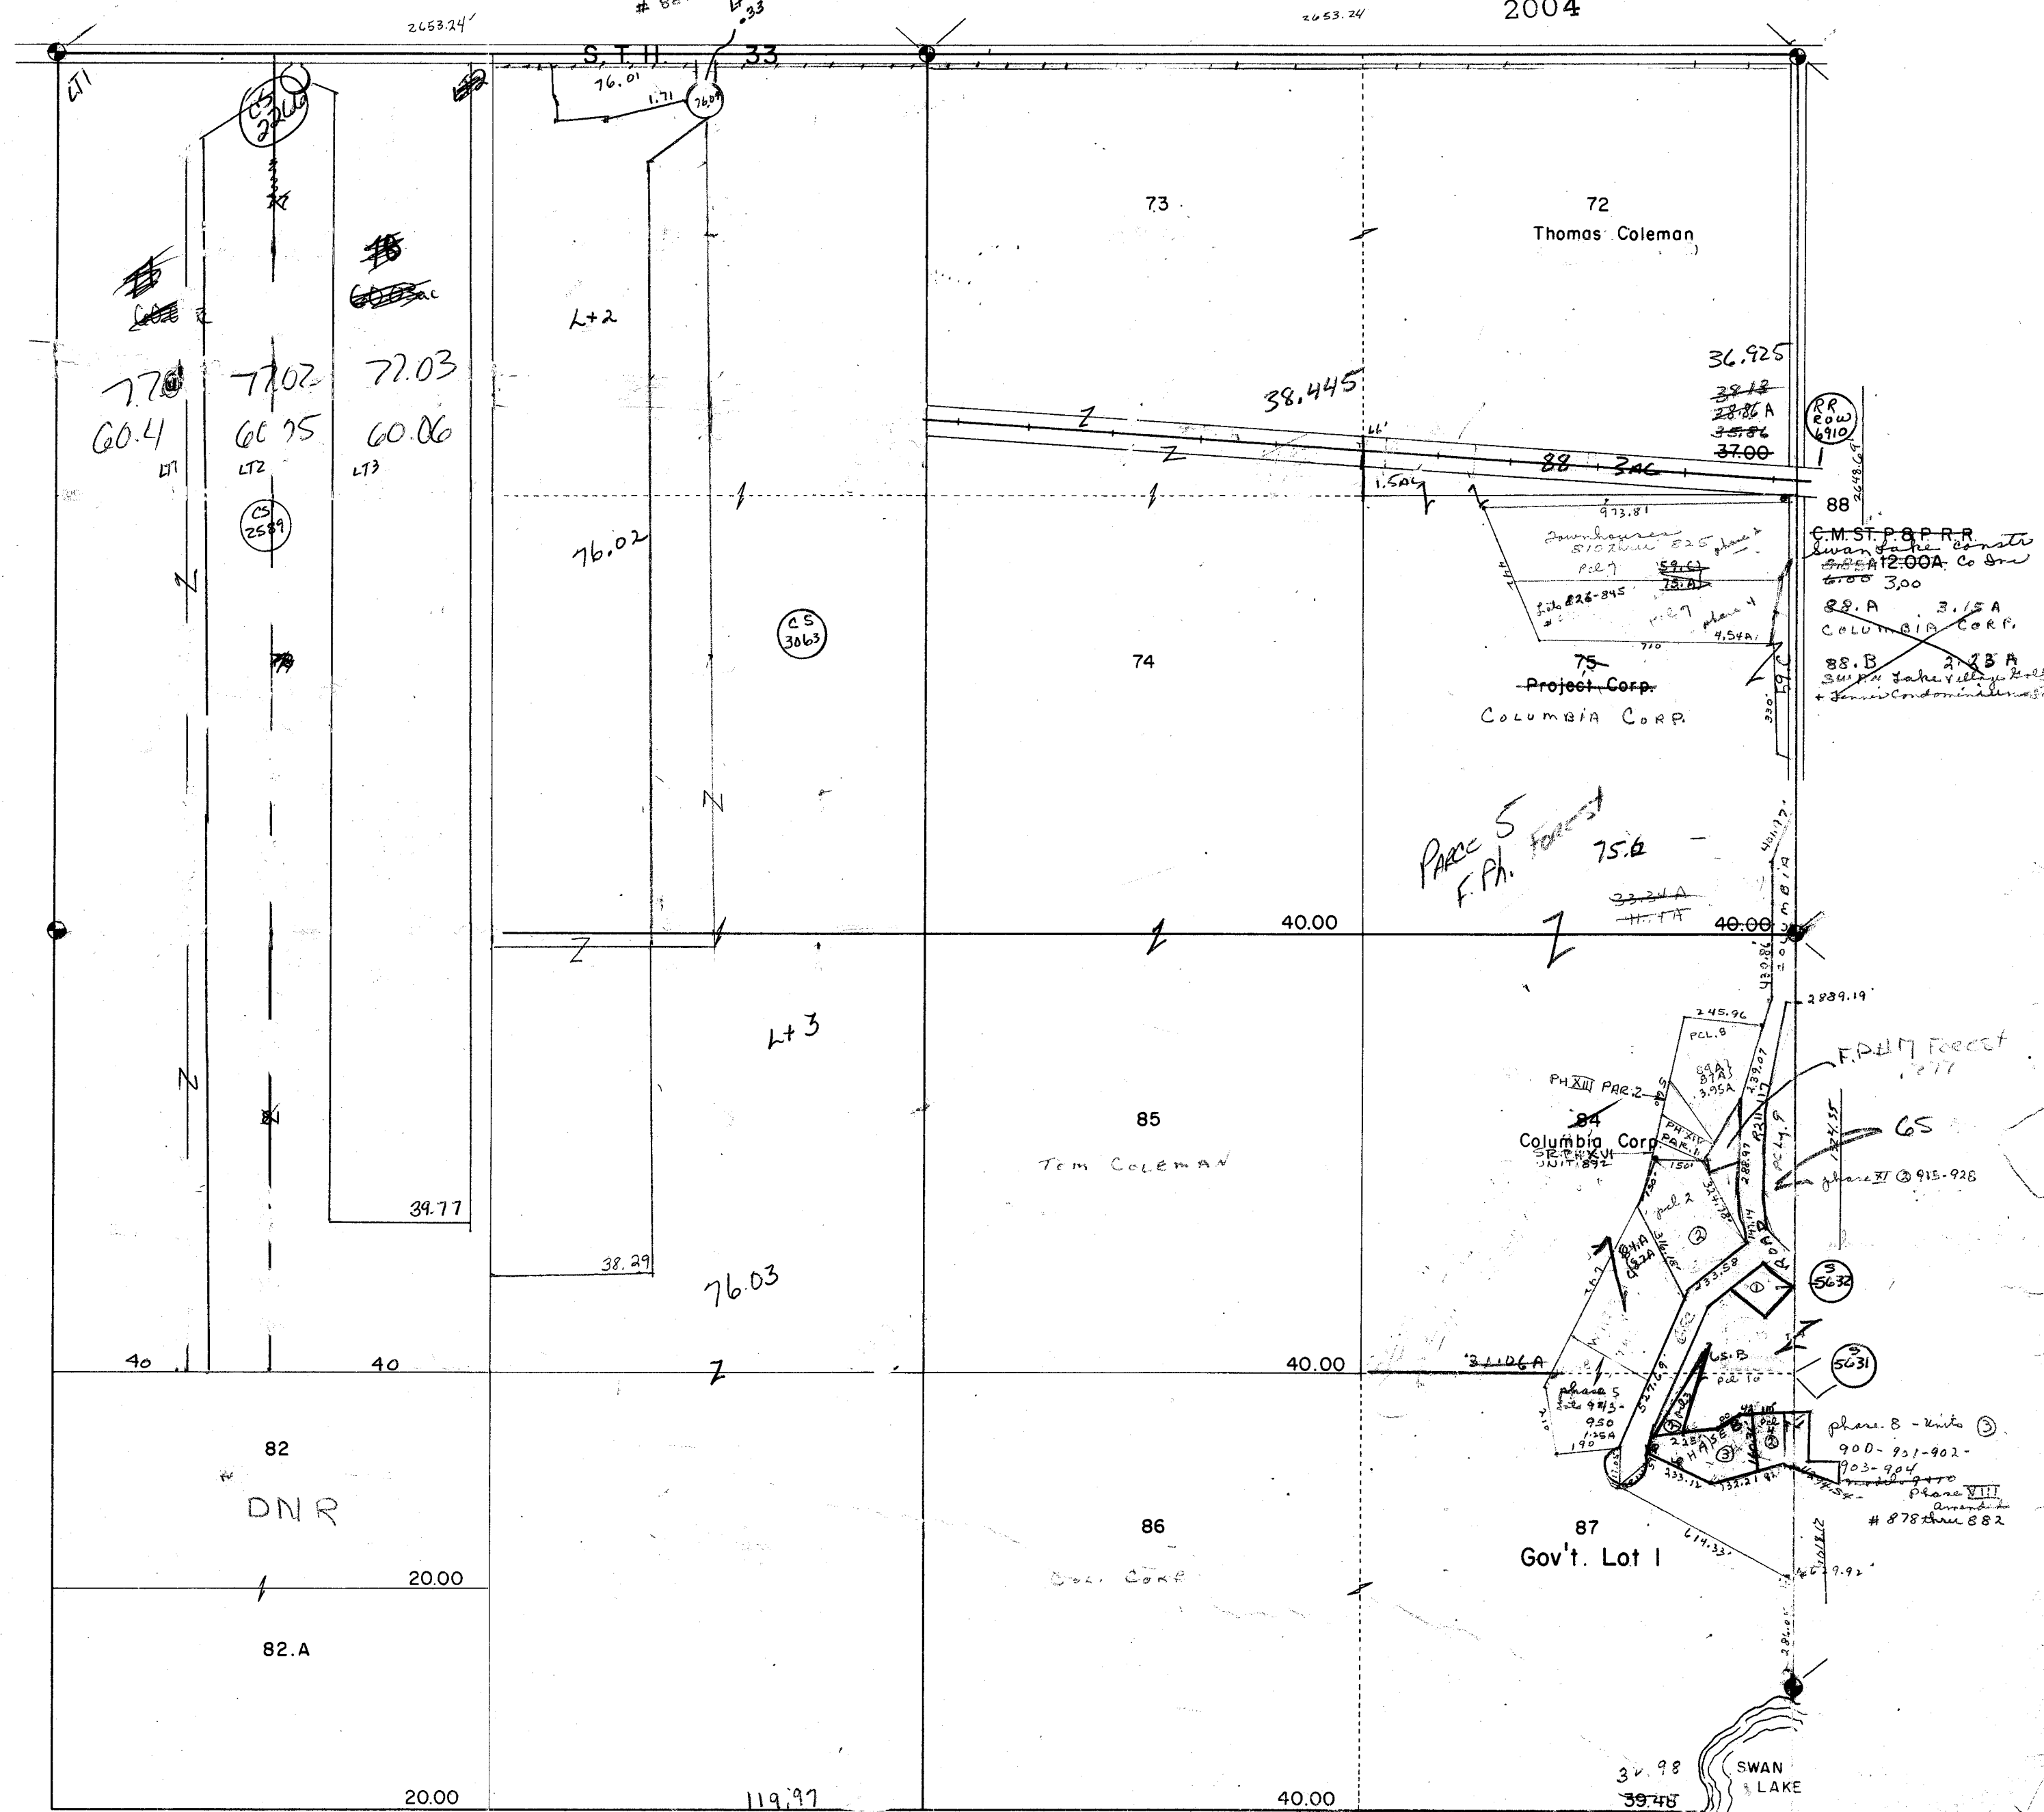

PROPERTY OF TAX LISTING DEPARTMENT

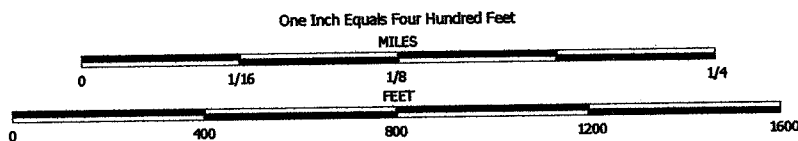


NOTE: This map was prepared for assessment use in accordance with the Wis. Stat. Chap. 70.09. All information contained herein is advisory only. Map accuracy is limited to the quality of data obtained from other Public Records. This map is not intended to be a substitute for an actual field survey. Public Land Survey Base is derived from U.S.G.S. Topographic maps unless otherwise noted. Other sources of the Land Base may be actual survey data. Base map data is from the April 1995 County Digital Orthophotos and/or U.S.G.S. 1:24,000 scale Topographic series. The user is responsible for the proper use of the data contained herein.

Created by The Columbia County Land Information Office -GIS Section. VMS. July 2004.

TAX PARCEL MAP

TOWN of PACIFIC

TOWN 12 NORTH RANGE 9 EAST
COLUMBIA COUNTY, WISCONSIN

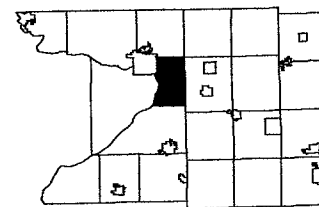

3	4	1
10	11	12
15	14	13
22	23	24
29	27	26
33	34	35

Replaced
2006



-SEE SECTION 3-

-SEE SECTION 1-

-SEE SECTION 11-


FOR DETAILED MAP OF SUBDIVISIONS, SEE THE PREVIOUS PAGES.

Replaced
-SECTION 2-
2006

PACIFIC

SEC. 3 T.12N. R.9E.

Replaced
2004

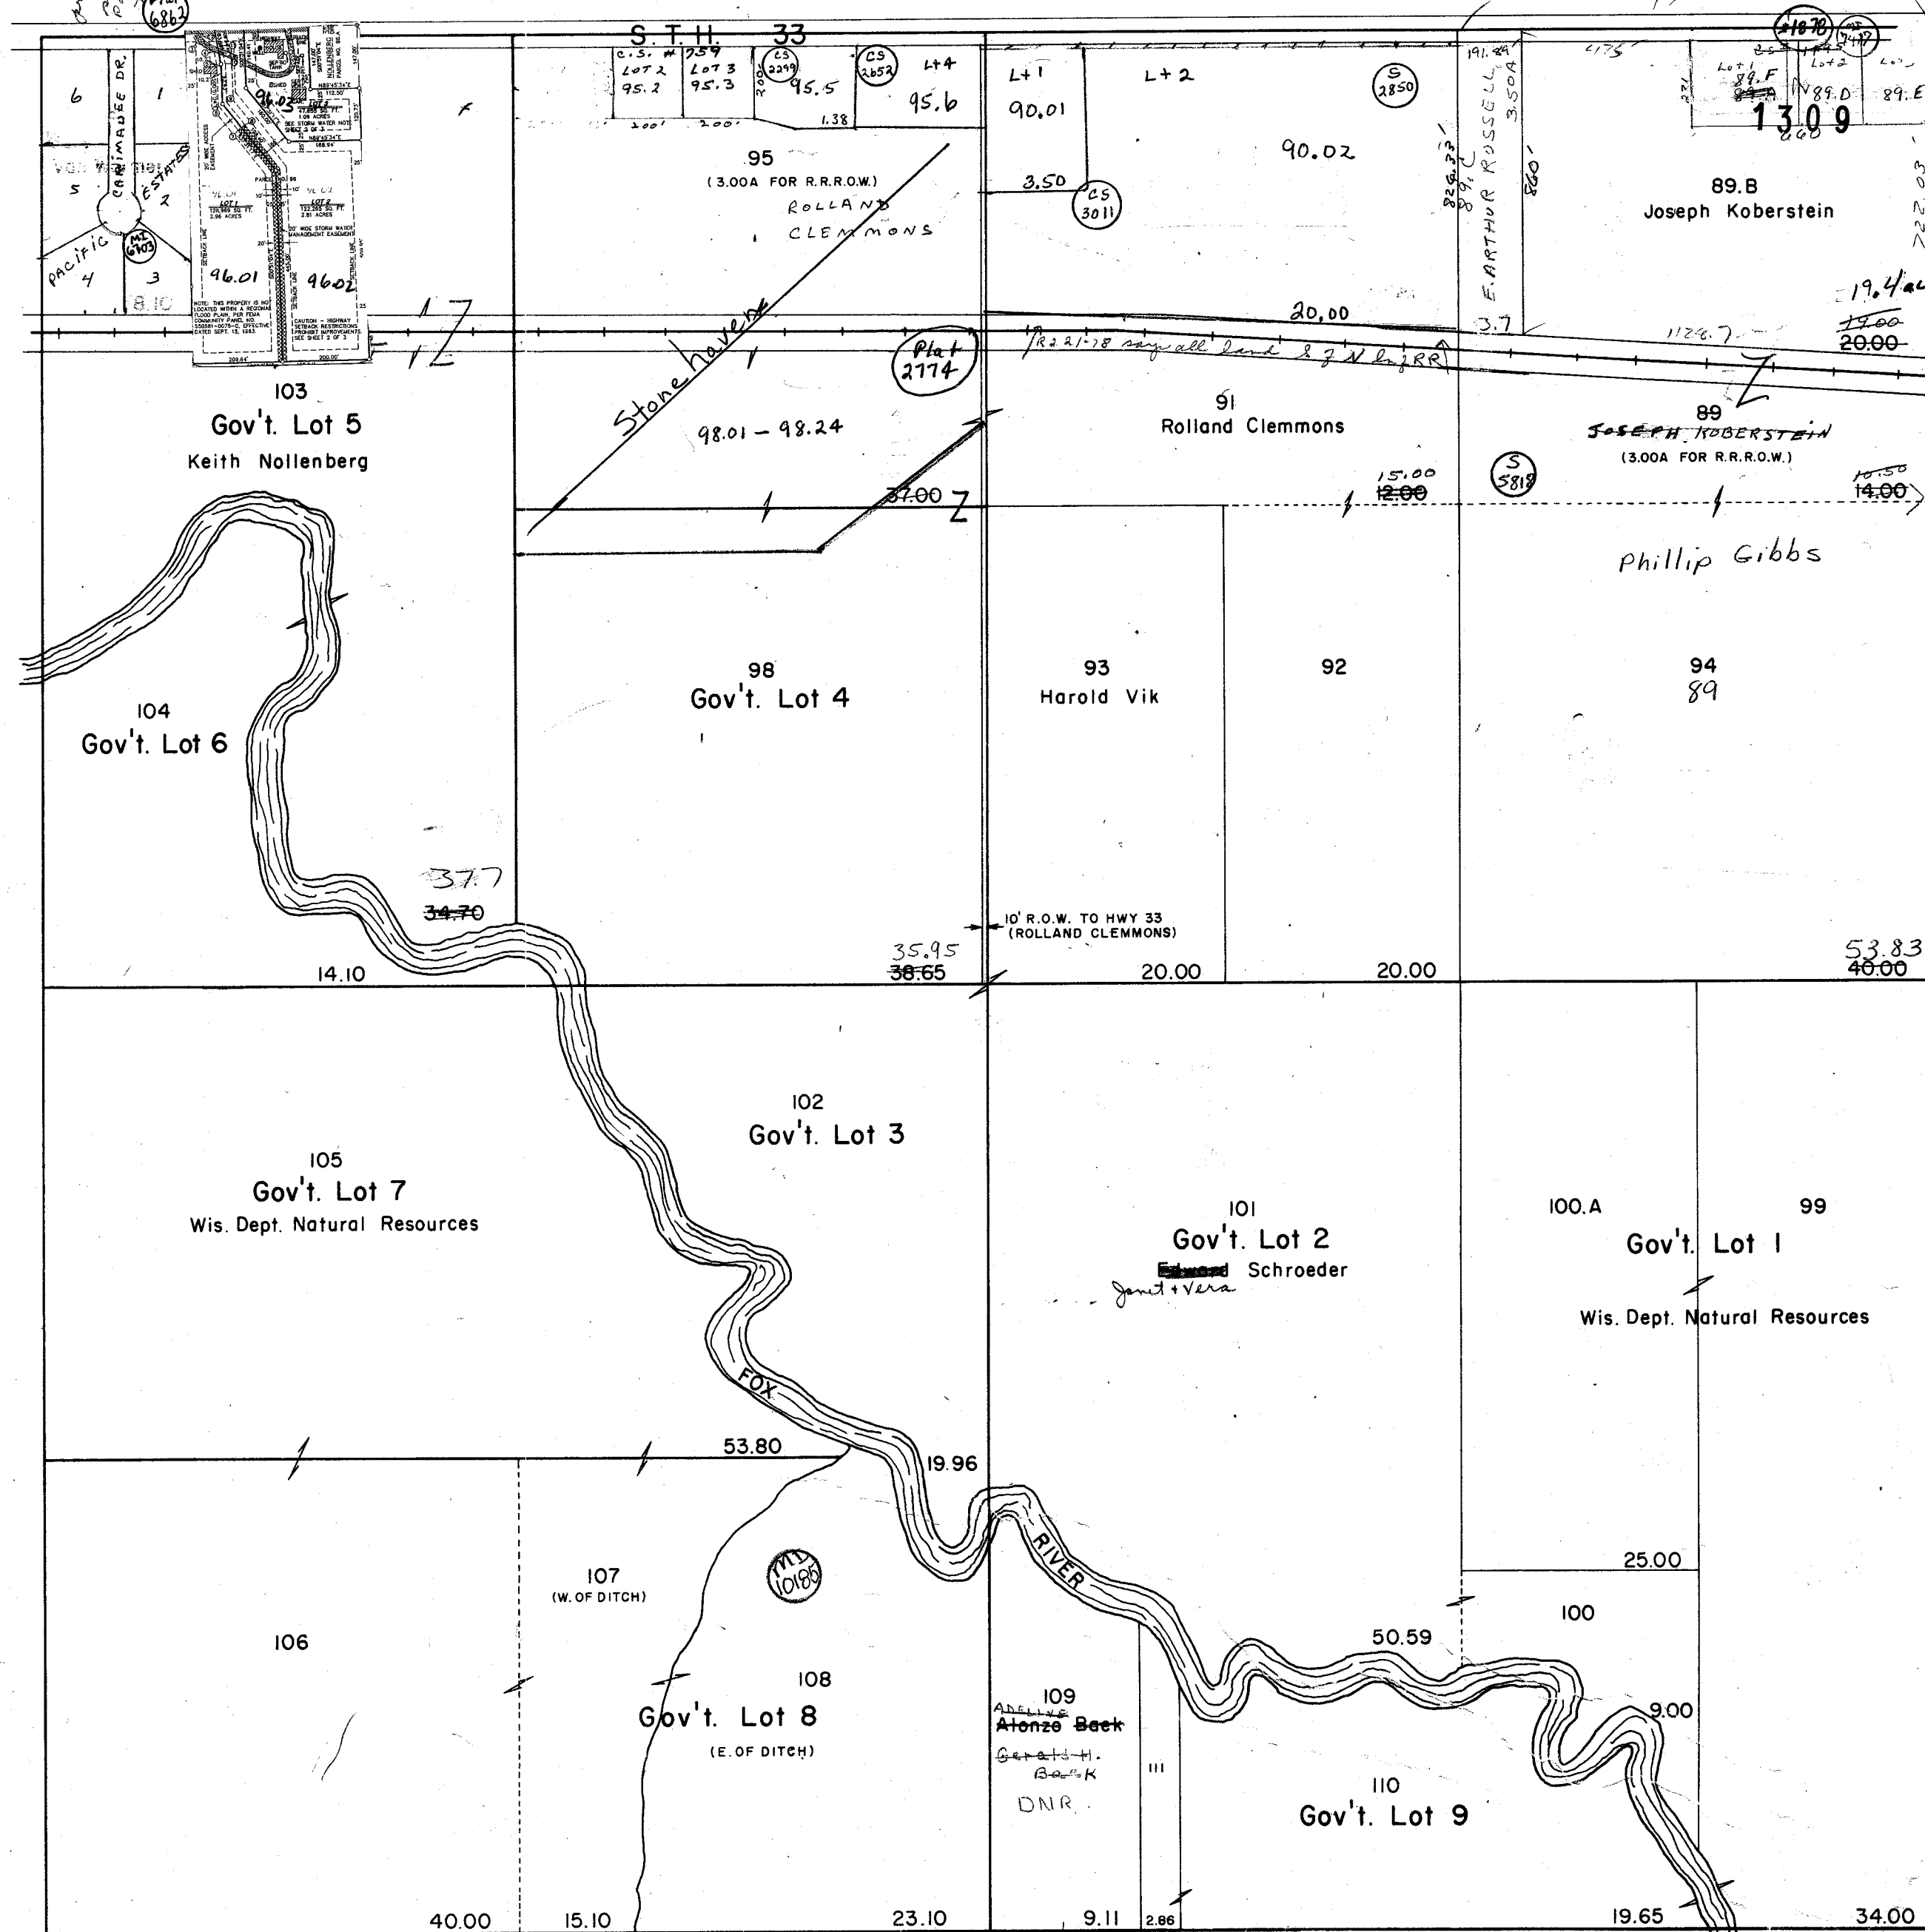


PROPERTY OF TAX LISTING DEPARTMENT

One Inch Equals Four Hundred Feet
MILES
0 1/16 1/8 1/4
FEET
0 400 800 1200 1600

NOTE: This map was prepared for assessment use in accordance with the Wis. St. Stat. Chap. 70.09. All information contained herein is advisory only. Map accuracy is limited to the quality of data obtained from other Public Records. This map is not intended to be a substitute for an actual field survey. Public Land Survey Base is derived from U.S.G.S Topographic maps unless otherwise noted. Other sources of the Land Base may be actual survey data. Base map data is from the April 1995 County Digital Orthophotos and/or U.S.G.S. 1:24,000 scale Topographic series. The user is responsible for the improper use of the data contained herein.


Created by The Columbia County Land Information Office -GIS Section. VNB, July 2004.

TAX PARCEL MAP
TOWN of PACIFIC
TOWN 12 NORTH RANGE 9 EAST
COLUMBIA COUNTY, WISCONSIN

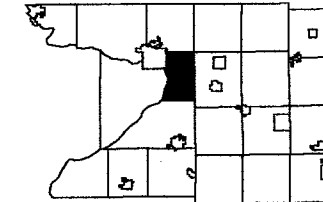

		2	1
	10	11	12
	15	14	13
	22	23	24
	27	28	25
33	34	35	36

Replaced
2006

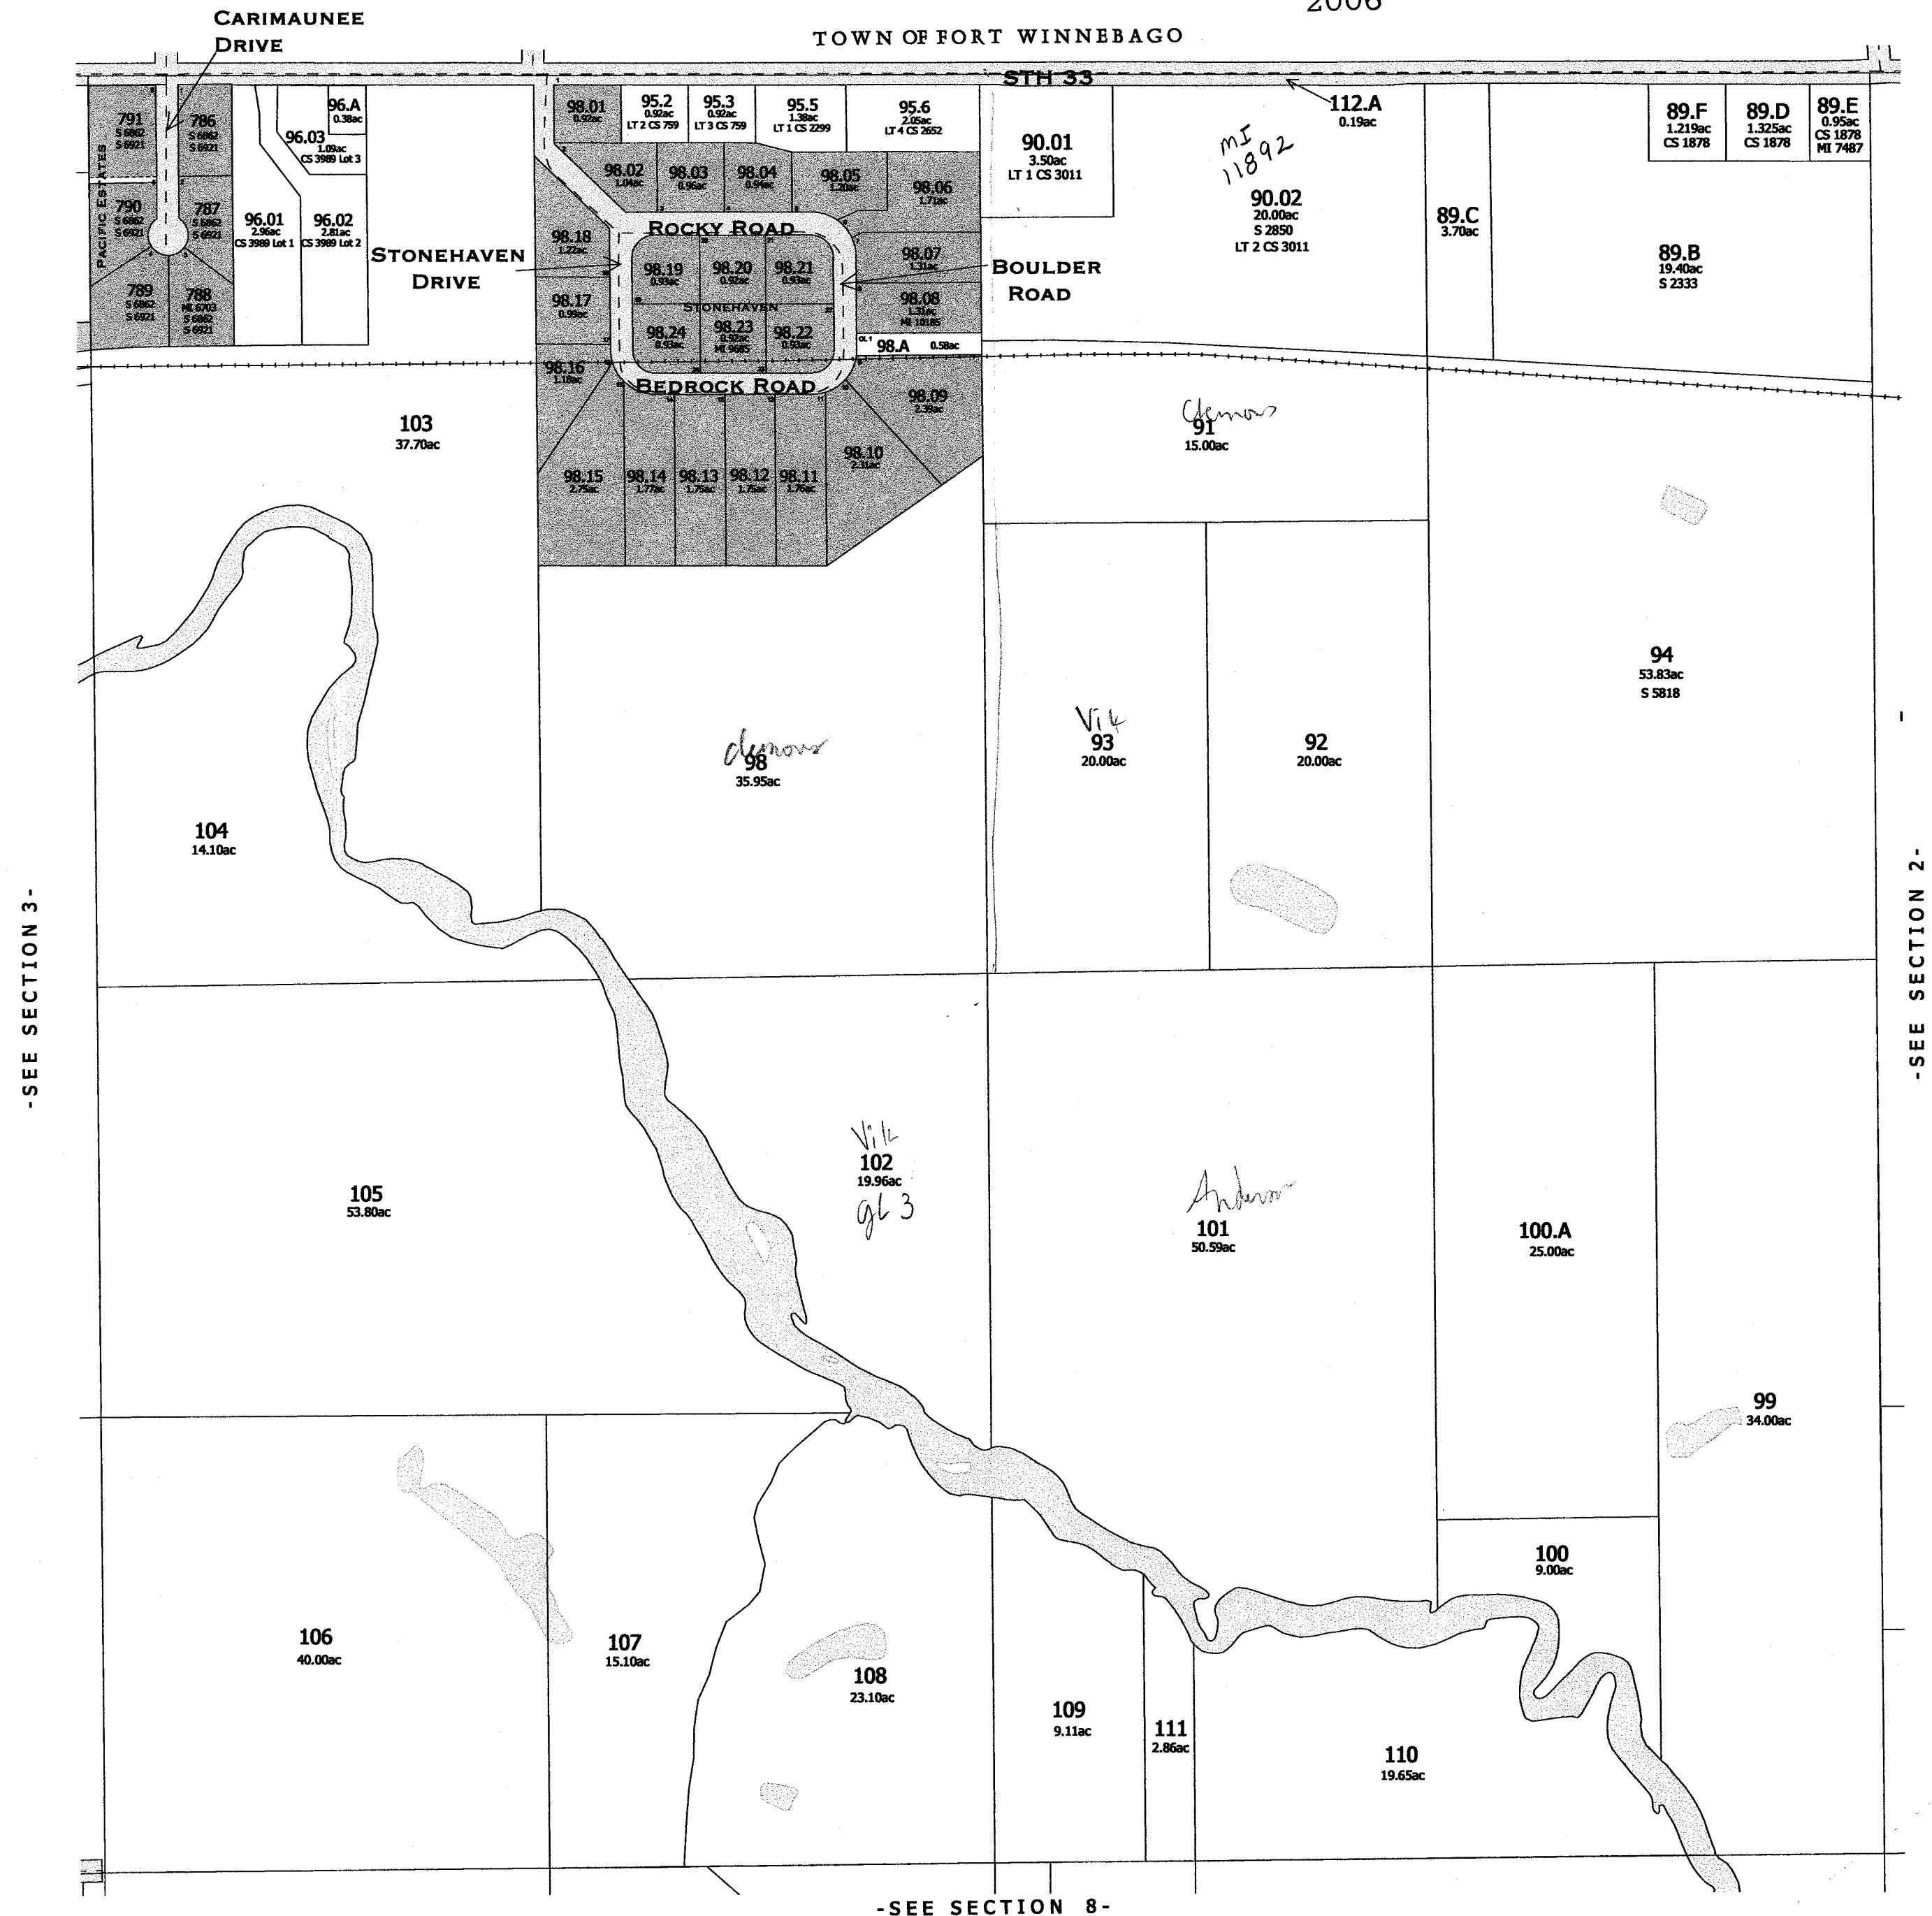

One Inch Equals Four Hundred Feet
 MILES
 0 1/16 1/8 1/4
 FEET
 0 400 800 1200 1600


NOTE: This map was prepared for assessment use in accordance with the Wis. St. Stat. Chap. 70.00. All information contained herein is advisory only. Map accuracy is limited to the quality of data obtained from other Public Records. This map is not intended to be a substitute for an actual field survey. Public Land Survey Base is derived from U.S.G.S. Topographic maps unless otherwise noted. Other sources of the Land Base may be actual survey data. Base map data is from the April 1995 County Digital Orthophotos and/or U.S.G.S. 1:24,000 scale Topographic series. The user is responsible for the improper use of the data contained herein.

Created by The Columbia County Land Information Office -GIS Section. VMB, February 2006.


TOWN of PACIFIC

TOWN 12 NORTH RANGE 9 EAST
 COLUMBIA COUNTY, WISCONSIN

Replaced
 2007

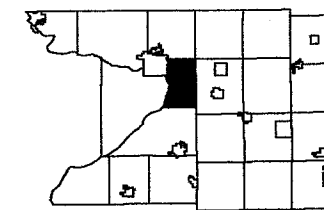

		2	1
10	11	12	
15	14	13	
22	23	24	
29	27	26	25
33	34	35	36

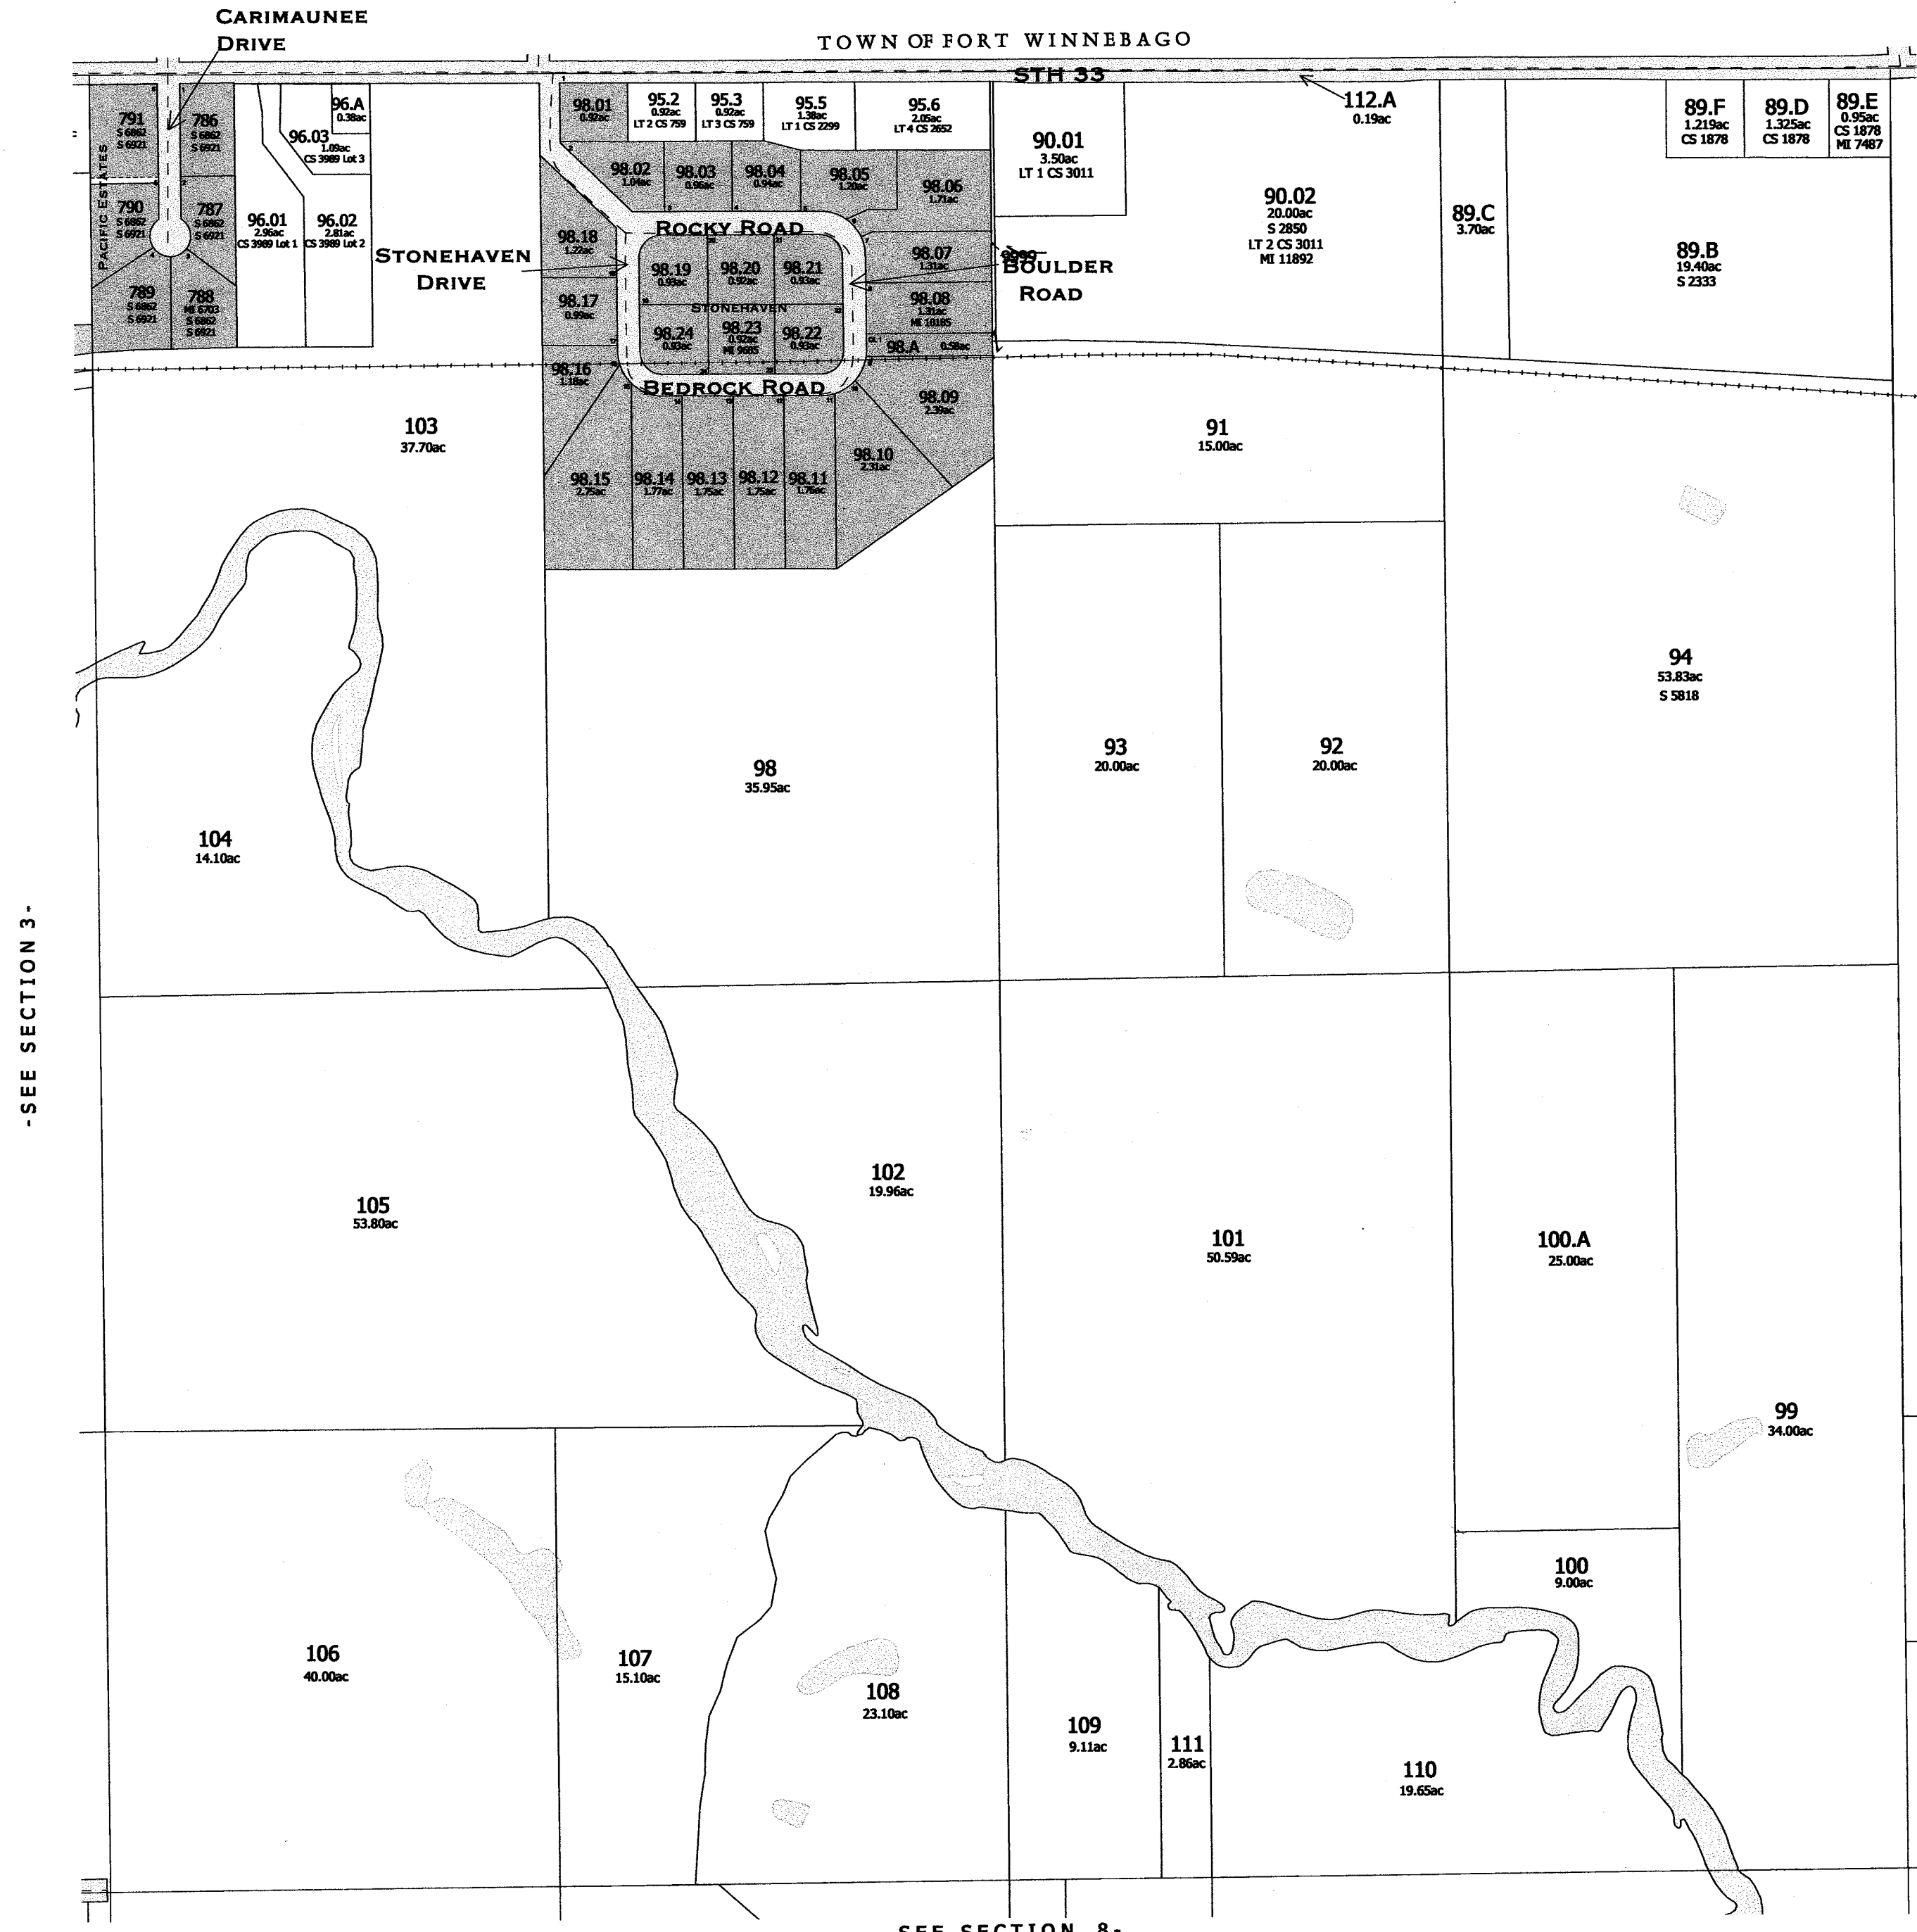

-SEE SECTION 3-

-SEE SECTION 2-

-SEE SECTION 8-


PACIFIC ESTATES	S6862
STONEHAVEN	S2774

Replaced
 2007

-SECTION 3-

Replaced
2004

NOTE: PRINTS MADE FROM THIS, MAY NOT AGREE WITH THE RECORDED DOCUMENT

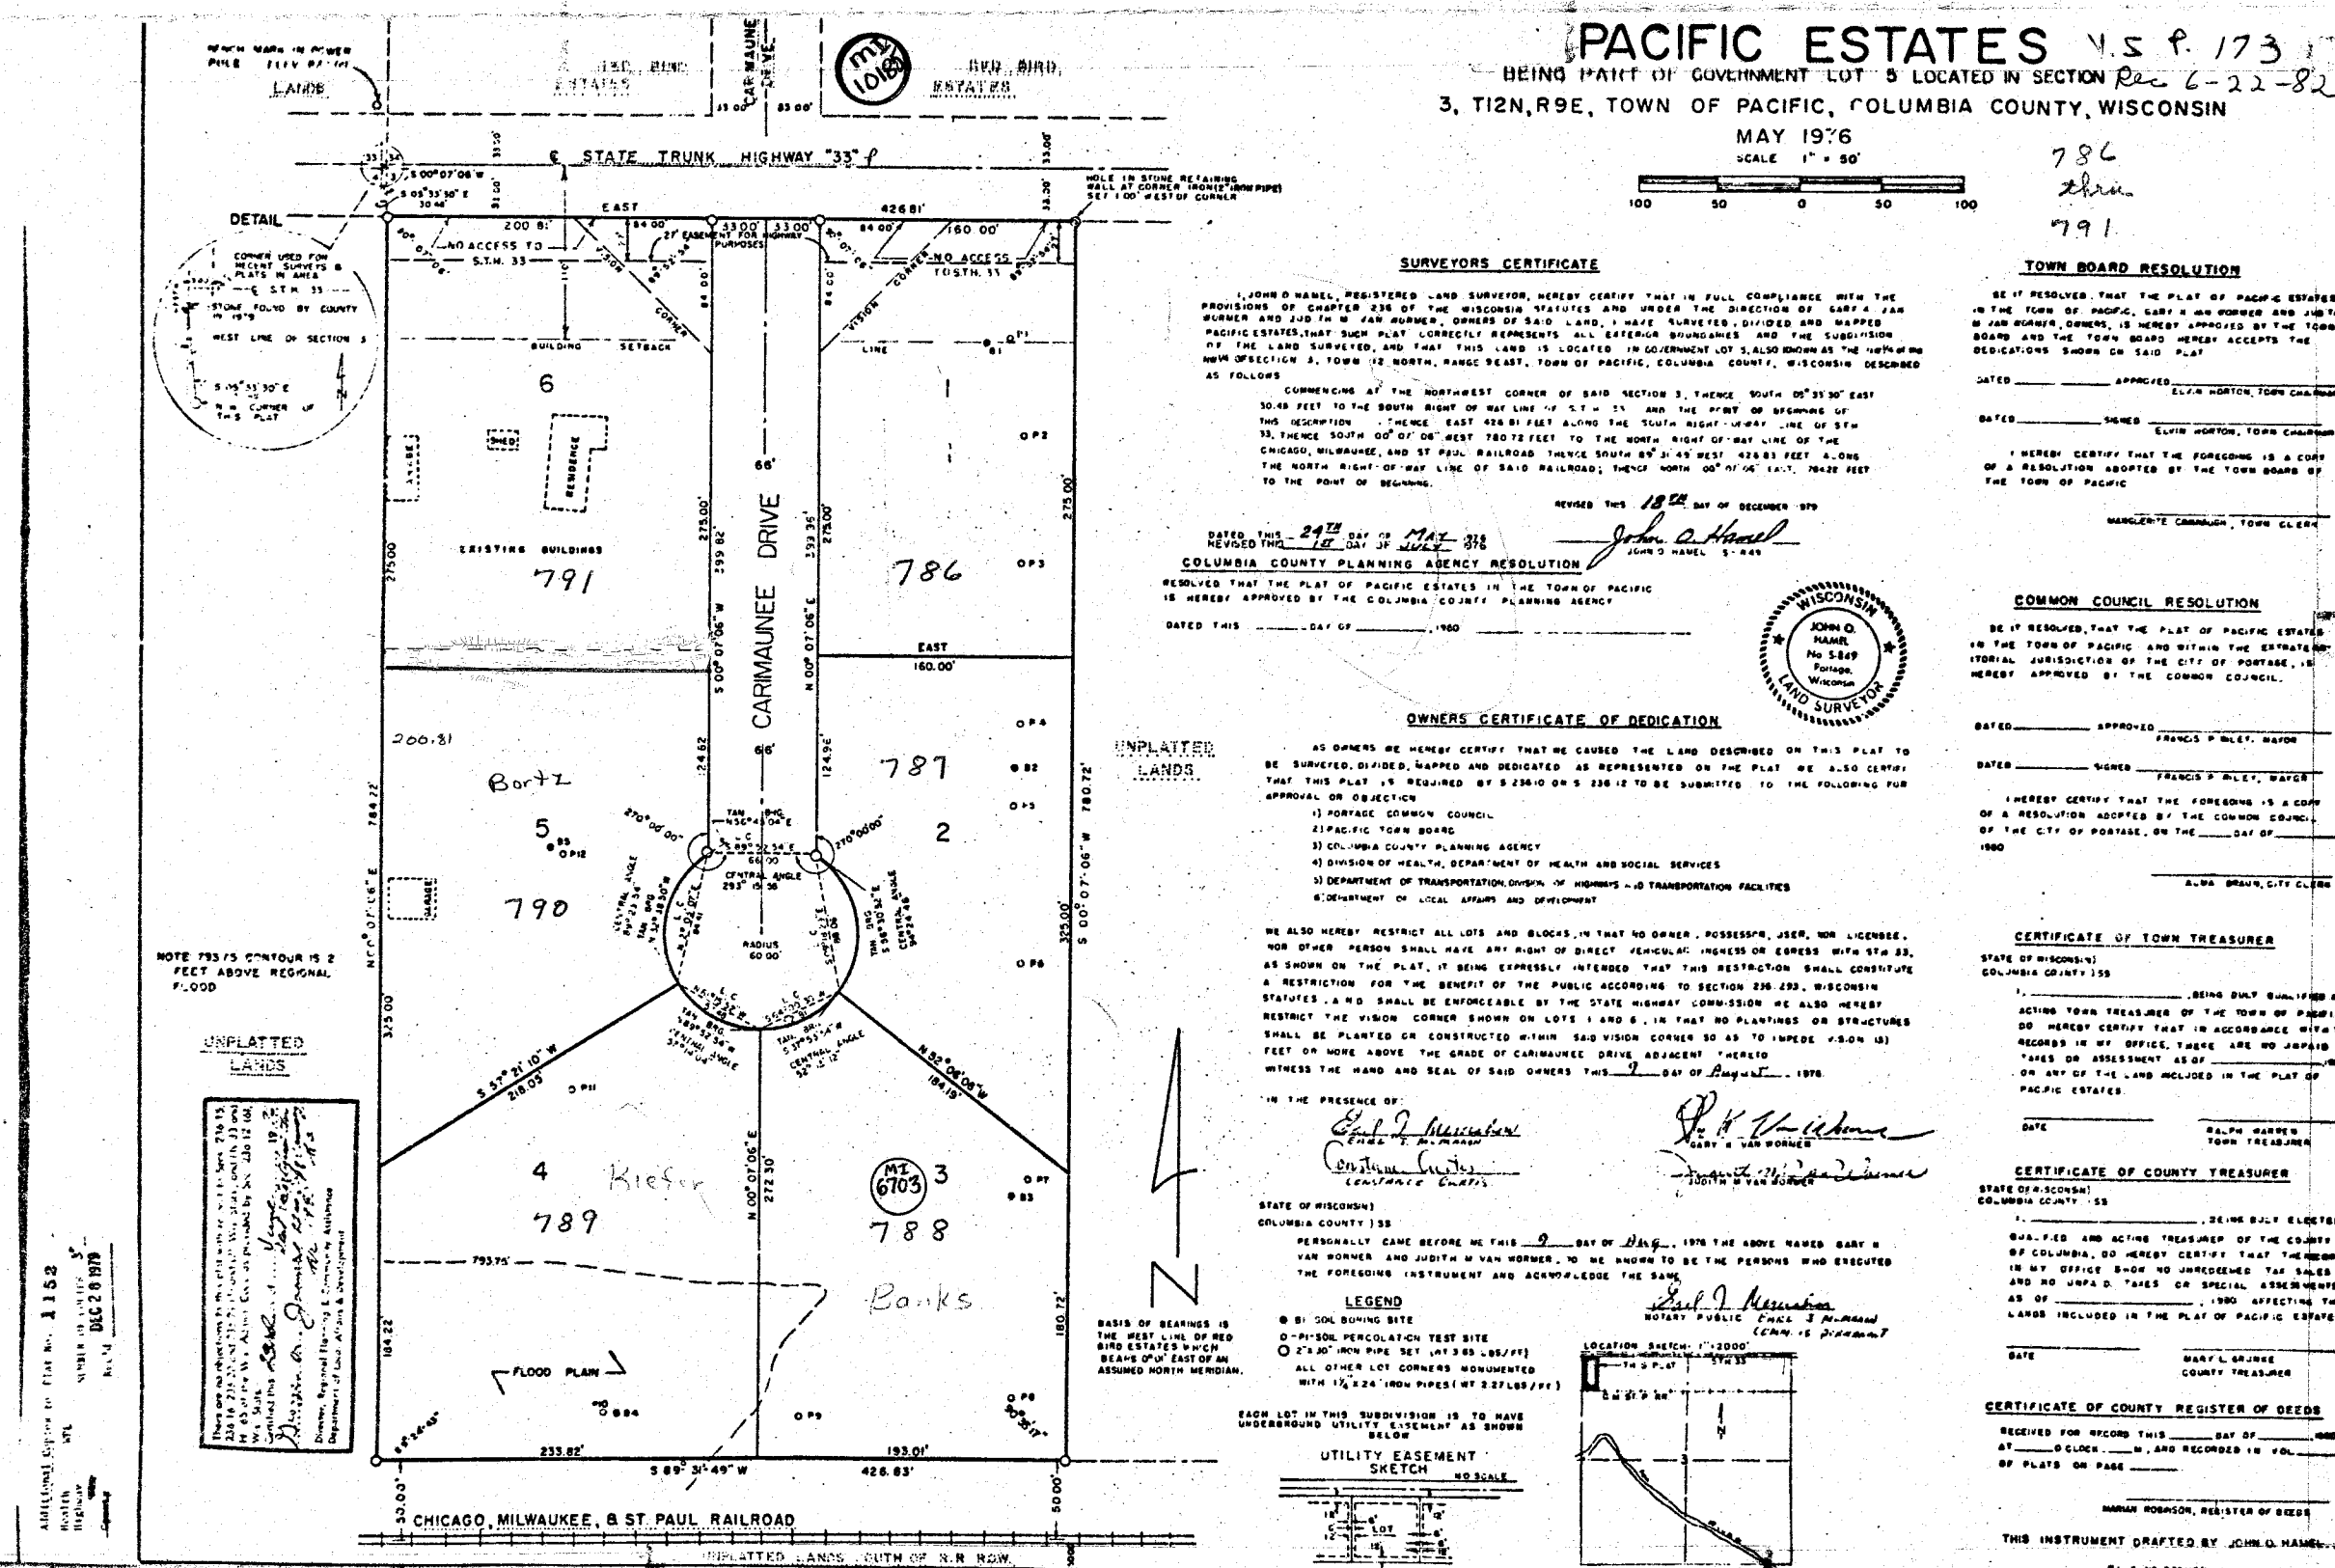


1983 Assm't. Roll

SEC. 3 + 4 T.12 R.9

V.S PLATS # 174
RESTRICTIONS
R 243-231
57.96

Replaced
2004

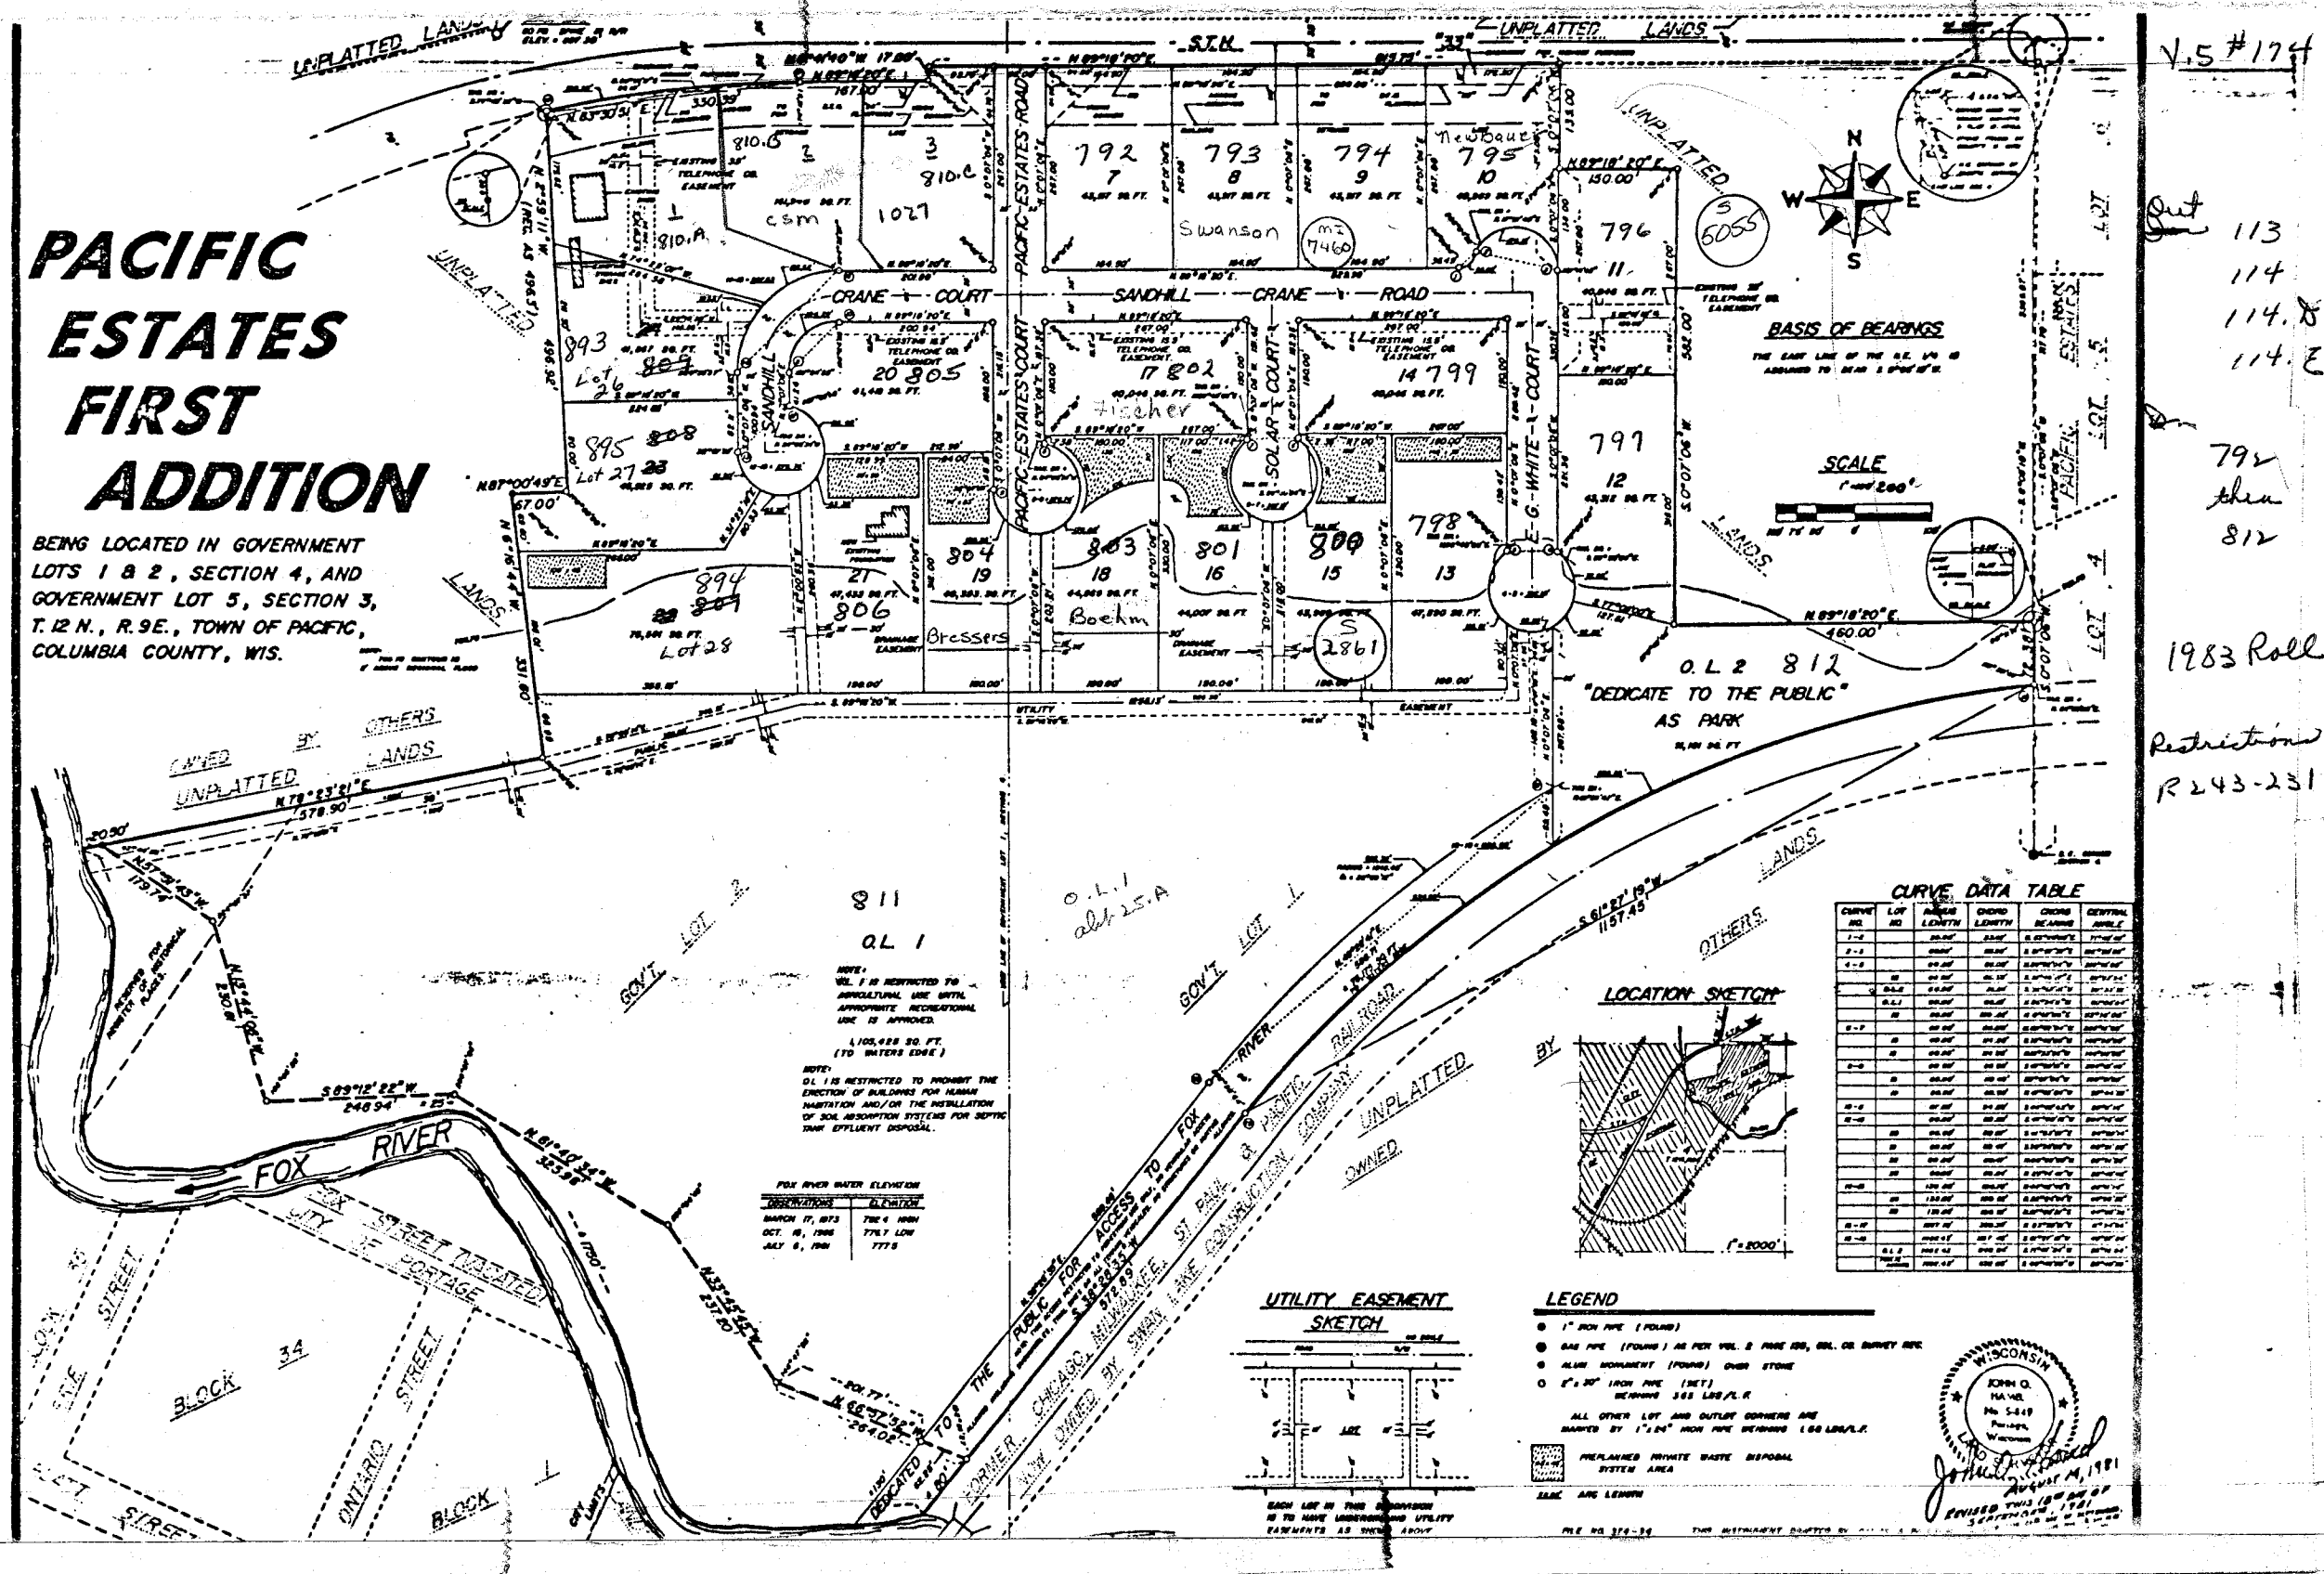

V.5 #174

Out
113
114
114.8
114. E

792
then
812


1983 Roll
Restrictions
R 243-231


plat
6920

PACIFIC

SEC. 4 T.12N. R.9E. Replaced
2004

57.96 A - 1st add

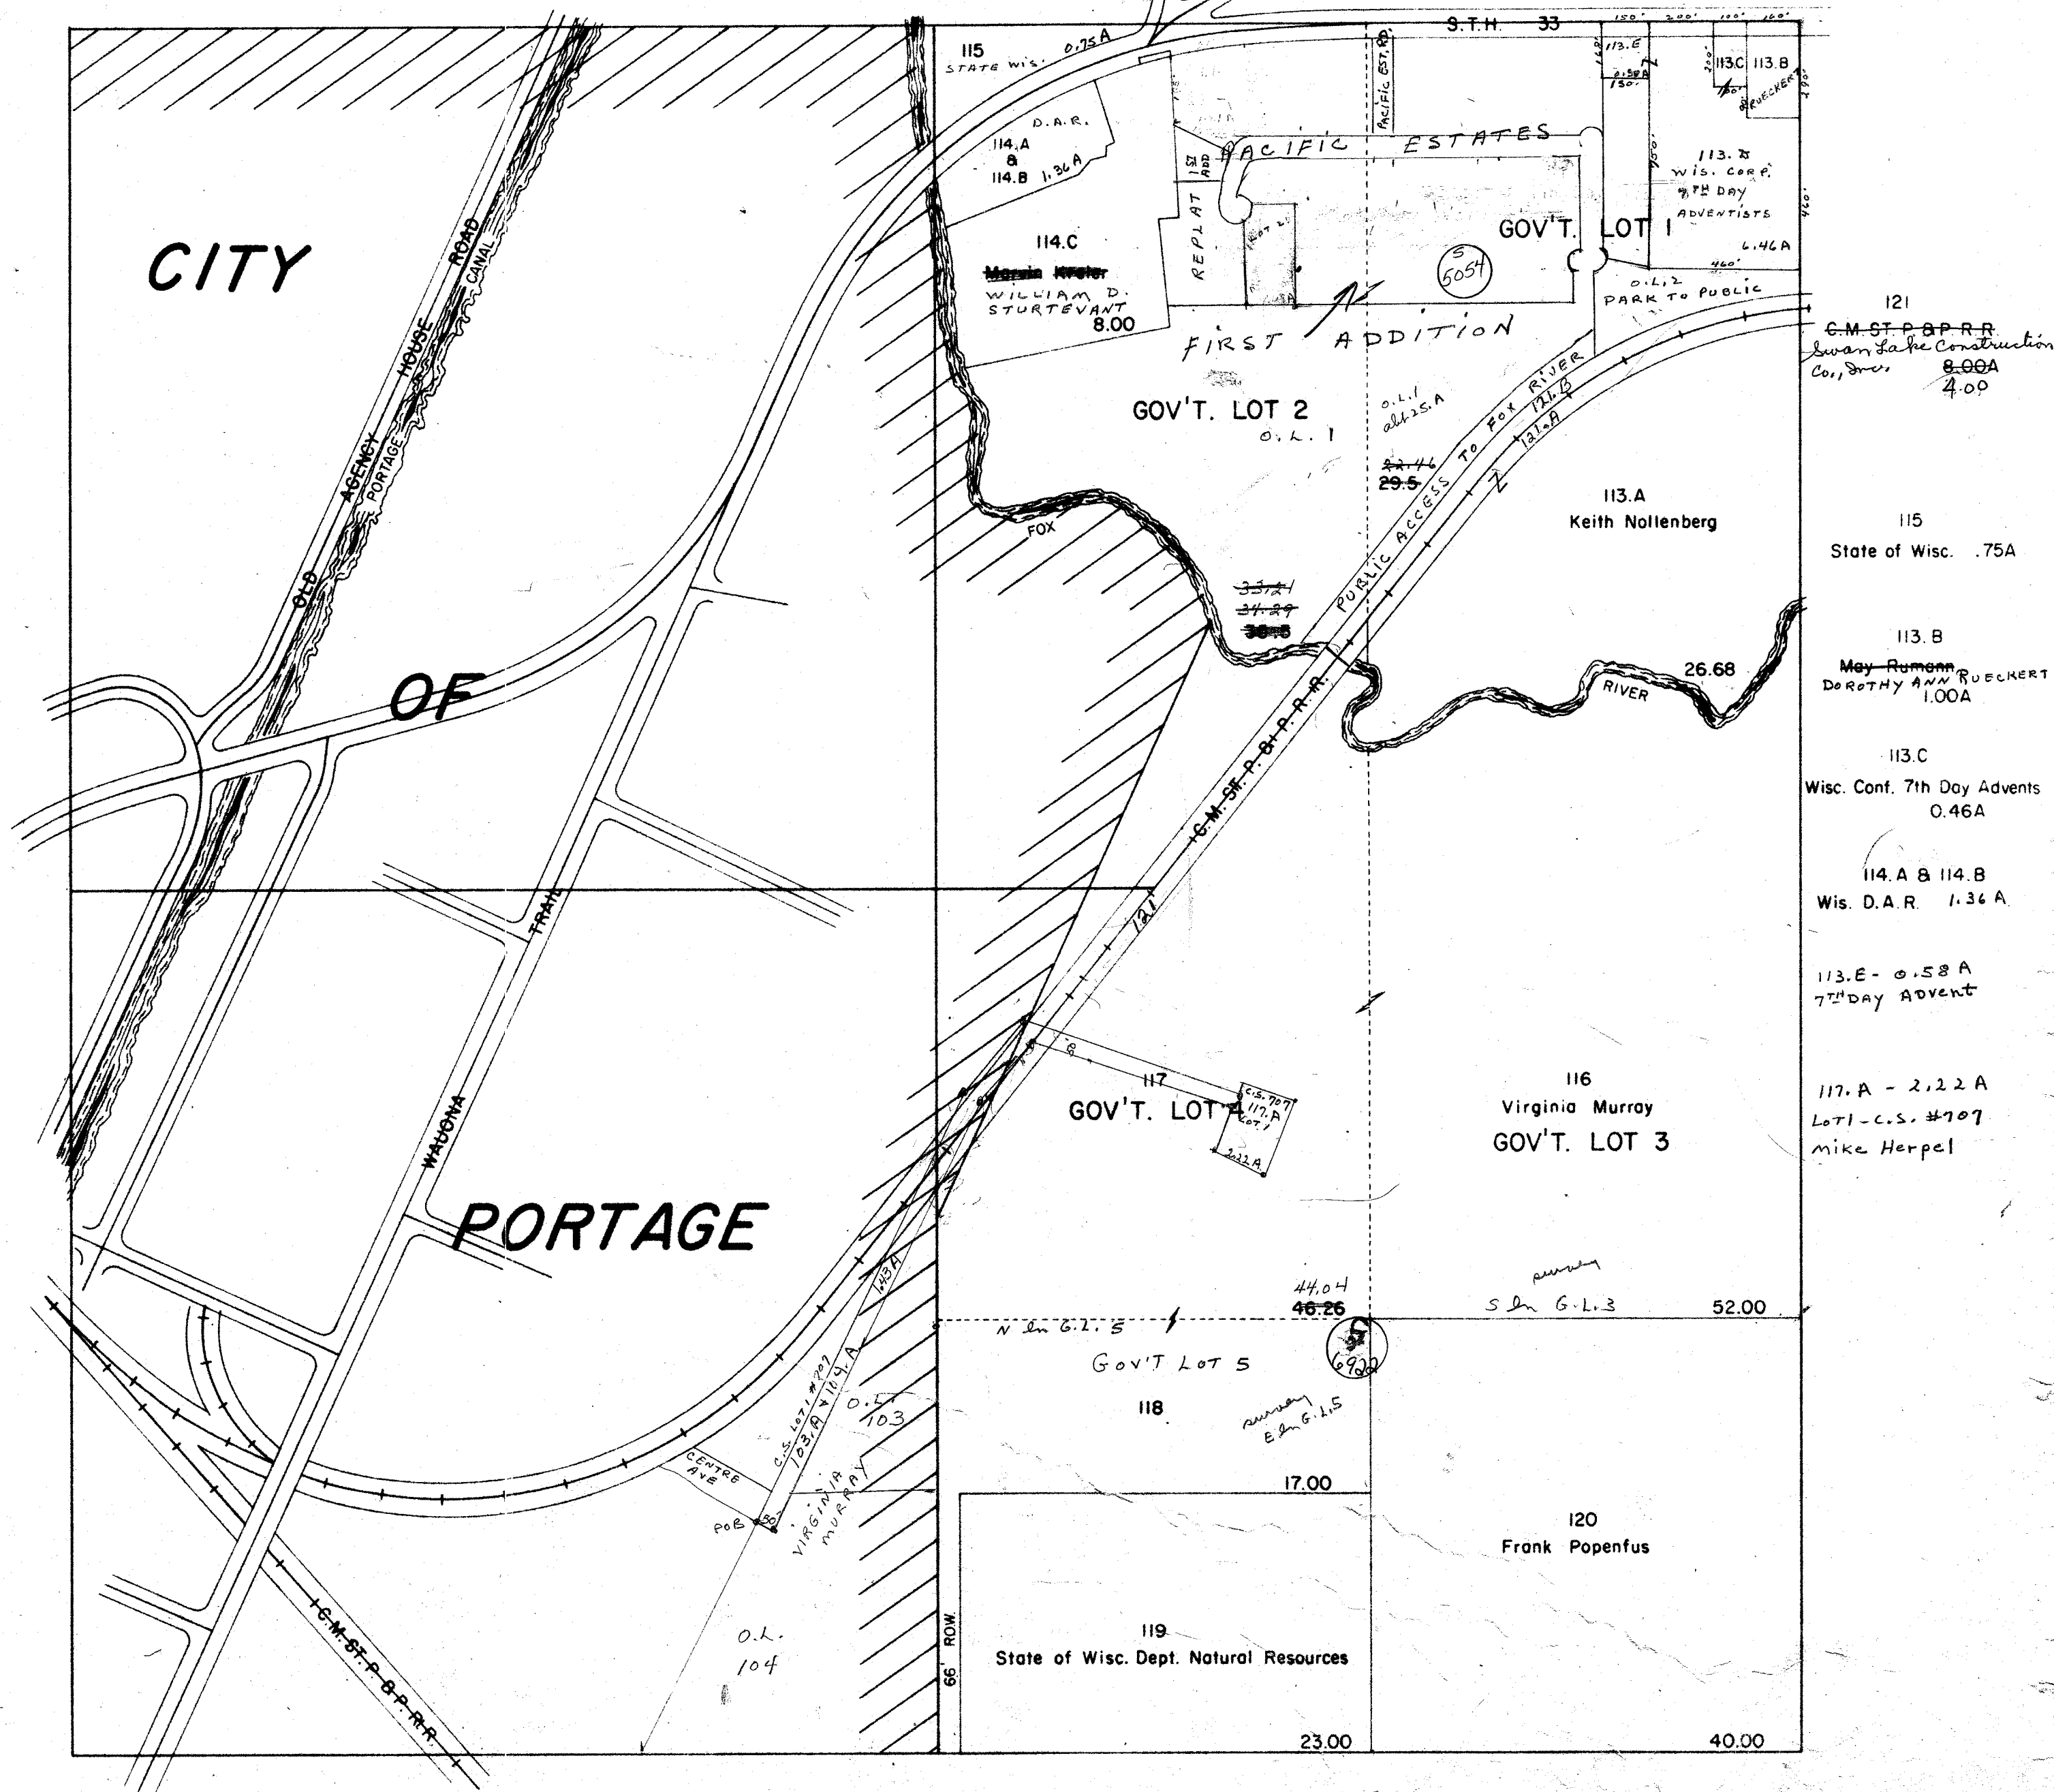

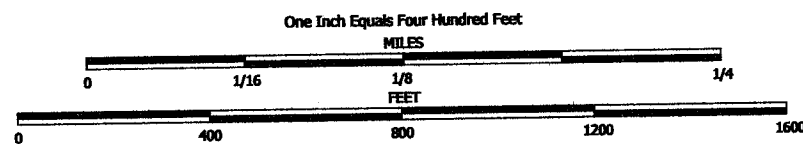


NOTE: This map was prepared for assessment use in accordance with the Wis. St. Stat. Chap. 70.02. All information contained herein is advisory only. Map accuracy is limited to the quality of data obtained from other Public Records. This map is not intended to be a substitute for an actual field survey. Public Land Survey Base is derived from U.S.G.S. Topographic maps unless otherwise noted. Other sources of the Land Base may be actual survey data. Base map data is from the April 1995 County Digital Orthophoto and/or U.S.G.S. 1:24,000 scale Topographic series. The user is responsible for the improper use of the data contained herein.

Created by The Columbia County Land Information Office - GIS Section. VMB. July 2004.

TAX PARCEL MAP

TOWN of PACIFIC


TOWN 12 NORTH RANGE 9 EAST
COLUMBIA COUNTY, WISCONSIN

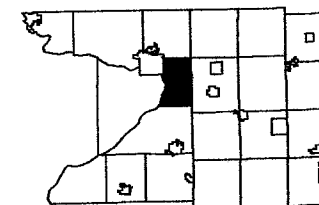

3	2	1
10	11	12
15	14	13
22	23	24
27	26	25
32	34	35

Replaced
2006

TOWN OF FORT WINNEBAGO

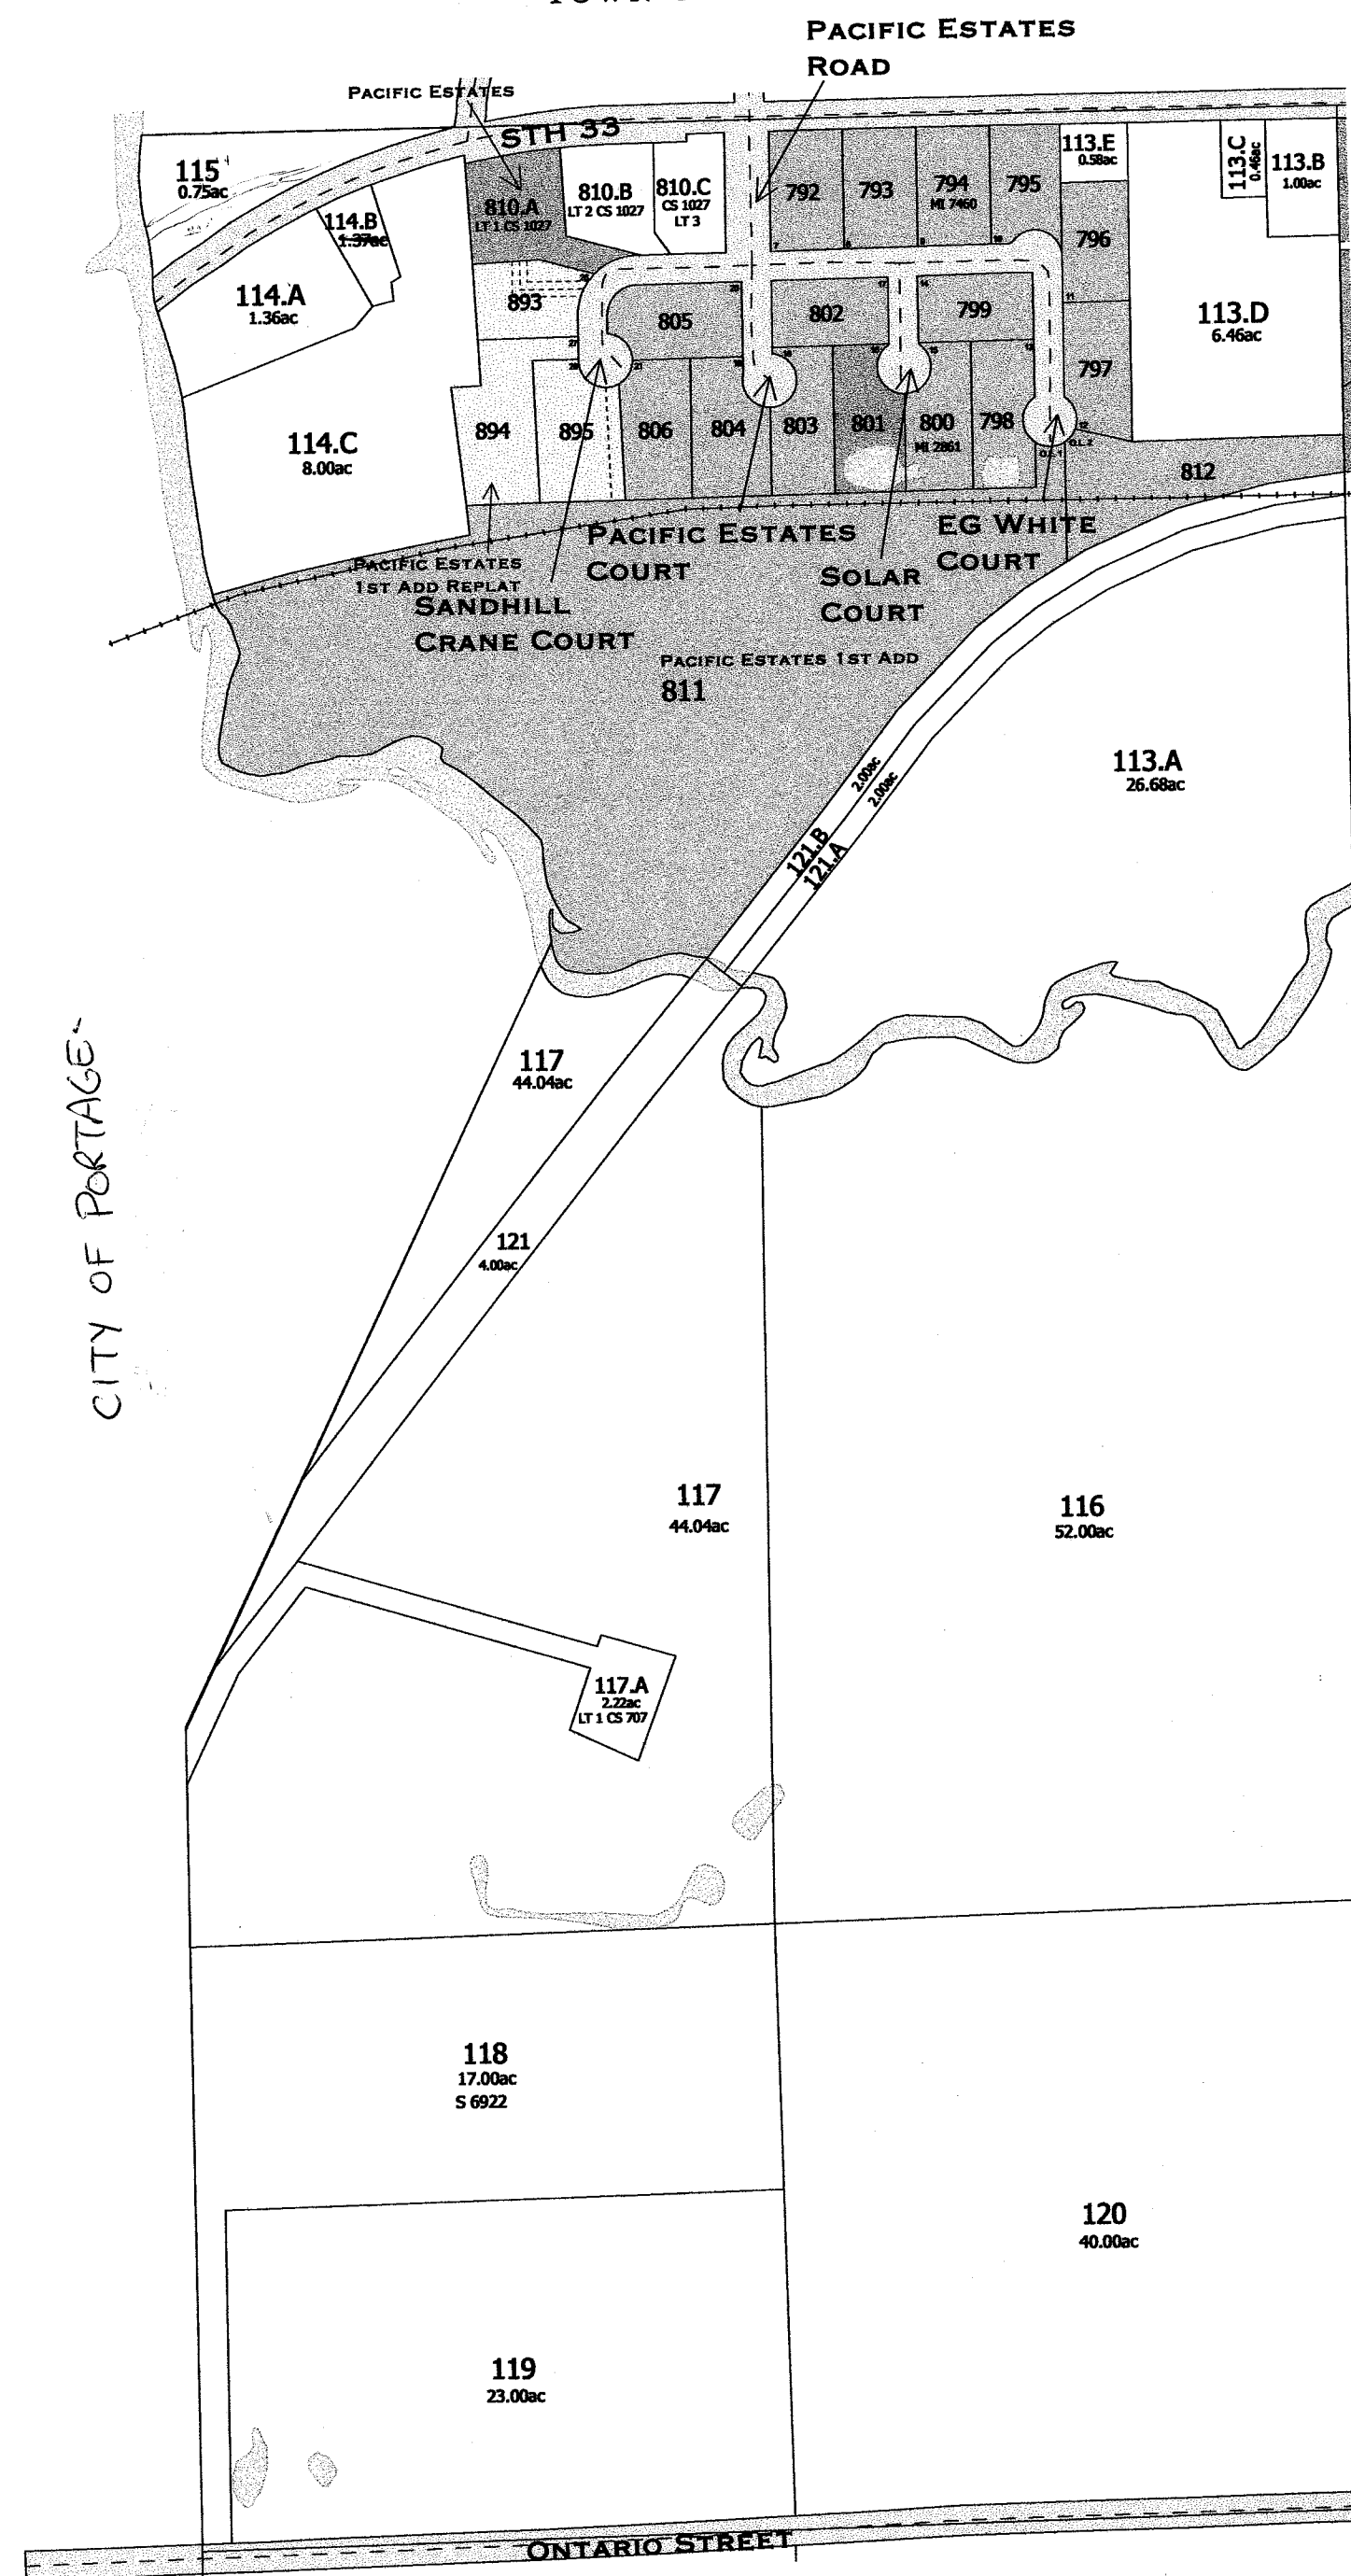

PACIFIC ESTATES - S6862
PACIFIC ESTATES 1ST ADDITION - S5055
PACIFIC ESTATES 1ST ADDITION REPLAY - REGISTER OF DEEDS
PRELIMINARY PACIFIC ESTATES 1ST ADDITION - S5054

CITY OF PORTAGE

-SEE SECTION 3-

-SEE SECTION 9-

Replaced
2006
-SECTION 4-

1985 Assm't. Roll

PACIFIC ESTATES FIRST
ADDITION REPLAT
REPLAT OF LOTS 22, 23 + 24
PACIFIC ESTATES FIRST ADDITION

Replaced
2004

V.5 PLATS # 177
S. 4 T. 12 R. 3
REC. 3-29-84

BASIS OF BEARINGS

THE EAST LINE OF THE NE 1/4 IS
ASSUMED TO BEAR S 00°05'10"W

NOTE: ALL LOTS SHALL HAVE A BUILDING SETBACK FROM THE
REAR LOT LINE OF NOT LESS THAN 25', ALSO ALL LOTS SHALL
HAVE AN ADJACENT SETBACK FROM THE SIDE LOT LINE OF
NOT LESS THAN 10' AND A MINIMUM SETBACK FROM A SIDE
LOT LINE OF 25'


SCALE: 1" = 50'



CURVE DATA TABLE

CURVE NO.	LOT NO.	RADIUS LENGTH	CHORD LENGTH	CHORD BEARING	CENTRAL ANGLE
1-2	1	153.00'	100.92'	S 22°24'54"W	44°35'36"
3-4	3	60.00'	103.55'	S 59°50'27"E	119°15'00"

LOCATION SKETCH

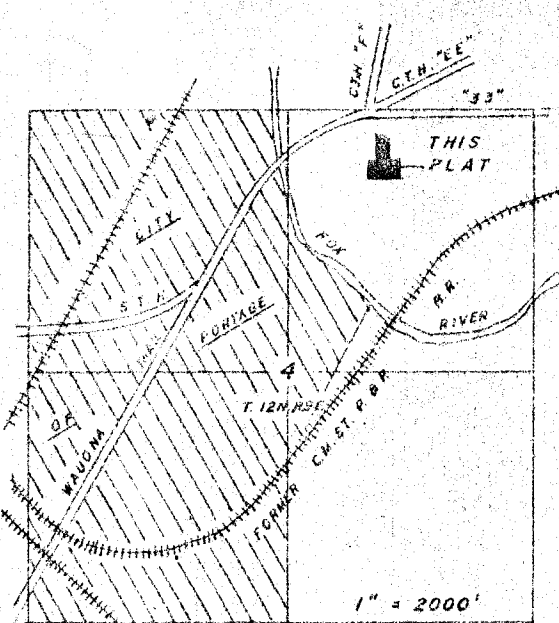


SURVEYOR:
JAMES R. GROTHMAN
141 EAST COOK ST.
PORTAGE, WI

SUBDIVIDER:
GARY VAN WORMER
ROUTE 1
PORTAGE, WI

NOTE:
7-3.75' CONTOUR IS 2'
ABOVE REGIONAL FLOOD

NOTE:
BENCH MARK IS THE SAME AS SHOWN ON
PACIFIC ESTATES FIRST ADDITION. BEING A
60 PD. SPIKE IN P.P. ON THE NORTH SIDE
OF S.T.H. "33". ELEV. = 807.30'

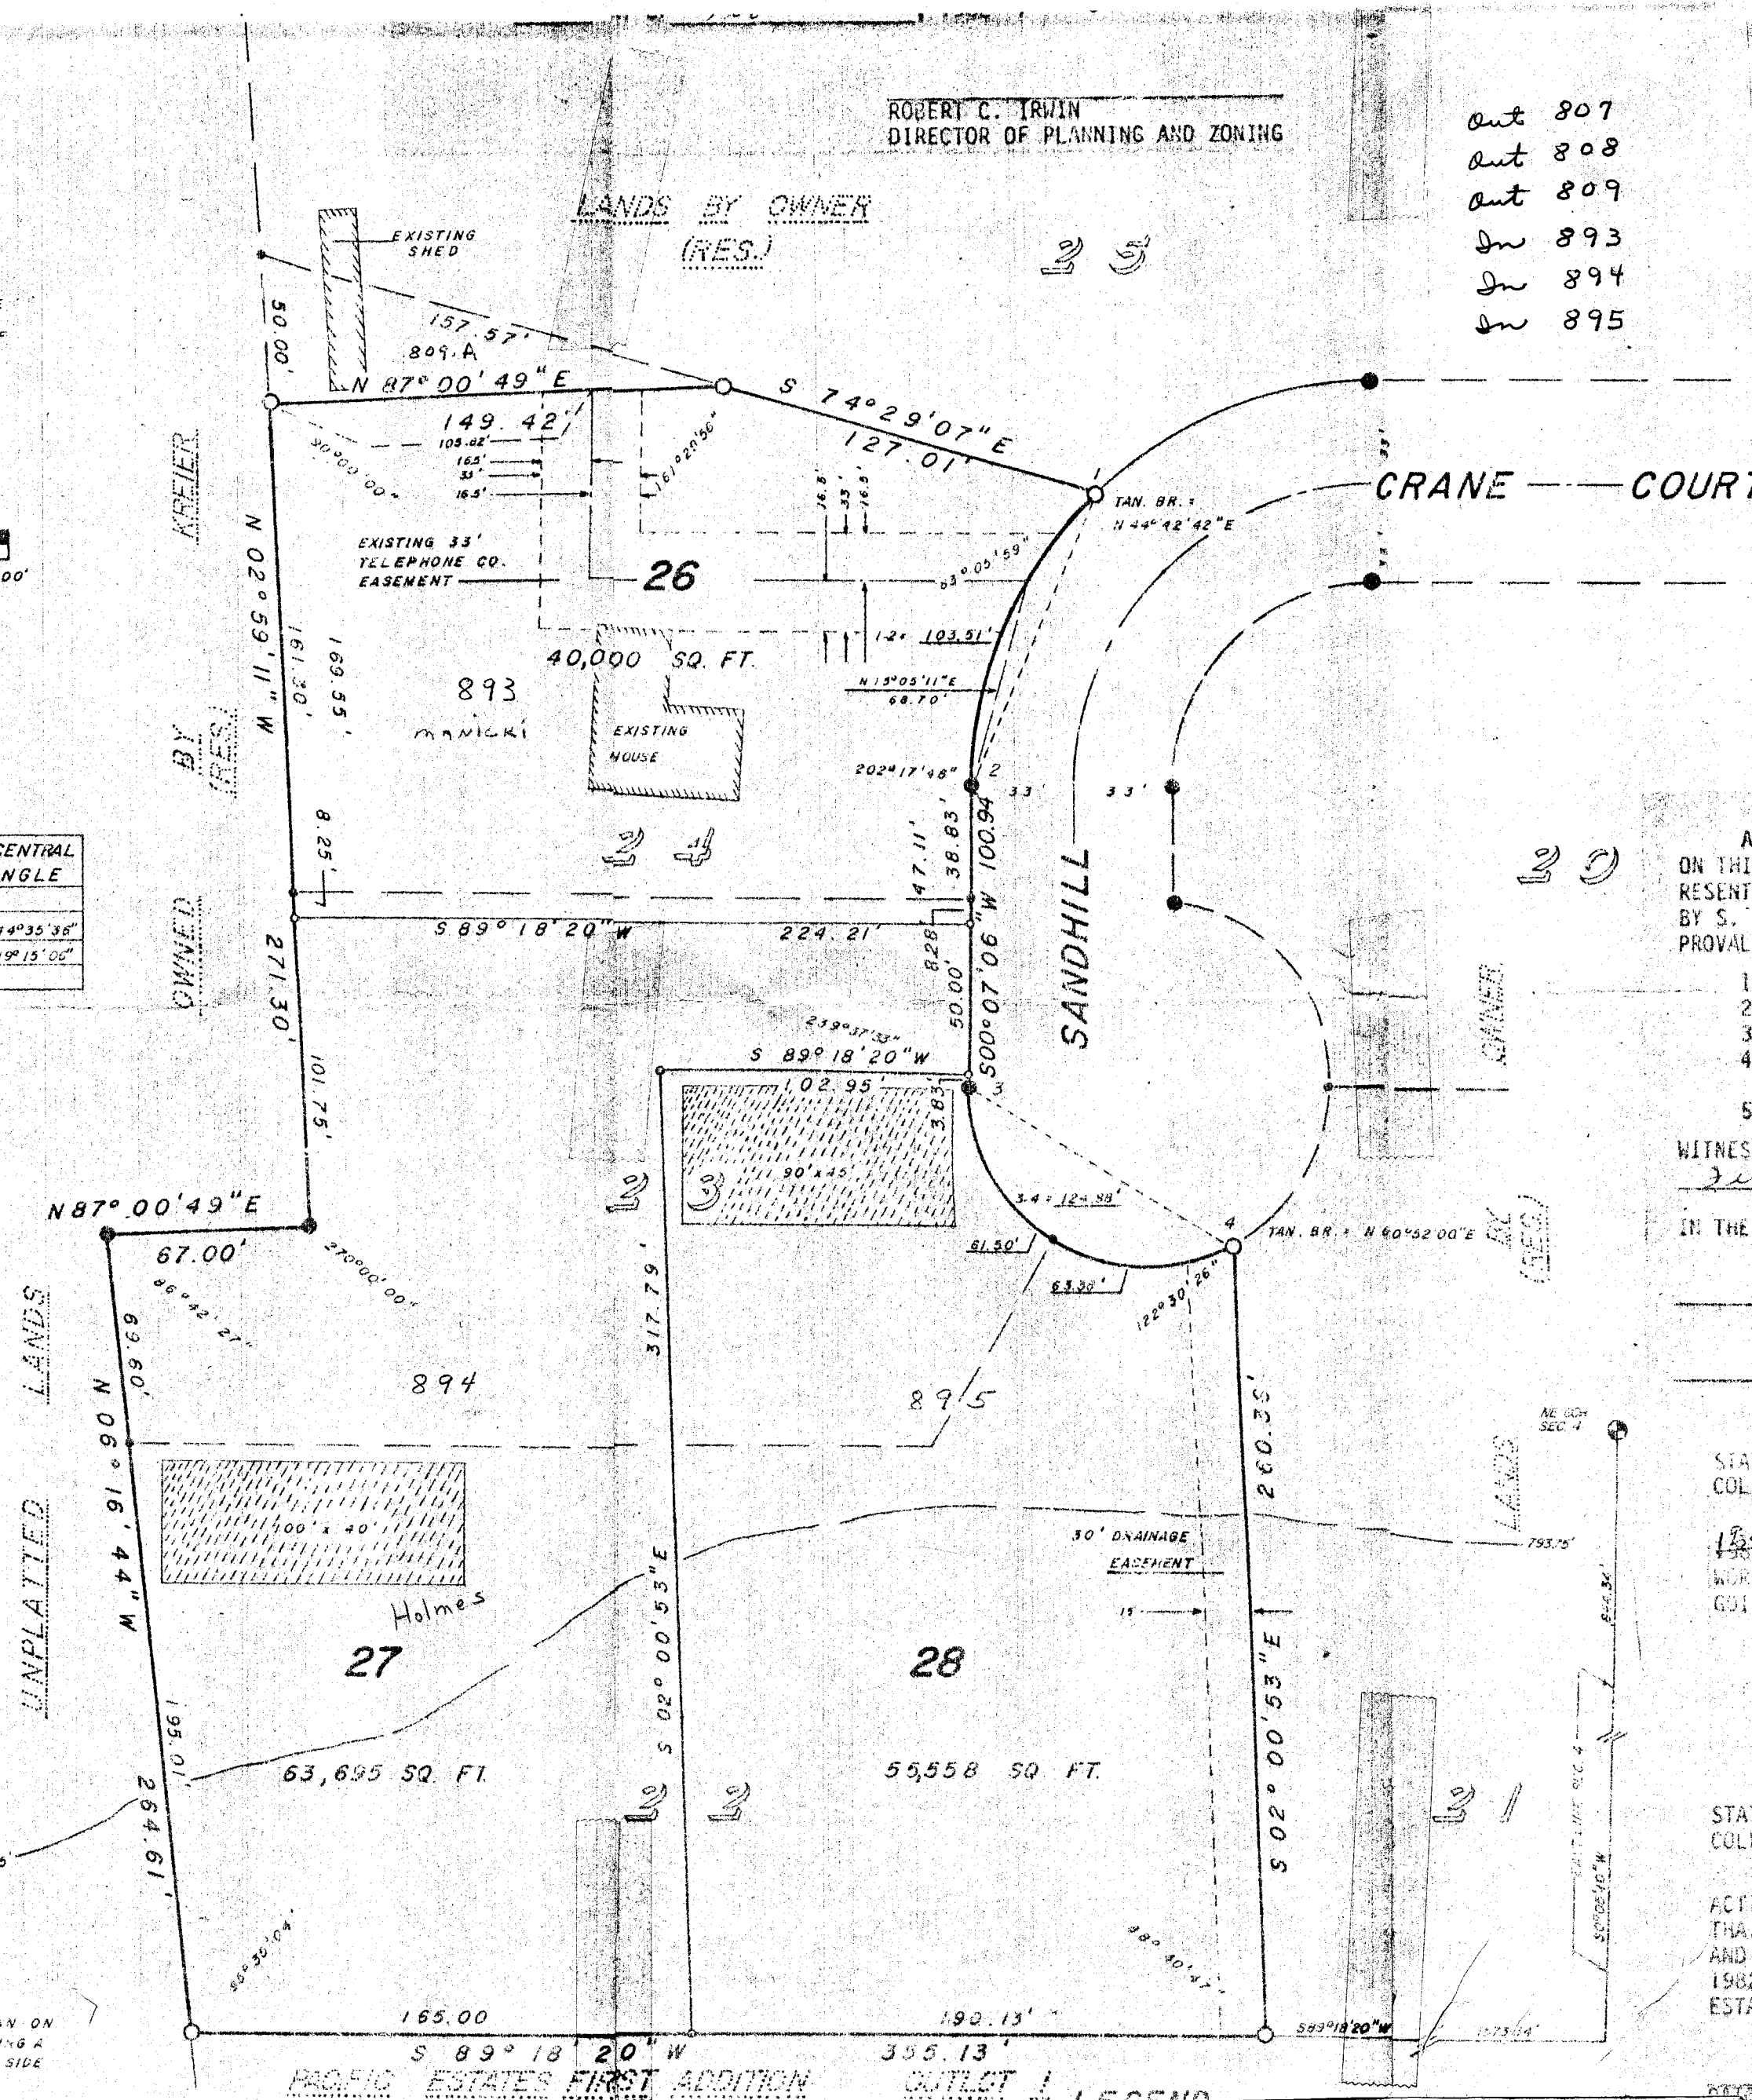

Out 807
Out 808
Out 809
In 893
In 894
In 895

AS
ON THIS
RESENT
BY S. 2
PROVAL

WITNESS
3-28
IN THE F

STATE
COLUM

184
WORM
GOIN

STATE
COLUM

ACTIN
THAT
AND
1982
ESTAT

PACIFIC
SEC. 9 T.12N. R.9E.

Replaced
2004

CITY

OF

PORTAGE

122
State of Wisc. Dept. Natural
Resources

122.A
State of Wis. Dept. Natural
Resources
1.00A

128
William Bube
4.96A

130
William Bube
1.34A

133
Portage Broadcasting
Station 4.13A

123

124

126

127

127

William Bube
David H. Bennett

133.A

125A

131.A

134.A

12.91A

C.M. ST. P. & P. R. R.


135

15.00

Part of W.P.B.P.
inside of city limits
not on T.R. all
in T. Pacific

4-5-77
per David Bennett
this is copy to him
of the same
of the same
of the same

3-152-6-4.97
2-150-2-13.22
2-237-7-5

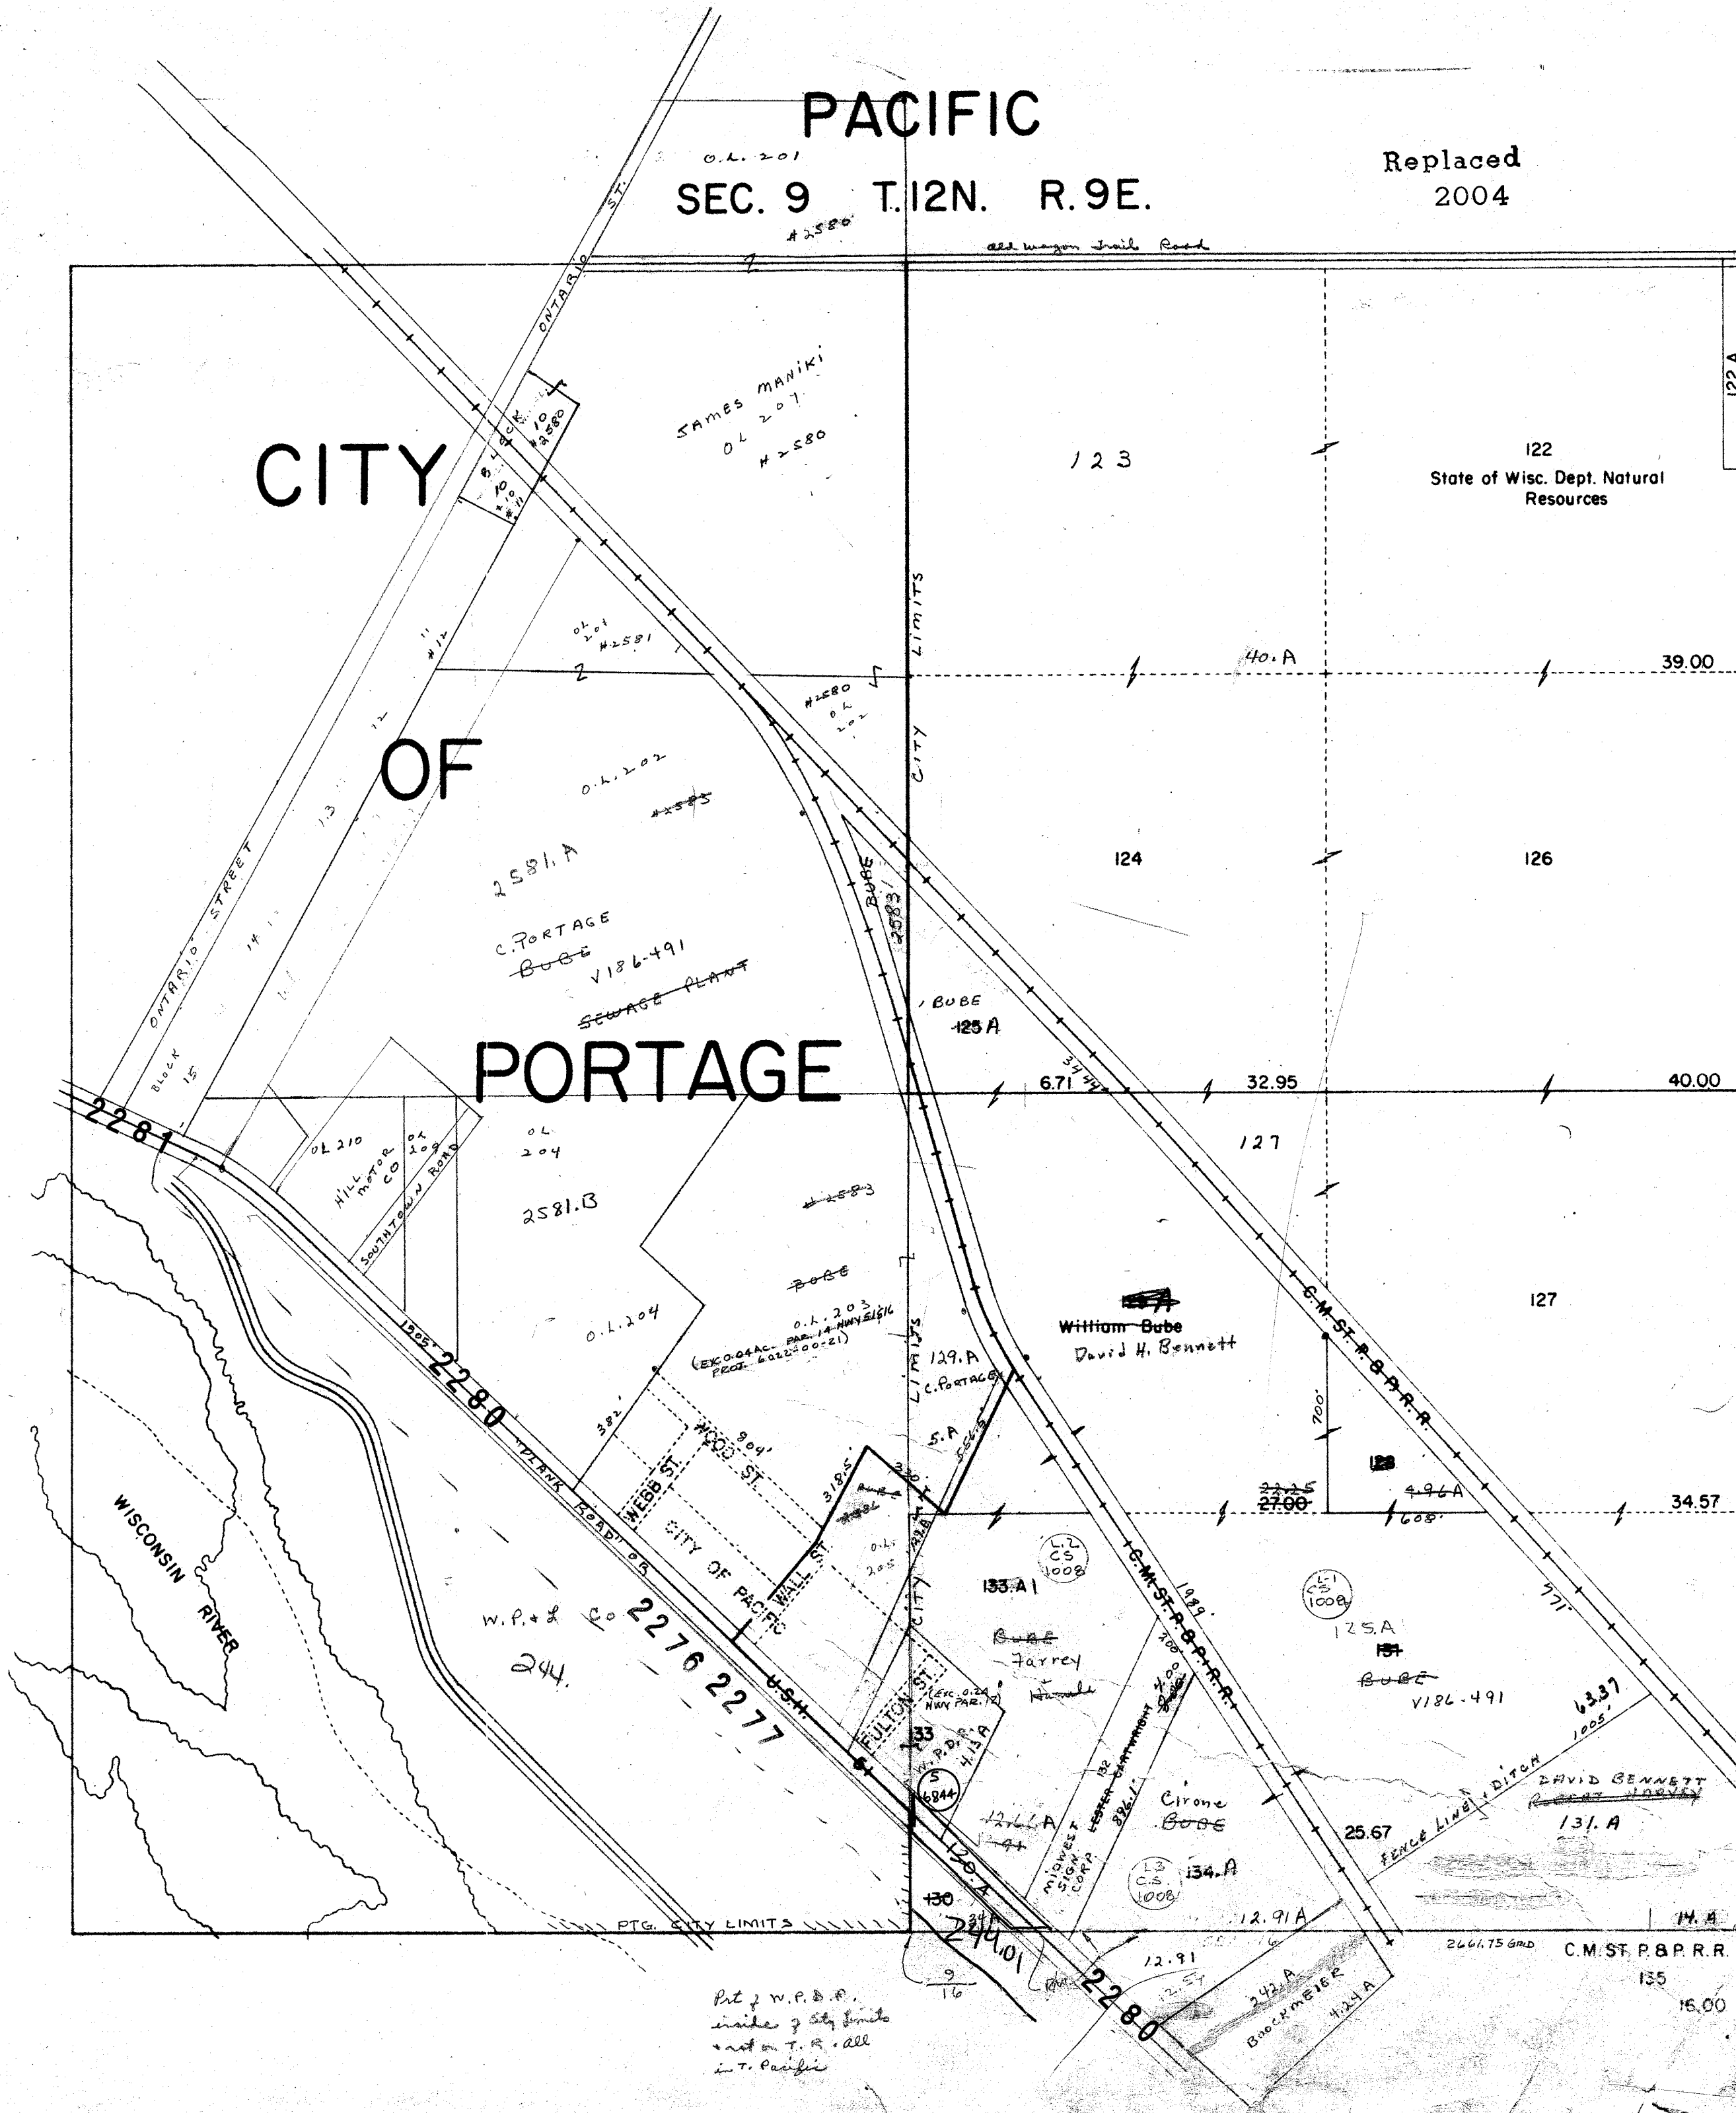

One Inch Equals Four Hundred Feet

MILES
0 1/16 1/8 1/4
FEET
0 400 800 1200 1600


NOTE: This map was prepared for assessment use in accordance with the Wis. St. Stat. Chap. 70.03. All information contained herein is advisory only. Map accuracy is limited to the quality of data obtained from other Public Records. This map is not intended to be a substitute for an actual field survey. Public Land Survey Base is derived from U.S.G.S. Topographic maps unless otherwise noted. Other sources of the Land Base may be actual survey data. Base map data is from the April 1995 County Digital Orthophotos and/or U.S.G.S. 1:24,000 scale Topographic series. The user is responsible for the improper use of the data contained herein.

Created by The Columbia County Land Information Office -GIS Section, VMB, July 2004.

TAX PARCEL MAP


TOWN of PACIFIC

TOWN 12 NORTH RANGE 9 EAST
COLUMBIA COUNTY, WISCONSIN

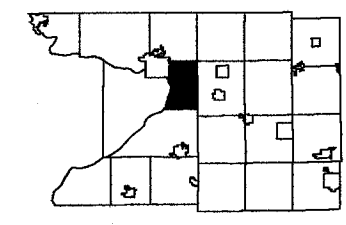

3	2	1
10	11	12
15	14	13
22	23	24
27	28	25
33	34	35

Replaced
2006

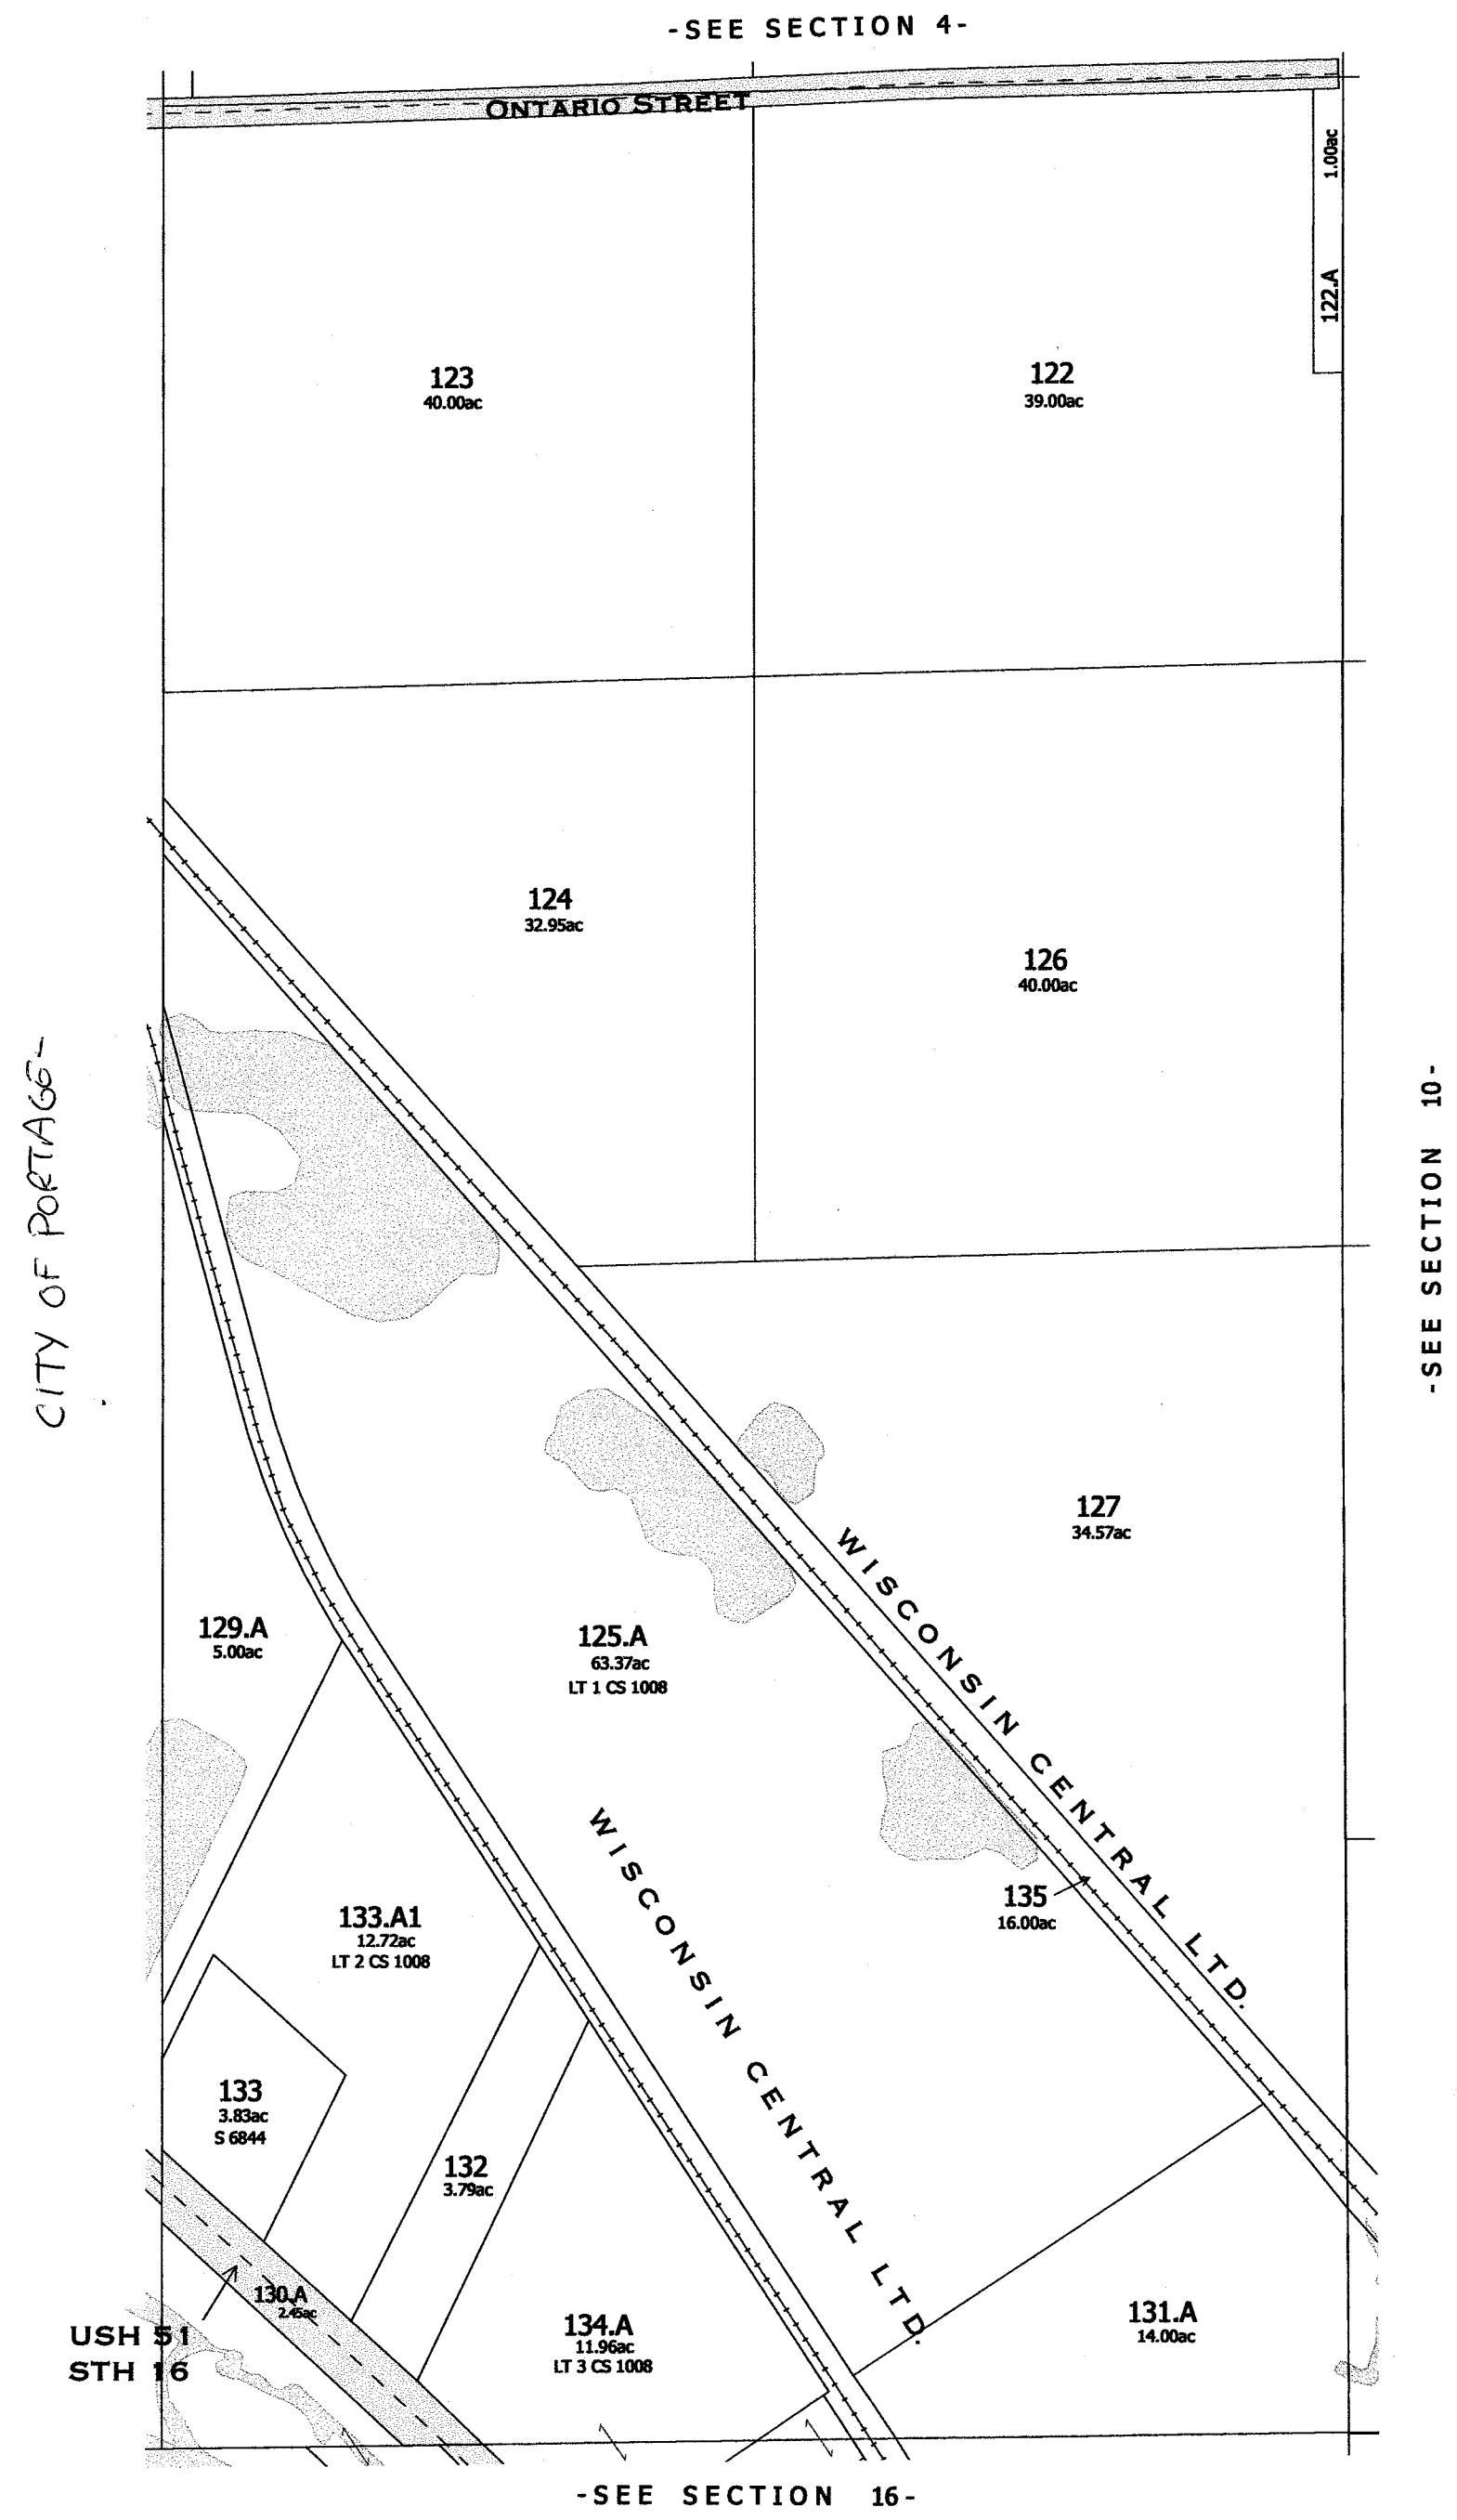


Replaced
2006

PACIFIC


SEC. 10 T.12N. R.9E.

Replaced
2004

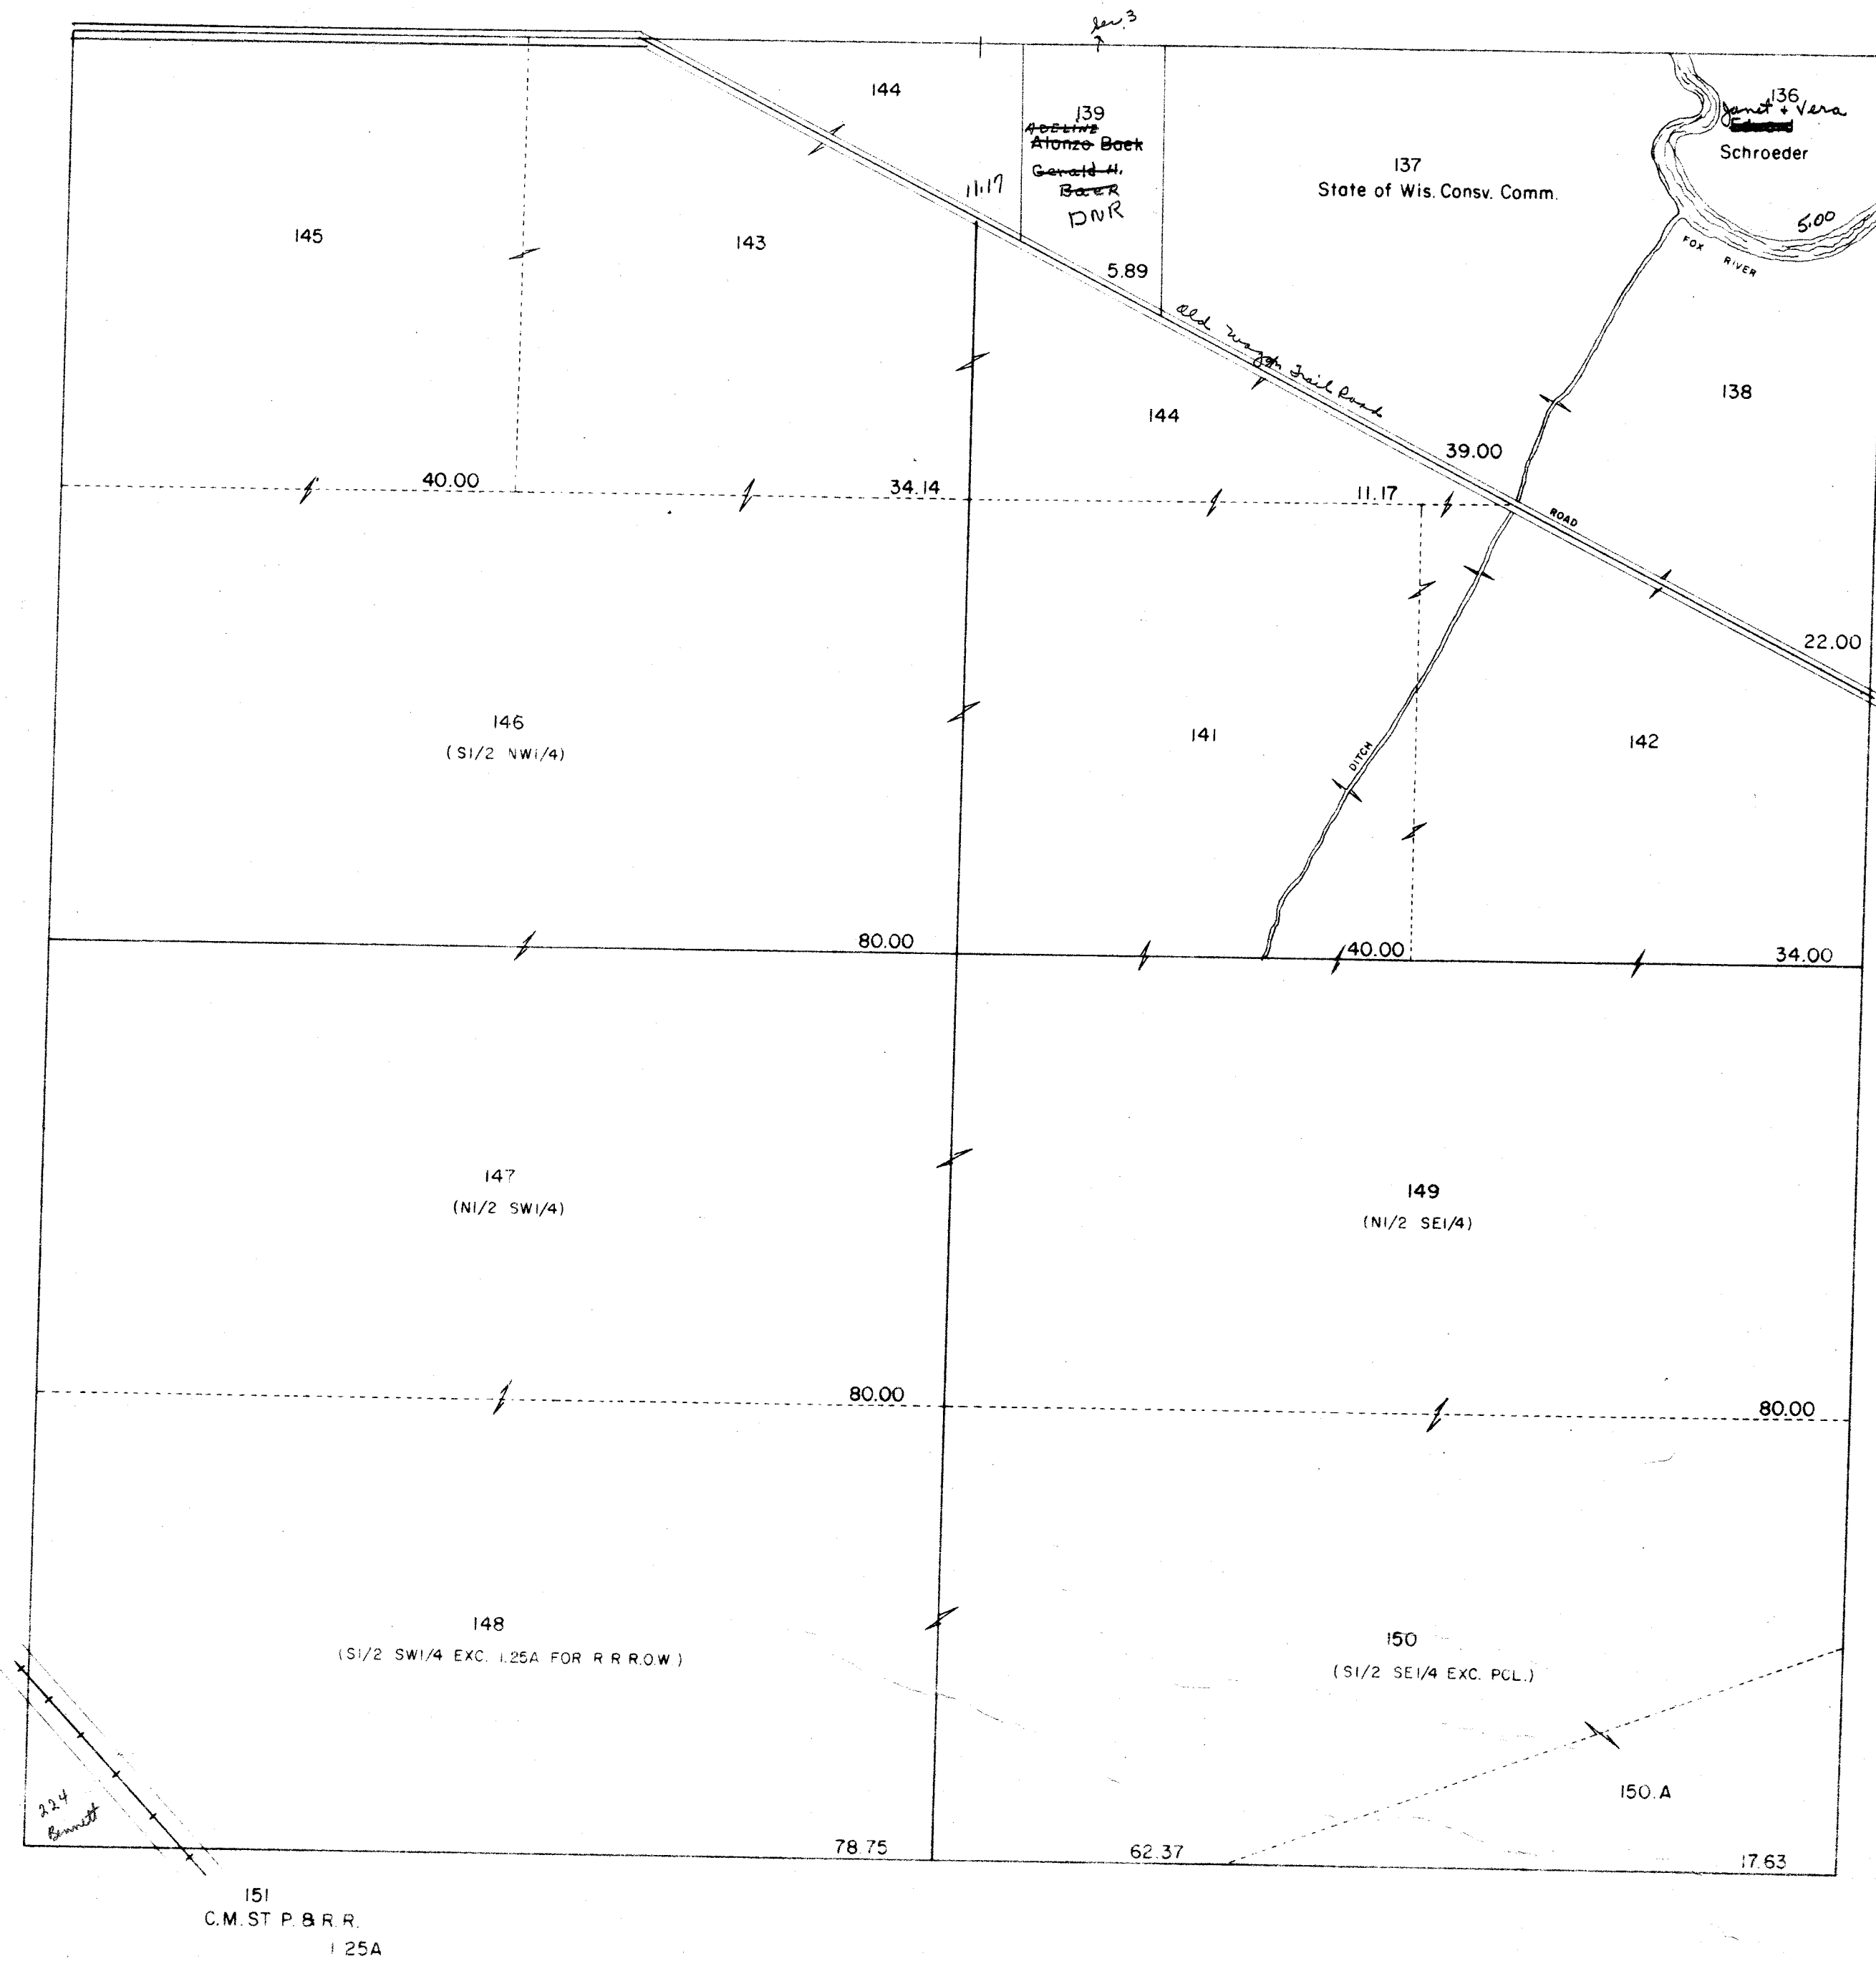

PACIFIC
SEC. II T.12N. R.9E

Replaced
2004

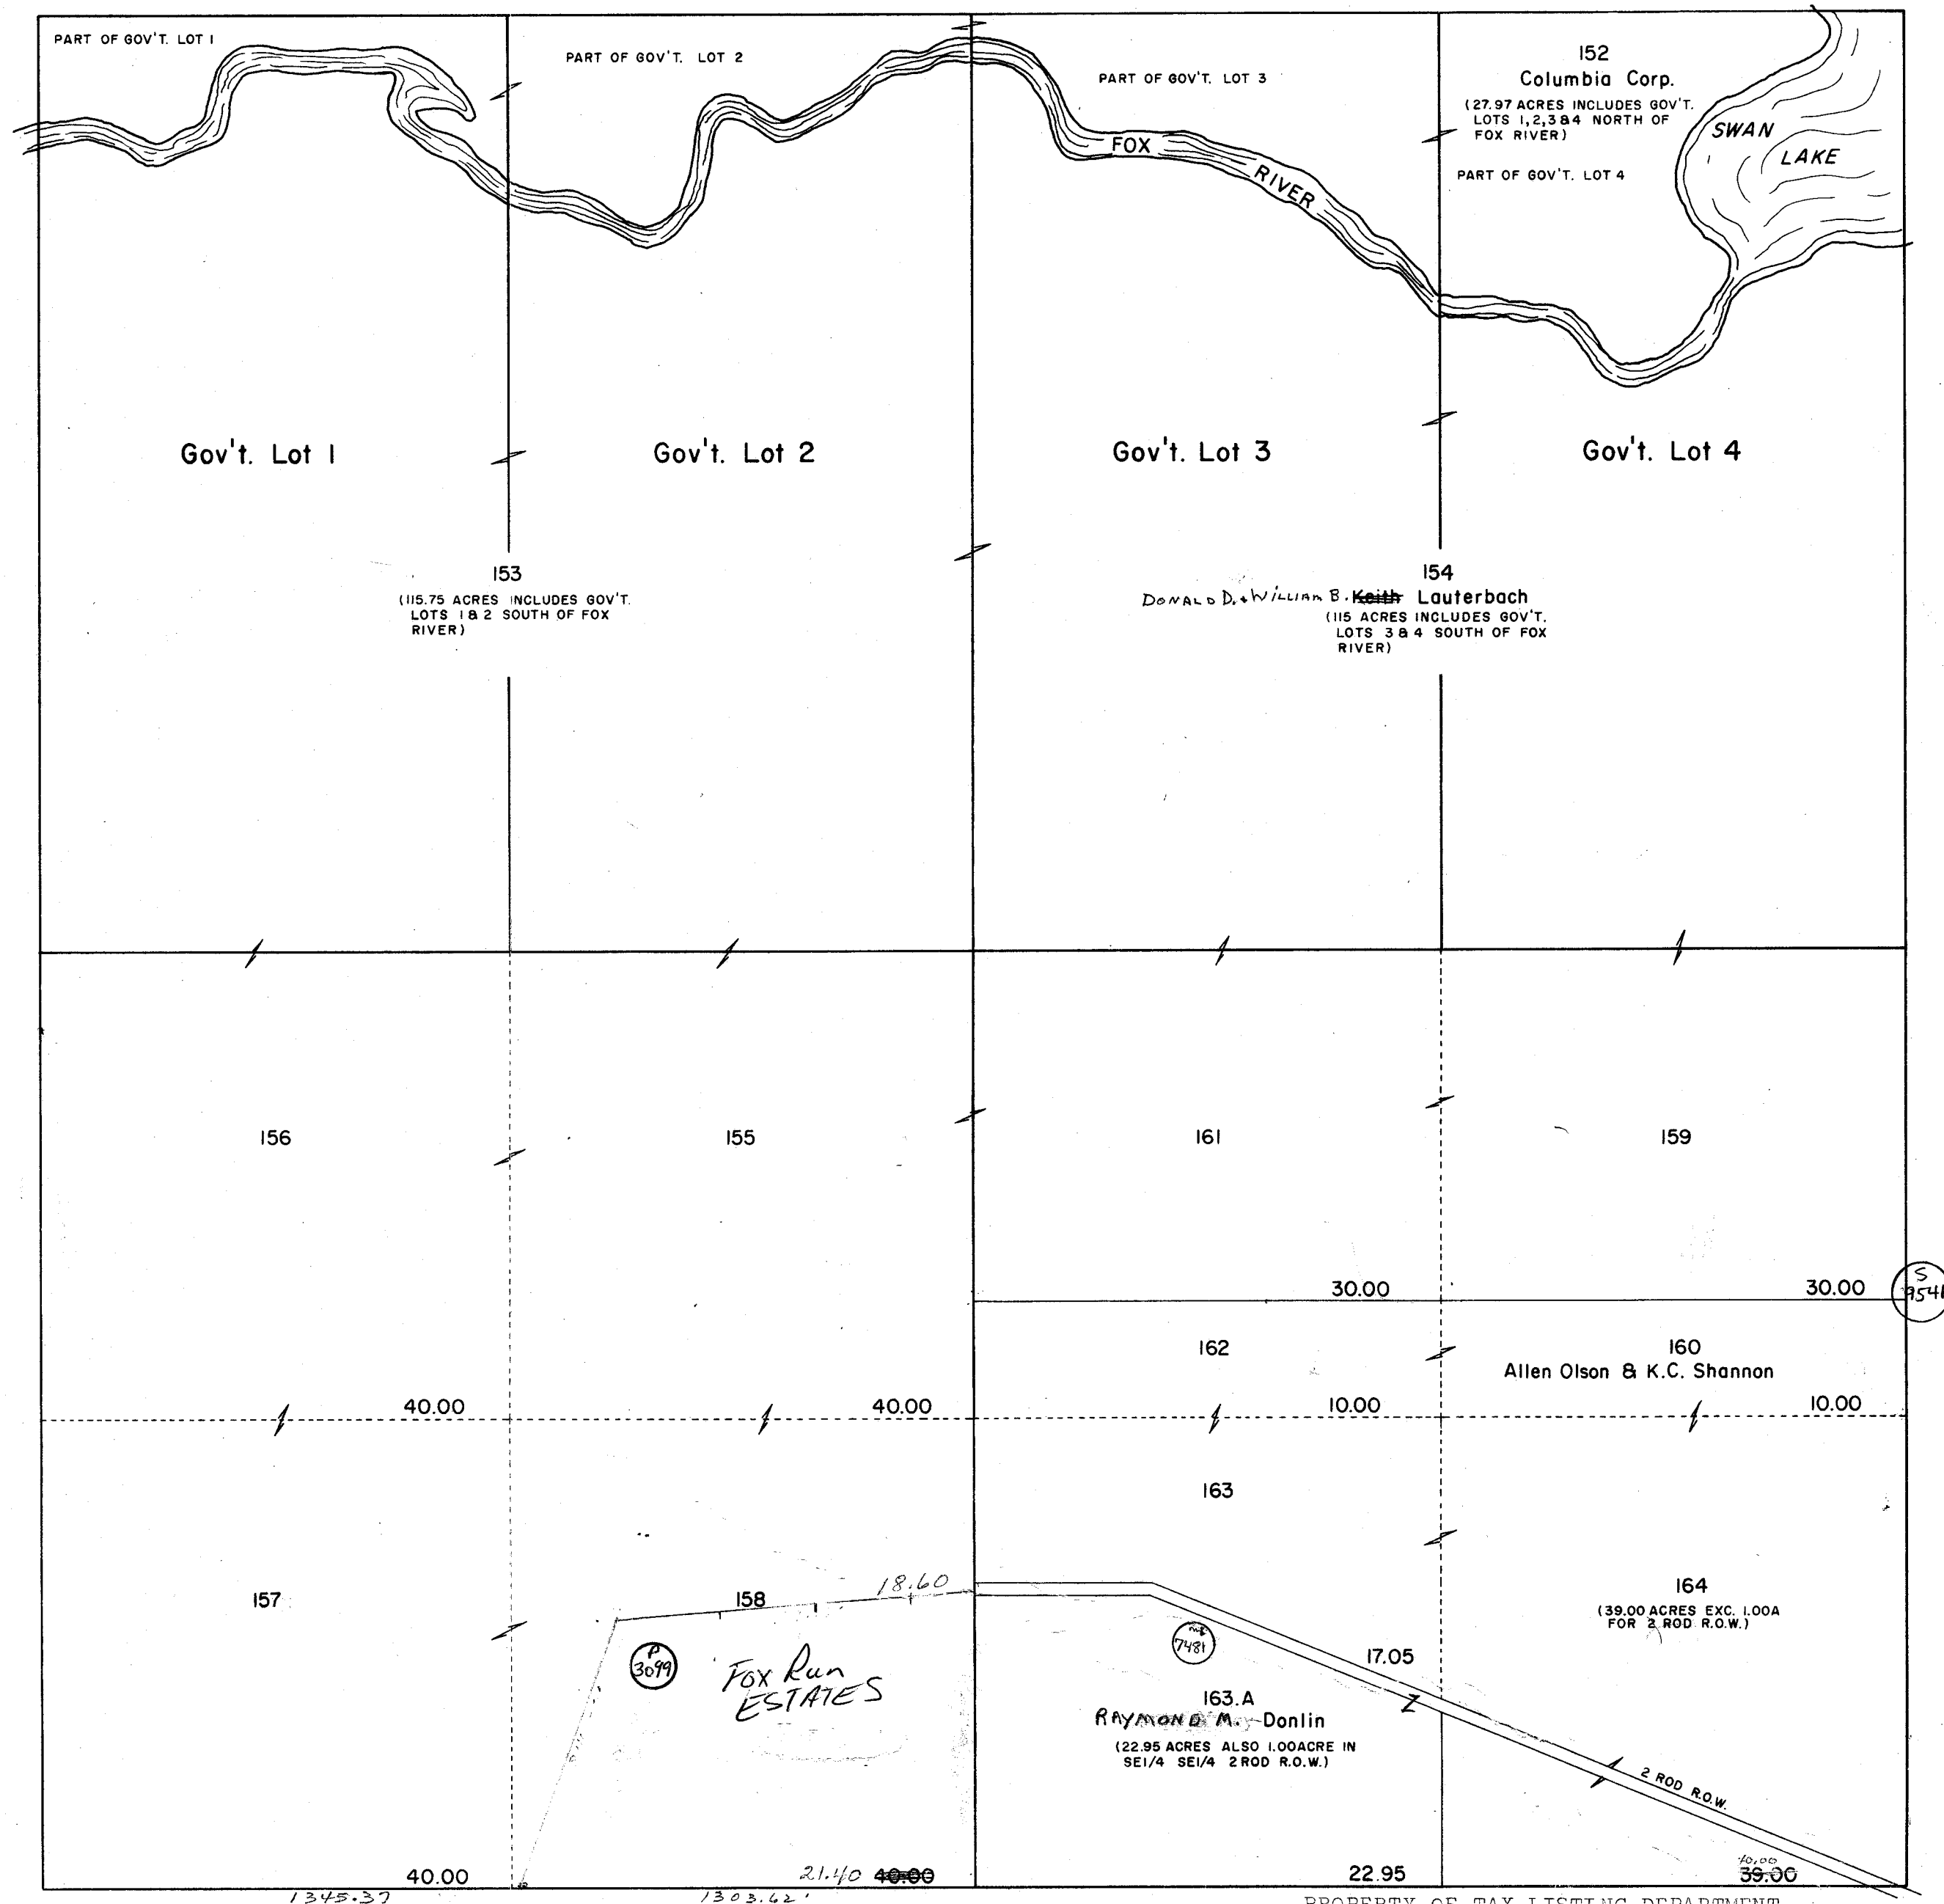



Encl for 33' strip R.O.W.
R 243 + 235 + 236 + 238

PACIFIC

SEC. 12 T. 12N. R. 9E.

Replaced
2004

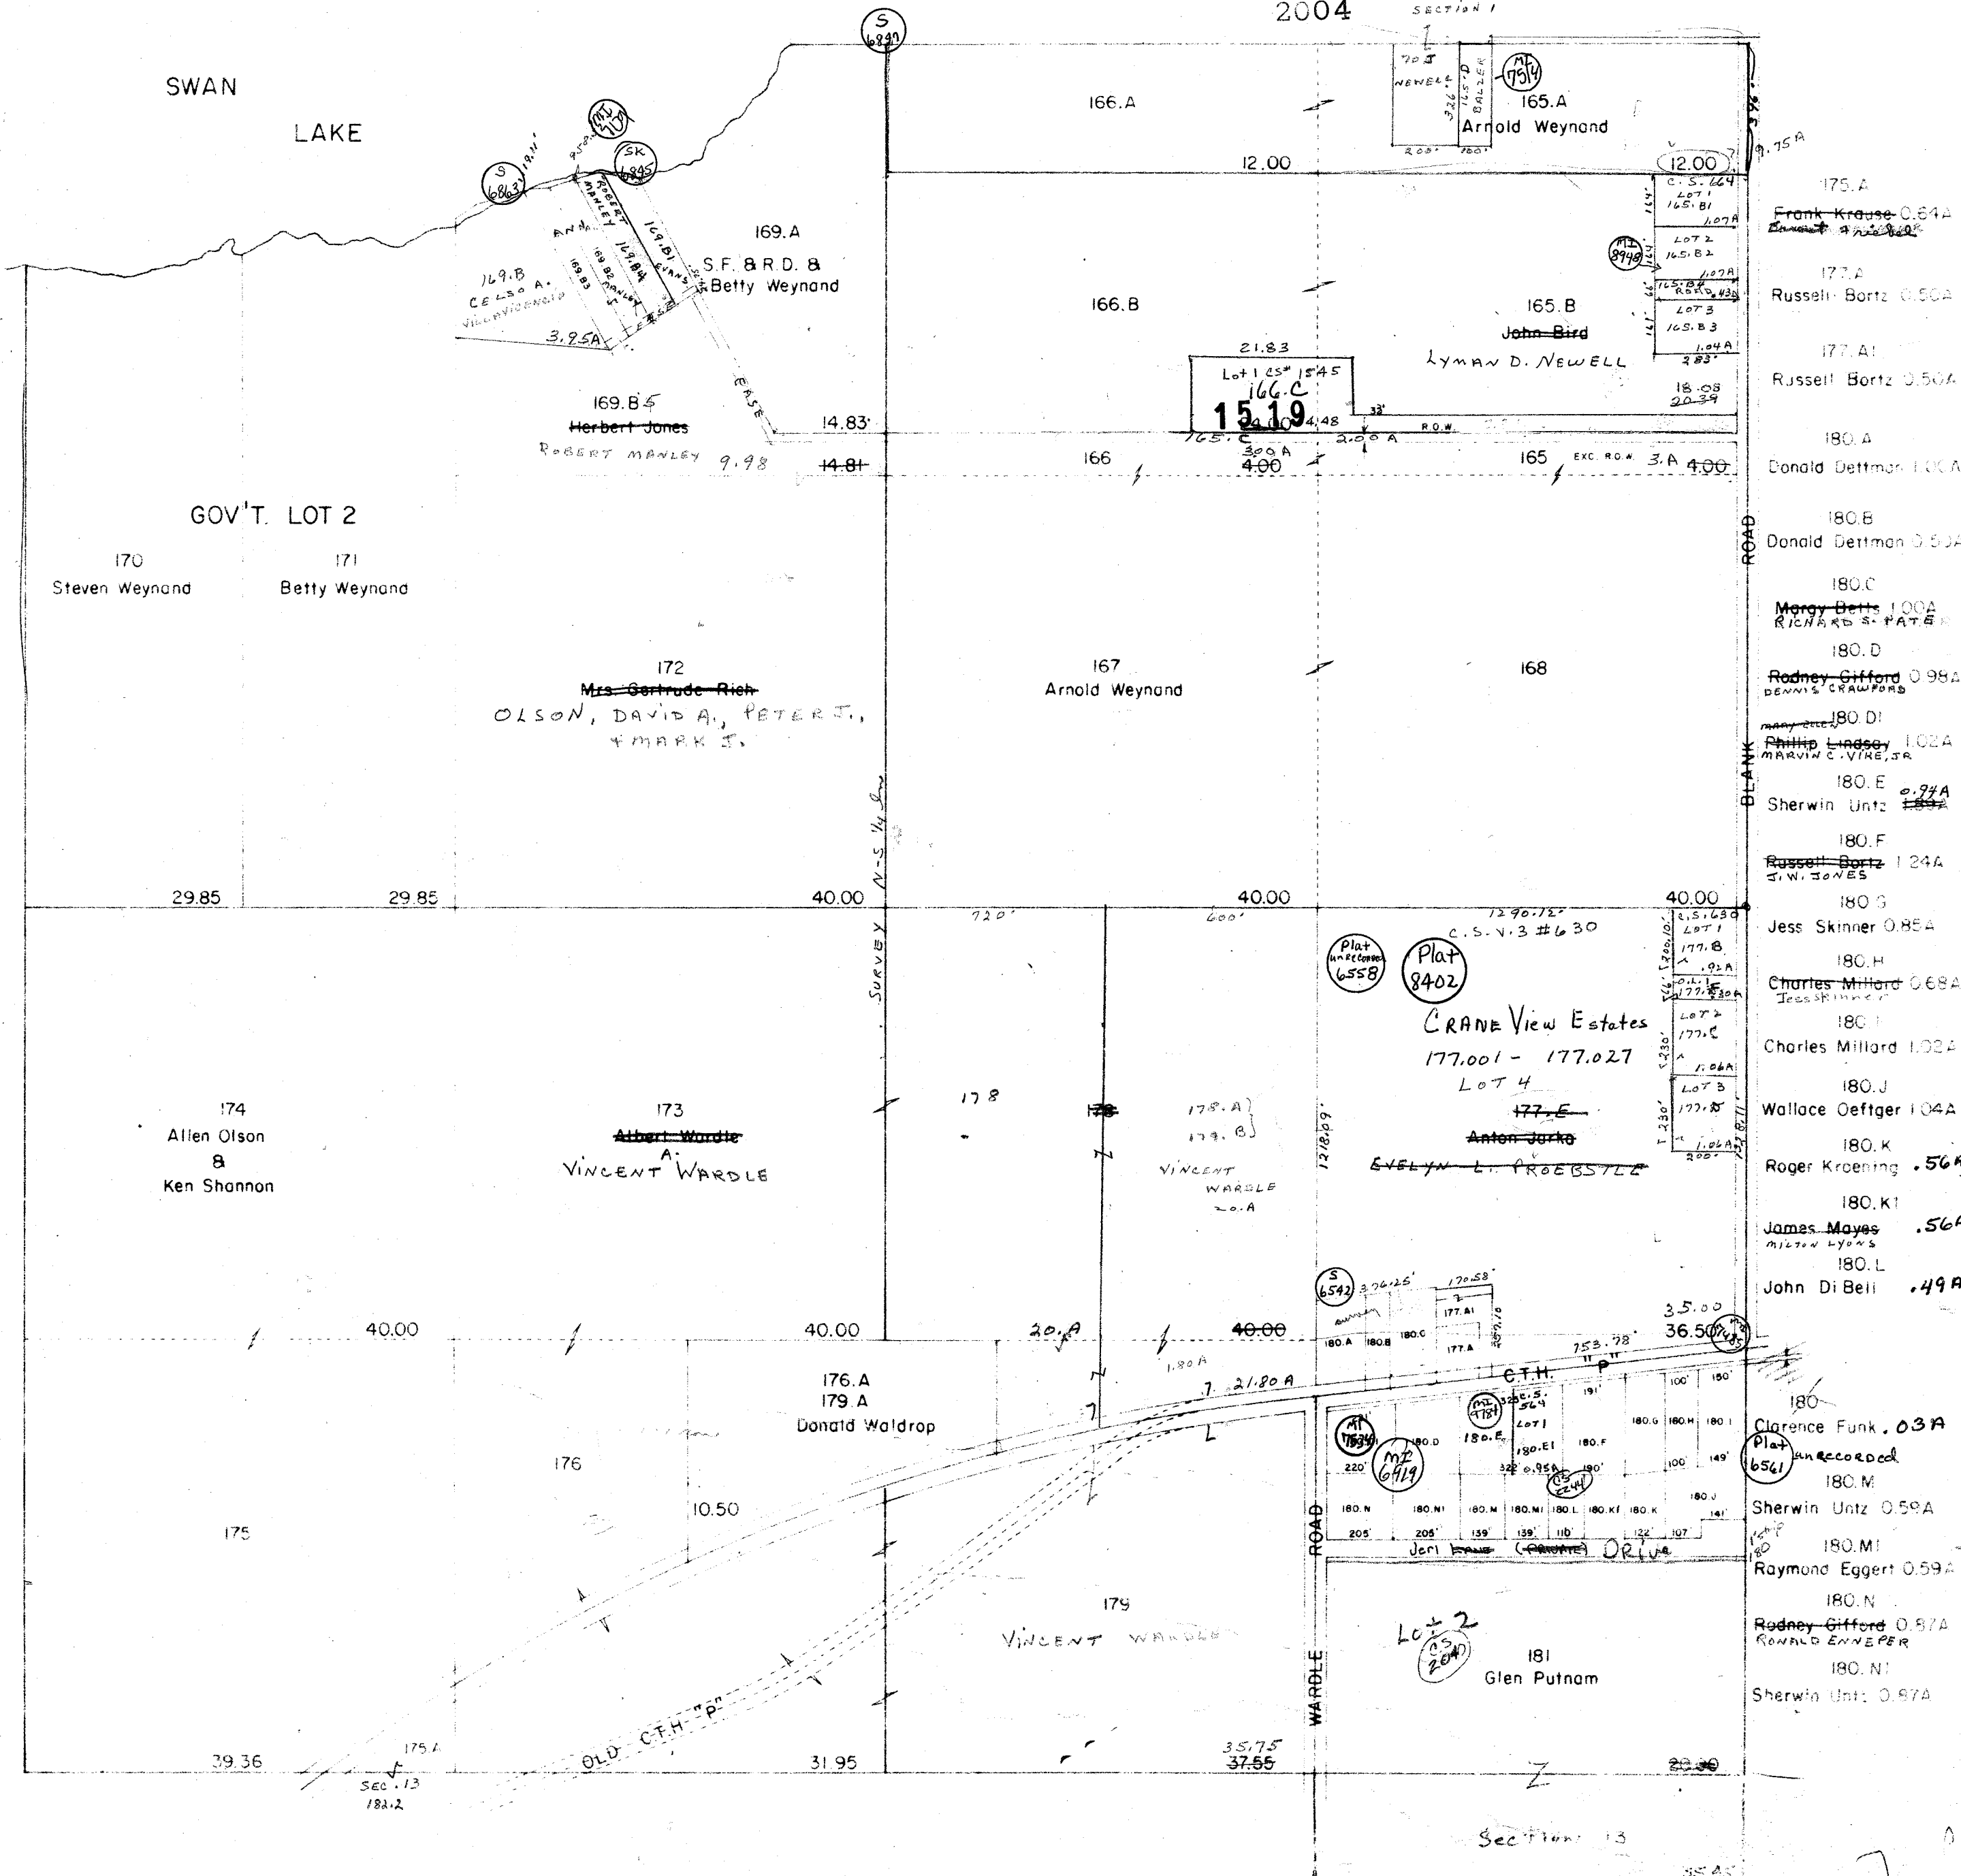

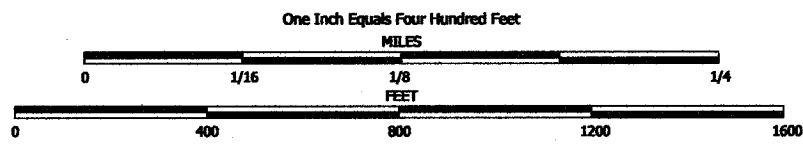

NOTE: This map was prepared for assessment use in accordance with the Wis. Stat. Chap. 70.09. All information contained herein is advisory only. Map accuracy is limited to the quality of data obtained from other public records. This map is not intended to be a substitute for an actual field survey. Public Land Survey Base is derived from U.S.G.S. Topographic maps unless otherwise noted. Other sources of the Land Base may be actual survey data. Base map data is from the April 1995 County Digital Orthophotos and/or U.S.G.S. 1:24,000 scale Topographic series. The user is responsible for the improper use of the data contained herein.


Created by The Columbia County Land Information Office - GIS Section. VMB, July 2004.

TAX PARCEL MAP

TOWN of PACIFIC


TOWN 12 NORTH RANGE 9 EAST
COLUMBIA COUNTY, WISCONSIN

Replaced
2005

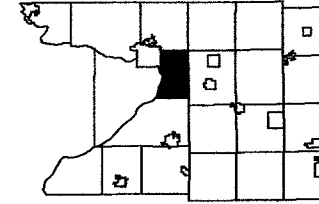

3	2	1
10	11	
15	14	13
22	23	24
28	27	26
33	34	35

-SEE SECTION 1-

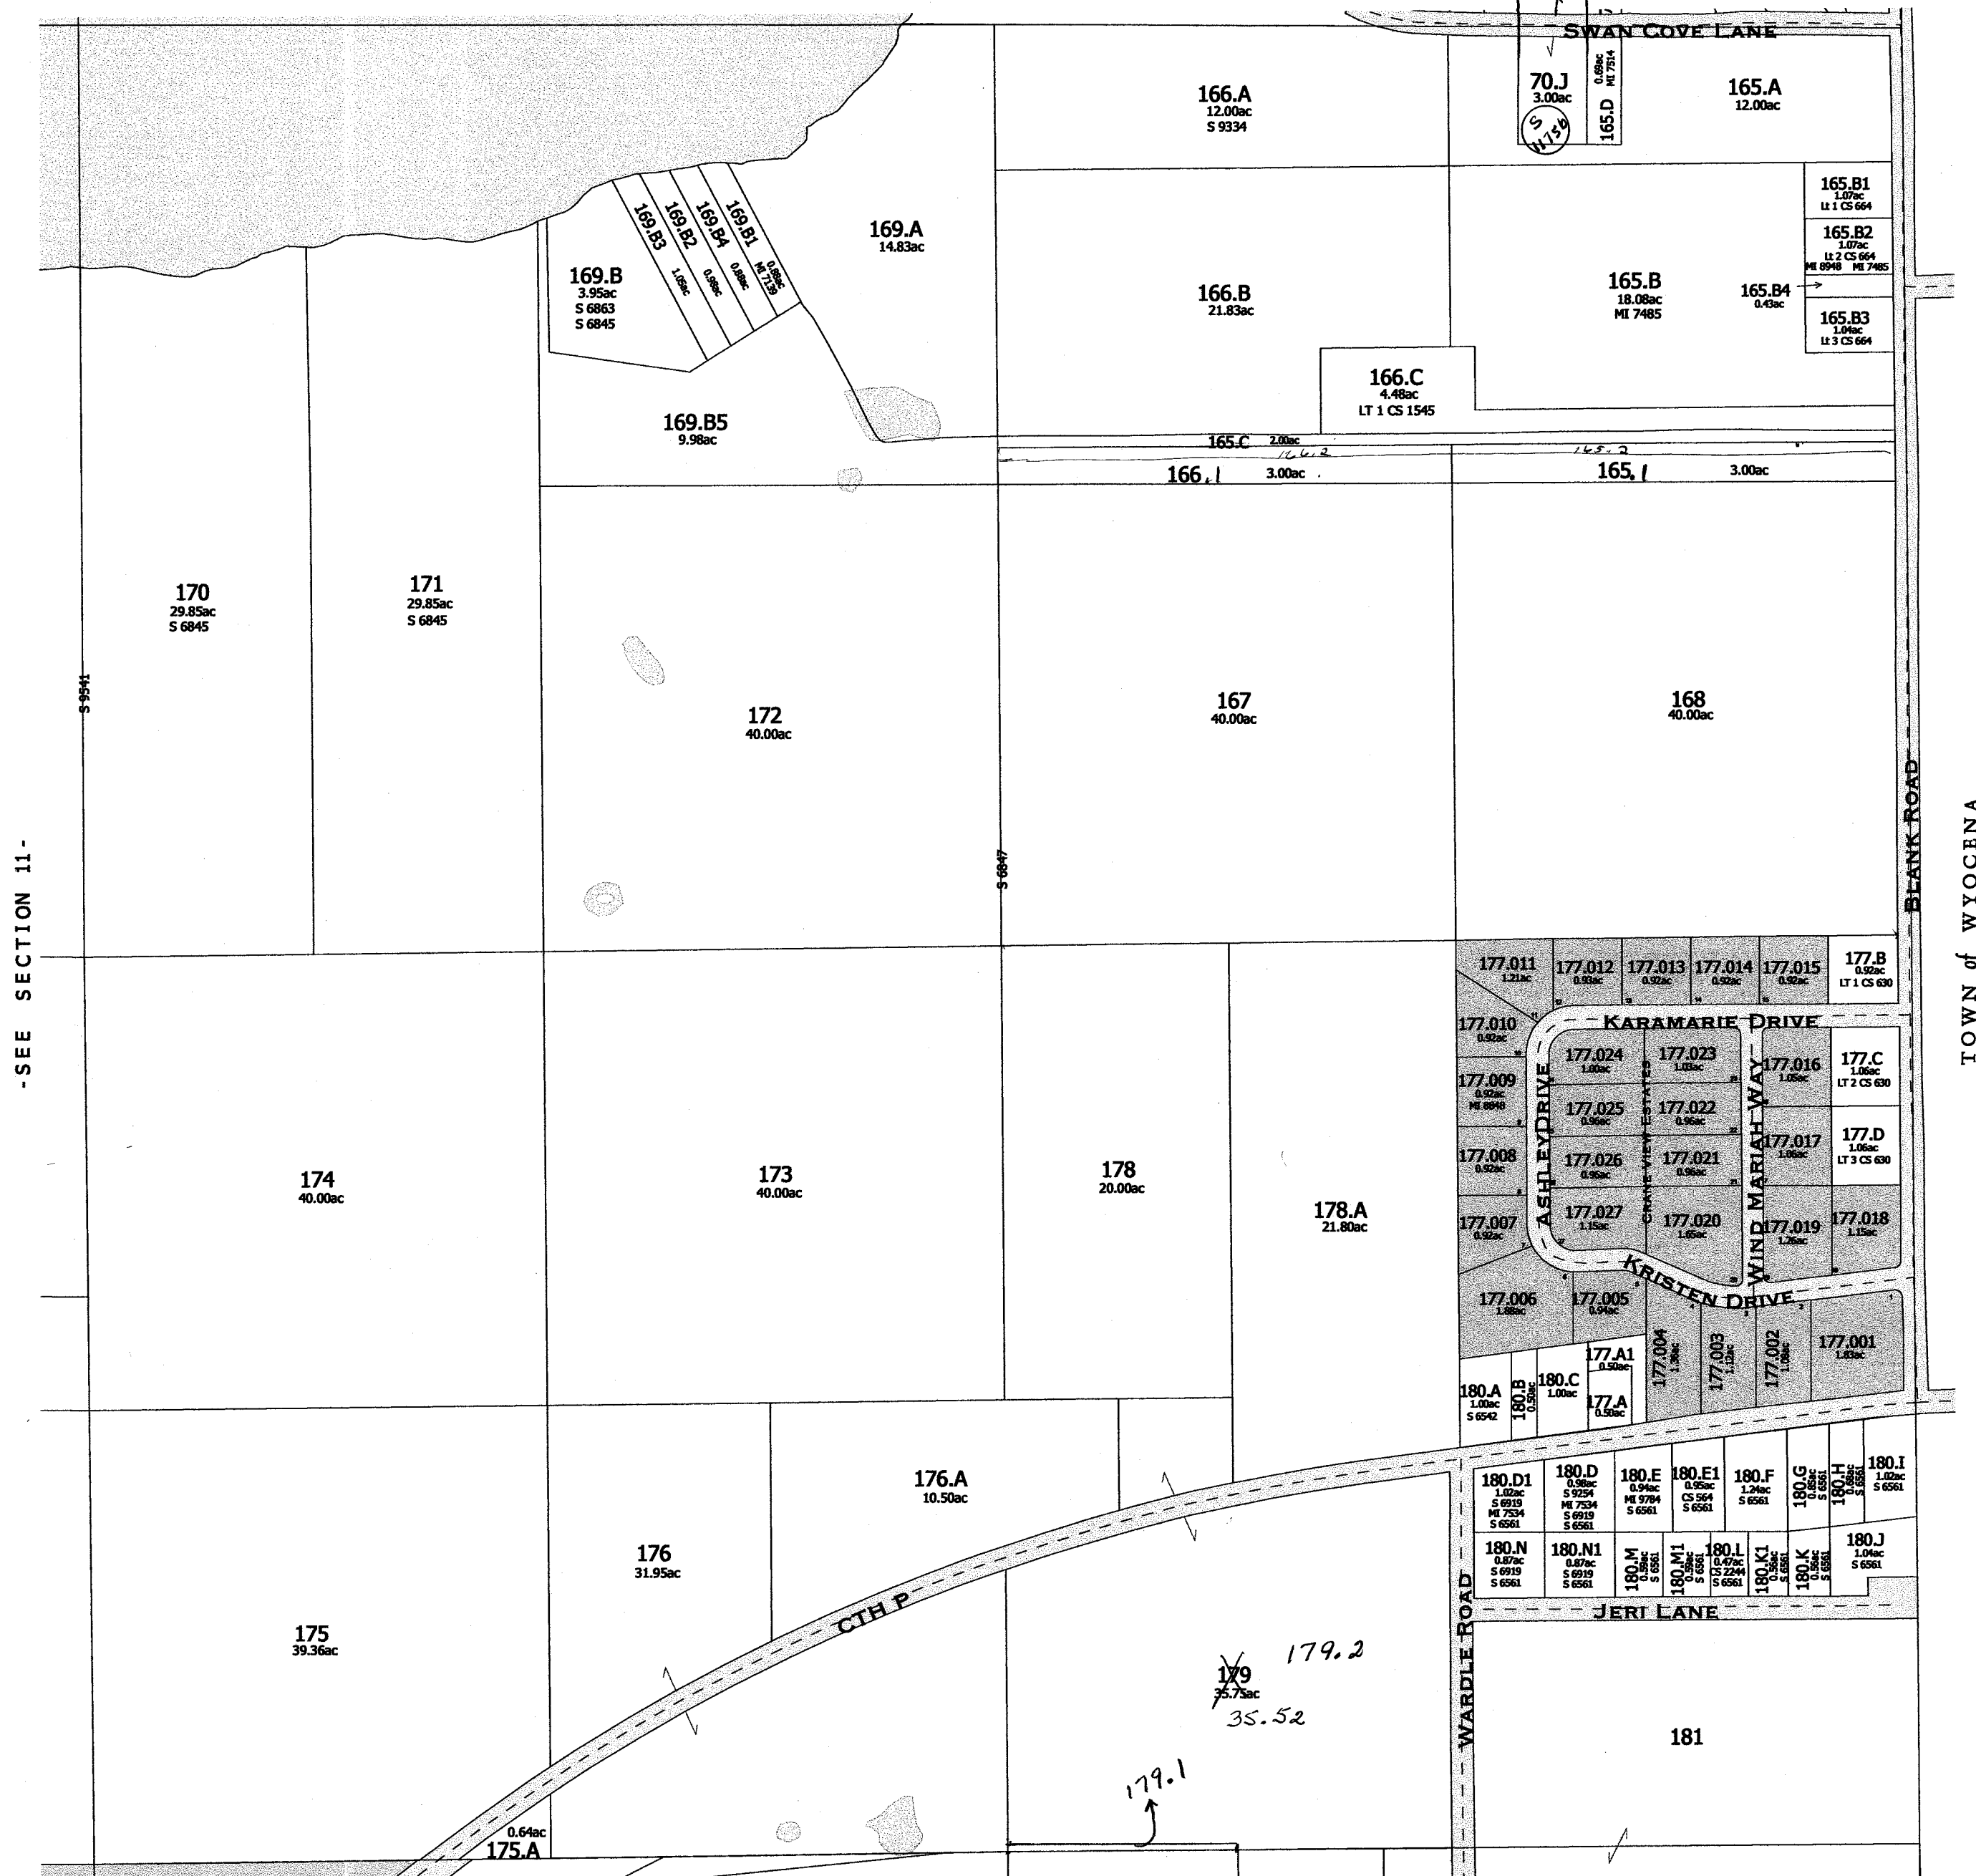


-SEE SECTION 13-

CRANEVIEW ESTATES - 86558, 8402

-SECTION 12-

2005

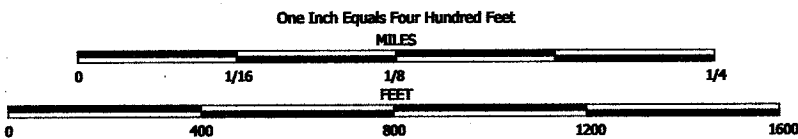

NOTE: This map was prepared for assessment use in accordance with the Wis. Stat. Chap. 70.09. All information contained herein is advisory only. Map accuracy is limited to the quality of data obtained from other Public Records. This map is not intended to be a substitute for an actual field survey. Public Land Survey Base is derived from U.S.G.S. Topographic maps unless otherwise noted. Other sources of the Land Base may be actual survey data. Base map data is from the April 1995 County Digital Orthophotos and/or U.S.G.S. 1:24,000 scale Topographic series. The user is responsible for the improper use of the data contained herein.


Created by The Columbia County Land Information Office -GIS Section. VMB, February 2006.

TAX PARCEL MAP

TOWN of PACIFIC


TOWN 12 NORTH RANGE 9 EAST
COLUMBIA COUNTY, WISCONSIN

Replaced
2007

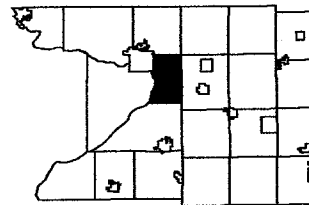

3	2	1
10	11	
15	14	13
22	23	24
29	27	26
33	34	35

-SEE SECTION 1-

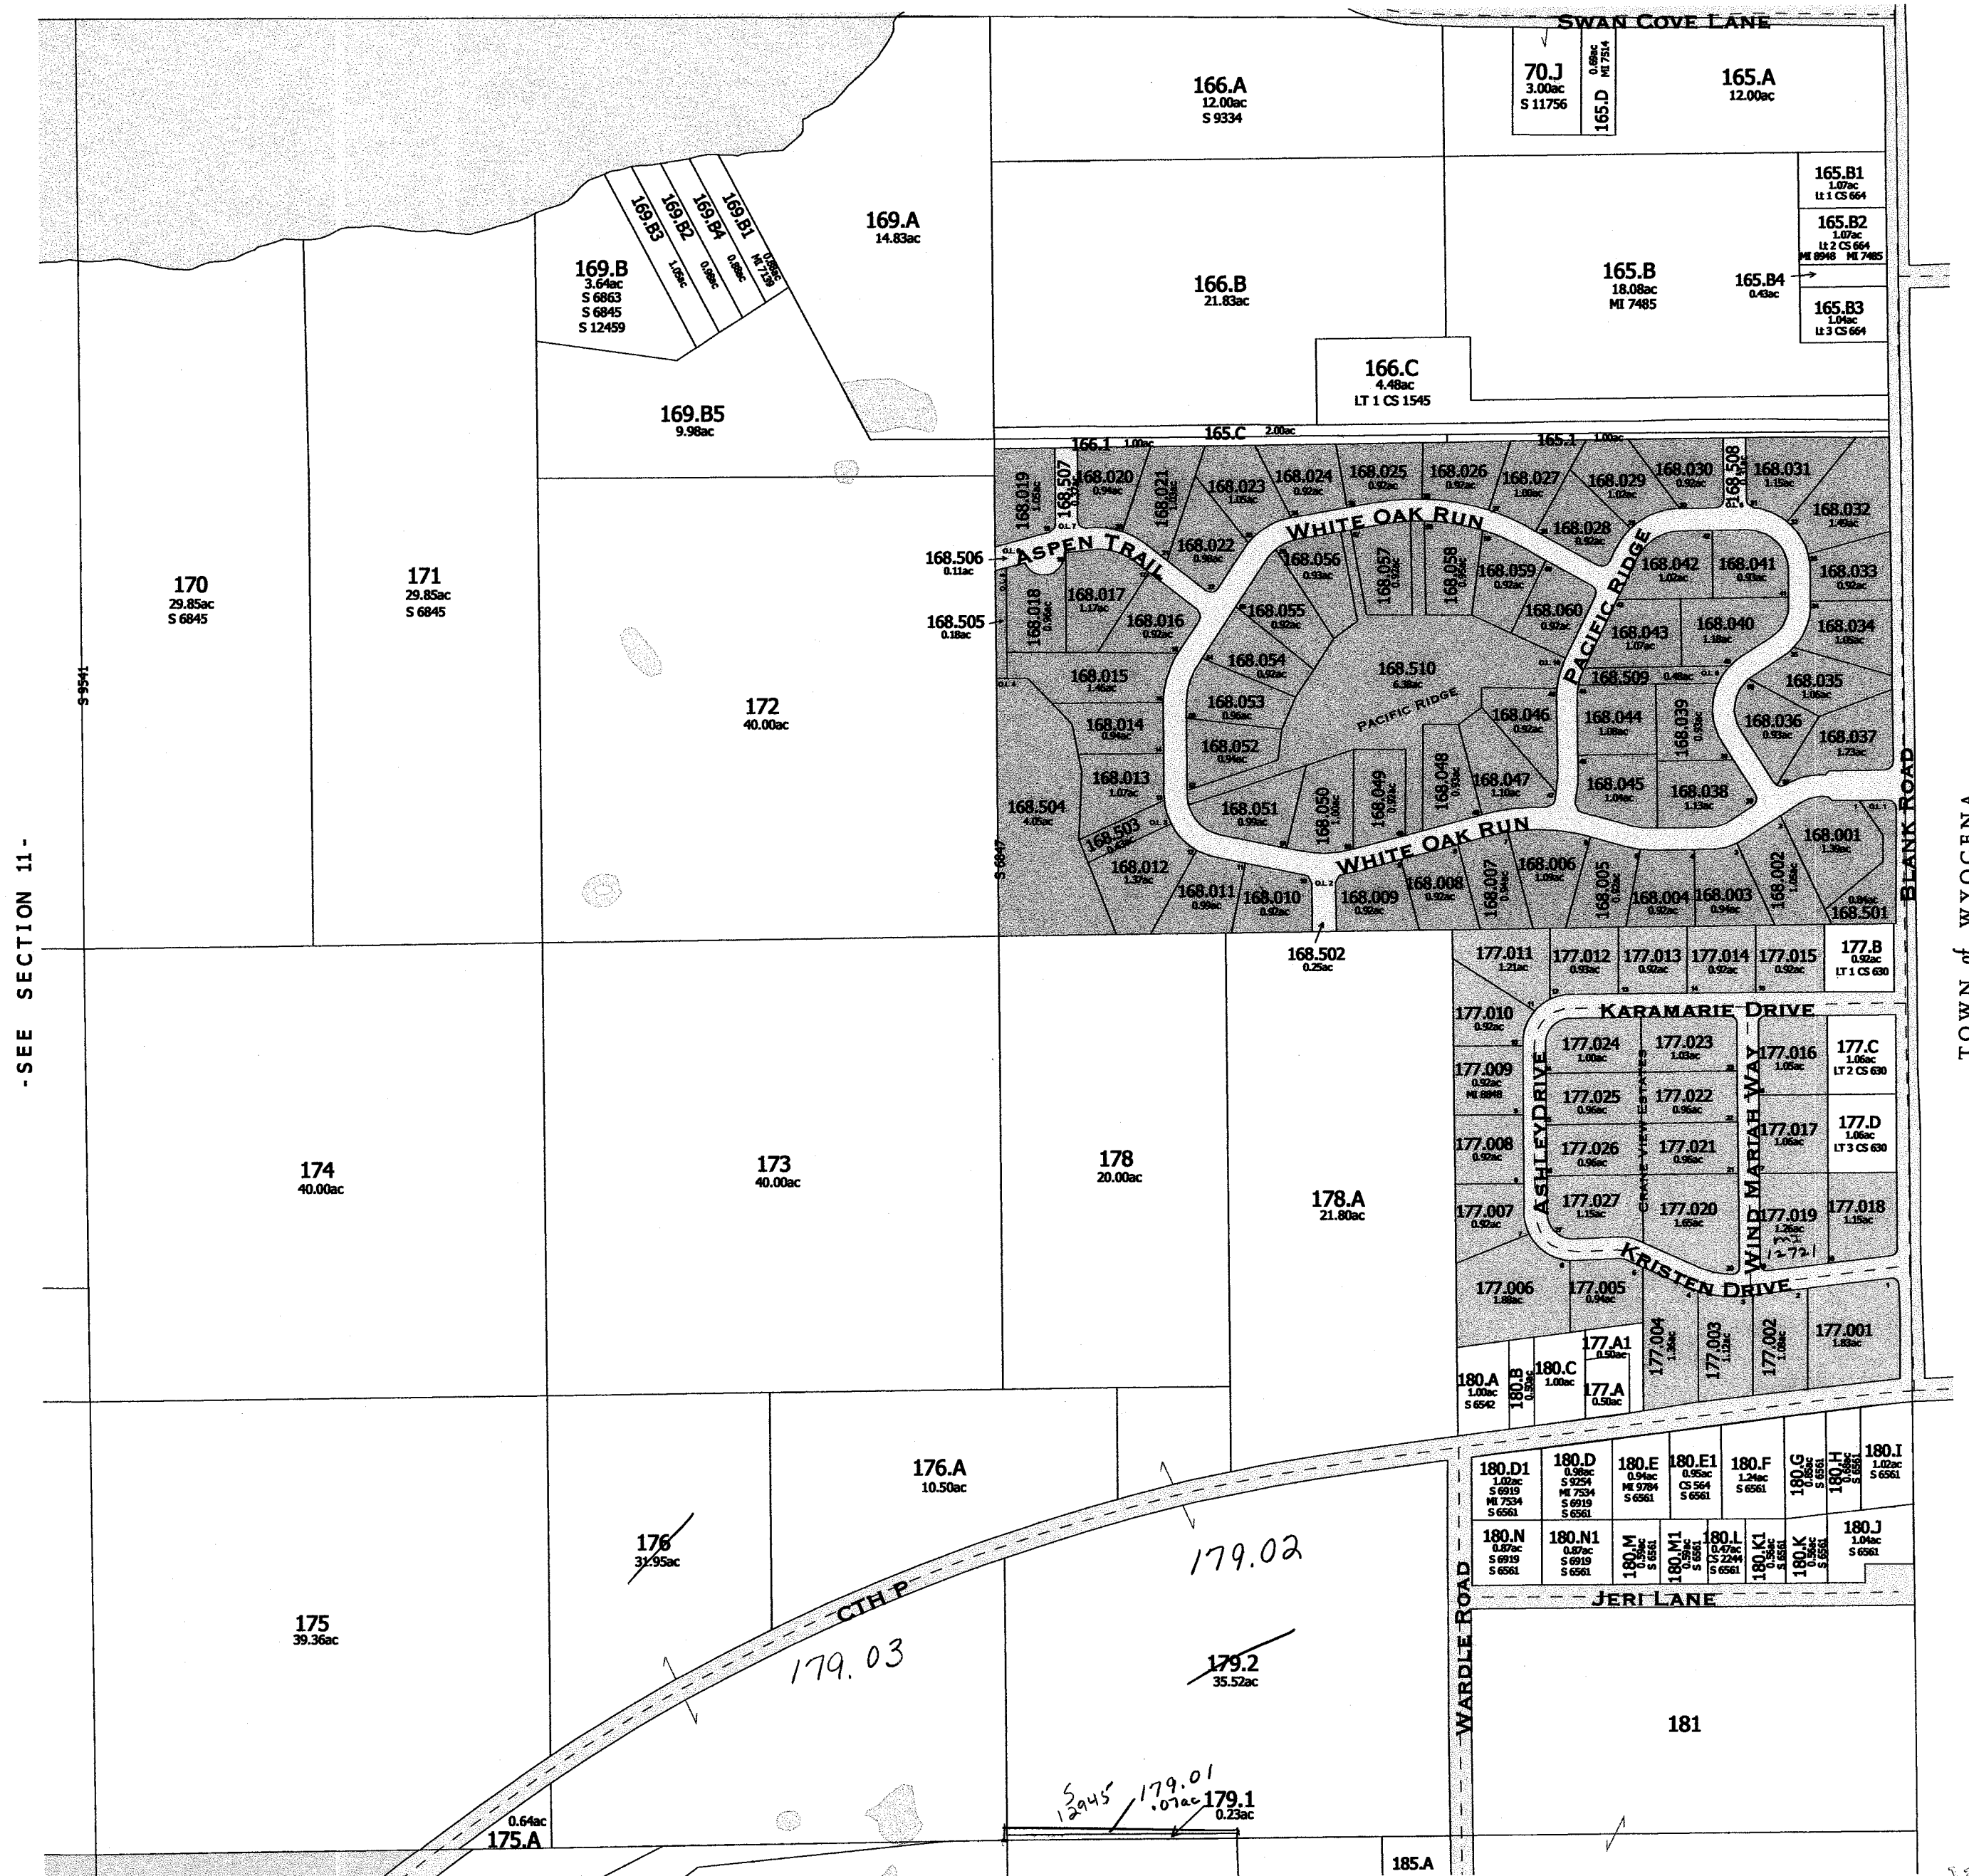

-SEE SECTION 11-

TOWN of WYOCENA

-SEE SECTION 13-

CRANEVIEW ESTATES - S6558, 8402


Replaced
2007

-SECTION 12-

PACIFIC

SEC. 13 T. 12N. R. 9E

Replaced
2004

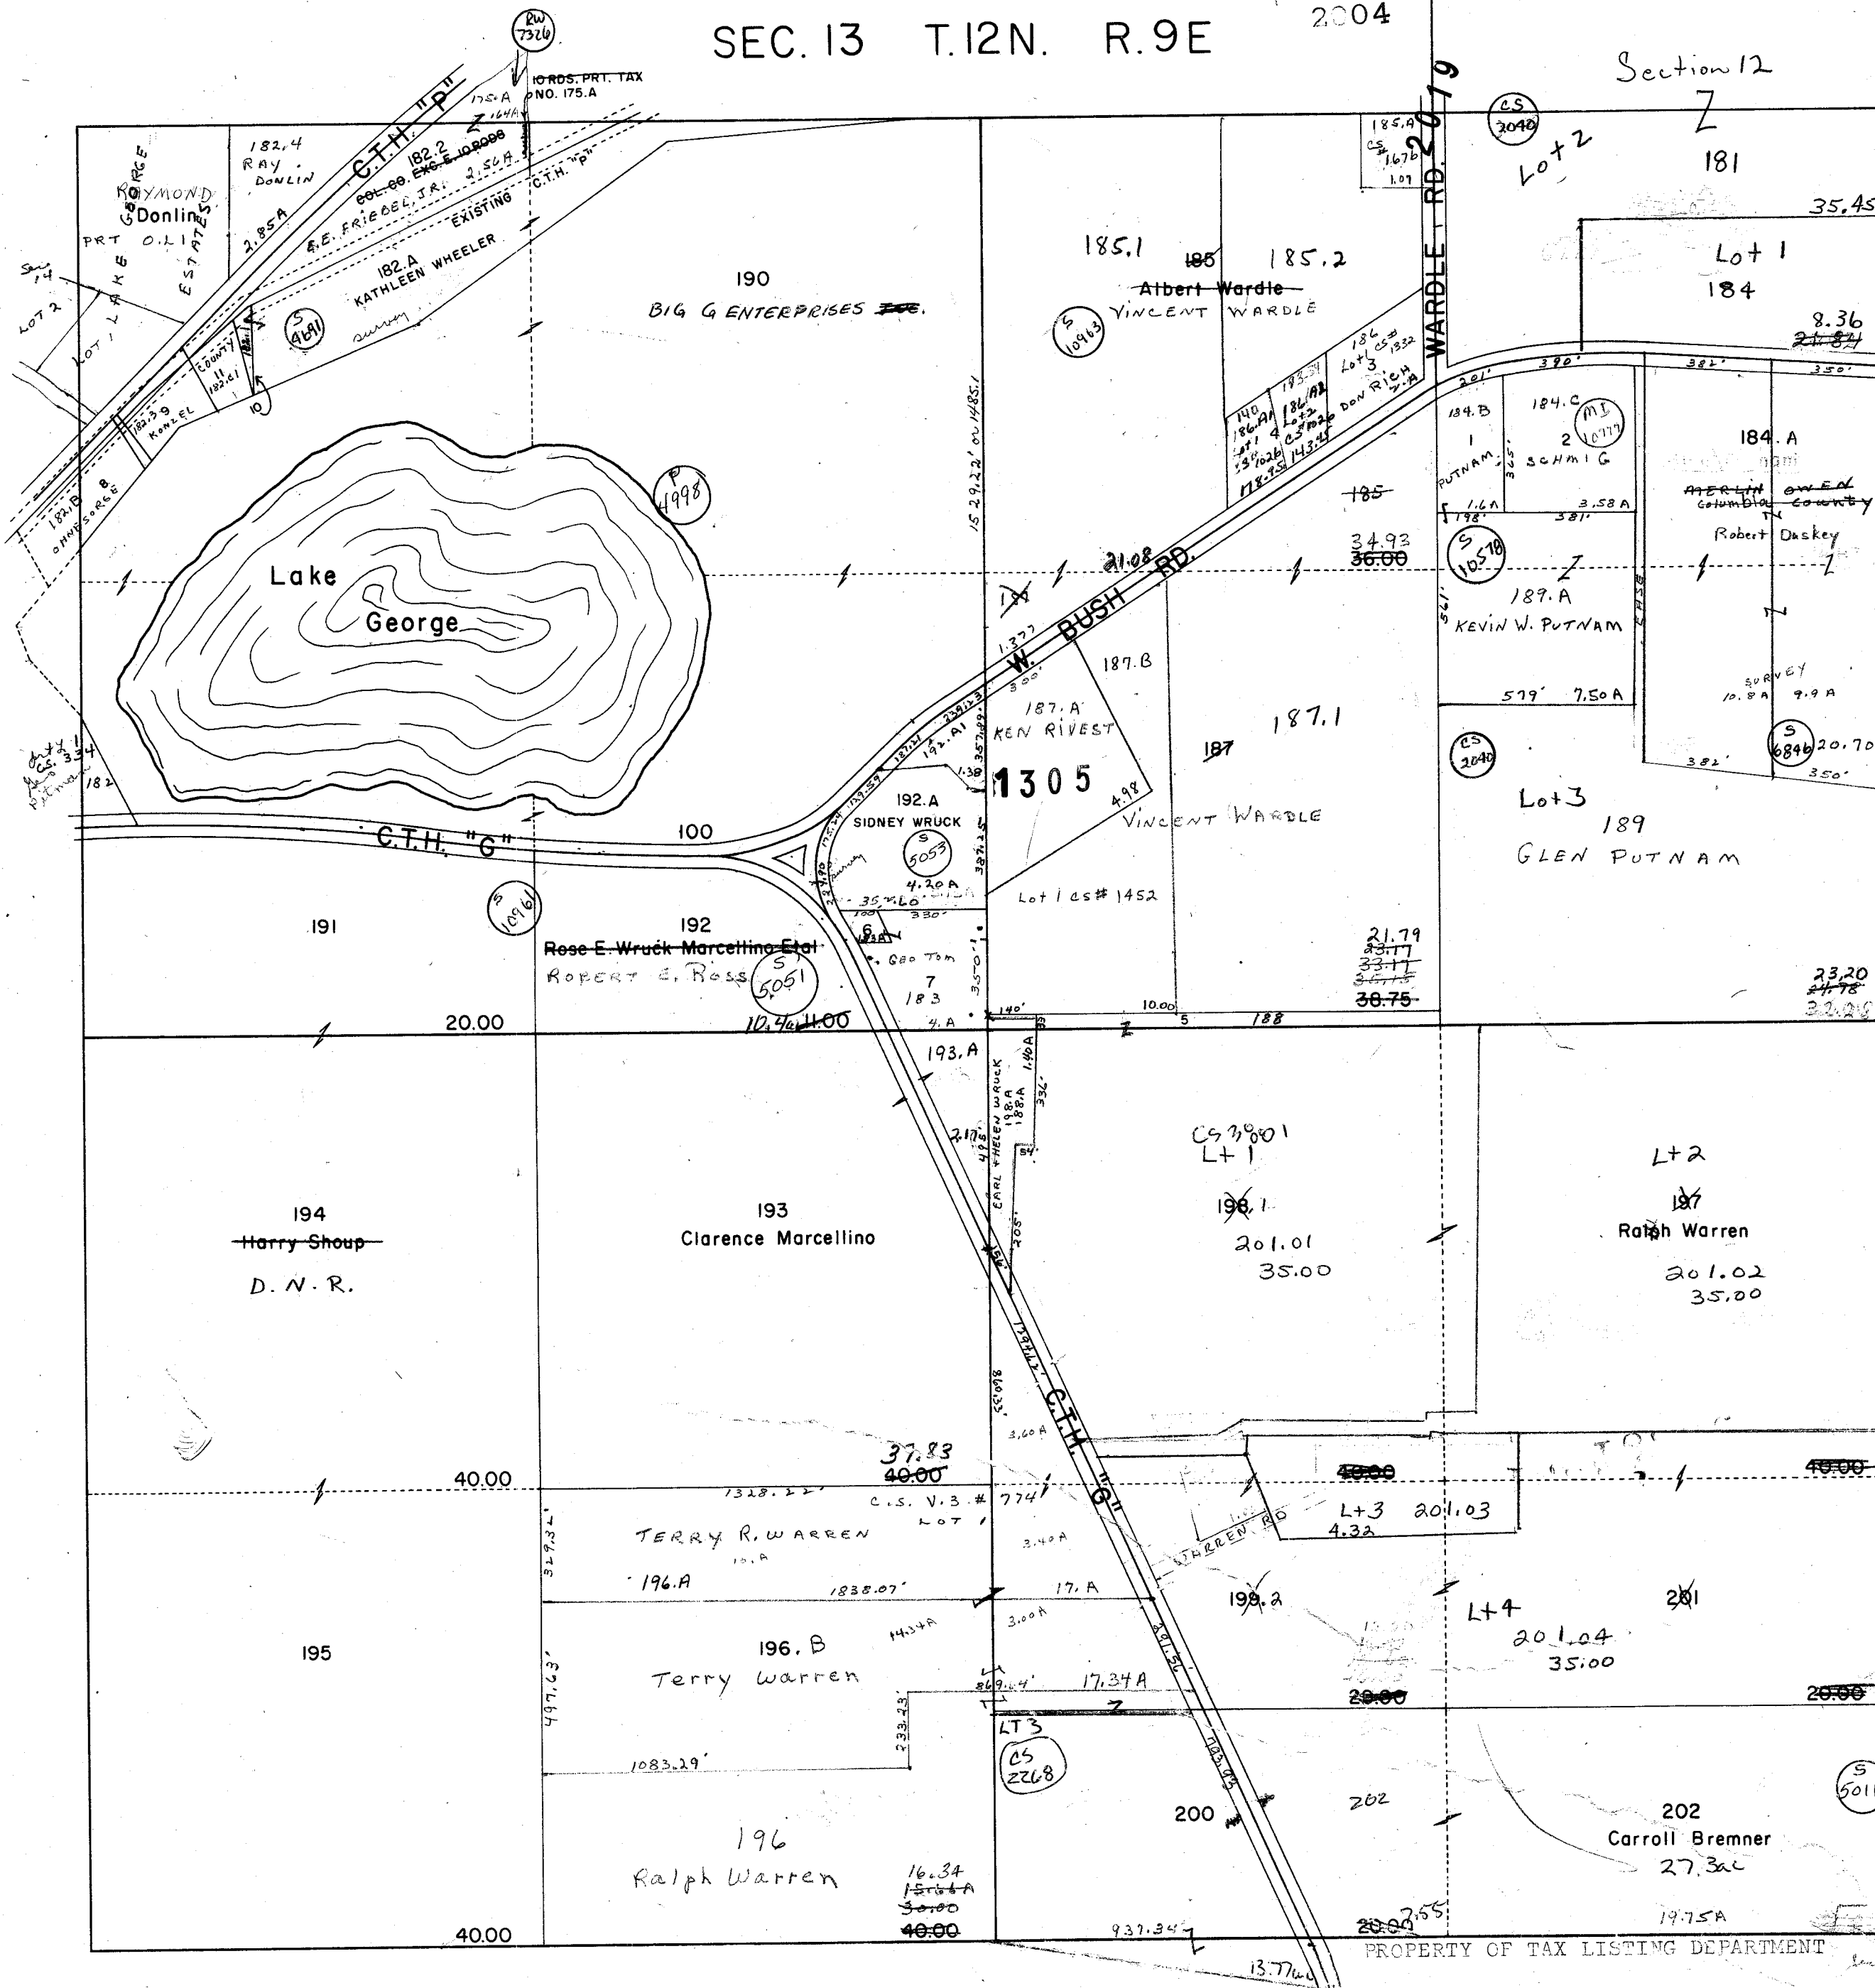

- 1-184.B Kevin Putnam
Keith Schmig
1.6A
- 2-184.C Keith Schmig
3.58A
- 3-186 Donald Rich
2.00A
- 4-186.A1+A2 Armond Rich
Theissen + Deane
2.00A
- 5-188 Ralph Warren 1.15A
+2.5A
- 6-183.A GEORGE TOM
0.25A
- 7-183 GEORGE TOM
3.75A
- 8-182.B Armin Ohnesorge 0.13A
- 9-182.3 Michael Konzel
- 10-182.1 Kathleen Wheeler
- 11-182.C1 Columbia County
- 192.A1 1.375A
wruck, Rivest P +
Rachmeyer

NOTE: 182.C
SAME AS TAX NO'S.
182.C1 & 182.1

PROPERTY OF TAX LISTING DEPARTMENT

One Inch Equals Four Hundred Feet

0 1/16 1/8 1/4
FEET
0 400 800 1200 1600


NOTE: This map was prepared for assessment use in accordance with the Wis. St. Stat. Chap. 70.09. All information contained herein is advisory only. Map accuracy is limited to the quality of data obtained from other Public Records. This map is not intended to be a substitute for an actual field survey. Public Land Survey Base is derived from U.S.G.S Topographic maps unless otherwise noted. Other sources of the Land Base may be actual survey data. Base map data is from the April 1995 County Digital Orthophotos and/or U.S.G.S 1:24,000 scale Topographic series. The user is responsible for the improper use of the data contained herein.

Created by The Columbia County Land Information Office -GIS Section, VMB, July 2004.

TAX PARCEL MAP


TOWN of PACIFIC


TOWN 12 NORTH RANGE 9 EAST
COLUMBIA COUNTY, WISCONSIN

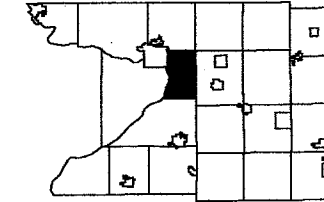

3	2	1
10	11	12
15	14	13
22	23	24
28	27	26
33	34	35

Replaced
2006

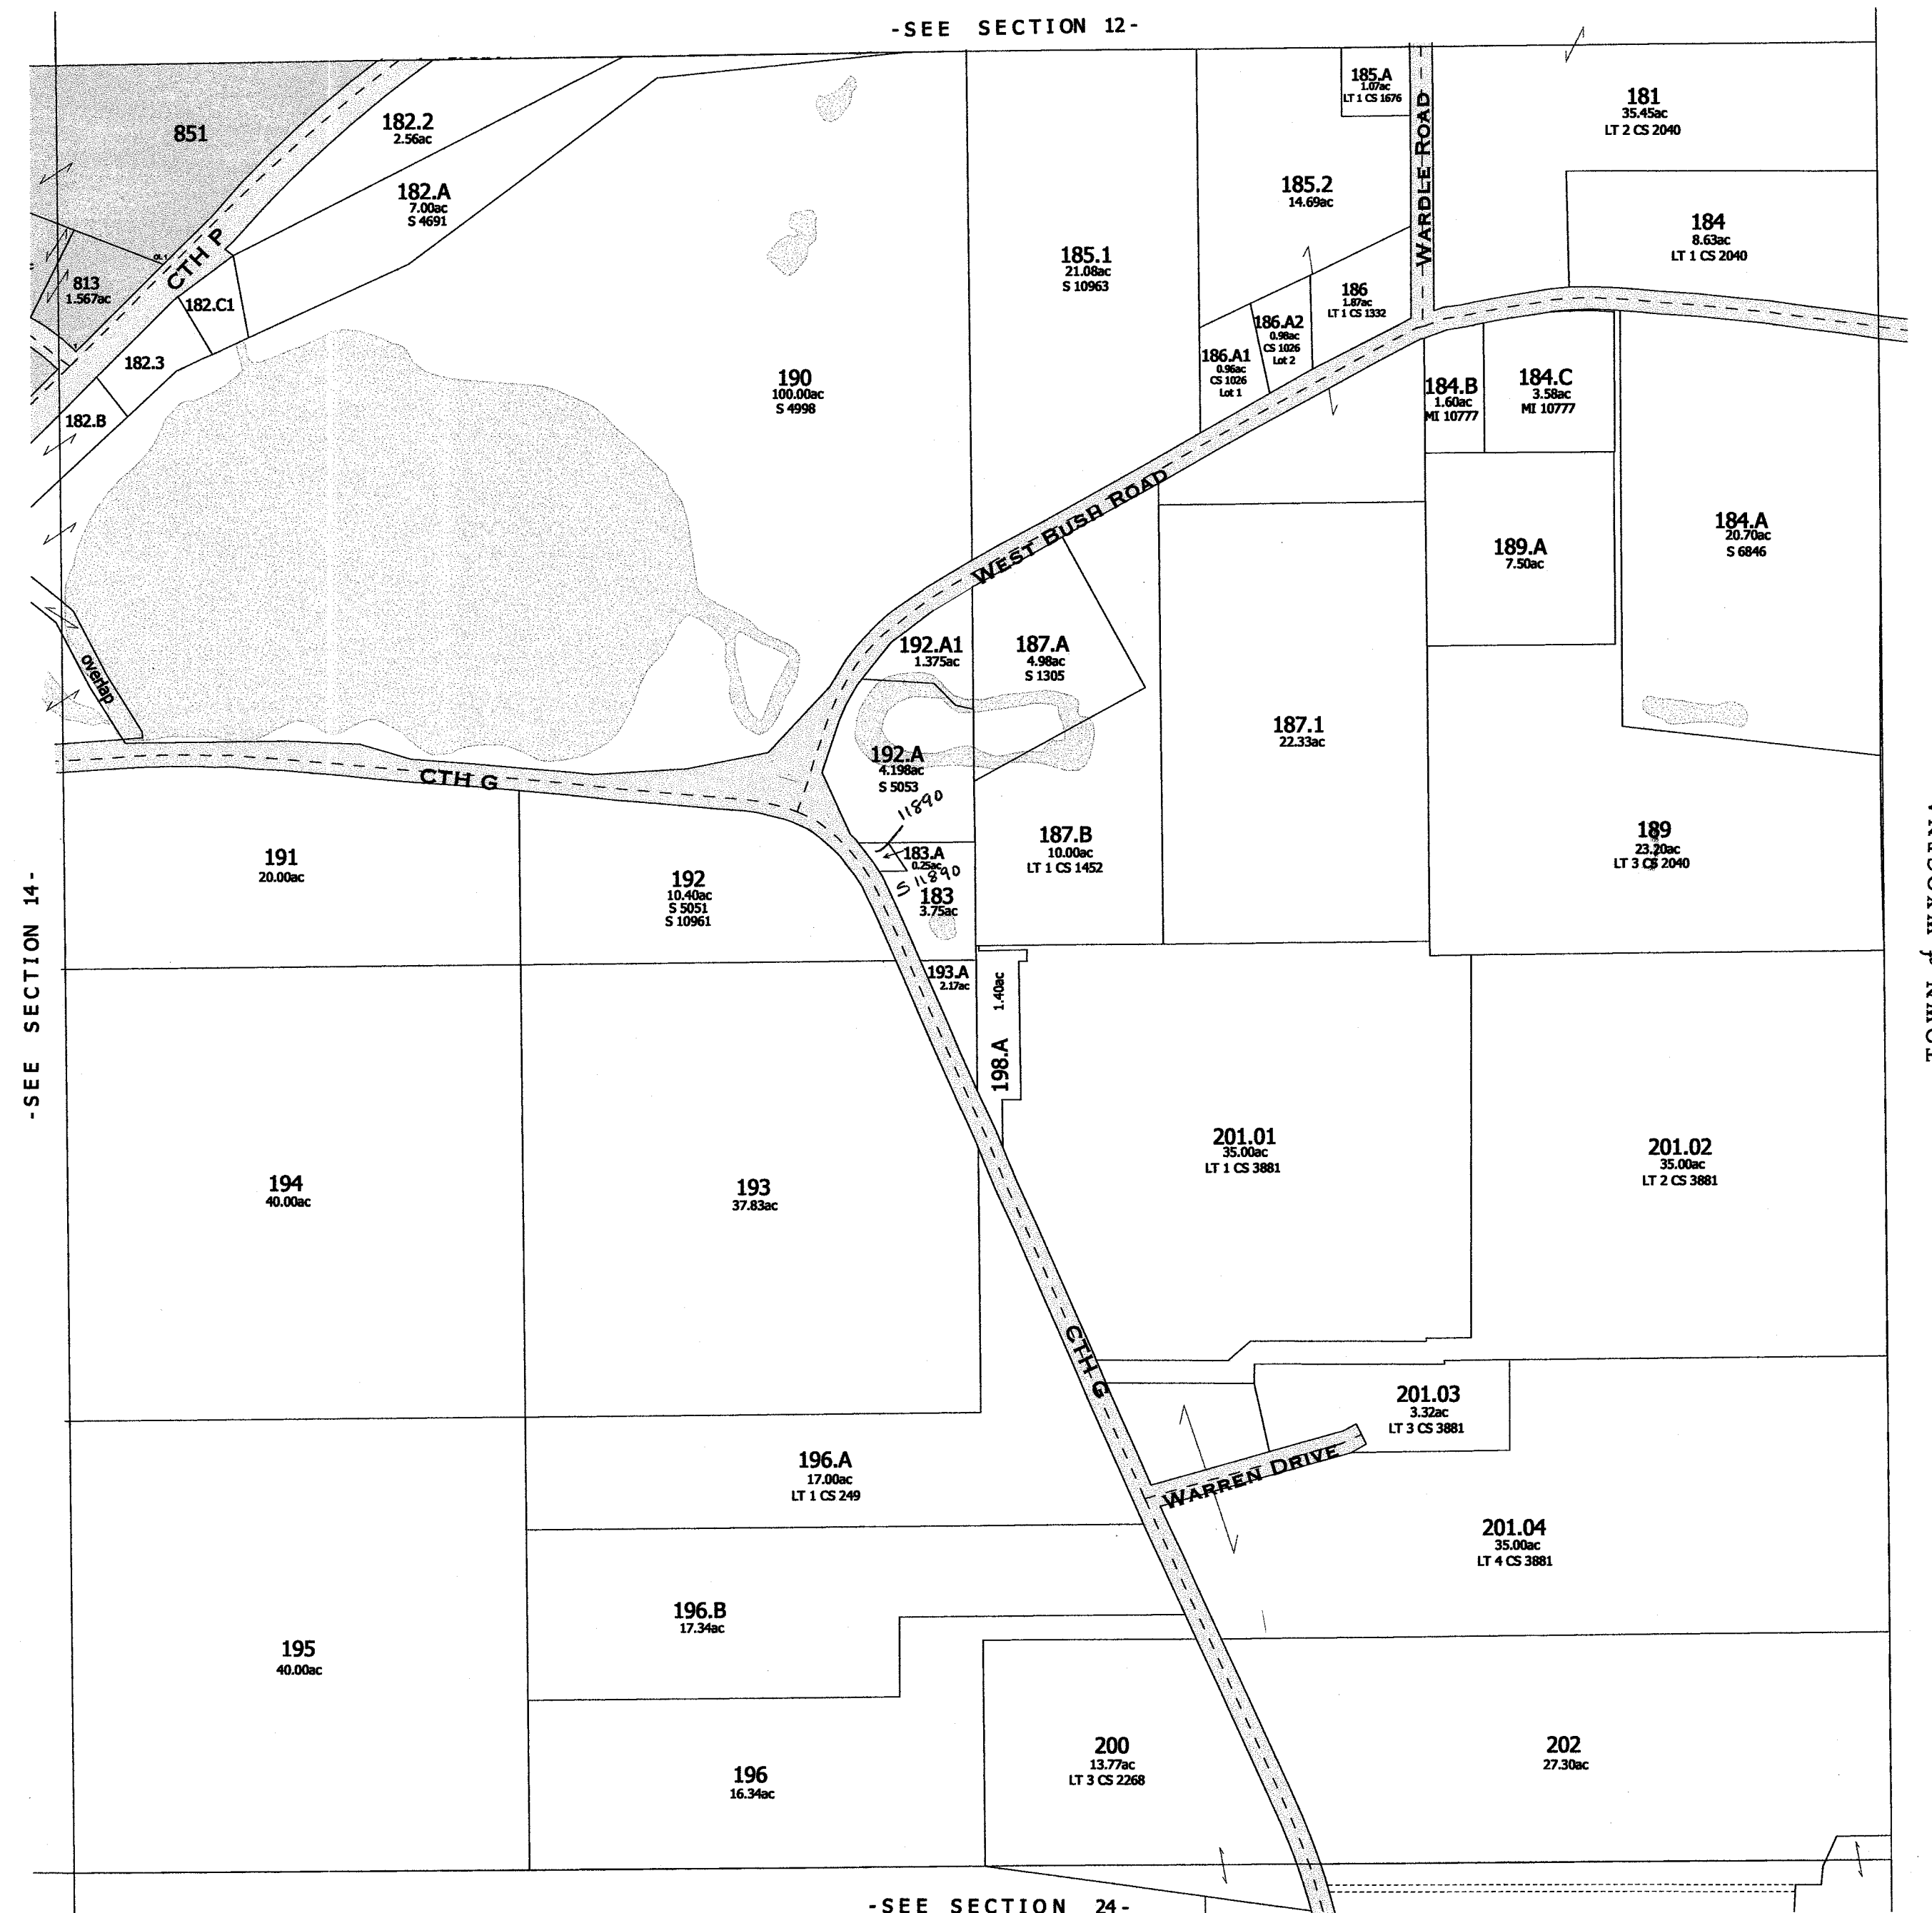


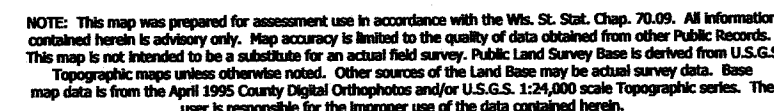


Created by The Columbia County Land Information Office -GIS Section. VMB. February 2006

TOWN of PACIFIC

TOWN 12 NORTH RANGE 9 EAST
COLUMBIA COUNTY, WISCONSIN

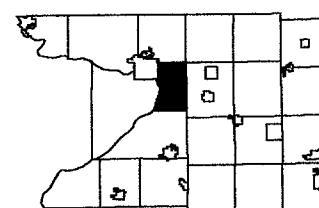


~~Replaced~~
2007

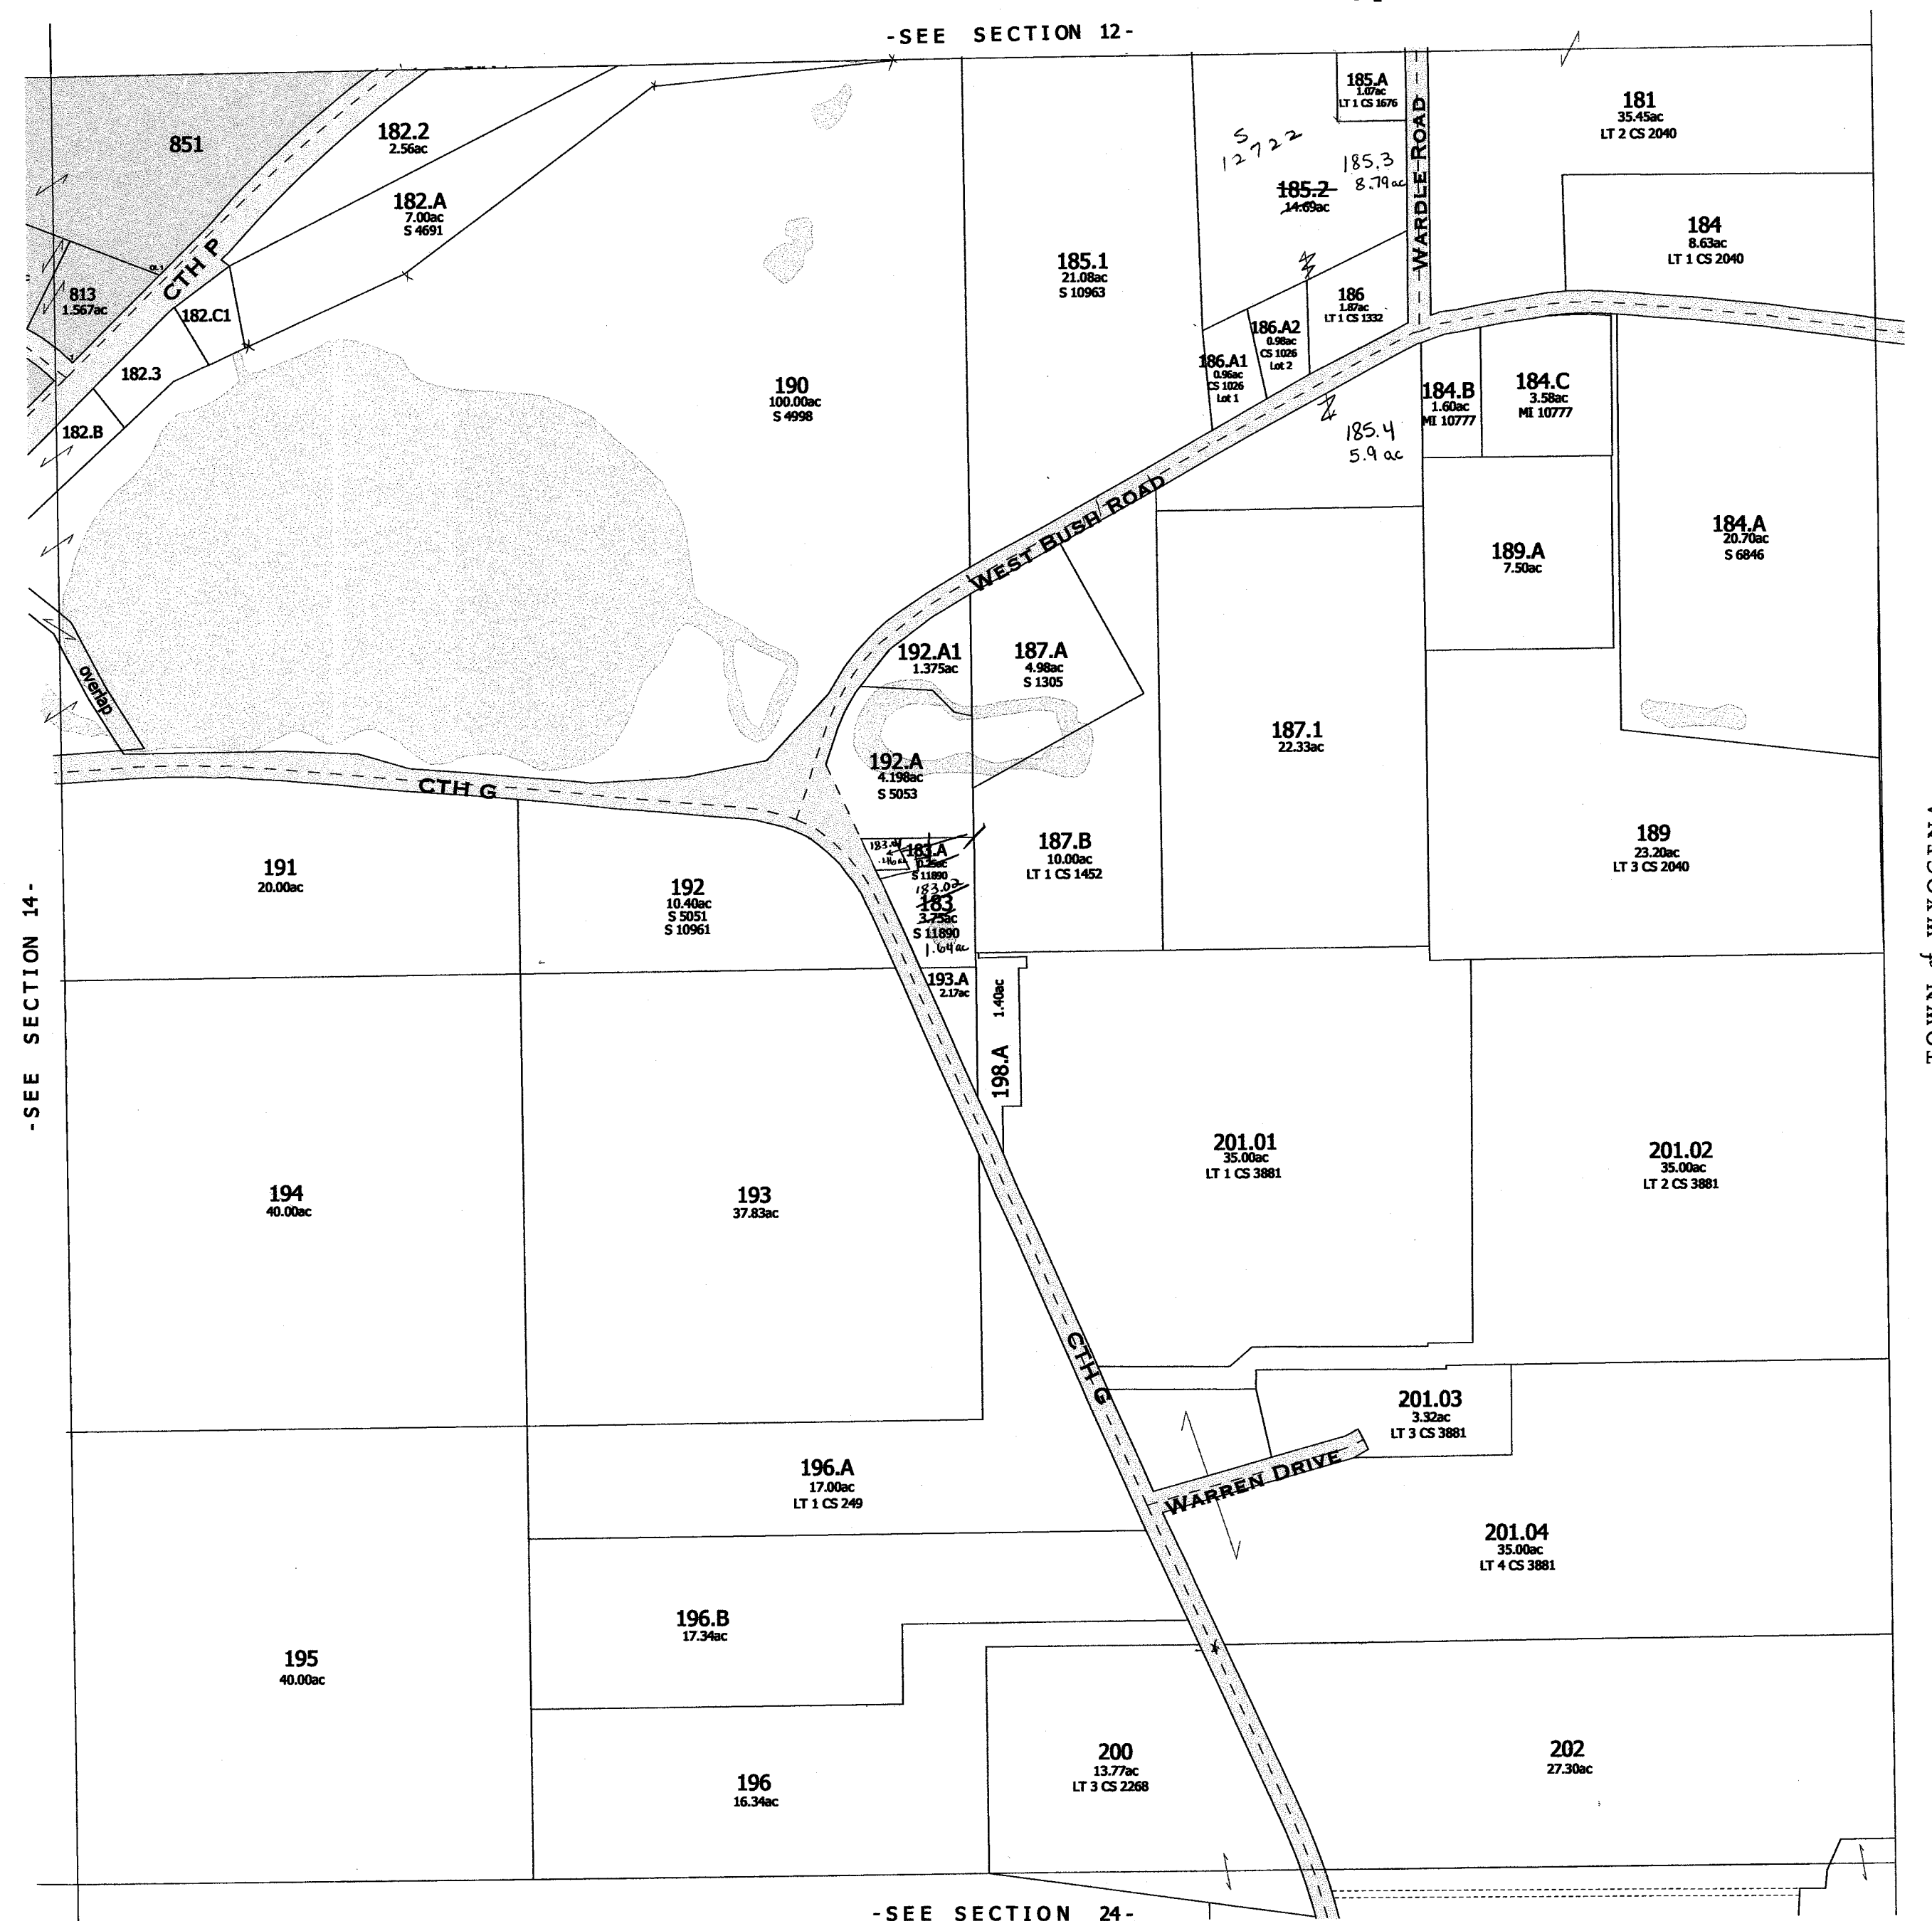


Replaced
2007

-SECTION 13-

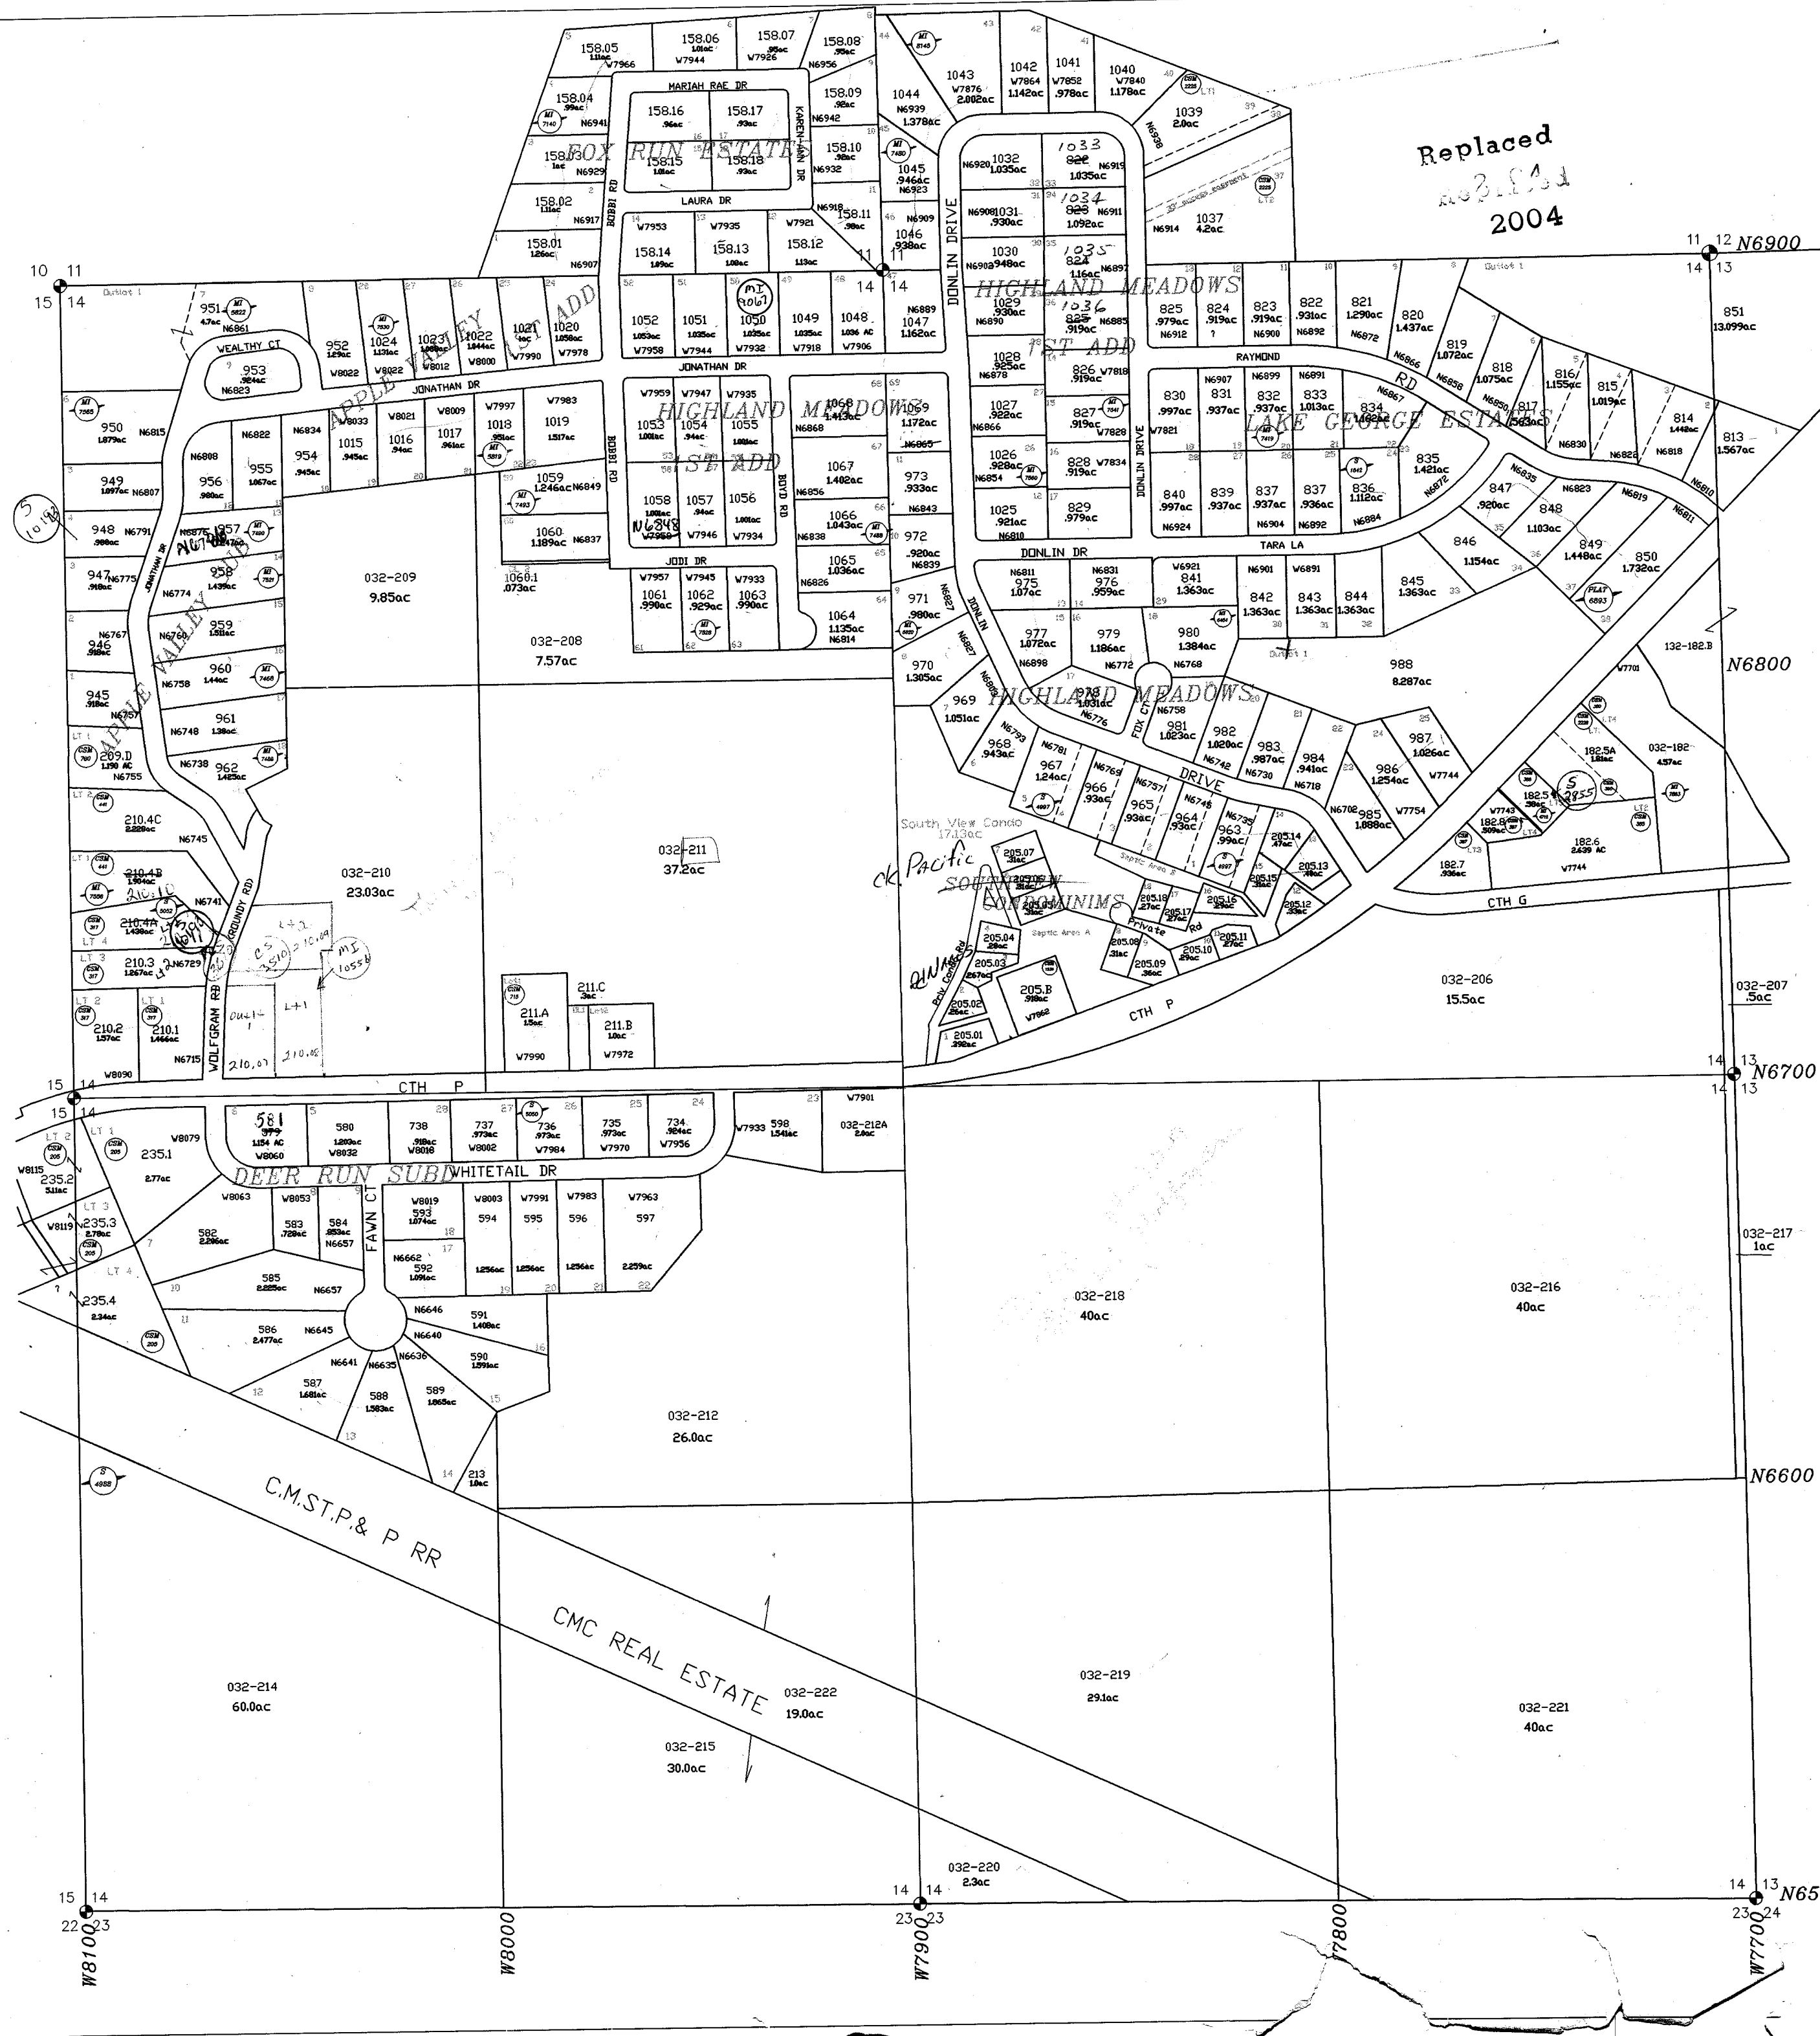

Town 12 North-Range 9 East
SECTION 14
Town of Pacific

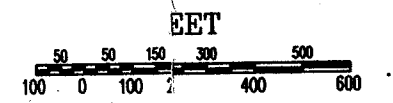


- 1. Plat on File
- 2. Survey on File
- 3. Certified Survey Map
- 4. Heritage Inspection on File
- 5. Instrumented Section Corner
- LT 1 or ...lot number of CSM/Plat

NOTE: This map is prepared for assessment use in accordance with Wis. Stat. Chap. 70.05. All information contained herein is advisory only. Map accuracy is limited to the quality of data obtained from other Public Records. This map is not intended to be a substitute for an actual field survey.

SEE QUARTER SECTION A
FOR MORE DETAILS ON SUBI

- 1. Apple Valley
- 2. Apple Valley 1st Add
- 3. Deer Run Subd.
- 4. Highland Meadows
- 5. Lake George Estates
- 6. Fox Run Estates
- 7. Highland Meadows 1st Add

COLUMBIA COUN	
Land Information	
Portage, Wisco	
ORIGINAL SCALE: 1" = 400'	LATES
DATE: 06/13/96	CAD Filename: 1412
SEC-TOWN-RANGE	
14-	2-09

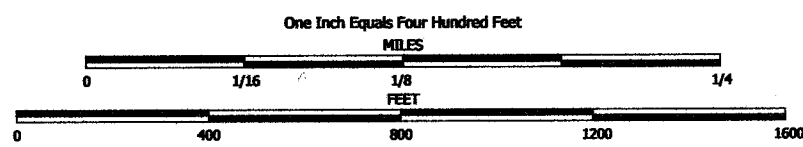


NOTE: This map was prepared for assessment use in accordance with the Wis. Stat. Chap. 70.09. All information contained herein is advisory only. Map accuracy is limited to the quality of data obtained from other Public Records. This map is not intended to be a substitute for an actual field survey. Public Land Survey Base is derived from U.S.G.S. Topographic maps unless otherwise noted. Other sources of the Land Base may be actual survey data. Base map data is from the April 1995 County Digital Orthophotos and/or U.S.G.S. 1:24,000 scale Topographic series. The user is responsible for the proper use of the data contained herein.

Created by The Columbia County Land Information Office - GIS Section. VMB, July 2004.

TAX PARCEL MAP

TOWN of PACIFIC


TOWN 12 NORTH RANGE 9 EAST
COLUMBIA COUNTY, WISCONSIN

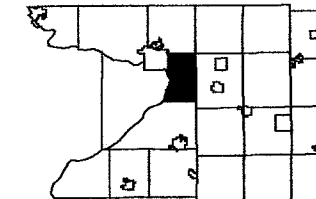

3	2	1
10	11	12
15	16	13
22	23	24
27	28	25
33	34	35

Replaced
2006

-SEE SECTION 11-

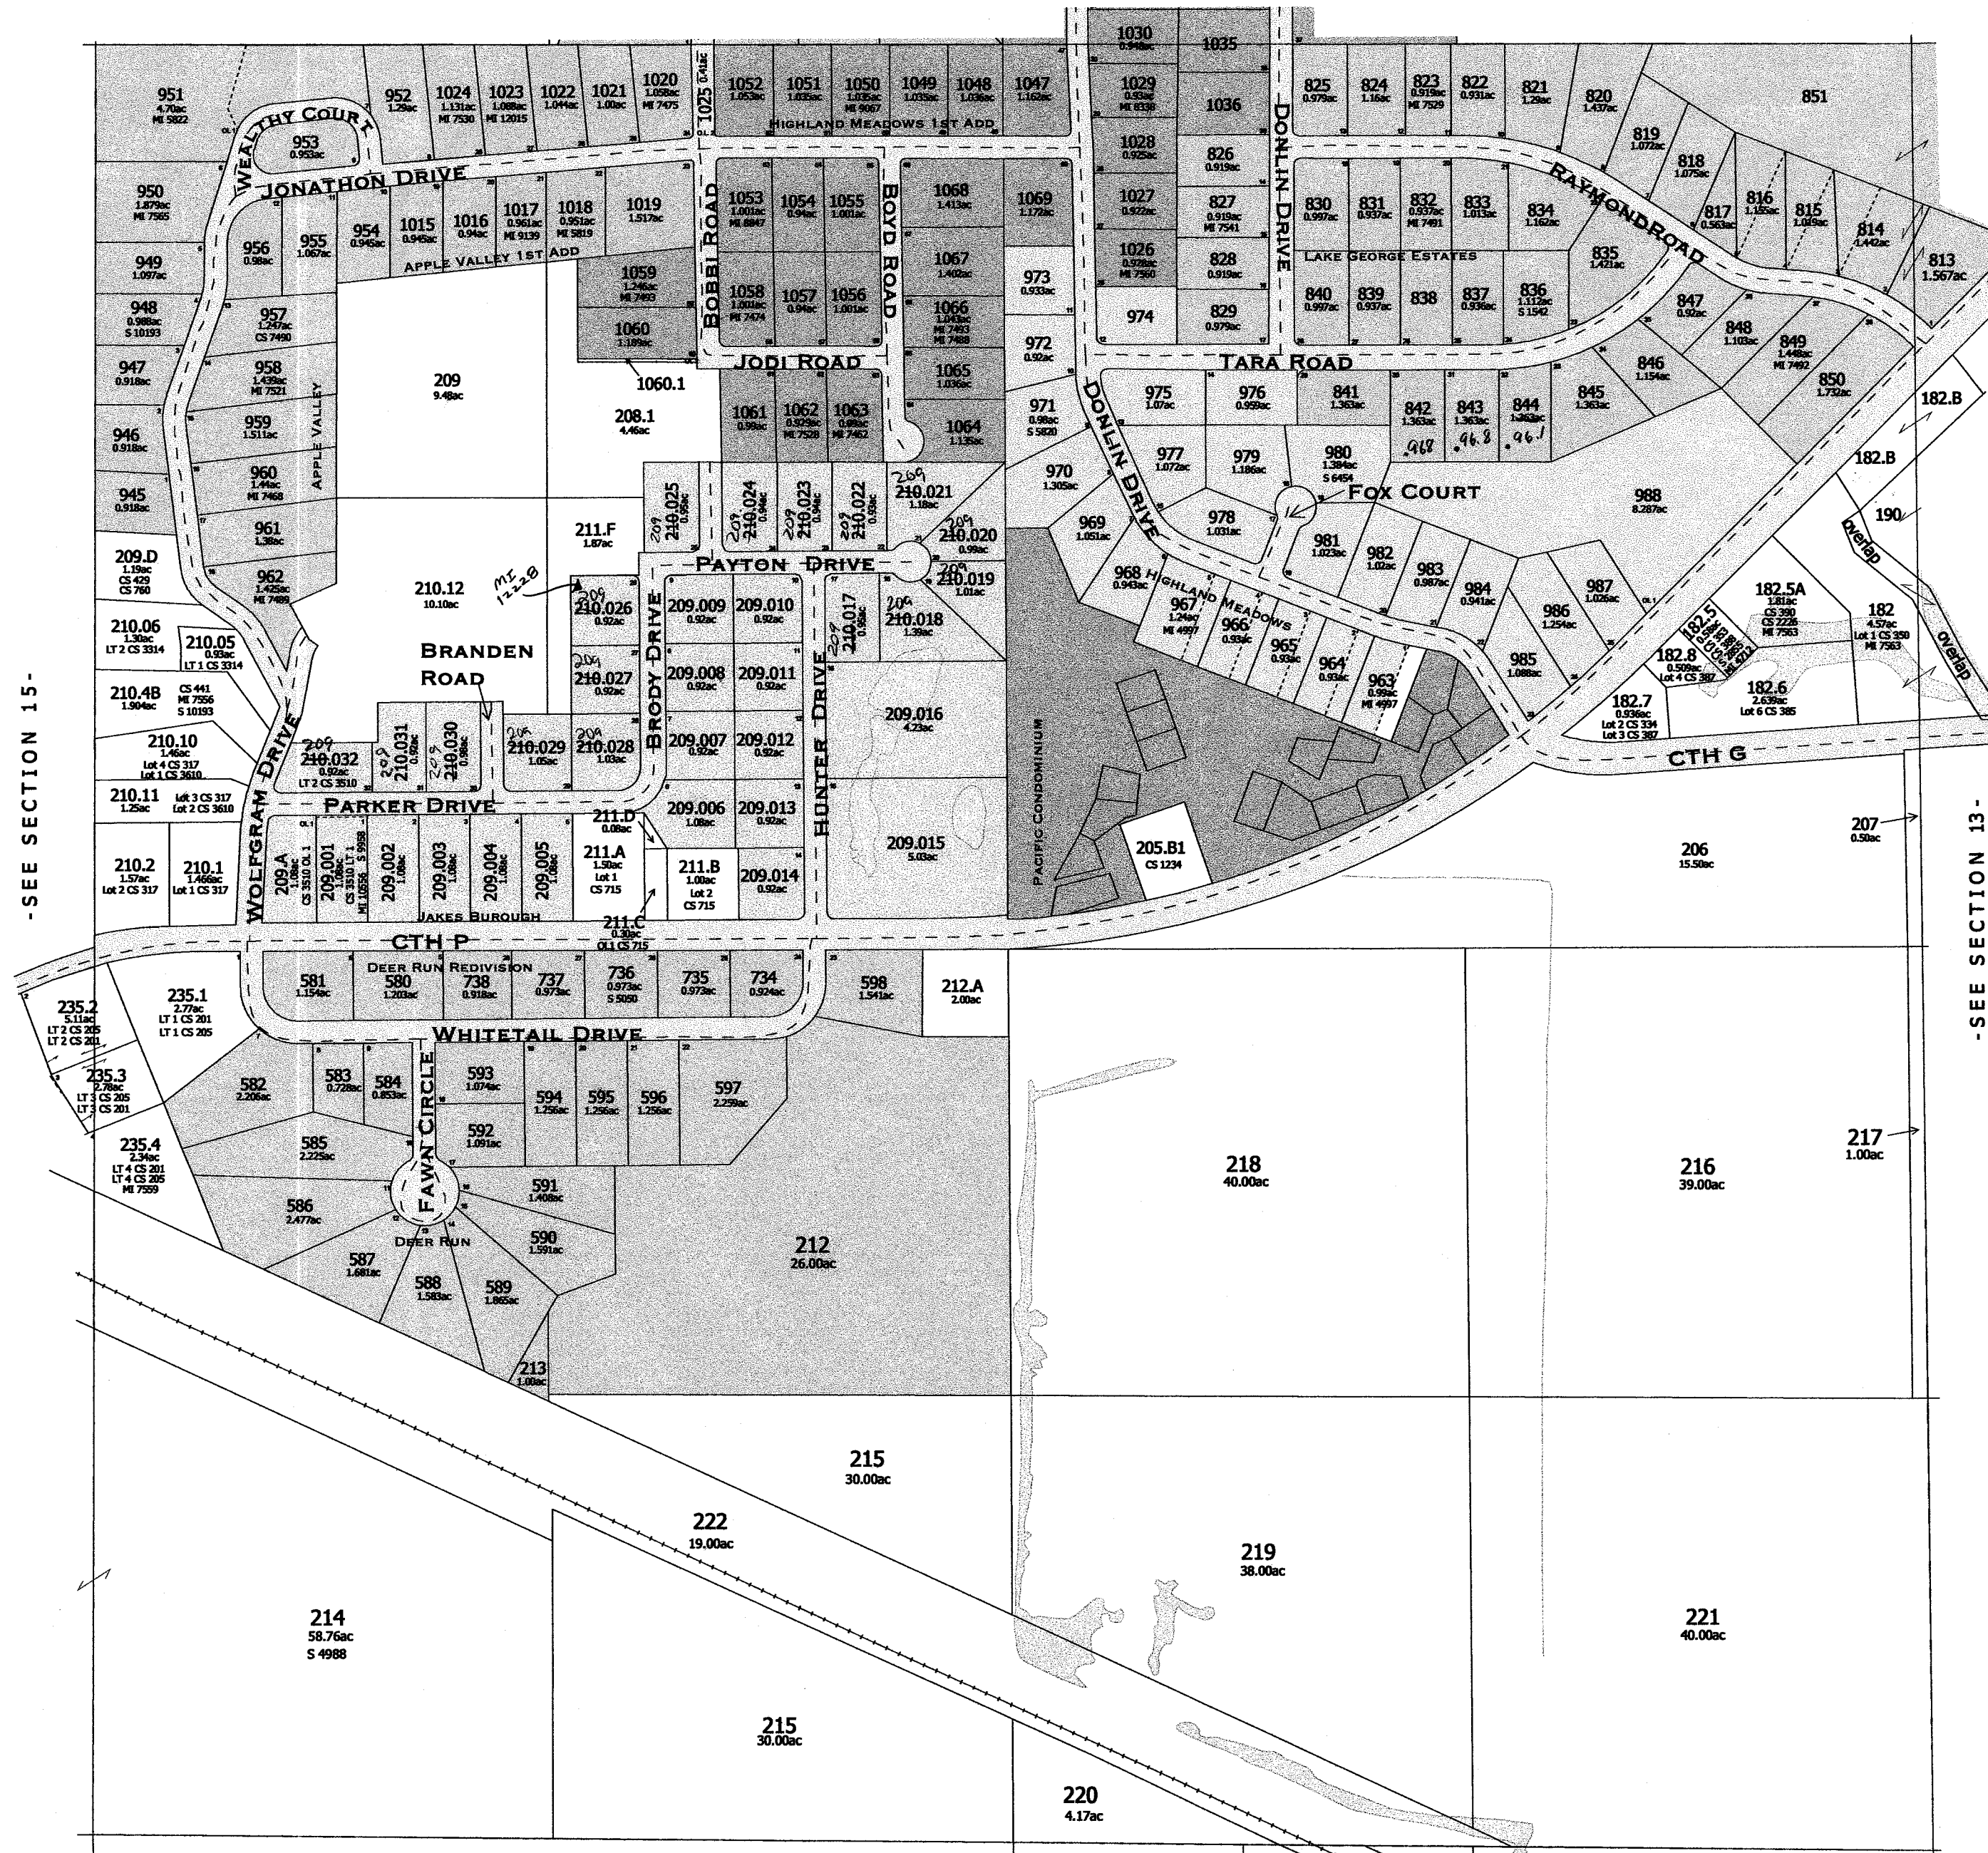

-SEE SECTION 15-

-SEE SECTION 13-


-SEE SECTION 23-

FOR DETAILED MAP OF CONDO PLAT, SEE NEXT PAGE.

APPLE VALLEY - S1307
APPLE VALLEY 1ST ADDITION - S1311
DEER RUN - S4989
DEER RUN REDIVISION - REGISTER OF DEEDS
HIGHLAND MEADOWS - S4999
HIGHLAND MEADOWS 1ST ADDITION - S1312
JAKE'S BOROUGH - S10683
LAKE GEORGE ESTATES - REGISTER OF DEEDS
PACIFIC CONDOMINIUM - S8505

Replaced
2006

-SECTION 14-

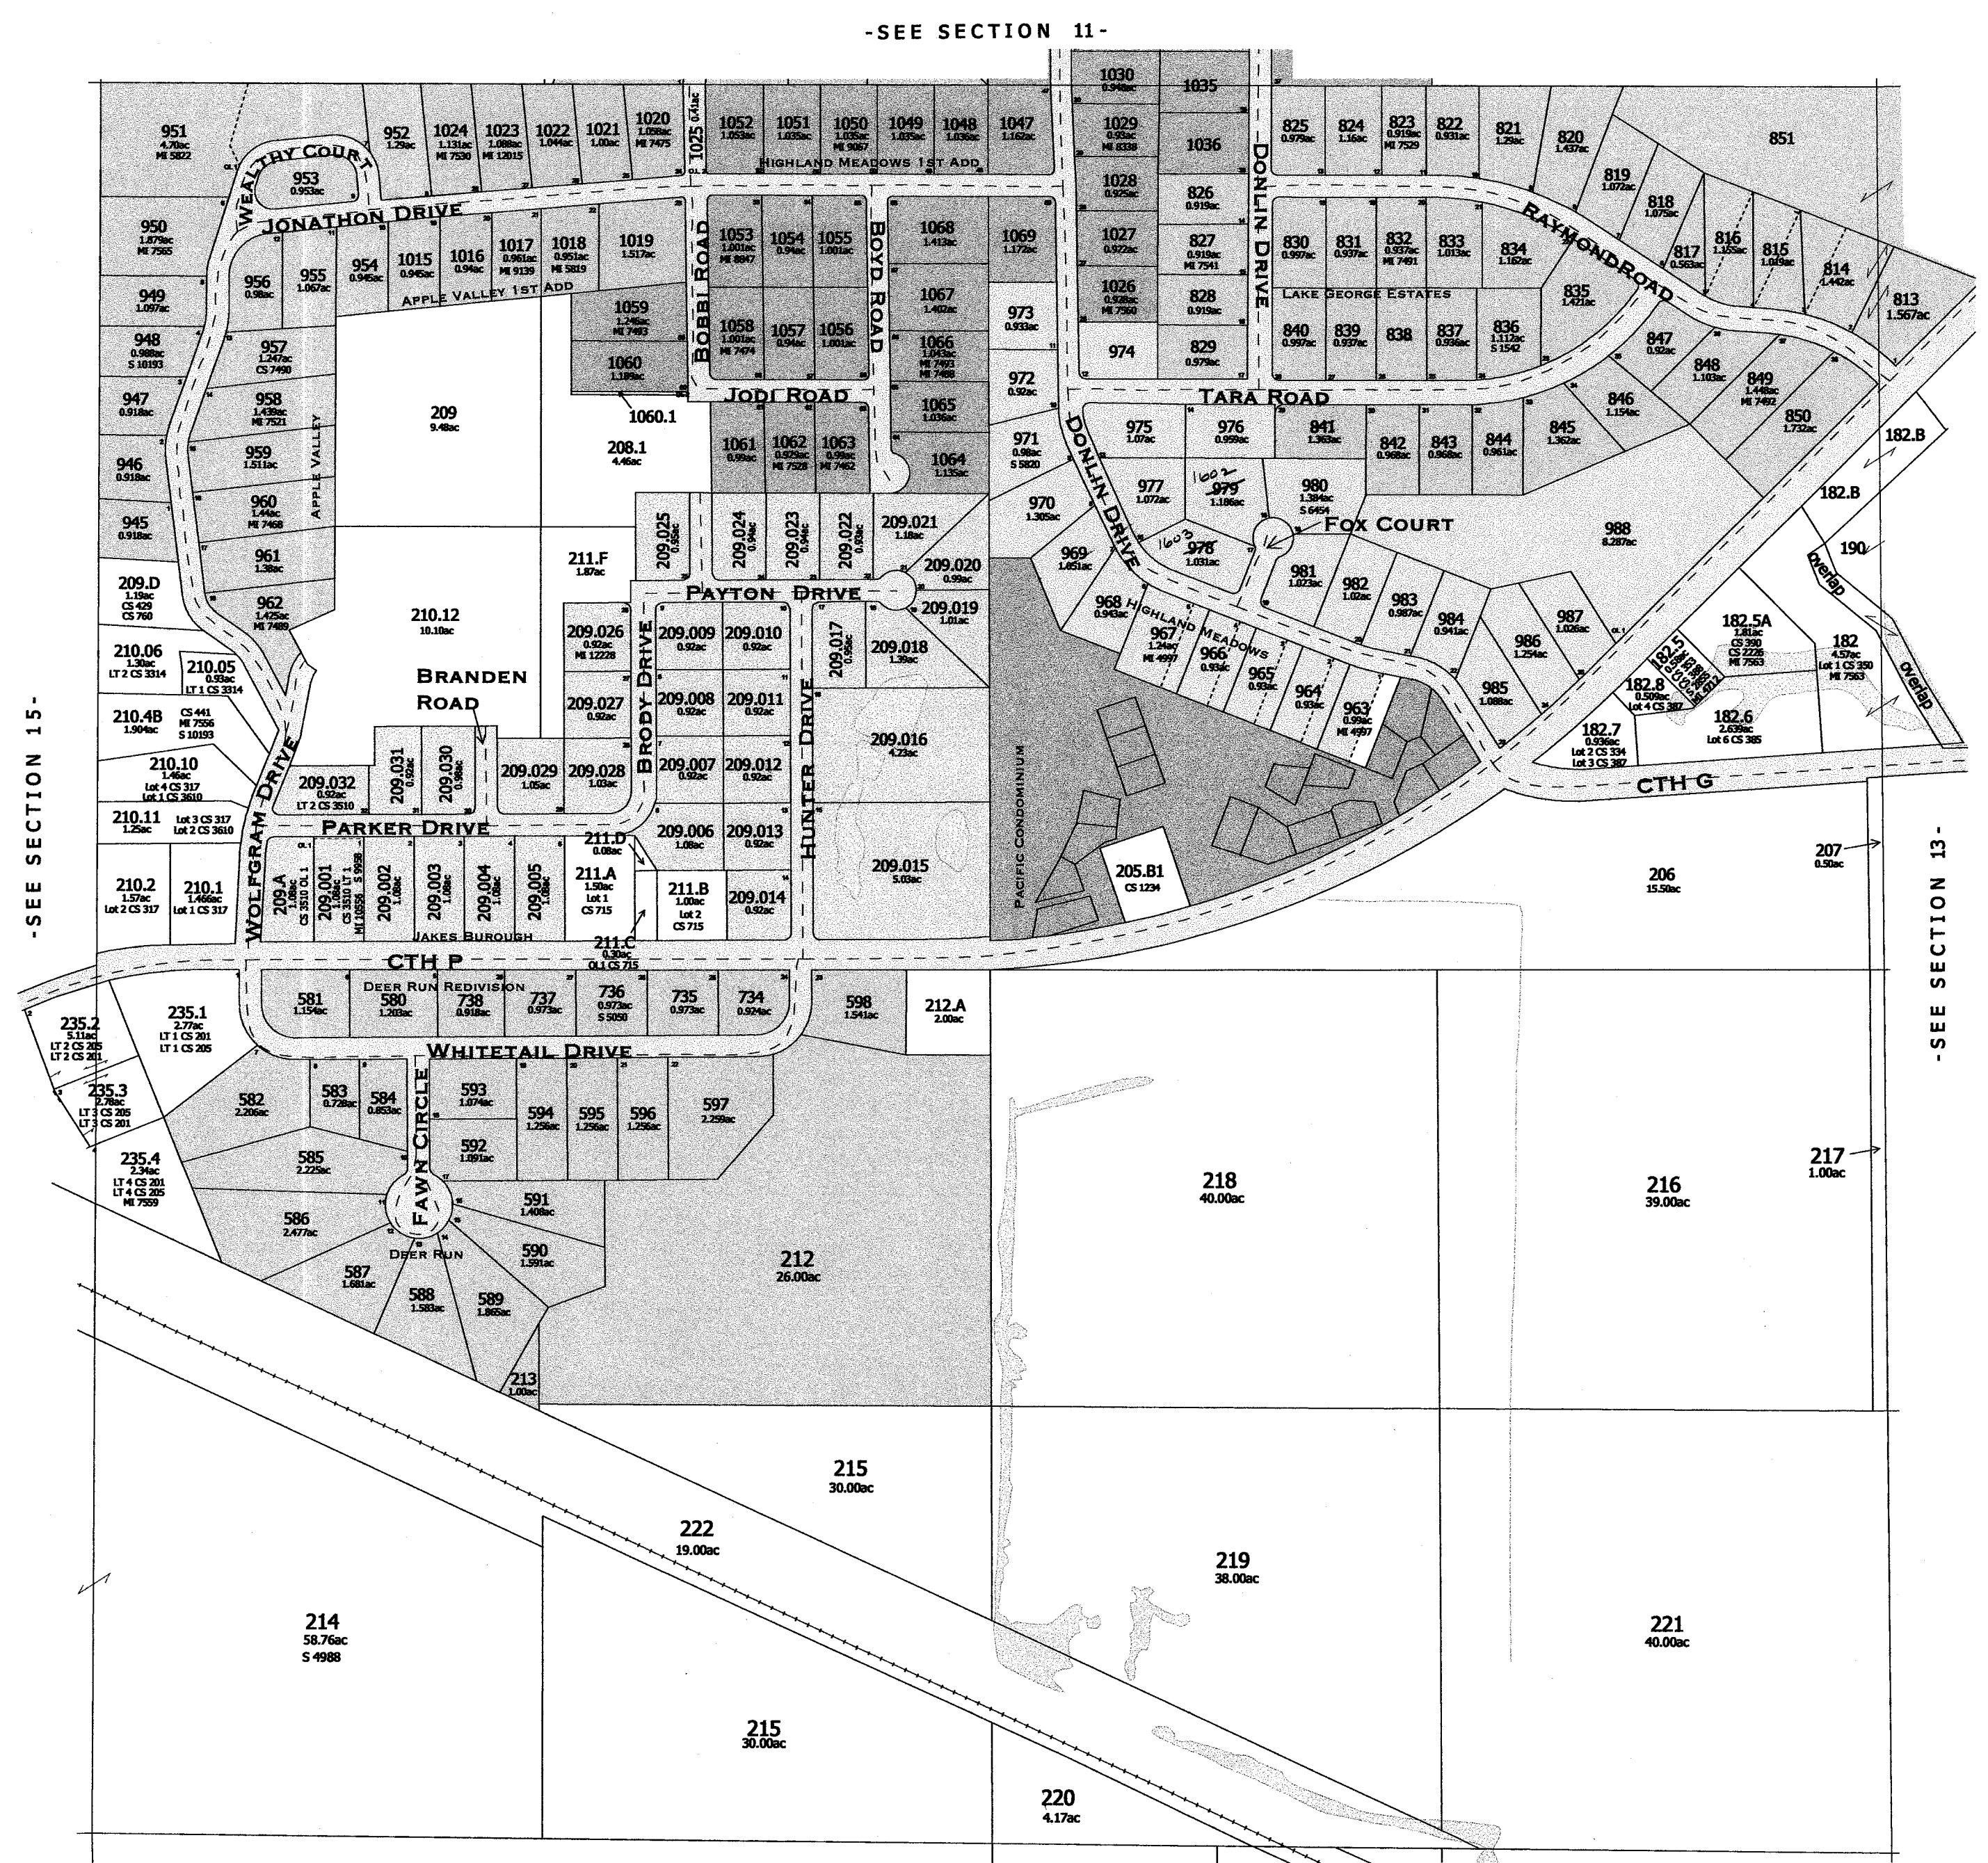

APPLE VALLEY - S1307
APPLE VALLEY 1ST ADDITION - S1311
DEER RUN - S4880
DEER RUN REDIVISION - REGISTER OF DEEDS 171B
HIGHLAND MEADOWS - S4999
HIGHLAND MEADOWS 1ST ADDITION - S1312
JAKE'S BURROUGH - S10683
LAKE GEORGE ESTATES - ROD 174A
PACIFIC CONDOMINIUM - S8505

One Inch Equals Two Hundred Feet

0 0.04 0.08 0.12 0.16 Miles

0 200 400 600 800 Feet

NOTE: This map was prepared for assessment use in accordance with the Wis. St. Stat. Chap. 70.03. All information contained herein is advisory only. Map accuracy is limited to the quality of data obtained from other Public Records. This map is not intended to be a substitute for an actual field survey. Public Land Survey Base is derived from U.S.G.S. Topographic maps unless otherwise noted. Other sources of the Land Base may be actual survey data. Base map data is from the April 1995 County Digital Orthophotos and/or U.S.G.S. 1:24,000 scale Topographic series. The user is responsible for the improper use of the data contained herein.

Created by The Columbia County Land Information Office -GIS Section. VMB. July 2004.

TAX PARCEL MAP


TOWN of PACIFIC

TOWN 12 NORTH RANGE 9 EAST
COLUMBIA COUNTY, WISCONSIN

Replaced
2006

-SEE SECTION 11-

- SEE SECTION 15 -

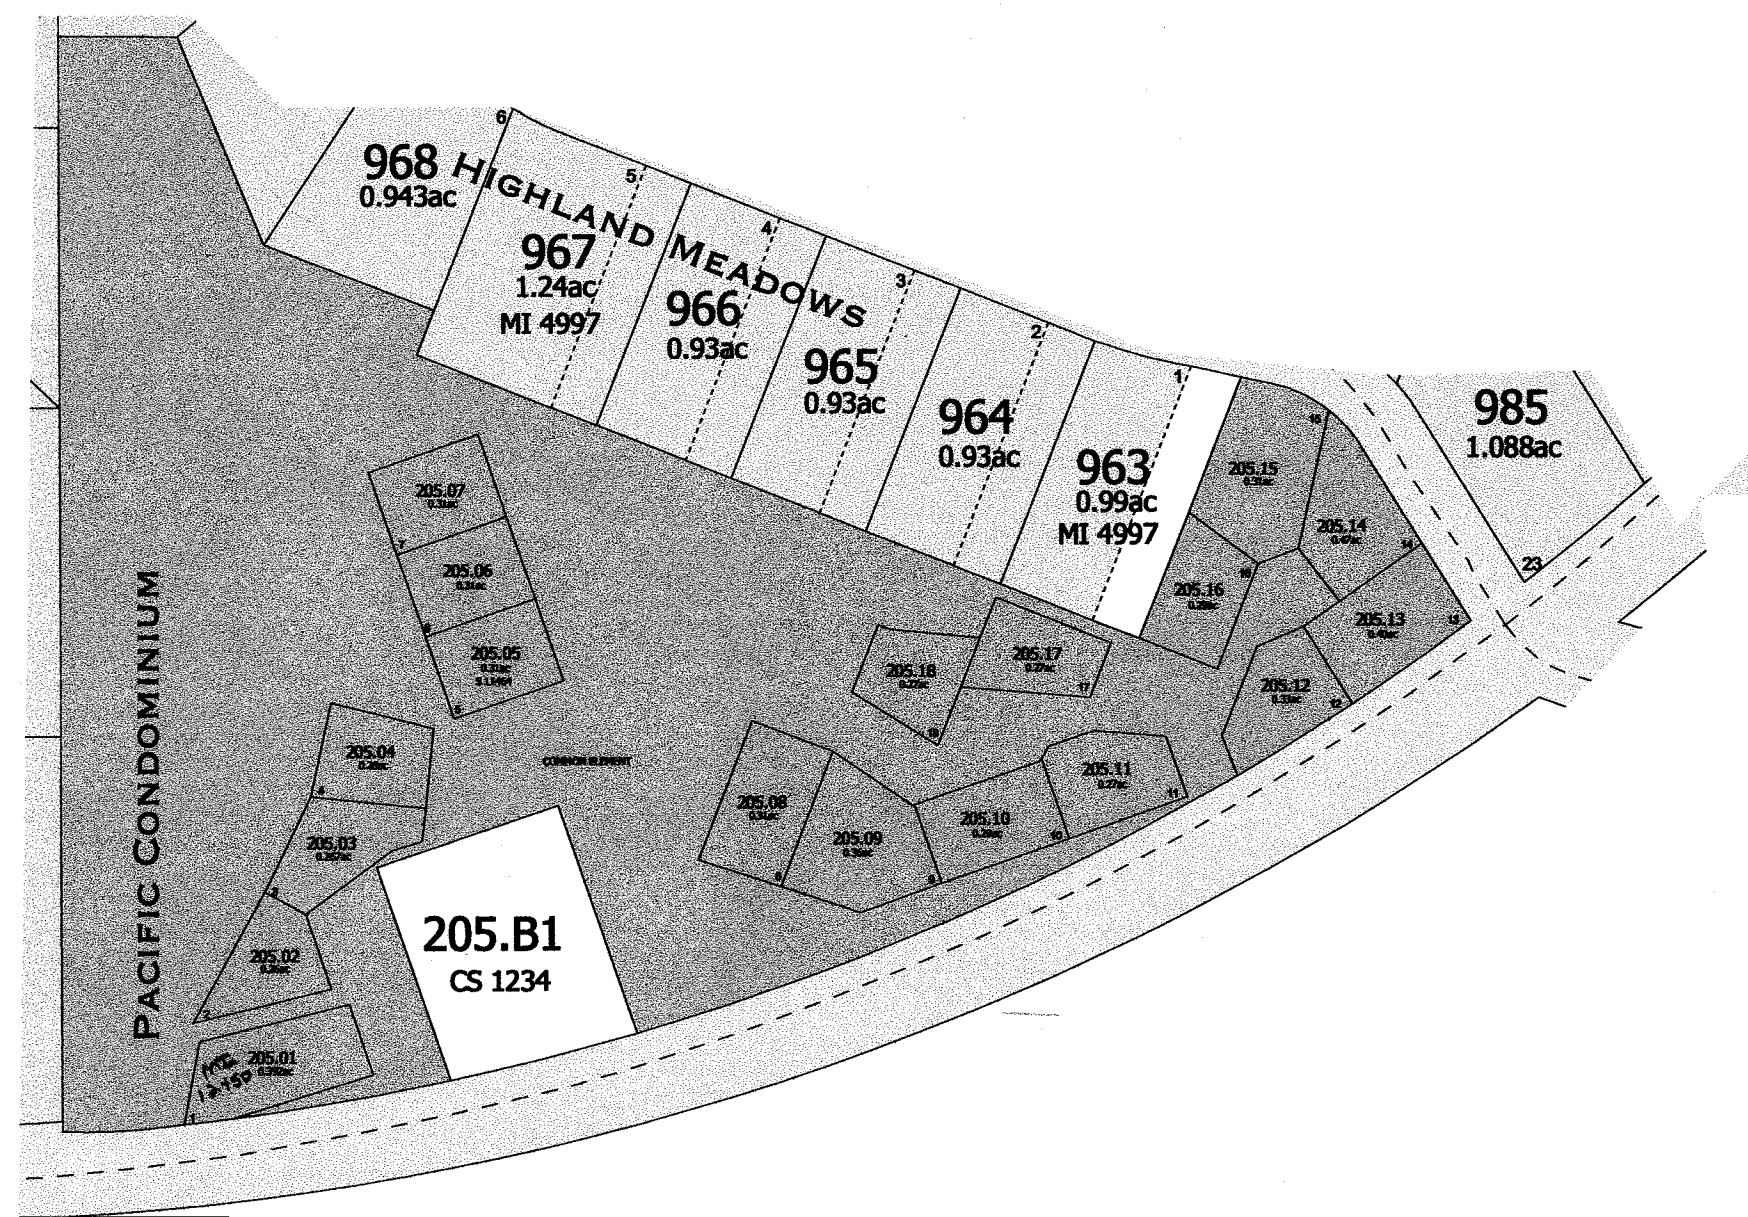

- SEE SECTION 13 -

-SEE SECTION 23-

PACIFIC CONDOMINIUM - S8505

Replaced
2006

- Pacific Condominium -

00.040.080.120.16 Miles

0200400600800 Feet

NOTE: This map was prepared for assessment use in accordance with the Wis. St. Stat. Chap. 70.09. All information contained herein is advisory only. Map accuracy is limited to the quality of data obtained from other Public Records. This map is not intended to be a substitute for an actual field survey. Public Land Survey Base is derived from U.S.G.S Topographic maps unless otherwise noted. Other sources of the Land Base may be actual survey data. Base map data is from the April 1995 County Digital Orthophotos and/or U.S.G.S. 1:24,000 scale Topographic series. The user is responsible for the improper use of the data contained herein.

Created by The Columbia County Land Information Office -GIS Section. VMB. February 2006.

TAX PARCEL MAP

TOWN of PACIFIC

TOWN 12 NORTH RANGE 9 EAST
COLUMBIA COUNTY, WISCONSIN


N

3	2	1	
10	11	12	
15	16	13	
22	23	24	
29	27	26	
33	34	35	36

Replaced
2007

-SEE SECTION 14-

-SEE SECTION 14-

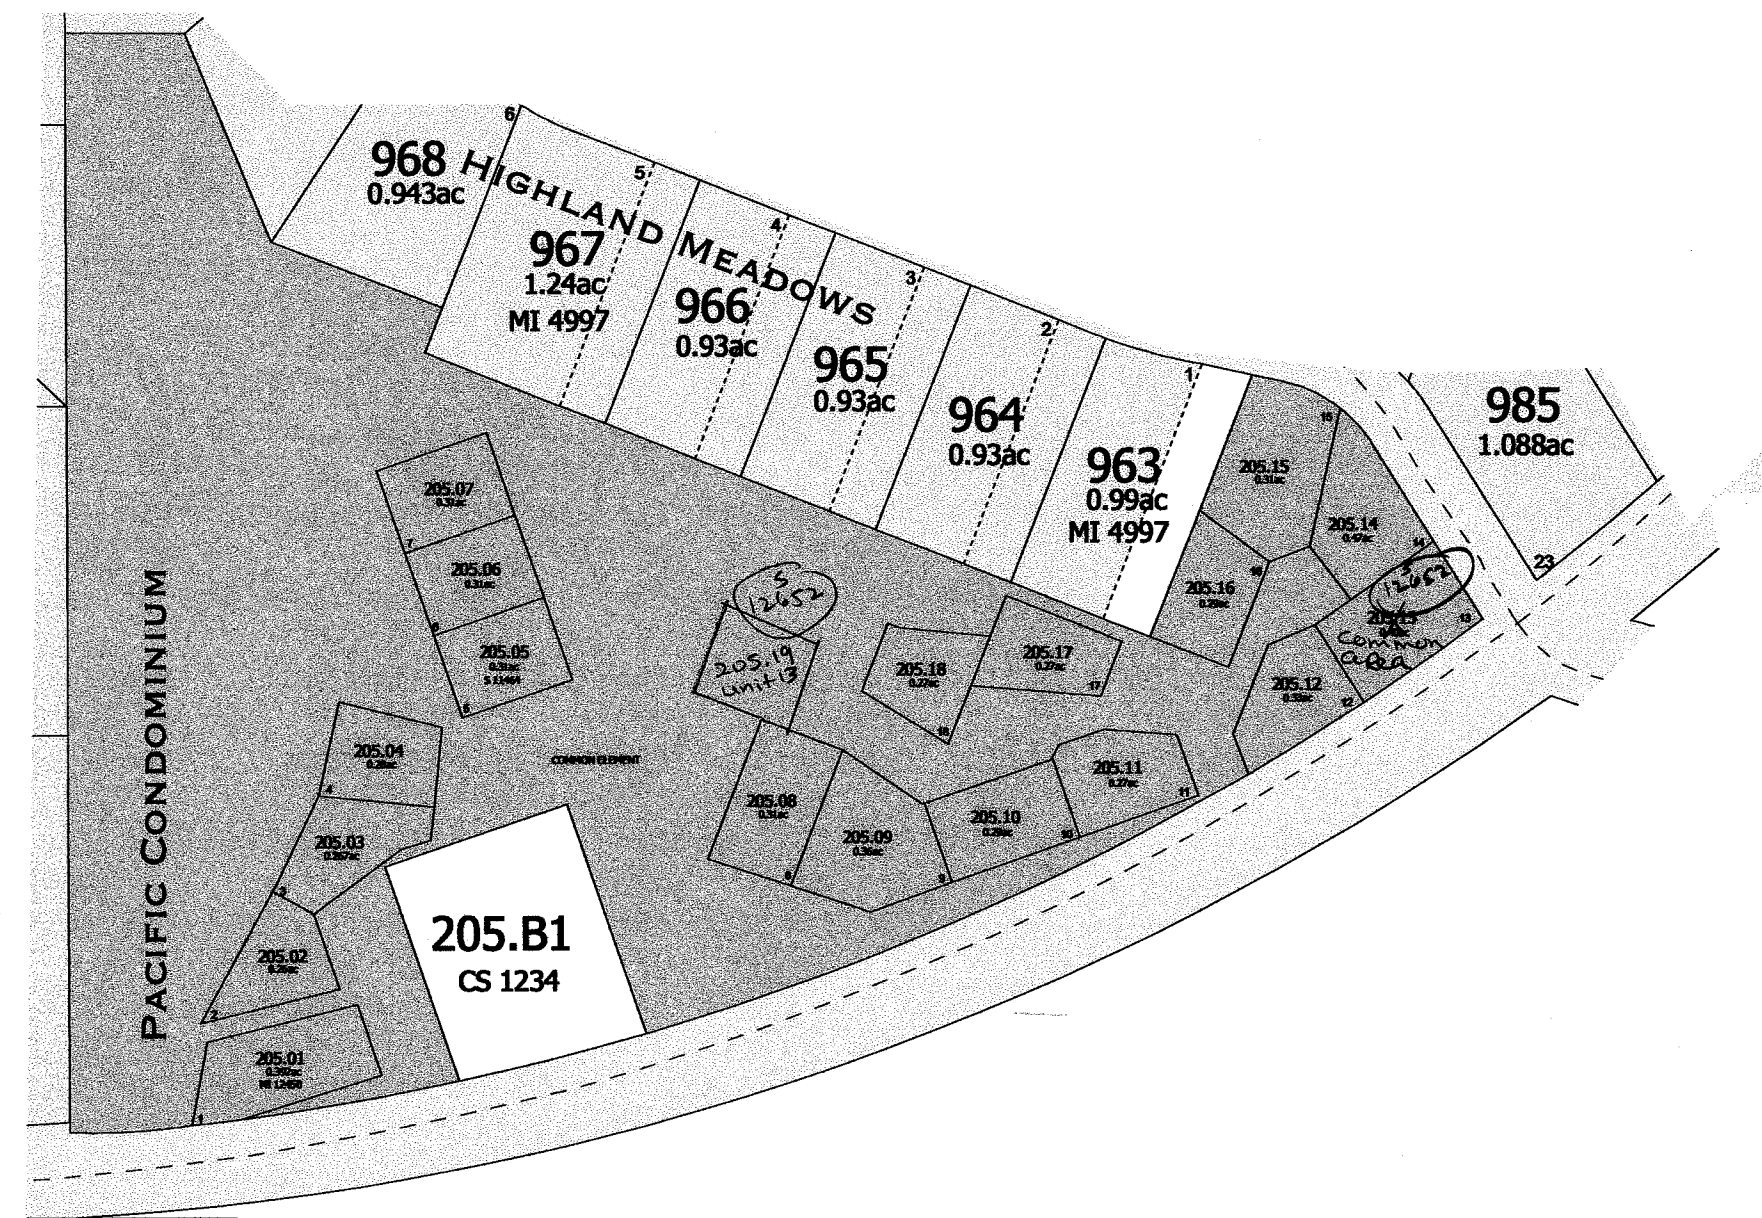

-SEE SECTION 14-


-SEE SECTION 14-

PACIFIC CONDOMINIUM - S8505

Replaced
2007

- Pacific Condominium -

Town of Pacific
Town 12 North-Range 9 East
North East Quarter
Section 14

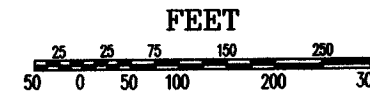


Replaced
2004

- PLAT 6893 Lake George Estates
PLAT 4999 Highland Meadows
PLAT 1312 Highland Meadows 1st Add

- Plat on F
Survey o
Certified
Mortg
Mon
LT 1 or 1

NOTE: This map
according
All inform
Map accur
obtained fr
is not inten
field survey.

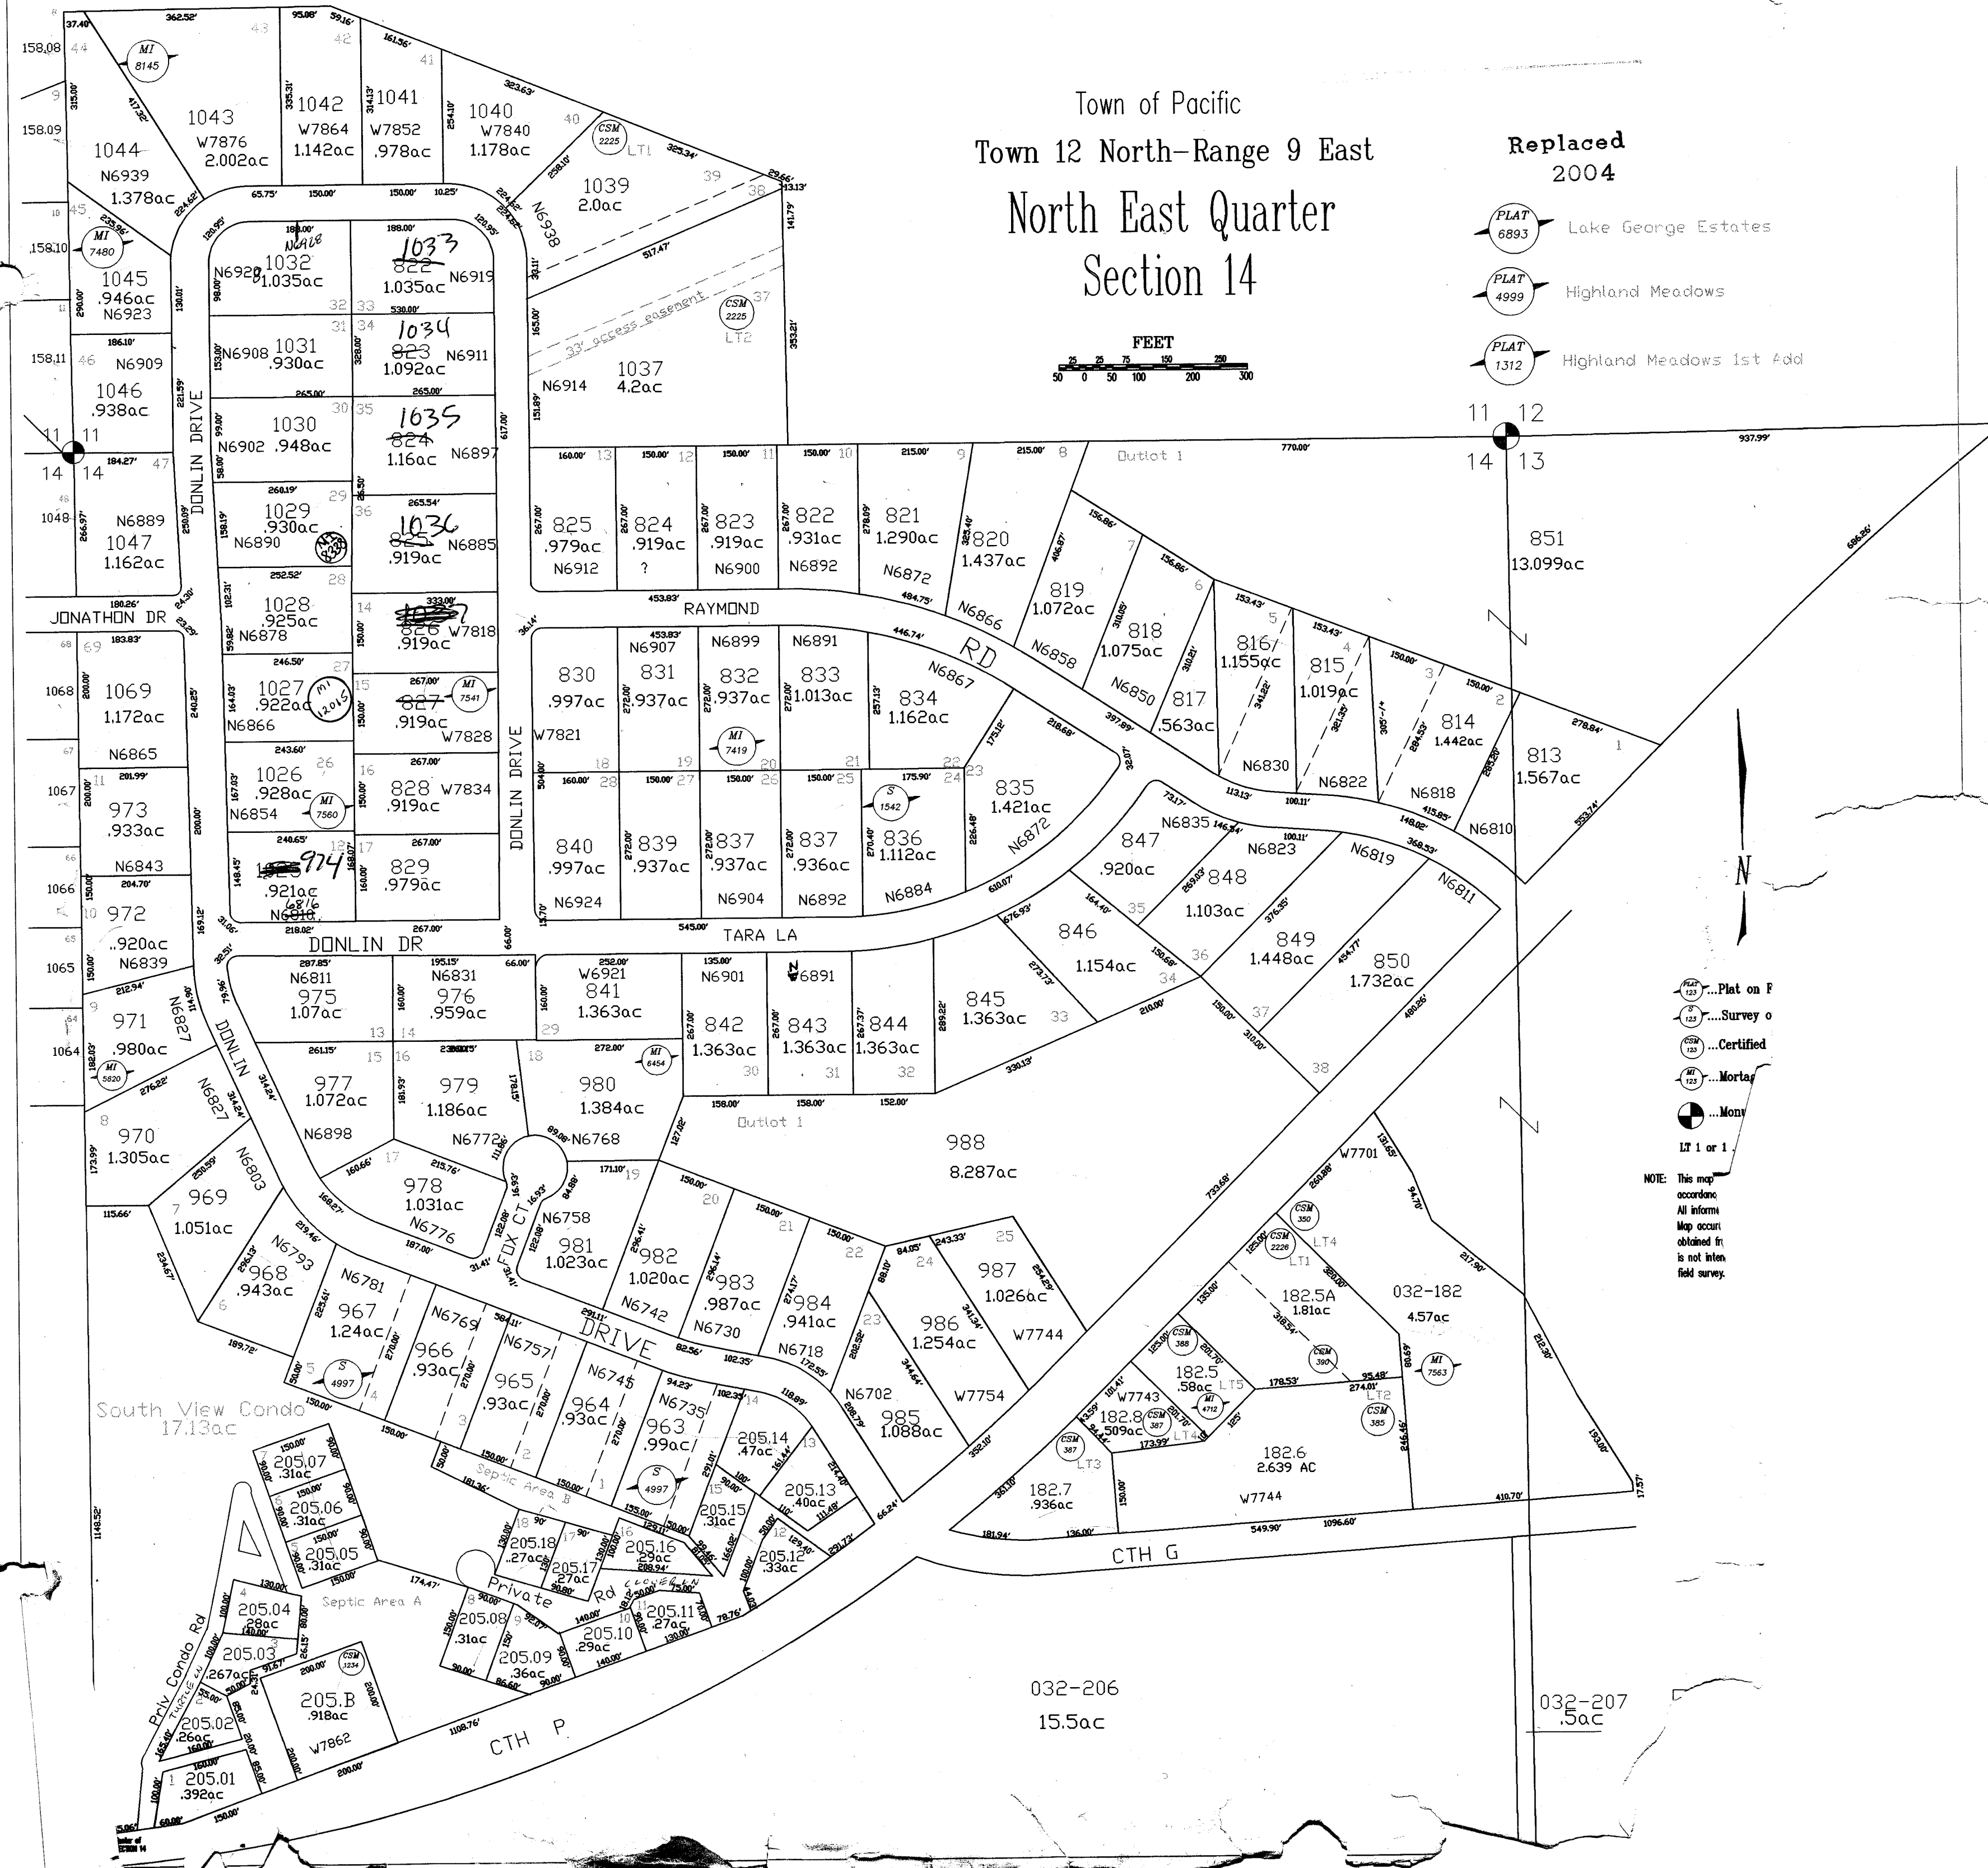

NW 1/4
Sec 14


Town of Pacific


Town 12 North-Range 9 East Replaced
2004

PLAT 3099 Fox Run Estates

PLAT 1307 Apple Valley


PLAT 1311 Apple Valley 1st Add

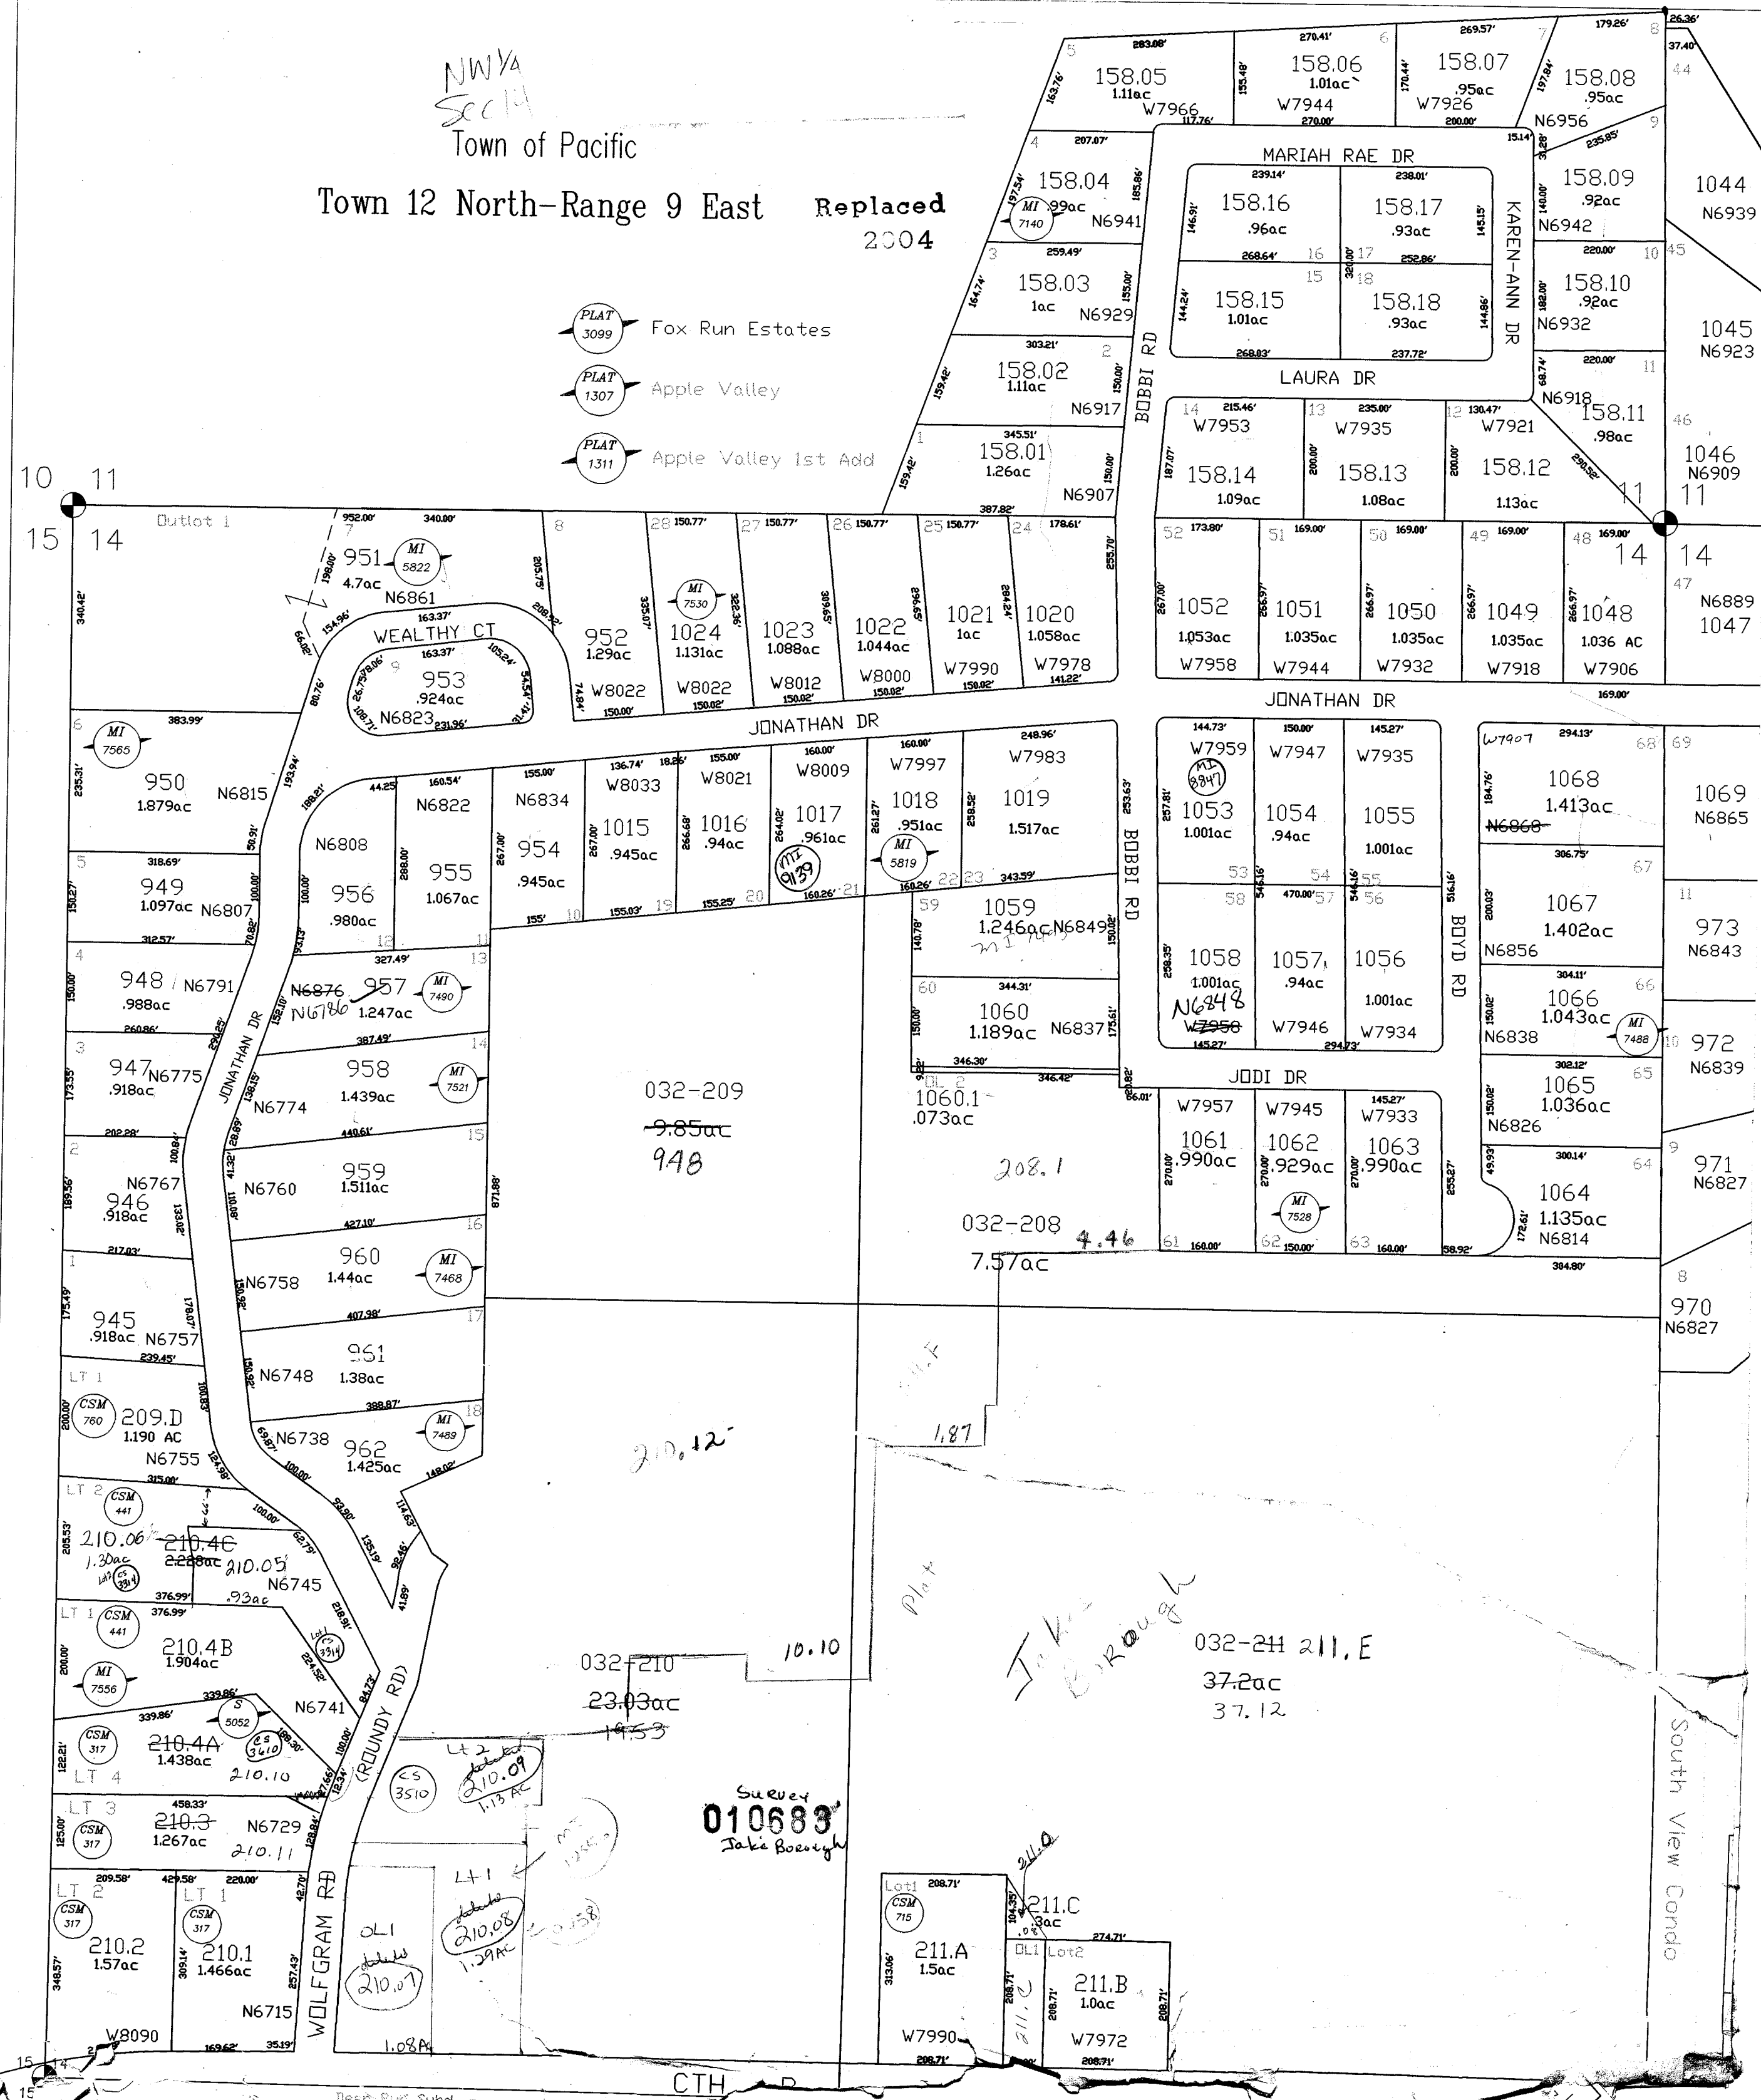

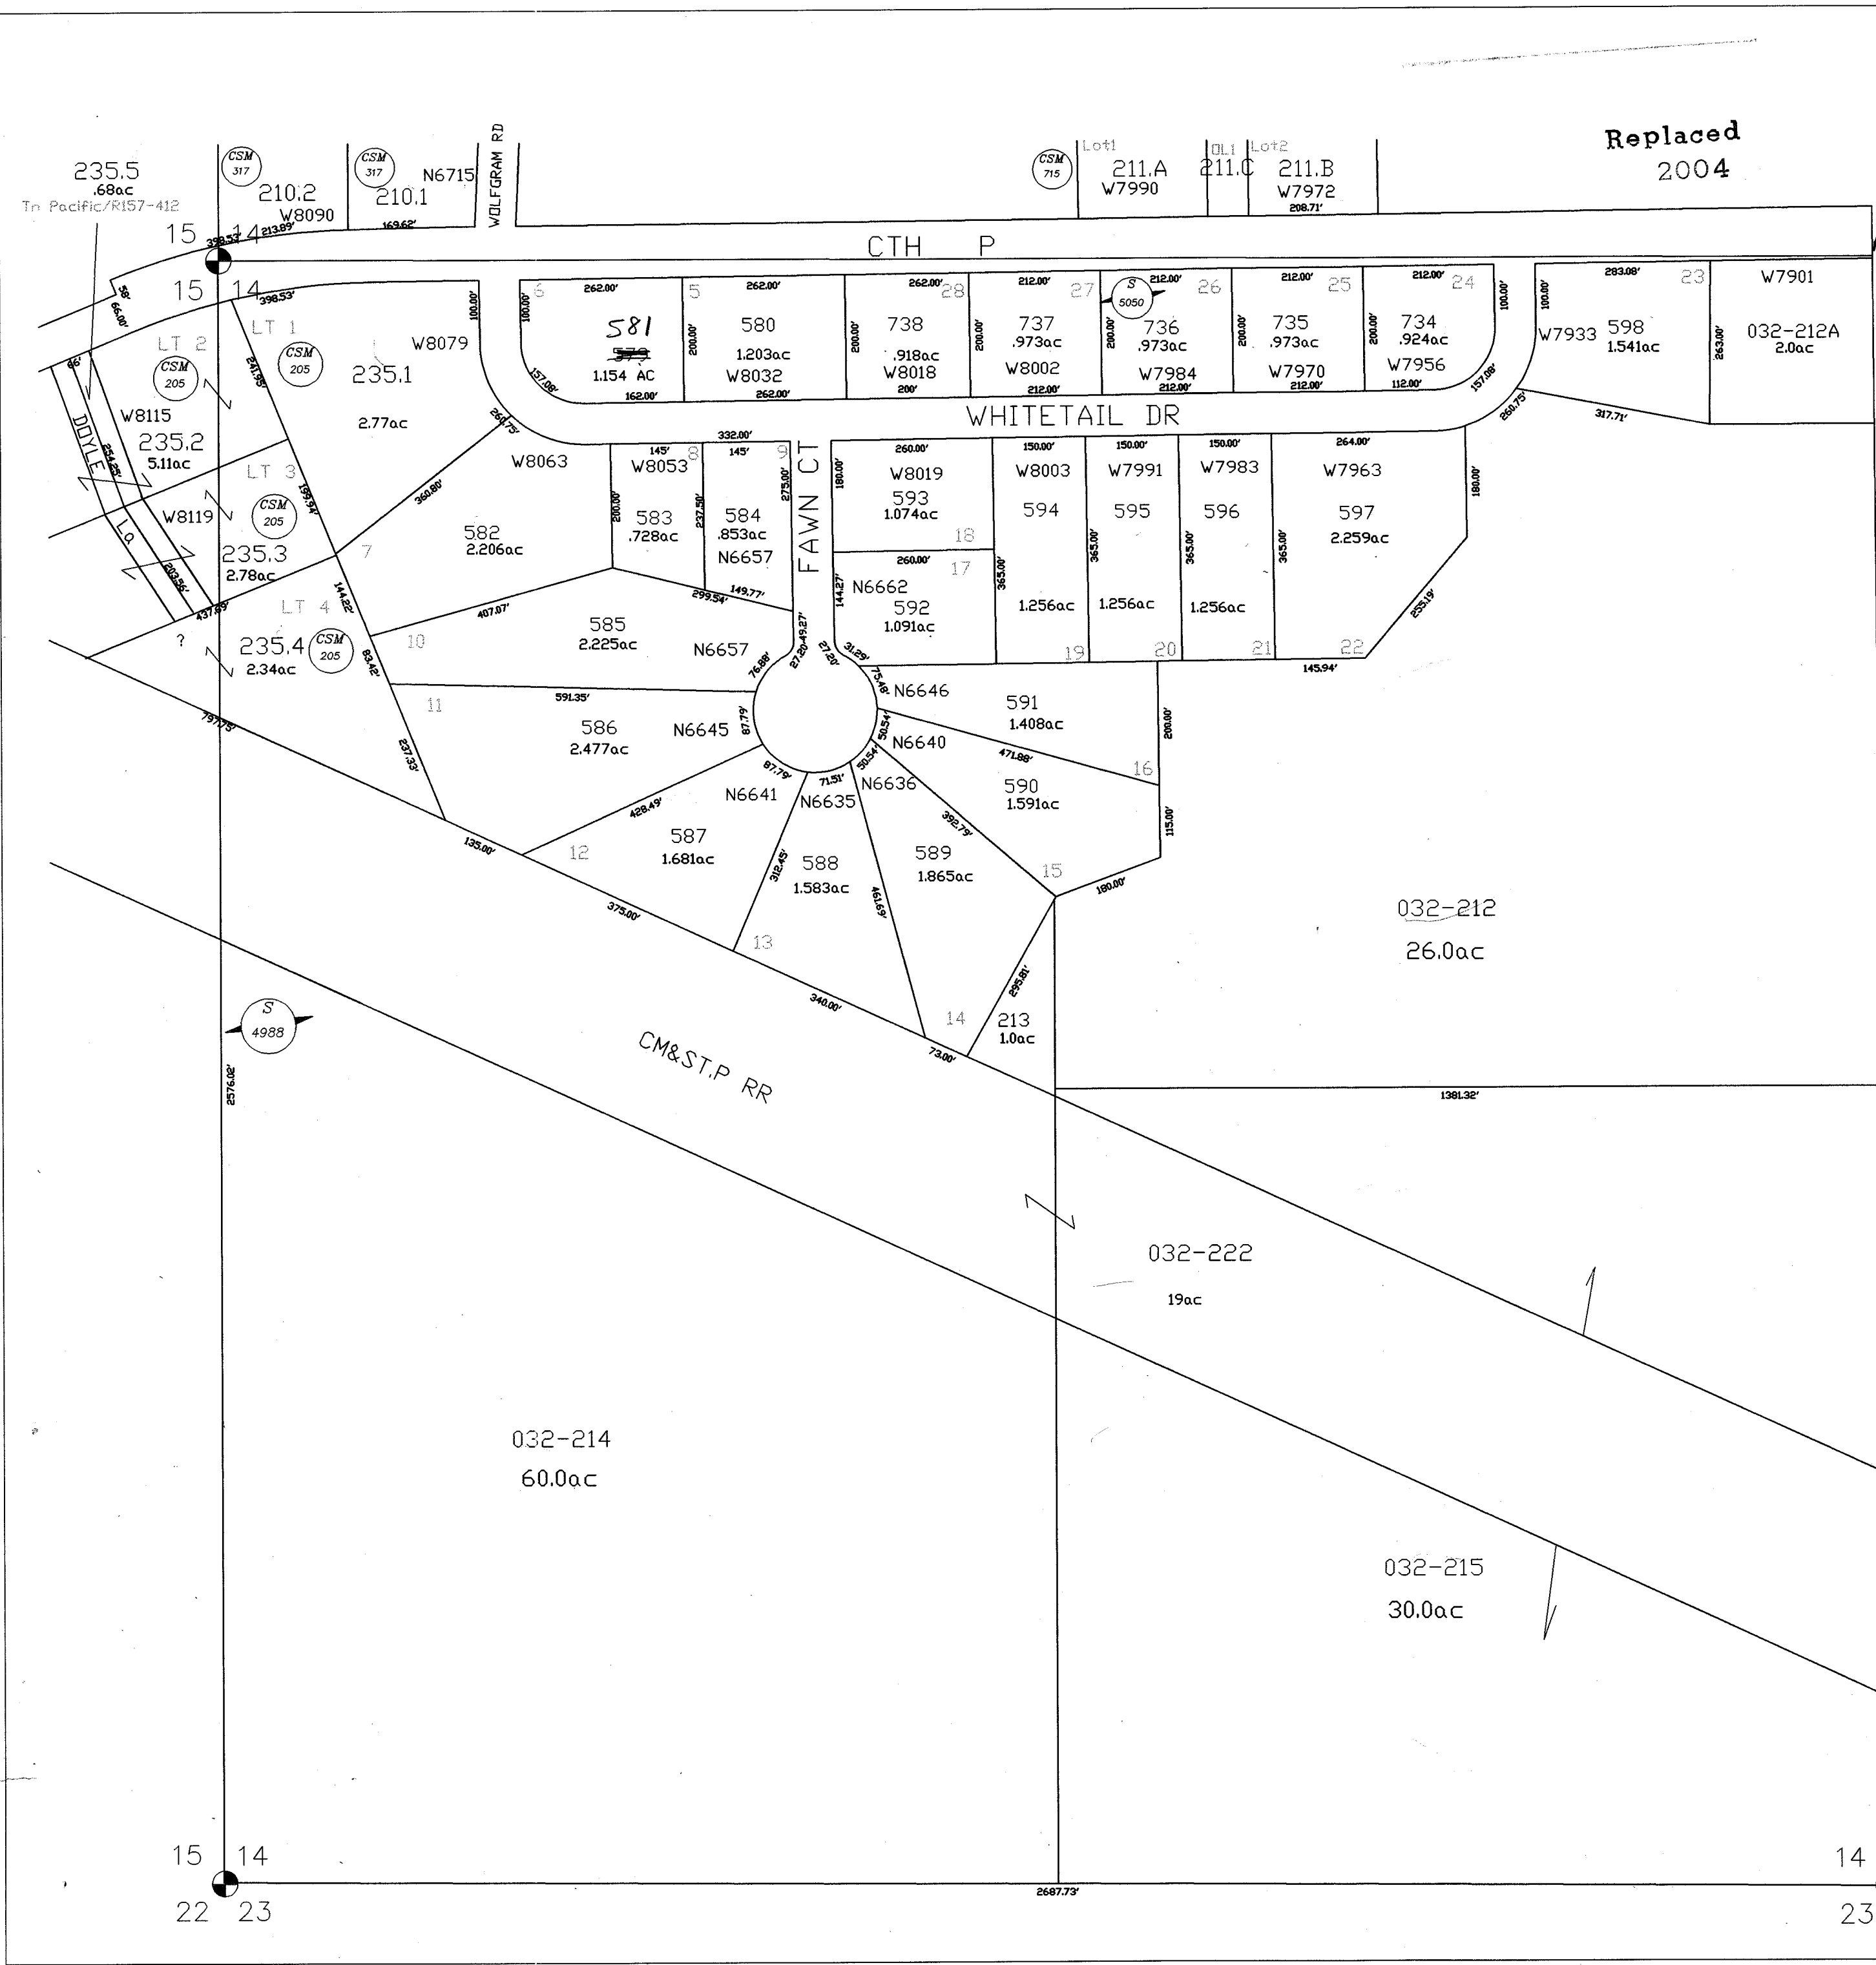

Center of SECTION 14

Town 12 North-Range 9 East
SECTION 14
Town of Pacific
South West Quarter

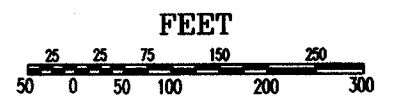

- ...Plat on File
- ...Survey on File
- ...Certified Survey Map
- ...Mortgage Inspection on File
- ...Monumented Section Corner
- LT 1 or 1lot number of CSM/Plat

NOTE: This map was prepared for assessment use in accordance with Wis. Stat. Chap. 70.09. All information contained herein is advisory only. Map accuracy is limited to the quality of data obtained from other Public Records. This map is not intended to be a substitute for an actual field survey.

4989 Deer Run Subd.

SECTION KEY

1 Section = Approx. 640 acres or 1 Sq. Mi.
1 1/4 Section = Approx. 160 Acres
1 1/16 Section = Approx. 40 Acres

COLUMBIA COUNTY
Land Information Department
Portage, Wisconsin

ORIGINAL SCALE	LATEST REVISION DATE:
DATE:	12/09/09 C.A.D. BY: T.D.H.
SEC KEY	

SEC. 15 T.12N. R.9E.

DNR

226
State of Wisconsin DNR

224
~~Robert Harvey~~
DAVID H. BENNETT

NOTE: THESE (2) PCLS. ARE
AN EXCEPTION OF DNR
DESCRIPTION

96
 DOTTED LINE
 REPRESENTS
 "OLD HWY. U.S. 51

NOTE: TAX NO. 223 IS
ALSO IN SEC. 16

Transfer form
page 133A

261.32

~~PARDDEVILLE ROAD~~
L Carmouth

240-1A
~~Wisconsin Power & Light Company~~
 240, I
 EDWIN MEHLTRETTET

Gieke
ESTATES

225. D
OTTO GEIKE
PCL IN SEC. 22
TOTAL ACREAGE
82.65
Dial - 20.00

John Terlecke

EXC. MEADOW VIEW PLAT
EXC. 20' R.O.W. W. SIDE
ADJACENT TO OLD FENCE
LINE ALSO PCL. OF LAND
IN SEC. 14 NW SW & SW SW.

5
4988

~~DENNIS FARROW~~
+
~~JOHN A. BRIDGE~~
J. E. O'LEARY

ALSO TRACT OF
LAND SEC. 22


229. Filling Sta.
2381 - Restaurant, hse

225.03
Sec 22

18.26

LOCATED IN THE SE 1/4 OF THE SE 1/4, THE SW 1/4 OF THE SE 1/4, THE NW 1/4 OF THE SE 1/4 AND THE NE 1/4 OF THE SE 1/4 OF SECTION 15, TOWN 12 NORTH, RANGE 9 EAST, TOWN OF PACIFIC, COLUMBIA COUNTY WISCONSIN.

Replaced
204

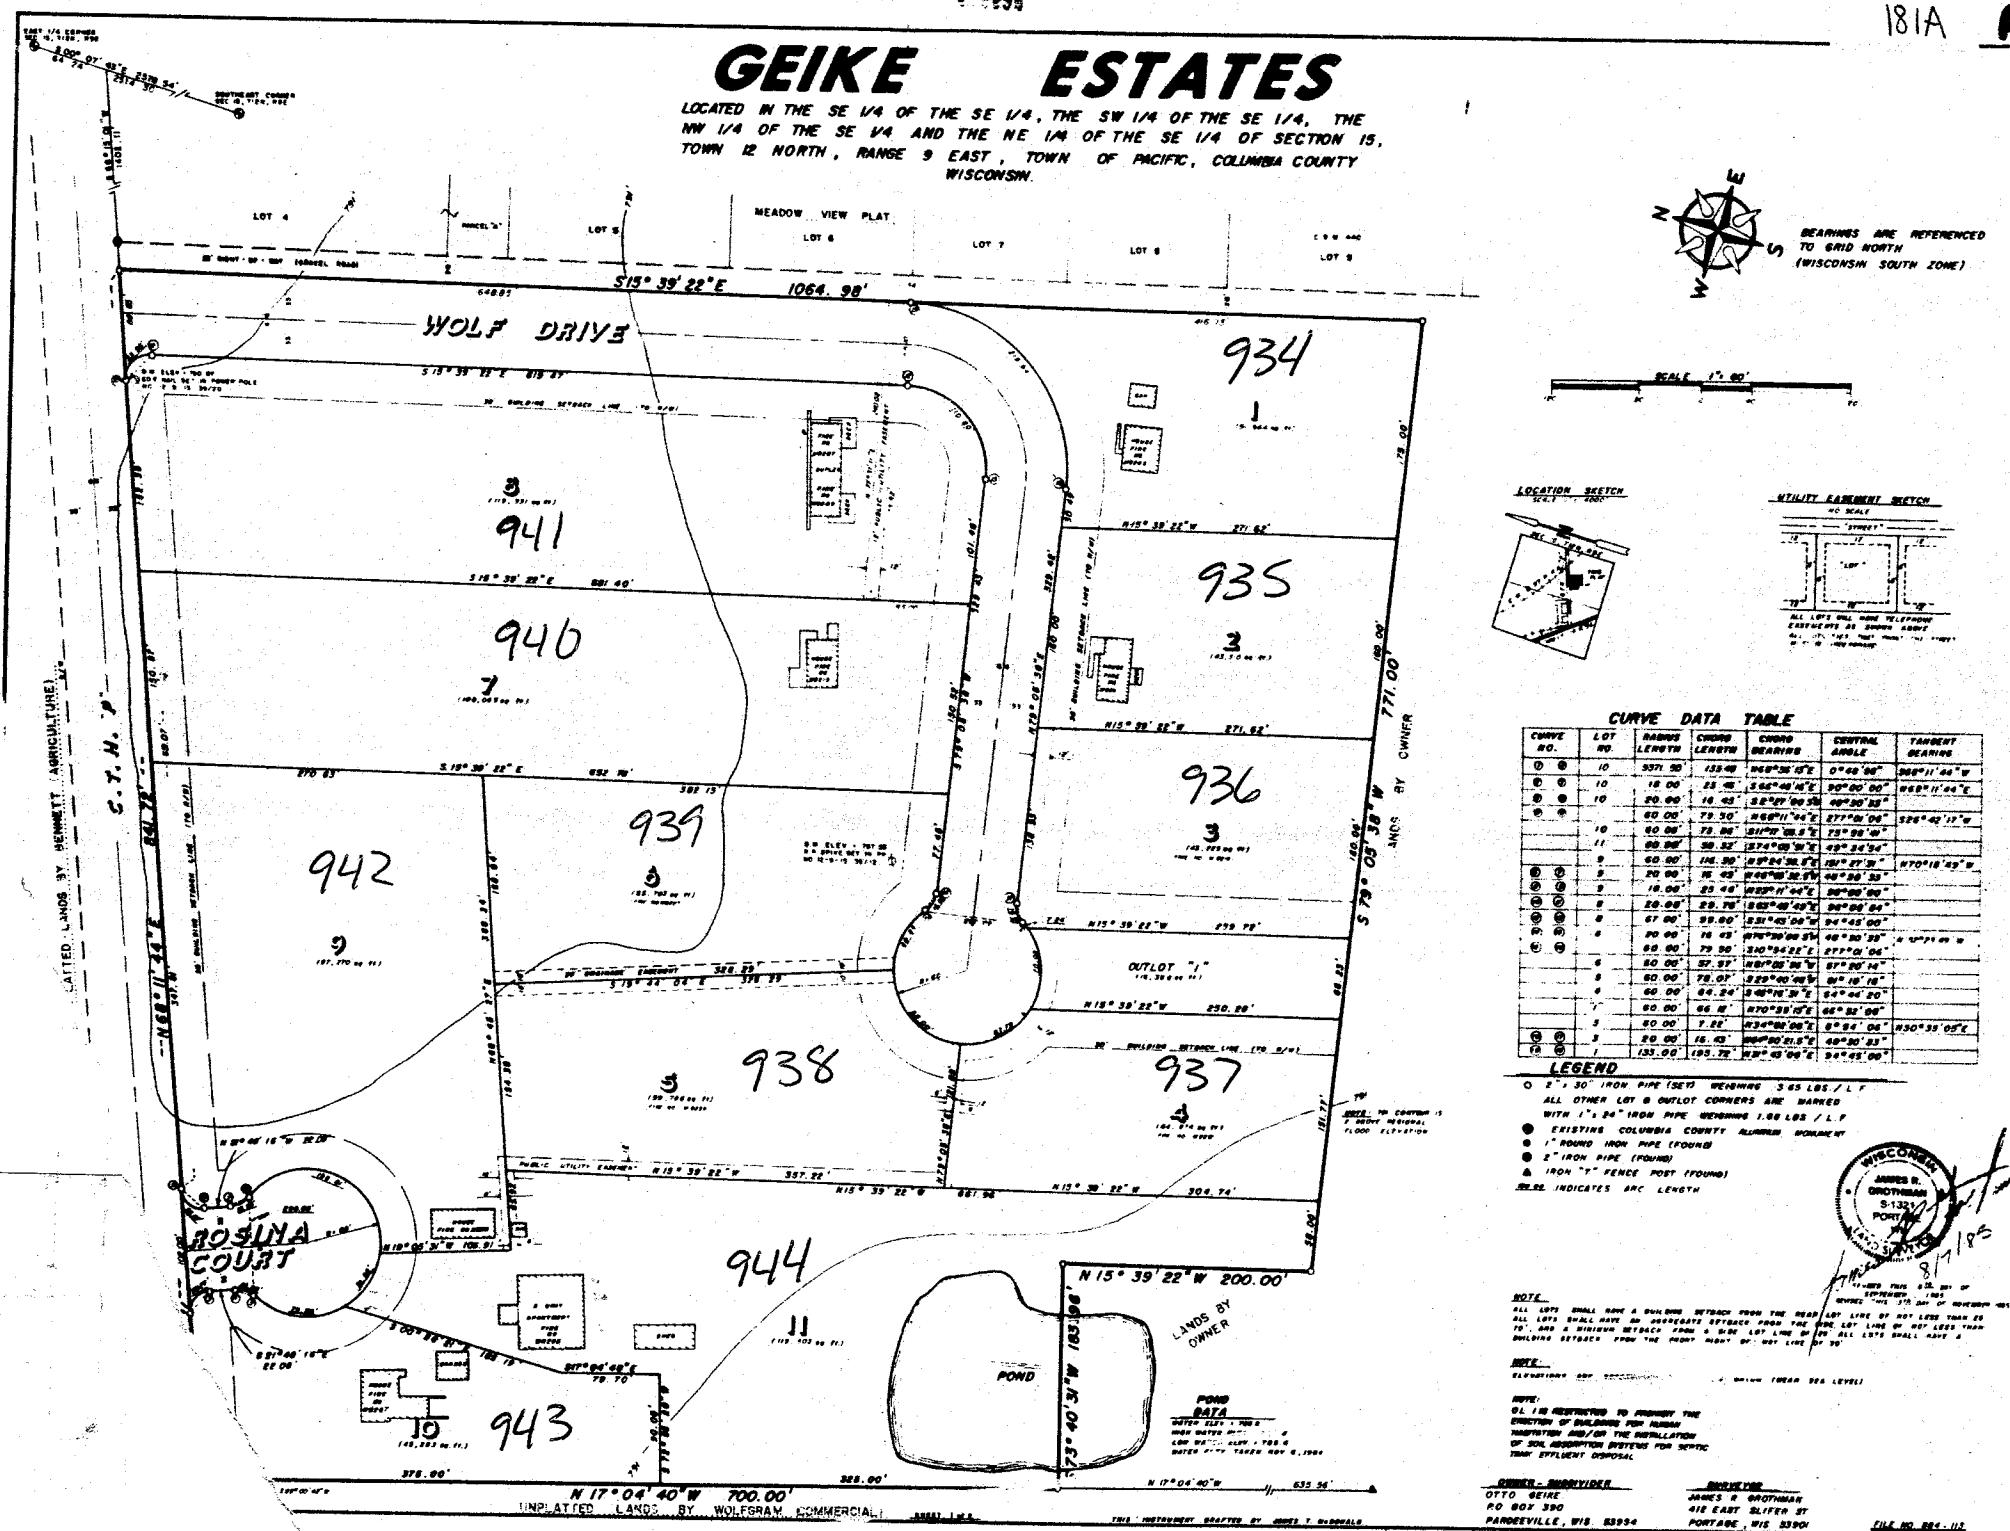


C.T.H. "P"

PACIFIC


SEC. 15 T.12N. R.9E.

Replaced
2004

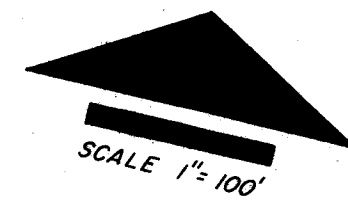

MEADOW VIEW PLAT

DENNIS JARCHOW & JOHN ALDRIDGE
R 178-793

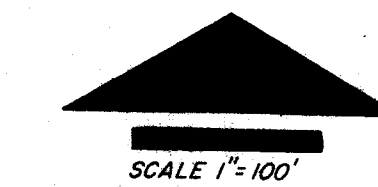

C.T.H. "P"

NOTE: Lots 1-8
526-533
John Terlecke


6580-OLeary

E1/4 Cor. Sec. 15



CERTIFIED SURVEY

C.M. ST. P. & P. R.R.

Sec. 15 Sec. 14

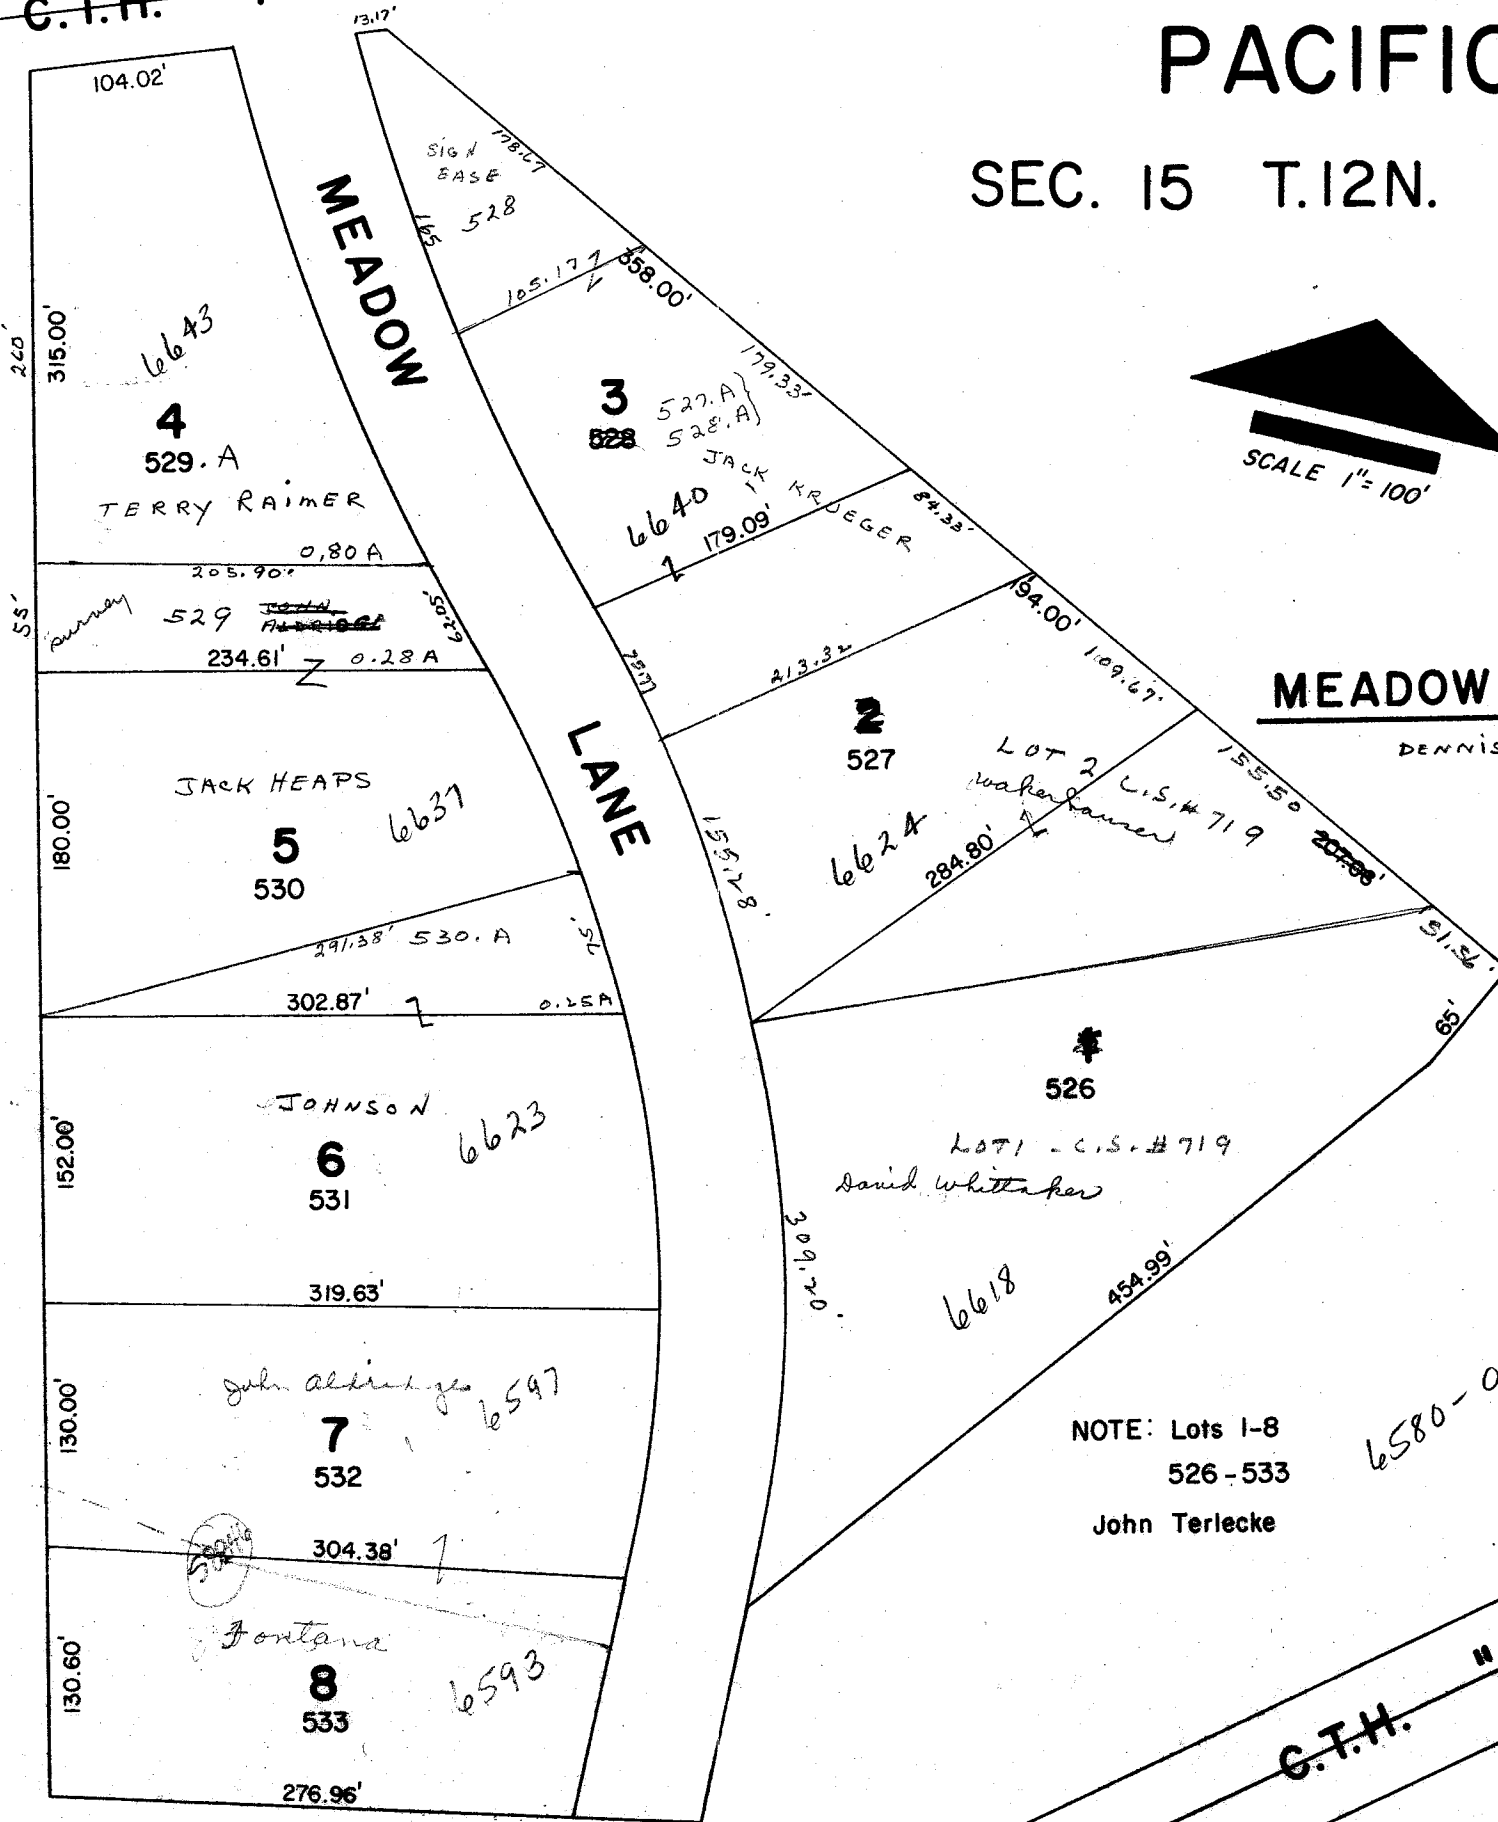

Miller
6581

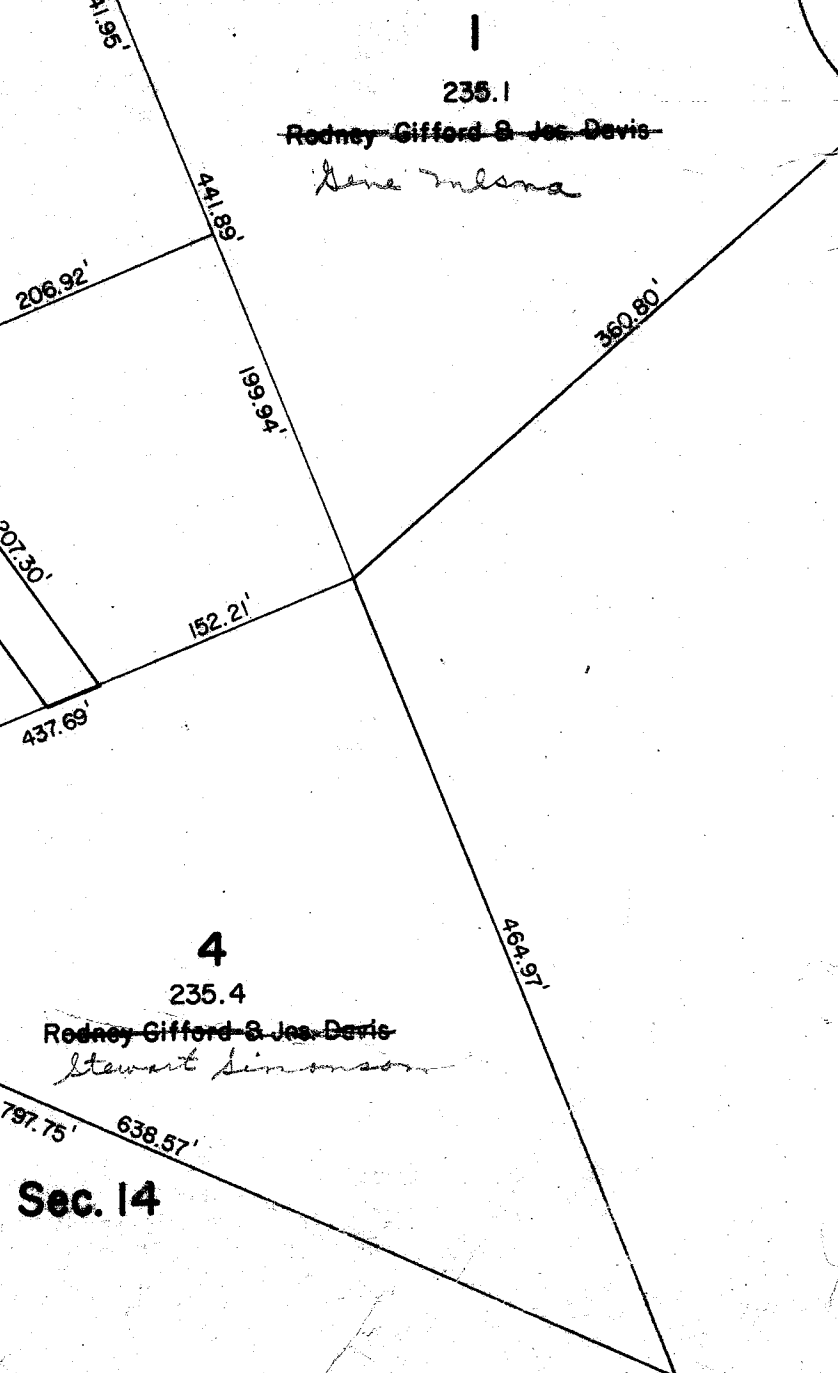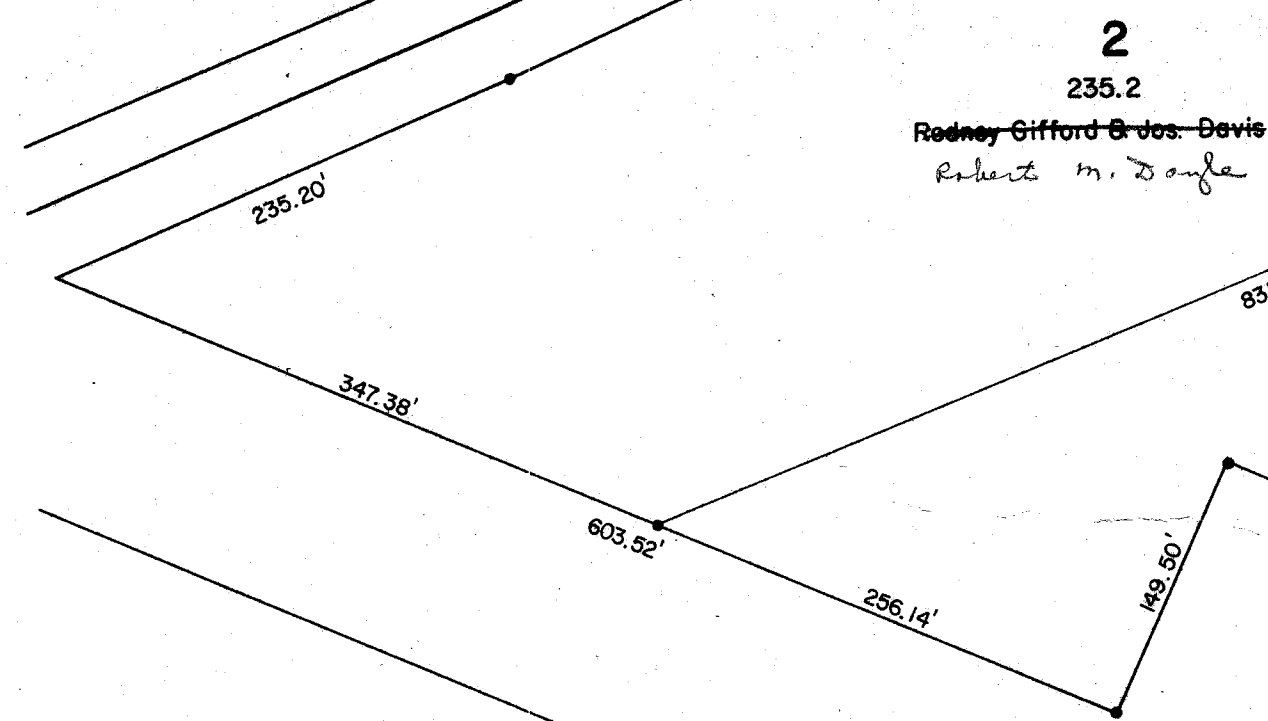

SEC. 16 T.12N. R.9E.

2004

22.80

244.01

242.A
553.54 1.94

242.B
553.54 1.94

242.C
553.54 1.94

243

244

Wisconsin Power & Light Co.

245

C.M. St. P. & N.W. Ry.

Also per in Sec. 9

ROBERT HARVEY

DAVID BENNETT

Miss Whitney 1.75

22.80

17.898 ac


City of Portage

Vaco Leasing Co.

1983

J. H. Sweeney, Surveyor


194.00

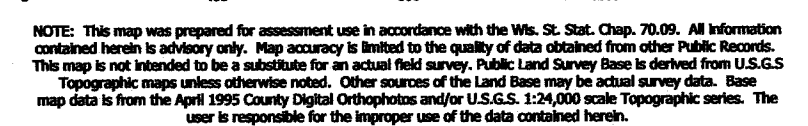

Created by The Columbia County Land Information Office -GIS Section. VMB. July 2004.


TOWN of PACIFIC

TOWN 12 NORTH RANGE 9 EAST
COLUMBIA COUNTY, WISCONSIN

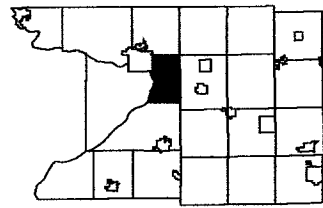

	3	2	1
	10	11	12
	15	14	13
	22	23	24
28	27	26	25
33	34	35	36

~~Replaced~~
2005

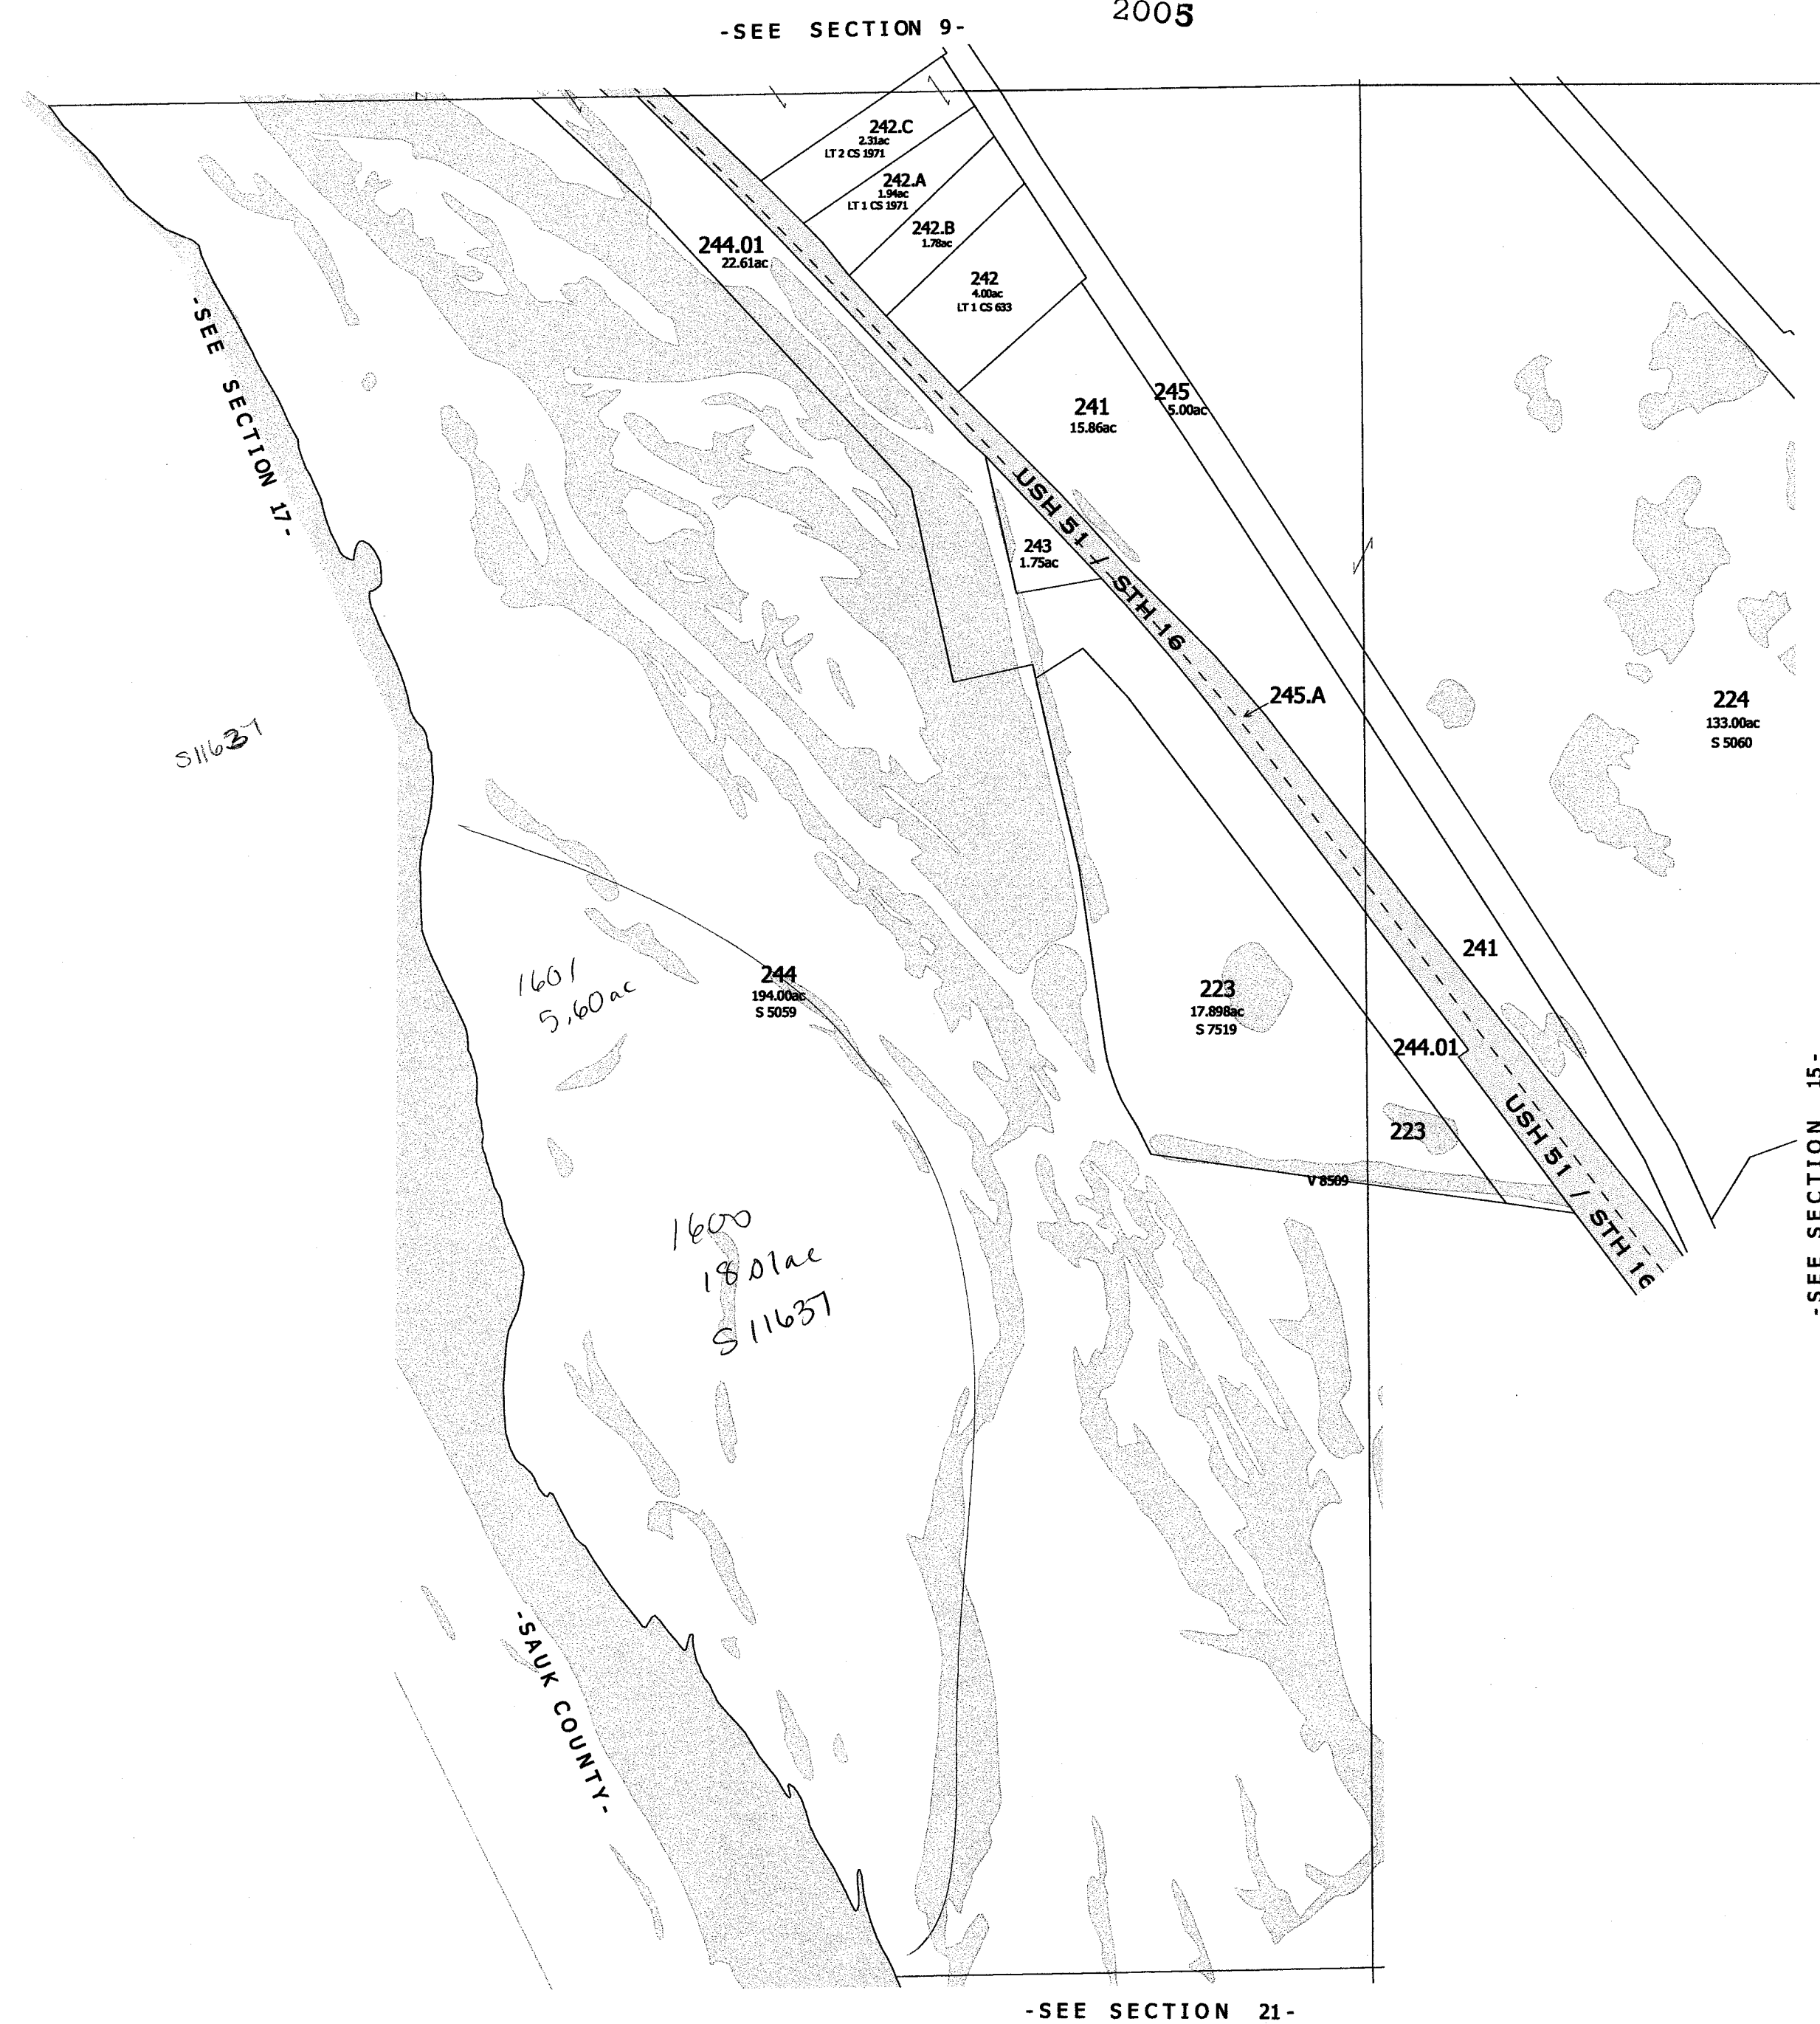


- SEE SECTION 21 -

-SECTION 16-

yes

PACIFIC
SEC. 21 T. 12N. R. 9E

Replaced
2004

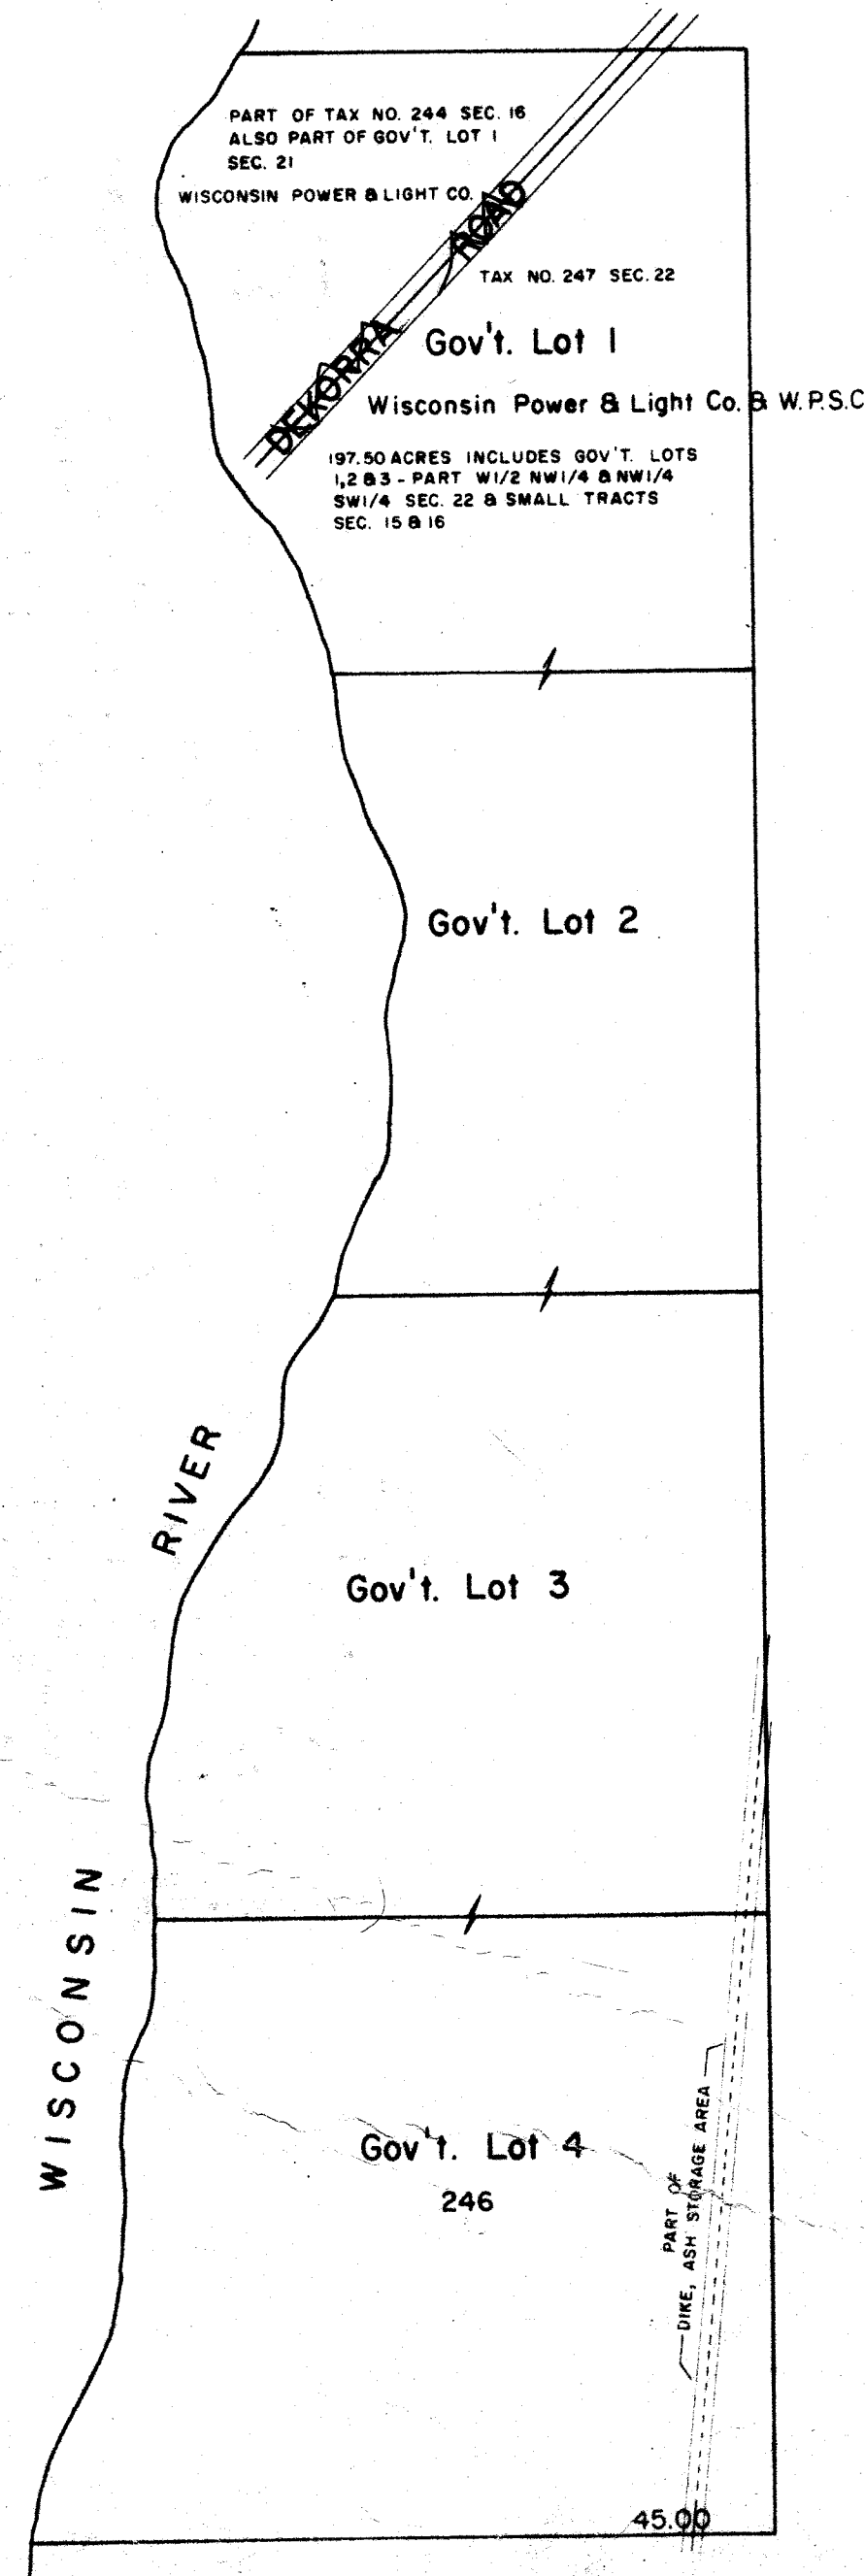

One Inch Equals Four Hundred Feet

MILES
0 1/16 1/8 1/4
FEET
0 400 800 1200 1600

NOTE: This map was prepared for assessment use in accordance with the Wis. St. Stat. Chap. 70.09. All information contained herein is advisory only. Map accuracy is limited to the quality of data obtained from other public Records. This map is not intended to be a substitute for an actual field survey. Public Land Survey Base is derived from U.S.G.S. Topographic maps unless otherwise noted. Other sources of the Land Base may be actual survey data. Base map data is from the April 1995 County Digital Orthophotos and/or U.S.G.S. 1:24,000 scale Topographic series. The user is responsible for the improper use of the data contained herein.


Created by The Columbia County Land Information Office -GIS Section. VMB. July 2004.

TAX PARCEL MAP

TOWN of PACIFIC


TOWN 12 NORTH RANGE 9 EAST
COLUMBIA COUNTY, WISCONSIN

Replaced
2006

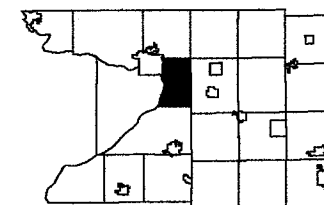

3	2	1
10	11	12
15	14	13
22	23	24
29	27	26
33	34	35

-SEE SECTION 16-

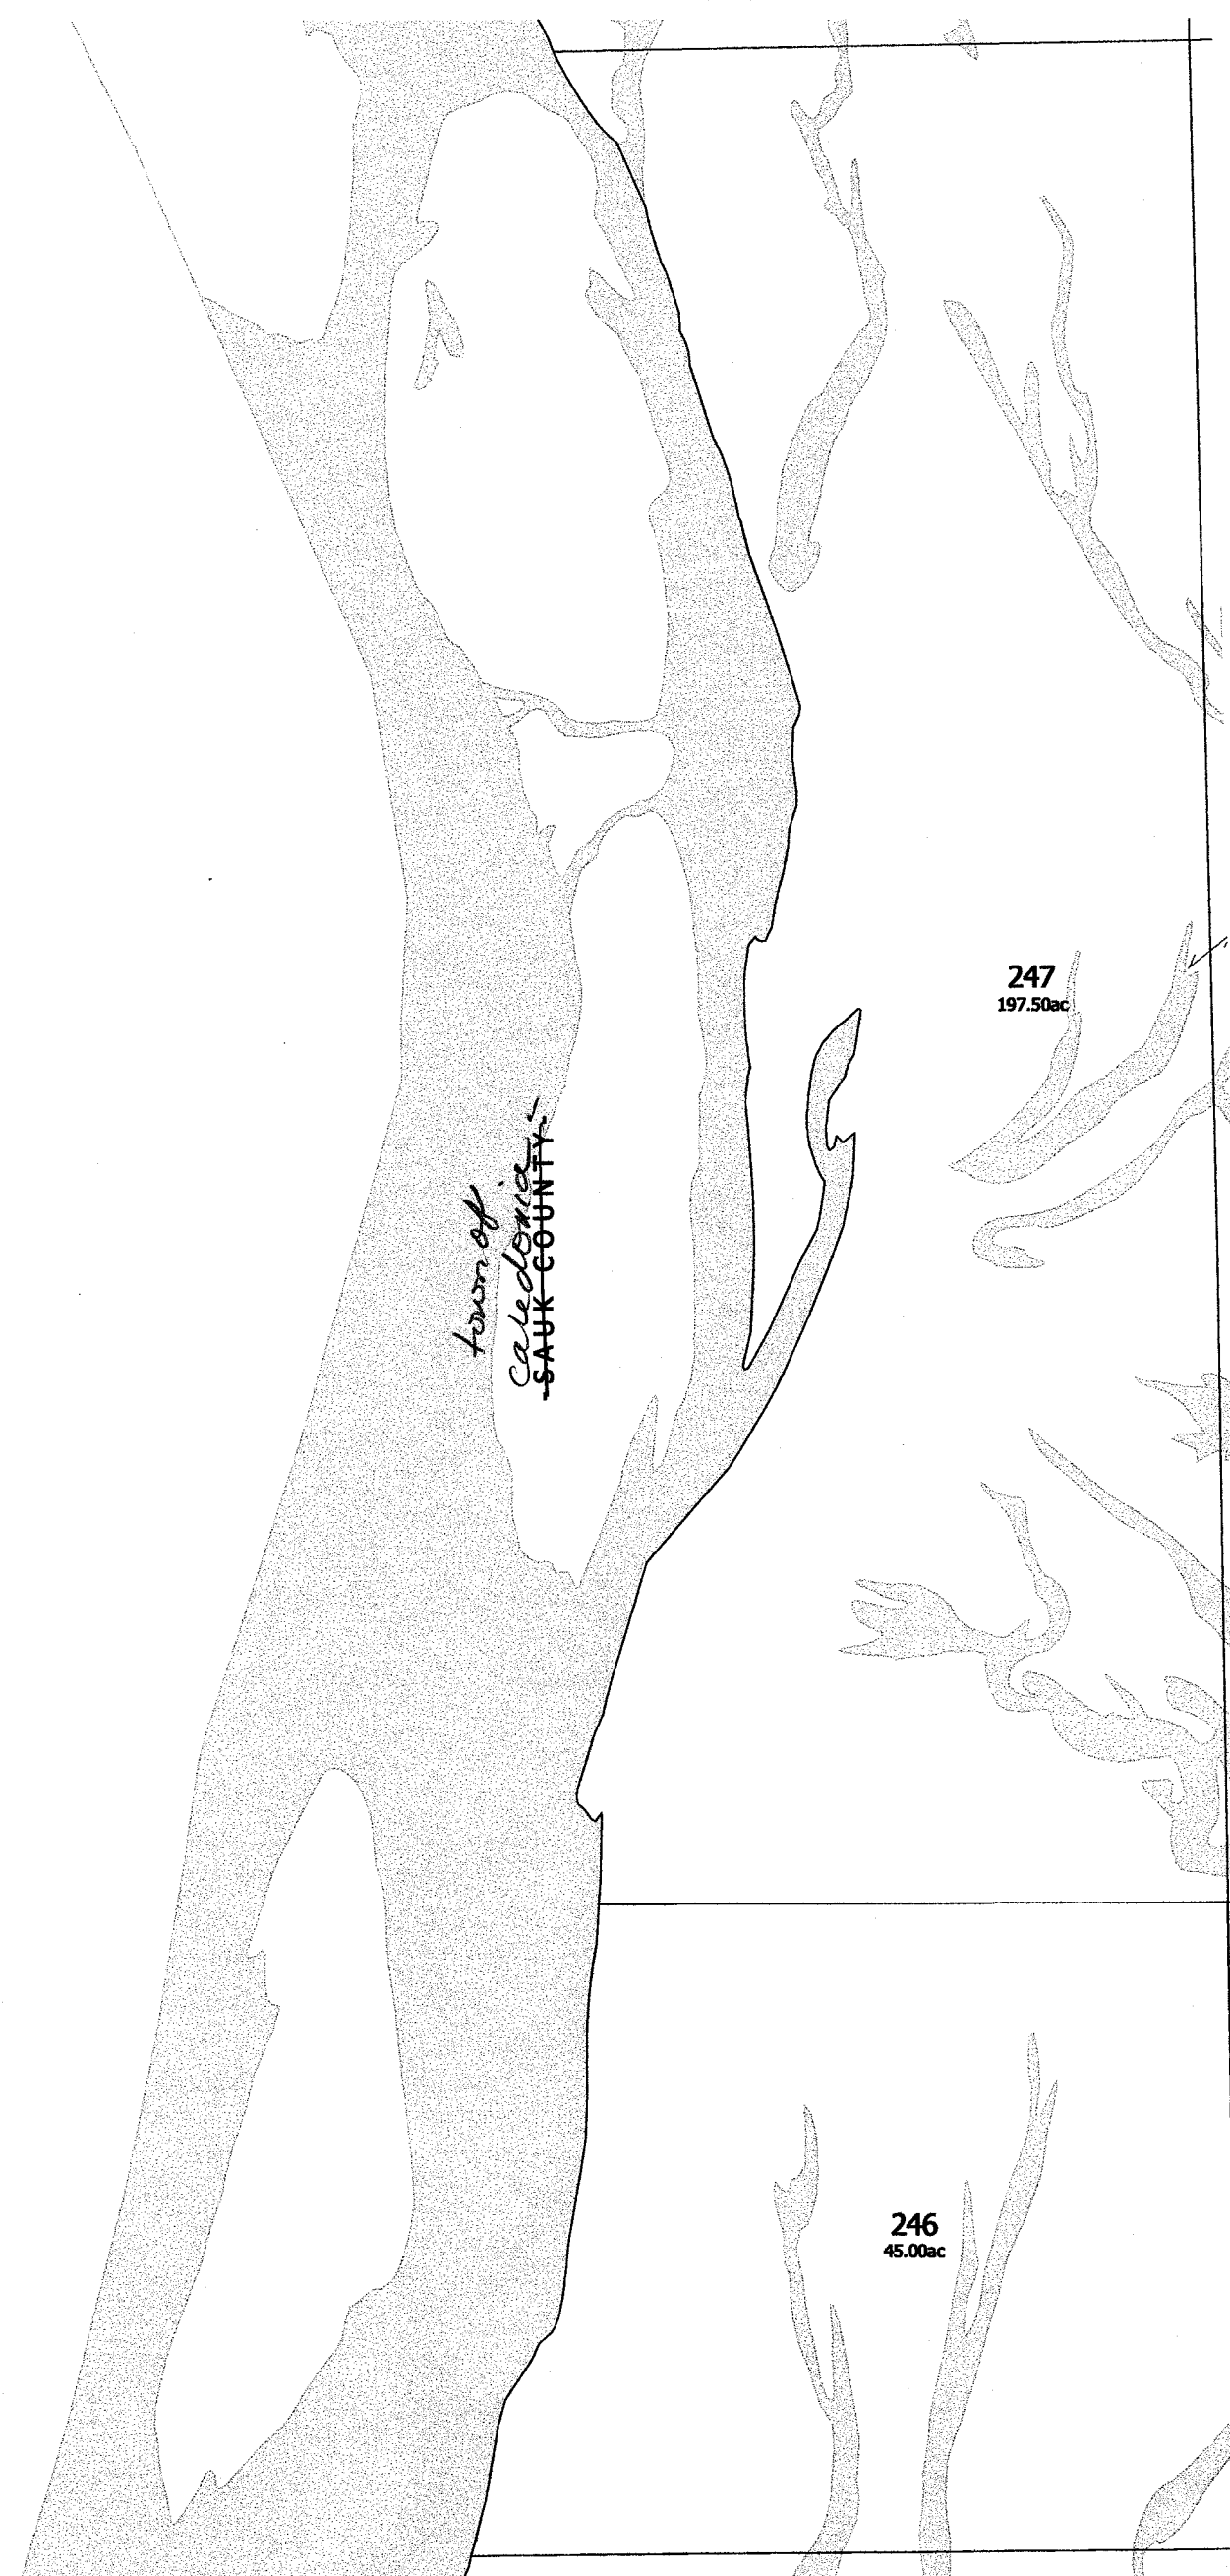

-SEE SECTION 22-

-SEE SECTION 28-

Replaced
2006


-SECTION 21-

PACIFIC

SEC. 22 T.12N. R.9E

Replaced
2004

actual

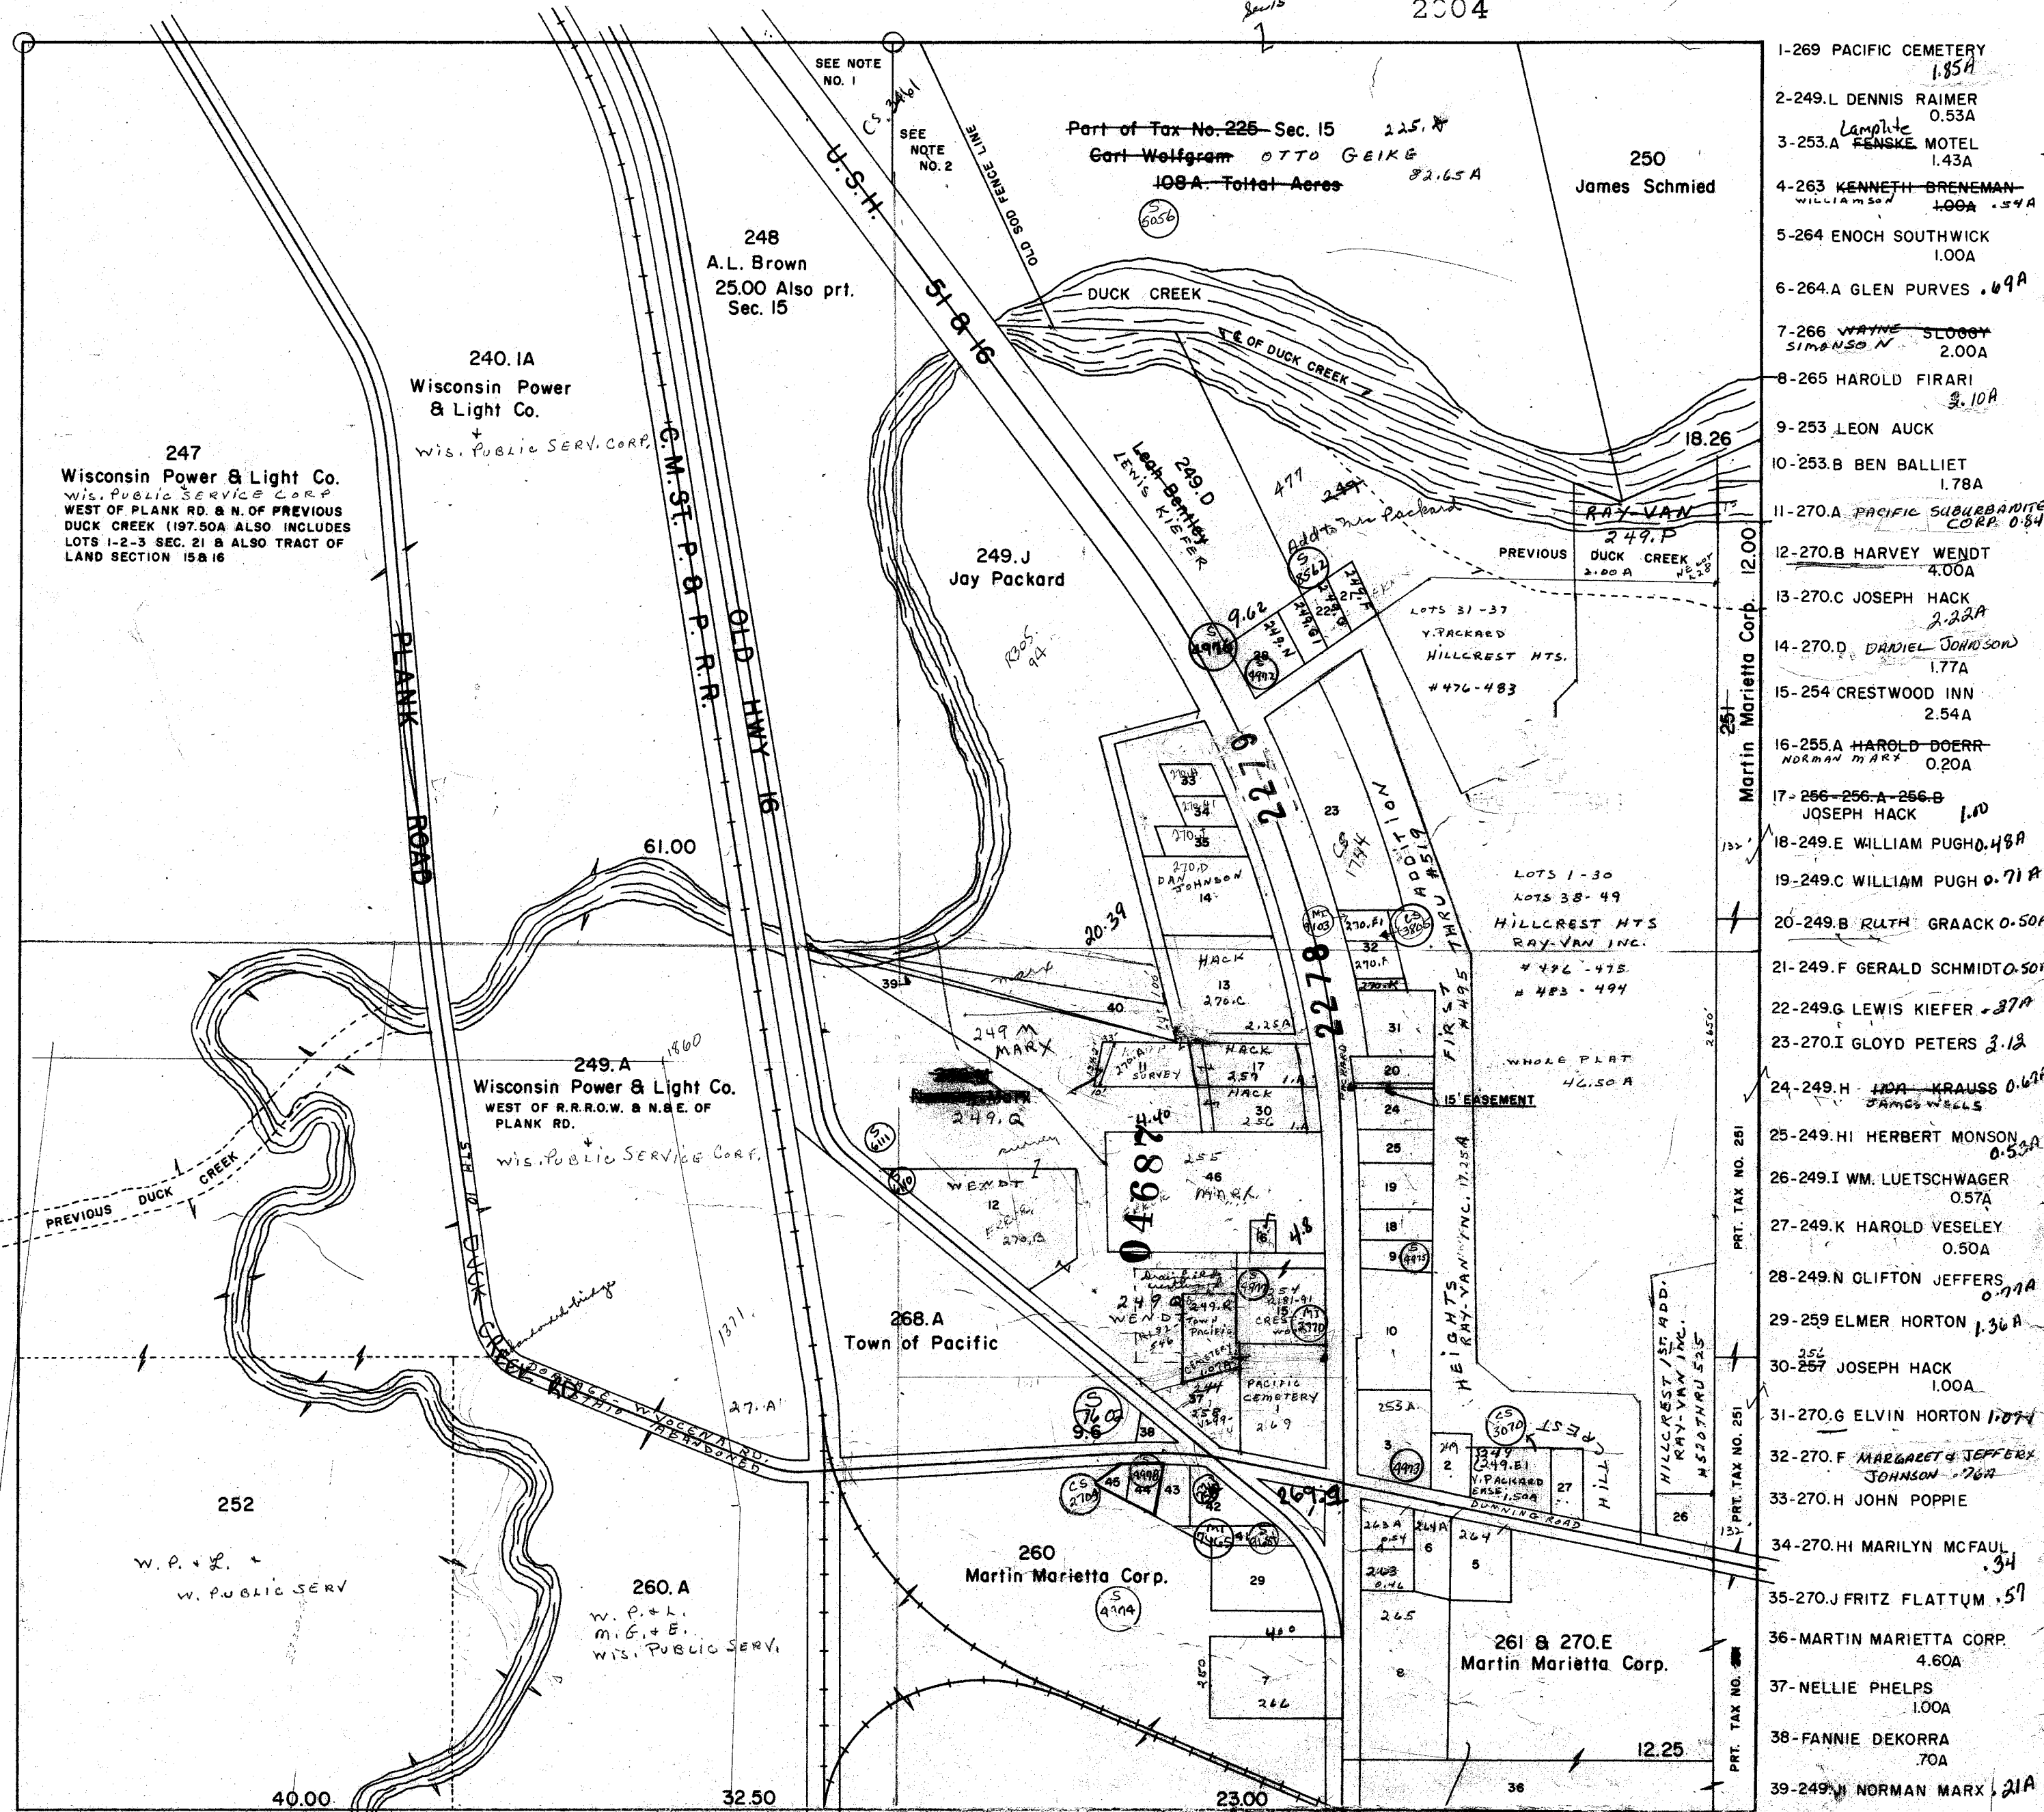

NOTE NO. 1
PRT. OF TAX NO. 231-231.A
SEC. 15 BIG RETAIL STORE

NOTE NO. 2
PRT. OF TAX NO. 252.A
SEC. 15 BIG RETAIL STORE
See R 124-320 - Lease & major
to proposed Ben Franklin Store

270
C.M. ST. P. & P.R.R.
14.00A

44-267.8 ROY EAGEN
267.01 31A
45-267.8 ROY EAGEN
0.18A
46-255 NORMAN MARX
4.8A

41-267.A VERNON SINES
0.60A

42-267 SAM SINES
0.36A

PROPERTY OF TAX LISTING DEPARTMENT


actual

PACIFIC

SEC. 22 T. 12N. R. 9E

Replaced
2004

ORIGINAL

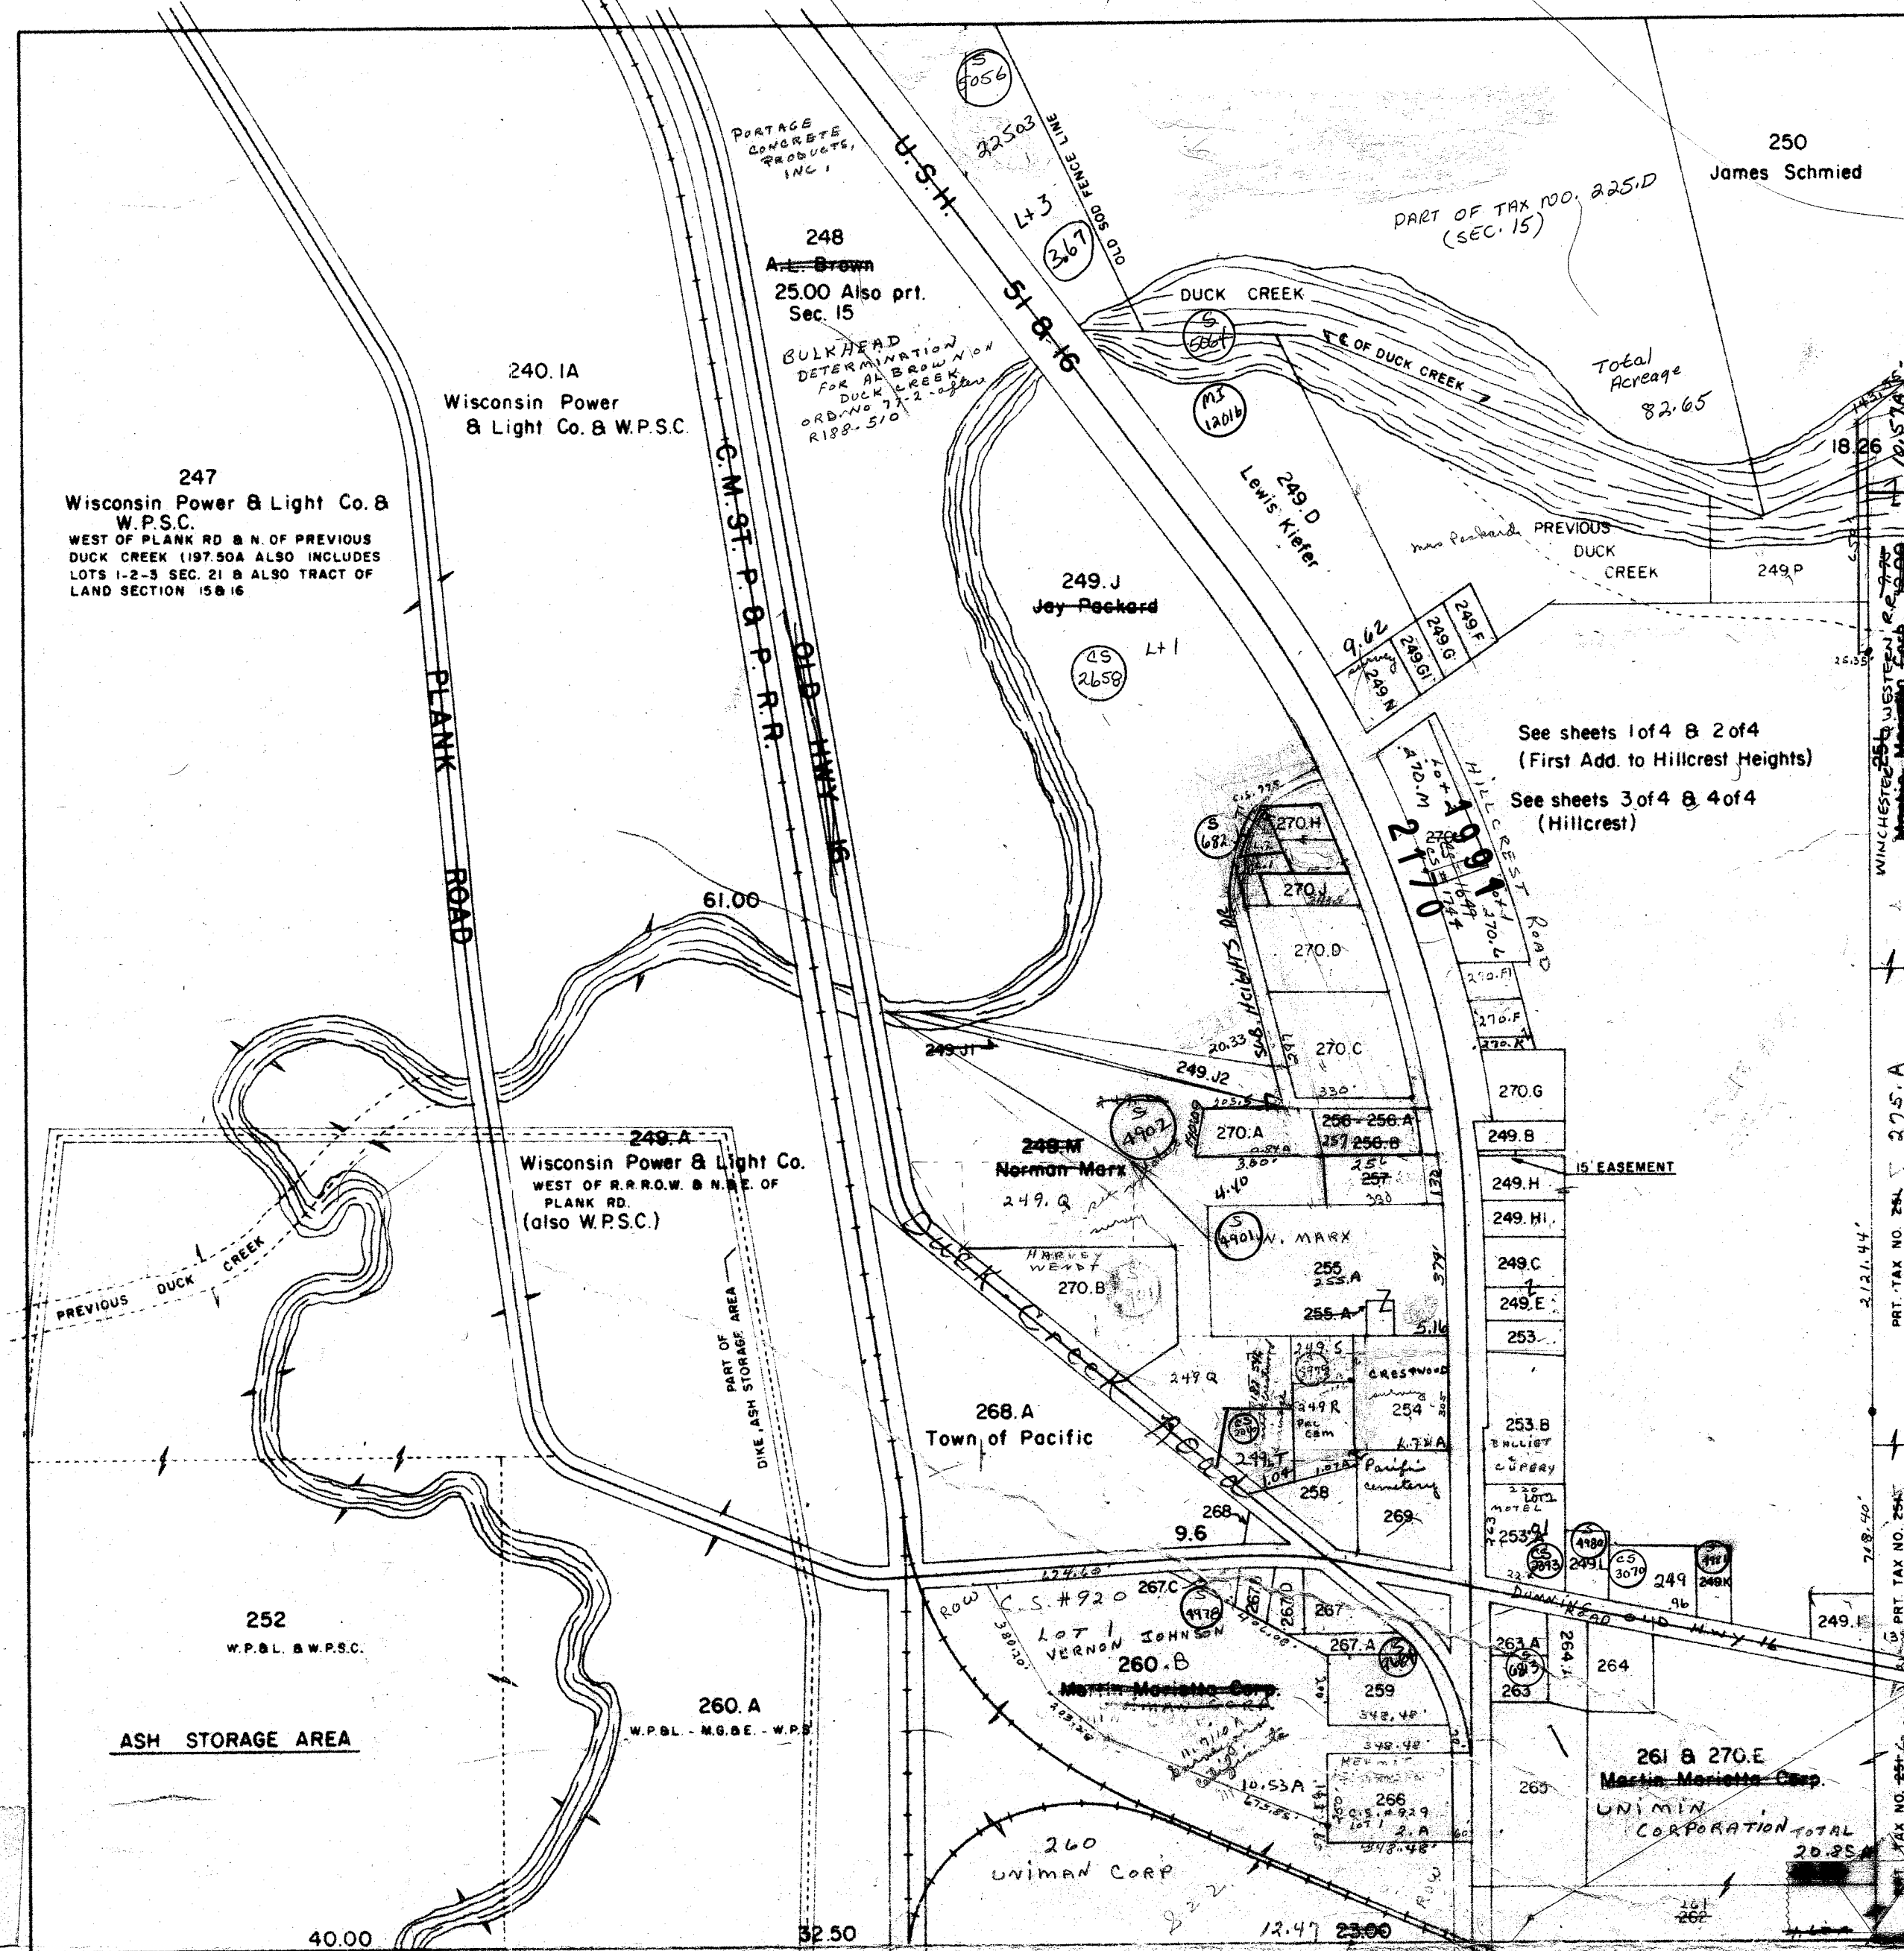


- C.S. V-3 #775
270. H2 - LOT 1 - G.W. TEL. CO.
270. H3 - LOT 2 - G.W. TEL. CO.
269 PACIFIC CEMETERY 1.85A
249 L DENNIS RAIMER 0.53A
253 A LAMP LITE MOTEL 1.43A
263 ~~Angela Ruth Breneman~~ 0.54A
264 ~~ENOCH SOUTHWICK~~ 1.00A
264 A GLEN PURVES 0.69A
266 ~~WAYNE SLOSSY~~ 2.00A
265 HAROLD FIRARI 2.10A
253 LEON AUCK 1.78A
270 A ~~PACIFIC SUBURBANITE~~ 0.81A
270 B HARVEY WENDT 4.00A
270 C JOSEPH HACK 2.22A
270 D DANIEL JOHNSON 1.77A
254 ~~PECK'S PLANTATION~~ 2.54A 1.72A
255 A NORMAN MARX 0.20A
256-256 A-256 B 1.00A
249 E WILLIAM PUGH 0.48A
249 C WILLIAM PUGH 0.71A
249 B ERNEST GRAACK 0.50A
249 F GERALD SCHMIDT 0.50A
249 G ~~LEWIS KIEFER~~ 3.7A
270 I SUSAN HALL 3.13
249 H ~~W.A. KRAUSS~~ 0.67A
249 HI HERBERT MONSON 0.33A
249 I ~~W.A. LUETSCHWAGER~~ 0.57A
249 K ~~HAROLD WESSER~~ 0.50A
249 N ~~CLINTON JEFFERS~~ 0.77A
259 ELMER HORTON 1.36A
257 JOSEPH HACK 1.00A
270 G ELVIN HORTON 1.07A
270 F ~~MARGARET JEFFERY~~ 0.76A
270 H JOHN ROPPIE 7.11A
270 HI MARILYN McFAUL 0.34
270 J FRITZ FLATTUM 0.57
262 MARTIN MARIETTA CORP 4.60A
258 MRS. NELLIE PHELPS 1.00A
268 FANNIE DEKORRAH 70A
249 J1 NORMAN MARX 2.1A
249 J2 NORMAN MARX 2.1A
249 G1 ~~W.A. KRAUSS~~ 0.37A
249 P RAY VAN INK 2.00A
263 A JOHN CAVANAUGH 0.51A

NOTE NO 1
PRT OF TAX NO. 231-231 A
SEC 15 BIG RETAIL STORE

NOTE NO 2
PRT OF TAX NO. 252 A
SEC 15 BIG RETAIL STORE

267 B ROY EAGEN 0.31A
267 C ROY EAGEN 0.18A
255 NORMAN MARX 4.8A

267 A VERNON SINES 0.60A
267 SAM SINES 0.36A
267 D DONALD BARTON 0.50A

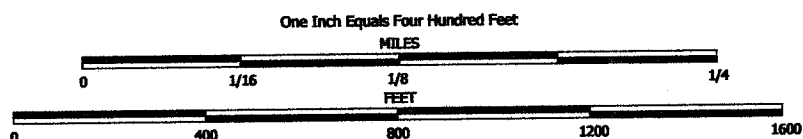


NOTE: This map was prepared for assessment use in accordance with the Wis. Stat. Chp. 70.09. All information contained herein is advisory only. Map accuracy is limited to the quality of data obtained from other Public Records. This map is not intended to be a substitute for an actual field survey. Public Land Survey Base is derived from U.S.G.S. Topographic maps unless otherwise noted. Other sources of the Land Base may be actual survey data. Base map data is from the April 1995 County Digital Orthophotos and/or U.S.G.S. 1:24,000 scale Topographic series. The user is responsible for the improper use of the data contained herein.

Created by The Columbia County Land Information Office - GIS Section. VMB, July 2004.

TAX PARCEL MAP


TOWN of PACIFIC

TOWN 12 NORTH RANGE 9 EAST
COLUMBIA COUNTY, WISCONSIN

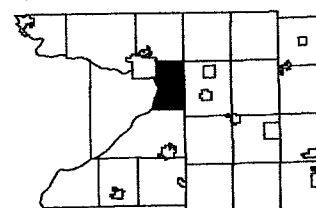

3	2	1
10	11	12
15	14	13
22	23	24
29	28	25
36	35	34


Replaced
2006

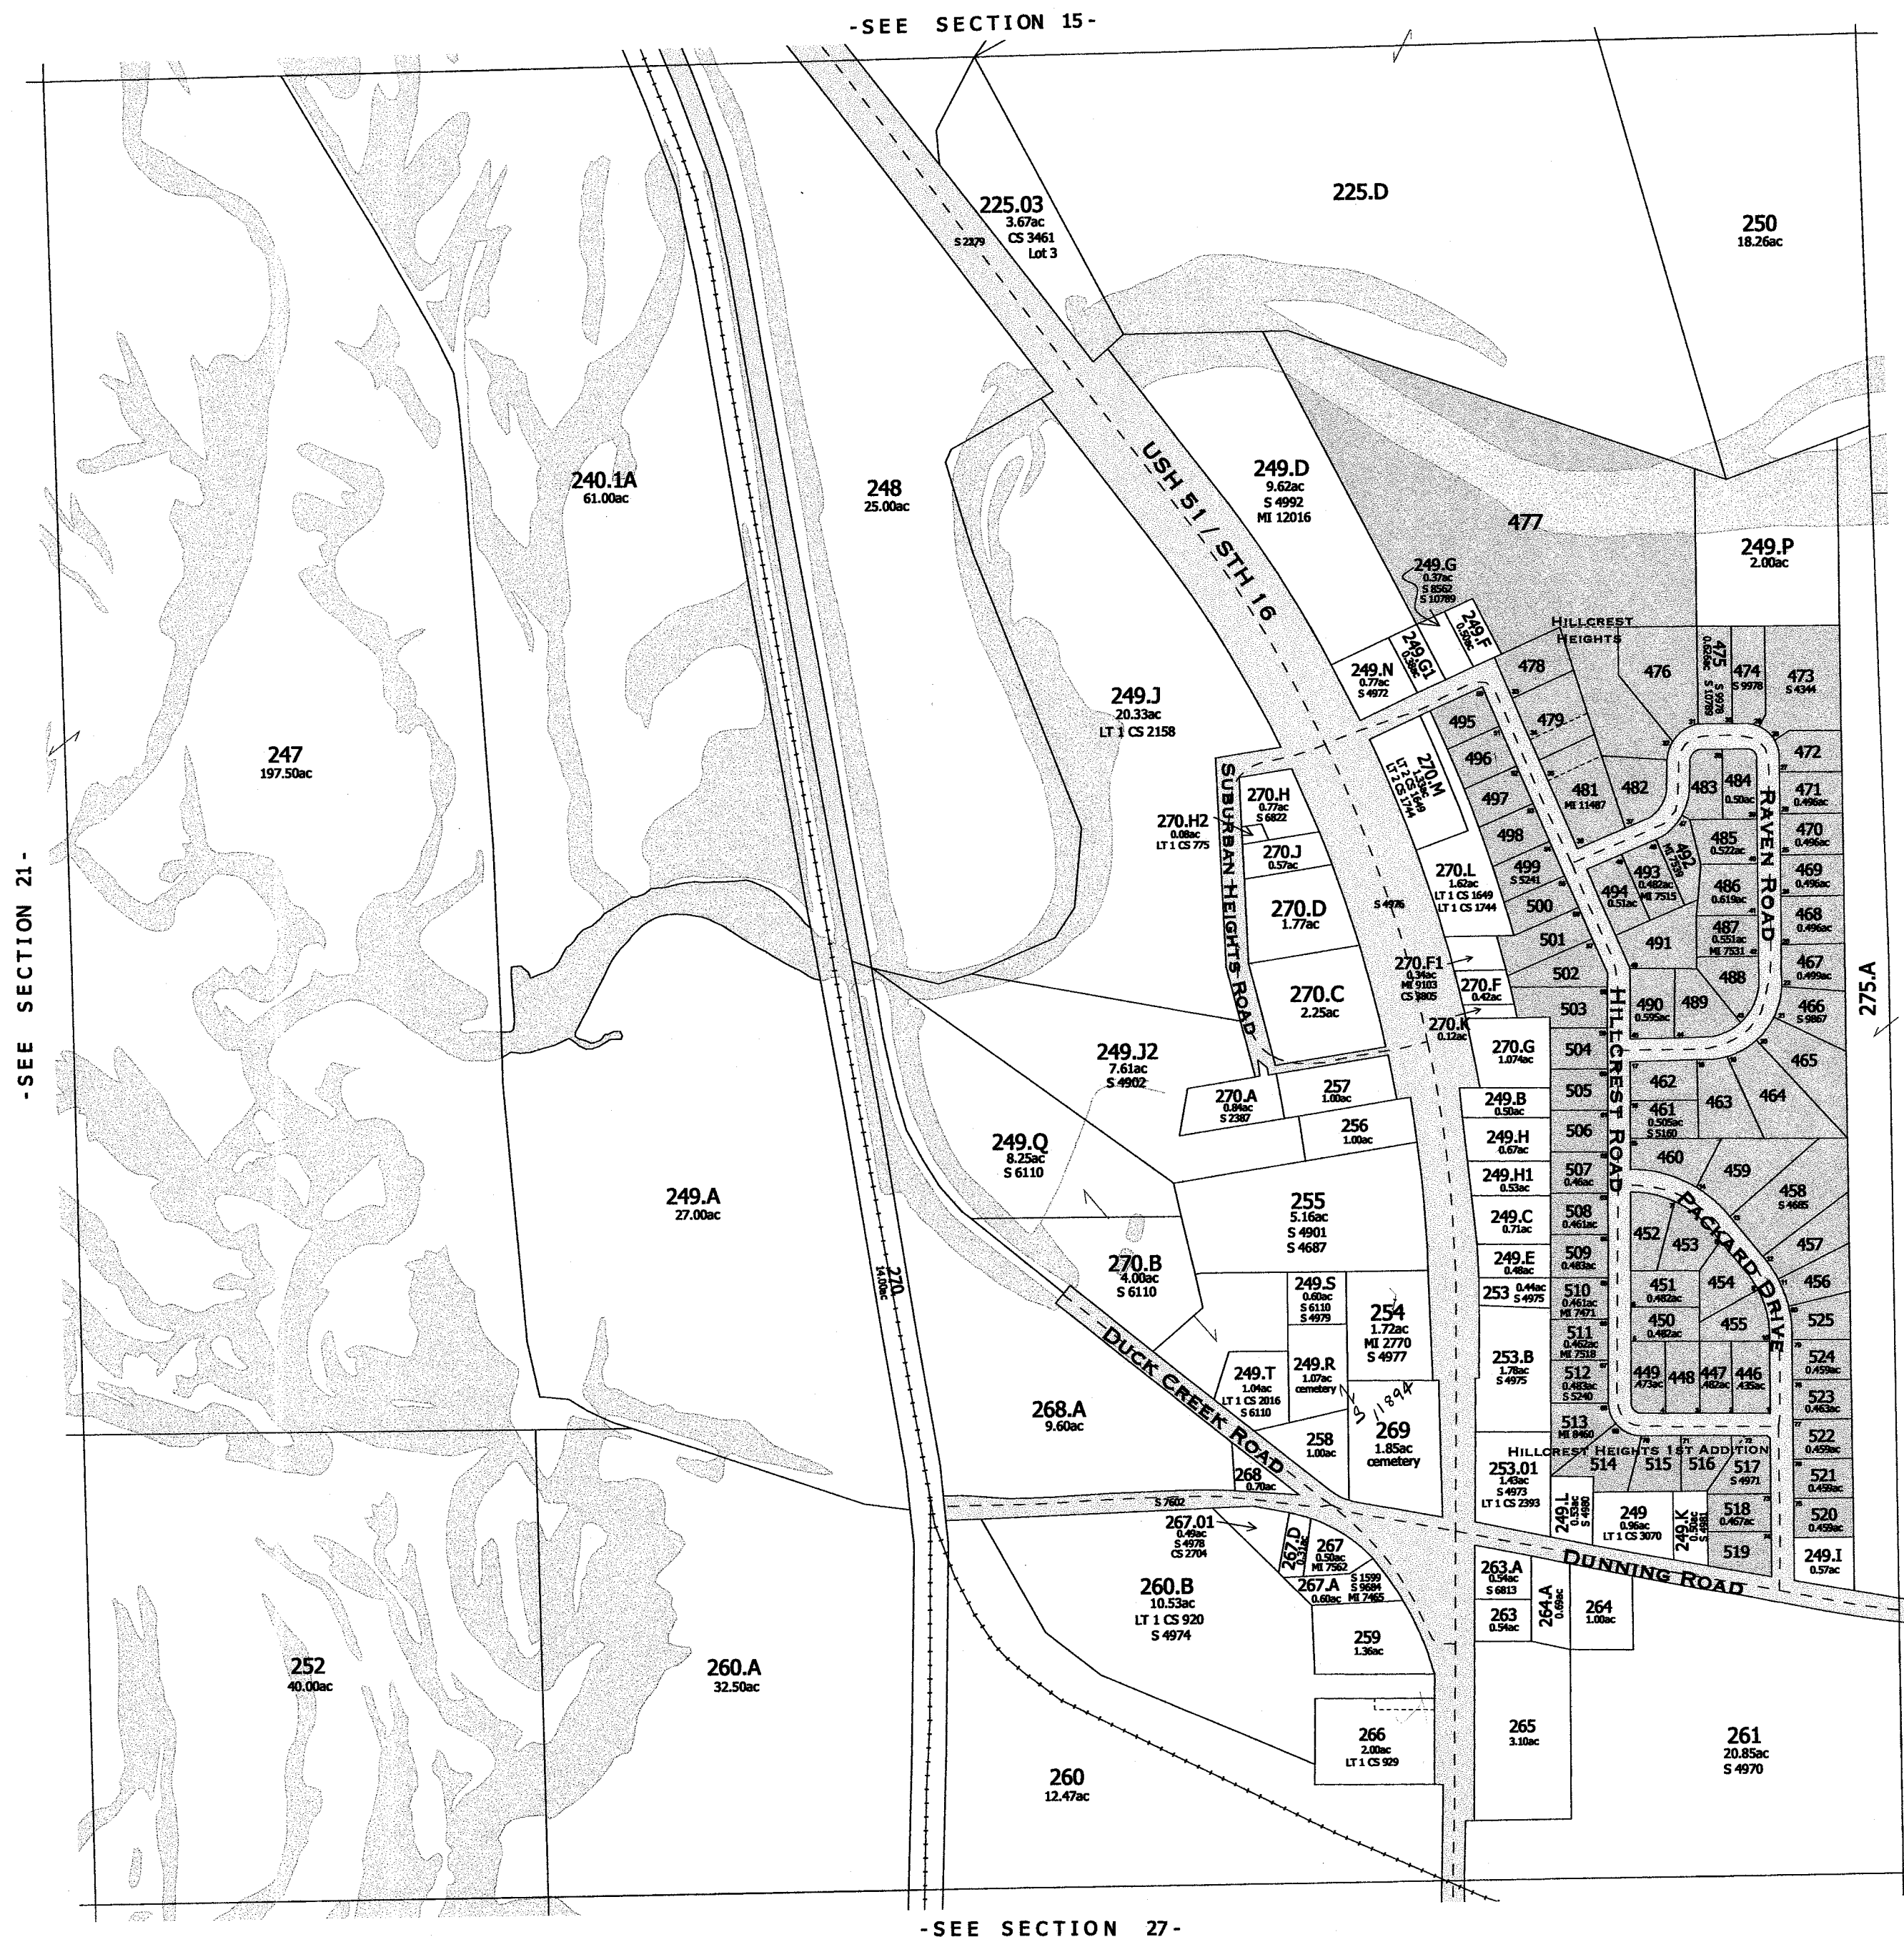

-SEE SECTION 27-

HILLCREST HEIGHTS - S7368
HILLCREST HEIGHTS 1ST ADDITION - S7369

Replaced
2006
-SECTION 22-

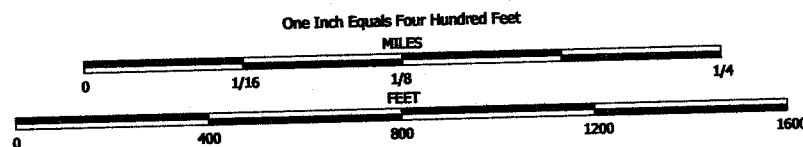


NOTE: This map was prepared for assessment use in accordance with the Wis. St. Stat. Chap. 70.09. All information contained herein is advisory only. Map accuracy is limited to the quality of data obtained from other Public Records. This map is not intended to be a substitute for an actual field survey. Public Land Survey Base is derived from U.S.G.S. Topographic maps unless otherwise noted. Other sources of the Land Base may be actual survey data. Base map data is from the April 1995 County Digital Orthophotos and/or U.S.G.S. 1:24,000 scale Topographic series. The user is responsible for the proper use of the data contained herein.

Created by The Columbia County Land Information Office -GIS Section. VMB, February 2006.

TAX PARCEL MAP


TOWN of PACIFIC

TOWN 12 NORTH RANGE 9 EAST
COLUMBIA COUNTY, WISCONSIN

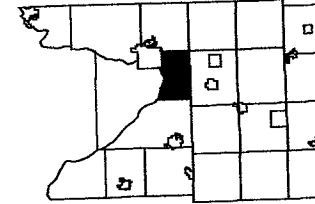

3	2	1
10	11	12
15	14	13
22	23	24
27	28	26
32	34	36

Replaced
2007

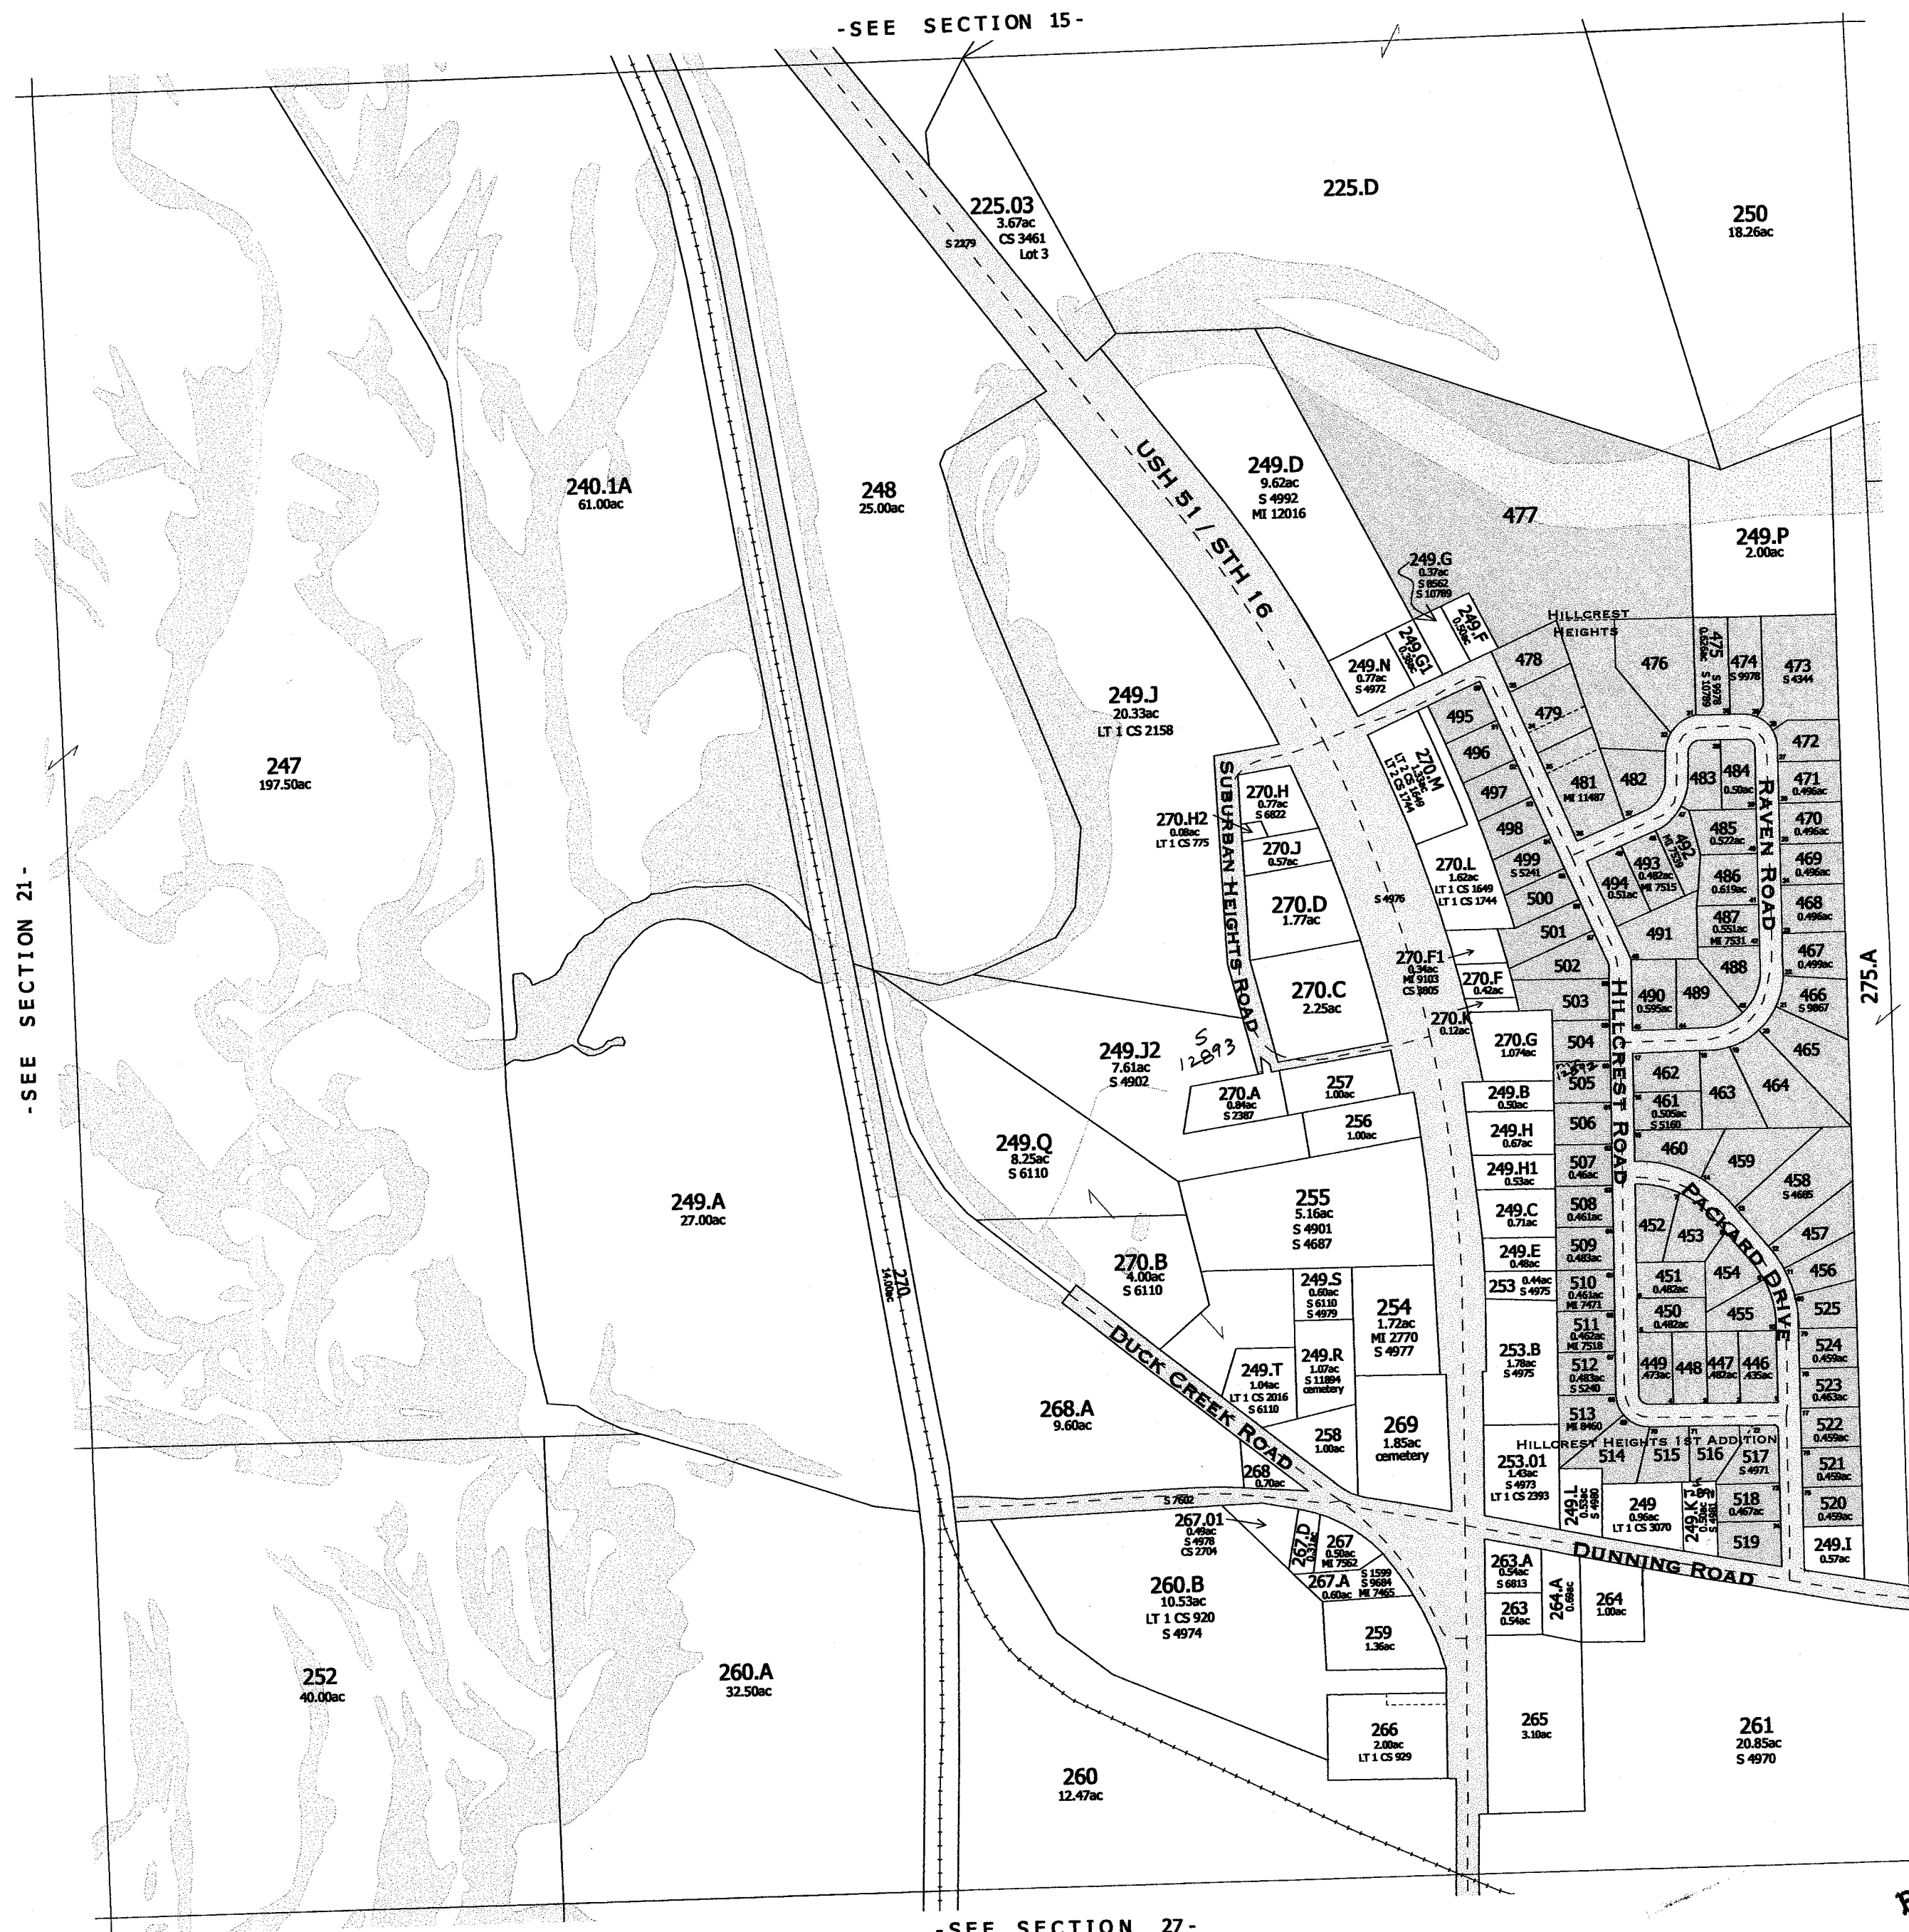

HILLCREST HEIGHTS - S7368
HILLCREST HEIGHTS 1ST ADDITION - S7369

-SECTION 22-


Replac
20

SEC. 22 T.12N. R.9E.

HILLCREST HEIGHTS

Plat
7368


UNPLATTED	LANDS	OWNED	BY	OTHERS

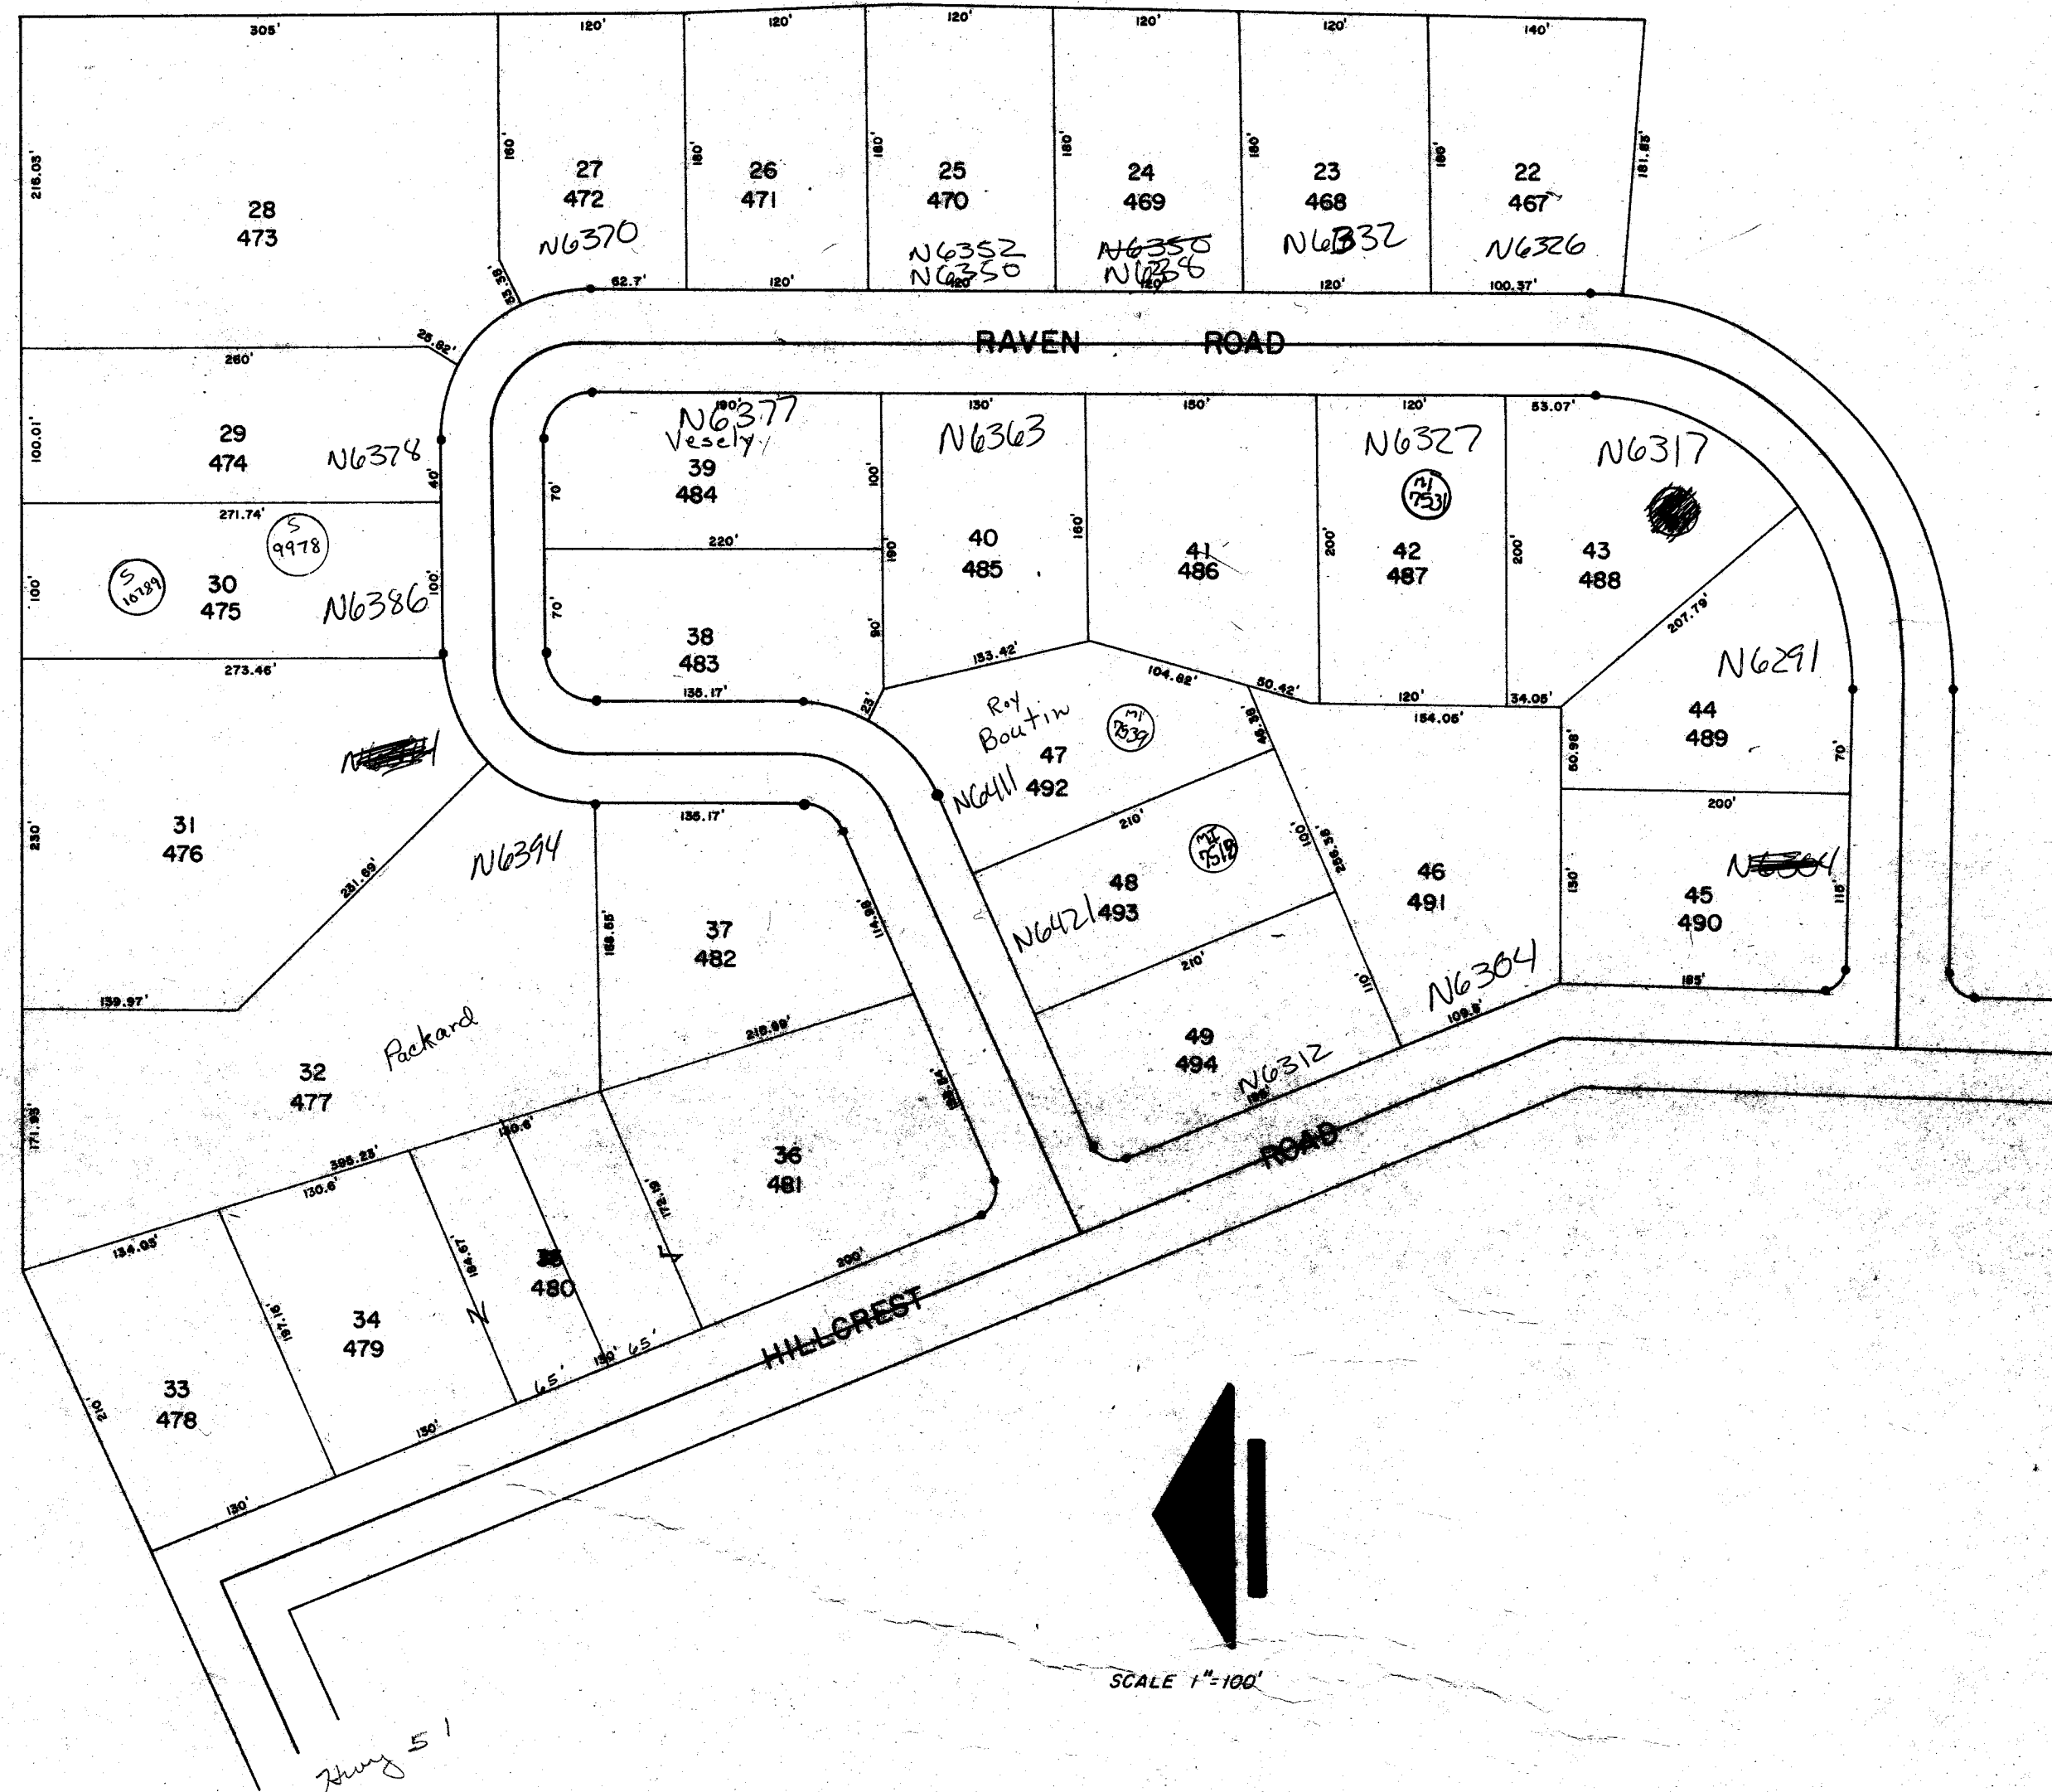

SEC. 22 T.12N. R.9E.

HILLCREST

Plat
7368

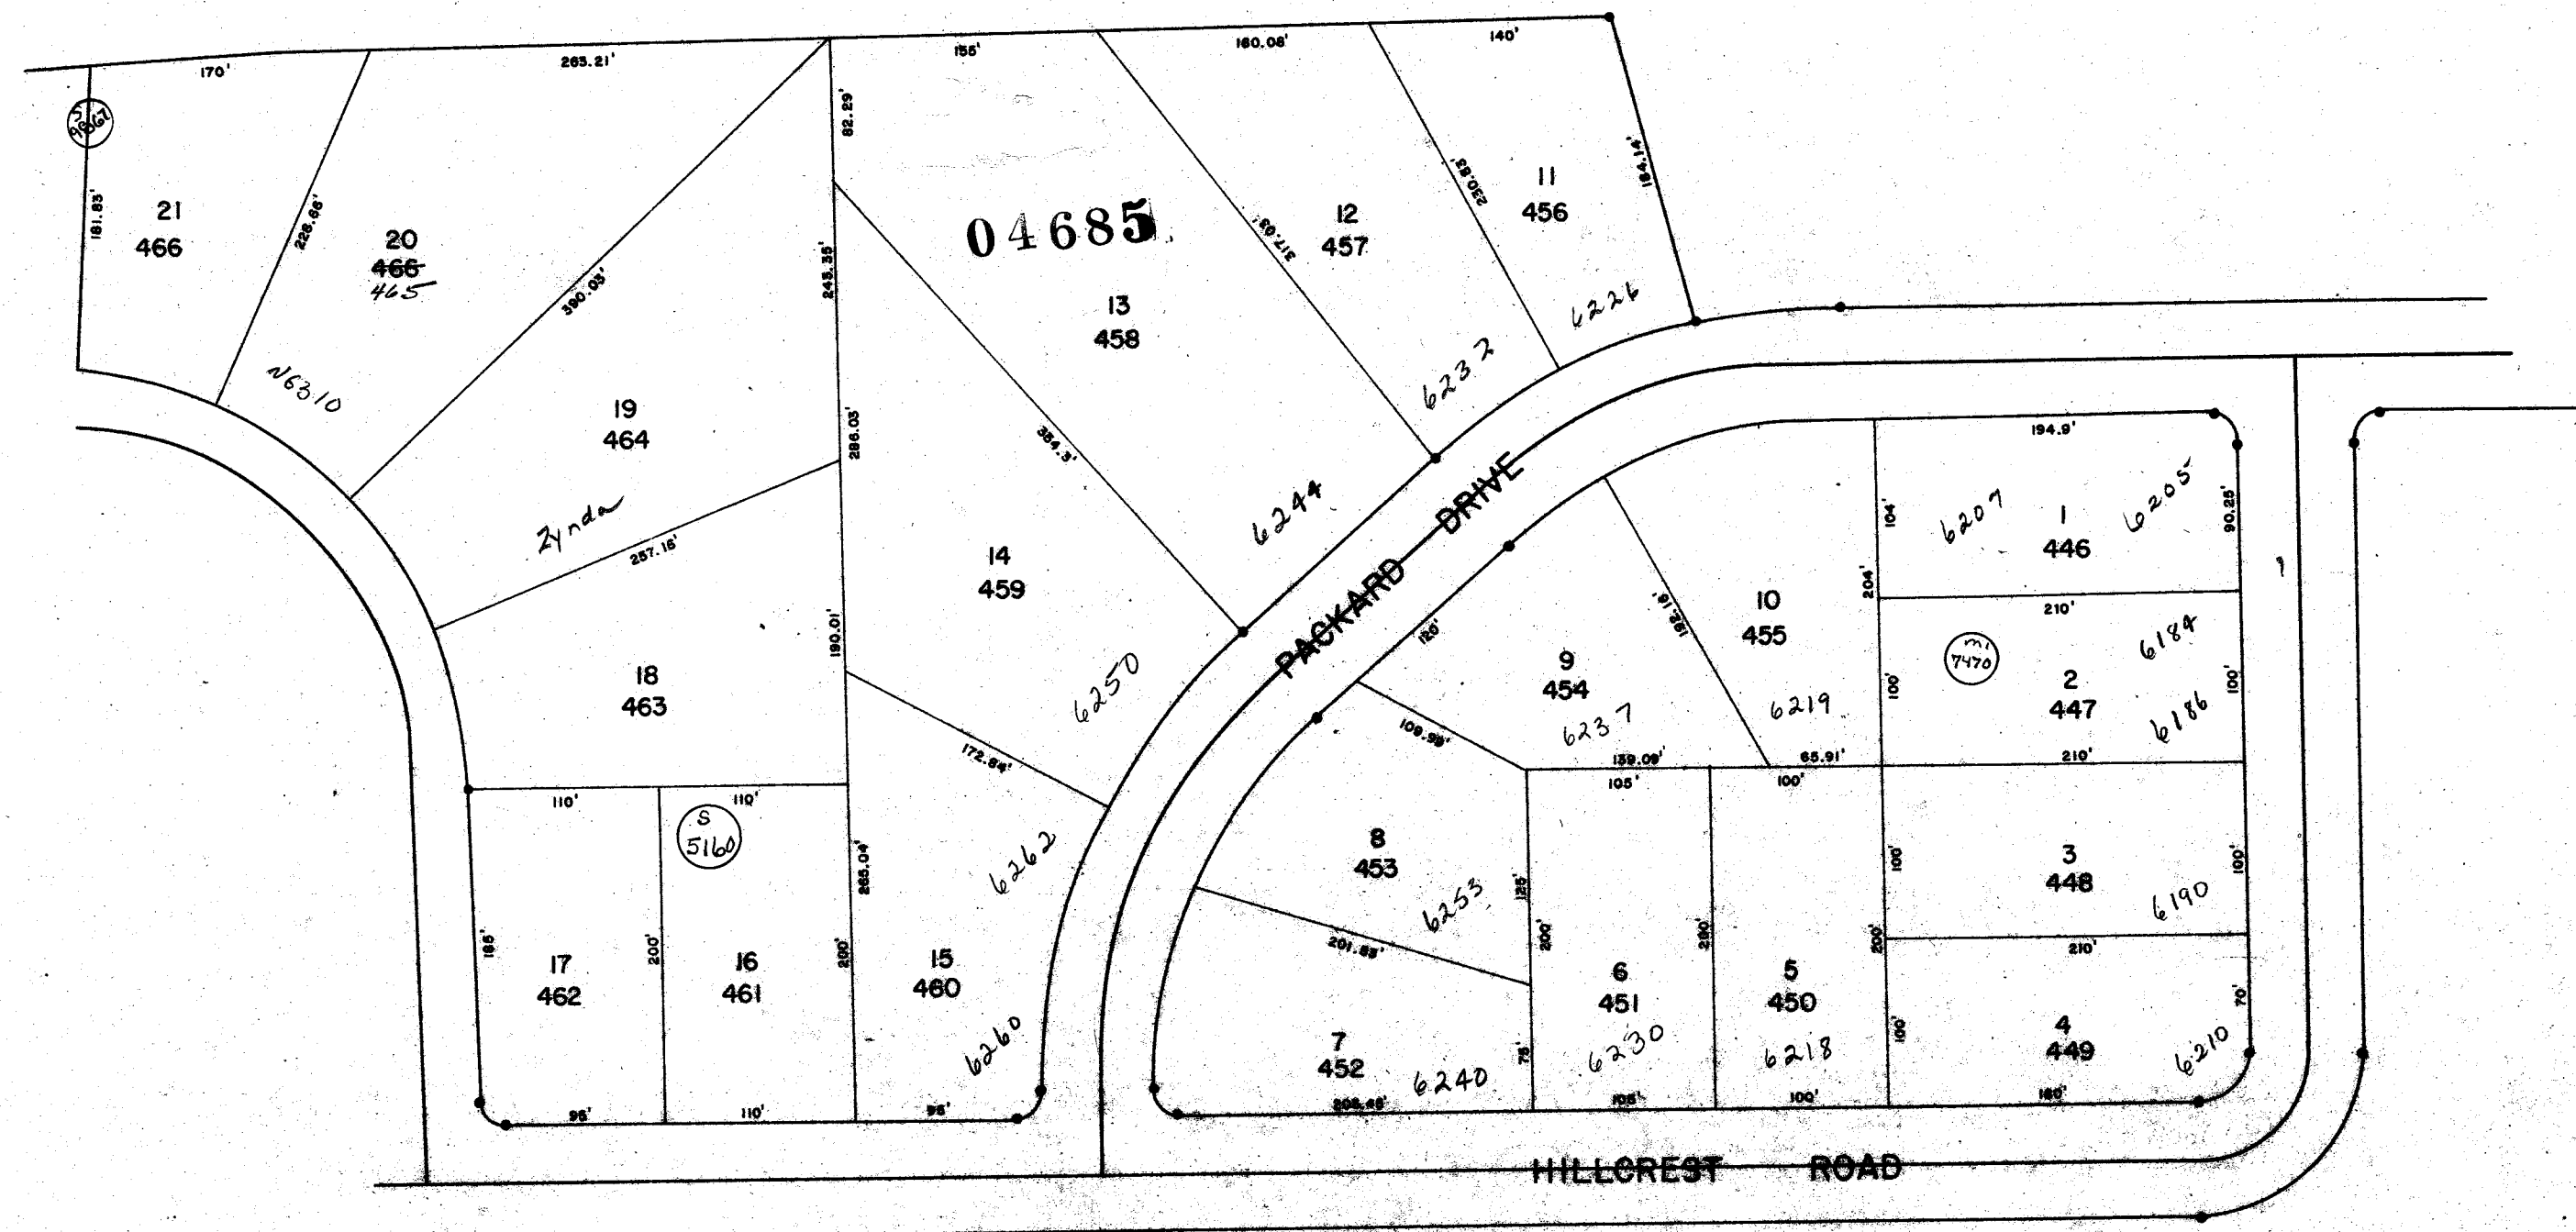


SCALE 1"=100'

PACIFIC

SEC. 22 T. 12N. R. 9E.

Replaced
2004

FIRST ADDITION TO HILLCREST HEIGHTS

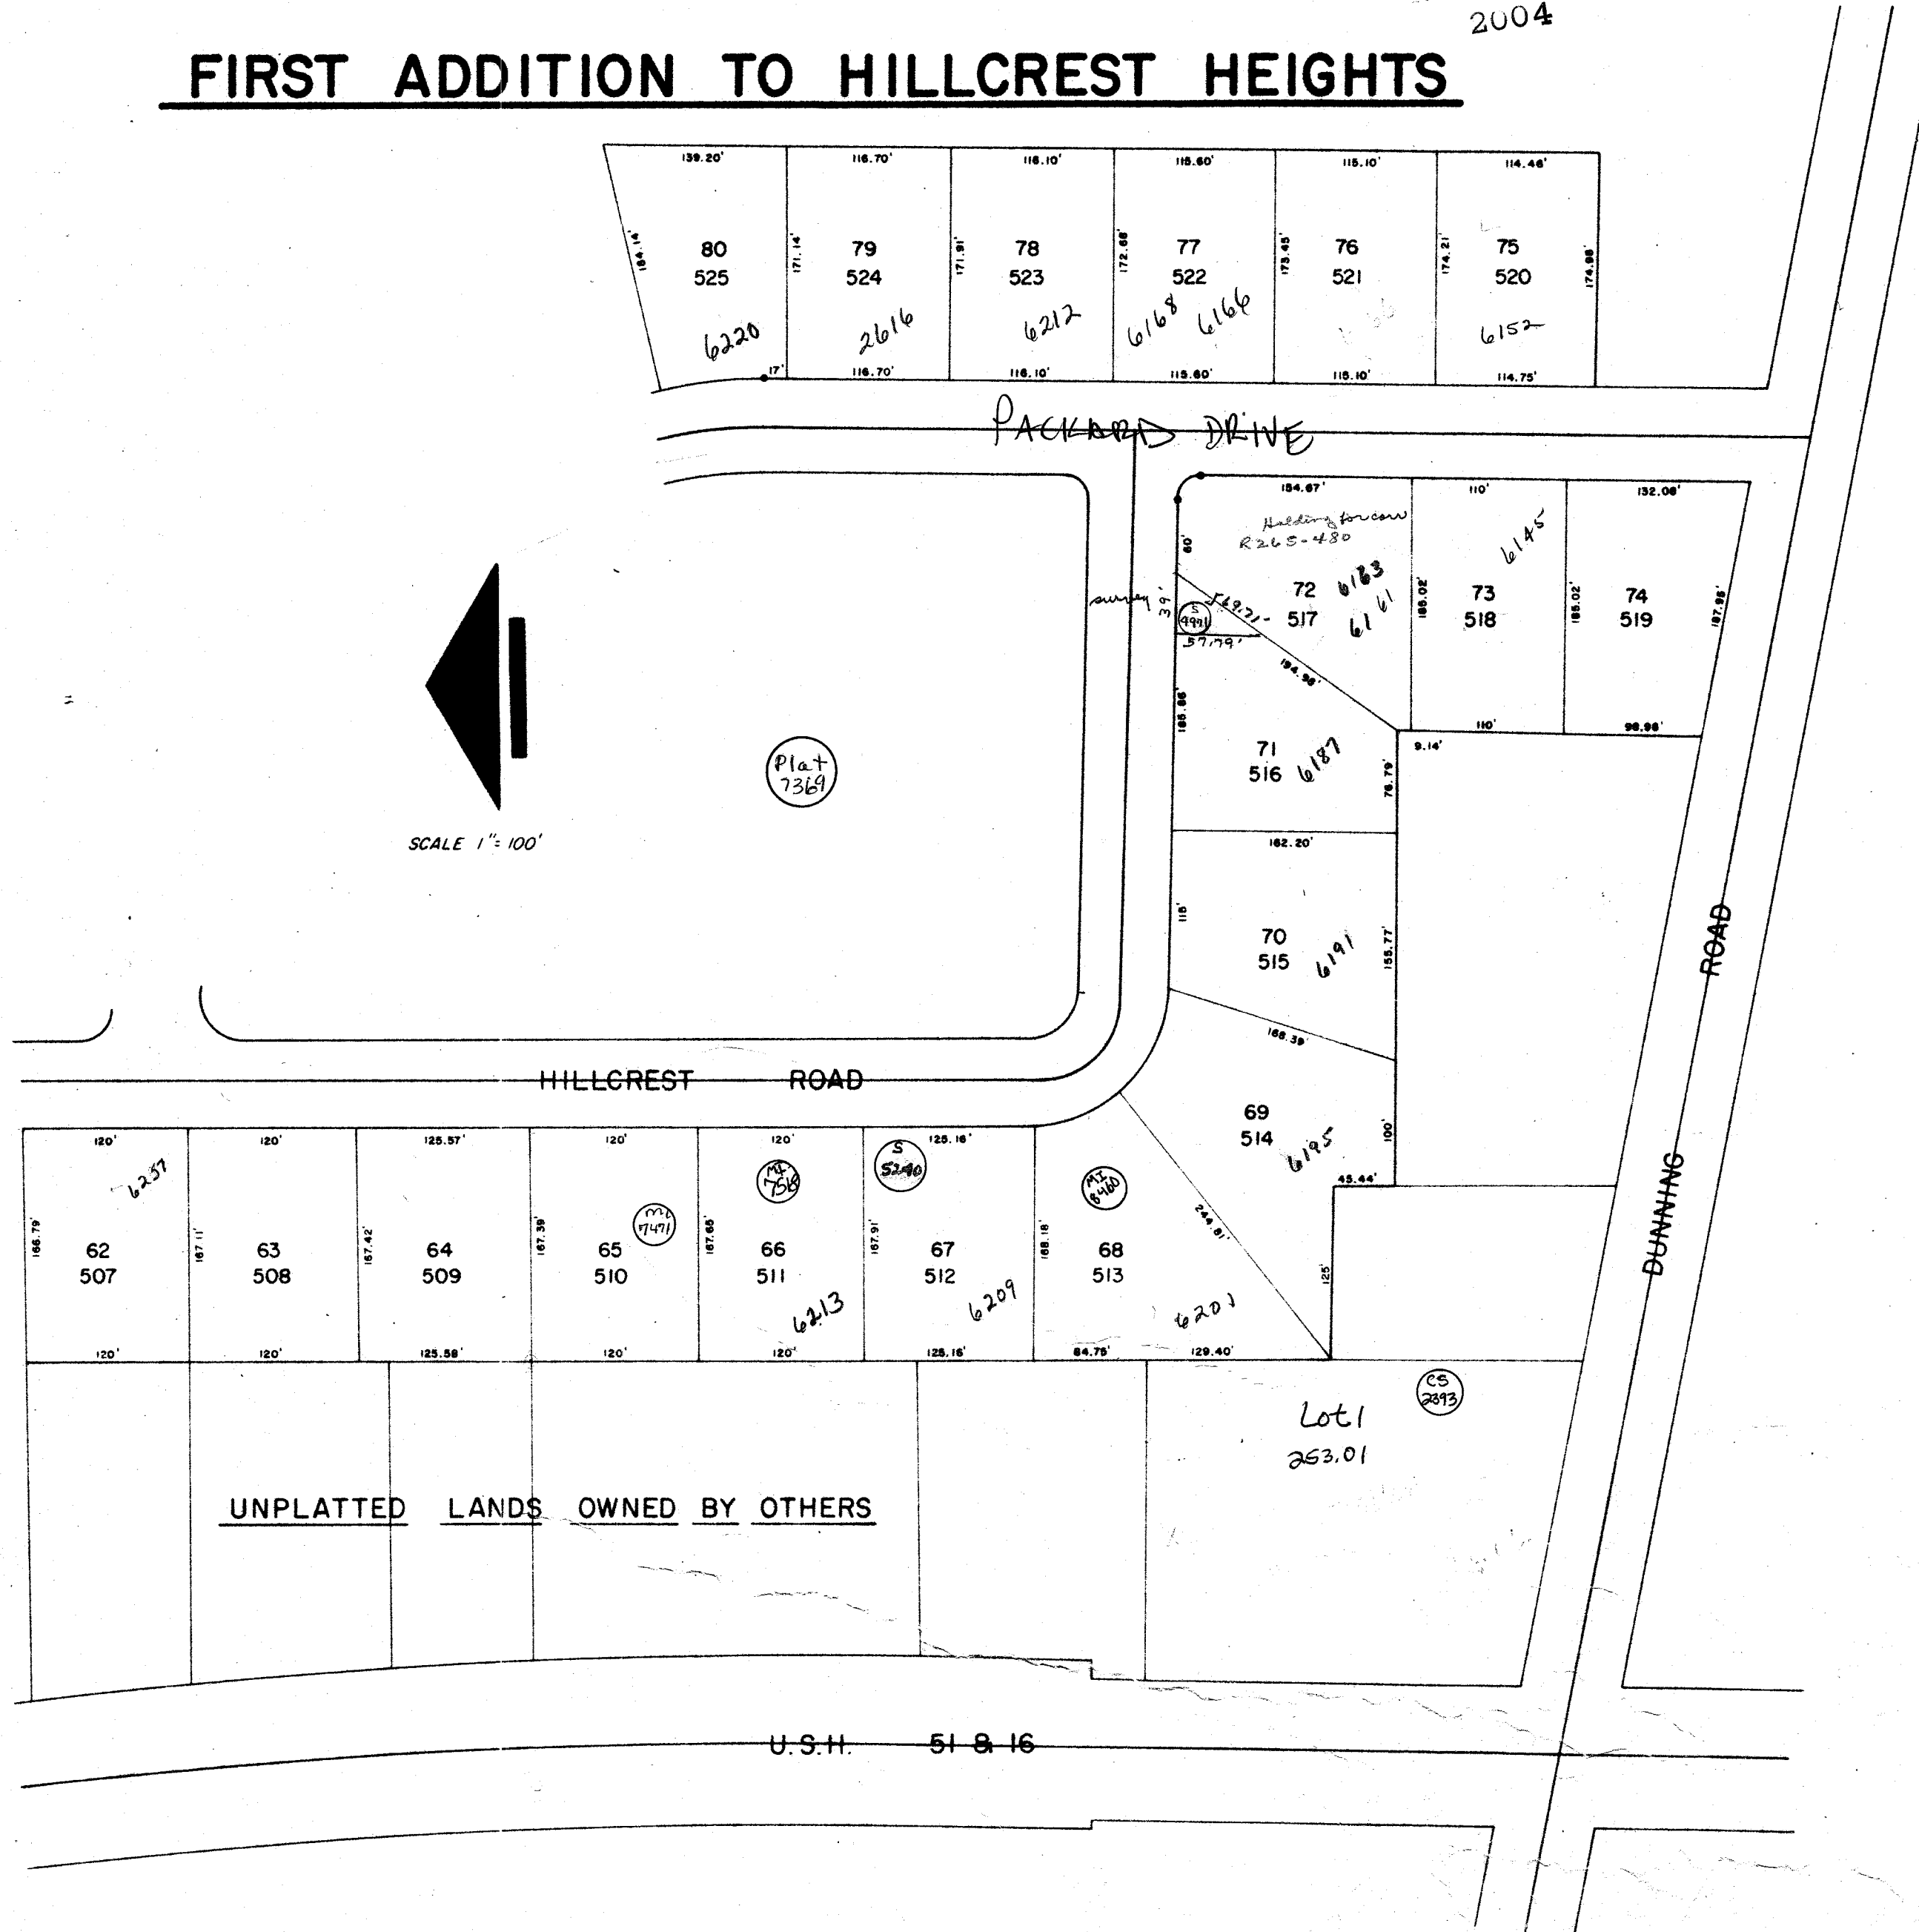

Replaced
2004

HILLCREST HEIGHTS

HILLCREST HT


HILLCREST

LOCATED IN THE NE 1/4 AND THE SE 1/4 OF SEC

UNPLATTED LANDS OWNED BY OTHERS

UNPLATTED LANDS OWNED BY OTHERS


UNPLATTED LANDS OWNED BY

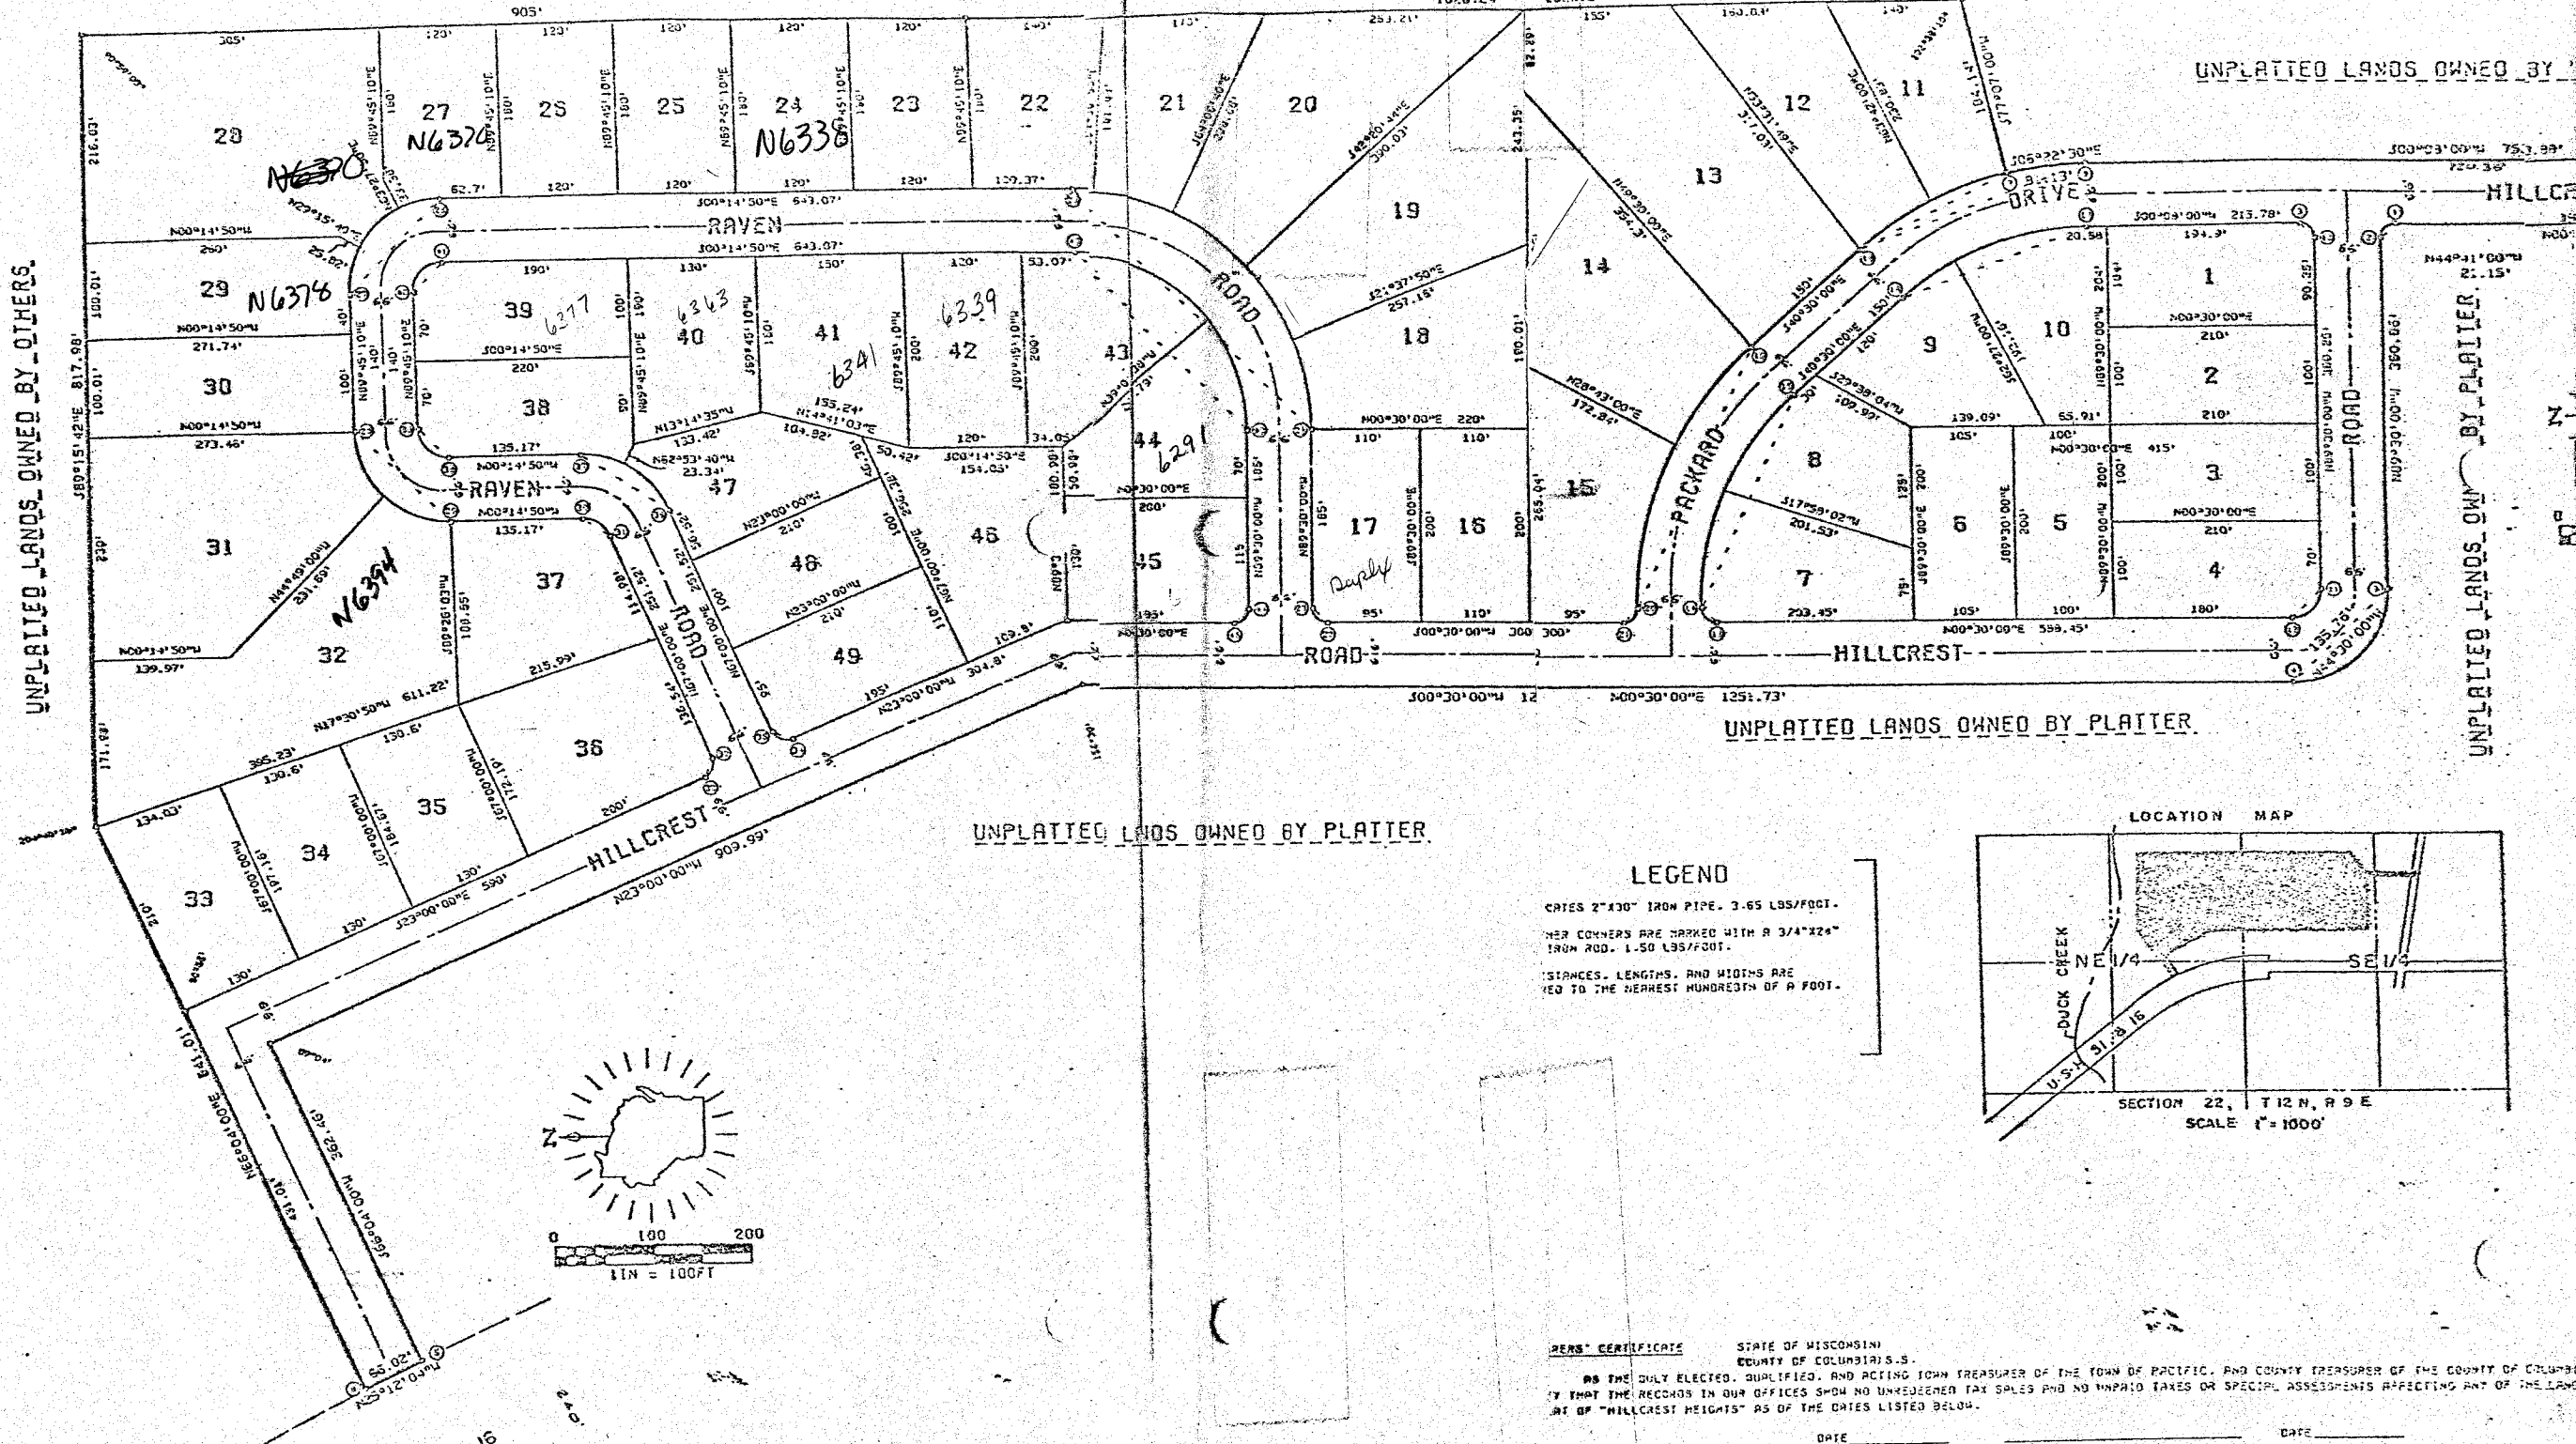


UNPLATTED LANDS OWNED BY PLATTER

LEGEND

CRITER 2"X30" IRON PIPE, 3.65 LBS/FOOT.
NEED CORNERS ARE MARKED WITH A 3/4"X24"
IRON ROD, 1.50 LBS/FOOT.
DISTANCES, LENGTHS, AND WIDTHS ARE
GIVEN TO THE NEAREST HUNDREDTH OF A FOOT.

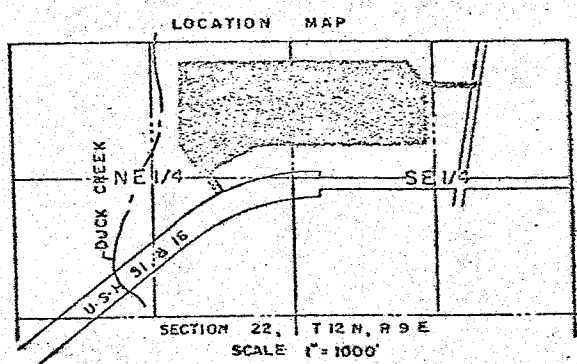

STATE OF WISCONSIN
COUNTY OF COLUMBIA
TOWN OF PACIFIC
I, the undersigned, being the duly elected, qualified, and acting town treasurer of the town of Pacific, and county treasurer of the county of Columbia, do hereby certify that the records in our offices show no unregistered tax sales and no unpaid taxes or special assessments affecting any of the lands hereof.
WITNESSED my hand and the seal of said town and county this 14th day of June, 2004.
TOWN OF PACIFIC
COUNTY OF COLUMBIA

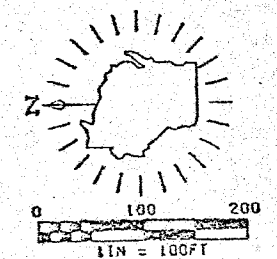

NOTE: PRINTS MADE FROM THIS MYLAR MAY NOT AGREE WITH THE RECORDS

RECORDS
DATE
BY
REMARKS

641
147

147
147

PARCEL NO.	DESCRIPTION	ACERAGE OR LOT NO.	NAME	NAME	NAME


NOTE: PRINTS MADE FROM THIS MYLAR MAY NOT AGREE WITH THE RECORDED DOCUMENT

FILE NO. 24
10 Hwy
4412-21



Replaced
2004 151

FIRST ADDITION
TO
HILLCREST HEIGHTS

LOCATED IN THE NE1/4-SE1/4, SE1/4-SE1/4,
SW1/4-NE1/4, SE1/4-NE1/4,
SECTION 22, T12N, R9E, TOWN OF PACIFIC,
COLUMBIA COUNTY, WISCONSIN.

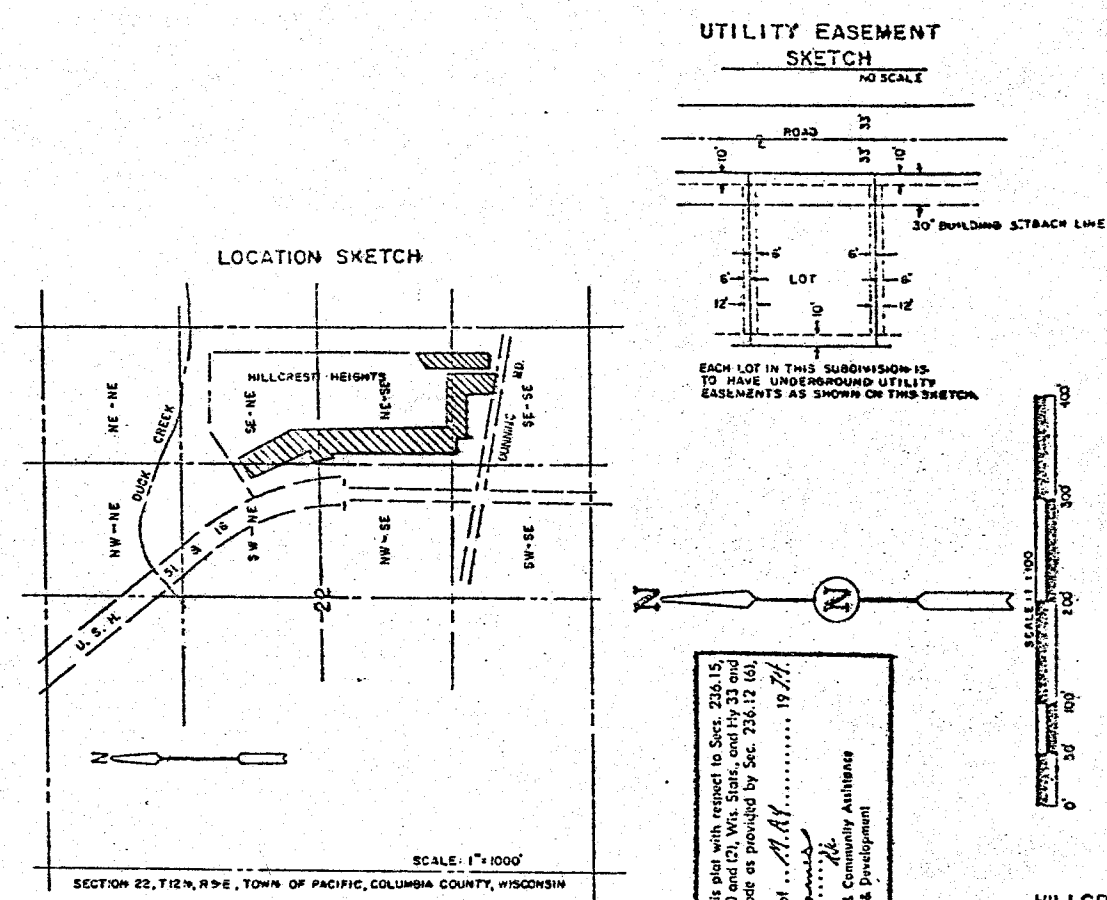


-LEGEND-
• EXISTING 1" IRON PIPE SURVEY MONUMENTS
• INDICATES 2" X 30" IRON PIPE WEIGHING 3.65 LBS. PER LINEAL FOOT.
ALL OTHER LOT CORNERS ARE MONUMENTED WITH 3/4" X 24" ROUND IRON RODS WEIGHING 1.50 LBS. PER LINEAL FOOT.
ALL LINEAR MEASUREMENTS HAVE BEEN MADE TO THE NEAREST ONE HUNDREDTH OF A FOOT. ALL ANGLES HAVE BEEN TURNED TO THE NEAREST MINUTE AND COMPUTED TO THE NEAREST SECOND.
ALL BEARINGS ARE REFERENCED TO THE EAST LINE OF SECTION 22, T12N, R9E, ASSUMED BEARING OF THE REFERENCE MERIDIAN IS N 89° 14' 50" W.

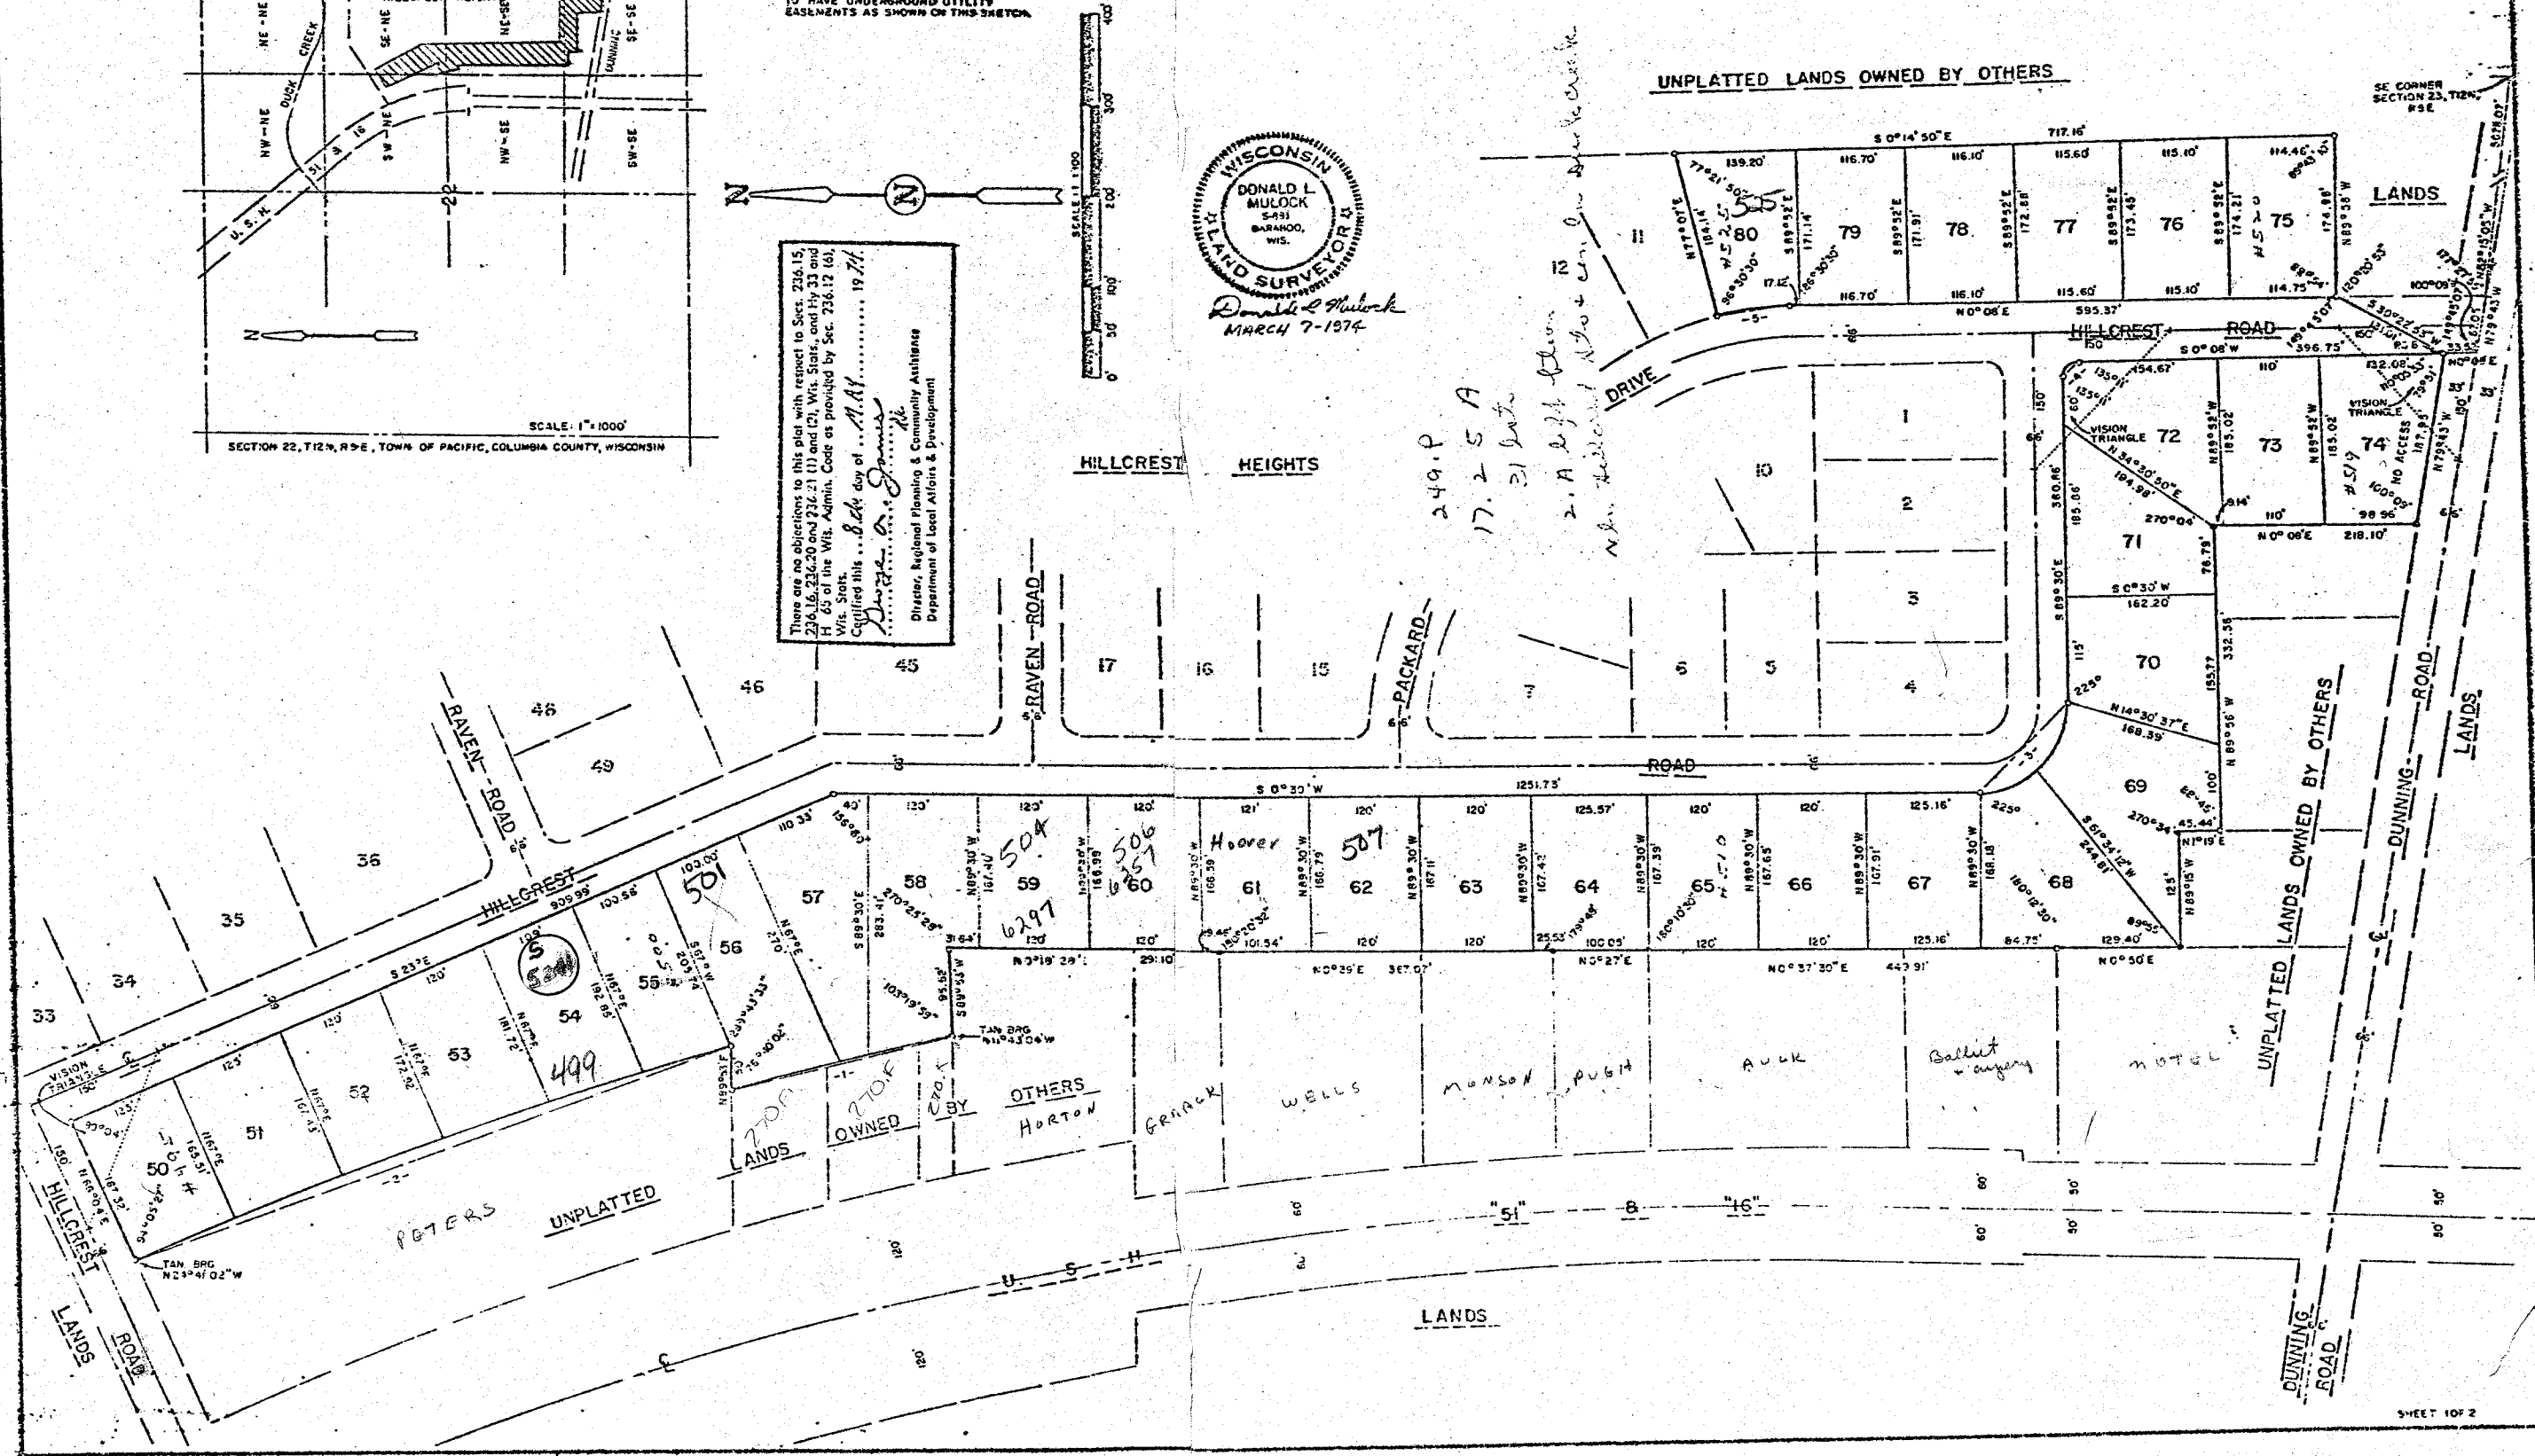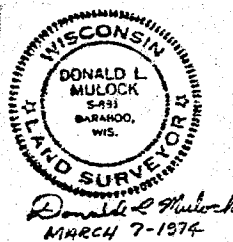

PACIFIC

SEC. 23 T.12N. R.9E

Replaced
2004

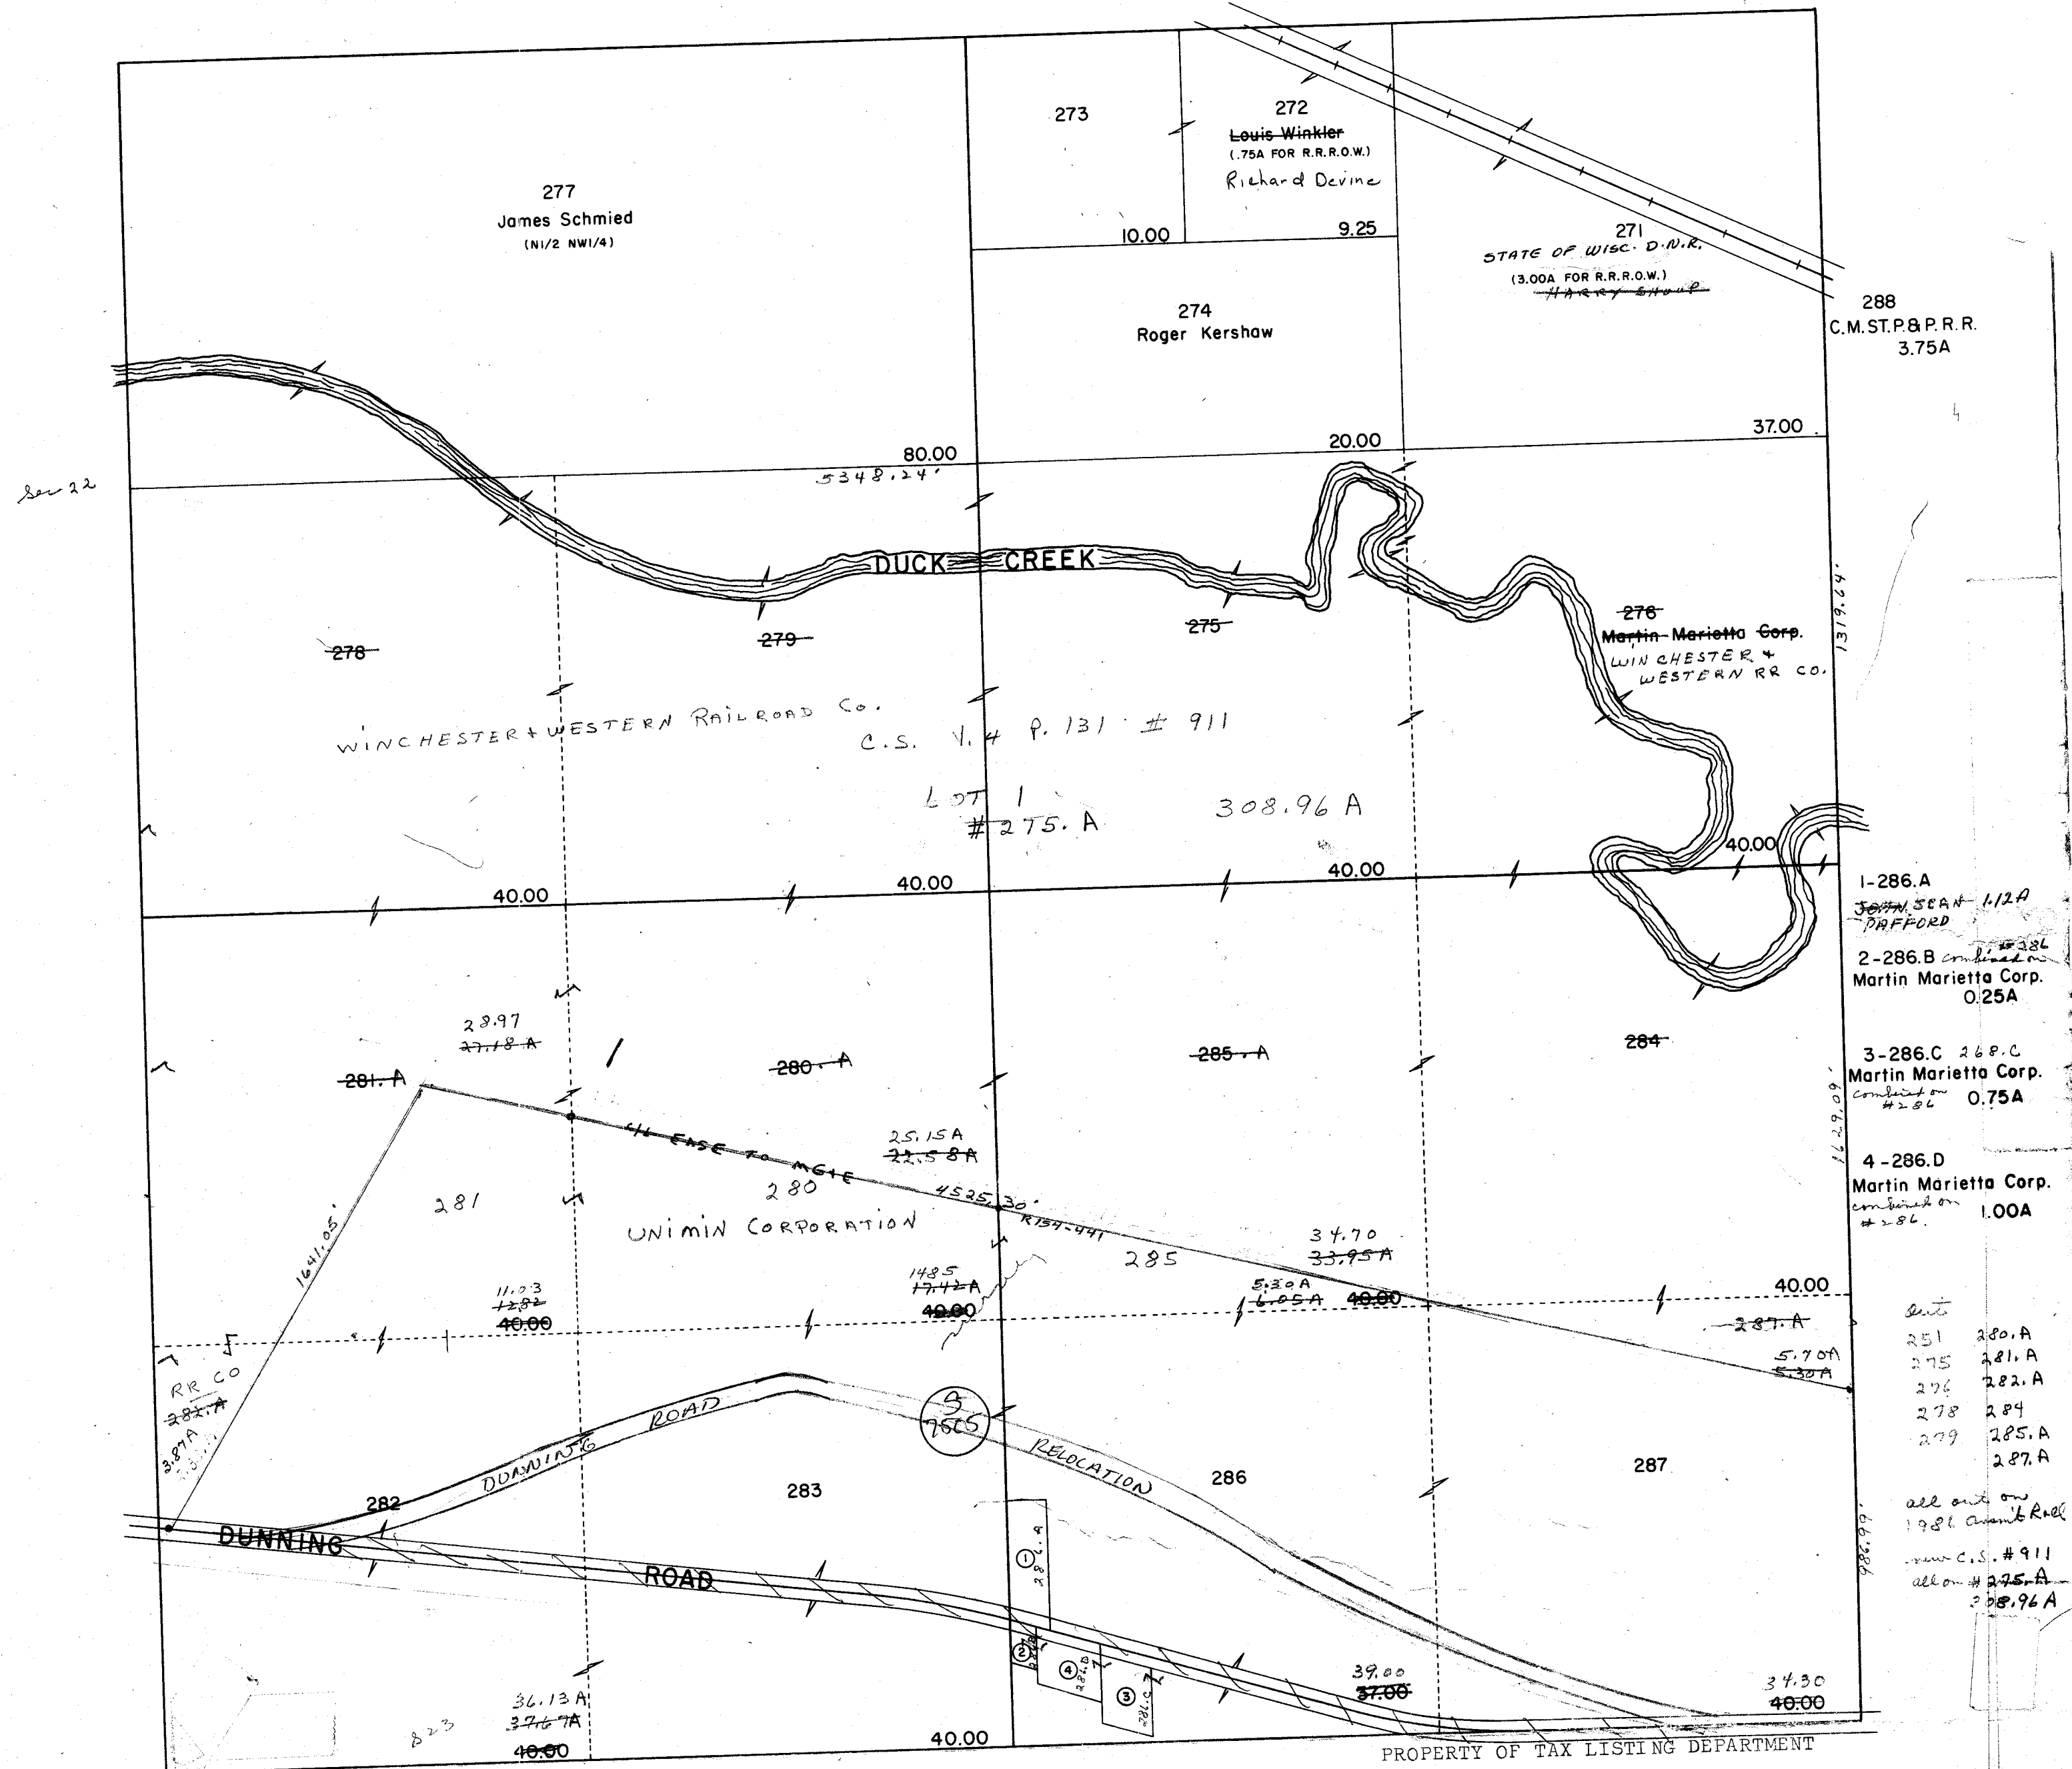

- 1-286.A JOHN SEAN - 1.12A PRAFFORD
- 2-286.B combined on Martin Marietta Corp. 0.25A
- 3-286.C 268.C Martin Marietta Corp. combined on #286 0.75A
- 4-286.D Martin Marietta Corp. combined on #286 1.00A

Acres

251	280.A
275	281.A
276	282.A
278	284
279	285.A
	287.A

all out on 1986 Census Roll

new C.S. # 911


all on # 275.A 308.96 A

(5) Relocation Dunning Rd

PACIFIC


SEC. 24 T. 12N. R. 9E

Replaced
2004

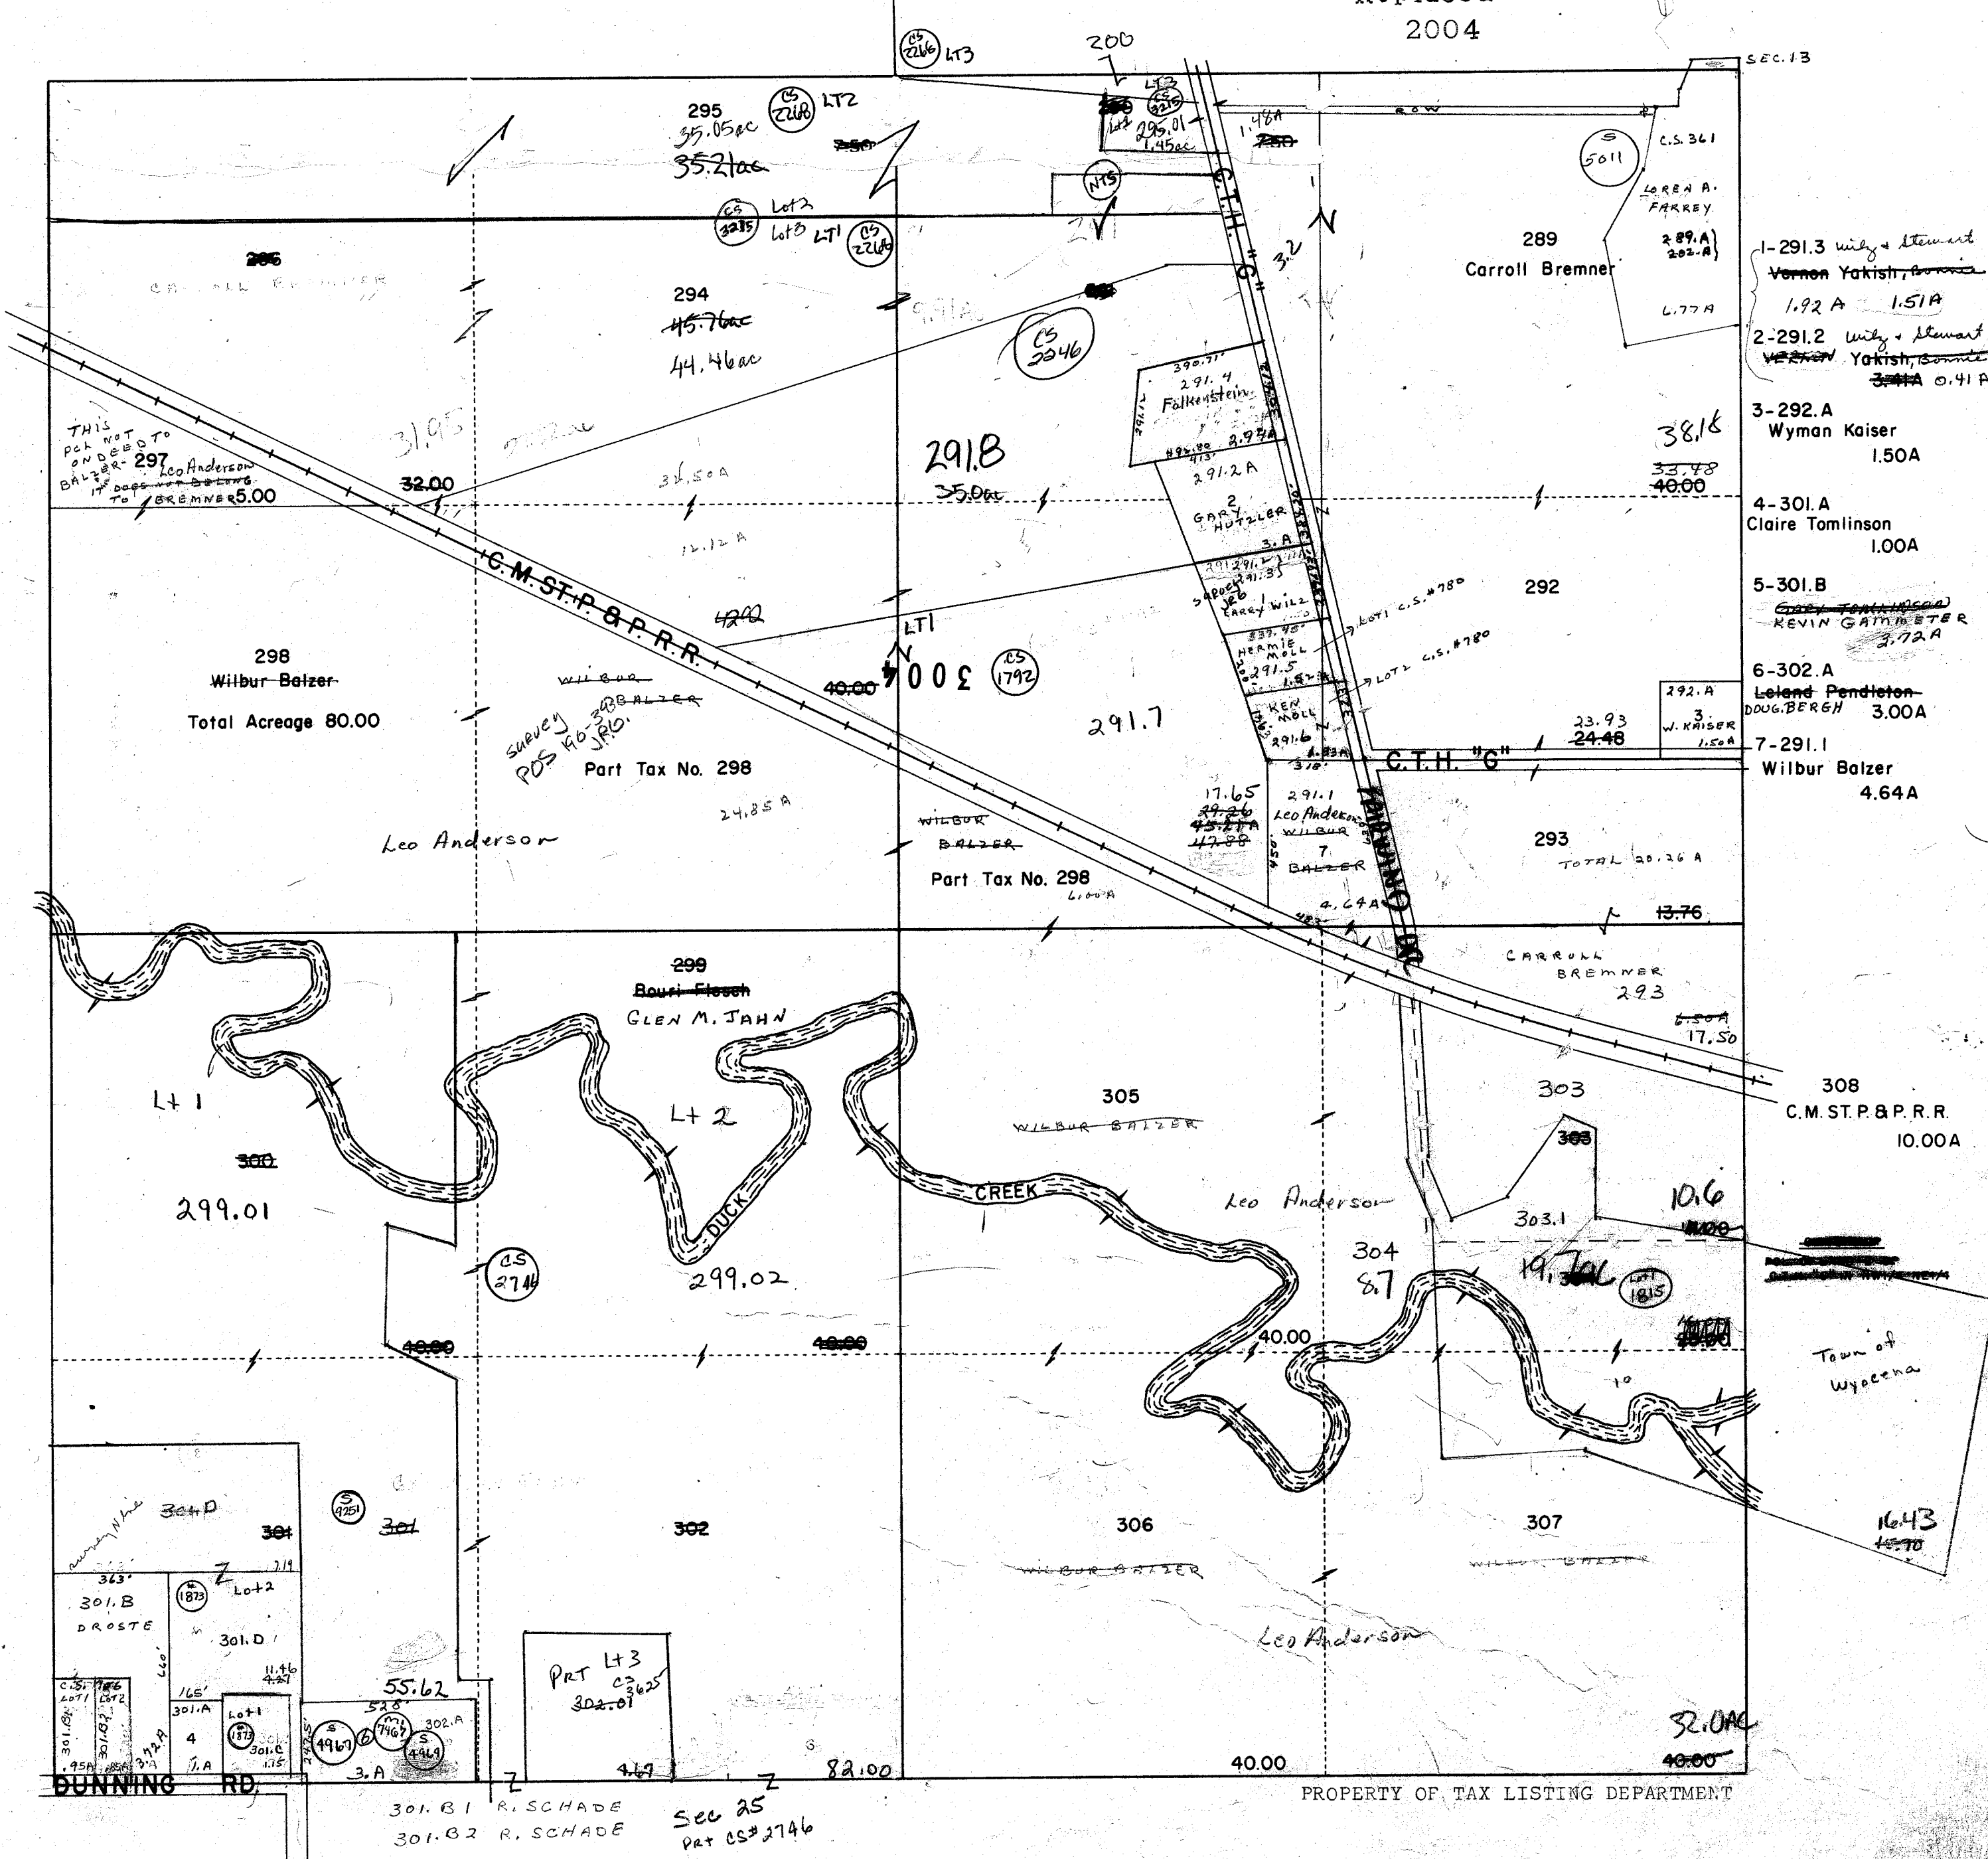



PROPERTY OF TAX LISTING DEPARTMENT

Replaced
2004

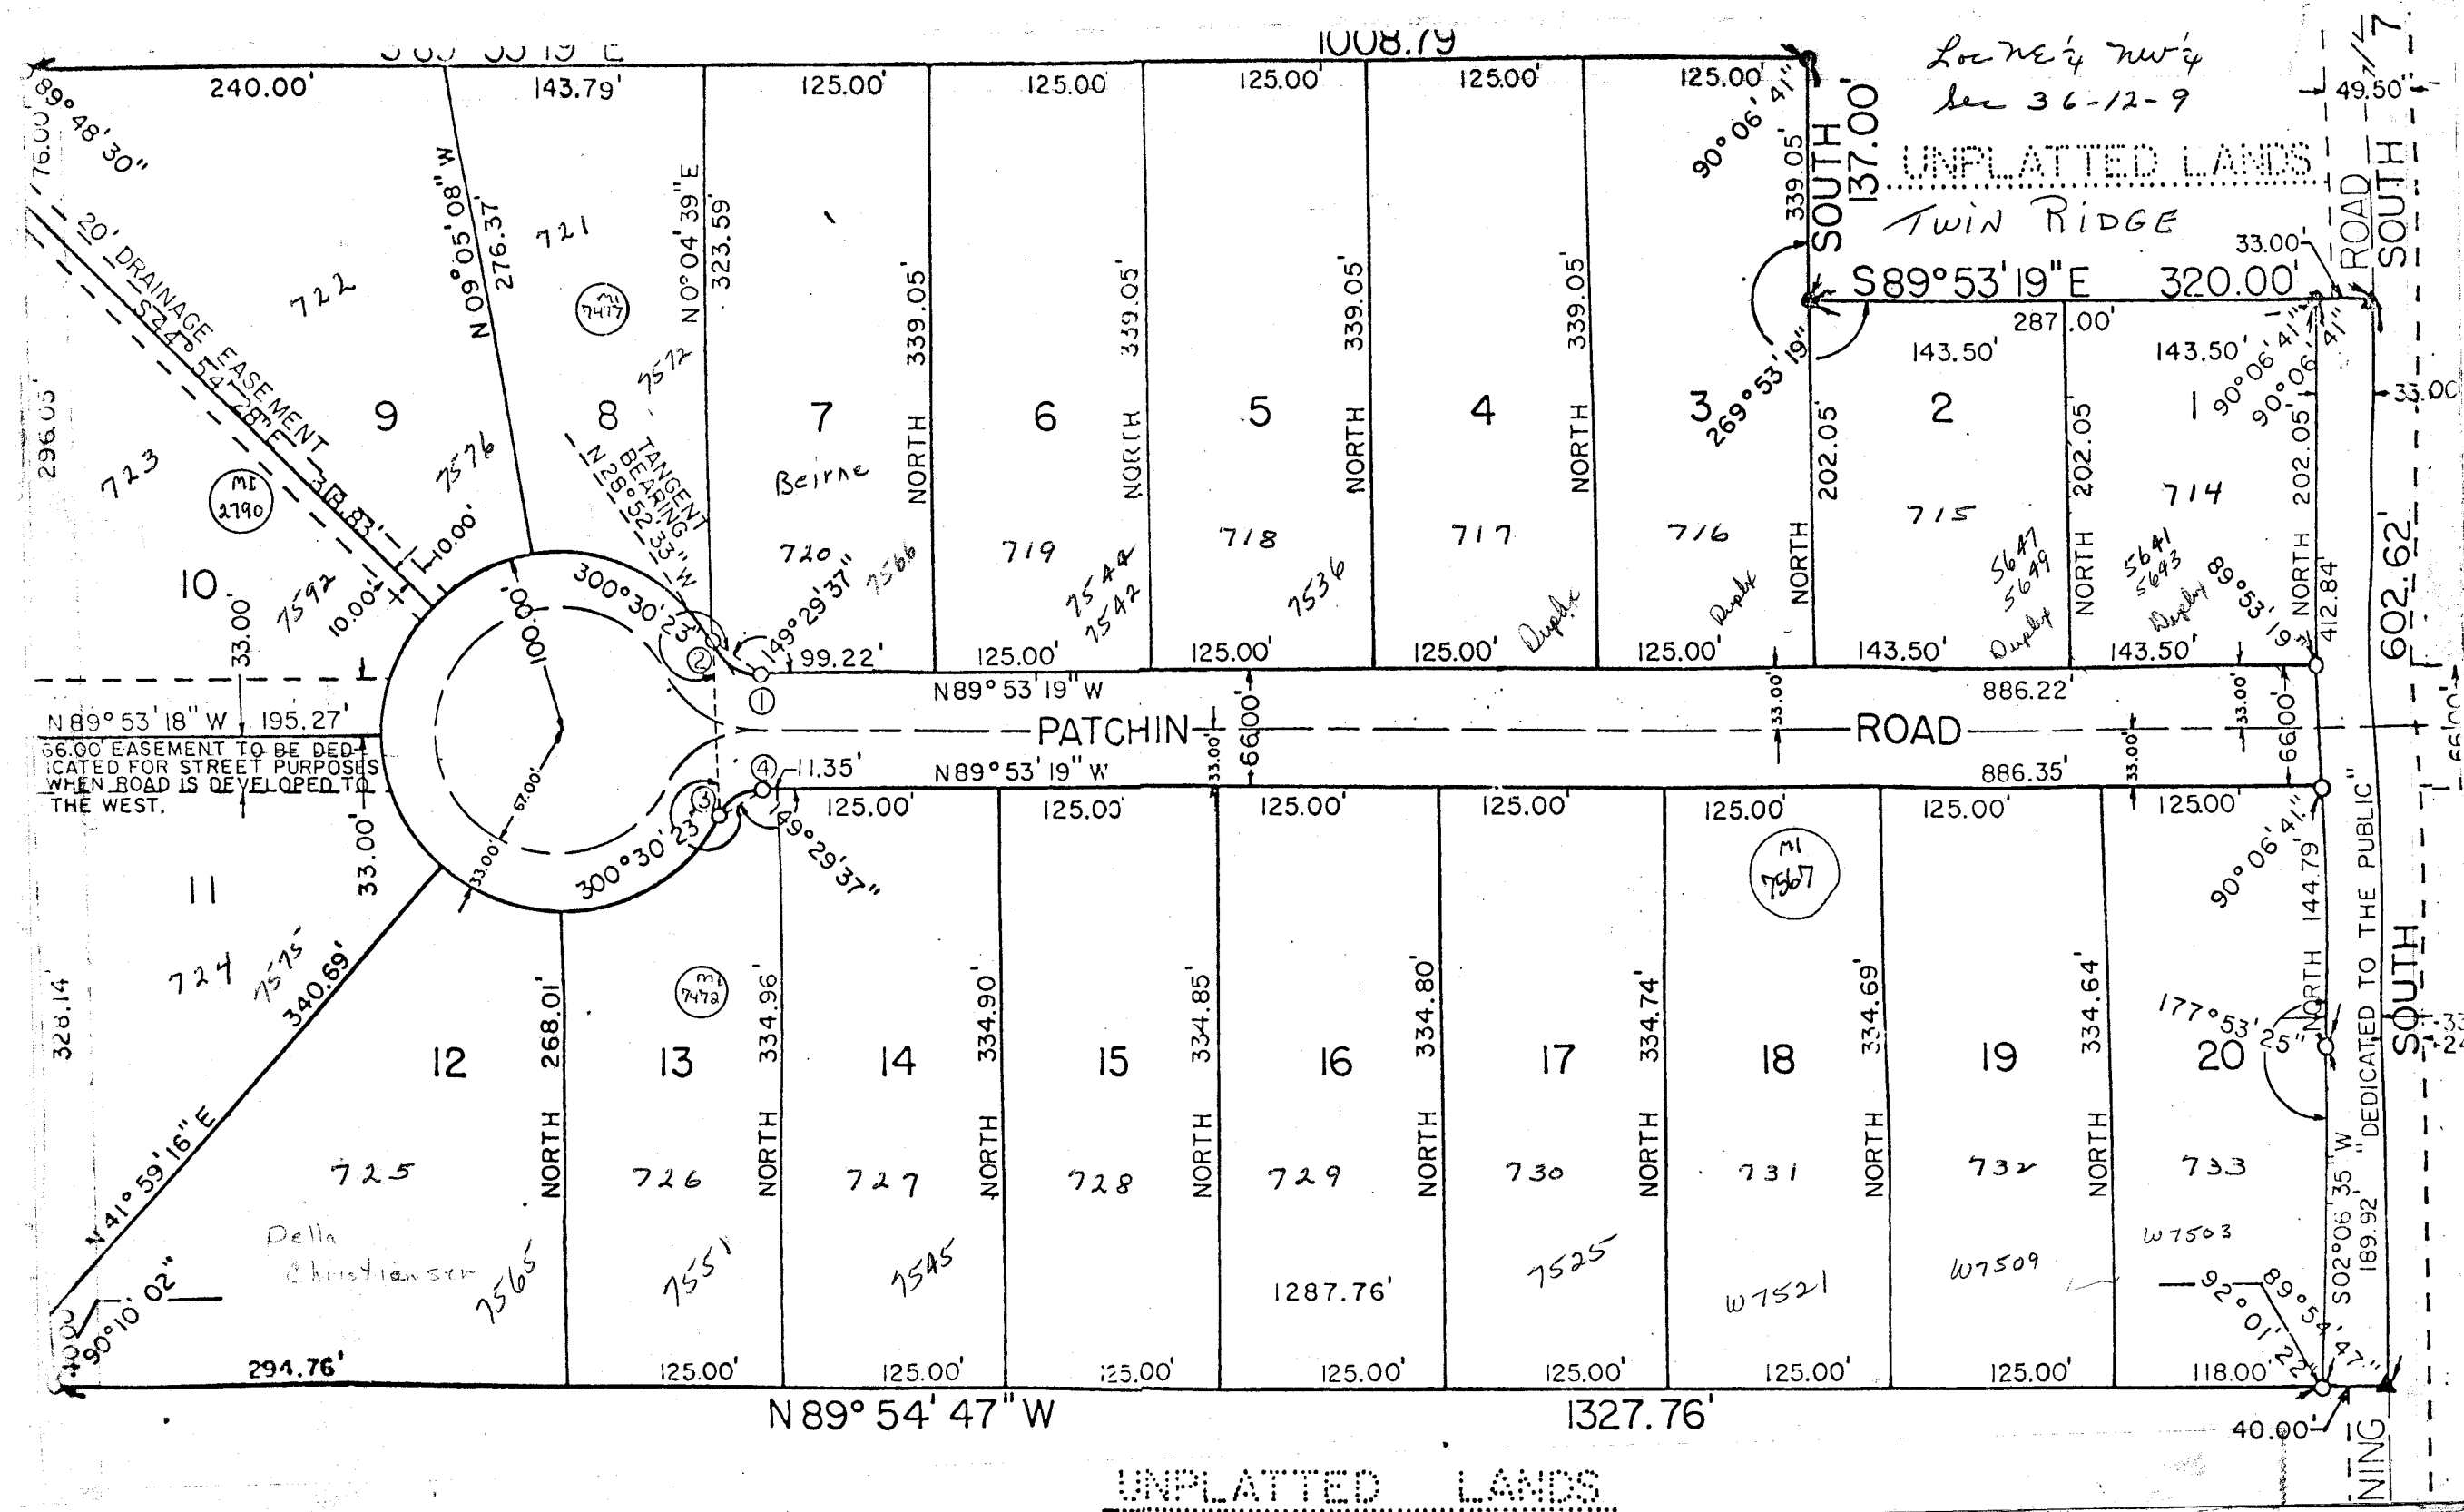


Replaced
2804

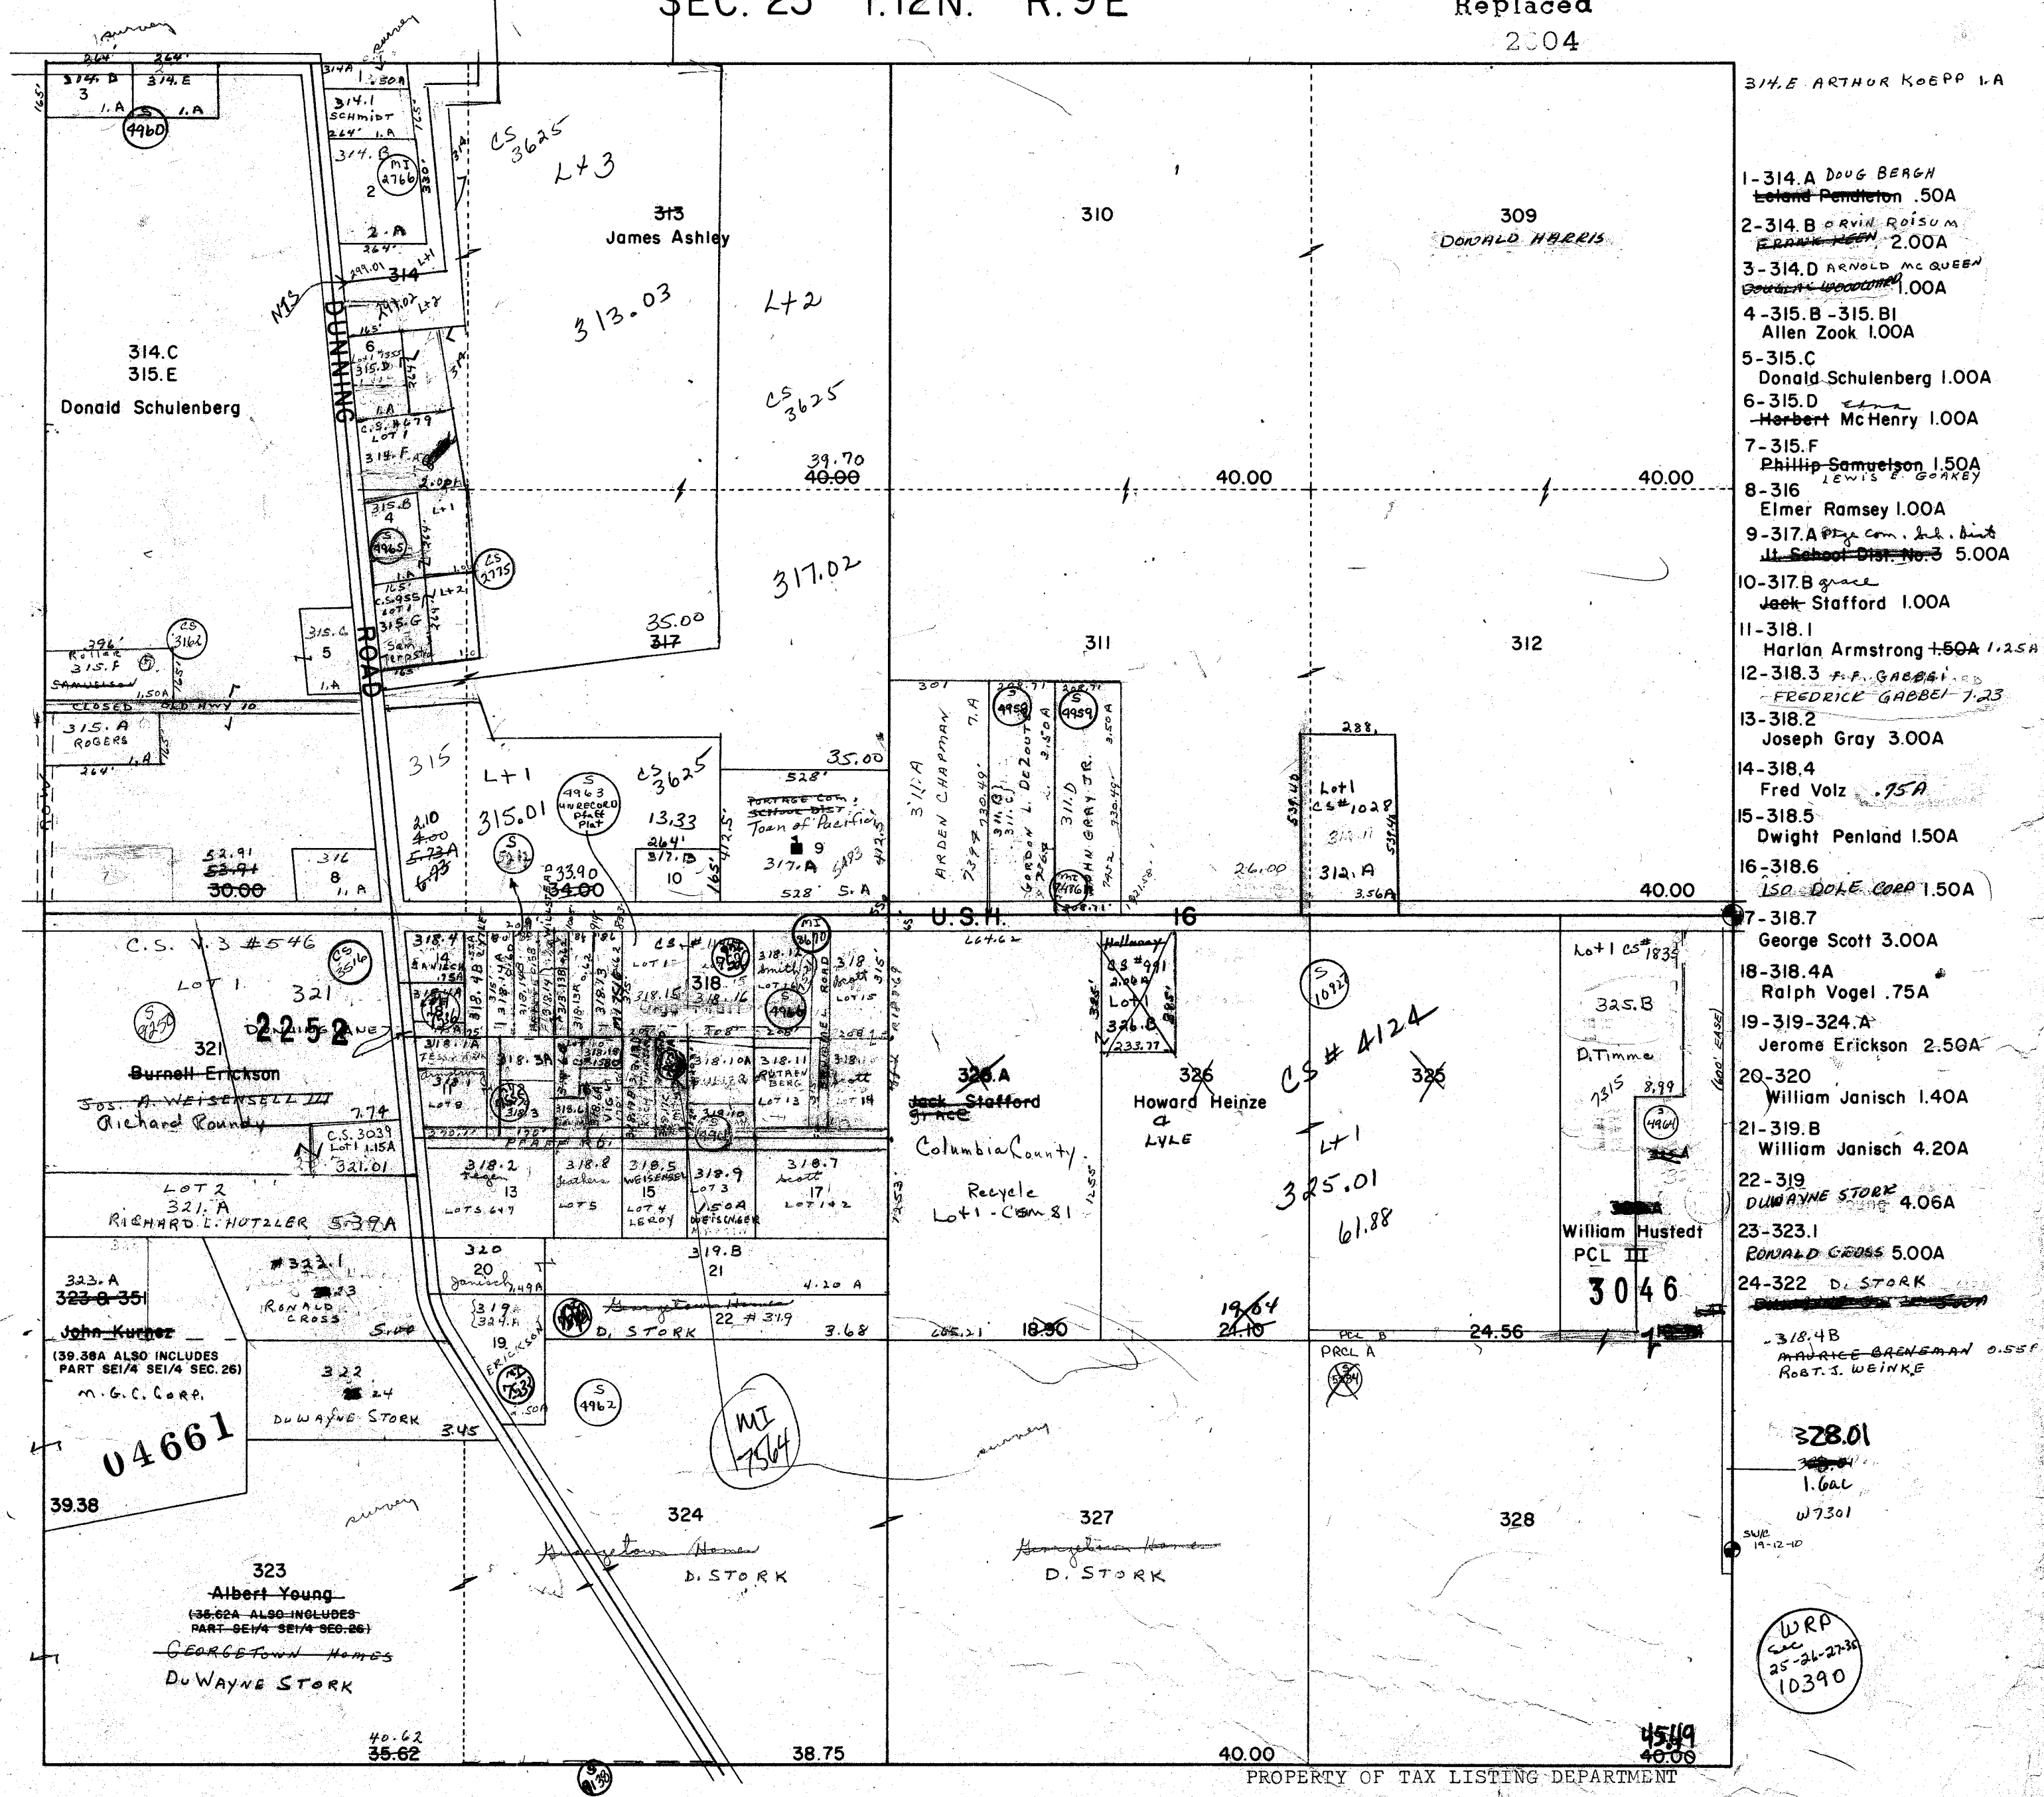

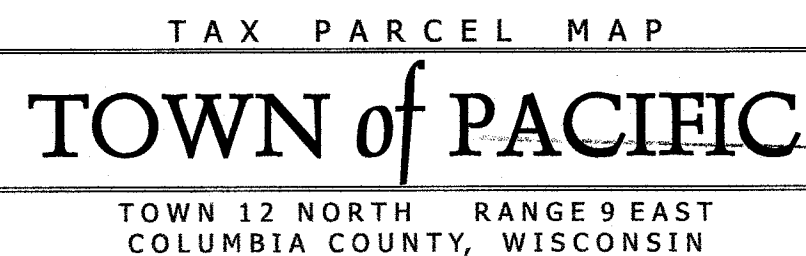

2006

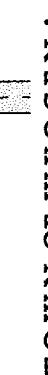

FOR DETAILED MAP OF SUBDIVISION AND SMALL PARCELS, SEE NEXT PAGE.


UNRECORDED PFAFF PLAT - S4963

- SECTION 25 -

Revised
2000

SEC. 26 T.12N. R.9E

1-333.1
Town of Pacific
.77A

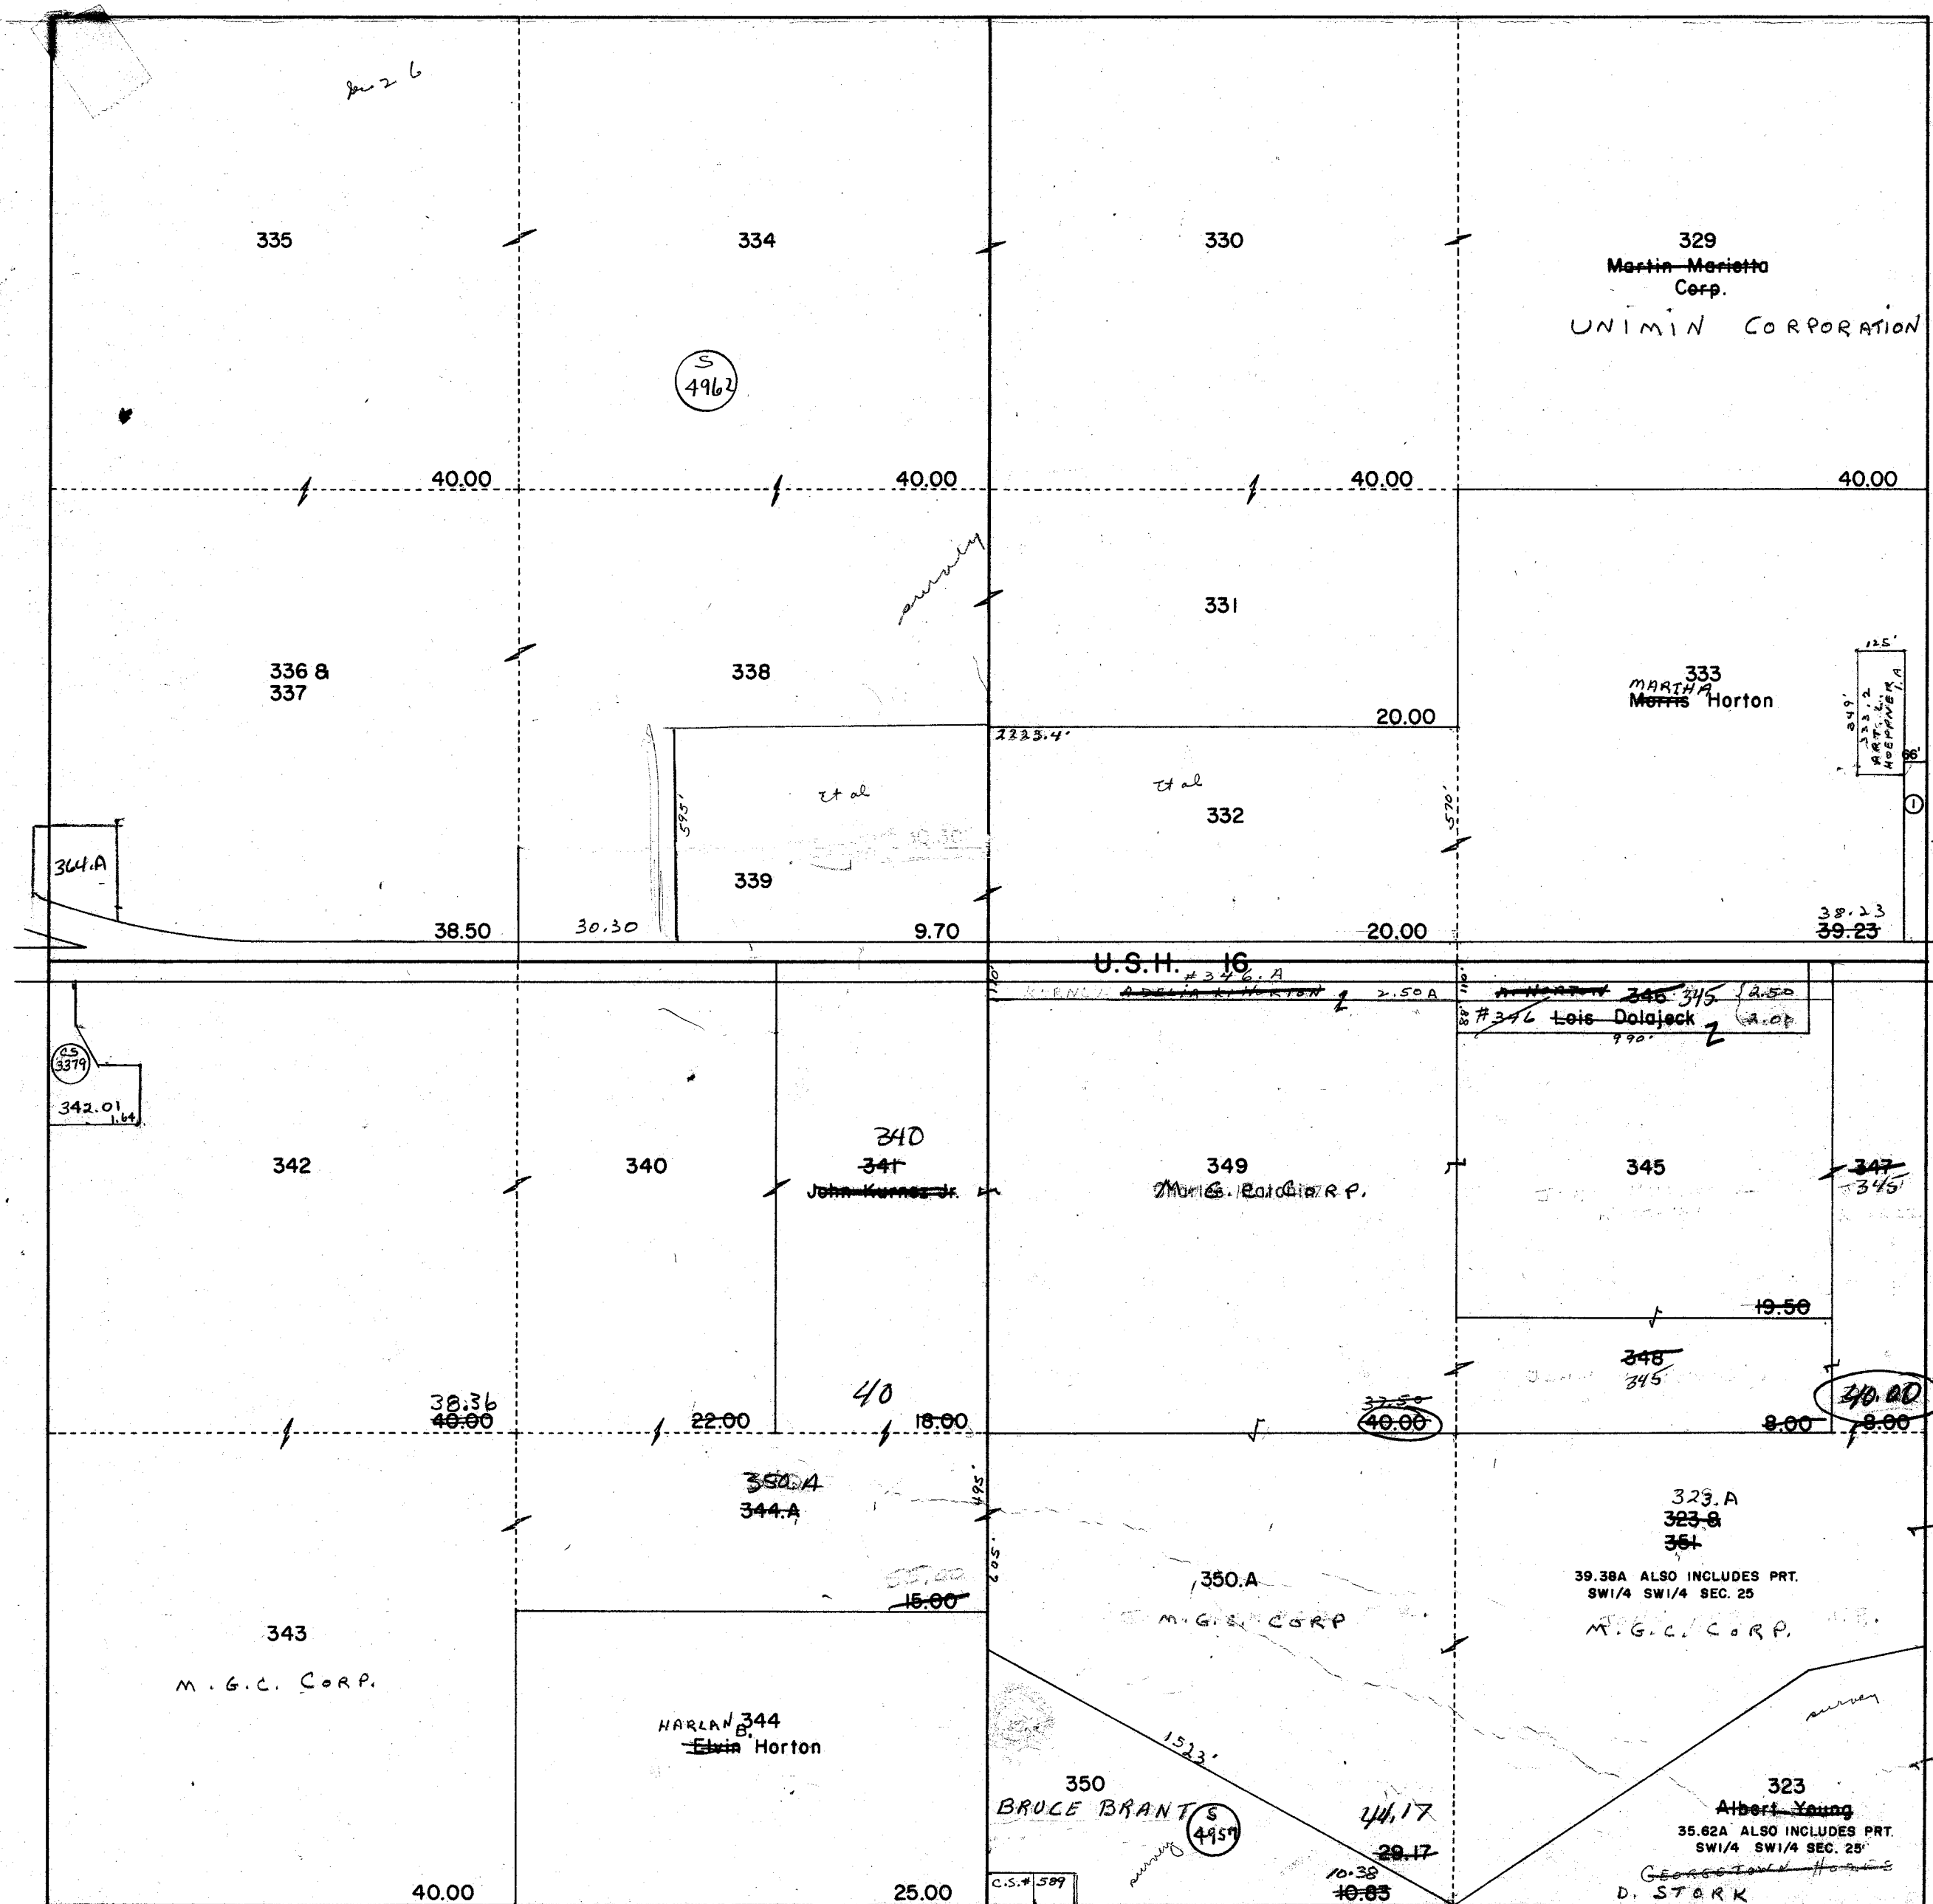


PROPERTY OF TAX LISTING DEPARTMENT

PACIFIC

SEC. 27 T.12N. R.9E

Replaced
2004


SEE NEXT SH.

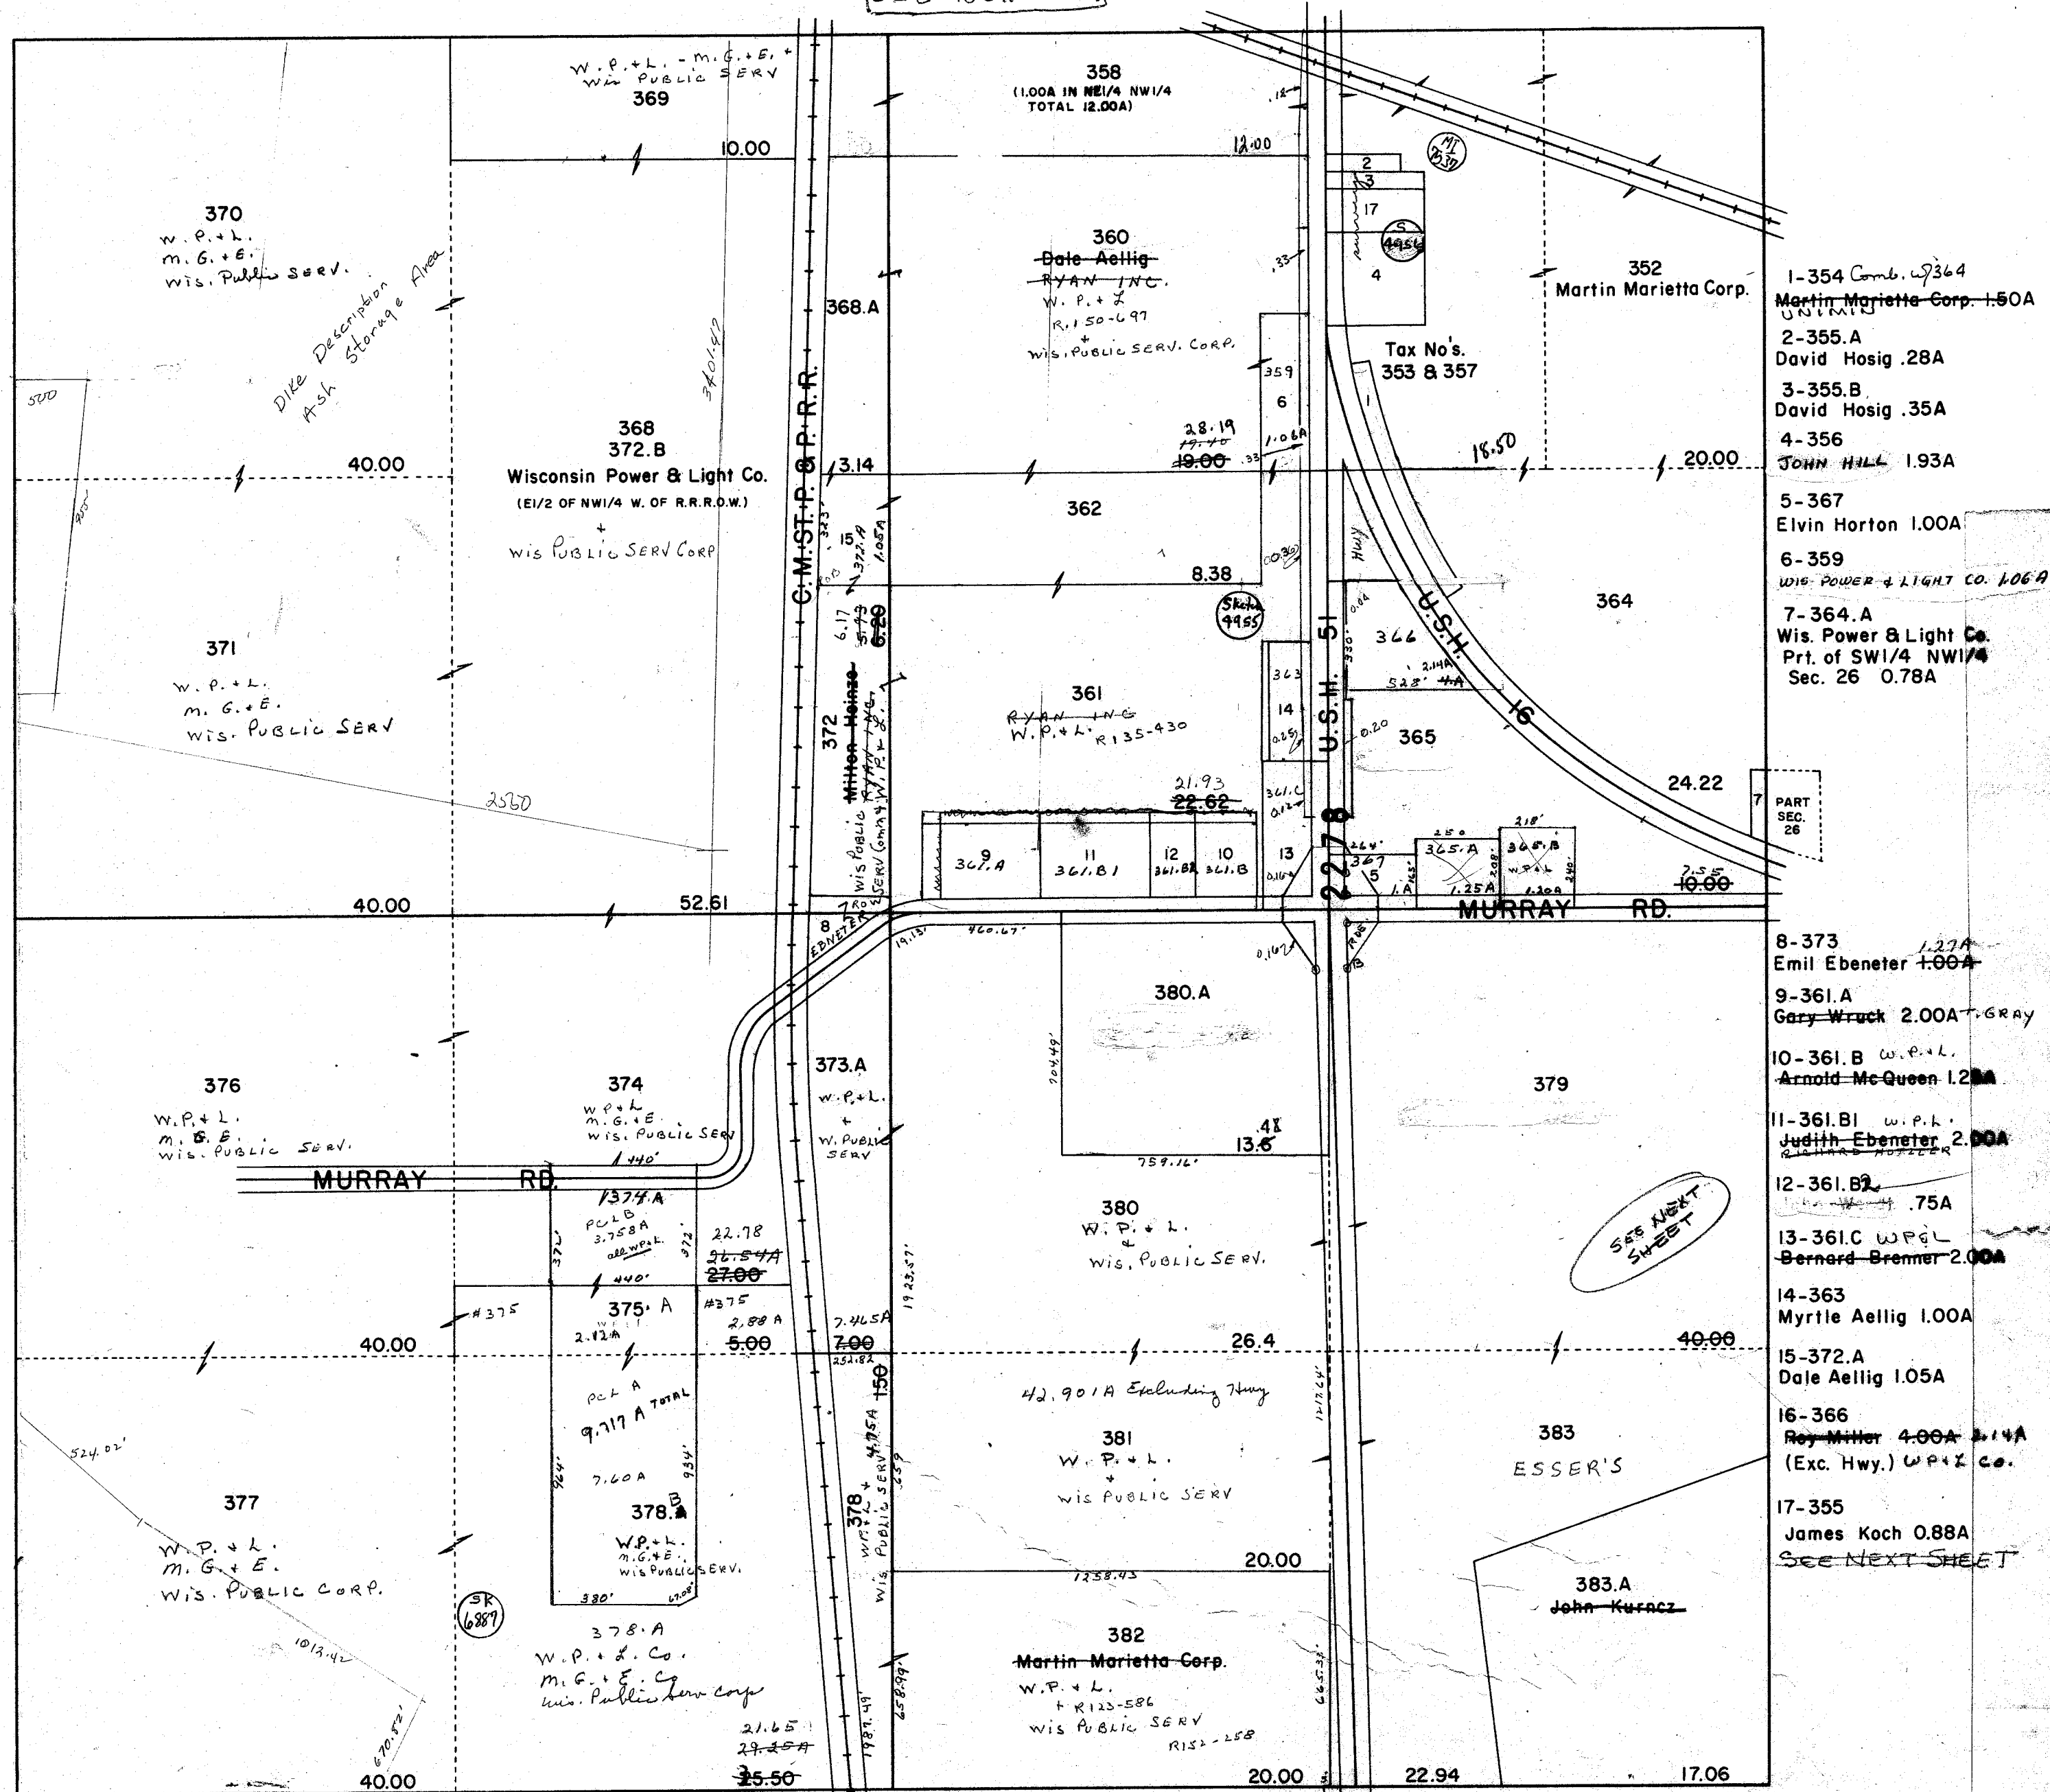

PCL A - 9.717 A (The 345 KV Columbia Plant Substation)
57.3% Indian Res. + Elec
18.3% wis. Public SERV.
24.4% W.P.L. Co.

PROPERTY OF TAX LISTING DEPARTMENT

Replaced
2004

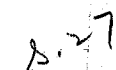

PACIFIC


SEC. 28 T. 12N. R. 9E.

Replaced
2004

G.L. 1 - 59.22 A
G.L. 2 - 48.90 A
G.L. 3 - 67.40 A
G.L. 4 - 59.00 A
234.52
+ 120.00
Total 354.52 A

385
358
Wisconsin Power & Light Co.
M.G. & E. Co.
W. in Public Use Corp.


1-9-74 Sec. 21-22-28
COVENANTS RUNNING WITH
CERTAIN LANDS OWNED BY WPL
BY DEPT. NAT. RESOURCES
R131-221

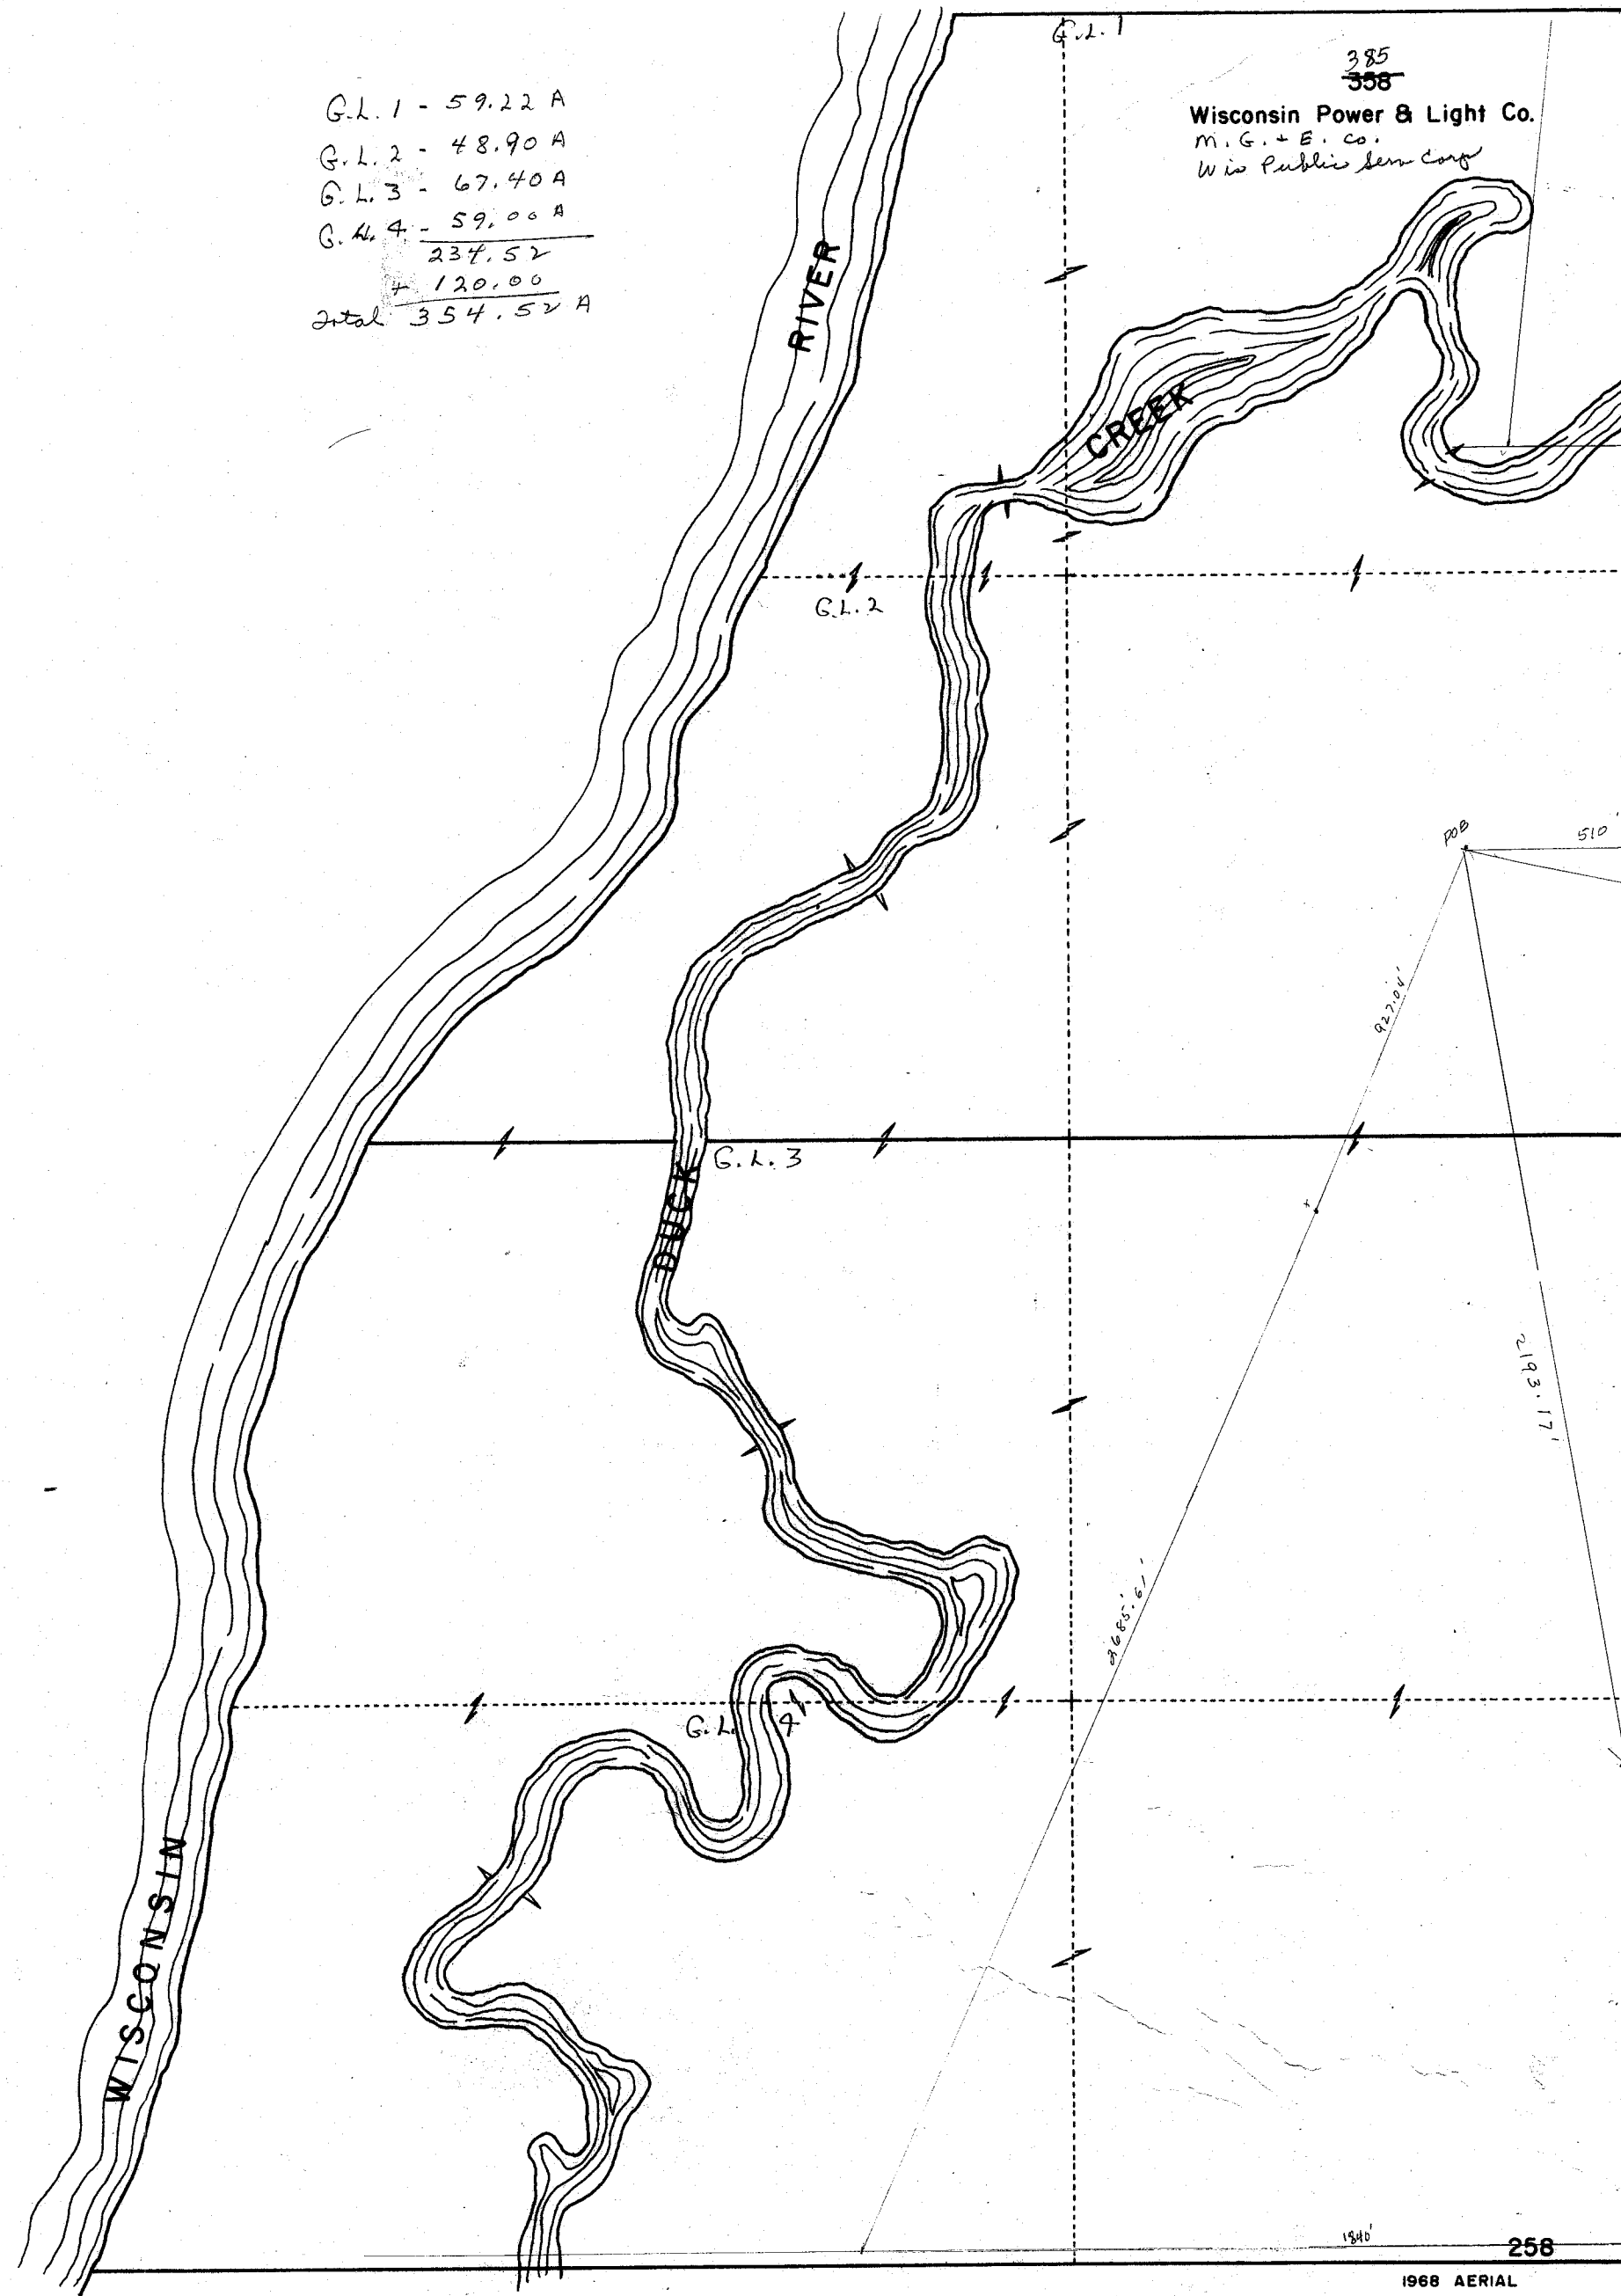


1968 AERIAL
PROPERTY OF TAX LISTING DEPARTMENT

PACIFIC
SEC. 28 T. 12N. R. 9E.

Replaced
2004

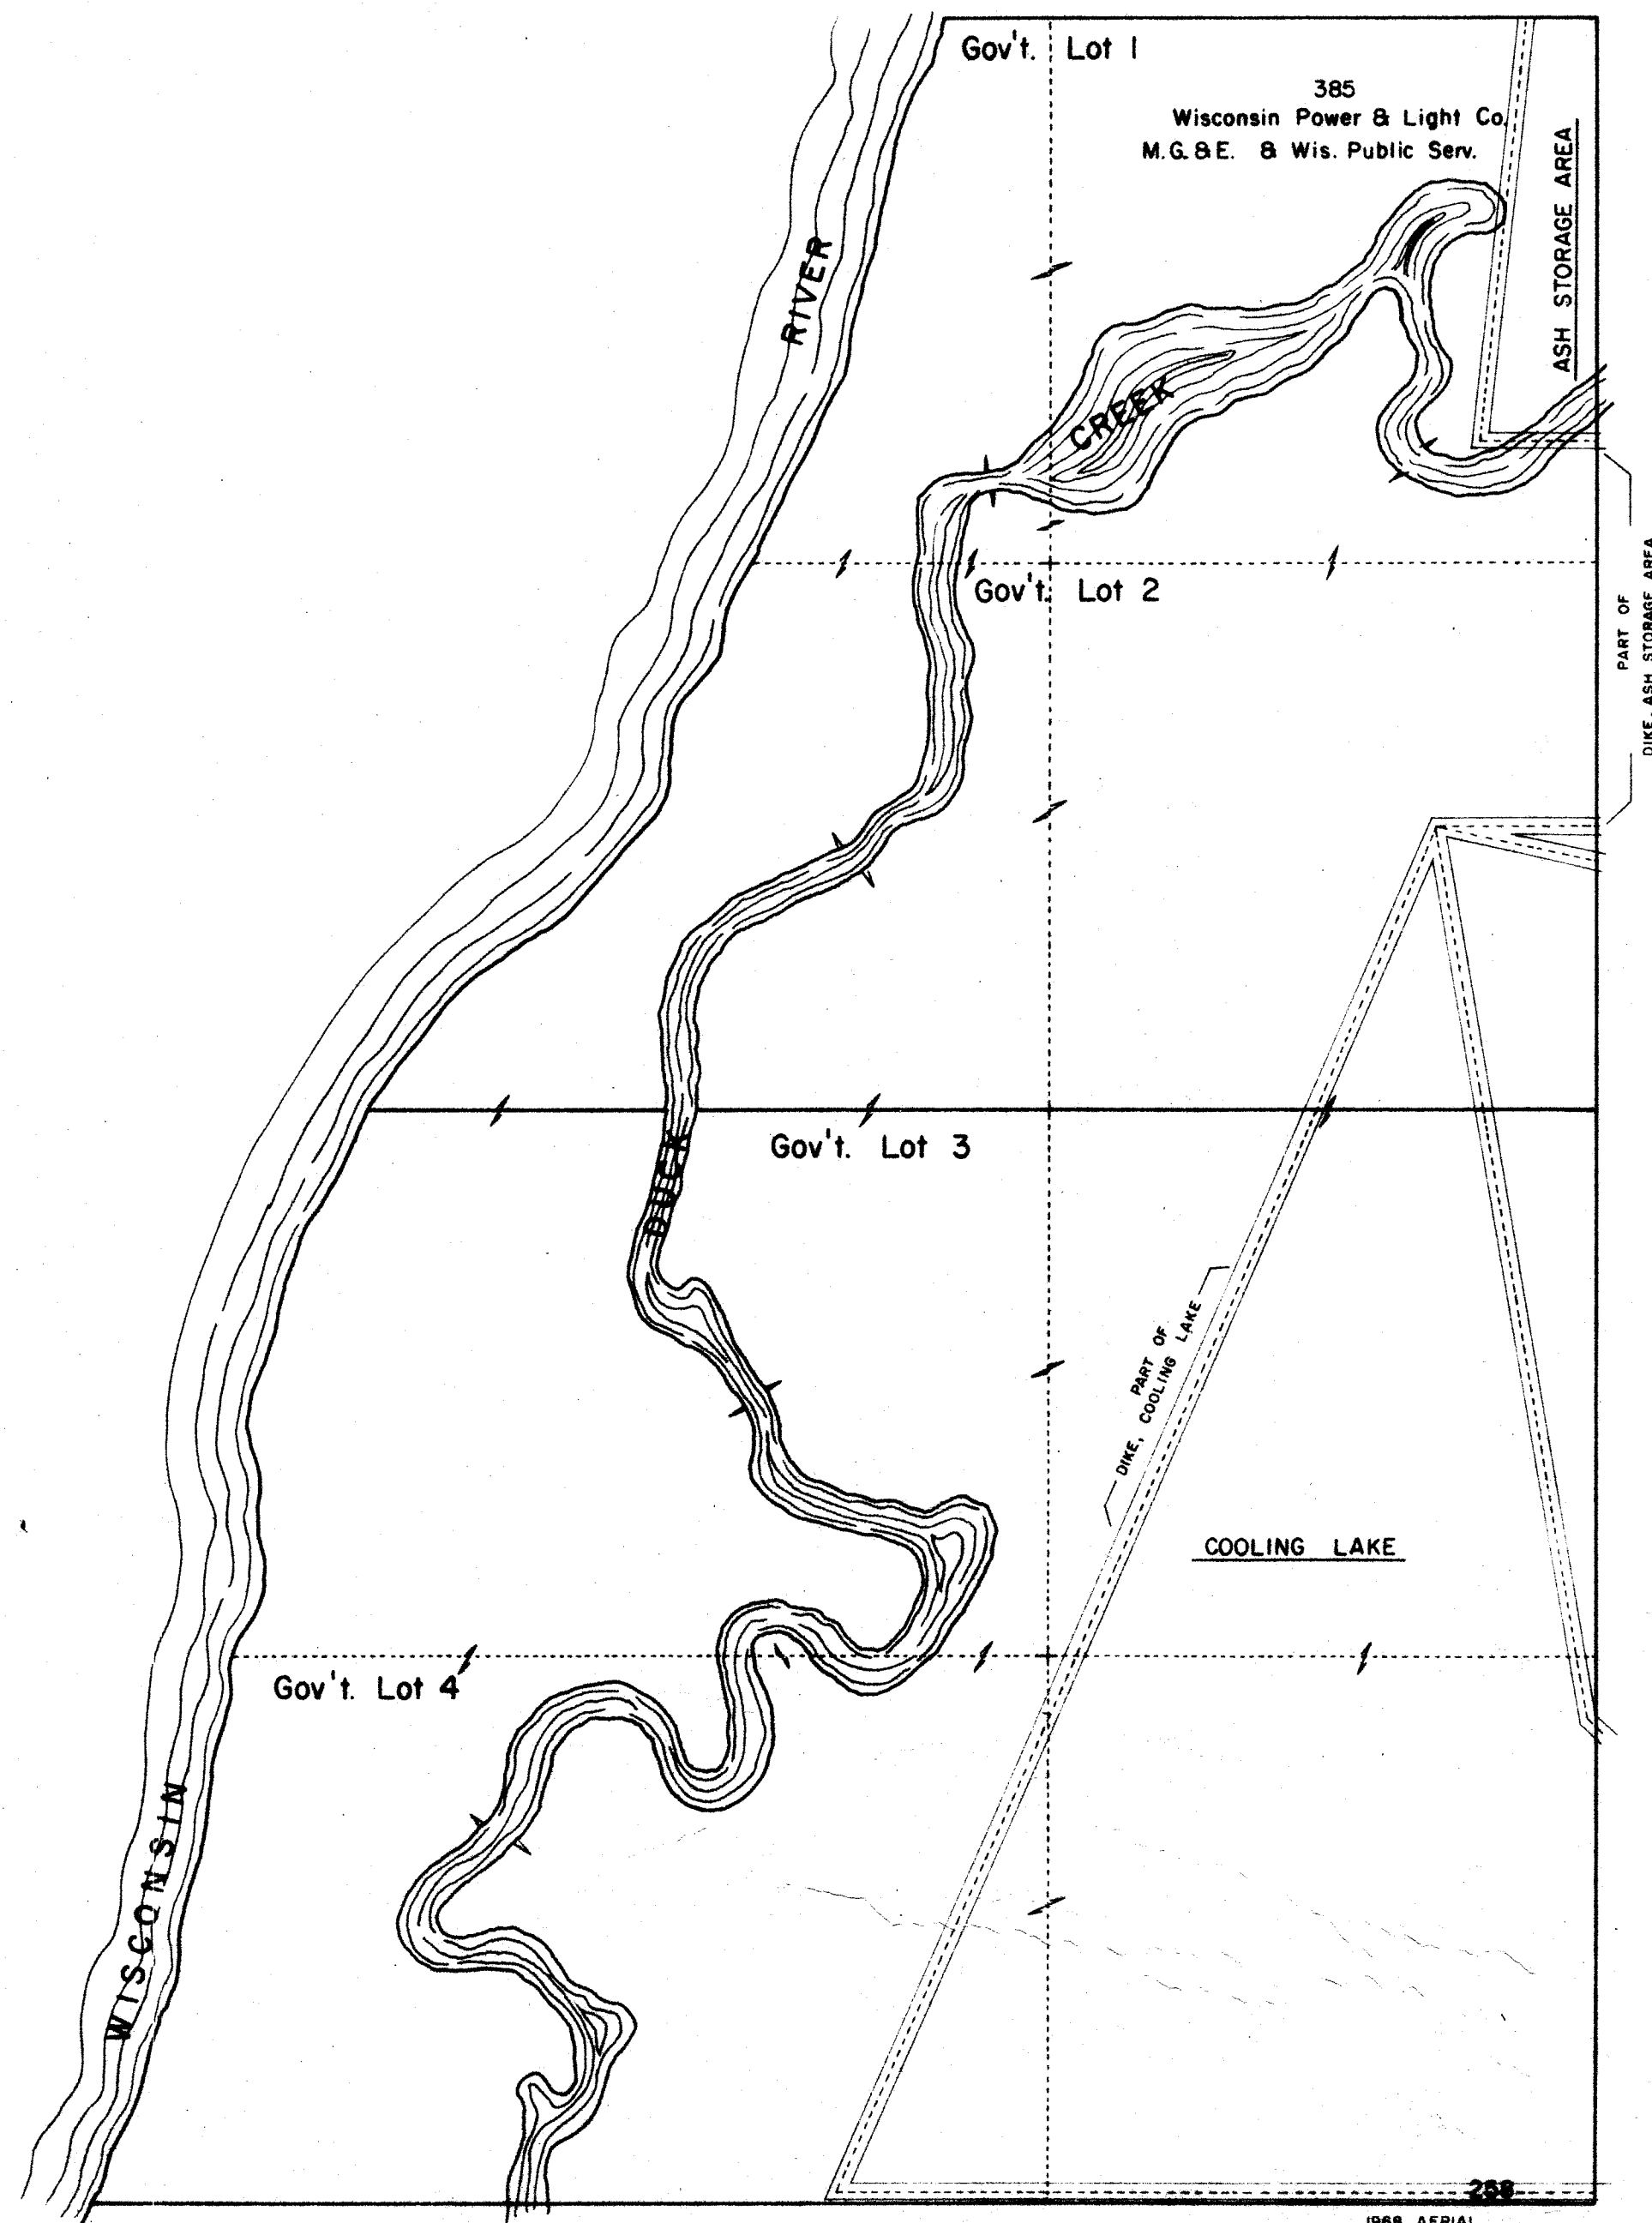

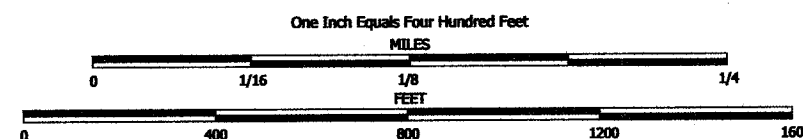


NOTE: This map was prepared for assessment use in accordance with the Wis. St. Stat., Chap. 70.09. All information contained herein is advisory only. Map accuracy is limited to the quality of data obtained from other public records. This map is not intended to be a substitute for an actual field survey. Public Land Survey Base is derived from U.S.G.S. Topographic maps unless otherwise noted. Other sources of the Land Base may be actual survey data. Base map data is from the April 1995 County Digital Orthophotos and/or U.S.G.S. 1:24,000 scale Topographic series. The user is responsible for the improper use of the data contained herein.

Created by The Columbia County Land Information Office -GIS Section. VMS. July 2004.

TAX PARCEL MAP

TOWN of PACIFIC


TOWN 12 NORTH RANGE 9 EAST
COLUMBIA COUNTY, WISCONSIN

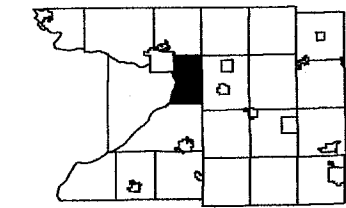

3	2	1
10	11	12
15	14	13
22	23	24
27	28	25
33	34	35
36		

Replaced
2006

-SEE SECTION 21-

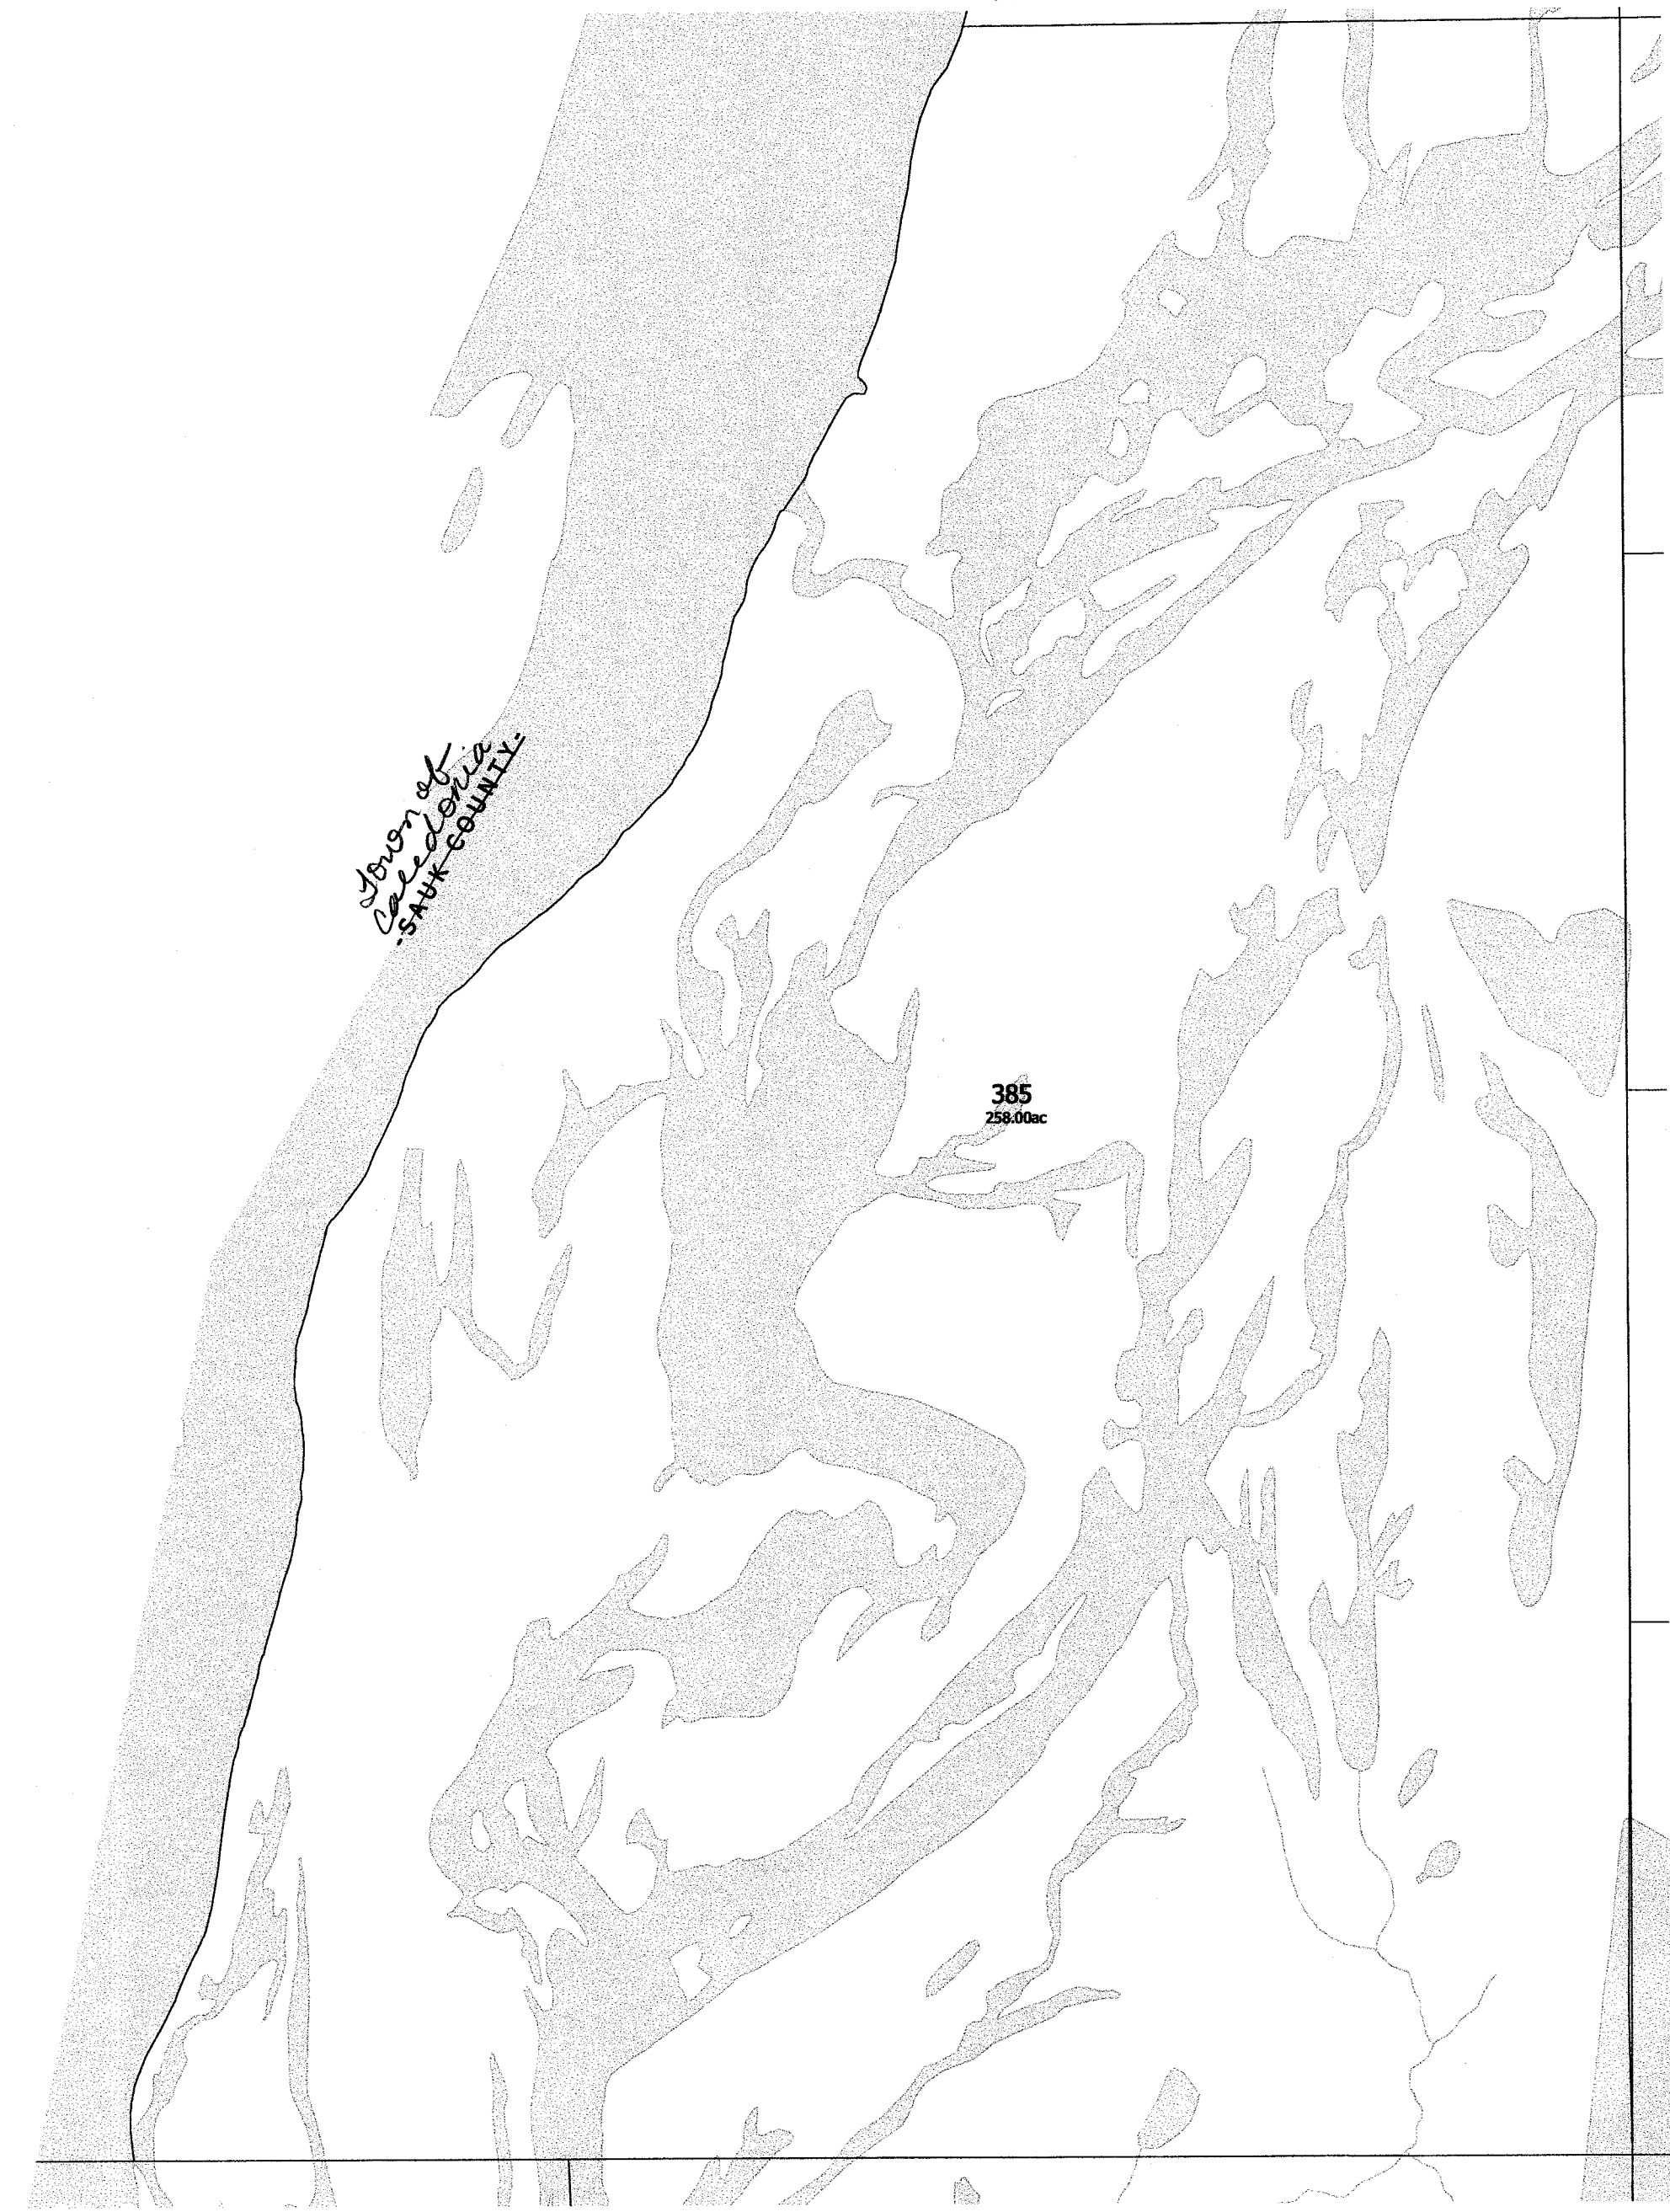

-SEE SECTION 27-

-SEE SECTION 33-


-SECTION 28-

Revised
2006

PACIFIC

SEC. 32 T.12N. R.9E.

Replaced
2004

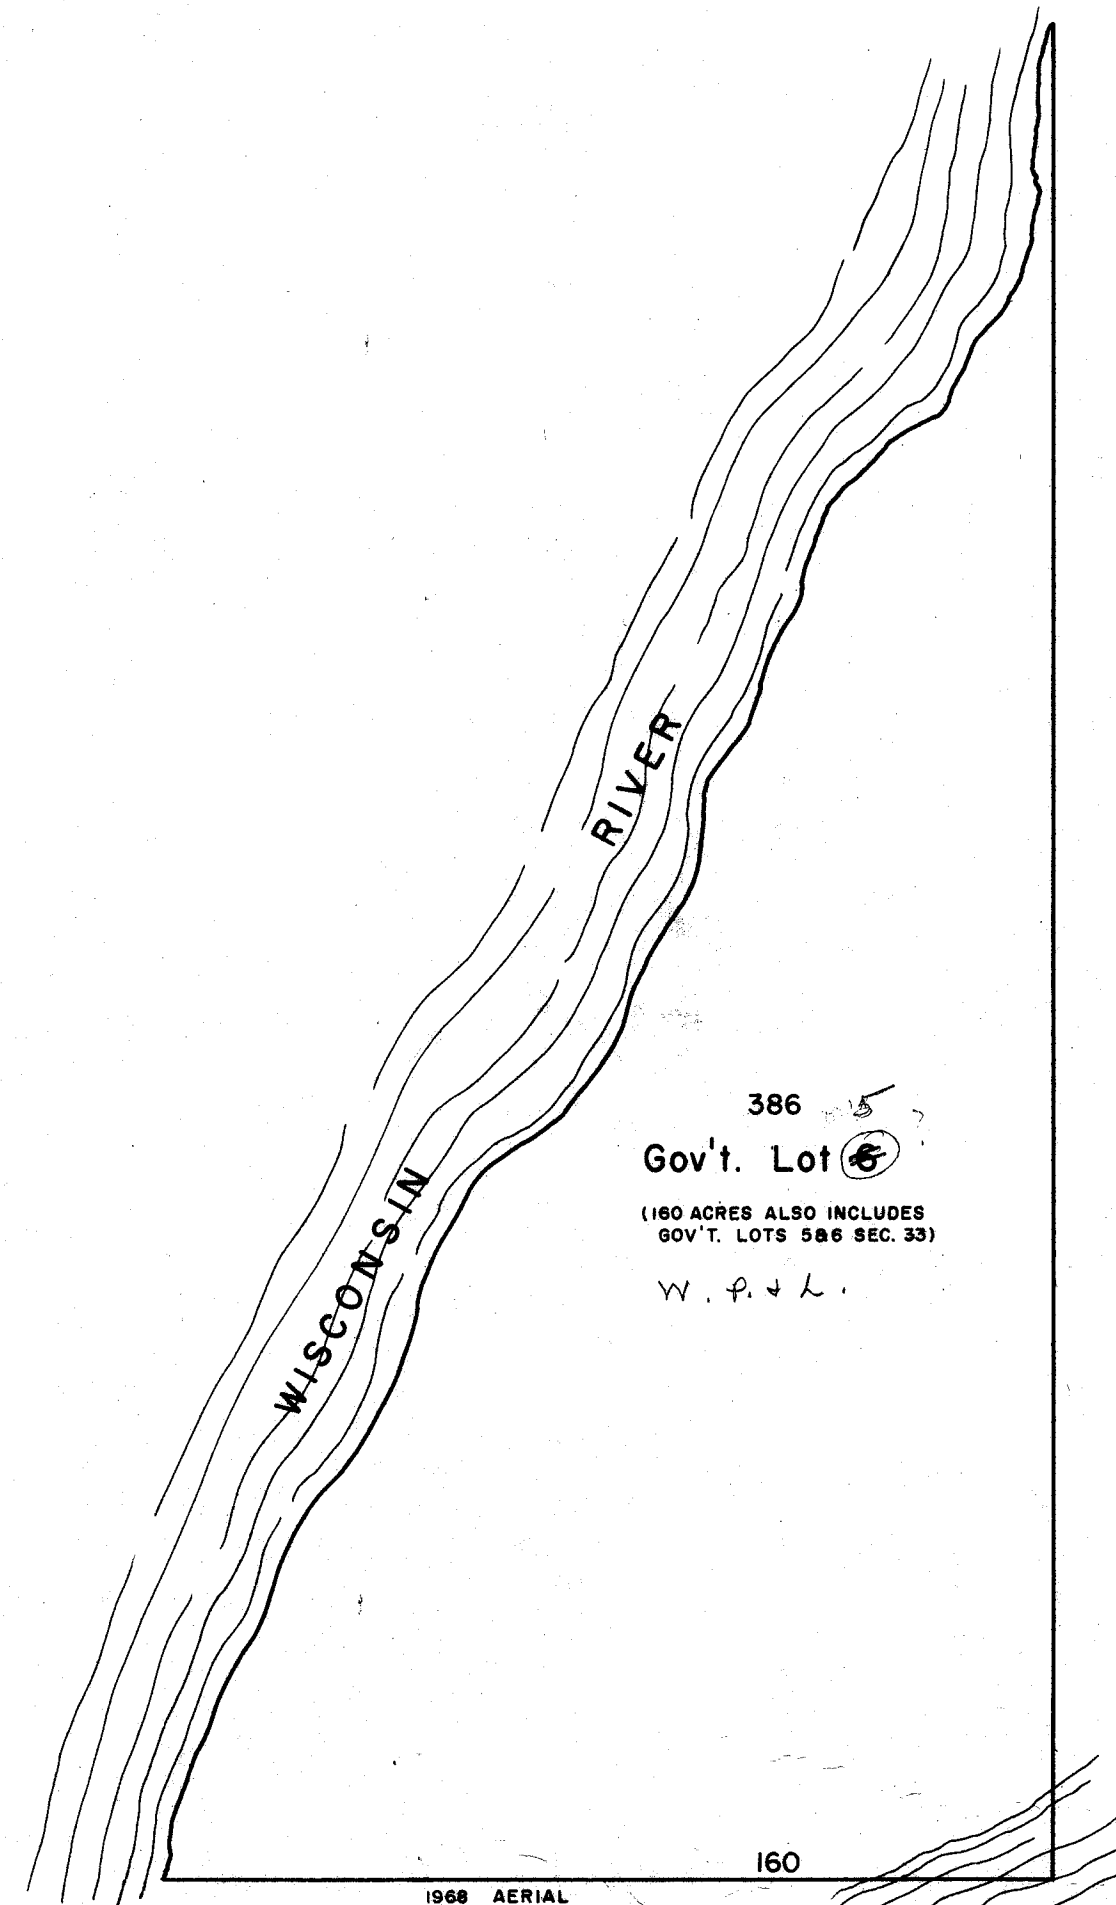

One Inch Equals Four Hundred Feet

MILES

0 1/16 1/8 1/4

FEET

0 400 800 1200 1600


NOTE: This map was prepared for assessment use in accordance with the Wis. Stat. Chap. 70.09. All information contained herein is advisory only. Map accuracy is limited to the quality of data obtained from other Public Records. This map is not intended to be a substitute for an actual field survey. Public Land Survey Base is derived from U.S.G.S Topographic maps unless otherwise noted. Other sources of the Land Base may be actual survey data. Base map data is from the April 1995 County Digital Orthophotos and/or U.S.G.S. 1:24,000 scale Topographic series. The user is responsible for the improper use of the data contained herein.

Created by The Columbia County Land Information Office -GIS Section. VMB. July 2004.

TAX PARCEL MAP


TOWN of PACIFIC

TOWN 12 NORTH RANGE 9 EAST
COLUMBIA COUNTY, WISCONSIN

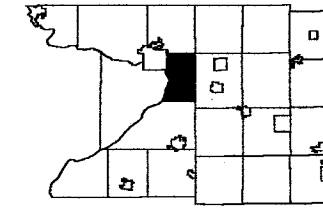

3	2	1
10	11	12
15	14	13
22	23	24
29	27	26
33	34	35

Replaced
2006

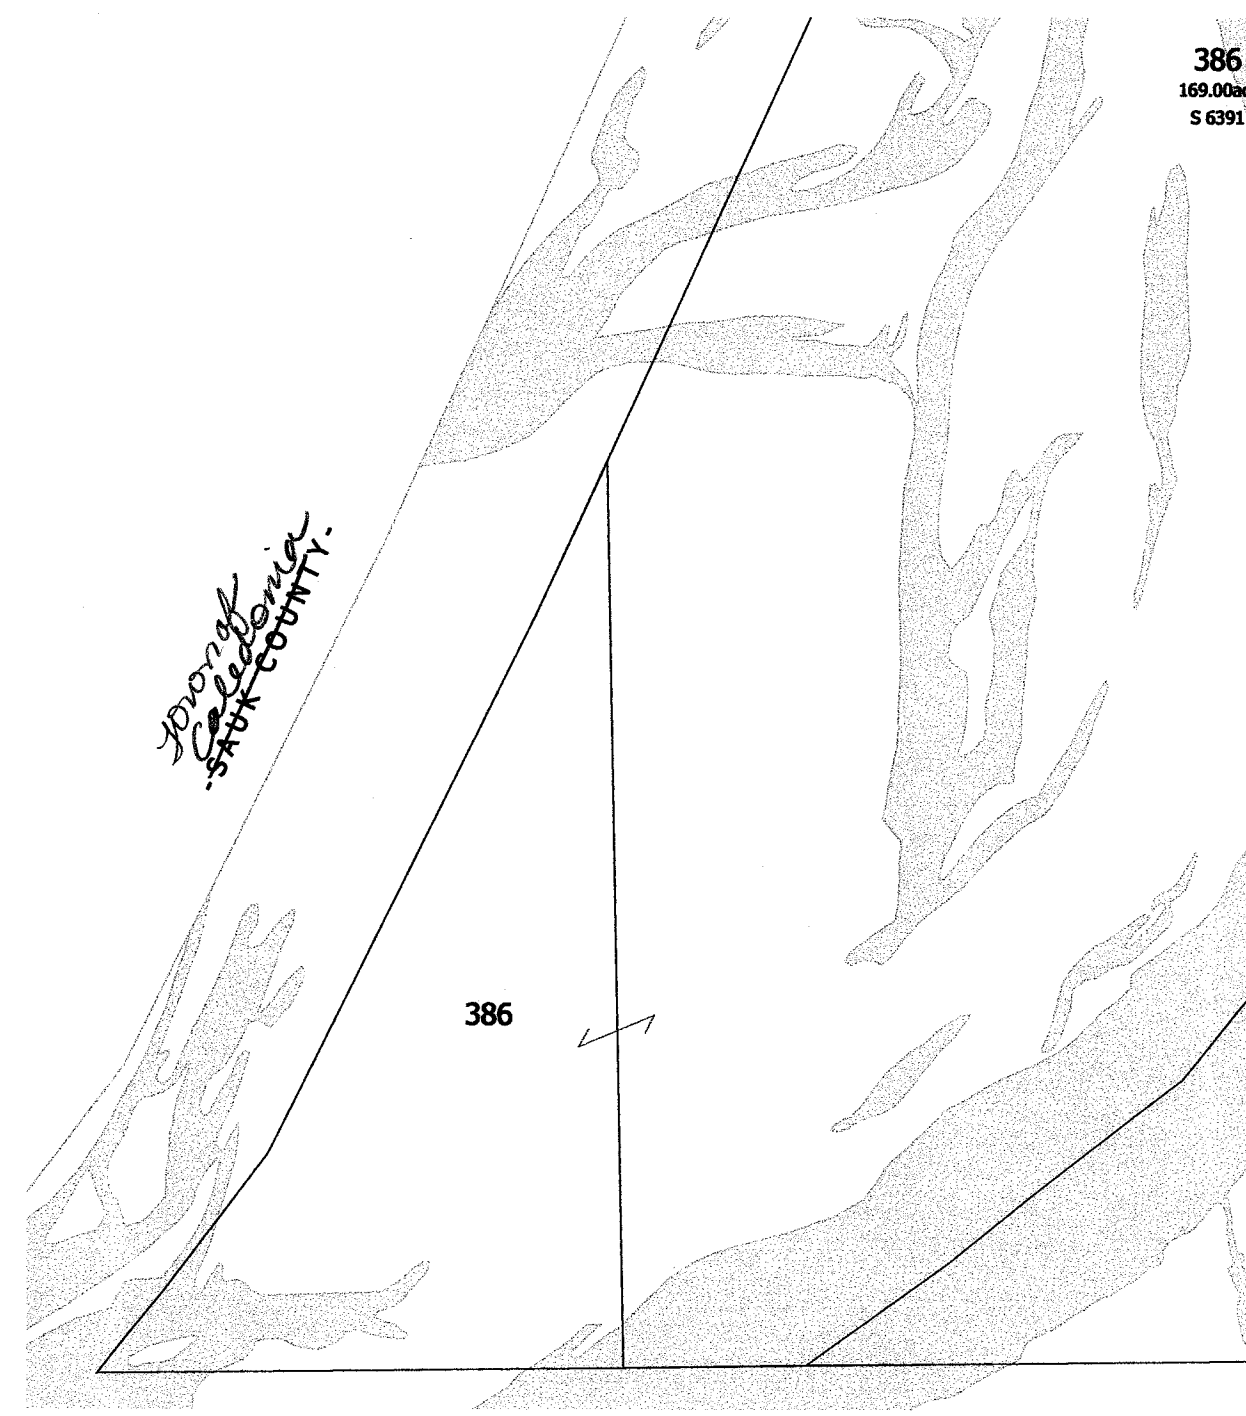

386
169.00ac
S 6391

- SEE SECTION 33 -


TOWN OF DEKORRA


Replaced
2006

PACIFIC

SEC. 33 T.12N. R.9E.

Replaced
2004

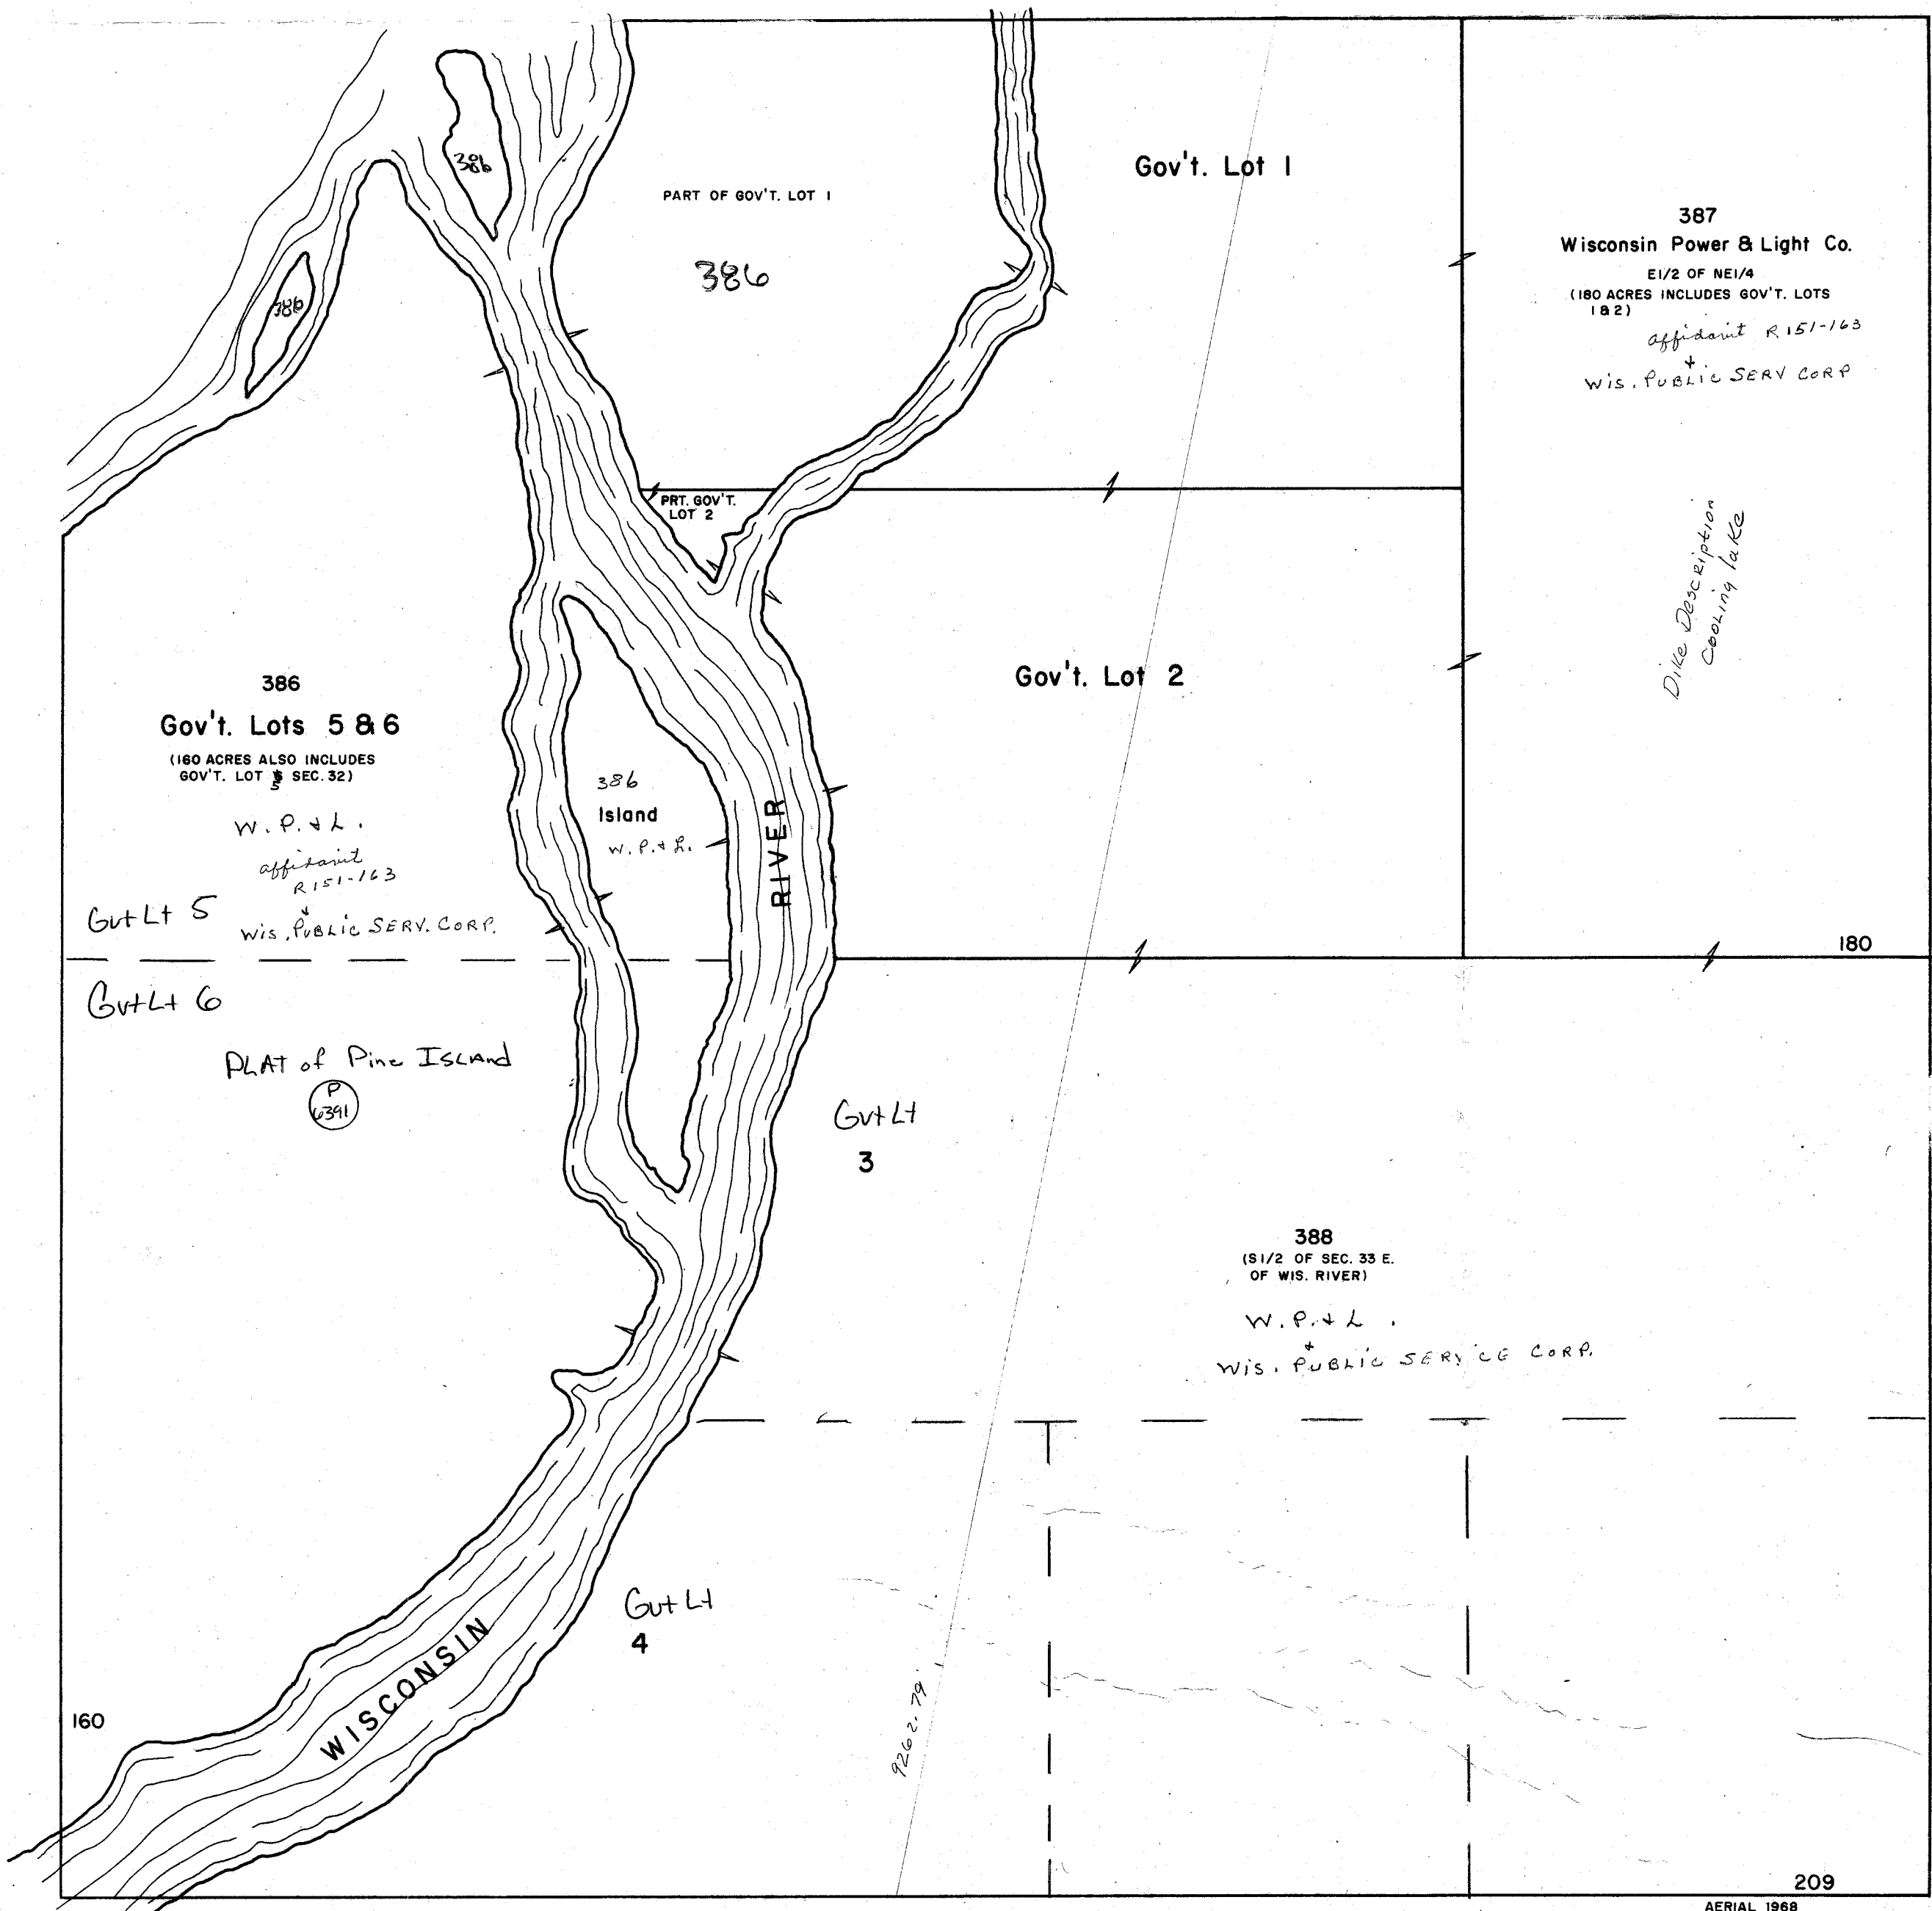

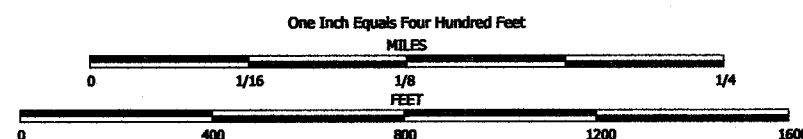


NOTE: This map was prepared for assessment use in accordance with the Wis. Stat. Chap. 70.09. All information contained herein is advisory only. Map accuracy is limited to the quality of data obtained from other Public Records. This map is not intended to be a substitute for an actual field survey. Public Land Survey Base is derived from U.S.G.S. Topographic maps unless otherwise noted. Other sources of the Land Base may be actual survey data. Base map data is from the April 1995 County Digital Orthophotos and/or U.S.G.S. 1:24,000 scale Topographic series. The user is responsible for the improper use of the data contained herein.

Created by The Columbia County Land Information Office -GIS Section. VMS. July 2004.

TAX PARCEL MAP

TOWN of PACIFIC

TOWN 12 NORTH RANGE 9 EAST
COLUMBIA COUNTY, WISCONSIN

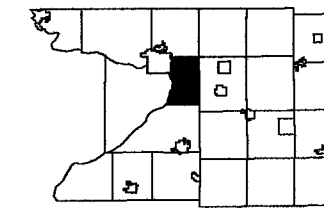

3	2	1
10	11	12
15	14	13
22	23	24
27	26	25
34	35	36

Replaced

2006

-SEE SECTION 28-



Young Caladonia
SAUK COUNTY

386
169.00ac
S 6391

387
180.00ac

388
209.00ac

-SEE SECTION 34-

TOWN OF DEKORRA


Replaced
2006

-SECTION 33-

PACIFIC
SEC. 34 T.12N. R.9E.

Replaced
2004

see next sheet

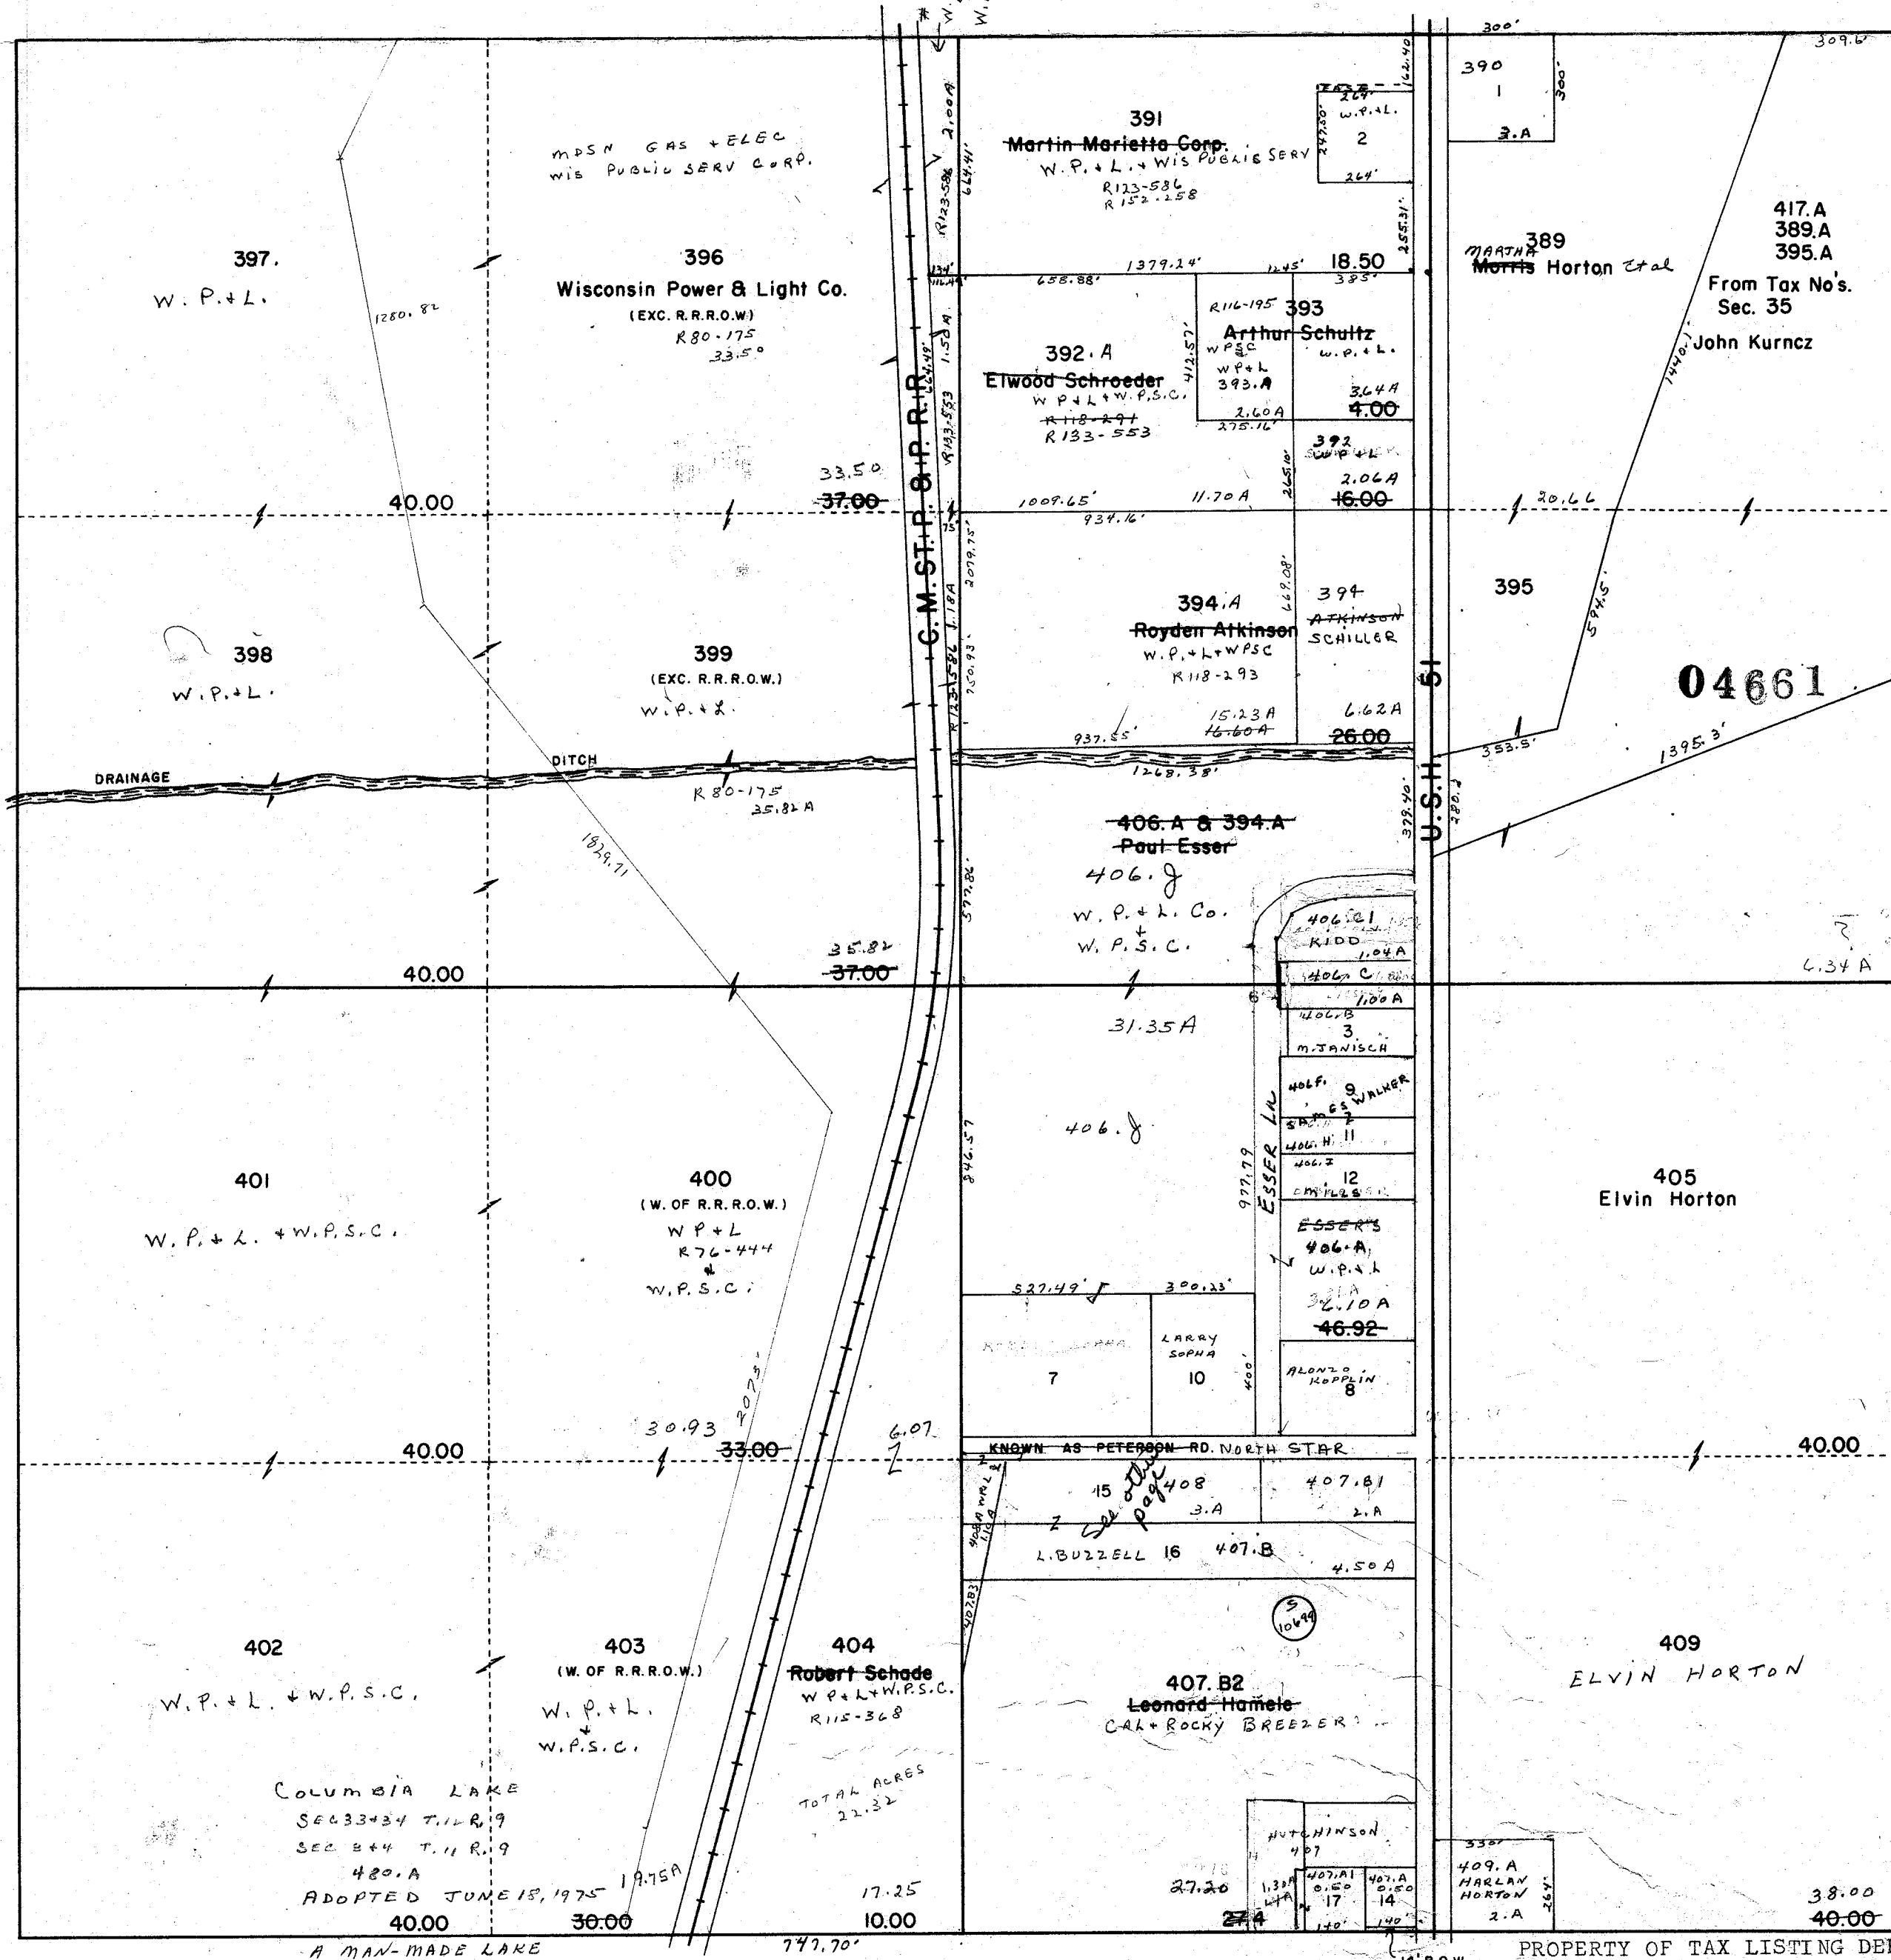


- 1-390 MARY JANET Raymond Race 3.00A
- 2-391.A W.P. & L. Co. Arthur Koop 1.50A
- 3-406.B & 394.B Melvin Janisch
- 4-406.C Roger Vesely
- 5-
- 6-406.C2 Roger Vesely
- 7-406.D W.P. & L. Robert Sopha 4.8A
- 8-406.E Alanzo Kopplin 3.00A WALKER
- 9-406.F WALKER Melvin Janisch 1.29A
- 10-406.G Larry Sopha 2.74A Diane Galk
- 11-406.H WALKER Patricia Jendure 0.81A
- 12-406.I Dorothy Brewer 1.08A DAWSON C. MILLS
- 13-
- 14-407.A James O'Neil 0.50A
- 15-408 Lynn Buzzell 3.50A
- 16-407.B Lynn Buzzell 4.50A
- 17-407.A1 L.L. HANSON Jesse James Powers Also 14' R.O.W. Pache-Virgin DAN

410
C.M. ST. P. & P. R.R.
12.00A

PROPERTY OF TAX LISTING DEPT.


PACIFIC
SEC. 34 T.12N. R.9E.

Replaced
2004

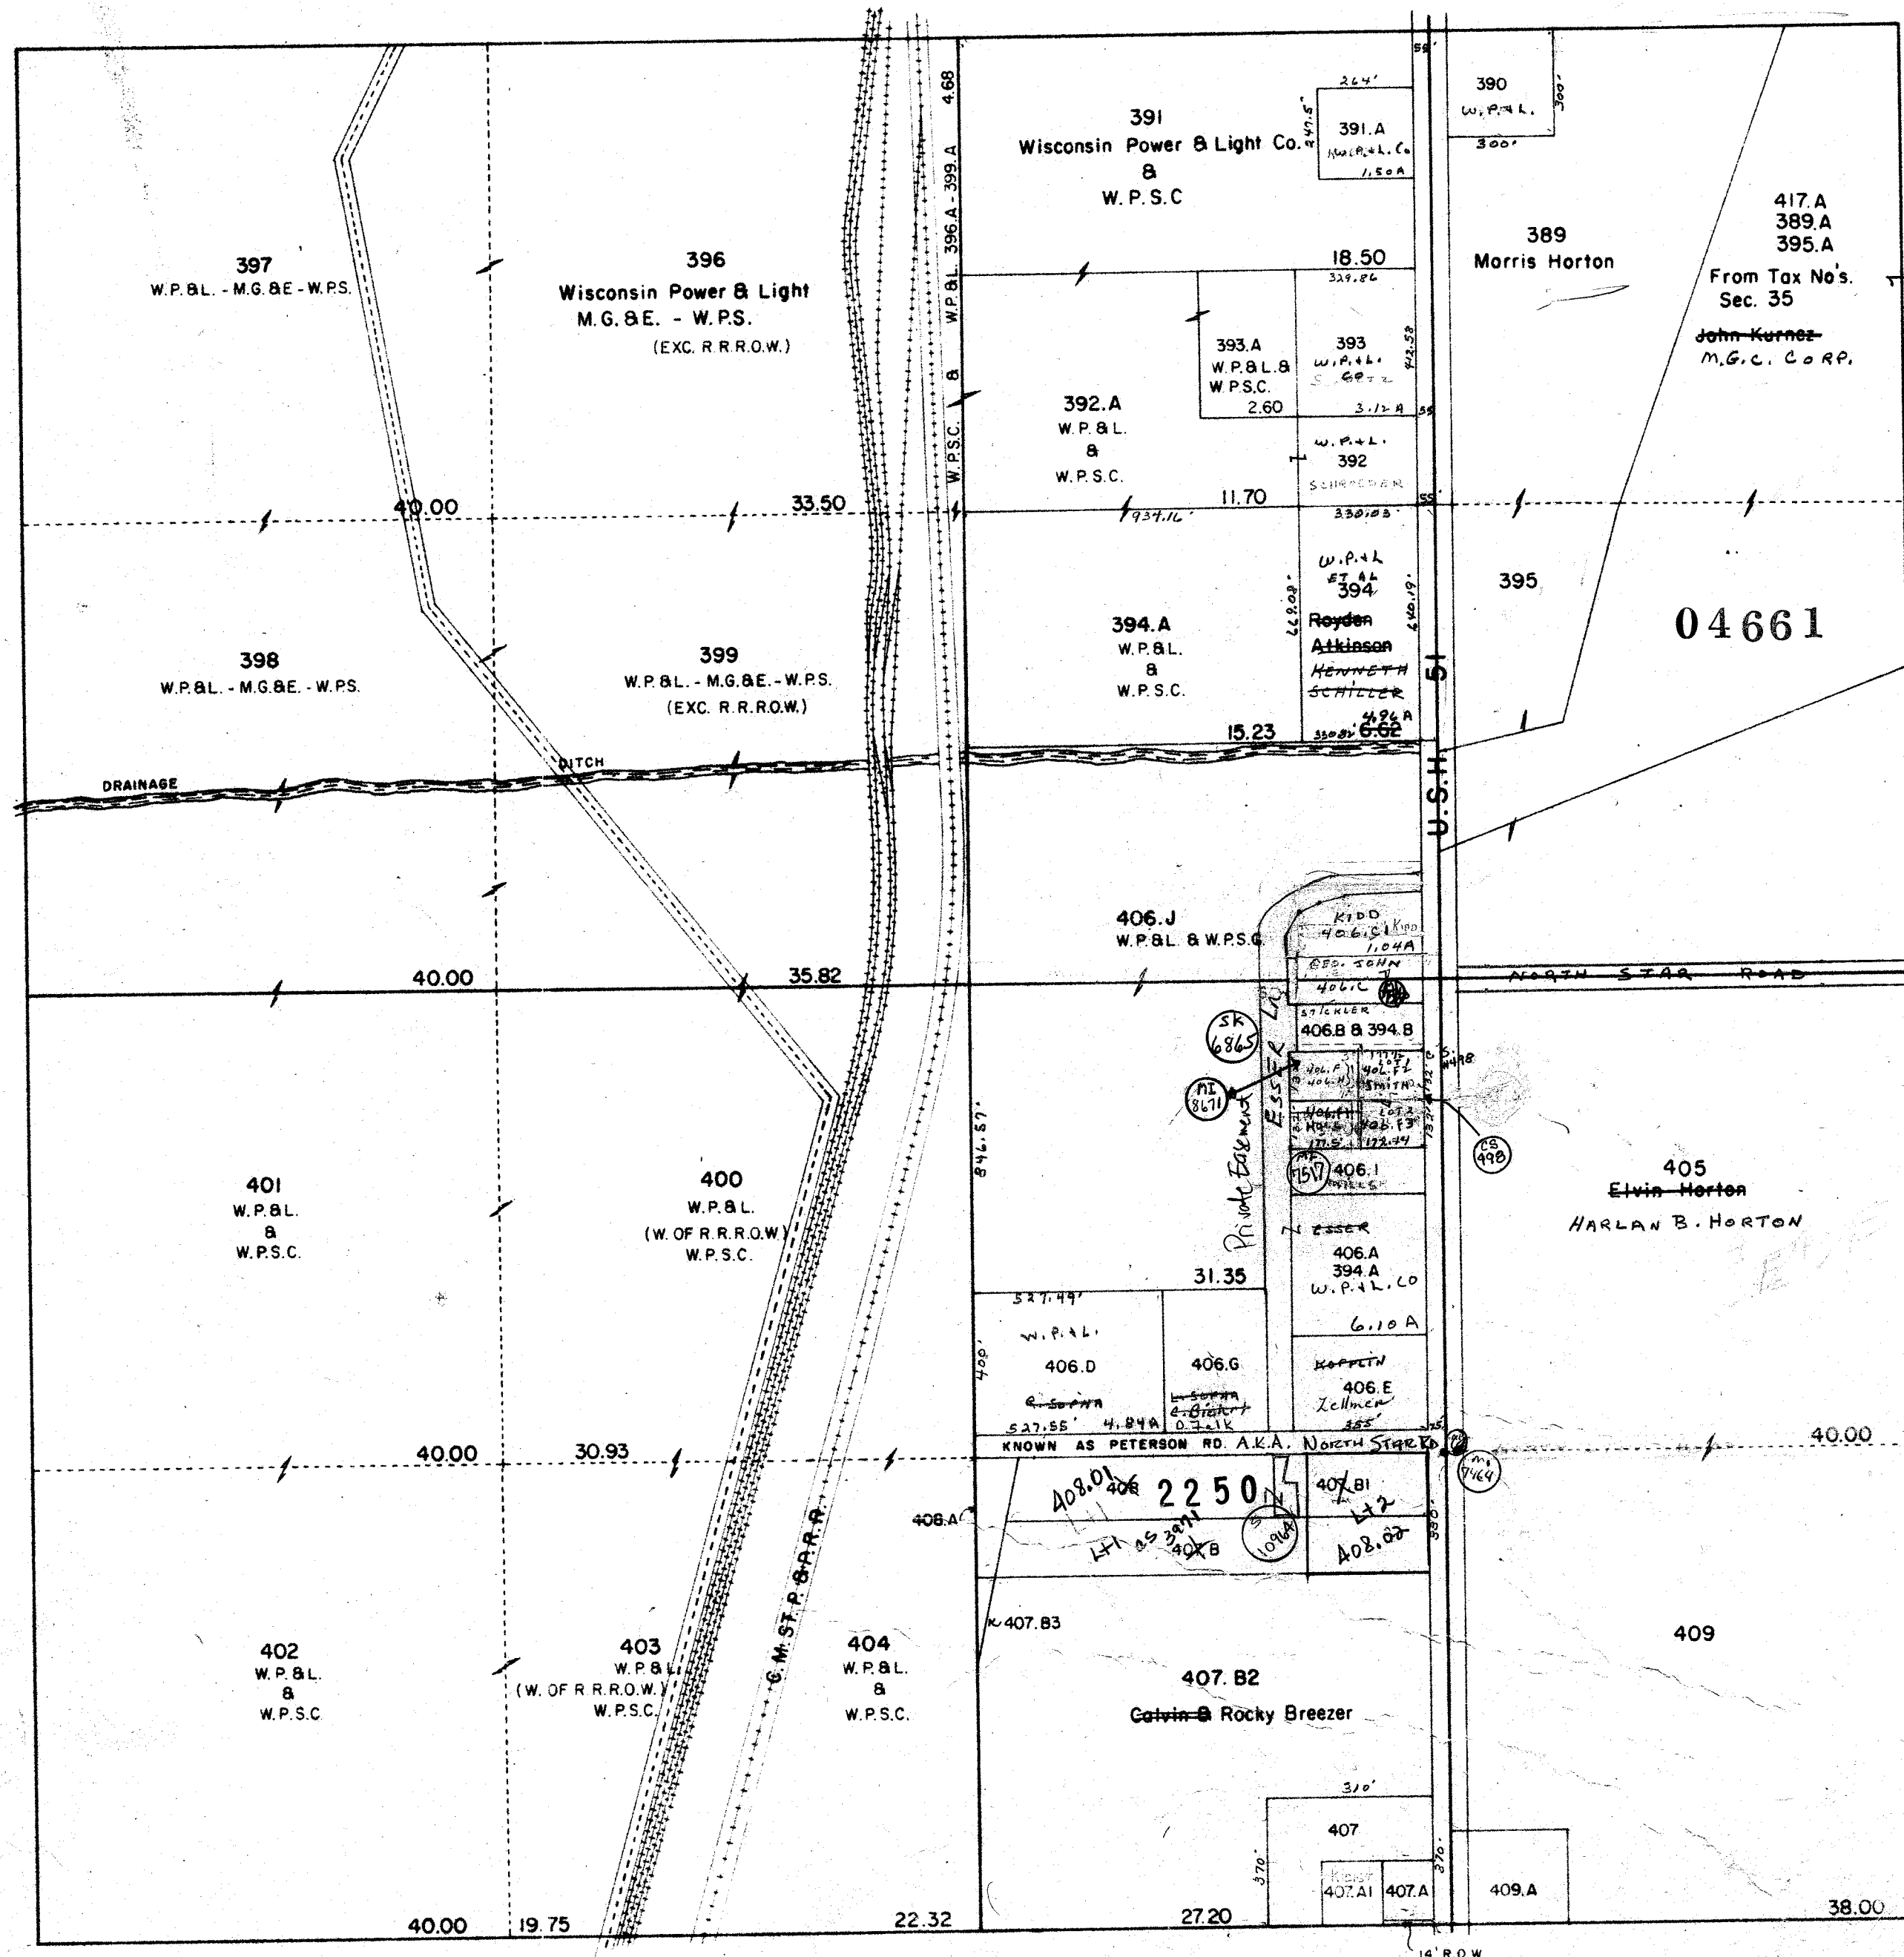

390 W.P. & L.
MARTIN RACE 3.00A 2.07A
391.A W.P. & L. Co.
Arthur Koopp 1.50A 7.90W
406.B & 394.B
Dale Strickler 0.90A
406.C
Roger Vesely 1.08A
392
Elwood Schroeder 2.06A
W.P. & L. Co.
406.D W.P. & L.
Robert Sopha 4.8A
406.E
Alonzo Kopplin 3.00A
406.F
Dale Strickler 1.29A 0.38A
JAMES WALKER
406.G
Larry Sopha 2.74A
Dine Talk
406.H
Dale Strickler 0.81A
JAMES WALKER
406.I
Dorothy Brewer 1.08A
DAMON C. MILLS
393 W.P. & L. Co.
Arthur Schultz 5.64A
(Dune 3.12A) To Row
407.A
James O'Neil 0.50A
PAUL T. GEORGE
408
Lynn Buzzell 3.00A
407.B
Lynn Buzzell 4.50A
407.A1 L.L. HANSON
Bryon Hartley 50A
Also 14' R.O.W.
406.A & 394.A
Paul Jerome 3.81A
407
Mrs. Hugh Hutchinson
1.4A
407.B1
Lynn Buzzell 1.98A
407.B3
Wisc. Power & Light Co.
0.15A
408.A
Wisc. Power & Light Co.
1.10A
409.A
Harlan Horton 2.00A

410
C.M. ST. P. & P. R.R.
12.00A

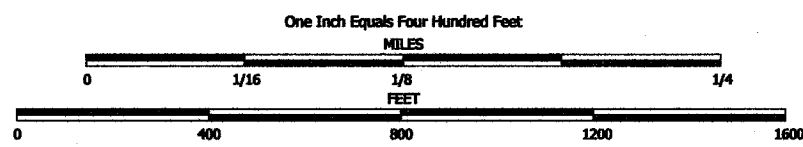


NOTE: This map was prepared for assessment use in accordance with the Wis. St. Stat. Chap. 70.09. All information contained herein is advisory only. Map accuracy is limited to the quality of data obtained from other Public Records. This map is not intended to be a substitute for an actual field survey. Public Land Survey Base is derived from U.S.G.S. Topographic maps unless otherwise noted. Other sources of the Land Base may be actual survey data. Base map data is from the April 1995 County Digital Orthophotos and/or U.S.G.S. 1:24,000 scale Topographic series. The user is responsible for the proper use of the data contained herein.

Created by The Columbia County Land Information Office -GIS Section. VMB. July 2004.

TAX PARCEL MAP

TOWN of PACIFIC

TOWN 12 NORTH RANGE 9 EAST
COLUMBIA COUNTY, WISCONSIN

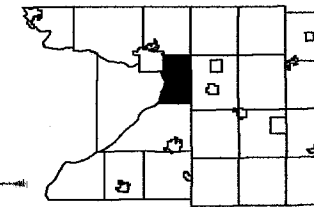


3	2	1
10	11	12
15	14	13
22	23	24
27	26	25
32	31	30

Replaced
2006

-SEE SECTION 27-

-SEE SECTION 33-

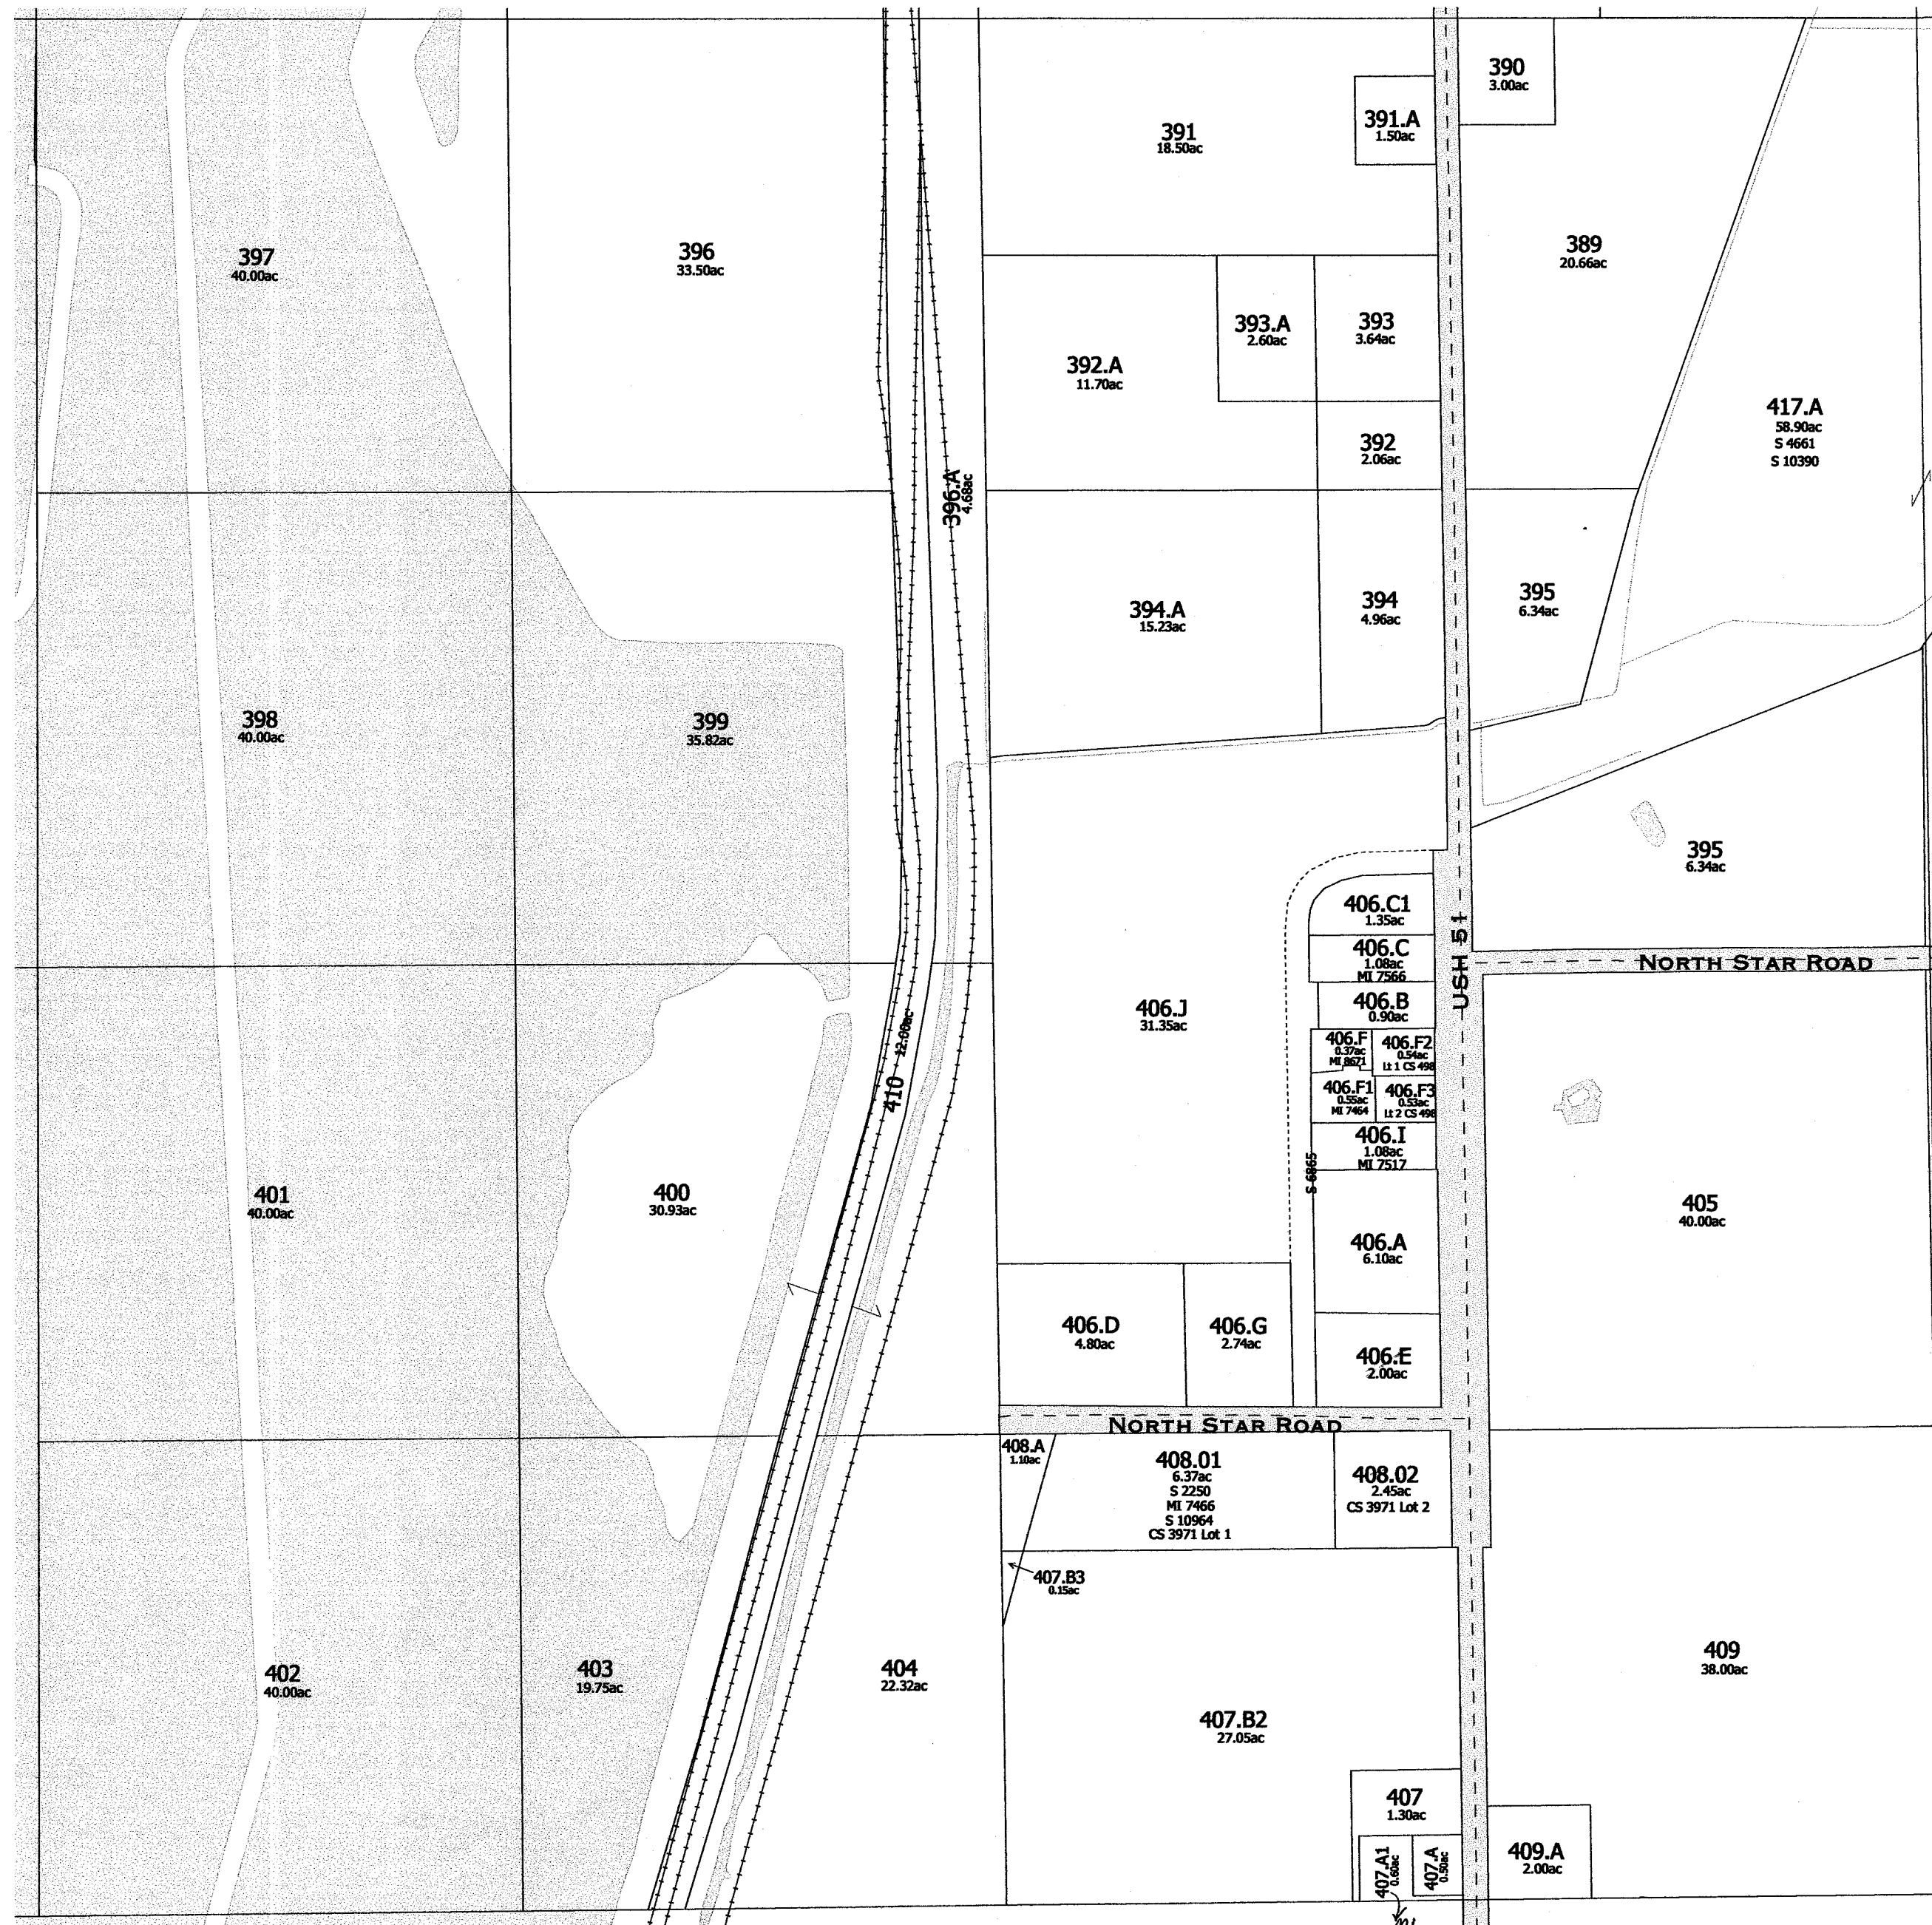


-SEE SECTION 35-

TOWN OF DEKORRA

Replaced
2006

-SECTION 34-


2004

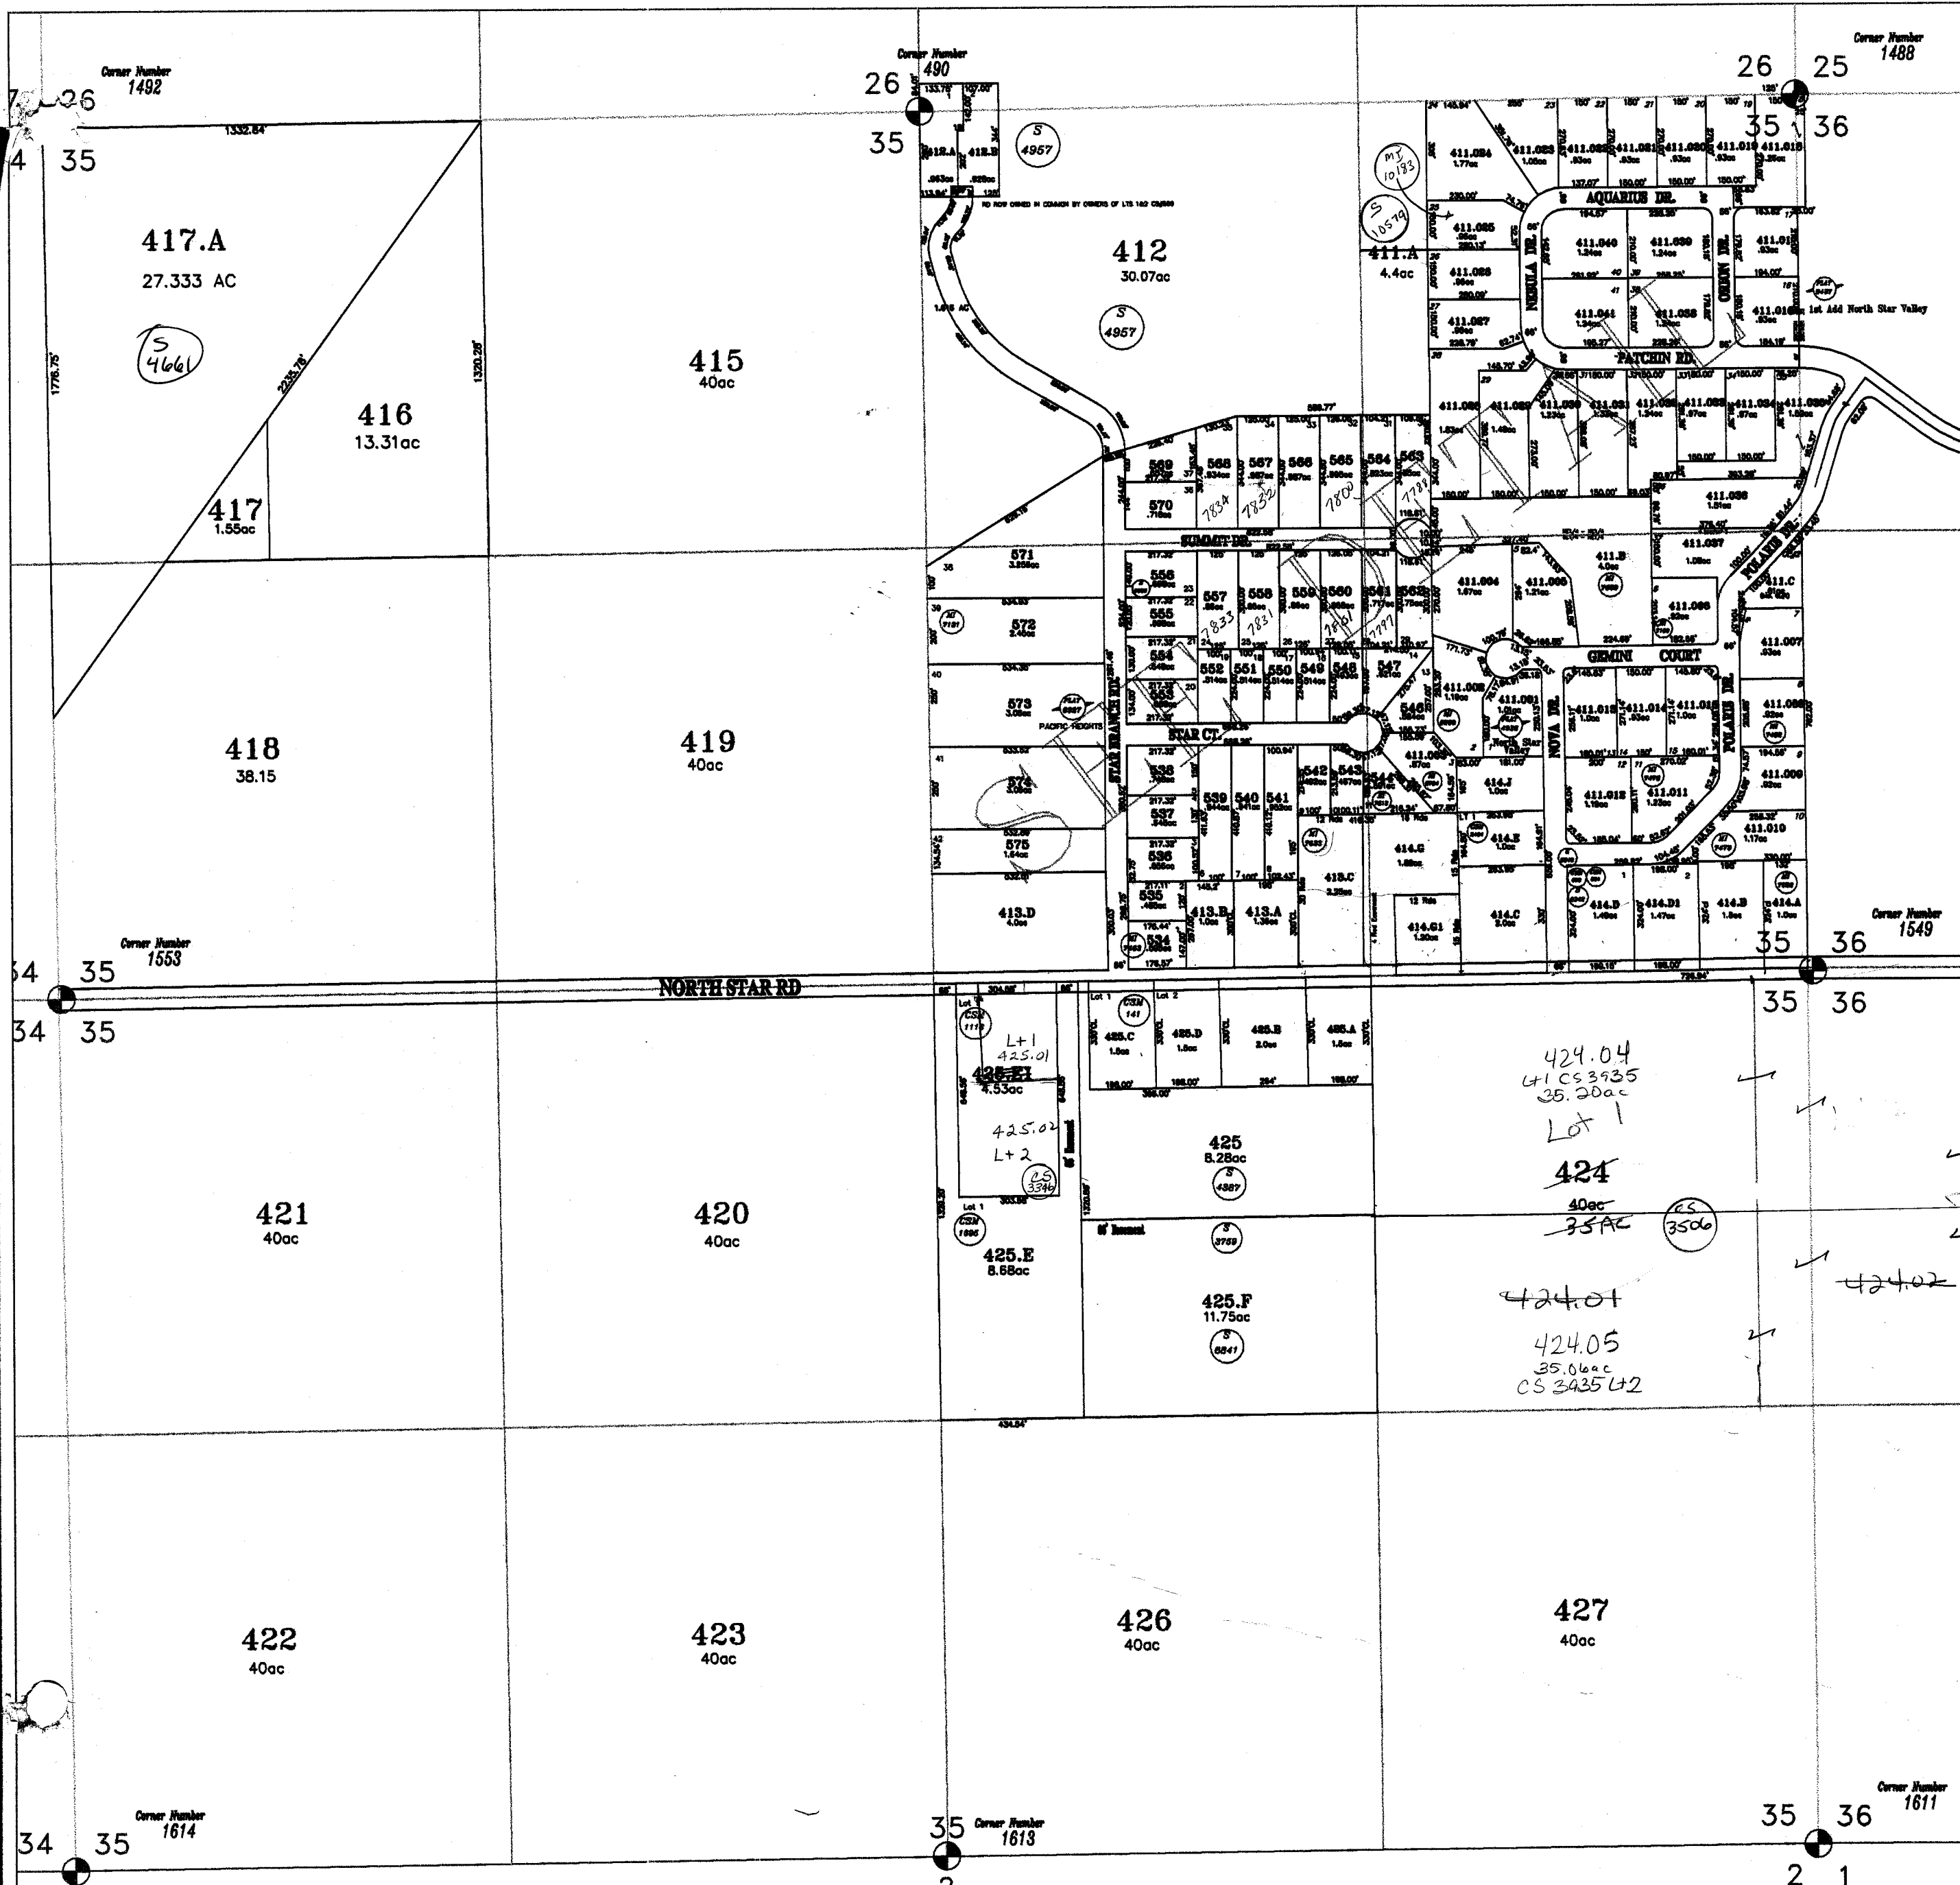






Town 12 North-Range 9 East

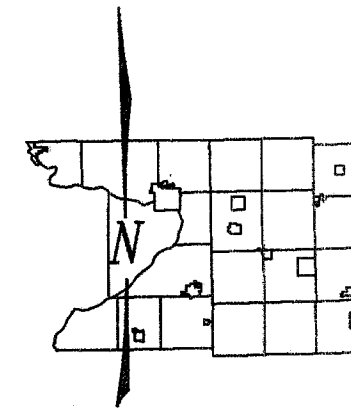Section 35

Town of Pacific



-  ...Plat on File
- Survey on File
-  ...Certified Survey Map
-  ...Mortgage Inspection on File
-  ...Monumented Section Corner

LT or Lotlot number of CSM/Plat


NOTE: This map was prepared for assessment use in accordance with Wis. St. Stat. Chap. 70.09. All information contained herein is advisory only. Map accuracy is limited to the quality of data obtained from other Public Records. This map is not intended to be a substitute for an actual field survey. Public Land Survey Base is derived from U.S.G.S. Topographic Maps unless otherwise noted. Other source of Land Base may be actual survey data.




One Inch Equals Four Hundred Feet
MILES
0 1/16 1/8 1/4
0 400 800 1200 1600
FEET
NOTE: This map was prepared for assessment use in accordance with the Wis. Stat. Chap. 70.09. All information contained herein is advisory only. Map accuracy is limited to the quality of data obtained from other Public Records. This map is not intended to be a substitute for an actual field survey. Public Land Survey Base is derived from U.S.G.S. Topographic maps unless otherwise noted. Other sources of the Land Base may be actual survey data. Base map data is from the April 1995 County Digital Orthophotos and/or U.S.G.S. 1:24,000 scale Topographic series. The user is responsible for the improper use of the data contained herein.
Created by The Columbia County Land Information Office -GIS Section. VMB. July 2004.

TAX PARCEL MAP
TOWN of PACIFIC
TOWN 12 NORTH RANGE 9 EAST
COLUMBIA COUNTY, WISCONSIN

Replaced
2005

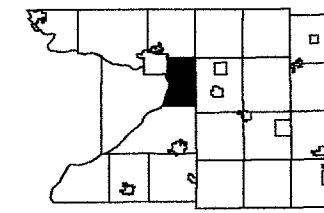


3	2	1
10	11	12
15	14	13
22	23	24
29	27	26
33	34	35

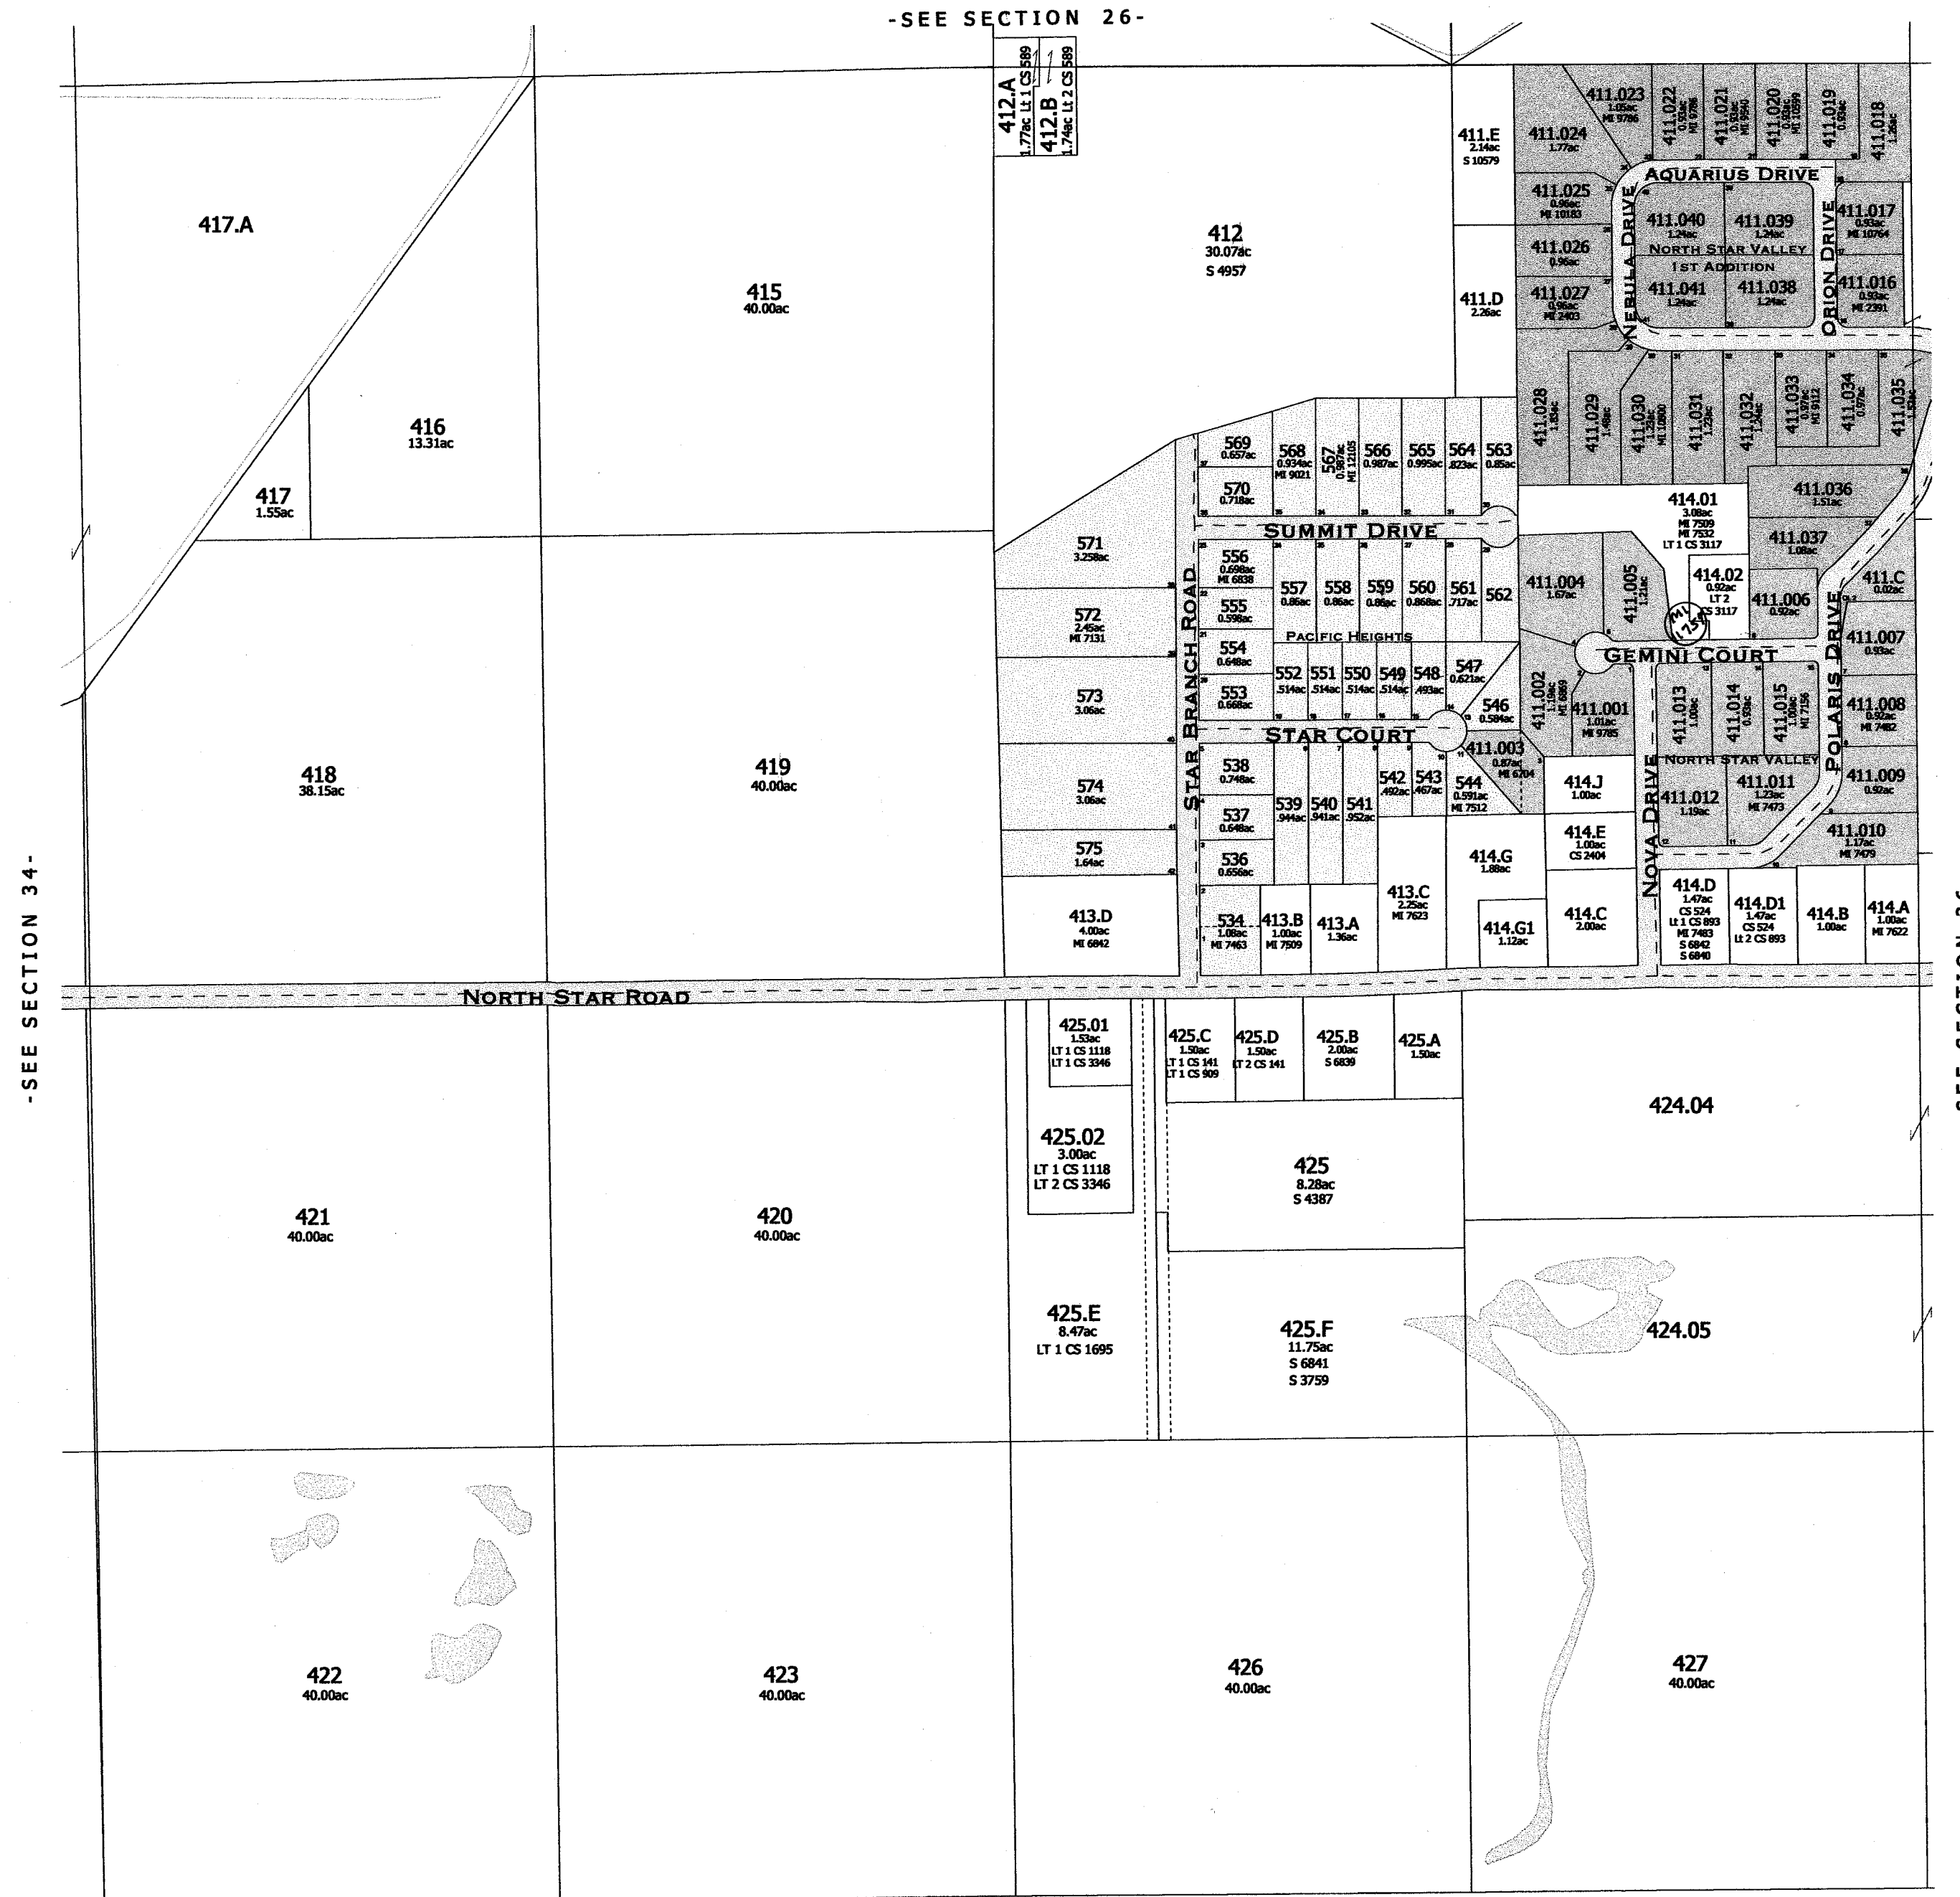

TOWN OF DEKORRA

NORTH STAR VALLEY - S4926
NORTH STAR VALLEY 1ST ADDITION - S8497
PACIFIC HEIGHTS - S6927


-SECTION 35-2005

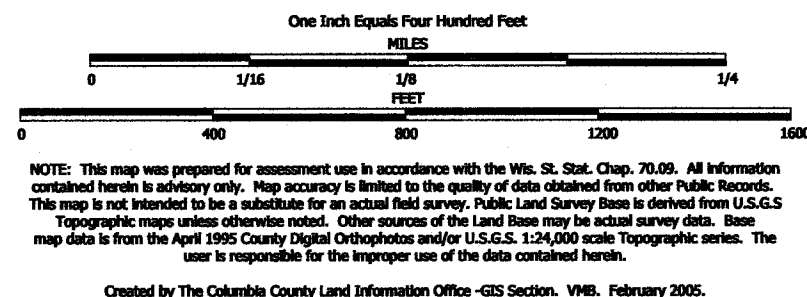

TAX PARCEL MAP


TOWN of PACIFIC

TOWN 12 NORTH RANGE 9 EAST
COLUMBIA COUNTY, WISCONSIN

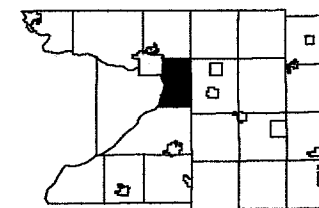

3	2	1
10	11	12
15	14	13
22	23	24
27	28	25
34	35	36



Replaced
2006

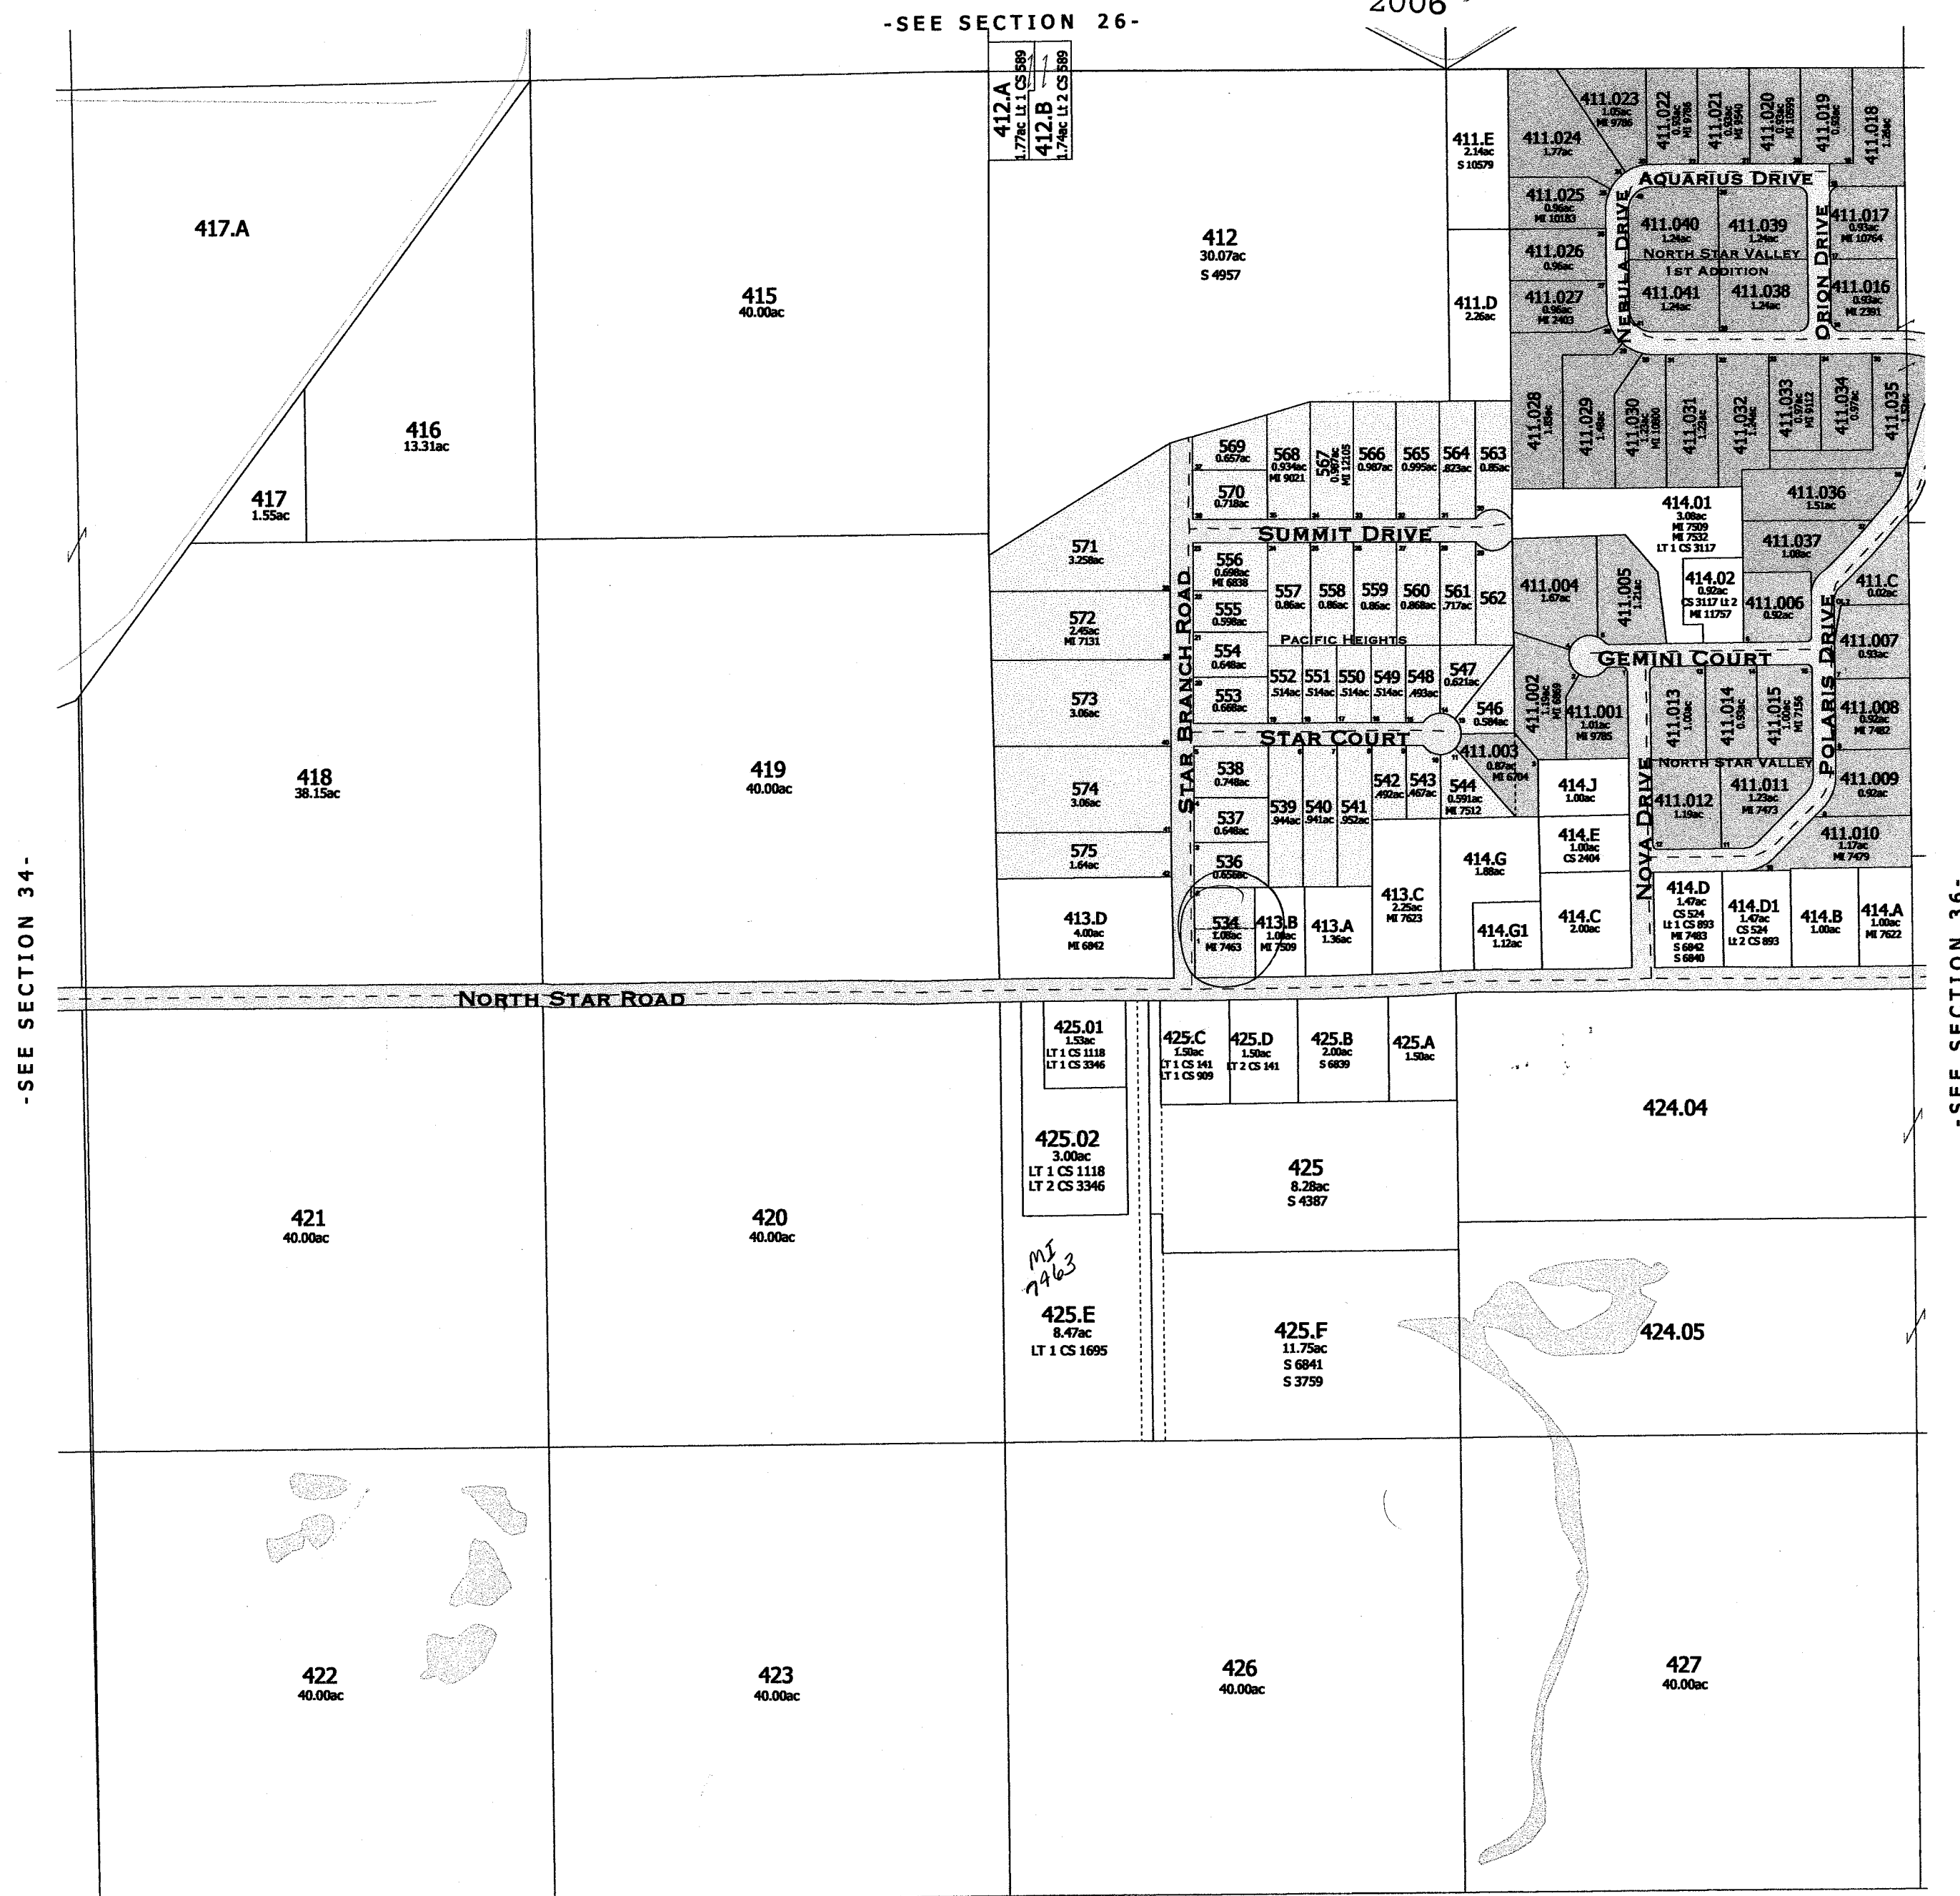

Corner Number
490


Replaced
2004 26

Corner Number
146

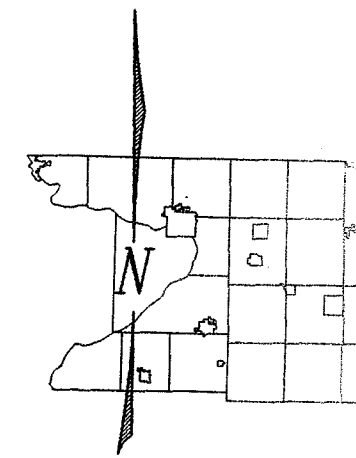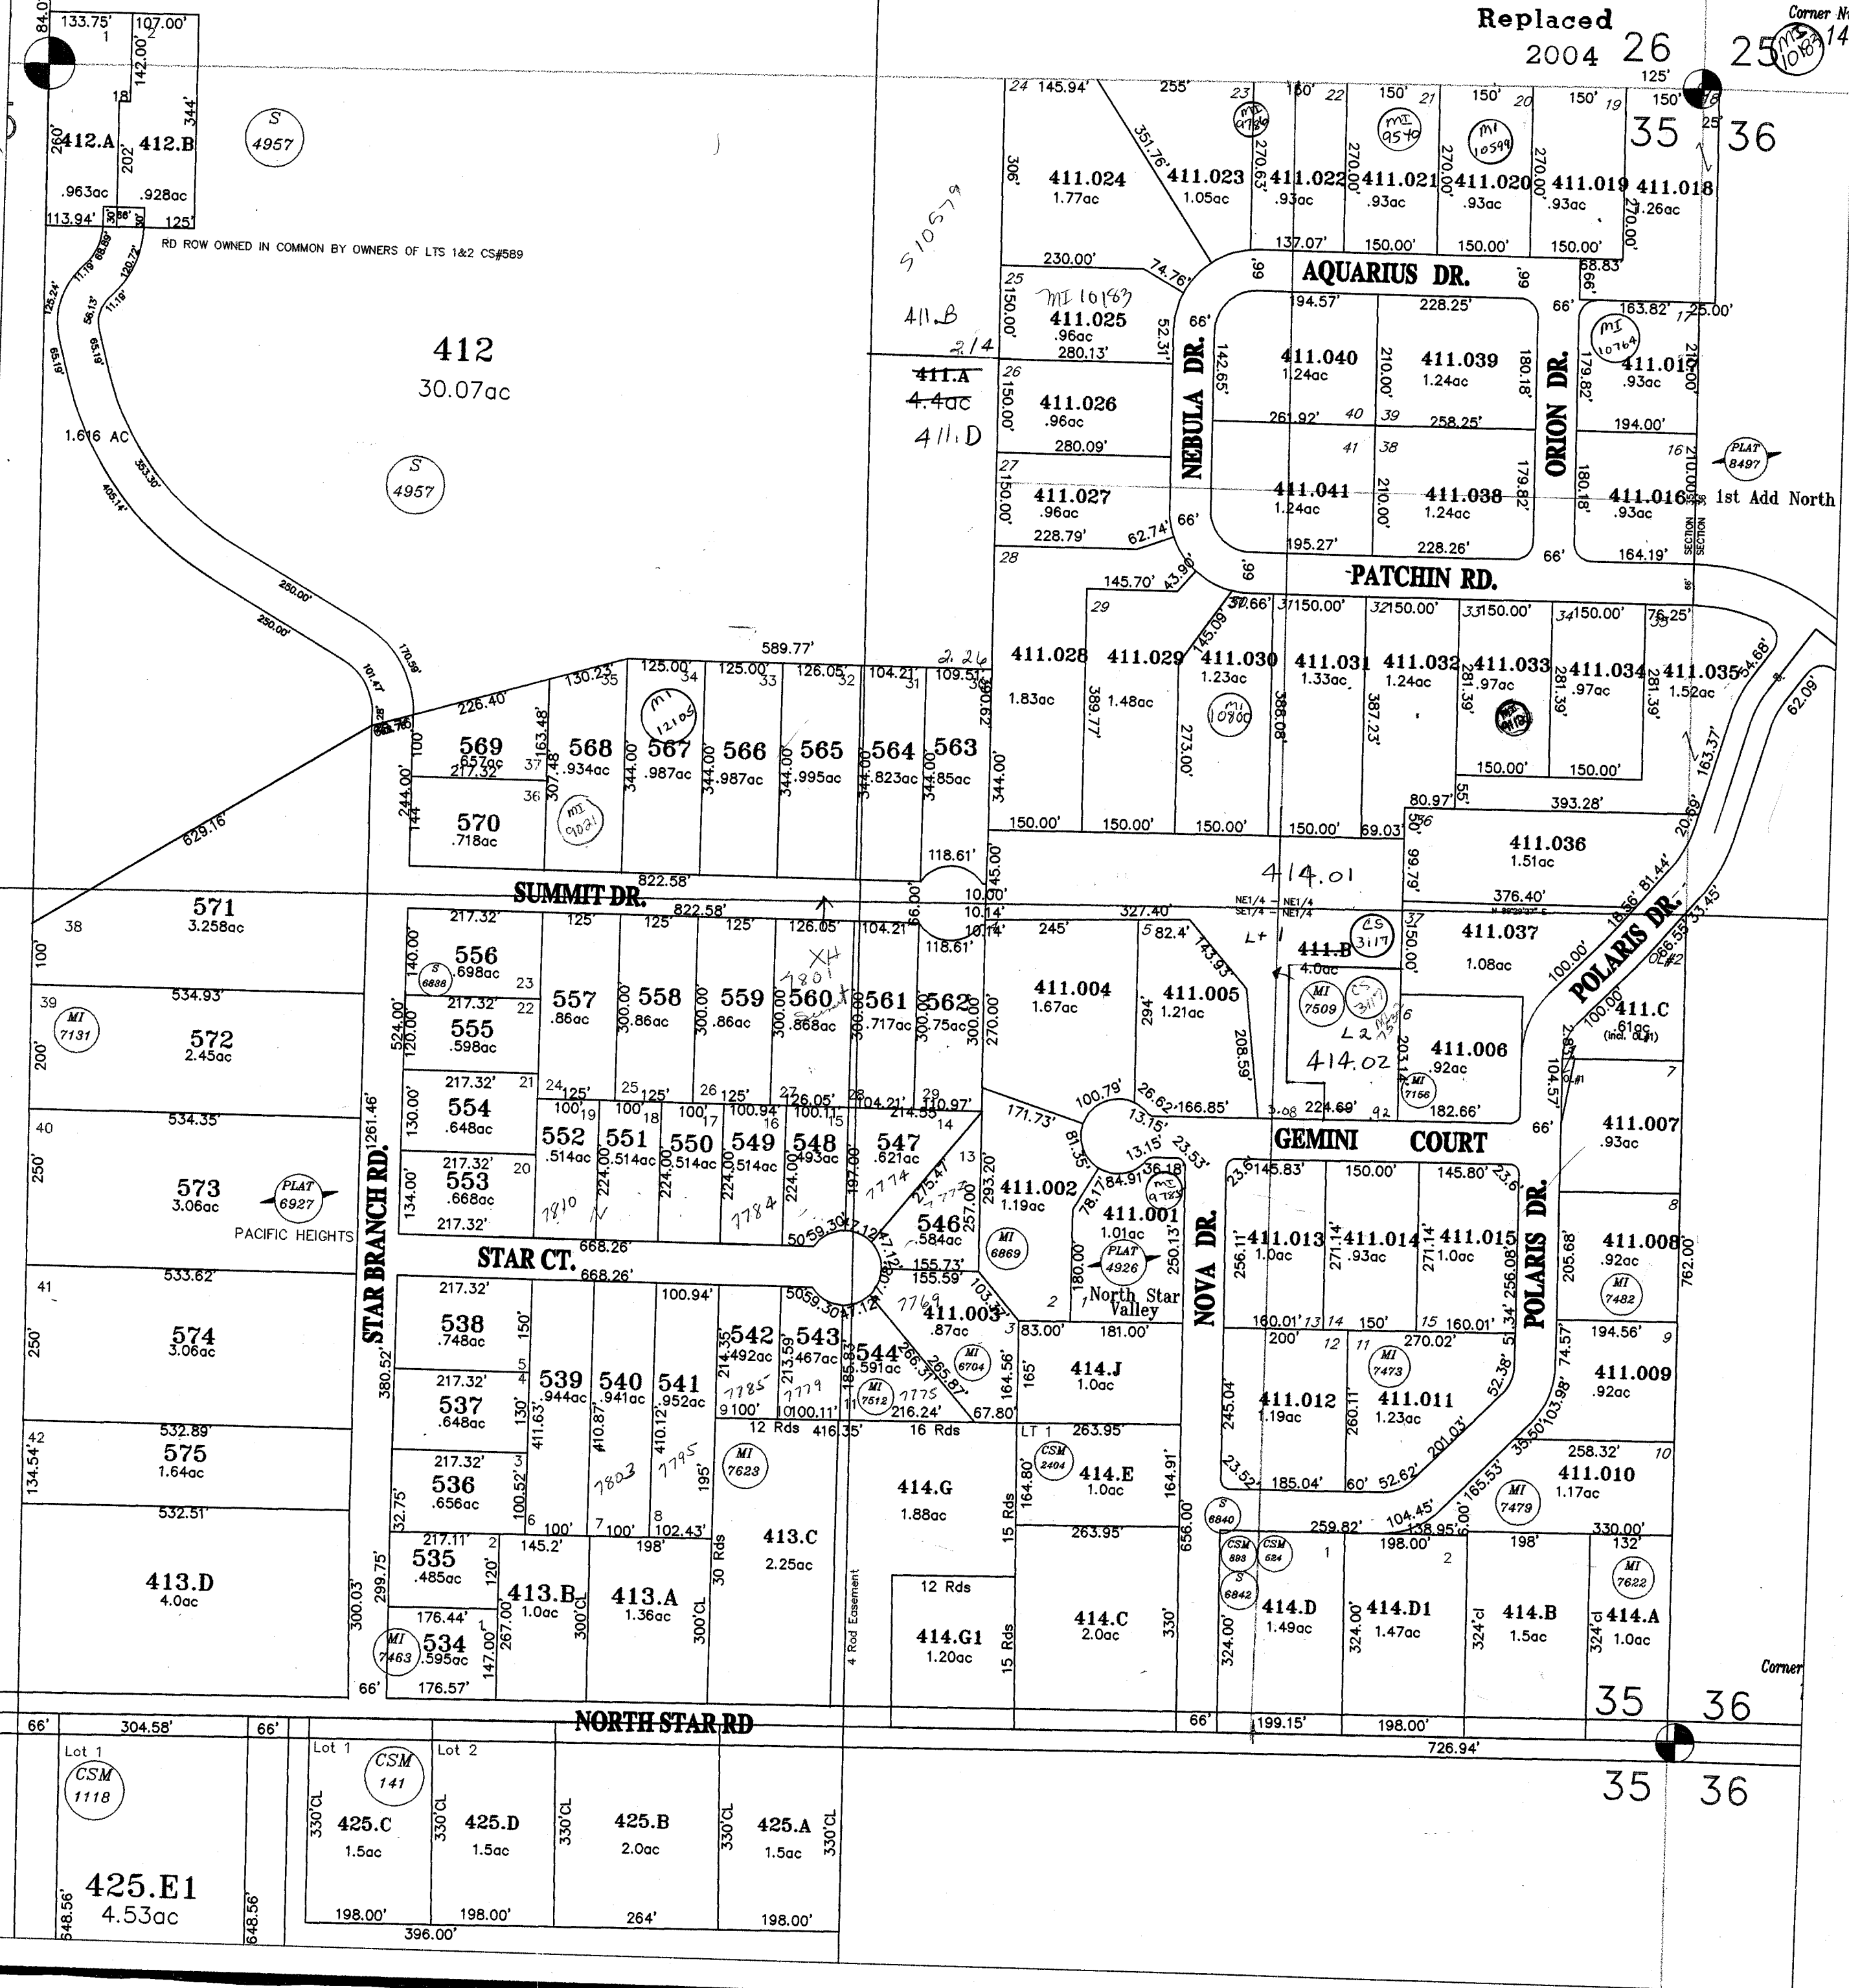

- ...Plat on File
- ...Survey on File
- ...Certified Survey Map
- ...Mortgage Inspection on
- ...Monumented Section


NOTE: This map was prepared for assessment purposes in accordance with Wis. Stat. Chap. 70.01. All information contained herein is advisory. Map accuracy is limited to the quality of data obtained from other Public Records. This is not intended to be a substitute for a field survey. Public Land Survey Base is derived from U.S.G.S. Topographic Maps unless otherwise noted. Other source of Land Base may be survey data.

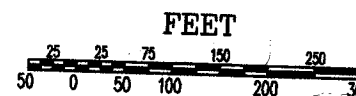


affid
N 2 1/2 NW 1/4
to show title
R 260-470
R 260-471

PACIFIC
SEC. 36 T. 12N. R. 9E.

Replaced
2004

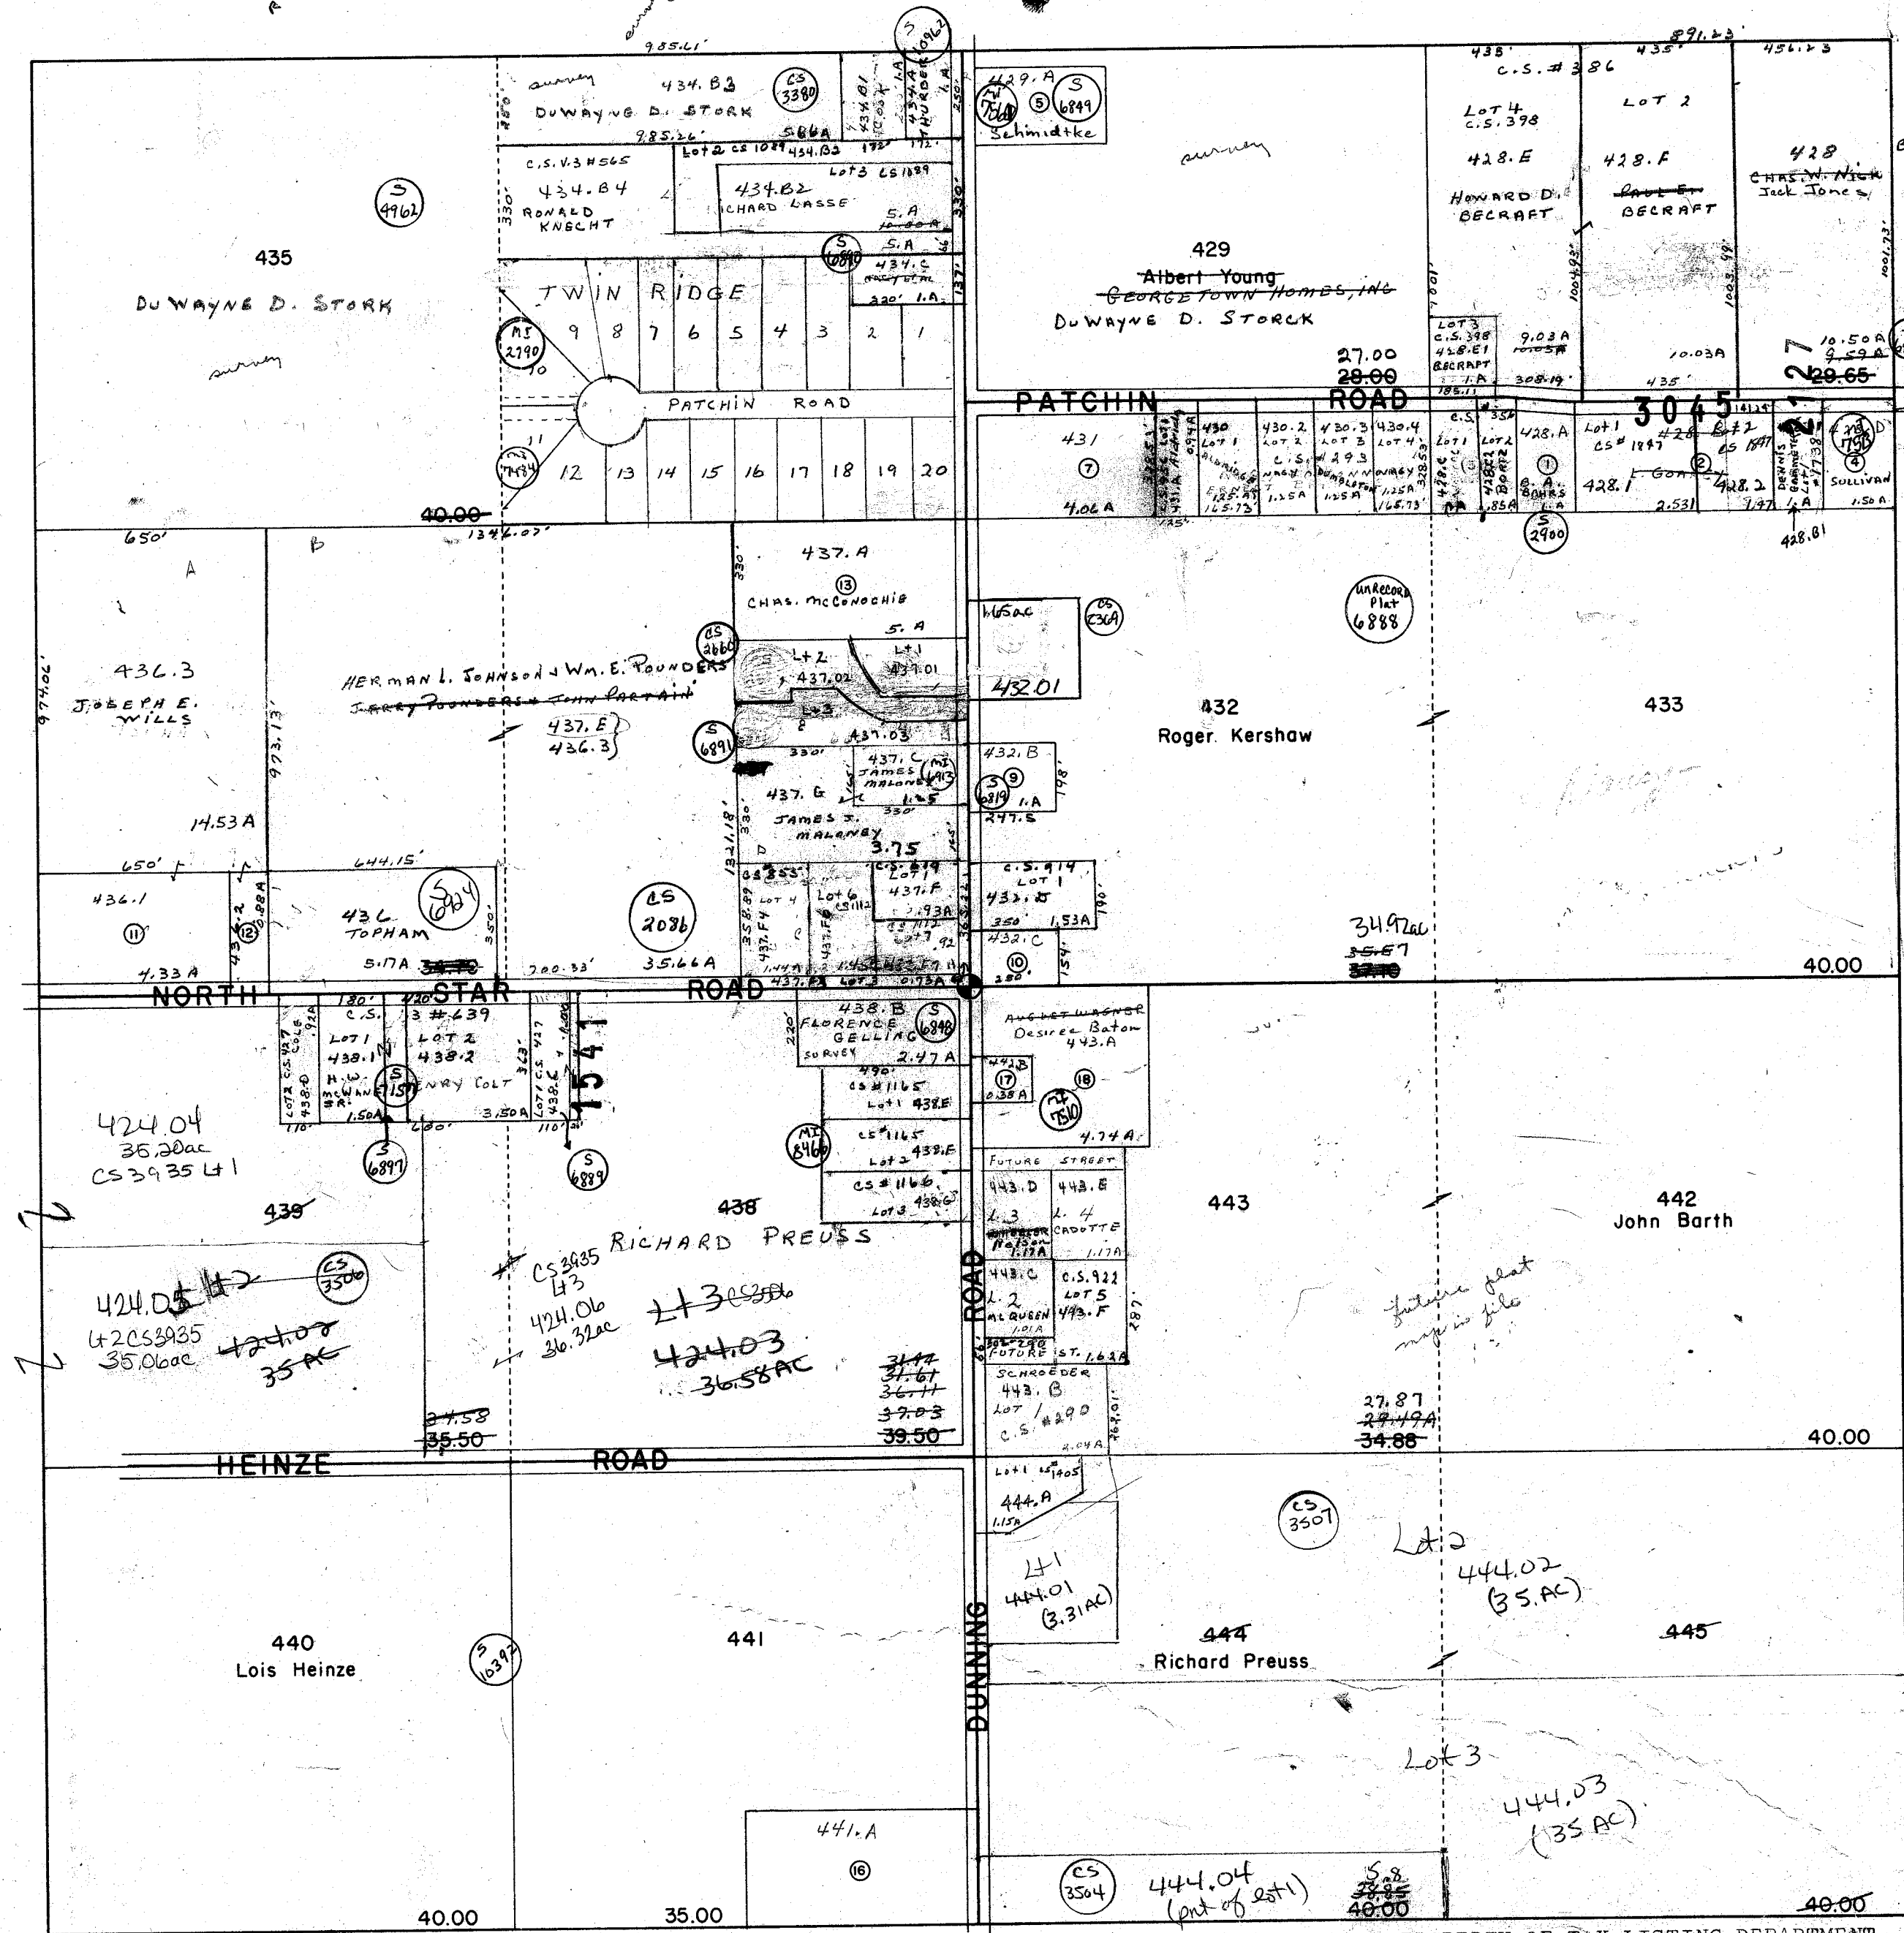

- 1-428.A
Atvin Storchman 1.00A
BRADLEY A. BARRS & TONI L.
- 2-428.B
Lewis Gookley 6.00A 5.00
- 3-428.C
NAGY-D'CONNOR, JESSE
Orville Corning 1.85A
- 4-428.D
Robt. Sullivan 1.50A
- 5-429.A
Charles Janisch 2.00A
Schmidtke
- 6-430
430.2-430.3-430.4
Ernest Brandes 5.00A
- 7-431
Lowe Gohesky 5.00A
Patricia Gohesky
- 8-432.A
Roger Kershaw 1.00A
- 9-432.B
Richard Aylward 1.00A
- 10-432.C
FRANCIS SMITH 0.90A
- 11-436.1
Joseph Wills 4.33A
- 12-436.2
Joseph Wills 0.88A
- 13-437.A
Charles McConochie 5.00A
- 14-437.B
Thomas Butler 2.65A
(2-Plots)
- 15-438.A & 439.A
Henry Colt 5.60A
438.A + 439.A
- 16-441.A
June Heinze 5.00A
- 17-442.B
Norman Simerson 0.38A
- 18-443.A
August Wagner 4.74A
- 432.D 1.53A
Byron Kershaw

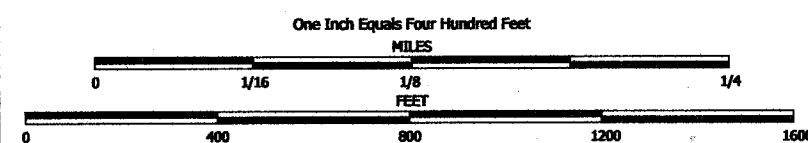


NOTE: This map was prepared for assessment use in accordance with the Wis. Stat. Chap. 70.09. All information contained herein is advisory only. Map accuracy is limited to the quality of data obtained from other public records. This map is not intended to be a substitute for an actual field survey. Public Land Survey Base is derived from U.S.G.S. Topographic maps unless otherwise noted. Other sources of the Land Base may be actual survey data. Base map data is from the April 1995 County Digital Orthophotos and/or U.S.G.S. 1:24,000 scale Topographic series. The user is responsible for the improper use of the data contained herein.

Created by The Columbia County Land Information Office -GIS Section, VMB, July 2004.

TAX PARCEL MAP

TOWN of PACIFIC

TOWN 12 NORTH RANGE 9 EAST
COLUMBIA COUNTY, WISCONSIN

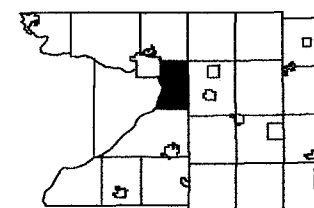


3	2	1
10	11	12
15	14	13
22	23	24
27	26	25
32	34	35

Replaced

2005

-SEE SECTION 25-

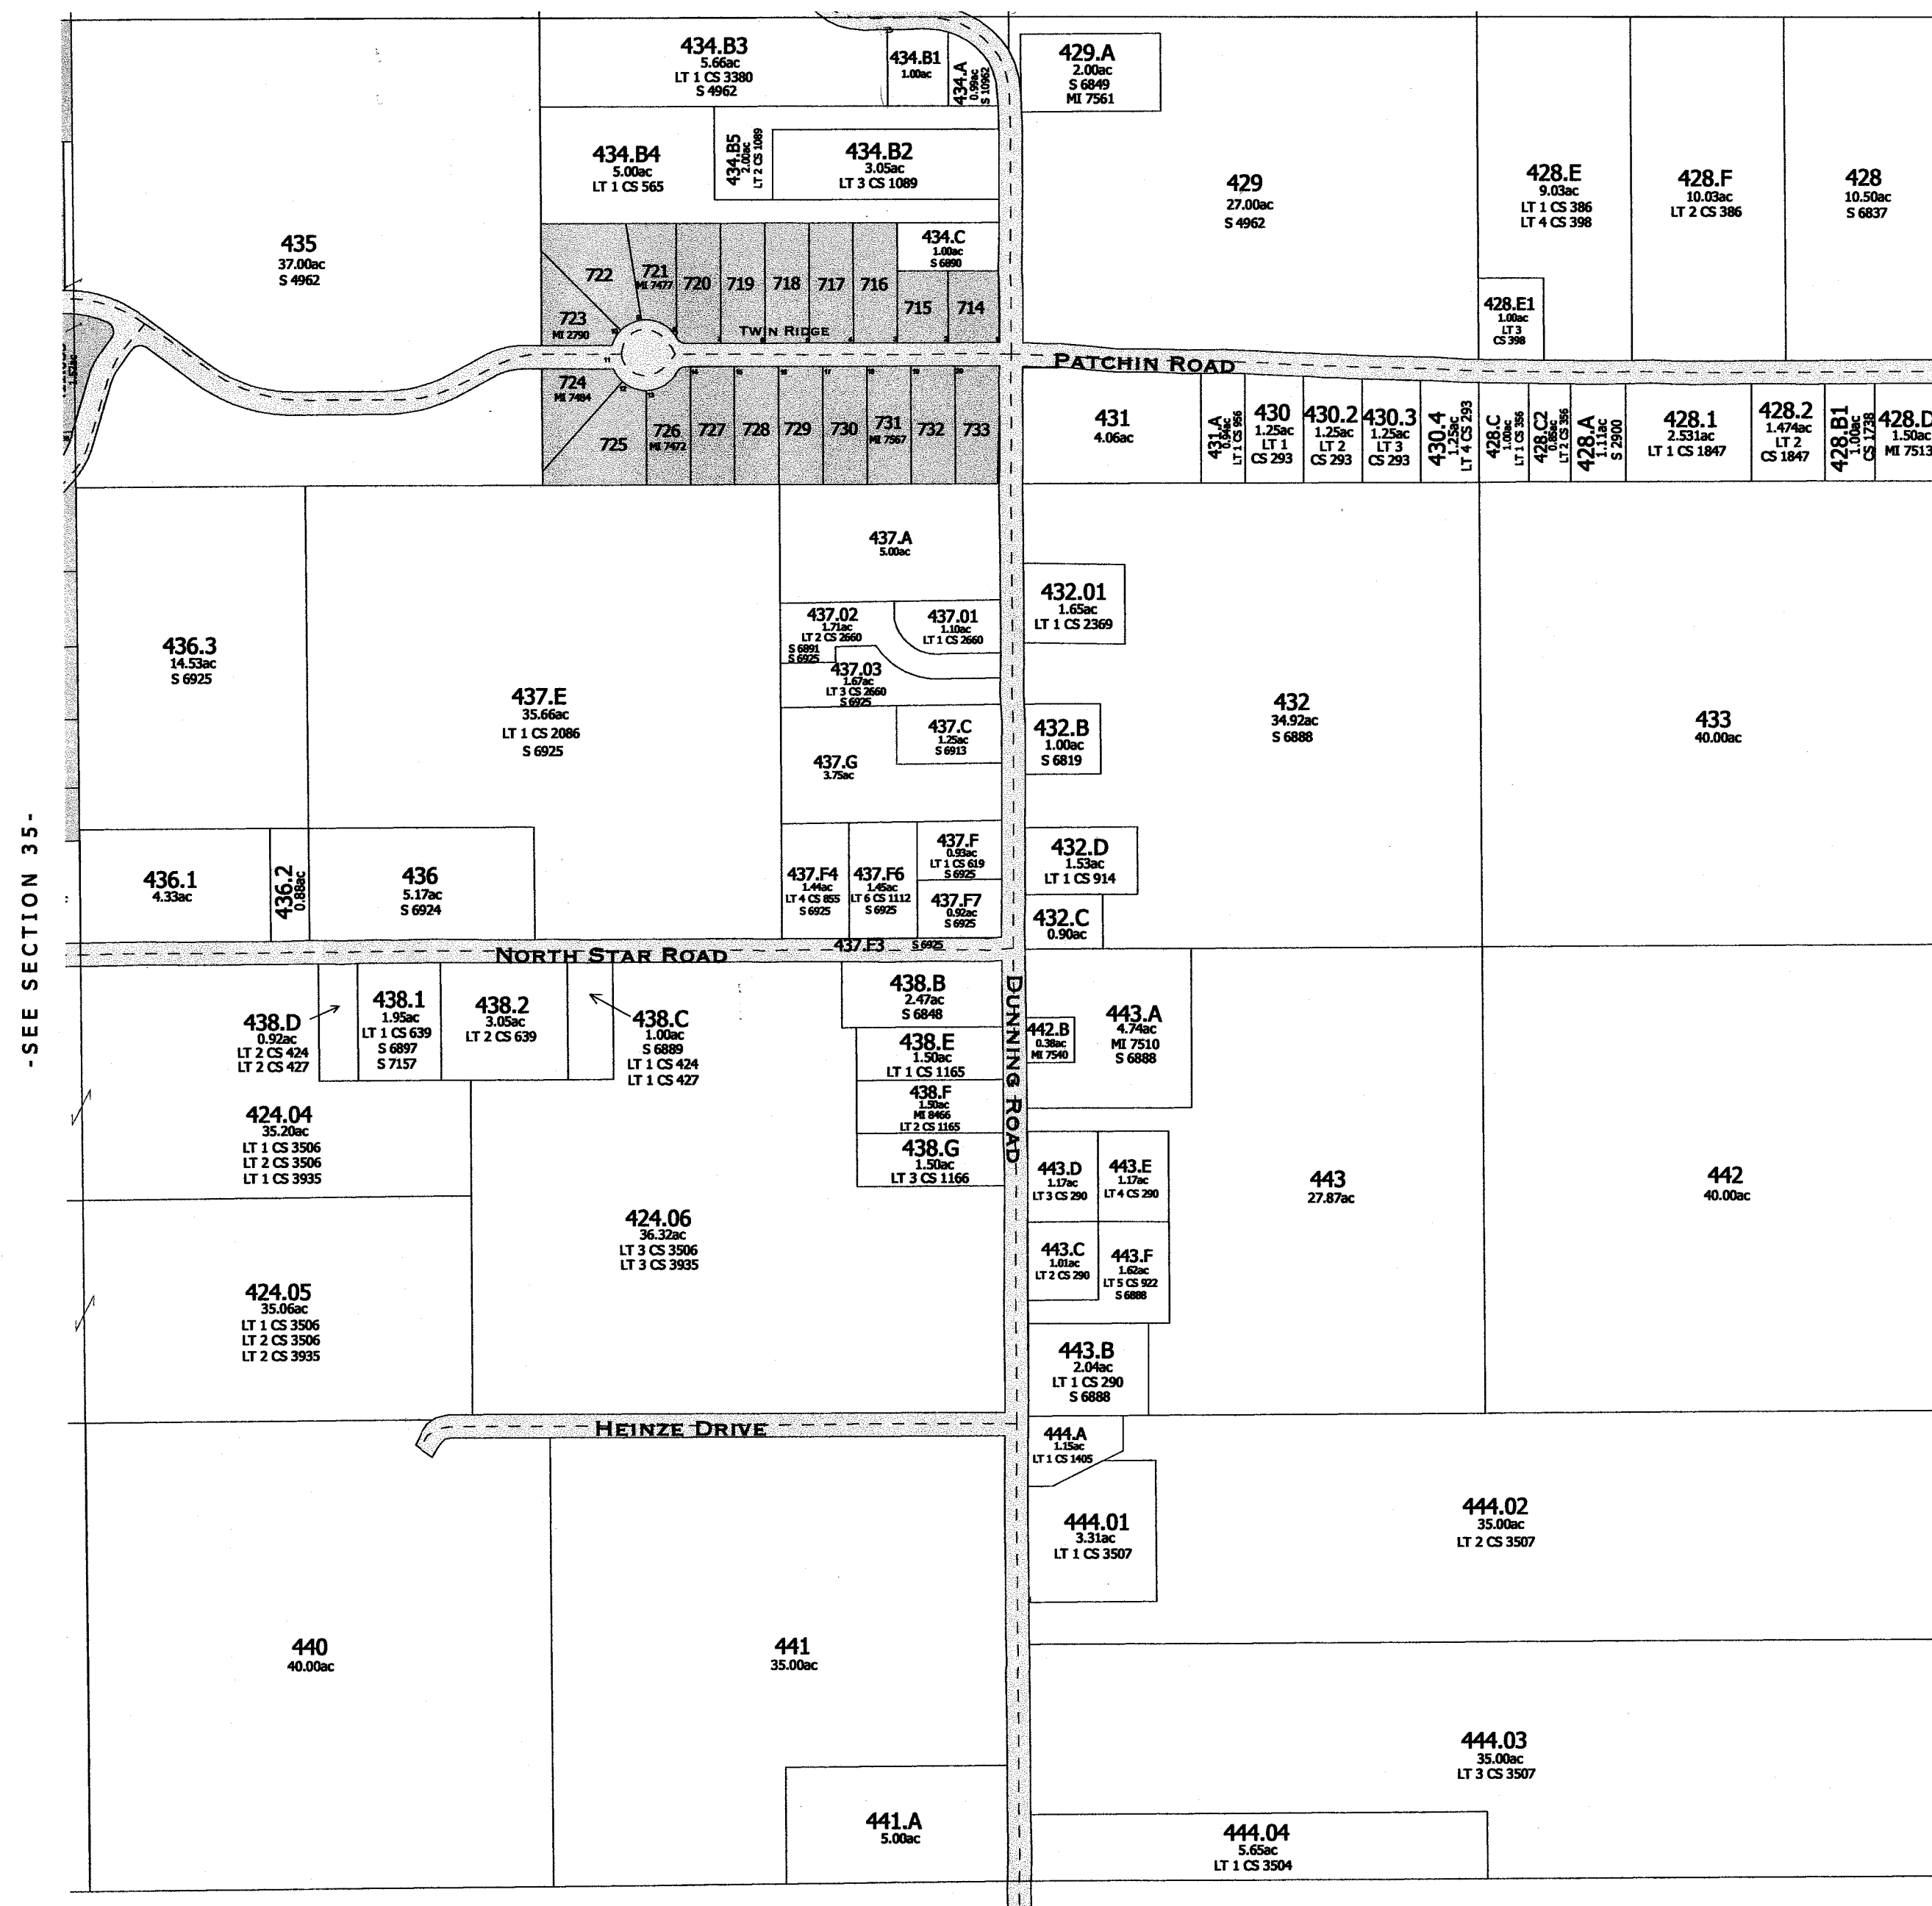

-SEE SECTION 35-

TOWN OF WYOCENA

TOWN OF DEKORRA

TWIN RIDGE - S6911

-SECTION 36-

Replaced
2005

CURVE	DELTA	RADIUS	ARC	CHORD	CHORD RECORDED AS
A	24°11'40"	375.00'	158.35'	N54°11'W, 157.18'	
B	14°58'	355.00'	92.70'	N21°11'W, 92.44'	N20°07'W, 107.41'
C	65°25'	87.63'	100.05'	N41°29'W, 94.71'	N44°55'45"W, 85.68'
D	44°50'	62.54'	48.94'	N67°42'E, 47.70'	
E	41°34'	64.82'	47.02'	N24°30'E, 46.00'	
F	56°04'	45.77'	44.79'	N29°48'W, 43.02'	

THE FOREST AT SWAN LAKE VILLAGE CONDOMINIUM



COLUMBIA COUNTY, WISCONSIN

PHASE I

Replaced
2004

I, Mark C. Carlson, registered land surveyor, hereby certify that I have surveyed the described parcels, that this plat is a correct representation of the exterior boundaries of the parcel described and the location of the buildings and driveways constructed or to be constructed as proposed at the date hereof and the identification and location of each unit and the common elements can be determined.


- () = recorded as
- SRE = Saddle Ridge Estates Condominium
- SR = Saddle Ridge Condominium
- SLV = Swan Lake Village
- Ph = Phase
- P = Parcel
- AM. = Amended
- FSLV = Forest at Swan Lake Village Condominium

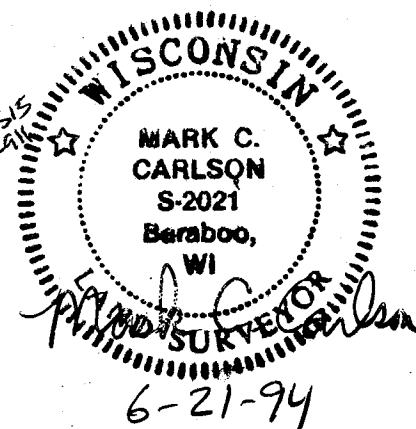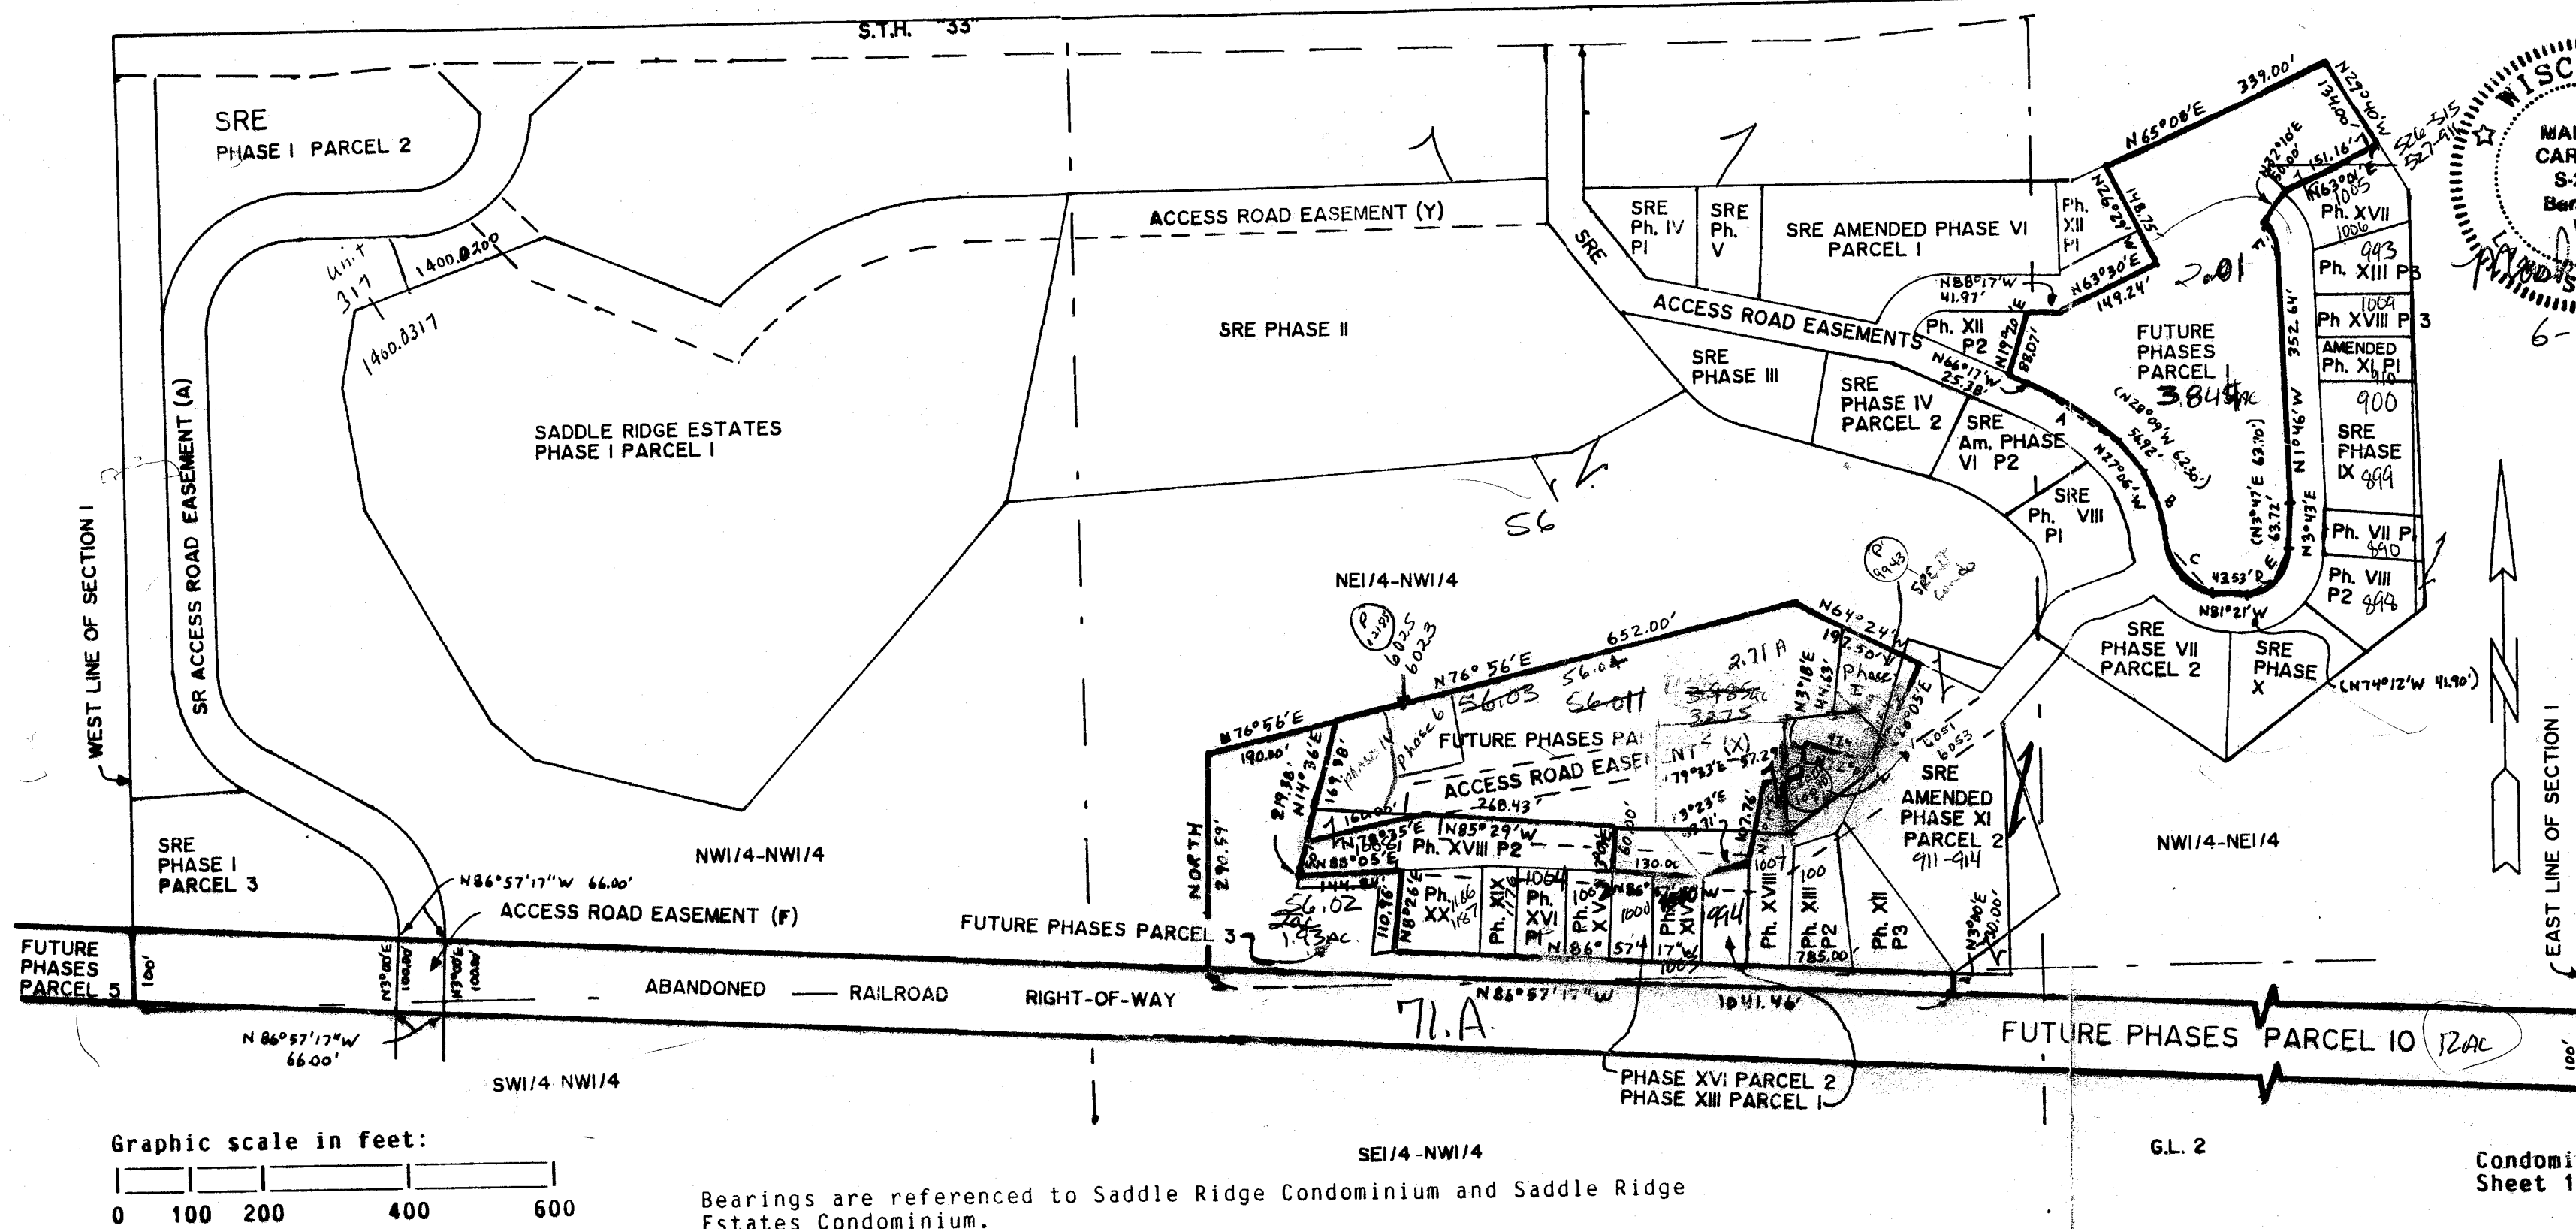

Replaced
2004

THE FOREST AT SWAN LAKE VILLAGE
CONDOMINIUM
COLUMBIA COUNTY, WISCONSIN
PHASE I

I, Mark C. Carlson, registered land surveyor, hereby certify that I have surveyed the described parcels, that this plat is a correct representation of the exterior boundaries of the parcel described and the location of the buildings and driveways constructed or to be constructed as proposed at the date hereof and the identification and location of each unit and the common elements can be determined.

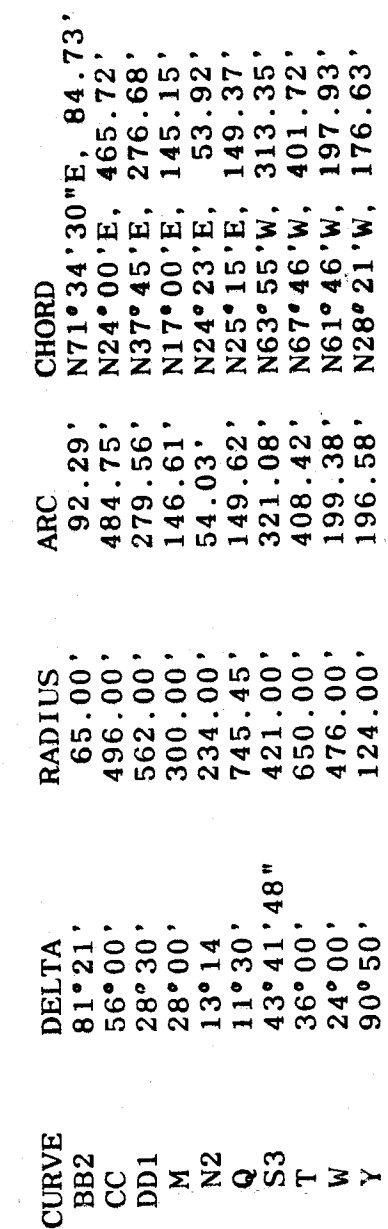



Condominium Plat
Sheet 2 of 7 sheets

[illegible]

THE FOREST AT SWAN LAKE VILLAGE CONDOMINIUM

COLUMBIA COUNTY, WISCONSIN

PHASE I

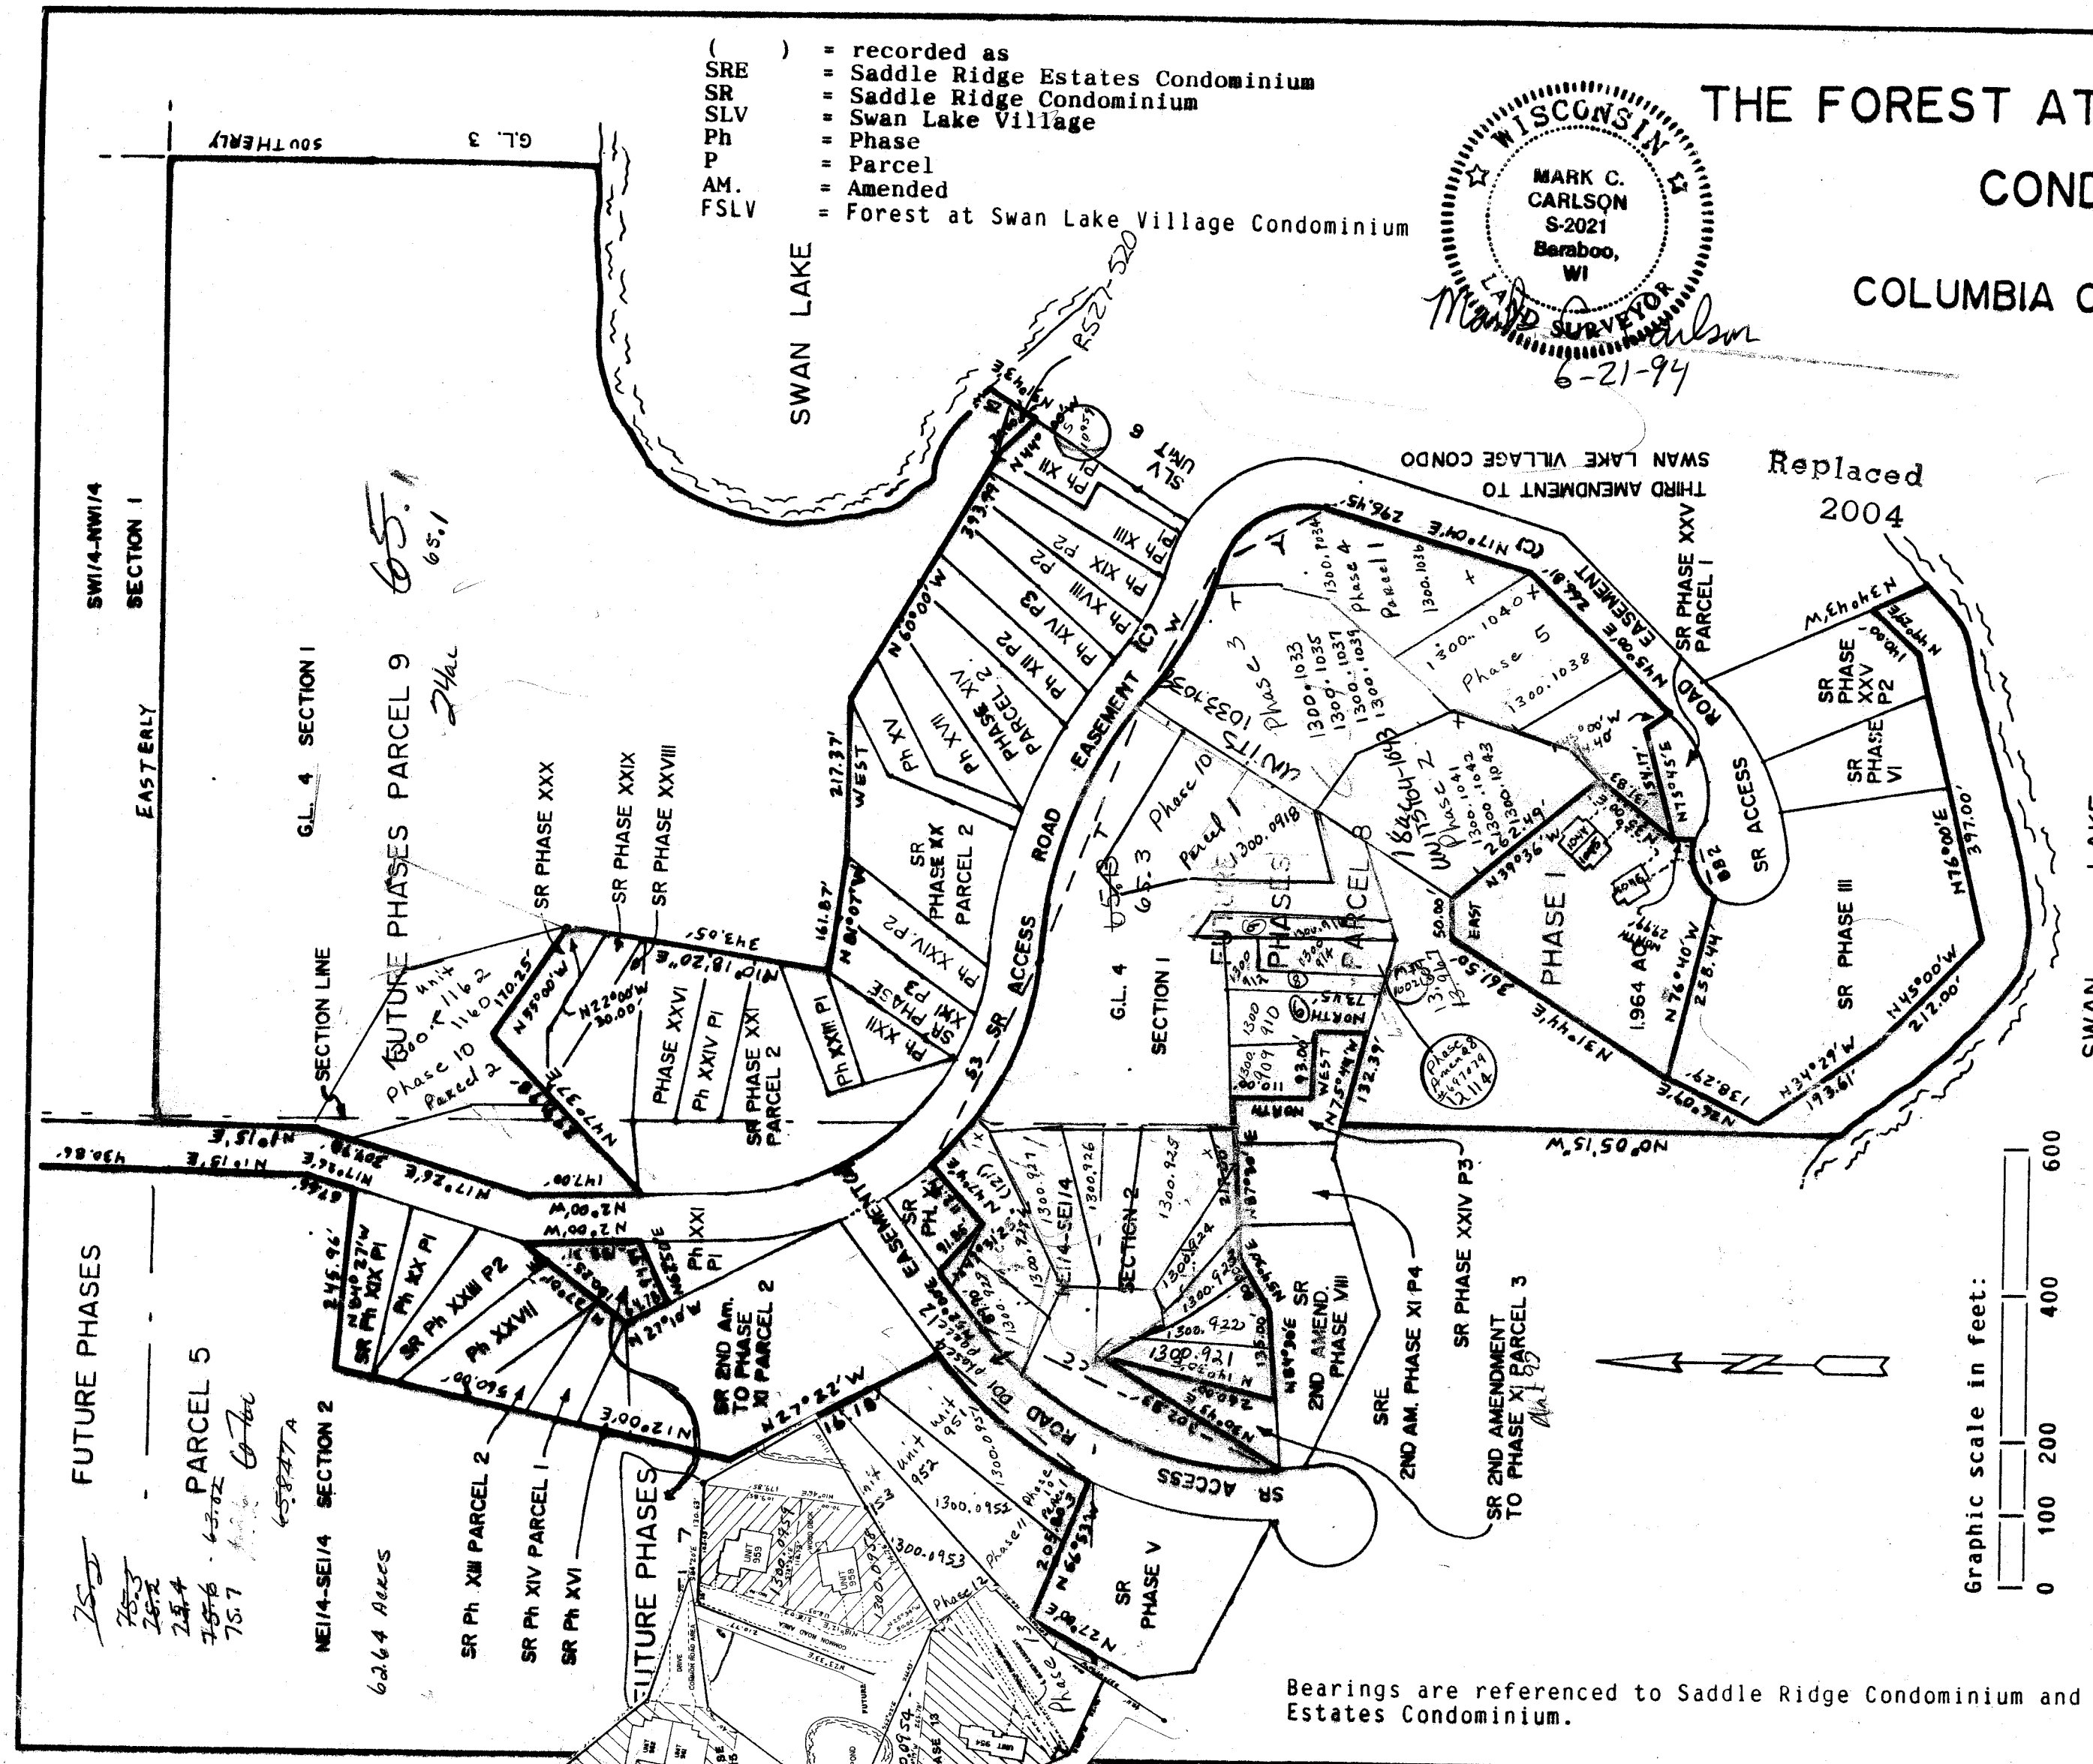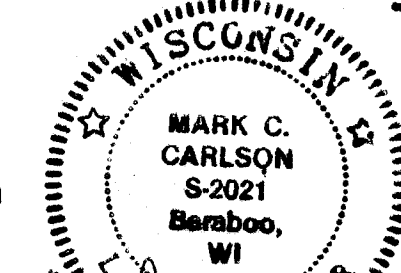


Bearings are referenced to Saddle Ridge Condominium and Saddle Ridge Estates Condominium.

I, Mark C. Carlson, registered land surveyor, hereby certify that I have surveyed the described parcels, that this plat is a correct representation of the exterior boundaries of the parcel described and the location of the buildings and driveways constructed or to be constructed as proposed at the date hereof and the identification and location of each unit and the common elements can be determined.

An agreement has been signed by Mark Carlson and Lee Gosda to exclude certain requirements of A-E 7, Wisconsin Administrative Code, namely setting monuments at the corners of the parcel described.

Condominium Plat
Sheet 3 of 7 sheets

CURVE	DELTA	RADIUS	ARC	CHORD
BB2	81° 21'	65.00'	92.29'	N71° 34' 30"E, 84.73'
CC	56° 00'	496.00'	484.75'	N24° 00'E, 465.72'
DD1	28° 30'	562.00'	279.56'	N37° 45'E, 276.68'
M	28° 00'	300.00'	146.61'	N17° 00'E, 145.15'
N2	13° 14'	234.00'	54.03'	N24° 23'E, 53.92'
Q	11° 30'	745.45'	149.62'	N25° 15'E, 149.37'
S3	43° 41' 48"	421.00'	321.08'	N63° 55'W, 313.35'
T	36° 00'	650.00'	408.42'	N67° 46'W, 401.72'
W	24° 00'	476.00'	199.38'	N61° 46'W, 197.93'
Y	90° 50'	124.00'	196.58'	N28° 21'W, 176.63'

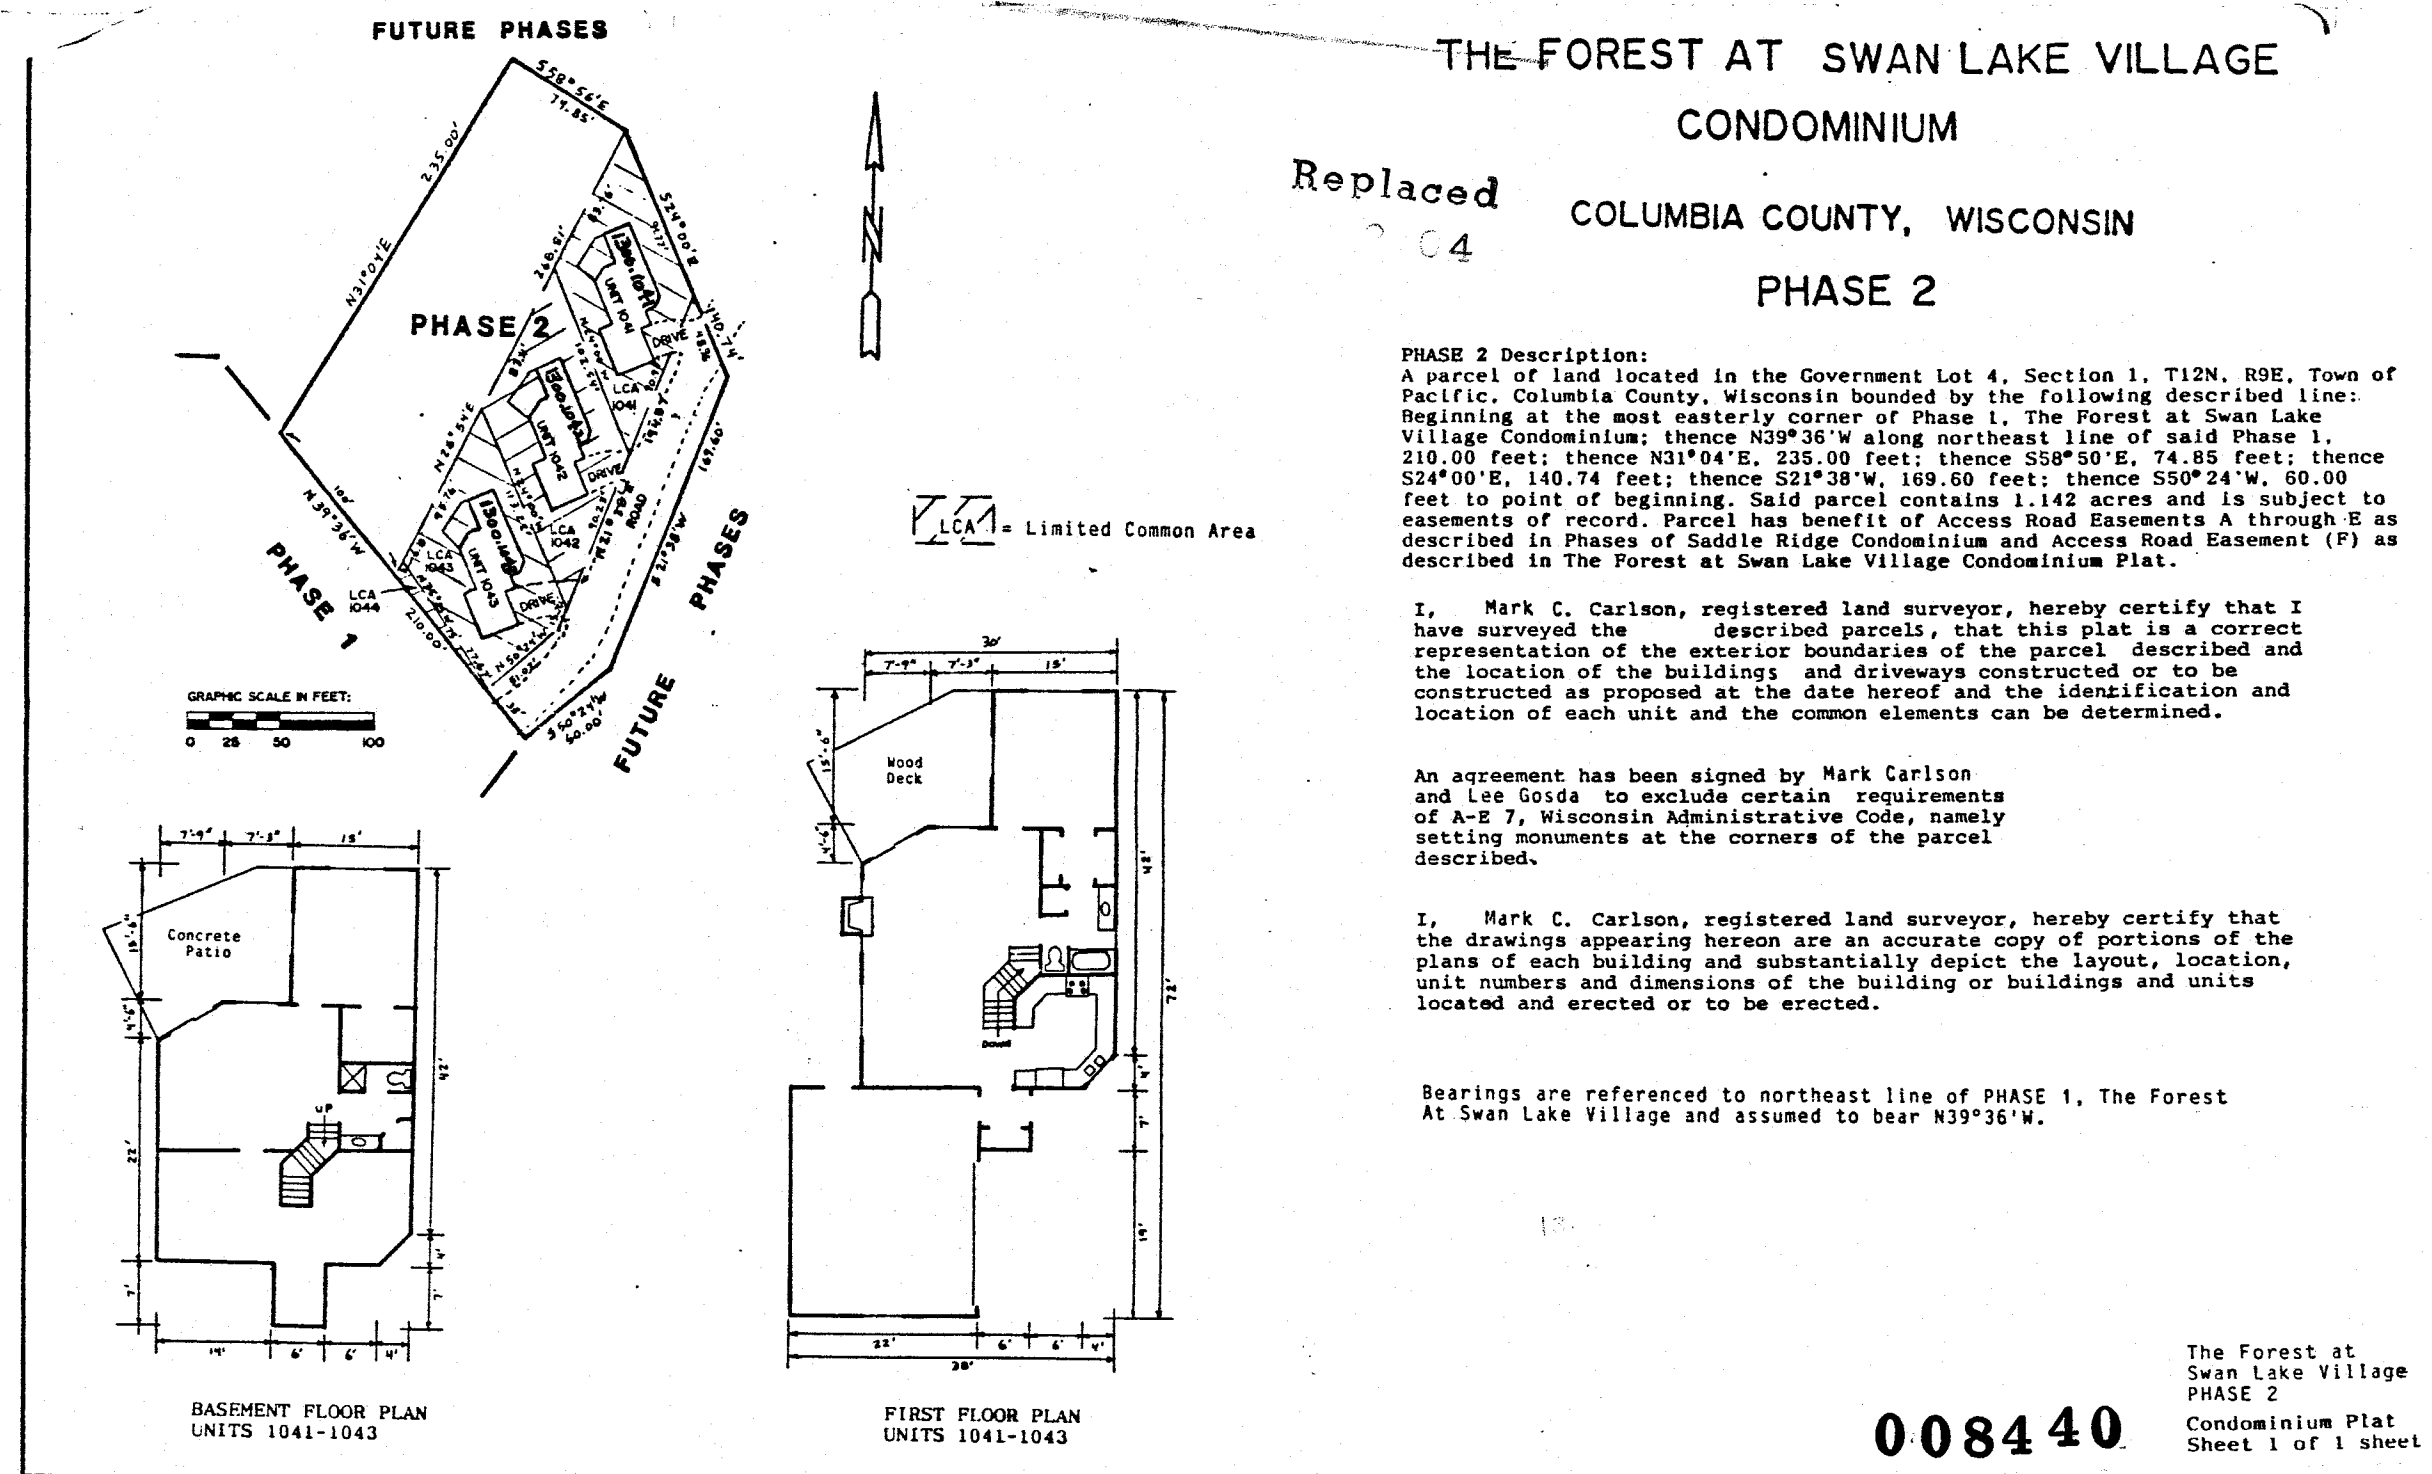

off 65.B

unit 1043 - 1300.1043
unit 1042 - 1300.1042
unit 1041 - 1300.1041


Fore
F

556330

THE FOREST AT SWAN LAKE VILLAGE CONDOMINIUM

Replaced
2004

COLUMBIA COUNTY, WISCONSIN
PHASE 3

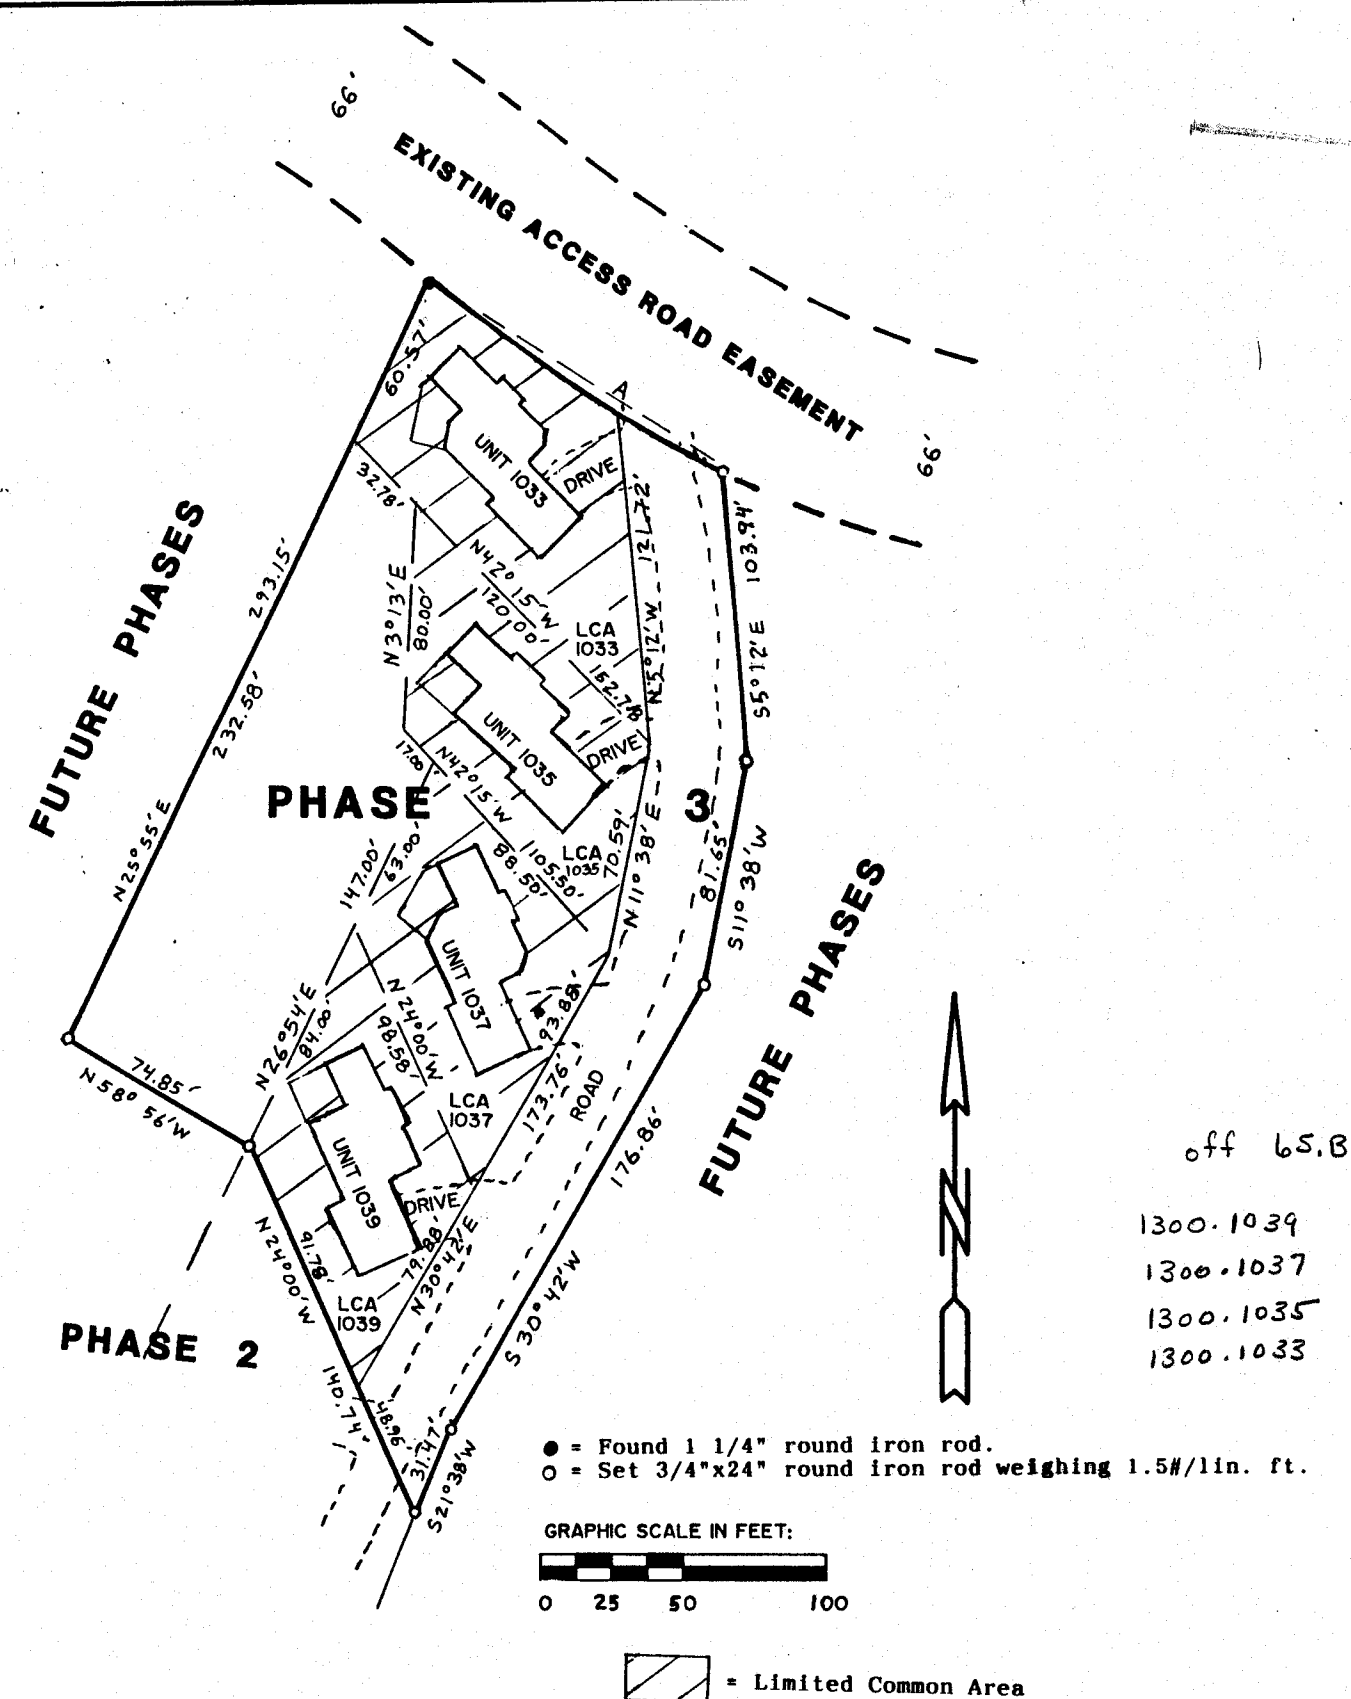


PHASE 3 DESCRIPTION:

A parcel of land located in Government Lot 4, Section 1, T12N, R9E, Town of Pacific, Columbia County, Wisconsin bounded by the following described line: Beginning at the most easterly corner of PHASE 2, The Forest at Swan Lake Village Condominium; thence N24°00'W along north line of said PHASE 2, 140.74 feet; thence N58°56'W along said north line, 74.85 feet; thence N25°55'E, 293.15 feet to southerly line of existing access road easement; thence easterly on a curve to the left, radius 476.00 feet, whose chord bears S57°06'30"E, 121.64 feet; thence S5°12'E, 103.94 feet; thence S11°38'W, 81.65 feet; thence S30°42'W, 176.86 feet; thence S21°38'W, 31.47 feet to point of beginning. Said parcel contains 1.265 acres and is subject to easements of record. Parcel has benefit of Access Road Easements A through E as described in Phases of Saddle Ridge Condominium and Access Road Easement (F) as described in the The Forest at Swan Lake Village Condominium Plat.

I, Mark C. Carlson, registered land surveyor, hereby certify that I have surveyed the above described parcel, that this plat is a correct representation of the exterior boundaries of the parcel described and the location of the buildings and driveways constructed or to be constructed as proposed at the date hereof and the identification and location of each unit and common elements can be determined.

Bearings are referenced to northeast line of PHASE 2, The Forest at Swan Lake Village and assumed to bear N24°00'W.

CURVE A: Delta = 14°41'00", Radius = 476.00', Arc = 121.97'
Chord = S57°06'30"E, 121.64'

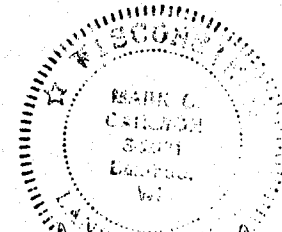

Mark C. Carlson
6-5-96

STATE OF WISCONSIN } SS
COLUMBIA COUNTY }
RECEIVED FOR RECORD

JUN 13 1996





Donny J. Hall

Reg. of Deeds at 2:25 PM


Vol 1 Page 206

The Forest at
Swan Lake Village
PHASE 3
Condominium Plat
Sheet 1 of 2 sheets

008439

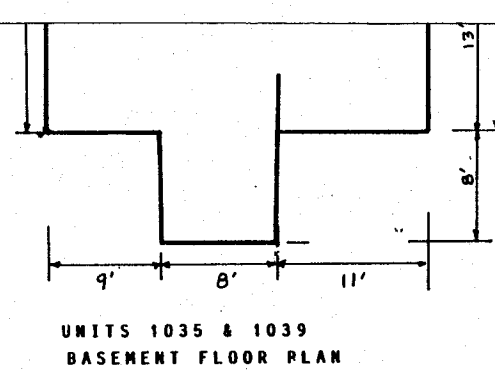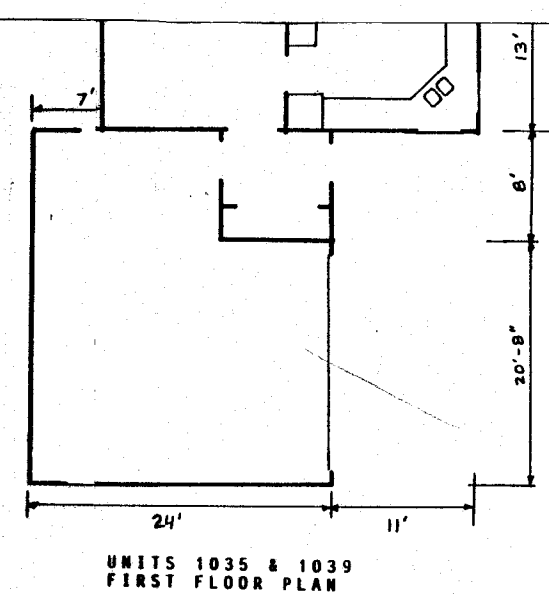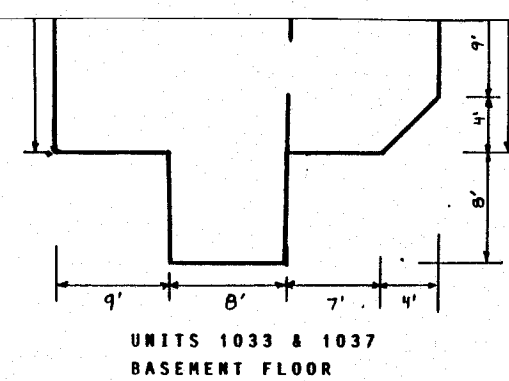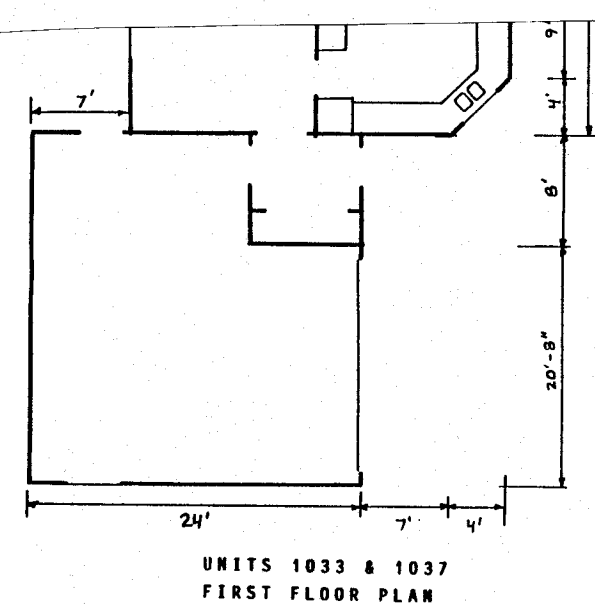

The Forest at
Swan Lake Village
PHASE 3
Condominium Plat
Sheet 2 of 2 sheets

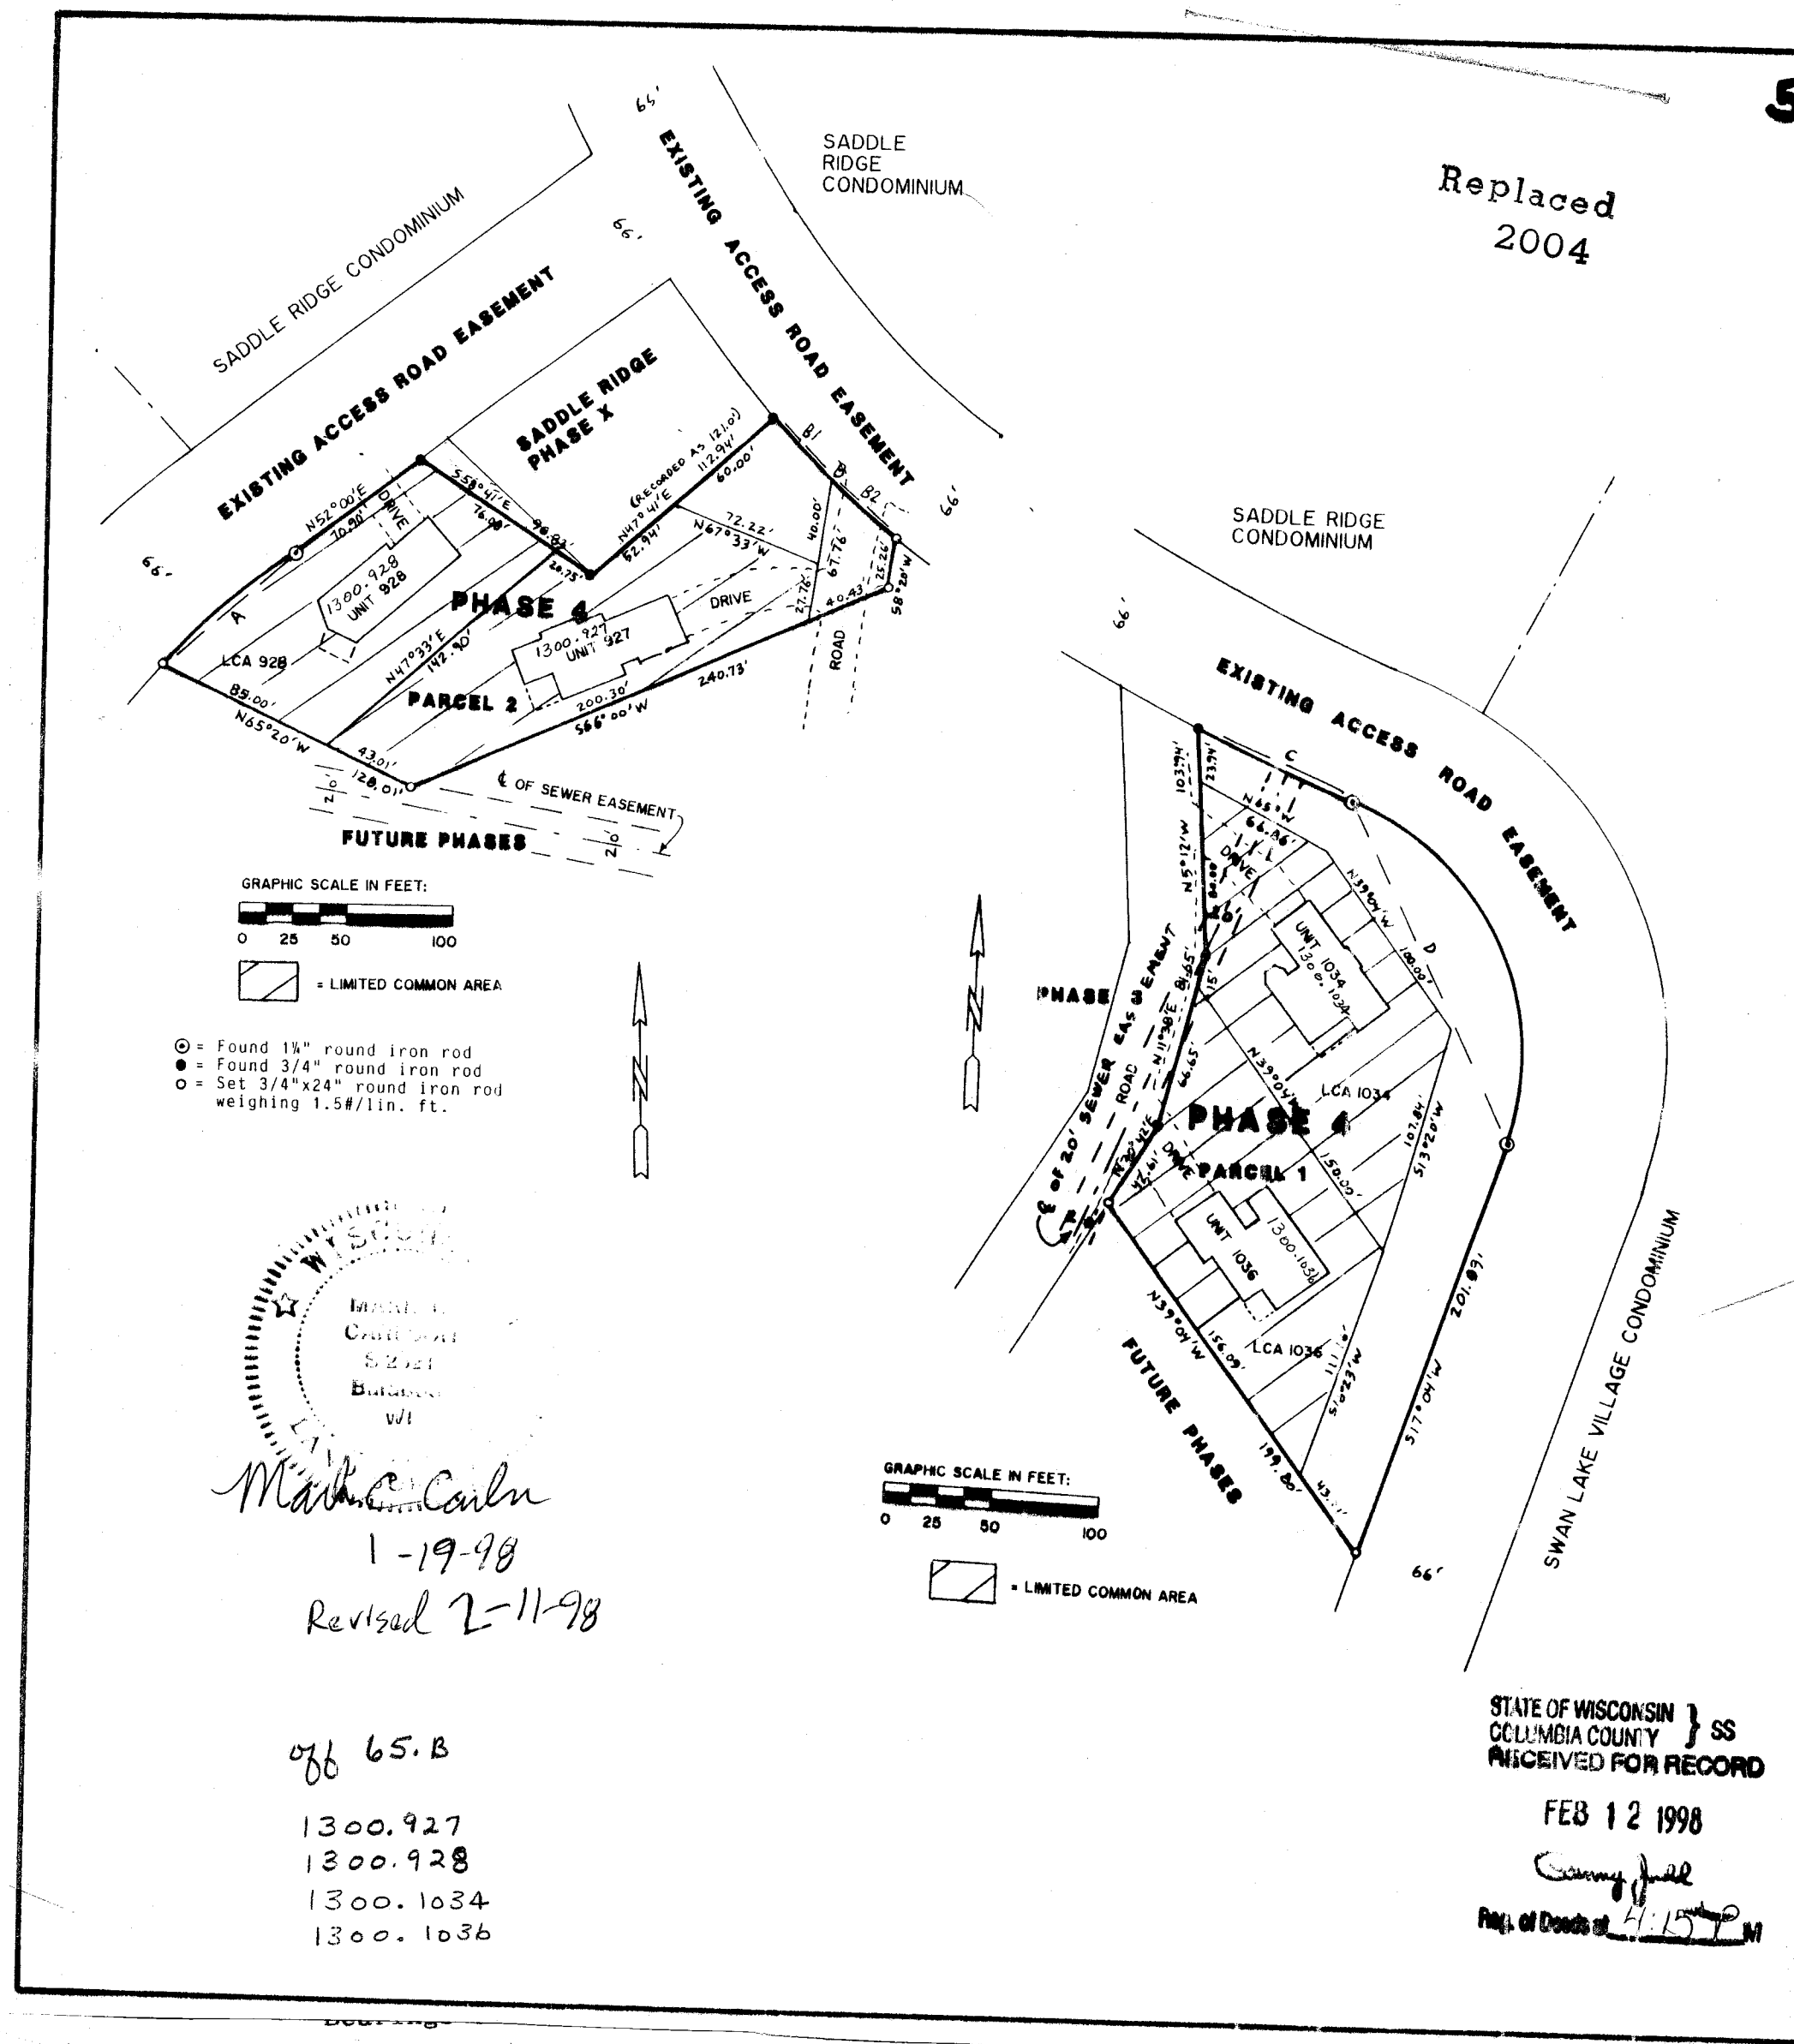

597051

THE FOREST AT S CONDOMINIUM


COLUMBIA COUNTY AMENDED PHASE 4

STATE OF WISCONSIN }
COLUMBIA COUNTY }
RECEIVED FOR RECORD

Replaced
2004

DEC 21 1998

Reg. of Deeds 1:55P

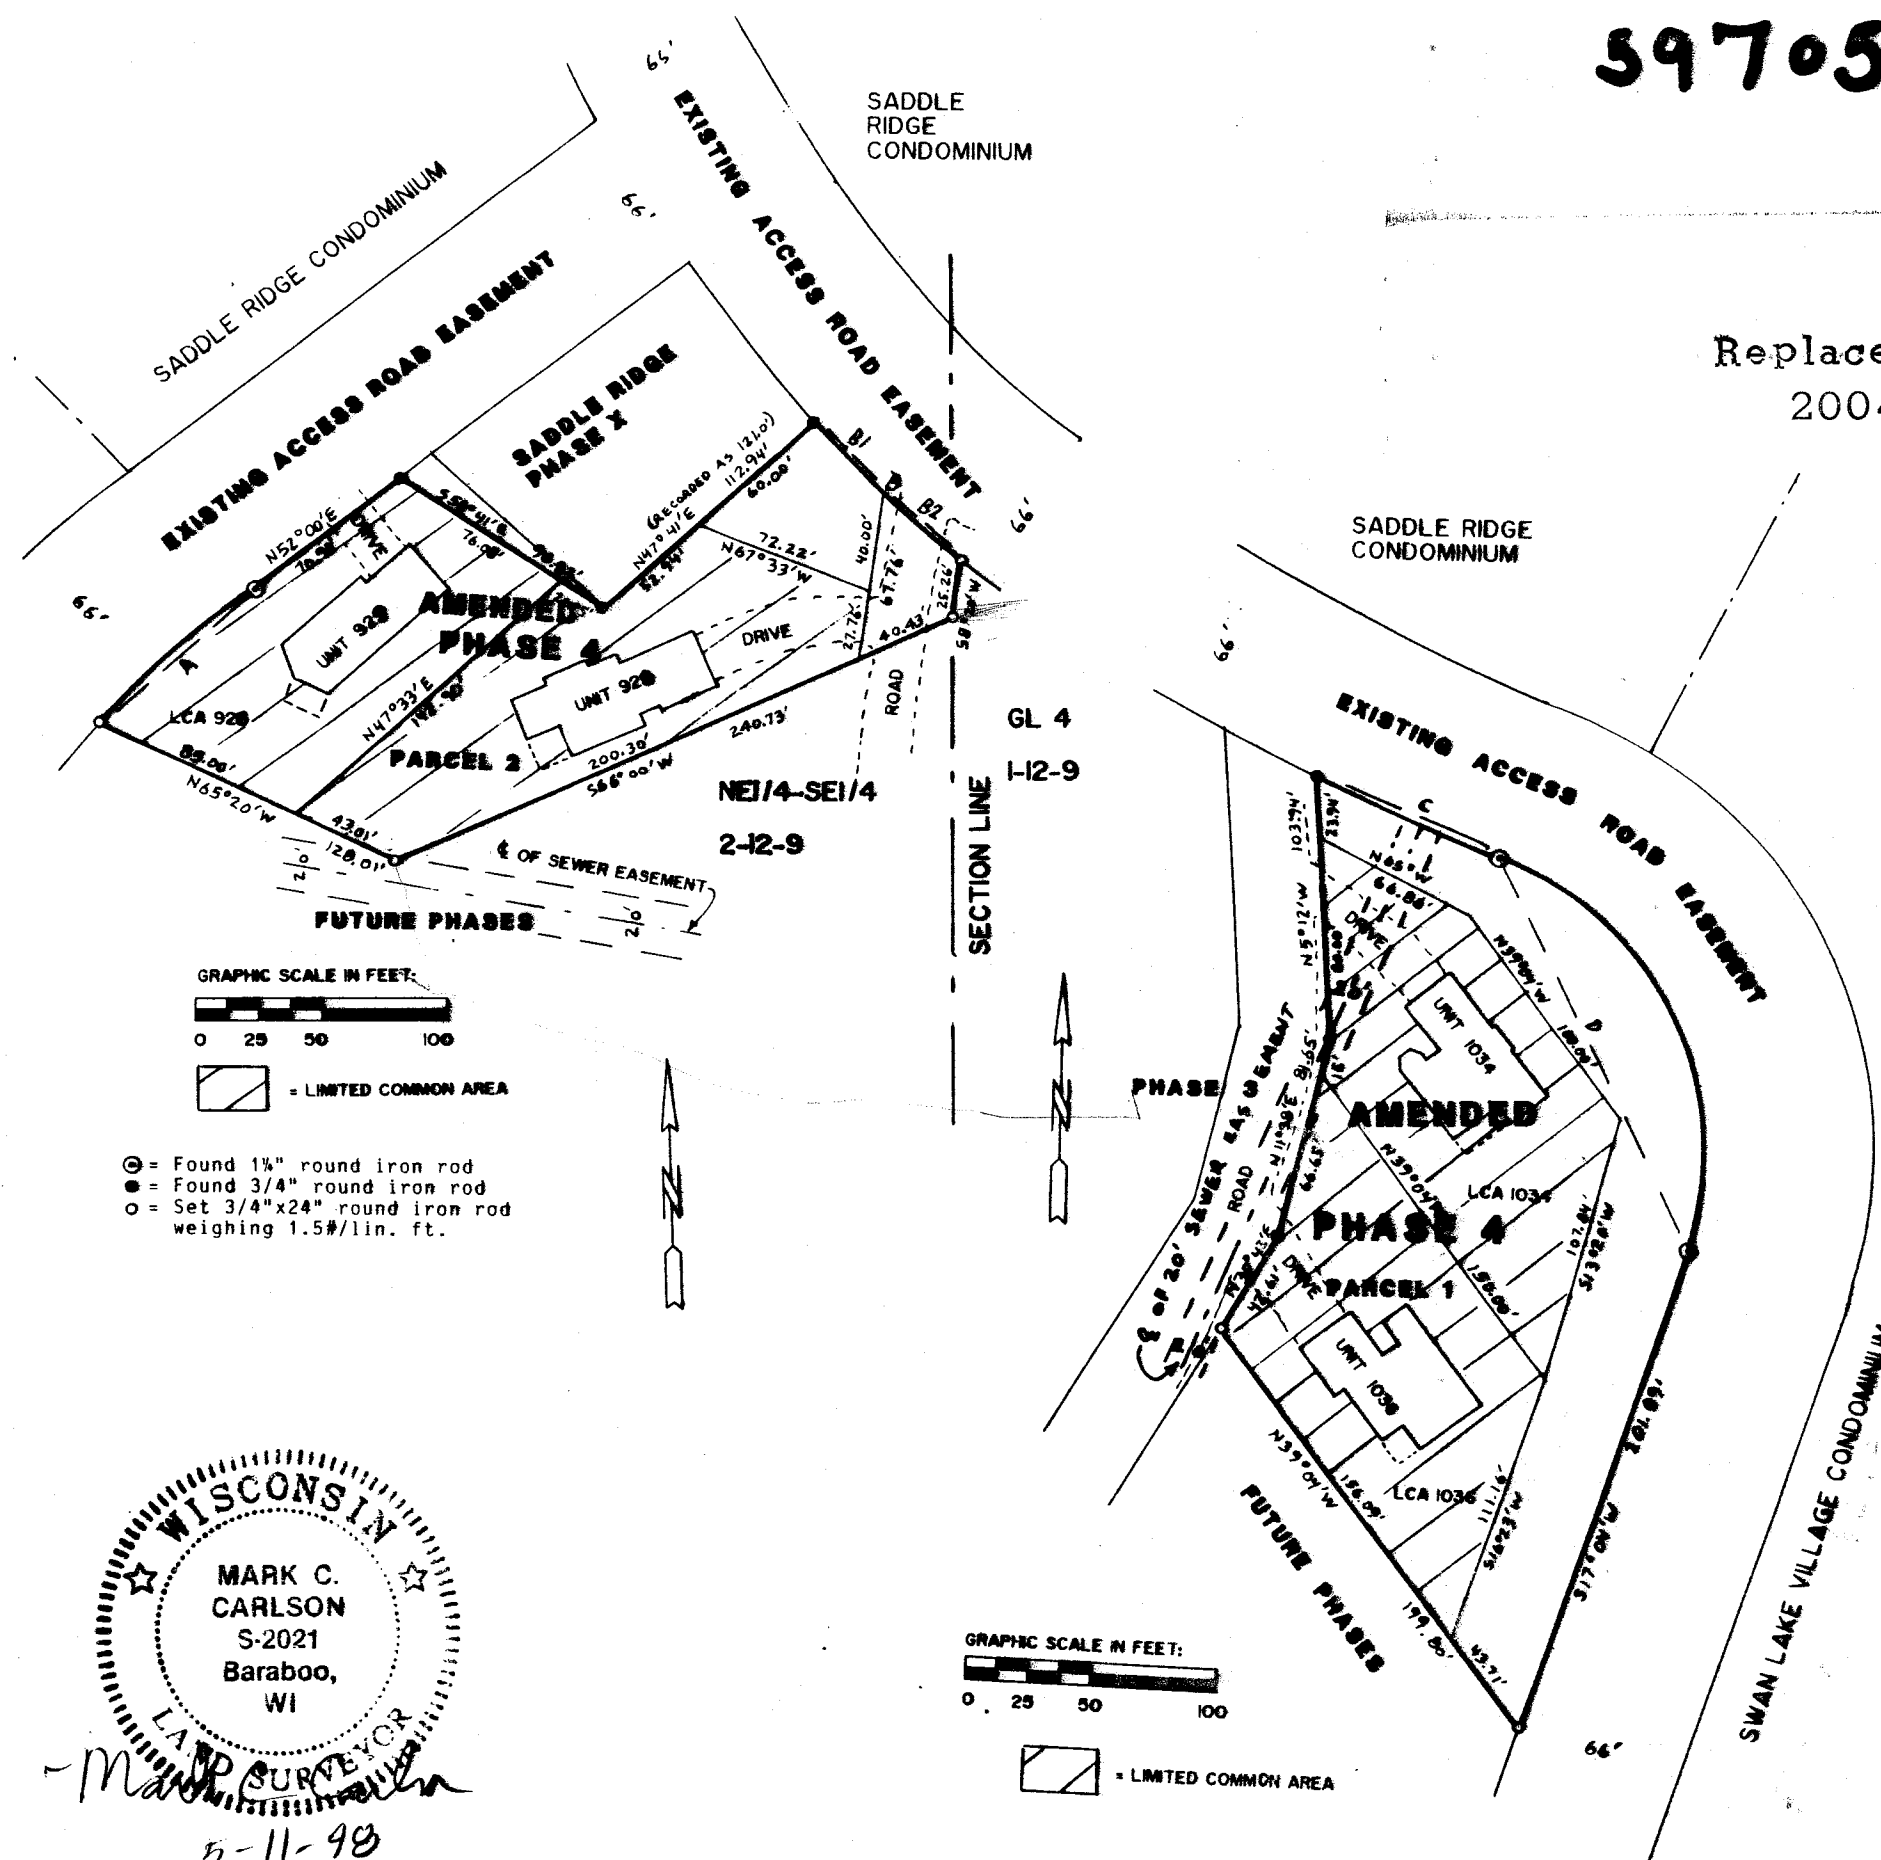

AMENDED PHASE 4 Parcel 1 DESCRIPTION:

A parcel of land located in Government Lot 4, Pacific, Columbia County, Wisconsin bounded by Beginning at the northeast corner of PHASE 3, Condominium; thence southeasterly on a curve to existing access road easement, radius 476.00 feet, S69°06'30"E, 77.32 feet; thence southeasterly said west line, radius, 124.00 feet, whose chord thence S17°04'W along said west line, 201.09 feet to west line of said Phase 3; thence N30°42'E, along said west line, 81.65 feet; thence N5°12' feet to point of beginning. Said parcel contains easements of record. Parcel has benefit of Access Road Easements A through E as described in Phases of Saddle Ridge Condominium described in the The Forest at Swan Lake Village

AMENDED PHASE 4 Parcel 2 DESCRIPTION:

A parcel of land located in NE1/4-SE1/4 and GORSE, Town of Pacific, Columbia County, Wisconsin, described line: Beginning at the most southerly Condominium; thence N47°41'E, along southeast to south line of existing access road easement the left along said south line, radius 421.00 feet, 79.94 feet; thence S8°20'W, 25.26 feet; thence N65°20'W, 128.01 feet to east line of existing northeasterly on a curve to the right along said whose chord bears N47°22'30"E, 79.97 feet; thence line, 70.90 feet; thence S59°41'E, 96.83 feet parcel contains 0.655 acres and is subject to benefit of Access Road Easements A through E as described in Phases of Saddle Ridge Condominium and Access Road Easement (F) at Swan Lake Village Condominium Plat.

I, Mark C. Carlson, registered land surveyor, have surveyed the above described parcels, that this representation of the exterior boundaries of the location of the buildings and driveways constructed at the date hereof and the identification and common elements can be determined.

Bearings are referenced to Saddle Ridge Condominium

CURVE:	DELTA:	RADIUS:	ARC:	CHORD
A	9°15'	496.00'	80.06'	N47°2
B	10°54'	421.00'	80.06'	S47°3
B1	5°27'	"	40.03'	S44°4
B2	5°27'	"	40.03'	S50°1
C	9°19'	476.00'	77.41'	S69°0
D	90°50'	124.00'	196.58'	S28°2

Vol 2 Pg

off 65.B

1300.1034 - Amended
1300.1036 - Amended
1300.928 - Amended
1300.929 - Amended

597052

THE FOREST AT SW

CONDOMINIUM

COLUMBIA COUNTY

PHASE 5


STATE OF WISCONSIN }
COLUMBIA COUNTY } SS
RECEIVED FOR RECORD

DEC 21 1998

Reg. of Deeds at 1:55P

AMENDED
PHASE 4 PARCEL 2

Replaced
NEW-SEA 2004
Sec. 2
G.L. 4
Sec. 1

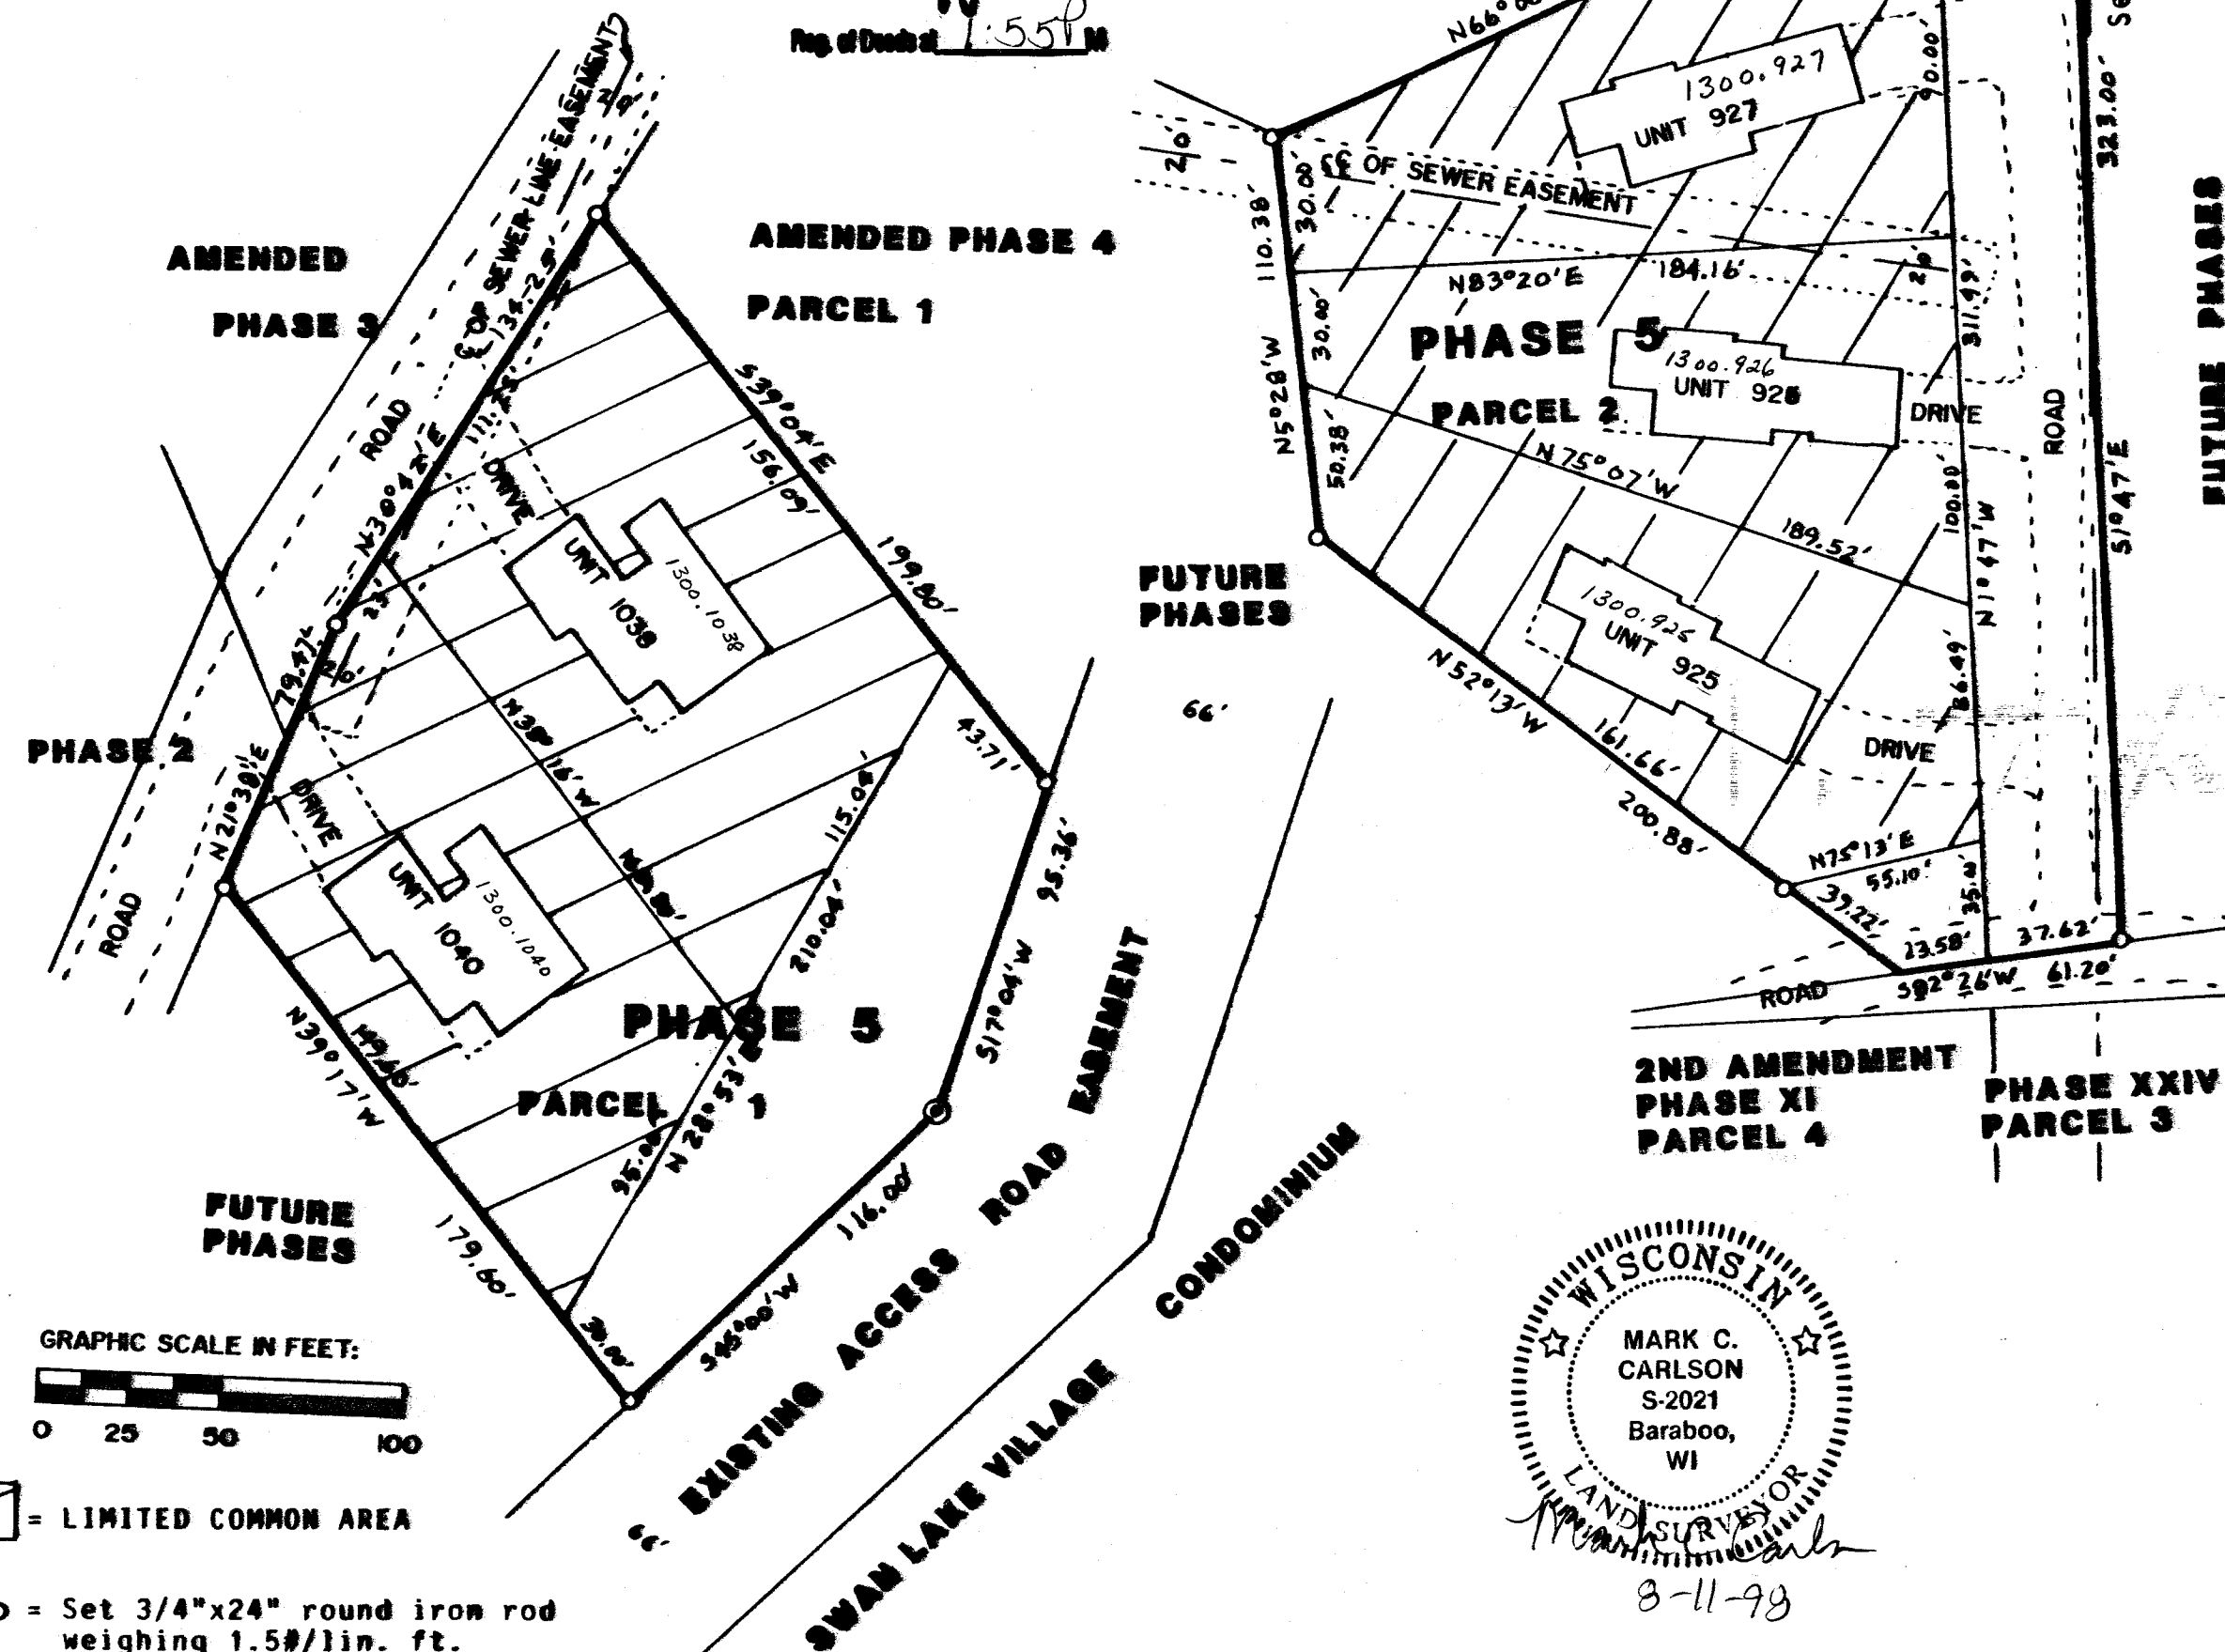

PHASE 5, Parcel 1 DESCRIPTION:
A parcel of land located in Government Township, Columbia County, Wisconsin bounded most southerly corner of AMENDED PHASE 4, Parcel 1; thence S17°04'W along said west line, 95.36 feet; thence N39°17'W, 179.60 feet to Village Condominium; thence N21°38'W, 134.25 feet to most westerly corner of S39°04'E along southwesterly line of / of beginning. Described parcel contains 1.00 acre and is subject to easements of Access Road East Saddle Ridge Condominium and Access Road East Swan Lake Village Condominium plat.

PHASE 5, Parcel 2 DESCRIPTION:
A parcel of land located in Government Township, Columbia County, Wisconsin described line: Beginning at the south corner of the Forest at Swan Lake Village; thence S thence N52°13'W, 200.88 feet; thence of said AMENDED PHASE 4, Parcel 2, 240.73 feet to point of beginning and is subject to easements of Access Road East Saddle Ridge Condominium and Access Road East Swan Lake Village Condominium plat.

I, Mark C. Carlson, registered land surveyor, certify that this plat is a correct and true description of the land described and the location of the boundaries and common elements to be determined.

Bearings are referenced to Saddle Ridge.

Vol 2 Pa.

off 65.B
1300.927
1300.926
1300.925
1300.1038
1300.1040

657670

THE FOREST AT SWAN LAKE VILLAGE CONDOMINIUM

COLUMBIA COUNTY, WISCONSIN AMENDED PHASE 5

PHASE 5, Parcel 1 DESCRIPTION:

A parcel of land located in Government Lot 4, Section 1, T12N, R9E, Town of Pacific, Columbia County, Wisconsin bounded by the following described line: Beginning at the most southerly corner of AMENDED PHASE 4, Parcel 1, The Forest at Swan Lake Village Condominium; thence S17°04'W, 95.36 feet; thence S45°00'W, 140.40 feet; thence N39°48'W, 167.69 feet; thence N21°38'E, 108.98 feet; thence N30°42'E, 134.25 feet; thence S39°04'E, 199.80 feet to point of beginning. Described parcel contains 1.03 acres and is subject to easements of record. Parcel has benefit of Access Road Easements A through E as described in Phases of Saddle Ridge Condominium and Access Road Easement (F) as described in the Forest at Swan Lake Village Condominium plat.

PHASE 5, Parcel 2 DESCRIPTION:

A parcel of land located in Government Lot 4, Section 1 and NE1/4-SE1/4, Section 2, T12N, R9E, Town of Pacific, Columbia County, Wisconsin bounded by the following described line: Beginning at the southeast corner of AMENDED PHASE 4, Parcel 2, The Forest at Swan Lake Village; thence S1°47'E, 323.00 feet; thence S82°26'W, 61.20 feet; thence N52°13'W, 200.88 feet; thence N5°28'W, 110.38 feet to the most southerly corner of said AMENDED PHASE 4, Parcel 2; thence N66°00'E along south line of said PHASE 4, Parcel 2, 240.73 feet to point of beginning. Described parcel contains 1.19 acres and is subject to easements of record. Parcel has benefit of Access Road Easements A through E as described in Phases of Saddle Ridge Condominium and Access Road Easement (F) as described in the Forest at Swan Lake Village Condominium plat.

I, Mark C. Carlson, registered land surveyor, hereby certify that I have surveyed the above described parcels, that this plat is a correct representation of the exterior boundaries of the parcels described and the location of buildings and driveways constructed or to be constructed as proposed at the date hereof and the identification and location of each unit and common elements to be determined.

Bearings are referenced to Saddle Ridge Condominium.

The Forest at
Swan Lake Village
Amended Phase 5
Sheet 1 of 4 sheets

010663

Replaced

NEW-SEW
Sec. 2

G.L. 4
Sec. 1

AMENDED
PHASE 4 PARCEL 2

AMENDED
PHASE 3

AMENDED PHASE 4
PARCEL 1

PHASE 5

PARCEL 2

TAX PARCEL #65.1

UNIT 927

UNIT 926

UNIT 925

UNIT 680

UNIT 67

605934
600000

THE FOREST AT S
CONDOM
COLUMBIA COUN
PHA

PHASE 6 DESCRIPTION:

A parcel of land located in Government Lot 4, Section 1, T12N, R9E, Town of Pacific, Columbia County, Wisconsin bounded by the following described line: Beginning at the southeast corner of PHASE XXIV, Parcel 3, Saddle Ridge Condominium; thence NORTH along east line of said Parcel 3, 13.45 feet; thence WEST along north line of said Parcel 3, 80.00 feet; thence N3°15'30"E, 132.25 feet; thence EAST, 118.47 feet; thence SOUTH, 217.18 feet; thence N75°44'W, 47.45 feet to point of beginning. Described parcel contains 0.454 acres and is subject to easements of record. Parcel has benefit of Access Road Easements A through E as described in Phases of Saddle Ridge Condominium and Access Road Easement (F) as described in the Forest at Swan Lake Village Condominium plat.

I, Mark C. Carlson, registered land surveyor, hereby certify that I have surveyed the above described parcel, that this plat is a correct representation of the exterior boundaries of the parcel described and the location of buildings and driveways constructed or to be constructed as proposed at the date hereof and the identification and location of each unit and common elements to be determined.


Bearings are referenced to Saddle Ridge Condominium.

I, Mark C. Carlson, registered land surveyor, hereby certify that the drawings appearing hereon are an accurate copy of portions of the original survey plat and they depict the layout, size, numbers and dimensions of the buildings and units located and erected or to be erected.




STATE OF WISCONSIN
COLUMBIA COUNTY
RECEIVED FOR RECORD
JUN 3 2004
Reg. of Deeds
Vol 1 pg. 206

Replaced
Replaced
2004

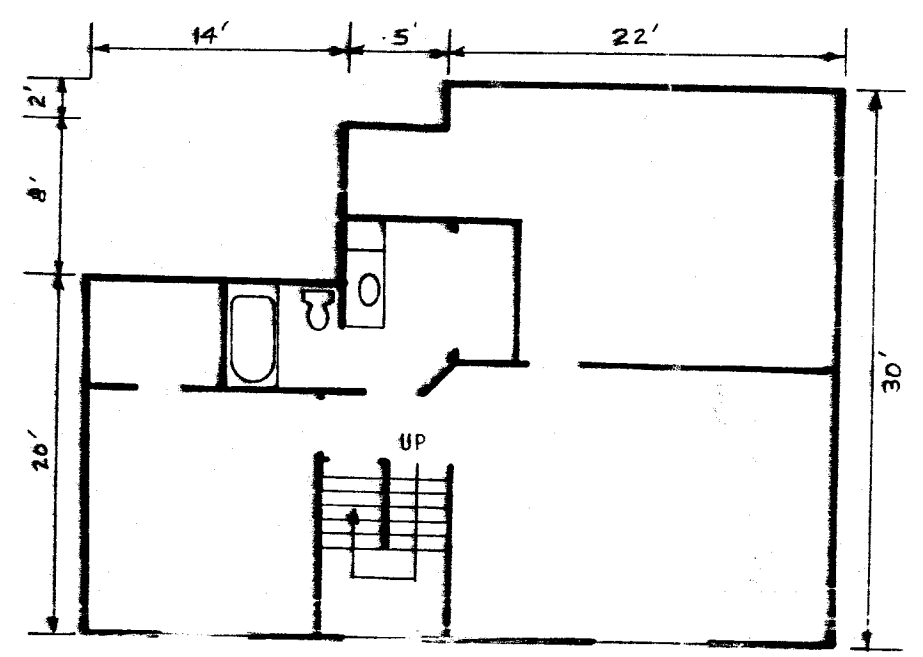

BASEMENT FLOOR PLAN UNIT 910

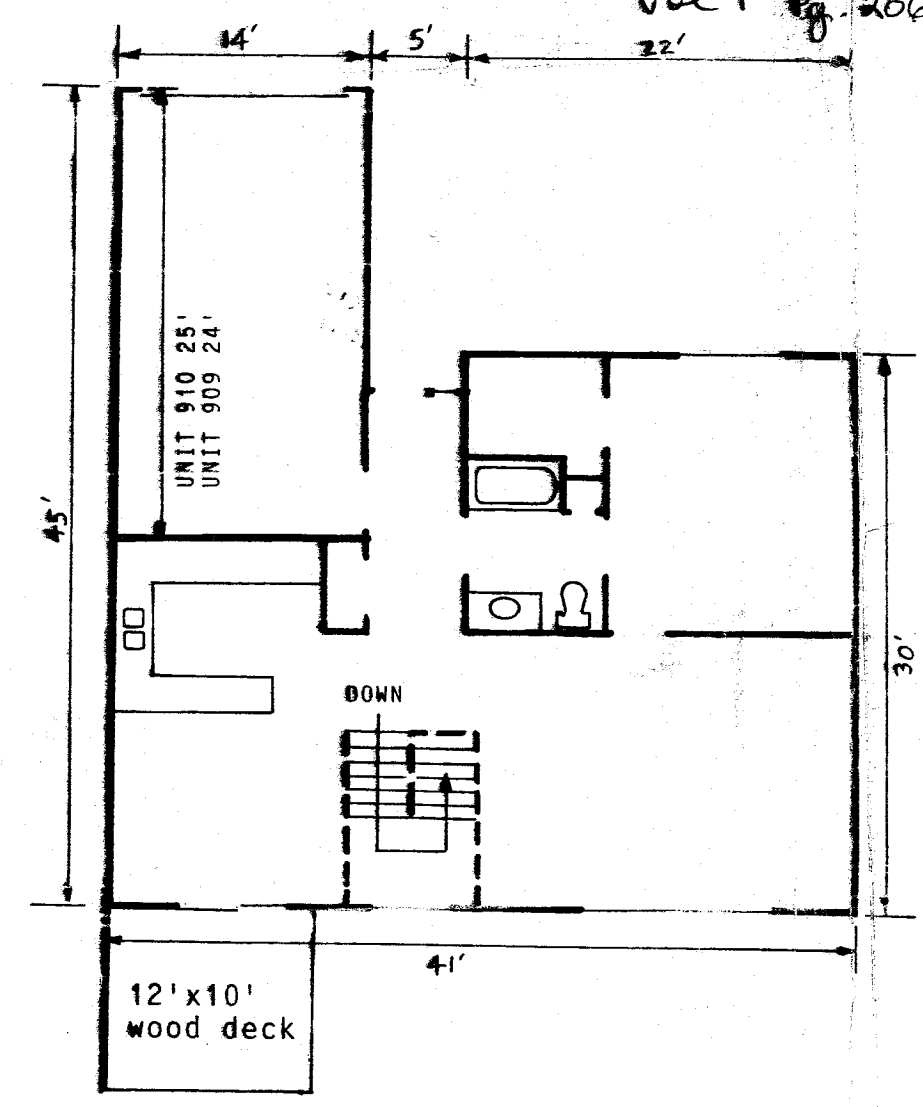


FIRST FLOOR PLAN UNIT 910

UNIT 909 is mirror image of UNIT 910, except garage is 1 foot shorter.


THE FOREST AT
SWAN LAKE VILLAGE

PHASE II
PARCEL 2

LANDS ADDED TO SADDLE
RIDGE PER COURT
SETTLEMENT

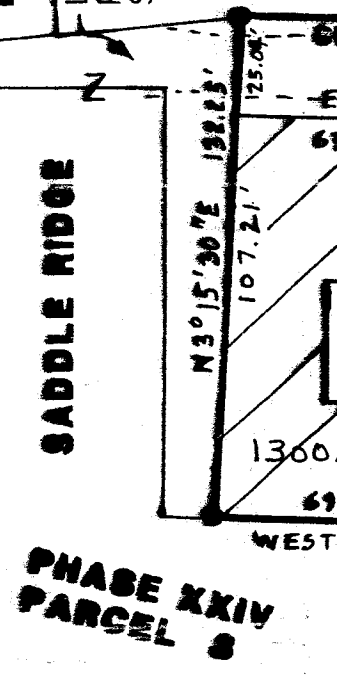

PHASE XXIV
PARCEL 8

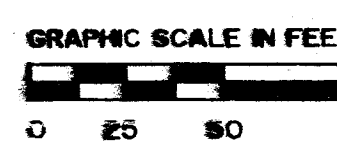

65.B
1300.909
1300.910


623663

THE FOREST AT SWAN LAKE CONDOMINIUM

COLUMBIA COUNTY, WISCONSIN
PHASE 7

Replaced
2004

THE FOREST AT SWAN
LAKE VILLAGE CONDOMINIUM

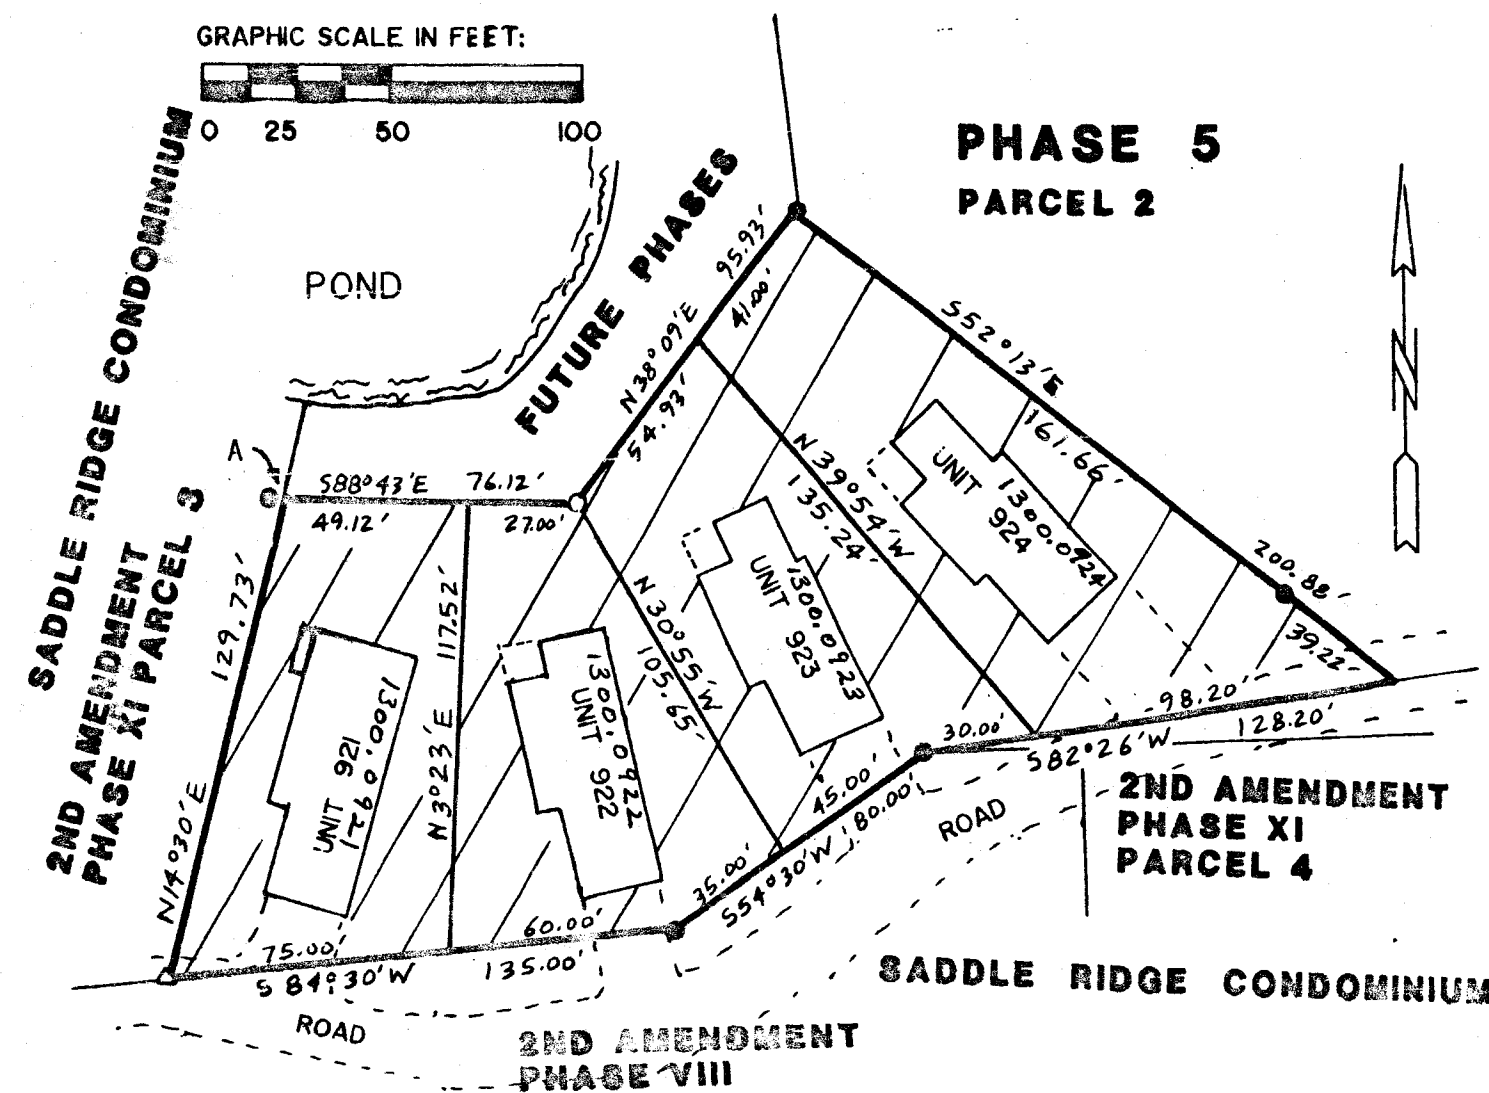

- = Found 3/4" round iron rod
- △ = Found PK nail in blacktop
- = Set 3/4"x24" round iron rod weighing 1.5 #/lin. ft.
- A = Found 3/4" rod N54°46'W, 0.27' from Condominium corner

▨ = LIMITED COMMON AREA



Mark C. Carlson

12-29-99

Revised 7-5-00

PHASE 7 DESCRIPTION:

A parcel of land located in Government Lot 4, Section 1, T12N, R9E, Town of I Columbia County, Wisconsin bounded by the following described line: Beginning southwest corner of PHASE 5, Parcel 2, The Forest At Swan Lake Condominium S 52°13'E along south line of said Parcel 2, 200.88 feet; thence S82°26'W, 128.20 feet; thence S54°30'W along north line of 2nd Amendment to Phase VIII, Saddle Ridge Condominium, 80.00 feet; thence S84°30'W along said north line, 135.00 feet to corner of 2nd Amendment to PHASE XI, Parcel 3, Saddle Ridge Condominium; thence N14°30'E along east line of said 2nd Amendment to PHASE XI, Parcel 3, 129.73 feet; thence S88°43'E, 76.12 feet; thence N38°09'E, 95.93 feet to point of beginning. D parcel contains 0.715 acres and is subject to easements of record. Parcel has been Access Road Easements A through E as described in Phases of Saddle Ridge Condominium and Access Road Easement (F) as described in the Forest at Swan Lake Village Condominium plat.

I, Mark C. Carlson, registered land surveyor, hereby certify that I have surveyed the described parcel, that this plat is a correct representation of the exterior boundaries of the parcel described and the location of buildings and driveways constructed or to be constructed as proposed at the date hereof and the identification and location of easements and common elements to be determined.

Bearings are referenced to Saddle Ridge Condominium.

I, Mark C. Carlson, registered land surveyor, hereby certify that the drawings appended heron are an accurate copy of portions of the plans of each building and substantiate the layout, unit numbers and dimensions of the buildings and units located at the site or to be erected.

STATE OF WISCONSIN COLUMBIA COUNTY RECEIVED FOR RECORD
JUL 7 2000
Denny Jull
Reg. of Deeds at 8:00 A.M.
Vol 2 Page 9

009812

UNIT 921 & 922
FIRST FLOOR PLAN

off 65.B


Unit 924 - 1300.0924
Unit 923 - 1300.0923
Unit 922 - 1300.0922
Unit 921 - 1300.0921

626287

THE FOREST AT SWAN LAKE VILLAGE CONDOMINIUM

COLUMBIA COUNTY, WISCONSIN

PHASE 8

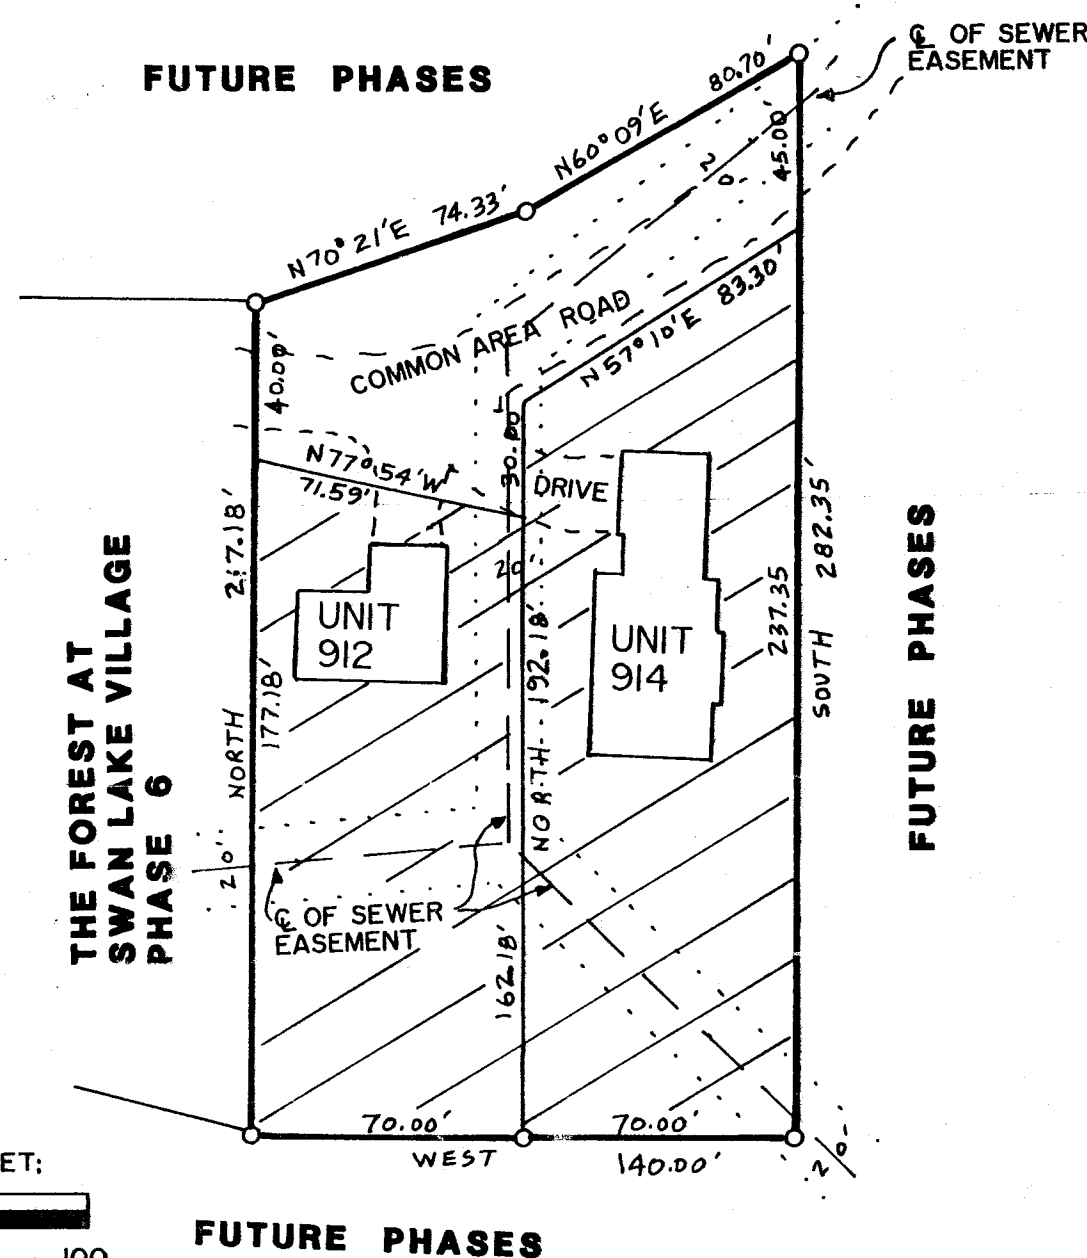Replaced
2004

= Limited Common Area

○ = Set 3/4"x24" round iron rod weighing 1.5#/lin. ft.

PHASE 8 DESCRIPTION:

A parcel of land located in Government Lot 4, Section 1, T12N, R9E, Town of Pacific, Columbia County, Wisconsin bounded by the following described line: Beginning at the southeast corner of PHASE 6, The Forest At Swan Lake Condominium; thence NORTH along east line of said PHASE 6, 217.18 feet to northeast corner of said PHASE 6; thence N70°21'E, 74.33 feet; thence N60°09'E, 80.70 feet; thence SOUTH, 282.35 feet; thence WEST, 140.00 feet to point of beginning. Described parcel contains 0.79 acres and is subject to easements of record. Parcel has benefit of Access Road Easements A through E as described in Phases of Saddle Ridge Condominium and Access Road Easement (F) as described in the Forest at Swan Lake Village Condominium plat.

I, Mark C. Carlson, registered land surveyor, hereby certify that I have surveyed the above described parcel, that this plat is a correct representation of the exterior boundaries of the parcel described and the location of buildings and driveways constructed or to be constructed as proposed at the date hereof and the identification and location of each unit and common elements to be determined.

Bearings are referenced to Saddle Ridge Condominium.

I, Mark C. Carlson, registered land surveyor, hereby certify that the drawings appearing hereon are an accurate copy of portions of the plans of each building and substantially depict the layout, unit numbers and dimensions of the buildings and units located and erected or to be erected.


STATE OF WISCONSIN
COLUMBIA COUNTY
REGISTERED FOR RECORD

SEP 1 1 2004

Mark C. Carlson

No. of Units 1310 P

Vol & Page 14

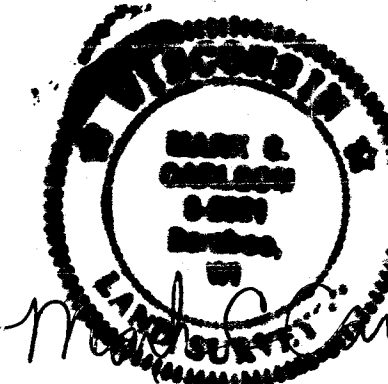PIN # 032-1300.914
1300.912

Carlson Surveying, 1709 Ash St., Baraboo, WI, 53913
Phone & FAX (608) 356-8598


Saddle Ridge
100 Saddle Ridge
Portage, WI, 53901

off 65.B


912 - 1300.0912
914 - 1300.0914

009854


The Forest at
Swan Lake Village
Phase 8
Sheet 1 of 2 sheets

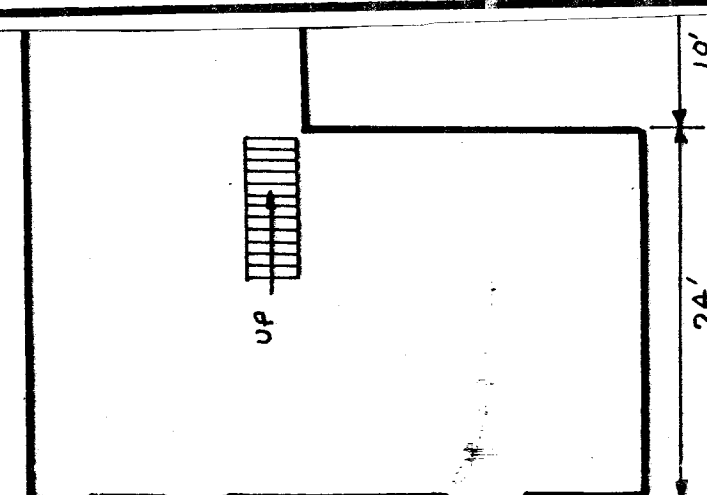

**UNIT 912
BASEMENT FLOOR PLAN**

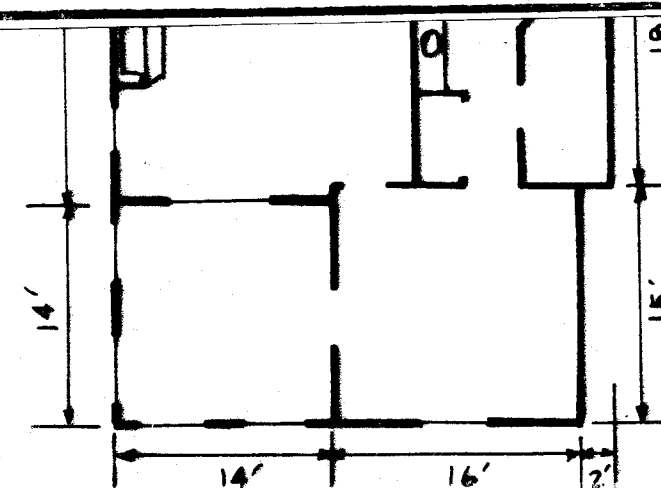

**UNIT 914
FIRST FLOOR PLAN**

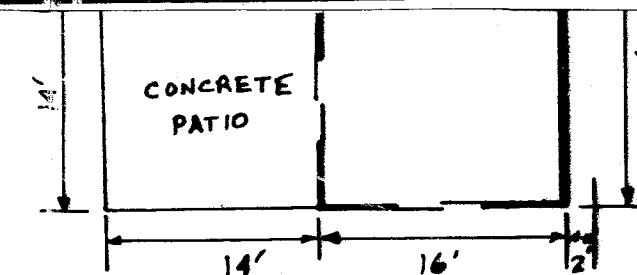

**UNIT 914
BASEMENT FLOOR PLAN**

009854

The Forest at
Swan Lake Village
Phase 7
Sheet 2 of 2 sheets

009854

THE FOREST AT SWAN LAKE VILLAGE CONDOMINIUM

Replaced
2004



COLUMBIA COUNTY, WISCONSIN

AMENDED PHASE 10

637891
STATE OF WISCONSIN } SS
COLUMBIA COUNTY
RECEIVED FOR RECORD

JUN 8 2001

Reg. of Deeds at 8:00 AM
Vol 2 Page 25

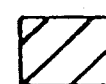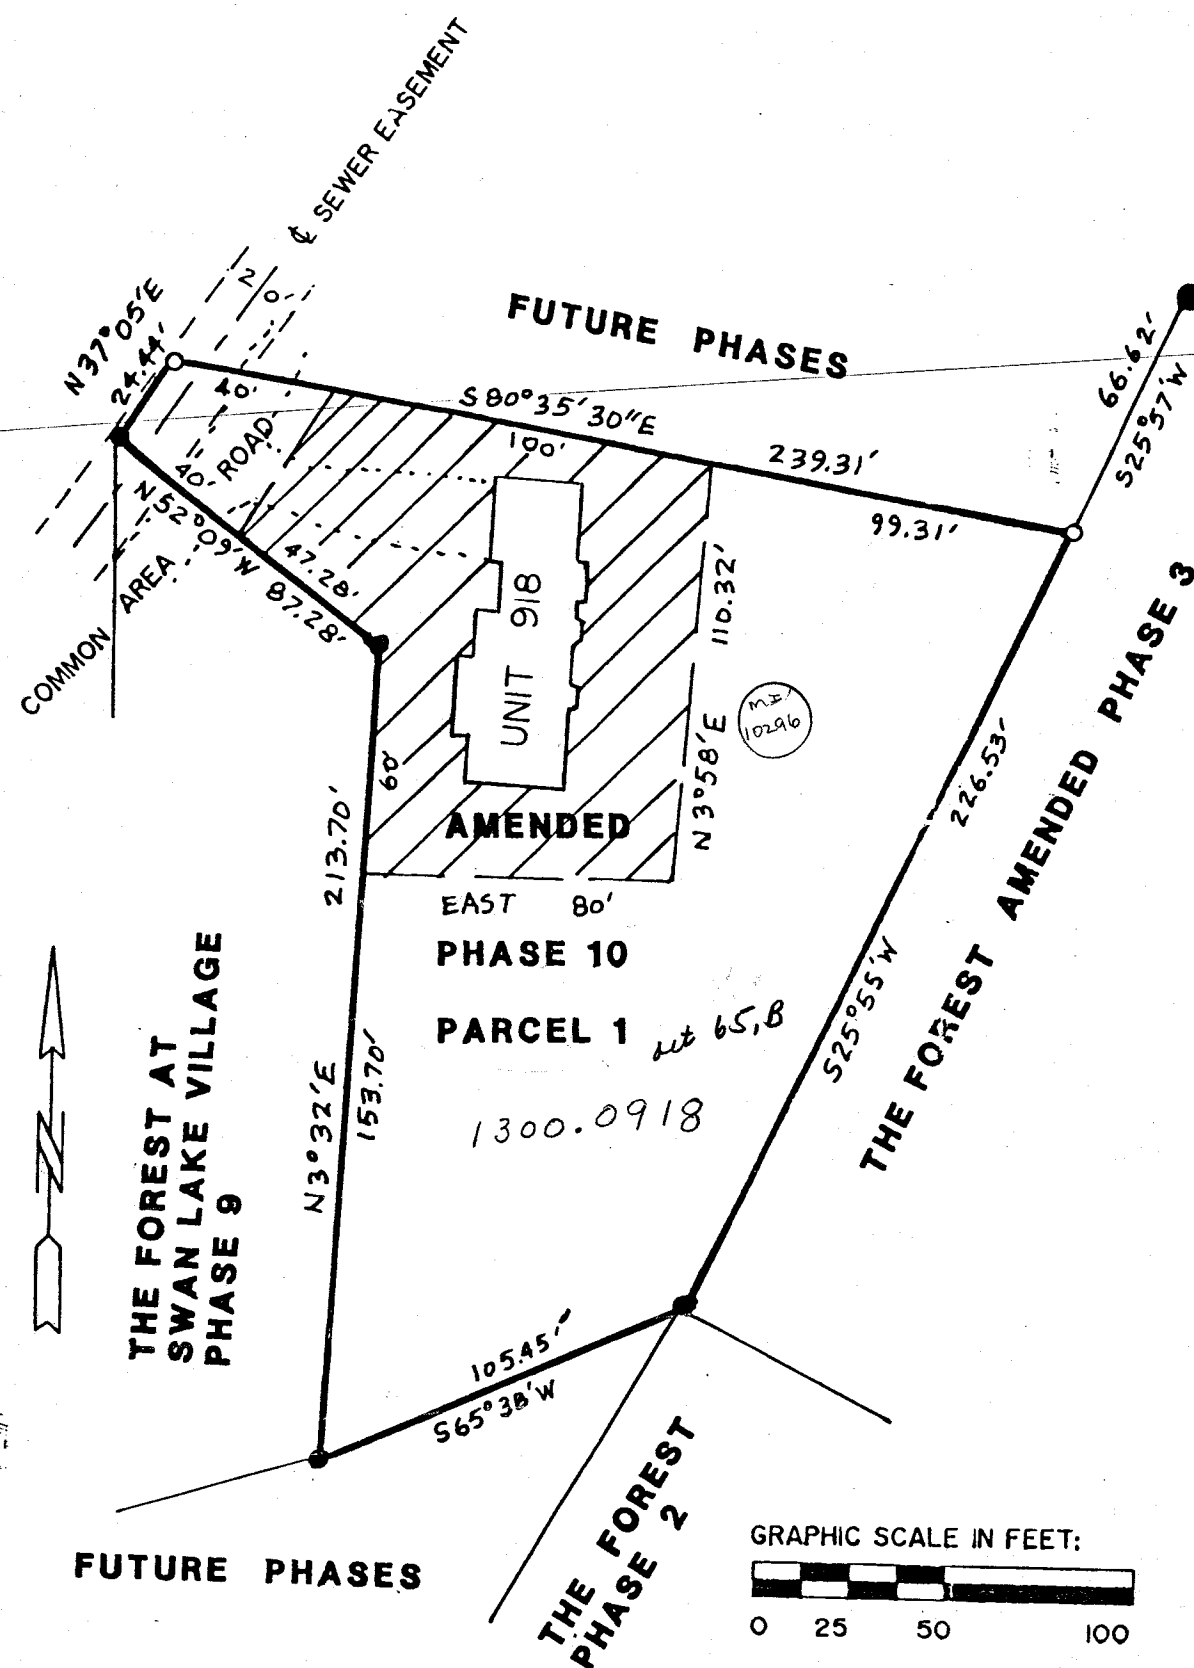


= Limited Common Area

- = Found 1 1/4" round iron rod
- = Found 3/4" round iron rod
- = Set 3/4"x24" round iron rod weighing 1.5#/lin. ft.

Carlson Surveying, Inc. 1709 Ash St., Baraboo, WI, 53913
Phone & FAX (608) 356-8598

Saddle Ridge Corporation
100 Saddle Ridge
Portage, WI, 53901

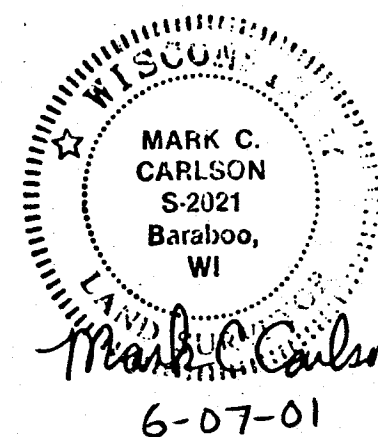

AMENDED PHASE 10, Parcel 1 DESCRIPTION:

A parcel of land located in Government Lot 4, Section 1, T12N, R9E, Town of Pacific, Columbia County, Wisconsin bounded by the following described line: Beginning at the southeast corner of PHASE 9, The Forest At Swan Lake Condominium; thence N3°32'E along east line of said PHASE 9, 213.70 feet to northeast corner of said PHASE 9; thence N52°09'W along north line of said PHASE 9, 87.28 feet to northwest corner of said PHASE 9; thence N37°05'E, 24.44 feet; thence S80°35'30"E, 239.31 feet to west line of Amended PHASE 3, The Forest At Swan Lake Village Condominium; thence S25°55'W along said west line, 226.53 feet to southwest corner of said Amended PHASE 3; thence S65°38'W, 105.45 feet to point of beginning. Described parcel contains 0.814 acres and is subject to easements of record. Parcel has benefit of Access Road Easements A through E as described in Phases of Saddle Ridge Condominium and Access Road Easement (F) as described in the Forest at Swan Lake Village Condominium plat.

AMENDED PHASE 10, Parcel 2 DESCRIPTION:

A parcel of land located in Government Lot 4 & NE1/4-SE1/4, Section 1, T12N, R9E, Town of Pacific, Columbia County, Wisconsin bounded by the following described line: Beginning at the most northerly corner of PHASE XXX, Saddle Ridge Condominium; thence S47°37'W along west line of said PHASE XXX, 119.98 feet to southwest corner of said PHASE XXX; thence N2°41'30"E, 94.97 feet; thence N29°58'W, 156.60 feet to east line of Access Road Easement (C); thence N17°26'E along said east line 40.00 feet; thence S77°30'E, 158.12 feet; thence S82°56'E, 36.12 feet; thence S22°00'E, 266.18 feet to northeast corner of said PHASE XXX; thence N55°00'W along north line said PHASE XXX, 170.25 feet to point of beginning. Described parcel contains 0.923 acres and is subject to easements of record. Parcel has benefit of Access Road Easements A through E as described in Phases of Saddle Ridge Condominium and Access Road Easement (F) as described in the Forest at Swan Lake Village Condominium plat.

AMENDED PHASE 10, Parcel 3 DESCRIPTION:

A parcel of land located in NE1/4-SE1/4, Section 1, T12N, R9E, Town of Pacific, Columbia County, Wisconsin bounded by the following described line: Beginning at the northeast corner of PHASE V, Saddle Ridge Condominium; thence N66°53'W along north line of said PHASE V, 85.02 feet; thence N37°51'E, 336.04 feet to west line of 2nd Amendment to PHASE XI, Parcel 2, Saddle Ridge Condominium; thence S27°22'E along said west line, 90.00 feet to southwest corner of said 2nd Amendment to PHASE XI, Parcel 2; thence Southwesterly on a curve to the left, radius 562.00 feet, whose chord bears S37°45'W, 276.68 feet to point of beginning. Described parcel contains 0.503 acres and is subject to easements of record. Parcel has benefit of Access Road Easements A through E as described in Phases of Saddle Ridge Condominium and Access Road Easement (F) as described in the Forest at Swan Lake Village Condominium plat.

I, Mark C. Carlson, registered land surveyor, hereby certify that I have surveyed the above described parcels, that this plat is a correct representation of the exterior boundaries of the parcels described and the location of buildings and driveways constructed or to be constructed as proposed at the date hereof and the identification and location of each unit and common elements to be determined.

Bearings are referenced to Saddle Ridge Condominium.

The Forest at
Swan Lake Village
Amended Phase 10
Sheet 1 of 4 sheets




= Limited Common Area

- = Found 1 1/4" round iron rod
- = Found 3/4" round iron rod
- = Set 3/4"x24" round iron rod weighing 1.5#/lin. ft.


Carlson Surveying, Inc. 1709 Ash St., Baraboo, WI, 53913
Phone & FAX (608) 356-8598

Saddle Ridge Corporation
100 Saddle Ridge
Portage, WI, 53901

CURVE A: Radius = 562.00', Delta = 28°30',
Arc = 279.56', Chord = S37°45'W, 276.68'

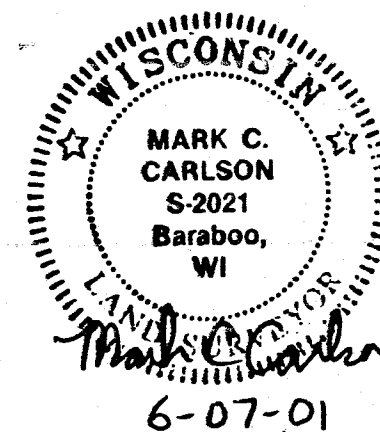

Bearings are referenced to Saddle Ridge Condominium.

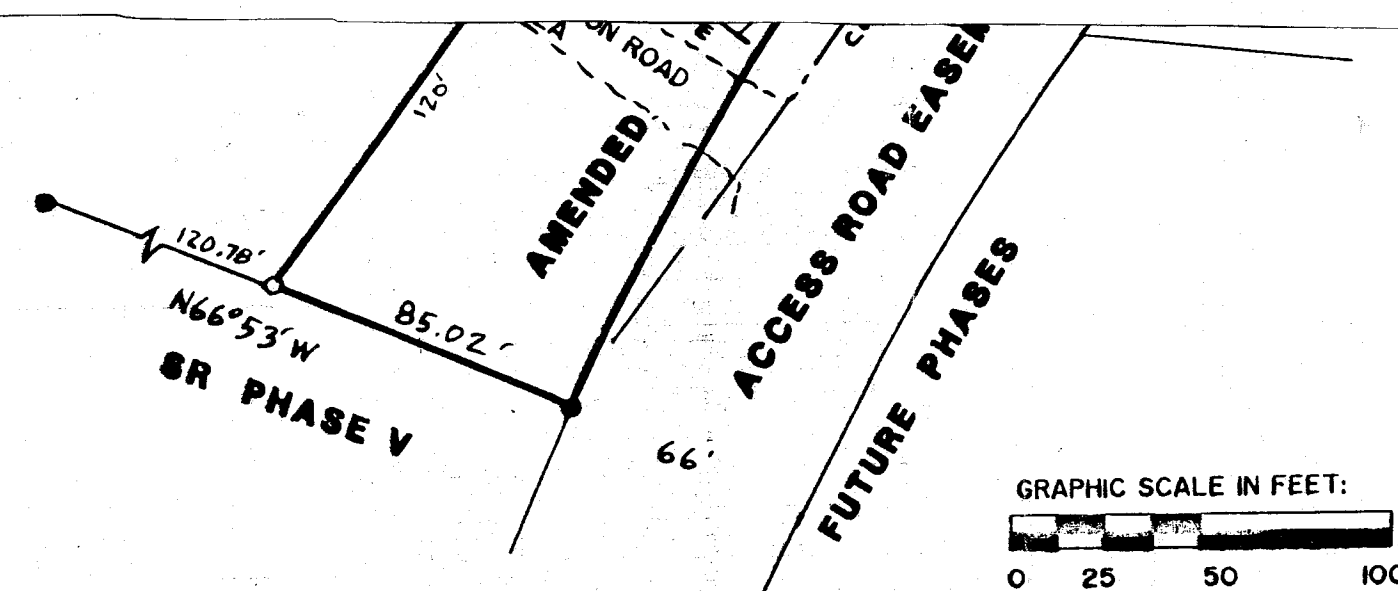

The Forest at
Swan Lake Village
Amended Phase 10
Sheet 2 of 4 sheets

THE FOREST AT SWAN LAKE VILLAGE CONDOMINIUM

COLUMBIA COUNTY, WISCONSIN

PHASE 11

Replaced
2004

AMENDED PHASE 11 DESCRIPTION:

A parcel of land located in NE1/4-SE1/4, Section 1, T12N, R9E, Town of Pacific, Columbia County, Wisconsin bounded by the following described line: Beginning at the most northerly corner of PHASE V, Saddle Ridge Condominium; thence N49°00'E, 393.05 feet to the west line of 2nd Amendment to PHASE XI, Parcel 2, Saddle Ridge Condominium; thence S27°22'E along said west line, 45.00 feet to northerly corner of The Forest at Swan Lake Village, Phase 10, Parcel 3; thence S37°51'W along west line of said Phase 10, 336.04 feet to southwest corner of said Phase 10; thence N66°53'W along north line of said Phase V, 120.78 feet to point of beginning. Described parcel contains 0.65 acres and is subject to easements of record. Parcel has benefit of Access Road Easements A through E as described in Phases of Saddle Ridge Condominium and Access Road Easement (F) as described in the Forest at Swan Lake Village Condominium plat.

I, Mark C. Carlson, registered land surveyor, hereby certify that I have surveyed the above described parcels, that this plat is a correct representation of the exterior boundaries of the parcels described and the location of buildings and driveways constructed or to be constructed as proposed at the date hereof and the identification and location of each unit and common elements to be determined.

Bearings are referenced to Saddle Ridge Condominium.

Carlson Surveying, Inc. 1709 Ash St., Baraboo, WI, 53913
Phone & FAX (608) 356-8598

Saddle Ridge Corporation
100 Saddle Ridge
Portage, WI, 53901

660400

STATE OF WISCONSIN } ss
COLUMBIA COUNTY
RECEIVED FOR RECORD


JUN 27 2002

Danny J. Judd
Reg. of Deeds at 8:00 A.M.



032-65.011

The Forest at
Swan Lake Village
Phase 11
Sheet 1 of 2 sheets

off 75.2
now
75.3
65.847
new
1300.0952

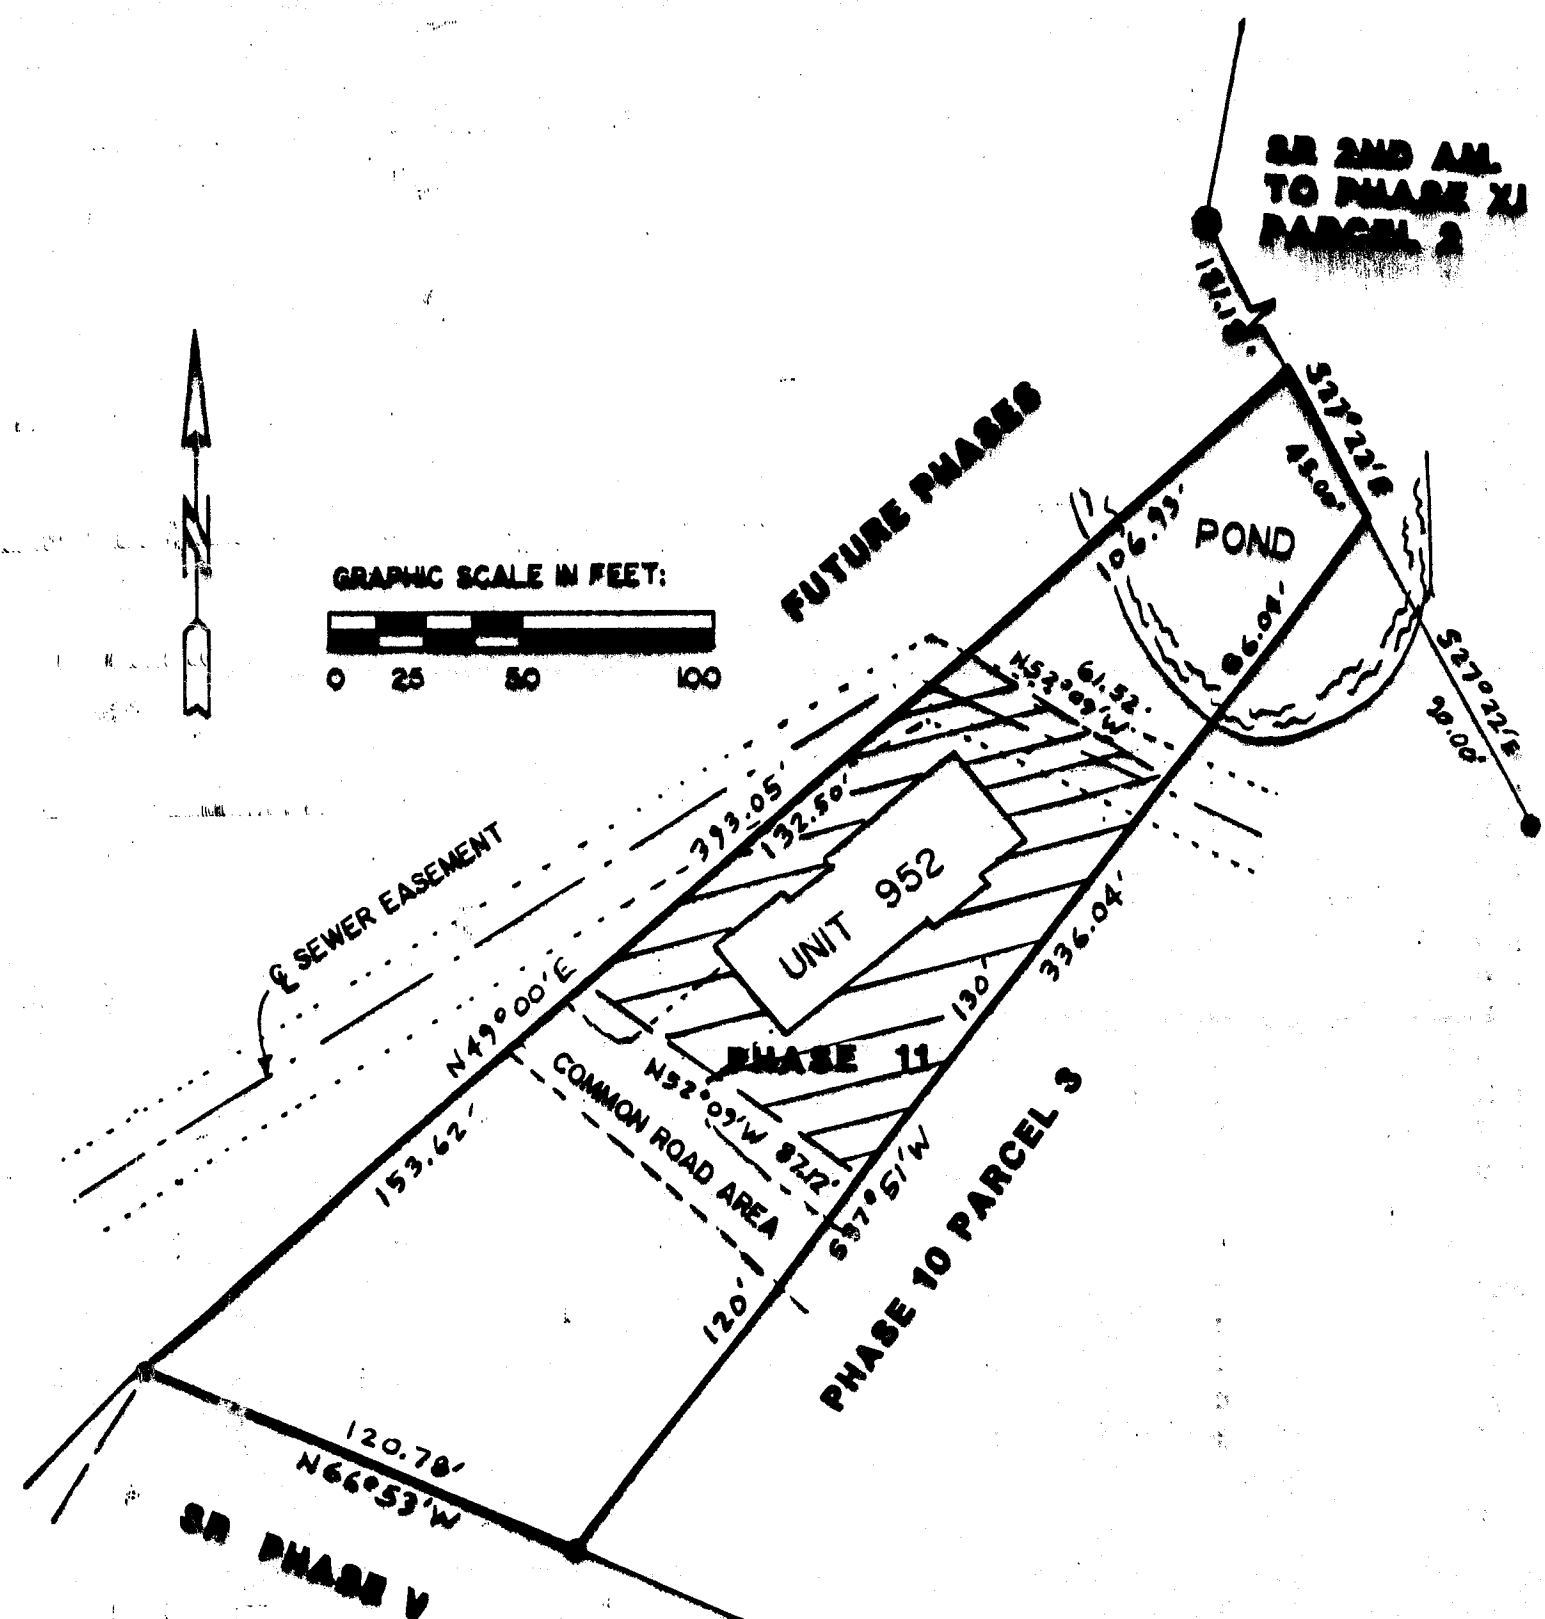

- = Limited Common Area
- = Found 1 1/4" round iron rod
- = Found 3/4" round iron rod
- = Set 3/4"x24" round iron rod weighing 1.5#/lin. ft.

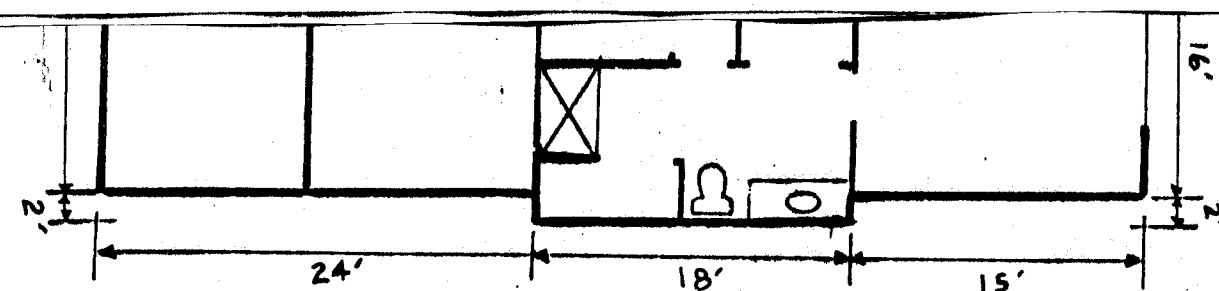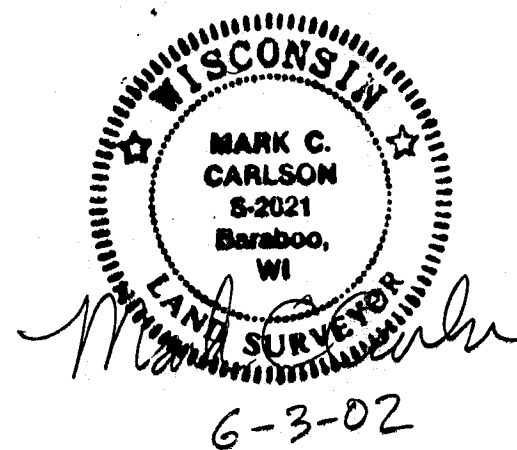

UNIT 952
BASEMENT FLOOR PLAN

The Forest at
Swan Lake Village
Phase 11
Sheet 2 of 2 sheets

010700


010700

THE FOREST AT SWAN LAKE VILLAGE CONDOMINIUM

COLUMBIA COUNTY, WISCONSIN

PHASE 12

Replaced
2004

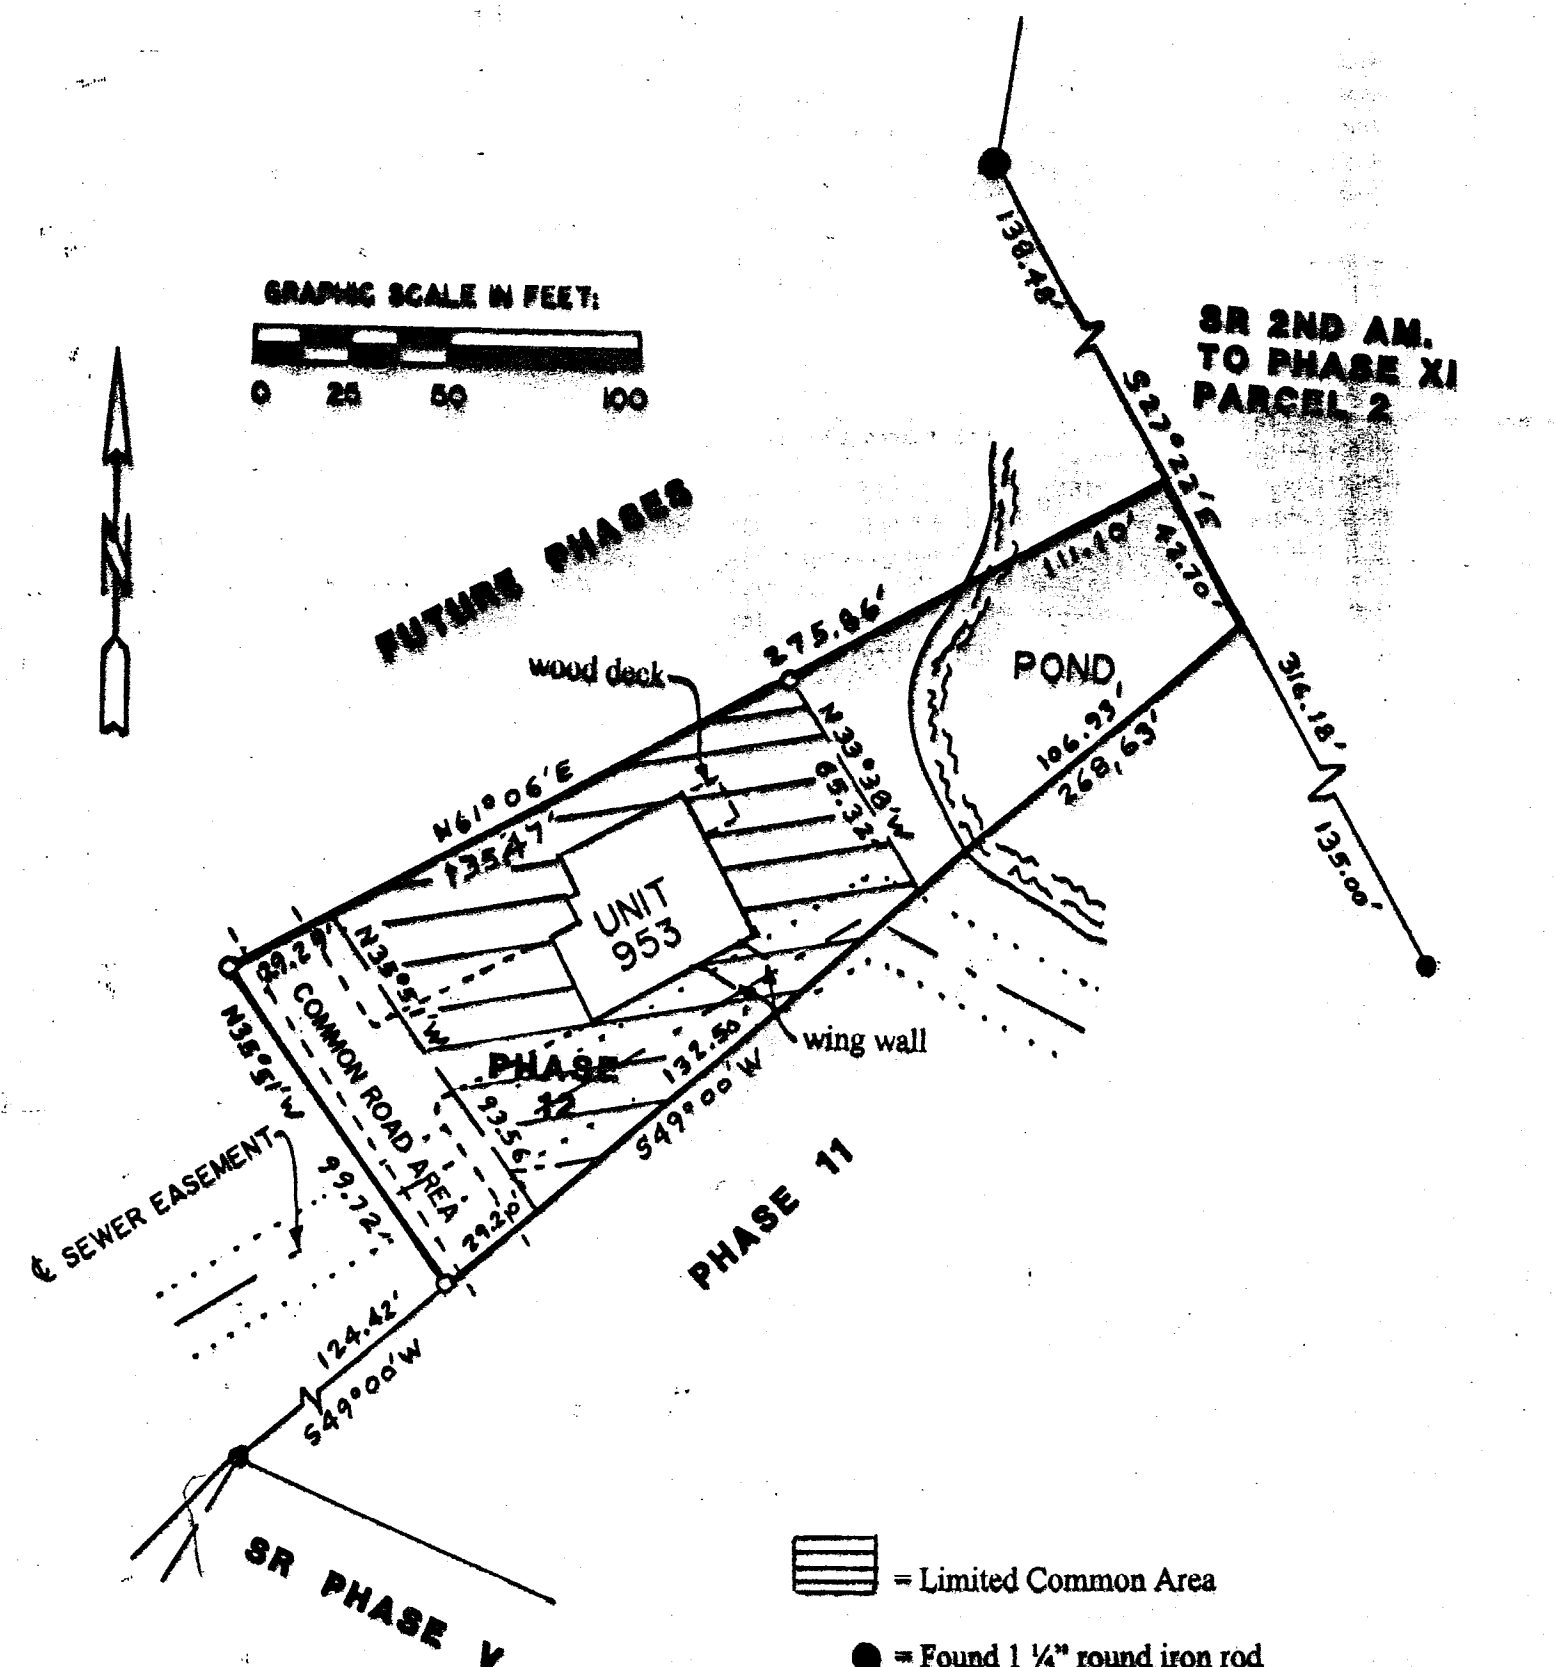

▨ = Limited Common Area

- = Found 1 1/4" round iron rod
- = Found 3/4" round iron rod
- = Set 3/4"x24" round iron rod weighing 1.5#/lin. ft.

Carlson Surveying, Inc. 1709 Ash St., Baraboo, WI, 53913
Phone & FAX (608) 356-8598

Saddle Ridge Corporation
100 Saddle Ridge
Portage, WI, 53901


PHASE 12 DESCRIPTION:

A parcel of land located in NE1/4-SE1/4, Section 1, T12N, R9E, Town of Pacific, Columbia County, Wisconsin bounded by the following described line: Beginning at the most northerly corner of PHASE 11, The Forest At Swan Lake Condominium; thence S49°00'W along the northwest line of said Phase 11, 268.63 feet; thence N35°51'W, 99.72 feet; thence N61°00'E, 275.86 feet to southwest line of Saddle Ridge 2nd Amendment to Phase XI, Parcel 2; thence S27°22'E along said southwest line, 42.70 feet to point of beginning. Described parcel contains 0.44 acres and is subject to sewer and other easements of record. Parcel has benefit of Access Road Easements A through E as described in Phases of Saddle Ridge Condominium and Access Road Easement (F) as described in the Forest at Swan Lake Village Condominium plat.

I, Mark C. Carlson, registered land surveyor, hereby certify that I have surveyed the above described parcel, that this plat is a correct representation of the exterior boundaries of the parcel described and the location of buildings and driveways constructed or to be constructed as proposed at the date hereof and the identification and location of each unit and common elements to be determined.

Bearings are referenced to Saddle Ridge Condominium.

I, Mark C. Carlson, registered land surveyor, hereby certify that the drawings appearing hereon are an accurate copy of portions of the plans of each building and substantially depict the layout, unit numbers and dimensions of the buildings and units located and erected or to be erected.

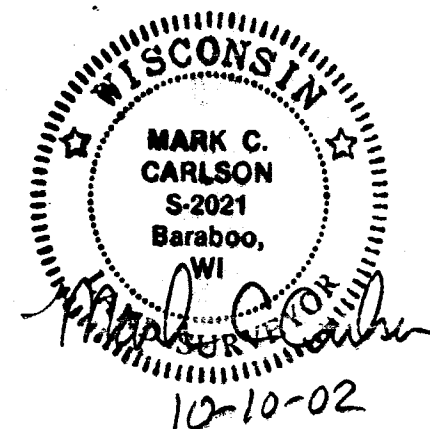


Town of Pacific
PRT 75.3
now - 75.4
New 1300.0953
unit 953

The Forest at
Swan Lake Village
Phase 12
Sheet 1 of 2 sheets

010912

UNIT 953
BASEMENT FLOOR PLAN

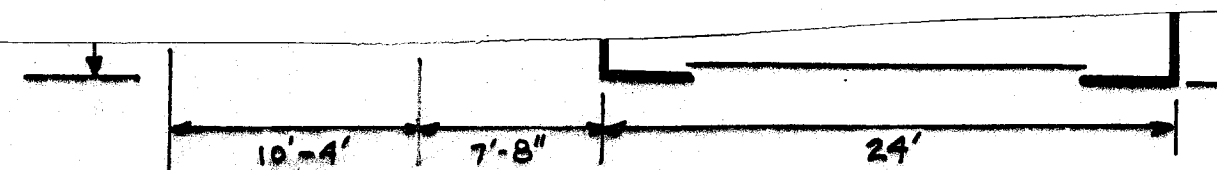

UNIT 953
FIRST FLOOR PLAN


The Forest at
Swan Lake Village
Phase 12
Sheet 2 of 2 sheets

010912

671874
Vol 2 Page 47
PIN# 75.3
STATE OF WISCONSIN } ss
COLUMBIA COUNTY
RECEIVED FOR RECORD
DEC 6 2002
Reg of Deeds at 8:00 A.M.

THE FOREST AT SWAN LAKE VILLAGE CONDOMINIUM COLUMBIA COUNTY, WISCONSIN PHASE 13

Replaced
2004

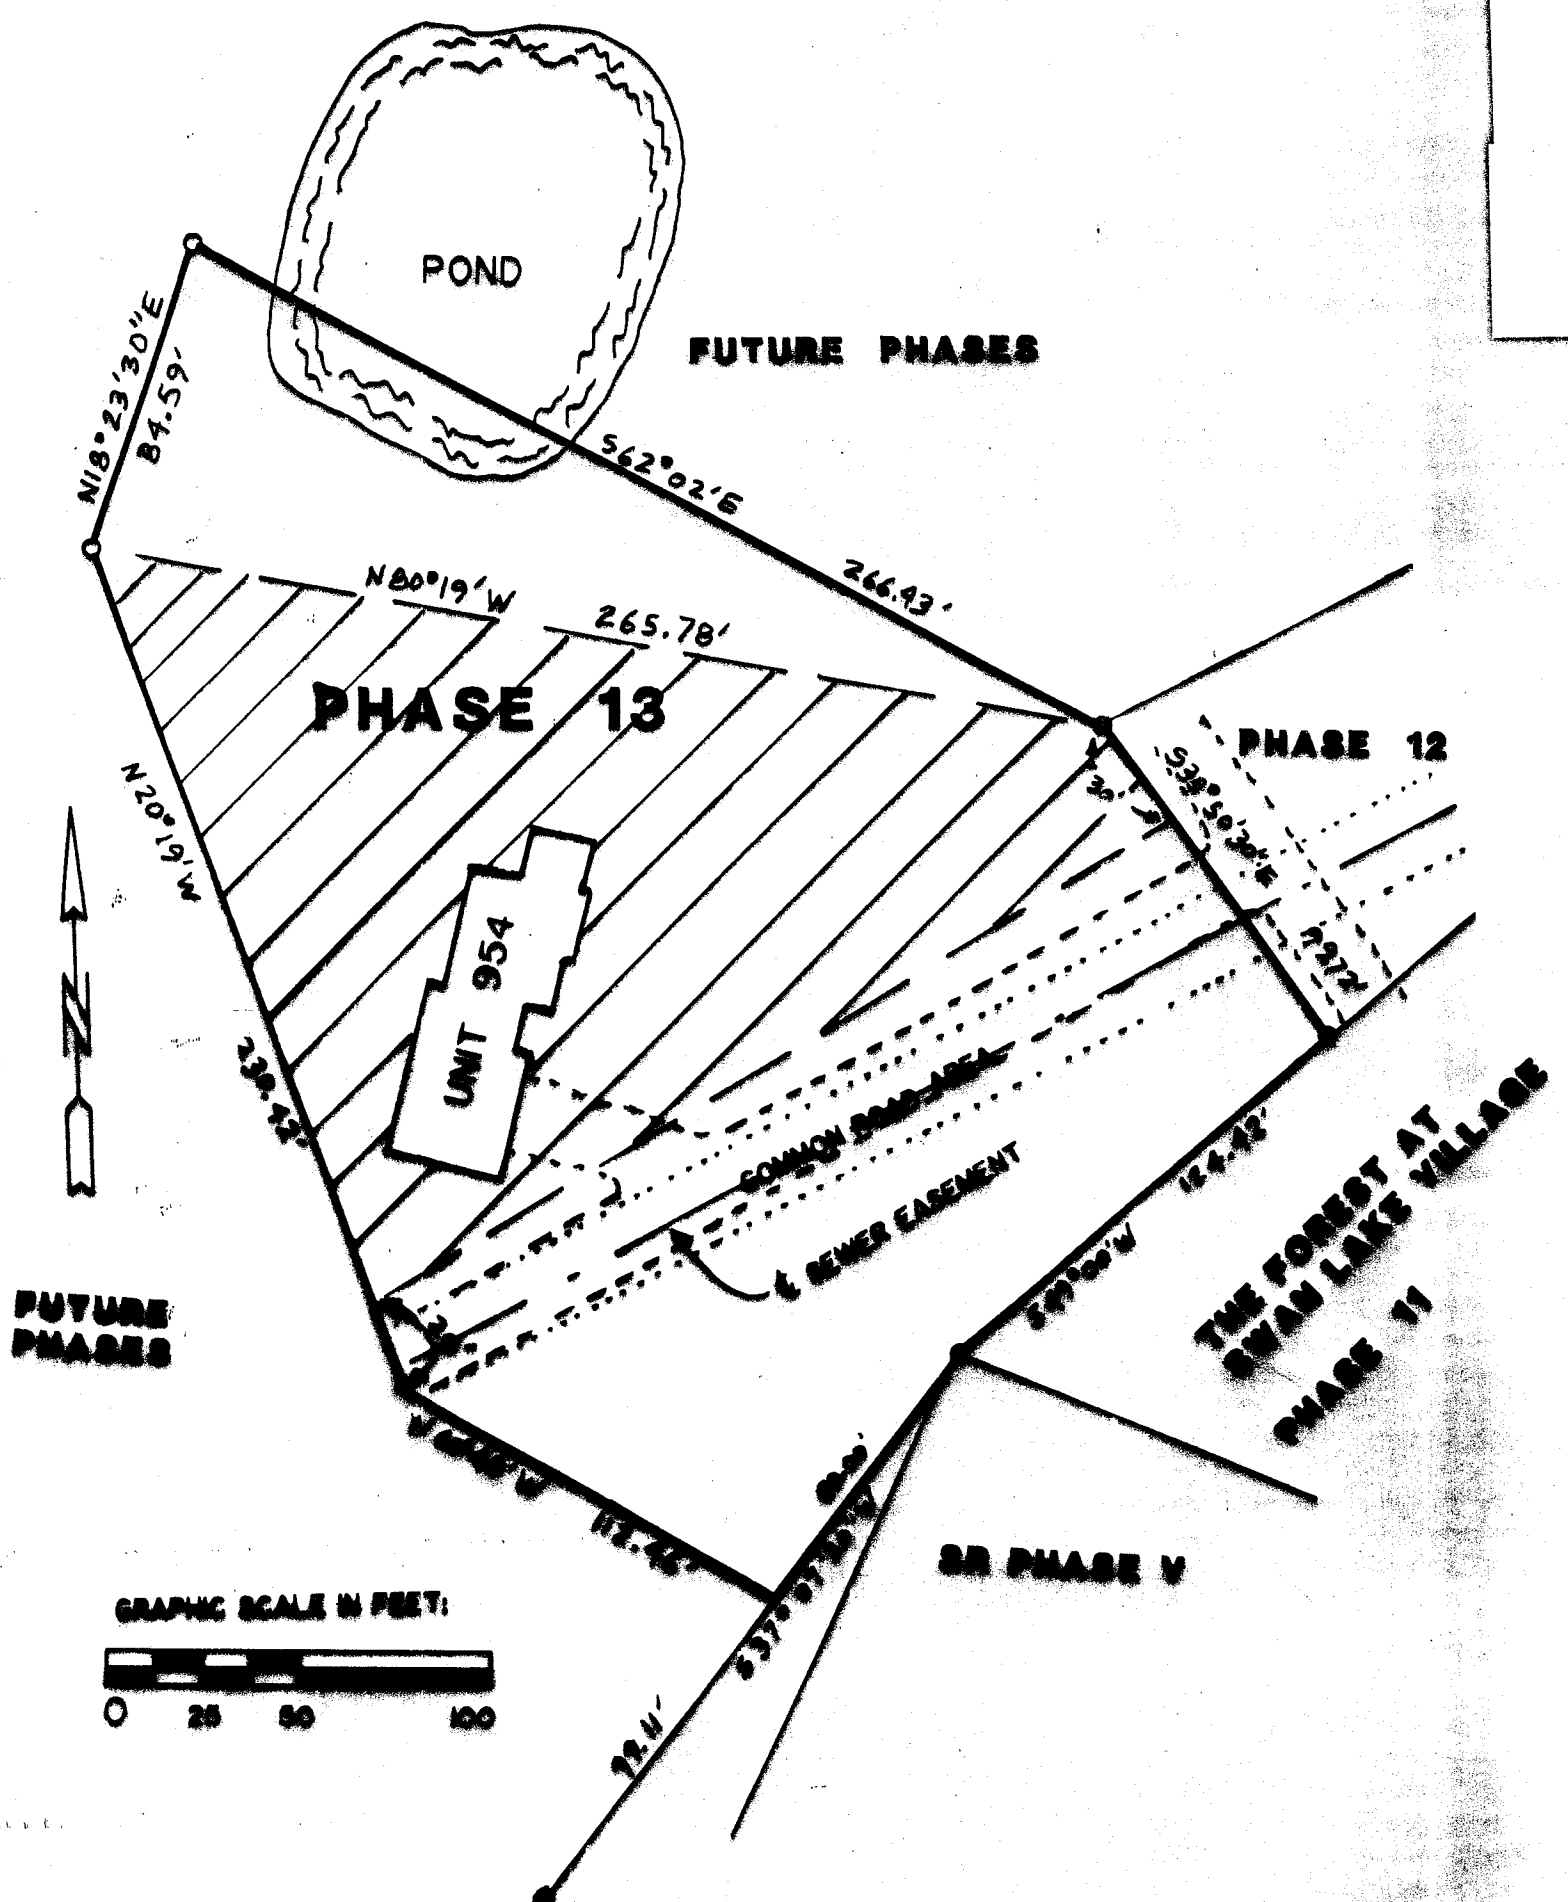

PHASE 13 DESCRIPTION:
A parcel of land located in NE1/4-SE1/4, Section 1, T12N, R9E, Town of Pacific, Columbia County, Wisconsin bounded by the following described line: Beginning at the southwest corner of PHASE 12, The Forest At Swan Lake Condominium; thence S35°50'30"E along south line of said PHASE 12, 99.72 feet to southeast corner of said PHASE 12; thence S49°00'W along north line of PHASE 11, 124.42 feet to southwest corner of said PHASE 11 and most northerly corner of Saddle Ridge, Phase V; thence S37°07'30"W, 80.00 feet; thence N60°48'W, 112.46 feet; thence N20°19'W, 230.42 feet; thence N18°23'30"E, 84.59 feet; thence S62°02'E, 266.43 feet to point of beginning. Described parcel contains 1.38 acres and is subject to sewer easement and other easements of record. Parcel has benefit of Access Road Easements A through E as described in Phases of Saddle Ridge Condominium and Access Road Easement (F) as described in the Forest at Swan Lake Village Condominium plat.

I, Mark C. Carlson, registered land surveyor, hereby certify that I have surveyed the above described parcel, that this plat is a correct representation of the exterior boundaries of the parcel described and the location of buildings and driveways constructed or to be constructed as proposed at the date hereof and the identification and location of each unit and common elements to be determined.

Bearings are referenced to Saddle Ridge Condominium.

WISCONSIN
MARK C. CARLSON
S-2021
Baraboo, WI
17-22-02

- [Hatched Box] = Limited Common Area
- ⊙ = Found 3/4" round iron rod
- ⊙ = Set 3/4"x24" round iron rod weighing 1.5#/lin. ft.


Carlson Surveying, Inc. 1709 Ash St., Baraboo, WI, 53913
Phone & FAX (608) 356-8598

Saddle Ridge Corporation
100 Saddle Ridge
Potosi, WI, 53901

Town of Pacific
PRT 75.4
now 75.5
New Unit 954
1300.954

The Forest at
Swan Lake Village
Phase 13
Sheet 1 of 2 sheets

010911

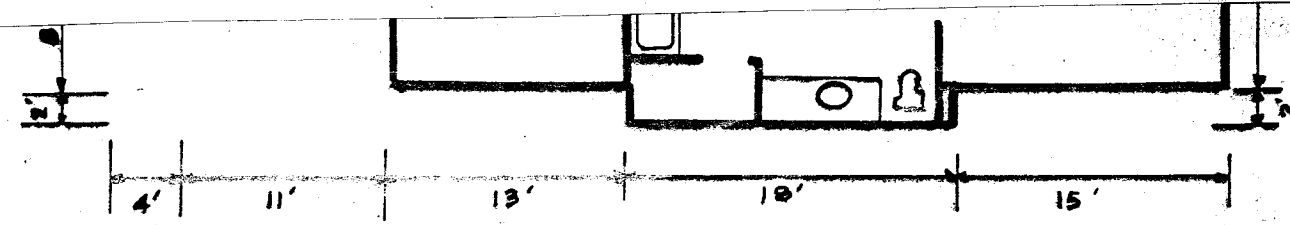

UNIT 954
BASEMENT FLOOR PLAN

CARLSON
S-2021
Baraboo, WI
Mark C. Carlson
11-22-02

These are an accurate copy of portions of the plans of each building and substantially depict the layout, unit numbers and dimensions of the buildings and units located and erected or to be erected.

The Forest at
Swan Lake Village
Phase 13
Sheet 2 of 2 sheets

010911

[illegible]

V.1 P.7 Condominium PLATS
1980 Assessment Roll
Rec. 9-19-79
682 thru 713
Models 1-2-3-4

404887

CONDOMINIUM PLAT OF
SADDLE RIDGE
AMENDED PHASE I


THIS SURVEY DESCRIBES THE
LAND AND BUILDINGS SUBJECT TO
THE CONDOMINIUM DECLARATION
FOR SADDLE RIDGE.

PHASE 2 DESCRIPTION

ELEMENT (A B B) DESCRIPTION

INT (D) DESCRIPTION

NEI/4 - NEI/4

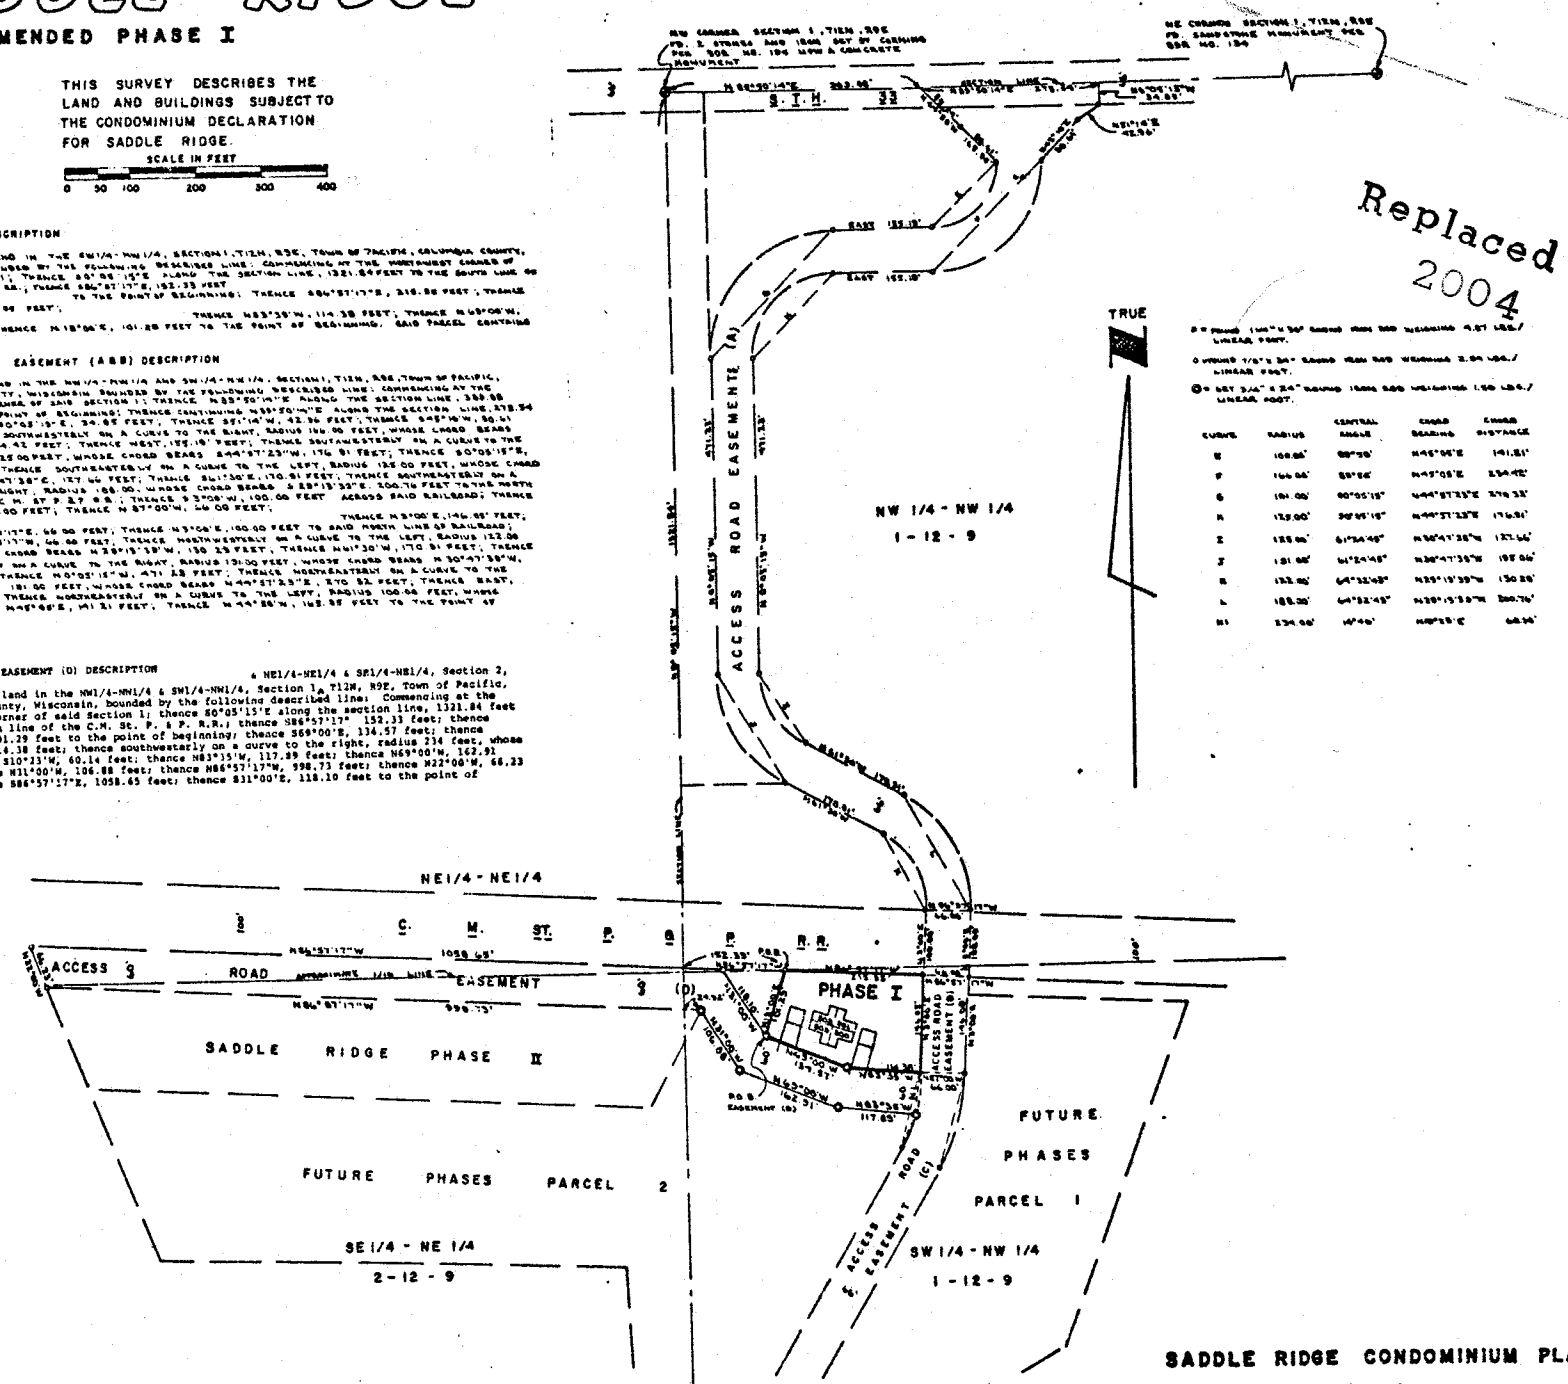

SADDLE RIDGE CONDOMINIUM PLAT

PAGE 1
1-1-7
5-2-3


SADDLE RIDGE CONDOMINIUM PLAT
PAGE 2

SADDLE RIDGE CONDOMINIUM FLAT
PAGE 3

[illegible]

VS. 1 PAGE 28

NE CORNER OF SECT. 2, T12N,
R9E FD. 2 STONES AND IRON
SET BY CORNING PER. BDR. NO.
194 NOW A CONCRETE MONUMENT

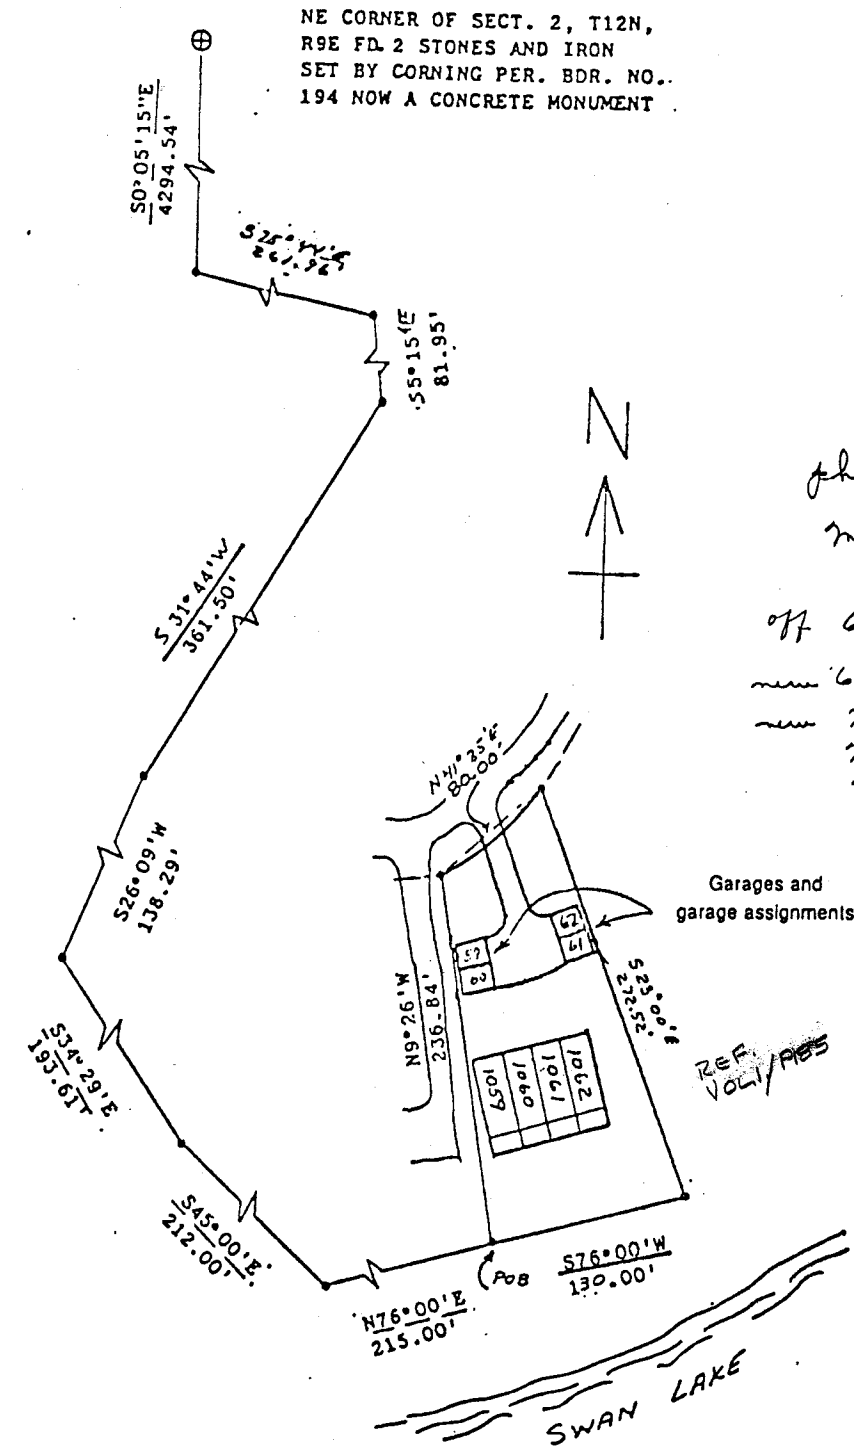

phase 6
model 7


off 65.3 per 10
new 681.6 0.60 A
new 767 - Unit 1059
768 - Unit 1060
769 - Unit 1061
770 - Unit 1062

Garages and
garage assignments

REF.
VOL. 1 P. 28

AMENDMENT TO
CONDOMINIUM PLAT OF
SADDLE RIDGE
PHASE VI

THIS SURVEY DESCRIBES LAND AND
BUILDINGS SUBJECT TO THE CONDO-
MINIUM DECLARATION FOR SADDLE RIDGE.

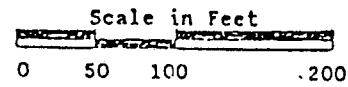


SADDLE RIDGE PHASE VI DESCRIPTION

A parcel of land in Government Lot 4, Section 1, T12N, R9E, Town of Pacific, Columbia County, Wisconsin, bounded by the following described line: Commencing at the northwest corner of said Section 1; Thence S0°05'15\"/>

I, Alvin F. Hamele, hereby certify that I have surveyed the above described property and that this plat is an accurate representation of the exterior boundary lines and the location of the buildings, garages and drives constructed or to be constructed upon the property and that the plat is a correct representation of Saddle Ridge Phase VI as proposed at the date hereof, and the identification and location of each unit and the common elements can be determined from the plat.


Date Feb 12, 1981 Alvin F. Hamele
Alvin F. Hamele,
Land Surveyor No. S-1453

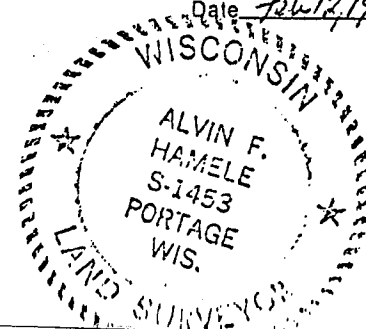

Amendment to
Saddle Ridge Condominium Plat
Page 4

garages and drives constructed or to be constructed upon the property and that the plat is a correct representation of Saddle Ridge Phase V as proposed at the date hereof, and the identification and location of each unit and the common elements can be determined from the plat.

Date Feb 12, 1981 Alvin F. Hamele
Alvin F. Hamele,
Land Surveyor No. S-1453

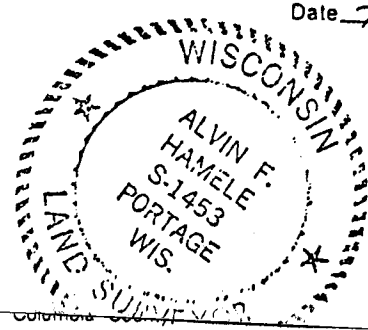


Amendment to
Saddle Ridge Condominium Plat
Page 3

described line: Commencing at the northeast corner of said Section 2; Thence S0°05'15\"/>

I, Alvin F. Hamele, hereby certify that I have surveyed the above described property and that this plat is an accurate representation of the exterior boundary lines and the location of the buildings, garages and drives constructed or to be constructed upon the property and that the plat is a correct representation of Saddle Ridge Phase IV as proposed at the date hereof, and the identification and location of each unit and the common elements can be determined from the plat.

Date Feb 12, 1981 Alvin F. Hamele
Alvin F. Hamele,
Land Surveyor No. S-1453

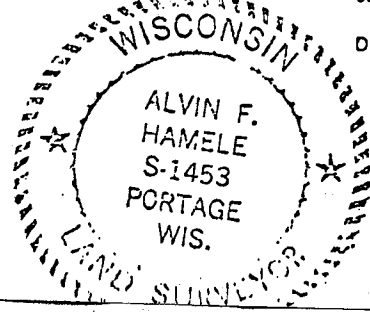

Amendment to
Saddle Ridge Condominium Plat
Page 2

V. 1 P. 28
condominium plat


Replaced
2004

739

thru

770

0.60 A

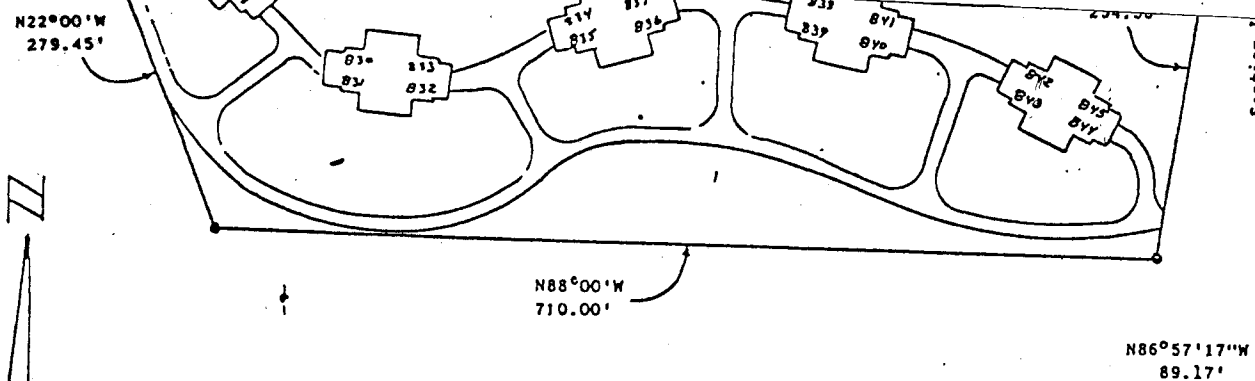

SEX - NEX
2 - 12 - 9

• = FOUND IRON ROD

741	820
742	829
743	830
744	831
745	832
746	833
747	834
748	835
749	836
750	837
751	838
752	839
753	840
754	841
755	842
756	843
757	844
758	845

Phase VII models 8+9
V.1 P. 89 Condo Plat
1984 Assessment Roll
S.1-12-9



(vno)

Saddle Ridge
Town of Pacific

Phase VIII models 9+10
V.1 P. 90 Condo Plat
1984 Assessment Roll
S.2-12-9

Covenants R261-166

V/Condo P. 89

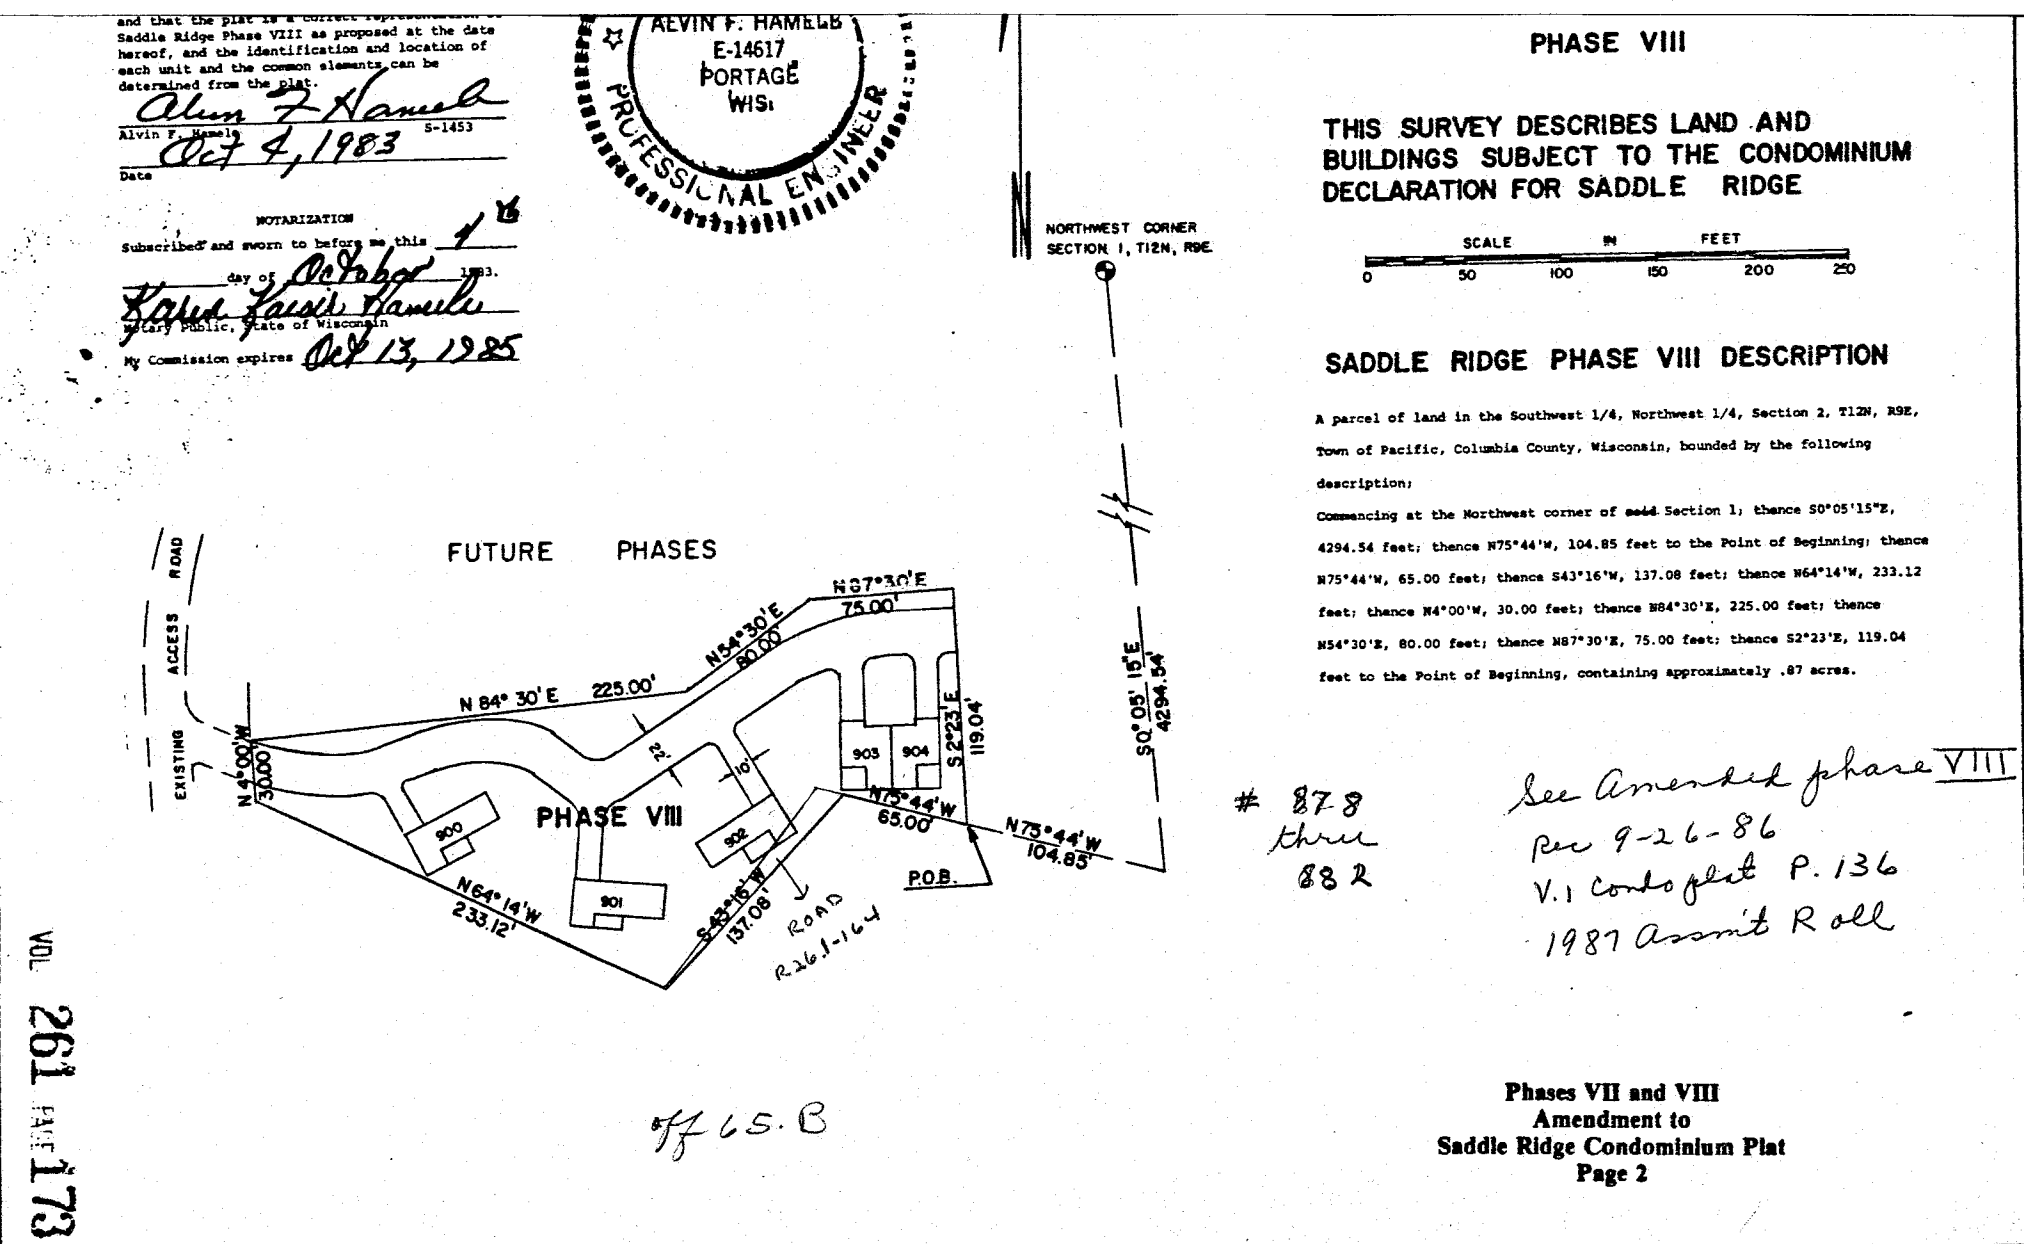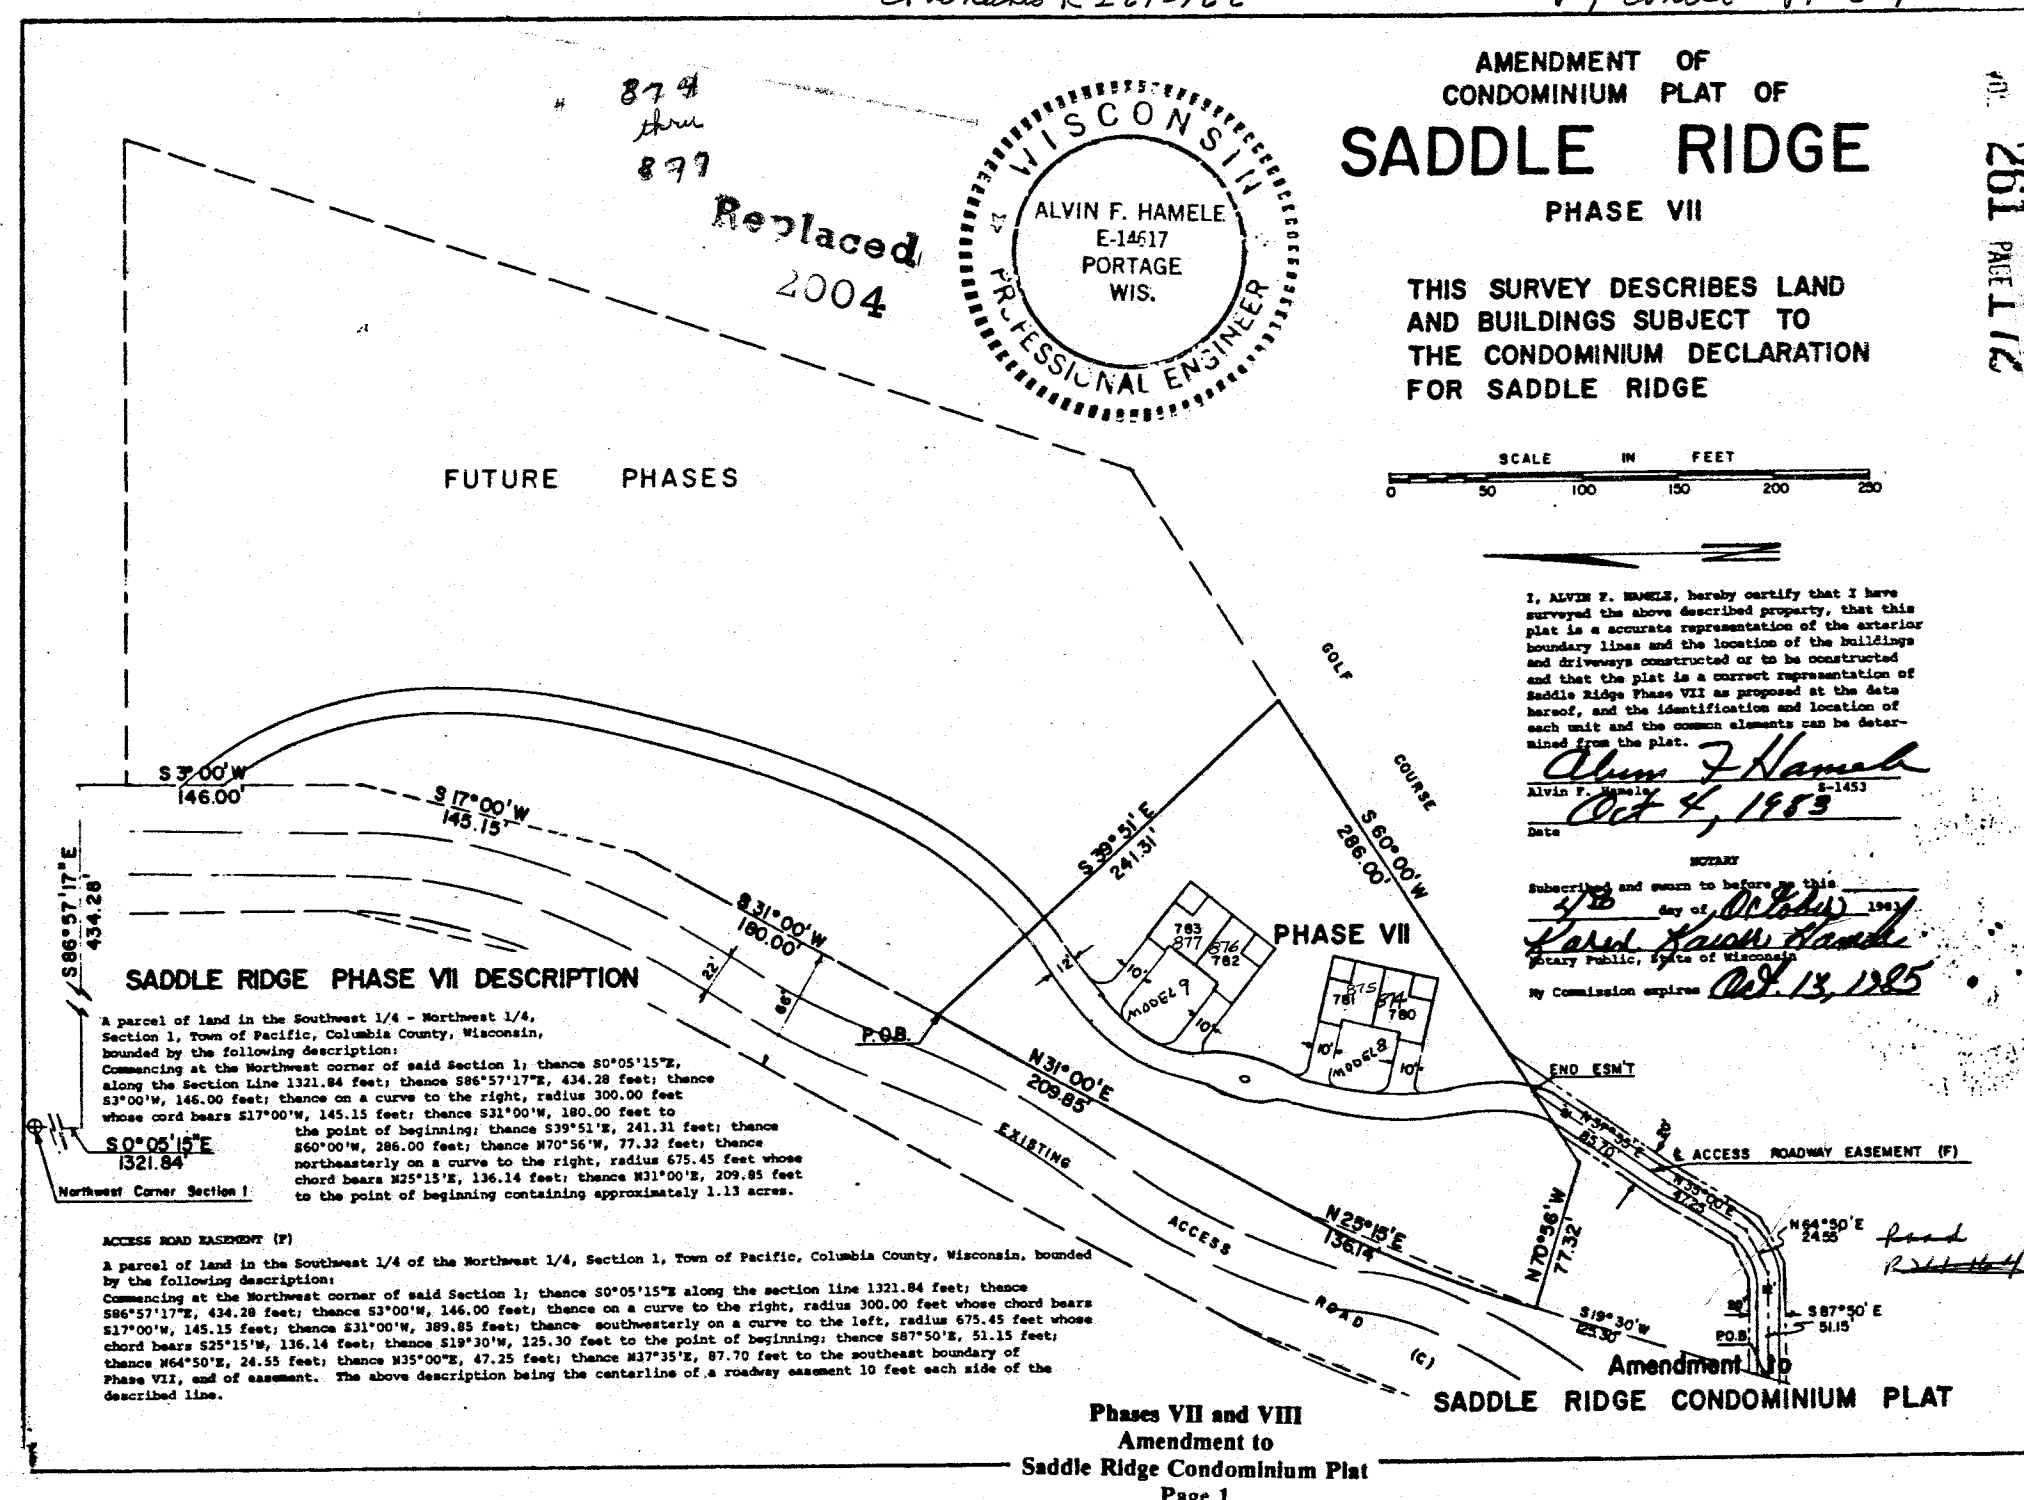

Saddle Ridge Estate
Town Pacific Plat G.L.1 S.2-12-9
Amended phase VIII
SEE 2ND AMEND. VOL 1-P147

V.1 Conts P. 136
Per 2-26-86
1987 Assmt

V.1 P. 136

Amended Phase VIII

1987 Assmt Roll
#878 thru 882

STATE OF WISCONSIN
COLUMBIA COUNTY
Received for record the 26
Day of September A.D. 1986
at 10:00 clock P.M. and recorded
in Vol. 1 of Records Page 136.

2004
SADDLE RIDGE
AMENDMENT TO CONDOMINIUM TRACT OF
SADDLE RIDGE
COLUMBIA COUNTY

THIS SURVEY DESCRIBES THE LAND
AND BUILDINGS SUBJECT TO THE
CONDOMINIUM DECLARATION FOR
SADDLE RIDGE

AMENDED PHASE VIII

AMENDED PHASE VIII Description

A parcel of land located in Government Lot 1, Section 2, T12N, R9E, Town of Pacific, Columbia County, Wisconsin bounded by the following described line: Commencing at the northeast of said Section 2; thence S0°05'15"E, 4294.54 feet; thence N75°44'W, 46.73 feet; thence S71°58'W, 92.09 feet to the point of beginning; thence S71°58'W, 132.21 feet; thence N64°14'W, 233.12 feet; thence N4°00'W, 30.00 feet; thence N84°30'E, 225.00 feet; thence N54°30'E, 80.00 feet; thence N87°30'E, 42.00 feet; thence S2°23'E, 160.31 feet to the point of beginning. Said parcel contains 39,040 square feet or 0.896 acres.

Image of this plan.

Graphic scale in feet:
0 25 50 100 150

EXISTING ACCESS
ROAD EASEMENT

FUTURE PHASES


AMENDED
PHASE VIII

UNIT 791, 792 UNIT 790, 792
BASEMENT PLAN


An agreement has been signed by Kenneth Carlson and Carl Berst to exclude certain requirements of A-E 5, Wisconsin Administrative Code, namely setting monuments at the corners of the parcel described.

I, Kenneth G. Carlson, registered land surveyor, hereby certify that the drawings appearing hereon are an accurate copy of portions of the plans of each building and substantially depict the layout, location, unit numbers and dimensions of the building or buildings and units located and erected or to be erected.

I, Kenneth G. Carlson, registered land surveyor, hereby certify that the drawings appearing hereon are an accurate copy of portions of the plans of each building and substantially depict the layout, unit numbers and dimensions of the building or buildings and located and erected or to be erected.

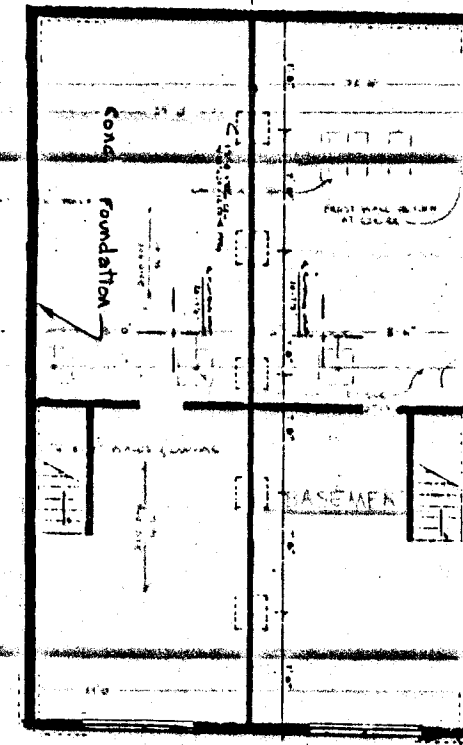

UNIT 894, 897, 898
BASEMENT PLAN
UNIT 903
BASEMENT PLAN
UNIT 904
BASEMENT PLAN

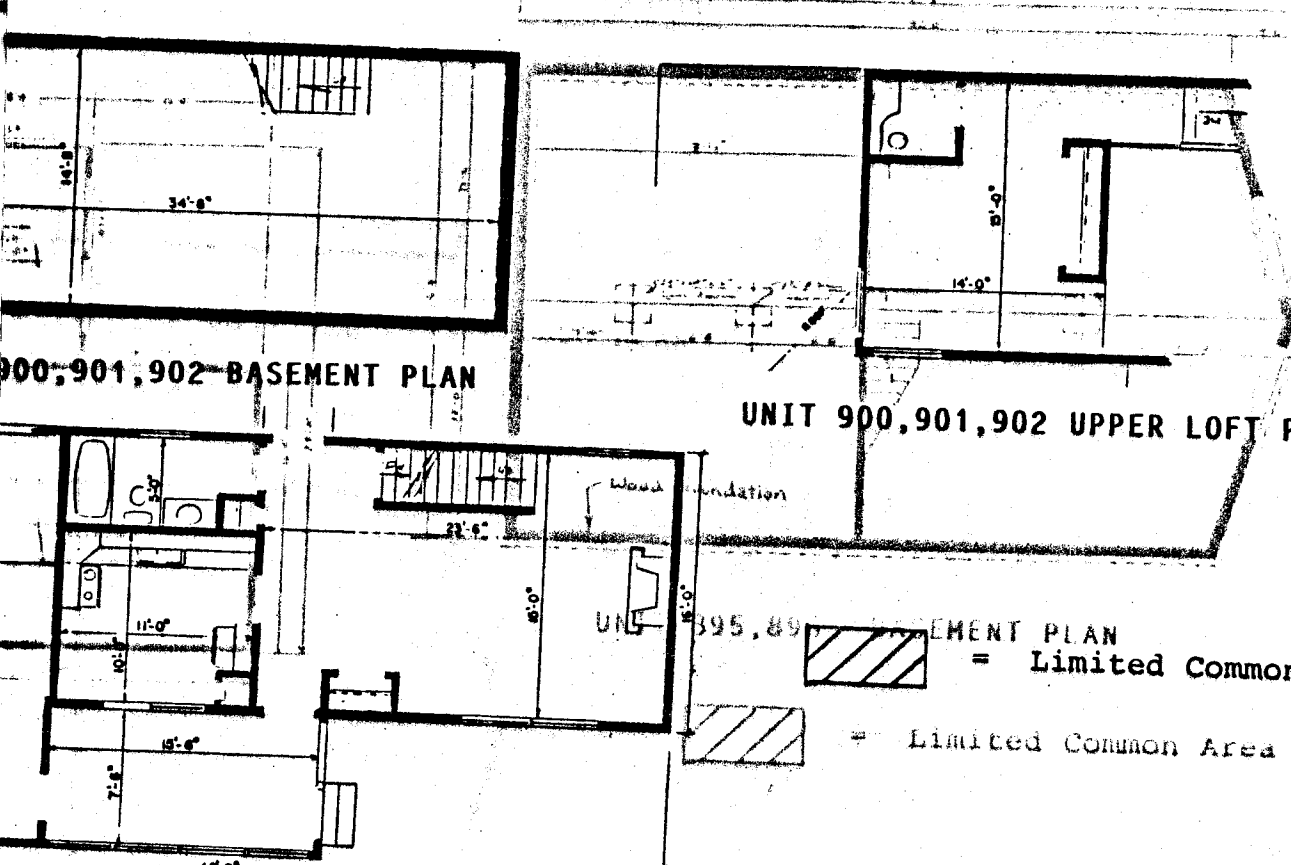

UNIT 900, 901, 902
FIRST FLOOR PLAN



UNIT 900, 901, 902 UPPER LOFT PLAN

UNIT 900, 901, 902
= Limited Common Area
= Limited Common Area

Condominium Plat Amended Phase VIII
PAGE 1 of 1 PAGE
PLAT 2 OF 3 PAGES

Replaced
2004

SR
P. 147

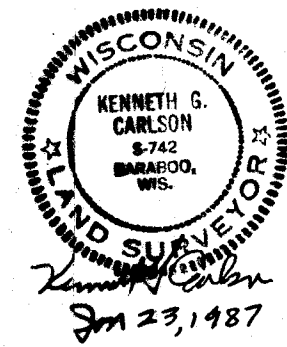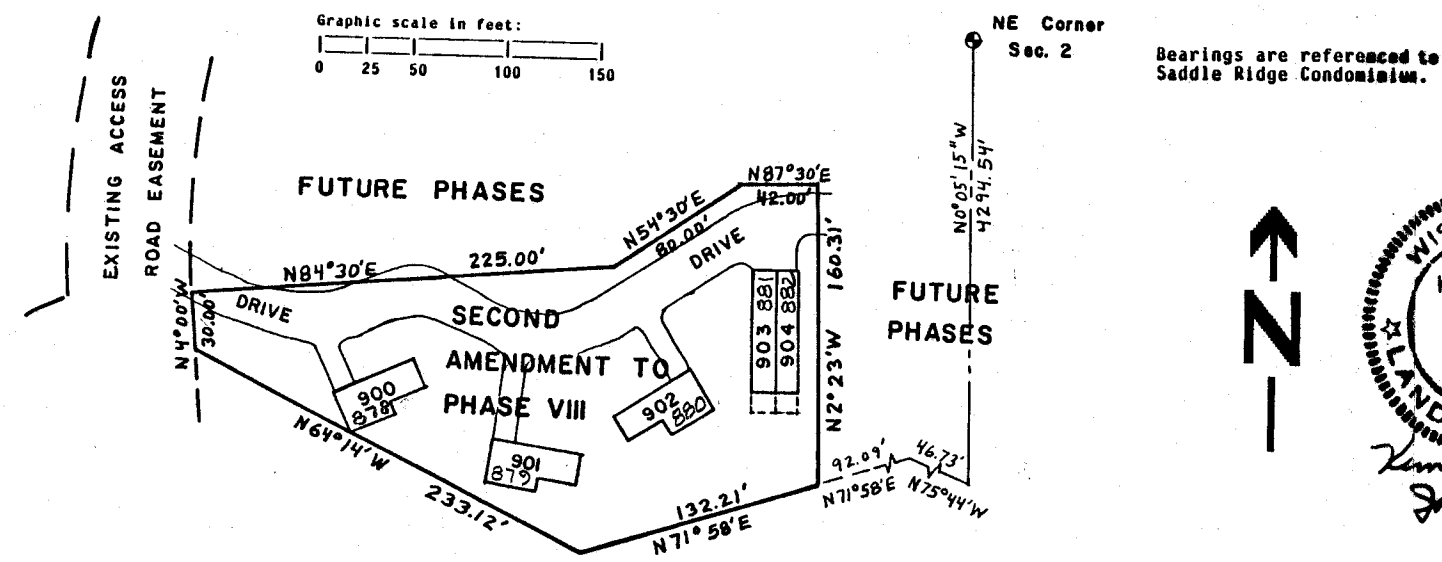

AMENDMENT TO CONDOMINIUM PLAT OF
SADDLE RIDGE
COLUMBIA COUNTY

THIS SURVEY DESCRIBES THE LAND
AND BUILDINGS SUBJECT TO THE
CONDOMINIUM DECLARATION FOR
SADDLE RIDGE

SECOND AMENDMENT TO PHASE VIII


An agreement has been signed by Kenneth Carlson and Carl Burst to exclude certain requirements of A-E 5, Wisconsin Administrative Code, namely setting monuments at the corners of the parcel described.

I, Kenneth G. Carlson, registered land surveyor, hereby certify that the drawings appearing hereon are an accurate copy of portions of the plat of each building and substantially depict the layout, location, unit numbers and dimensions of the building or buildings and units located and erected or to be erected.


I, Kenneth G. Carlson, registered land surveyor, hereby certify that I have surveyed the above described parcel, that this plat is a correct representation of the exterior boundaries of the parcel described and the location of the building and driveways constructed or to be constructed as proposed at the date hereof and the identification and location of each unit and the common elements can be determined.

SECOND AMENDMENT TO PHASE VIII Description:


A parcel of land located in Government Lot 1, Section 2, T12N, R9E, Town of Pacific, Columbia County, Wisconsin bounded by the following described line: Commencing at the northeast of said Section 2; thence S0°05'15"E, 4294.54 feet; thence N75°44'W, 46.73 feet; thence S71°58'W, 92.09 feet to the point of beginning; thence S71°58'W, 132.21 feet; thence N64°14'W, 233.12 feet; thence N4°00'W, 30.00 feet; thence N84°30'E, 225.00 feet; thence N54°30'E, 80.00 feet; thence N87°30'E, 42.00 feet; thence S2°23'E, 160.31 feet to the point of beginning. Said parcel contains 39,040 square feet or 0.896 acres.

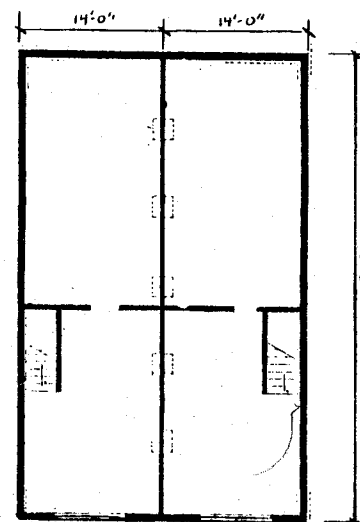


UNIT 903
BASEMENT PLAN

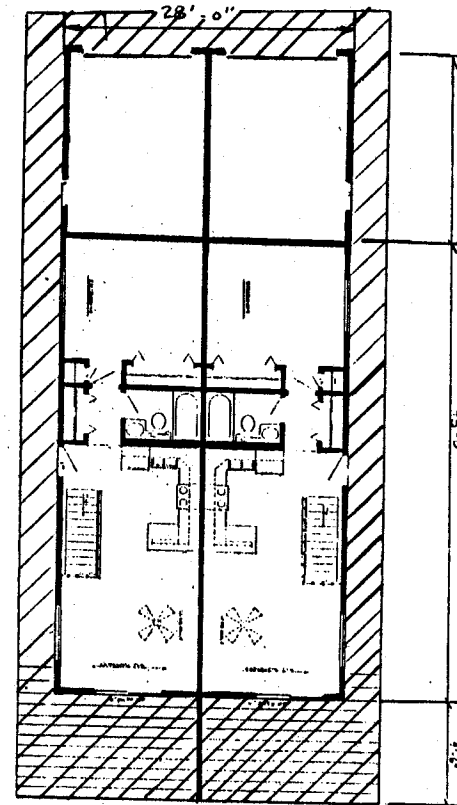


UNIT 904
FIRST FLOOR PLAN

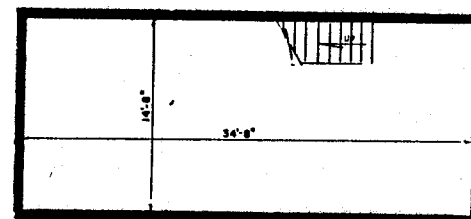

UNIT 900,901,902 BASEMENT PLAN

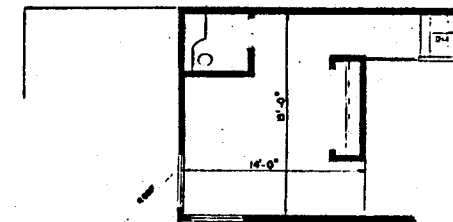



UNIT 900,901,902 UPPER LOFT PLAN

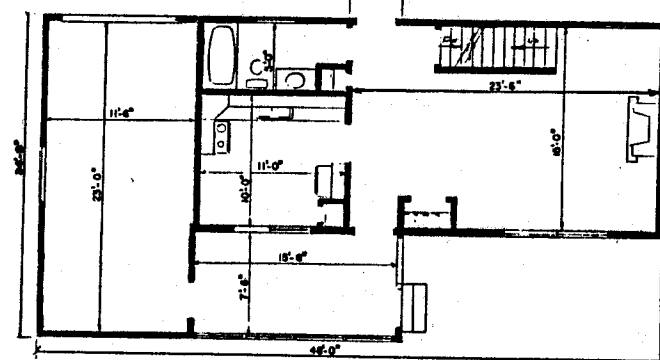

UNIT 900,901,902 FIRST FLOOR PLAN

Legend: = Limited Common Area

Condominium Plat
Second Amendment to Phase VIII
PAGE 1 of 1 PAGE

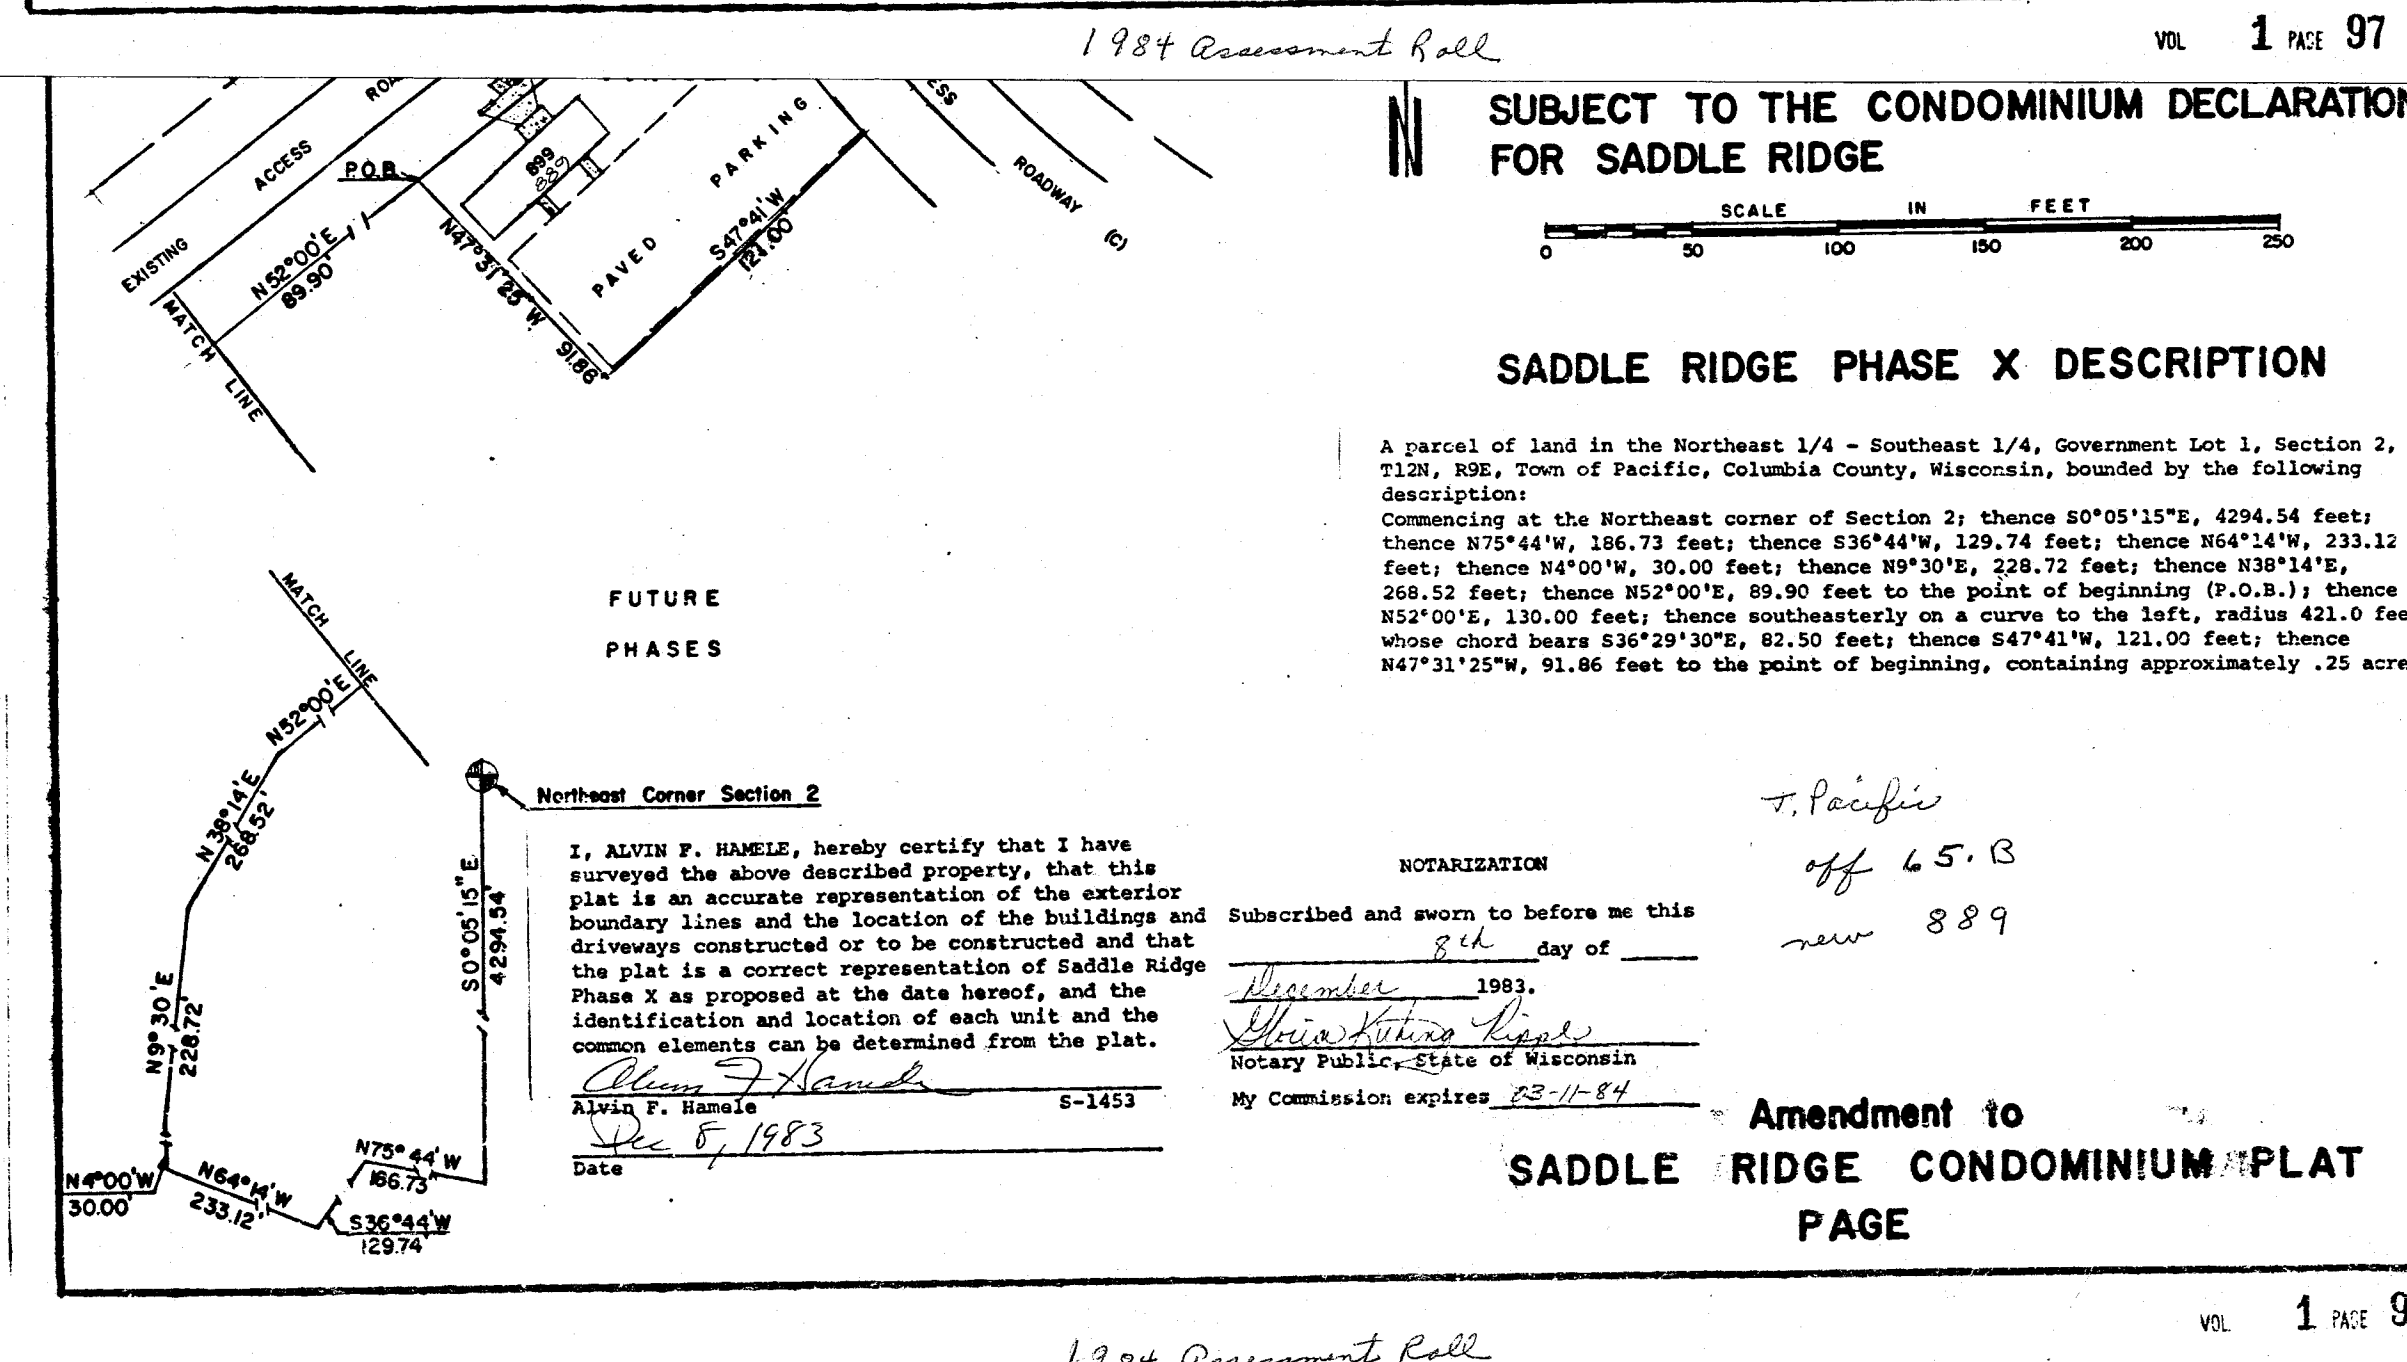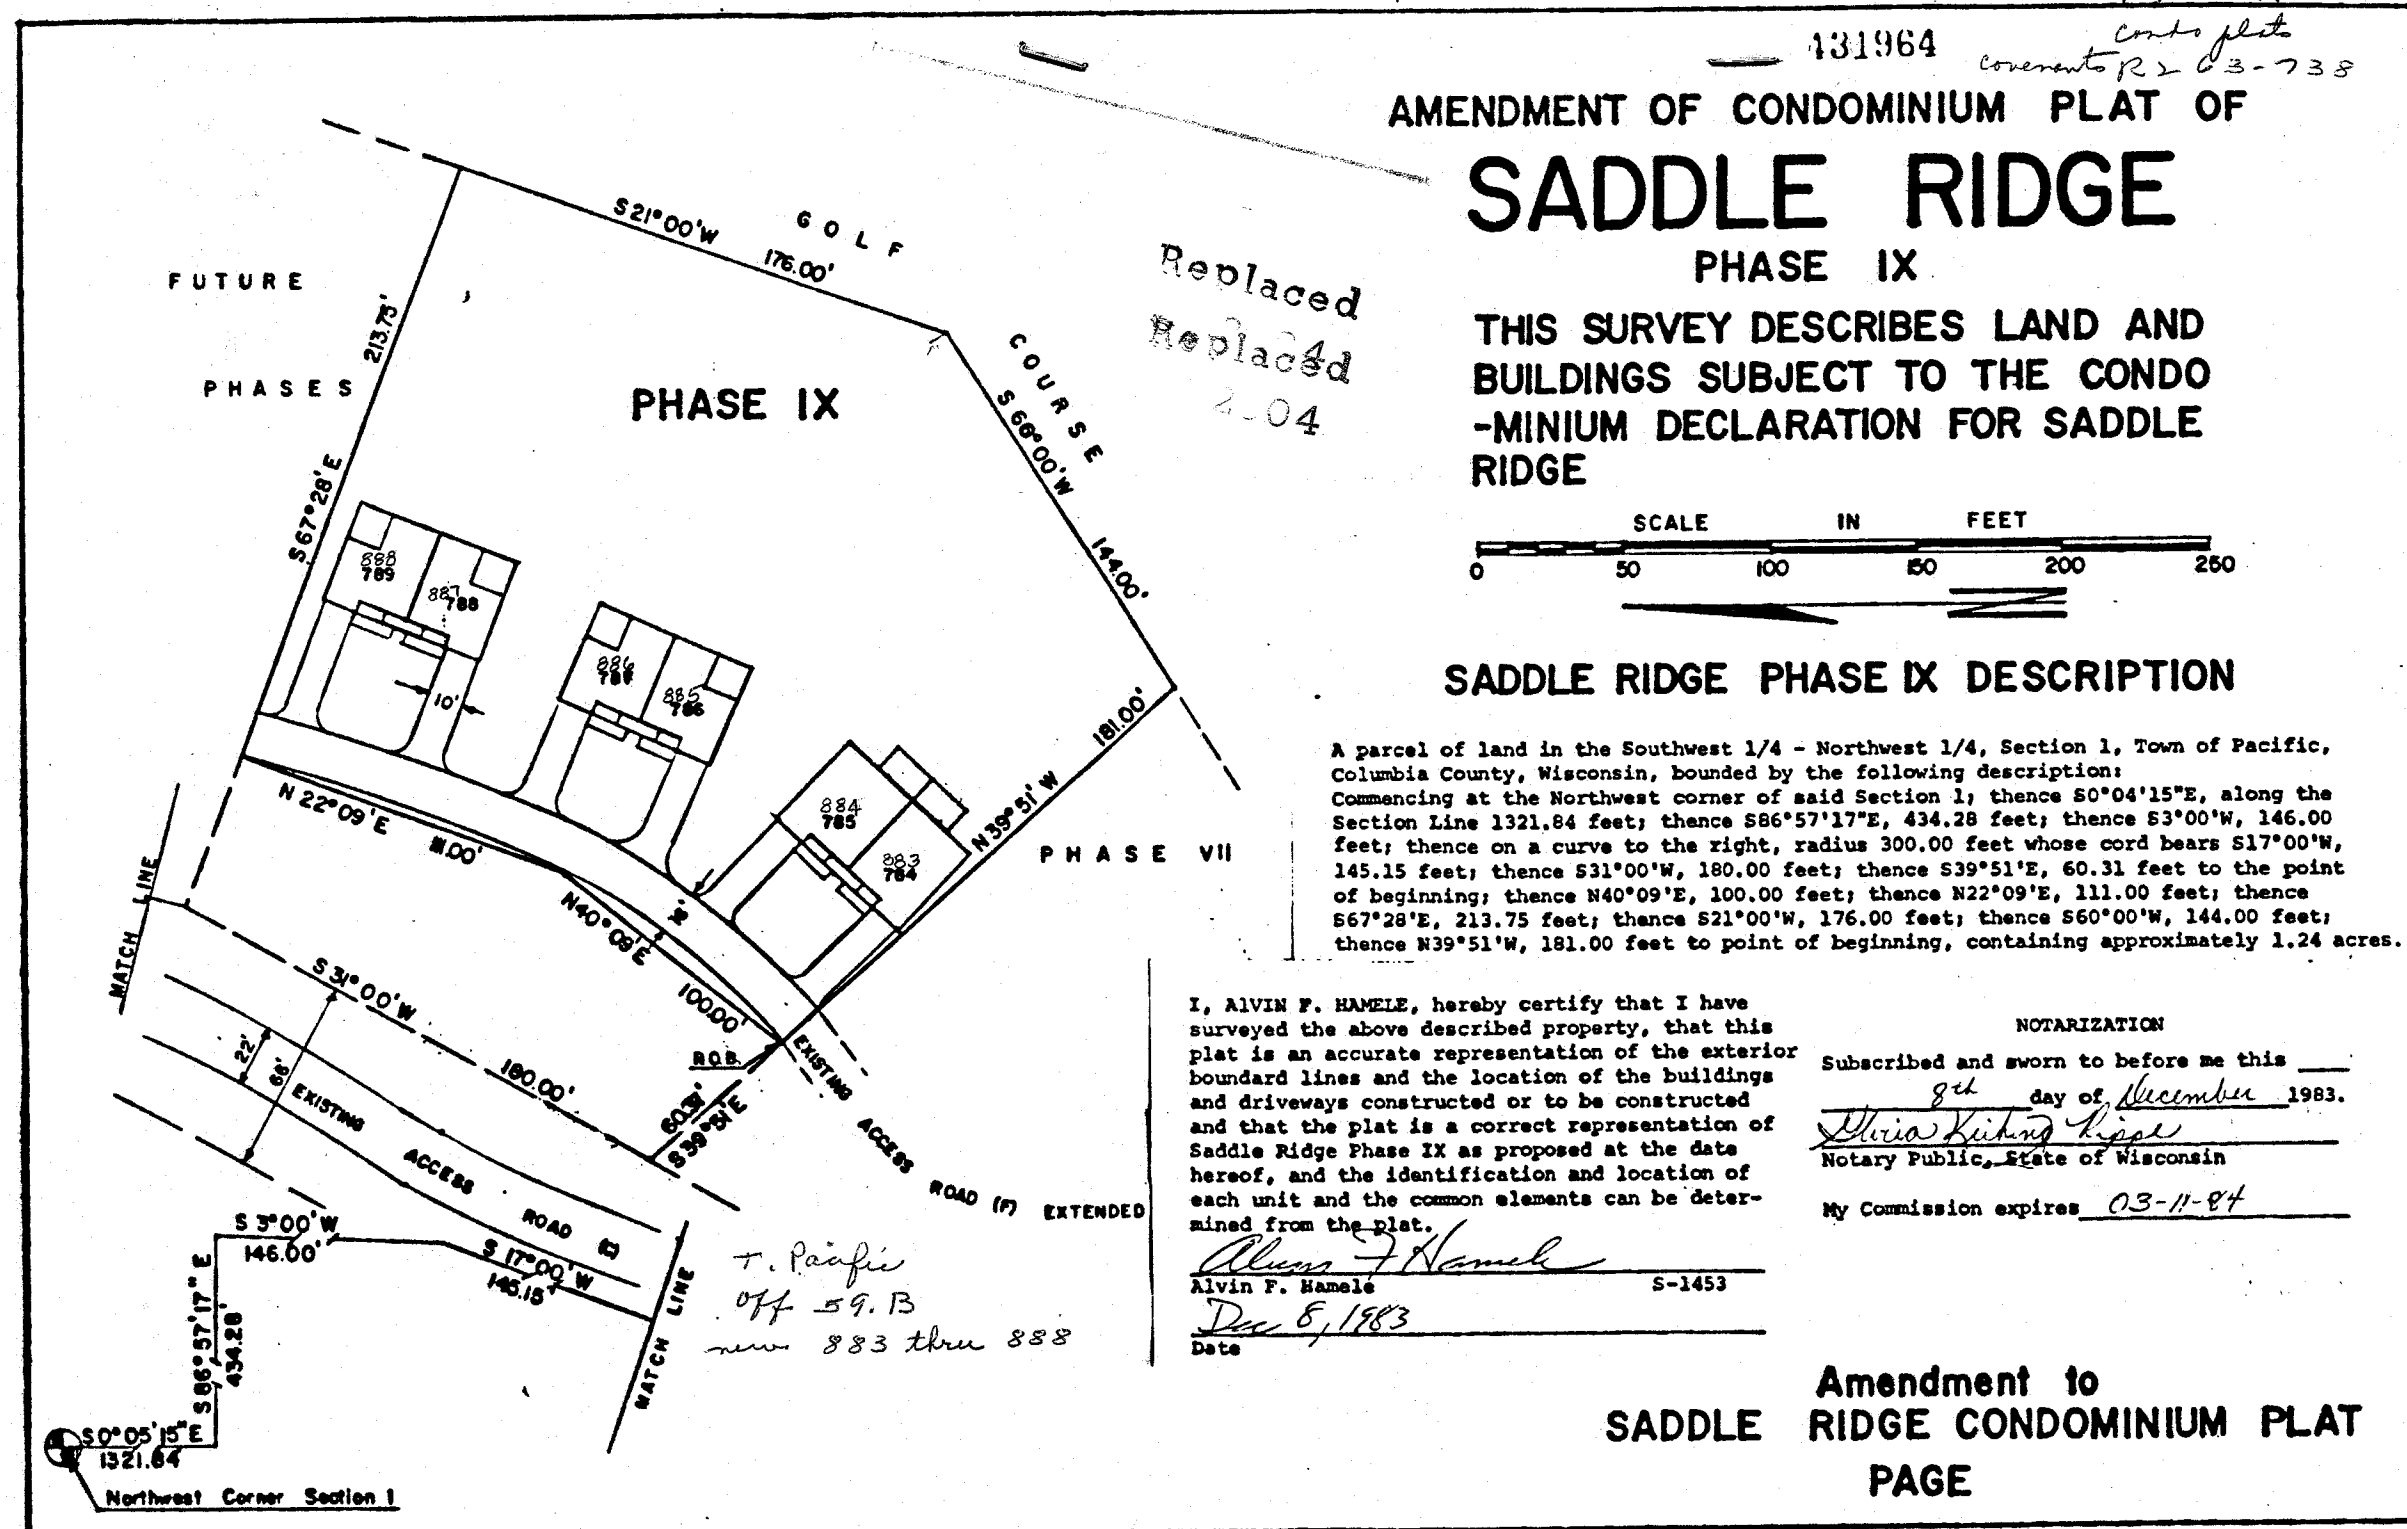

Amendment to Condominium Plat
Saddle Ridge

Town of Pacific

Sec. 1-12-9

NE & SE 1/4 Sec. 2-12-9

Phase XI

#915-928

1987 Assmt Roll
V. & Condo P. 139
Pr 9-26-86

Replaced
2004

452519

AMENDED
PHASE I

FUTURE
PHASES

FUTURE PHASES

PHASE
XI

PARCEL 1

PHASE IX

Graphic scale in feet:
0 25 50 100 150

PHASE XI PARCEL 1 Description:

A parcel of land located in the SW-NE, Section 1, T12N, R9E, Town of Pacific, Columbia County, Wisconsin bounded by the following described line: Beginning at the northwest corner of PHASE IX of Saddle Ridge Condominium; thence N3°30'W, 160.46 feet; thence S85°56'E, 292.92 feet; thence S21°00'W, 237.00 feet; thence N67°28'W, 213.75 feet to the point of beginning. Said parcel contains 48,610 square feet or 1.116 acres.

PHASE XI PARCEL 2 Description:

A parcel of land located in the NE-SE, Section 2, T12N, R9E, Town of Pacific, Columbia County, Wisconsin bounded by the following described line: Commencing at the northwest corner of PHASE V of Saddle Ridge Condominium; thence N27°00'E, 470.00 feet to the point of beginning; thence N12°00'E, 150.00 feet; thence N88°00'E, 150.00 feet; thence S27°10'E, 324.78 feet; thence S52°00'W, 233.58 feet; thence N27°22'W, 316.18 feet to the point of beginning. Said parcel contains 84,640 square feet or 1.943 acres.


PHASE XI PARCEL 3 Description:

A parcel of land located in Government Lot 1, Section 2, T12N, R9E, Town of Pacific, Columbia County, Wisconsin bounded by the following described line: Commencing at the northeast corner of said Section 2; thence S0°05'15"E along the section line, 4294.54 feet; thence N75°44'W, 24.47 feet; thence N2°23'W, 142.06 feet; thence S87°30'W, 152.00 feet; thence S54°30'W, 80.00 feet; thence S84°30'W, 135.00 feet to the point of beginning; thence S84°30'W, 90.00 feet; thence N30°43'E, 302.83 feet; thence S14°30'W, 260.00 feet to the point of beginning. Said parcel contains 10,990 square feet or 0.252 acres.

PHASE XI PARCEL 4 Description:

A parcel of land located in Government Lot 1, Section 2, T12N, R9E, Town of Pacific, Columbia County, Wisconsin bounded by the following described line: Commencing at the northeast corner of said Section 2; thence S0°05'15"E along the section line, 4294.54 feet; thence N75°44'W, 22.26 feet; thence S71°58'W, 92.09 feet; thence N2°23'W, 160.31 feet; thence N87°30'E, 110.00 feet; thence S2°23'E, 142.06 feet to the point of beginning. Said parcel contains 16,080 square feet or 0.369 acres.

Graphic scale in feet:
0 25 50 100 150

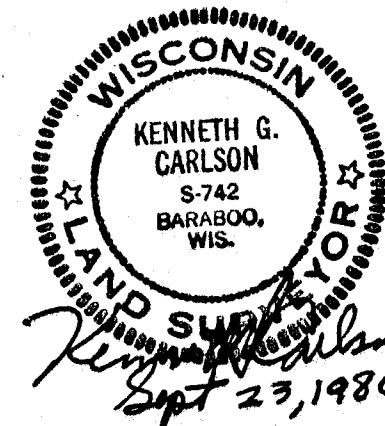

⊙ = Found 1" round iron rod

An agreement has been signed by Kenneth Carlson and Carl Berst to exclude certain requirements of A-E 5, Wisconsin Administrative Code, namely setting monuments at the corners of the parcel described.

I, Kenneth G. Carlson, registered land surveyor, hereby certify that I have surveyed the above described parcel, that this plat is a correct representation of the exterior boundaries of the parcel described and the location of the building and driveways constructed or to be constructed as proposed at the date hereof and the identification and location of each unit and the common elements can be determined.

AMENDMENT TO CONDOMINIUM
SADDLE RIDGE
COLUMBIA COUNTY

THIS SURVEY DESCRIBES THE
AND BUILDINGS SUBJECT TO THE
CONDOMINIUM DECLARATION FOR
SADDLE RIDGE

PHASE XI

FUTURE PHASES

PHASE XI
PARCEL 2

FUTURE PHASES

Bearings are referenced to
Saddle Ridge Condominium.

off 57.8
off 65.8
off 84. A
but 90.3
new 915 thru 928

Section 1 - off 1
Section 2 - off 2-3-4


PHASE V

*Saddle Ridge Condominium
Town Pacific*

Phase XI
1986 Assmt Roll
2-2-12-9

See
Amended plat
V.1 Conto P.139
Rec 9-26-86
1987 Assmt Roll

An agreement has been signed by Kenneth Carlson and Carl Berst to exclude certain requirements of A-E 5, Wisconsin Administrative Code, namely setting monuments at the corners of the parcel described.

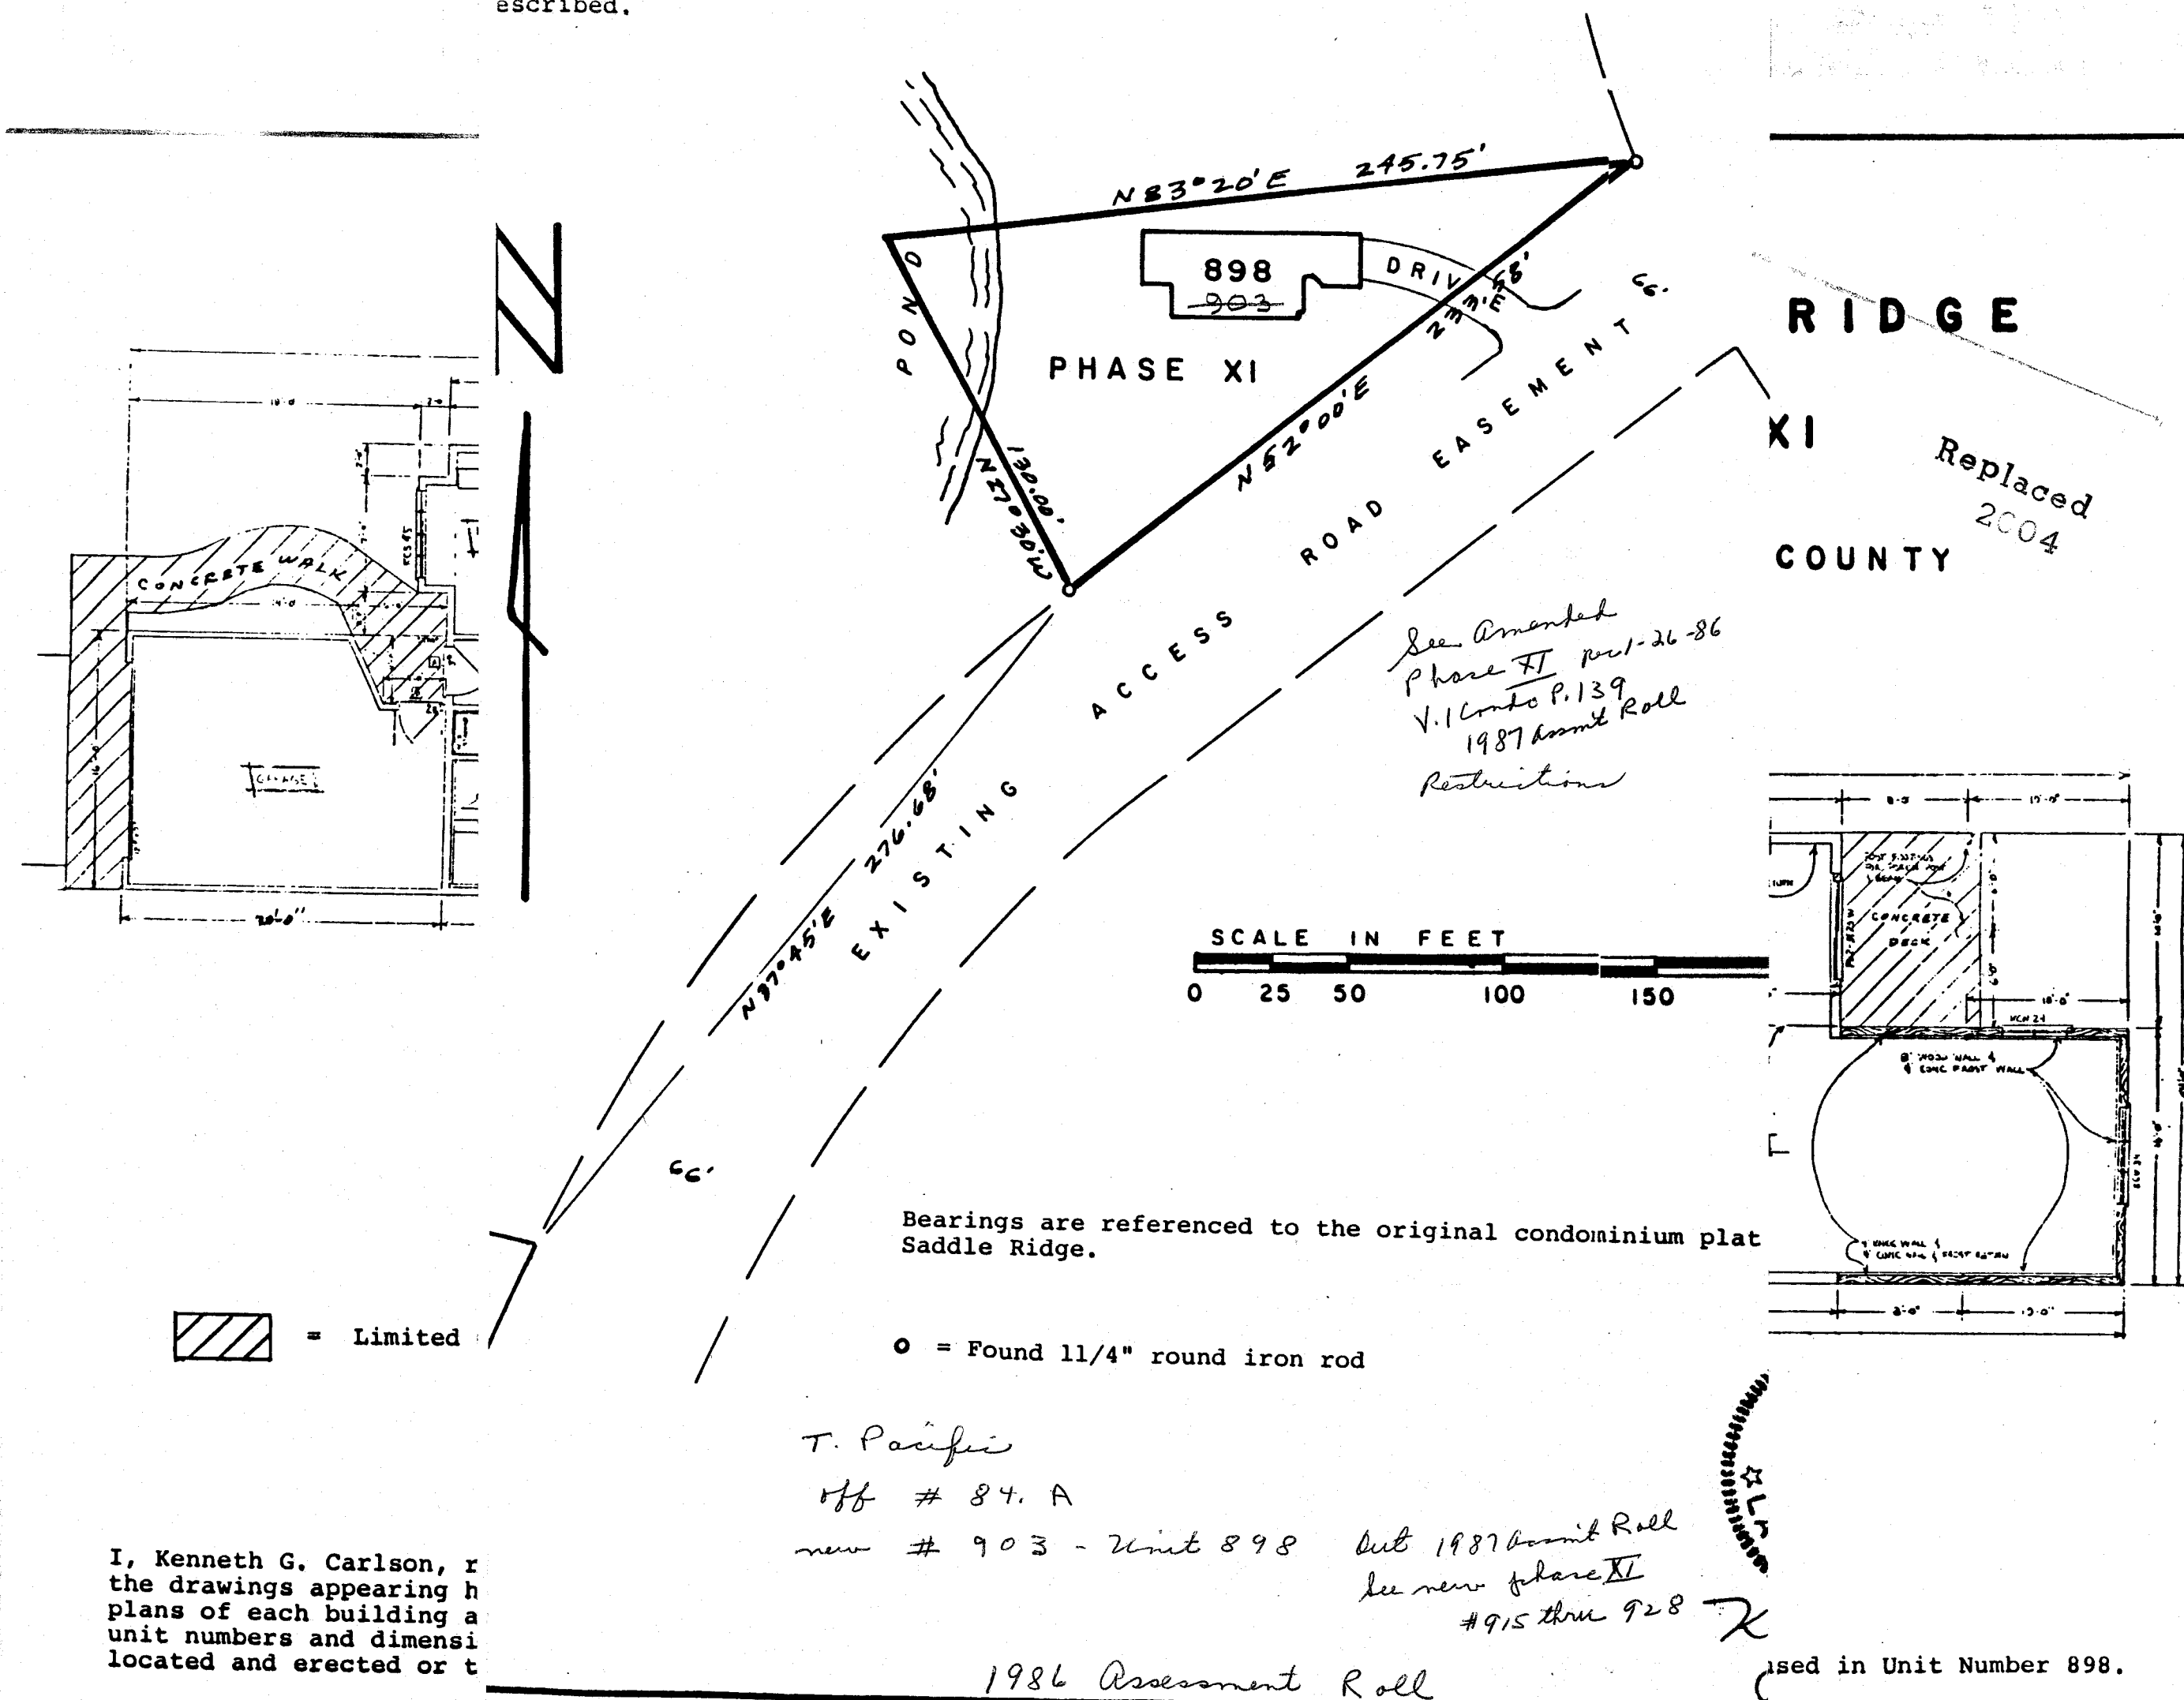

1-143

Saddle Ridge
Town of Pacific

Vol. 1 Condo 176

'90

478054

AMENDMENT TO CONDOMINIUM PLAT OF
SADDLE RIDGE
COLUMBIA COUNTY

THIS SURVEY DESCRIBES THE LAND
AND BUILDINGS SUBJECT TO THE
CONDOMINIUM DECLARATION FOR
SADDLE RIDGE

SECOND AMENDMENT TO PHASE XI

Replaced
2004

SR
P110 and

AMENDED PHASE XI PARCEL 1 Description:

A parcel of land located in the SW-1/4, Section 1, T12N, R9E, Town of Pacific, Columbia County, Wisconsin bounded by the following described line: Beginning at the northwest corner of PHASE IX of Saddle Ridge Condominium; thence N3°30'W, 160.46 feet; thence S85°56'E, 272.12 feet; thence S21°00'W, 237.00 feet; thence N67°28'W, 213.75 feet to the point of beginning. Said parcel contains 48,610 square feet or 1.116 acres.

AMENDED PHASE XI PARCEL 2 Description:


A parcel of land located in the NE-1/4, Section 2, T12N, R9E, Town of Pacific, Columbia County, Wisconsin bounded by the following described line: Commencing at the northwest corner of PHASE V of Saddle Ridge Condominium; thence N27°00'E, 470.00 feet to the point of beginning; thence N12°00'E, 150.00 feet; thence N88°00'E, 150.00 feet; thence S27°10'E, 324.78 feet; thence S52°00'W, 233.58 feet; thence N27°22'W, 316.18 feet to the point of beginning. Said parcel contains 84,640 square feet or 1.943 acres.

AMENDED PHASE XI PARCEL 3 Description:

A parcel of land located in Government Lot 1, Section 2, T12N, R9E, Town of Pacific, Columbia County, Wisconsin bounded by the following described line: Commencing at the northeast corner of said Section 2; thence S0°05'15"E along the section line, 4294.54 feet; thence N75°44'W, 24.47 feet; thence N2°23'W, 142.06 feet; thence S87°30'W, 152.00 feet; thence S54°30'W, 80.00 feet; thence S84°30'W, 135.00 feet to the point of beginning; thence S84°30'W, 90.00 feet; thence N30°43'E, 302.63 feet; thence S14°30'W, 260.00 feet to the point of beginning. Said parcel contains 10,990 square feet or 0.252 acres.

AMENDED PHASE XI PARCEL 4 Description:

A parcel of land located in Government Lot 1, Section 2, T12N, R9E, Town of Pacific, Columbia County, Wisconsin bounded by the following described line: Commencing at the northeast corner of said Section 2; thence S0°05'15"E along the section line, 4294.54 feet; thence N75°44'W, 24.47 feet to the point of beginning; thence N2°23'W, 142.06 feet; thence S87°30'W, 152.00 feet; thence S54°30'W, 80.00 feet; thence S84°30'W, 135.00 feet to the point of beginning; thence S84°30'W, 90.00 feet; thence N30°43'E, 302.63 feet; thence S14°30'W, 260.00 feet to the point of beginning. Said parcel contains 16,000 square feet or 0.368 acres.

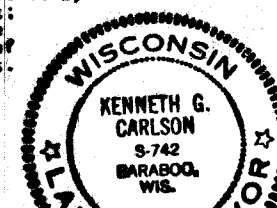





o = Found 1 1/2" round iron rod

An agreement has been signed by Kenneth Carlson and Carl Berst to exclude certain requirements of A-E 5, Wisconsin Administrative Code, namely setting monuments at the corners of the parcel described.


I, Kenneth G. Carlson, registered land surveyor, hereby certify that I have surveyed the above described parcel, that this plat is a correct representation of the exterior boundaries of the parcel described and the location of the building and driveways constructed or to be constructed as proposed at the date hereof and the identification and location of each unit and the common elements can be determined.

Condominium Plat
SADDLE RIDGE
SECOND AMENDMENT TO PHASE XI
Page 1 of 4 Pages


Vol. 1 - Page 176

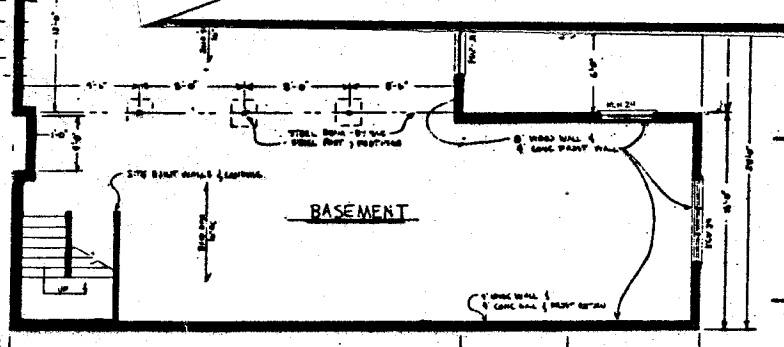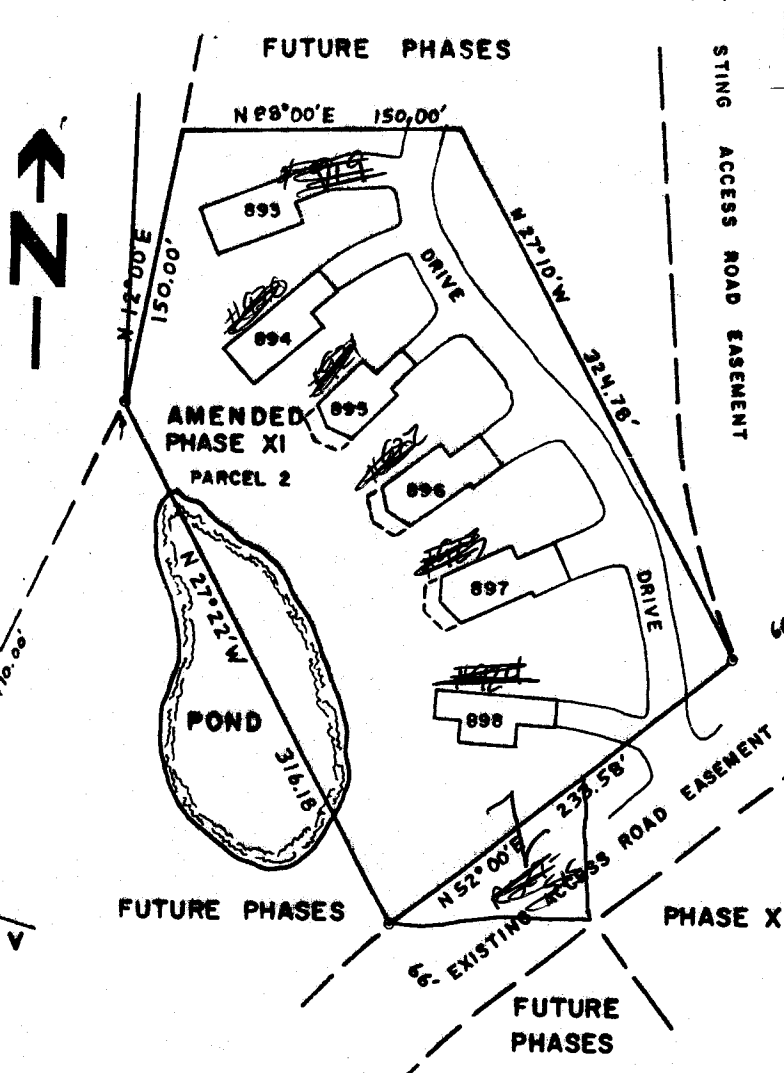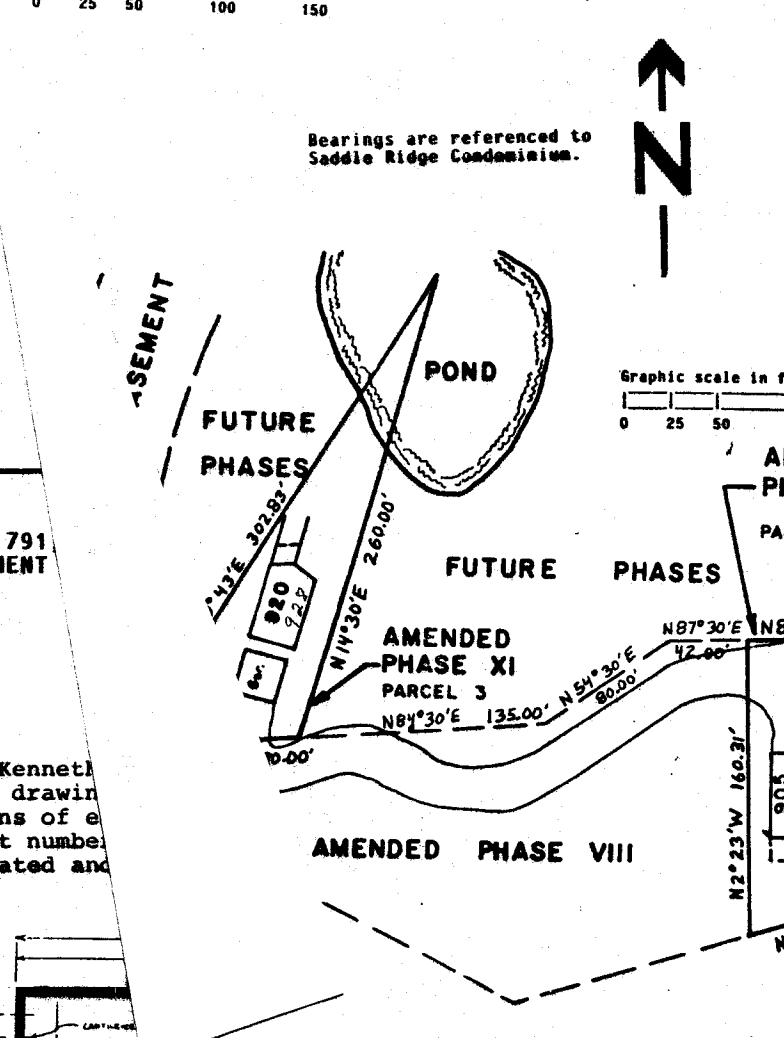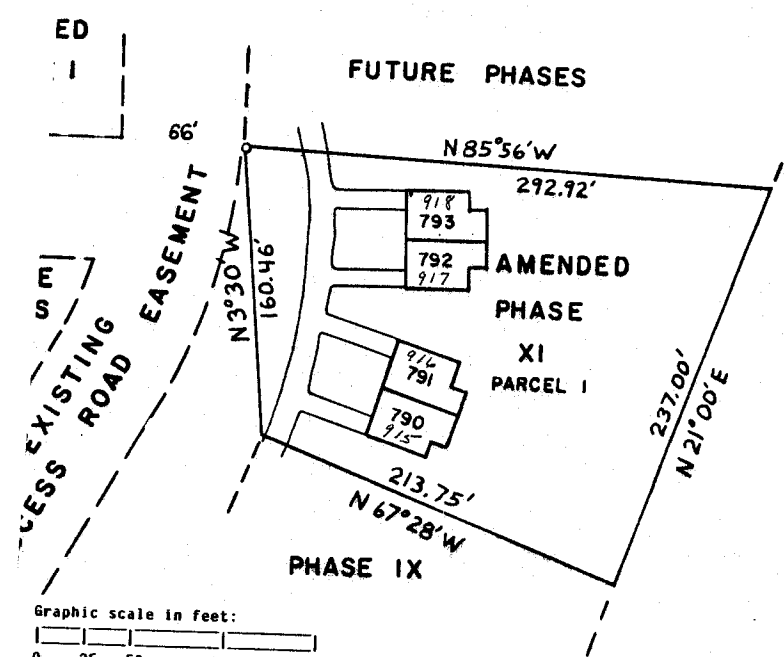

UNIT 894, 898
BASEMENT PLAN

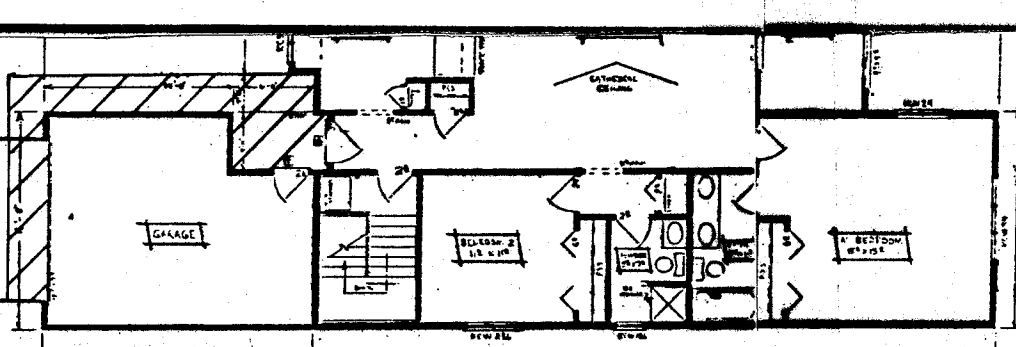

UNIT 898
FIRST FLOOR PLAN

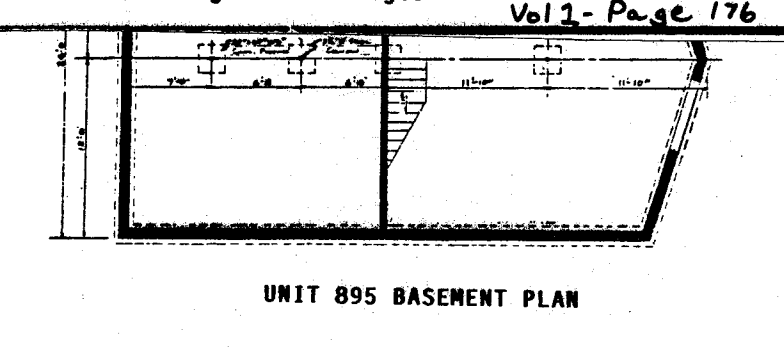

UNIT 895 BASEMENT PLAN


▨ = Limited Common Area

STATE OF WISCONSIN } SS
COLUMBIA COUNTY }
RECEIVED FOR RECORD


OCT 25 1989

Reg. of Deeds at 3:15 P.M.

Condominium Plat
Saddle Ridge
SECOND AMENDMENT TO PHASE XI
Page 2 of 4 Pages

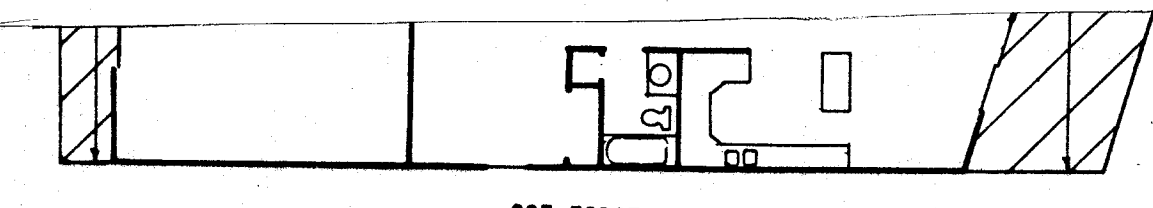


UNIT 907
FIRST FLOOR PLAN

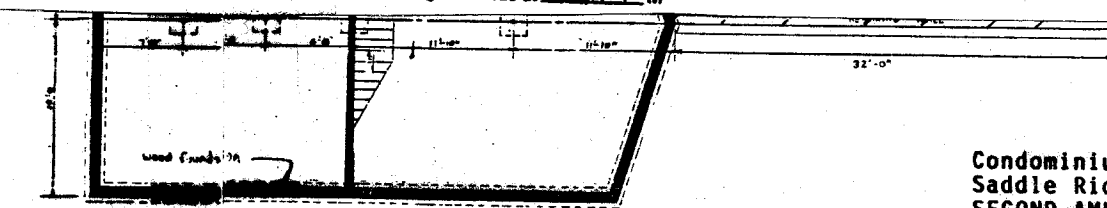

UNIT 920
BASEMENT PLAN

Condominium Plat
Saddle Ridge
SECOND AMENDMENT TO PHASE XI
Page 3 of 4 Pages

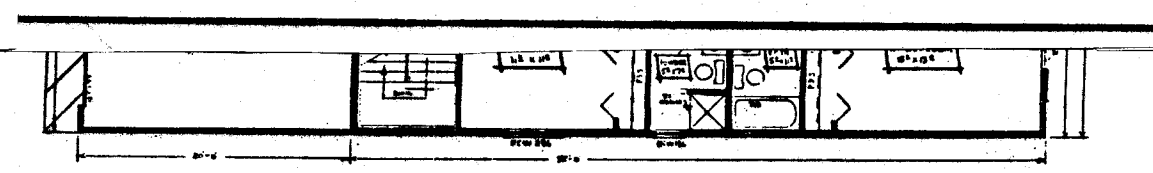

UNIT 894
FIRST FLOOR PLAN

I, Kenneth G. Carlson, registered land surveyor, hereby certify that the drawings appearing hereon are an accurate copy of portions of the plans of each building and substantially depict the layout, location, unit numbers and dimensions of the building or buildings and units located and erected or to be erected.

Condominium Plat
Saddle Ridge
SECOND AMENDMENT TO PHASE XI
Page 4 of 4 Pages

Prev. Shown on Vol. 143

UOL-142
RUC 3-4-87

SR
P12

1-142



SADDLE RIDGE
TN OF PACIFIC

VOL 1-148
REC 5-29-87

Replaced
2004

458782



SR
P13

AMENDMENT TO CONDOMINIUM PLAT OF
SADDLE RIDGE
COLUMBIA COUNTY

THIS SURVEY DESCRIBES THE LAND
AND BUILDINGS SUBJECT TO THE
CONDOMINIUM DECLARATION FOR
SADDLE RIDGE

PHASE XIII

STATE OF WISCONSIN
COLUMBIA COUNTY
Received for record the 29
Day of May A.D. 1987
at 4:00 o'clock P.M. and recorded
in Vol. of Records Page
Marian Robinson
Register of Deeds

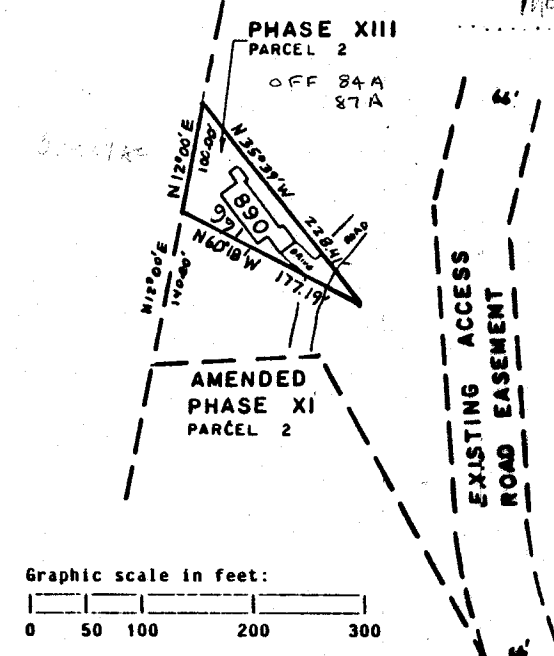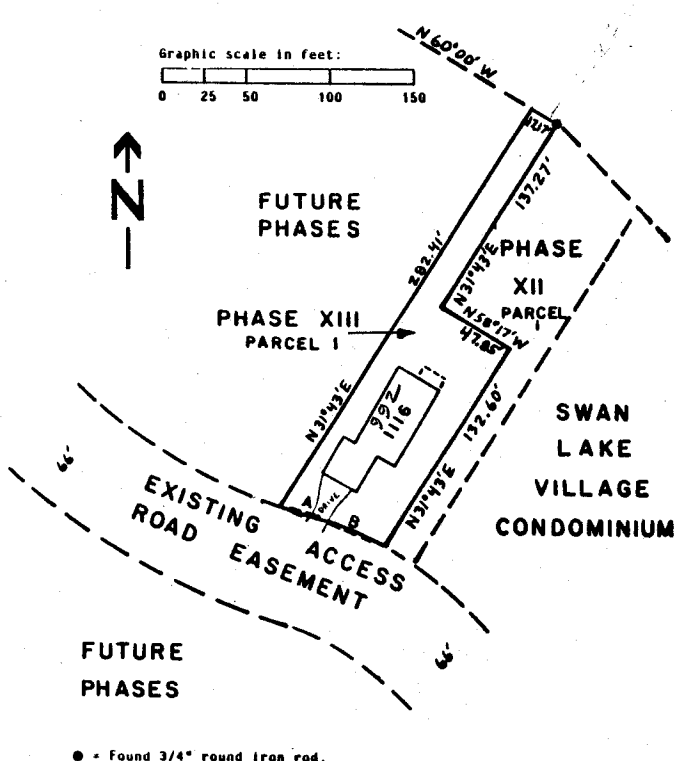

Bearings are referenced to
Saddle Ridge Condominiums

An agreement has been signed by Kenneth Carlson
and Carl Berst to exclude certain requirements
of A-E S, Wisconsin Administrative Code, namely
setting monuments at the corners of the parcel
described.



Kenneth Carlson
Apr 20, 1987

I, Kenneth G. Carlson, registered land surveyor, hereby certify that I
have surveyed the above described parcel, that this plat is a correct
representation of the exterior boundaries of the parcel described and
the location of the building and driveways constructed or to be
constructed as proposed at the date hereof and the identification and
location of each unit and the common elements can be determined.

PHASE XIII PARCEL 1 Description:

A parcel of land located in Government Lot 4, Section 1, T12N, R9E,
Town of Pacific, Columbia County, Wisconsin bounded by the following
described line: Beginning at the most northerly corner of Phase XII,
Parcel 1, of Saddle Ridge Condominium; thence S31°43'W, 137.27 feet;
thence S58°17'E, 47.85 feet; thence S31°43'W, 132.60 feet; thence
northwesterly on a curve to the left, radius 190.00 feet, whose chord
bears N68°02'W, 37.96 feet; thence northwesterly on a curve to the right,
radius 410.00 feet, whose chord bears N71°47'W, 28.37 feet; thence
N31°43'E, 282.41 feet; thence S60°00'E, 17.17 feet to point of beginning.
Said parcel contains 11,340 square feet or 0.260 acres.

PHASE XIII PARCEL 2 Description:

A parcel of land located in NEK-SEK, Section 2, T12N, R9E, Town of
Pacific, Columbia County, Wisconsin bounded by the following described
line: Commencing at the northwest corner of Amended Phase XI, parcel 2,
of Saddle Ridge Condominium; thence N12°00'E, 140.00 feet to point of
beginning; thence N12°00'E, 100.00 feet; thence S35°39'E, 228.41 feet;
thence N60°18'W, 177.19 feet to point of beginning. Said parcel contains
8440 square feet or 0.194 acres.

CURVE	DELTA	RADIUS	ARC	CHORD	CHORD
			BEARING	DISTANCE	DISTANCE
A	3°58'	410'	28.38'	N71°47'W	28.37'
B	11°28'	190'	38.02'	N68°02'W	37.96'

Condominium Plat Phase XIII

PAGE 1 OF 2 PAGES

VOL 1-148

Voc 1 - 156
Rec 8-27-87

Replaced
2004

460969

SR
P14

THIS SURVEY DESCRIBES THE LAND
AND BUILDINGS SUBJECT TO THE
CONDOMINIUM DECLARATION FOR
SADDLE RIDGE

PHASE XIV

PHASE XIV PARCEL 1 Description:
A parcel of land located in the NE1/4-SE1/4, Section 2, T12N, R9E,
Township 12 North, Range 9 East, Columbia County, Wisconsin bounded by the
following described line: Beginning at the southwest corner of
PHASE XIII, Parcel 2, Saddle Ridge Condominium; thence
S60°18'N, 177.19 feet; thence S37°01'W, 55.00 feet; thence
N60°18'N, 149.40 feet; thence N12°00'E, 70.00 feet to point
of beginning. Said parcel contains 9,930 square feet or
0.228 acres.

PHASE I/IV PARCEL 2 Description:
A parcel of land located in Government Lot 4, Section 1, T12N, R9E, Town of Pacific, Columbia County, Wisconsin bounded by the following described line: Beginning at the northwest corner of the intersection of Sections 2, 3, 4 and 5, Thence S 15° 15' 34" E 342' 36" W, 277.52 feet; thence westerly on a curve to the left, radius 716.00 feet; whose chord bears N63°20'17" W, 135.18 feet; thence S60°45' E, 312.10 feet; thence S60°00' E, 55.03 feet to the beginning. Said parcel contains 25,400 square feet or 0.584 acres.

PHASE XIV PARCEL 3 Description:
A parcel of land located in Government Lot 4, Section 1, T12N,
R9E, E1/2 of Sec. 1, Coumbe County, Wisconsin bounded by the
following described line: Beginning at the northeast corner of
Phase XII, Parcel 2, Saddle Ridge Condominium; thence S60°00'E,
60.00 feet; thence S42°37'N, 290.58 feet; thence westerly on a
curve to the right, radius 410.00 feet; whose chord bears
N50°32'03"W, 10.97 feet; thence westerly on a curve to the
left, radius 410.00 feet; whose chord bears N51°40'22"W, 47.64
feet; thence N42°36'E, 281.64 feet to point of beginning. Said
parcel contains 16,720 square feet or 0.384 acres.

CURVE	DELTA	RADIUS	ARC	CHORD BEARING	CHORD DISTANCE
A	10°50'	716.00'	135.38'	N63°20'17"W	135.18'
B	3°48'46"	716.00'	47.65'	N51°40'22"W	47.64'
C	1°32'	410.00'	10.97'	N50°32'03"W	10.97'

● = Found 3/4" round iron rod.


Condominium Plat Phase XIV

PAGE 1 OF 2 PAGES


Vol 1-196

STATE OF WISCONSIN
COLUMBIA COUNTY

Received for record the 27
Day of August A.D. 1987
at 4:05 o'clock P.M. and recorded
in Vol. of Page
Marian Robinson
Register of Deeds

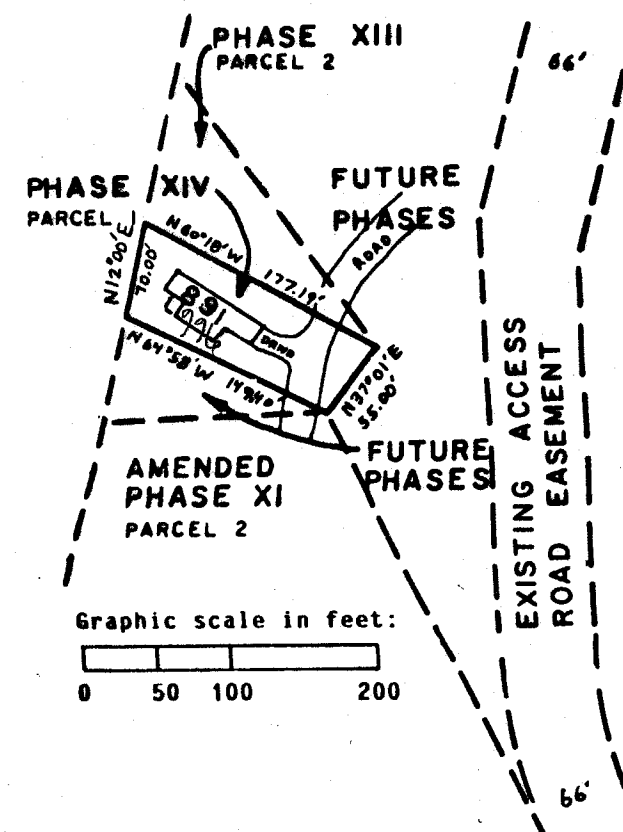

Bearings are referenced to
Saddle Ridge Condominium

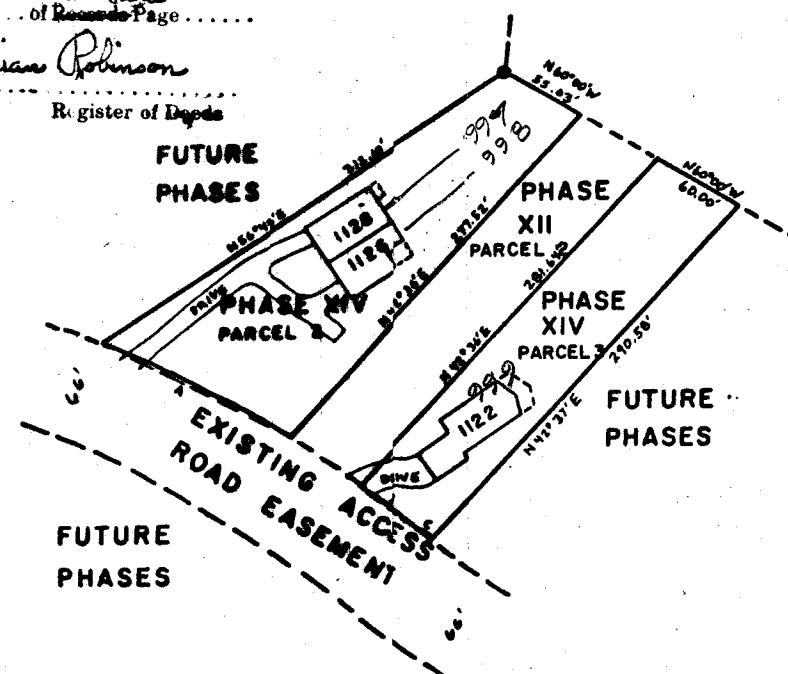

I, Kenneth G. Carlson, registered land surveyor, hereby certify that I have surveyed the above described parcel, that this plat is a correct representation of the exterior boundaries of the parcel described and the location of the building and driveways constructed or to be constructed as proposed at the date hereof and the identification and location of each unit and the common elements can be determined.

An agreement has been signed by Kenneth Carlson and Carl Berst to exclude certain requirements of A-E 5, Wisconsin Administrative Code, namely setting monuments at the corners of the parcel described.



Kenneth Carlson
Aug 26, 1987

Replaced
2004

46 53 464053

AMENDMENT TO CONDOMINIUM PLAT OF
SADDLE RIDGE
COLUMBIA COUNTY

THIS SURVEY DESCRIBES THE LAND
AND BUILDINGS SUBJECT TO THE
CONDOMINIUM DECLARATION FOR
SADDLE RIDGE

PHASE XV

PHASE XV Description:
A parcel of land located in Government Lot 4, Section 1, T12N,
R9E, Town of Pacific, Columbia County, Wisconsin bounded by
the following described line: Beginning at the most westerly
corner of PHASE XIV, Parcel 2, Saddle Ridge Condominium, thence
westerly on a curve to the left, radius 716.00 feet, whose
chord bears N69°51'W, 27.49 feet; thence N22°40'E, 181.79 feet;
thence N60°30'E, 114.66 feet; thence S60°00'E, 65.00 feet;
thence S60°30'W, 180.00 feet; thence S22°40'W, 124.63 feet to
point of beginning. Said parcel contains 12,600 square feet or
0.289 acres.

I, Kenneth G. Carlson, registered land surveyor, hereby certify that I
have surveyed the above described parcel, that this plat is a correct
representation of the exterior boundaries of the parcel described and
the location of the building and driveways constructed or to be
constructed as proposed at the date hereof and the identification and
location of each unit and the common elements can be determined.

CURVE	DELTA	RADIUS	ARC	CHORD BEARING	CHORD DISTANCE
A	2°12'	716.00'	27.49'	N69°51'W	27.49'


An agreement has been signed by Kenneth Carlson
and Carl Berst to exclude certain requirements
of A-E 5, Wisconsin Administrative Code, namely
setting monuments at the corners of the parcel
described.

● = Found 3/4" round iron rod.



▨ = Limited Common Area

Condominium Plat
Saddle Ridge
Phase XV
Page 1 of 1 Page


I, Kenneth G. Carlson, registered
land surveyor, hereby certify that
the drawings appearing hereon are
an accurate representation of the
plans of each building and
substantial location, number and
dimension of the building or
buildings and units erect or to be erected.

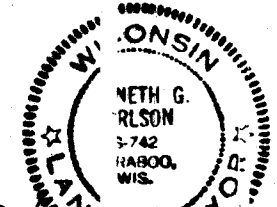

STATE OF WISCONSIN
COLUMBIA COUNTY
Received for me this 30th day of June, A.D. 1988.
at _____ of the County of _____
in Vol. _____ of the _____
_____ of the _____
_____ of the _____

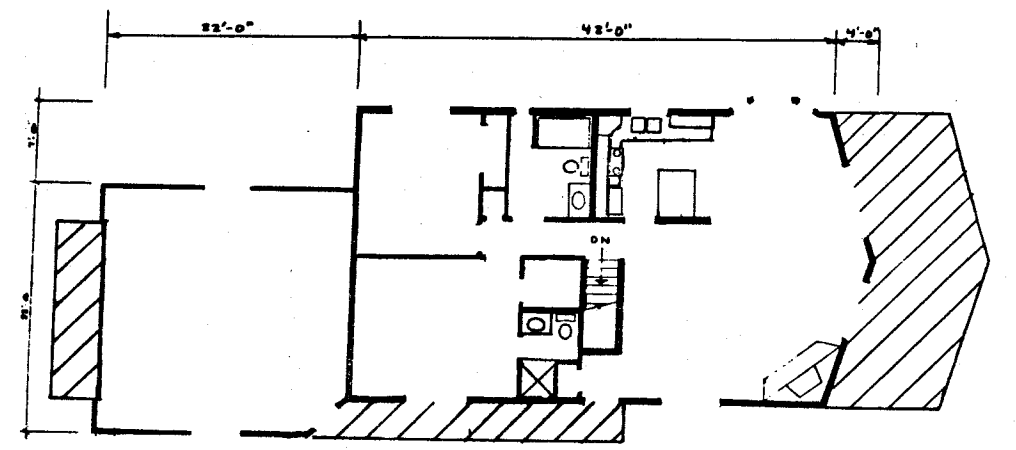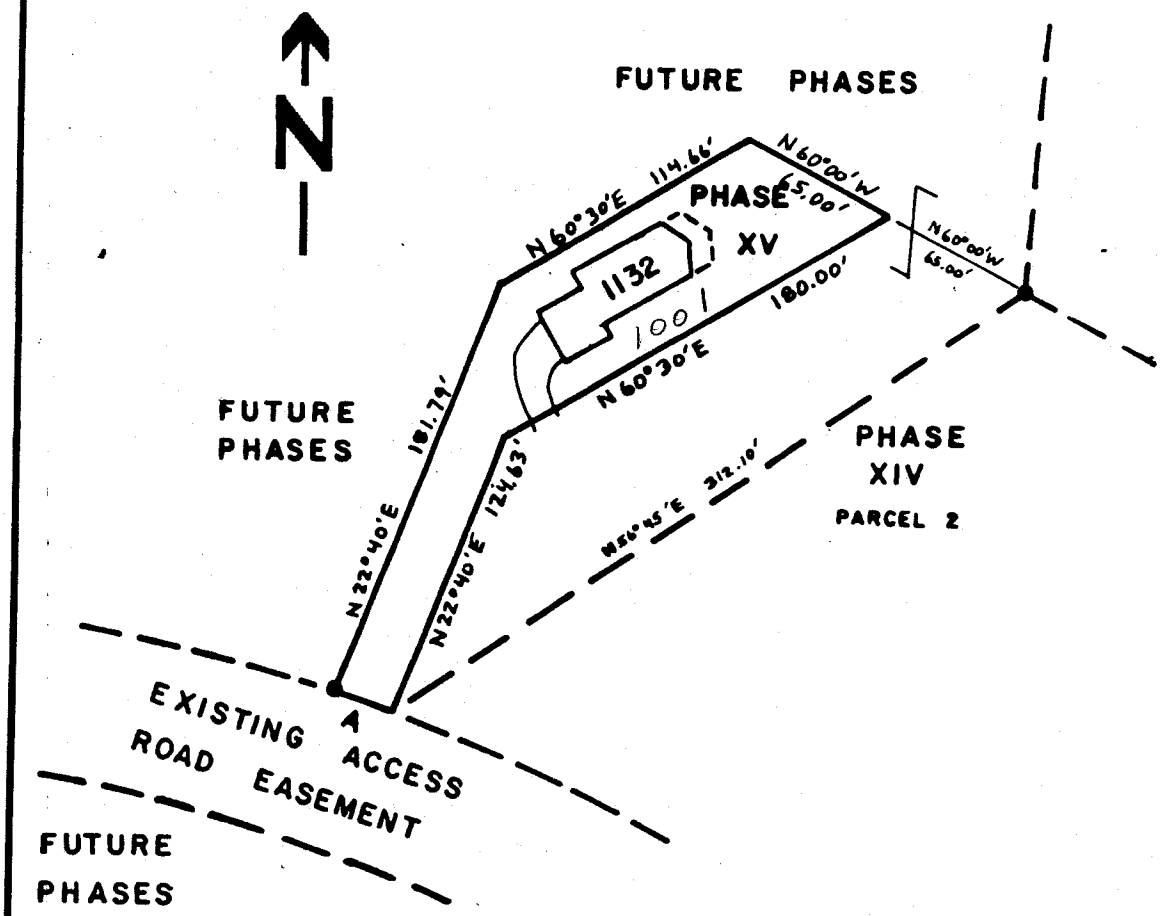

UNIT 1132
FIRST FLOOR PLAN

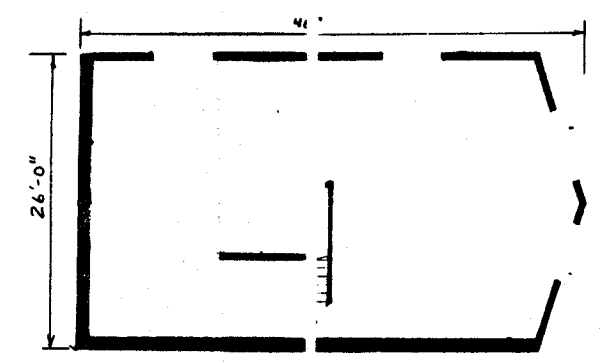

UNIT 1132
BASEMENT FLOOR PLAN

₹ 8.00

SADDLE RIDGE
SEC. 2 - T12N - R9E
TOWN OF PACIFIC
PH XVII

VOL 001-165
CONDOMINIUM PLATS
REC. 4-28-88
#1130
1989 ASSESSMENT ROLL

Replaced
2004

467293

STATE OF WISCONSIN
COUNTY OF COLUMBIA
Received for record the 28th
Day of June A.D. 1988
at 2:10 o'clock P.M. and recorded
in V.L. of Records Page
Marian Robinson
Register of Deeds

AMENDMENT TO CONDOMINIUM PLAT OF
SADDLE RIDGE
COLUMBIA COUNTY

THIS SURVEY DESCRIBES THE LAND
AND BUILDINGS SUBJECT TO THE
CONDOMINIUM DECLARATION FOR
SADDLE RIDGE

PHASE XVII

PHASE XVII DESCRIPTION:
A parcel of land located in Government Lot 4, Section 1, T12N, R9E,
Town of Pacific, Columbia County, Wisconsin bounded by the following
described line: Beginning at the most northerly corner of PHASE XIV,
PARCEL 2, Saddle Ridge Condominium; thence S56°45'W, along west line of
said PHASE XIV, PARCEL 2, 312.10 feet to southwest corner of said
PHASE XIV, PARCEL 2, also being the southeast corner of PHASE XV,
Saddle Ridge Condominium; thence N22°40'E, along east line of said
PHASE XV, 124.63 feet; thence N60°30'E, along east line of said PHASE
XV, 180.00 feet to northeast corner of said PHASE XV; thence S60°00'E,
65.00 feet to point of beginning. Said parcel contains 15,940 square
feet or 0.366 acres.

• = Found 3/4" round iron rod.



= Limited Common Area

I, Kenneth G. Carlson, registered land surveyor, hereby certify that I
have surveyed the above described parcel, that this plat is a correct
representation of the exterior boundaries of the parcel described and
the location of the building and driveways constructed or to be
constructed as proposed at the date hereof and the identification and
location of each unit and the common elements can be determined.


An agreement has been signed by Kenneth Carlson
and Carl Berst to exclude certain requirements
of A-E 7, Wisconsin Administrative Code, namely
setting monuments at the corners of the parcel
described.

I, Kenneth G. Carlson, registered land surveyor, hereby certify that
the drawings appearing hereon are an accurate copy of portions of the
plans of each building and substantially depict the layout, location,
unit numbers and dimensions of the building or buildings and units
located and erected or to be erected.

Condominium Plat
Saddle Ridge
Phase XVII
Page 1 of 1 Page

PLOTTED IN PARCEL 9 IN G.L. 4 1-12-90
SEE R 336-586 with Supp
AND AMENDMENT TO CONDOMINIUM
DECLARATION & EASEMENTS

VOL 1 PAGE 165

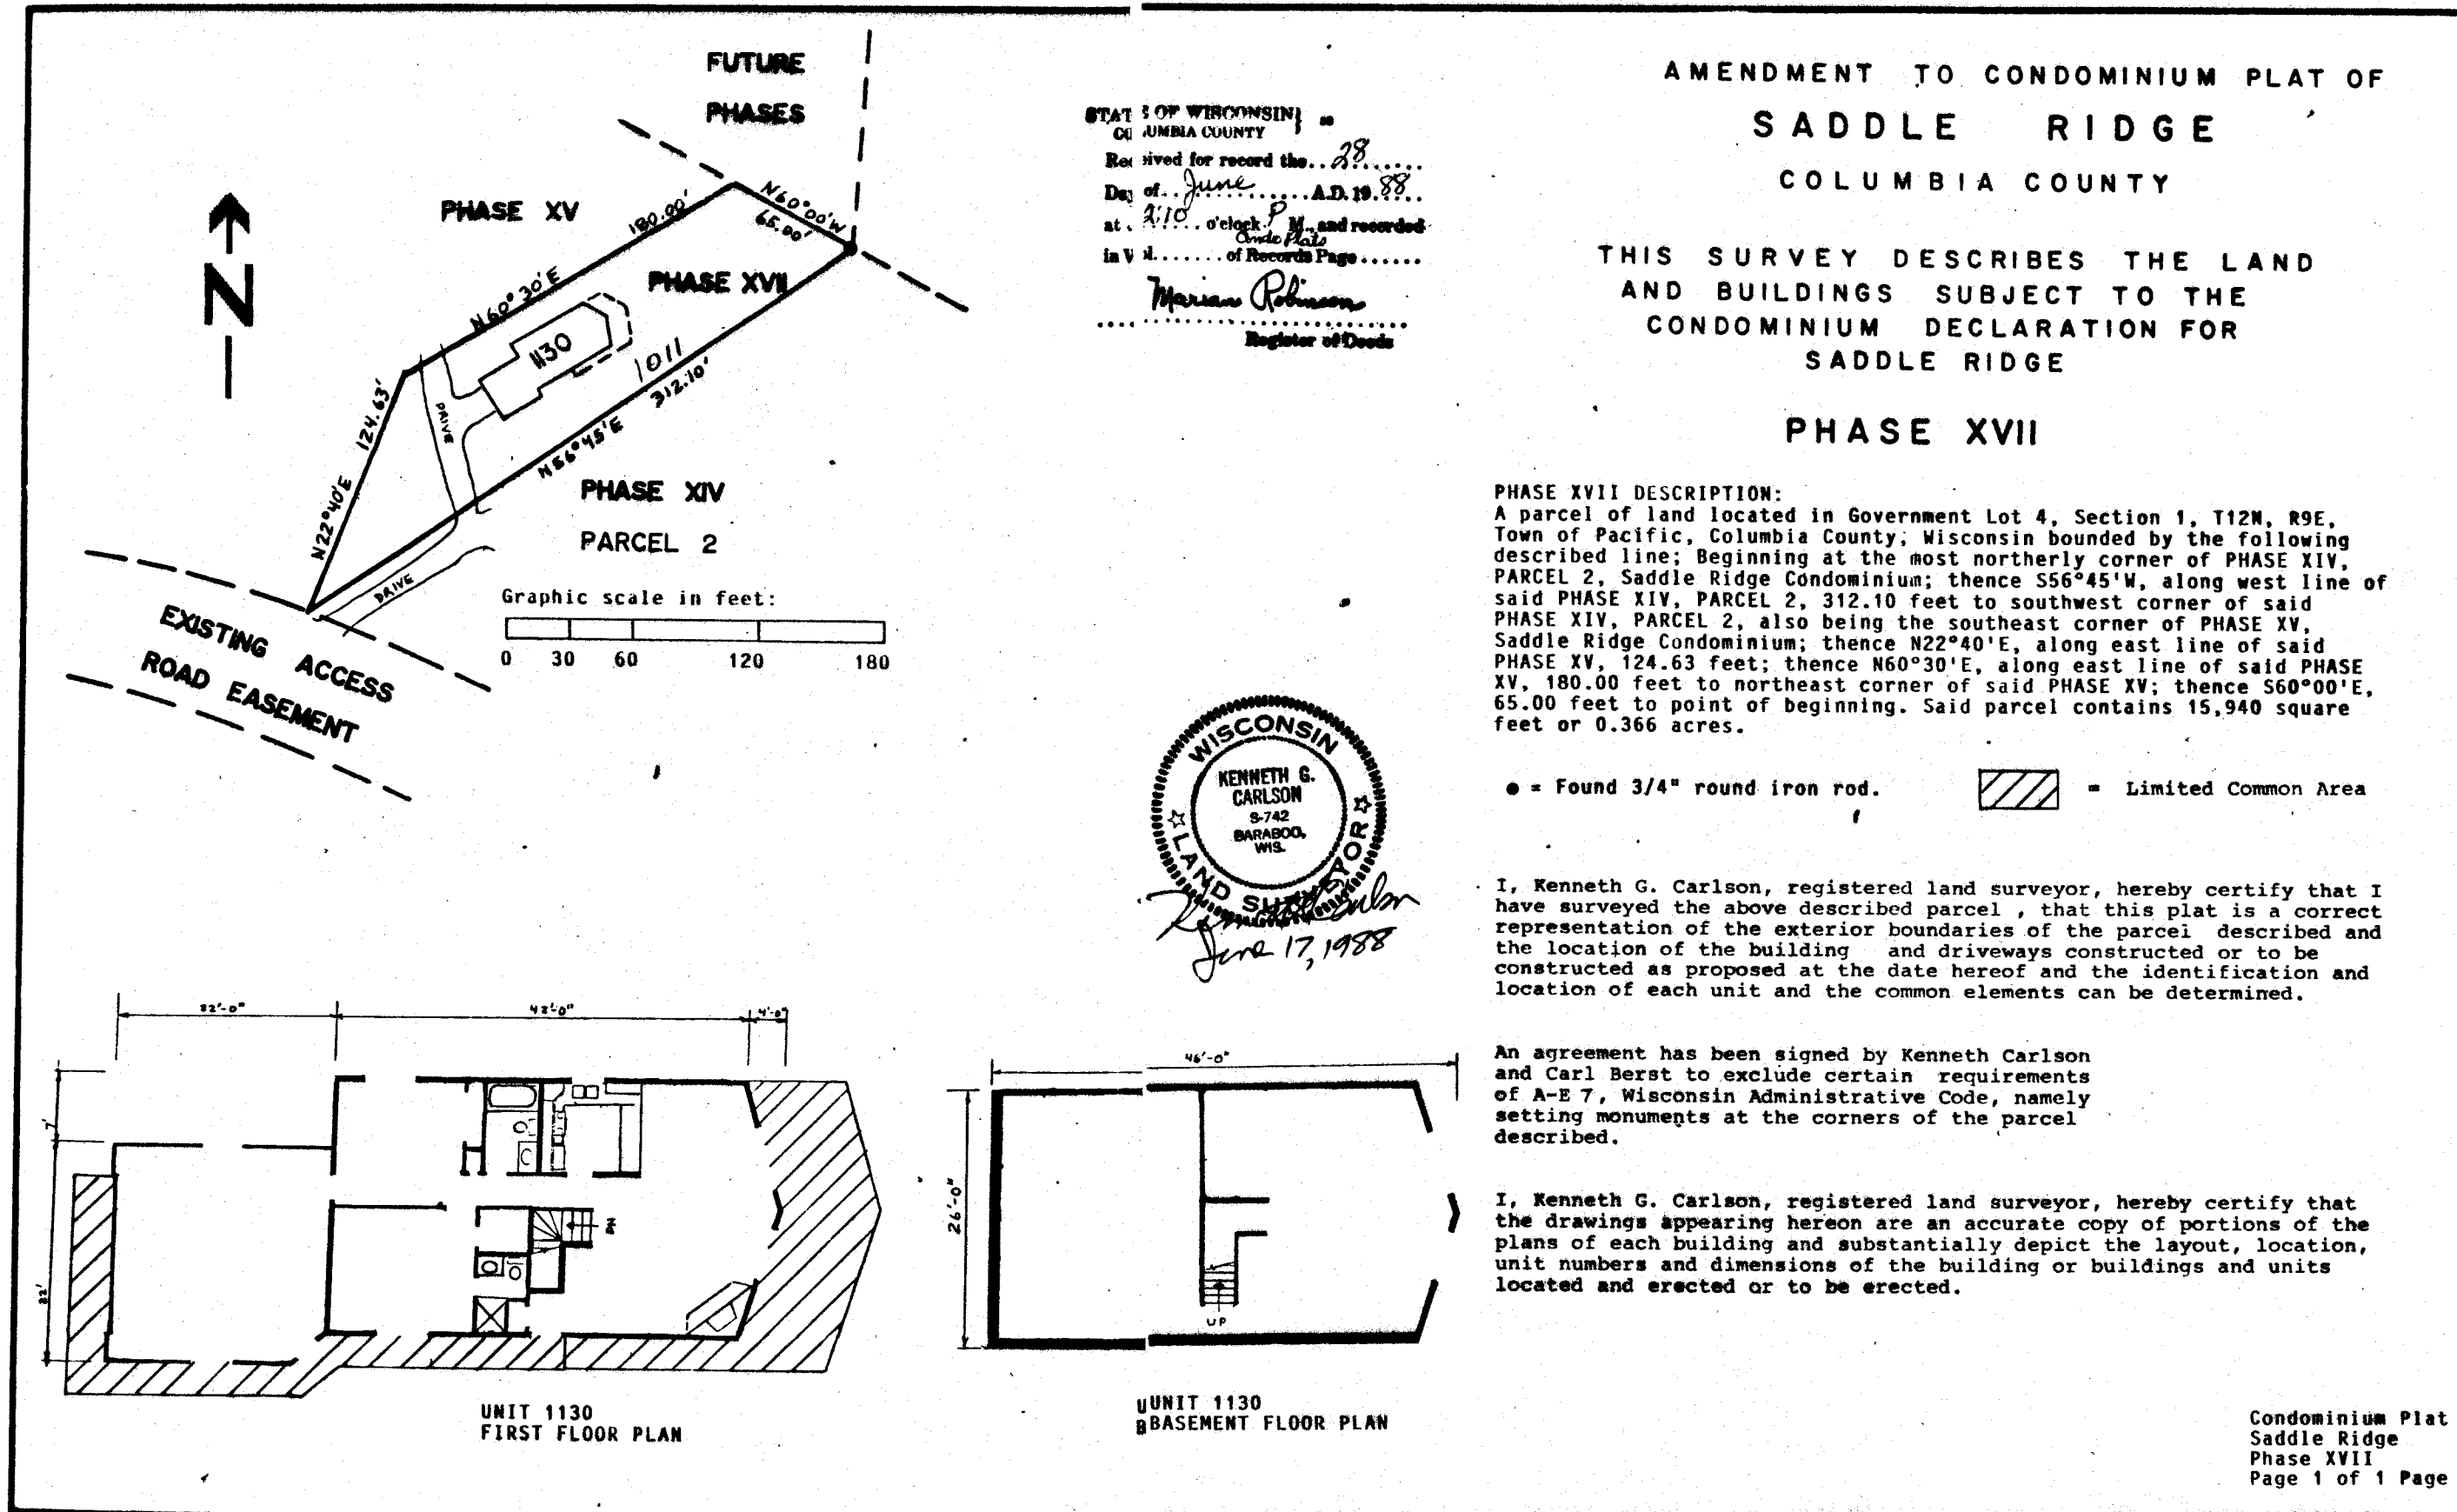

SADDLE RIDGE
TN. OF PACIFIC
SW 1/4 NW 4 E GL 4
1-12-9
PH. XVIII

Replaced
4



472919

AMENDMENT TO CONDOMINIUM PLAT OF
SADDLE RIDGE
COLUMBIA COUNTY

THIS SURVEY DESCRIBES THE LAND
AND BUILDINGS SUBJECT TO THE
CONDOMINIUM DECLARATION FOR
SADDLE RIDGE

PHASE XVIII

Replaced
2004

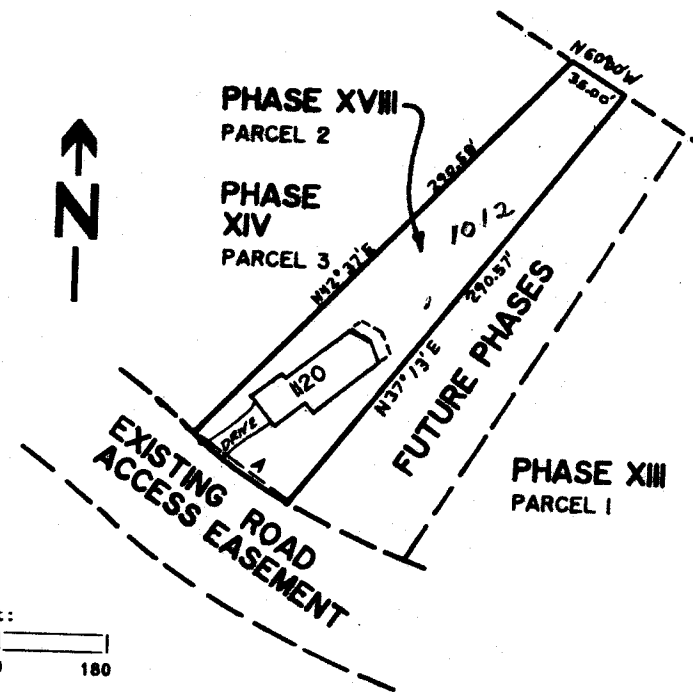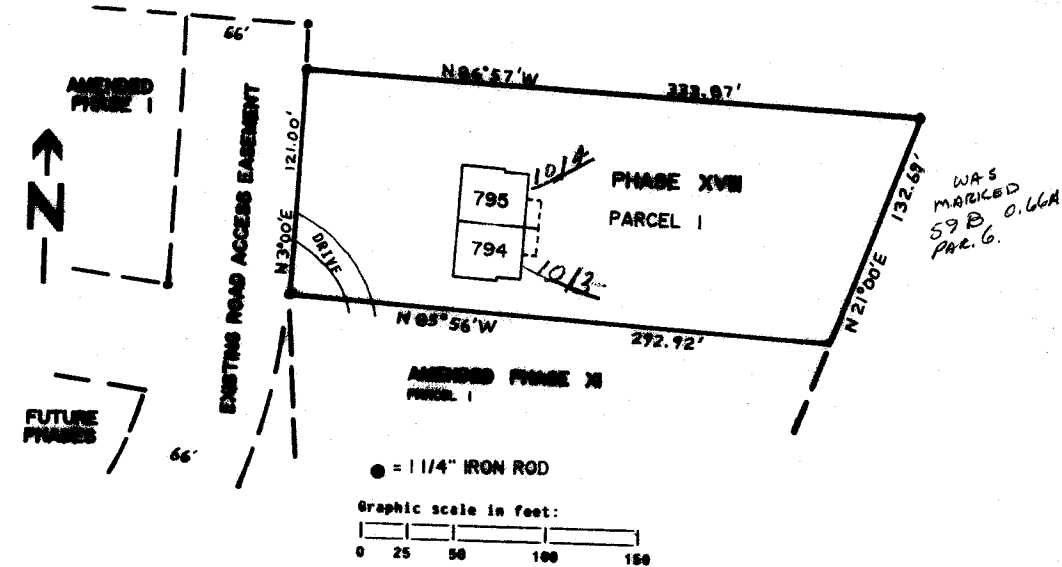


PHASE XVIII PARCEL 1 Description:
A parcel of land located in the SW 1/4 NW 4, Section 1, T12N, R9E,
Town of Pacific, Columbia County, Wisconsin bounded by the following
described line: Beginning at the northeast corner of AMENDED PHASE XI,
PARCEL 1, Saddle Ridge Condominium; thence N85°56'W, 272.92 feet;
thence N3°00'E, 121.00 feet; thence S86°57'E, 333.87 feet; thence
S21°00'W, 132.69 feet to point of beginning. Said parcel contains
38,790 square feet or 0.890 acres.

PHASE XVIII PARCEL 2 Description:
A parcel of land located in Government Lot 4, Section 1, T12N, R9E,
Town of Pacific, Columbia County, Wisconsin bounded by the following
described line: Beginning at the northeast corner of PHASE XIV,
PARCEL 3, Saddle Ridge Condominium; thence S60°00'E, 35.00 feet;
thence S37°13'W, 290.57 feet; thence northwesterly on a curve to the
right, radius 410.00 feet; whose chord bears N55°39'W, 62.19 feet;
thence N42°37'E, 290.58 feet to point of beginning. Said parcel
contains 14,030 square feet or 0.322 acres.

CURVE A: DELTA= 8°42', RADIUS= 410.00 feet, ARC= 62.25 feet,
CHORD= N55°39'W, 62.19 feet

I, Kenneth G. Carlson, registered land surveyor, hereby certify that I
have surveyed the above described parcel, that this plat is a correct
representation of the exterior boundaries of the parcel described and
the location of the building and driveways constructed or to be
constructed as proposed at the date hereof and the identification and
location of each unit and the common elements can be determined.



An agreement has been signed by Kenneth Carlson
and Carl Berst to exclude certain requirements
of A-F Wisconsin Administrative Code, namely
units at the corners of the parcel

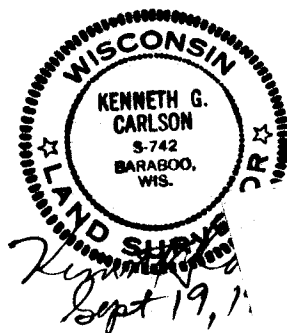

1989
Sept 19, 1989

Condominium Plat
Saddle Ridge
PHASE XVIII
Page 1 of 2 Pages

VOL 1 PAGE 171

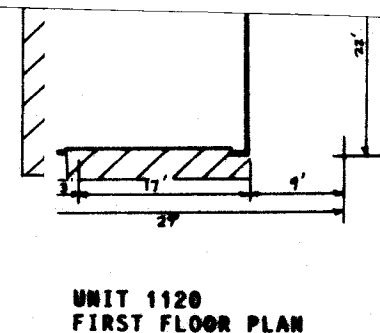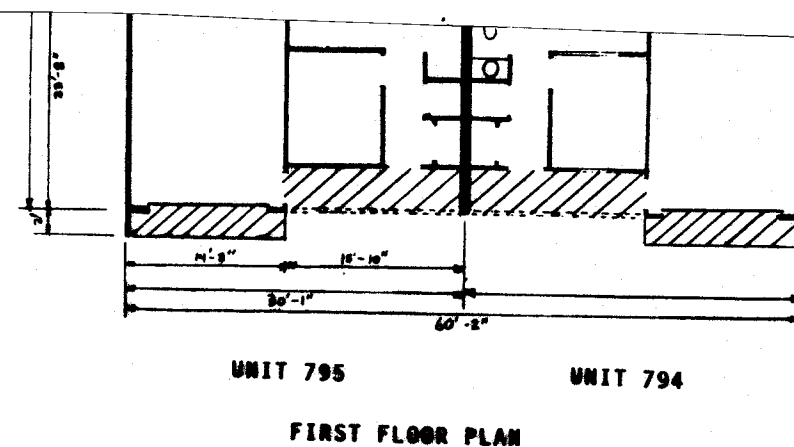

UNIT 1120
BASEMENT FLOOR PLAN

Legend: Hatched area = Limited Common Area

I, Kenneth G. Carlson, registered land surveyor, hereby certify that
the drawings appearing hereon are an accurate copy of portions of the
plans of each building and substantially depict the layout, location,
unit numbers and dimensions of the building or buildings and units
located and erected or to be erected.

Condominium Plat
Saddle Ridge
PHASE XVIII
Page 2 of 2 Pages


476730

AMENDMENT TO CONDOMINIUM PLAT OF SADDLE RIDGE COLUMBIA COUNTY

THIS SURVEY DESCRIBES THE LAND
AND BUILDINGS SUBJECT TO THE
CONDOMINIUM DECLARATION FOR
SADDLE RIDGE

PHASE XIX

Replaced
2004

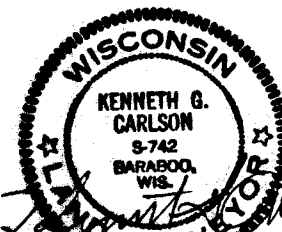

PHASE XIX PARCEL 1 Description:
A parcel of land located in the NE1/4-SE1/4, Section 2, T12N, R9E, Town of Pacific, Columbia County, Wisconsin bounded by the following described line: Commencing at the most northerly corner of PHASE XIII, PARCEL 2, Saddle Ridge Condominium; thence N12°00'E, 125.00 feet to point of beginning; thence N12°00'E, 45.00 feet; thence S84°27'E, 245.96 feet; thence S17°26'W, 80.00 feet; thence N76°18'W, 236.93 feet to point of beginning. Said parcel contains 14,960 square feet or 0.343 acres.

PHASE XIX PARCEL 2 Description:
A parcel of land located in Government lot 4, Section 1, T12N, R9E, Town of Pacific, Columbia County, Wisconsin bounded by the following described line: Beginning at the northwest corner of PHASE XIII, PARCEL 1, Saddle Ridge Condominium; thence S31°43'W, 282.41 feet; thence northwesterly on a curve to the right, radius 410.00 feet, whose chord bears N64°54'W, 70.06 feet; thence N37°13'E, 290.57 feet; thence S60°00'E, 41.79 feet to point of beginning; said parcel contains 15,920 square feet or 0.366 acres.

CURVE A: DELTA= 9°48', RADIUS= 410.00 feet, ARC= 70.15 feet,
CHORD= N64°54'W, 70.06 feet

I, Kenneth G. Carlson, registered land surveyor, hereby certify that I have surveyed the above described parcel, that this plat is a correct representation of the exterior boundaries of the parcel described and the location of the building and driveways constructed or to be constructed as proposed at the date hereof and the identification and location of each unit and the common elements can be determined.

An agreement has been signed by Kenneth Carlson and Carl Berst to exclude certain requirements of A-E 7, Wisconsin Administrative Code, namely setting monuments at the corners of the parcel described.


Condominium Plat
Saddle Ridge
PHASE XIX
Page 1 of 2 Pages

STATE OF WISCONSIN } ss
COLUMBIA COUNTY }
RECEIVED FOR RECORD


AUG 31 1989

Reg. of Deeds at 4:45 P.M.

Graphic scale in feet:
0 30 60 120 180

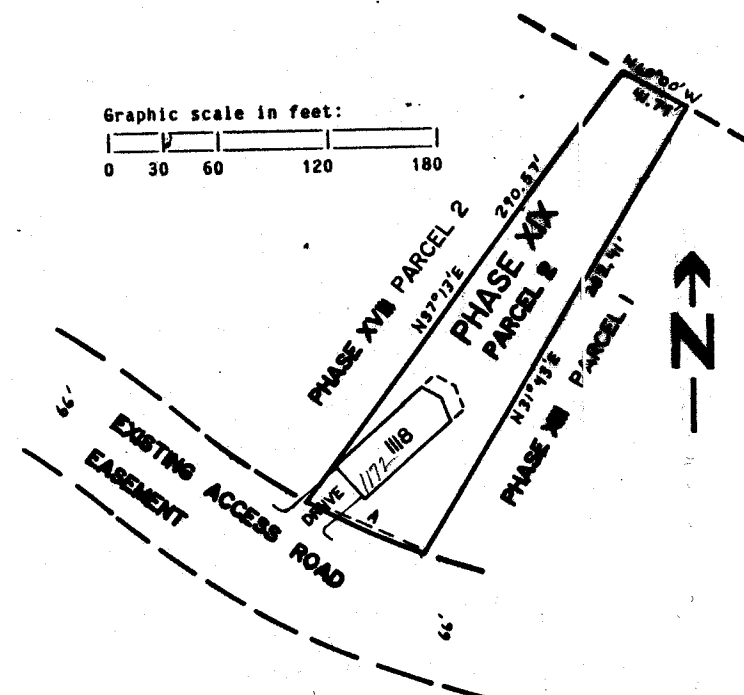

Vol 1 Page 173

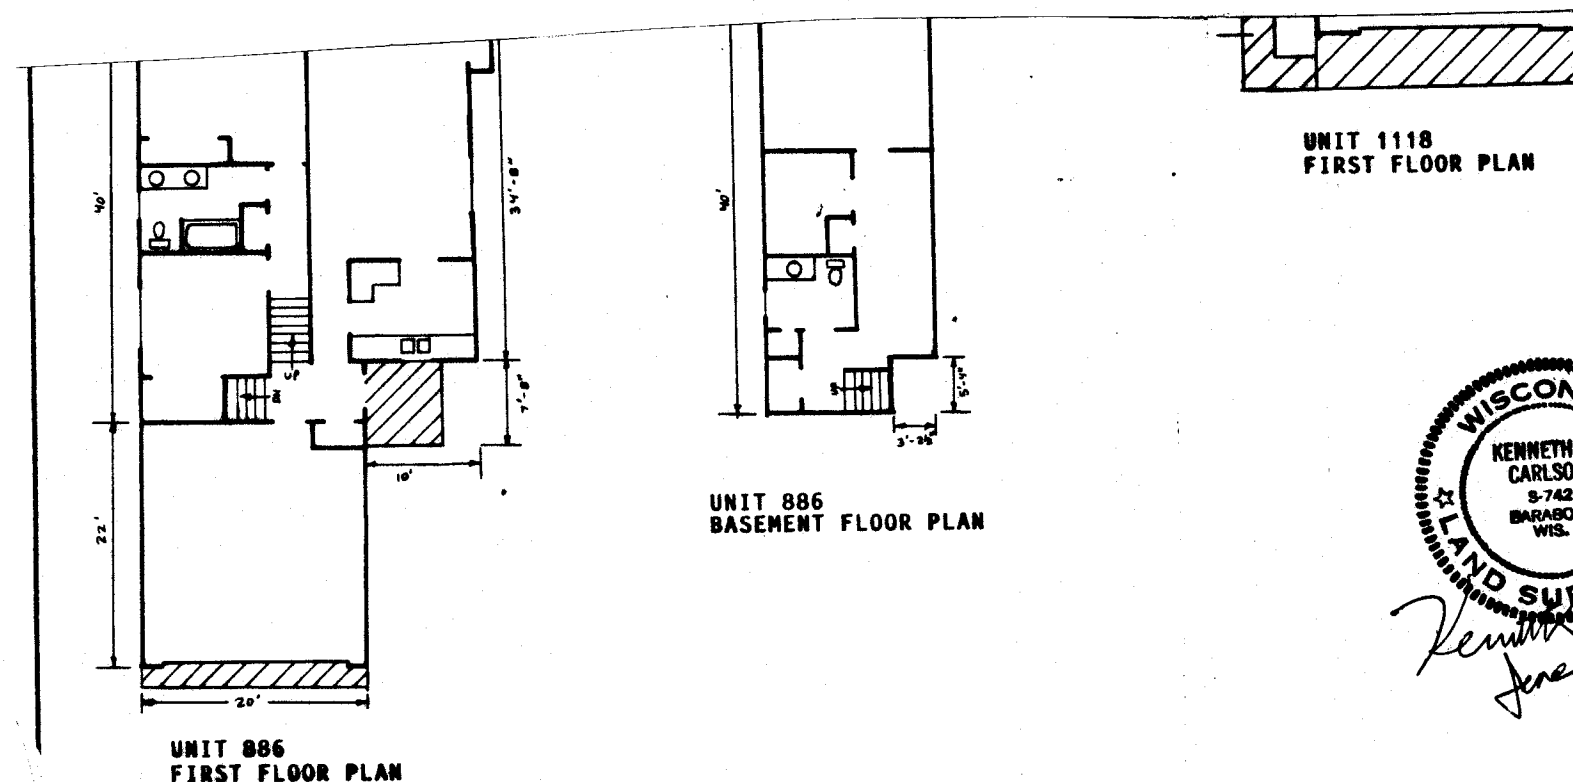

I, Kenneth G. Carlson, registered land surveyor, hereby certify that the drawings appearing hereon are an accurate copy of portions of the plans of each building and substantially depict the layout, location, unit numbers and dimensions of the building or buildings and units located and erected or to be erected.

= Limited Common Area

Condominium Plat
Saddle Ridge
PHASE XIX
Page 2 of 2 Pages

478086

AMENDMENT TO CONDOMINIUM PLAT OF
SADDLE RIDGE
COLUMBIA COUNTY

THIS SURVEY DESCRIBES THE LAND
AND BUILDINGS SUBJECT TO THE
CONDOMINIUM DECLARATION FOR
SADDLE RIDGE

PHASE XX

PHASE XX PARCEL 1 Description:
A parcel of land located in the NE1/4, Section 2, T12N, R9E,
Town of Pacific, Columbia County, Wisconsin bounded by the
following described line: Beginning at the southeast corner
of PHASE XIX, Saddle Ridge Condominium, thence
S17°26'W, 90.00 feet; thence S55°04'W, 247.90 feet; thence
S76°18'E, 236.93 feet to point of beginning.
Said parcel contains 10,640 square feet or 0.244 acres.

PHASE XX PARCEL 2 Description:
A parcel of land located in Government Lot 4, Section 1, T12N,
R9E, Town of Pacific, Columbia County, Wisconsin bounded by
the following described line: Beginning at the most northerly
corner of PHASE XV, Saddle Ridge Condominium; thence S60°30'W,
119.66 feet; thence S22°40'W, 181.79 feet; thence westerly on
a curve to the left, radius 716.00 feet, whose chord bears
N78°22'W, 184.59 feet; thence W36°00'W, 234.15 feet; thence
EAST, 217.37 feet to point of beginning.
Said parcel contains 36,910 square feet or 0.847 acres.

STATE OF WISCONSIN } SS
COLUMBIA COUNTY
RECEIVED FOR RECORD

OCT 26 1989

Donny J. J. J.
Reg. of Deeds at 9:55 A.M.





I, Kenneth G. Carlson, registered land surveyor, hereby certify that I
have surveyed the above described parcel, that this plat is a correct
representation of the exterior boundaries of the parcel described and
the location of the building and driveways constructed or to be
constructed as proposed at the date hereof and the identification and
location of each unit and the common elements can be determined.

An agreement has been signed by Kenneth Carlson
and Carl Berst to exclude certain requirements
of A-E 7, Wisconsin Administrative Code, namely
setting monuments at the corners of the parcel
described.

Condominium Plat
Saddle Ridge
PHASE XX
Page 1 of 2 Pages

Vol 1 Page 177

SN
P

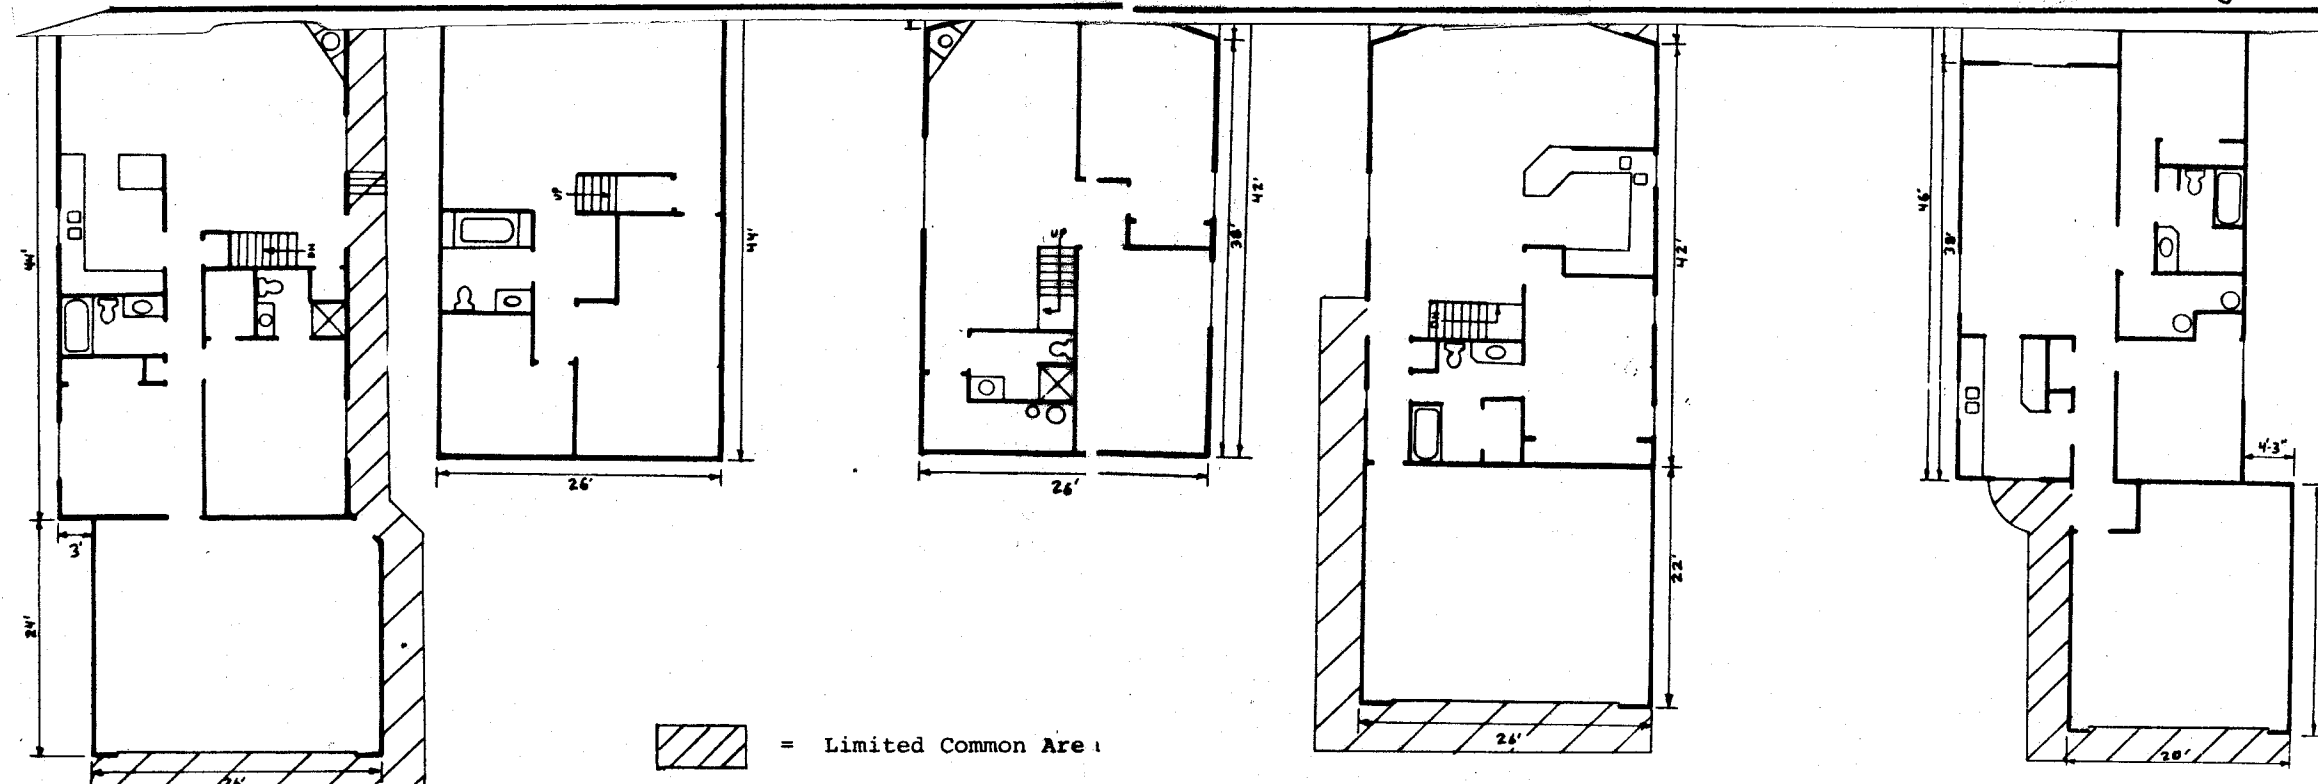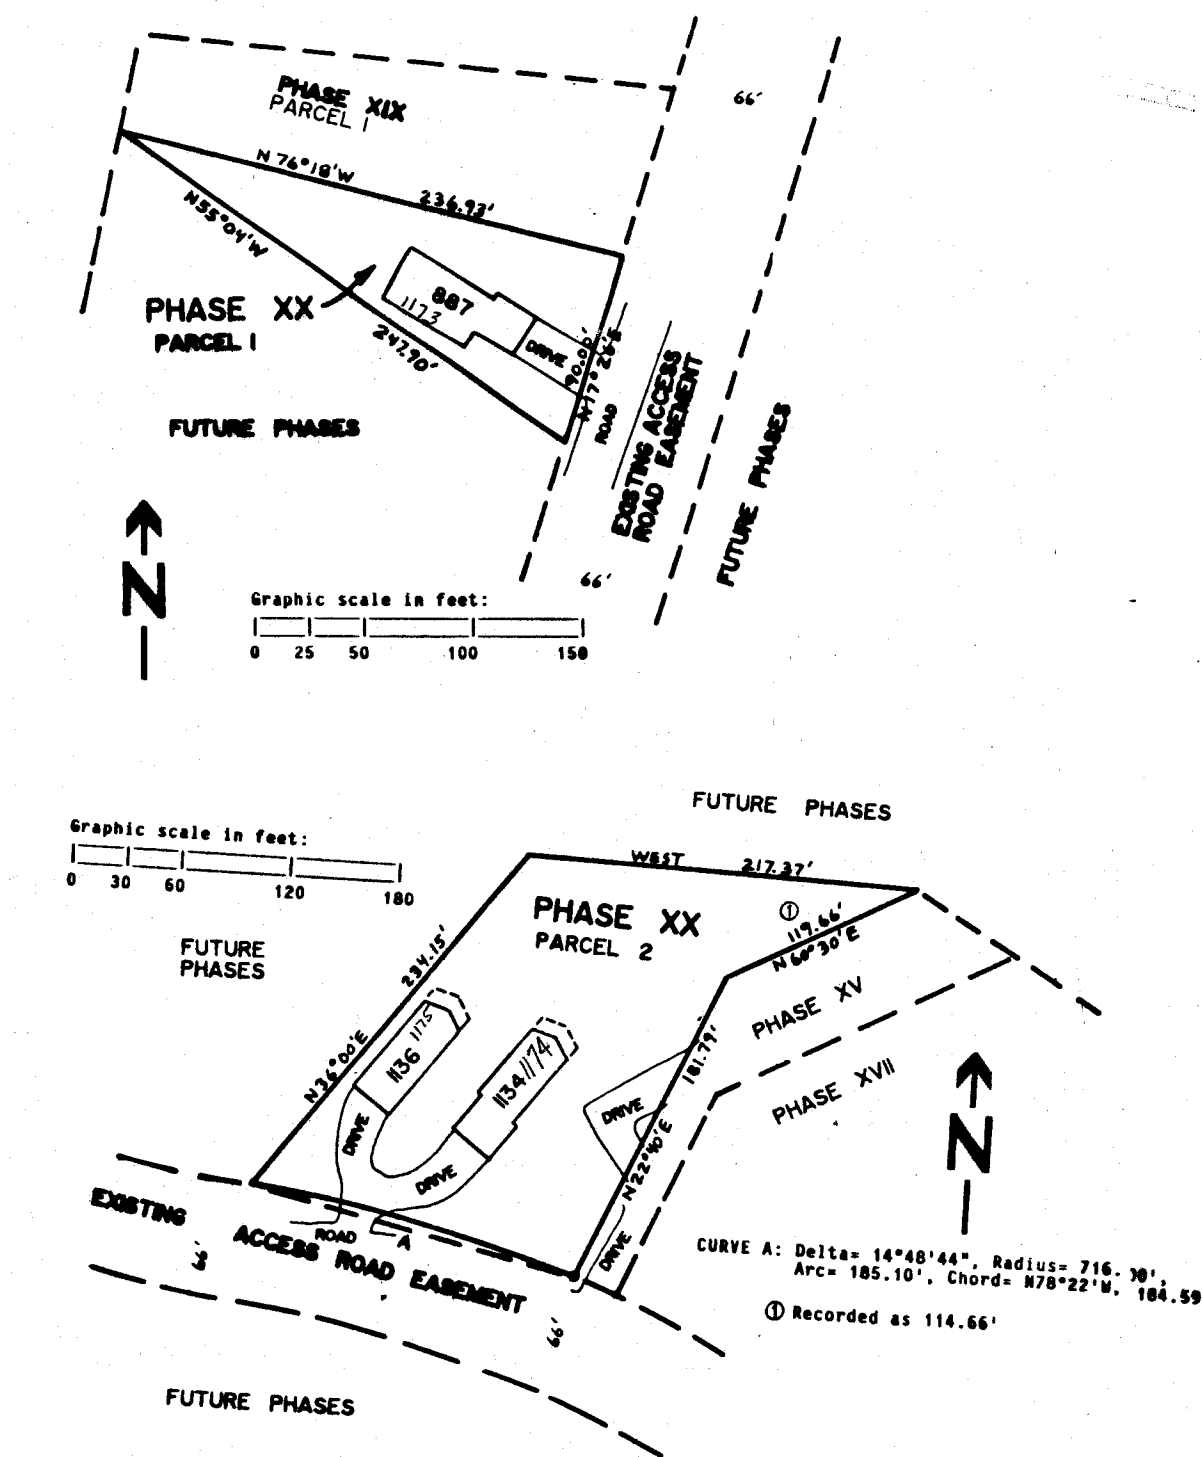


Condominium Plat
Saddle Ridge
PHASE XX
Page 2 of 2 Pages

480590

AMENDMENT TO CONDOMINIUM PLAT OF SADDLE RIDGE 1310 COLUMBIA COUNTY

THIS SURVEY DESCRIBES THE LAND
AND BUILDINGS SUBJECT TO THE
CONDOMINIUM DECLARATION FOR
SADDLE RIDGE

PHASE XXI

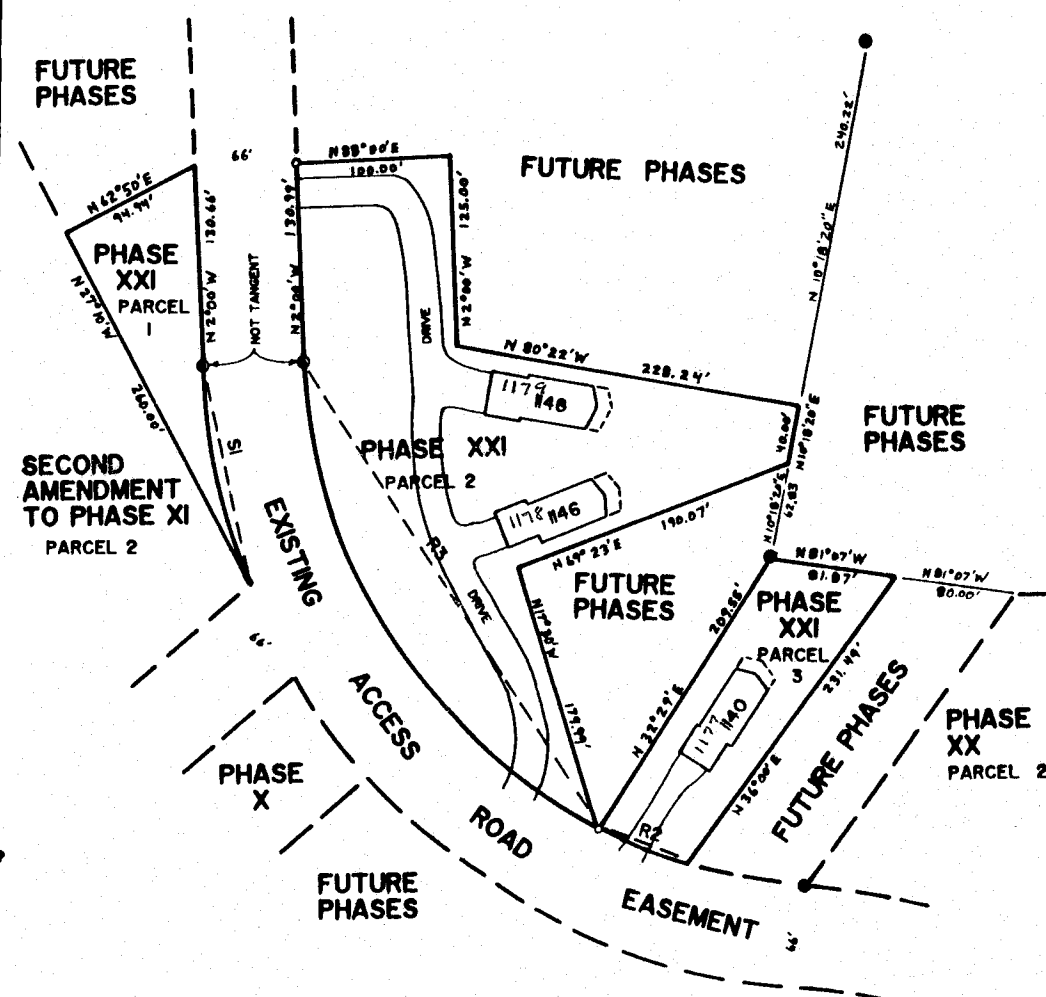

Graphic scale in feet:
0 30 60 120 180

CURVE	DELTA	RADIUS	ARC	CHORD BEARING	CHORD DISTANCE
R2	10°00'	355.00'	61.98'	N68°01'W	61.88'
R3	61°27'	355.00'	380.74'	N32°17'30"W	362.75'
S1	28°08'	421.00'	147.94'	N11°38'W	147.14'
AAS	12°45'	360.00'	80.11'	N57°47'50"E	79.95'

Replaced
2004

PHASE XXI PARCEL 1 Description:
A parcel of land located in NE-S-E, Section 2, T12N, R9E, Town of Pacific, Columbia County, Wisconsin bounded by the following described line: Beginning at the most easterly corner of SECOND AMENDMENT TO PHASE XI, PARCEL 2, Saddle Ridge Condominium; thence N27°10'W, 250.00 feet; thence N62°50'E, 94.94 feet; thence S2°00'E, 130.66 feet; thence southerly on a curve to the left, radius 421.00 feet, whose chord bears S11°38'E, 147.14 feet to point of beginning. Said parcel contains 10,100 square feet or 0.232 acres.

PHASE XXI PARCEL 2 Description:
A parcel of land located in NE-S-E, Section 2 and Government Lot 4, Section 1, T12N, R9E, Town of Pacific, Columbia County, Wisconsin bounded by the following described line: Commencing at the northwest corner of PHASE XI, PARCEL 2, Saddle Ridge Condominium; thence N01°07'W, 161.87 feet; thence S32°29'W, 209.55 feet to point of beginning; thence northwesterly on a curve to the right, radius 355.00 feet, whose chord bears N32°17'30"W, 362.75 feet; thence S2°00'E, 130.99 feet; thence N08°00'E, 100.00 feet; thence S2°00'E, 125.00 feet; thence S80°22'E, 228.24 feet; thence S10°18'20"W, 40.00 feet; thence S69°23'W, 190.07 feet; thence S17°30'E, 179.99 feet to point of beginning. Said parcel contains 59,520 square feet or 1.366 acres.

PHASE XXI PARCEL 3 Description:
A parcel of land located in Government Lot 4, Section 1, T12N, R9E, Town of Pacific, Columbia County, Wisconsin bounded by the following described line: Commencing at the northwest corner of PHASE XI, PARCEL 2, Saddle Ridge Condominium; thence N01°07'W, 80.00 feet to point of beginning; thence S36°00'W, 231.49 feet; thence westerly on a curve to the right, radius 355.00 feet, whose chord bears N68°01'W, 61.88 feet; thence N32°29'E, 209.55 feet; thence S01°07'E, 81.87 feet to point of beginning. Said parcel contains 14,860 square feet or 0.341 acres.

PHASE XXI PARCEL 4 Description:
A parcel of land located in Government Lot 4, Section 1, T12N, R9E, Town of Pacific, Columbia County, Wisconsin bounded by the following described line: Commencing at the northwest corner of PHASE VI, Saddle Ridge Condominium; thence N68°59'E, 72.93 feet (recorded as N41°35'E, 80.00 feet), to point of beginning; thence northeasterly on a curve to the left, radius 360.00 feet, whose chord bears N57°47'50"E, 79.95 feet; thence S24°49'E, 70.33 feet; thence S54°32'W, 89.34 feet; thence N23°00'W, 76.20 feet to point of beginning. Said parcel contains 6,010 square feet or 0.138 acres.

- = Found 3/4" round iron rod.
- = Found 1 1/2" round iron rod.
- = Recorded as N41°35'E, 80.00 feet.

I, Kenneth G. Carlson, registered land surveyor, hereby certify that I have surveyed the above described parcel, that this plat is a correct representation of the exterior boundaries of the parcel described and the location of the building and driveways constructed or to be constructed as proposed at the date hereof and the identification and location of each unit and the common elements can be determined.

An agreement has been signed by Kenneth Carlson and Carl Berst to exclude certain requirements of A-E 7, Wisconsin Administrative Code, namely setting monuments at the corners of the parcel described.


Graphic scale in feet:
0 30 60 120 180

STATE OF WISCONSIN } SS
COLUMBIA COUNTY
RECEIVED FOR RECORD

FEB 26 1990

Ken Carlson
Land Surveyor
Rec 5, 1489

Condominium Plat
Saddle Ridge
PHASE XXI
Page 1 of 2 pages
Vol 1 - Page 190

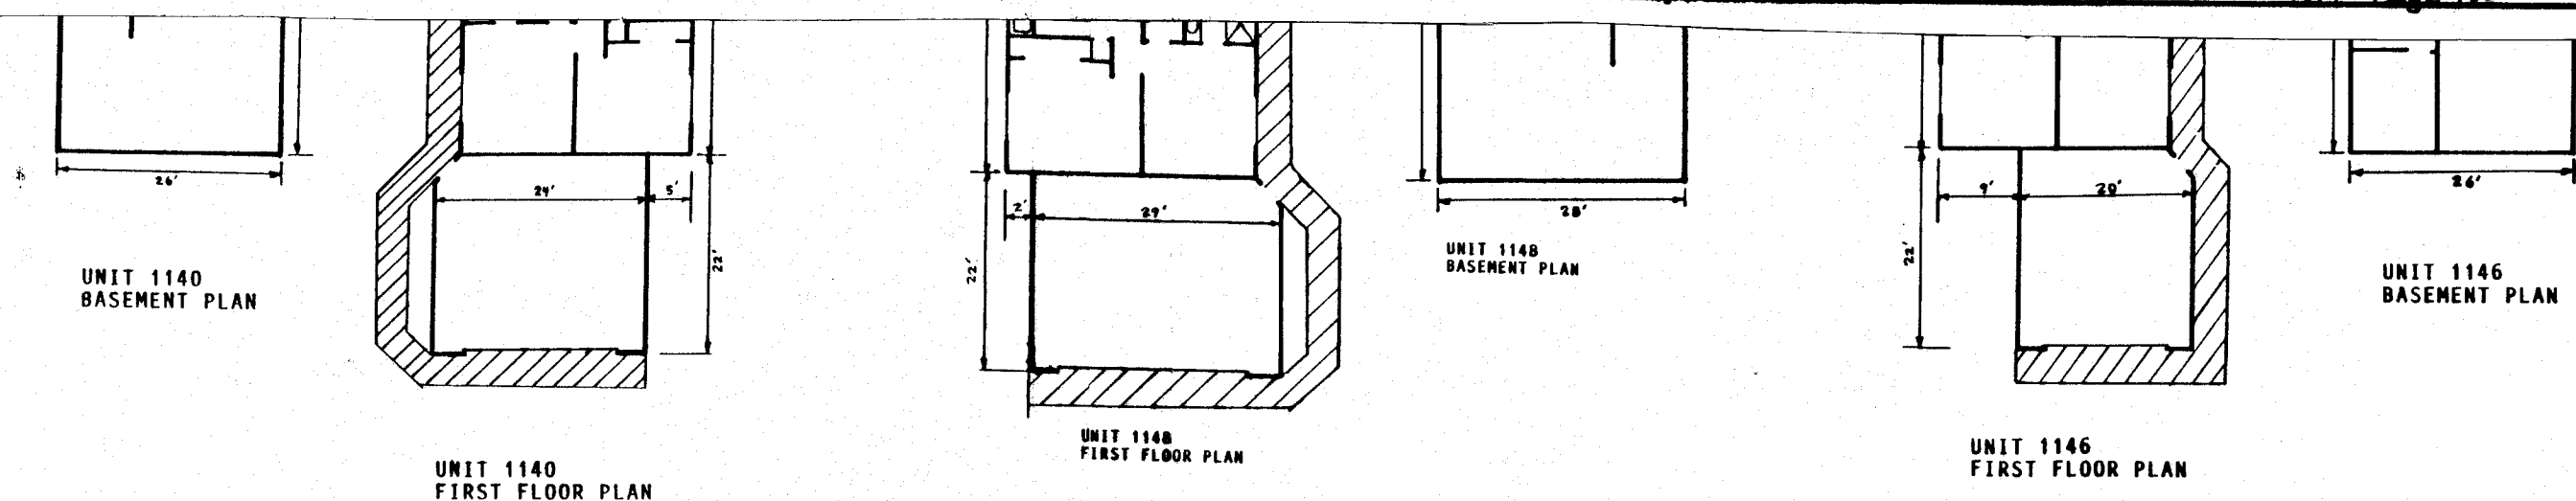

I, Kenneth G. Carlson, registered land surveyor, hereby certify that the drawings appearing hereon are an accurate copy of portions of the plans of each building and substantially depict the layout, location, unit numbers and dimensions of the building or buildings and units erected or to be erected.

▨ = Limited Common Area

Condominium Plat
Saddle Ridge
PHASE XXI
Page 2 of 2 pages

Believed to
be in Sec. 1

AMENDMENT TO CONDOMINIUM PLAT OF
SADDLE RIDGE
COLUMBIA COUNTY

THIS SURVEY DESCRIBES THE LAND
AND BUILDINGS SUBJECT TO THE
CONDOMINIUM DECLARATION FOR
SADDLE RIDGE

PHASE XXII

Replaced
2-04

APP 72386-721


PHASE XXII Description: 1180 G.L.4
A parcel of land located in ~~NE 1/4~~ Section 2, T12N, R9E,
Town of Pacific, Columbia County, Wisconsin bounded by the
following described line:
Beginning at the southwest corner of PHASE XXI, PARCEL 3;
thence N17°30'W along the east line of PHASE XXI, PARCEL 2,
129.99 feet; thence N70°48'E, 160.56 feet to the northwest
corner of PHASE XXI, PARCEL 3; thence S32°29'W along the
west line of PHASE XXI, PARCEL 3, 209.55 feet to point
of beginning.
Said parcel contains 10,430 square feet or 0.239 acres.

I, Kenneth G. Carlson, registered land surveyor, hereby certify that I
have surveyed the above described parcel, that this plat is a correct
representation of the exterior boundaries of the parcel described and
the location of the building and driveways constructed or to be
constructed as proposed at the date hereof and the identification and
location of each unit and the common elements can be determined.


An agreement has been signed by Kenneth Carlson
and Carl Berst to exclude certain requirements
of A-E 7, Wisconsin Administrative Code, namely
setting monuments at the corners of the parcel
described.

I, Kenneth G. Carlson, registered land surveyor, hereby certify that
the drawings appearing hereon are an accurate copy of portions of the
plans of each building and substantially depict the layout, location,
unit numbers and dimensions of the building or buildings and units
located and erected or to be erected.

Condominium Plat
Saddle Ridge
PHASE XXII
Page 1 of 1 page
Vol 1 - Page 181

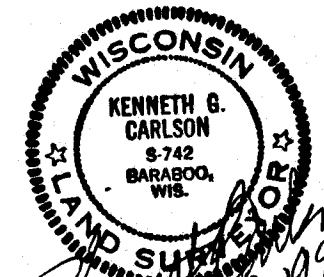


LIMITED COMMON AREA

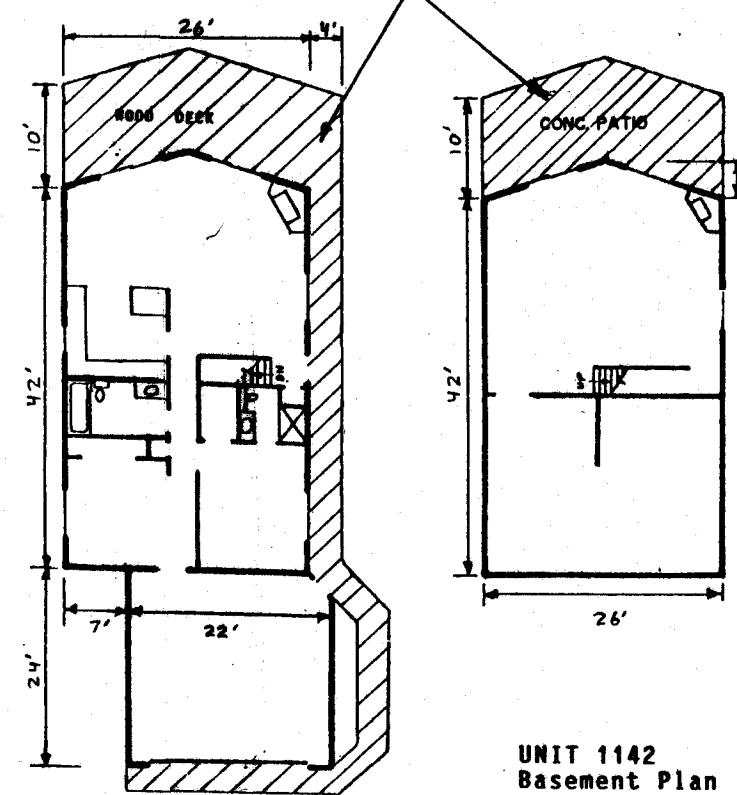

UNIT 1142
First Floor Plan

UNIT 1142
Basement Plan

○ = Found 3/4" round iron rod.
● = Found 1 1/2" round iron rod.

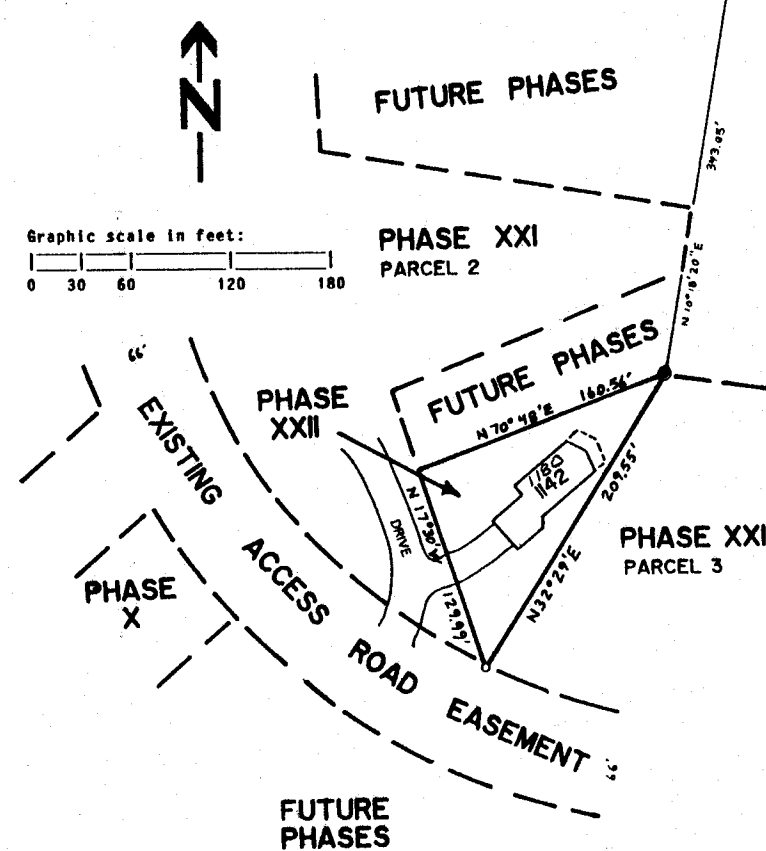


STATE OF WISCONSIN } ss
COLUMBIA COUNTY }
RECEIVED FOR RECORD

APR 30 1990

Reg. of Deeds at \$8.00/H

Replaced
2004

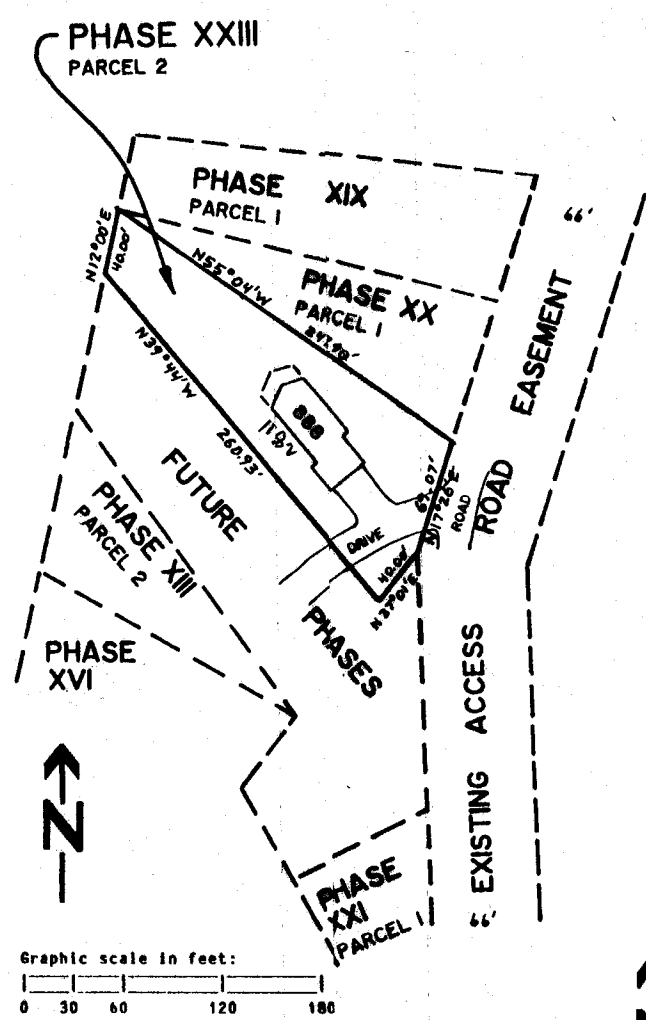

STATE OF WISCONSIN } ss
COLUMBIA COUNTY }
RECEIVED FOR RECORD

JUN 21 1990

Denny J. Judd
Reg. of Deeds at 8:00 P.M.

AMENDMENT TO CONDOMINIUM PLAT OF
SADDLE RIDGE
COLUMBIA COUNTY

THIS SURVEY DESCRIBES THE LAND
AND BUILDINGS SUBJECT TO THE
CONDOMINIUM DECLARATION FOR
SADDLE RIDGE

PHASE XXIII

PHASE XXIII, PARCEL 1 Description: 1181
A parcel of land located in NE1/4-SE1/4, Section 2 and Government Lot 4,
Section 1, all T12N, R9E, Town of Pacific, Columbia County,
Wisconsin bounded by the following described line:
Beginning at the northeast corner of PHASE XXII, Saddle Ridge
Condominium; thence S70°48'W along north line of said PHASE XXII,
160.56 feet to east line of PHASE XXI, PARCEL 2, Saddle Ridge
Condominium; thence N17°30'W along said east line, 50.00 feet to
a corner of said PHASE XXI, PARCEL 2; thence N69°23'E along south
line of said PHASE XXI, PARCEL 2, 190.07 feet to corner of said
PHASE XXI, PARCEL 2; thence S10°18'20"W, 62.83 feet to point of
beginning.
Said parcel contains 9,140 square feet or 0.210 acres.

PHASE XXIII, PARCEL 2 Description: 1182
A parcel of land located in NE1/4-SE1/4, Section 2, T12N, R9E, Town of
Pacific, Columbia County, Wisconsin bounded by the following
described line:
Beginning at the most westerly corner of PHASE XX, PARCEL 1, Saddle
Ridge Condominium; thence S55°04'E along south line of said PHASE
XX, PARCEL 1, 247.90 feet; thence S17°26'W, 69.07 feet; thence
S37°01'W, 40.00 feet; thence N39°44'W, 260.93 feet; thence N12°00'E,
40.00 feet to point of beginning.
Said parcel contains 17,680 square feet or 0.406 acres.

- = Found 3/4" round iron rod.
- ⊙ = Found 1 1/2" round iron rod.

I, Kenneth G. Carlson, registered land surveyor, hereby certify that I
have surveyed the above described parcel, that this plat is a correct
representation of the exterior boundaries of the parcel described and
the location of the building and driveways constructed or to be
constructed as proposed at the date hereof and the identification and
location of each unit and the common elements can be determined.

An agreement has been signed by Kenneth Carlson
and Carl Berst to exclude certain requirements
of A-E 7, Wisconsin Administrative Code, namely
setting monuments at the corners of the parcel
described.

Condominium Plat
Saddle Ridge
PHASE XXIII
Page 1 of 2 pages



SR
P23


484783

AMENDMENT TO CONDOMINIUM PLAT OF
SADDLE RIDGE
COLUMBIA COUNTY

THIS SURVEY DESCRIBES THE LAND
AND BUILDINGS SUBJECT TO THE
CONDOMINIUM DECLARATION FOR
SADDLE RIDGE

PHASE XXIV

Replaced
Replaced
2004

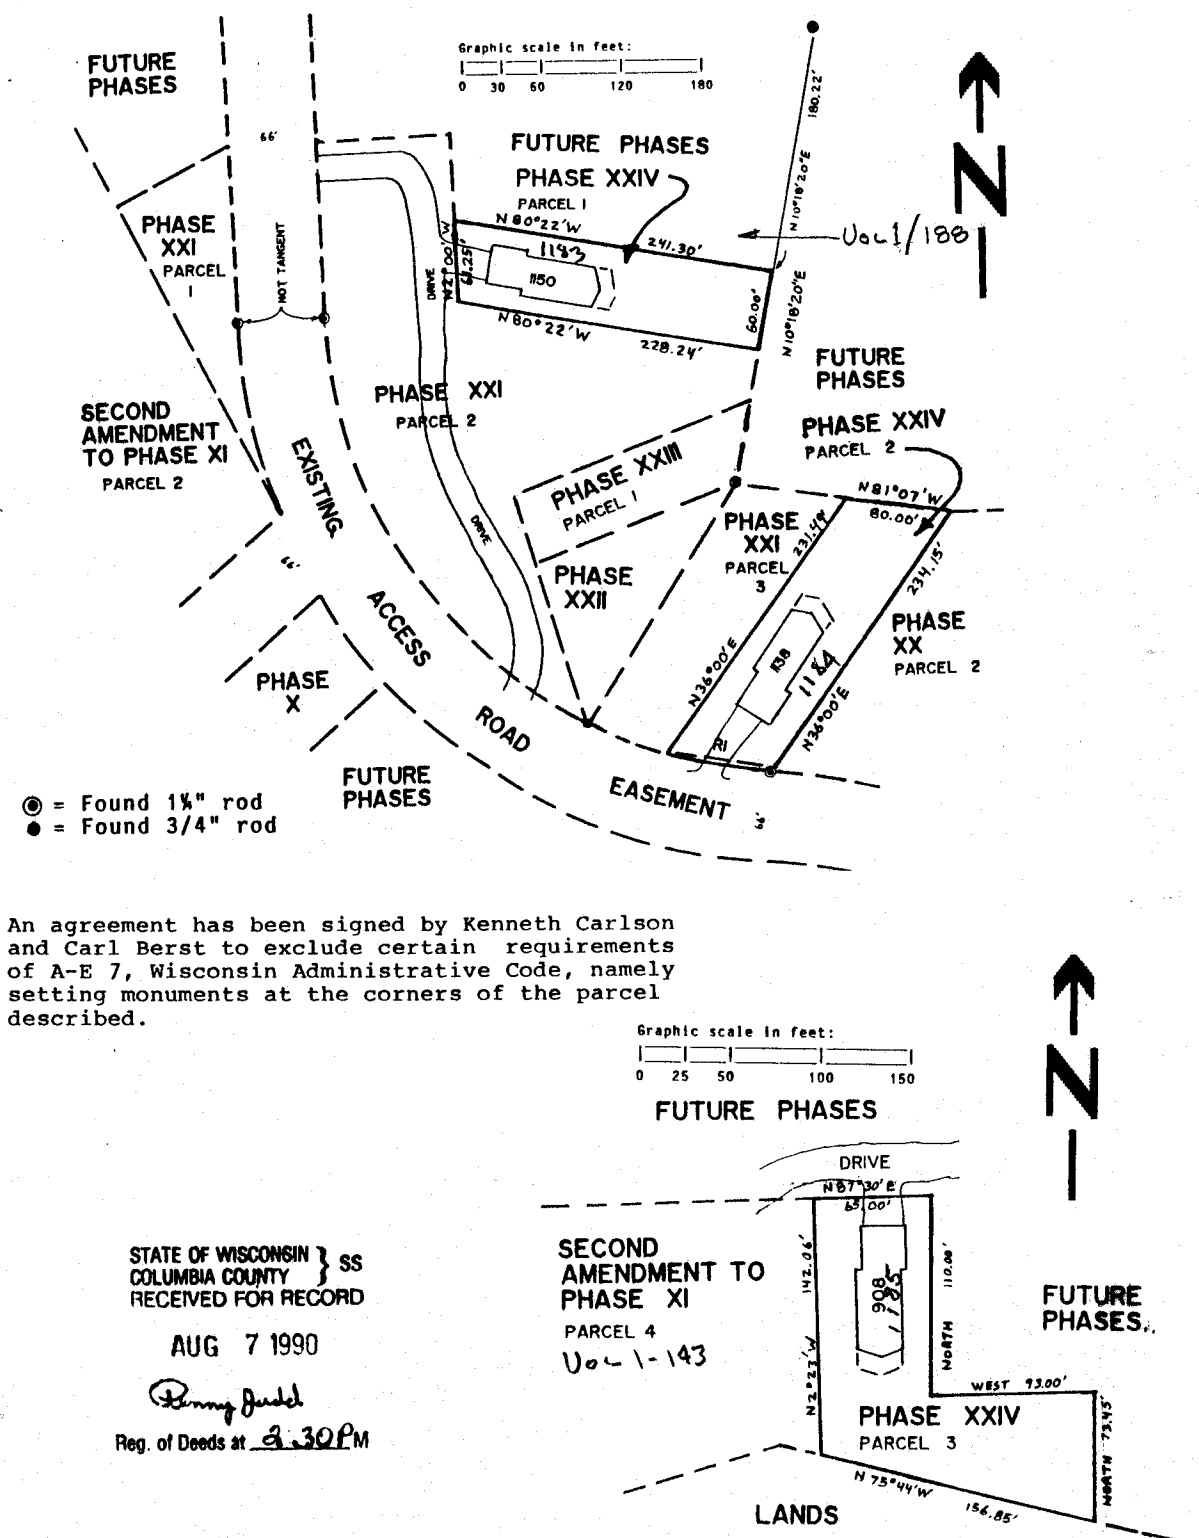

(1150) PHASE XXIV, PARCEL 1 Description:
A parcel of land located in NE1/4-SE1/4, Section 2 and Government Lot 4, Section 1, all T12N, R9E, Town of Pacific, Columbia County, Wisconsin bounded by the following described line:
Beginning at the most easterly corner of PHASE XXI, PARCEL 2, Saddle Ridge Condominium; thence N80°22'W along a north line of said PHASE XXI, 228.24 feet to an east line of said PHASE XXI; thence N2°00'W along said east line, 61.25 feet; thence S80°22'E, 241.30 feet; thence S10°18'20"W, 60.00 feet to point of beginning.
Said parcel contains 14,080 square feet or 0.323 acres.

(1138) PHASE XXIV, PARCEL 2 Description:
A parcel of land located in Government Lot 4, Section 1, T12N, R9E, Town of Pacific, Columbia County, Wisconsin bounded by the following described line:
Beginning at the northwest corner of PHASE XX, PARCEL 2, Saddle Ridge Condominium; thence S36°00'W along west line of said PHASE XX, 234.15 feet to southwest corner of said PHASE XX; thence westerly on a curve to the right, radius 355.00 feet, whose chord bears N79°23'30"W, 78.82 feet to the southeast corner of PHASE XXI, PARCEL 3, Saddle Ridge Condominium; thence N36°00'E along east line of said PHASE XXI, 231.49 feet to point of beginning.
Said parcel contains 16,690 square feet or 0.383 acres.

(908) PHASE XXIV, PARCEL 3 Description:
A parcel of land located in Government Lot 1, Section 2 and Government Lot 4, Section 1, all T12N, R9E, Town of Pacific, Columbia County, Wisconsin bounded by the following described line:
Beginning at the southeast corner of SECOND AMENDMENT TO PHASE XI, PARCEL 4, Saddle Ridge Condominium; thence N2°23'W along east line of said PHASE XI, 142.06 feet; thence N87°30'E, 65.00 feet; thence SOUTH, 110.00 feet; thence EAST, 93.00 feet; thence SOUTH, 73.45 feet; thence N75°44'W, 156.85 feet to point of beginning.
Said parcel contains 15,060 square feet or 0.346 acres.


CURVE R1: Delta= 12°45', Radius= 355.00', Arc= 78.99'
Chord= N79°23'30"W, 78.82'

I, Kenneth G. Carlson, registered land surveyor, hereby certify that I have surveyed the above described parcel, that this plat is a correct representation of the exterior boundaries of the parcel described and the location of the building and driveways constructed or to be constructed as proposed at the date hereof and the identification and location of each unit and the common elements can be determined.


CONDOMINIUM PLAT
Saddle Ridge
PHASE XXIV
Page 1 of 2 pages

Vol 1 - Page 183


PHASE XXIV

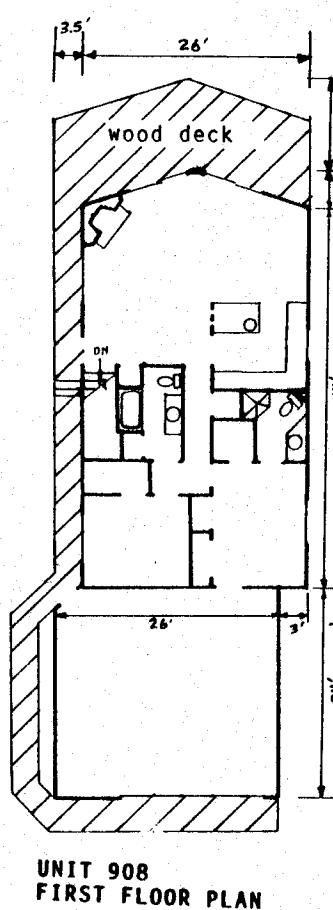


UNIT 908
BASEMENT FLOOR PLAN

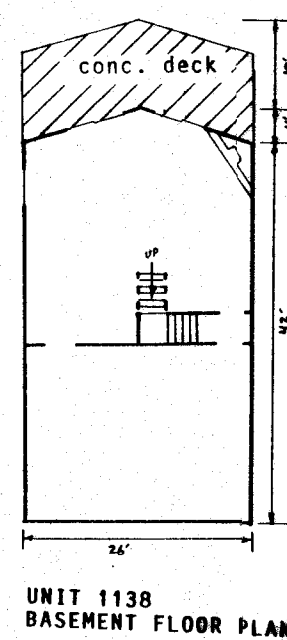


UNIT 1138
BASEMENT FLOOR PLAN

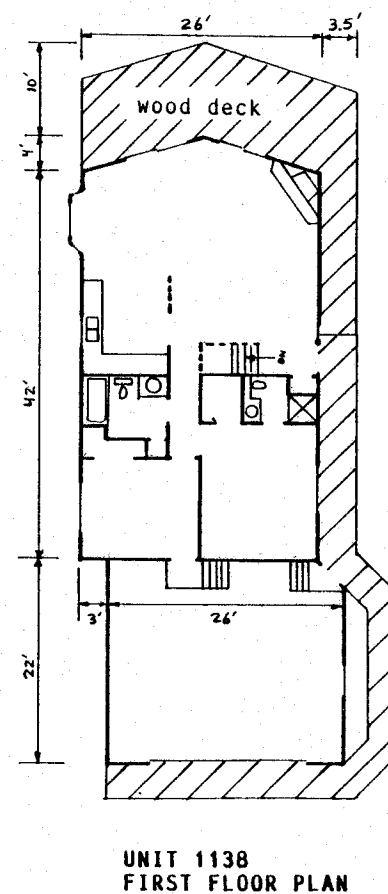

UNIT 1138
FIRST FLOOR PLAN

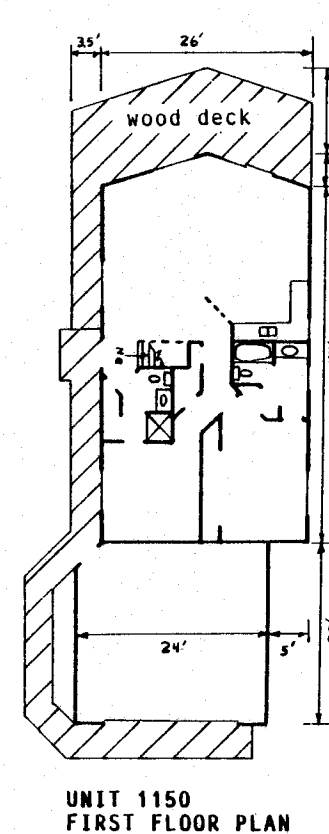

UNIT 1150
FIRST FLOOR PLAN

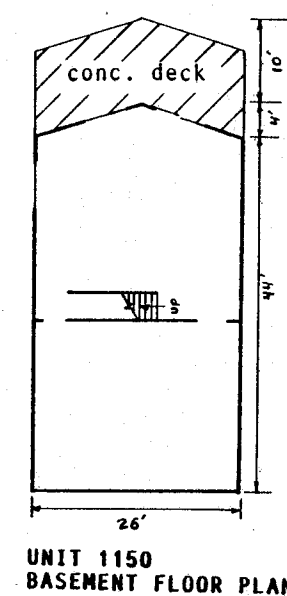

UNIT 1150
BASEMENT FLOOR PLAN

CONDOMINIUM PLAT
Saddle Ridge
PHASE XXIV
Page 2 of 2 pages


Replaced
2004

4934
73


AMENDMENT TO CONDOMINIUM PLAT OF
SADDLE RIDGE
COLUMBIA COUNTY

THIS SURVEY DESCRIBES THE LAND
AND BUILDINGS SUBJECT TO THE
CONDOMINIUM DECLARATION FOR
SADDLE RIDGE

PHASE XXV

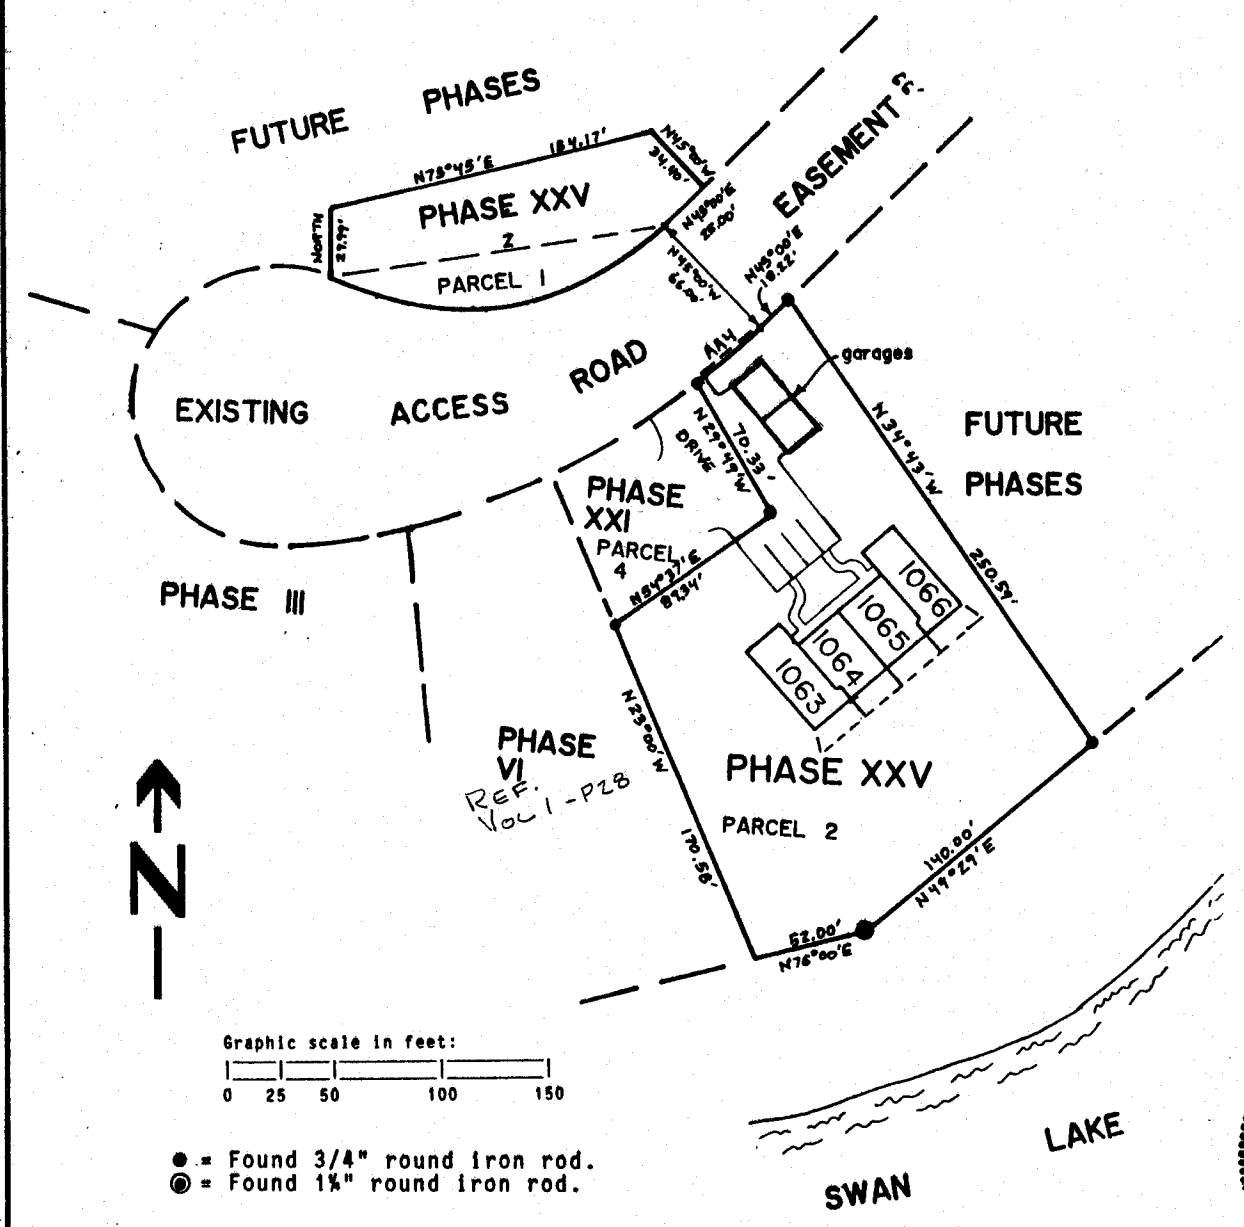

I, Mark C. Carlson, registered land surveyor, hereby certify that I have surveyed the above described parcel, that this plat is a correct representation of the exterior boundaries of the parcel described and the location of the buildings and driveways constructed or to be constructed as proposed at the date hereof and the identification and location of each unit and the common elements can be determined.

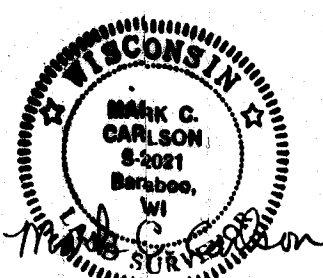

5-30-91
Rev 7-15-91
Rev 7-29-91

PHASE XXV, PARCEL 1 Description:
A parcel of land located in Government Lot 4, Section 1, T12N, R9E, Town of Pacific, Columbia County bounded by the following described line: Commencing at the northeast corner of PHASE XXI, PARCEL 4, Saddle Ridge Condominium; thence Northeasterly along the south line of Access Road Easement on a curve to the left, radius 360.00 feet, whose chord bears N48°12'40"E, 40.34 feet; thence N45°00'W, 66.00 feet to north line of Access Road Easement and point of beginning; thence N45°00'E, along said north line, 25.00 feet; thence N45°00'W, 34.40 feet; thence S75°45'W, 154.17 feet; thence SOUTH, 29.99 feet to said north line; thence Easterly along said north line on a curve to the left, radius 136.00 feet, whose chord bears N80°34'E, 158.22 feet to point of beginning. Said parcel contains 8,770 square feet or 0.201 acres.

PHASE XXV, PARCEL 2 Description:
A parcel of land located in Government Lot 4, Section 1, T12N, R9E, Town of Pacific, Columbia County bounded by the following described line: Beginning at the northeast corner of PHASE XXI, PARCEL 4, Saddle Ridge Condominium; thence Northeasterly along the south line of Access Road Easement on a curve to the left, radius 360.00 feet, whose chord bears N48°12'40"E, 40.34 feet; thence N45°00'E along said south line, 18.22 feet; thence S34°43'E, 250.59 feet; thence S49°29'W, 140.00 feet; thence S76°00'W, 52.00 feet to southeast corner of PHASE VI, Saddle Ridge Condominium; thence N23°00'W along east line of said PHASE VI, 170.58 feet to southwest corner of said PHASE XXI, PARCEL 4; thence N54°37'E along south line of said PHASE XXI, PARCEL 4, 89.34 feet to southeast corner of said PHASE XXI, PARCEL 4; thence N29°49'W along east line of said PHASE XXI, PARCEL 4, 70.33 feet to point of beginning. Said parcel contains 35,110 square feet or 0.806 acres.

An agreement has been signed by Mark Carlson and Carl Berst to exclude all requirements of A-E 7 of the Wisconsin Administrative Code except the preparation of a U.S. public land survey monument record and a map of work performed.

CURVE	DELTA	RADIUS	ARC	CHORD
Z	71°08'	136.00'	168.86'	N80°34'E, 158.22'
AA4	6°25'20"	360.00'	40.36'	N48°12'40"E, 40.34'

CONDOMINIUM PLAT
Saddle Ridge
PHASE XXV
Page 1 of 2 pages

Vol 1 - Page 185

Unit 1063 - 1188
Unit 1064 - 1189
Unit 1065 - 1190
Unit 1066 - 1191
Parcel 1 - 1202
2 - 1203

Vol 1 - P. 185


Replaced
2004

4983

AMENDMENT TO CONDOMINIUM PLAT OF
SADDLE RIDGE
COLUMBIA COUNTY

THIS SURVEY DESCRIBES THE LAND
AND BUILDINGS SUBJECT TO THE
CONDOMINIUM DECLARATION FOR
SADDLE RIDGE

PHASE XXVI

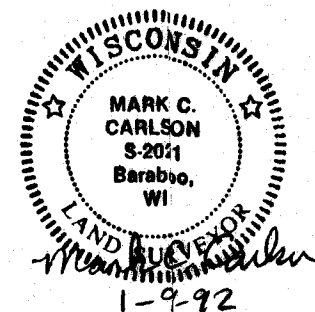

PHASE XXVI Description:
A parcel of land located in NE1/4-SE1/4, Section 2 and Government Lot 4,
Section 1, all T12N, R9E, Town of Pacific, Columbia County, Wisconsin
bounded by the following described line:
Beginning at the northeast corner of Phase XXIV, Parcel 1, Saddle
Ridge Condominium; thence N80°22'W along north line of said Phase XXIV,
241.30 feet to northwest corner of said Phase XXIV; thence N2°00'W along
east line of Phase XXI, Parcel 2, Saddle Ridge Condominium, 63.75 feet;
thence S86°32'E, 256.69 feet; thence S10°18'20"W, 90.00 feet to point
of beginning.
Said parcel contains 19,000 square feet or 0.436 acres.

I, Mark C. Carlson, registered land surveyor, hereby certify that I
have surveyed the above described parcel, that this plat is a correct
representation of the exterior boundaries of the parcel described and
the location of the buildings and driveways constructed or to be
constructed as proposed at the date hereof and the identification and
location of each unit and the common elements can be determined.

An agreement has been signed by Mark Carlson and Carl Berst to
exclude all requirements of A-E 7 of the Wisconsin Administrative Code
except the preparation of a U.S. public land survey monument record
and a map of work performed.

I, Mark C. Carlson, registered land surveyor, hereby certify that
the drawings appearing hereon are an accurate copy of portions of the
plans of each building and substantially depict the layout, location,
unit numbers and dimensions of the building or buildings and units
located and erected or to be erected.

STATE OF WISCONSIN } ss
COLUMBIA COUNTY }
RECEIVED FOR RECORD

JAN 10 1992

Donny J. J. J.
Reg. of Deeds of L1452 M

CONDOMINIUM PLAT
Saddle Ridge
PHASE XXVI
Page 1 of 1 page

Vol 1 - Page 177

188



Replaced
2004

506531


AMENDMENT TO CONDOMINIUM PLAT OF
SADDLE RIDGE
COLUMBIA COUNTY

THIS SURVEY DESCRIBES THE LAND
AND BUILDINGS SUBJECT TO THE
CONDOMINIUM DECLARATION FOR
SADDLE RIDGE


PHASE XXVII

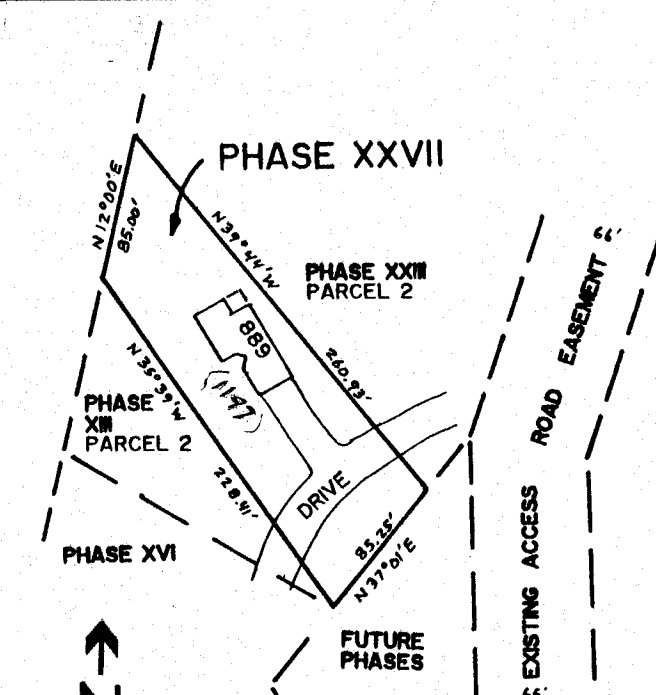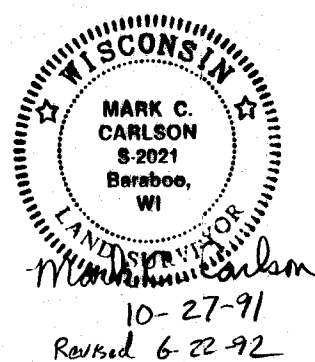

Graphic scale in feet:
0 30 60 120 180

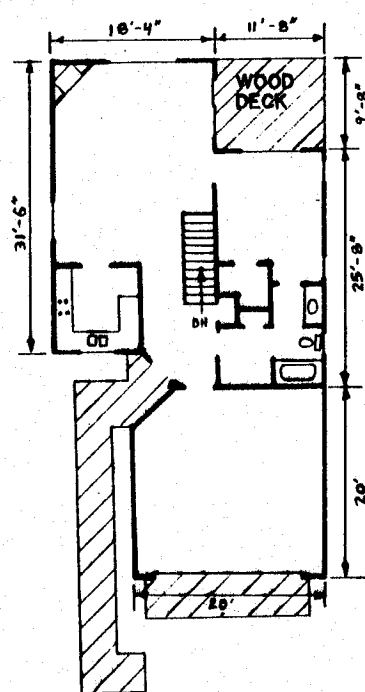

UNIT 889
First Floor Plan

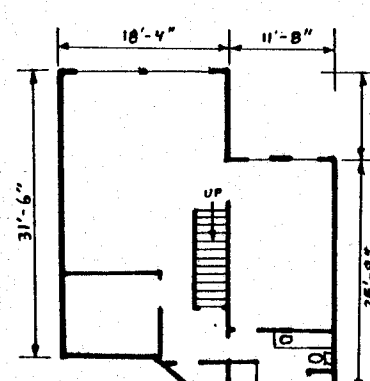


UNIT 889
Basement Floor Plan

PHASE XXVII Description:
A parcel of land located in NE1/4, Section 2, T12N, R9E, Town of Pacific, Columbia County, Wisconsin bounded by the following described line: Beginning at the northwest corner of PHASE XIII, Parcel 2, Saddle Ridge Condominium; thence N12°00'E, 85.00 feet to southwest corner of PHASE XXIII, Parcel 2, Saddle Ridge Condominium; thence S39°44'E along south line of said PHASE XXIII, 260.93 feet to southeast corner of said PHASE XXIII; thence S37°01'W, 85.25 feet to southeast corner of said PHASE XIII; thence N35°39'W along north line of said PHASE XIII, 228.41 feet to point of beginning.
Said parcel contains 18,000 square feet or 0.413 acres.

I, Mark C. Carlson, registered land surveyor, hereby certify that I have surveyed the above described parcel, that this plat is a correct representation of the exterior boundaries of the parcel described and the location of the buildings and driveways constructed or to be constructed as proposed at the date hereof and the identification and location of each unit and the common elements can be determined.

An agreement has been signed by Mark Carlson and Carl Berst to exclude all requirements of A-E 7 of the Wisconsin Administrative Code except the preparation of a U.S. public land survey monument record and a map of work performed.

I, Mark C. Carlson, registered land surveyor, hereby certify that the drawings appearing hereon are an accurate copy of portions of the plans of each building and substantially depict the layout, location, unit numbers and dimensions of the building or buildings and units located and erected or to be erected.

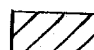 = Limited Common Area

* = PARCEL 2

STATE OF WISCONSIN } ss
COLUMBIA COUNTY }
RECEIVED FOR RECORD


AUG 26 1992

Benjamin J. Judd
Reg. of Deeds at 4:00 P.M.

CONDOMINIUM PLAT
Saddle Ridge
PHASE XXVII
Page 1 of 1 page

Vol 1 Page 189

Replaced
2004

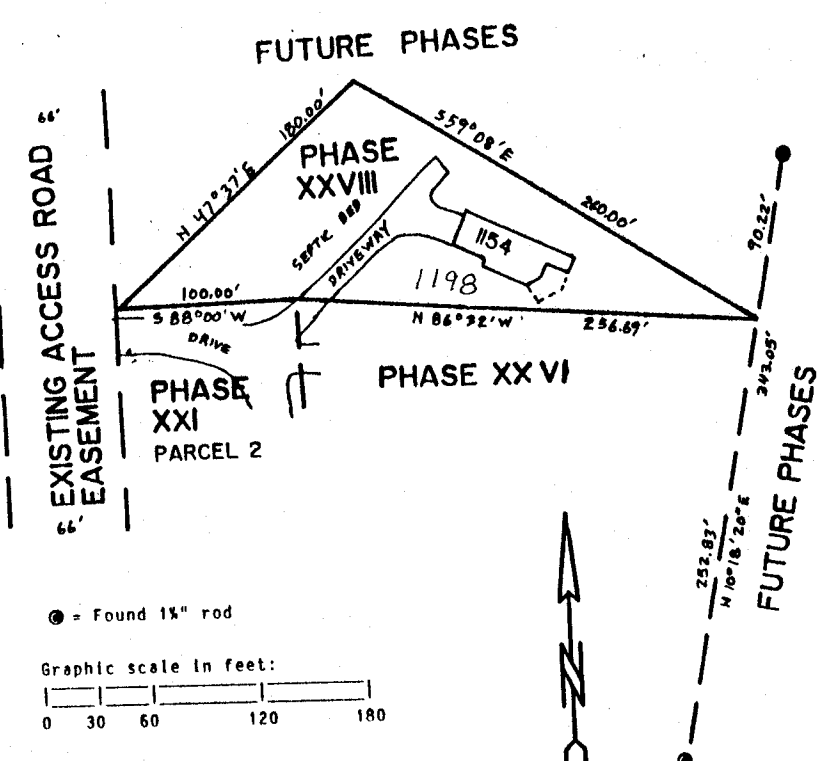

STATE OF WISCONSIN } ss
COLUMBIA COUNTY }
RECEIVED FOR RECORD
MAY 20 1993
Perry J. G. J.
Reg. / Deeds at 111.55 PM



AMENDMENT TO CONDOMINIUM PLAT OF
SADDLE RIDGE
COLUMBIA COUNTY

THIS SURVEY DESCRIBES THE LAND
AND BUILDINGS SUBJECT TO THE
CONDOMINIUM DECLARATION FOR
SADDLE RIDGE



PHASE XXVIII

PHASE XXVIII Description:
A parcel of land located in NEW-SEK, Section 2 and Government Lot 4, Section 1, all T12N, R9E, Town of Pacific, Columbia County, Wisconsin bounded by the following described line:
Beginning at the northeast corner of PHASE XXVI, Saddle Ridge Condominium; thence N86°32'W along north line of said PHASE XXVI, 256.69 feet to northeast corner of PHASE XXI, Parcel 2, Saddle Ridge Condominium; thence S88°00'W along north line of said PHASE XXI, Parcel 2, 100.00 feet to northwest corner of said PHASE XXI, Parcel 2; thence N47°37'E, 180.00 feet; thence S59°08'E, 260.00 feet to point of beginning. Said parcel contains 21,180 square feet or 0.486 acres.

I, Mark C. Carlson, registered land surveyor, hereby certify that I have surveyed the above described parcel, that this plat is a correct representation of the exterior boundaries of the parcel described and the location of the buildings and driveways constructed or to be constructed as proposed at the date hereof and the identification and location of each unit and the common elements can be determined.

An agreement has been signed by Mark Carlson and Carl Berst to exclude all requirements of A-E 7 of the Wisconsin Administrative Code except the preparation of a U.S. public land survey monument record and a map of work performed.

I, Mark C. Carlson, registered land surveyor, hereby certify that the drawings appearing hereon are an accurate copy of portions of the plans of each building and substantially depict the layout, location, unit numbers and dimensions of the building or buildings and units located and erected or to be erected.

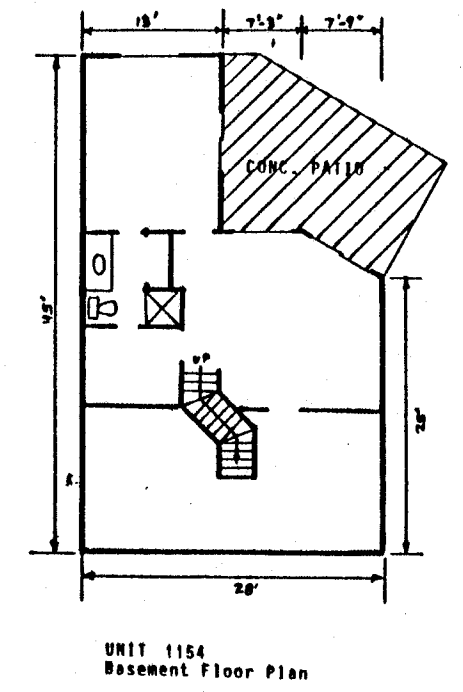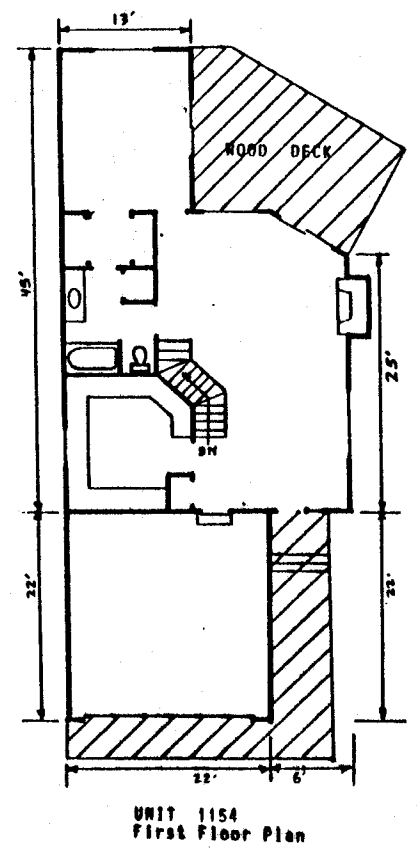


▨ = Limited Common Area

CONDOMINIUM PLAT
Saddle Ridge
PHASE XXVIII
Page 1 of 1 page

Replaced
04



045043

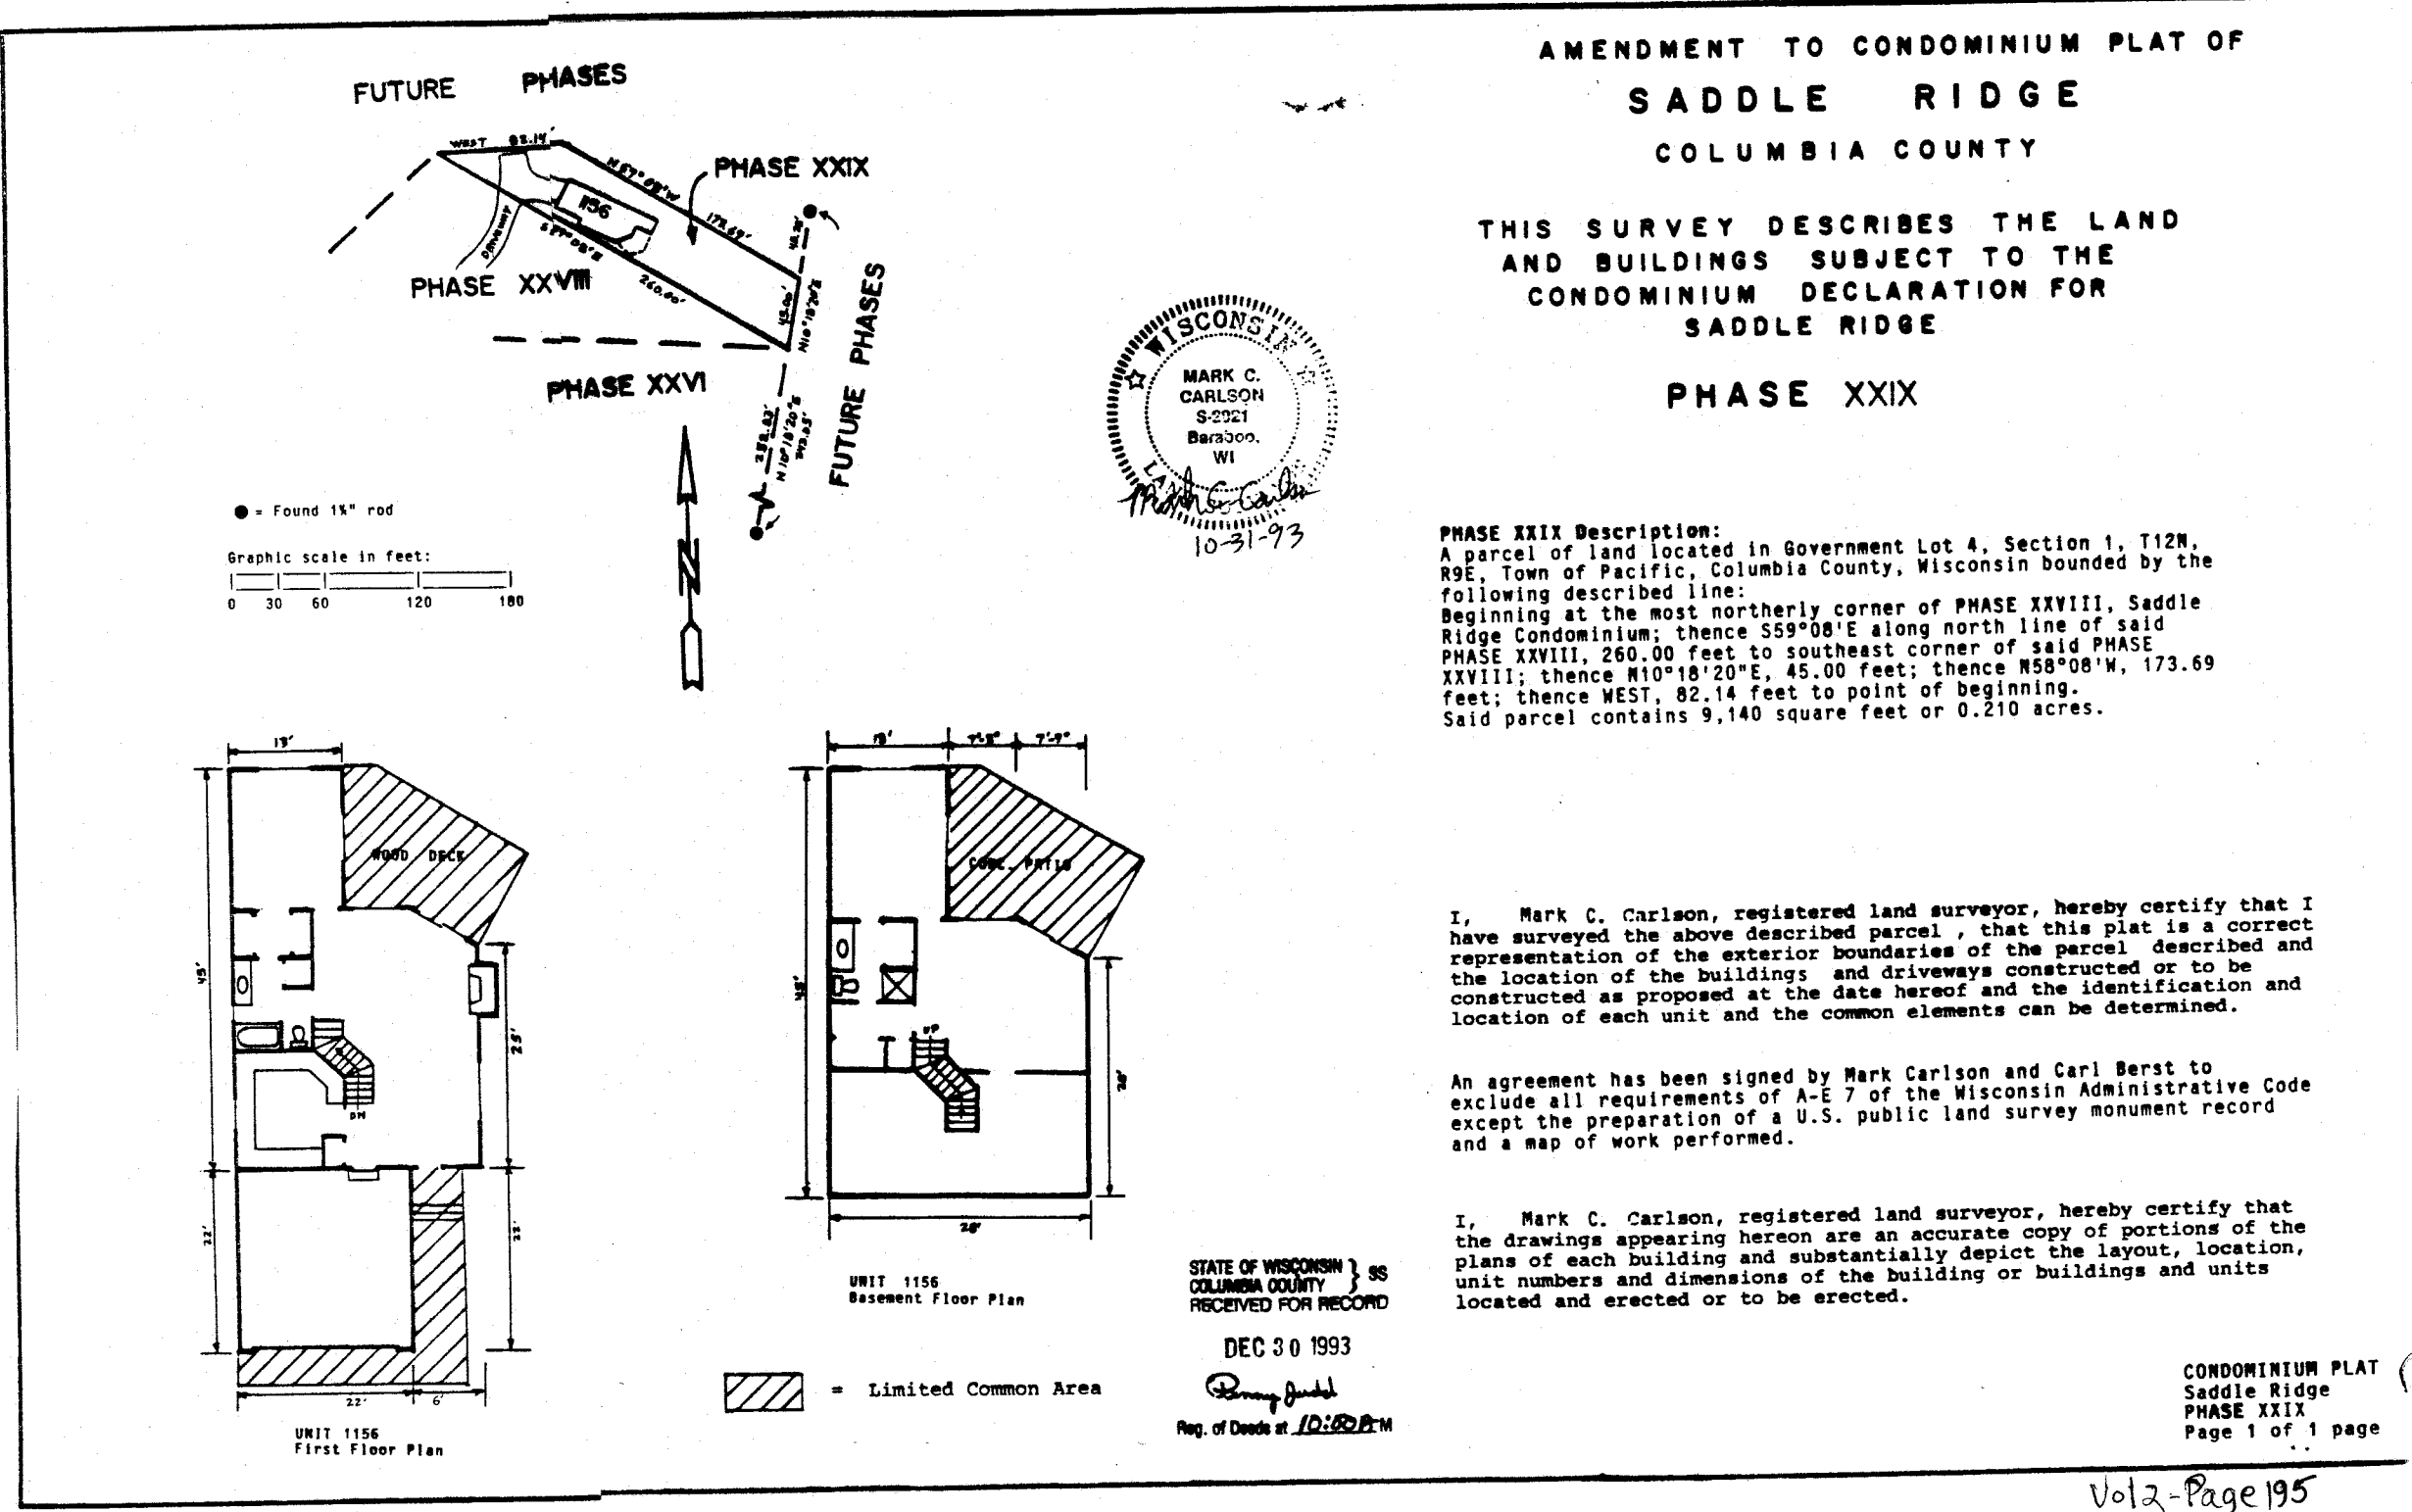

Replaced
2004

525345

FUTURE PHASES

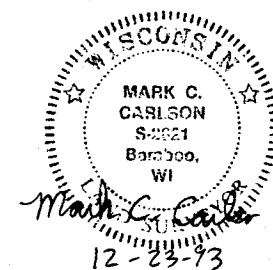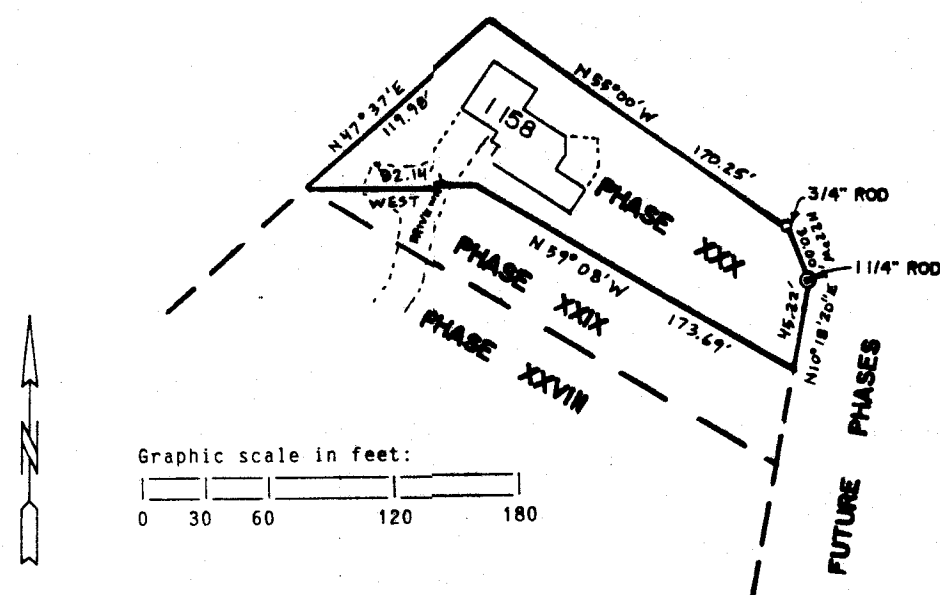

AMENDMENT TO CONDOMINIUM PLAT OF
SADDLE RIDGE
COLUMBIA COUNTY

THIS SURVEY DESCRIBES THE LAND
AND BUILDINGS SUBJECT TO THE
CONDOMINIUM DECLARATION FOR
SADDLE RIDGE

PHASE XXX


PHASE XXX Description:

A parcel of land located in Government Lot 4, Section 1, T12N, R9E, Town of Pacific, Columbia County, Wisconsin bounded by the following described line:
Beginning at the northeast corner of PHASE XXIX, Saddle Ridge Condominium; thence N59°08'W along north line of said PHASE XXIX, 173.69 feet; thence West along said northline, 82.14 feet to northwest corner of said PHASE XXIX; thence N47°37'E, 119.98 feet; thence S55°00'E, 170.25 feet; thence S22°E, 30.00 feet; thence S10°18'20"W, 45.22 feet to point of beginning.
Said parcel contains 14,890 square feet or 0.342 acres.


I, Mark C. Carlson, registered land surveyor, hereby certify that I have surveyed the above described parcel, that this plat is a correct representation of the exterior boundaries of the parcel described and the location of the buildings and driveways constructed or to be constructed as proposed at the date hereof and the identification and location of each unit and the common elements can be determined.

An agreement has been signed by Mark Carlson and Carl Bess to exclude certain requirements of A-E 7, Wisconsin Administrative Code, namely setting monuments at the corners of the parcel described.

I, Mark C. Carlson, registered land surveyor, hereby certify that the drawings appearing hereon are an accurate copy of portions of the plans of each building and substantially depict the layout, location, unit numbers and dimensions of the building or buildings and units located and erected or to be erected.

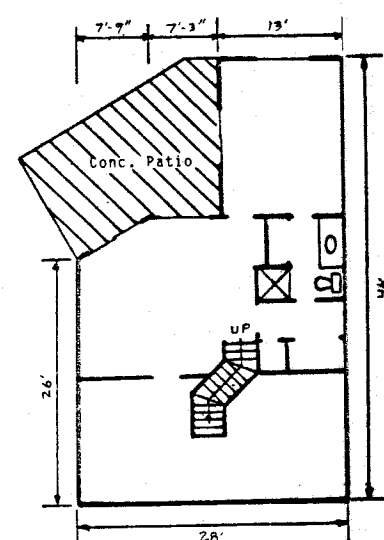

UNIT 1158
Basement Floor Plan

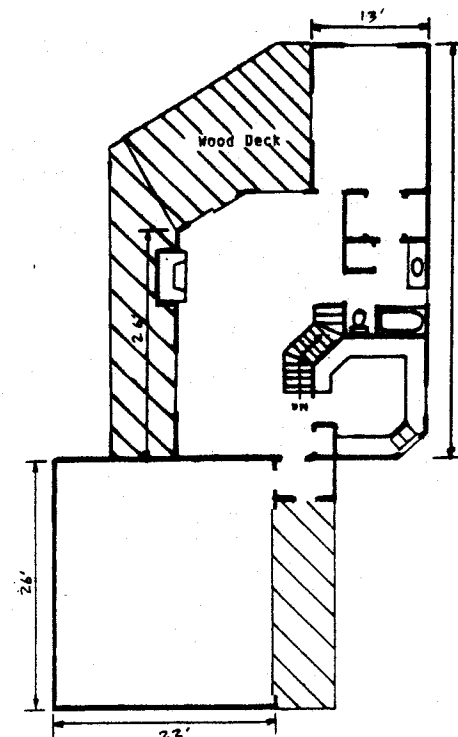

UNIT 1158
First Floor Plan

STATE OF WISCONSIN } ss
COLUMBIA COUNTY }
RECEIVED FOR RECORD
DEC 30 1993
Reg. of Deeds at 12/30/93

= Limited Common Area


CONDOMINIUM PLAT
Saddle Ridge
PHASE XXX
Page 1 of 1 page

Vol 1- Page 196

5/8
P30


PHASE I

SCALE IN FEET



0 50 100 200 300 400

Replaced
2004

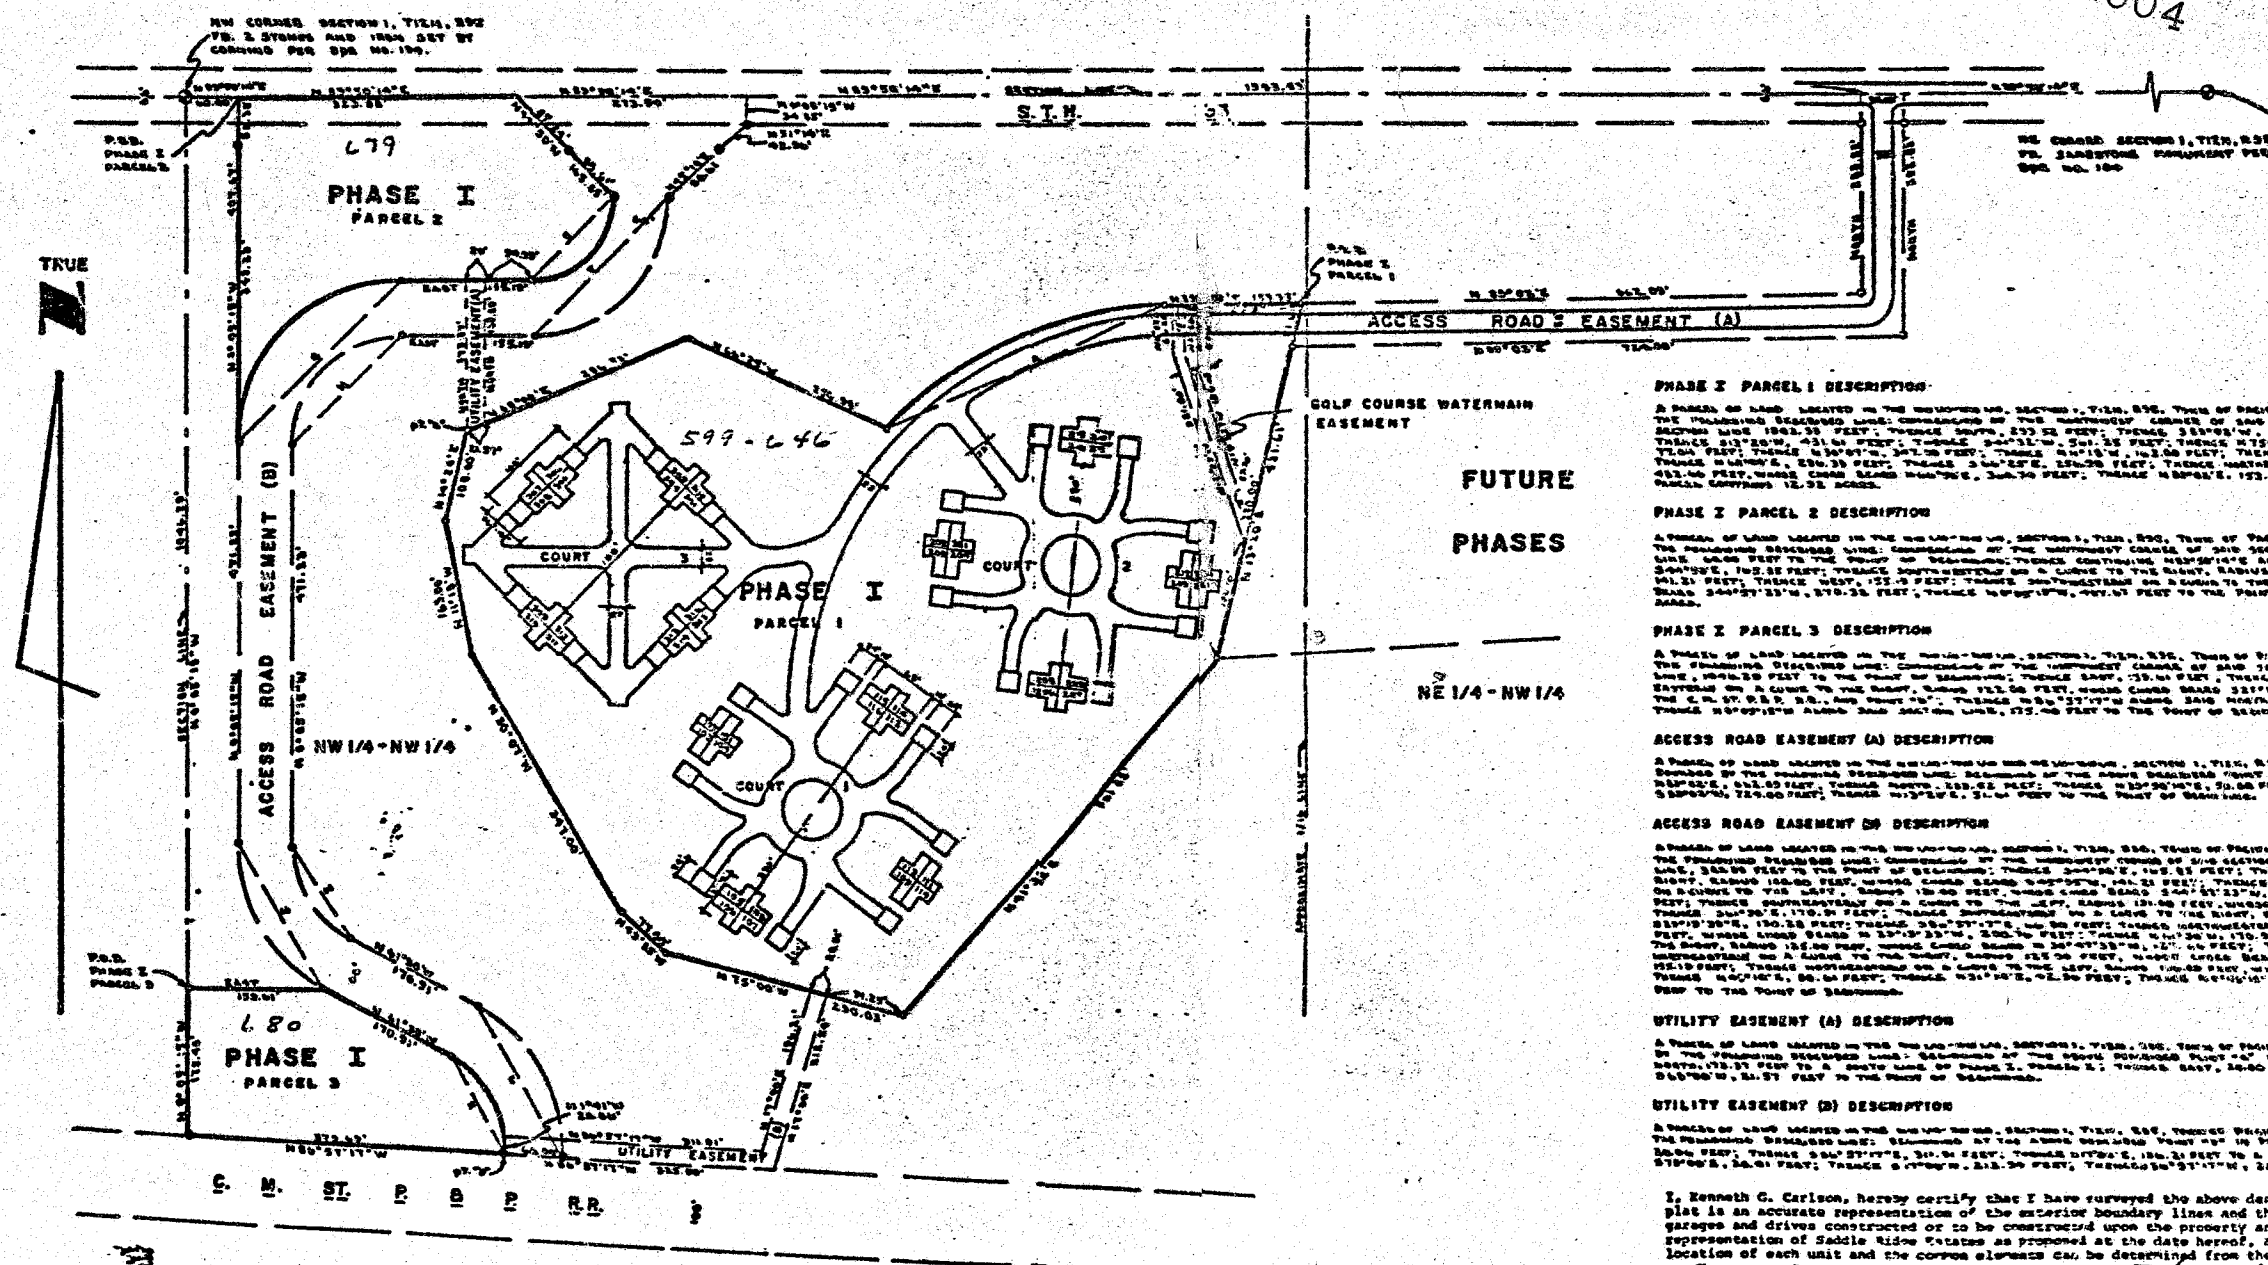[illegible][illegible]

A TRAPLINE OF LAND LOCATED IN E. 1/4 SEC. 10-14-16-17, SECTION 9, T.23N., R.20E., TOWNSHIP OF TAPAH, COLUMBIA COUNTY, WISCONSIN, BOUNDED BY THE PLYMOUTH ROCKED LIND: COMMENCED AT THE WESTMOST CORNER OF SAID SECTION 11 THENCE S64°11'11" E ALONG THE SOUTH LINE OF SAID SECTION 11 TO THE POINT OF BEGINNING; THENCE CONTINUING N68°14'11" E ALONG THE SECTION LINE, 313.00 FEET; THENCE S44°52'11" E, 102.50 FEET; THENCE SOUTH-EASTWARD ON A CURVE TO THE RIGHT, RADIUS 100.00 FEET, WHERE AN ARCS BEARS S45°03'11" E, 100.00 FEET; THENCE S64°11'11" E, 100.00 FEET; THENCE S64°11'11" E ALONG THE EAST LINE OF SAID SECTION 11 TO THE POINT OF BEGINNING; BEARS S44°52'11" E, 370.35 FEET; THENCE N48°03'11" W, 100.00 FEET TO THE POINT OF BEGINNING. SAID PLYMOUTH ROCKED LIND BEARS

A TRAIL OF S&W LOCATED ON THE NORTH-WEST CORNER, SECTION 1, T18N, R36E, TOWNSHIP 18 NORTH, CONTOUR COUNTY, MONTANA, BEGINNING AT THE SHARPER RIVER, AND COMMENCING AT THE CORNER OF SAID SECTION 1, TOWNSHIP 18 NORTH, R36E, AND RANDED THE SECTION LINE, APPROX 50 FEET TO THE POINT OF BEGINNING; THENCE SOUTHWEST, 75.00 FEET, THENCE S80°E, 170.00 FEET; THENCE S80°E, 100.00 FEET, BEYOND A CORNER TO THE NORTH, BEYOND 225.00 FEET, BEYOND CORNER BEARS 221°E/55°E, 130.00 FEET TO THE NORTH LINE OF THE E. 1/2 OF S&W, R.R. AND POWER "B". THENCE TO S80°37'E, 100.00 FEET BEYOND SAID NORTH LINE, 37.00 FEET TO SAID SECTION LINE; THENCE S80°37'E, 100.00 FEET BEYOND SAID NORTH LINE, 175.00 FEET TO THE POINT OF BEGINNING; SAID TRAIL CONTAINS 1.25 ACRES.

A TRAIL OF ROAD LIES IN THE N.W. CORNER OF SECTION 7, T.18N., R.2E., TOWNSHIP OF FRANKLIN, CLAYTON COUNTY, MISSISSIPPI BOUNDED BY THE FOLLOWING BEARING AND DISTANCE: BEGINNING AT THE NORTH WEST-CORNER POINT OF SECTION 6 ON EAST 1/2 SEC. 6, S. 18° 05' E., 612.05 FEET; THENCE NORTH, 229.02 FEET; THENCE N. 30° 50' W., 52.00 FEET; THENCE SOUTH, 222.03 FEET; THENCE S 80° 00' W., 724.00 FEET; THENCE S 80° 00' W., 31.00 FEET TO THE POINT OF BEGINNING.

[illegible]


WITNESSETH THAT THE ABOVE DESCRIBED

[illegible]

I, Kenneth G. Carlson, hereby certify that I have surveyed the above described property and that this plat is an accurate representation of the exterior boundary lines and the location of the buildings, garages and drives constructed or to be constructed upon the property and that the plat is a correct representation of Saddle Ridge Estates as proposed at the date hereof, and the identification and location of each unit and the common elements can be determined from the plat.

March 23, 1978
Date

James H. Carlson
JAMES H. CARLSON, LAND SURVEYOR, DIST. 3 1928

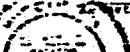Seal of the State of Illinois, Department of Land Surveying, James H. Carlson, Surveyor, District 3, 1928.

Received this
14th day of
April, 1928
27th day of July 1928
Received this 11 day of Sept., 1928
Received 10th day of Sept, 1928
Received this 28th day of Sept, 1928

SADDLE RIDGE ESTATES EXHIBIT A PAGE

05185

WISCONSIN;
COUNTY

or Record the 4
October A.D. 1978
 o'clock ^{PM} and recorded
 by Plate
 of Records Page 1

Bill
Register of Deeds

GOLF COURSE WATER MAIN BASIN

A parcel of land 15 feet wide located in the NW 1/4-sec 4, Section 5, T22N, R20E, Town of Pacific, Colusa County, 15 feet wide bounded by the following described points: Commencing at the above described point of beginning of Phase I Parcel 1 thence S89°02'W, 125.83 feet to the point of beginning of this parcel; thence S55°58'E, 63.80 feet; thence S19°27'W, 154.00 feet; thence N01°27'W, 27.70 feet; thence N19°27'W, 221.80 feet; thence N00°58'W, 66.23 feet; thence N89°02'E, 15.00 feet to the point of beginning of this parcel.

SADDLE RIDGE ESTATES
SEC. 1 T. 12 R. 9
TOWN OF PACIFIC
PHASE III

V. 5 P. 53 CONDOMINIUM PLATS
REC. 12-20-81
#852 THRU 855
1983 Assessment Roll

Replaced
2004

SADDLE RIDGE ESTATES

THIS SURVEY DESCRIBES THE LAND
AND BUILDINGS SUBJECT TO THE
CONDOMINIUM DECLARATION FOR
SADDLE RIDGE ESTATES

PHASE III

SCALE IN FEET
0 50 100 150

FUTURE

PHASES

NE 1/4 of NW 1/4

PHASE II

ACCESS ROAD

EASEMENT (C)

PHASE III
COURT

6



SADDLE RIDGE ESTATES
EXHIBIT A PAGE 3
VOL. 1 PAGE 59

NW CORNER
SECTION 1
T12N, R9E
Found 2 stones and iron set by
Corning per BPR No. 194

N 89° 50' 14" E 1983.53'
Section Line
S 15.86' W 140.18'
S 89° 02' W 50.00'

PHASE III DESCRIPTION

A parcel of land in the Northeast 1/4 Northwest 1/4, Section 1,
T12N, R9E, Town of Pacific, Columbia County, Wisconsin, bounded
by the following described line:

Commencing at the Northwest corner of said Section 1; thence N89°50'14"E,
along the section line 1983.53 feet; thence South 283.52 feet; thence
S36°56'E, 176.50 feet to Point of Beginning (P.O.B.); thence S79°49'E,
274.64 feet; thence S10°11'W, 137.37 feet; thence N73°30'W, 87.15 feet;
thence northwesterly on a curve to the right, radius 176.00 feet whose
chord bears N57°00'W, 99.97 feet; thence N36°56'W, 130.83 feet to the
Point of Beginning, said area containing approximately .61 acres.

ACCESS ROAD EASEMENT (C)

A parcel of land in the Northeast 1/4 Northwest 1/4, Section 1,
T12N, R9E, Town of Pacific, Columbia County, Wisconsin, bounded
by the following described line:

Commencing at the Northwest corner of said Section 1; thence N89°50'14"E,
along the section line 1983.53 feet; thence South 283.52 feet to the
Point of Beginning; thence S36°56'E, 176.50 feet; thence S79°49'E,
274.64 feet; thence N10°11'E, 50.00 feet; thence N79°49'W, 255.00 feet;
thence N36°56'W, 140.18 feet; thence South 15.86 feet; thence S89°02'W,
50.00 feet, to the Point of Beginning. (P.O.B.)

I, Alvin F. Hamele, hereby certify that I have surveyed
the above described property and that this plat is an
accurate representation of the exterior boundary lines
and the location of the buildings, garages, and drives
constructed or to be constructed upon the property and
that the plat is a correct representation of Saddle
Ridge Estates Phase III as proposed to the date hereof,
and the identification and location of each unit and
the common elements can be determined from the plat.

Dec 17, 1982
Date

Alvin F. Hamele
Alvin F. Hamele, S-1453



Commencing at the Northwest corner of Section 1, thence N95°00'14"E along the Section line 1980.53 feet; thence north 281.52 feet; thence S16°56'E, 176.50 feet; thence S79°49'E, 276.64 feet to the point of beginning (P.O.B.) thence N01°15'30.00" west; thence N79°00'14"E, 77.19 feet; thence S66°17'18"E, 224.15 feet to the Northwest corner of Section 1, right; radius 185.82 feet; whose chord bears S29°00'W, 225.68 feet; thence southeasterly on a Curve Right, radius 407.21 feet, whose chord bears S21°43'W, 186.37 feet; thence N55°05'W, 50.00 feet; thence northerly on a curve to the left, radius 357.21 feet, whose chord bears N55°05'W, 50.00 feet; thence westerly on a curve left radius 115.52 feet whose chord bears N29°00'W, 165.00 feet; thence S66°17'W, 218.03 feet; thence N79°49'W, 71.26 feet to the point of beginning.

SADDLE RIDGE ESTATES
SEC. 1 T. 12 R. 9
TOWN PACIFIC
PHASE V - cont'd

V. 1 P. 84 CONDOMIN PLATS
REC 8-18-83
862
1984 ASSESSMENT ROLL
DECLARATIONS R258-792

Replaced
2004

SEE
P. 5

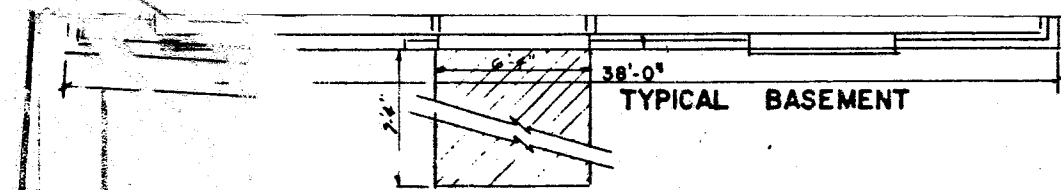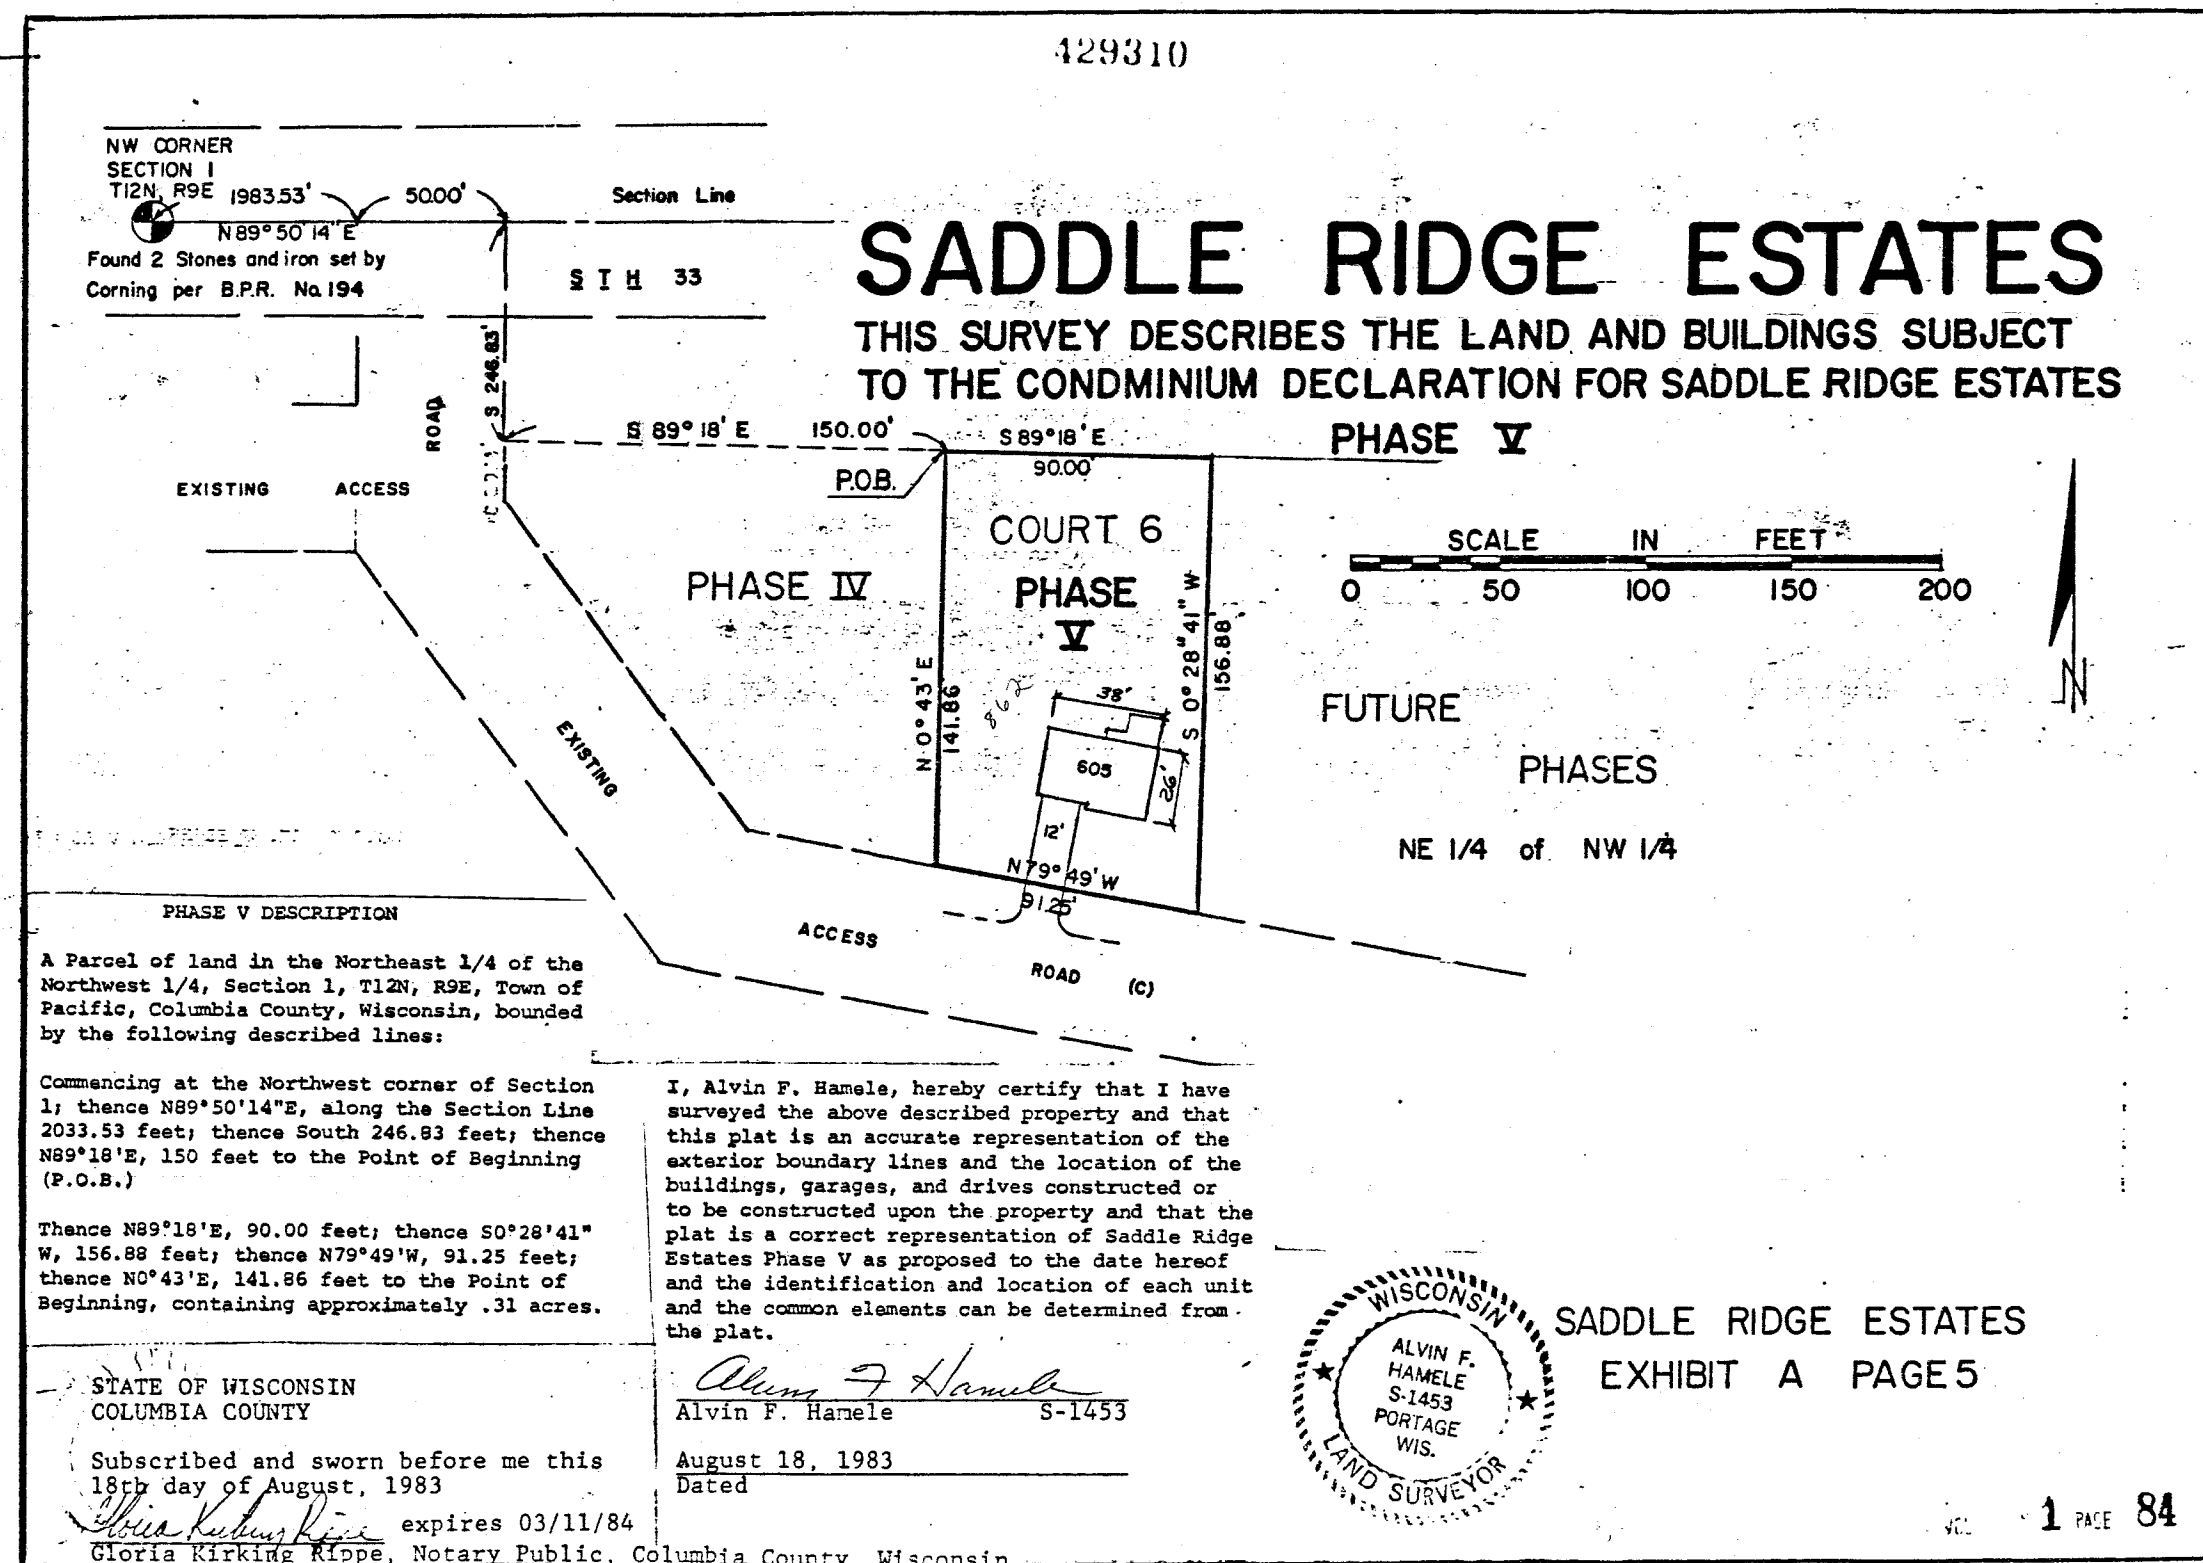


SADDLE RIDGE ESTATES
ROUTE "1" PORTAGE, WISCONSIN 53901

Pcl 1 - 1.419 AC.
Pcl 2 - 0.495 AC.

Saddle Ridge Estates Condominium
Phase 5 Court 6
Prt NE NW + NW NE Sec 1-12-9

1987 Assmt Roll
Pcl 9-22-86
V.1 Condo Page 130

Amendment to Pcl 1+2 Phase V1
863 thru 873

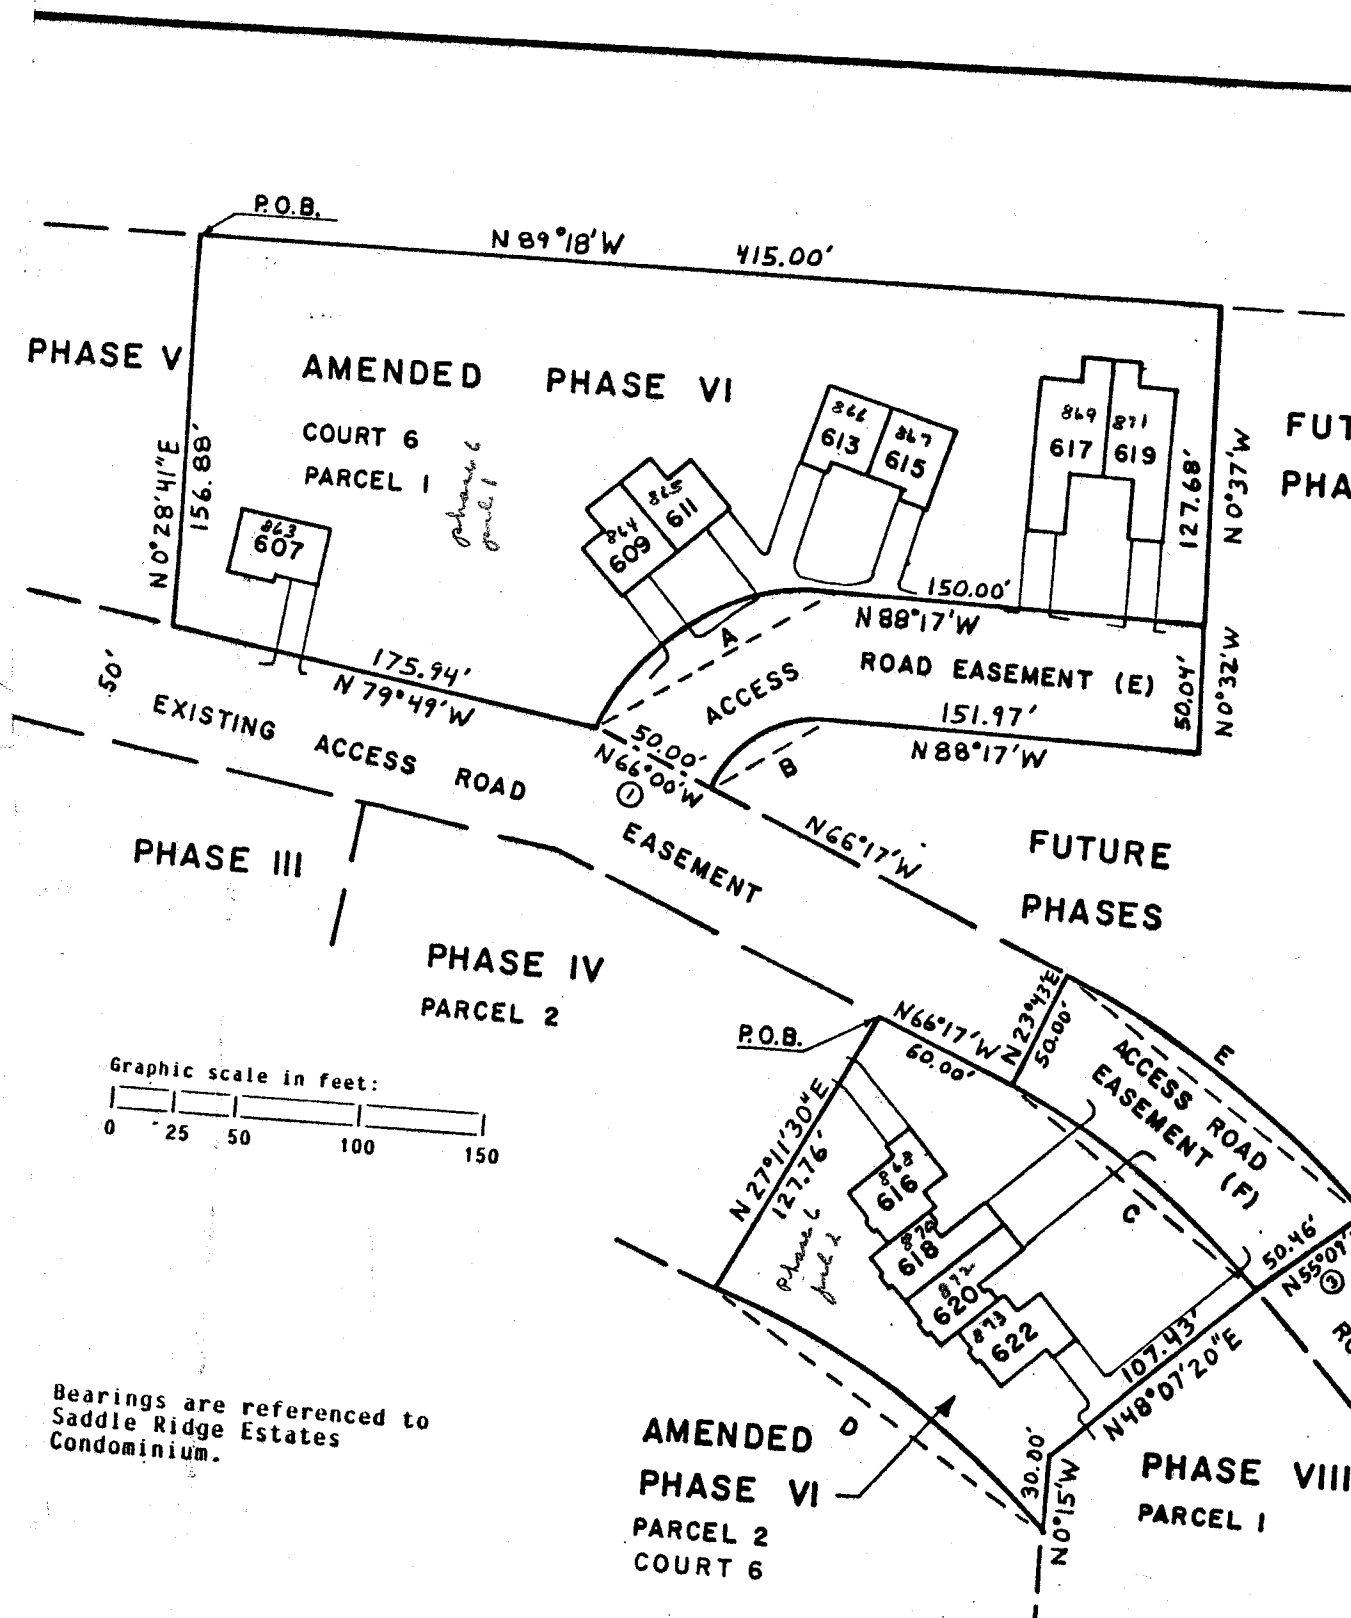

DELTA	RADIUS	ARC	CHORD
68°00'	100.00'	118.68'	N57°43'E, 111.84'
68°16'30"	50.00'	59.58'	N57°34'30"E, 56.12'
23°04'20"	325.00'	130.88'	N54°45'W, 130.00'
31°00'	308.00'	166.65'	N58°00'W, 164.62'
24°11'40"	375.00'	158.35'	N54°11'W, 157.18'

RECORDED AS:
166°17'W
109.00'
146°47'E, 50.00'
14°43'W, 150.00'

I, Kenneth G. Carlson, register
have surveyed the above descri
representation of the exterior
the location of the building
constructed as proposed at the
location of each unit and the

An agreement has been s
and Carl Berst to exclu
of A-E S, Wisconsin Adm
setting monuments at th
described.

MENT TO CONDOMINIUM PLAT OF E RIDGE ESTATES COLUMBIA COUNTY

Replaced
2004
VEY DESCRIBES THE LAND AND
SUBJECT TO THE CONDOMINIUM
ION FOR SADDLE RIDGE ESTATES

AMENDED PHASE VI

D PHASE VI PARCEL 1 Description:
of land located in the NEW-NW and NW-NW, Section 1, T12N,
of Pacific, Columbia County, Wisconsin bounded by the
described line: Beginning at the northeast corner of PHASE
Ridge Estates Condominium; thence S89°18'E, 415.00 feet;
37°E, 127.68 feet; thence N88°17'W, 150.00 feet; thence
erly on a curve to the left, radius 100.00 feet; whose chord
43°W, 111.84 feet; thence N79°49'W, 175.94 feet; thence
E, 156.88 feet to the point of beginning. Said parcel contains
quare feet or 1.419 acres.

ED PHASE VI PARCEL 2 Description:
of land located in the NEW-NW and NW-NW, Section 1, T12N,
n of Pacific, Columbia County, Wisconsin bounded by the
g described line: Beginning at the northeast corner of PHASE
l 2, Saddle Ridge Estates Condominium; thence S66°17'E, 60.00
ence southeasterly on a curve to the right, radius 325.00
ose chord bears S54°45'E, 130.00 feet; thence S48°07'20"W,
feet; thence S0°15'E, 30.00 feet; thence northwesterly on a curve
left, radius 308.00 feet, whose chord bears N58°00'W, 164.62
hence N27°11'30"E, 127.76 feet to the point of beginning. Said
contains 21,540 square feet or 0.495 acres.

ED PHASE VI ACCESS ROAD EASEMENT (E):
of land located in NEW-NW and NW-NW, Section 1, T12N, R9E,
f Pacific, Columbia County, Wisconsin bounded by the following
ed line: Commencing at the northeast corner of PHASE V,
dle Ridge Estates Condominium; thence S89°18'E, 415.00 feet;
50°37'E, 127.68 feet to the point of beginning; thence S0°32'E,
feet; thence N88°17'W, 151.97 feet; thence westerly on a curve to
ft, radius 50.00 feet, whose chord bears S57°34'30"W, 56.12 feet;
N66°00'W, 50.00 feet; thence easterly on a curve to the right,
100.00 feet, whose chord bears N57°43'E, 111.84 feet; thence
E, 150.00 feet to the point of beginning. Said parcel contains
square feet or 0.276 acres.

ED PHASE VI ACCESS ROAD EASEMENT (F):
of land located in NEW-NW and NW-NW, Section 1, T12N, R9E,
f Pacific, Columbia County, Wisconsin bounded by the following
bed line: Commencing at the northeast corner of PHASE IV, Parcel
dle Ridge Estates Condominium; thence S66°17'E, 60.00 feet to the
of beginning; thence N23°43'E, 50.00 feet; thence easterly on
ve to the right, radius 375.00 feet, whose chord bears S54°11'E,
8 feet; thence S55°09'W, 50.46 feet; thence westerly on a curve to
left, radius 325.00 feet, whose chord bears N54°45'W, 130.00 feet
point of beginning. Said parcel contains 7,230 square feet or
acres.

Condominium Plat Amended Phase VI

PAGE 1 of 2 PAGES

Vol 1- 130


1 PAGE 131

Saddle Ridge Estate
Town of Pacific

Phase VII Count 6
1985 Assent Roll
2-1-12-9

V. 1 Conto
Page 103
Rec 1-6-84

T. Pacific
J. A.
Jul 1-0.20 A
Jul 2-0.49 A
new # 890 - Unit 638
891 - Unit 628
892 - Unit 630
all phase VII count 6
Covenants R 264-266

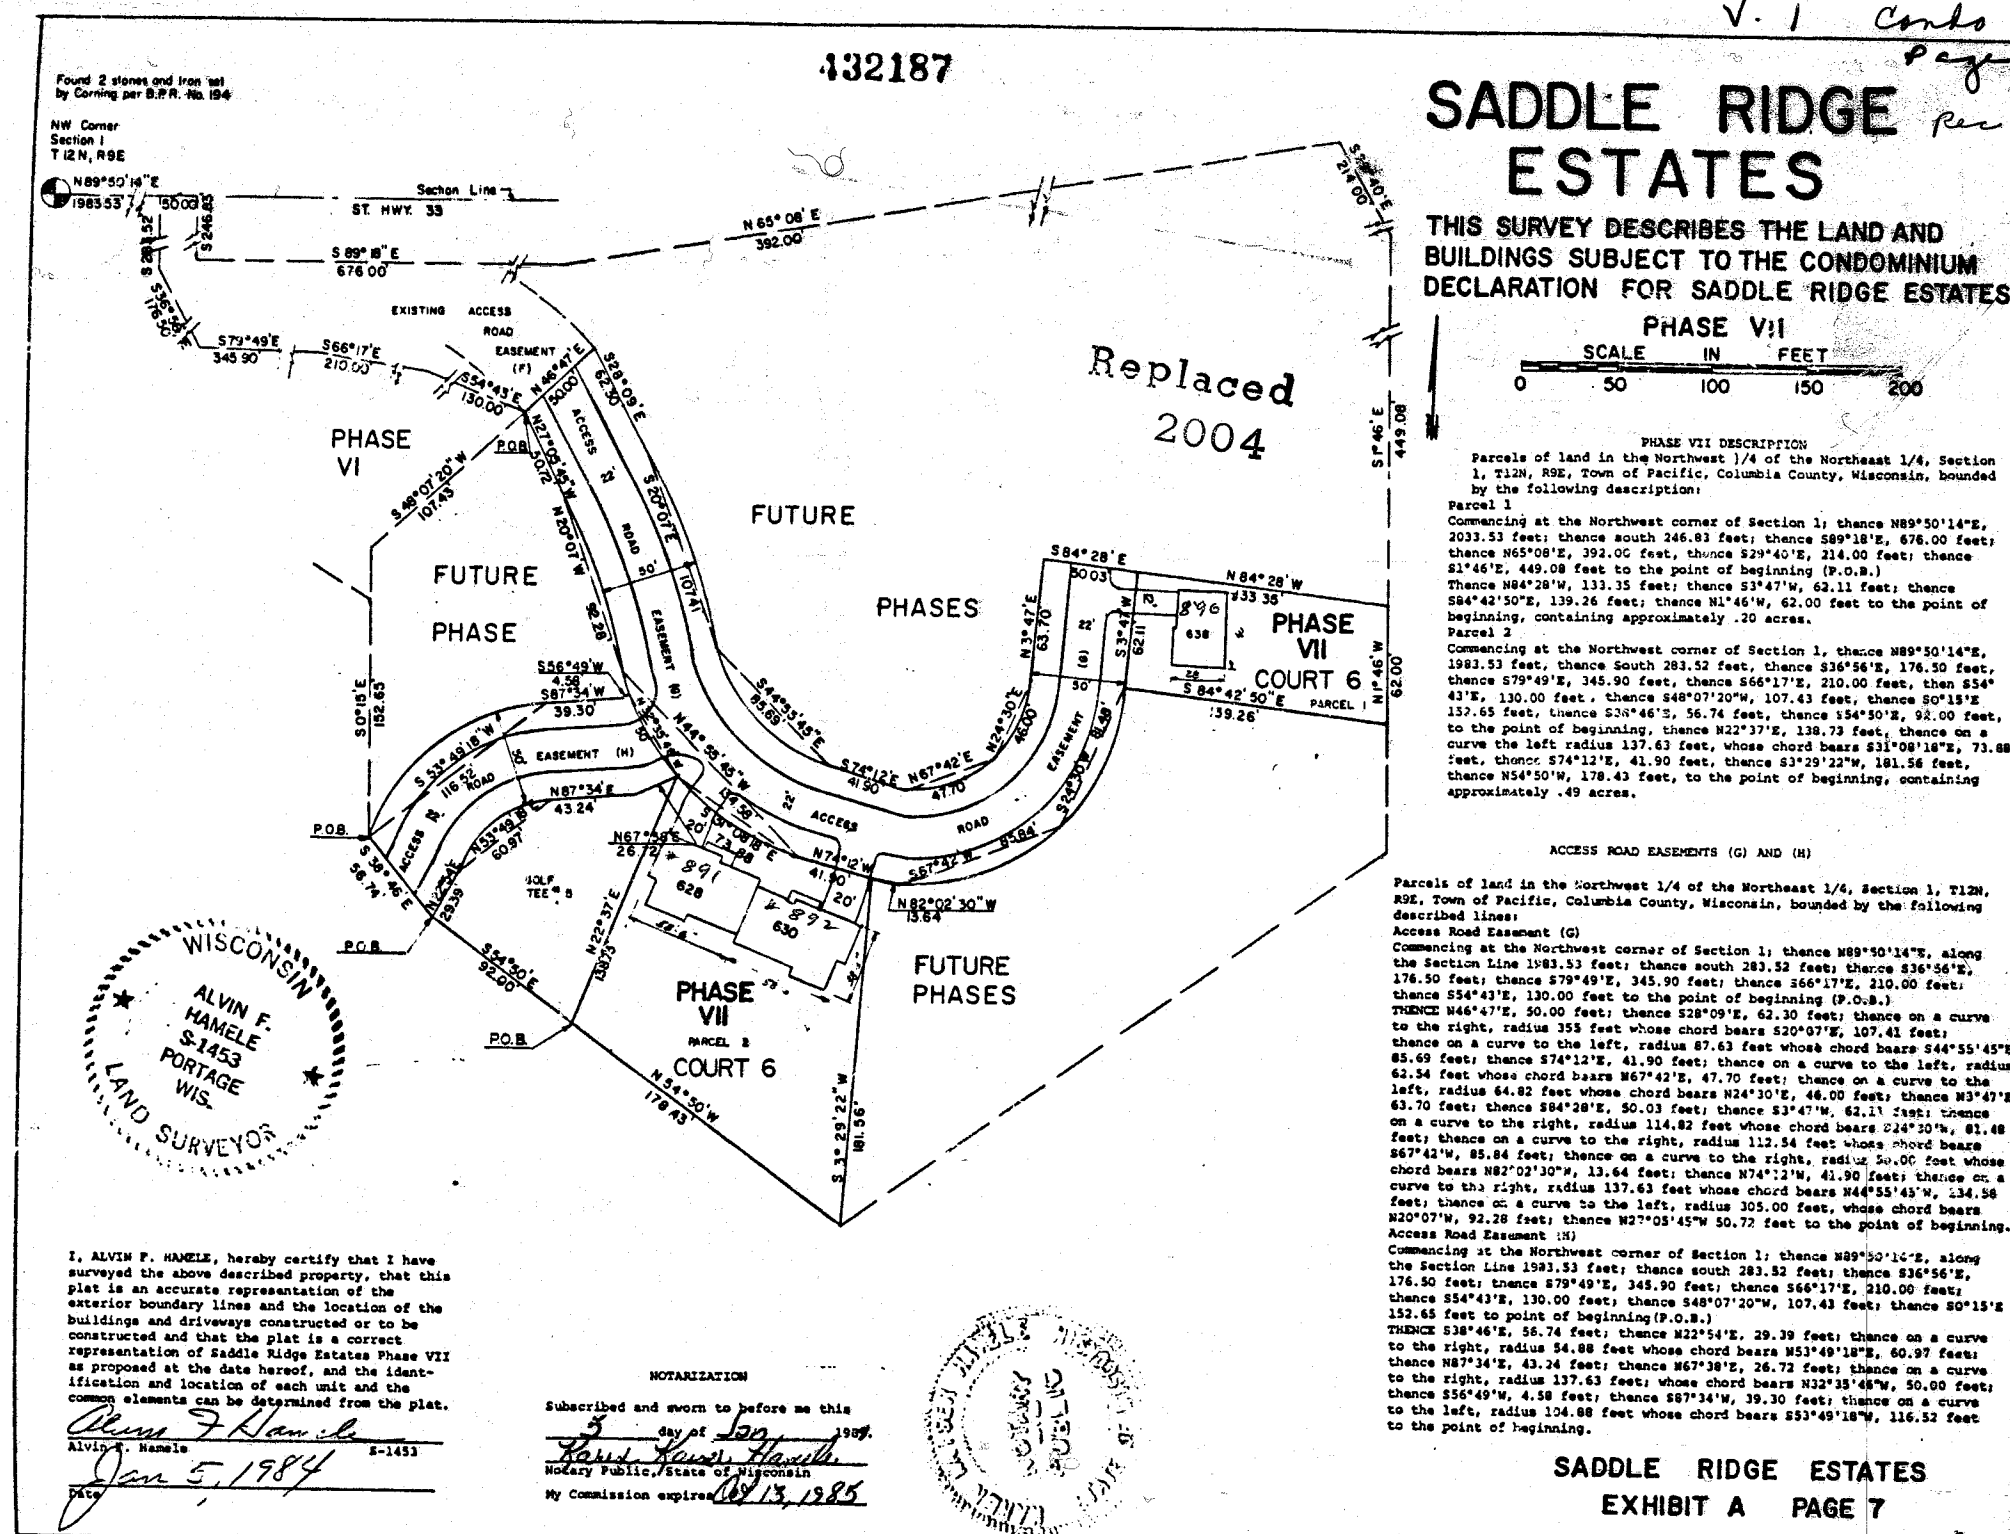

SADDL

An agreement has been signed by Kenneth Carlson and Carl Berst to exclude certain requirements of A-E, Wisconsin Administrative Code, namely setting monuments at the corners of the parcels described.

Curve	Radius	Central Angle	Chord Bearing	Chord Distance
A	114.82'	35°06'	N21°16'E	69.24'
D	104.88'	67°29'20"	N53°49'18"E	116.52'
E	305.00'	17°24'	N20°07'W	92.28'
F	137.63'	7°44'15"	N19°31'42"W	18.57'
G	91.21'	84°30'	N0°15'W	122.65'

Line: Recorded as:
 3 4.58'
 4 N38°46'W, 56.74'

SADDLE RIDGE ESTATES COLUMBIA COUNTY

THIS SURVEY DESCRIBES THE LAND AND BUILDINGS SUBJECT TO THE CONDOMINIUM DECLARATION FOR SADDLE RIDGE ESTATES

AMENDED PHASE VIII

STATE OF WISCONSIN } SS
 COLUMBIA COUNTY
 RECEIVED FOR RECORD

NOV 21 1991

Donny Judd
 Reg. of Deeds at 4:15 PM

SCALE IN FEET
 0 25 50 100 150

PHASE VIII DESCRIPTION

Parcels of land in the NW1/4-NEL/4 and NE1/4-NW1/4, Section 1, T12N, R9E, Town of Pacific, Columbia County, Wisconsin bounded by the following described lines:

Parcel 1:
 Beginning at the southeast corner of Phase VI, Parcel 2; thence N0°15'W along the east line of said Phase VI, Parcel 2, 30.00 feet; thence N48°07'20"E along said east line of Phase VI, Parcel 2, 107.43 feet; thence S27°05'45"E, 50.72 feet; thence on a curve to the right, radius 305.00 feet, whose chord bears S20°07'E, 92.28 feet; thence on a curve to the left, radius 137.63 feet, whose chord bears S19°31'42"E, 18.57 feet; thence S56°49'W, 8.43 feet; thence S87°34'W, 39.30 feet; thence on a curve to the left, radius 104.88 feet, whose chord bears S53°49'18"W, 116.52 feet; thence on a curve to the left, radius 91.21 feet, whose chord bears N0°15'W, 122.65 feet to the point of beginning. Containing 17,660 square feet or 0.40 acres.

Parcel 2:
 Beginning at the southeast corner of Phase VII, Parcel 1; thence S1°46'E, 63.92 feet; thence S53°35'W, 100.00 feet; thence N50°00'W, 111.33 feet; thence on a curve to the left, radius 114.82 feet, whose chord bears N21°16'E, 69.24 feet to the southwest corner of said Phase VII, Parcel 1; thence S84°42'50"E, 132.26 feet to the point of beginning. Containing 15,080 square feet or 0.35 acres.

I, Kenneth G. Carlson, registered land surveyor, hereby certify that I have surveyed the above described parcels, that this plat is a correct representation of the exterior boundaries of the parcels described and the location of the buildings and driveways constructed or to be constructed as proposed at the date hereof and the identification and location of each unit and the common elements can be determined.

CONDOMINIUM PLAT
 Saddle Ridge Estates
 Amended Phase VIII
 Page 1 of 4 pages.

EXHIBIT A PAGE 8

Vol 1 - Page 186

REF. Vol 1 - P 115

Vol 1 - P 186

Recorded
V.I

Replaced
2004

Restrictions
R 281-73

COLUMBIA COUNTY
COLUMBIA COUNTY

PHASE IX

T. Pacific
off 2. A
new 899
900


SCALE IN FEET

0 25 50 100 150

Commencing at the northeast corner of Parcel 1, Phase VII Saddle Ridge Estates Condominium; thence N84°28'W along the north line of said Parcel 1, 132.97 feet to the point of beginning; thence N84°28'W, 50.41 feet; thence N1°46'W, 174.62 feet; thence S89°30'E, 50.04 feet; thence S1°46'E, 179.04 feet to the point of beginning.

EXHIBIT A PA

FUTURE PHASES

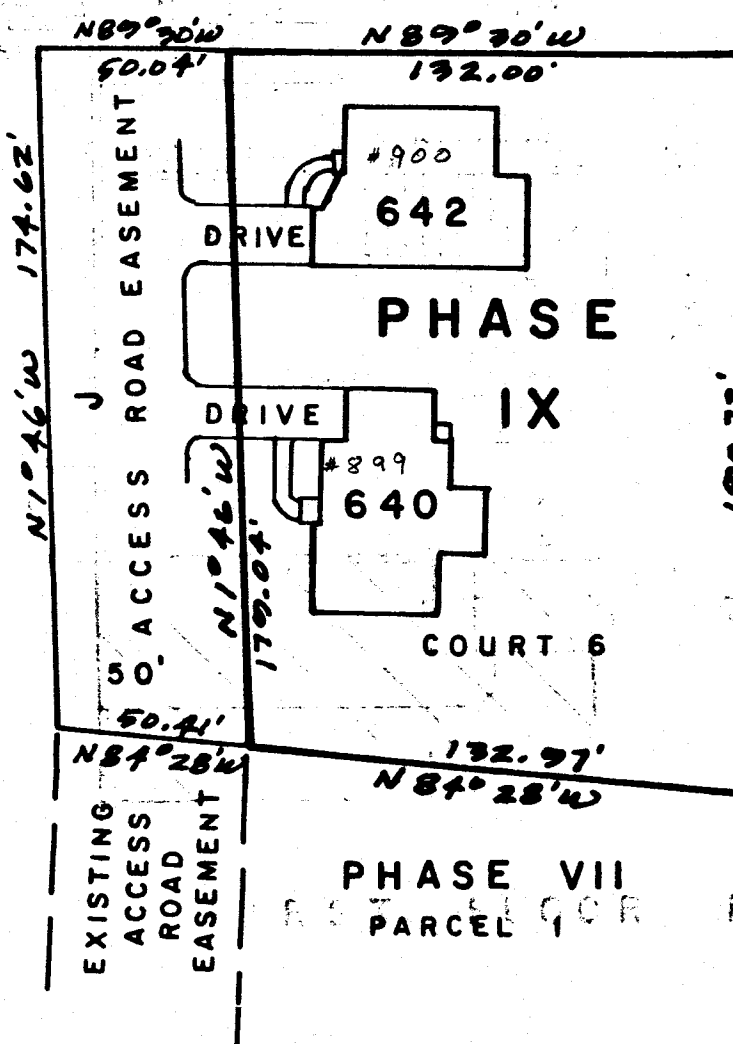

0 = Found 3/4" round iron rod.

I, Kenneth G. Carlson, registered land surveyor, hereby certify that I have surveyed the above described parcels, that the plat is a correct representation of the exterior boundaries of the parcels described and the location of the buildings and structures thereon or to be constructed as proposed at the date hereof, that the identification and location of each unit and the common areas can be determined from the plat.

1986 Assmt Roll

3RE
P9


Double Rings either
Jewelry or Perfume

Phase IX cont'd
1986 cont'd R 02 001036
Dec. 1-12-9

Saddle Ridge Estates
Town of Pacific

Phase X Court 6
1986 Assesment Roll
Sec 1-12-9

An agreement has been signed by Kenneth Carlson and Carl Berst to exclude certain requirements of A-E 5, Wisconsin Administrative Code, namely setting monuments at the corners of the parcel described.

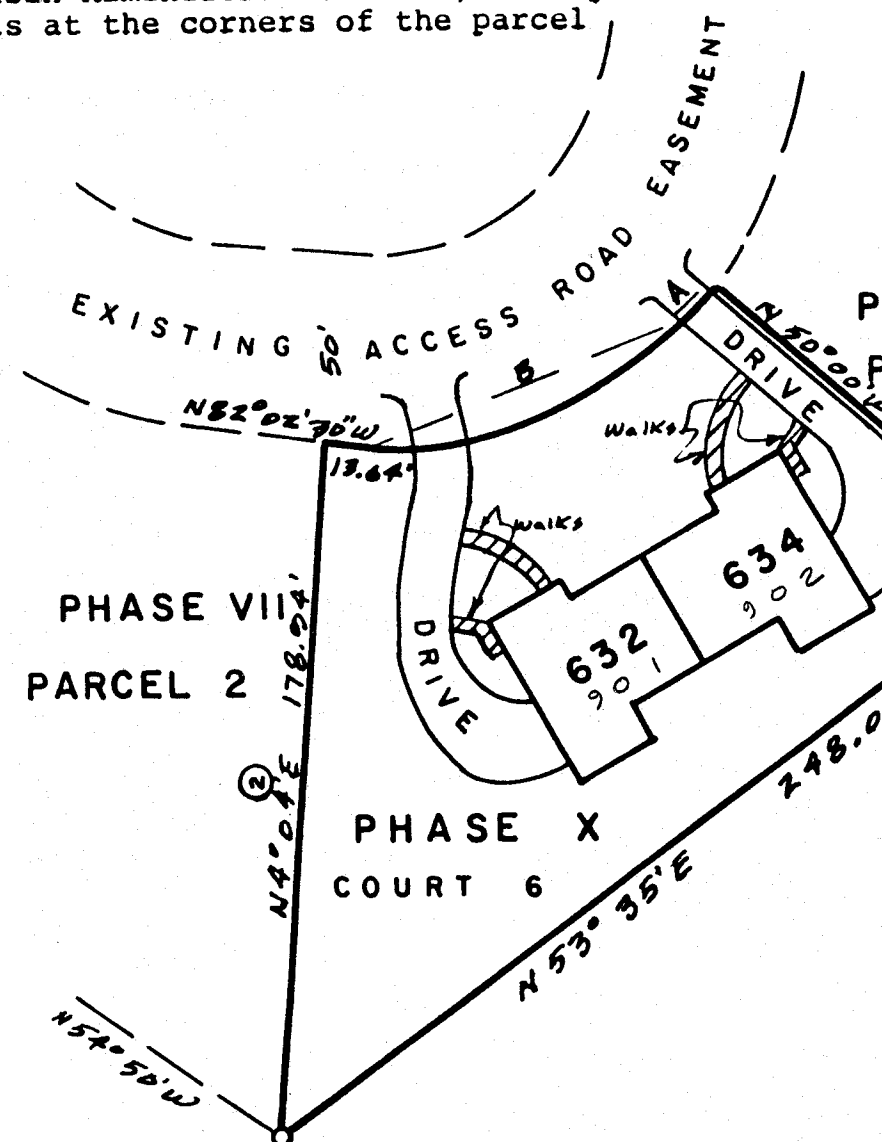

AMENDMENT TO CONDOMINIUM PLAT OF
SADDLE RIDGE ESTATES
COLUMBIA COUNTY

THIS SURVEY DESCRIBES THE LAND AND
BUILDINGS SUBJECT TO THE CONDOMINIUM
DECLARATION FOR SADDLE RIDGE ESTATES

PHASE X



r. Pacific
Pt 2-A - Unit 632
new 901 - Unit 634
new 902 - Unit 634

Restrictions R285-58

PHASE X DESCRIPTION


A parcel of land located in the NW1/4-NE1/4, Section 1, T12N, R9E, Town of Pacific, Columbia County, Wisconsin bounded by the following described line: Beginning at the southeast corner of Phase VII, Parcel 2; thence N4°04'E, 178.94 feet; thence S82°02'30"E, 13.64 feet; thence easterly on a curve to the left, radius 112.54 feet, whose chord bears N67°42'E, 85.84 feet; thence easterly on a curve to the left, radius 114.82 feet, whose chord bears N42°03'E, 12.95 feet; thence S50°00'E, 111.33 feet; thence S53°35'W, 248.00 feet to the point of beginning. Said parcel contains 21,130 square feet or 0.48 acres.

Curve	Radius	Central Angle	Chord Bearing	Chord Distance
A	114.82'	6°28'	N42°03'E	12.95'
B	112.54'	44°50'	N67°42'E	85.84'

Bearings are referenced to Phases VII and VI of Saddle Ridge Estates.

O = Found 3/4" round iron rod.

Line ② recorded as N3°29'22"E, 181.56'.

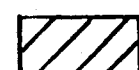 = Limited Common Area

I, Kenneth G. Carlson, registered land surveyor, hereby certify that I have surveyed the above described parcel, that this plat is a correct representation of the exterior boundaries of the parcel described and the location of the building and driveways constructed or to be constructed as proposed at the date hereof and the identification and location of each unit and the common elements can be determined.

Condominium Plat Phase X


PAGE 1 of 2 PAGES

FIRST FLOOR PLAN

1986 Assessment Roll

V.1 Court 6 P.125

NOTE: RIGHT UNIT IS BLANK
MIRROR IMAGE OF LEFT UNIT (1)

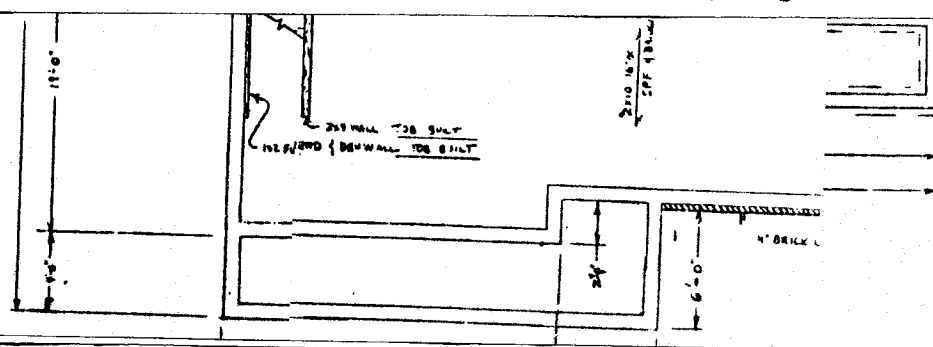


Amendment to Condominium Plat of
Saddle Ridge Estates
Town of Pacific

8.1-12-9
Prt NE NW + NW NE 1.95 A
Phase XI

910 - 914

452316
452316

PAGE 132

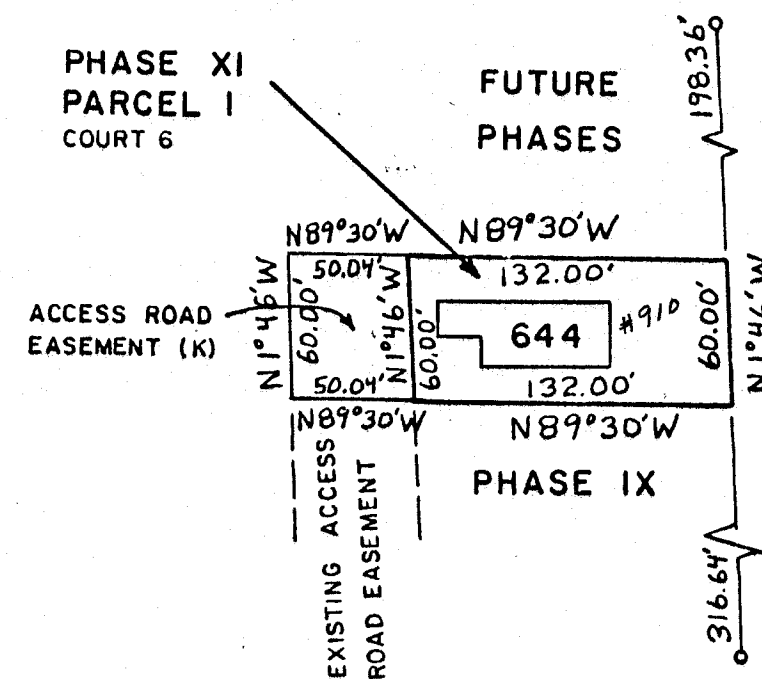


Graphic scale in feet:
0 25 50 100 150

Bearings are referenced to
Saddle Ridge Estates
Condominium.

o = Found 3/4" round iron rod


I, Kenneth G. Carlson, registered land surveyor, hereby certify that I have surveyed the above described parcel, that this plat is a correct representation of the exterior boundaries of the parcel described and the location of the building and driveways constructed or to be constructed as proposed at the date hereof and the identification and location of each unit and the common elements can be determined.

An agreement has been signed by Kenneth Carlson and Carl Berst to exclude certain requirements of A-E 5, Wisconsin Administrative Code, namely setting monuments at the corners of the parcel described.

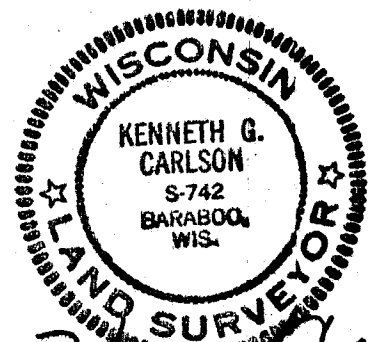

Replaced
2004
Sept 20, 1986

Graphic scale in feet:
0 25 50 100 150

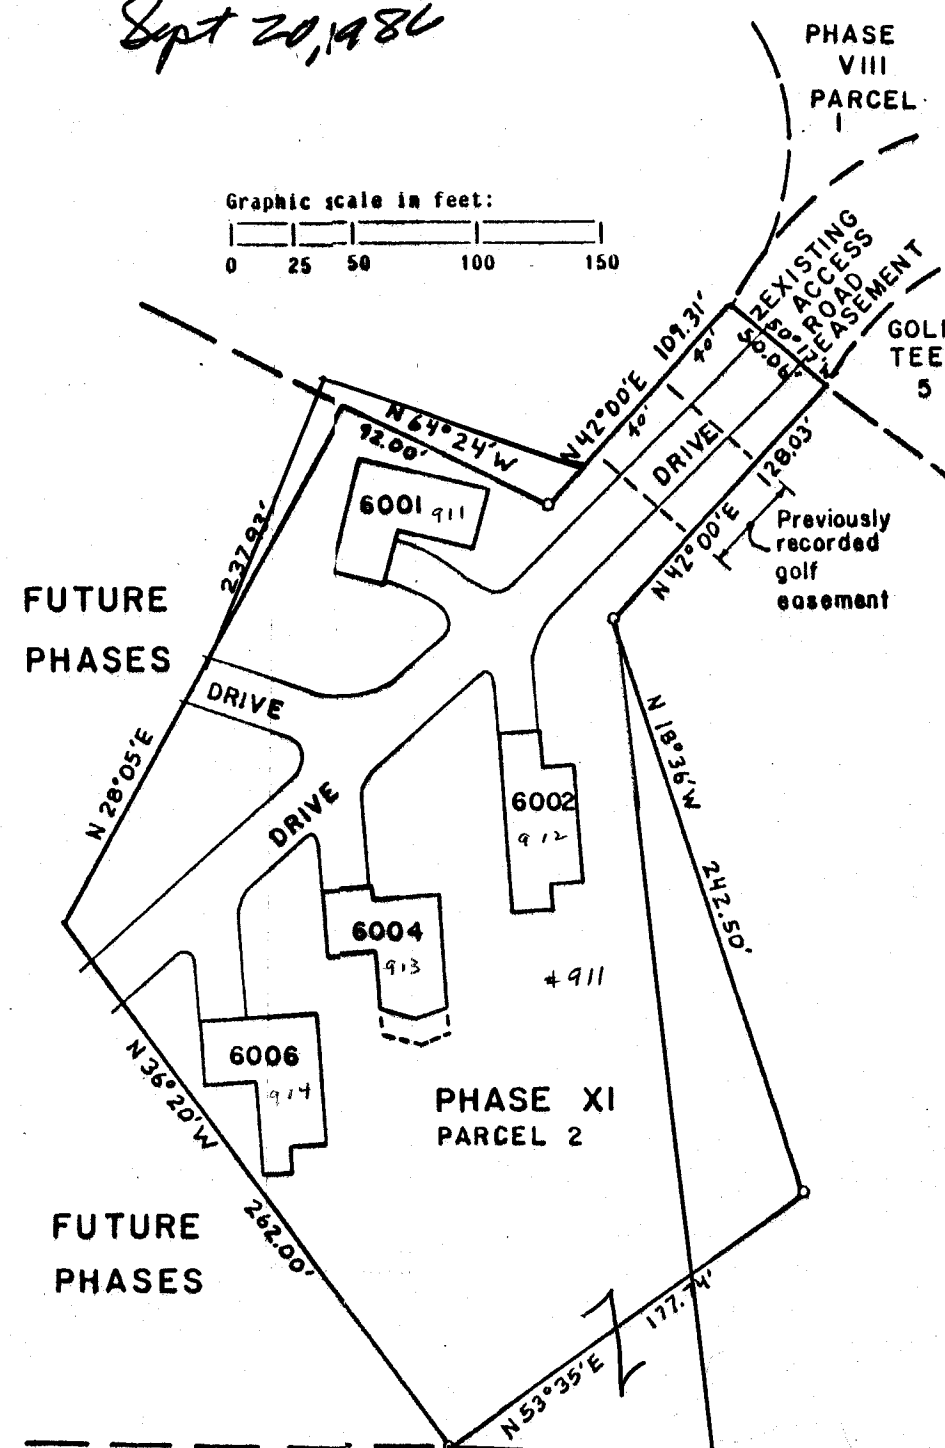

AMENDMENT TO CONDOMINIUM PLAT SADDLE RIDGE EST COLUMBIA COUNTY

THIS SURVEY DESCRIBES THE LAND
BUILDINGS SUBJECT TO THE CONDO
DECLARATION FOR SADDLE RIDGE E

PHASE XI SEE AMEND PH XI FILED 1-150

PHASE XI PARCEL 1 Description:

A parcel of land located in NW 1/4-NE 1/4, Section 1, T12N, R9E, Town of Pacific, Columbia County, Wisconsin bounded by the following line: Beginning at the northeast corner of Phase IX Saddle Ridge Condominium; thence N89°30'W, 132.00 feet; thence N1°46'W, 60.00 feet; thence S89°30'E, 132.00 feet; thence S1°46'E, 60.00 feet to the point of beginning. Said parcel contains 7,910 square feet or 0.182

PHASE XI ACCESS ROAD EASEMENT (K) Description:

A parcel of land located in NW 1/4-NE 1/4, Section 1, T12N, R9E, Town of Pacific, Columbia County, Wisconsin bounded by the following line: Beginning at the northwest corner of PHASE IX, Saddle Ridge Estates Condominium; thence N89°30'W, 50.04 feet; thence N1°46'W, 60.00 feet; thence S89°30'E, 50.04 feet; thence S1°46'E, 60.00 feet to the point of beginning.

PHASE XI PARCEL 2 Description:

A parcel of land located in NE 1/4-NW 1/4 and NW 1/4-NE 1/4, Section 1, T12N, R9E, Town of Pacific, Columbia County, Wisconsin bounded by the following described line: Beginning at the most southerly corner of Parcel 1, PHASE VIII, Saddle Ridge Estates Condominium; thence S50°17'E, 50.06 feet; thence S42°00'W, 128.03 feet; thence S18°24'25'W, 177.74 feet; thence N36°20'W, 262 feet; thence N28°05'E, 237.93 feet; thence S64°24'E, 92.00 feet; thence N42°00'E, 109.31 feet to the point of beginning. Said parcel contains 77,030 square feet or 1.768 acres.

452316
STATE OF WISCONSIN
COLUMBIA COUNTY

Received for record the... 22...
Day of... September... A.D. 1986.
at 8:00 o'clock A.M., and recorded
in Vol. ... of Records Page 132.

Marian Robinson


Register of Deeds

Con
PAGI

SADDLE RIDGE ESTATES
TN OF PACIFIC
AMENDED PHASE II

Replaced
2004

458784

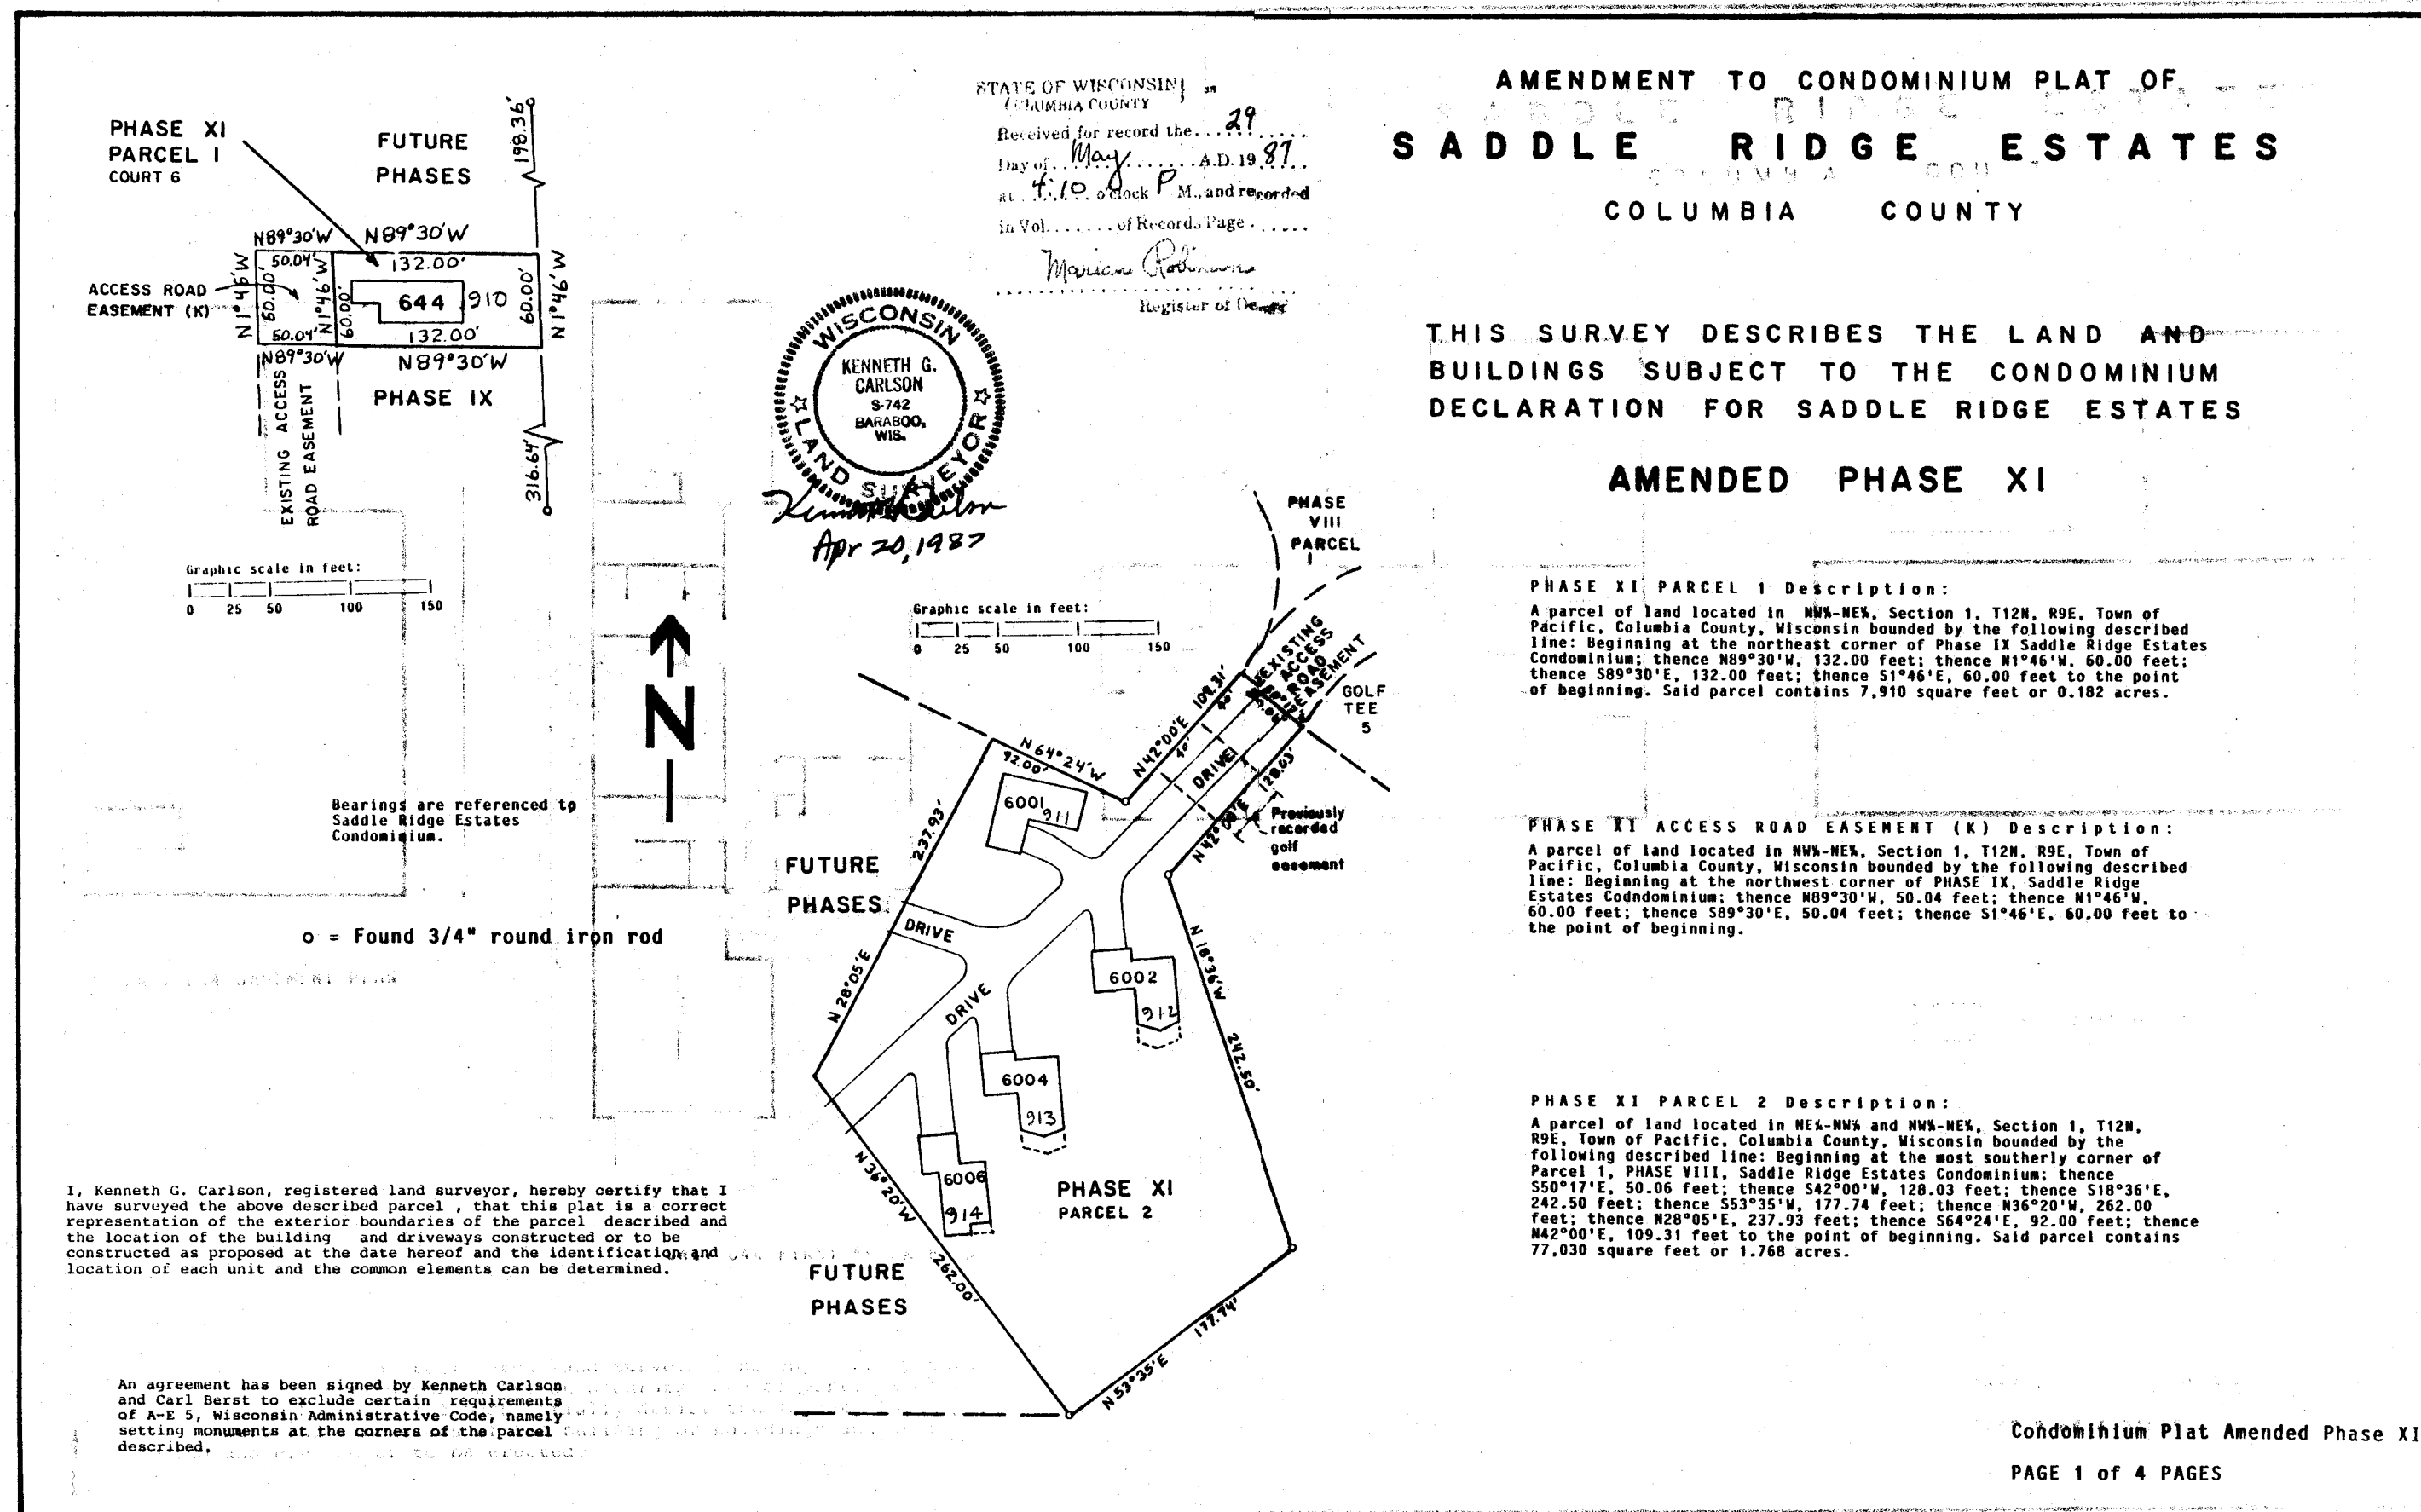

Pl 1 - 0.233 # 929-930
Pl 2 - 0.188 # 931-932
Pl 3 - 0.361 # 933
0.782 AC.

Saddle Ridge Estates Amendment Condo Plat
Phase XII
Part new NE + NE NW Sec. 1-12-9

1987 Assessment Roll
Rec 12-26-86
Y.I Condo P.140

Condo V.I P.140

Covenants
R310-771
in map file

Replaced
Re-recorded
2004


454841

Bearings are referenced to
Saddle Ridge Estates Condominium.

STATE OF WISCONSIN
COLUMBIA COUNTY
Received for record the...
Day of...
at...
in Vol...
Marian Robinson
Register of Deeds


AMENDMENT TO CONDOMINIUM PLAT OF
SADDLE RIDGE ESTATES
COLUMBIA COUNTY
PHASE XII

THIS SURVEY DESCRIBES THE LAND AND
BUILDINGS SUBJECT TO THE CONDOMINIUM
DECLARATION FOR SADDLE RIDGE ESTATES

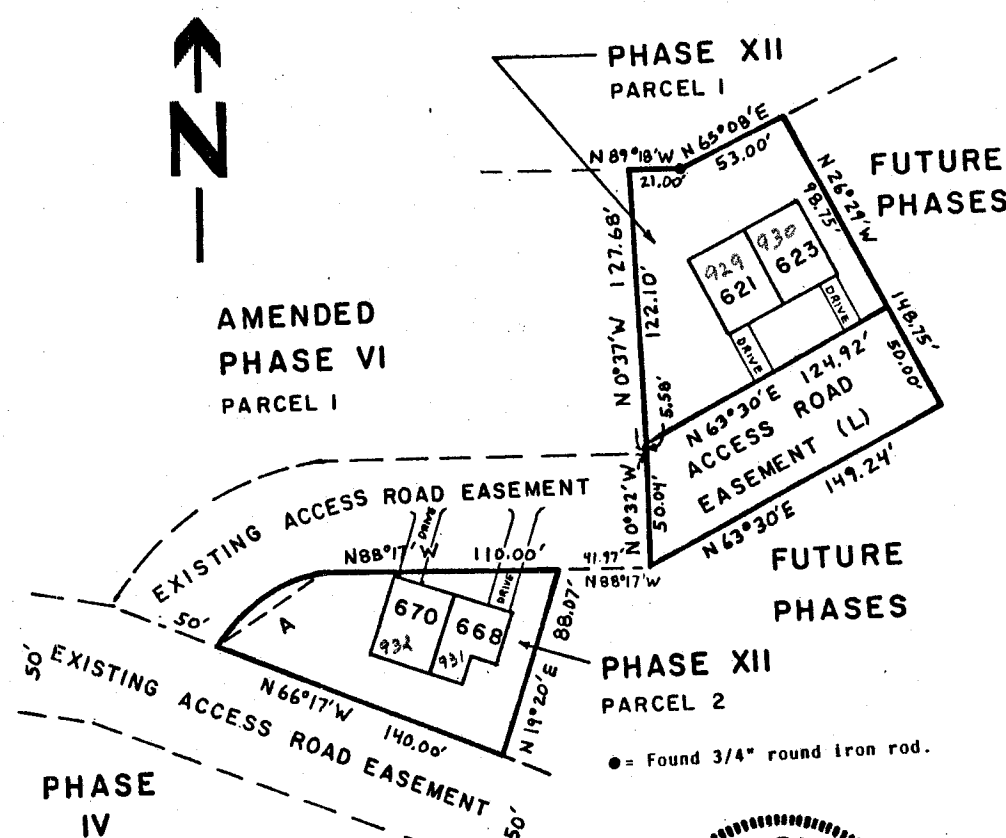

Graphic scale in feet:
0 25 50 100 150

Bearings are referenced to
Saddle Ridge Estates Condominium.

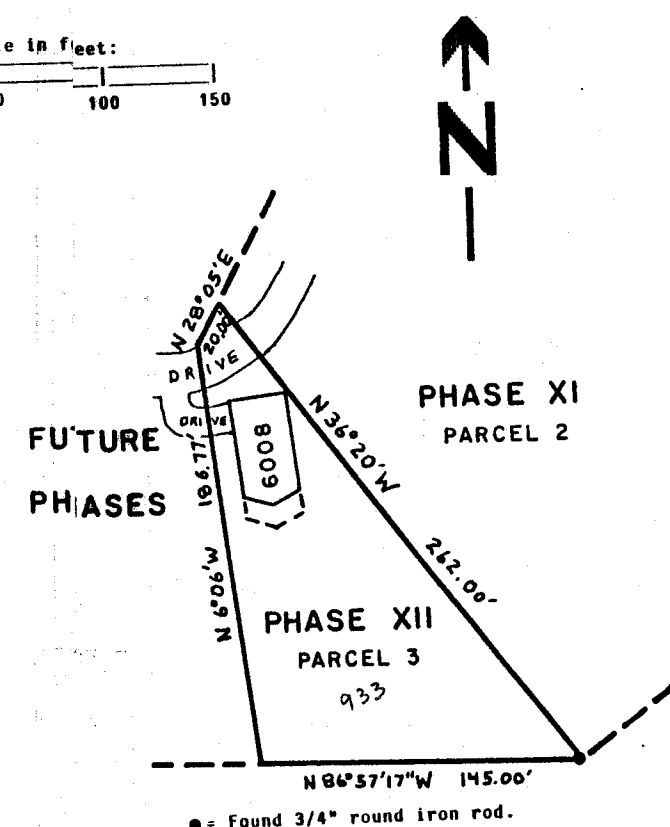

PHASE XII PARCEL 1 Description:
A parcel of land located in NW1/4-NE1/4, Section 1, T12N, R9E, Town of
Pacific, Columbia County, Wisconsin bounded by the following
described line: Beginning at the northeast corner of AMENDED PHASE VI,
Parcel 1, Saddle Ridge Estates Condominium; thence S89°18'E, 21.00
feet; thence N65°08'E, 53.00 feet; thence S26°29'E, 98.75 feet; thence
S63°30'W, 124.92 feet; thence N0°37'W, 122.10 feet to point of
beginning. Said parcel contains 10,160 square feet or 0.233 acres.

PHASE XII PARCEL 2 Description:
A parcel of land located in NW1/4-NE1/4, Section 1, T12N, R9E, Town of
Pacific, Columbia County, Wisconsin bounded by the following
described line: Beginning at the southeast corner of AMENDED PHASE VI,
Parcel 1, Saddle Ridge Estates Condominium; thence
S0°32'E, 50.04 feet; thence N80°17'W, 41.97 feet to point of
beginning; thence S19°20'W, 88.07 feet; thence N66°17'W, 140.00
feet; thence N57°34'30"E, 56.12 feet; thence S80°17'E,
whose chord bears N57°34'30"E, 56.12 feet; thence S80°17'E,
110.00 feet to point of beginning. Said parcel contains 8,210 square
feet or 0.188 acres.

PHASE XII PARCEL 3 Description:
A parcel of land located in NW1/4-NE1/4, Section 1, T12N, R9E, Town of
Pacific, Columbia County, Wisconsin bounded by the following described
line: Beginning at the most southerly corner of PHASE XI, Parcel 2,
Saddle Ridge Estates Condominium; thence N86°57'17"W, 145.00 feet;
thence N6°06'W, 186.77 feet; thence N28°05'E, 20.00 feet; thence
S36°20'E, 262.00 feet to point of beginning. Said parcel contains
15,730 square feet or 0.361 acres.

PHASE XII ACCESS ROAD EASEMENT (L) Description:
A parcel of land located in NW1/4-NE1/4, Section 1, T12N, R9E, Town of
Pacific, Columbia County, Wisconsin bounded by the following described
line: Beginning at the southeast corner of AMENDED PHASE VI, Parcel 1,
Saddle Ridge Estates Condominium; thence N0°37'W, 5.58 feet; thence
N63°30'E, 124.92 feet; thence S26°29'E, 50.00 feet; thence S63°30'W,
149.24 feet; thence N0°32'W, 50.04 feet to point of beginning.
Said parcel contains 6,850 square feet or 0.157 acres.

CURVE	DELTA	RADIUS	ARC	CHORD
A	68°16'30"	50.00'	59°38'	N57°34'30"E, 56.12'

Condominium Phase XII
PAGE 1 of 2 PAGES

I, Kenneth G. Carlson, registered land surveyor, hereby certify that I
have surveyed the above described parcel, that this plat is a correct
representation of the exterior boundaries of the parcel described and
the location of the building and driveways constructed or to be
constructed as proposed at the date hereof and the identification and
location of each unit and the common elements can be determined.

An agreement has been signed by Kenneth Carlson
and Carl Berst to exclude certain requirements
of A-E 5, Wisconsin Administrative Code, namely
setting monuments at the corners of the parcels
described.

I,
th
pl
un
lo

PAGE 2 OF 2 PAGES

V.I P.141

001 WE 141

SADDLE RIDGE ESTATES
TND PACIFIC
SEC 1-12N-9E

V1-154
Rec 8-27-87


Replaced
2004

460968


AMENDMENT TO CONDOMINIUM PLAT OF
SADDLE RIDGE ESTATES
COLUMBIA COUNTY

THIS SURVEY DESCRIBES THE LAND AND
BUILDINGS SUBJECT TO THE CONDOMINIUM
DECLARATION FOR SADDLE RIDGE ESTATES

PHASE XIII

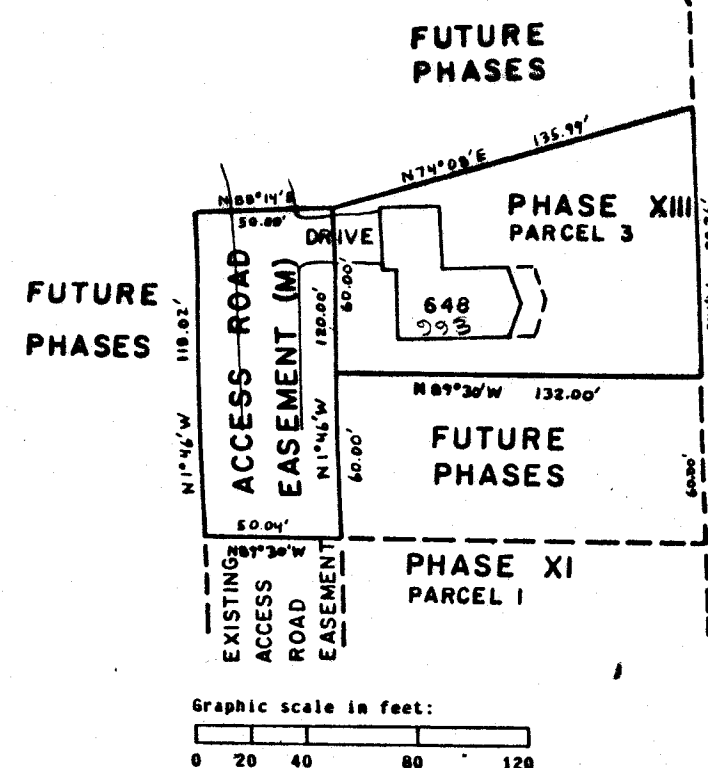

Bearings are referenced to
Saddle Ridge Estates Condominium.

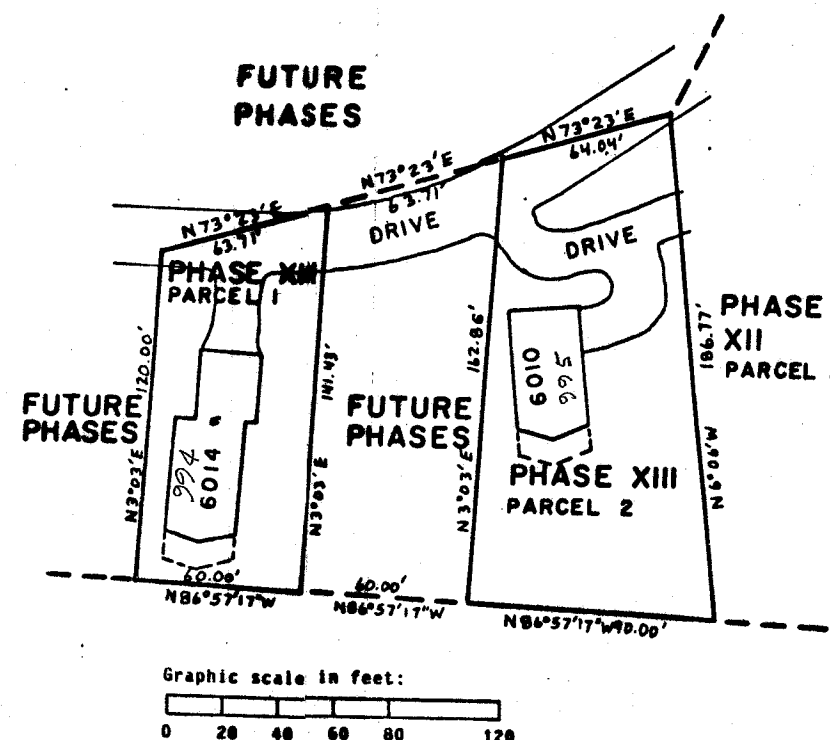


PHASE XIII PARCEL 1 Description:
A parcel of land located in the NW-NE, Section 1, T12N, R9E,
Town of Pacific, Columbia County, Wisconsin bounded by the
following described line: Commencing at the southwest corner
of PHASE XII, Parcel 3, Saddle Ridge Estates Condominium;
thence N89°30'W, 150.00 feet to point of beginning; thence
continuing N89°30'W, 60.00 feet; thence N3°03'E, 120.00 feet;
thence N73°23'E, 63.71 feet; thence S3°03'W, 141.43 feet to
the point of beginning. Said parcel contains 7,840 square
feet or 0.180 acres.

PHASE XIII PARCEL 2 Description:
A parcel of land located in the NW-NE, Section 1, T12N, R9E,
Town of Pacific, Columbia County, Wisconsin bounded by the
following described line: Beginning at the southwest corner
of PHASE XII, Parcel 3, Saddle Ridge Estates Condominium;
thence N89°30'W, 90.00 feet; thence N3°03'E, 162.00 feet;
thence N73°23'E, 64.04 feet thence S6°06'E, 186.77 feet to
point of beginning. Said parcel contains 13,210 square
feet or 0.303 acres.

PHASE XIII PARCEL 3 Description:
A parcel of land located in the NW-NE, Section 1, T12N, R9E,
Town of Pacific, Columbia County, Wisconsin bounded by the
following described line: Commencing at the northwest corner
of PHASE XI, Parcel 1, Saddle Ridge Estates Condominium;
thence N1°46'W, 60.00 feet to point of beginning; thence
continuing N1°46'W, 60.00 feet; thence N74°08'E, 135.99 feet;
thence S1°46'E, 98.36 feet; thence N89°30'W, 132.00 feet to
point of beginning. Said parcel contains 10,440 square feet
or 0.240 acres.

ACCESS ROAD EASEMENT (M) Description:
A parcel of land located in the NW-NE, Section 1, T12N, R9E,
Town of Pacific, Columbia County, Wisconsin bounded by the
following described line: Beginning at the northwest corner
of PHASE XI, Parcel 1, Saddle Ridge Estates Condominium;
thence N89°30'W, 50.04 feet; thence N1°46'W, 118.02 feet;
thence N88°14'E, 50.00 feet; thence S1°46'E, 120.00 feet to
point of beginning.

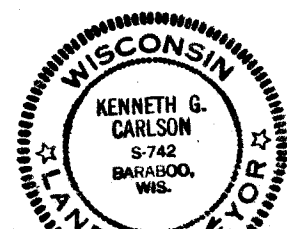

Aug 26, 1987

I, Kenneth G. Carlson, registered land surveyor, hereby certify that I
have surveyed the above described parcel, that this plat is a correct
representation of the exterior boundaries of the parcel described and
the location of the building and driveways constructed or to be
constructed as proposed at the date hereof and the identification and
location of each unit and the common elements can be determined.

An agreement has been signed by Kenneth Carlson
and Carl Hurst to exclude certain requirements
of A-E 5, Wisconsin Administrative Code, namely
setting monuments at the corners of the parcel
described.

CONDOMINIUM PLAT PHASE XIII
PAGE 1 OF 2 PAGES

V1-154

SADDLE RIDGE ESTATES
TN OF PACIFIC

NOG 1-158
REC 1-20-88

Replaced
2004

4641051

464051

AMENDMENT TO CONDOMINIUM PLAT OF
SADDLE RIDGE ESTATES
COLUMBIA COUNTY

THIS SURVEY DESCRIBES THE LAND AND
BUILDINGS SUBJECT TO THE CONDOMINIUM
DECLARATION FOR SADDLE RIDGE ESTATES


PHASE XIV

PHASE XIV Description:

A parcel of land located in MEK-MW, Section 1, T12N, R9E, Town of Pacific, Columbia County, Wisconsin bounded by the following described line: Beginning at the southwest corner of PHASE XIII, Parcel 1, Saddle Ridge Estates Condominium; thence N86°57'17"W, 70.00 feet; thence N3°03'E, 120.00 feet; thence S86°57'17"E, 70.00 feet; thence S3°03'W, 120.00 feet to point of beginning. Said parcel contains 8,400 square feet or 0.193 acres.


I, Kenneth G. Carlson, registered land surveyor, hereby certify that I have surveyed the above described parcels, that this plat is a correct representation of the exterior boundaries of the parcels described and the location of the buildings and driveways constructed or to be constructed as proposed at the date hereof and the identification and location of each unit and the common elements can be determined.

I, Kenneth G. Carlson, registered land surveyor, hereby certify that the drawings appearing hereon are an accurate copy of portions of the plans of each building and substantially depict the layout, location, unit numbers and dimensions of the building or buildings and units located and erected or to be erected.


 = Limited Common Area

An agreement has been signed by Kenneth Carlson and Carl Berst to exclude certain requirements of A-E 5 Wisconsin Administrative Code, namely setting monuments at the corners of the parcels described.


Condominium Plat
Saddle Ridge Estates
Phase XIV
Page 1 of 1 Page

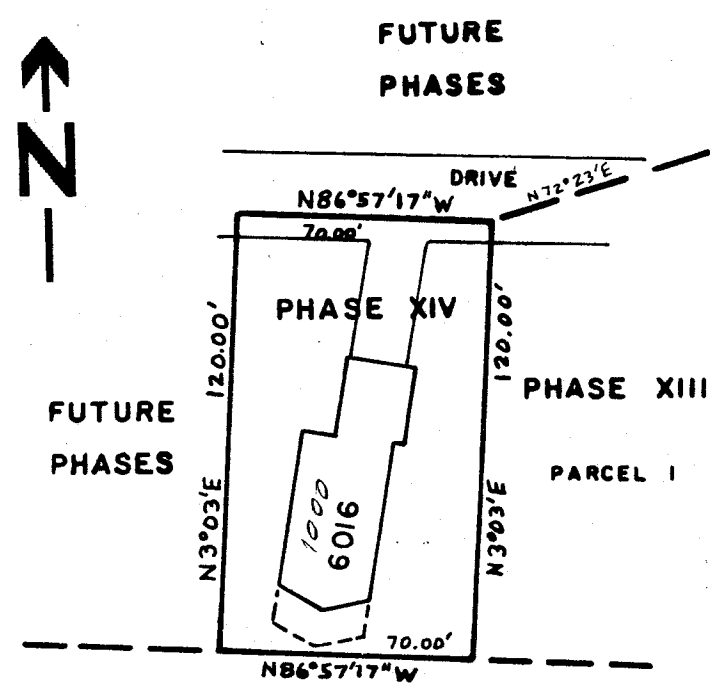

Graphic scale in feet:
0 20 40 60 80 120

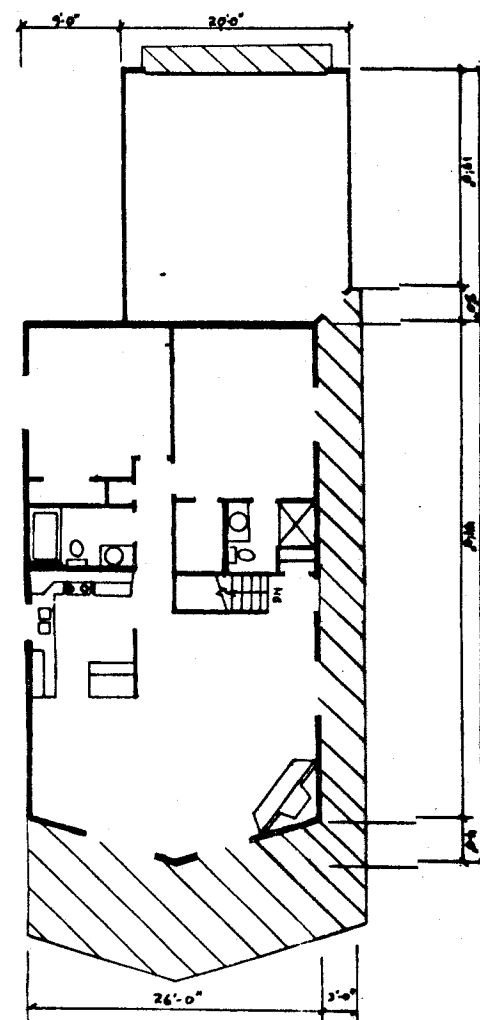

UNIT 6016
FIRST FLOOR PLAN

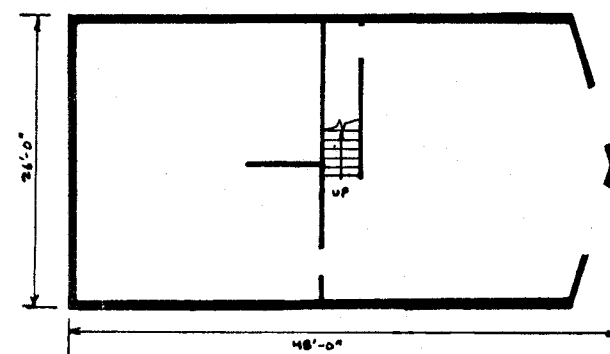

UNIT 6016
BASEMENT FLOOR PLAN

STATE OF WISCONSIN
COLUMBIA COUNTY
Received for record the...
Day of... A.D. 1987
at... o'clock... M., and recorded
in Vol. ... of Records Page...
Manian Robinson
Register of Deeds



SADDLE RIDGE ESTATES
SEC - 1 - T12N - R9E
TOWN OF PACIFIC
PHASE XV

VOL. 001 - P163
CONDOMINIUM PLATS
REC. 6-13-88
6028
1989 ASSESSMENT ROLL

Replaced
2004

466907

AMENDMENT TO CONDOMINIUM PLAT OF
SADDLE RIDGE ESTATES
COLUMBIA COUNTY

THIS SURVEY DESCRIBES THE LAND AND
BUILDINGS SUBJECT TO THE CONDOMINIUM
DECLARATION FOR SADDLE RIDGE ESTATES

PHASE XV

PHASE XV Description:

A parcel of land located in NEK-NW, Section 1, T12N, R9E, Town of Pacific, Columbia County, Wisconsin bounded by the following described line: Commencing at the southwest corner of PHASE XIV, Saddle Ridge Estates Condominium; thence N86°57'17"W, 60.00 feet to point of beginning; thence N86°57'17"W, 60.00 feet; thence N3°03'E, 120.00 feet; thence S86°57'17"E, 60.00 feet; thence S3°03'W, 120.00 feet to point of beginning. Said parcel contains 7,200 square feet or 0.165 acres.

I, Kenneth G. Carlson, registered land surveyor, hereby certify that I have surveyed the above described parcel, that this plat is a correct representation of the exterior boundaries of the parcel described and the location of the building and driveways constructed or to be constructed as proposed at the date hereof and the identification and location of each unit and the common elements can be determined.

An agreement has been signed by Kenneth Carlson and Carl Berst to exclude certain requirements of A-E 5, Wisconsin Administrative Code, namely setting monuments at the corners of the parcel described.

I, Kenneth G. Carlson, registered land surveyor, hereby certify that the drawings appearing hereon are an accurate copy of portions of the plans of each building and substantially depict the layout, location, unit numbers and dimensions of the building or buildings and units located and erected or to be erected.

STATE OF WISCONSIN
COLUMBIA COUNTY

Subscribed and sworn to before me this 19th day of June, A.D. 1988, at 11:00 AM.

Notary Public

My Comm. Expires 12/31/90

Notary Public


Saddle Ridge Estates

PHASE XV



Page 1 of 1 page

▨ = Limited Common Area


FUTURE PHASES

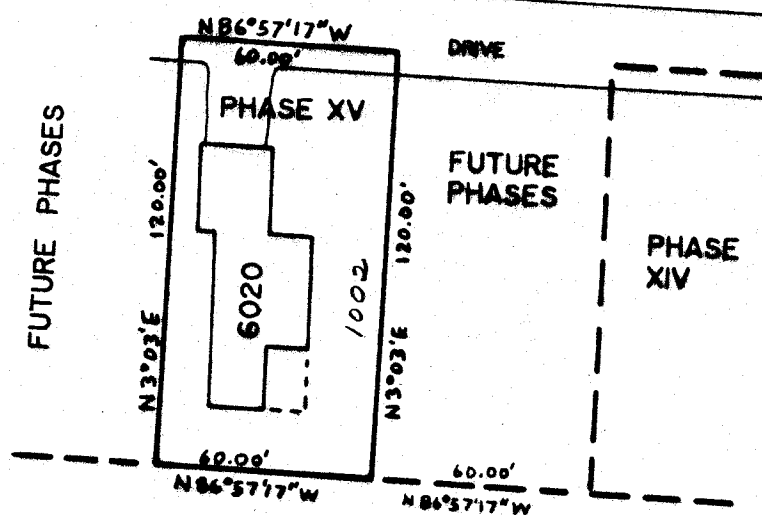

Graphic scale in feet:

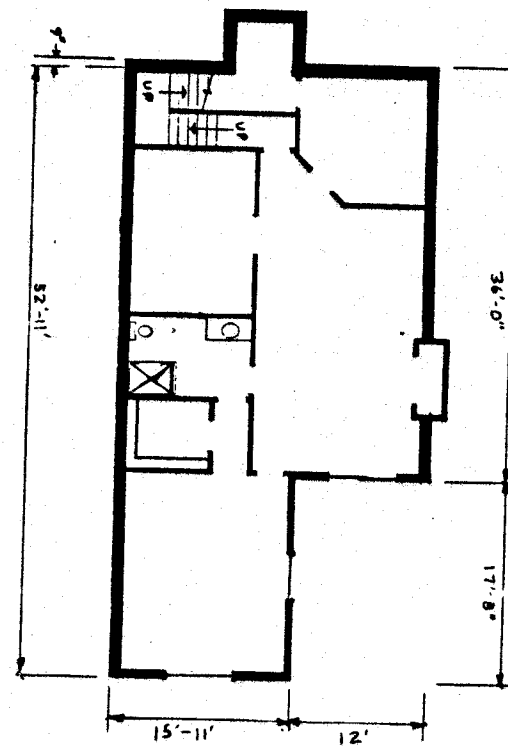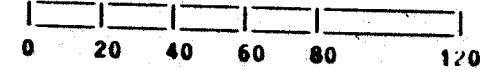

UNIT 6020
BASEMENT FLOOR PLAN

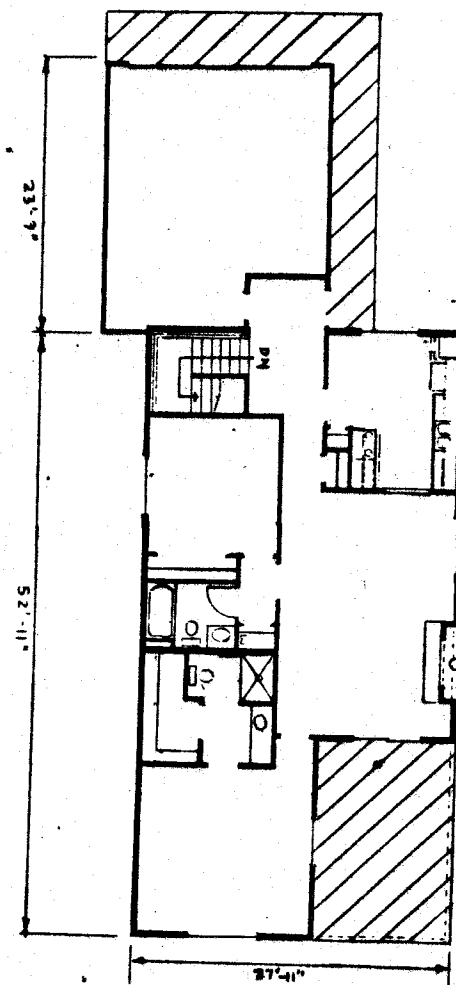

UNIT 6020
FIRST FLOOR PLAN

PLOTTED IN PARCEL 4
NE-NW-1-12-9

VOL 001 PAGE 163

SADDLE RIDGE ESTATES
SEC. 1, T12N-R9E
TOWN OF PACIFIC
PHASE XVI


VOL. 001 P. 166
CONDOMINIUM PLAT
REC. 15-88
#6022 & 6018
1988 ASSESSMENT ROLL

Replaced
2004

001 PAGE 166

468453

R/L
210

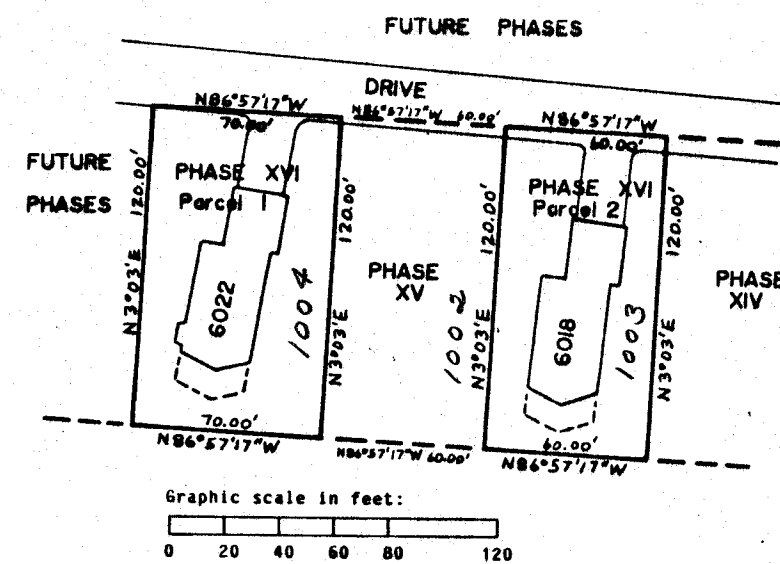

Kenneth G. Carlson
July 23, 1988

AMENDMENT TO CONDOMINIUM PLAT OF
SADDLE RIDGE ESTATES
COLUMBIA COUNTY

THIS SURVEY DESCRIBES THE LAND AND
BUILDINGS SUBJECT TO THE CONDOMINIUM
DECLARATION FOR SADDLE RIDGE ESTATES

PHASE XVI

HASE XVI Parcel 1 Description:

parcel of land located in the NE1/4-NE1/4, Section 1, T12N, R9E, Town of Pacific, Columbia County, Wisconsin bounded by the following described line: Beginning at the southwest corner of PHASE XV, SADDLE RIDGE ESTATES CONDOMINIUM; thence N86°57'17"W, 70.00 feet; thence S3°03'E, 120.00 feet; thence S86°57'17"E, 70.00 feet; thence S3°03'W, 20.00 feet to point of beginning. Said parcel contains 8400 square feet or 0.193 acres.

HASE XVI Parcel 2 Description:

parcel of land located in the NE1/4-NE1/4, Section 1, T12N, R9E, Town of Pacific, Columbia County, Wisconsin bounded by the following described line: Beginning at the southeast corner of PHASE XV, SADDLE RIDGE ESTATES CONDOMINIUM; thence N3°03'E, 120.00 feet; thence S86°57'17"E, 60.00 feet; thence S3°03'W, 120.00 feet; thence N86°57'17"W, 1.00 feet to point of beginning. Said parcel contains 7200 square feet or 0.165 acres.


I, Kenneth G. Carlson, registered land surveyor, hereby certify that I have surveyed the above described parcel, that this plat is a correct representation of the exterior boundaries of the parcel described and the location of the building and driveways constructed or to be constructed as proposed at the date hereof and the identification and location of each unit and the common elements can be determined.

An agreement has been signed by Kenneth Carlson and Carl Berst to exclude certain requirements of A-E 7, Wisconsin Administrative Code, namely setting monuments at the corners of the parcel described.


I, Kenneth G. Carlson, registered land surveyor, hereby certify that the drawings appearing hereon are an accurate copy of portions of the plans of each building and substantially depict the layout, location, unit numbers and dimensions of the building or buildings and units located and erected or to be erected.

 = Limited Common Area


Condominium Plat
Saddle Ridge Estates
PHASE XVI
Page 1 of 1 page

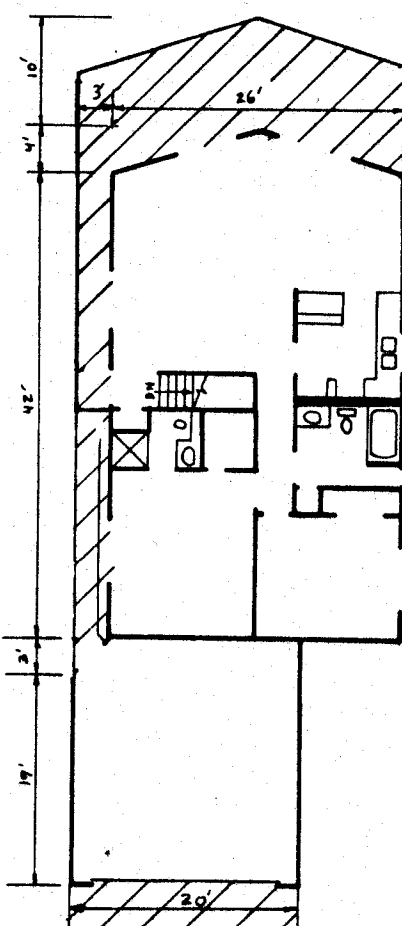

UNIT 6018
FIRST FLOOR PLAN

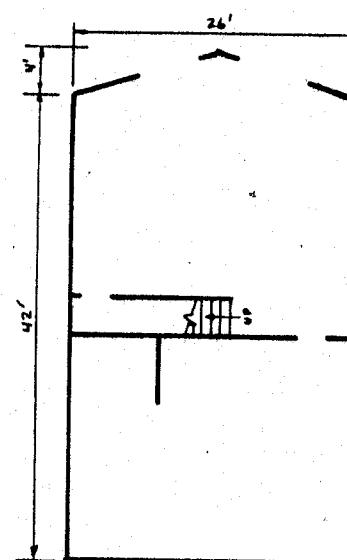

UNIT 6018 & 6022
BASEMENT FLOOR PLAN

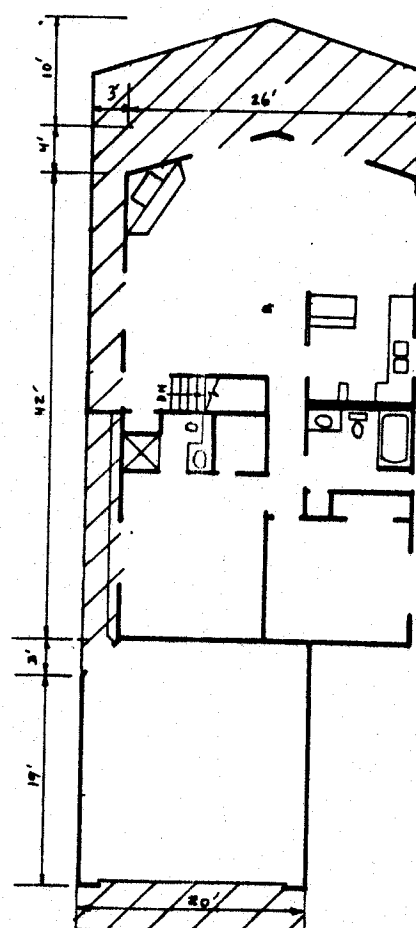

UNIT 6022
FIRST FLOOR PLAN

STATE OF WISCONSIN
COLUMBIA COUNTY
Received for record this 15th day of
Aug. A.D. 1988, at 10:45 AM.
Marian Robinson Reg. of Deeds

PLOTTED IN PARCEL 4
NE-NW-1-12-9

Replaced
2004

468775

AMENDMENT TO CONDOMINIUM PLAT OF
SADDLE RIDGE ESTATES
COLUMBIA COUNTY
PHASE XVII

THIS SURVEY DESCRIBES THE LAND AND
BUILDINGS SUBJECT TO THE CONDOMINIUM
DECLARATION FOR SADDLE RIDGE ESTATES

PHASE XVII Description:
A parcel of land located in NW1/4-NE1/4, Section 1, T12N, R9E, Town of Pacific, Columbia County, Wisconsin bounded by the following described line: Beginning at the northeast corner of PHASE XIII, PARCEL 3, Saddle Ridge Estates Condominium; thence S74°08'W, 135.99 feet; thence northwesterly on a curve to the left, radius 95.77 feet, whose chord bears N29°48'W, 90.02 feet; thence N63°01'E, 151.16 feet; thence S29°40'E, 80.00 feet; thence S1°46'E, 40.00 feet to point of beginning. Said parcel contains 14780 square feet or 0.339 acres.


ACCESS ROAD EASEMENT (N) Description:
A parcel of land located in NW1/4-NE1/4, Section 1, T12N, R9E, Town of Pacific, Columbia County, Wisconsin bounded by the following described line: Beginning at the northeast corner of PHASE XIII, PARCEL 3, Saddle Ridge Estates Condominium; thence S88°14'W, 50.00 feet; thence northwesterly on a curve to the left, radius 45.77 feet, whose chord bears N29°48'W, 43.02 feet; thence N32°10'E, 50.00 feet; thence southeasterly on a curve to the right, radius 95.77 feet, whose chord bears S29°48'E, 90.02 feet to point of beginning. Said parcel contains 3,460 square feet or 0.080 acres.

I, Kenneth G. Carlson, registered land surveyor, hereby certify that I have surveyed the above described parcel, that this plat is a correct representation of the exterior boundaries of the parcel described and the location of the building and driveways constructed or to be constructed as proposed at the date hereof and the identification and location of each unit and the common elements can be determined.

An agreement has been signed by Kenneth Carlson and Carl Berst to exclude certain requirements of A-E 7, Wisconsin Administrative Code, namely setting monuments at the corners of the parcel described.


I, Kenneth G. Carlson, registered land surveyor, hereby certify that the drawings appearing hereon are an accurate copy of portions of the plans of each building and substantially depict the layout, location, unit numbers and dimensions of the building or buildings and units located and erected or to be erected.

Condominium Plat
Saddle Ridge Estates
PHASE XVII
Page 1 of 1 Page


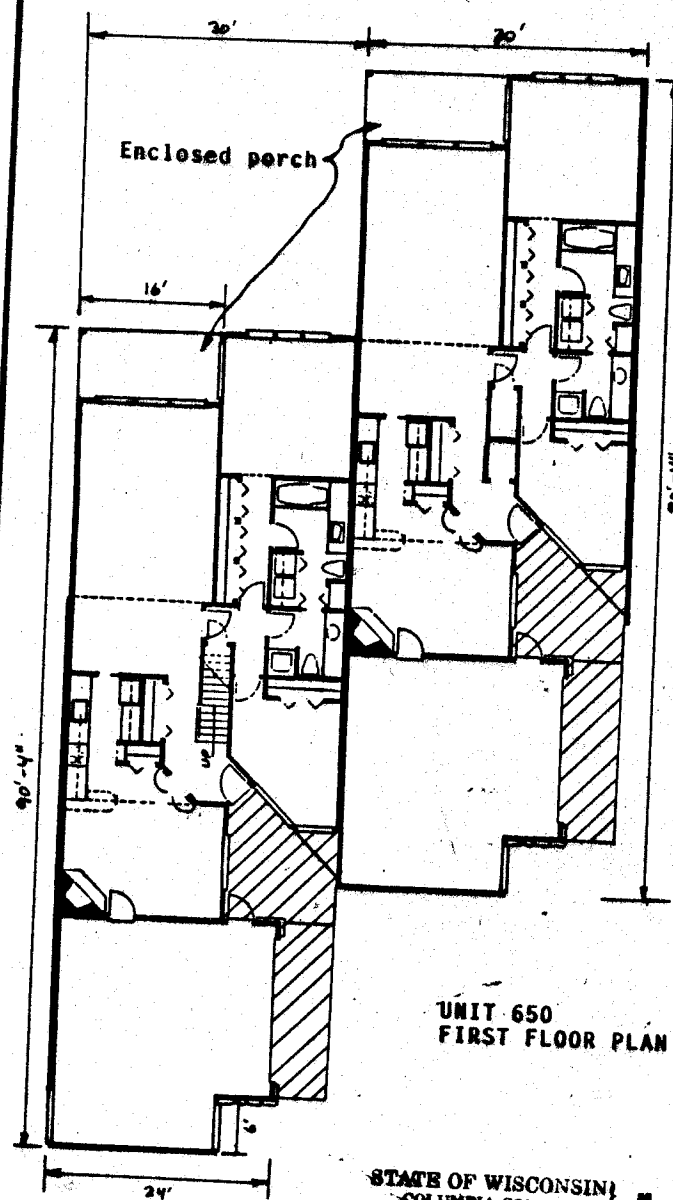


UNIT 652
FIRST FLOOR PLAN

STATE OF WISCONSIN
COLUMBIA COUNTY
Received for record the 29th
Day of August A.D. 1988
at 9:00 o'clock A.M. and recorded
in Vol. _____ of Records Page _____
Marian Robinson
Register of Deeds

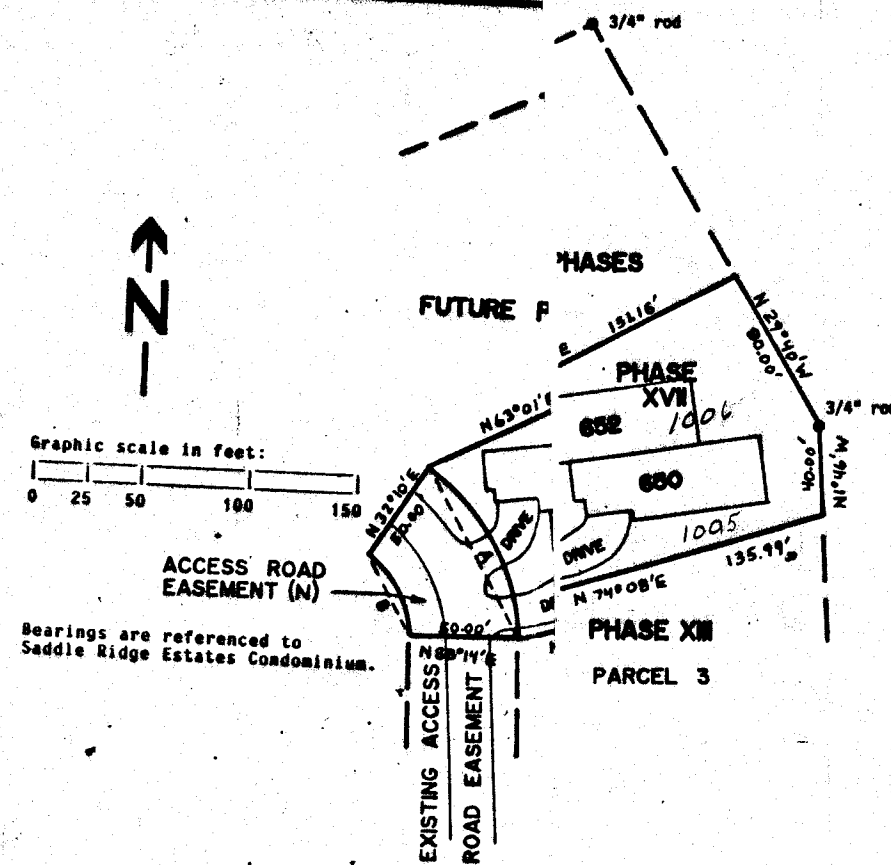

CURVE	DELTA	RADIUS	ARC	CHORD
A	56°04'	95.77'	93.72'	N29°48'W, 90.02'
B	56°04'	45.77'	44.79'	N29°48'W, 43.02'

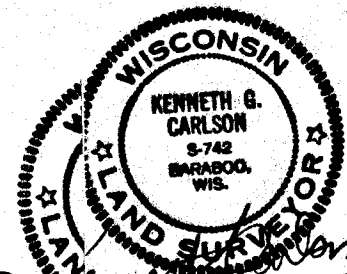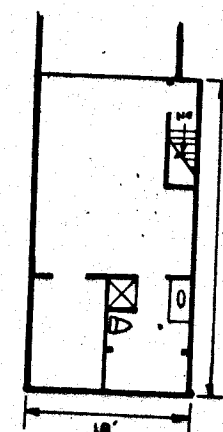

Rem Aug 23, 1988
a


PLOTTED IN PARCEL 4-NW1/4-NE1/4 SEC 1

SADDLE RIDGE ESTATES
SEC. 1-T12N-R9E
TOWN OF PACIFIC
PHASE XVIII

VOL. 001-P169
CONDOMINIUM PLATS
REC. 1-19-89
646-6012 & 6032
1990 ASSESSMENT 204

Replaced
2004

472004

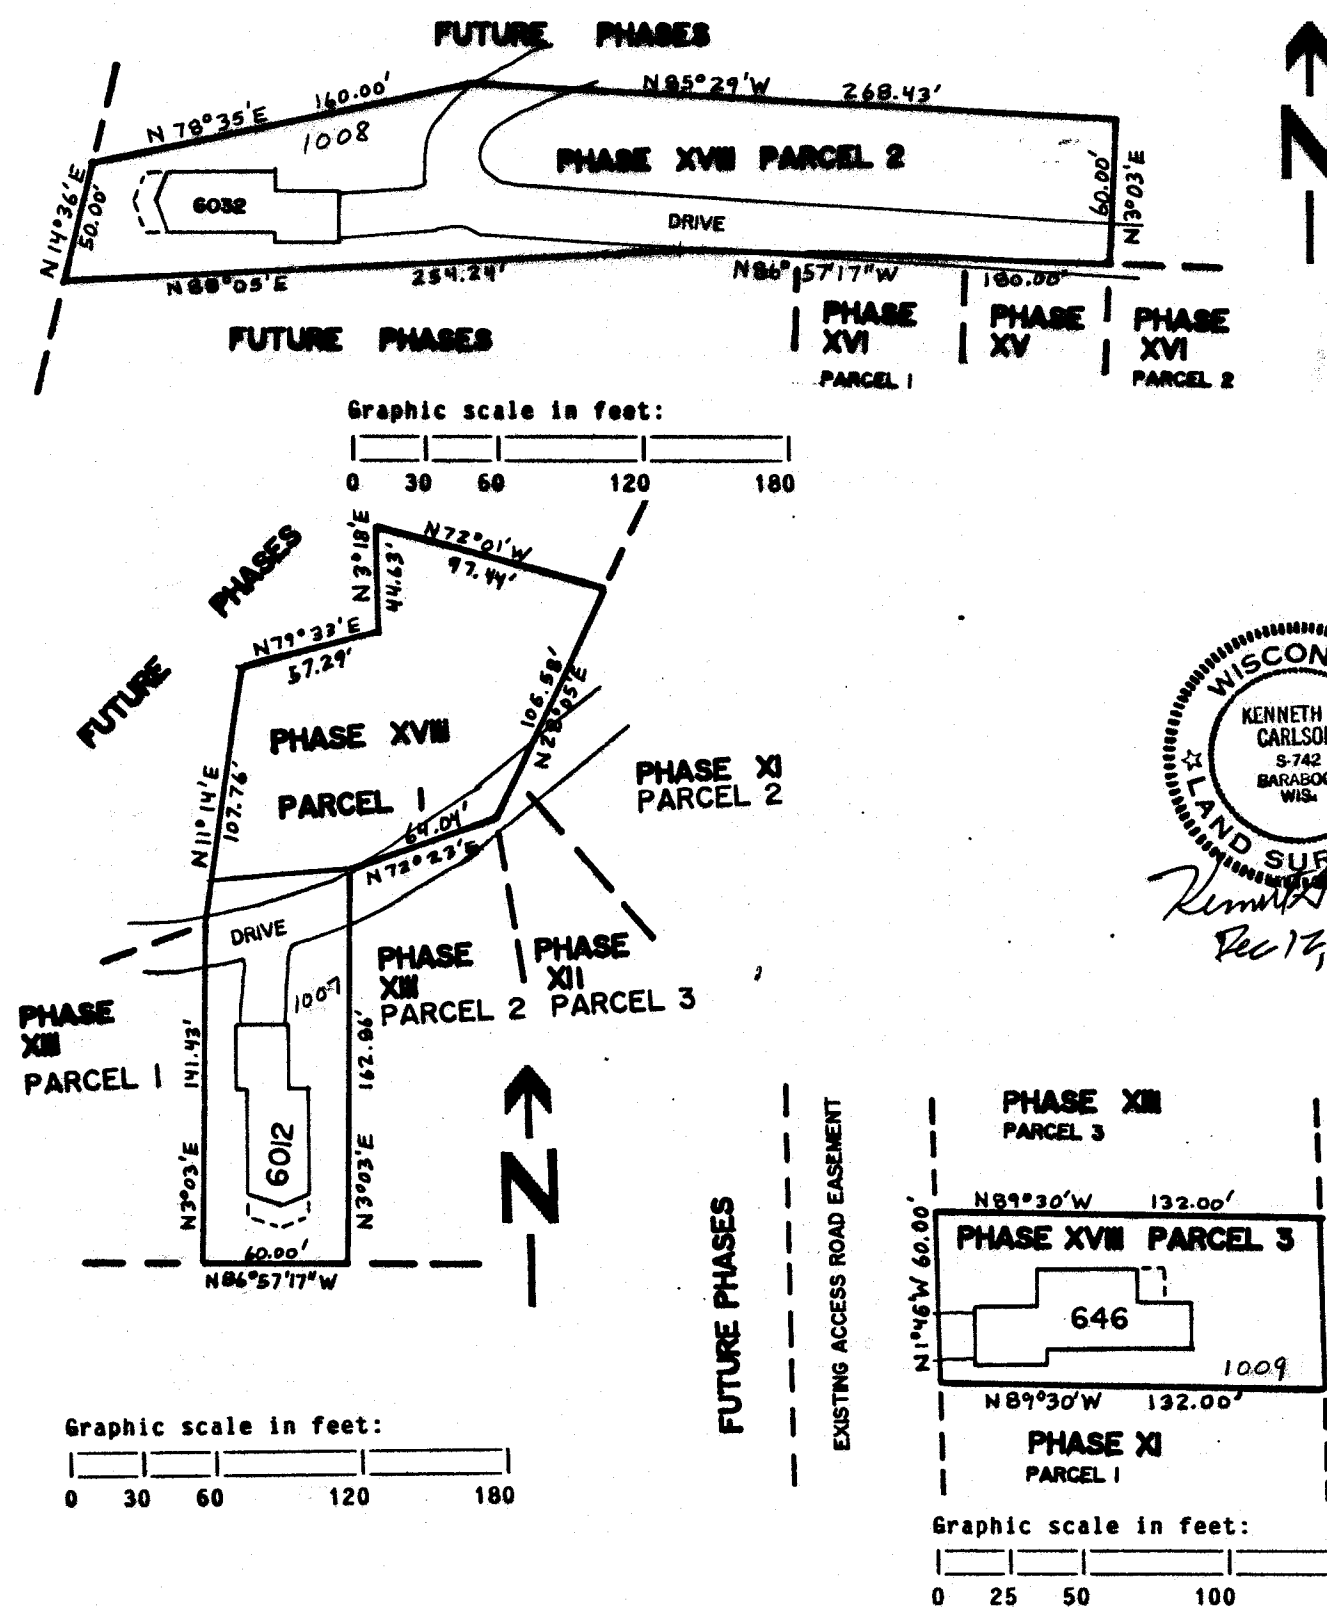

AMENDMENT TO CONDOMINIUM PLAT OF
SADDLE RIDGE ESTATES
COLUMBIA COUNTY

THIS SURVEY DESCRIBES THE LAND AND
BUILDINGS SUBJECT TO THE CONDOMINIUM
DECLARATION FOR SADDLE RIDGE ESTATES
PHASE XVIII

PHASE XVIII PARCEL 1 Description:

A parcel of land located in the NE1/4, Section 1, T12N, R9E, Town of Pacific, Columbia County, Wisconsin bounded by the following described line: Beginning at the southeast corner of PHASE XIII, PARCEL 1, Saddle Ridge Estates Condominium; thence N3°03'E, 141.43 feet; thence N11°14'E, 107.76 feet; thence N79°33'E, 57.29 feet; thence N3°18'E, 44.63 feet; thence S72°01'E, 97.44 feet; thence S28°05'W, 106.58 feet; thence S72°23'W, 64.04 feet; thence S3°03'W, 162.86 feet; thence N86°57'17"W, 60.00 feet to point of beginning. Said parcel contains 23,910 square feet or 0.549 acres.

PHASE XVIII PARCEL 2 Description:

A parcel of land located in the NE1/4, Section 1, T12N, R9E, Town of Pacific, Columbia County, Wisconsin bounded by the following described line: Beginning at the northeast corner of PHASE XIV, Saddle Ridge Estates Condominium; thence N86°57'17"W, 180.00 feet; thence S88°05'W, 254.24 feet; thence N14°36'E, 50.00 feet; thence N78°35'E, 160.00 feet; thence S85°29'E, 268.43 feet; thence S3°03'W, 60.00 feet to point of beginning. Said Parcel contains 27,110 square feet or 0.622 acres.

PHASE XVIII, PARCEL 3 Description:


A parcel of land located in the NW1/4, Section 1, T12N, R9E, Town of Pacific, Columbia County, Wisconsin bounded by the following described line: Beginning at the northwest corner of PHASE XII, PARCEL 1, Saddle Ridge Estates Condominium; thence N1°46'W, 60.00 feet; thence S89°30'E, 132.00 feet; thence S1°46'E, 60.00 feet; thence N89°30'W, 132.00 feet to point of beginning. Said parcel contains 7,910 square feet or 0.182 acres.

I, Kenneth G. Carlson, registered land surveyor, hereby certify that I have surveyed the above described parcel, that this plat is a correct representation of the exterior boundaries of the parcel described and the location of the building and driveways constructed or to be constructed as proposed at the date hereof and the identification and location of each unit and the common elements can be determined.

An agreement has been signed by Kenneth Carlson and Carl Berst to exclude certain requirements of A-E 7, Wisconsin Administrative Code, namely setting monuments at the corners of the parcel described.

CONDOMINIUM PLAT
SADDLE RIDGE ESTATES
PHASE XVIII
Page 1 of 2 pages

VOL. 1 PAGE 169

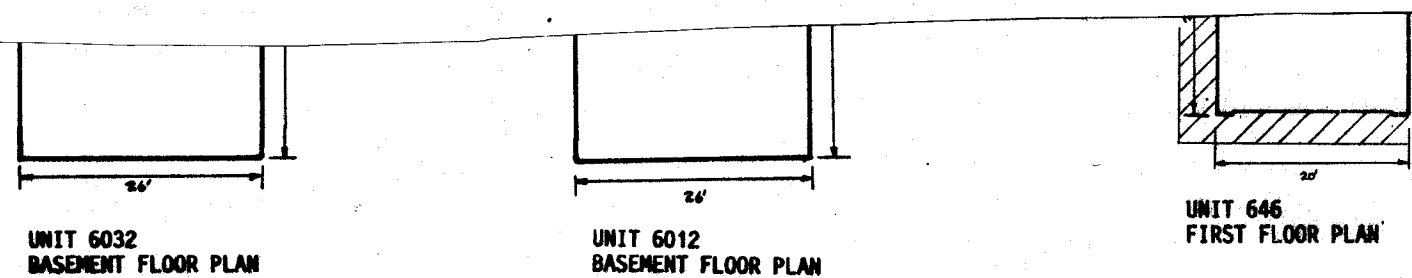

STATE OF WISCONSIN
COLUMBIA COUNTY
RECEIVED FOR RECORD


JAN 19 1989

Reg. of Deeds at 10:45 A.M.

CONDOMINIUM PLAT
SADDLE RIDGE ESTATES
PHASE XVIII
Page 2 of 2 pages

Replaced
2004

479553

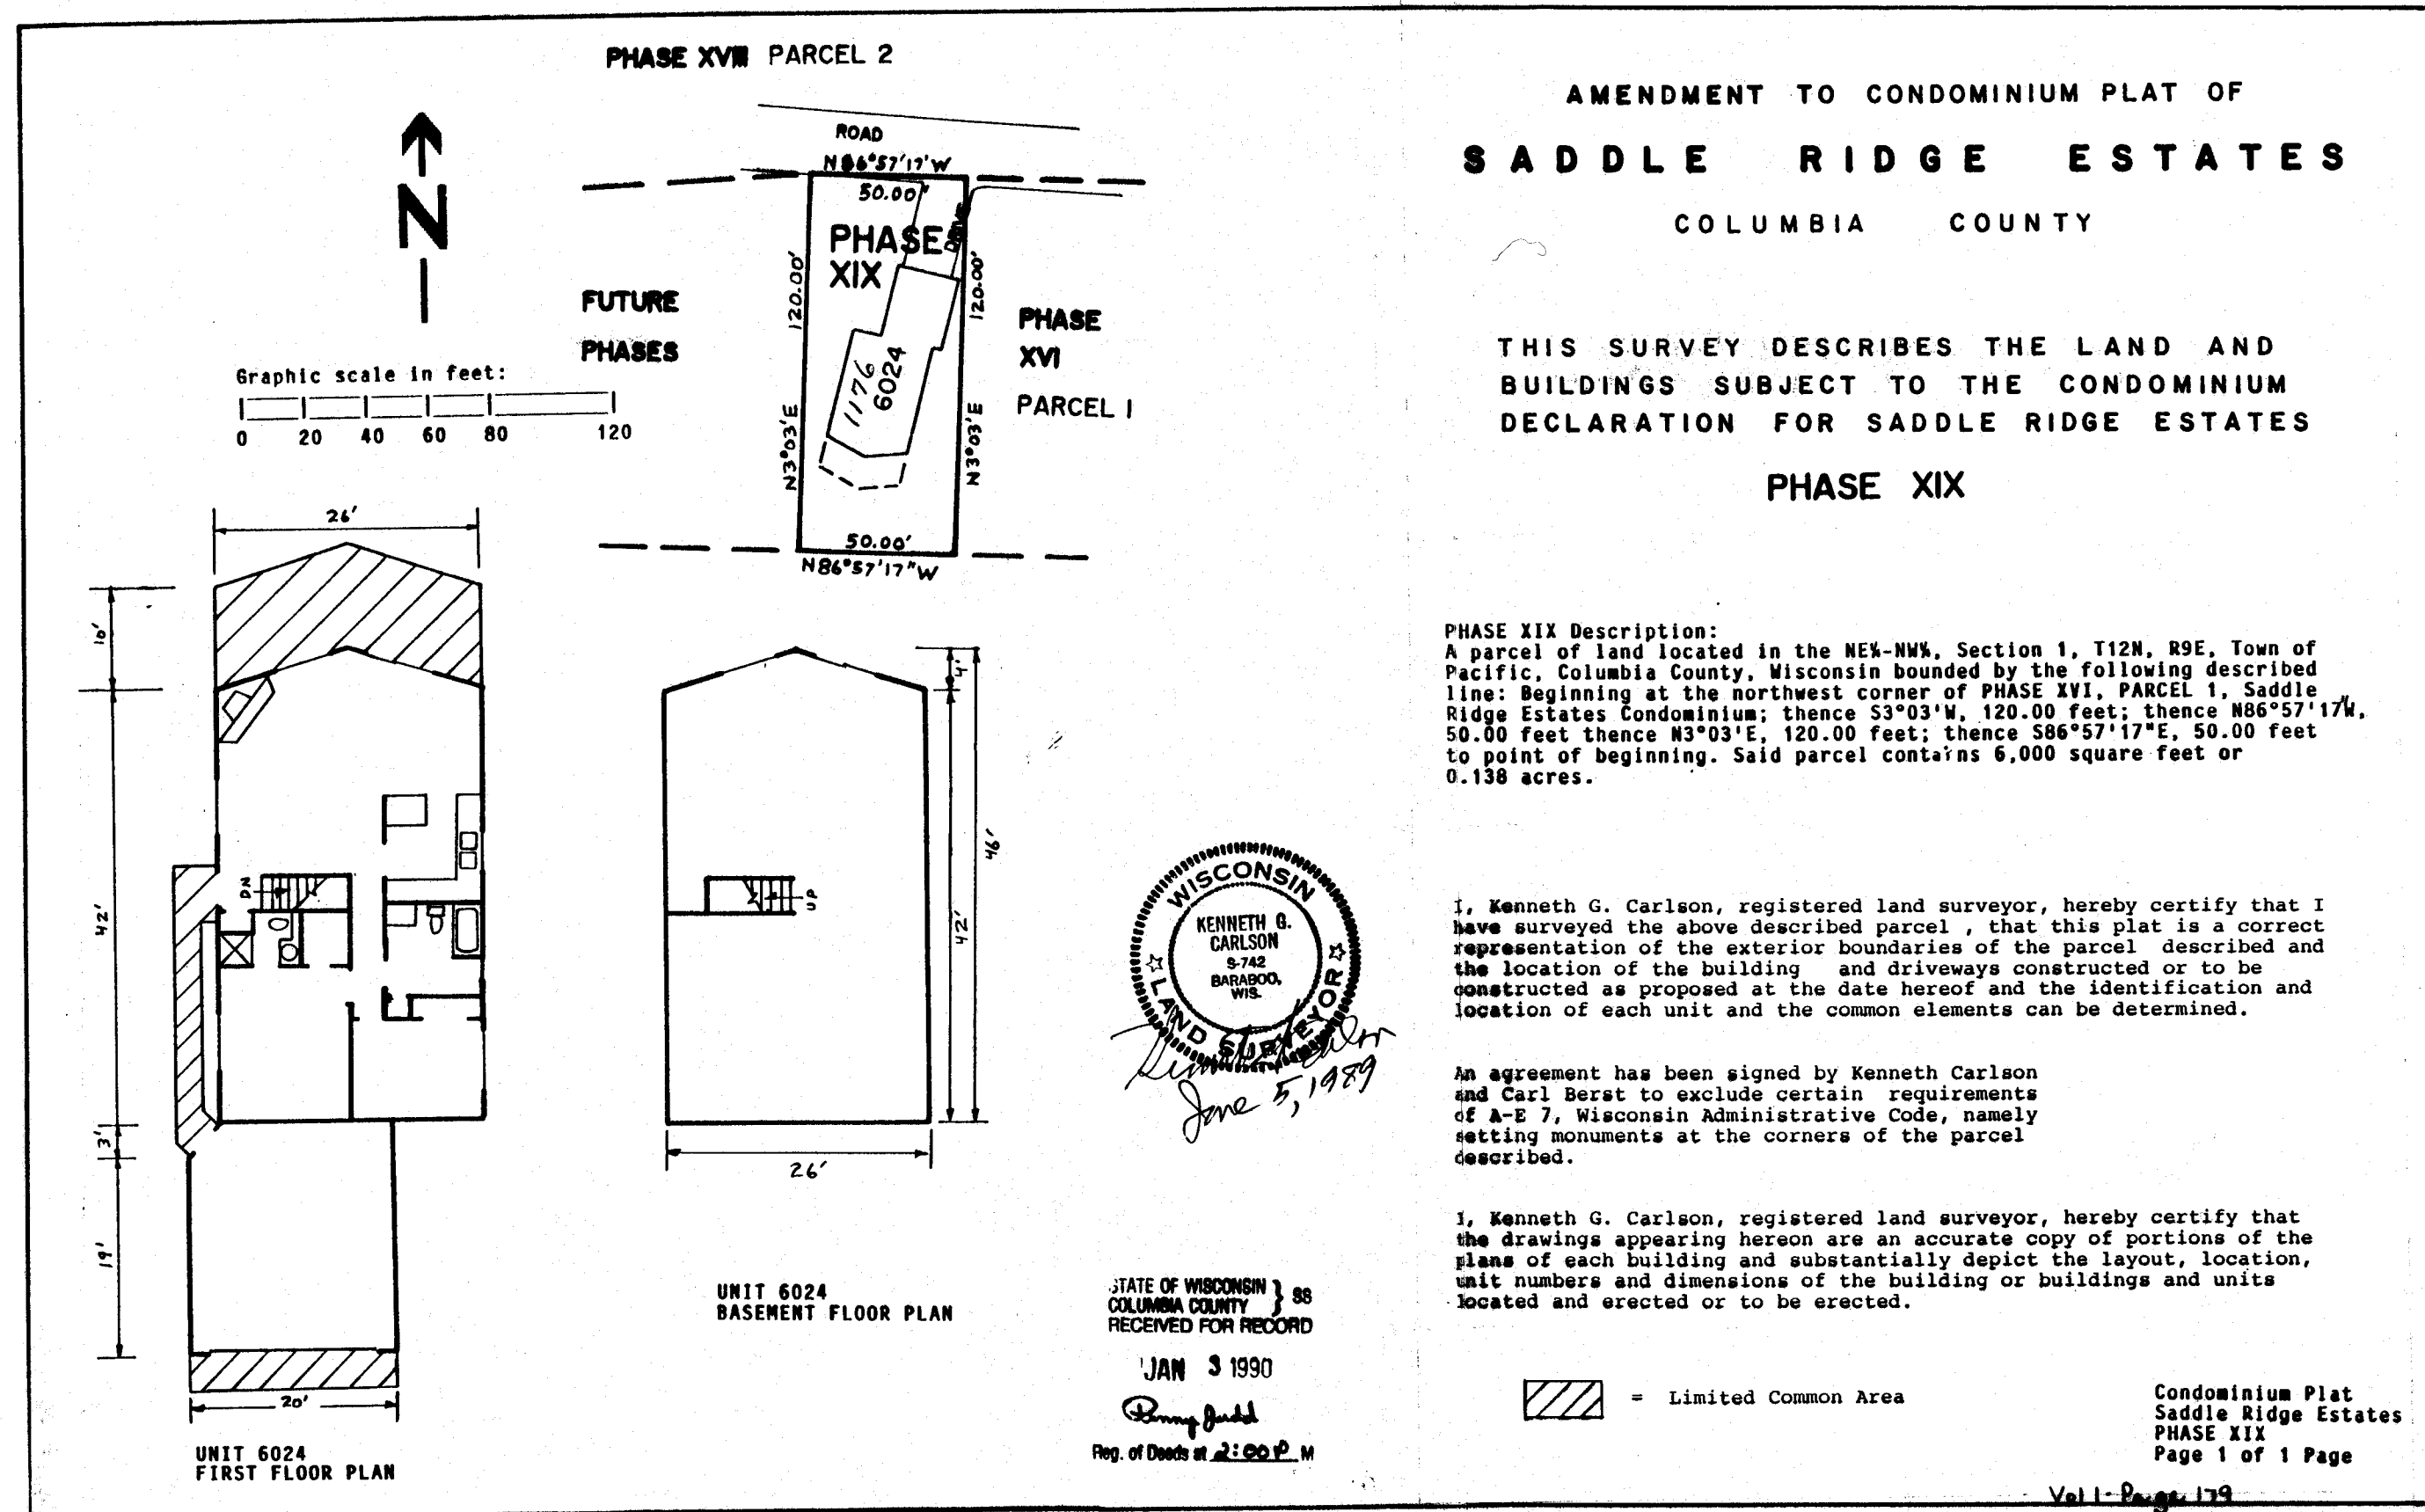

Replaced
2004

AMENDMENT TO CONDOMINIUM PLAT OF
SADDLE RIDGE ESTATES
COLUMBIA COUNTY

THIS SURVEY DESCRIBES THE LAND AND
BUILDINGS SUBJECT TO THE CONDOMINIUM
DECLARATION FOR SADDLE RIDGE ESTATES

PHASE XX

PHASE XX Description:
A parcel of land located in the NE¼-NNW, Section 1, T12N, R9E, Town of Pacific, Columbia County, Wisconsin bounded by the following described line: Beginning at the northwest corner of PHASE XIX, Saddle Ridge Estates Condominium; thence S3°03'W, 120.00 feet; thence N86°57'17"W, 120.00 feet; thence N8°26'E, 110.96 feet; thence N88°05'E, 110.00 feet to point of beginning. Said parcel contains 13,200 square feet or 0.303 acres.

I, Mark C. Carlson, registered land surveyor, hereby certify that I have surveyed the above described parcel, that this plat is a correct representation of the exterior boundaries of the parcel described and the location of the buildings and driveways constructed or to be constructed as proposed at the date hereof and the identification and location of each unit and the common elements can be determined.

An agreement has been signed by Mark Carlson and Carl Berst to exclude all requirements of A-E 7 of the Wisconsin Administrative Code except the preparation of a U.S. public land survey monument record and a map of work performed.

I, Mark C. Carlson, registered land surveyor, hereby certify that the drawings appearing hereon are an accurate copy of portions of the plans of each building and substantially depict the layout, location, unit numbers and dimensions of the building or buildings and units located and erected or to be erected.


STATE OF WISCONSIN } 86
COLUMBIA COUNTY }
RECEIVED FOR RECORD

NOV 5 1990


Reg. of Deeds at 2:30 PM



Condominium Plat
Saddle Ridge Estates
PHASE XX
Page 1 of 1 page
Vol 1 - Page 184

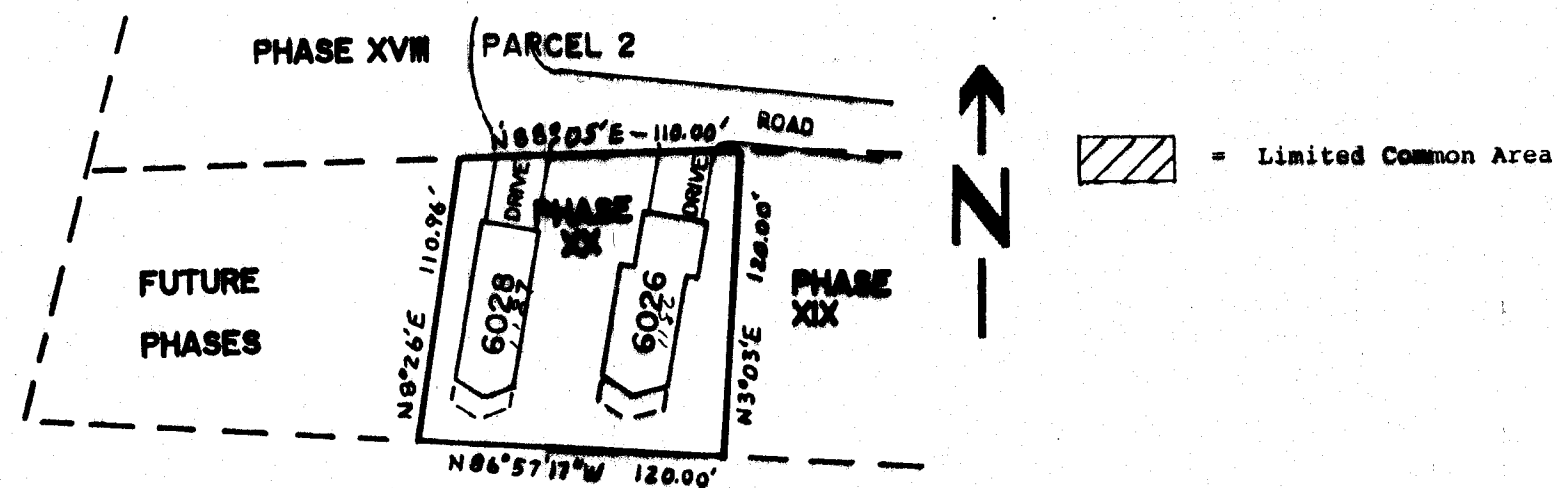

Graphic scale in feet:
0 30 60 120 180

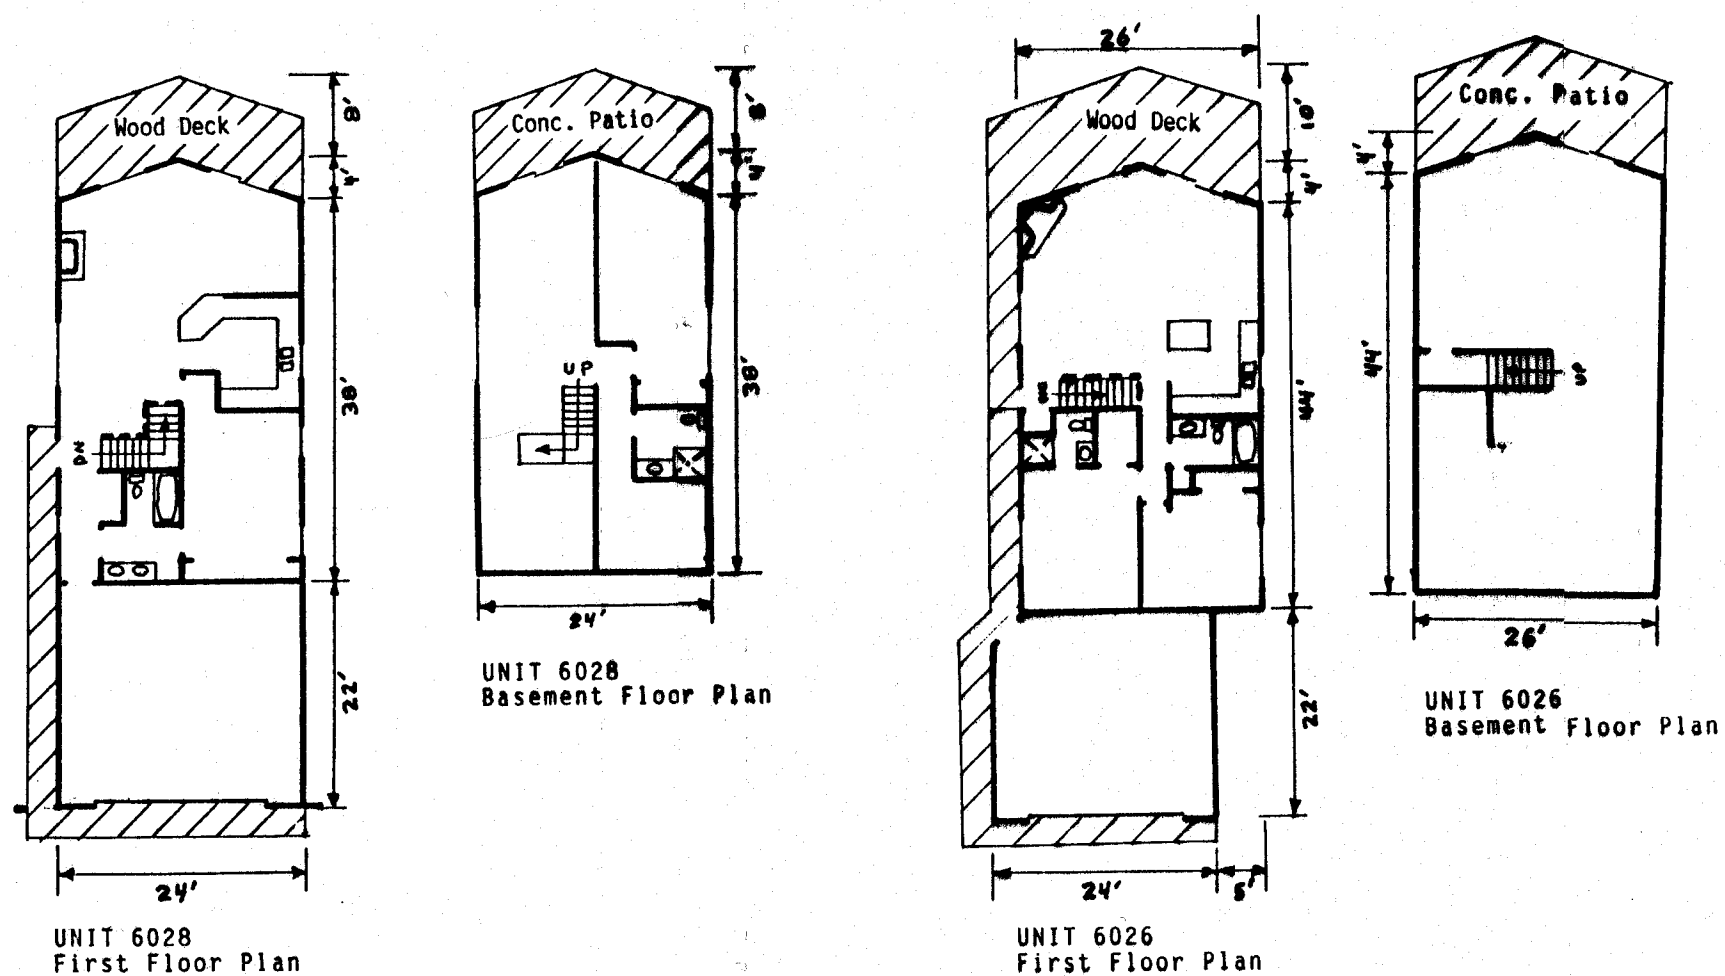

Replaced
2004

**SRE II CONDOMINIUM
PHASE 1
COLUMBIA COUNTY, WISCONSIN**

- = FOUND 1 1/4" IRON ROD
- = FOUND 3/4" ROUND IRON ROD
- ⊕ = FOUND GOVERNMENT CORNER
- ▼ = FOUND DOT CAP
- = SET 3/4"X24" ROUND IRON ROD
- ⊙ = FOUND 3/4" PIPE

---S--- = E of sewer easement

GRAPHIC SCALE IN FEET:



Bearings are referenced to Saddle Ridge Condominium and Saddle Ridge Estates Condominium.


I, **Mark C. Carlson**, registered land surveyor, hereby certify that I have surveyed the above described parcels, that this plat is a correct representation of the exterior boundaries of the parcels described and the location of buildings and driveways constructed or to be constructed as proposed at the date hereof and the identification and location of each unit and common elements to be determined.

I, Mark C. Carlson, registered land surveyor, hereby certify that the drawings appearing hereon are an accurate copy of portions of the plans of each building and substantially depict the layout, unit numbers and dimensions of the buildings and units located and erected or to be erected.

() = recorded as
SRE = Saddle Ridge Estates Condominium
SR = Saddle Ridge Condominium
SLV = Swan Lake Village Condominium
FSLV = The Forest at Swan Lake Village Condominium
Ph = Phase
P = Parcel
AM. = Amended

T13N R9E
SECTION 36
SW $\frac{1}{4}$ - SE $\frac{1}{4}$

SECTION 36
T13N. R9E

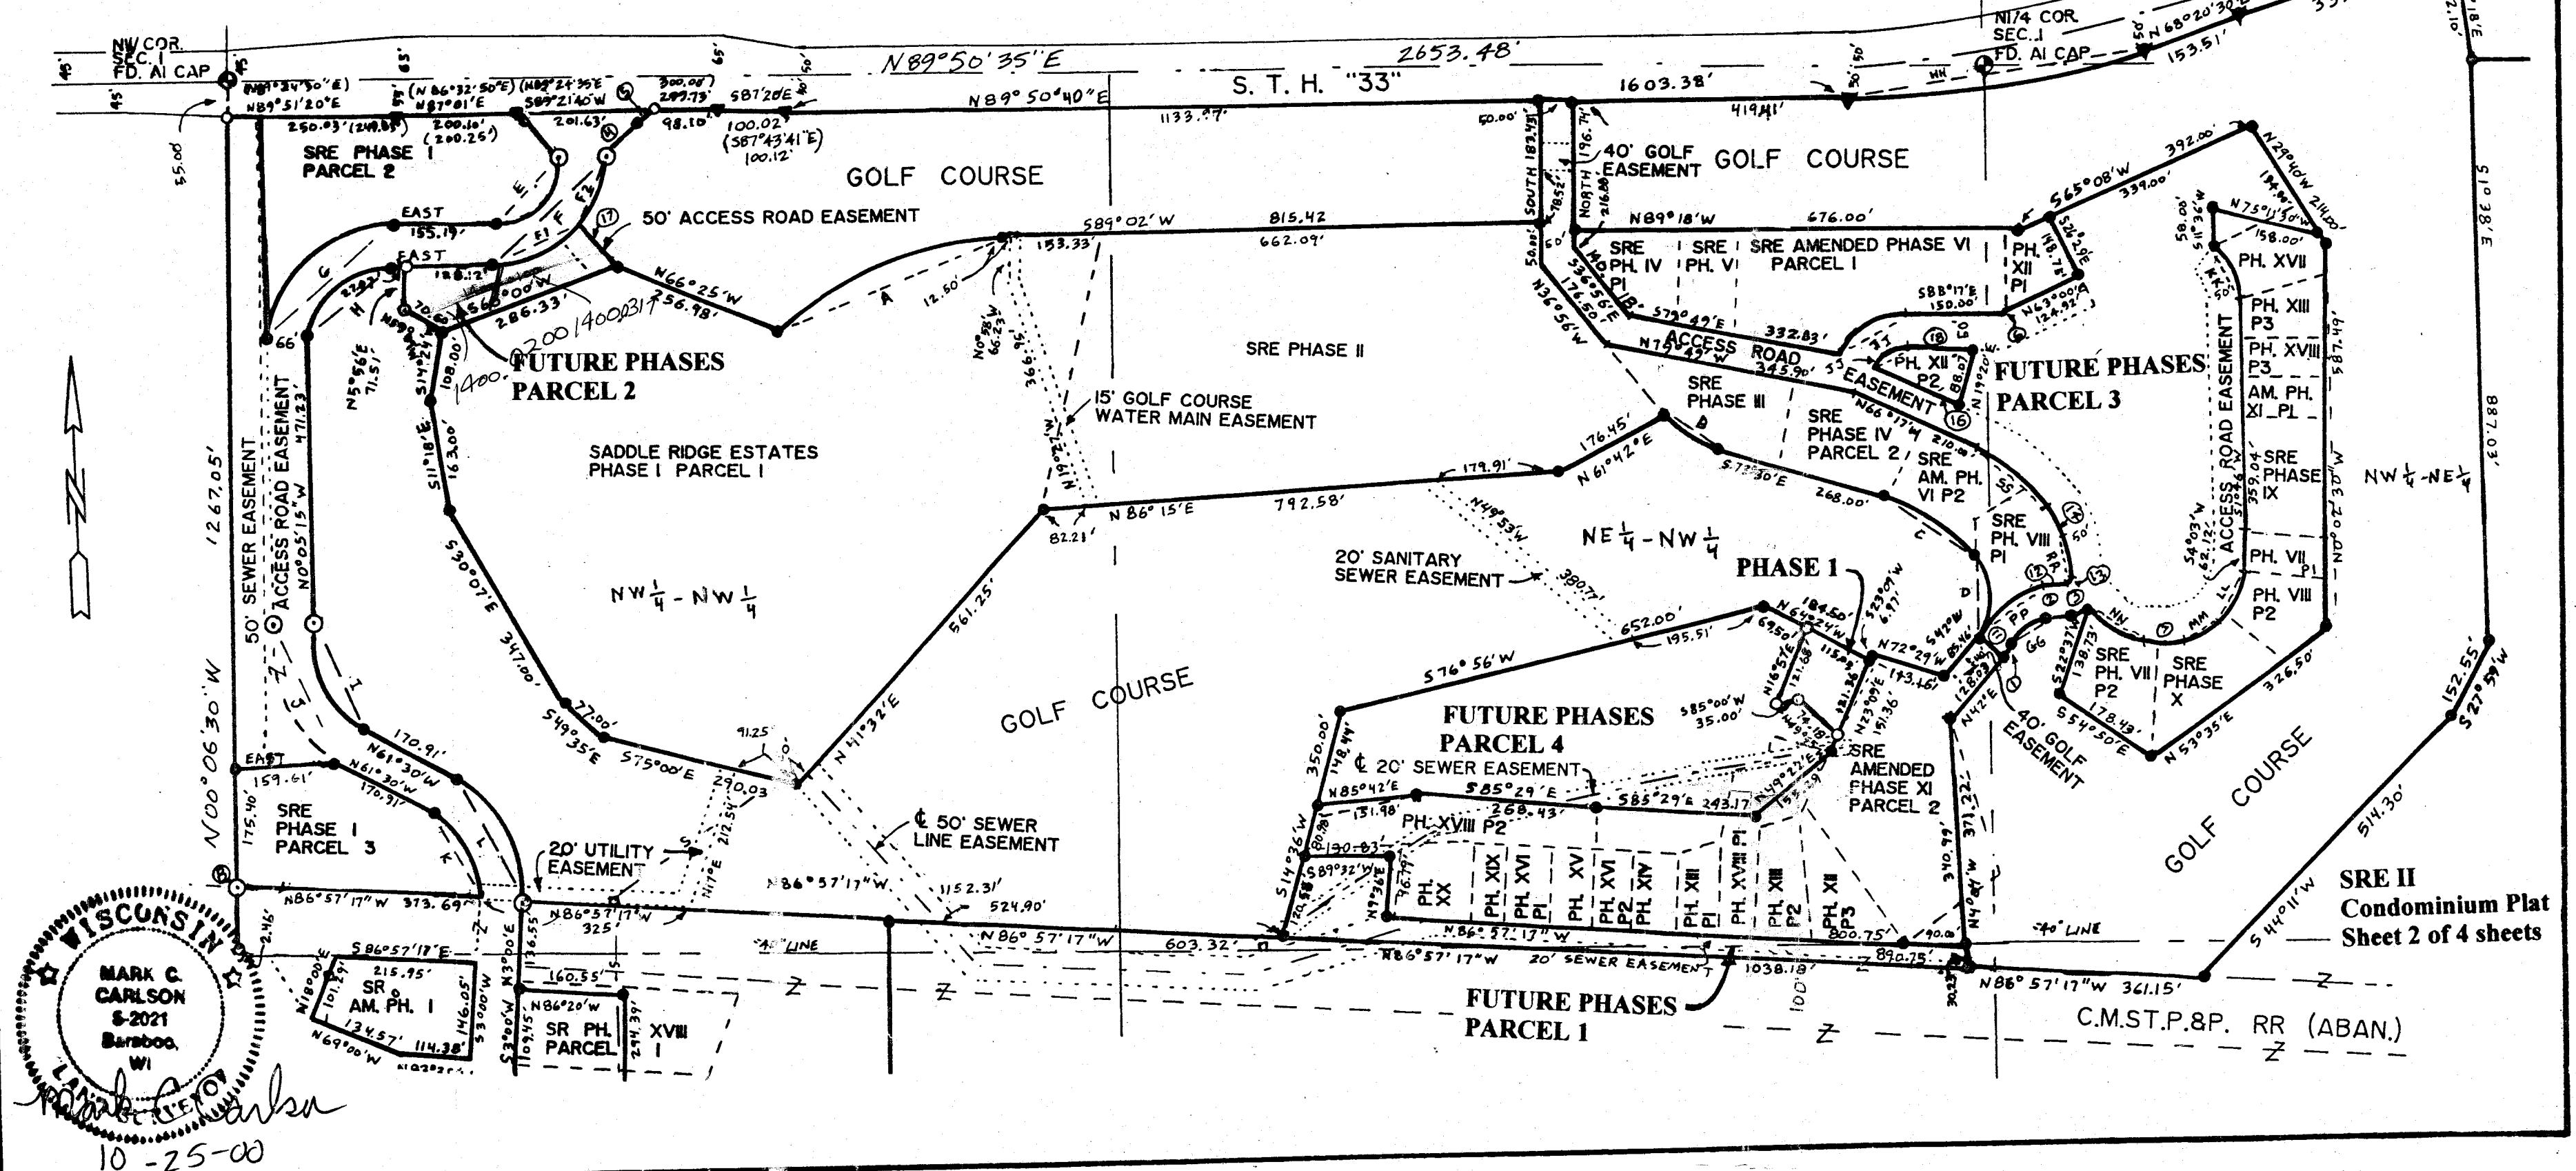

(See amended Phase I
filed 8/3/2001
010260)



629115

STATE OF WISCONSIN
COLUMBIA COUNTY
RECEIVED FOR RECORD


NOV 21 2000

Donny Jull
Reg. of Deeds at 4.00 PM
Vol 2 Page 17


SRE II CONDOMINIUM PHASE 1 COLUMBIA COUNTY, WISCONSIN

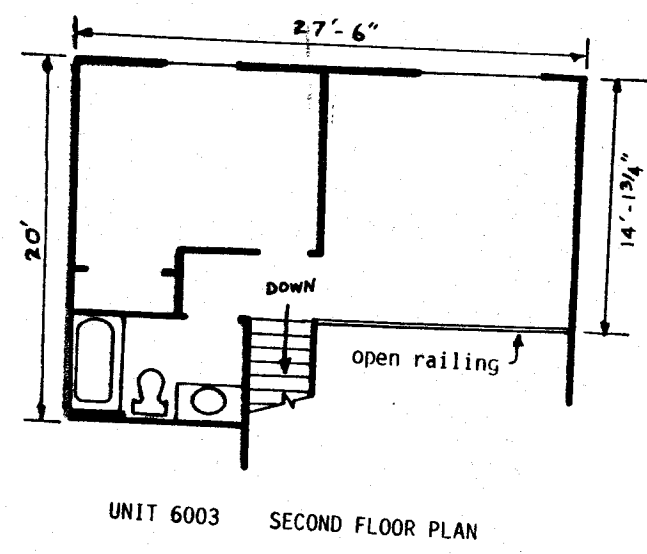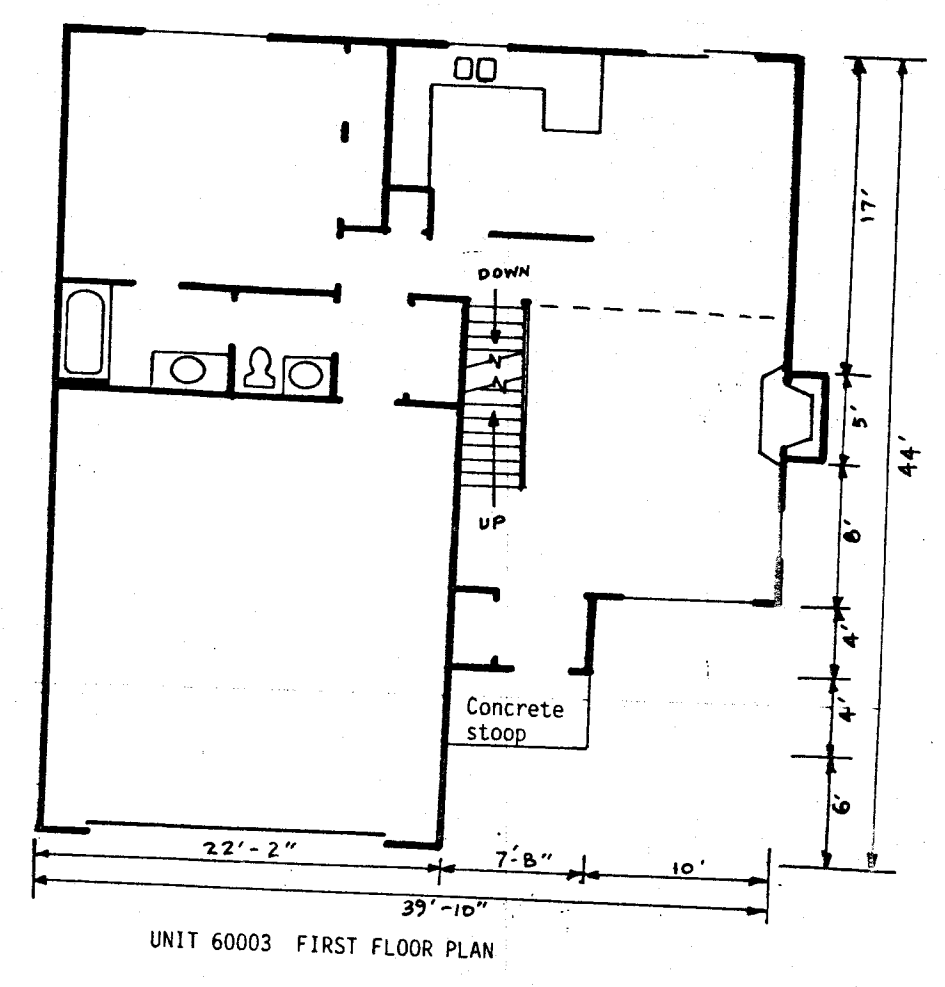

Unit 6005 is mirror image of Unit 6003.
Client: The Saddle Ridge Corporation, 100 Saddle Ridge, Portage, WI, 53901
Carlson Surveying Inc., 1709 Ash Street, Baraboo, WI, 53913

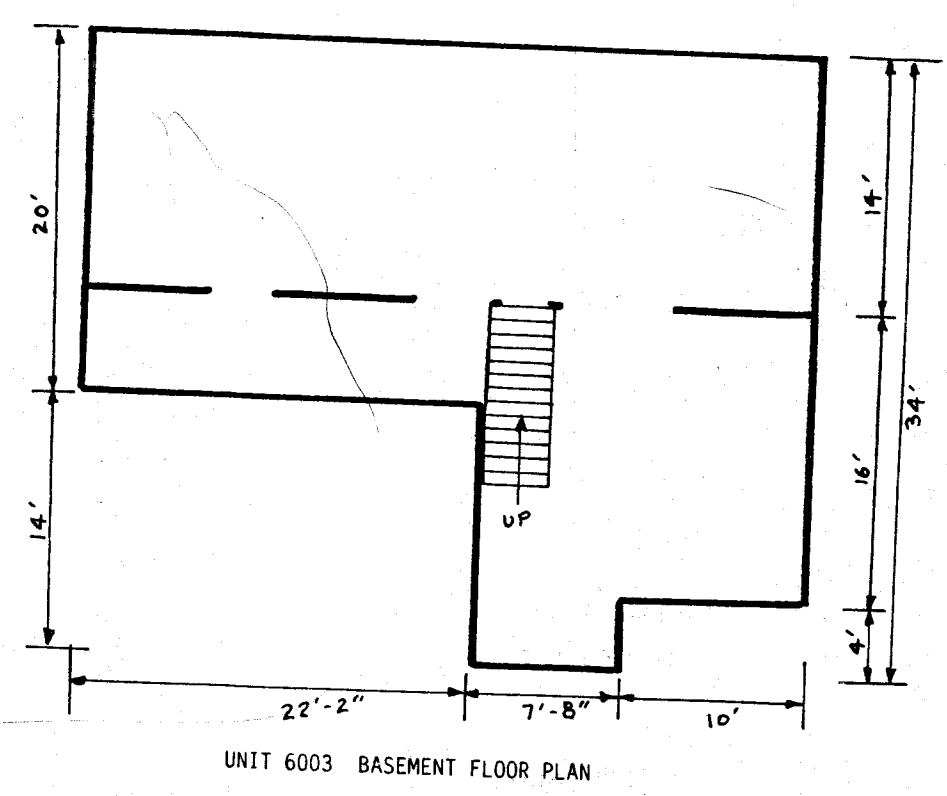

WISCONSIN
MARK C
CARLSON
S-3021
Baraboo,
WI
10-25-00

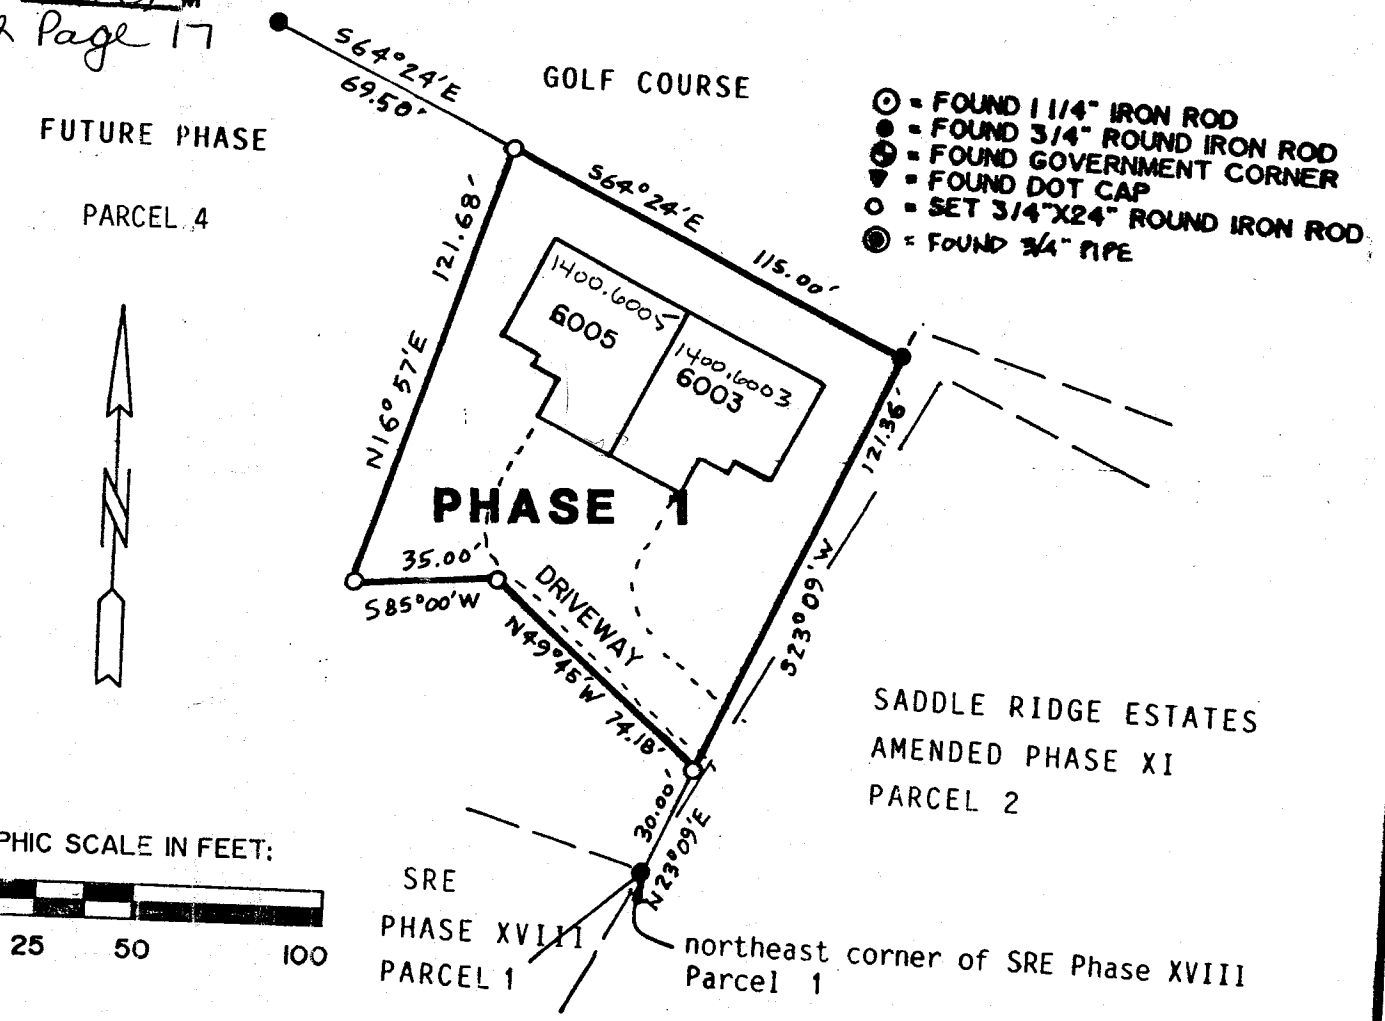

Bearings are referenced to Saddle Ridge Condominium and Saddle Ridge Estates Condominium.

I, Mark C. Carlson, registered land surveyor, hereby certify that I have surveyed the above described parcels, that this plat is a correct representation of the exterior boundaries of the parcels described and the location of buildings and driveways constructed or to be constructed as proposed at the date hereof and the identification and location of each unit and common elements to be determined.

I, Mark C. Carlson, registered land surveyor, hereby certify that the drawings appearing hereon are an accurate copy of portions of the plans of each building and substantially depict the layout, unit numbers and dimensions of the buildings and units located and erected or to be erected.

SRE II
Condominium Plat
Sheet 1 of 4 sheets

pat 56.01
new 1400.6005
new 1400.6003

town of Pacific
Sec 1-12 A
SRE II Condominium
Phase 1


629115

STATE OF WISCONSIN
COLUMBIA COUNTY
RECEIVED FOR RECORD


NOV 21 2000 Replaced
2004

Reg. of Deeds at 4:00 PM
Vol 2 Page 17

SRE II CONDOMINIUM PHASE 1 COLUMBIA COUNTY, WISCONSIN

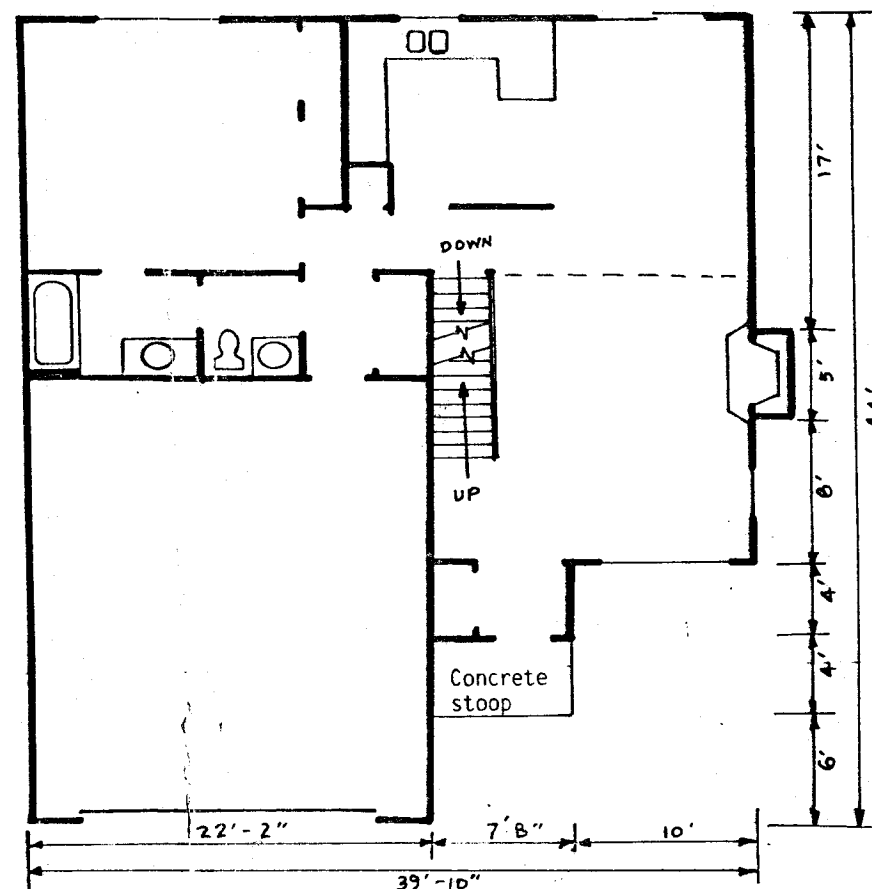

UNIT 6003 FIRST FLOOR PLAN

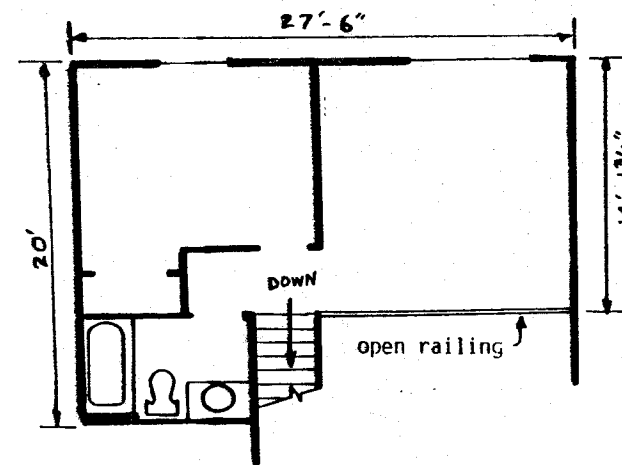


UNIT 6003 SECOND FLOOR PLAN


Unit 6005 is mirror image of Unit 6003.

Client: The Saddle Ridge Corporation, 100 Saddle Ridge, Portage, WI, 53901



Carlson Surveying Inc., 1709 Ash Street, Baraboo, WI, 53913

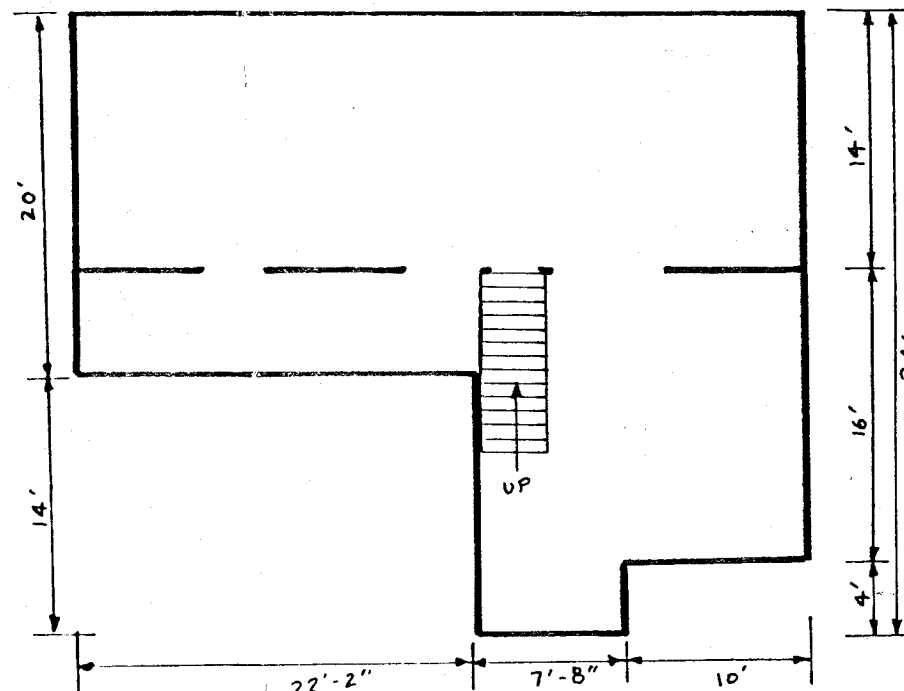

UNIT 6003 BASEMENT FLOOR PLAN

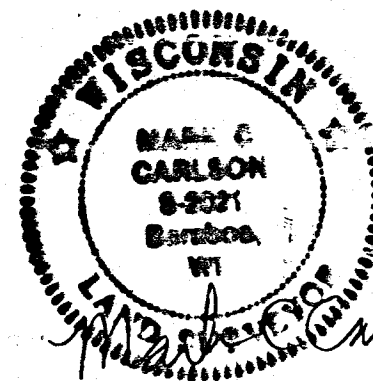

GRAPHIC SCALE IN FEET:

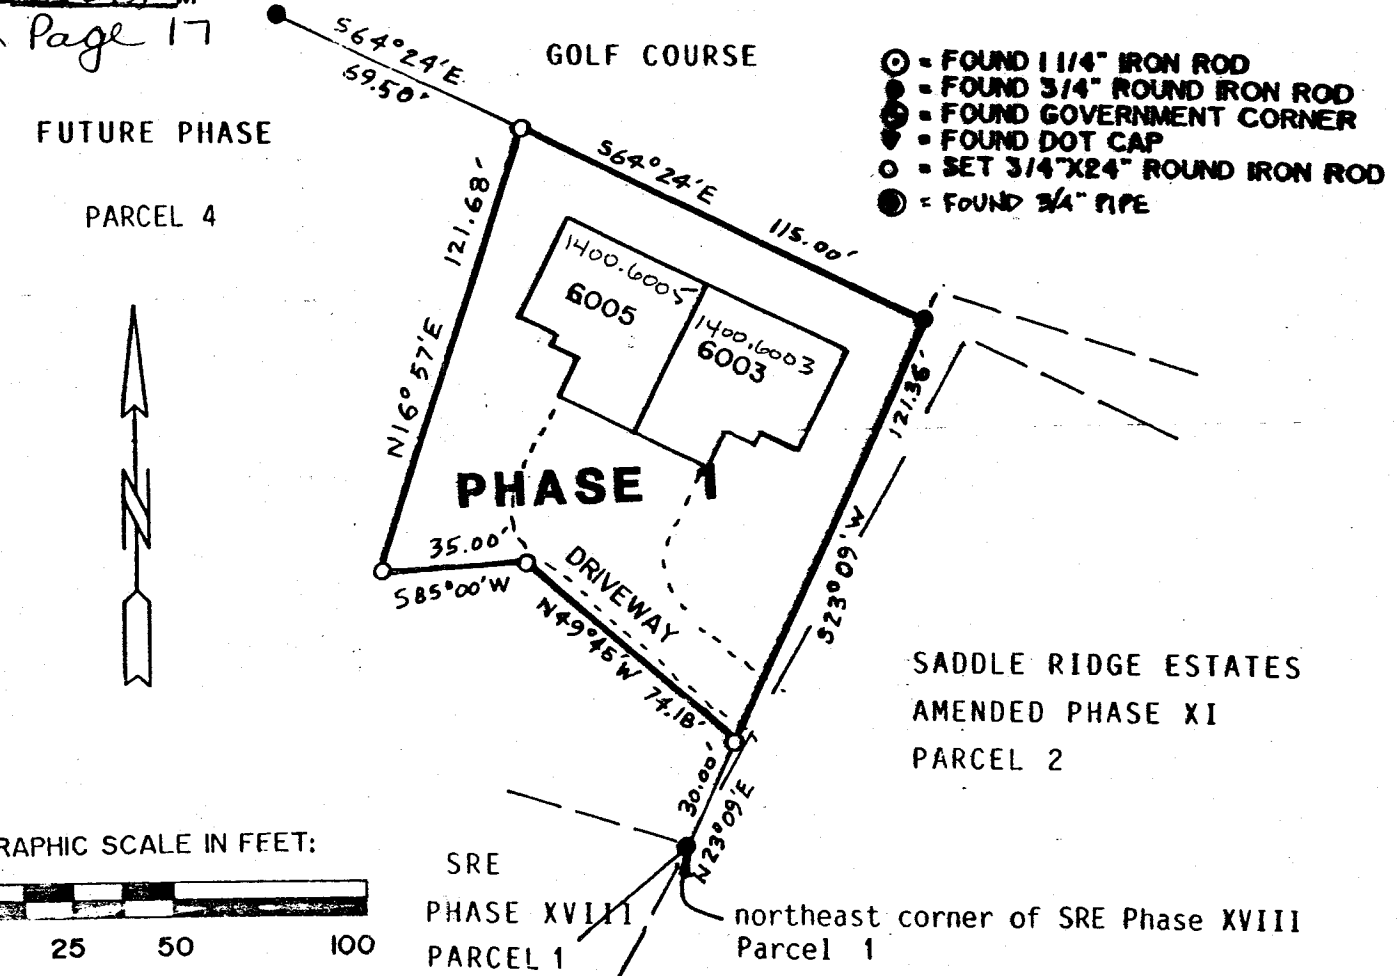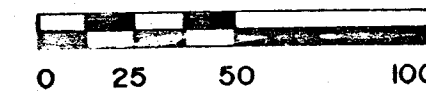

PHASE 1 DESCRIPTION:

A parcel of land located in NE1/4-NW1/4, Section 1, T12N, R9E, Town of Pacific, Columbia County, Wisconsin bounded by the following described line:
Commencing at the northeast corner of Phase XVIII, Parcel 1, Saddle Ridge Estates Condominium, thence N23°09'E, 30.00 feet to point of beginning; thence N49°45'W, 74.18 feet; thence S85°00'W, 35.00 feet; thence N16°57'E, 121.68 feet; thence S64°24'E, 115.00 feet; thence S23°09'W, 121.36 feet to point of beginning.
Described parcel contains 12,170 square feet and benefits from existing access road easements for Saddle Ridge Estates Condominium.

Bearings are referenced to Saddle Ridge Condominium and Saddle Ridge Estates Condominium.

I, Mark C. Carlson, registered land surveyor, hereby certify that I have surveyed the above described parcels, that this plat is a correct representation of the exterior boundaries of the parcels described and the location of buildings and driveways constructed or to be constructed as proposed at the date hereof and the identification and location of each unit and common elements to be determined.

I, Mark C. Carlson, registered land surveyor, hereby certify that the drawings appearing hereon are an accurate copy of portions of the plans of each building and substantially depict the layout, unit numbers and dimensions of the buildings and units located and erected or to be erected.

SRE II
Condominium Plat
Sheet 1 of 4 sheets


pt 56.01
new 1400.6005
new 1400.6003

009943


June 12, 2004
SRE II Condominium
Phase 1

Replaced
2004

SRE II CONDOMINIUM AMENDED PHASE 1 COLUMBIA COUNTY, WISCONSIN

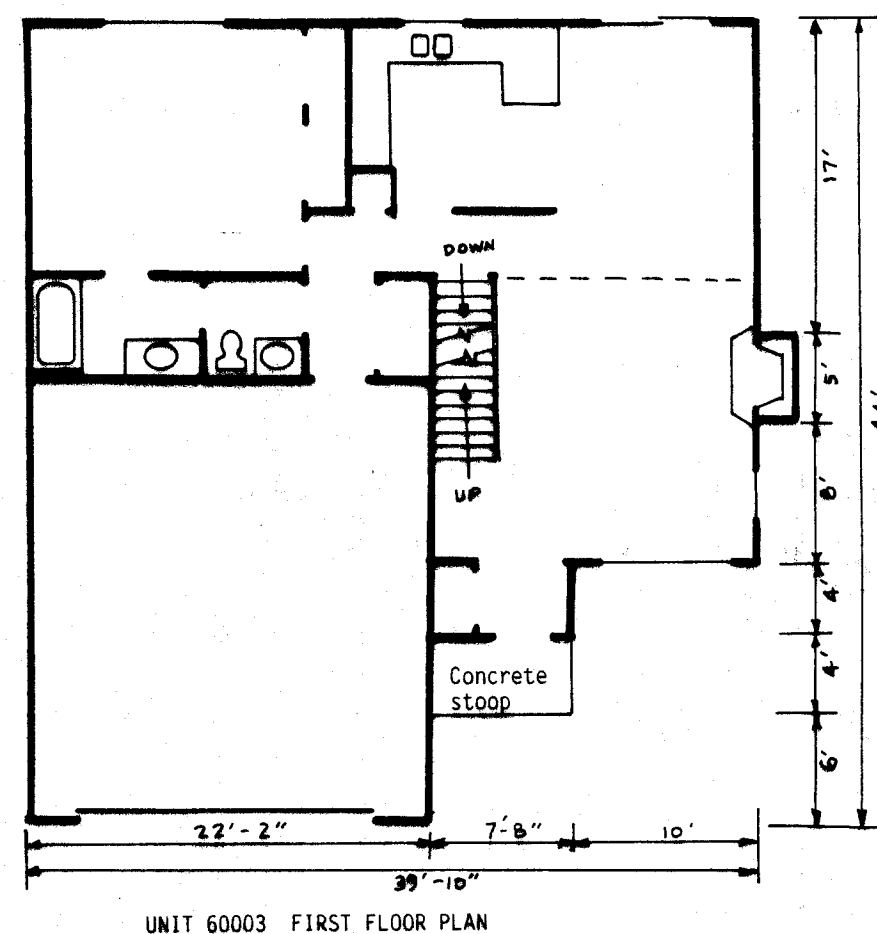

UNIT 6003 FIRST FLOOR PLAN

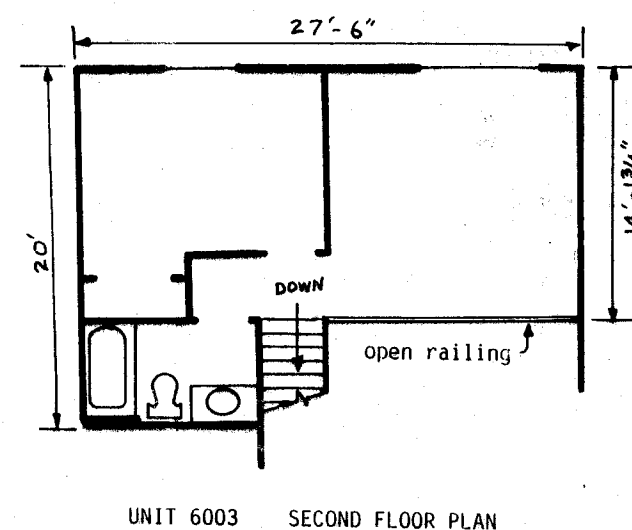


UNIT 6003 SECOND FLOOR PLAN

Unit 6005 is mirror image of Unit 6003.

Client: The Saddle Ridge Corporation, 100 Saddle Ridge, Portage, WI, 53901

Carlson Surveying Inc., 1709 Ash Street, Baraboo, WI, 53913

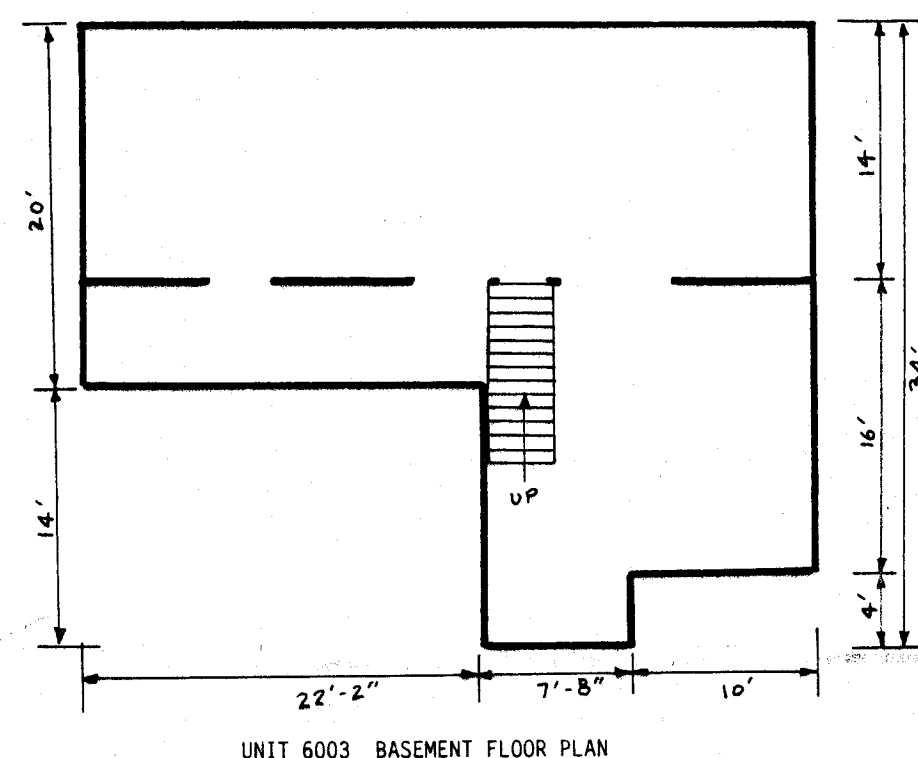

UNIT 6003 BASEMENT FLOOR PLAN


STATE OF WISCONSIN } SS
COLUMBIA COUNTY
RECEIVED FOR RECORD

AUG 3 2001


Danny Jull
Reg. of Deeds at 9:55 AM

Vol 2 Page 28

641141

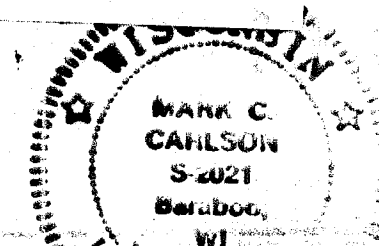

7-16-01

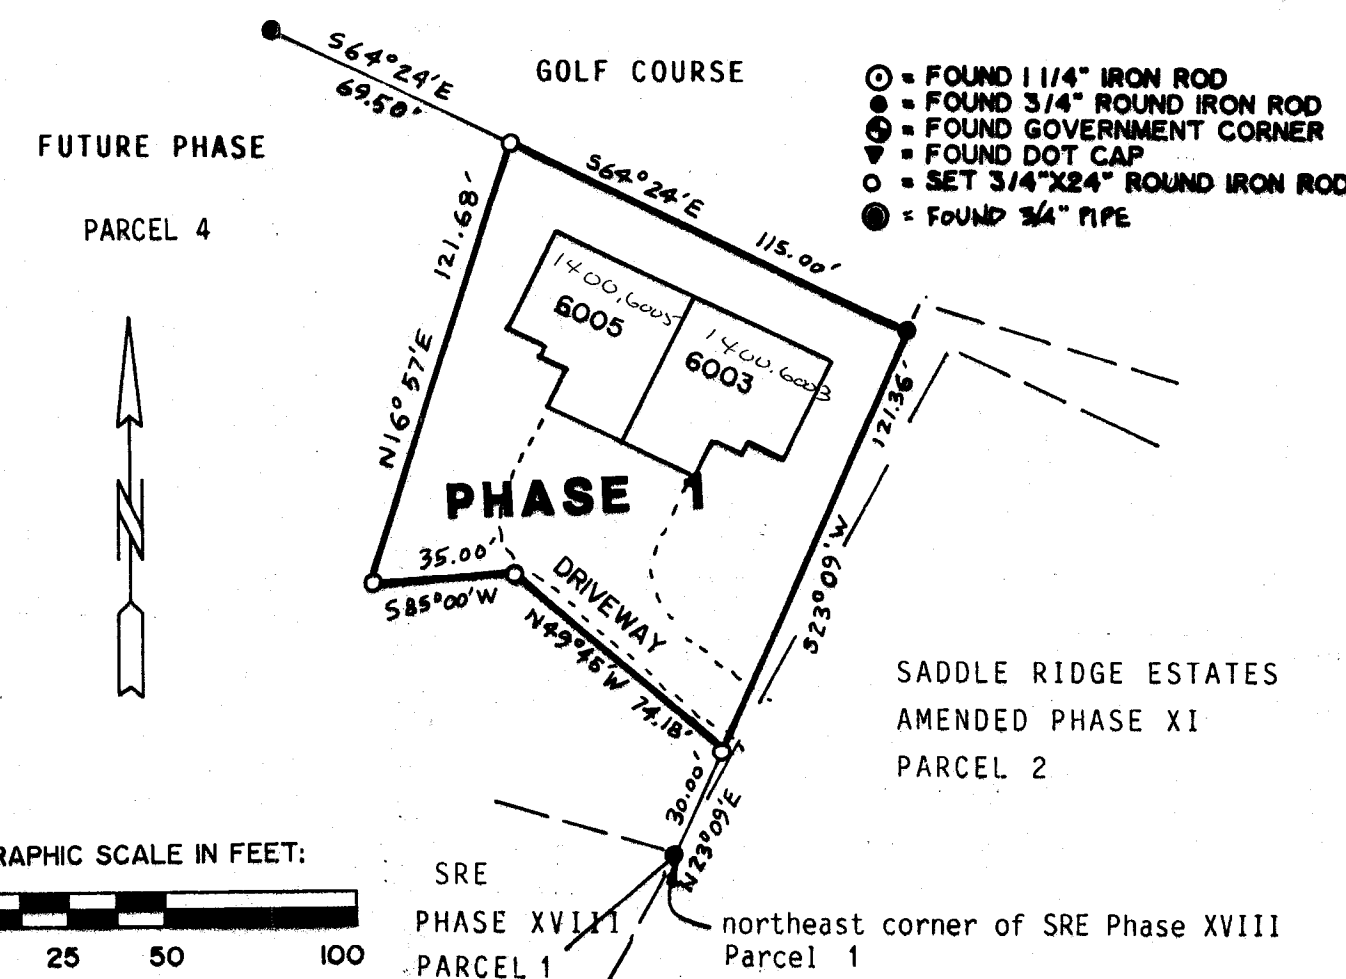

PHASE 1 DESCRIPTION:

A parcel of land located in NE1/4-NW1/4, Section 1, T12N, R9E, Town of Pacific, Columbia County, Wisconsin bounded by the following described line: Commencing at the northeast corner of Phase XVIII, Parcel 1, Saddle Ridge Estates Condominium, thence N23°09'E, 30.00 feet to point of beginning; thence N49°45'W, 74.18 feet; thence S85°00'W, 35.00 feet; thence N16°57'E, 121.68 feet; thence S64°24'E, 115.00 feet; thence S23°09'W, 121.36 feet to point of beginning. Described parcel contains 12,170 square feet and benefits from existing access road easements for Saddle Ridge Estates Condominium.

Bearings are referenced to Saddle Ridge Condominium and Saddle Ridge Estates Condominium.

I, Mark C. Carlson, registered land surveyor, hereby certify that I have surveyed the above described parcels, that this plat is a correct representation of the exterior boundaries of the parcels described and the location of buildings and driveways constructed or to be constructed as proposed at the date hereof and the identification and location of each unit and common elements to be determined.

I, Mark C. Carlson, registered land surveyor, hereby certify that the drawings appearing hereon are an accurate copy of portions of the plans of each building and substantially depict the layout, unit numbers and dimensions of the buildings and units located and erected or to be erected.

SRE II
Condominium Plat
Sheet 1 of 4 sheets

Iron of Pacific Sec 1-12-9
SRE II Units
Amended Phase I

SRE II CONDOMINIUM
AMENDED PHASE 2
COLUMBIA COUNTY, WISCONSIN

Replaced
Recorded
2004

PHASE 2 DESCRIPTION:
A parcel of land located in NE1/4-NW1/4, Section 1, T12N, R9E, Town of Pacific, Columbia County, Wisconsin bounded by the following described line:
Beginning at the northeast corner of Phase XVIII, Parcel 1, Saddle Ridge Estates Condominium, thence S49°22'W, 155.29 feet; thence N9°00'W, 170.00 feet; thence N85°00'E, 100.00 feet; thence S49°45'E, 74.18 feet; thence S23°09'W, 30.00 feet to point of beginning.
Described parcel contains 16,260 square feet and benefits from existing access road easements for Saddle Ridge Estates Condominium.



Client: The Saddle Ridge Corporation, 100 Saddle Ridge, Portage, WI, 53901

Carlson Surveying Inc., 1709 Ash Street, Baraboo, WI, 53913


I, Mark C. Carlson, registered land surveyor, hereby certify that I have surveyed the above described parcel, that this plat is a correct representation of the exterior boundaries of the parcel described and the location of buildings and driveways constructed or to be constructed as proposed at the date hereof and the identification and location of each unit and common elements to be determined.

Bearings are referenced to Saddle Ridge Condominium.

I, Mark C. Carlson, registered land surveyor, hereby certify that the drawings appearing hereon are an accurate copy of portions of the plans of each building and substantially depict the layout, unit numbers and dimensions of the buildings and units located and erected or to be erected.

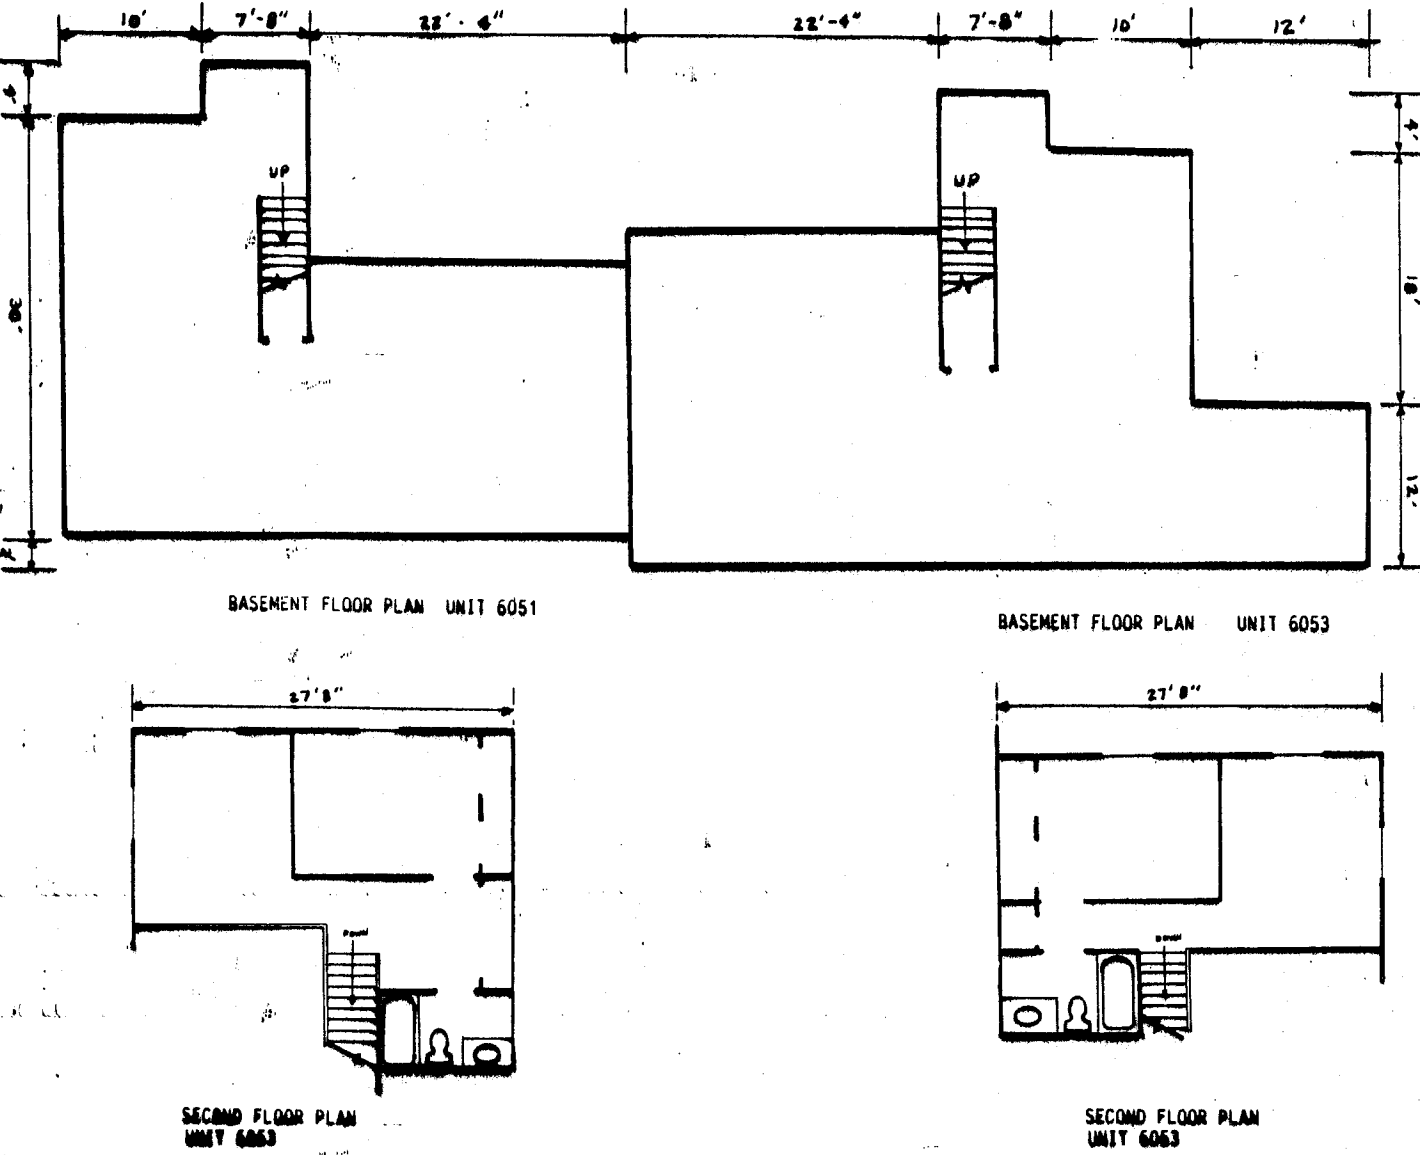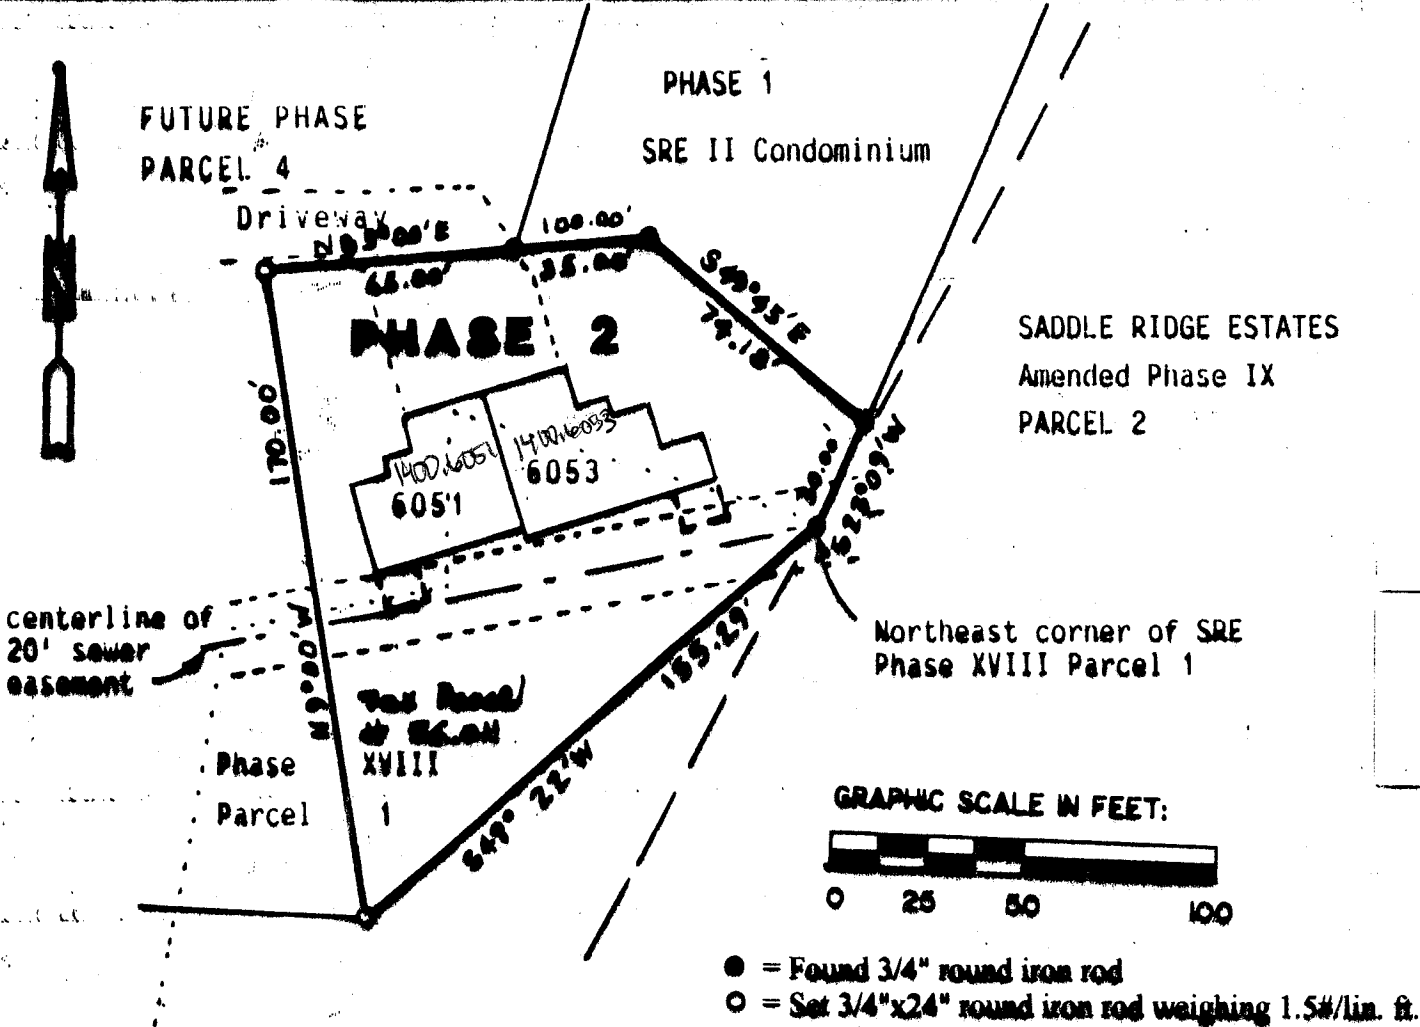


WISCONSIN
MARK C. CARLSON
S-2021
Baraboo, WI
9-7-01

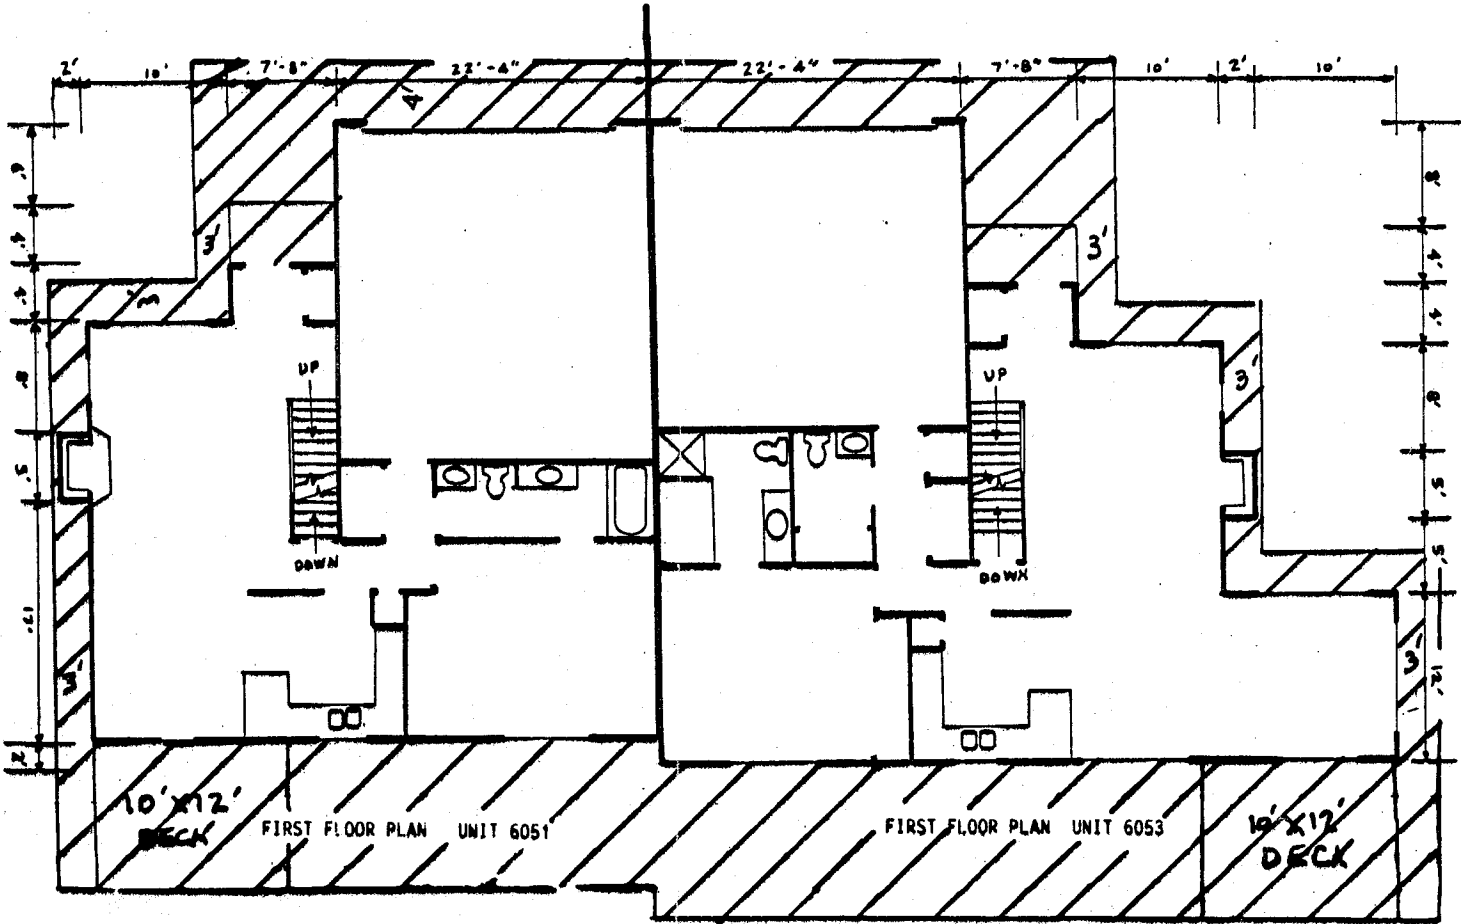

SRE II
Condominium Plat
Sheet 1 of 1 sheets

unit 6051 - 1400.6051 Amend - Decks
unit 6053 - 1400.6053

010661

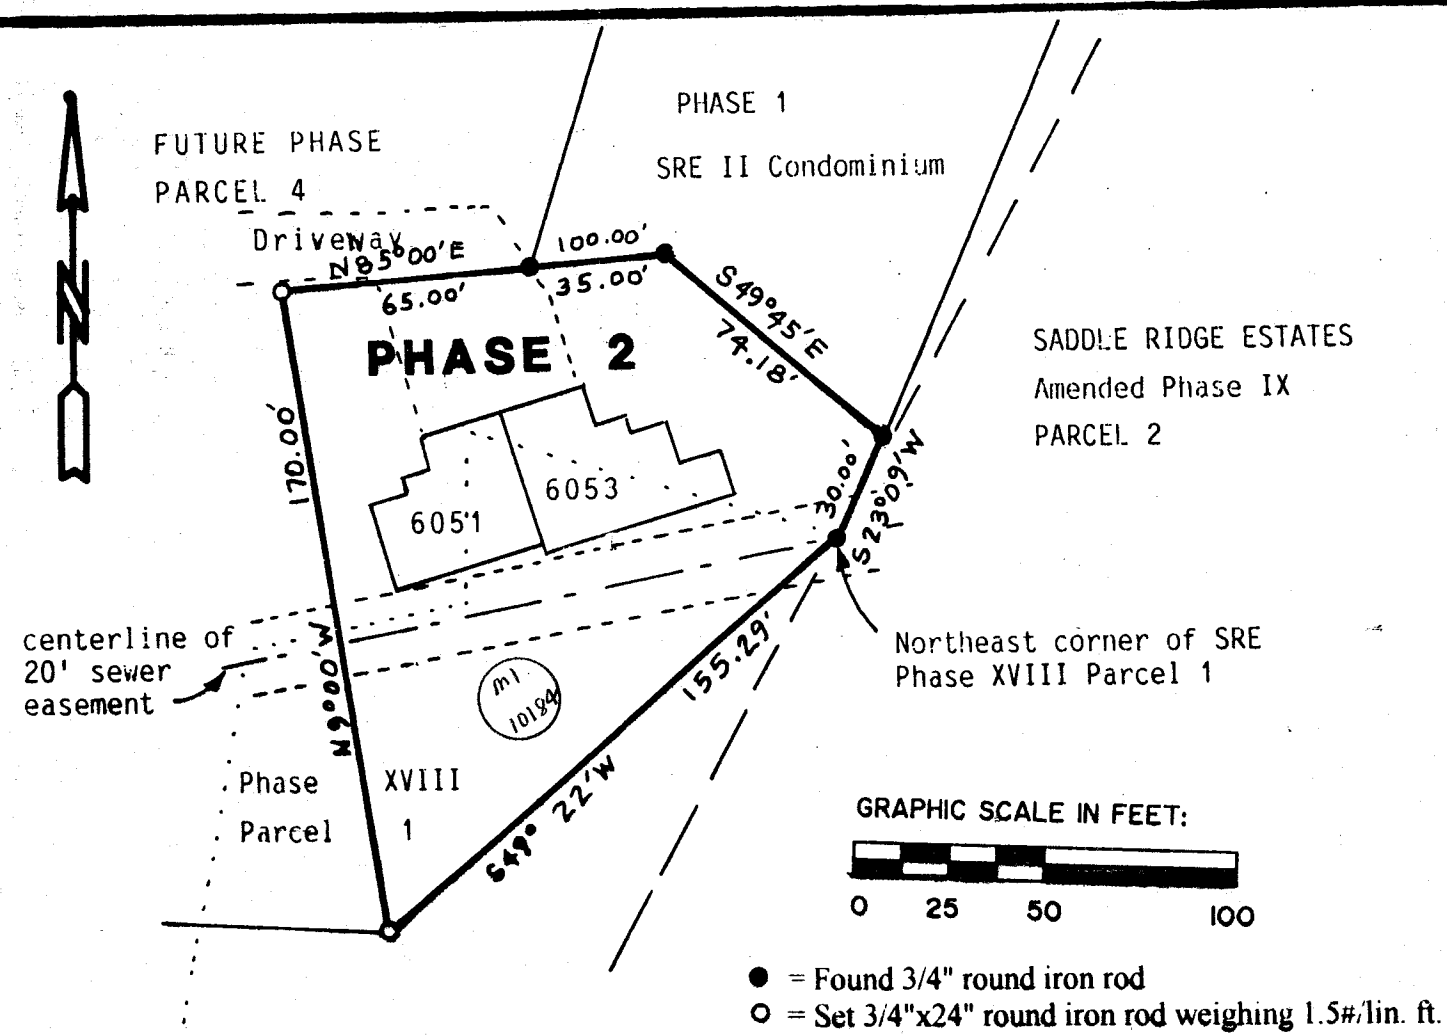


STATE OF WISCONSIN
COLUMBIA COUNTY
RECEIVED FOR RECORD

MAR 12 2001

Garry Jull
Reg. of Deeds at 8:00 AM
Vol 2 Page 19

633001

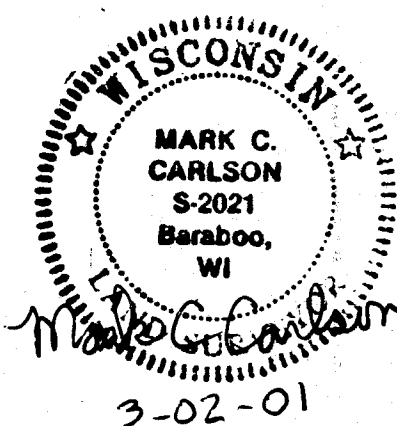

SRE II COND PHASE 2 COLUMBIA CO

Replaced
2004

PHASE 2 DESCRIPTION:

A parcel of land located in NE1/4-NW1/4, Section 1, T12N, R9E, Town of Park County, Wisconsin bounded by the following described line:

Beginning at the northeast corner of Phase XVIII, Parcel 1, Saddle Ridge Estates, Wisconsin; thence S49°22'W, 155.29 feet; thence N9°00'W, 170.00 feet; thence N85°00'E, S49°45'E, 74.18 feet; thence S23°09'W, 30.00 feet to point of beginning.

Described parcel contains 16,260 square feet and benefits from existing access Saddle Ridge Estates Condominium.


Client: The Saddle Ridge Corporation, 100 Saddle Ridge, Portage, WI, 53901

Carlson Surveying Inc., 1709 Ash Street, Baraboo, WI, 53913

I, Mark C. Carlson, registered land surveyor, hereby certify that I have surveyed this parcel, that this plat is a correct representation of the exterior boundaries of the location of buildings and driveways constructed or to be constructed as per hereof and the identification and location of each unit and common elements


Bearings are referenced to Saddle Ridge Condominium.

I, Mark C. Carlson, registered land surveyor, hereby certify that the drawings are an accurate copy of portions of the plans of each building and substantially the numbers and dimensions of the buildings and units located and erected or to be

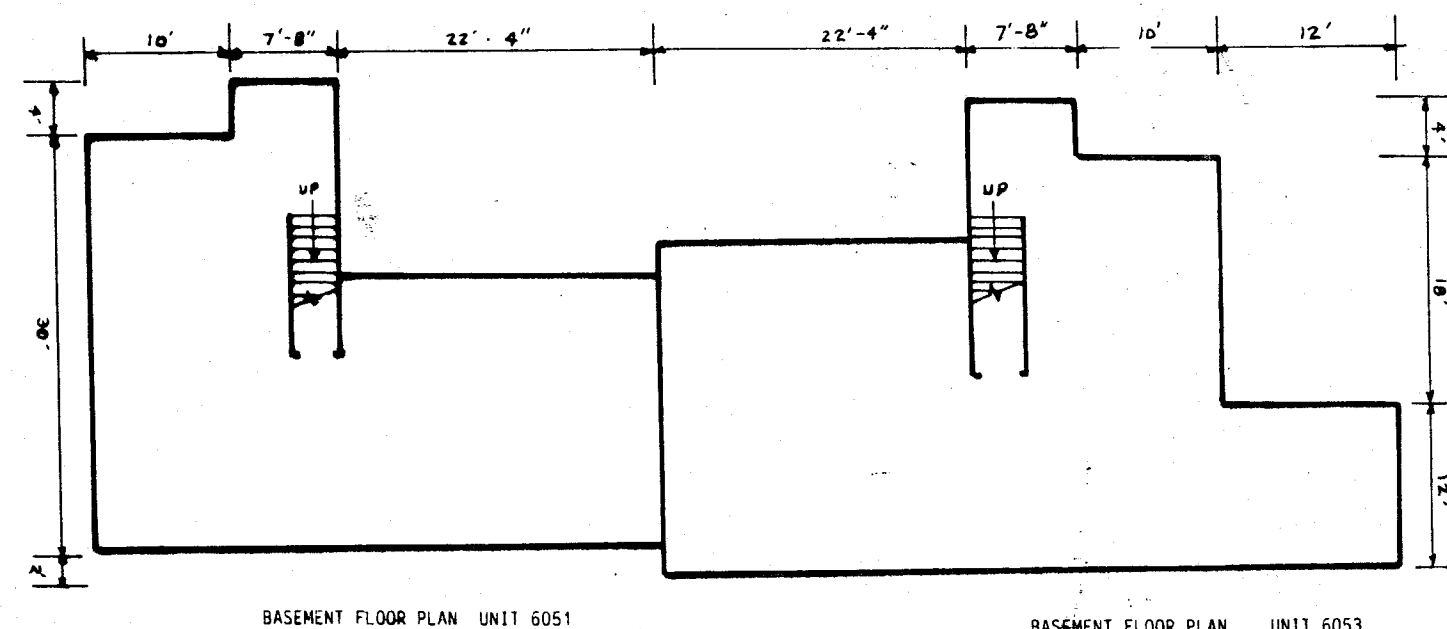


BASEMENT FLOOR PLAN UNIT 6051


BASEMENT FLOOR PLAN UNIT 6053

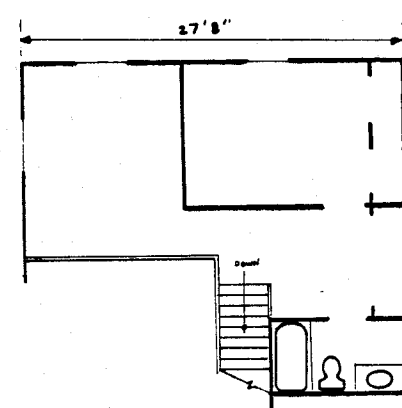

SECOND FLOOR PLAN
UNIT 6051

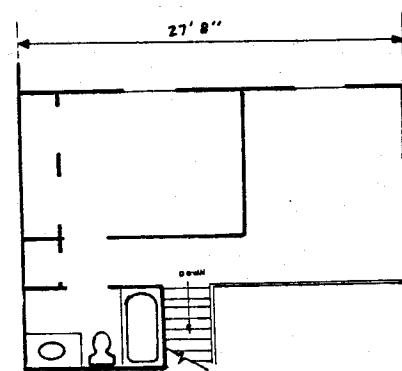

SECOND FLOOR PLAN
UNIT 6053

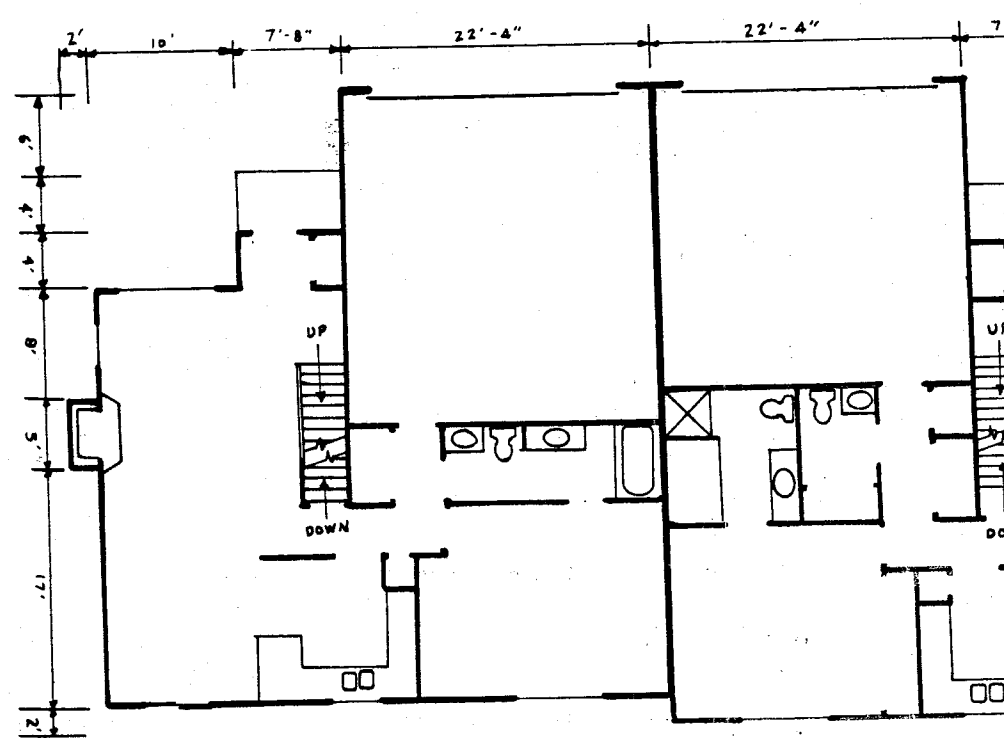


FIRST FLOOR PLAN UNIT 6051

FIRST FLOOR PLAN UNIT 6053

off 56.01
new
Unit 6051 - 1400.6051
Unit 6053 - 1400.6053

GOLF COURSE

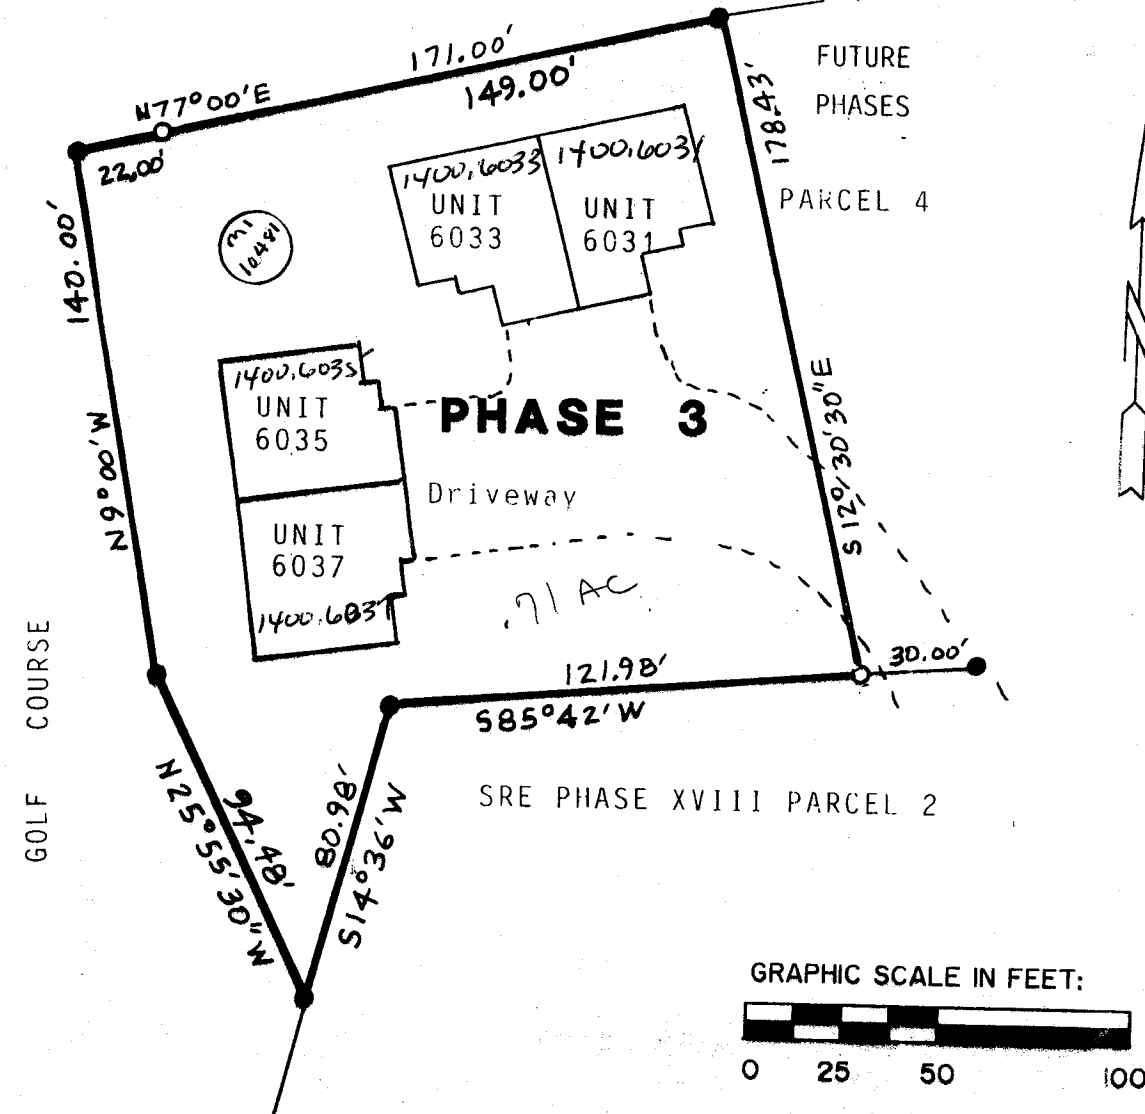

PHASE 3 DESCRIPTION:

A parcel of land located in NE1/4-NW1/4, Section 1, T12N, R9E, Town of Pacific, Columbia County, Wisconsin bounded by the following described line:

Beginning at the northwest corner of FUTURE PHASES, Parcel 4, SRE II Condominium; thence N77°00'E, 171.00 feet; thence S12°30'30"E, 178.43 feet; thence S85°42'W, 121.98 feet; thence S14°36'W, 80.98 feet; thence N25°55'30"W, 94.48 feet; thence N9°00'W, 140.00 feet to point of beginning.

Described parcel contains 31,130 square feet and benefits from existing access road easements for Saddle Ridge Condominium.

Bearings are referenced to Saddle Ridge Condominium and Saddle Ridge Estates Condominium.

I, Mark C. Carlson, registered land surveyor, hereby certify that I have surveyed the above described parcels, that this plat is a correct representation of the exterior boundaries of the parcels described and the location of buildings and driveways constructed or to be constructed as proposed at the date hereof and the identification and location of each unit and common elements to be determined.

I, Mark C. Carlson, registered land surveyor, hereby certify that the drawings appearing hereon are an accurate copy of portions of the plans of each building and substantially depict the layout, unit numbers and dimensions of the buildings and units located and erected or to be erected.

641143

STATE OF WISCONSIN } SS
COLUMBIA COUNTY
RECEIVED FOR RECORD

AUG 3 2001




Danny Jull
Reg. of Deeds at 9:55AM
Vol 2 Page 29

SRE II CONDOMINIUM PHASE 3 COLUMBIA COUNTY, WISCONSIN

Client: The Saddle Ridge Corporation, 100 Saddle Ridge, Portage, WI, 53901

Carlson Surveying Inc., 1709 Ash Street, Baraboo, WI, 53913

Replaced
2004

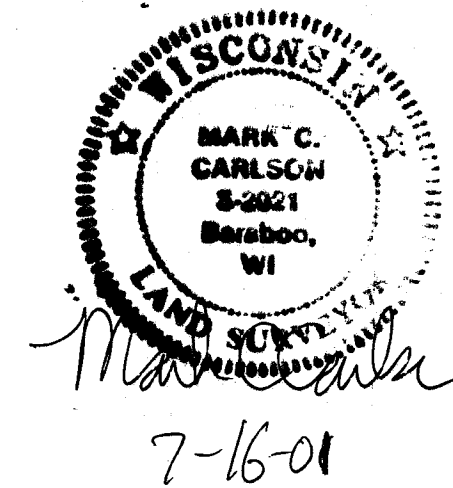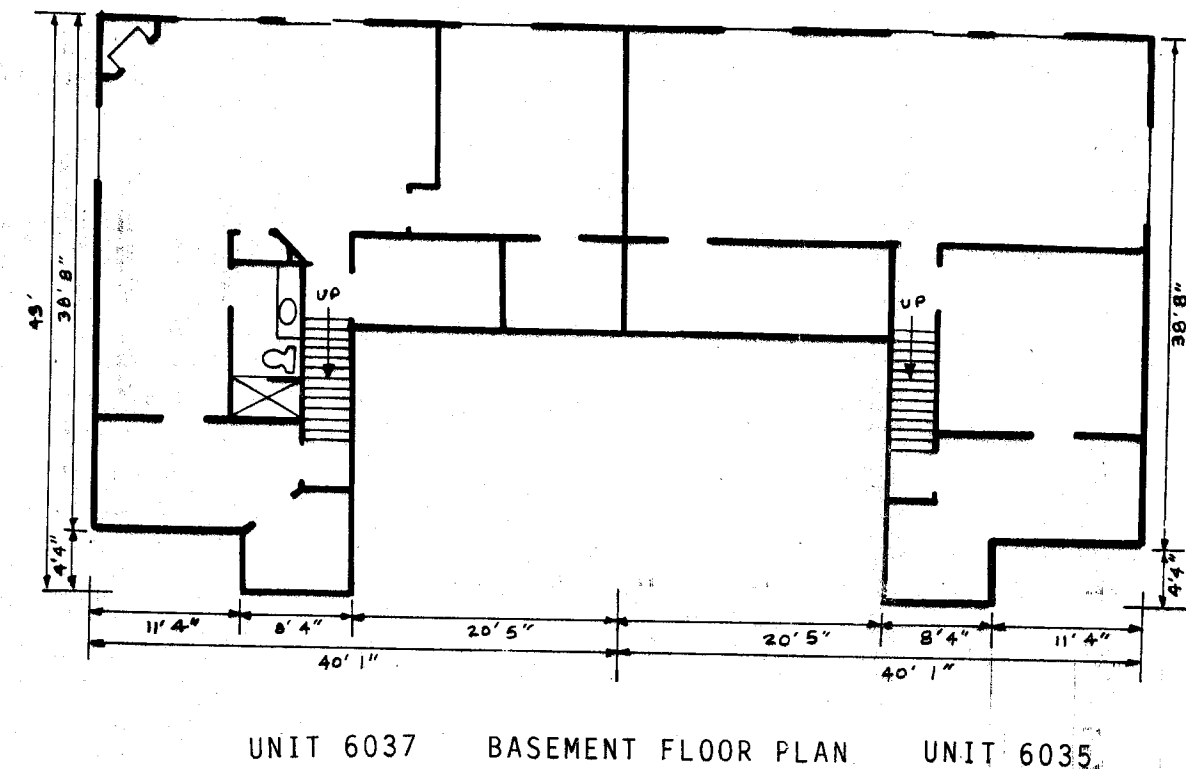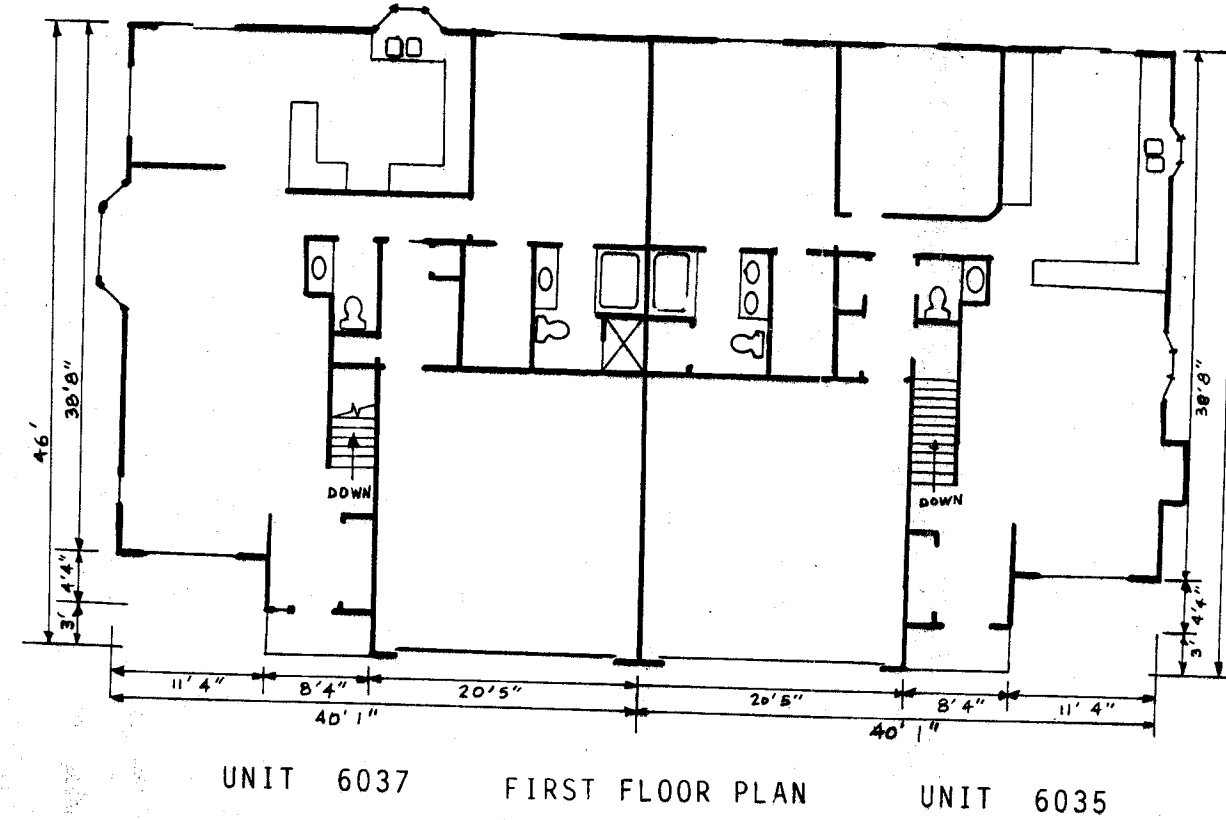

SRE II
Condominium Plat
Sheet 1 of 2 sheets

pt of 56.01 (~~3.275~~) - deleted & created 56.011 (3.275 Ac)
new 1400.6031 - unit 6031
1400.6033 - unit 6033
1400.6035 - unit 6035
1400.6037 - unit 6037

Sum of Pacific
See 1-12-9
new
1400.6031
1400.6033
1400.6035
1400.6037


657669

SRE II CONDOMINIUM AMENDED PHASE 3 COLUMBIA COUNTY, WISCONSIN



Client: The Saddle Ridge Corporation, 100 Saddle Ridge, Portage, WI, 53901

Carlson Surveying Inc., 1709 Ash Street, Baraboo, WI, 53913

GOLF COURSE

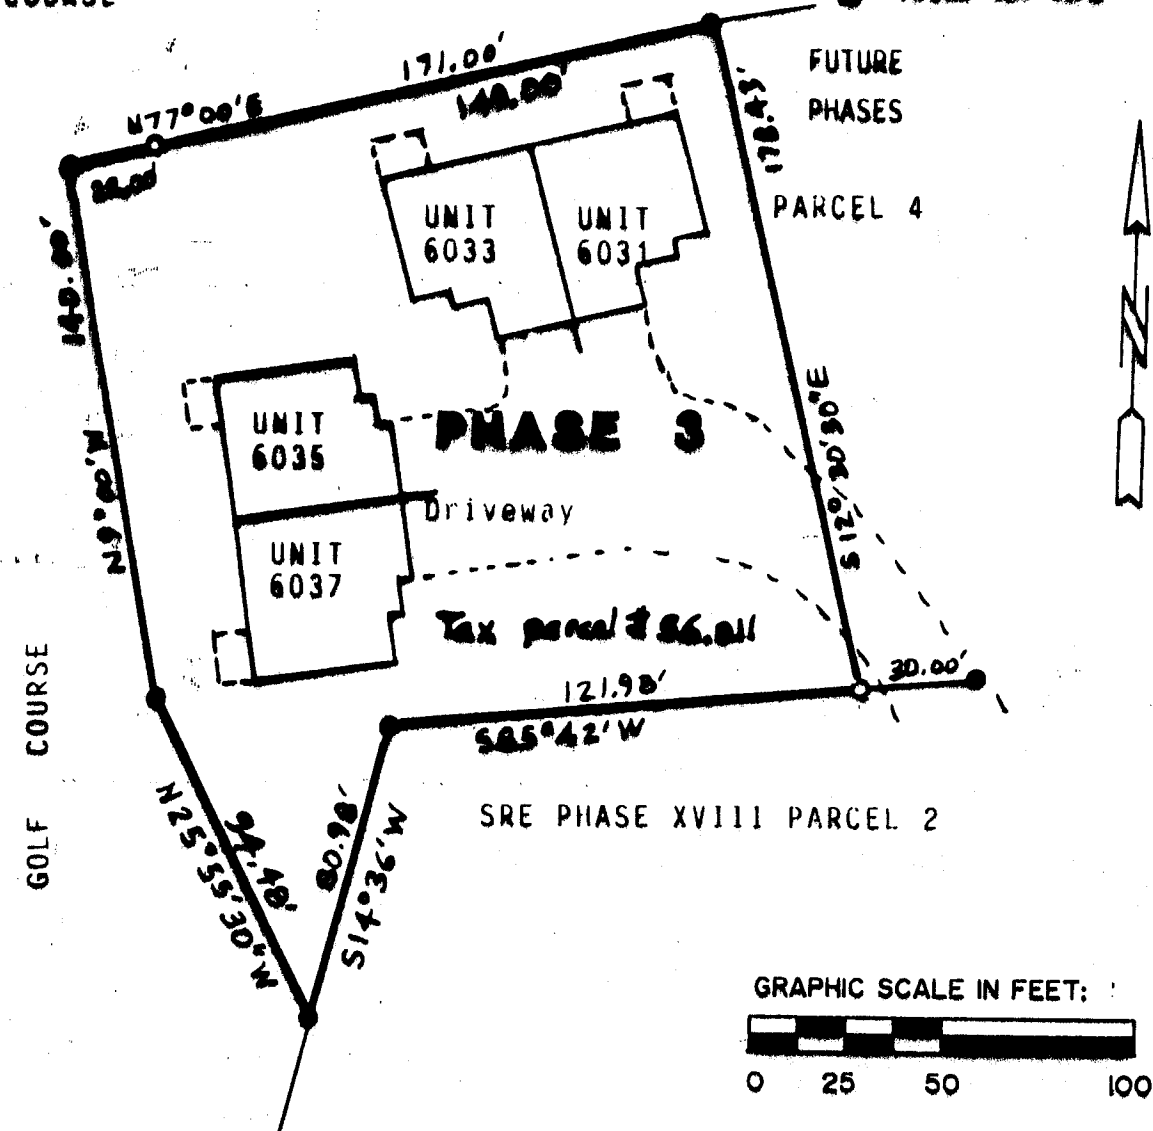

- FOUND 1 1/4" IRON ROD
- FOUND 3/4" ROUND IRON ROD
- FOUND GOVERNMENT CORNER
- FOUND DOT CAP
- SET 3/4"x24" BOUND IRON ROD
- FOUND 3/4" R/S

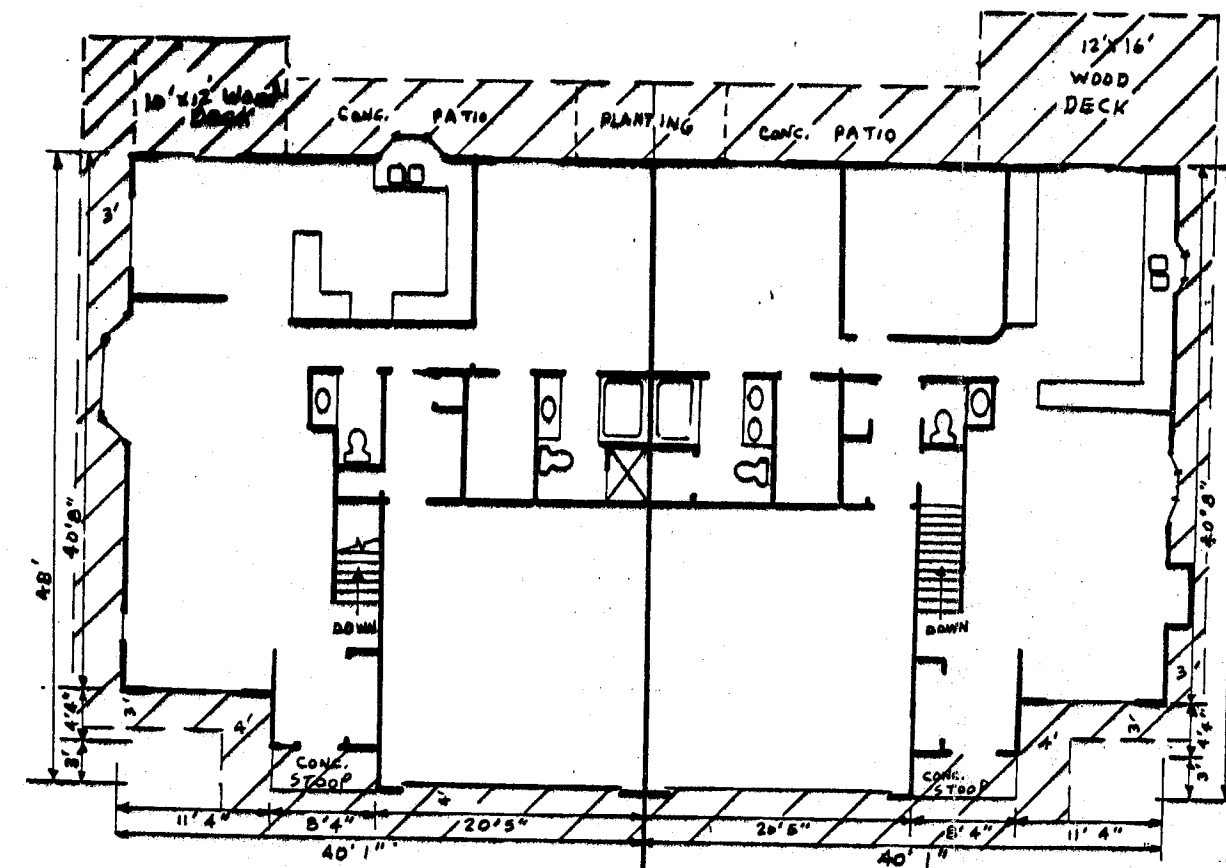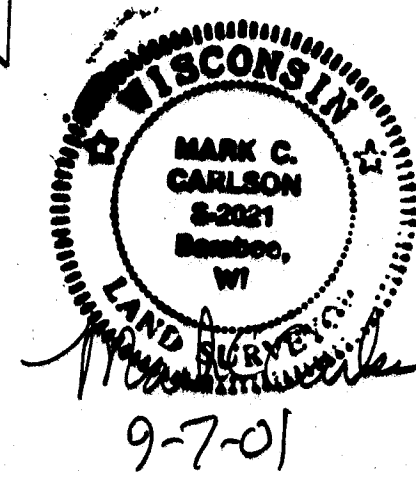Replaced
2004

= Limited Common Area


PHASE 3 DESCRIPTION:

A parcel of land located in NE1/4-NW1/4, Section 1, T12N, R9E, Town of Pacific, Columbia County, Wisconsin bounded by the following described line:
Beginning at the northwest corner of FUTURE PHASES, Parcel 4, SRE II Condominium; thence N77°00'E, 171.00 feet; thence S12°30'30"E, 178.43 feet; thence S85°42'W, 121.98 feet; thence S14°36'W, 80.98 feet; thence N25°55'30"W, 94.48 feet; thence N9°00'W, 140.00 feet to point of beginning.
Described parcel contains 31,130 square feet and benefits from existing access road easements for Saddle Ridge Condominium.

Bearings are referenced to Saddle Ridge Condominium and Saddle Ridge Estates Condominium.

I, Mark C. Carlson, registered land surveyor, hereby certify that I have surveyed the above described parcels, that this plat is a correct representation of the exterior boundaries of the parcels described and the location of buildings and driveways constructed or to be constructed as proposed at the date hereof and the identification and location of each unit and common elements to be determined.

I, Mark C. Carlson, registered land surveyor, hereby certify that the drawings appearing hereon are an accurate copy of portions of the plans of each building and substantially depict the layout, unit numbers and dimensions of the buildings and units located and erected or to be erected.

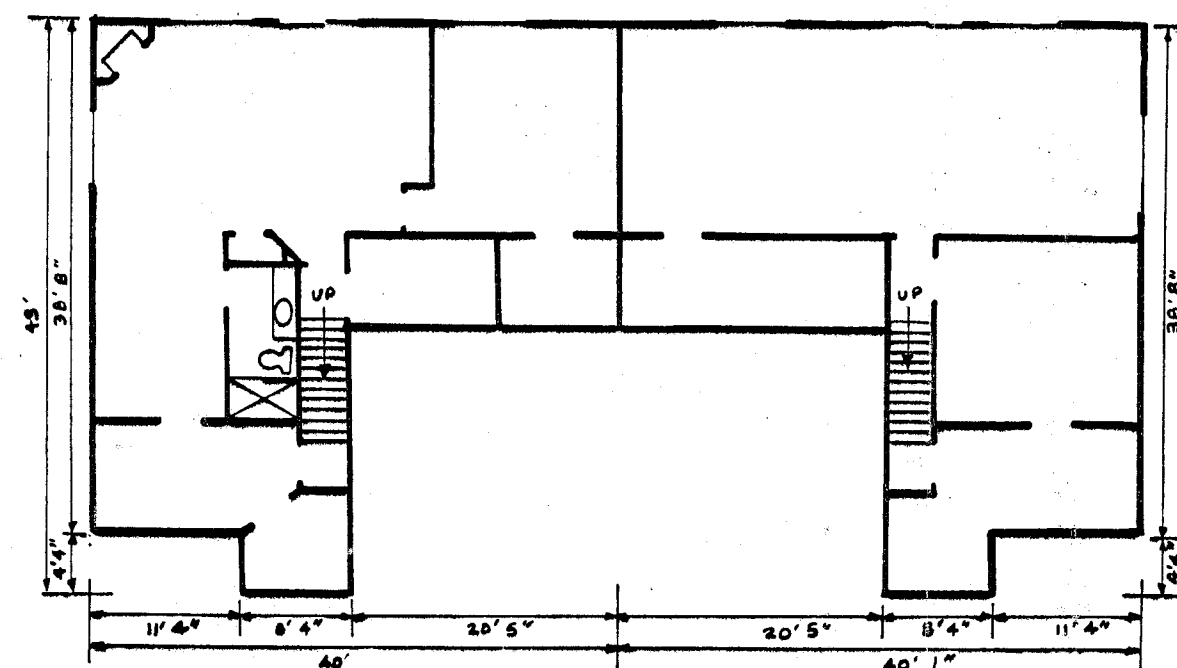

STATE OF WISCONSIN } SS
COLUMBIA COUNTY
RECEIVED FOR RECORD

May 9 2002
Denny Judd
Reg. of Deeds at 8:00AM
Vol 2 Page 35

SRE II
Condominium Plat
Sheet 1 of 2 sheets

Unit-6031 — 1400.6031
Unit-6037 — 1400.6033
Unit-6035 — 1400.6035
Unit-6037 — 1400.6037


Amended - Add decks

01.0662

661467

**SRE II CONDOMINIUM
PHASE 4
COLUMBIA COUNTY, WISCONSIN**

Replaced
2004

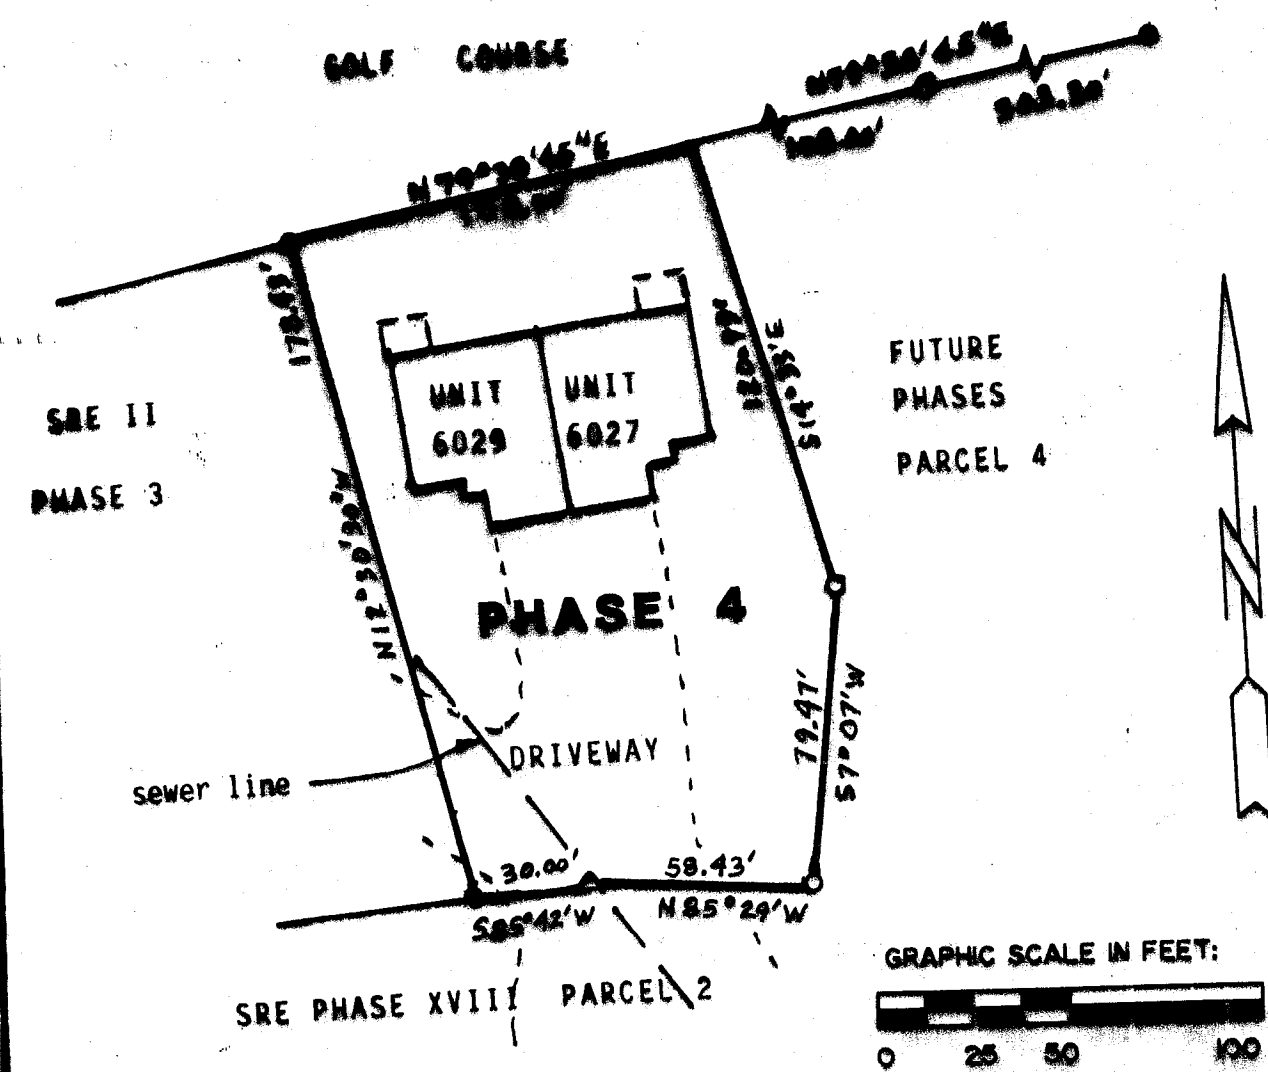


- = Found 3/4" iron rod
- ▲ = Set PK nail in blacktop
- = Set 1/2"x24" round iron rod weighing 1.5#/lin. Ft

Bearings are referenced to Saddle Ridge Estates Condominium.


PHASE 4 DESCRIPTION:
A parcel of land located in NE1/4-NW1/4, Section 1, T12N, R9E, Town of Pacific, Columbia County, Wisconsin bounded by the following described line:
Beginning at the southeast corner of PHASE 3, SRE II Condominium; thence N12°30'30"W along east line of said PHASE 3, 178.43 feet to northeast corner of said PHASE 3; thence N79°38'45"E, 108.00 feet; thence S14°33'E, 120.99 feet; thence S7°07'W, 79.47 feet; thence N85°29'W, 58.43 feet; thence S85°42'W, 30.00 feet to point of beginning.
Described parcel contains 19,888 square feet and benefits from existing access road easements for Saddle Ridge Estates Condominium.

I, Mark C. Carlson, registered land surveyor, hereby certify that I have surveyed the above described parcel, that this plot is a correct representation of the exterior boundaries of the parcel described and the location of buildings and driveways constructed or to be constructed as proposed at the date hereof and the identification and location of each unit and common areas can be determined.

Client: The Saddle Ridge Corporation, 100 Saddle Ridge, Portage, WI, 53901
Carlson Surveying Inc., 1700 Ash Street, Racine, WI, 53413

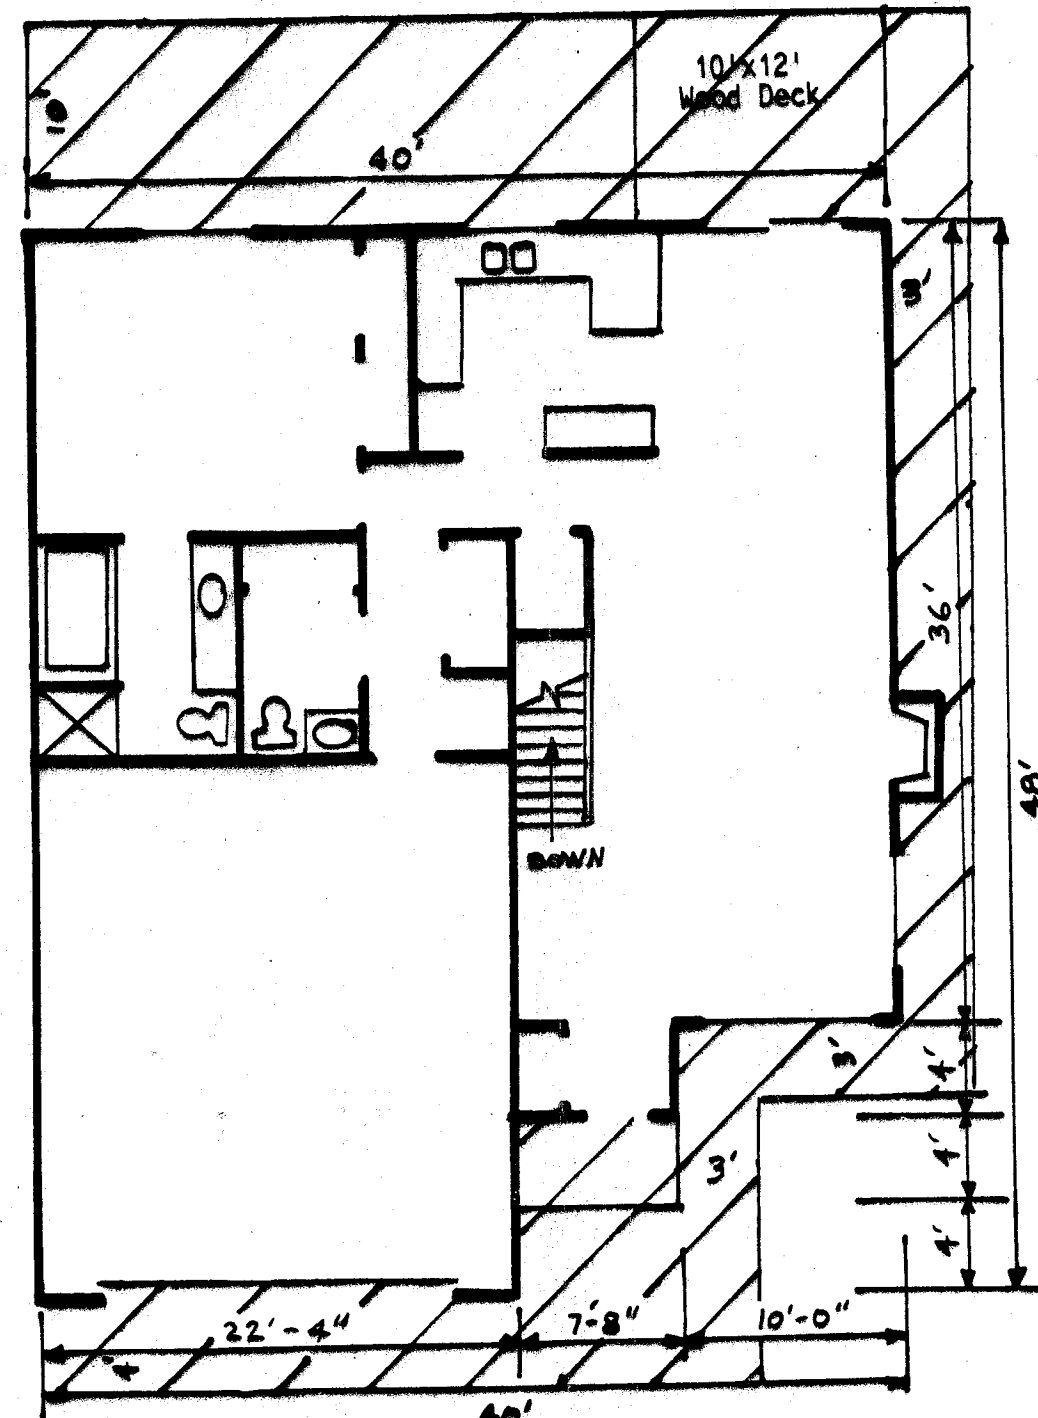

UNIT 6027
FIRST FLOOR PLAN

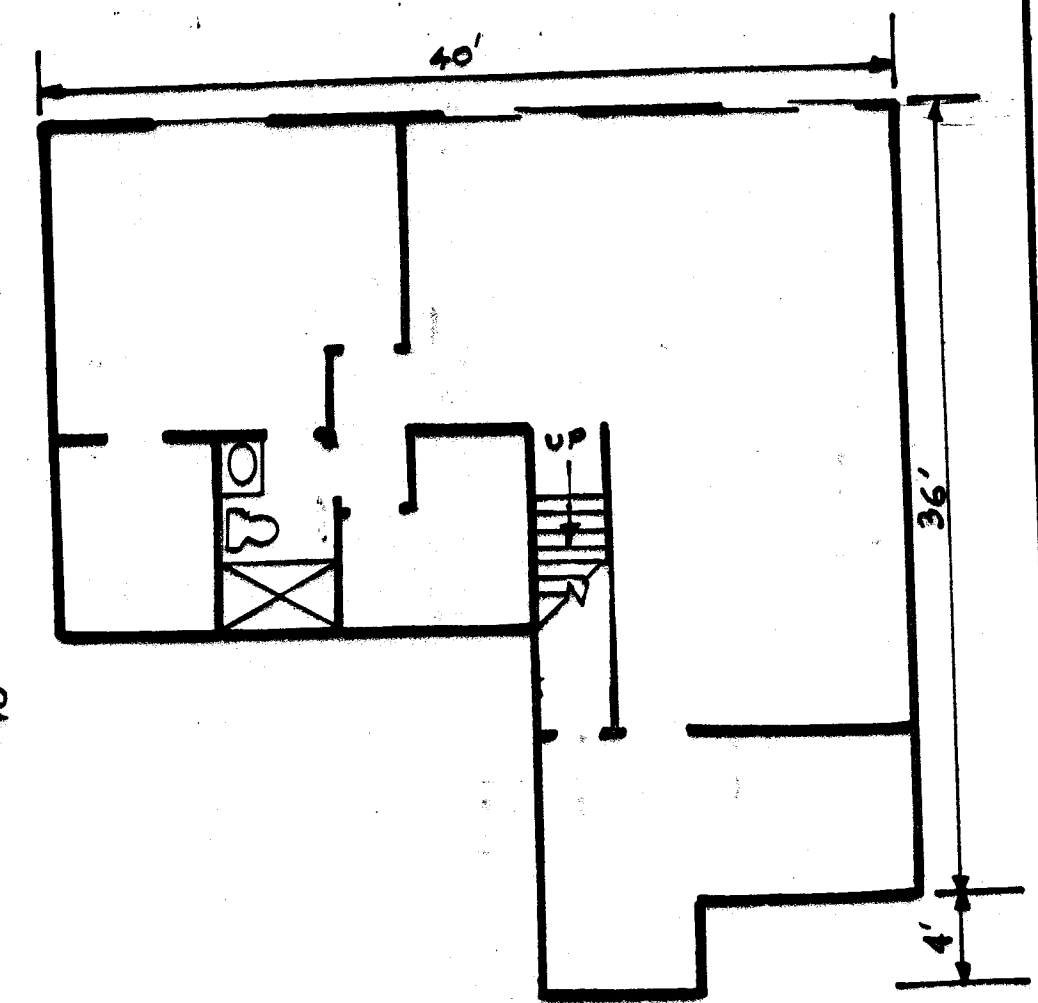

UNIT 6027
BASEMENT FLOOR PLAN

Unit 6029 is mirror image of Unit 6027.

= Limited common area

STATE OF WISCONSIN
COUNTY OF COLUMBIA
RECORDED
JUL 1 1992
By *[Signature]*
Notary Public
Vol. A Page 40

[Signature]
6-26-02


I, Mark C. Carlson, registered land surveyor, hereby certify that the drawing appearing hereon are an accurate copy of portions of the plans of each building and substantially depict the layout, unit numbers and dimensions of the buildings and units located and erected or to be erected.

SRE II
PHASE 4
Condominium Plat
Sheet 1 of 1 sheet

0010733

56.011
now
56.03

1400.6027
1400.6029

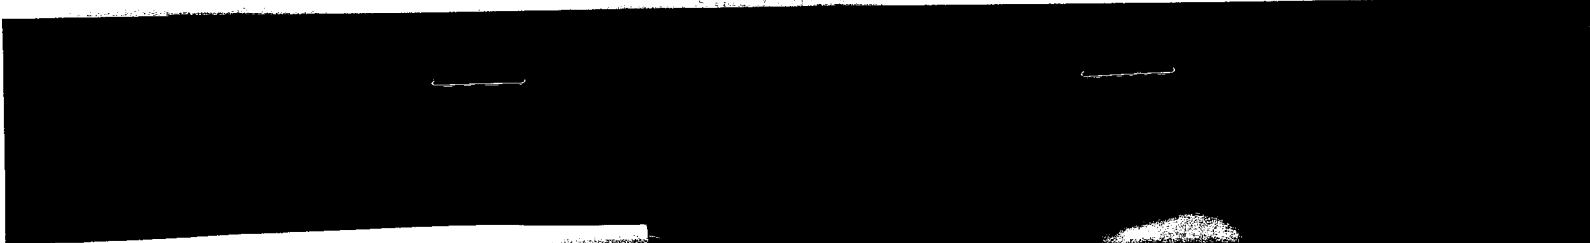

SRE II CONDOMINIUM
PHASE 6

COLUMBIA COUNTY, WISCONSIN

Carlson Surveying, Inc. 1709 Ash St., Baraboo, WI, 53913
Phone & FAX (608) 356-8598

Saddle Ridge Corporation
100 Saddle Ridge
Portage, WI, 53901

Replaced
2004

PHASE 6 DESCRIPTION:
A parcel of land located in NE1/4-NW1/4, Section 1, T12N, R9E, Town of Pacific, Columbia County, Wisconsin bounded by the following described line: Beginning at the northeast corner of PHASE 4, SRE II Condominium; thence N79°38'45"E, 108.00 feet; thence S11°14'E, 106.36 feet; thence S71°34'W, 101.78 feet; thence N14°33'W, 120.99 feet to point of beginning. Described parcel contains 0.27 acres and is subject to easements of record. Parcel has benefit of Access Road Easements A through E as described in Phases of Saddle Ridge Condominium and Access Road Easement (F) as described in the Forest at Swan Lake Village Condominium plat.

I, Mark C. Carlson, registered land surveyor, hereby certify that I have surveyed the above described parcel, that this plat is a correct representation of the exterior boundaries of the parcel described and the location of buildings and driveways constructed or to be constructed as proposed at the date hereof and the identification and location of each unit and common elements to be determined.

- = Found 3/4" round iron rod
- = Set 3/4"x24" round iron rod weighing 1.5#/lin. ft.

Bearings are referenced to Saddle Ridge Condominium.

Town of Pacific
PRT 56.03
now 56.04

STATE OF WISCONSIN } ss
COLUMBIA COUNTY
RECEIVED FOR RECORD

OCT 28 2003

Denny J. Hall
Reg of Deeds at 8:00 AM

Vol 2 Page 61

012185

SRE II
Phase 6
Sheet 1 of 2 sheets

SRE II
PL

Mark C. Carlson
Surveyor
Wisconsin

SECTION	TOWN	RANGE	BLOCK	WARD	OF	PARCEL NO.	DESCRIPTION	ACERAGE OR LOT NO.	NAME	NAME	NAME
---------	------	-------	-------	------	----	------------	-------------	--------------------	------	------	------

Swan Lake Village Condominium
Town of Pacific

Plat G.L. 4 Sec. 1-12-9 3-30 A

1987 Assessment Roll
Y. 1 Condo Plots P. 129
Revised 2-24-86

Swan
Lake

904 - 909

447468



SURVEYORS CERTIFICATE:


I, Kenneth G. Carlson, registered land surveyor, hereby certify that this plat is a correct representation of the condominium described and the identification and location of each unit and the common elements can be determined from the plat.

Date Dec 11, 1985 Kenneth G. Carlson
Kenneth G. Carlson

Access Road Easement Description:

A parcel of land in NW1/4-NW1/4, SW1/4-NW1/4, Government Lot 4, Section 1 and NE1/4-SE1/4, Section 2, all T12N, R9E, Town of Pacific, Columbia County, Wisconsin bounded by the following described line: Commencing at the northwest corner of said Section 1; thence N89°50'14"E along the section line, 389.88 feet to the point of beginning; thence continuing N89°50'14"E along the section line, 273.54 feet; thence S0°05'15"E, 34.85 feet; thence S51°14'W, 42.96 feet; thence S45°10'W, 80.61 feet; thence southwesterly on a curve to the right, radius 166.00 feet, whose chord bears S45°05'W, 234.42 feet; thence West, 155.19 feet; thence southwesterly on a curve to the left, radius 125.00 feet, whose chord bears S44°57'23"W, 176.91 feet; thence S0°05'15"E, 471.23 feet; thence southeasterly on a curve to the left, radius 125.00 feet, whose chord bears S30°47'38"E, 127.66 feet; thence S61°30'E, 170.91 feet; thence southeasterly on a curve to the right, radius 188.00 feet, whose chord bears S29°13'39"E, 200.76 feet; thence S3°00'W, 246.00 feet; thence southwesterly on a curve to the right, radius 300.00 feet, whose chord bears S17°00'W, 145.15 feet; thence S31°00'W, 389.85 feet; thence southwesterly on a curve to the left, radius 679.45 feet, whose chord bears S25°15'W, 136.14 feet; thence S19°30'W, 391.29 feet; thence S1°15'W, 429.71 feet; thence S17°26'W, 304.98 feet; thence S2°00'E, 277.99 feet; thence southeasterly on a curve to the left, radius 355.00 feet, whose chord bears S43°40'E, 476.00 feet; thence southeasterly on a curve to the right, radius 716.00 feet, whose chord bears S67°46'E, 442.51 feet; thence southeasterly on a curve to the left, radius 410.00 feet, whose chord bears S61°46'E, 170.49 feet; thence southeasterly on a curve to the right, radius 190.00 feet, whose chord bears S28°21'E, 270.65 feet; thence S17°04'W, 96.54 feet; thence N72°56'W, 66.00 feet; thence N17°04'E, 96.54 feet; thence northwesterly on a curve to the left, radius 124.00 feet, whose chord bears N28°21'W, 176.63 feet; thence northwesterly on a curve to the right, radius 476.00 feet, whose chord bears N61°46'W, 197.93 feet; thence northwesterly on a curve to the left, radius 650.00 feet, whose chord bears N67°46'W, 401.72 feet; thence northwesterly on a curve to the right, radius 421.00 feet, whose chord bears N43°40'W, 564.51 feet; thence N2°00'W, 288.97 feet; thence N17°26'E, 306.73 feet; thence N1°15'E, 430.86 feet; thence N19°30'E, 401.97 feet; thence northeasterly on a curve to the right, radius 745.45 feet, whose chord bears N25°15'E, 149.37 feet; thence N31°00'E, 389.85 feet; thence northeasterly on a curve to the left, radius 234.00 feet, whose chord bears N17°00'E, 113.22 feet; thence N3°00'E, 246.05 feet; thence northwesterly on a curve to the left, radius 122.00 feet, whose chord bears N29°13'39"W, 130.28 feet; thence N61°30'W, 170.91 feet; thence northwesterly on a curve to the right, radius 191.00 feet, whose chord bears N30°47'38"W, 195.06 feet; thence N0°05'15"W, 471.23 feet; thence northeasterly on a curve to the right, radius 191.00 feet, whose chord bears N44°57'23"E, 270.32 feet; thence East, 155.19 feet; thence northeasterly on a curve to the left, radius 100.00 feet, whose chord bears N45°05'E, 141.21 feet; thence N44°50'W, 165.85 feet to the point of beginning.

G.L. 4
SECTION 1

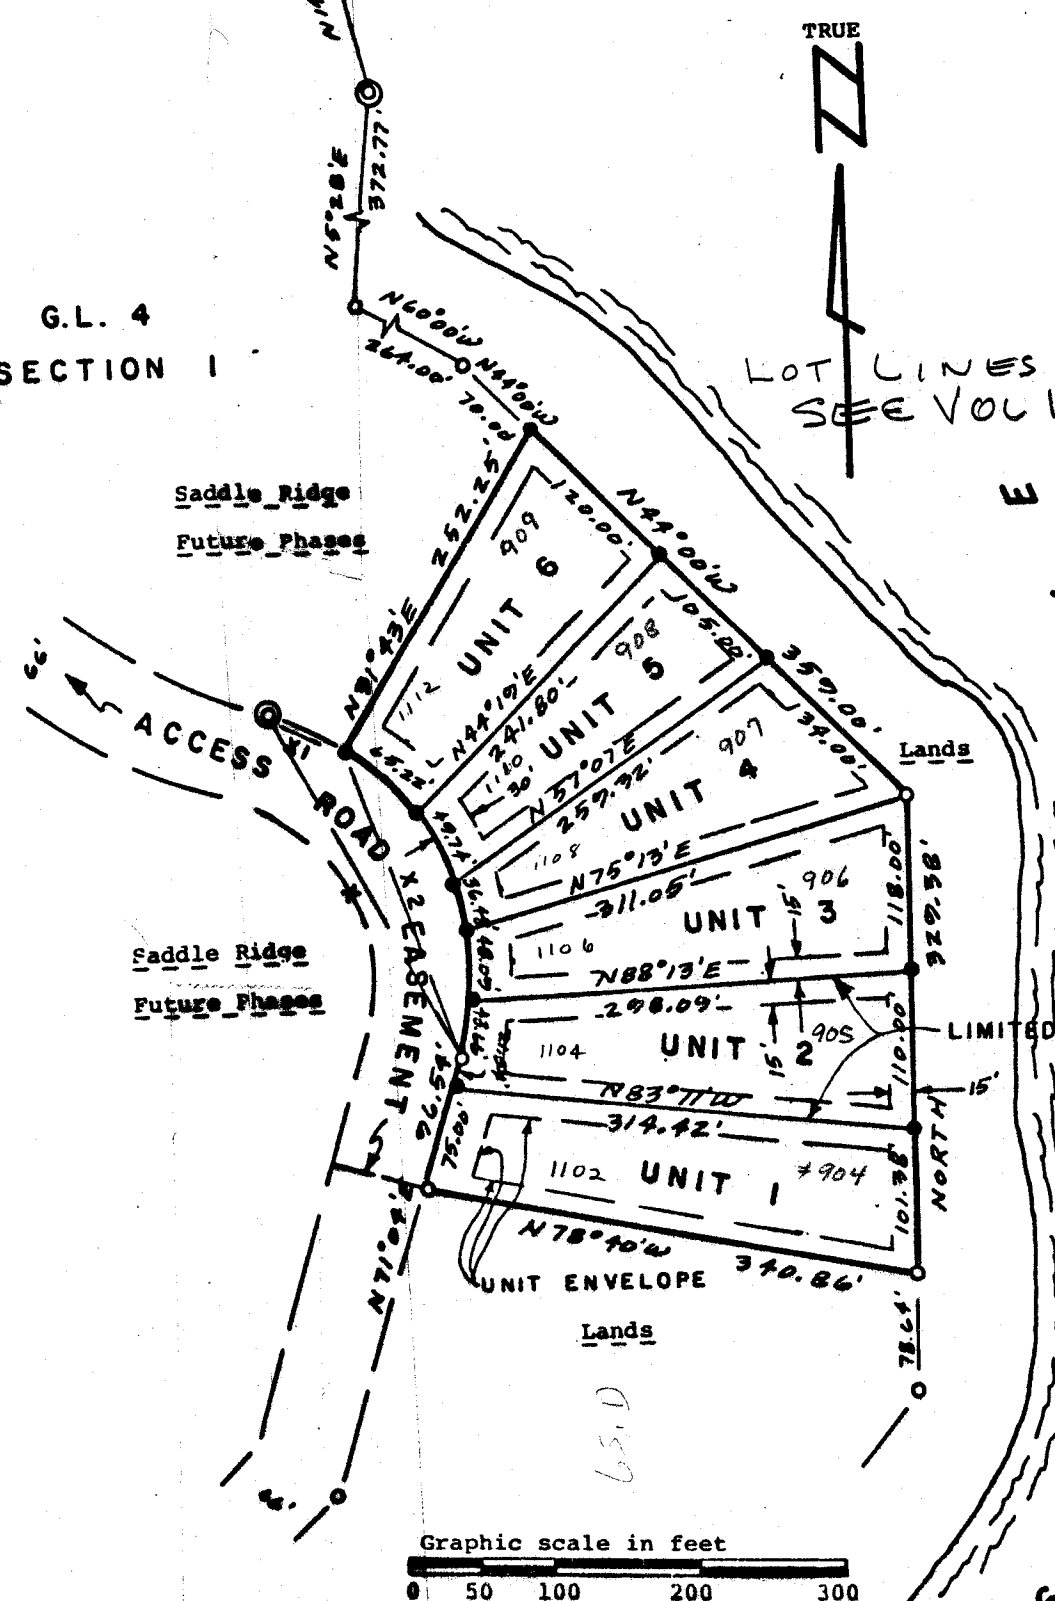

**SWAN LAKE VILLAGE C
COLUMBIA COUNTY
CONDOMINIUM P**

This survey describes the land sub:
Condominium Declaration for Swan La
Condominium

Replaced
2004

Curve	Lot	Radius	Central Angle	Chord Bearing
X		190'	90°50'	N28°21'W
X1			17°30'	N65°01'W
X2			79°20'	N19°36'W
	6		19°40'	N46°26'W
	5		15°00'	N29°06'W
	4		11°00'	N16°06'W
	3		14°30'	N3°21'W
	2		13°10'	N10°30'E

Description-

A parcel of land located in Government Lot 4, Town of Pacific, Columbia County, Wisconsin described line:

Commencing at the northwest corner of said Section 1 along the section line, 2889.19 feet; thence S77°30'E, 151.00 feet; thence S85°00'E, 151.00 feet; thence S5°28'W, 372.77 feet; thence S44°00'E, 70.00 feet to the point of beginning; thence S44°00'E, 359.00 feet; thence South, 226.92 feet; thence N31°43'E, 252.25 feet to the point of beginning.

Said parcel contains 143,980 square feet or

NOTE: Limited Common Elements - All laws and elements boundary lines not occupied by limited common elements appurtenant to

Bearing, are
Condominium
1 bears N0°0

447468

STATE OF WISCONSIN
COLUMBIA COUNTY

Received for record the...

Day of February... A.D. 1986

at 11:30 o'clock A.M. and recorded

in Vol. 1... of Records Page 129

Marian Robinson

Register of Deeds

Ground
Ground
at 3
high

476946



Found Aluminium Monument.
Northwest corner Section 1.

Replaced
2004

SURVEYORS CERTIFICATE:

I, Kenneth G. Carlson, registered land surveyor, hereby certify that this plat is a correct representation of the condominiums described and the identification of each unit envelope and the common elements can be determined from the plat.


Date Aug 10, 1989 Kenneth G. Carlson
Kenneth G. Carlson

ACCESS ROAD EASEMENT (C) DESCRIPTION

Access Road Easement Description:

A parcel of land in NW1/4-NW1/4, SW1/4-NW1/4, Government Lot 4, Section 1 and NE1/4-SE1/4, SE1/4-NE1/4, Section 2, all T12N, R9E, Town of Pacific, Columbia County, Wisconsin bounded by the following described line: Commencing at the northwest corner of said Section 1; thence N89°50'14"E along the section line, 389.88 feet to the point of beginning; thence continuing N89°50'14"E along the section line, 273.54 feet; thence S0°05'15"E, 34.85 feet; thence S51°14'W, 42.96 feet; thence S45°10'W, 80.61 feet; thence southwesterly on a curve to the right, radius 166.00 feet, whose chord bears S45°05'W, 234.42 feet; thence West, 155.19 feet; thence southwesterly on a curve to the left, radius 125.00 feet, whose chord bears S44°57'23"W, 176.91 feet; thence S0°05'15"E, 471.23 feet; thence southeasterly on a curve to the left, radius 125.00 feet, whose chord bears S30°47'38"E, 127.66 feet; thence S61°30'E, 170.91 feet; thence southeasterly on a curve to the right, radius 188.00 feet, whose chord bears S29°13'39"E, 200.76 feet; thence S3°00'W, 246.00 feet; thence southwesterly on a curve to the right, radius 300.00 feet, whose chord bears S17°00'W, 145.15 feet; thence S31°00'W, 389.85 feet; thence southwesterly on a curve to the left, radius 679.45 feet, whose chord bears S25°15'W, 136.14 feet; thence S19°30'W, 391.29 feet; thence S1°15'W, 429.71 feet; thence S17°26'W, 304.98 feet; thence S2°00'E, 277.99 feet; thence southeasterly on a curve to the left, radius 355.00 feet, whose chord bears S43°40'E, 476.00 feet; thence southeasterly on a curve to the right, radius 716.00 feet, whose chord bears S67°46'E, 442.51 feet; thence southeasterly on a curve to the left, radius 410.00 feet, whose chord bears S61°46'E, 170.49 feet; thence southeasterly on a curve to the right, radius 190.00 feet, whose chord bears S28°21'E, 270.65 feet; thence S17°04'W, 312.88 feet; thence S45°00'W, 308.22 feet; thence southwesterly on a curve to the right, radius 360 feet, whose chord bears S65°20'W, 250.19 feet; thence northerly on a curve to the right, radius 65 feet, whose chord bears N1°07'E, 127.56 feet; thence northeasterly on a curve to the left, radius 136 feet, whose chord bears N80°34'E, 158.22 feet; thence N45°00'E, 291.81 feet; thence N17°04'E, 296.45 feet; thence northwesterly on a curve to the left, radius 124.00 feet, whose chord bears N28°21'W, 176.63 feet; thence northwesterly on a curve to the right, radius 476.00 feet, whose chord bears N61°46'W, 197.93 feet; thence northwesterly on a curve to the left, radius 650.00 feet, whose chord bears N67°46'W, 401.72 feet; thence northwesterly on a curve to the right, radius 421.00 feet, whose chord bears N43°40'W, 504.51 feet; thence N2°00'W, 288.97 feet; thence N17°26'E, 306.73 feet; thence N1°15'E, 430.86 feet; thence N19°30'E, 401.97 feet; thence northeasterly on a curve to the right, radius 745.45 feet, whose chord bears N25°15'E, 149.37 feet; thence N31°00'E, 389.85 feet; thence northeasterly on a curve to the left, radius 234.00 feet, whose chord bears N17°00'E, 113.22 feet; thence N3°00'E, 246.05 feet; thence northwesterly on a curve to the left, radius 122.00 feet, whose chord bears N29°13'39"W, 130.28 feet; thence N61°30'W, 170.91 feet; thence northwesterly on a curve to the right, radius 191.00 feet, whose chord bears N30°47'38"W, 195.06 feet; thence N0°05'15"W, 471.23 feet; thence northeasterly on a curve to the right, radius 191.00 feet, whose chord bears N44°57'23"E, 270.32 feet; thence East, 155.19 feet; thence northeasterly on a curve to the left, radius 100.00 feet, whose chord bears N45°05'E, 141.21 feet; thence N44°50'W, 165.85 feet to the point of beginning.

G.L. 4
SECTION 1

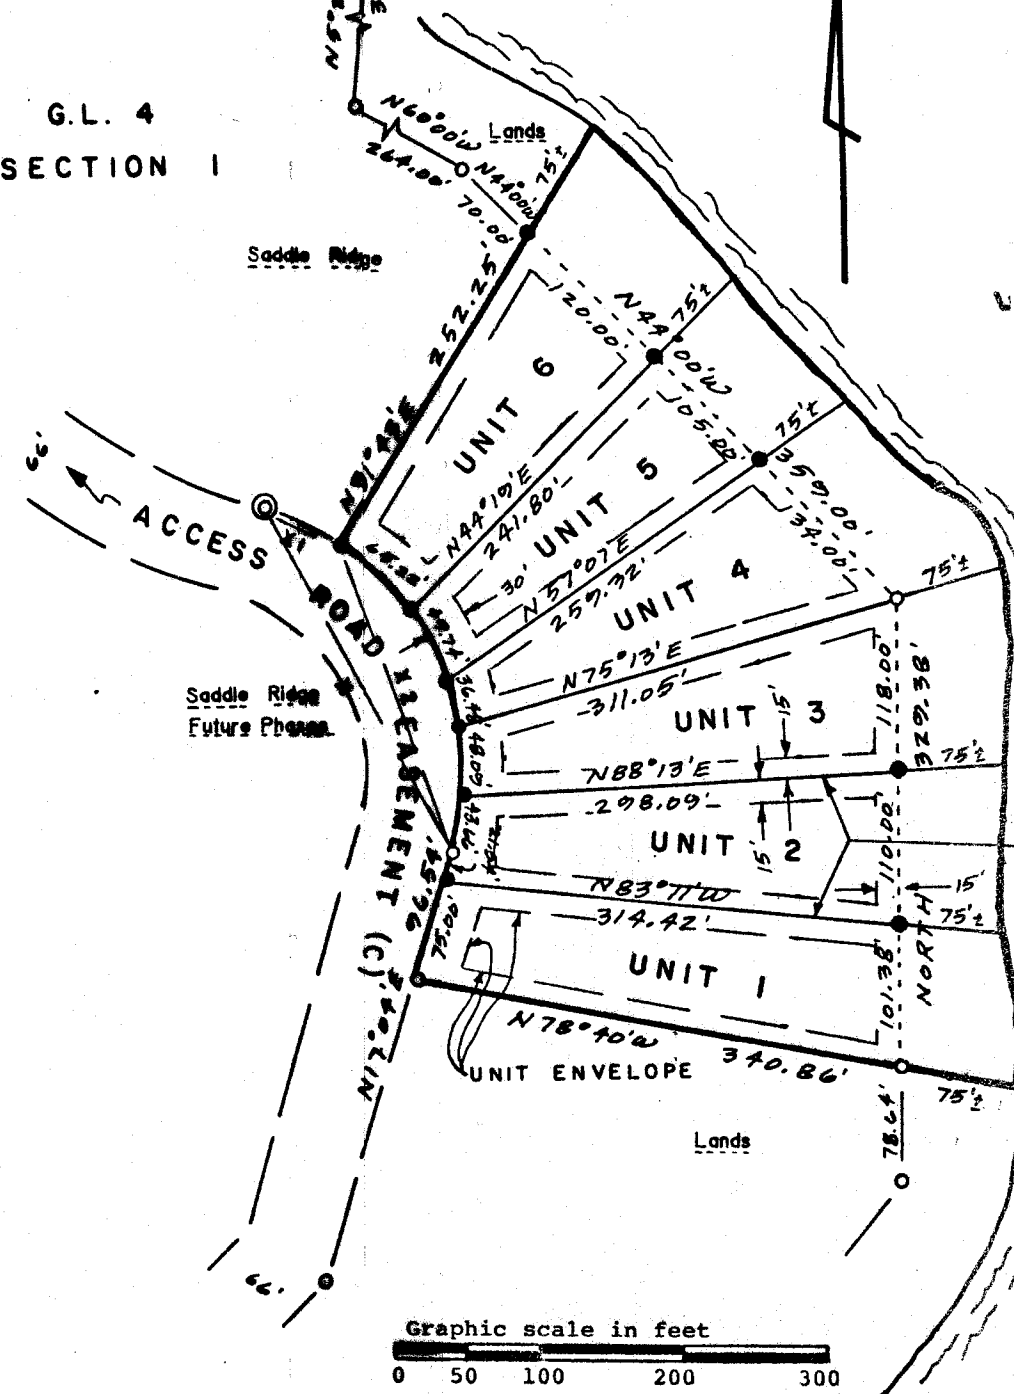

SWAN LAKE


SECOND AMENDMENT

MINIMUM

MINIMUM

Replaced
2004

497540

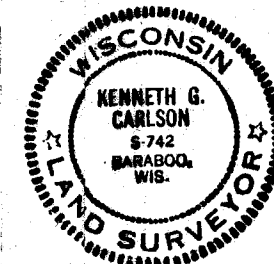

SWAN LAKE VILLAGE CONDOMINIUM COLUMBIA COUNTY SECOND AMENDMENT TO CONDOMINIUM PLAT

SURVEYOR'S CERTIFICATE:

I, Kenneth G. Carlson, registered land surveyor, hereby certify that this plat is a correct representation of the condominiums described and the identification of each unit envelope and the common elements can be determined from the plat.

Date Dec 10, 1991 Kenneth G. Carlson
Kenneth G. Carlson

This survey describes the land subject to the
Condominium Declaration for Swan Lake Village
Condominium

DESCRIPTION UNITS 1-10:

A parcel of land located in Government Lot 4, Section 1, T12N, R9E, Town of Pacific, Columbia County, Wisconsin bounded by the following described line: Commencing at the northwest corner of said Section 1; thence S0°05'15"E, 2889.19 feet; thence N77°30'W, 18.08 feet; thence S77°30'E, 151.00 feet; thence S85°00'E, 520.00 feet; thence S14°00'E, 350.00 feet; thence S5°28'W, 372.77 feet; thence S50°00'E, 264.00 feet; thence S44°00'E, 70.00 feet to point of beginning, also being 75 feet, more or less, from waters edge of Swan Lake; thence along the meander line S14°00'E, 355.00 feet; thence SOUTH, 329.38 feet; thence S45°58'W, 173.13 feet; thence S37°07'W, 181.12 feet; thence S48°20'W, 85.15 feet to end of meander line, also being 135 feet, more or less, from the waters edge of Swan Lake; thence N47°11'W, 199.48 feet; thence N45°00'E, 65.00 feet; thence N17°04'E, 312.88 feet; thence northerly on a curve to the left, radius 190.00 feet, whose chord bears N19°36'W, 226.92 feet; thence N31°43'E, 252.25 feet to point of beginning, including all lands lying between meander line and water's edge of Swan Lake.
Said parcel contains 333,000 square feet, more or less, or 7.8 acres, more or less.

CURVE	UNIT	RADIUS	DELTA	CHORD BEARING	CHORD DISTANCE	ARC
X	1	190'	90°50'	N28°21'W	270.65'	301.21'
X1			17°30'	N65°01'W	57.81'	58.02'
X2			73°20'	N19°36'W	226.92'	243.19'
	6		19°40'	N45°26'W	64.30'	65.22'
	5		15°00'	N29°06'W	49.60'	49.74'
	4		11°00'	N18°03'W	36.42'	36.48'
	3		14°30'	N 37°11'W	47.96'	48.09'
	2		13°10'	N10°11'E	43.56'	43.66'

NOTE: Limited Common Elements: All lands within the limited common elements boundary lines not occupied by the unit shall be limited common elements appurtenant to the respective unit.

Bearings are referenced to Saddle Ridge Condominium where the west line of Section 1 bears N0°05'15"W.

⊙ = Found 1" round iron rod.

⊙ = Found 3/4" round iron rod.

⊙ = Set 3/4"x24" round iron rod weighing 1.58/lineal foot.

STATE OF WISCONSIN }
COLUMBIA COUNTY }
RECEIVED FOR RECORD

DEC 17 1991

Denny G. Gidd
Reg. of Deeds at 11:20 AM

Vol 1 - Page 187

REF VOL 1 - P 174
1 - P 129

Swam
3rd Am

T PLAT

SURVEYORS CERTIFICATE:

Date Sept 23, 1993 Kenneth G. Carlson
Kenneth G. Carlson

21'
02'
19'
22'
74'
48'
09'
66'

} 98
BOARD

AM

ACCESS ROAD EASEMENT (C) DESCRIPTION
Access Road Easement Description:

Access Road Easement Description:

A parcel of land in NW1/4-NW1/4, SW1/4-NW1/4, Government Lot 4, Section 1 and NE1/4-SE1/4, SE1/4-NE1/4, Section 2 all T12N, R5E, Town of Pacific, Columbia County, Wisconsin bounded by the following described line: Commencing at the northwest corner of said Section 1; thence N89°50'14"E along the section line, 389.88 feet to the point of beginning; thence continuing N89°50'14"E along the section line, 273.54 feet; thence S89°50'14"E, 157.99 feet; thence S89°50'14"E, 170.00 feet; thence S89°50'14"E, 80.61 feet; thence southeasterly on a curve to the right, radius 166.00 feet, whose chord bears S45°05'W, 234.42 feet; thence West, 155.19 feet; thence southeasterly on a curve to the left, radius 125.00 feet, whose chord bears S44°57'23"W, 176.91 feet; thence S0°05'15"E, 471.23 feet; thence southeasterly on a curve to the left, radius 125.00 feet, whose chord bears S0°05'15"E, 471.23 feet; thence southeasterly on a curve to the right, radius 170.00 feet, whose chord bears S29°13'39"E, 200.76 feet; thence S3°00'W, 246.00 feet; thence southeasterly on a curve to the right, radius 300.00 feet, whose chord bears S17°00'W, 145.15 feet, thence S31°00'W, 389.85 feet; thence southeasterly on a curve to the left, radius 679.45 feet, whose chord bears S25°15'W, 429.71 feet; thence S17°26'W, 304.98 feet; thence S15°15'W, 429.71 feet; thence S17°26'W, 304.98 feet; thence S2°00'E, 277.99 feet; thence southeasterly on a curve to the left, radius 355.00 feet, whose chord bears S43°40'E, 476.00 feet; thence southeasterly on a curve to the right, radius 716.00 feet, whose chord bears S67°15'E, 444.00 feet; thence S45°00'W, 308.22 feet; thence S17°04'W, 312.88 feet; thence S45°00'W, 308.22 feet; thence southeasterly on a curve to the right, radius 360 feet, whose chord bears S65°22'W, 250.19 feet; thence northerly on a curve to the left, radius 127.58 feet, whose chord bears N1°07'40"E, 127.58 feet; thence northerly on a curve to the left, radius 136 feet, whose chord bears N80°34'E, 158.22 feet; thence N45°00'E, 291.81 feet; thence N81°04'E, 296.45 feet; thence northerly on a curve to the left, radius 124.00 feet, whose chord bears N28°21'W, 176.63 feet; thence northerly on a curve to the right, radius 170.00 feet, whose chord bears N61°46'W, 197.93 feet; thence northerly on a curve to the left, radius 650.00 feet, whose chord bears N67°46'W, 401.72 feet; thence northerly on a curve to the right, radius 421.00 feet, whose chord bears N43°40'W, 564.51 feet; thence N2°00'W, 288.97 feet; thence N17°26'W, 308.22 feet; thence N19°30'W, 401.97 feet; thence northerly on a curve to the right, radius 745.45 feet, whose chord bears N25°15'E, 149.37 feet; thence N31°00'E, 389.85 feet; thence northerly on a curve to the left, radius 234.00 feet, whose chord bears N17°00'E, 133.22 feet; thence N19°30'W, 401.97 feet; thence northerly on a curve to the left, radius 122.00 feet, whose chord bears N29°13'39"W, 130.28 feet; thence N61°30'W, 170.91 feet; thence northerly on a curve to the right, radius 191.00 feet, whose chord bears N30°47'38"W, 195.06 feet; thence N0°05'15'W, 471.23 feet; thence northerly on a curve to the right, radius 191.00 feet, whose chord bears N44°57'23'E, 270.32 feet; thence N19°30'W, 401.97 feet; thence northerly on a curve to the left, radius 100.00 feet, whose chord bears N45°05'E, 141.21 feet; thence N44°50'W, 165.85 feet to the point of beginning.

off 65.D - new unit 11-1199
unit 12-1200
unit 13-1201

194

CONDOMINIUM PLAT OF
SWAN LAKE VILLAGE
GOLF AND TENNIS CONDOMINIUM B

SWAN LAKE VILLAGE
GOLF AND TENNIS CONDOMINIUM B

PHASE I DESCRIPTION:

A parcel of land in the NE 1/4 - NE 1/4, Section 2, T12N, R9E, Town of Pacific, Columbia County, Wisconsin, bounded by the following described line: Commencing at the NE corner of said Section 2; Thence S0°05'15"E, along section line 1221.69 feet; Thence N86°57'17"W, 1053.18 feet to the point of beginning; Thence N86°57'17"W, 269.62 feet; Thence S3°02'43"W, 100.00 feet; Thence S86°57'17"E, 269.62 feet; Thence N3°02'43"E, 100.00 feet, to the point of beginning. Said parcel contains 0.62 acres.


FUTURE PHASE DESCRIPTION:

A parcel of land in the NE 1/4 - NE 1/4, Section 2, T12N, R9E, Town of Pacific, Columbia County, Wisconsin, bounded by the following described line: Commencing at the NE corner of said Section 2; Thence S0°05'15"E, along section line, 1221.69 feet, to the point of beginning; Thence N86°57'17"W, 1053.18 feet; Thence S3°02'43"W, 100.00 feet; Thence S86°57'17"E, 1058.65 feet; Thence N0°05'15"W, 100.15 feet, to the point of beginning.


Received for record the...
Day of June... A.D. 1981...
at 2:00 o'clock P.M., and recorded
in Vol. 1... of Records Page 45...
Marian Robinson
Register of Deeds

THIS SURVEY DESCRIBES AS "PHASE I" THE LAND AND BUILDINGS SUBJECT TO THE CONDOMINIUM DECLARATION FOR SWAN LAKE VILLAGE GOLF AND TENNIS CONDOMINIUM B.

THIS SURVEY DESCRIBES AS "FUTURE PHASES" THE LAND ADJACENT TO SWAN LAKE VILLAGE GOLF AND TENNIS CONDOMINIUM B WHICH MAY IN ITS ENTIRETY OR PORTIONS THEREOF BE ANNEXED AND ADDED TO THE CONDOMINIUM IN ACCORDANCE WITH TERMS OF THE DECLARATION.

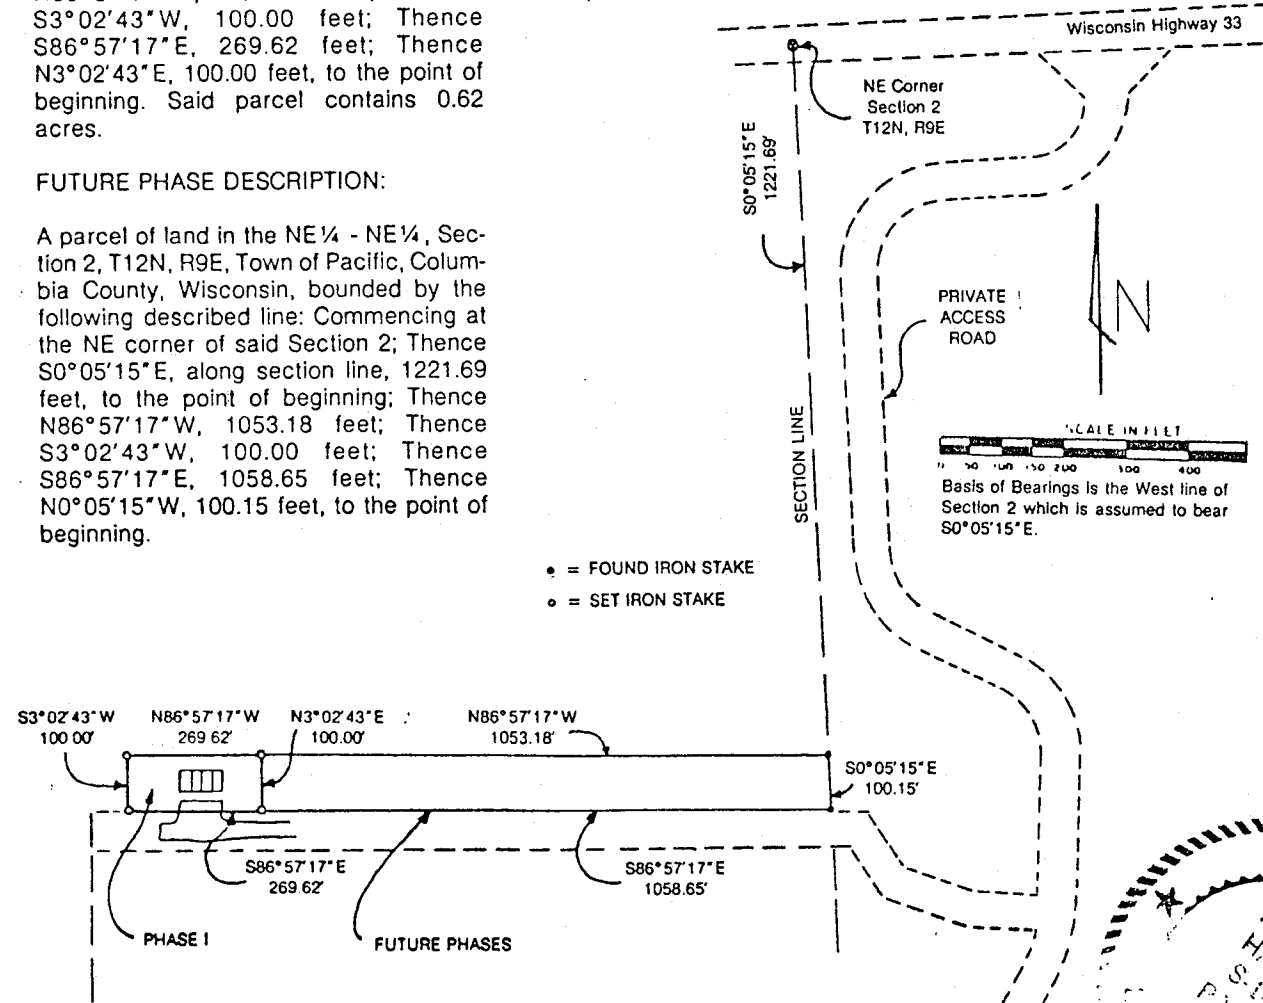

I, Alvin F. Hamele, hereby certify that I have surveyed the above described property and that this plat is an accurate representation of the exterior boundary lines and the location of the buildings, garages and drives constructed or to be constructed upon the property and that the plat is a correct representation of Swan Lake Village Golf and Tennis Condominium B, as proposed at the date hereof, and the identification and location of each unit and the common elements can be determined from the plat.

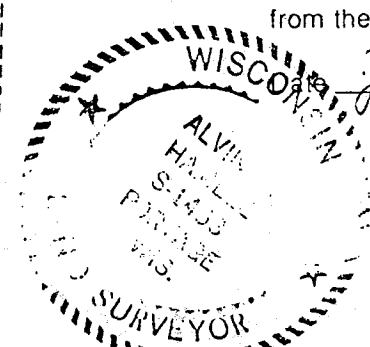

Swan Lake Village
Golf and Tennis Condominium B
Condominium Plat - Page 1

1982 Assessment Roll

LEGEND


- Unit/Limited Common Boundary
- Limited Common Area
- Living Room
- Dining Room
- Kitchen
- Bedroom
- Toilet/Bath
- Screen Porch
- Parking
- Utility
- Storage Area
- Den
- Sidewalks appurtenant as limited common area to all units in building

I, William J. Wolf
a Professional Engineer duly licensed by the State of Wisconsin, do hereby certify that the drawings appearing hereon are an accurate copy of portions of the plans of each building as filed with and approved by the State of Wisconsin and substantially depict the layout, location, unit numbers and dimensions of the building or buildings and units located and erected or to be erected.

NOTARIZATION

Subscribed and sworn to before me this 27th day of May
Sincerely, A. Arias
Notary Public, State of Wisconsin
My commission expires

Typical First Floor
Swan Lake Village
Golf and Tennis Condominium B
Condominium Plat - Page 3

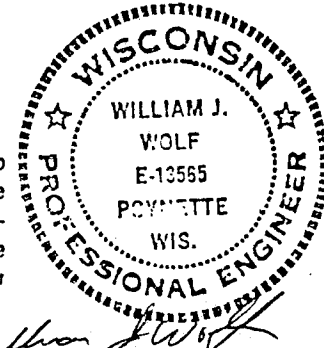

LEGEND


- Unit/Limited Common Boundary
- Limited Common Area
- Living Room
- Dining Room
- Kitchen
- Bedroom
- Toilet/Bath
- Screen Porch
- Parking
- Utility
- Storage Area
- Den

I, William J. Wolf
a Professional Engineer duly licensed by the State of Wisconsin, do hereby certify that the drawings appearing hereon are an accurate copy of portions of the plans of each building as filed with and approved by the State of Wisconsin and substantially depict the layout, location, unit numbers and dimensions of the building or buildings and units located and erected or to be erected.

NOTARIZATION

Subscribed and sworn to before me this 27th day of May
Sincerely, A. Arias
Notary Public, State of Wisconsin
My commission expires 9-25-83

Typical Second Floor
Swan Lake Village
Golf and Tennis Condominium B
Condominium Plat - Page 4

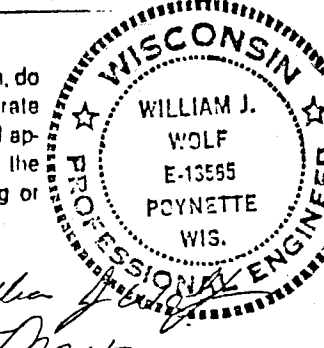

Replaced
2004

off # 88.B
(p. 1)
776
777-Unit
778-Unit
779-Unit
780-Unit

V.1 P.47

V.1 P.48

SWAN LAKE VILLAGE
GOLF AND TENNIS CONDOMINIUM C

PHASE I DESCRIPTION:

A parcel of land in the SE 1/4 of the NE 1/4, Section 1, T12N, R9E, Town of Pacific, Columbia County, Wisconsin, bounded by the following described line: Commencing at the NE corner of said Section 1; Thence S0°18'10"W along the section line, 1515.83 feet to the point of beginning; Thence N87°13'45"W, 200.00 feet; Thence S19°30'03"W, 104.44 feet; Thence S87°13'45"E, 200.00 feet; Thence N19°30'03"E, 104.44 feet to the point of beginning.

FUTURE PHASE DESCRIPTION:

A parcel of land in the SE 1/4 of the NE 1/4, Section 1, T12N, R9E, Town of Pacific, Columbia County, Wisconsin, bounded by the following described line: Commencing at the NE corner of said Section 1, Thence S0°18'10"W along the section line 1515.83 feet; Thence N87°13'45"W, 200.00 feet; Thence N87°13'45"W, 1115.96 feet; Thence S0°53'0"W, 100.07 feet; Thence S87°13'45"E, 1081.74 feet; Thence N19°30'03"E, 104.44 feet to the point of beginning.

STATE OF WISCONSIN
COLUMBIA COUNTY

Received for record the...

Day of June... A.D. 1981...

at 2:00 o'clock P.M., and recorded
in Vol. 1... of Records Page 49...

Marian Robinson

Register of Deeds

CONDOMINIUM PLAT OF

SWAN LAKE VILLAGE
GOLF AND TENNIS CONDOMINIUM C

THIS SURVEY DESCRIBES AS "PHASE I" THE LAND AND BUILDINGS SUBJECT TO THE CONDOMINIUM DECLARATION FOR SWAN LAKE VILLAGE GOLF AND TENNIS CONDOMINIUM C.



THIS SURVEY DESCRIBES AS "FUTURE PHASES" THE LAND ADJACENT TO SWAN LAKE VILLAGE GOLF AND TENNIS CONDOMINIUM C WHICH MAY IN ITS ENTIRETY OR PORTIONS THEREOF BE ANNEXED AND ADDED TO THE CONDOMINIUM IN ACCORDANCE WITH TERMS OF THE DECLARATION.

I, Alvin F. Hamele, hereby certify that I have surveyed the above described property and that this plat is an accurate representation of the exterior boundary lines and the location of the buildings, garages and drives constructed or to be constructed upon the property and that the plat is a correct representation of Swan Lake Village Golf and Tennis Condominium C, as proposed at the date hereof, and the identification and location of each unit and the common elements can be determined from the plat.

Date June 8, 1981
Alvin F. Hamele
Land Surveyor No. S-1453

Swan Lake Village
Golf and Tennis Condominium C
Condominium Plat — Page 1

VOL 1 PAGE 49

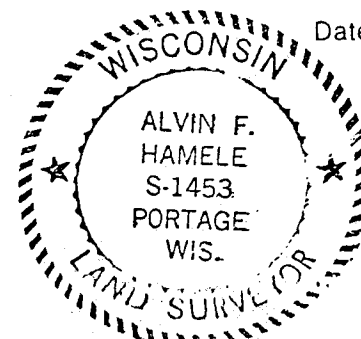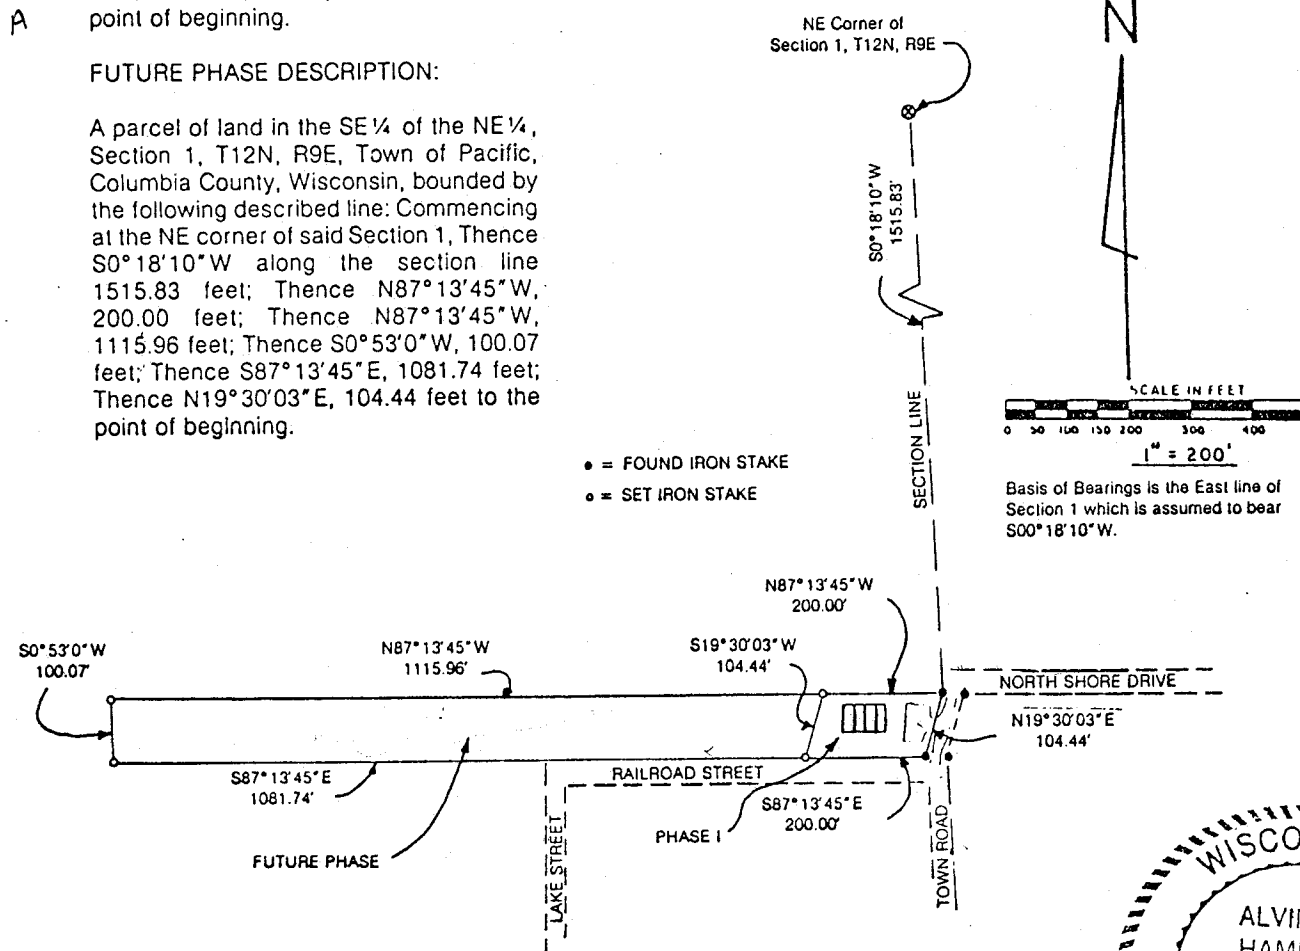


1982 Assessment Roll

Replaced
2004

off # 71
new 781
new 782 - Unit 1
new 783 - Unit 2
new 784 - Unit 3
new 785 - Unit 4

Withdrawn from
Condominium
R518-01



Swan
Lake
Golf
(C)

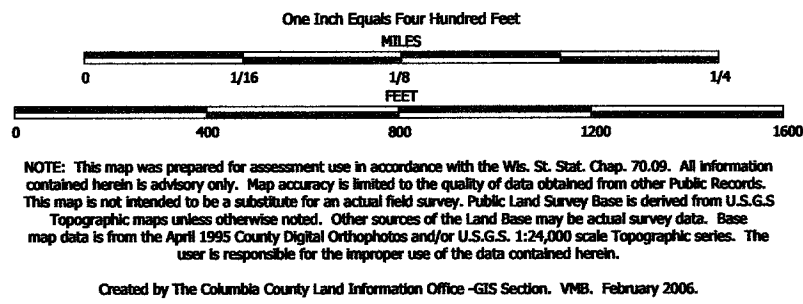


TAX PARCEL MAP

TOWN of PACIFIC

TOWN 12 NORTH - RANGE 9 EAST
COLUMBIA COUNTY, WISCONSIN

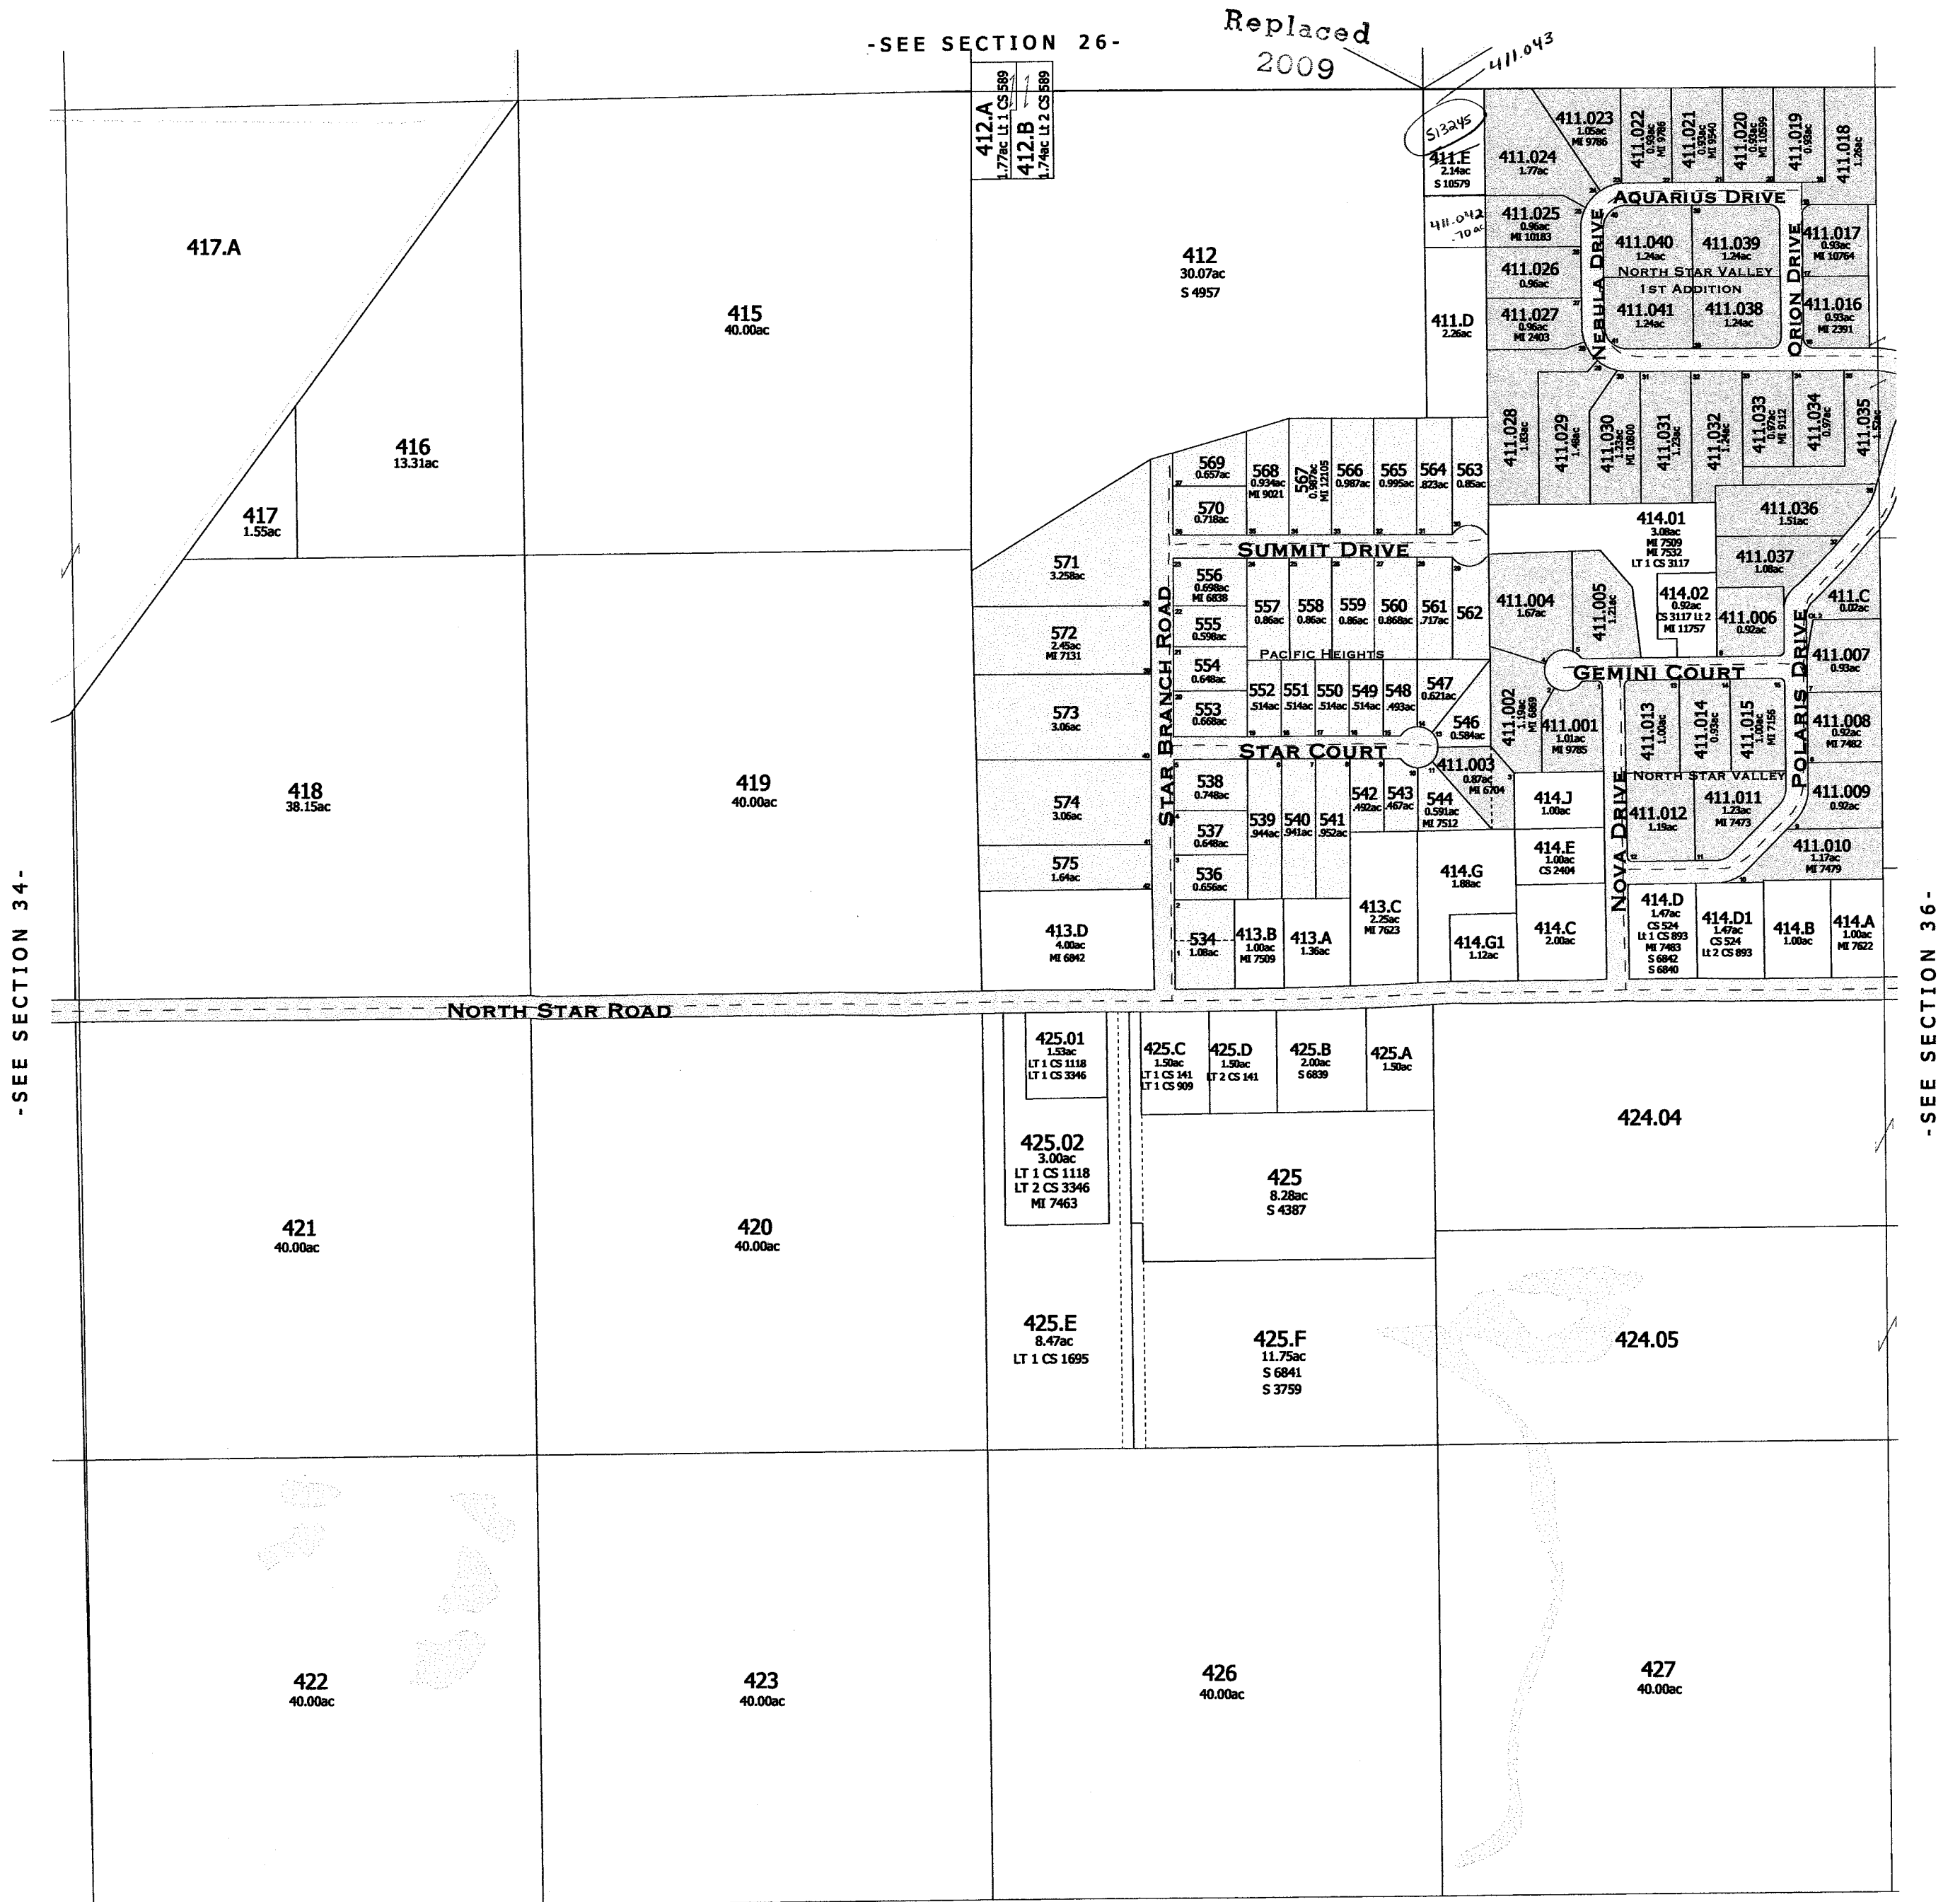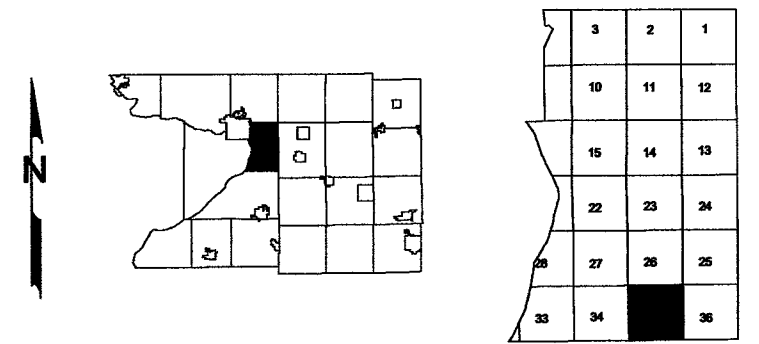

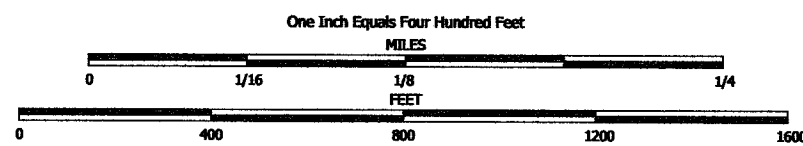


NOTE: This map was prepared for assessment use in accordance with the Wis. St. Stat. Chap. 70.09. All information contained herein is advisory only. Map accuracy is limited to the quality of data obtained from other Public Records. This map is not intended to be a substitute for an actual field survey. Public Land Survey Base is derived from U.S.G.S Topographic maps unless otherwise noted. Other sources of the Land Base may be actual survey data. Base map data is from the April 1995 County Digital Orthophotos and/or U.S.G.S 1:24,000 scale Topographic series. The user is responsible for the improper use of the data contained herein.

Created by The Columbia County Land Information Office -GIS Section. VMB. February 2006.

TAX PARCEL MAP

TOWN of PACIFIC

TOWN 12 NORTH RANGE 9 EAST
COLUMBIA COUNTY, WISCONSIN

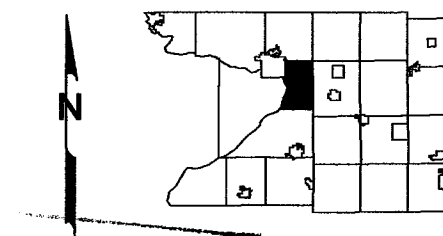

3	2	1
10	11	12
15	14	13
22	23	24
28	27	26
33	32	31

Replaced
2009

-SEE SECTION 27-

-SEE SECTION 33-



-SEE SECTION 35-

TOWN OF DEKORRA

-SECTION 34-

One Inch Equals Four Hundred Feet

0 1/16 1/8 1/4

0 400 800 1200 1600

FEET

0 1/16 1/8 1/4

FEET

0 400 800 1200 1600

FEET

TAX PARCEL MAP

TOWN of PACIFIC

TOWN 12 NORTH RANGE 9 EAST
COLUMBIA COUNTY, WISCONSIN

NOTE: This map was prepared for assessment use in accordance with the Wis. St. Stat. Chap. 70.09. All information contained herein is advisory only. Map accuracy is limited to the quality of data obtained from other Public Records. This map is not intended to be a substitute for an actual field survey. Public Land Survey Base is derived from U.S.G.S Topographic maps unless otherwise noted. Other sources of the Land Base may be actual survey data. Base map data is from the April 1995 County Digital Orthophotos and/or U.S.G.S. 1:24,000 scale Topographic series. The user is responsible for the improper use of the data contained herein.

Created by The Columbia County Land Information Office -GIS Section, VMB, February 2006.

3 2 1


10 11 12

15 14 13

22 23 24

27 28 25

34 35 36

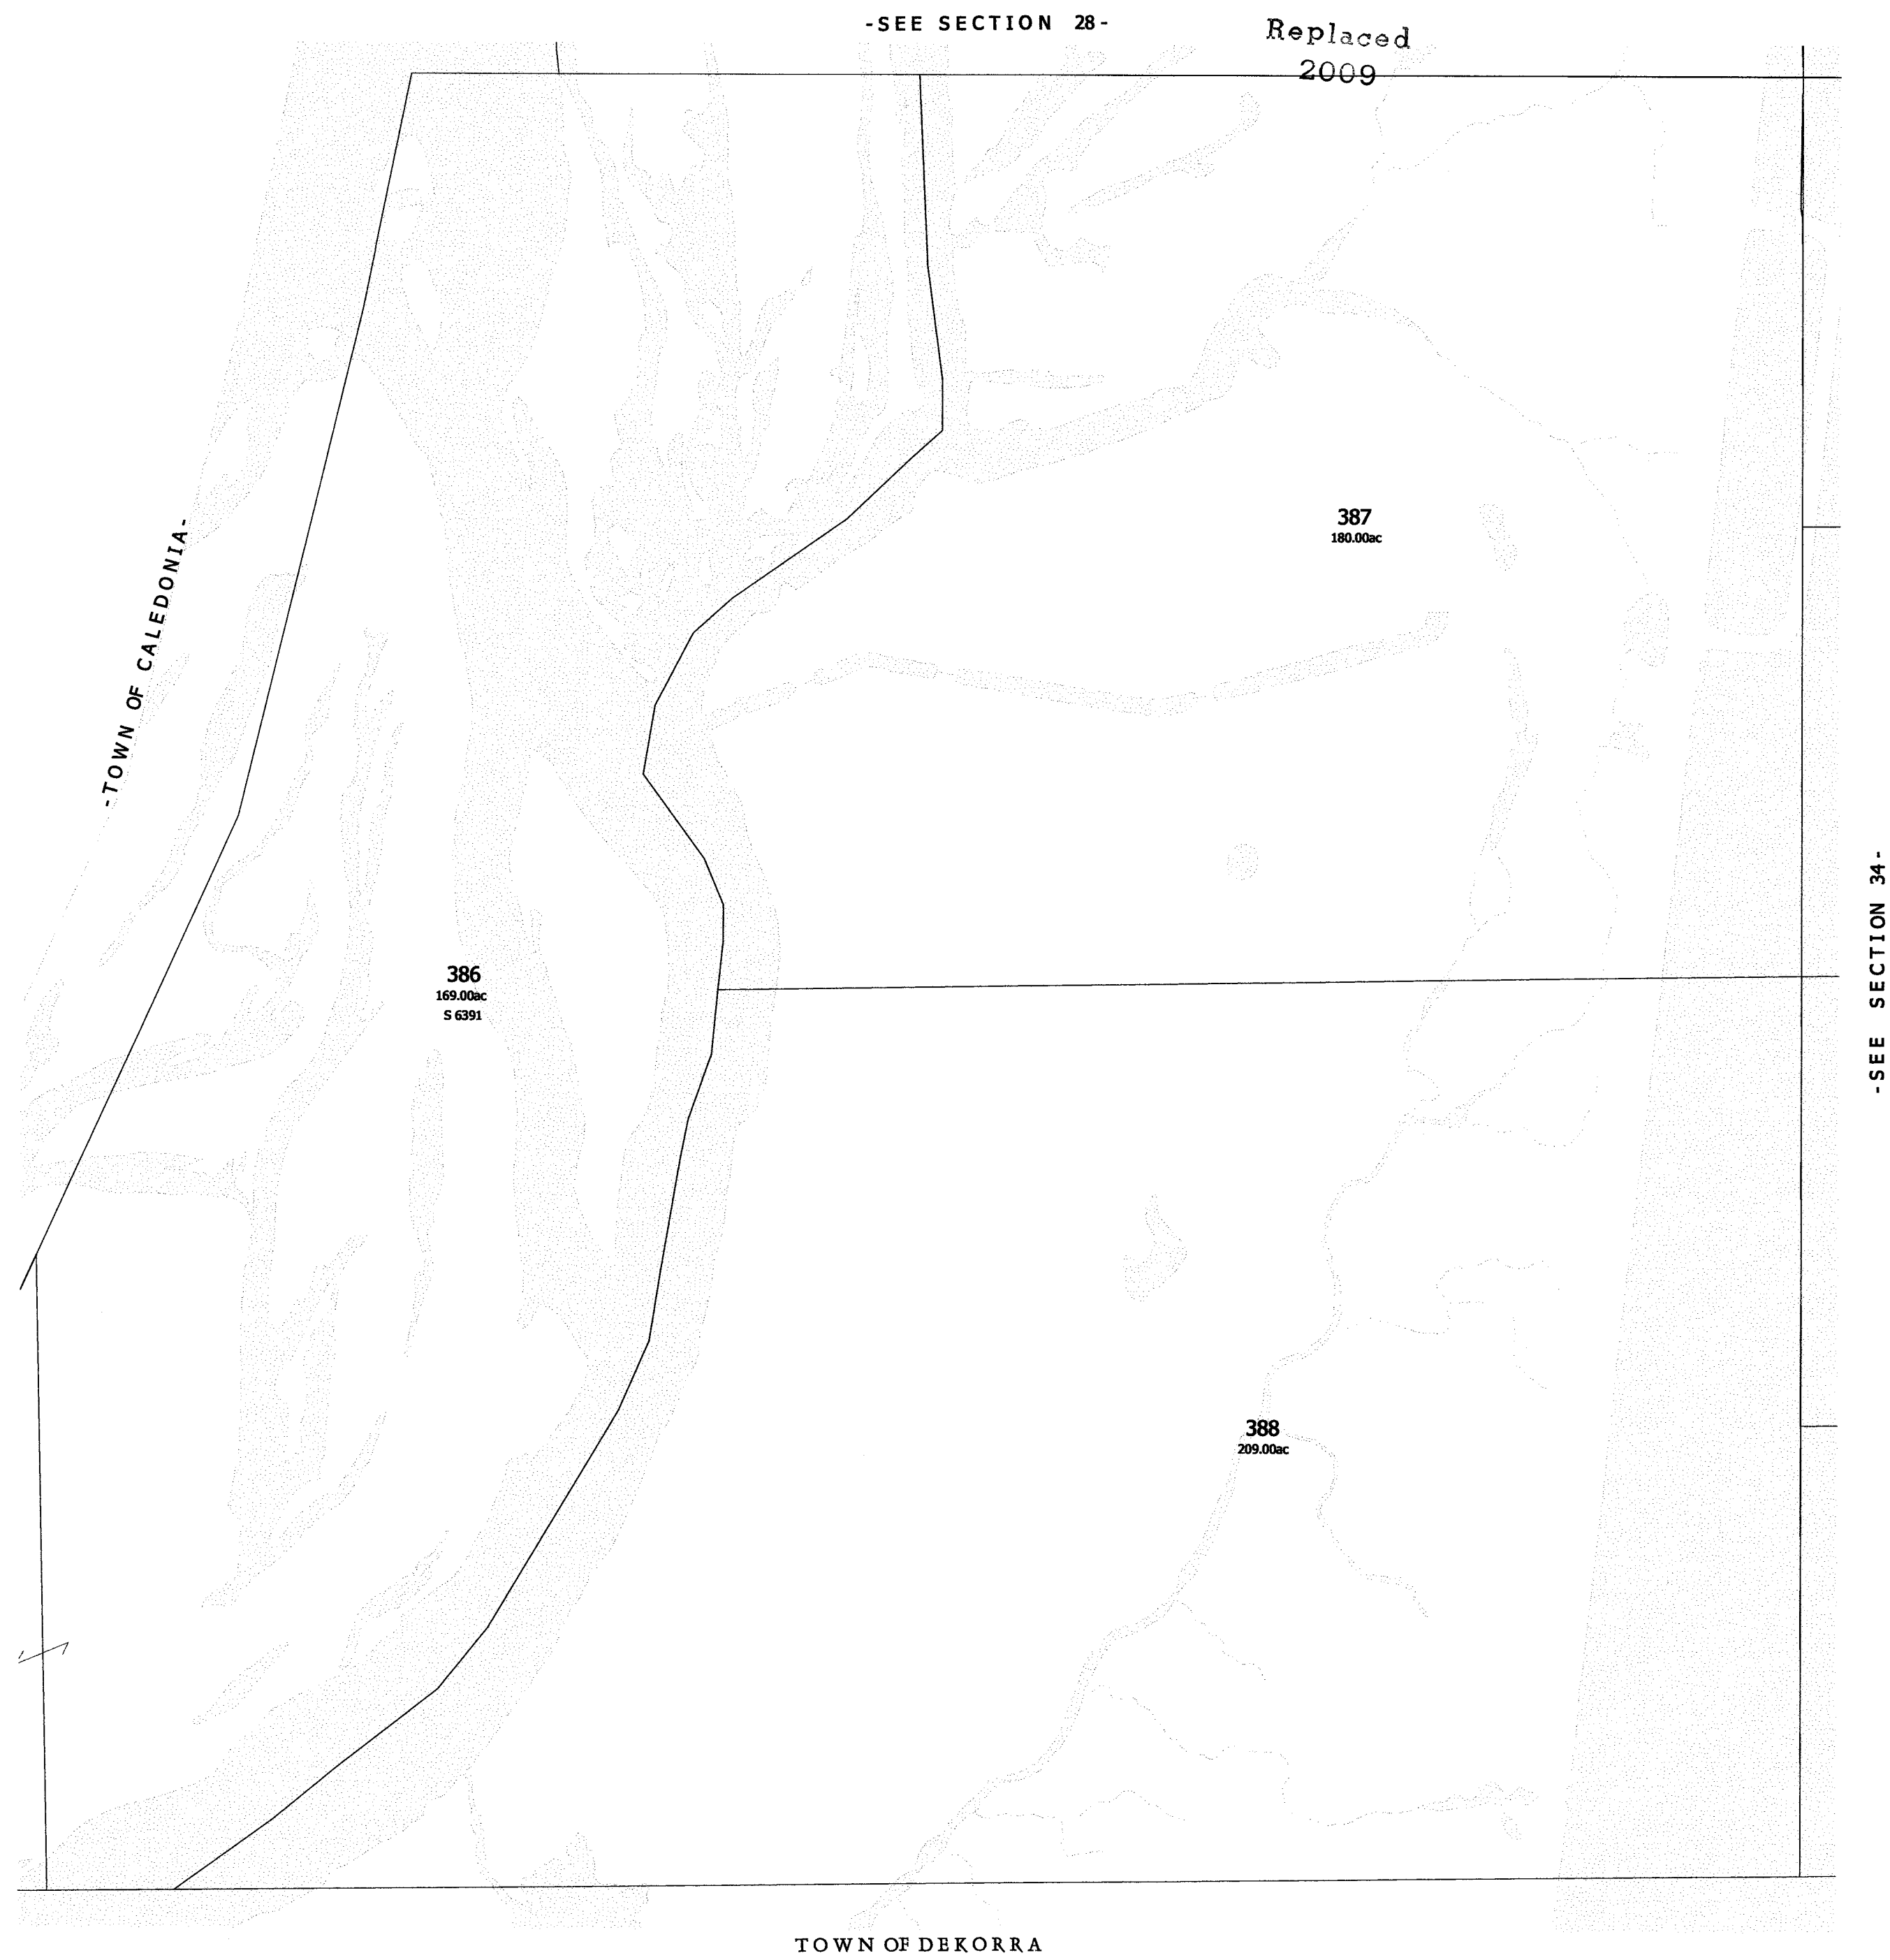

One Inch Equals Four Hundred Feet

MILES

0 1/16 1/8 1/4

FEET

0 400 800 1200 1600


NOTE: This map was prepared for assessment use in accordance with the Wis. St. Stat. Chap. 70.09. All information contained herein is advisory only. Map accuracy is limited to the quality of data obtained from other Public Records. This map is not intended to be a substitute for an actual field survey. Public Land Survey Base is derived from U.S.G.S. Topographic maps unless otherwise noted. Other sources of the Land Base may be actual survey data. Base map data is from the April 1995 County Digital Orthophotos and/or U.S.G.S. 1:24,000 scale Topographic series. The user is responsible for the improper use of the data contained herein.

Created by The Columbia County Land Information Office -GIS Section. VMB. February 2006.

TAX PARCEL MAP


TOWN of PACIFIC

TOWN 12 NORTH RANGE 9 EAST
COLUMBIA COUNTY, WISCONSIN

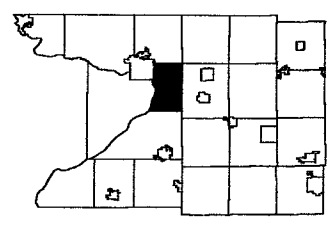


	3	2	1
	10	11	12
	15	14	13
	22	23	24
	27	26	25
	33	34	35

Replaced
2009

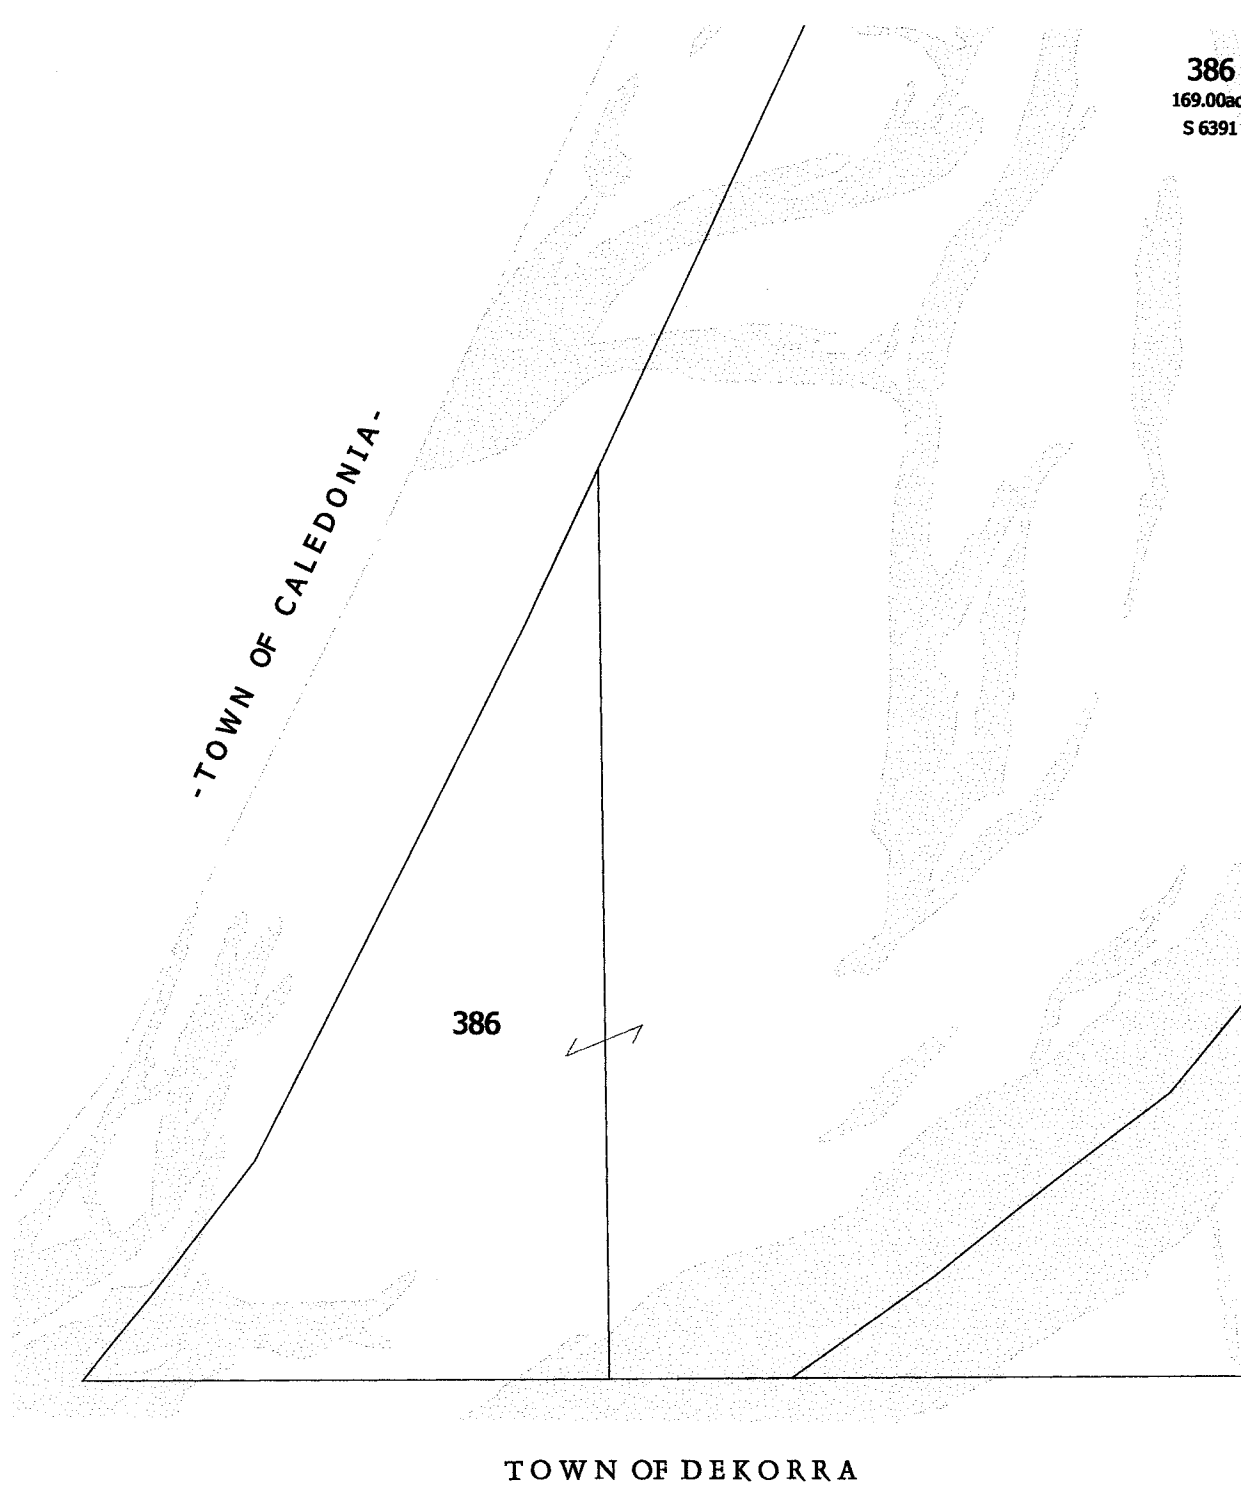

-SEE SECTION 33-

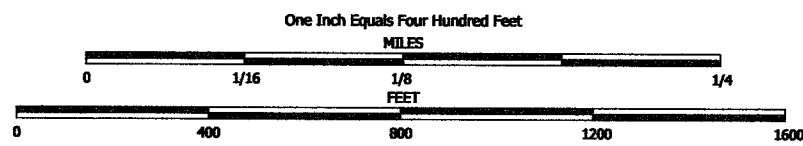


NOTE: This map was prepared for assessment use in accordance with the Wis. St. Stat. Chap. 70.09. All information contained herein is advisory only. Map accuracy is limited to the quality of data obtained from other Public Records. This map is not intended to be a substitute for an actual field survey. Public Land Survey Base is derived from U.S.G.S Topographic maps unless otherwise noted. Other sources of the Land Base may be actual survey data. Base map data is from the April 1995 County Digital Orthophotos and/or U.S.G.S. 1:24,000 scale Topographic series. The user is responsible for the improper use of the data contained herein.

Created by The Columbia County Land Information Office -GIS Section. VMB, February 2006.


TAX PARCEL MAP

TOWN of PACIFIC

TOWN 12 NORTH RANGE 9 EAST
COLUMBIA COUNTY, WISCONSIN

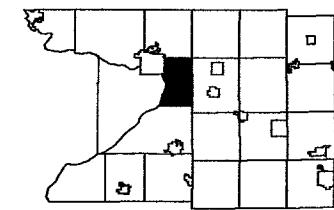

3	2	1
10	11	12
15	14	13
22	23	24
27	26	25
32	34	35

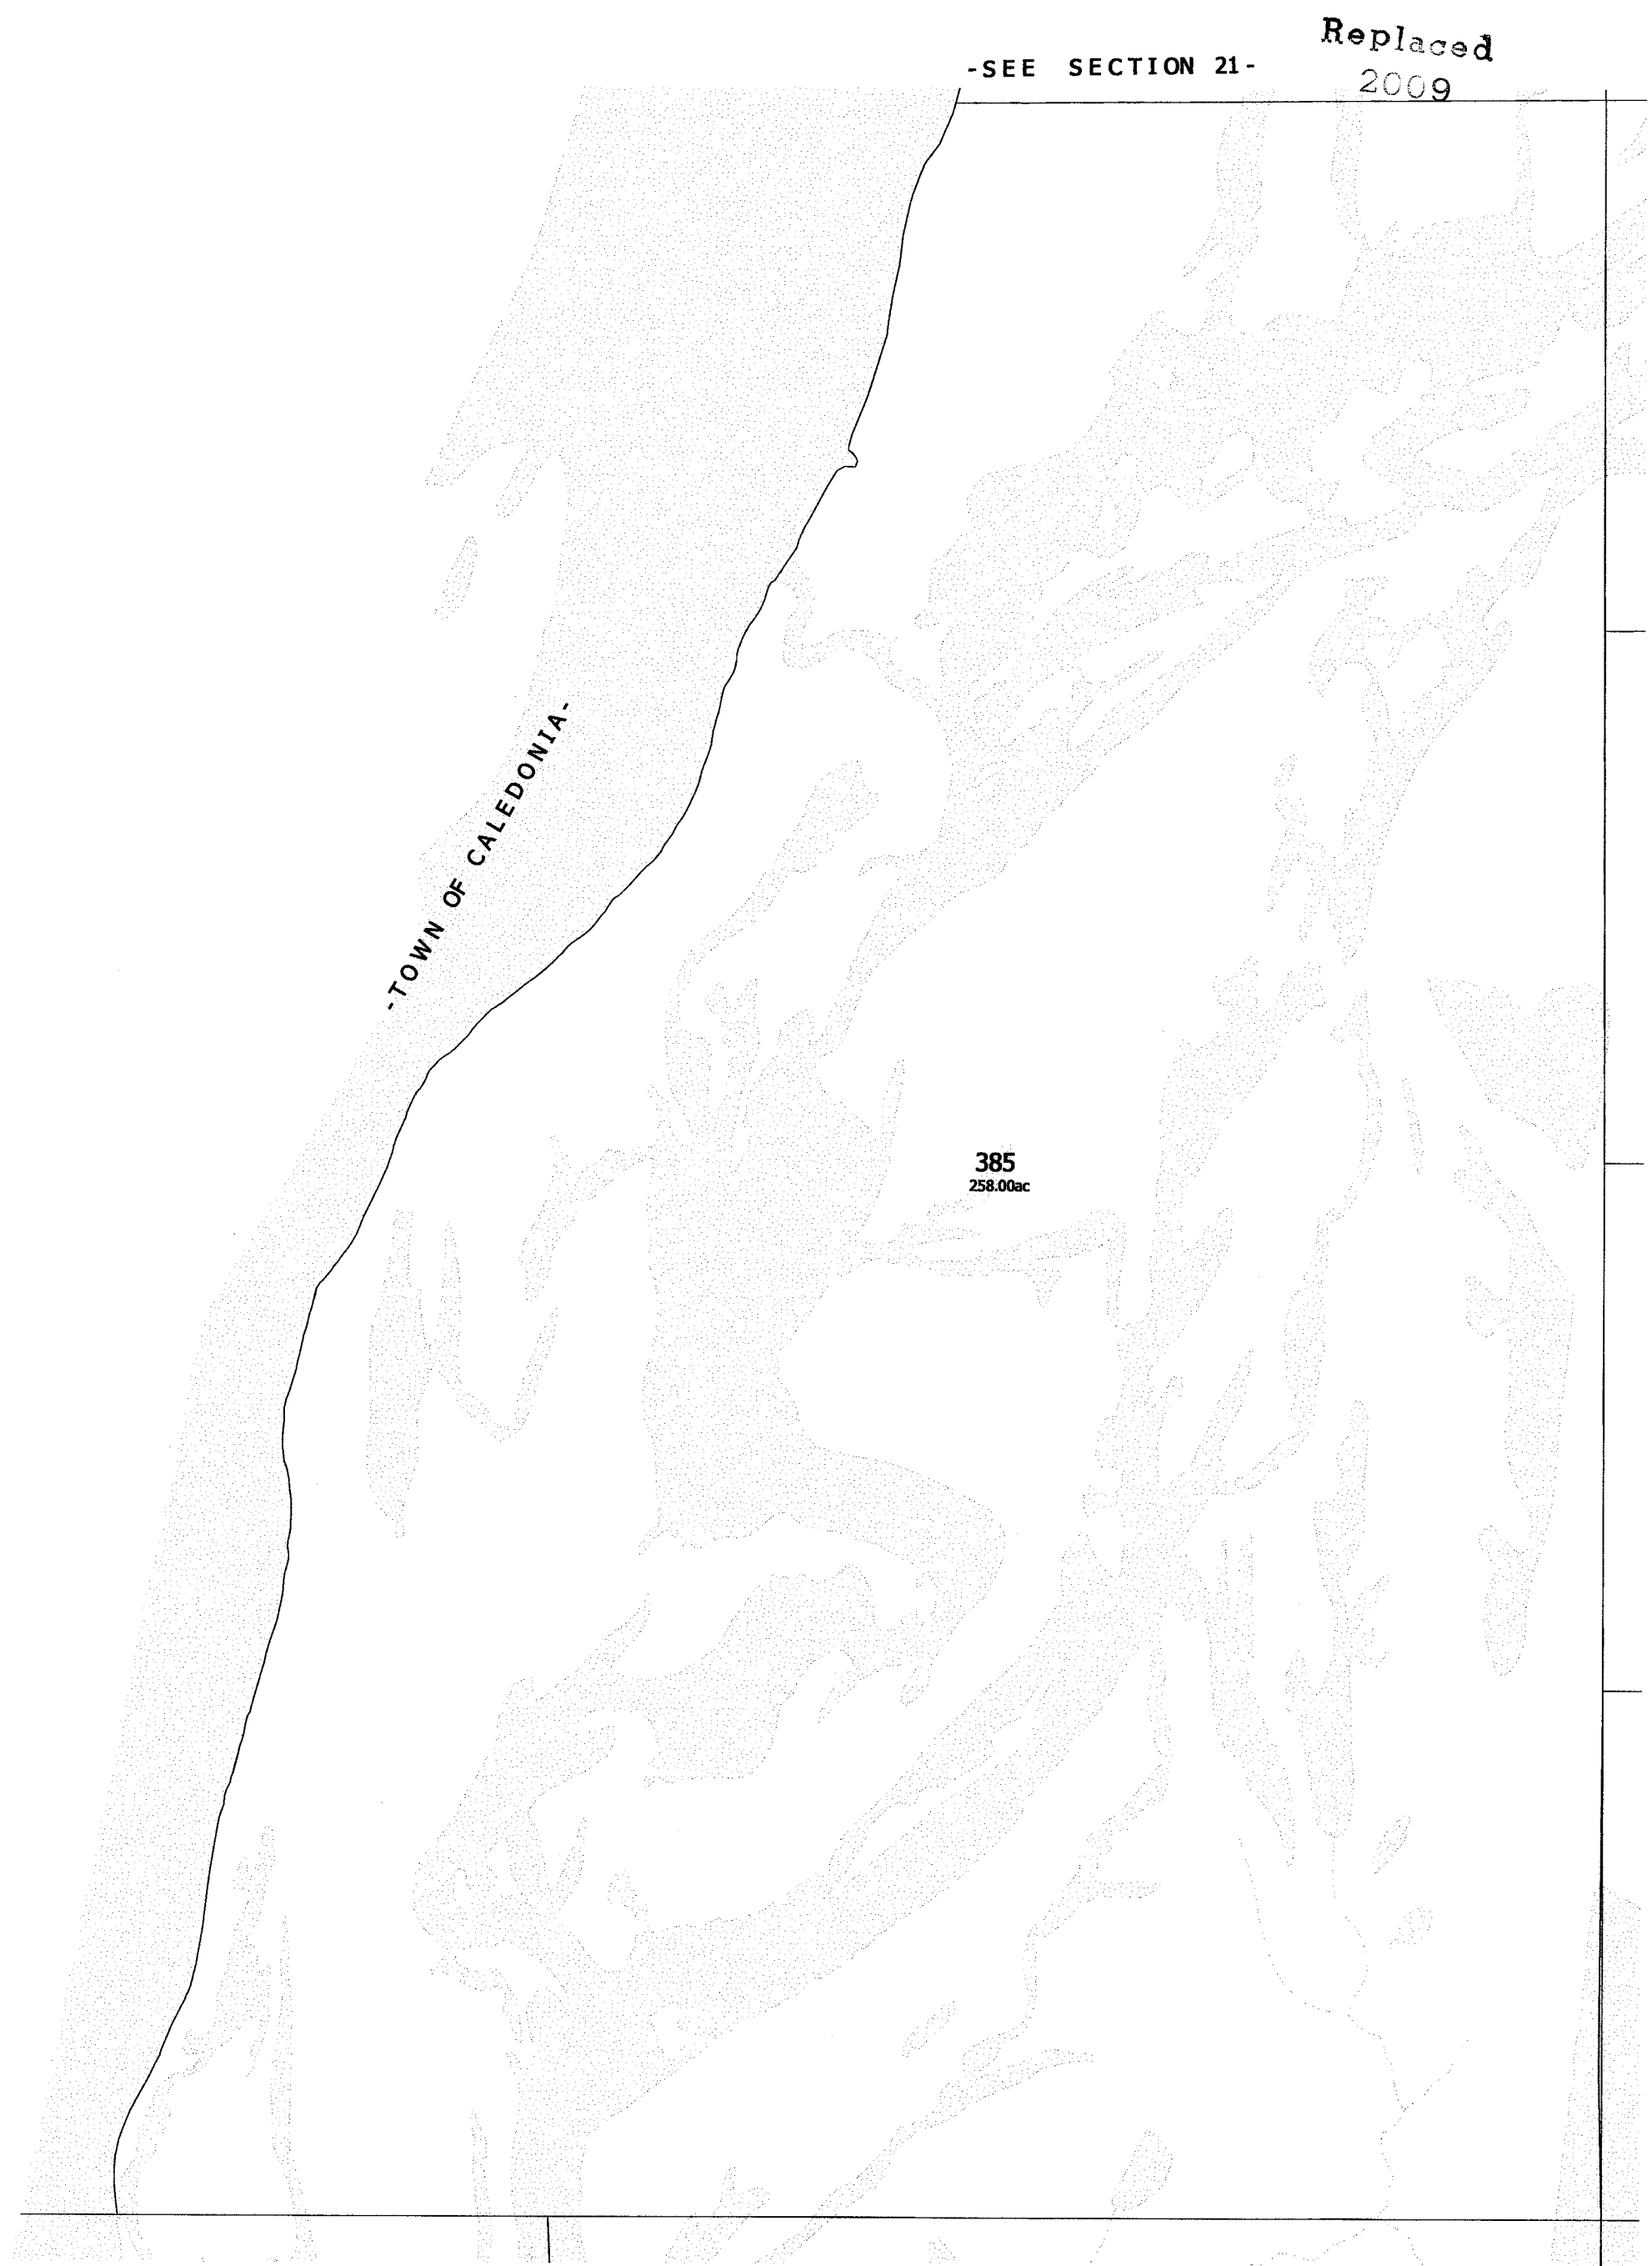


-SEE SECTION 21-
Replaced
2009

-SEE SECTION 27-

-SEE SECTION 33-

-SECTION 28-

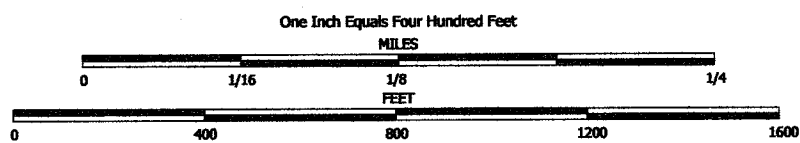


NOTE: This map was prepared for assessment use in accordance with the Wis. St. Stat. Chap. 70.09. All information contained herein is advisory only. Map accuracy is limited to the quality of data obtained from other Public Records. This map is not intended to be a substitute for an actual field survey. Public Land Survey Base is derived from U.S.G.S. Topographic maps unless otherwise noted. Other sources of the Land Base may be actual survey data. Base map data is from the April 1995 County Digital Orthophotos and/or U.S.G.S. 1:24,000 scale Topographic series. The user is responsible for the improper use of the data contained herein.

Created by The Columbia County Land Information Office -GIS Section. VMB. July 2004.


TAX PARCEL MAP



TOWN of PACIFIC


TOWN 12 NORTH RANGE 9 EAST
COLUMBIA COUNTY, WISCONSIN

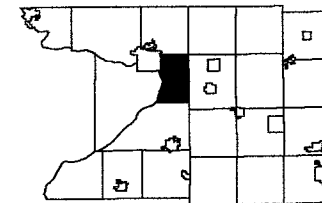

3	2	1
10	11	12
15	14	13
22	23	24
28	26	25
33	34	35

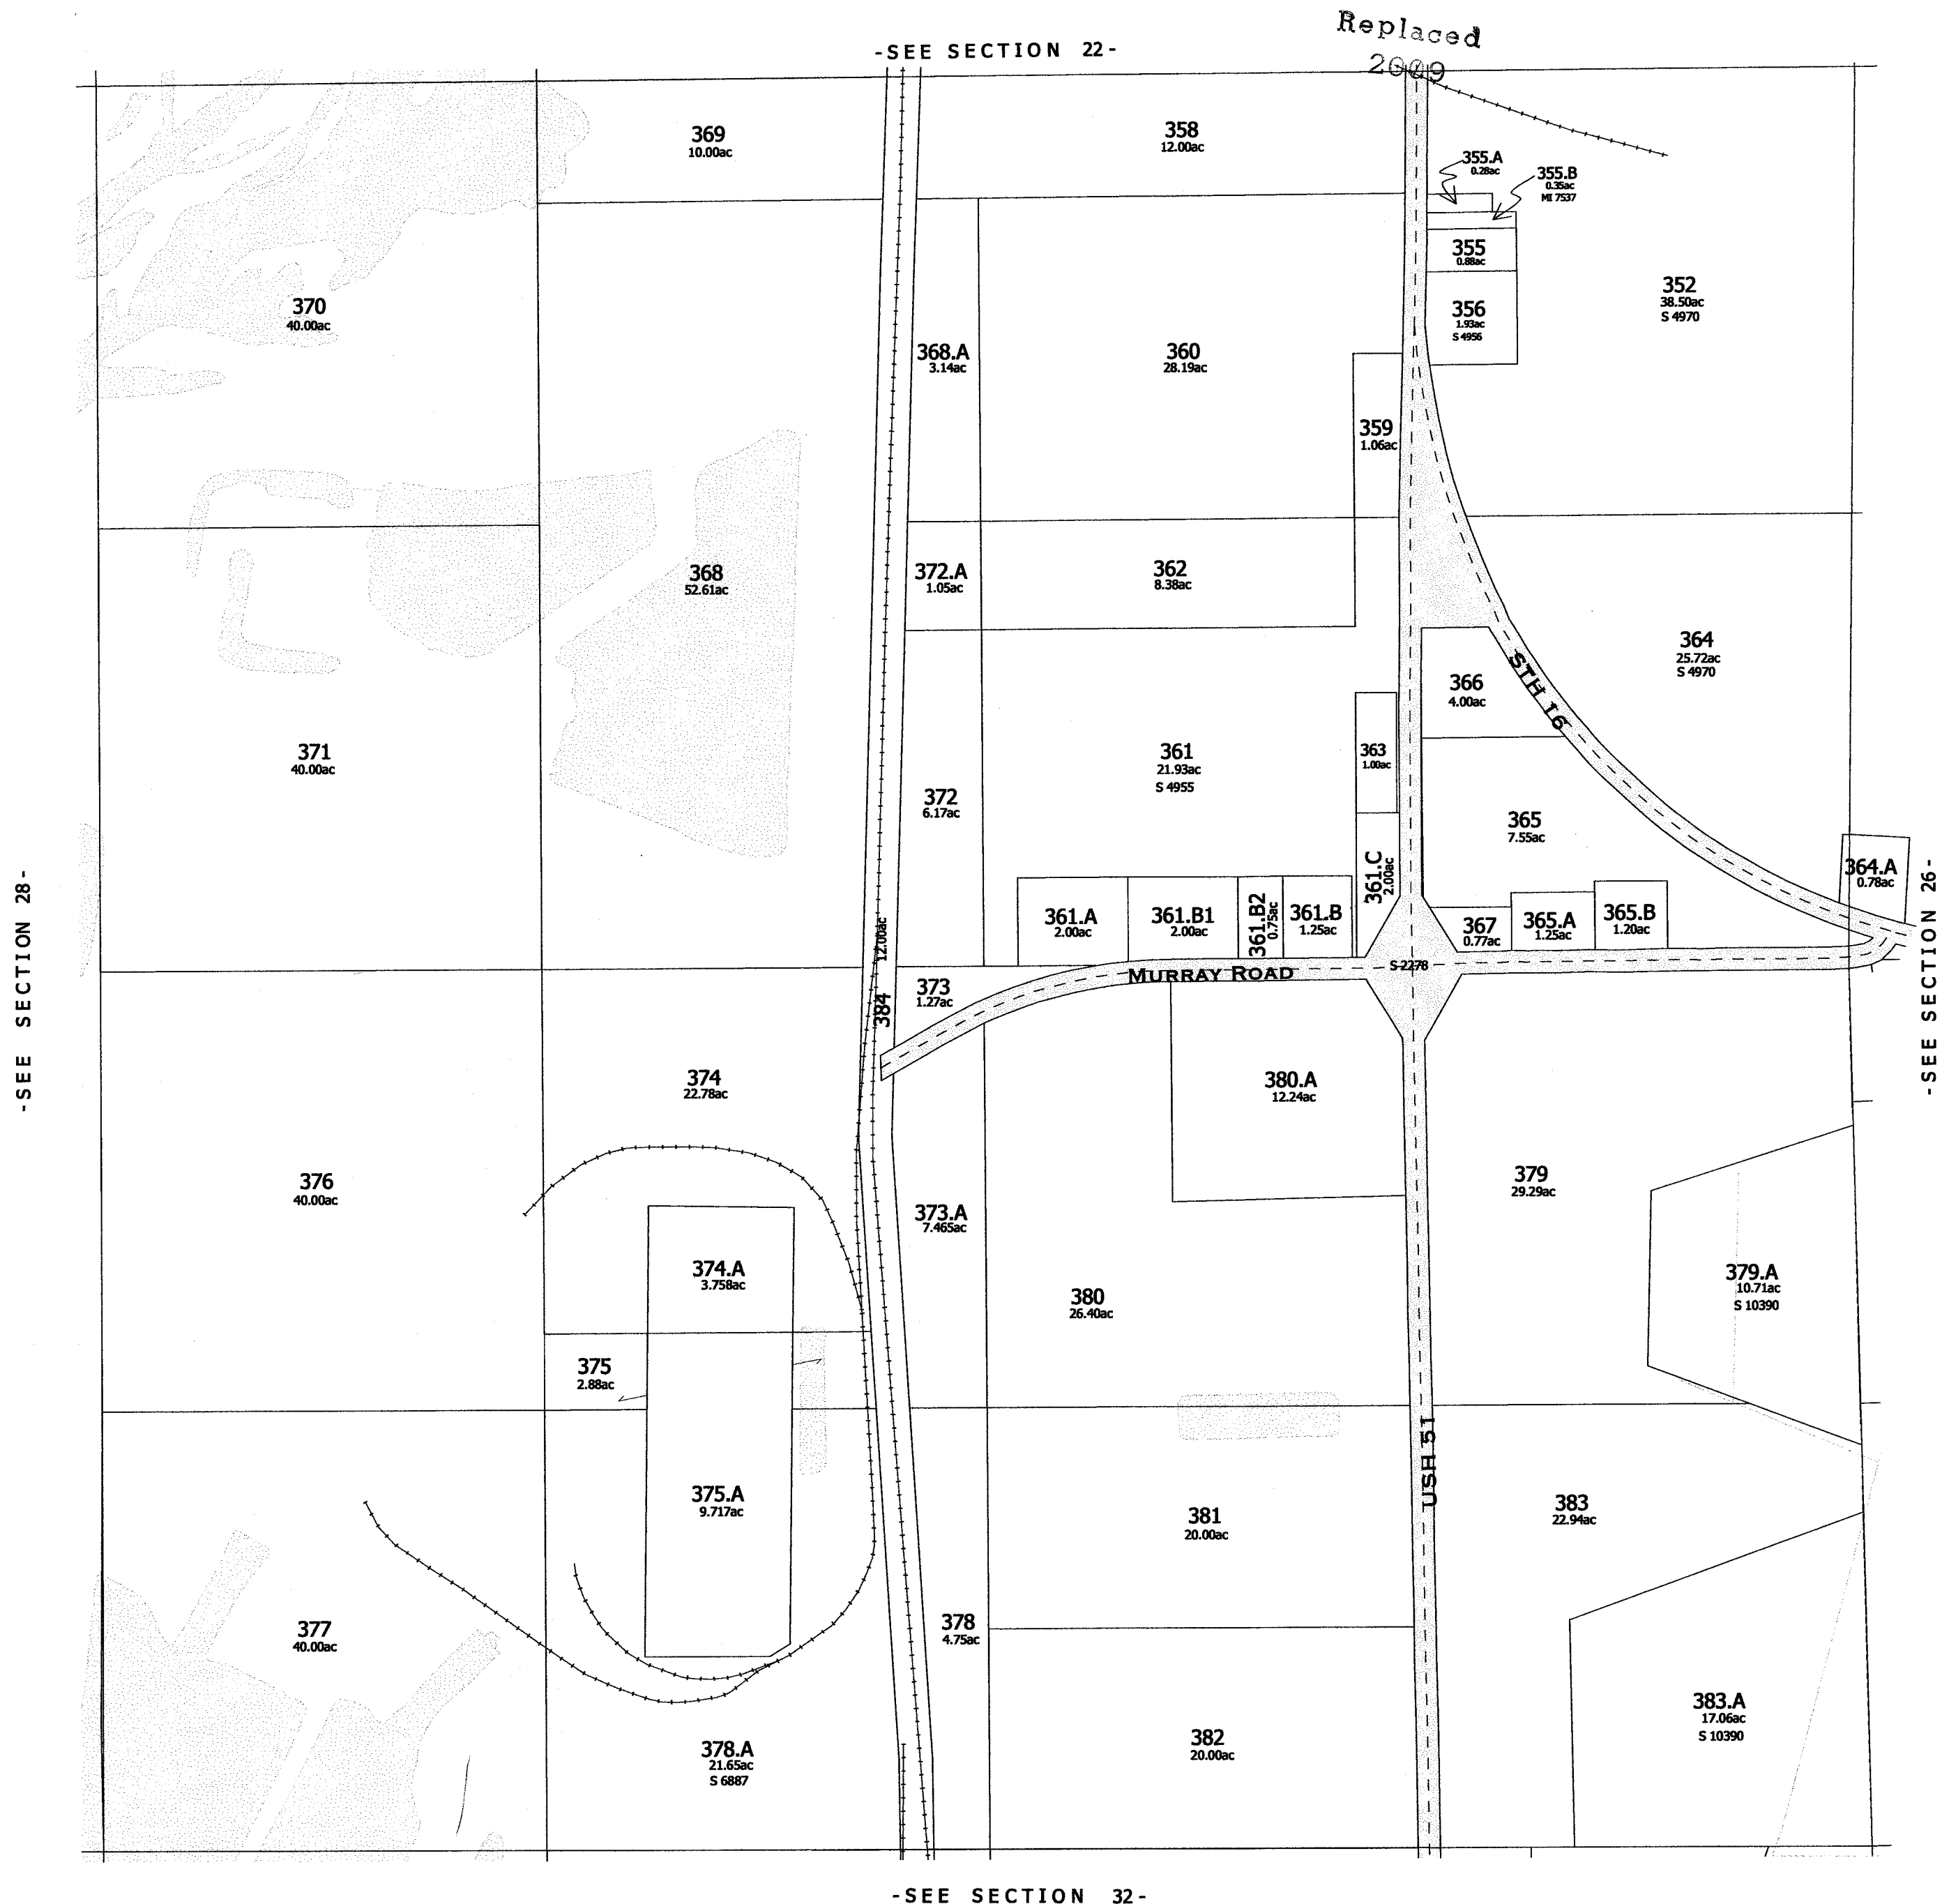

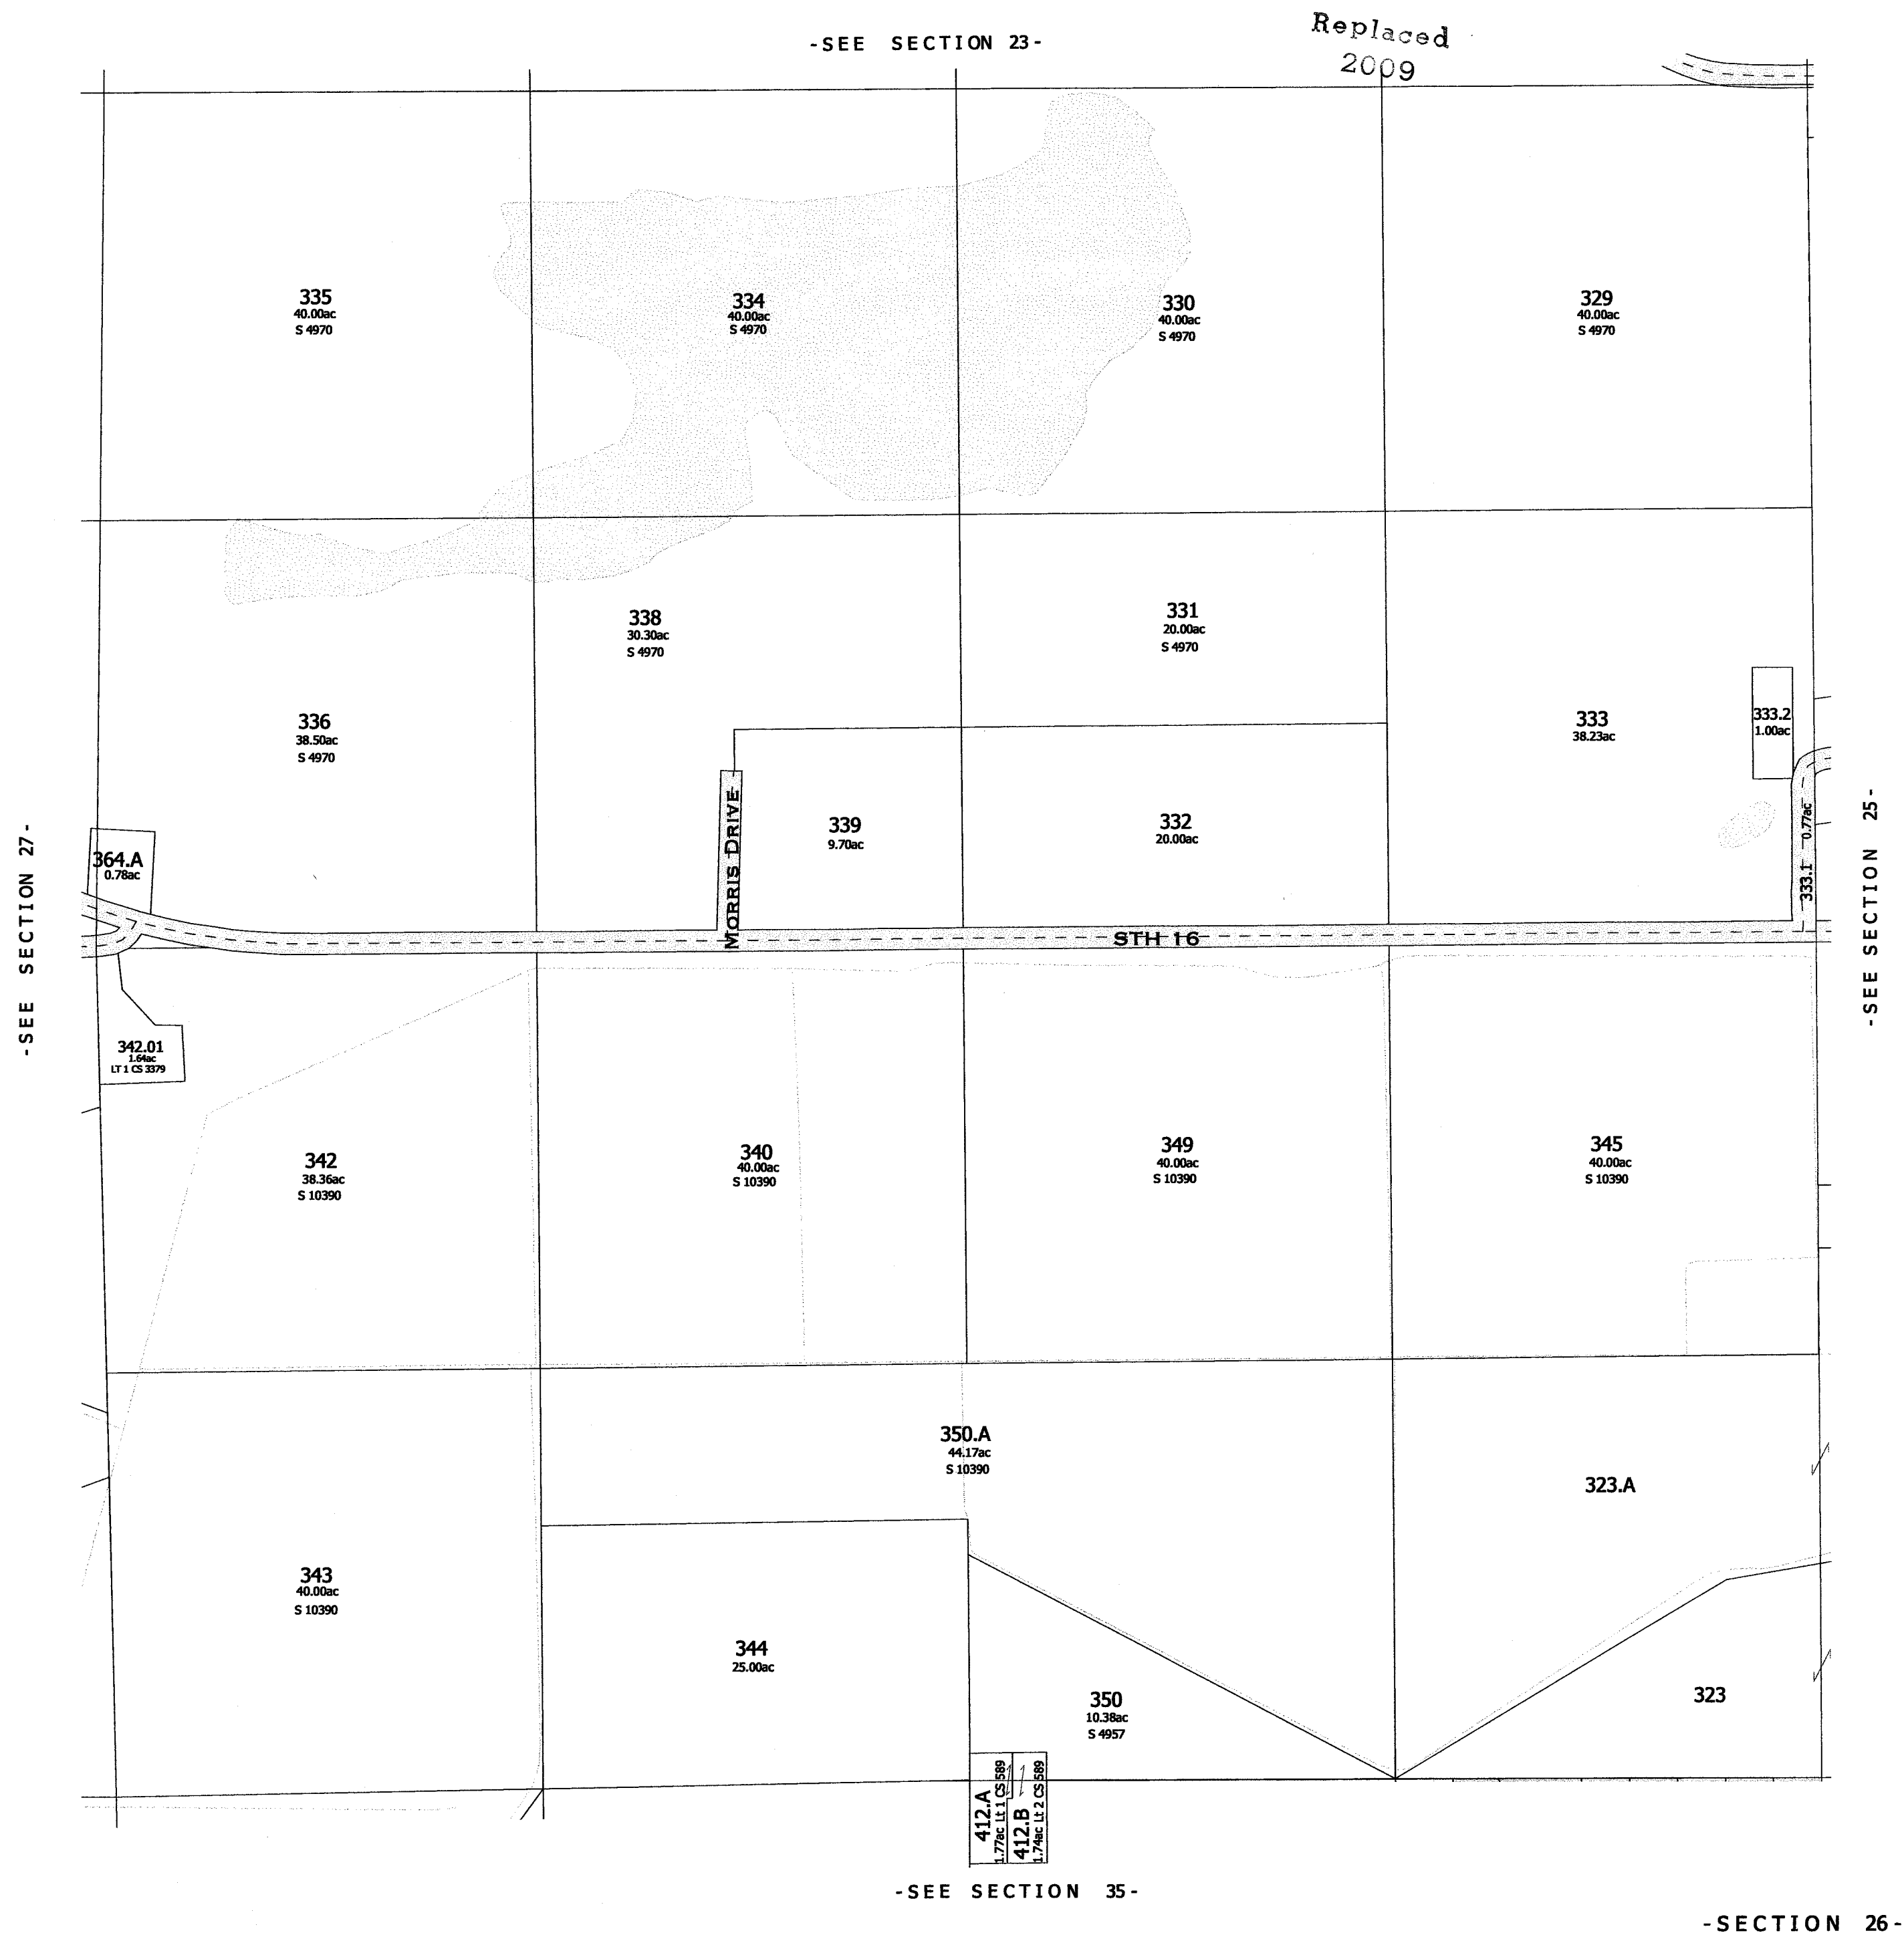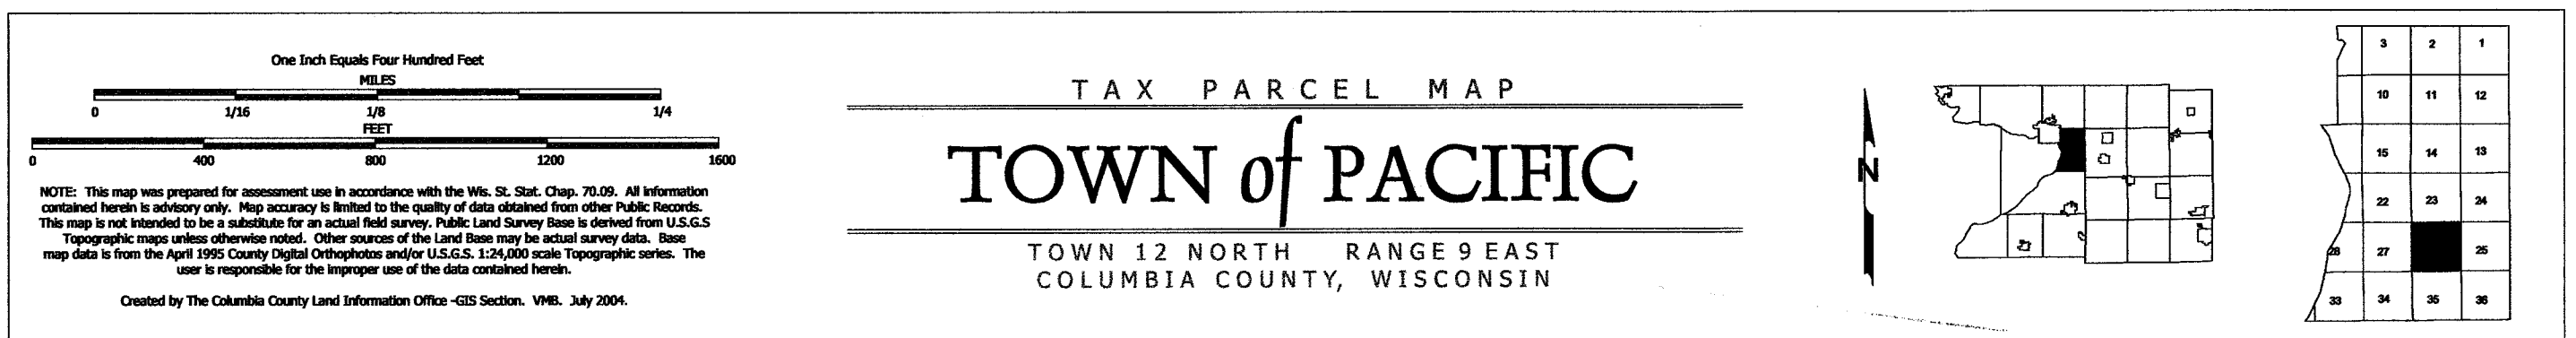

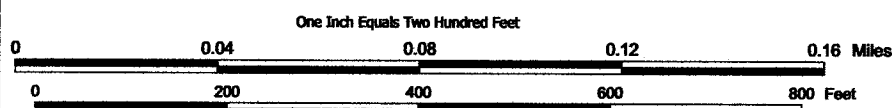


NOTE: This map was prepared for assessment use in accordance with the Wis. St. Stat. Chap. 70.09. All information contained herein is advisory only. Map accuracy is limited to the quality of data obtained from other Public Records. This map is not intended to be a substitute for an actual field survey. Public Land Survey Base is derived from U.S.G.S. Topographic maps unless otherwise noted. Other sources of the Land Base may be actual survey data. Base map data is from the April 1995 County Digital Orthophotos and/or U.S.G.S. 1:24,000 scale Topographic series. The user is responsible for the improper use of the data contained herein.

Created by The Columbia County Land Information Office -GIS Section. VMB. July 2004.

TAX PARCEL MAP

TOWN of PACIFIC


TOWN 12 NORTH RANGE 9 EAST
COLUMBIA COUNTY, WISCONSIN

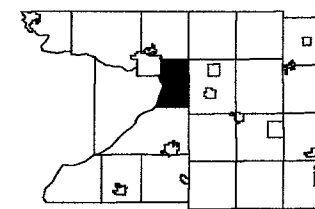

3	2	1
10	11	12
15	14	13
22	23	24
28	27	26
33	34	35


Replaced
2009

-SEE SECTION 25-

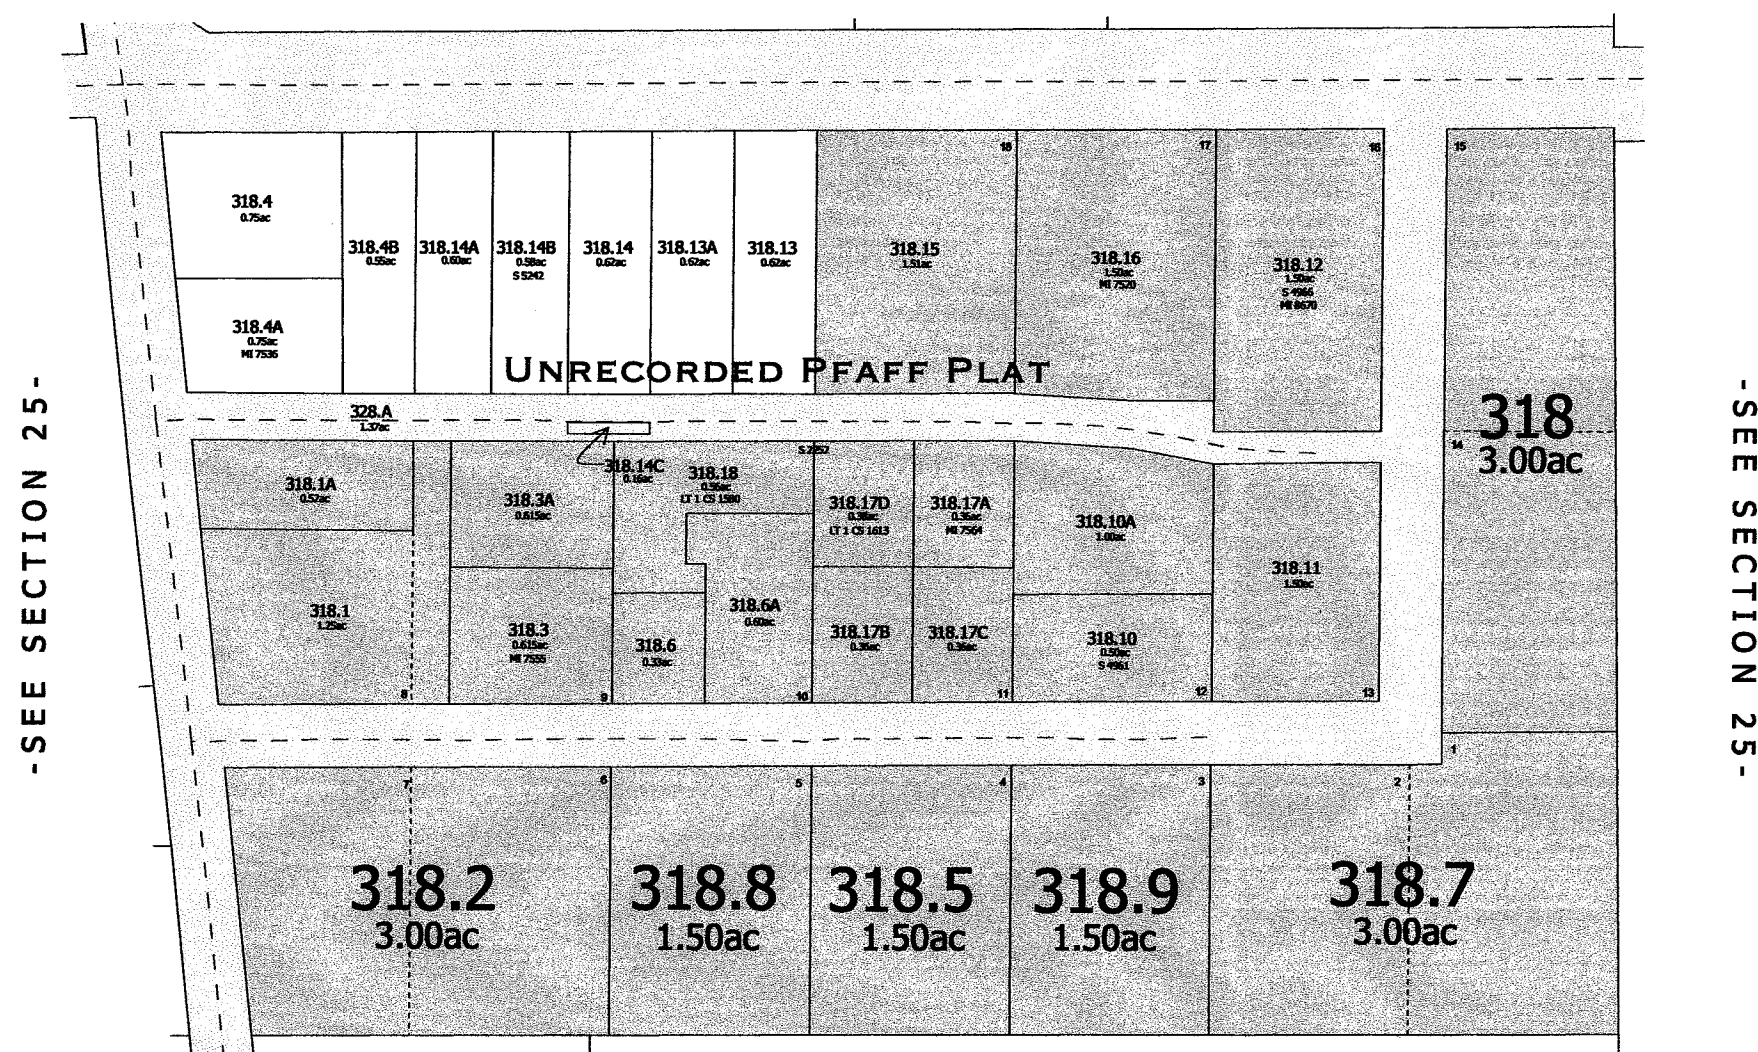

-SEE SECTION 25-


UNRECORDED PFAFF PLAT - S4963

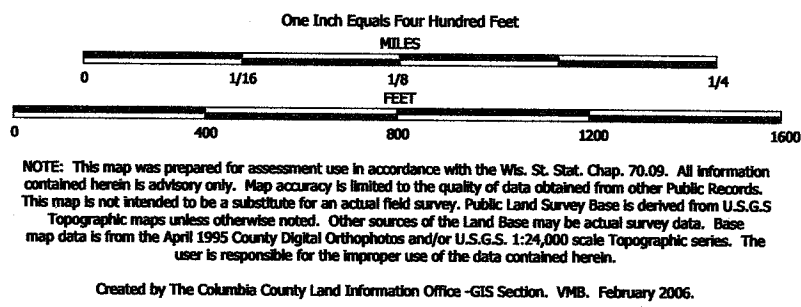


TAX PARCEL MAP

TOWN of PACIFIC

TOWN 12 NORTH RANGE 9 EAST
COLUMBIA COUNTY, WISCONSIN

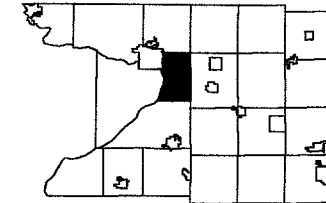

3	2	1
10	11	12
15	14	13
22	23	24
29	27	26
33	34	35

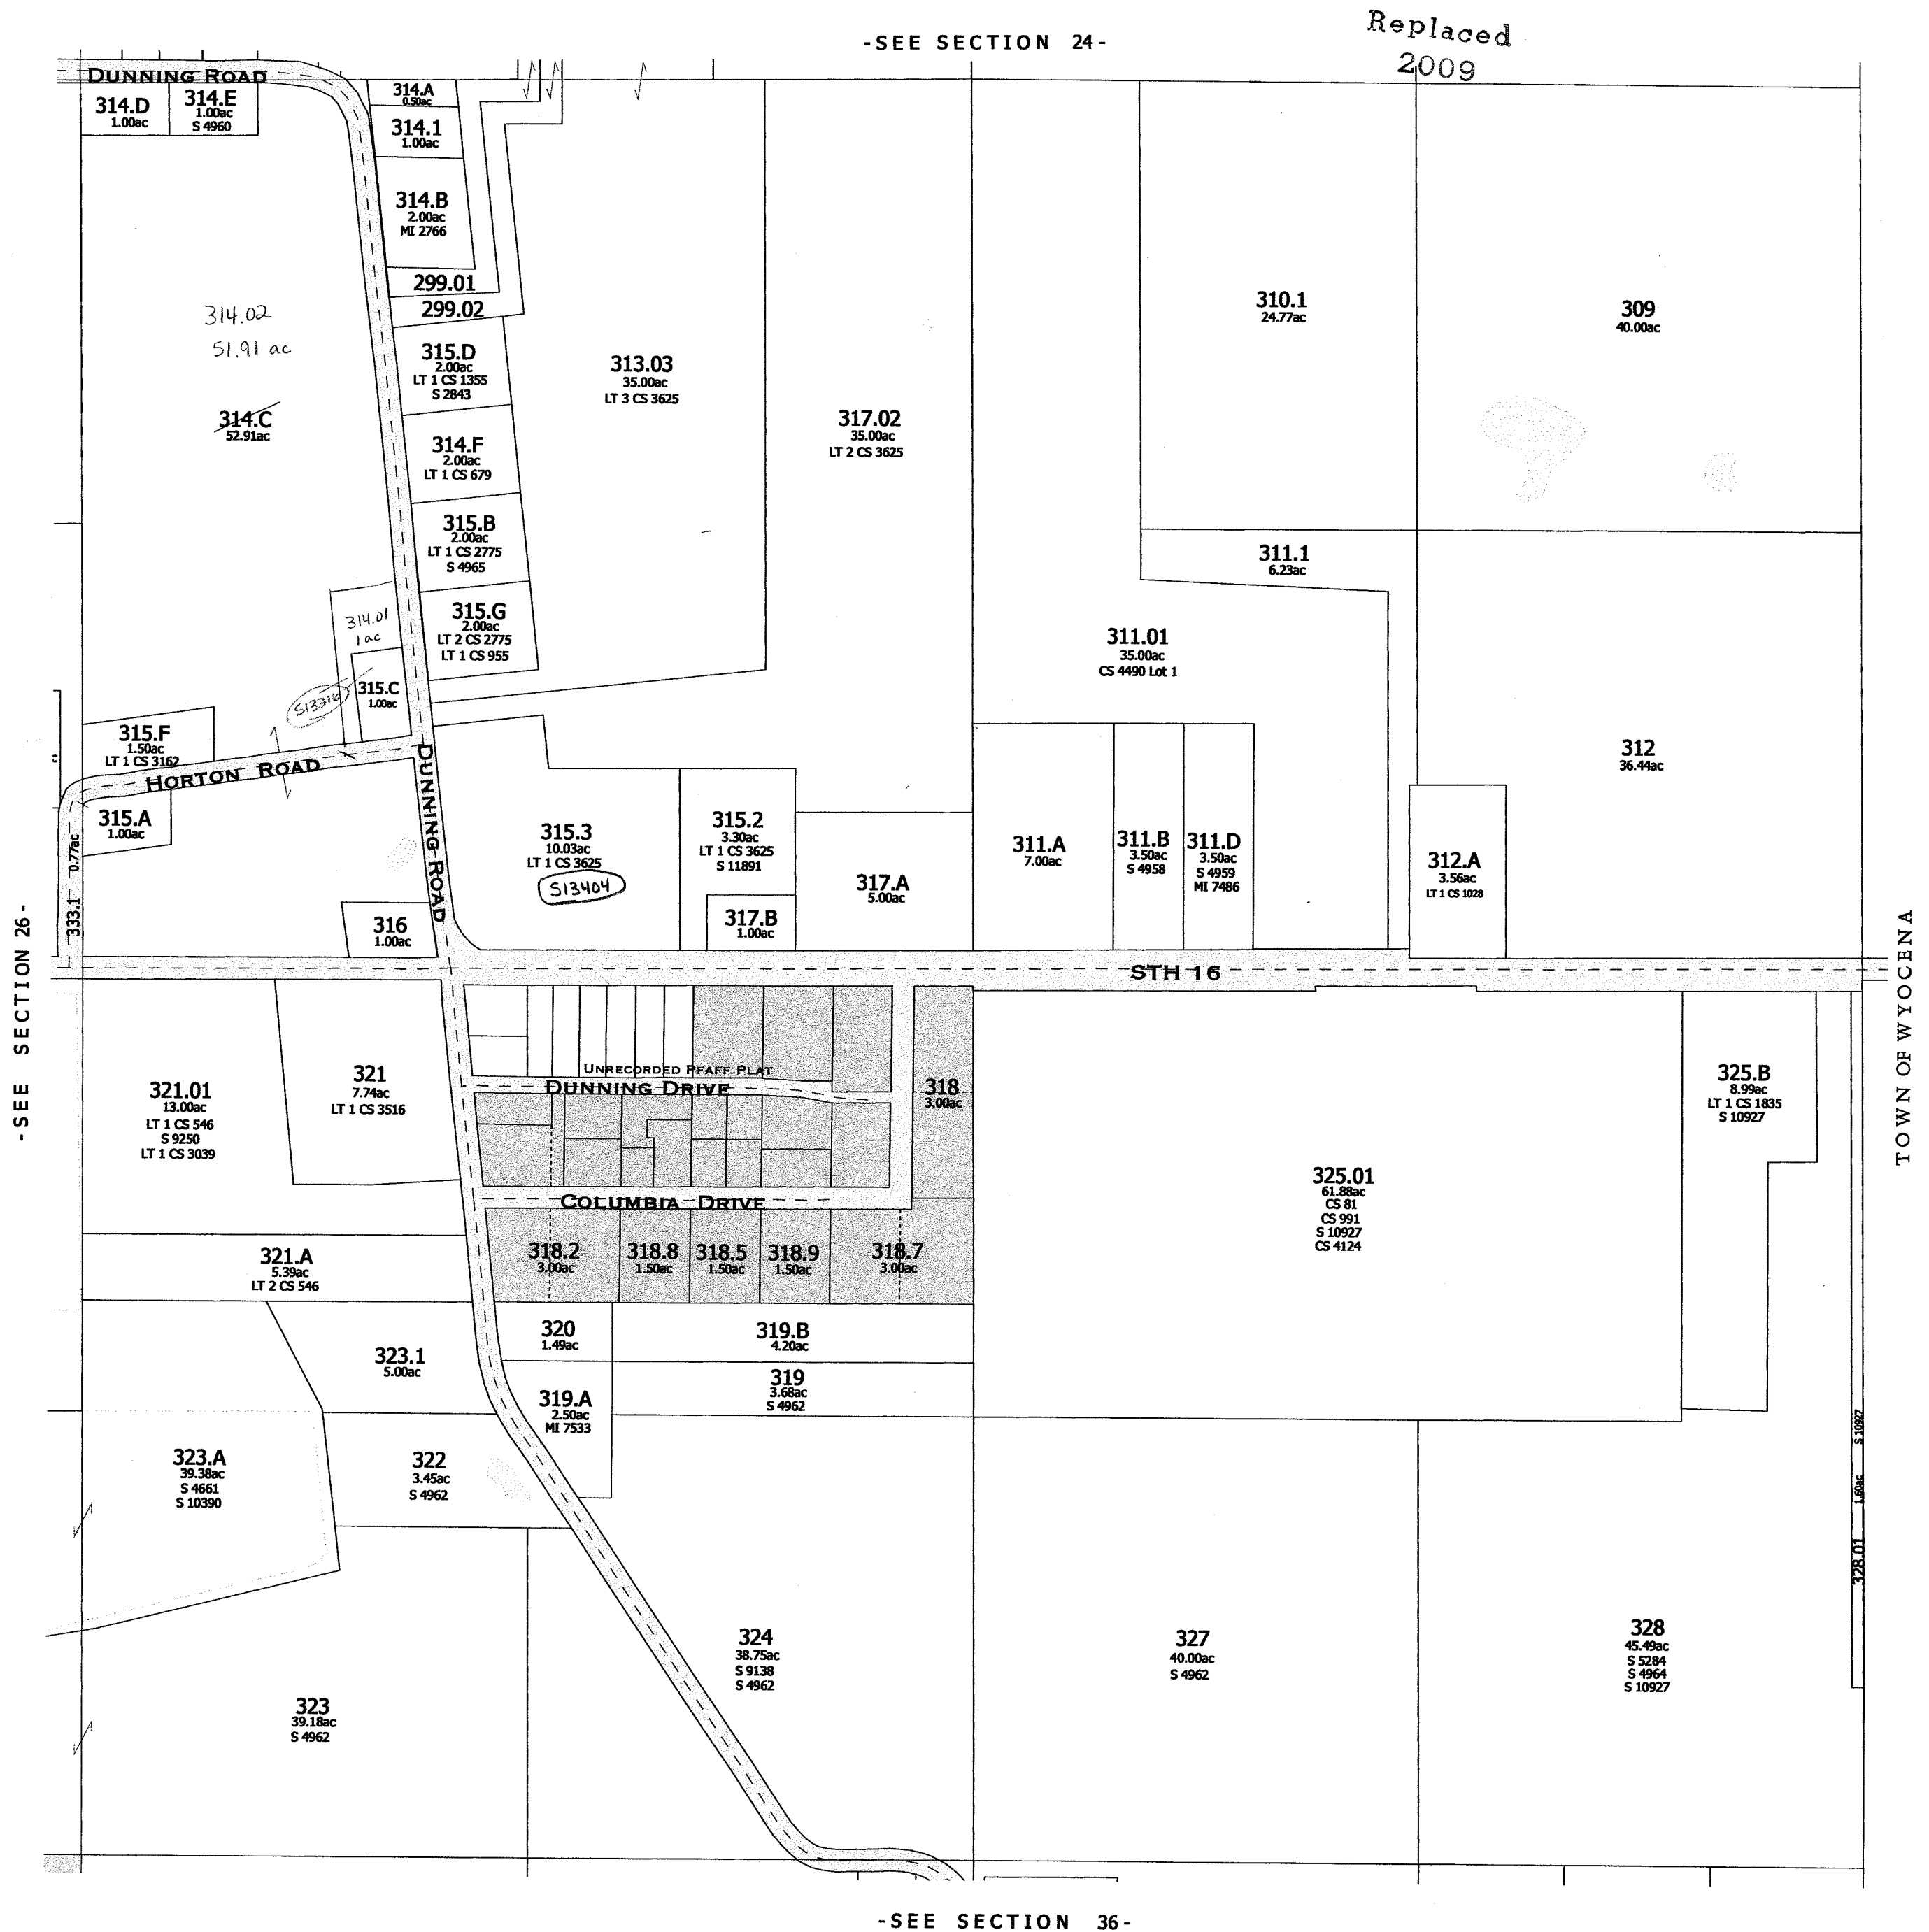

FOR DETAILED MAP OF SUBDIVISION AND SMALL PARCELS, SEE NEXT PAGE.

UNRECORDED PFAFF PLAT - S4963

One Inch Equals Four Hundred Feet

MILES
0 1/16 1/8 1/4

FEET
0 400 800 1200 1600


NOTE: This map was prepared for assessment use in accordance with the Wis. Stat. Chap. 70.09. All information contained herein is advisory only. Map accuracy is limited to the quality of data obtained from other Public Records. This map is not intended to be a substitute for an actual field survey. Public Land Survey Base is derived from U.S.G.S. Topographic maps unless otherwise noted. Other sources of the Land Base may be actual survey data. Base map data is from the April 1995 County Digital Orthophotos and/or U.S.G.S. 1:24,000 scale Topographic series. The user is responsible for the improper use of the data contained herein.

Created by The Columbia County Land Information Office -GIS Section. VMB. July 2004.


TAX PARCEL MAP


TOWN of PACIFIC

TOWN 12 NORTH RANGE 9 EAST
COLUMBIA COUNTY, WISCONSIN

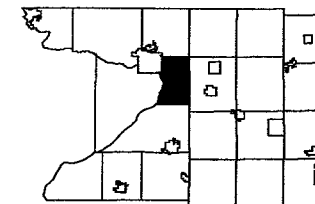

3	2	1
10	11	12
15	14	13
22	23	
28	27	26
33	34	35

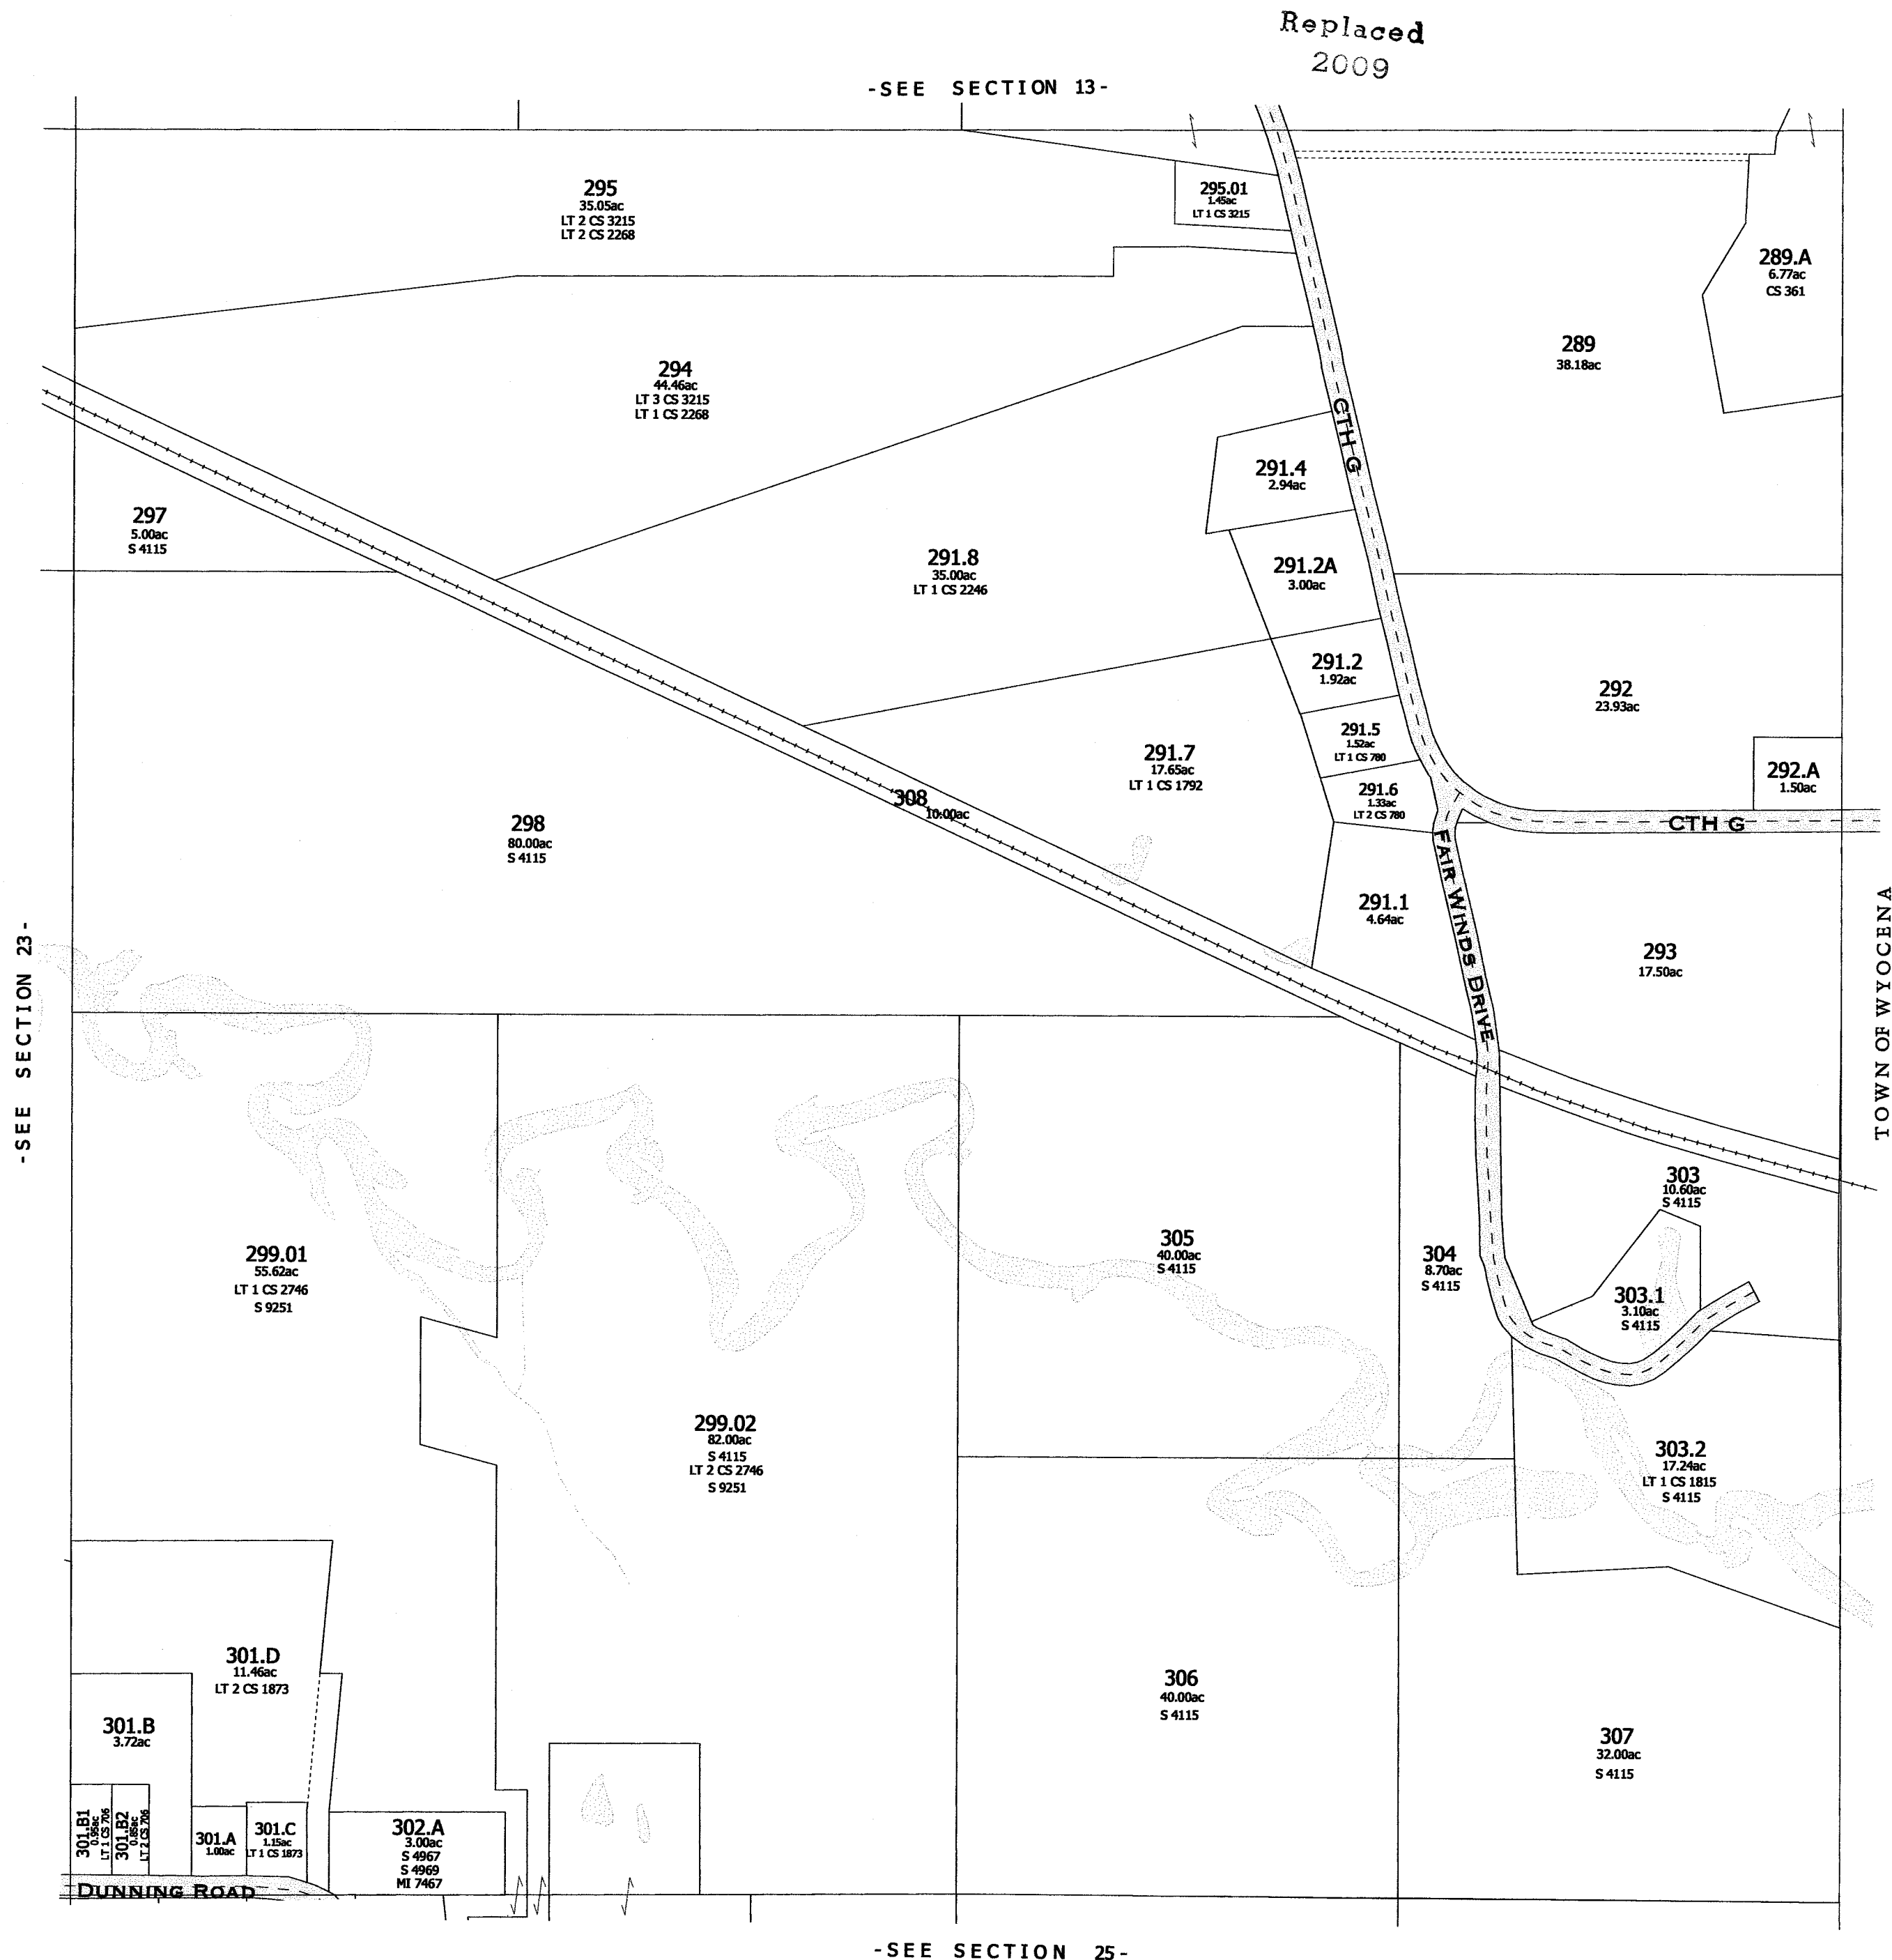

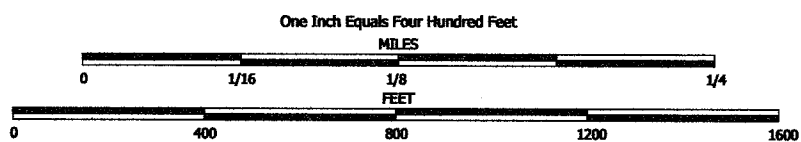


NOTE: This map was prepared for assessment use in accordance with the Wis. St. Stat. Chap. 70.09. All information contained herein is advisory only. Map accuracy is limited to the quality of data obtained from other Public Records. This map is not intended to be a substitute for an actual field survey. Public Land Survey Base is derived from U.S.G.S. Topographic maps unless otherwise noted. Other sources of the Land Base may be actual survey data. Base map data is from the April 1995 County Digital Orthophotos and/or U.S.G.S. 1:24,000 scale Topographic series. The user is responsible for the improper use of the data contained herein.

Created by The Columbia County Land Information Office -GIS Section. VMB. July 2004.


TAX PARCEL MAP


TOWN of PACIFIC

TOWN 12 NORTH RANGE 9 EAST
COLUMBIA COUNTY, WISCONSIN

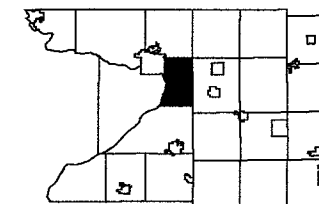

	3	2	1
10	11	12	
15	14	13	
22	24		
28	27	26	25
33	34	35	36

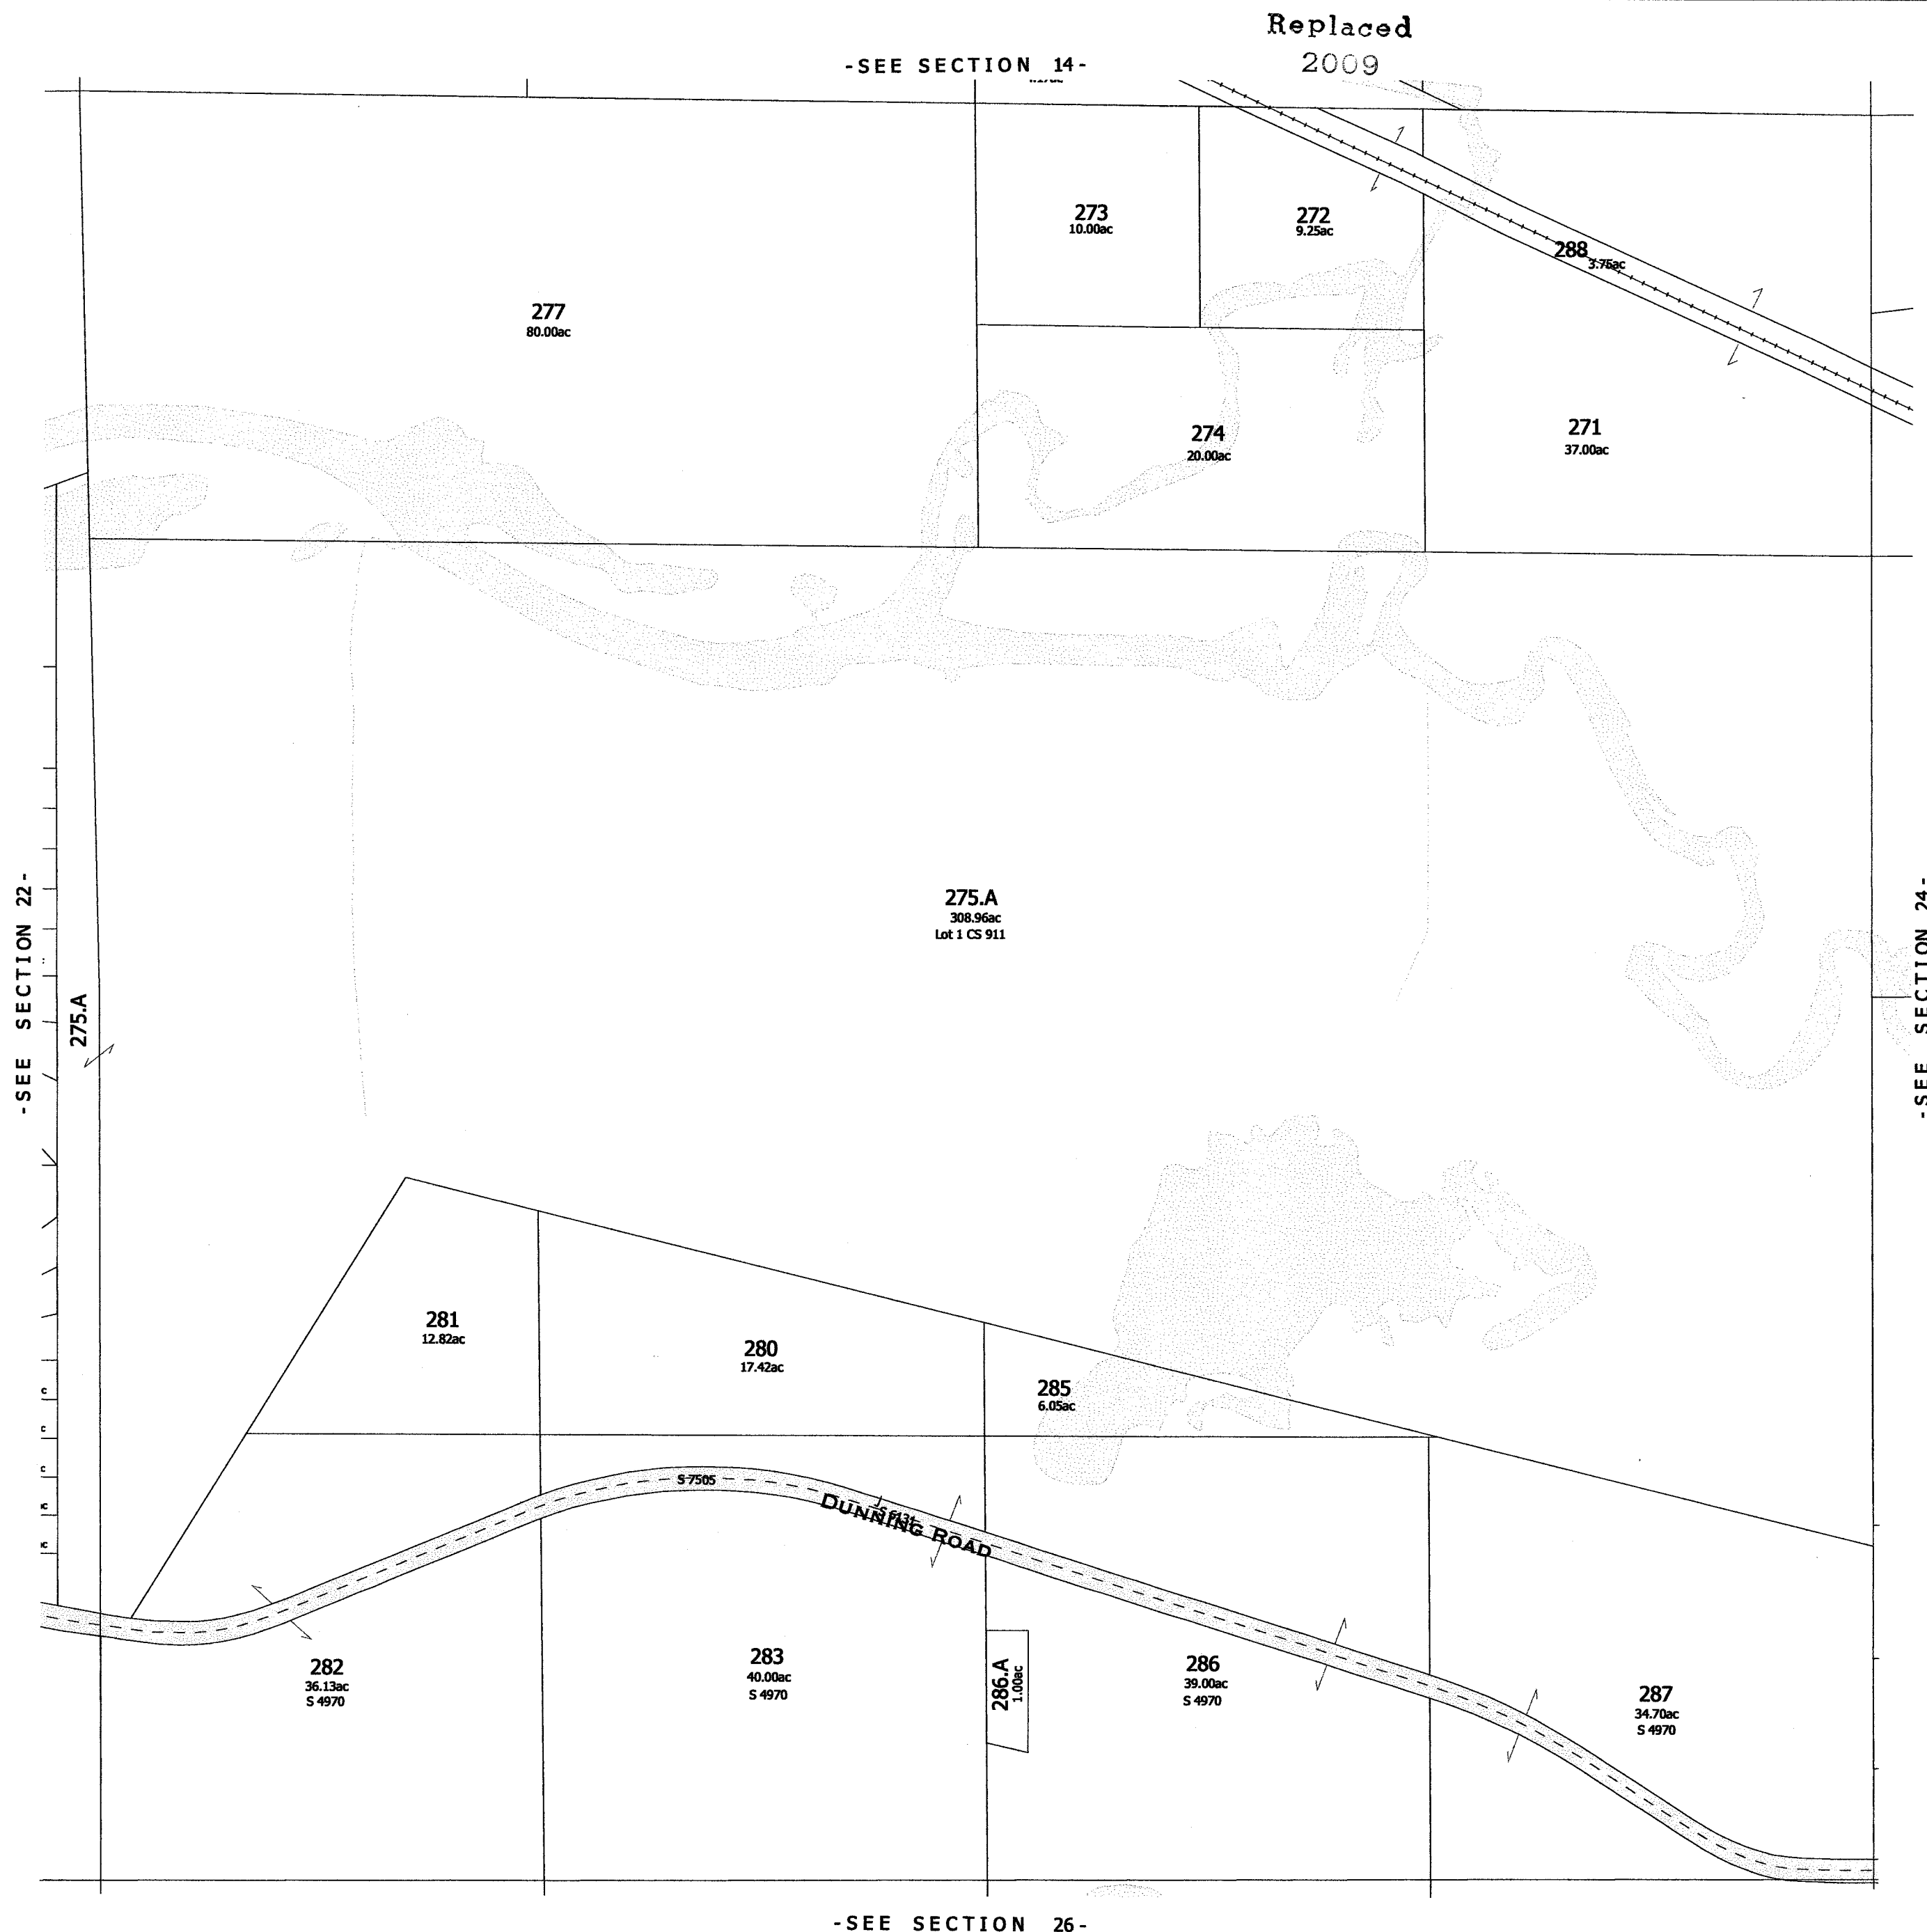


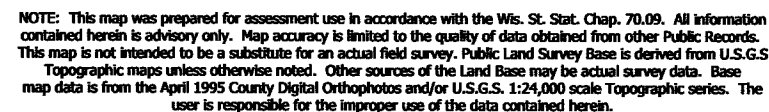

Created by The Columbia County Land Information Office -GIS Section. VMB. February 2007.

TOWN of PACIFIC

TOWN 12 NORTH RANGE 9 EAST
COLUMBIA COUNTY, WISCONSIN

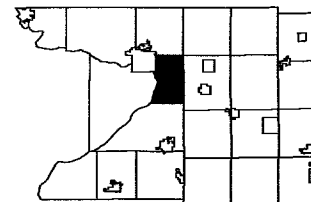

Replaced
2009

-SEE SECTION 15-


-SEE SECTION 21-

-SEE SECTION 23-

- SEE SECTION 27 -

- SECTION 22 -

HILLCREST HEIGHTS - S7368
HILLCREST HEIGHTS 1ST ADDITION - S7369

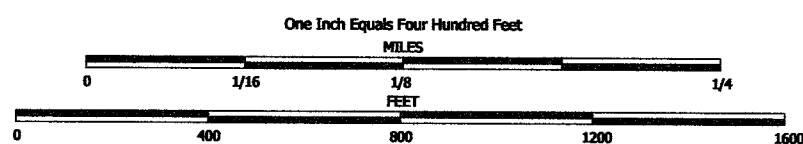


NOTE: This map was prepared for assessment use in accordance with the Wis. Stat. Chap. 70.05. All information contained herein is advisory only. Map accuracy is limited to the quality of data obtained from other Public Records. This map is not intended to be a substitute for an actual field survey. Public Land Survey Base is derived from U.S.G.S Topographic maps unless otherwise noted. Other sources of the Land Base may be actual survey data. Base map data is from the April 1995 County Digital Orthophotos and/or U.S.G.S 1:24,000 scale Topographic series. The user is responsible for the improper use of the data contained herein.

Created by The Columbia County Land Information Office -GIS Section. VMB. February 2006.

TAX PARCEL MAP

TOWN of PACIFIC

TOWN 12 NORTH RANGE 9 EAST
COLUMBIA COUNTY, WISCONSIN

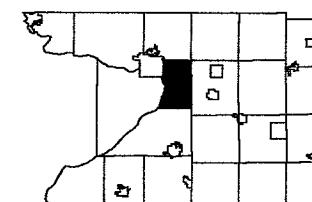

	3	2	1
	10	11	12
	15	14	13
	22	23	24
26	27	28	25
33	34	35	36

Replaced
2009

-SEE SECTION 16-

-TOWN OF CALEDONIA-


247
197.50ac

-SEE SECTION 22-

246
45.00ac

-SEE SECTION 28-

-SECTION 21-

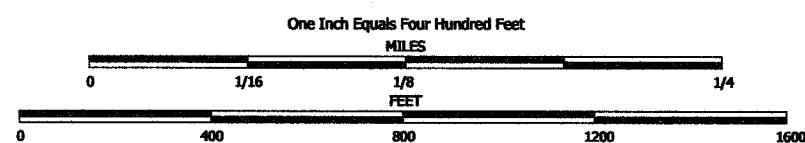


NOTE: This map was prepared for assessment use in accordance with the Wis. St. Stat. Chap. 70.09. All information contained herein is advisory only. Map accuracy is limited to the quality of data obtained from other Public Records. This map is not intended to be a substitute for an actual field survey. Public Land Survey Base is derived from U.S.G.S. Topographic maps unless otherwise noted. Other sources of the Land Base may be actual survey data. Base map data is from the April 1995 County Digital Orthophotos and/or U.S.G.S. 1:24,000 scale Topographic series. The user is responsible for the improper use of the data contained herein.

Created by The Columbia County Land Information Office -GIS Section. VMB. February 2005.


TAX PARCEL MAP

TOWN of PACIFIC

TOWN 12 NORTH RANGE 9 EAST
COLUMBIA COUNTY, WISCONSIN

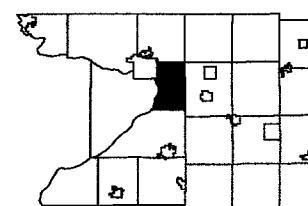

	3	2	1
10	11	12	
15	14	13	
22	23	24	
27	26	25	
33	34	35	36

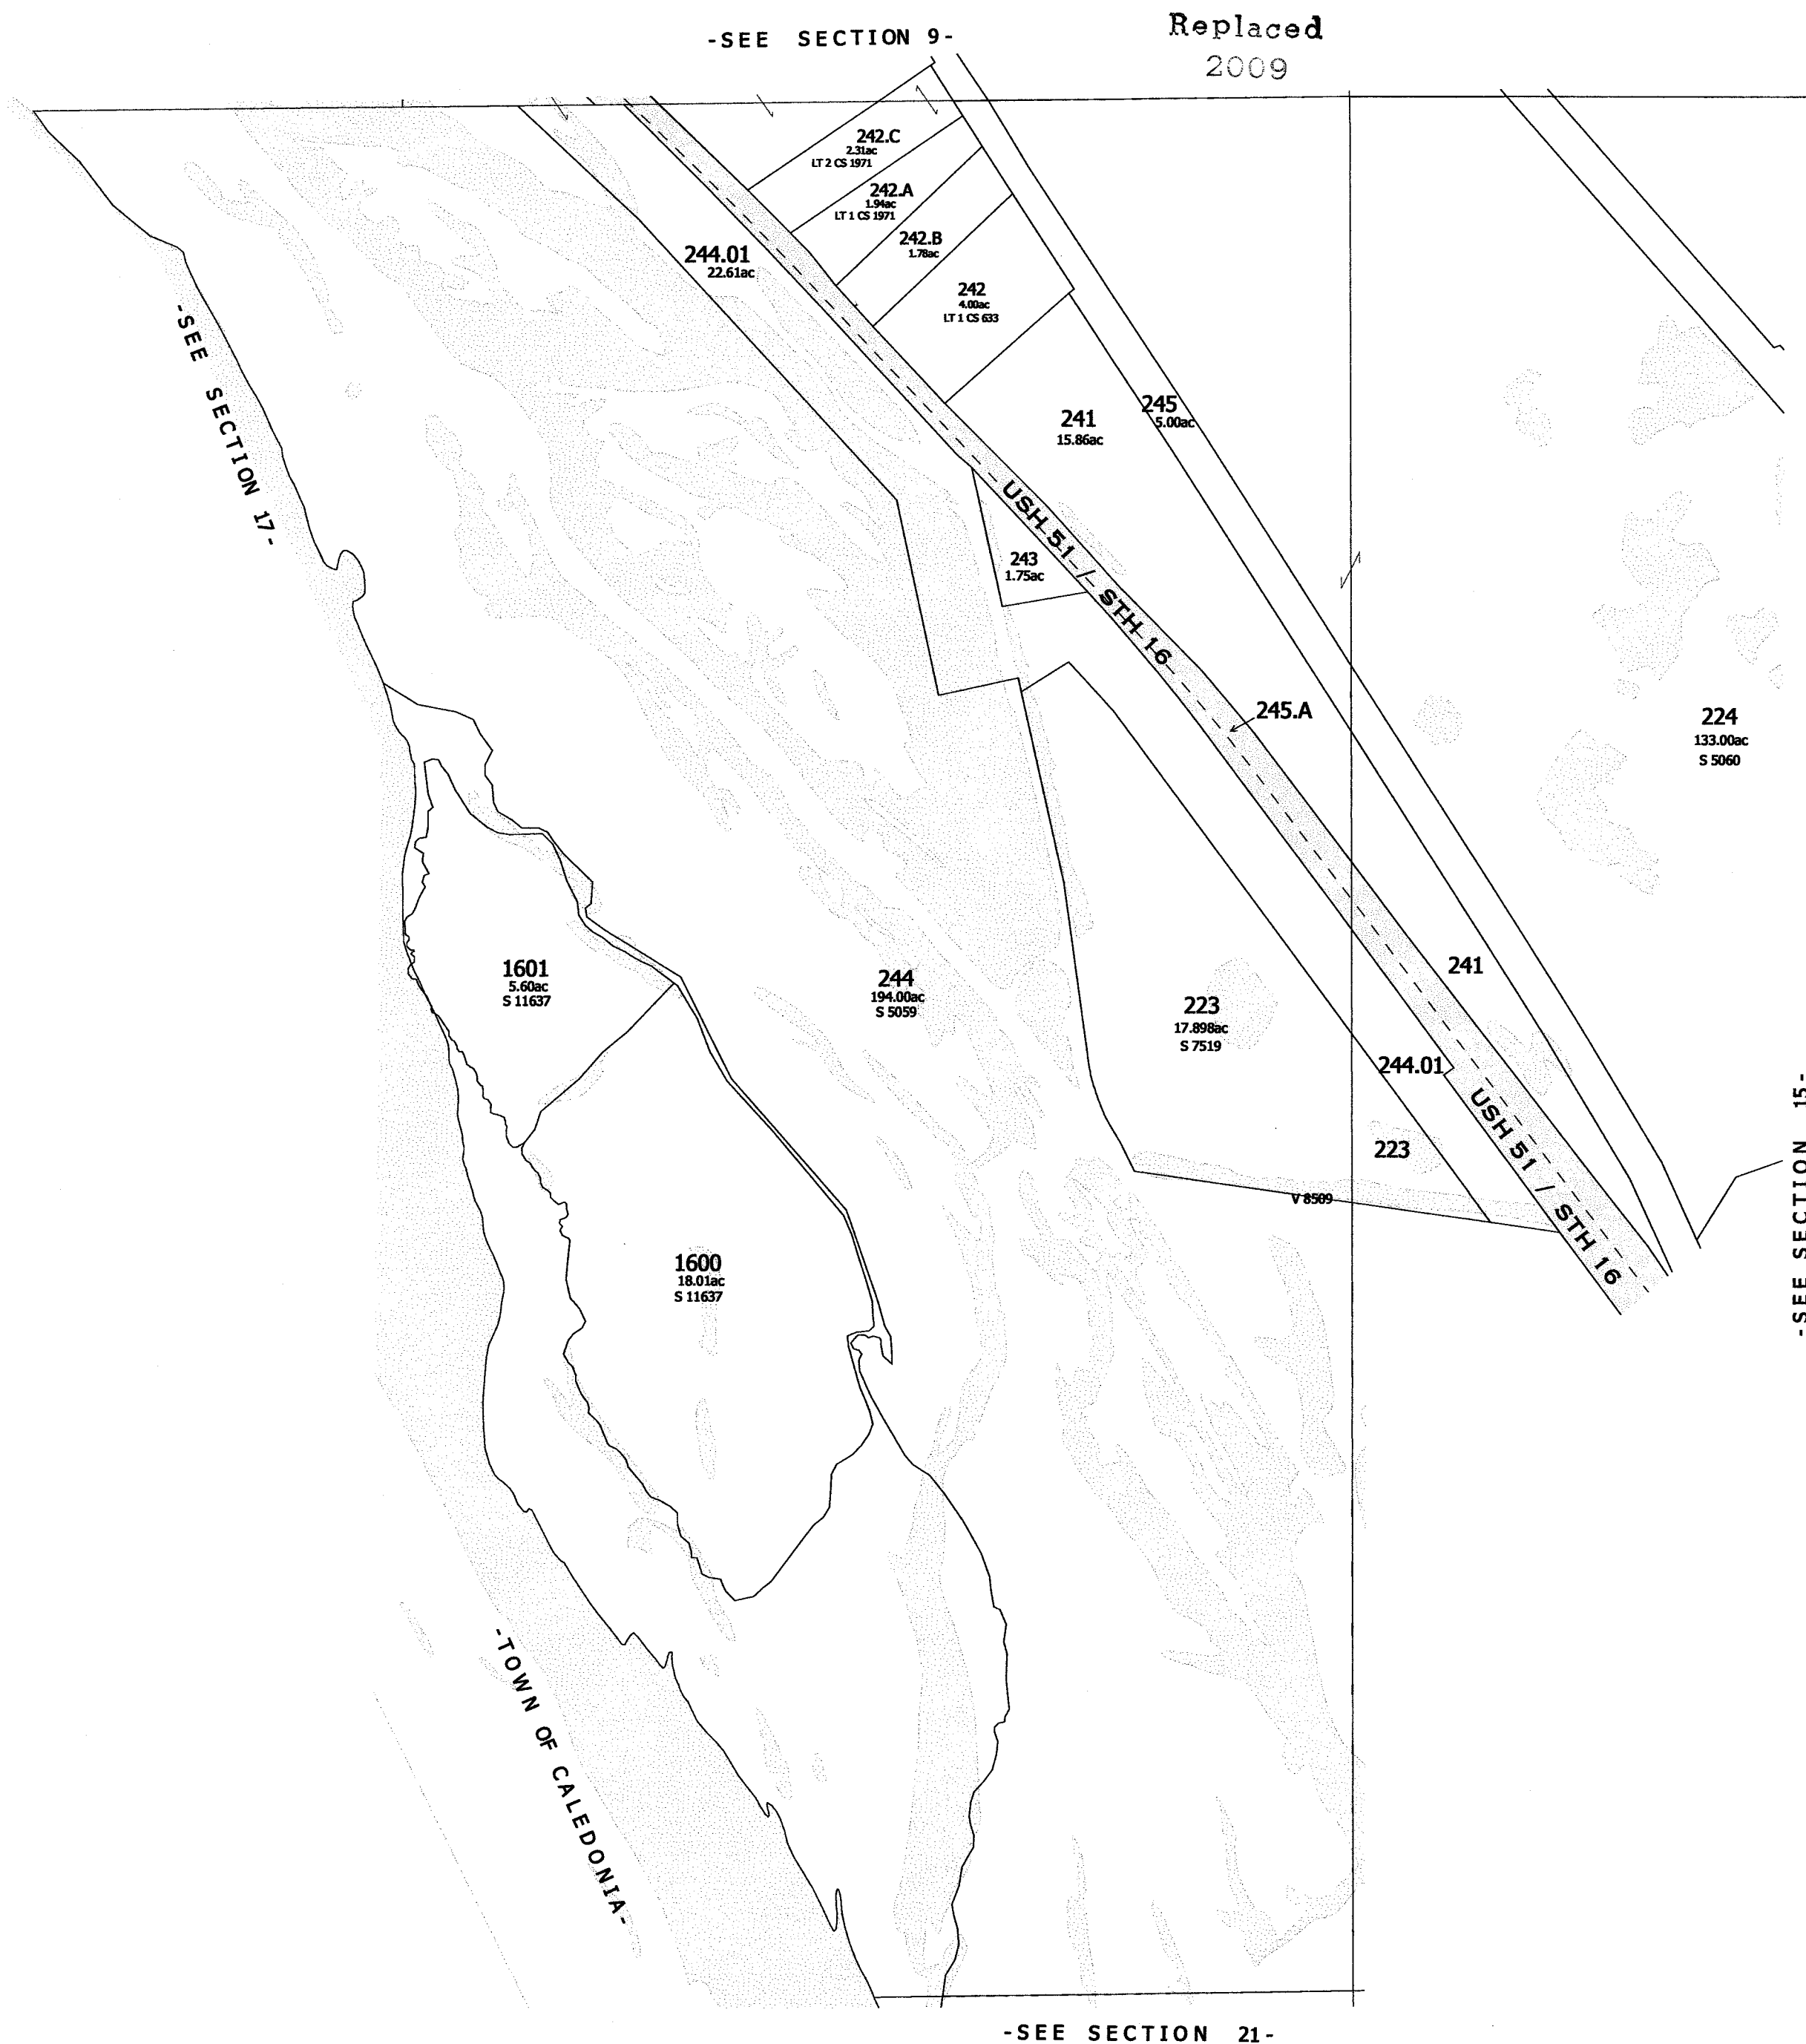

One Inch Equals Four Hundred Feet
MILES
0 1/16 1/8 1/4
FEET
0 400 800 1200 1600


NOTE: This map was prepared for assessment use in accordance with the Wis. St. Stat. Chap. 70.09. All information contained herein is advisory only. Map accuracy is limited to the quality of data obtained from other Public Records. This map is not intended to be a substitute for an actual field survey. Public Land Survey Base is derived from U.S.G.S. Topographic maps unless otherwise noted. Other sources of the Land Base may be actual survey data. Base map data is from the April 1995 County Digital Orthophotos and/or U.S.G.S. 1:24,000 scale Topographic series. The user is responsible for the improper use of the data contained herein.

Created by The Columbia County Land Information Office -GIS Section. VMB. July 2004.

TAX PARCEL MAP

TOWN of PACIFIC

TOWN 12 NORTH RANGE 9 EAST
COLUMBIA COUNTY, WISCONSIN

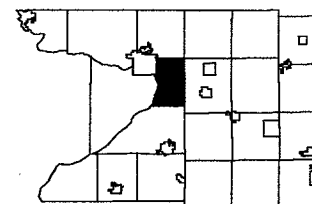

3	2	1
10	11	12
22	23	24
28	27	26
33	34	35

Replaced
2009


-SEE SECTION 10-



-SEE SECTION 22-

GEIKE ESTATES - REGISTER OF DEEDS 181A
MEADOWVIEW PLAT - ROD 155

-SECTION 15-

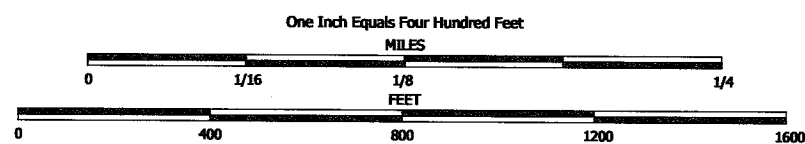


NOTE: This map was prepared for assessment use in accordance with the Wis. St. Stat. Chap. 70.09. All information contained herein is advisory only. Map accuracy is limited to the quality of data obtained from other Public Records. This map is not intended to be a substitute for an actual field survey. Public Land Survey Base is derived from U.S.G.S Topographic maps unless otherwise noted. Other sources of the Land Base may be actual survey data. Base map data is from the April 1995 County Digital Orthophotos and/or U.S.G.S. 1:24,000 scale Topographic series. The user is responsible for the improper use of the data contained herein.

Created by The Columbia County Land Information Office -GIS Section. VMB. February 2007.

TAX PARCEL MAP

TOWN of PACIFIC


TOWN 12 NORTH RANGE 9 EAST
COLUMBIA COUNTY, WISCONSIN

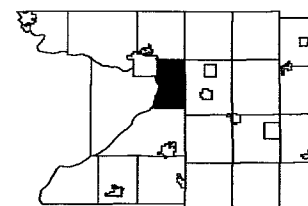

3	2	1
10	11	12
15	16	13
22	23	24
28	27	26
33	34	35

Replaced
2009

-SEE SECTION 11-

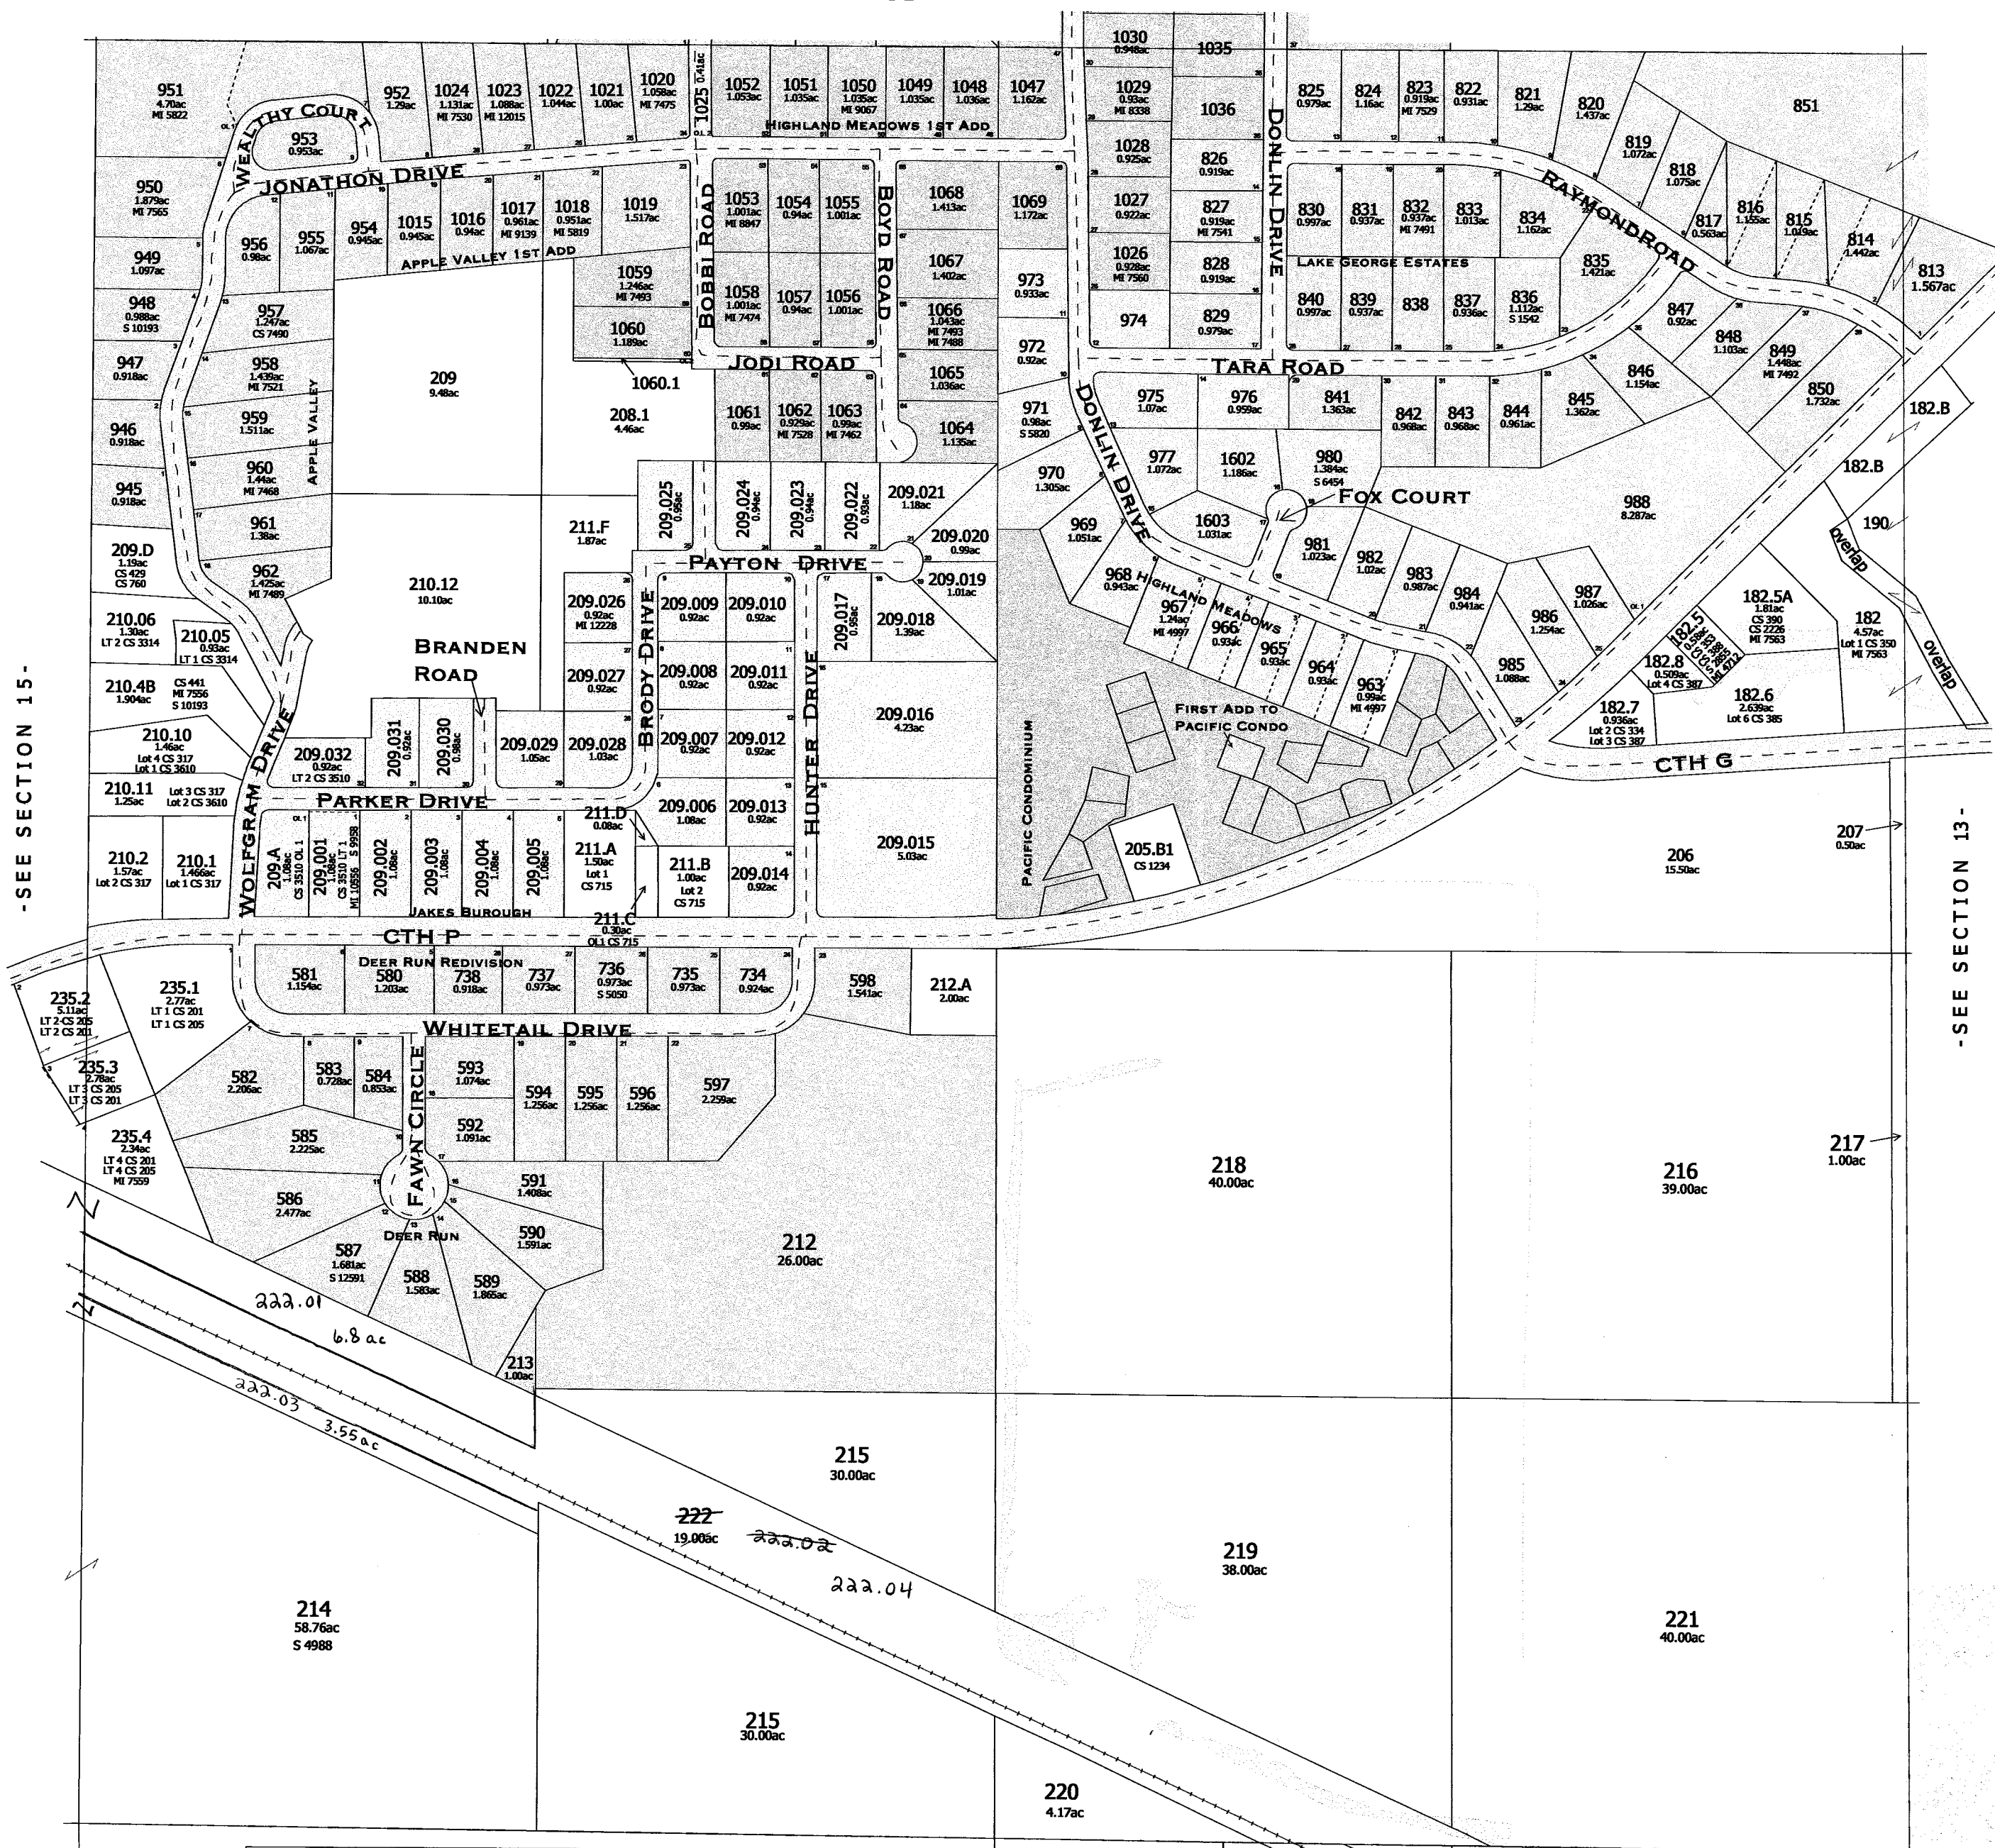


APPLE VALLEY - S1307
APPLE VALLEY 1ST ADDITION - S1311
DEER RUN - S4989
DEER RUN REDIVISION - REGISTER OF DEEDS 1718
HIGHLAND MEADOWS - S4999
HIGHLAND MEADOWS 1ST ADDITION - S1312
JAKE'S BOROUGH - S10683
LAKE GEORGE ESTATES - ROD 174A
PACIFIC CONDOMINIUM - S8505
FIRST ADDENDUM TO PACIFIC CONDOMINIUM - S12652

-SEE SECTION 23-

FOR DETAILED MAP OF CONDO PLAT, SEE NEXT PAGE.

-SECTION 14-

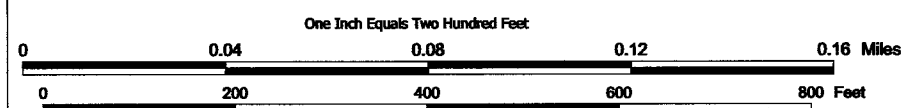


NOTE: This map was prepared for assessment use in accordance with the Wis. St. Stat. Chap. 70.09. All information contained herein is advisory only. Map accuracy is limited to the quality of data obtained from other Public Records. This map is not intended to be a substitute for an actual field survey. Public Land Survey Base is derived from U.S.G.S. Topographic maps unless otherwise noted. Other sources of the Land Base may be actual survey data. Base map data is from the April 1995 County Digital Orthophotos and/or U.S.G.S. 1:24,000 scale Topographic series. The user is responsible for the improper use of the data contained herein.

Created by The Columbia County Land Information Office -GIS Section. VMB. February 2007.

TAX PARCEL MAP

TOWN of PACIFIC

TOWN 12 NORTH RANGE 9 EAST
COLUMBIA COUNTY, WISCONSIN

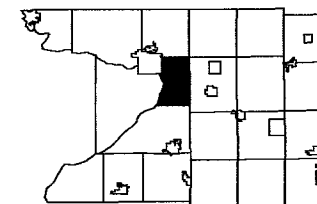


3	2	1
10	11	12
15	13	14
22	23	24
28	27	26
33	34	35

Replaced
2009

-SEE SECTION 14-


-SEE SECTION 14-

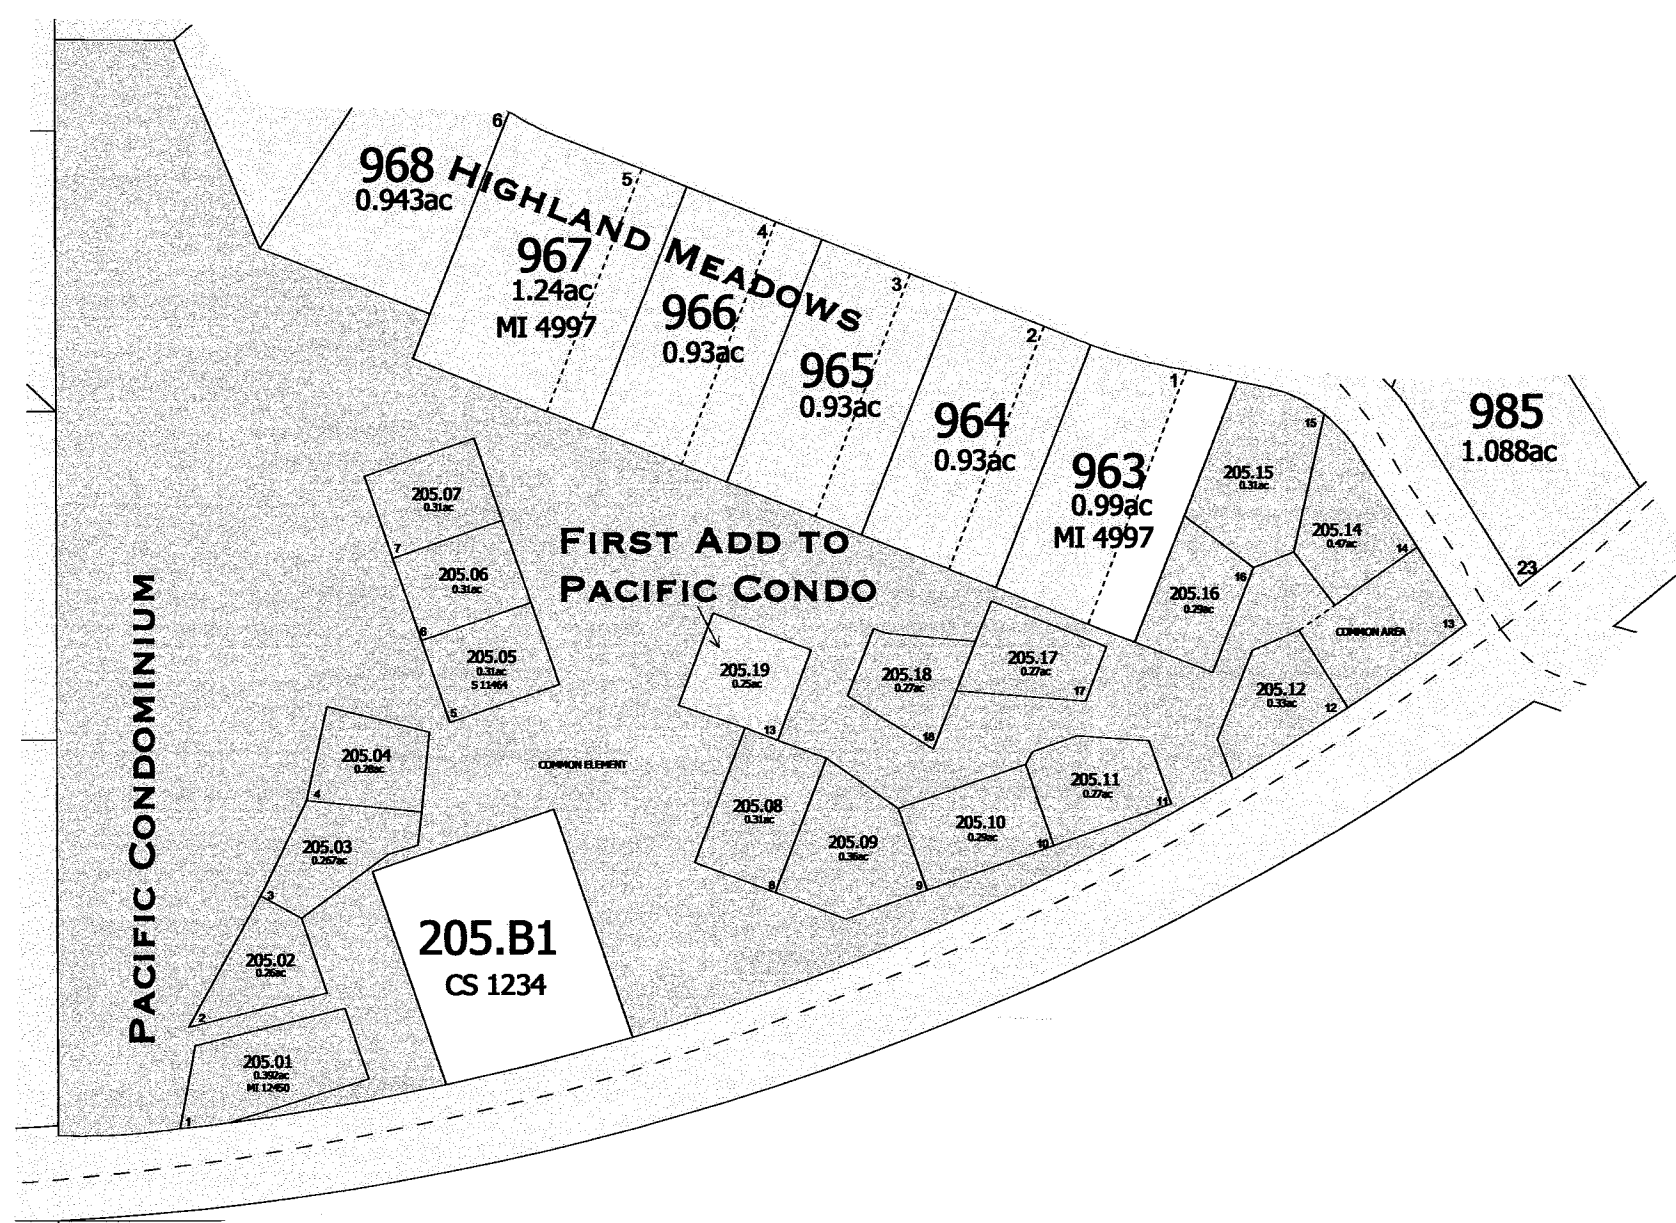

-SEE SECTION 14-

-SEE SECTION 14-

PACIFIC CONDOMINIUM - S8505
FIRST ADDENDUM TO PACIFIC CONDO - S12652

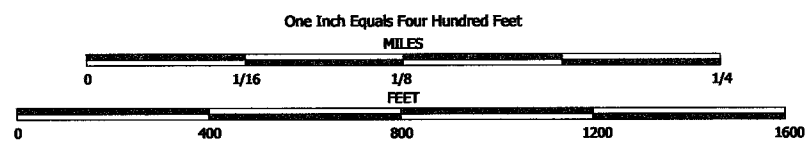


NOTE: This map was prepared for assessment use in accordance with the Wis. St. Stat. Chap. 70.09. All information contained herein is advisory only. Map accuracy is limited to the quality of data obtained from other public records. This map is not intended to be a substitute for an actual field survey. Public Land Survey Base is derived from U.S.G.S. Topographic maps unless otherwise noted. Other sources of the Land Base may be actual survey data. Base map data is from the April 1995 County Digital Orthophotos and/or U.S.G.S. 1:24,000 scale Topographic series. The user is responsible for the improper use of the data contained herein.

Created by The Columbia County Land Information Office -GIS Section. VMB. February 2007.


TAX PARCEL MAP


TOWN of PACIFIC

TOWN 12 NORTH RANGE 9 EAST
COLUMBIA COUNTY, WISCONSIN

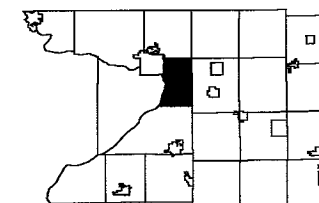

3	2	1
10	11	12
15	14	13
22	23	24
28	27	26
33	34	35

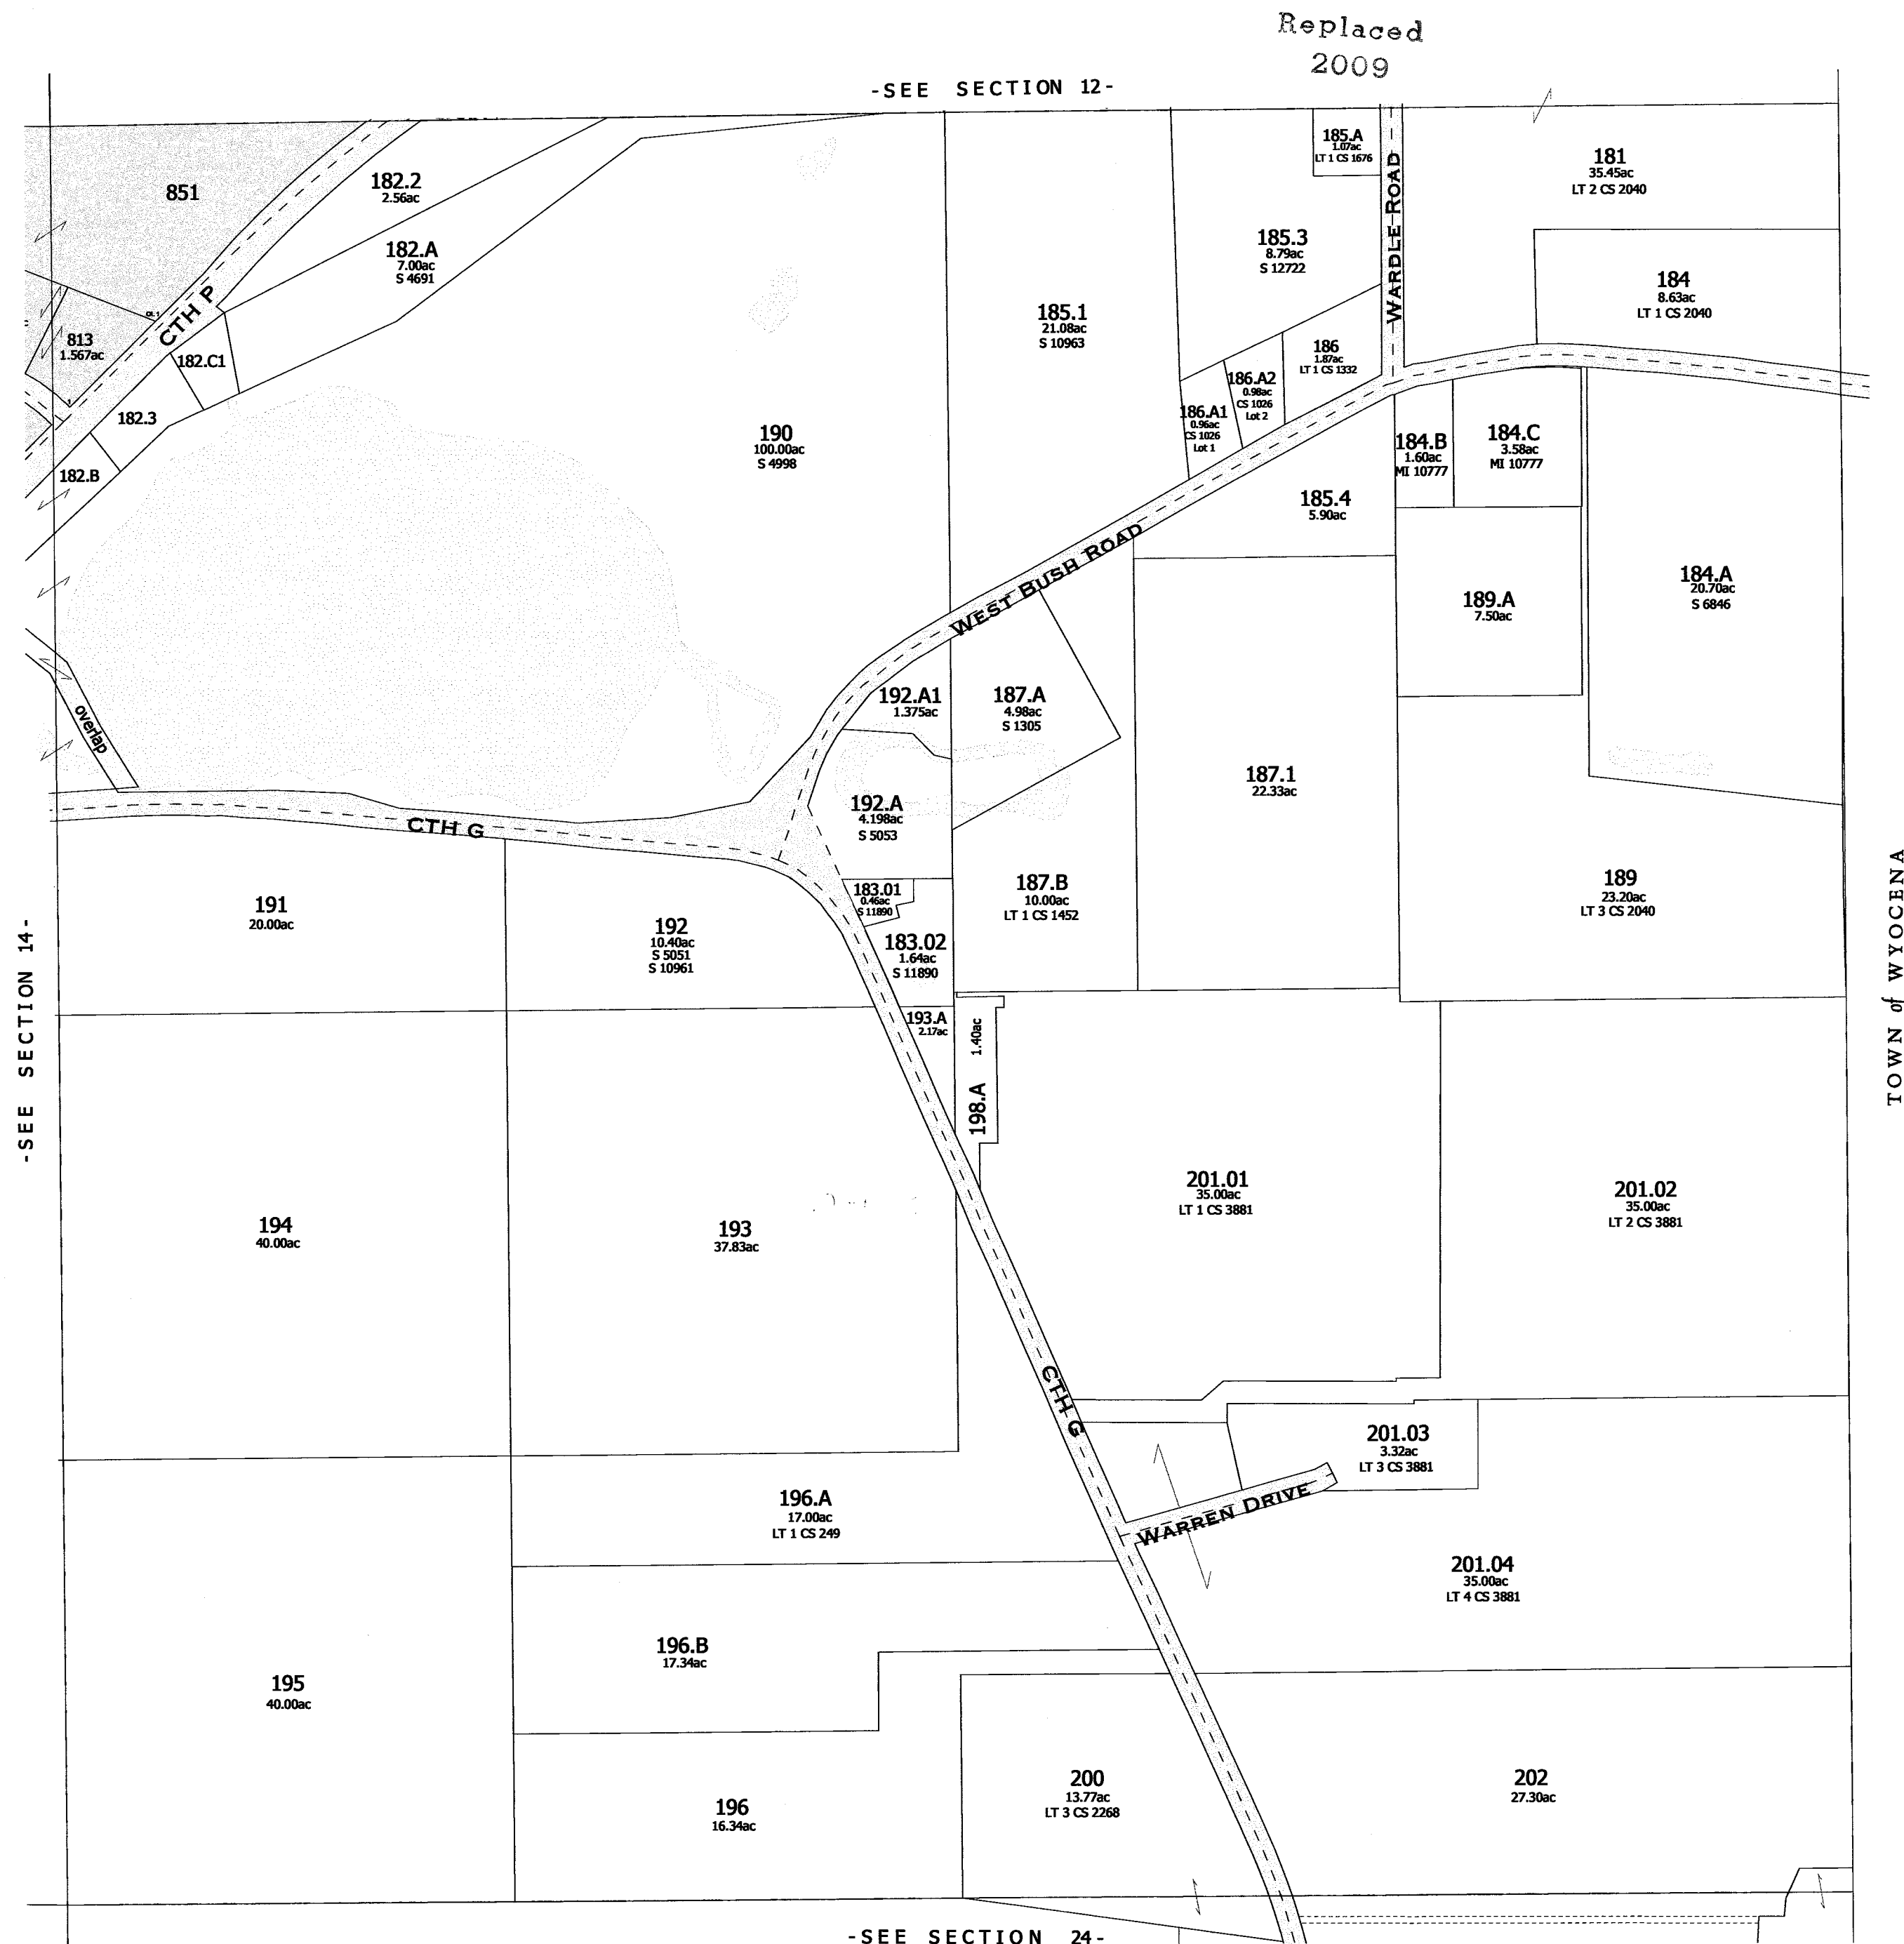


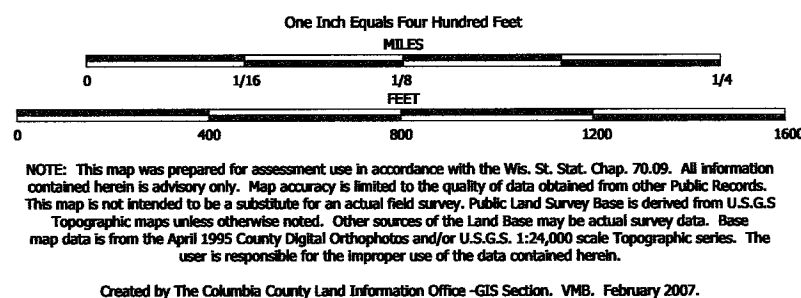

TAX PARCEL MAP

TOWN of PACIFIC


TOWN 12 NORTH RANGE 9 EAST
COLUMBIA COUNTY, WISCONSIN

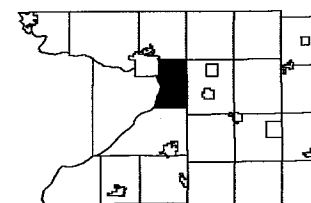

3	2	1
10	11	
15	14	13
22	23	24
29	27	26
33	34	35

Replaced
2009

-SEE SECTION 11-

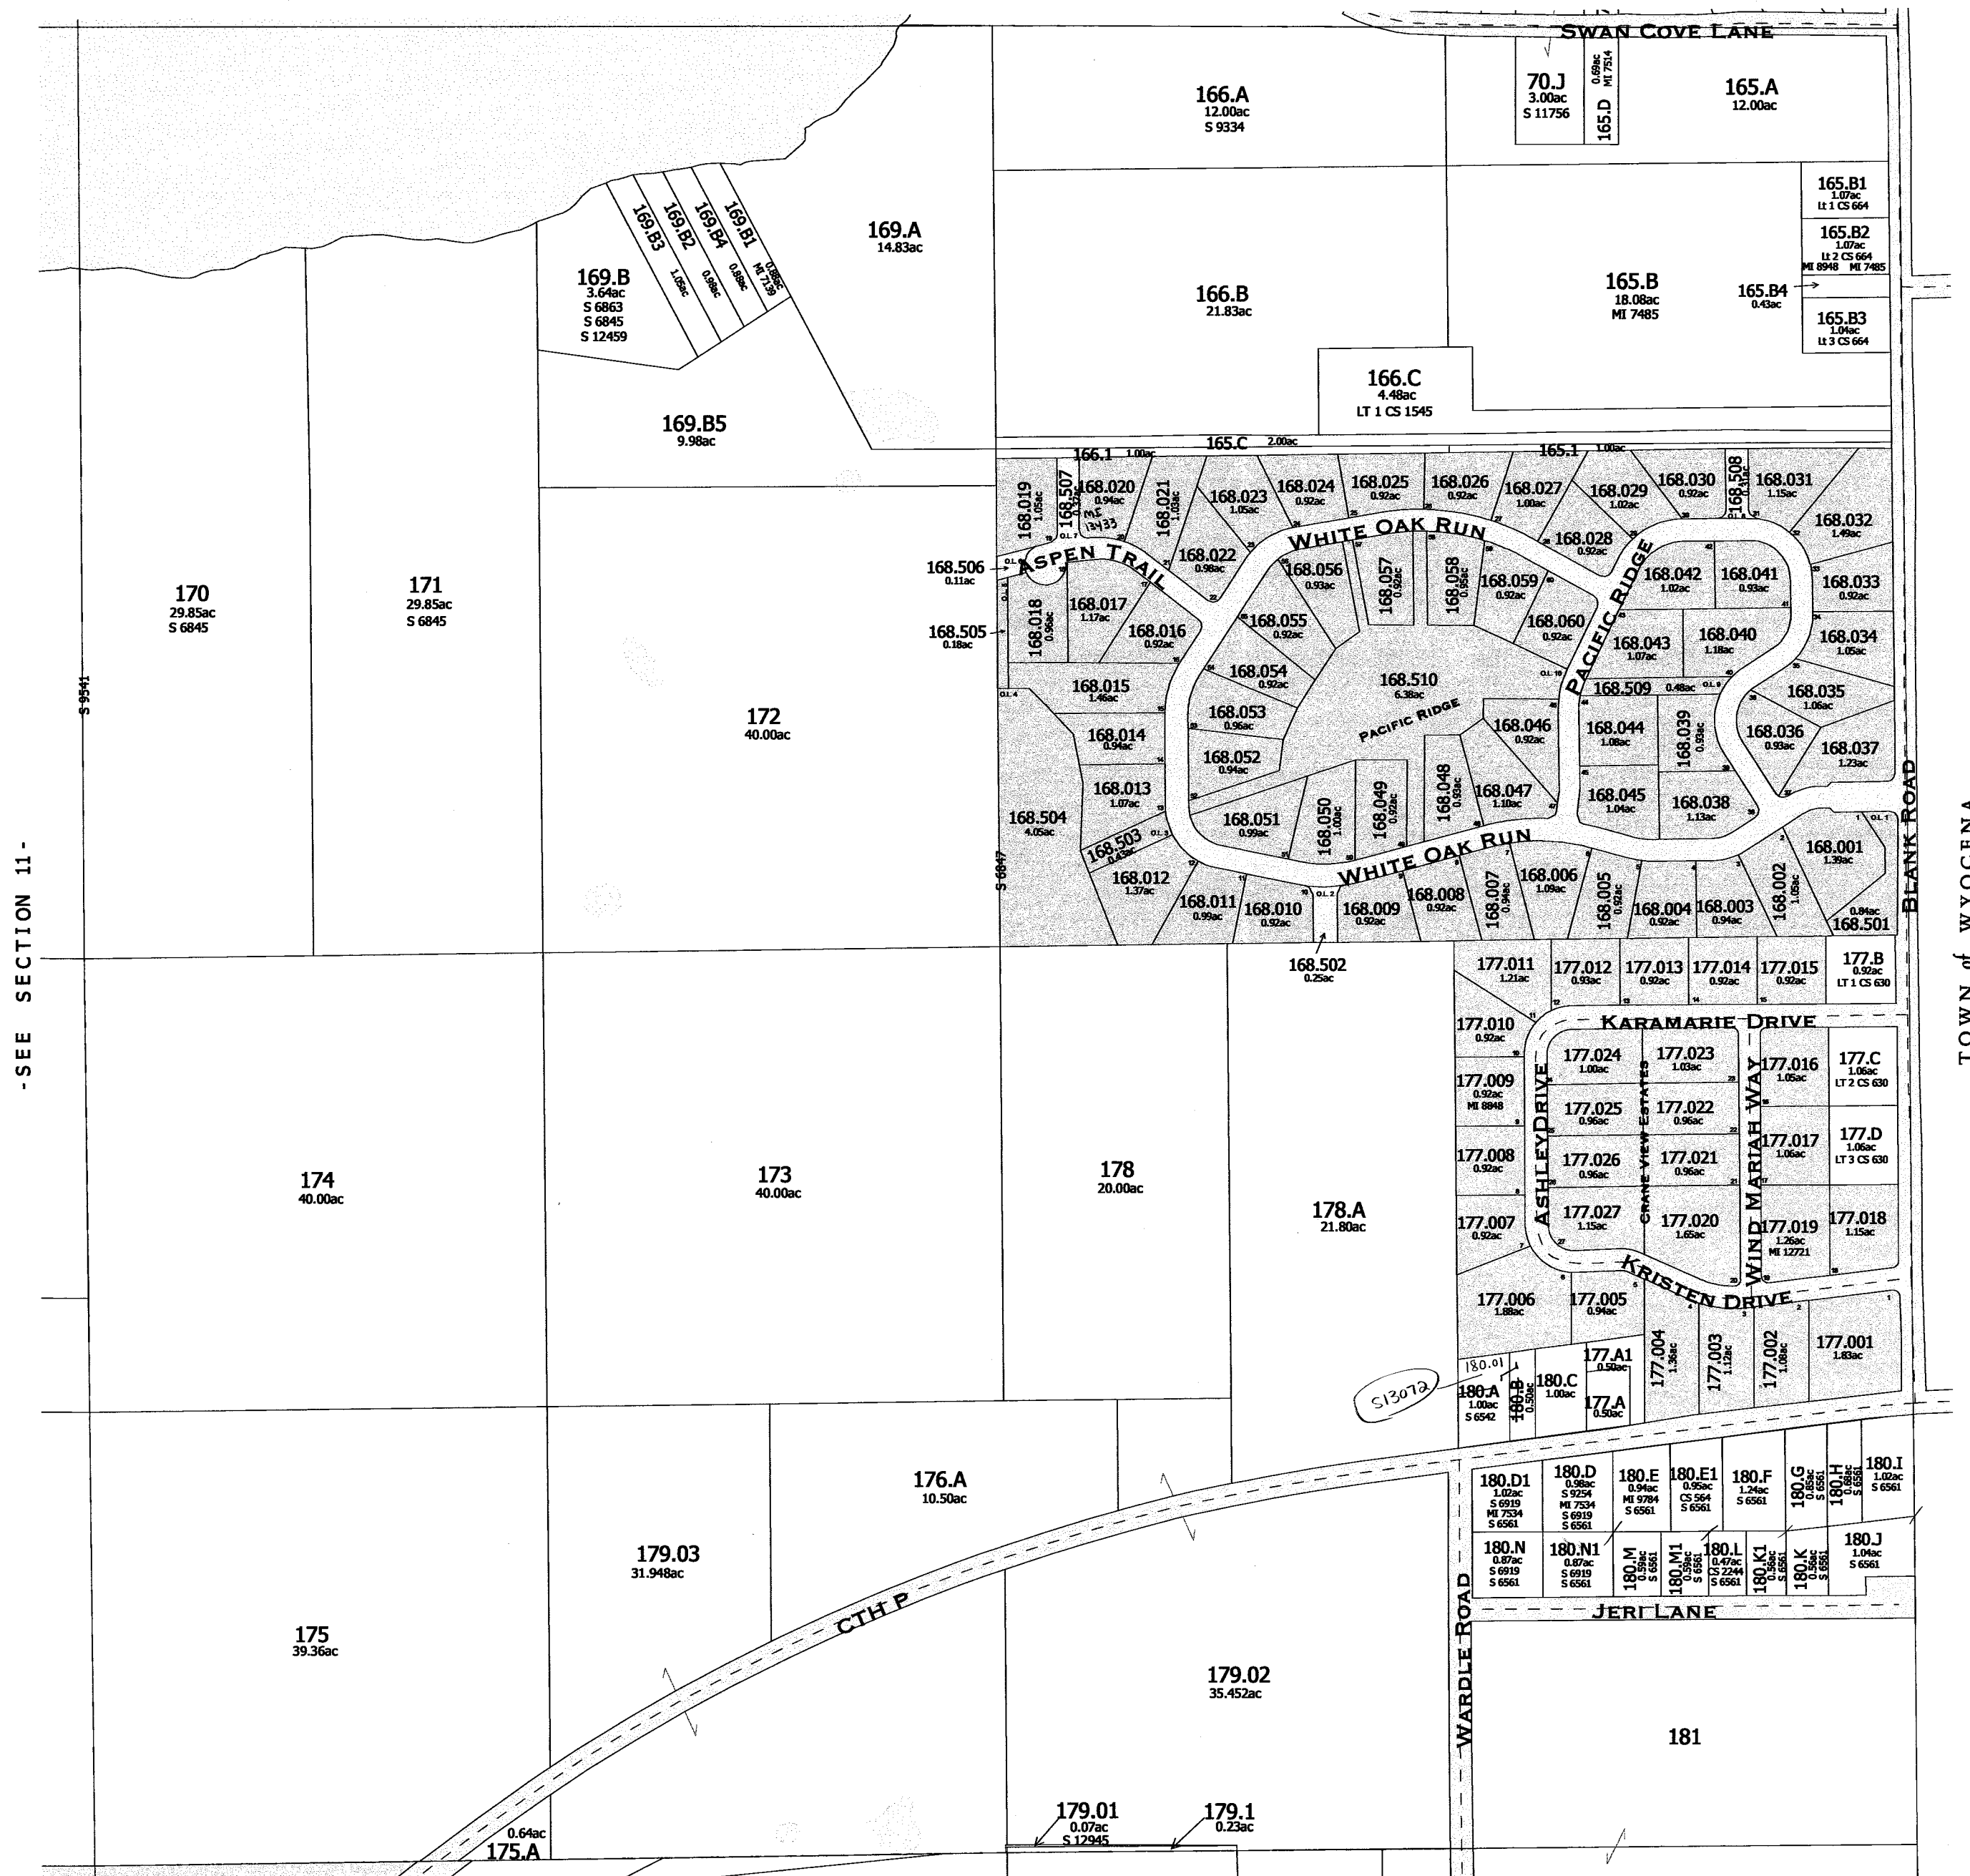

-SEE SECTION 13-

CRANEVIEW ESTATES - S 6558, S 8402
PACIFIC RIDGE - S 12354

-SECTION 12-

One Inch Equals Four Hundred Feet

MILES

0 1/16 1/8 1/4

0 400 800 1200 1600



NOTE: This map was prepared for assessment use in accordance with the Wis. Stat. Chap. 70.09. All information contained herein is advisory only. Map accuracy is limited to the quality of data obtained from other Public Records. This map is not intended to be a substitute for an actual field survey. Public Land Survey Base is derived from U.S.G.S Topographic maps unless otherwise noted. Other sources of the Land Base may be actual survey data. Base map data is from the April 1995 County Digital Orthophotos and/or U.S.G.S. 1:24,000 scale Topographic series. The user is responsible for the improper use of the data contained herein.

Created by The Columbia County Land Information Office -GIS Section. VMB. July 2004.


TAX PARCEL MAP


TOWN of PACIFIC

TOWN 12 NORTH RANGE 9 EAST
COLUMBIA COUNTY, WISCONSIN

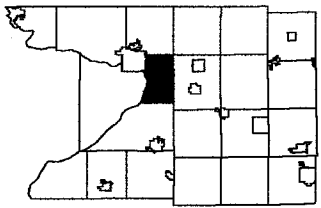

3	2	1
10		12
15	14	13
22	23	24
29	27	26
33	34	35

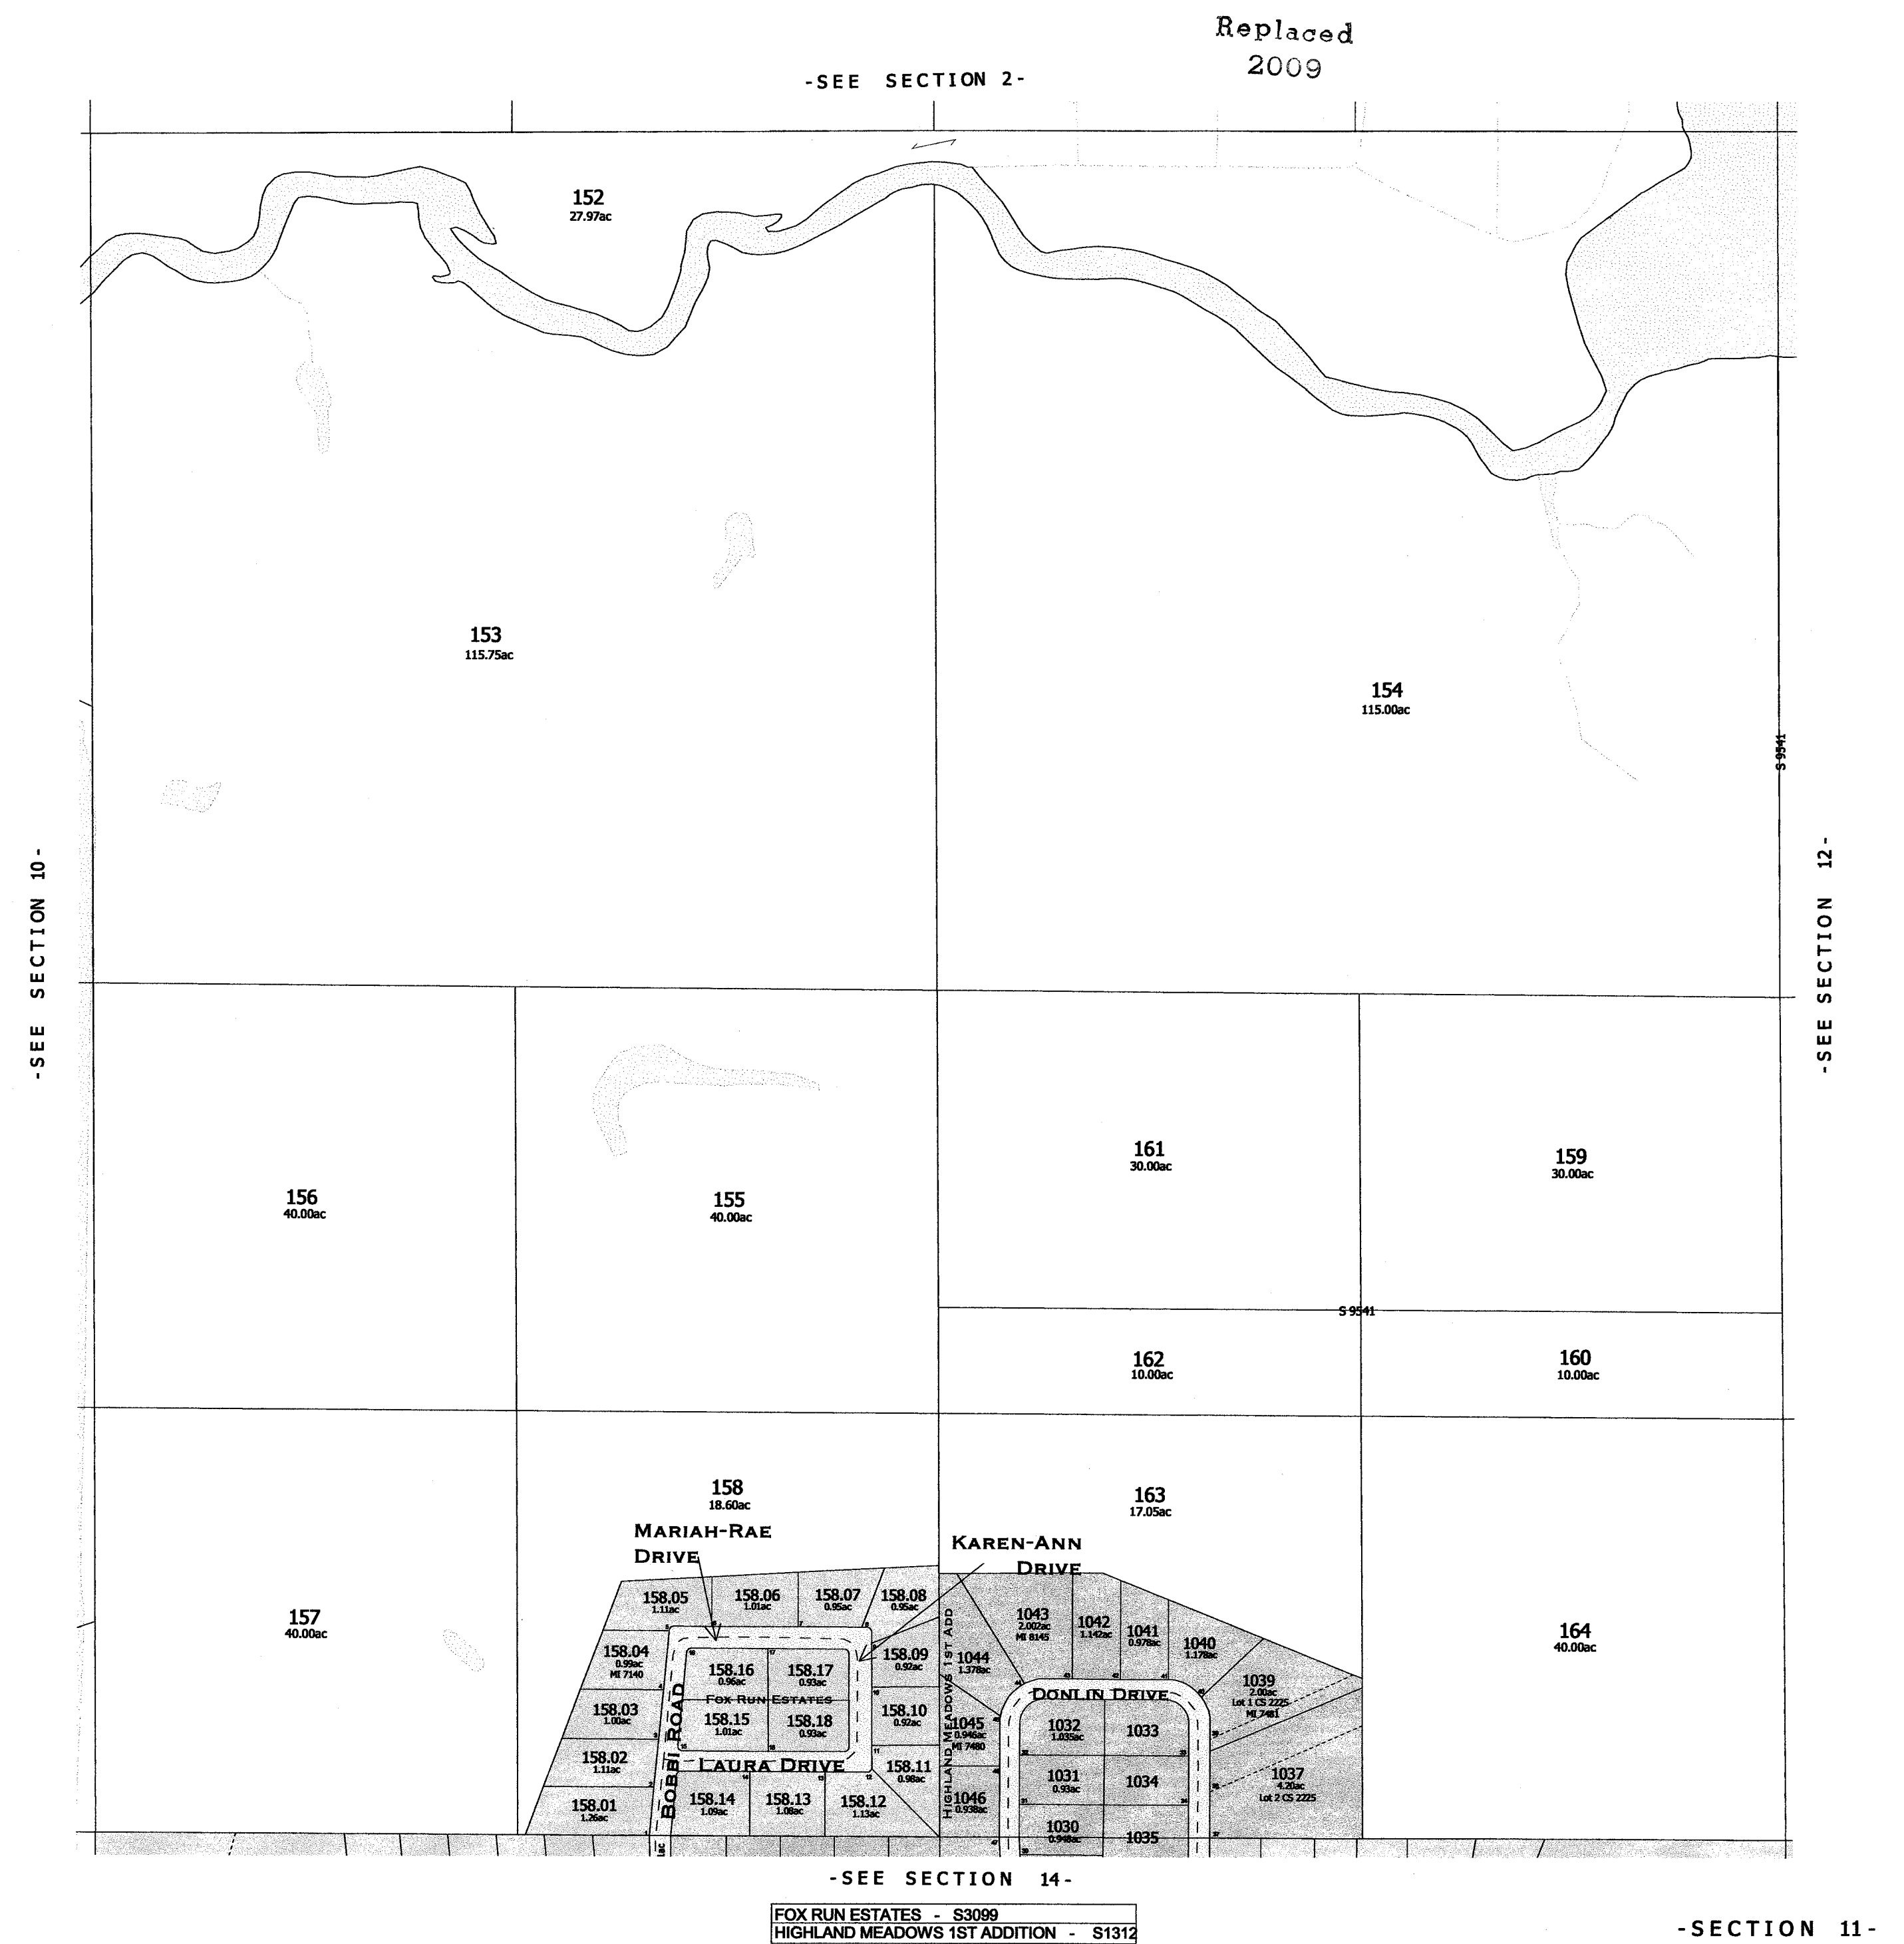

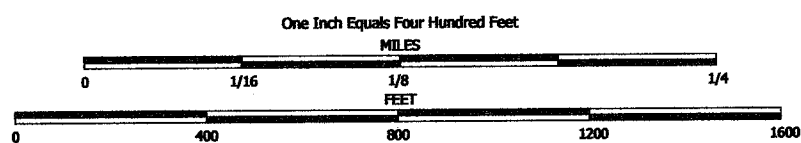


NOTE: This map was prepared for assessment use in accordance with the Wis. St. Stat. Chap. 70.09. All information contained herein is advisory only. Map accuracy is limited to the quality of data obtained from other Public Records. This map is not intended to be a substitute for an actual field survey. Public Land Survey Base is derived from U.S.G.S. Topographic maps unless otherwise noted. Other sources of the Land Base may be actual survey data. Base map data is from the April 1995 County Digital Orthophotos and/or U.S.G.S. 1:24,000 scale Topographic series. The user is responsible for the improper use of the data contained herein.

Created by The Columbia County Land Information Office -GIS Section. VMB. July 2004.

TAX PARCEL MAP

TOWN of PACIFIC

TOWN 12 NORTH RANGE 9 EAST
COLUMBIA COUNTY, WISCONSIN

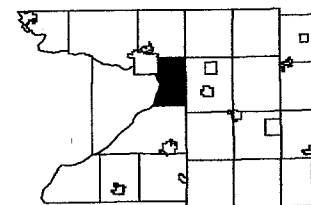

3	2	1
11	12	
15	14	13
22	23	24
28	27	26
35	34	33

Replaced
2009

-SEE SECTION 3-


-SEE SECTION 9-

-SEE SECTION 11-

-SEE SECTION 15-

-SECTION 10-



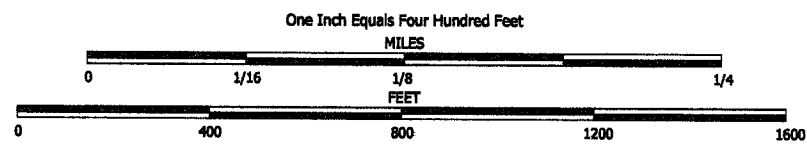


NOTE: This map was prepared for assessment use in accordance with the Wis. St. Stat. Chap. 70.09. All information contained herein is advisory only. Map accuracy is limited to the quality of data obtained from other Public Records. This map is not intended to be a substitute for an actual field survey. Public Land Survey Base is derived from U.S.G.S. Topographic maps unless otherwise noted. Other sources of the Land Base may be actual survey data. Base map data is from the April 1995 County Digital Orthophotos and/or U.S.G.S. 1:24,000 scale Topographic series. The user is responsible for the improper use of the data contained herein.

Created by The Columbia County Land Information Office -GIS Section. VMB. February 2005.

TAX PARCEL MAP

TOWN of PACIFIC


TOWN 12 NORTH RANGE 9 EAST
COLUMBIA COUNTY, WISCONSIN

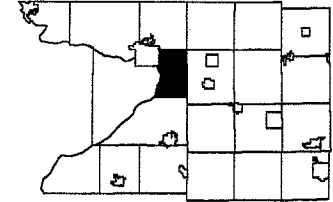


3	2	1
10	11	12
15	14	13
22	23	24
29	27	26
33	34	35
36		

-SEE SECTION 4-

Replaced
2009

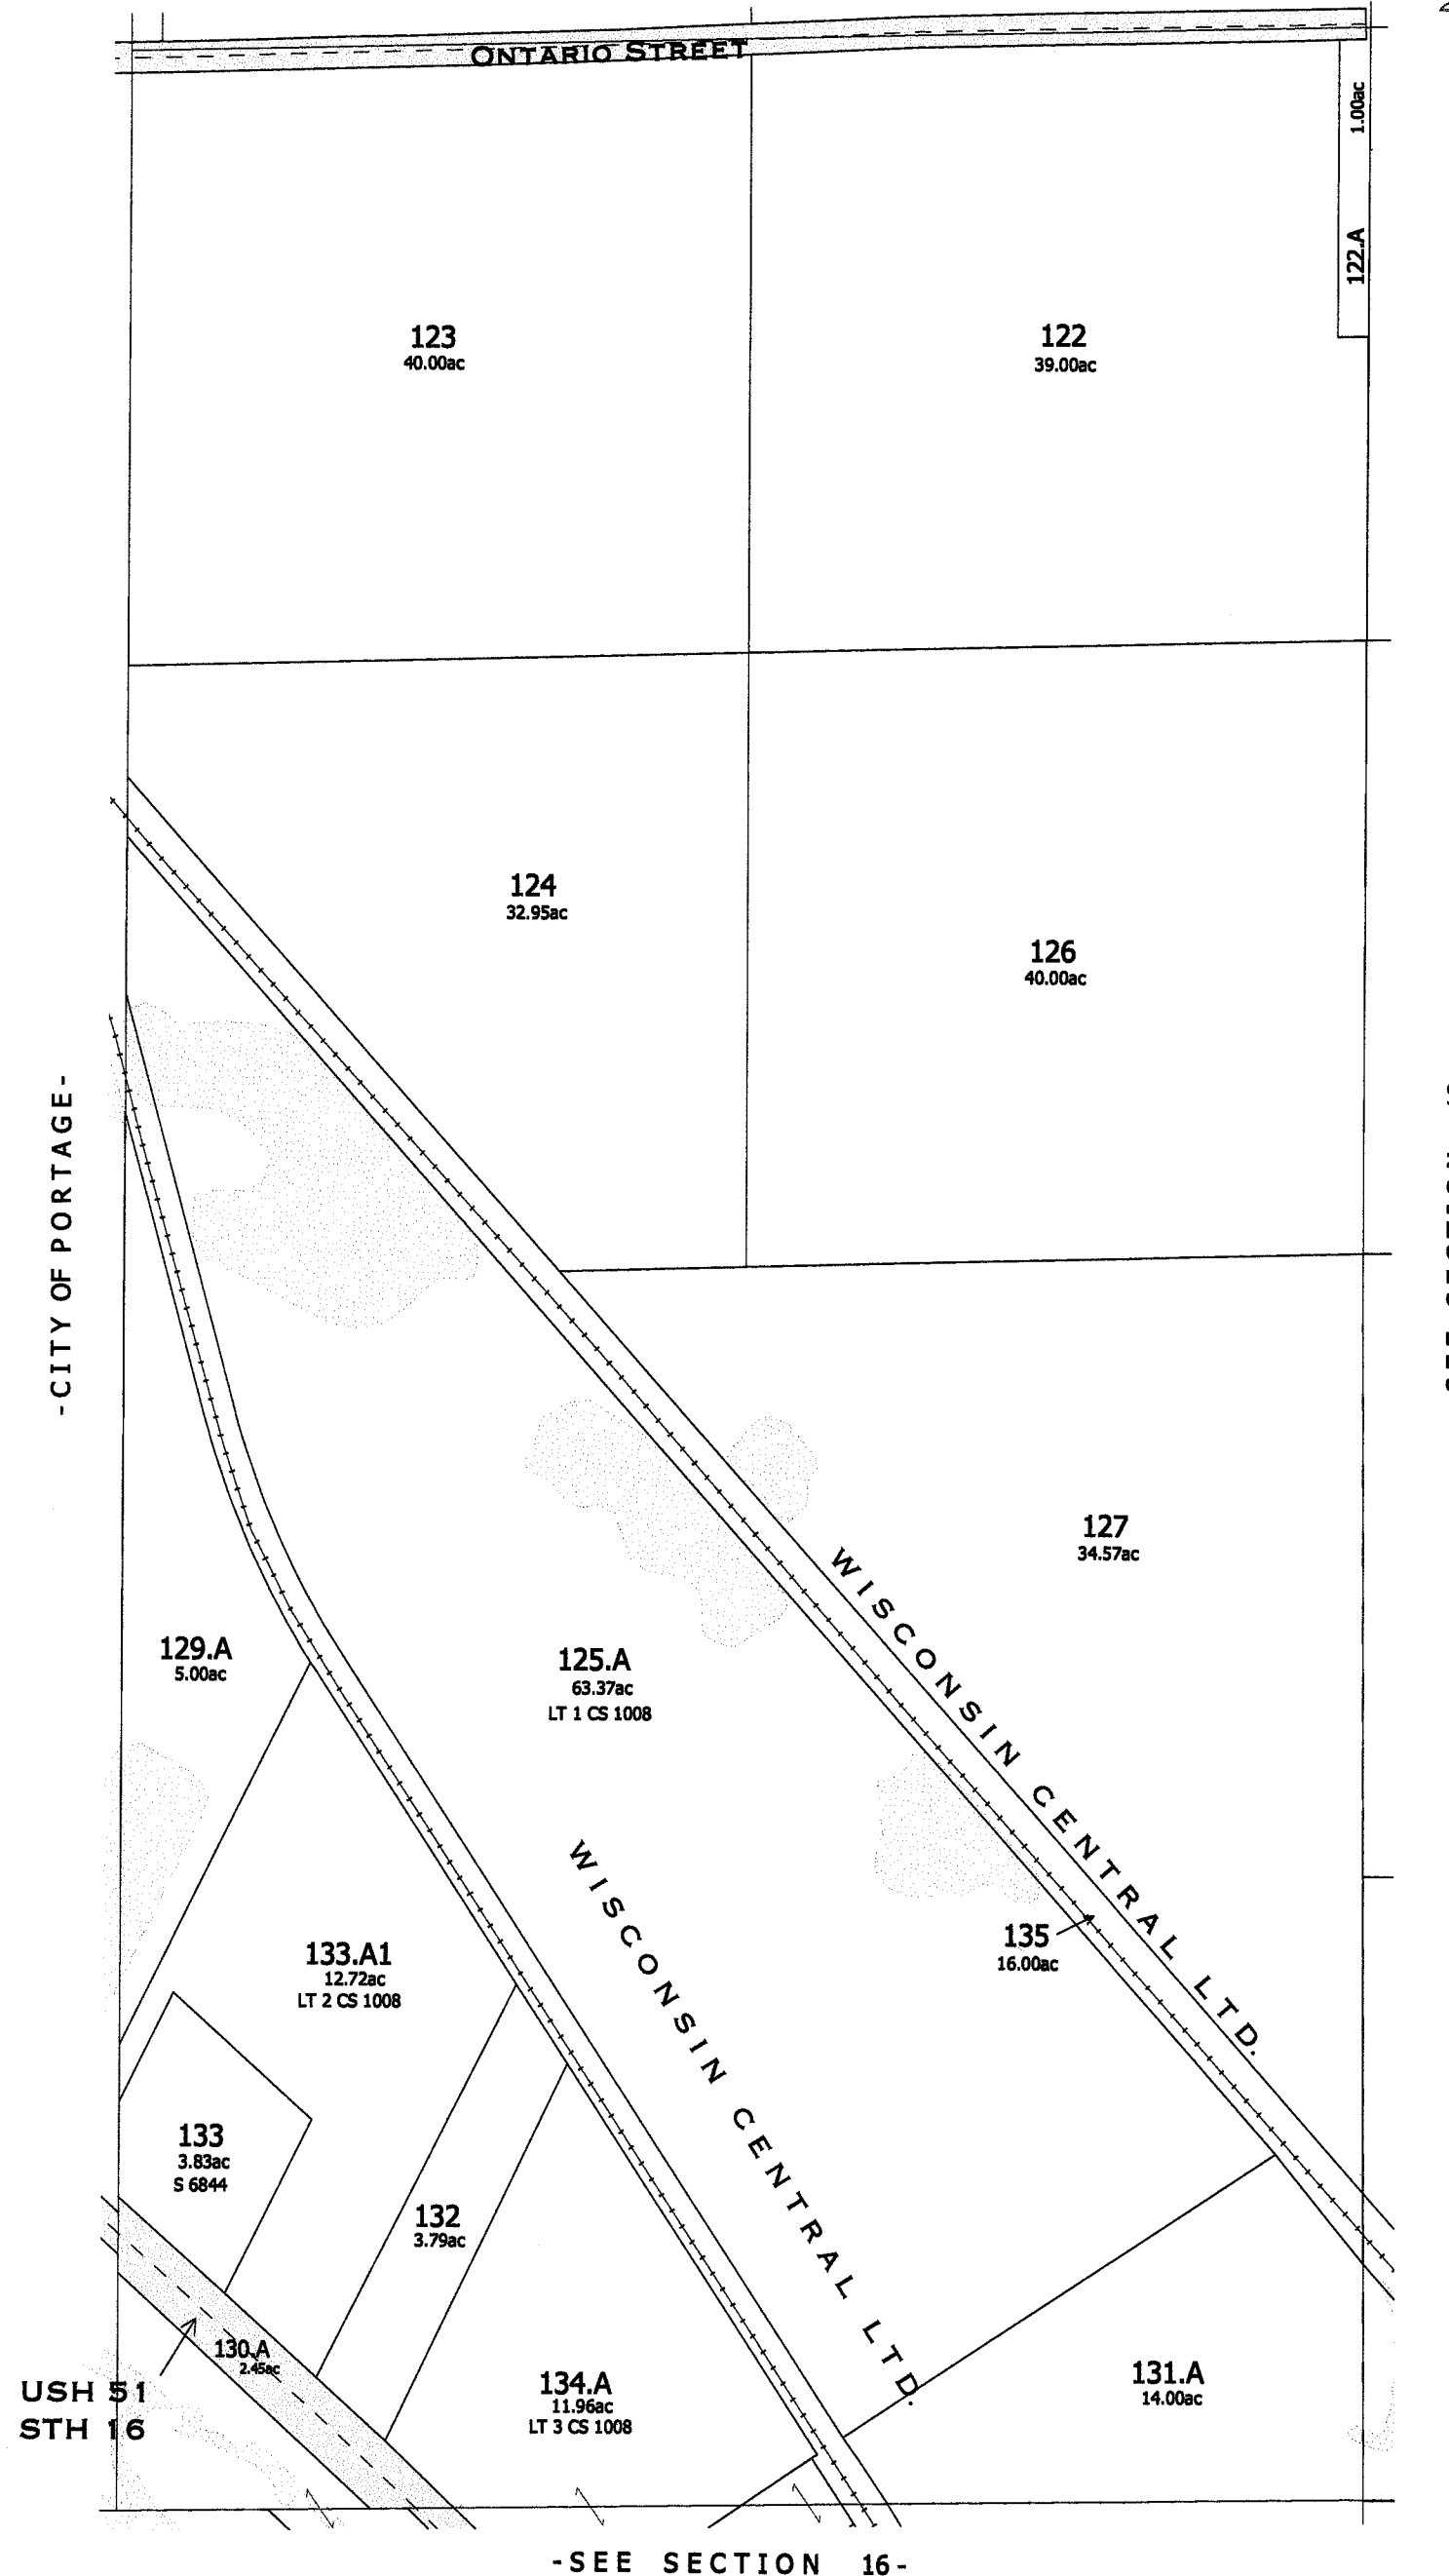

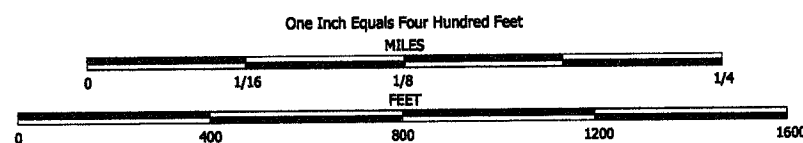


NOTE: This map was prepared for assessment use in accordance with the Wis. St. Stat. Chap. 70.09. All information contained herein is advisory only. Map accuracy is limited to the quality of data obtained from other Public Records. This map is not intended to be a substitute for an actual field survey. Public Land Survey Base is derived from U.S.G.S Topographic maps unless otherwise noted. Other sources of the Land Base may be actual survey data. Base map data is from the April 1995 County Digital Orthophotos and/or U.S.G.S. 1:24,000 scale Topographic series. The user is responsible for the improper use of the data contained herein.

Created by The Columbia County Land Information Office -GIS Section. VMB. February 2006.


TAX PARCEL MAP

TOWN of PACIFIC

TOWN 12 NORTH RANGE 9 EAST
COLUMBIA COUNTY, WISCONSIN

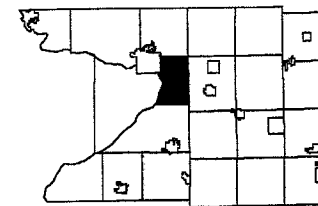

3	2	1
10	11	12
15	14	13
22	23	24
28	27	26
33	34	35

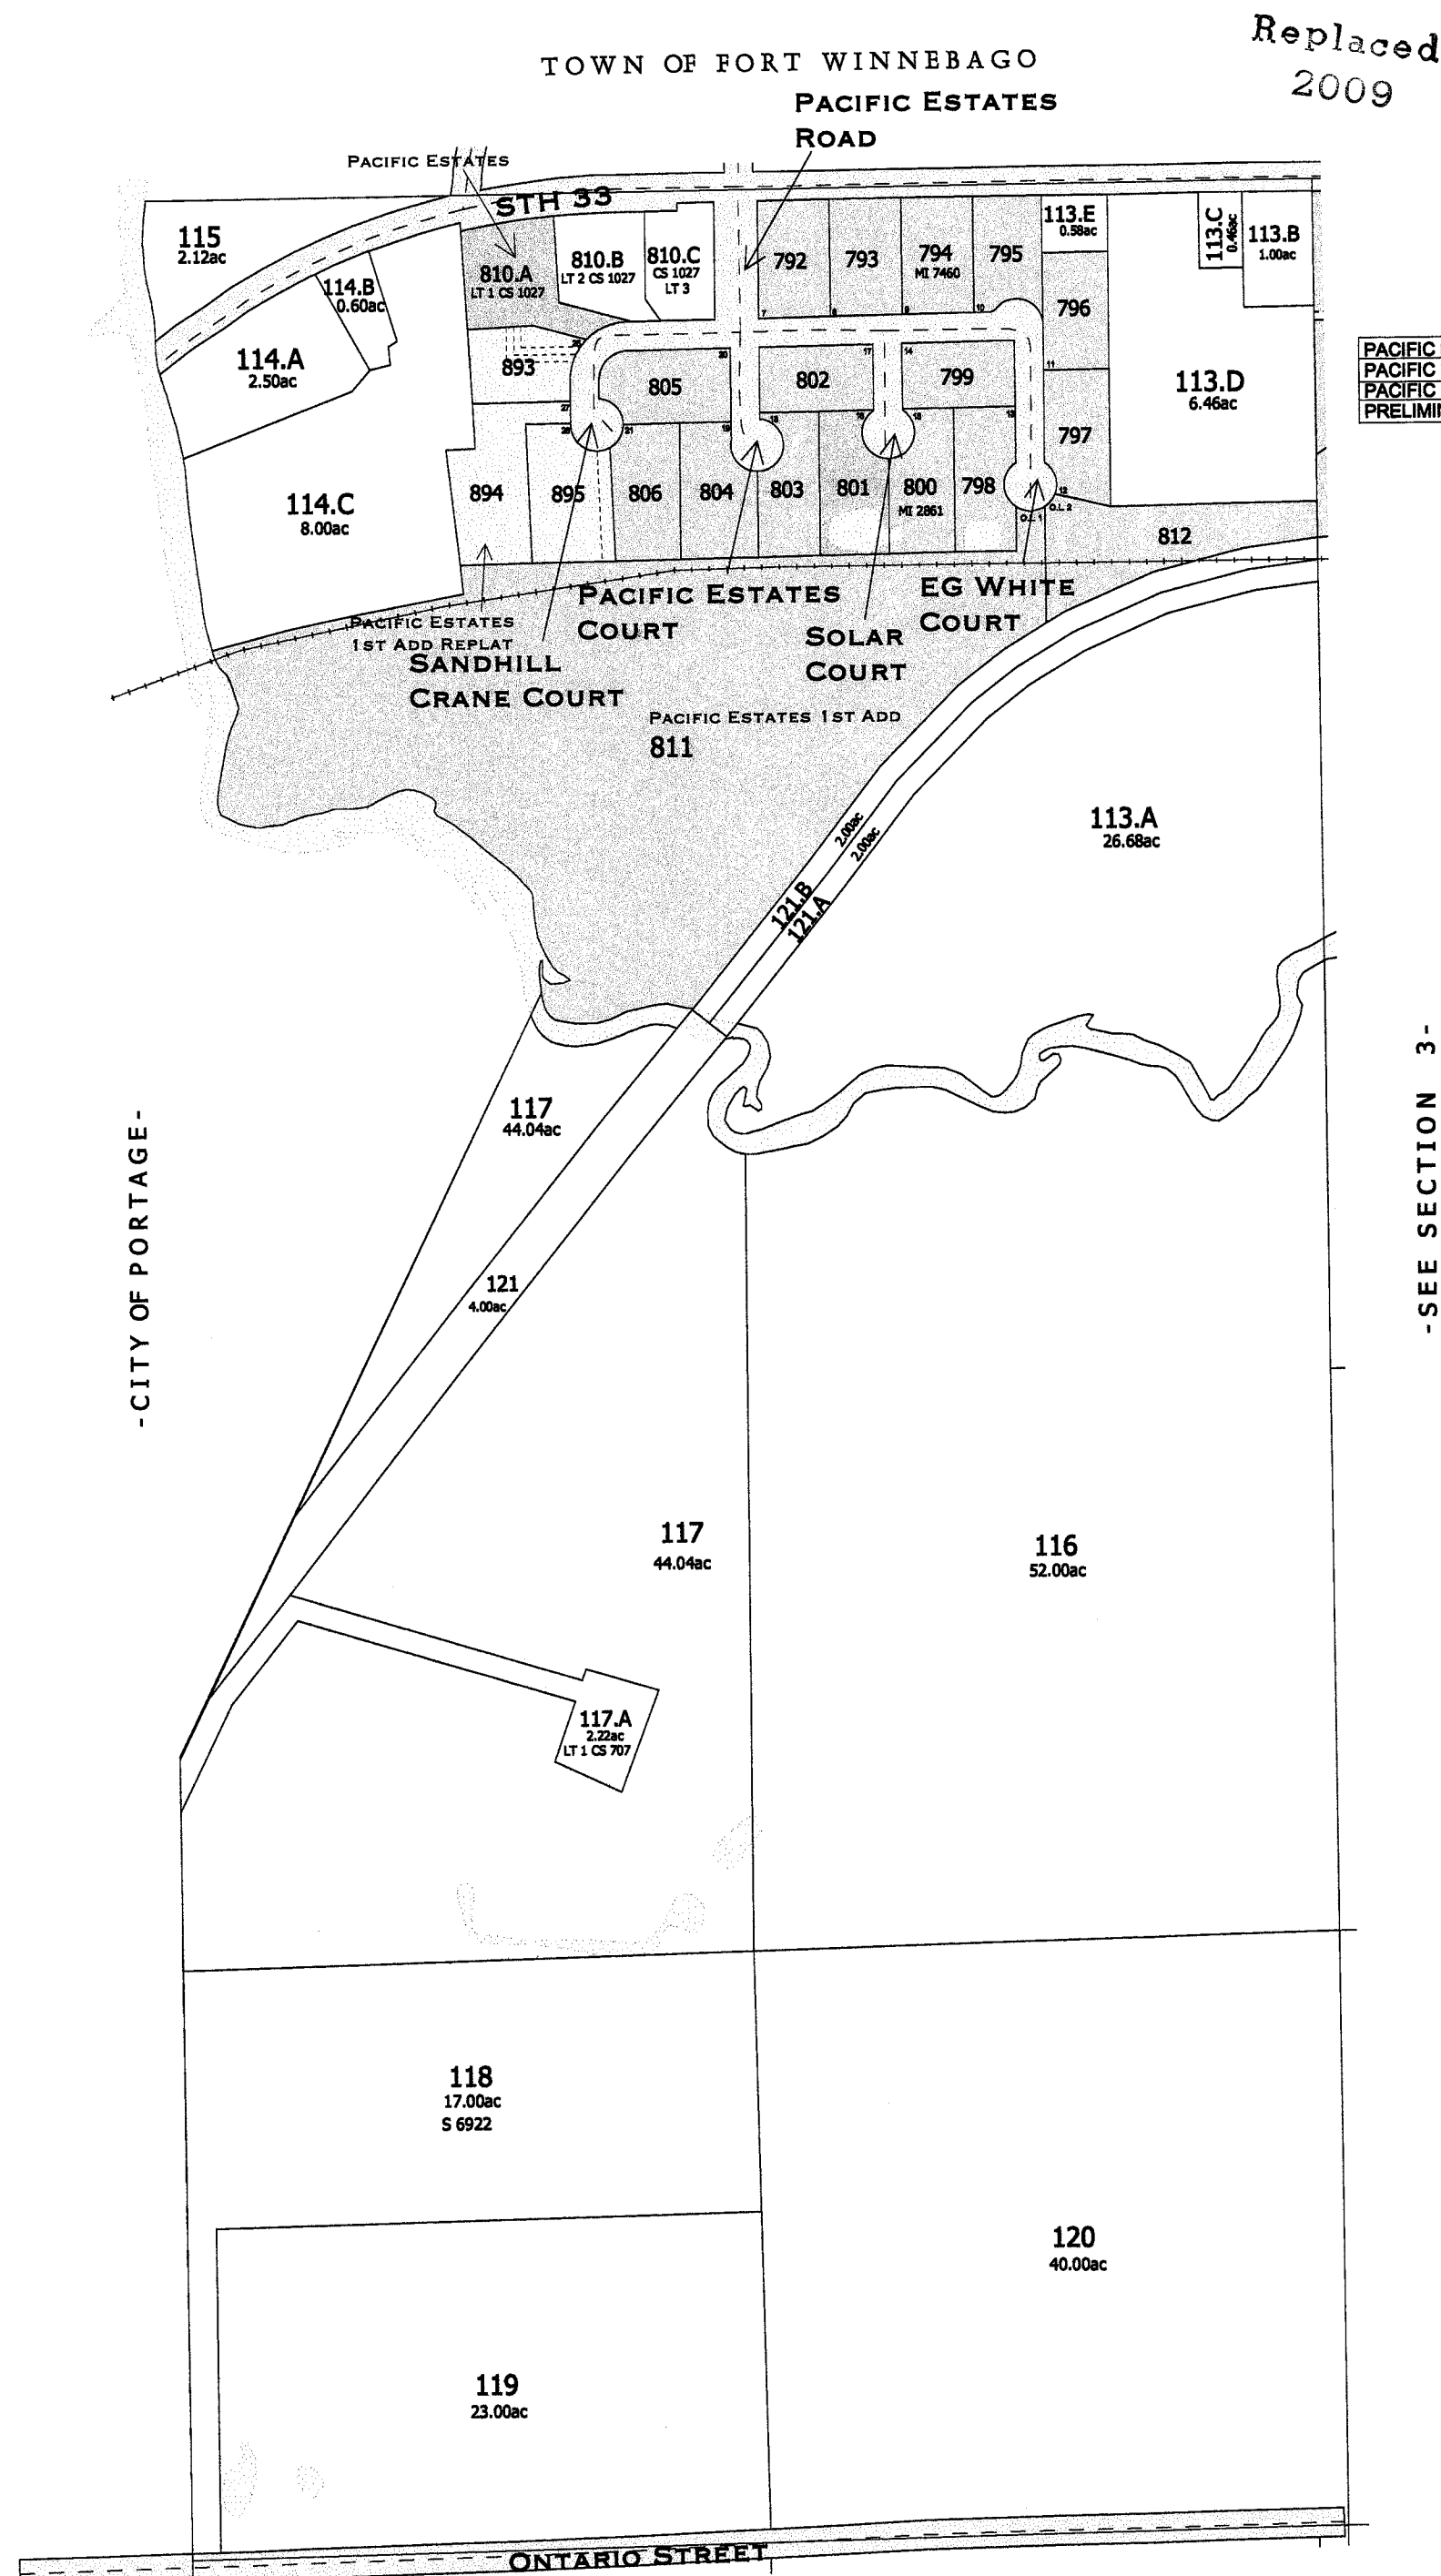

PACIFIC ESTATES - S6862
PACIFIC ESTATES 1ST ADDITION - S5055
PACIFIC ESTATES 1ST ADDITION REPLAT - REGISTER OF DEEDS 177B
PRELIMINARY PACIFIC ESTATES 1ST ADDITION - S5054

One Inch Equals Four Hundred Feet
MILES
0 1/16 1/8 1/4
FEET
0 400 800 1200 1600


NOTE: This map was prepared for assessment use in accordance with the Wis. St. Stat. Chap. 70.09. All information contained herein is advisory only. Map accuracy is limited to the quality of data obtained from other Public Records. This map is not intended to be a substitute for an actual field survey. Public Land Survey Base is derived from U.S.G.S. Topographic maps unless otherwise noted. Other sources of the Land Base may be actual survey data. Base map data is from the April 1995 County Digital Orthophotos and/or U.S.G.S. 1:24,000 scale Topographic series. The user is responsible for the improper use of the data contained herein.

Created by The Columbia County Land Information Office -GIS Section. VMB. February 2006.

TAX PARCEL MAP


TOWN of PACIFIC

TOWN 12 NORTH RANGE 9 EAST
COLUMBIA COUNTY, WISCONSIN

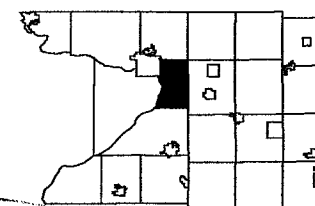


	3		1
	10	11	12
	15	14	13
	22	23	24
29	27	26	25
33	34	35	36

Replaced
2009

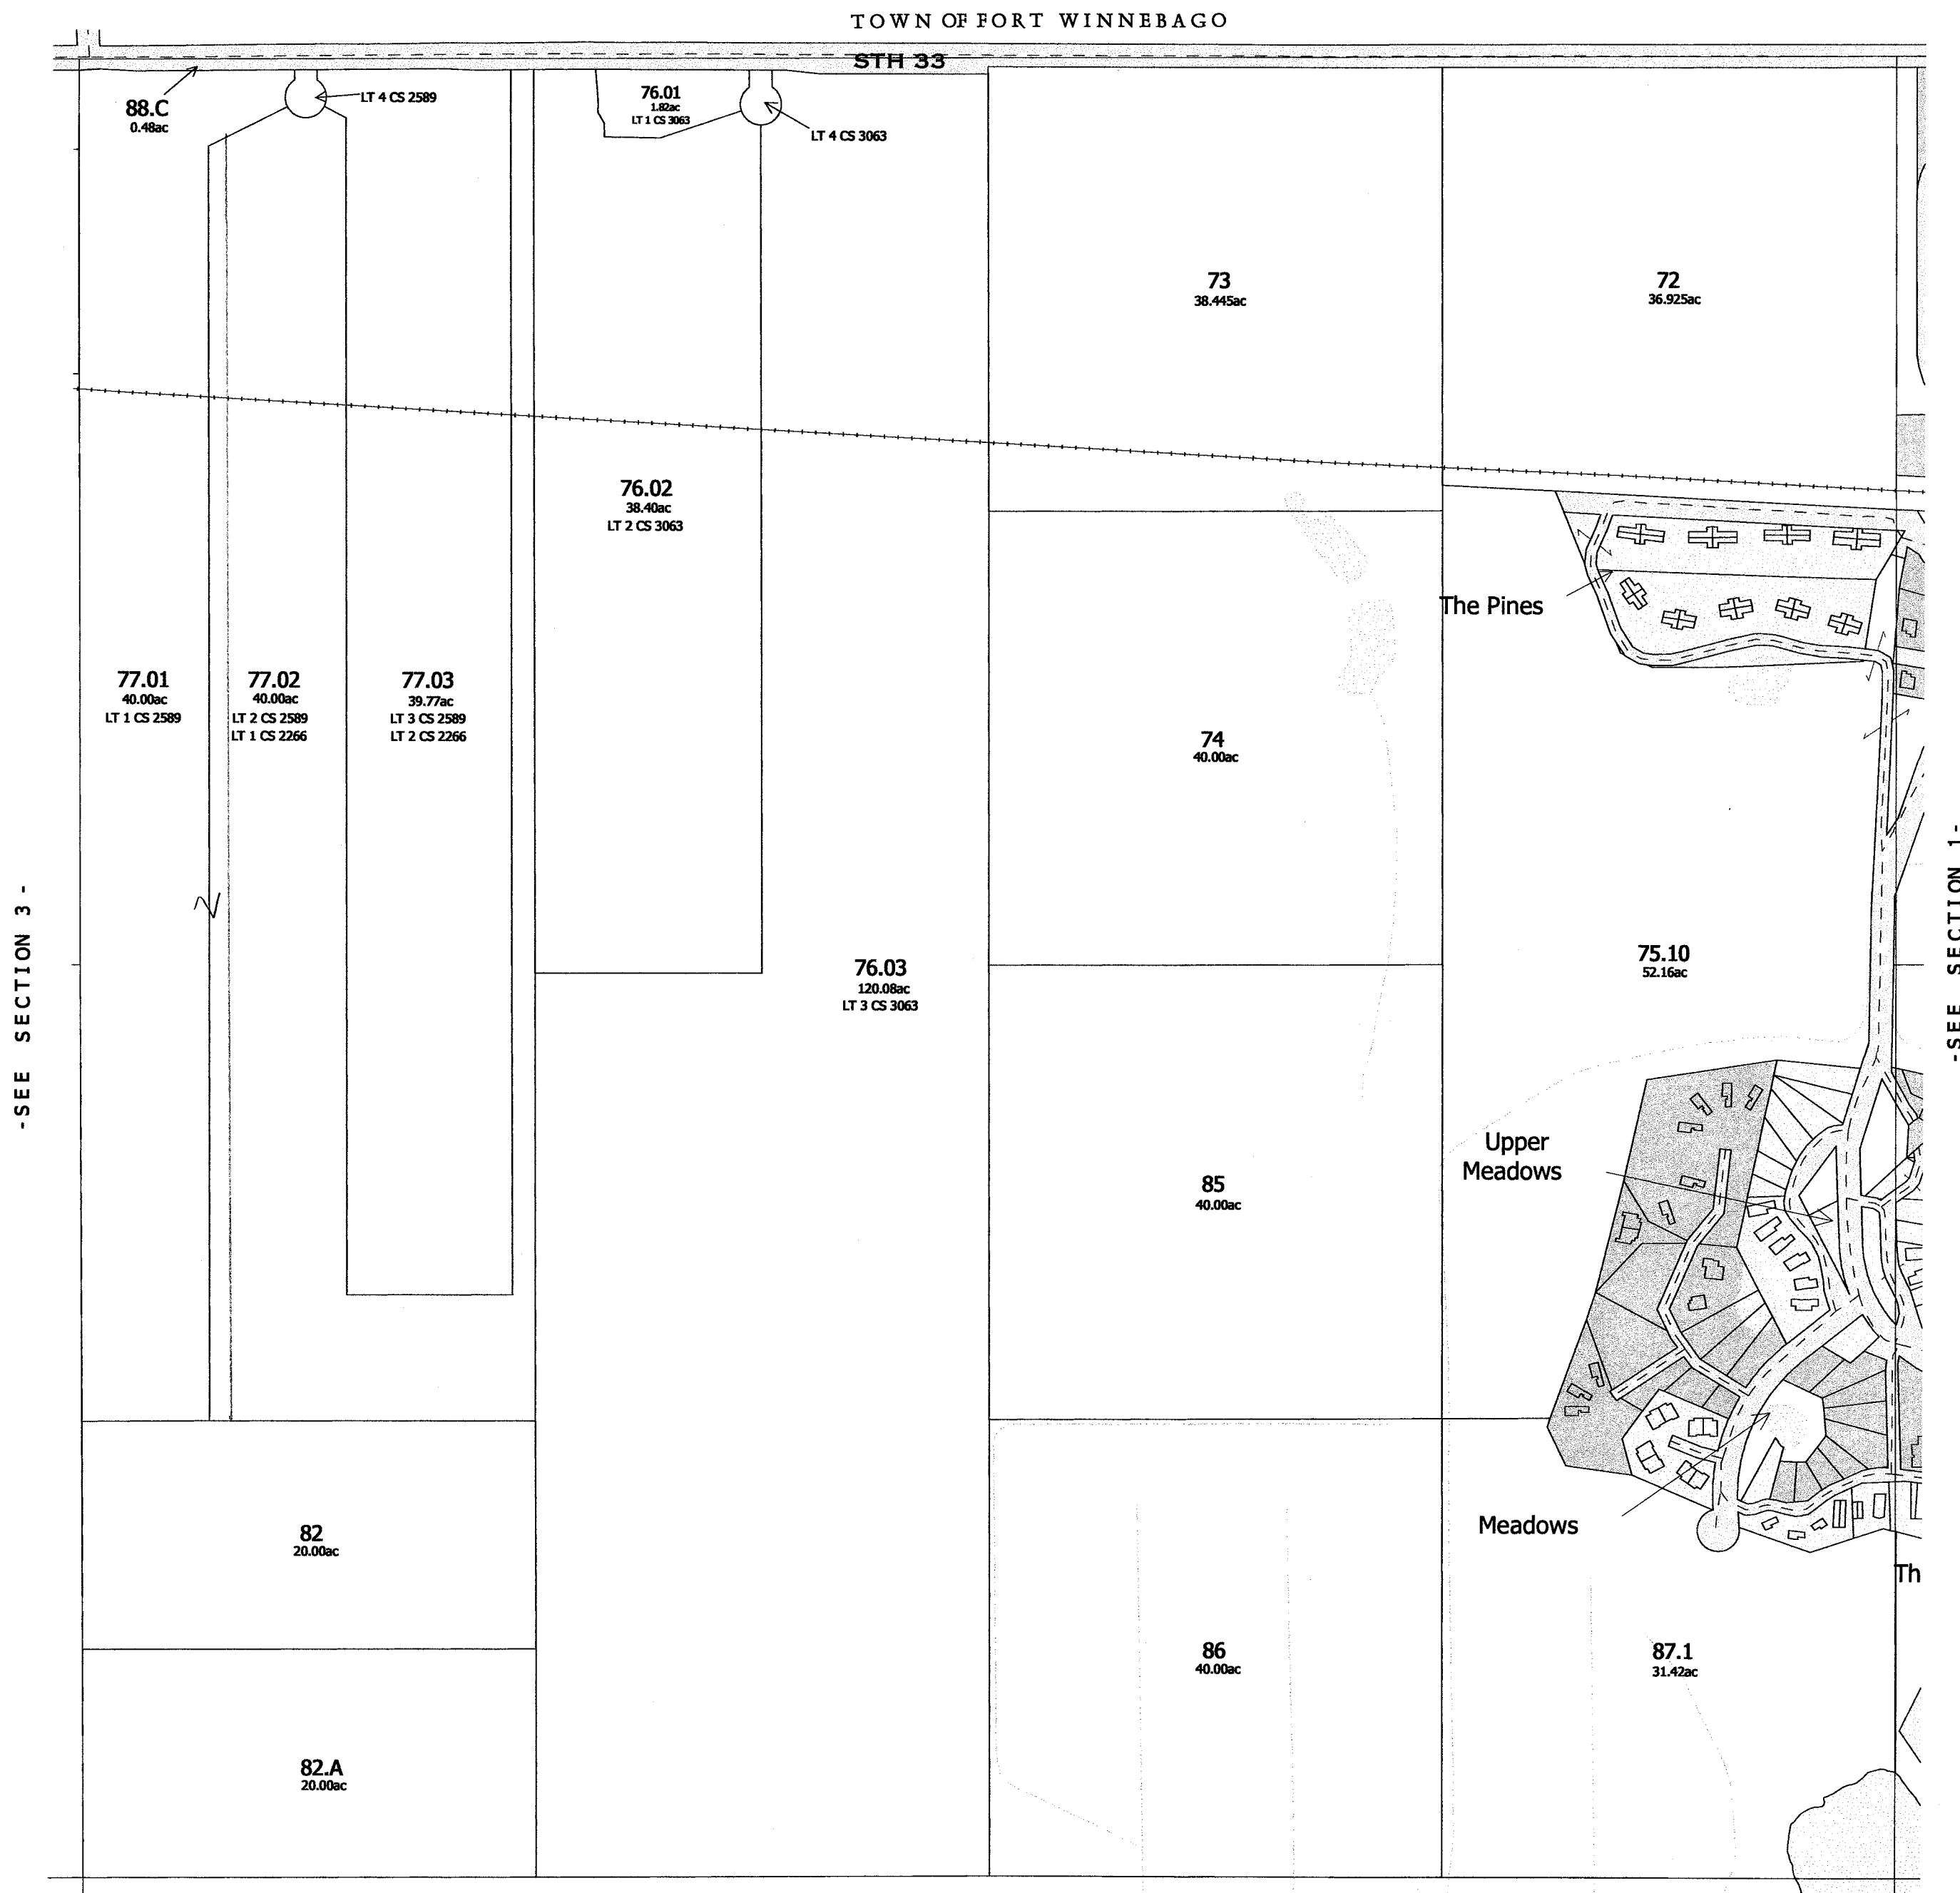

-SEE SECTION 11 -
FOR DETAILED MAP OF SUBDIVISIONS, SEE THE PREVIOUS PAGES.

-SECTION 2 -

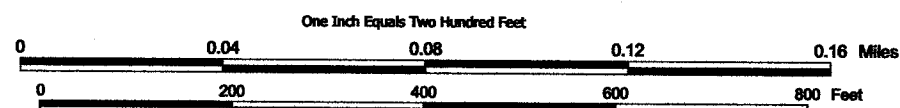


NOTE: This map was prepared for assessment use in accordance with the Wis. St. Stat. Chap. 70.09. All information contained herein is advisory only. Map accuracy is limited to the quality of data obtained from other Public Records. This map is not intended to be a substitute for an actual field survey. Public Land Survey Base is derived from U.S.G.S. Topographic maps unless otherwise noted. Other sources of the Land Base may be actual survey data. Base map data is from the April 1995 County Digital Orthophotos and/or U.S.G.S. 1:24,000 scale Topographic series. The user is responsible for the improper use of the data contained herein.

Created by The Columbia County Land Information Office -GIS Section. VMB. February 2005.

TAX PARCEL MAP

TOWN of PACIFIC


TOWN 12 NORTH RANGE 9 EAST
COLUMBIA COUNTY, WISCONSIN

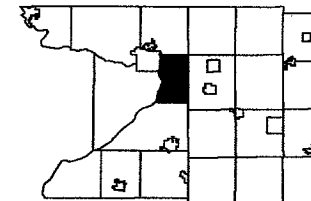

3	2	
10	11	12
15	14	13
22	23	24
29	27	26
33	34	35
36		

Replaced
2009


-SEE SECTION 1-

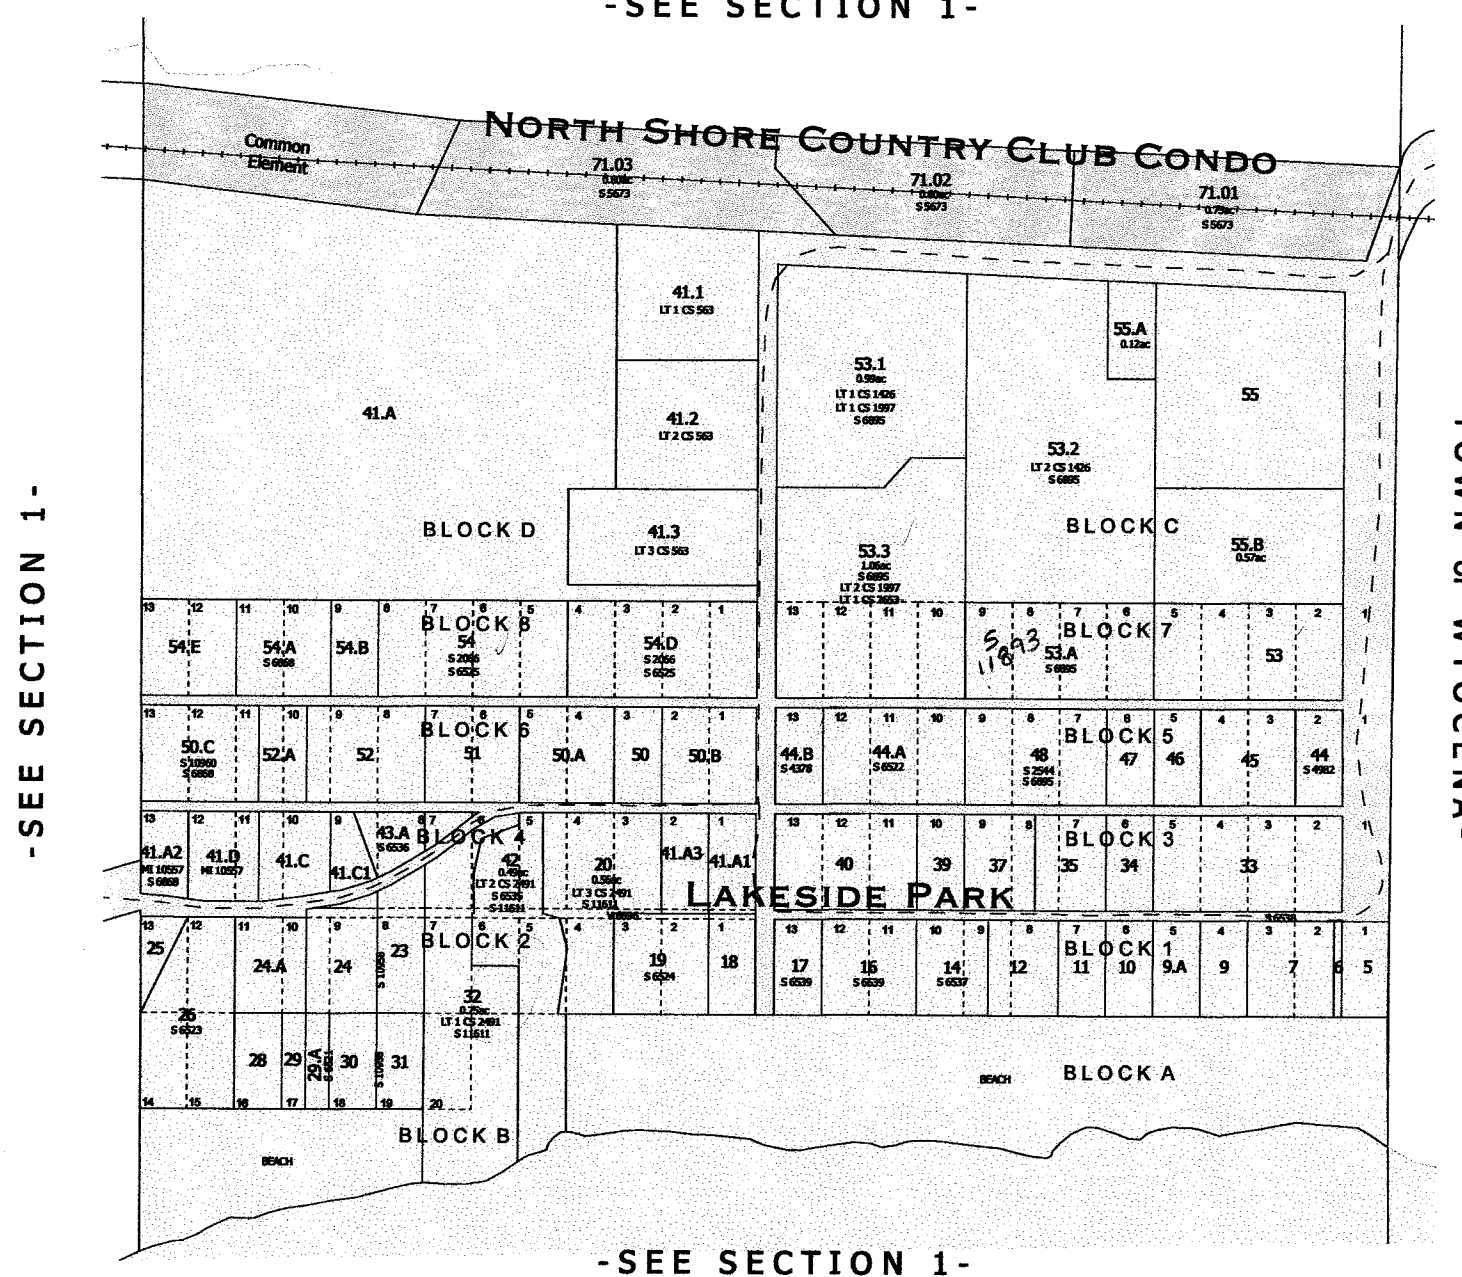

-SEE SECTION 1-

SURVEY INDEX

LAKEVIEW PARK ELEVATIONS	6926
NORTH SHORE COUNTRY CLUB	8957

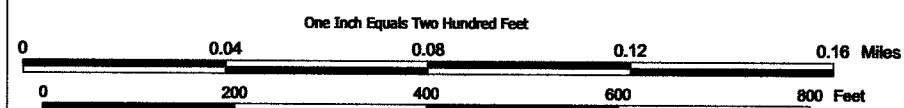


NOTE: This map was prepared for assessment use in accordance with the Wis. Stat. Chap. 70.09. All information contained herein is advisory only. Map accuracy is limited to the quality of data obtained from other Public Records. This map is not intended to be a substitute for an actual field survey. Public Land Survey Base is derived from U.S.G.S. Topographic maps unless otherwise noted. Other sources of the Land Base may be actual survey data. Base map data is from the April 1995 County Digital Orthophotos and/or U.S.G.S. 1:24,000 scale Topographic series. The user is responsible for the improper use of the data contained herein.

Created by The Columbia County Land Information Office -GIS Section, V4B, February 2006.

TAX PARCEL MAP

TOWN of PACIFIC

TOWN 12 NORTH RANGE 9 EAST
COLUMBIA COUNTY, WISCONSIN

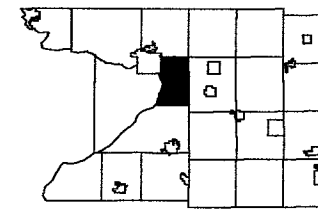

3	2	
10	11	12
15	14	13
22	23	24
29	27	25
33	34	35
36		

Replaced
2009

-SEE PAGE B-

SURVEY INDEX

THE FOREST AT SWAN LAKE - PHASE 1	S6123
THE FOREST AT SWAN LAKE - PHASE 2	S8440-S6413
THE FOREST AT SWAN LAKE - PHASE 3	S8439
THE FOREST AT SWAN LAKE - AMENDED PHASE 4	S8975
THE FOREST AT SWAN LAKE - PHASE 5	S8976
THE FOREST AT SWAN LAKE - AMENDED PHASE 5	S10663
THE FOREST AT SWAN LAKE - 2ND AMENDMENT TO PHASE 5	S11506
THE FOREST AT SWAN LAKE - AMENDED PHASE 6	S11636
THE FOREST AT SWAN LAKE - PHASE 7	S9812
THE FOREST AT SWAN LAKE - PHASE 8	S9854
THE FOREST AT SWAN LAKE - PHASE 9	S12114
THE FOREST AT SWAN LAKE - AMENDED PHASE 10	S10259
THE FOREST AT SWAN LAKE - PHASE 11	S10700
THE FOREST AT SWAN LAKE - PHASE 12	S10912
THE FOREST AT SWAN LAKE - PHASE 13	S10911
THE FOREST AT SWAN LAKE - PHASE 14	S11149
THE FOREST AT SWAN LAKE - PHASE 15	S12186
THE FOREST AT SWAN LAKE - PHASE 16	S11498
THE FOREST AT SWAN LAKE - PHASE 17	S11503
THE FOREST (OVERVIEW) 11/22/94	S6392
SADDLE RIDGE - AMENDED PHASE XXI	S11634
SADDLE RIDGE - AMENDED PHASE XXV	S11635

-SEE SECTION 1-


-SEE SECTION 1-

ADDITIONAL SURVEYS

CONDO PLAT OF SWAN LAKE VILLAGE GOLF & TENNIS CONDO C	5673
SADDLE RIDGE (UNDEVELOPED SUBDIVISION PLAT)	6556
SRE EXHIBIT C	6562
SWAN LAKE RESORT(UNDEVELOPED)	6541

-SEE SECTION 11-

-SEE SECTION 12-

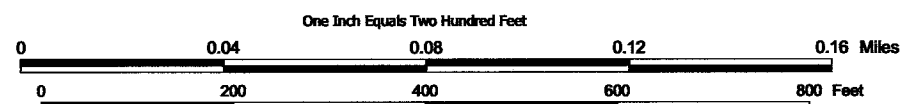


NOTE: This map was prepared for assessment use in accordance with the Wis. St. Stat. Chap. 70.09. All information contained herein is advisory only. Map accuracy is limited to the quality of data obtained from other Public Records. This map is not intended to be a substitute for an actual field survey. Public Land Survey Base is derived from U.S.G.S. Topographic maps unless otherwise noted. Other sources of the Land Base may be actual survey data. Base map data is from the April 1995 County Digital Orthophotos and/or U.S.G.S. 1:24,000 scale Topographic series. The user is responsible for the improper use of the data contained herein.

Created by The Columbia County Land Information Office -GIS Section. VMB. February 2007.

TAX PARCEL MAP

TOWN of PACIFIC

TOWN 12 NORTH RANGE 9 EAST
COLUMBIA COUNTY, WISCONSIN

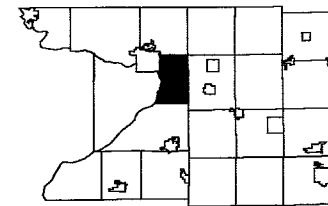

3	2	
10	11	12
15	14	13
22	23	24
28	27	26
33	34	35
		36

Replaced
2009

-TOWN of FORT WINNEBAGO-

STH 33




-SEE SECTION 1-

-SEE PAGE A-

-SEE PAGE C-

SURVEY INDEX	
THE FOREST AT SWAN LAKE - PHASE 1	S6123
THE FOREST AT SWAN LAKE - PHASE 16	S11498
THE FOREST AT SWAN LAKE - PHASE 17	S11503
THE FOREST (OVERVIEW) 11/22/94	S6392
SRE PHASE I	6885
SRE AMENDED PHASE I	12061
SRE 2ND AMENDMENT TO PHASE I	11507

ADDITIONAL SURVEYS	
CONDO PLAT OF SWAN LAKE VILLAGE	GOLF & TENNIS CONDO C
SADDLE RIDGE (UNDEVELOPED SUBDIVISION PLAT)	6556
SRE EXHIBIT C	6562
SWAN LAKE RESORT(UNDEVELOPED)	6541

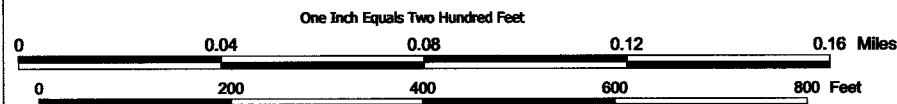


NOTE: This map was prepared for assessment use in accordance with the Wis. St. Stat. Chap. 70.09. All information contained herein is advisory only. Map accuracy is limited to the quality of data obtained from other Public Records. This map is not intended to be a substitute for an actual field survey. Public Land Survey Base is derived from U.S.G.S. Topographic maps unless otherwise noted. Other sources of the Land Base may be actual survey data. Base map data is from the April 1995 County Digital Orthophotos and/or U.S.G.S. 1:24,000 scale Topographic series. The user is responsible for the improper use of the data contained herein.

Created by The Columbia County Land Information Office -GIS Section. VMB. February 2007.

TAX PARCEL MAP

TOWN of PACIFIC


TOWN 12 NORTH RANGE 9 EAST
COLUMBIA COUNTY, WISCONSIN

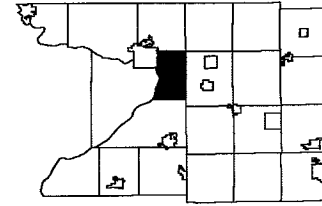

3	2	
10	11	12
15	14	13
22	23	24
28	27	26
33	34	35
		36

Replaced
2009

-TOWN of FORT WINNEBAGO-

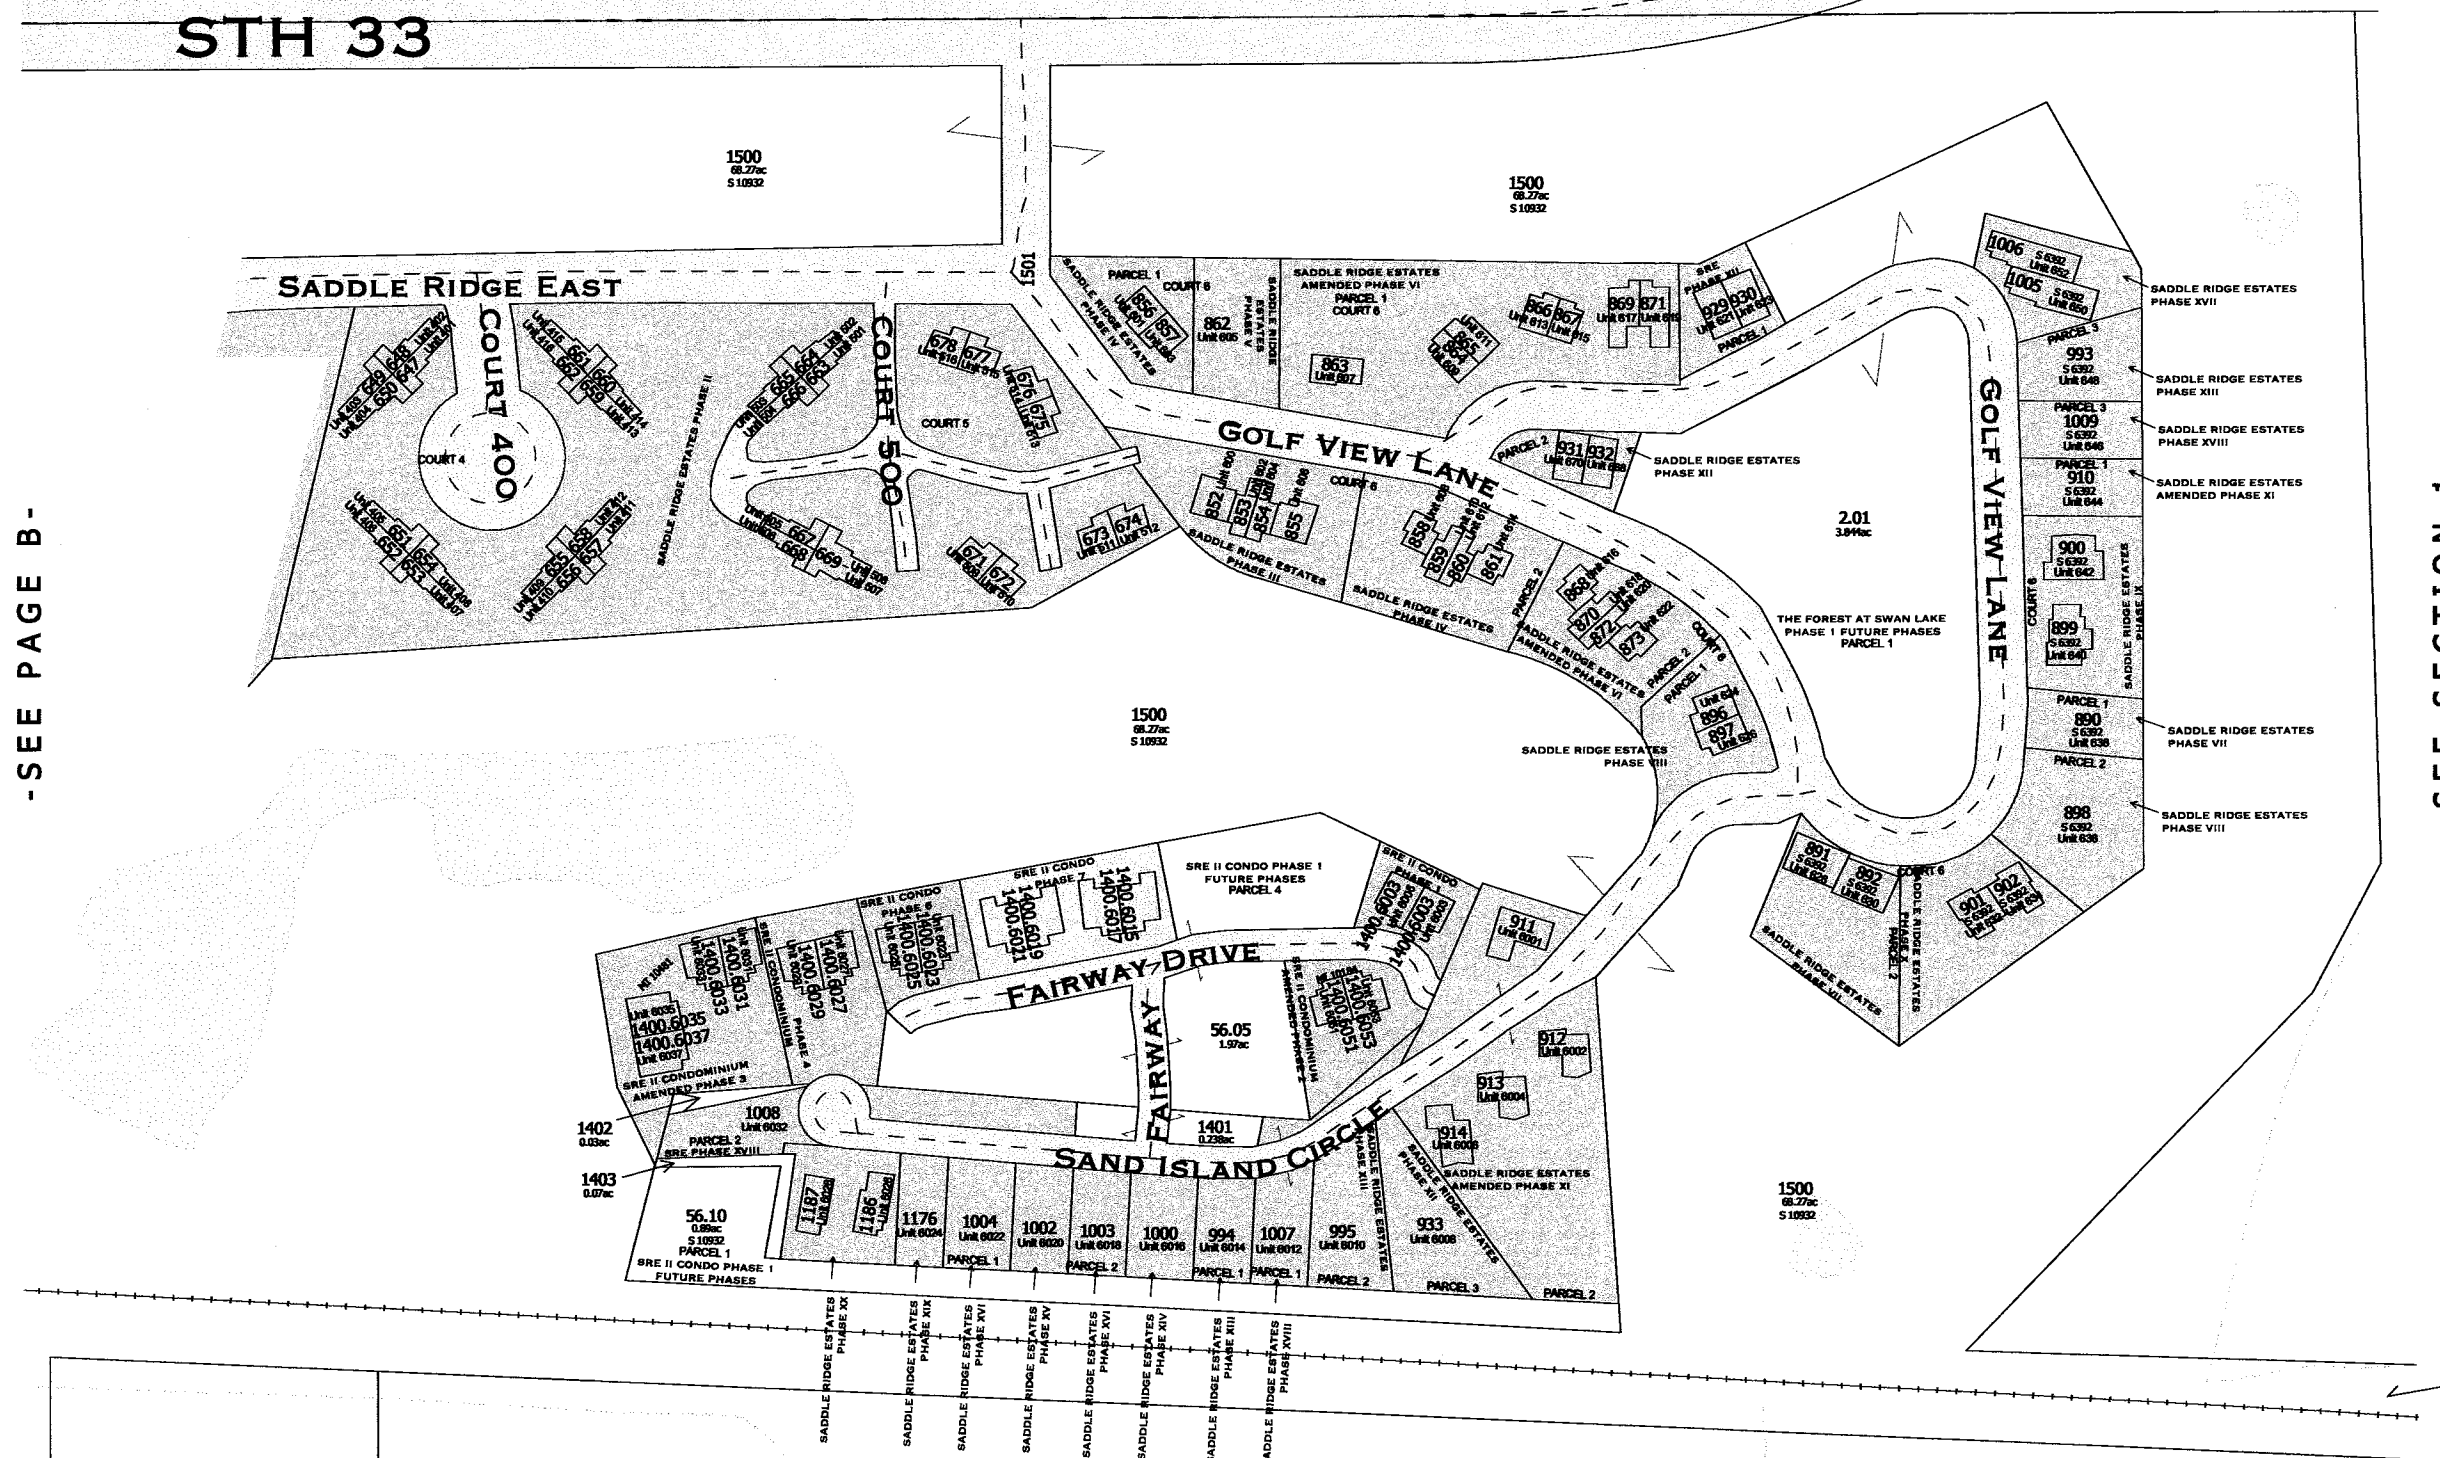

-SEE PAGE B-

-SEE SECTION 1-


-SEE SECTION 1-

SURVEY INDEX

THE FOREST AT SWAN LAKE - PHASE 1	S 6123
SRE II PHASE I	9943
SRE II AMENDED PHASE I	10260
SRE II PHASE II	10090
SRE II AMENDED PHASE II	10661
SRE II PHASE III	10261
SRE II AMENDED PHASE III	10662
SRE II PHASE IV	10733
SRE II PHASE VI	12185
SRE II PHASE VII	12793

ADDITIONAL SURVEYS


CONDO PLAT OF SWAN LAKE VILLAGE GOLF & TENNIS CONDO C	5673
SADDLE RIDGE (UNDEVELOPED SUBDIVISION PLAT)	6556
SRE EXHIBIT C	6562
SWAN LAKE RESORT(UNDEVELOPED)	6541

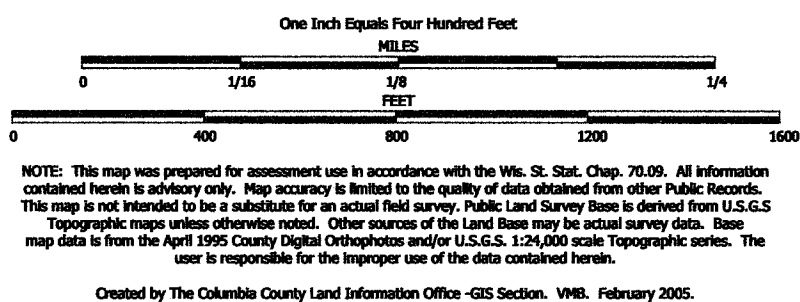

TAX PARCEL MAP

TOWN of PACIFIC

TOWN 12 NORTH RANGE 9 EAST
COLUMBIA COUNTY, WISCONSIN

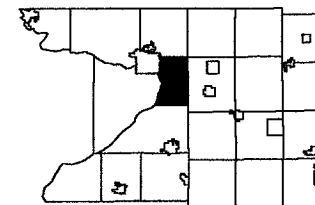


3	2	
10	11	12
15	14	13
22	23	24
29	27	26
33	34	35

TOWN OF FORT WINNEBAGO

Replaced
2009

-SEE SECTION 2-

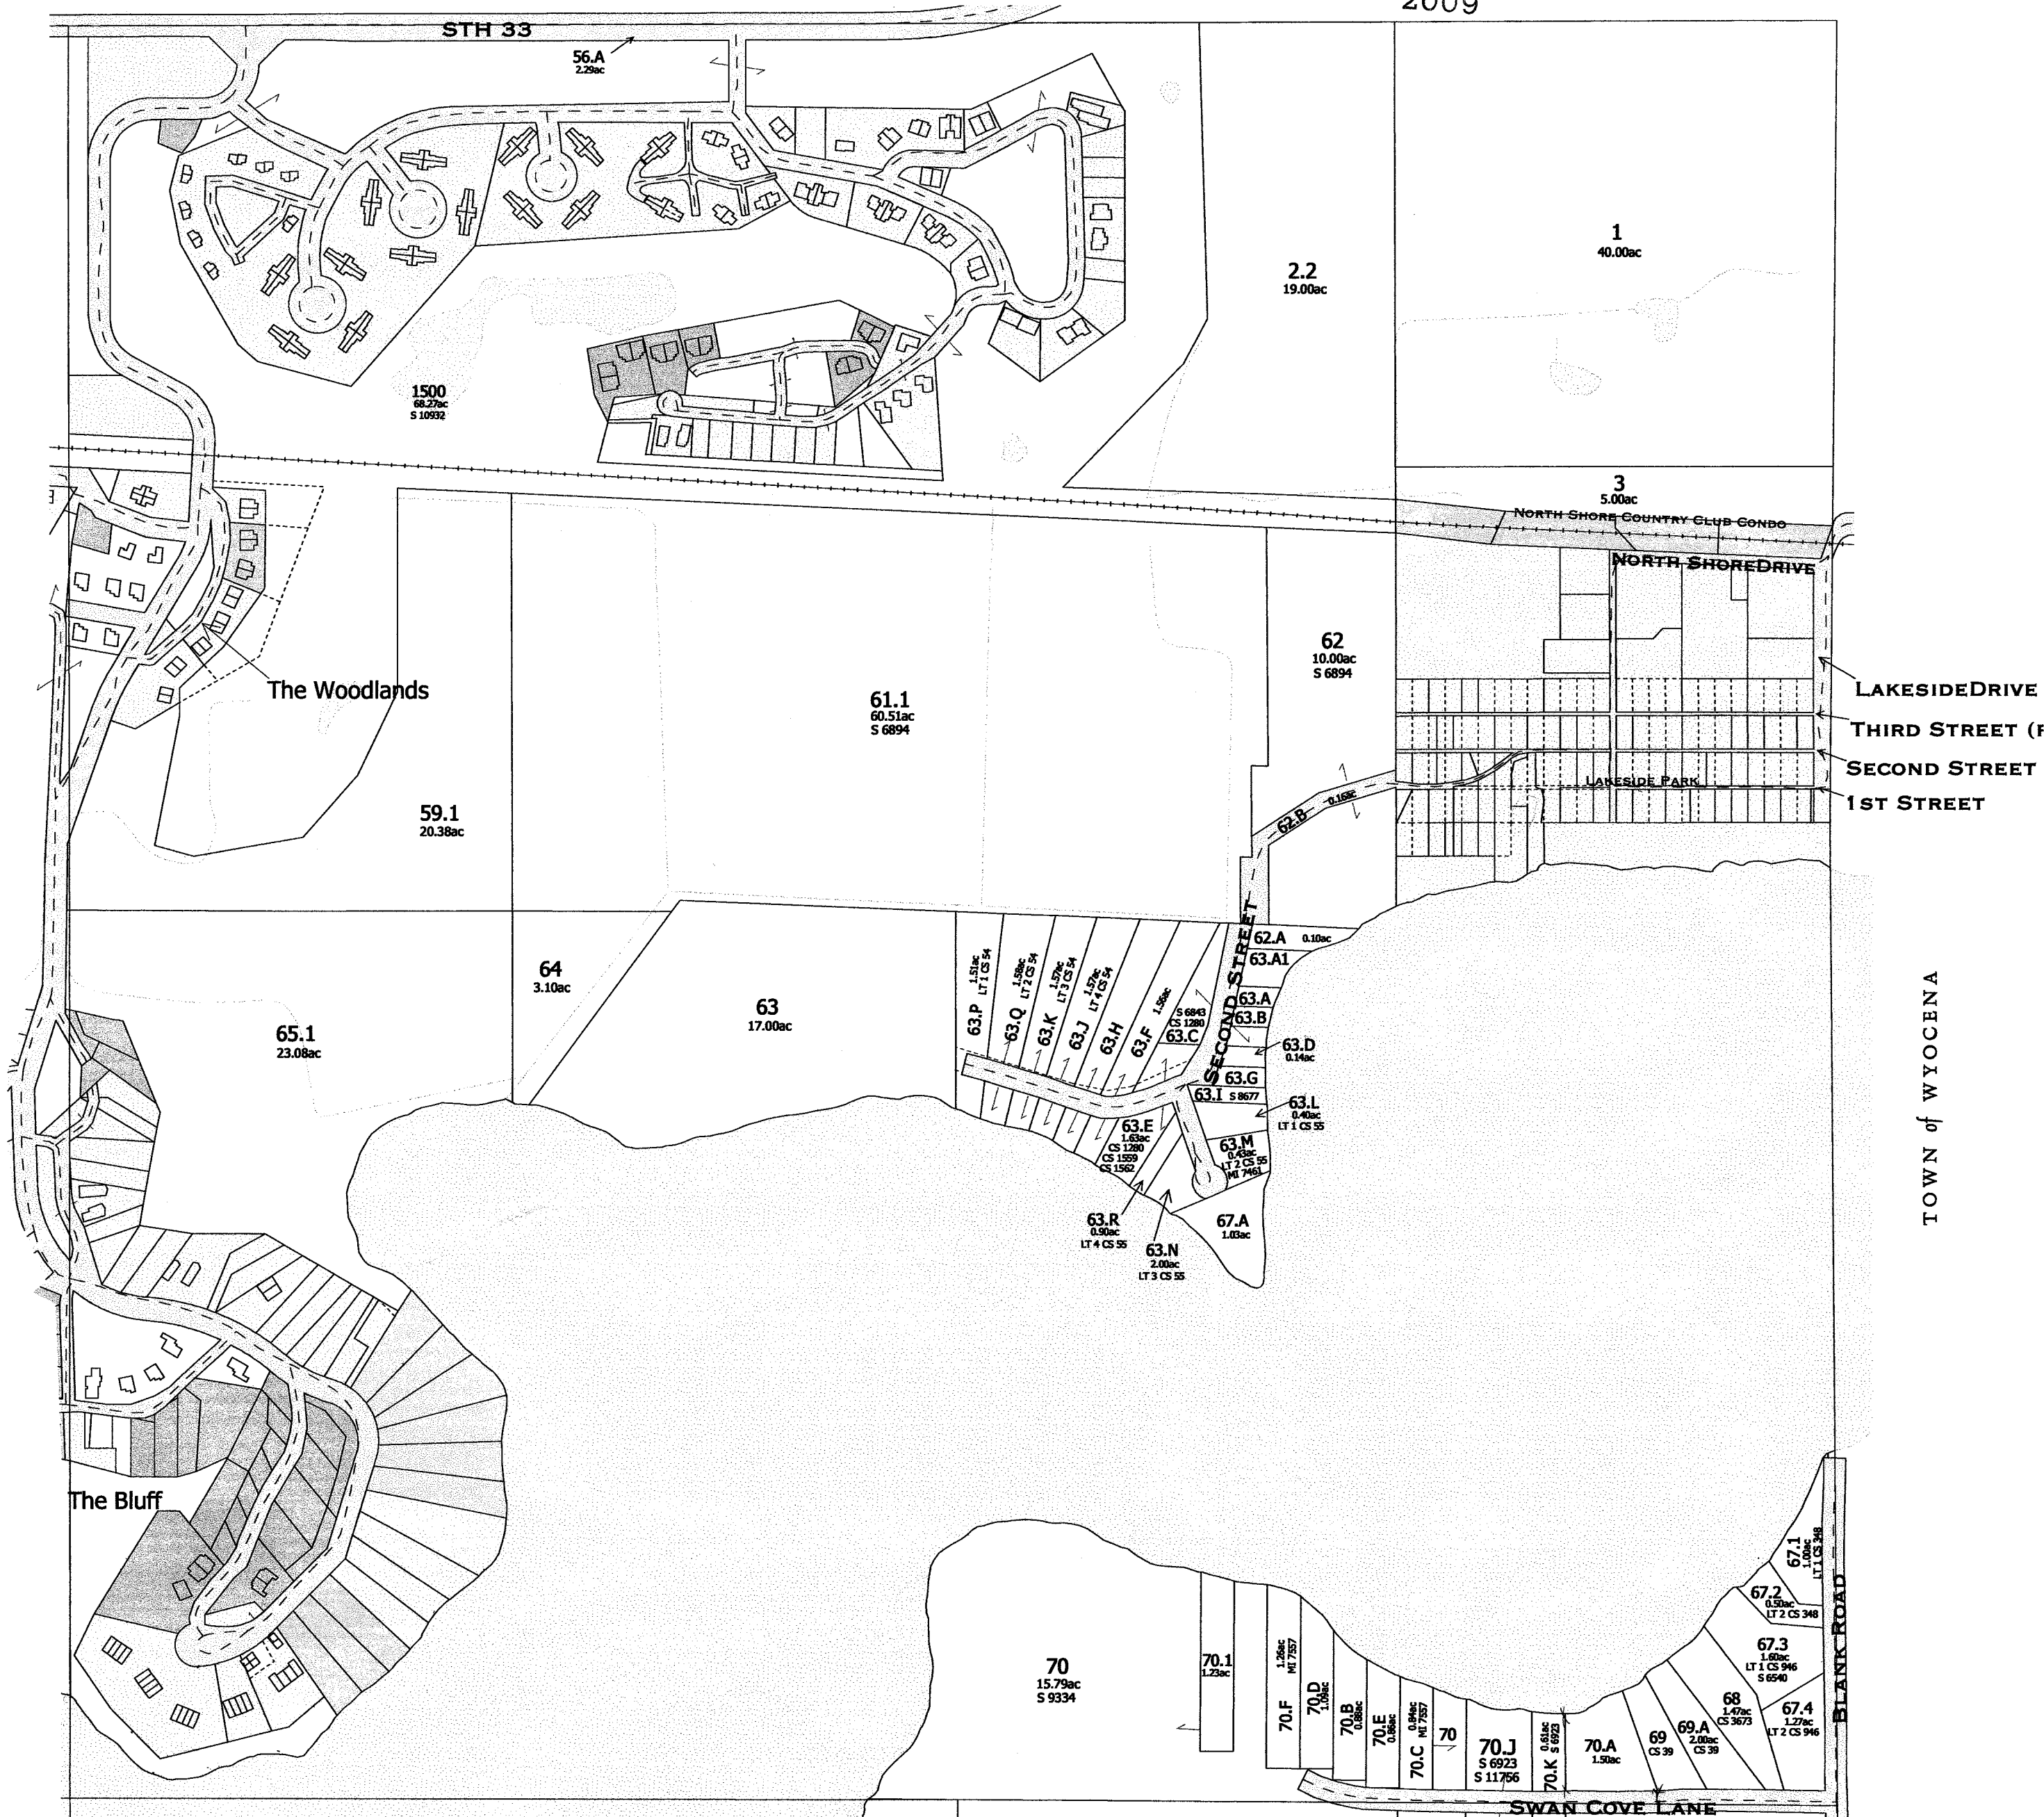

-SEE SECTION 12-

FOR DETAILED MAP OF SUBDIVISIONS, SEE THE FOLLOWING PAGES.

-SECTION 1-


NOTE: This map was prepared for assessment use in accordance with the Wis. St. Stat. Chap. 70.09. All information contained herein is advisory only. Map accuracy is limited to the quality of data obtained from other Public Records. This map is not intended to be a substitute for an actual field survey. Public Land Survey Base is derived from U.S.G.S Topographic maps unless otherwise noted. Other sources of the Land Base may be actual survey data. Base map data is from the April 1995 County Digital Orthophotos and/or U.S.G.S. 1:24,000 scale Topographic series. The user is responsible for the improper use of the data contained herein.

Created by The Columbia County Land Information Office -GIS Section, VMB, February 2007.

TAX PARCEL MAP

TOWN of PACIFIC

TOWN 12 NORTH RANGE 9 EAST
COLUMBIA COUNTY, WISCONSIN

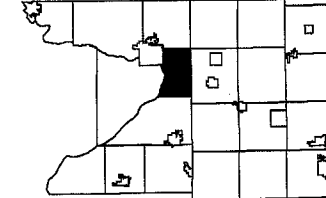

3	2	1
10	11	12
15	14	13
22	23	24
28	27	26
33	34	35

Replaced
2009

TOWN OF FORT WINNEBAGO


SECTION	SUBDIVISION PLAT
14	APPLE VALLEY
14	APPLE VALLEY 1ST ADDITION
12	CRANE VIEW ESTATES
14	DEER RUN
14	DEER RUN REDIVISION
1	FOREST AT SWAN LAKE PHASE 1
11, 14	FOX RUN ESTATES
15	GEIKE ESTATES
14	HIGHLAND MEADOWS
11, 14	HIGHLAND MEADOWS 1ST ADDITION
22	HILLCREST HEIGHTS
22	HILLCREST HEIGHTS 1ST ADDITION
14	JAKE'S BOROUGH
14	LAKE GEORGE ESTATES
1	LAKESIDE PARK PLAT
15	MEADOWVIEW
1	NORTH SHORE COUNTRY CLUB
35	NORTH STAR VALLEY
35	NORTH STAR VALLEY 1ST ADDITION
14	PACIFIC CONDOMINIUM
3, 4	PACIFIC ESTATES
4	PACIFIC ESTATES 1ST ADDITION
4	PACIFIC ESTATES 1ST ADDITION REPLAT
35	PACIFIC HEIGHTS
12	PACIFIC RIDGE
1	SADDLE RIDGE
1	SADDLE RIDGE ESTATES
1	SRE II CONDOMINIUM
3	STONEHAVEN PLAT
1	SWAN LAKE CONDOMINIUM
1	SWAN LAKE VILLAGE CONDOMINIUM 2ND AMENDMENT
1	SWAN LAKE VILLAGE CONDOMINIUM 3RD AMENDMENT
36	TWIN RIDGE
25	UNRECORDED PFAFF PLAT

ADDITIONAL SURVEYS & FILED DOCUMENTS

S4996 PARTS OF SECTIONS 14, 15, 22, & 23
V8509 VACATION OF LEARMOUTH ROAD
S6865 SECTION 34


ROAD RELOCATION SURVEYS

S2276 HWY 16/51
S2277
S2278
S2279
S2280
S2281
S7505 DUNNING ROAD

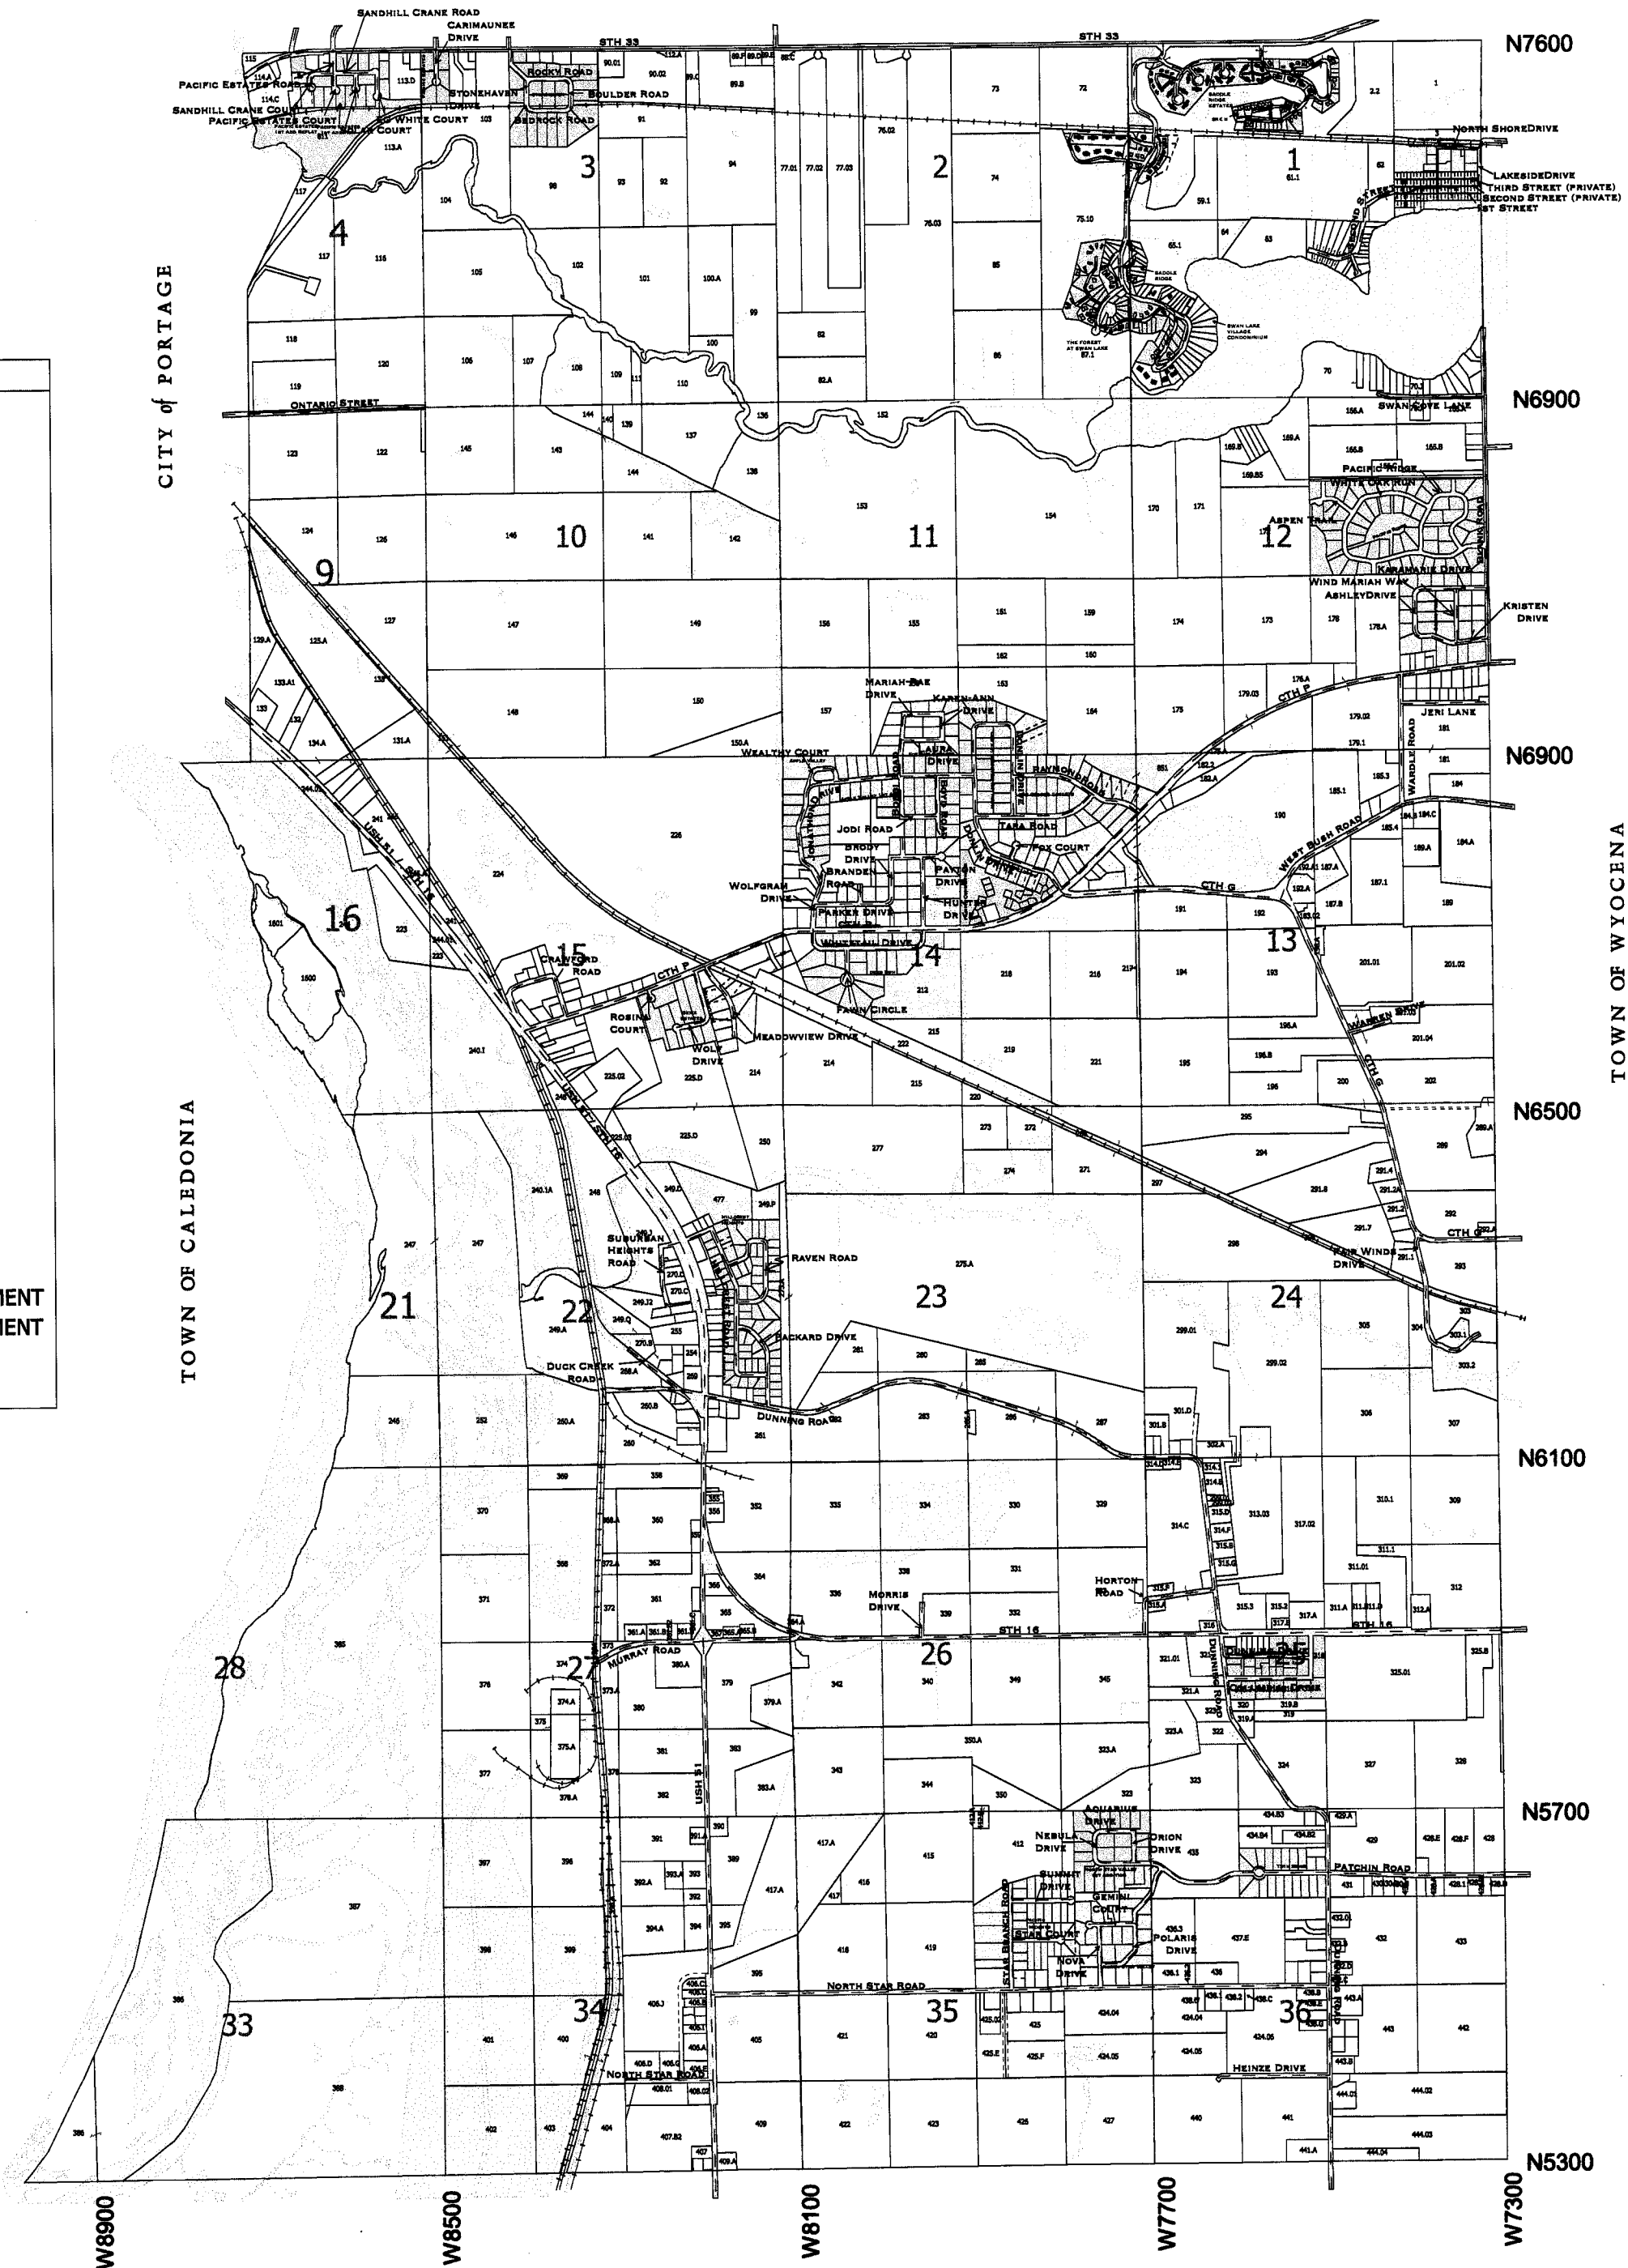

TOWN OF DEKORRA

PAGE - PLAT INDEX

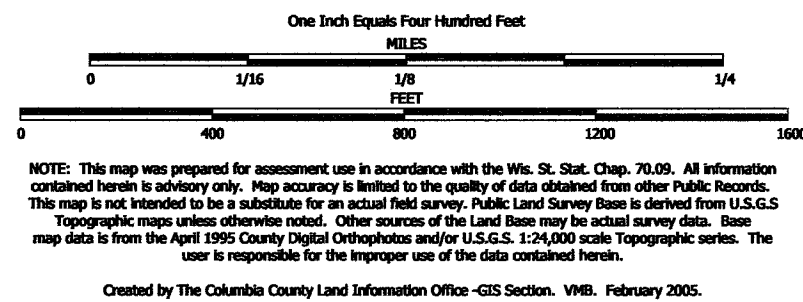


TAX PARCEL MAP

TOWN of PACIFIC

TOWN 12 NORTH RANGE 9 EAST
COLUMBIA COUNTY, WISCONSIN

Replaced
2009

-SEE SECTION 25-

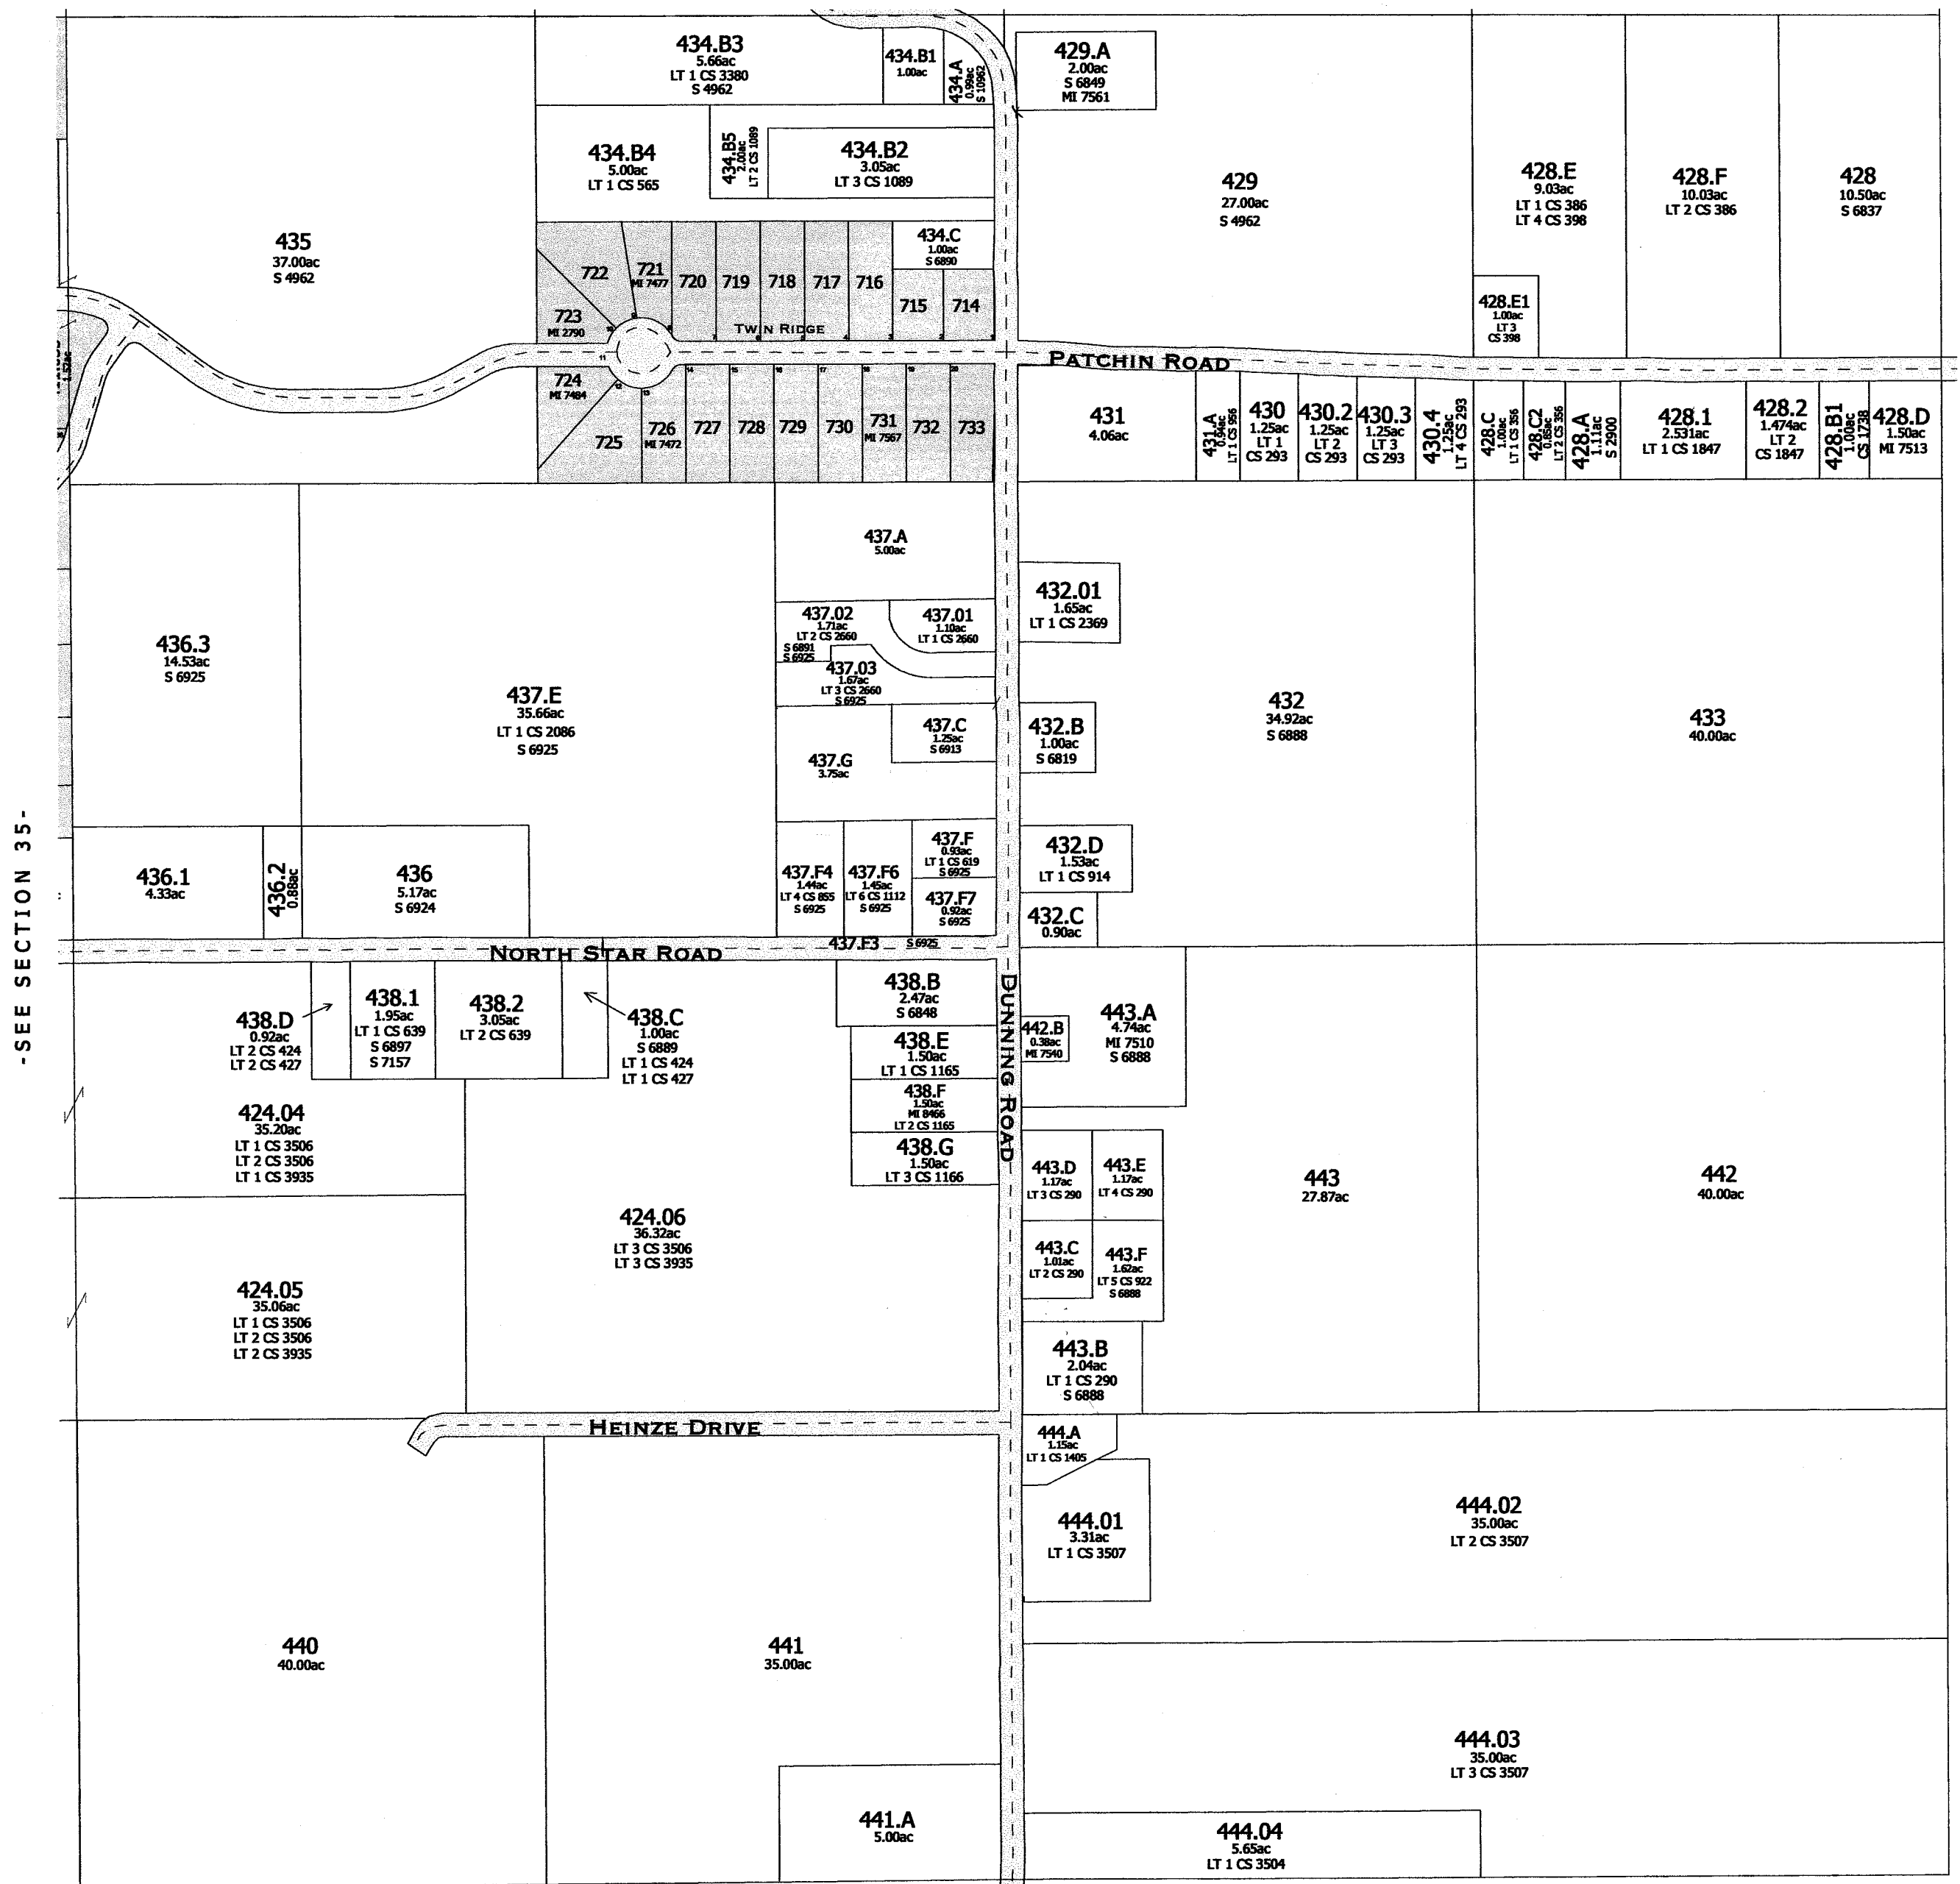

TOWN OF DEKORRA

TWIN RIDGE - S6911


-SECTION 36-

TOWN OF PACIFIC


SECTION 4 T12N R9E

1 inch = 400 feet 1:4,800

SEE SECTION 33 TOWN OF FORT WINNEBAGO

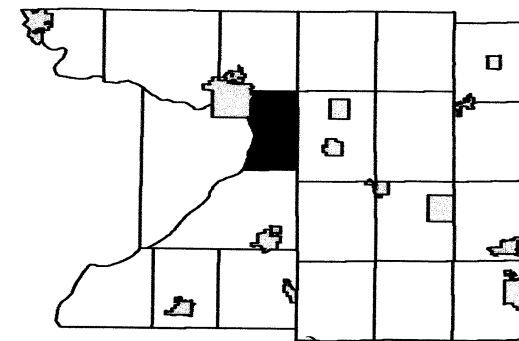

2	3	2	1
9	10	11	12
16	15	14	13
	22	23	24
28	27	26	25
33	34	35	36

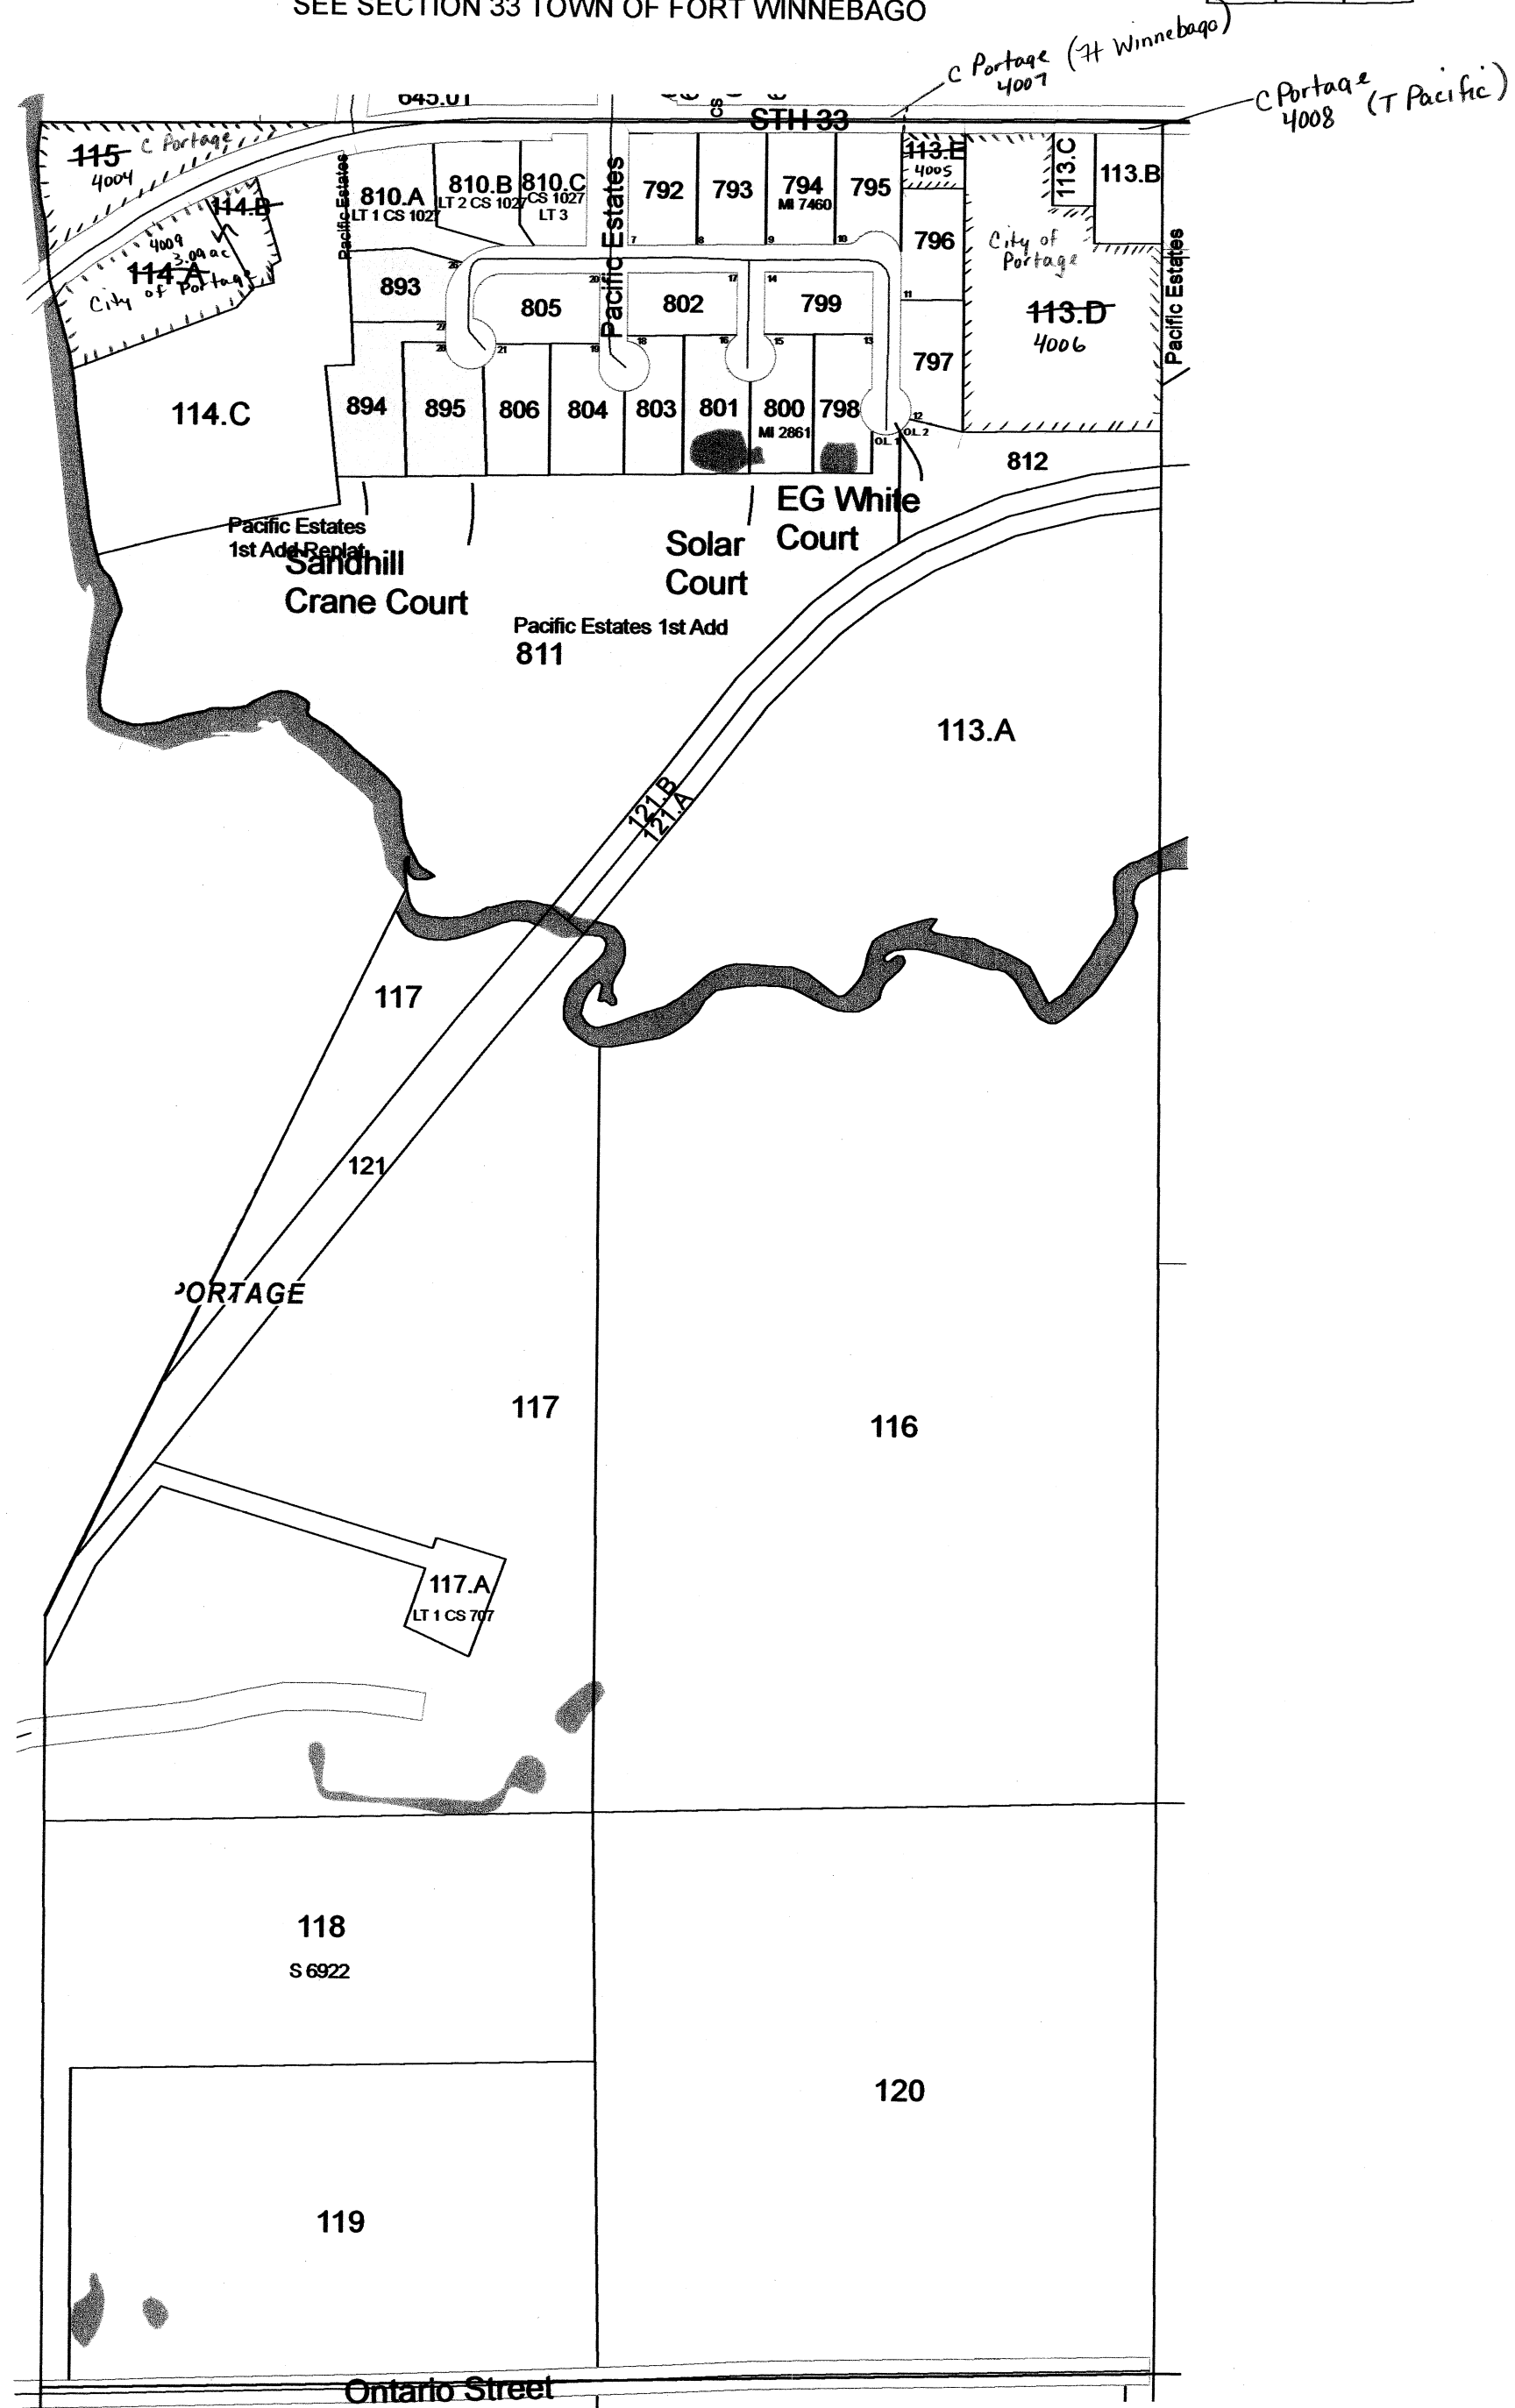


SEE CITY OF PORTAGE

SEE SECTION 03 TOWN OF PACIFIC

1 inch = 400 feet 1:4,800

4		2	1
9	10	11	12
16	15	14	13
	22	23	24
28	27	26	25
33	34	35	36

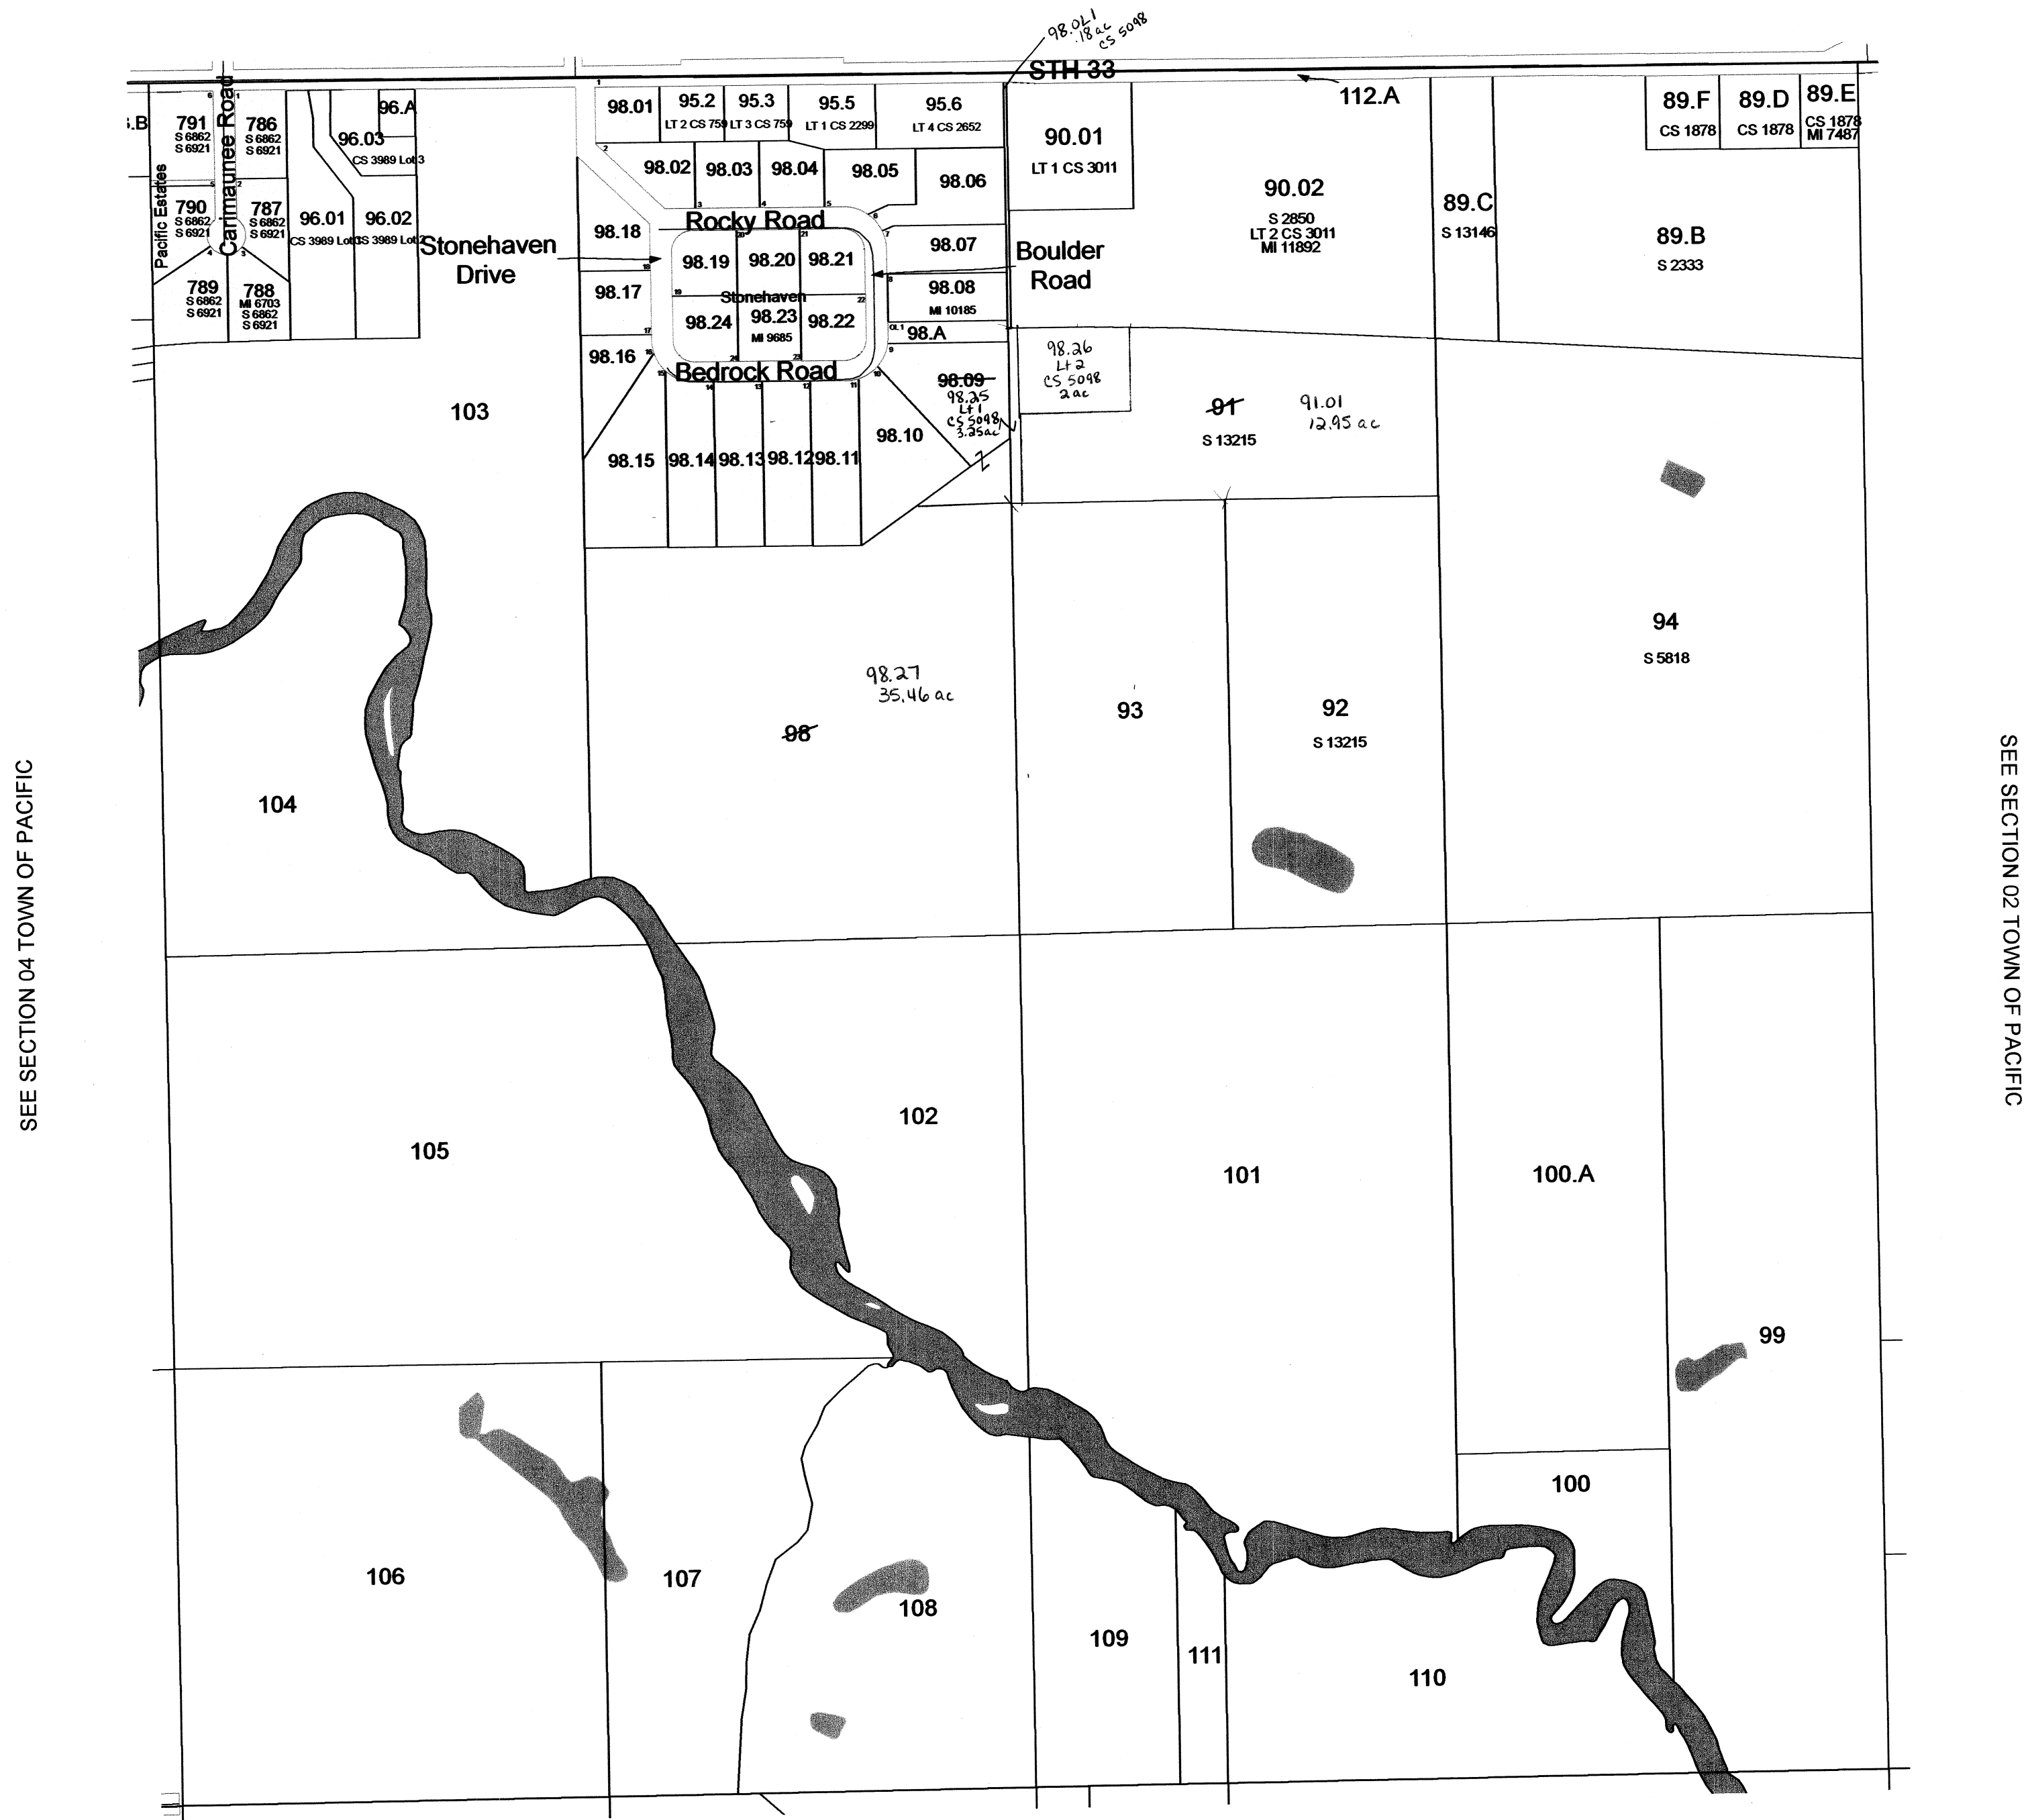


February 10, 2009
Columbia County Land Information

SEE SECTION 10 TOWN OF PACIFIC

Replaced
2010


SECTION 03
T12N R9E

TOWN OF PACIFIC

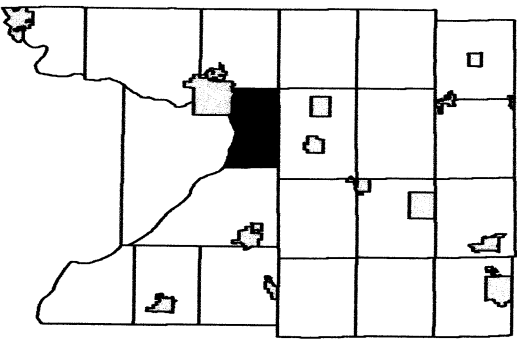

	3	2	1
9	10	11	12
16	15	14	13
	22	23	24
28	27	26	25
33	34	35	36

SEE TOWN OF FORT WINNEBAGO

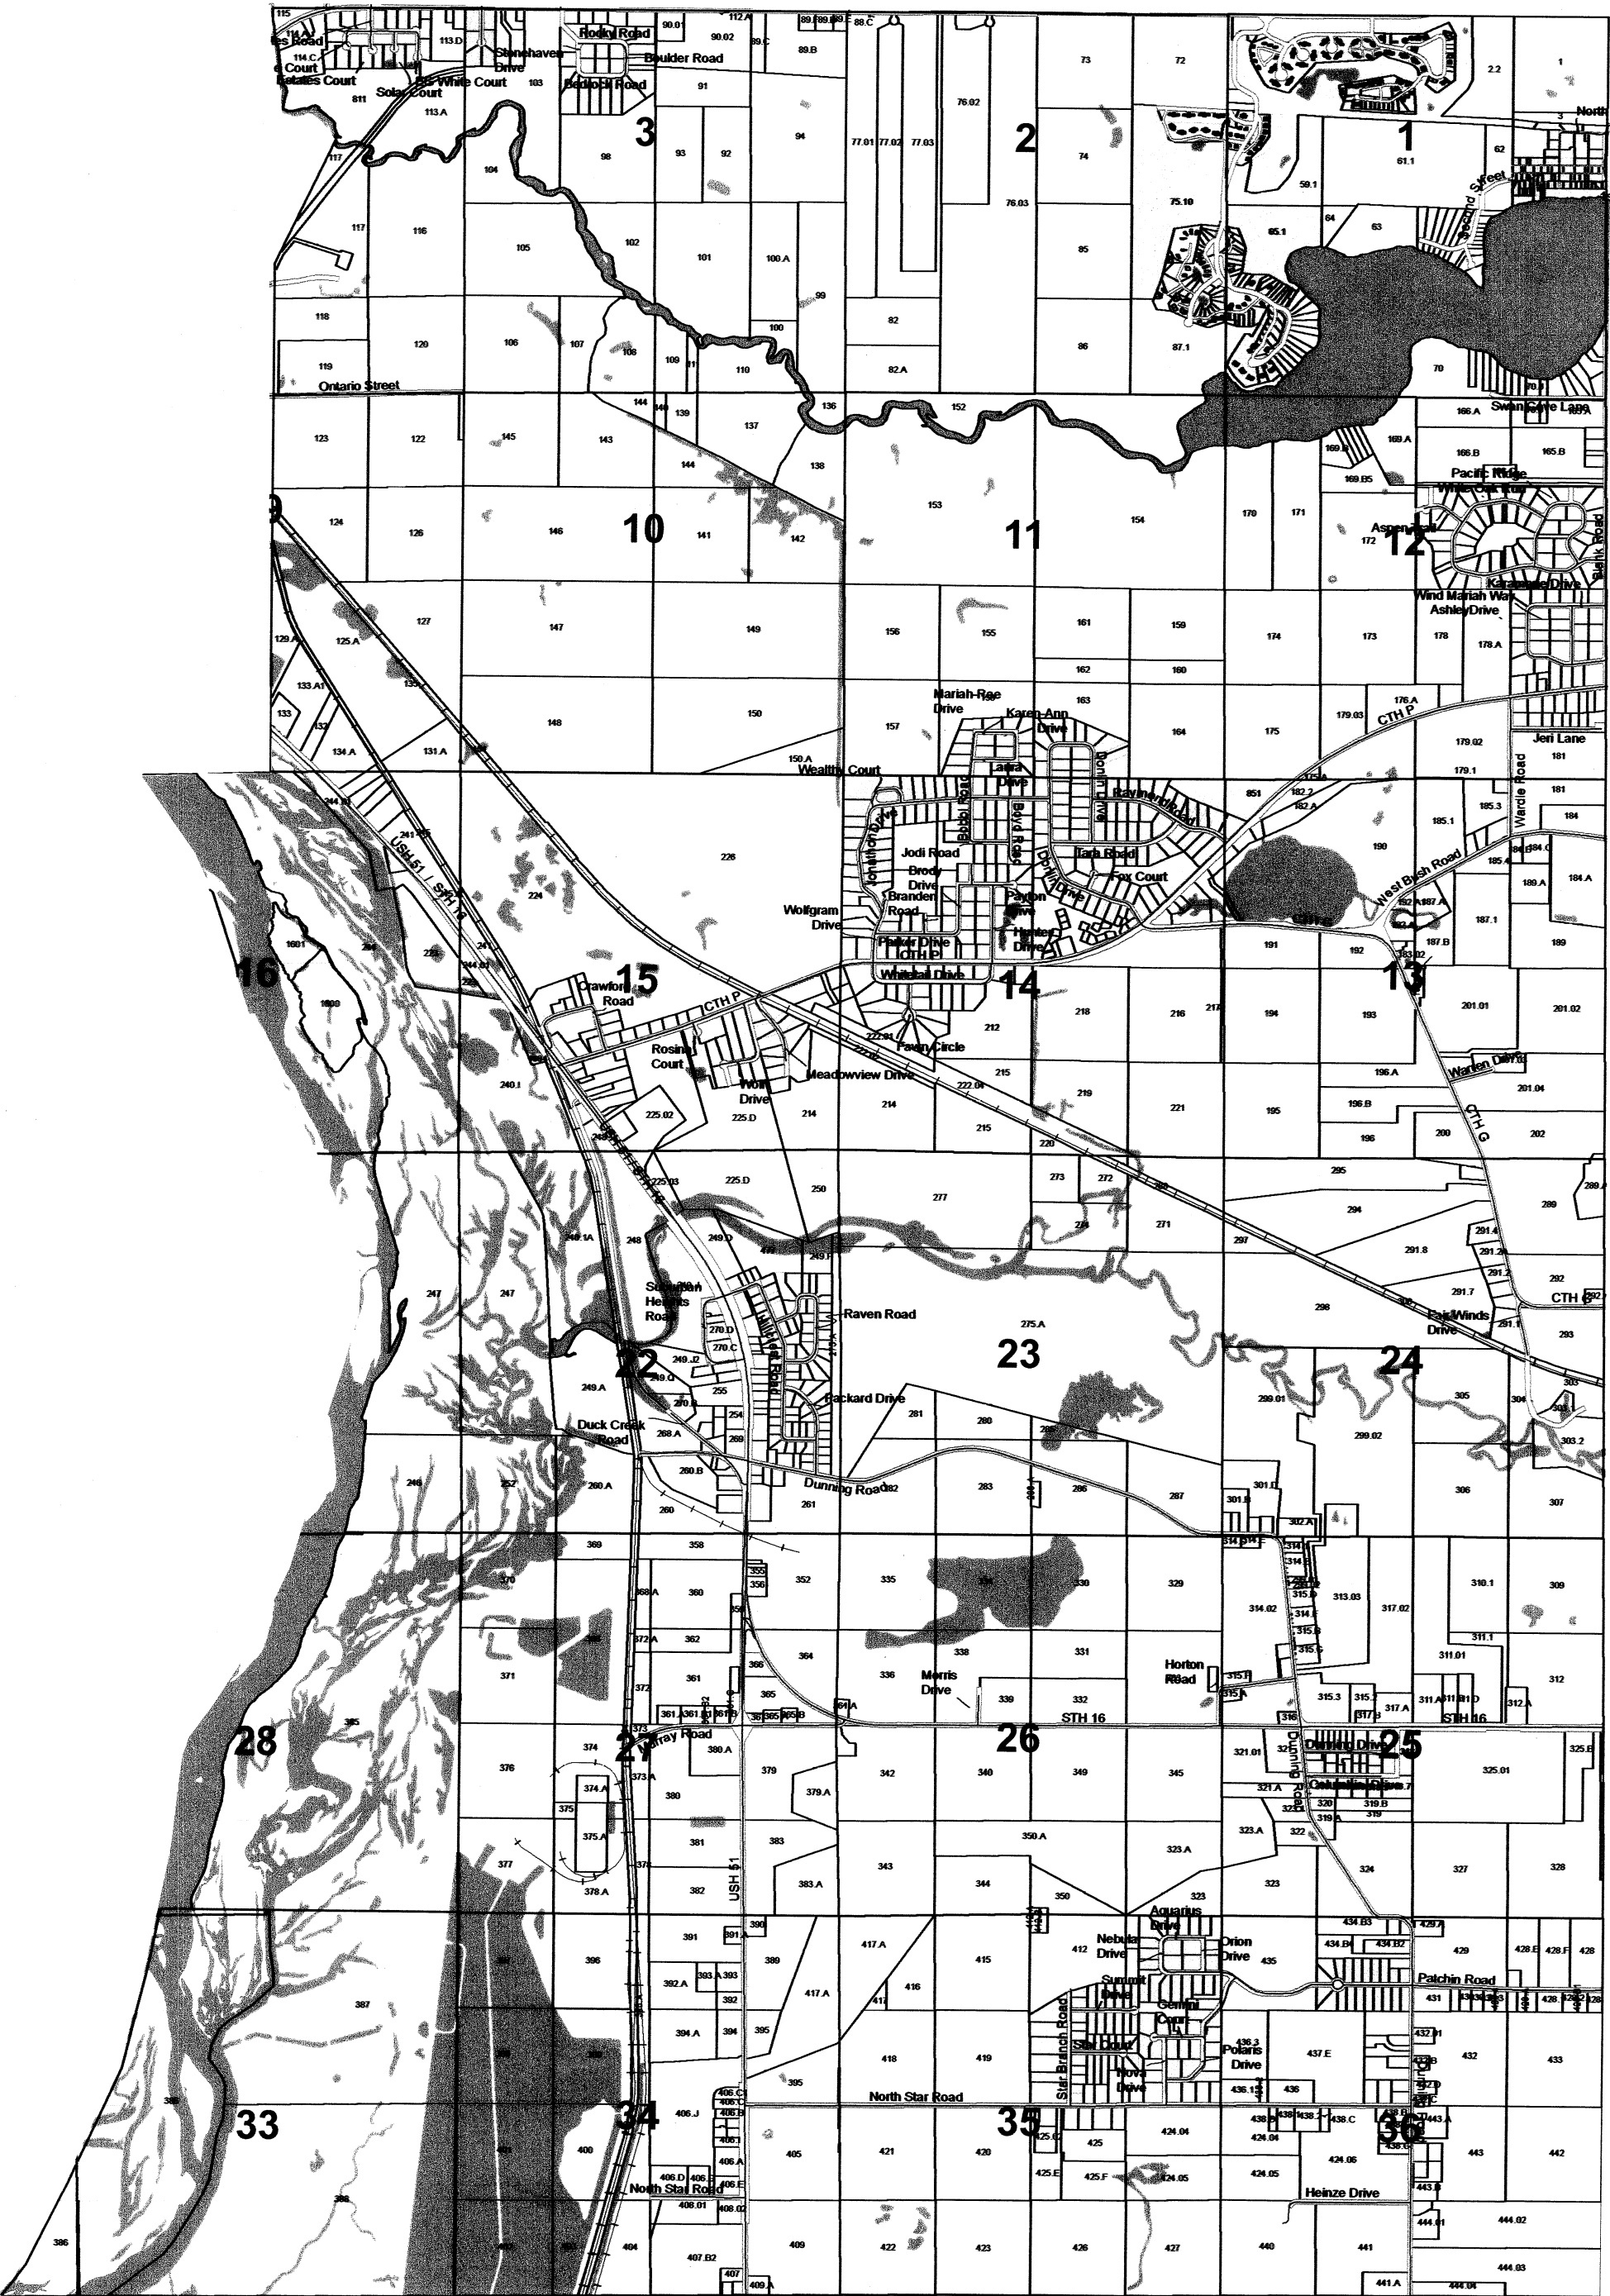

SEE TOWN OF CALEDONIA


SEE TOWN OF WYOCENA

SEE TOWN OF DEKORRA

TOWN OF PACIFIC

SECTION 25 T12N R9E

1 inch = 400 feet 1:4,800

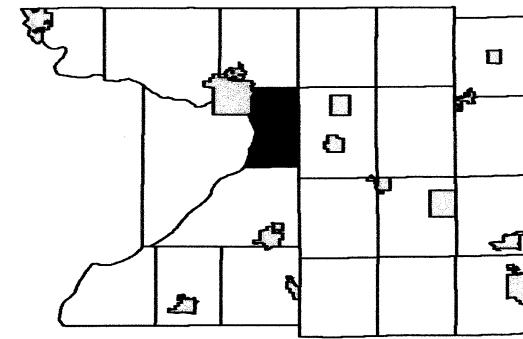


3	2	1
10	11	12
16	15	14
22	23	24
28	27	26
33	34	35

SEE SECTION 24 TOWN OF PACIFIC

SEE SECTION 26 TOWN OF PACIFIC

SEE SECTION 19 TOWN OF WYOCENA

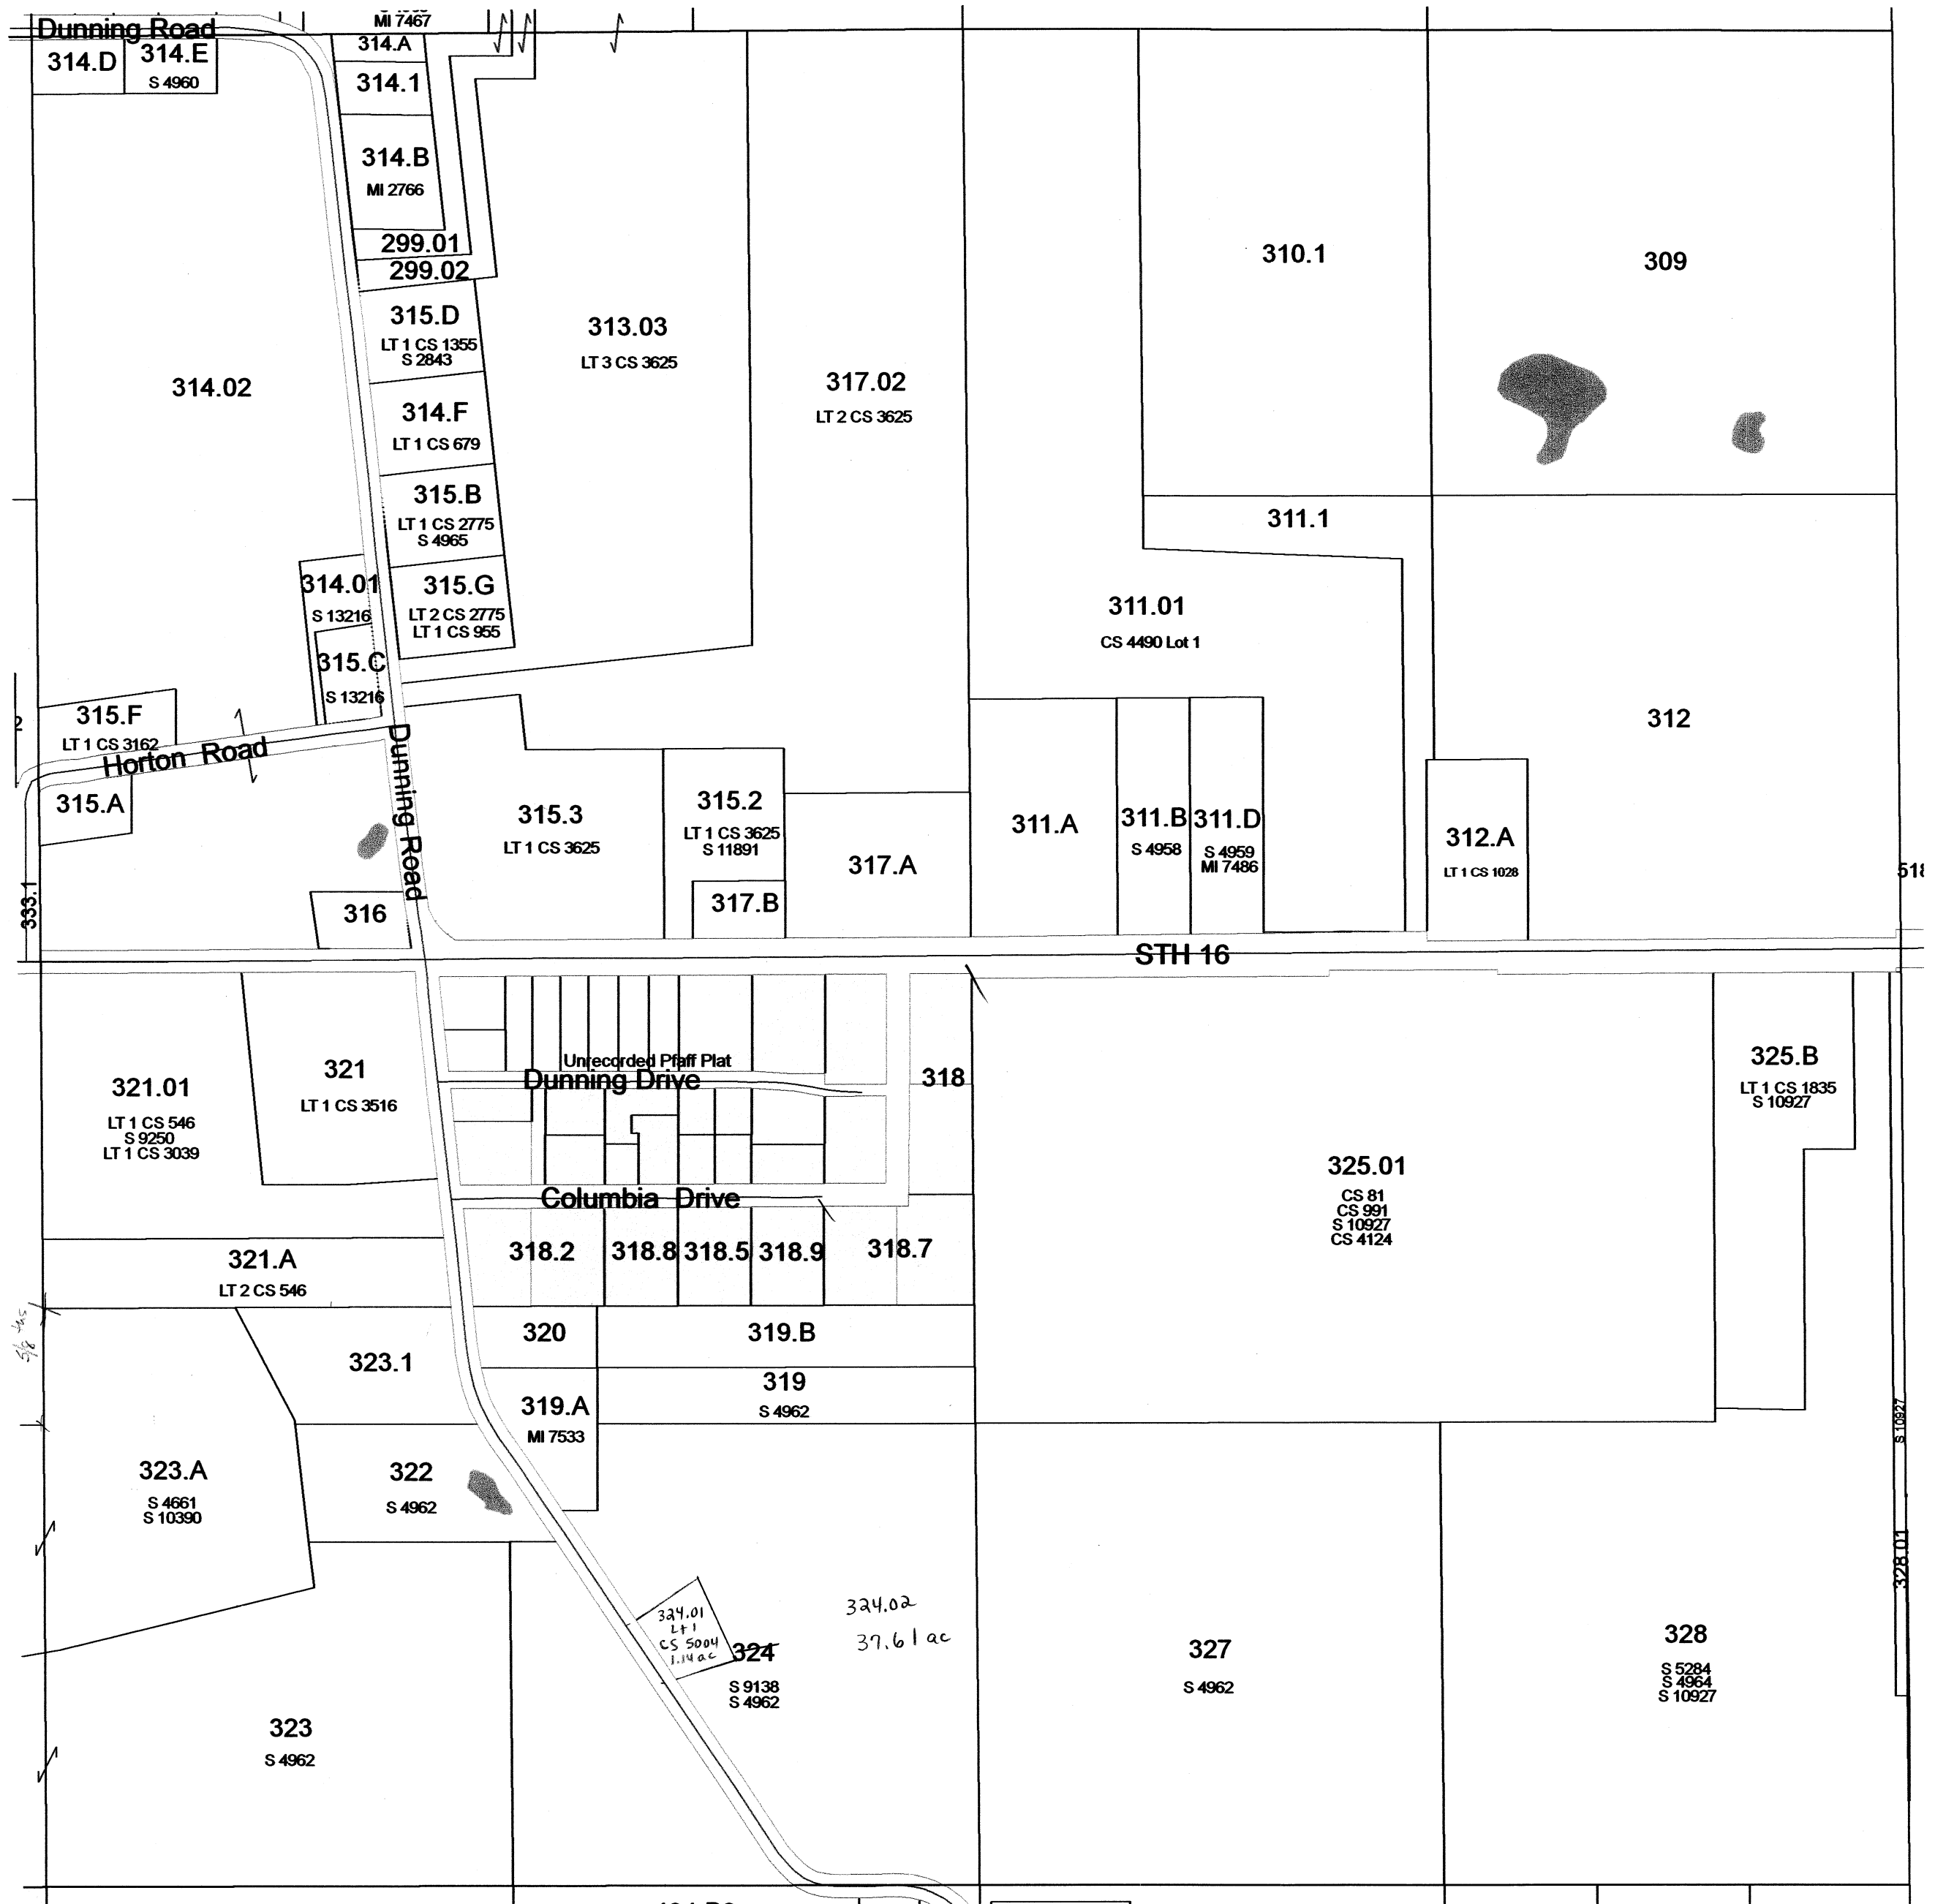


SEE SECTION 36 TOWN OF PACIFIC

TOWN OF PACIFIC


SECTION 4 T12N R9E

1 inch = 400 feet 1:4,800

SEE SECTION 33 TOWN OF FORT WINNEBAGO

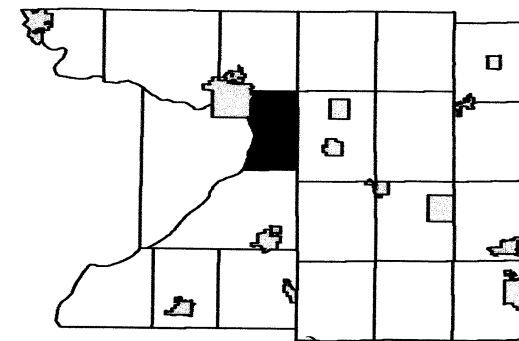

2	3	2	1
9	10	11	12
16	15	14	13
	22	23	24
28	27	26	25
33	34	35	36

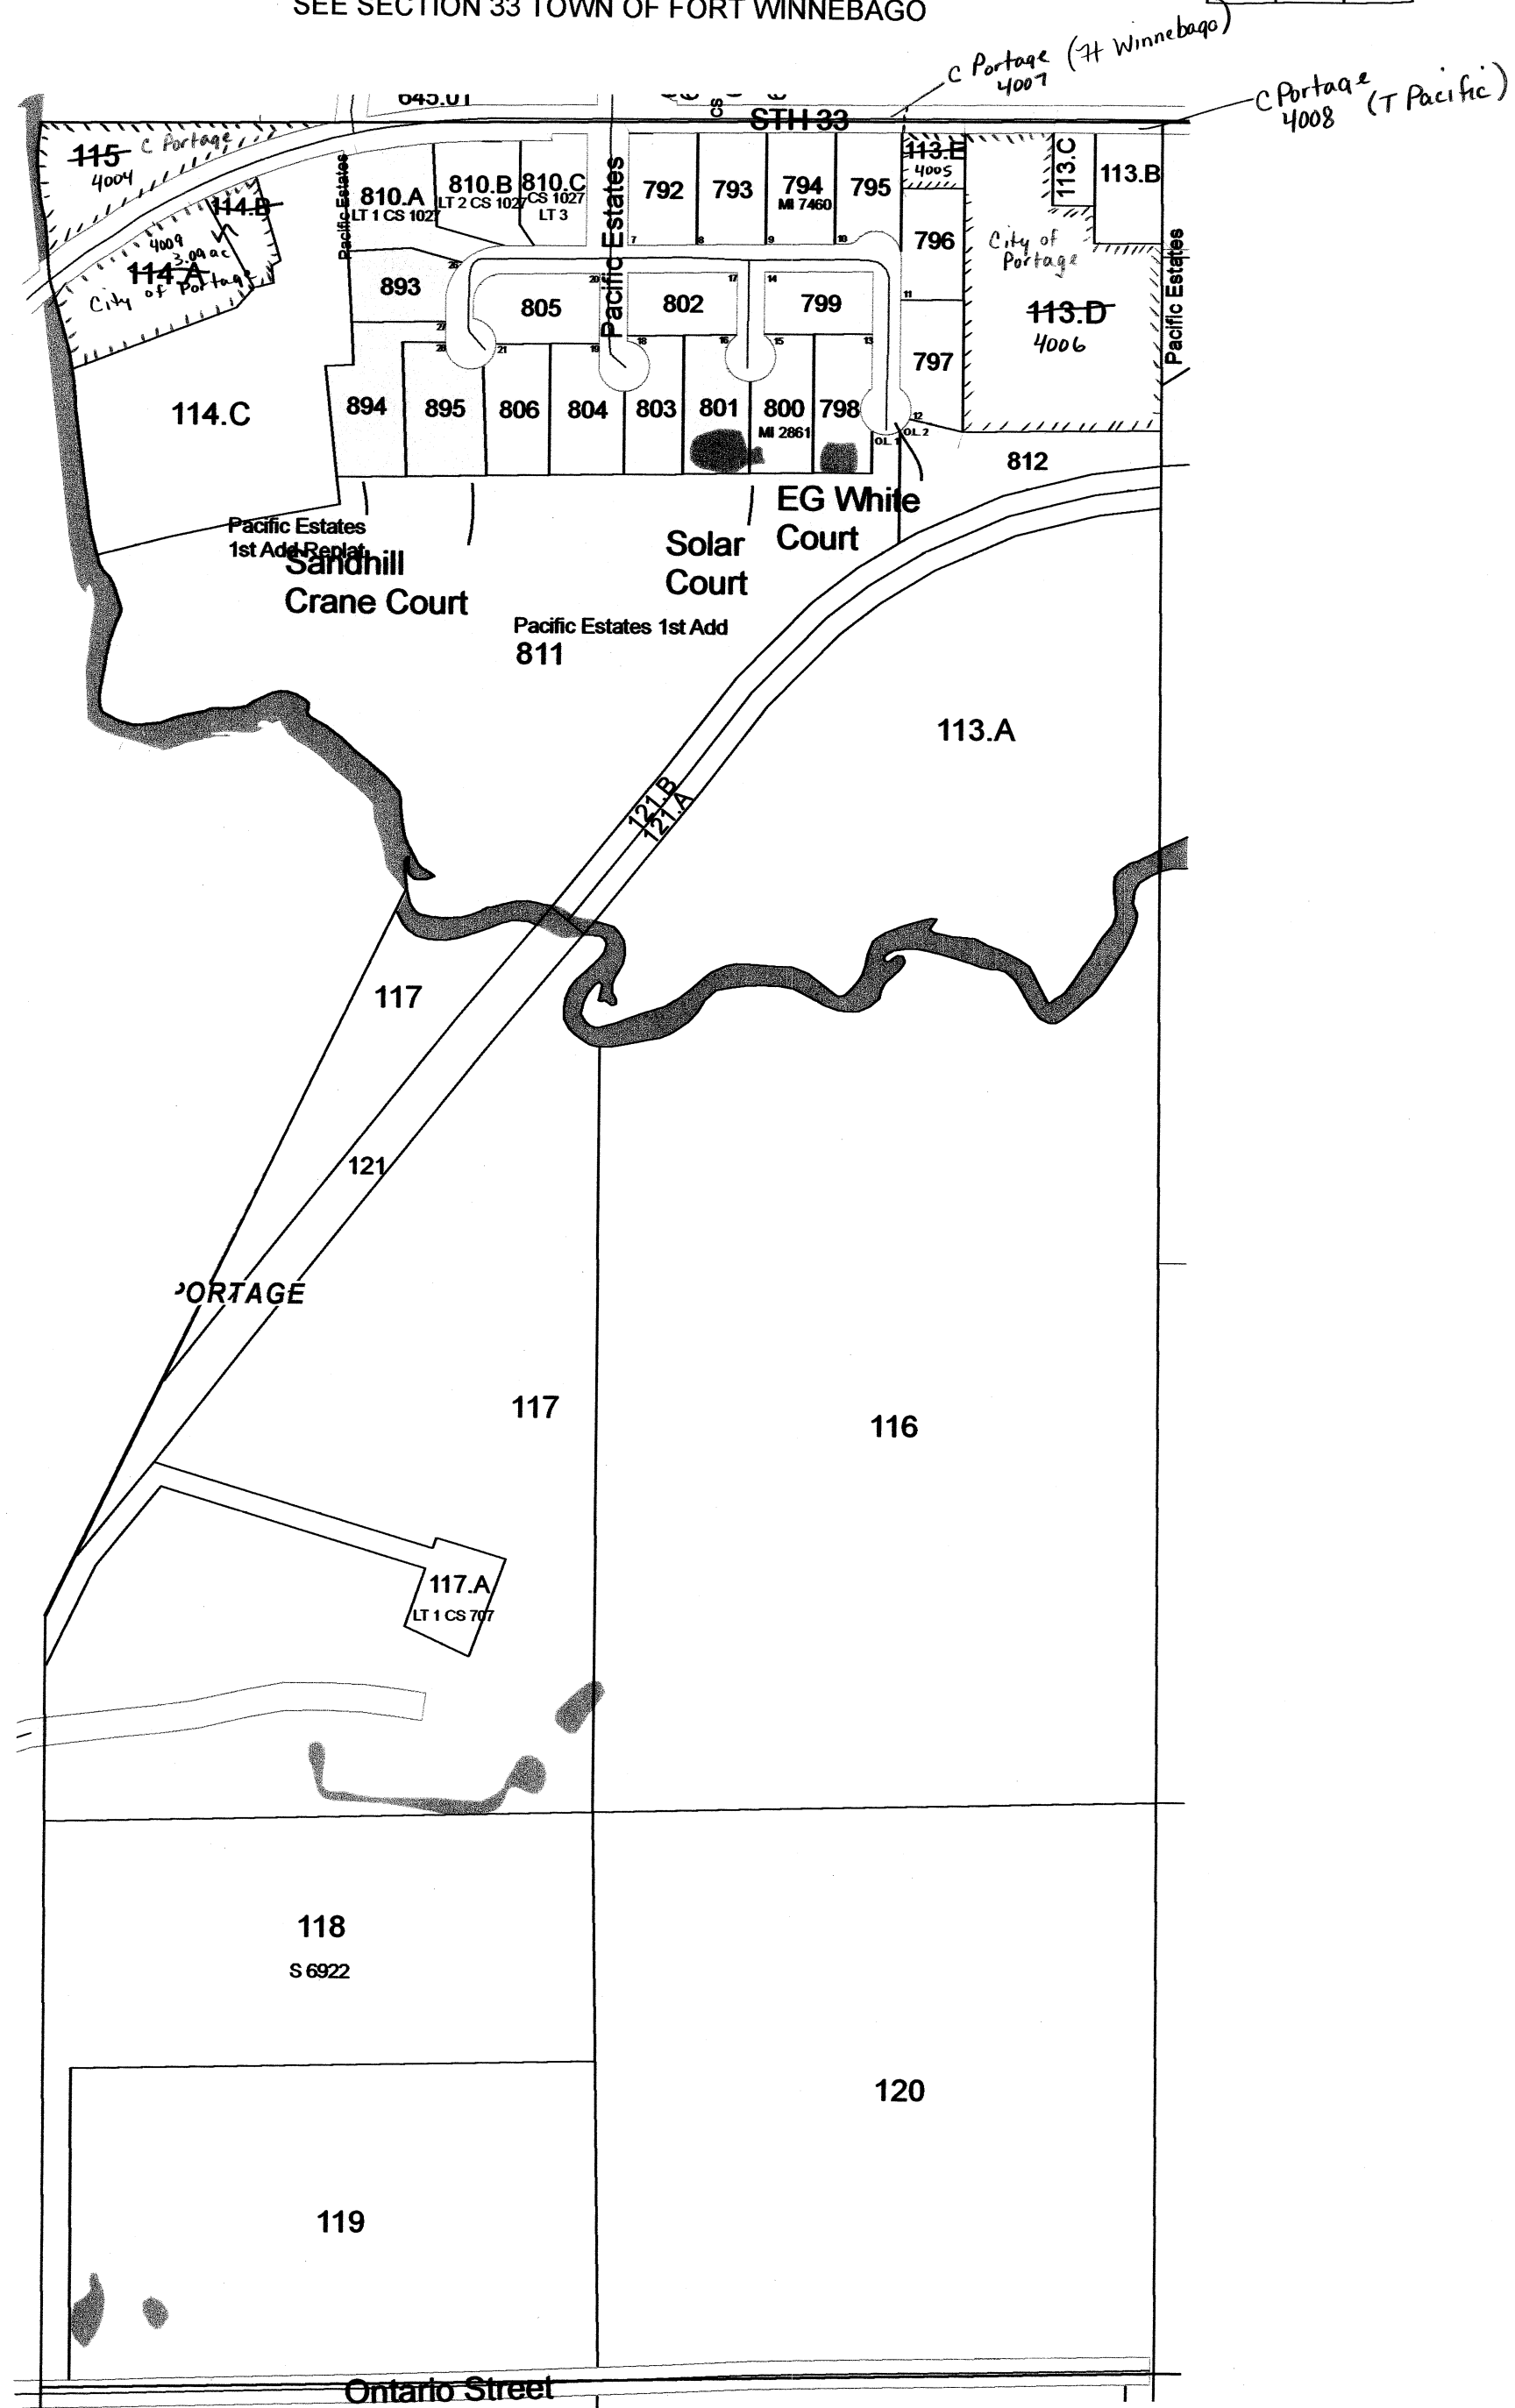


SEE CITY OF PORTAGE

SEE SECTION 03 TOWN OF PACIFIC

1 inch = 400 feet 1:4,800

4		2	1
9	10	11	12
16	15	14	13
	22	23	24
28	27	26	25
33	34	35	36

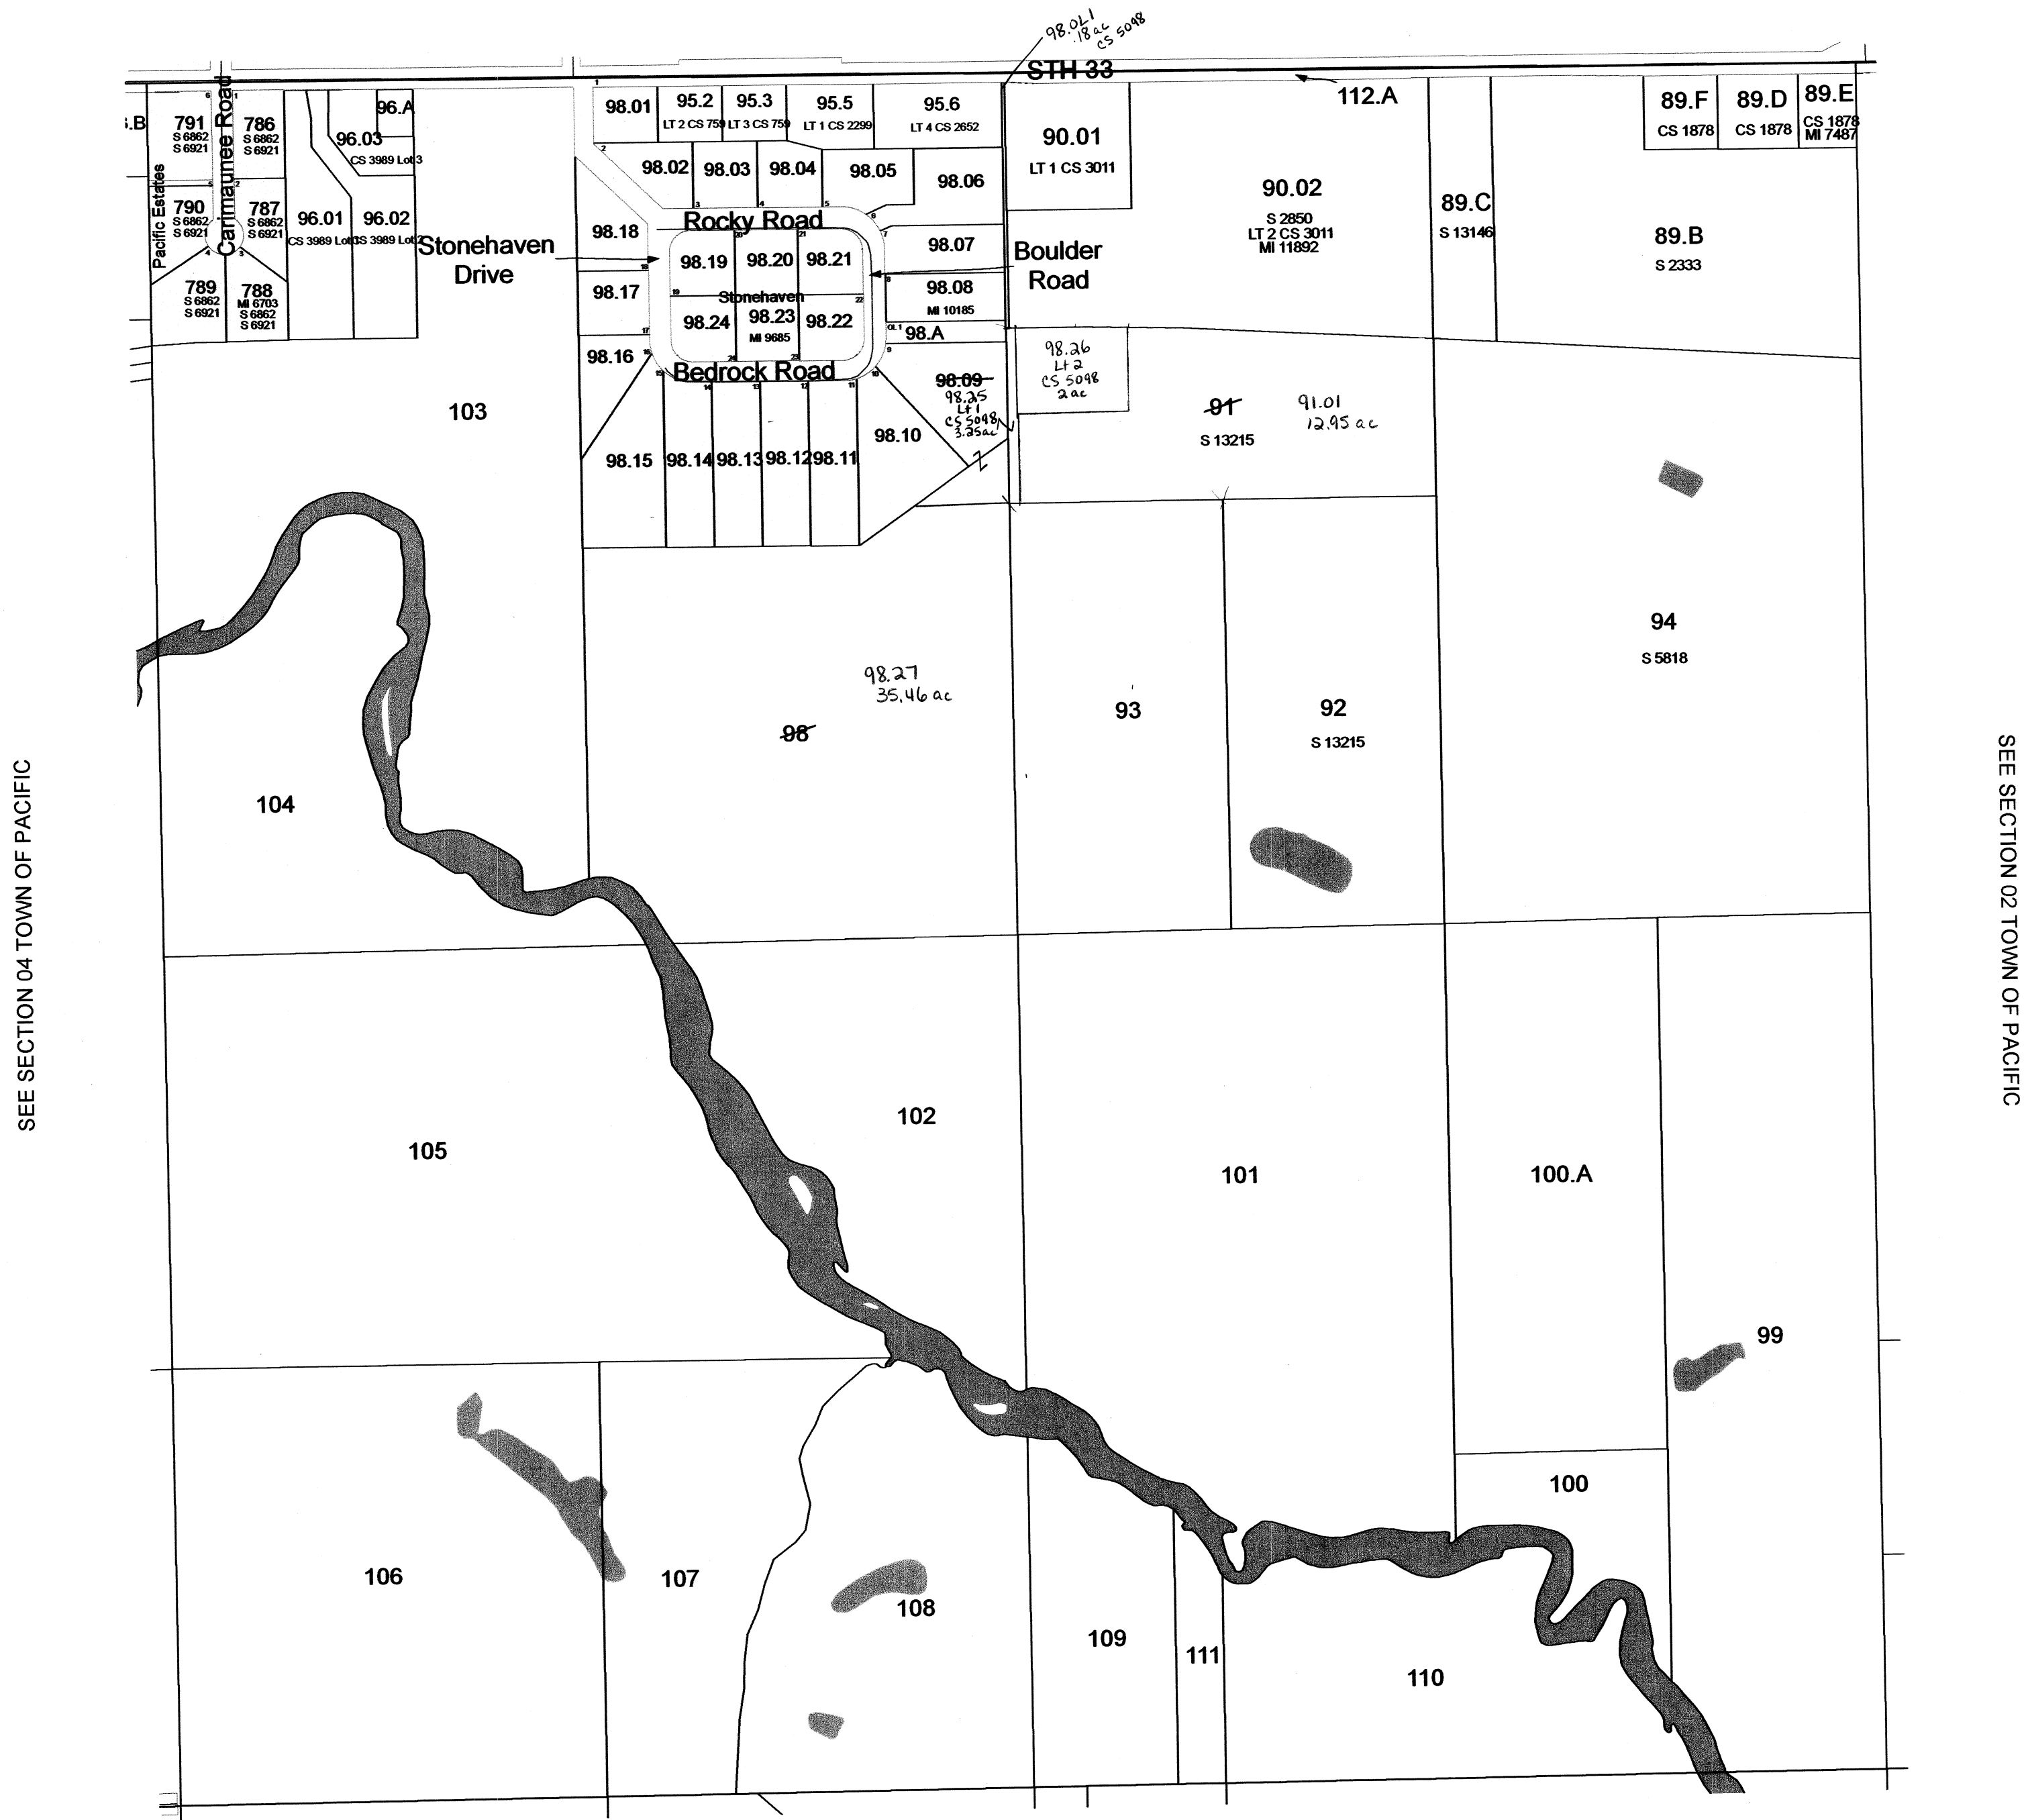


February 10, 2009
Columbia County Land Information

SEE SECTION 10 TOWN OF PACIFIC

Replaced
2010


SECTION 03
T12N R9E

TOWN OF PACIFIC

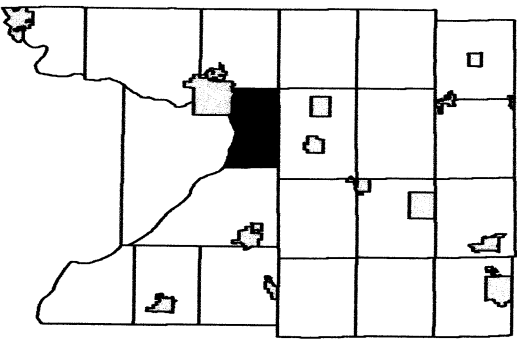

	3	2	1
9	10	11	12
16	15	14	13
	22	23	24
28	27	26	25
33	34	35	36

SEE TOWN OF FORT WINNEBAGO

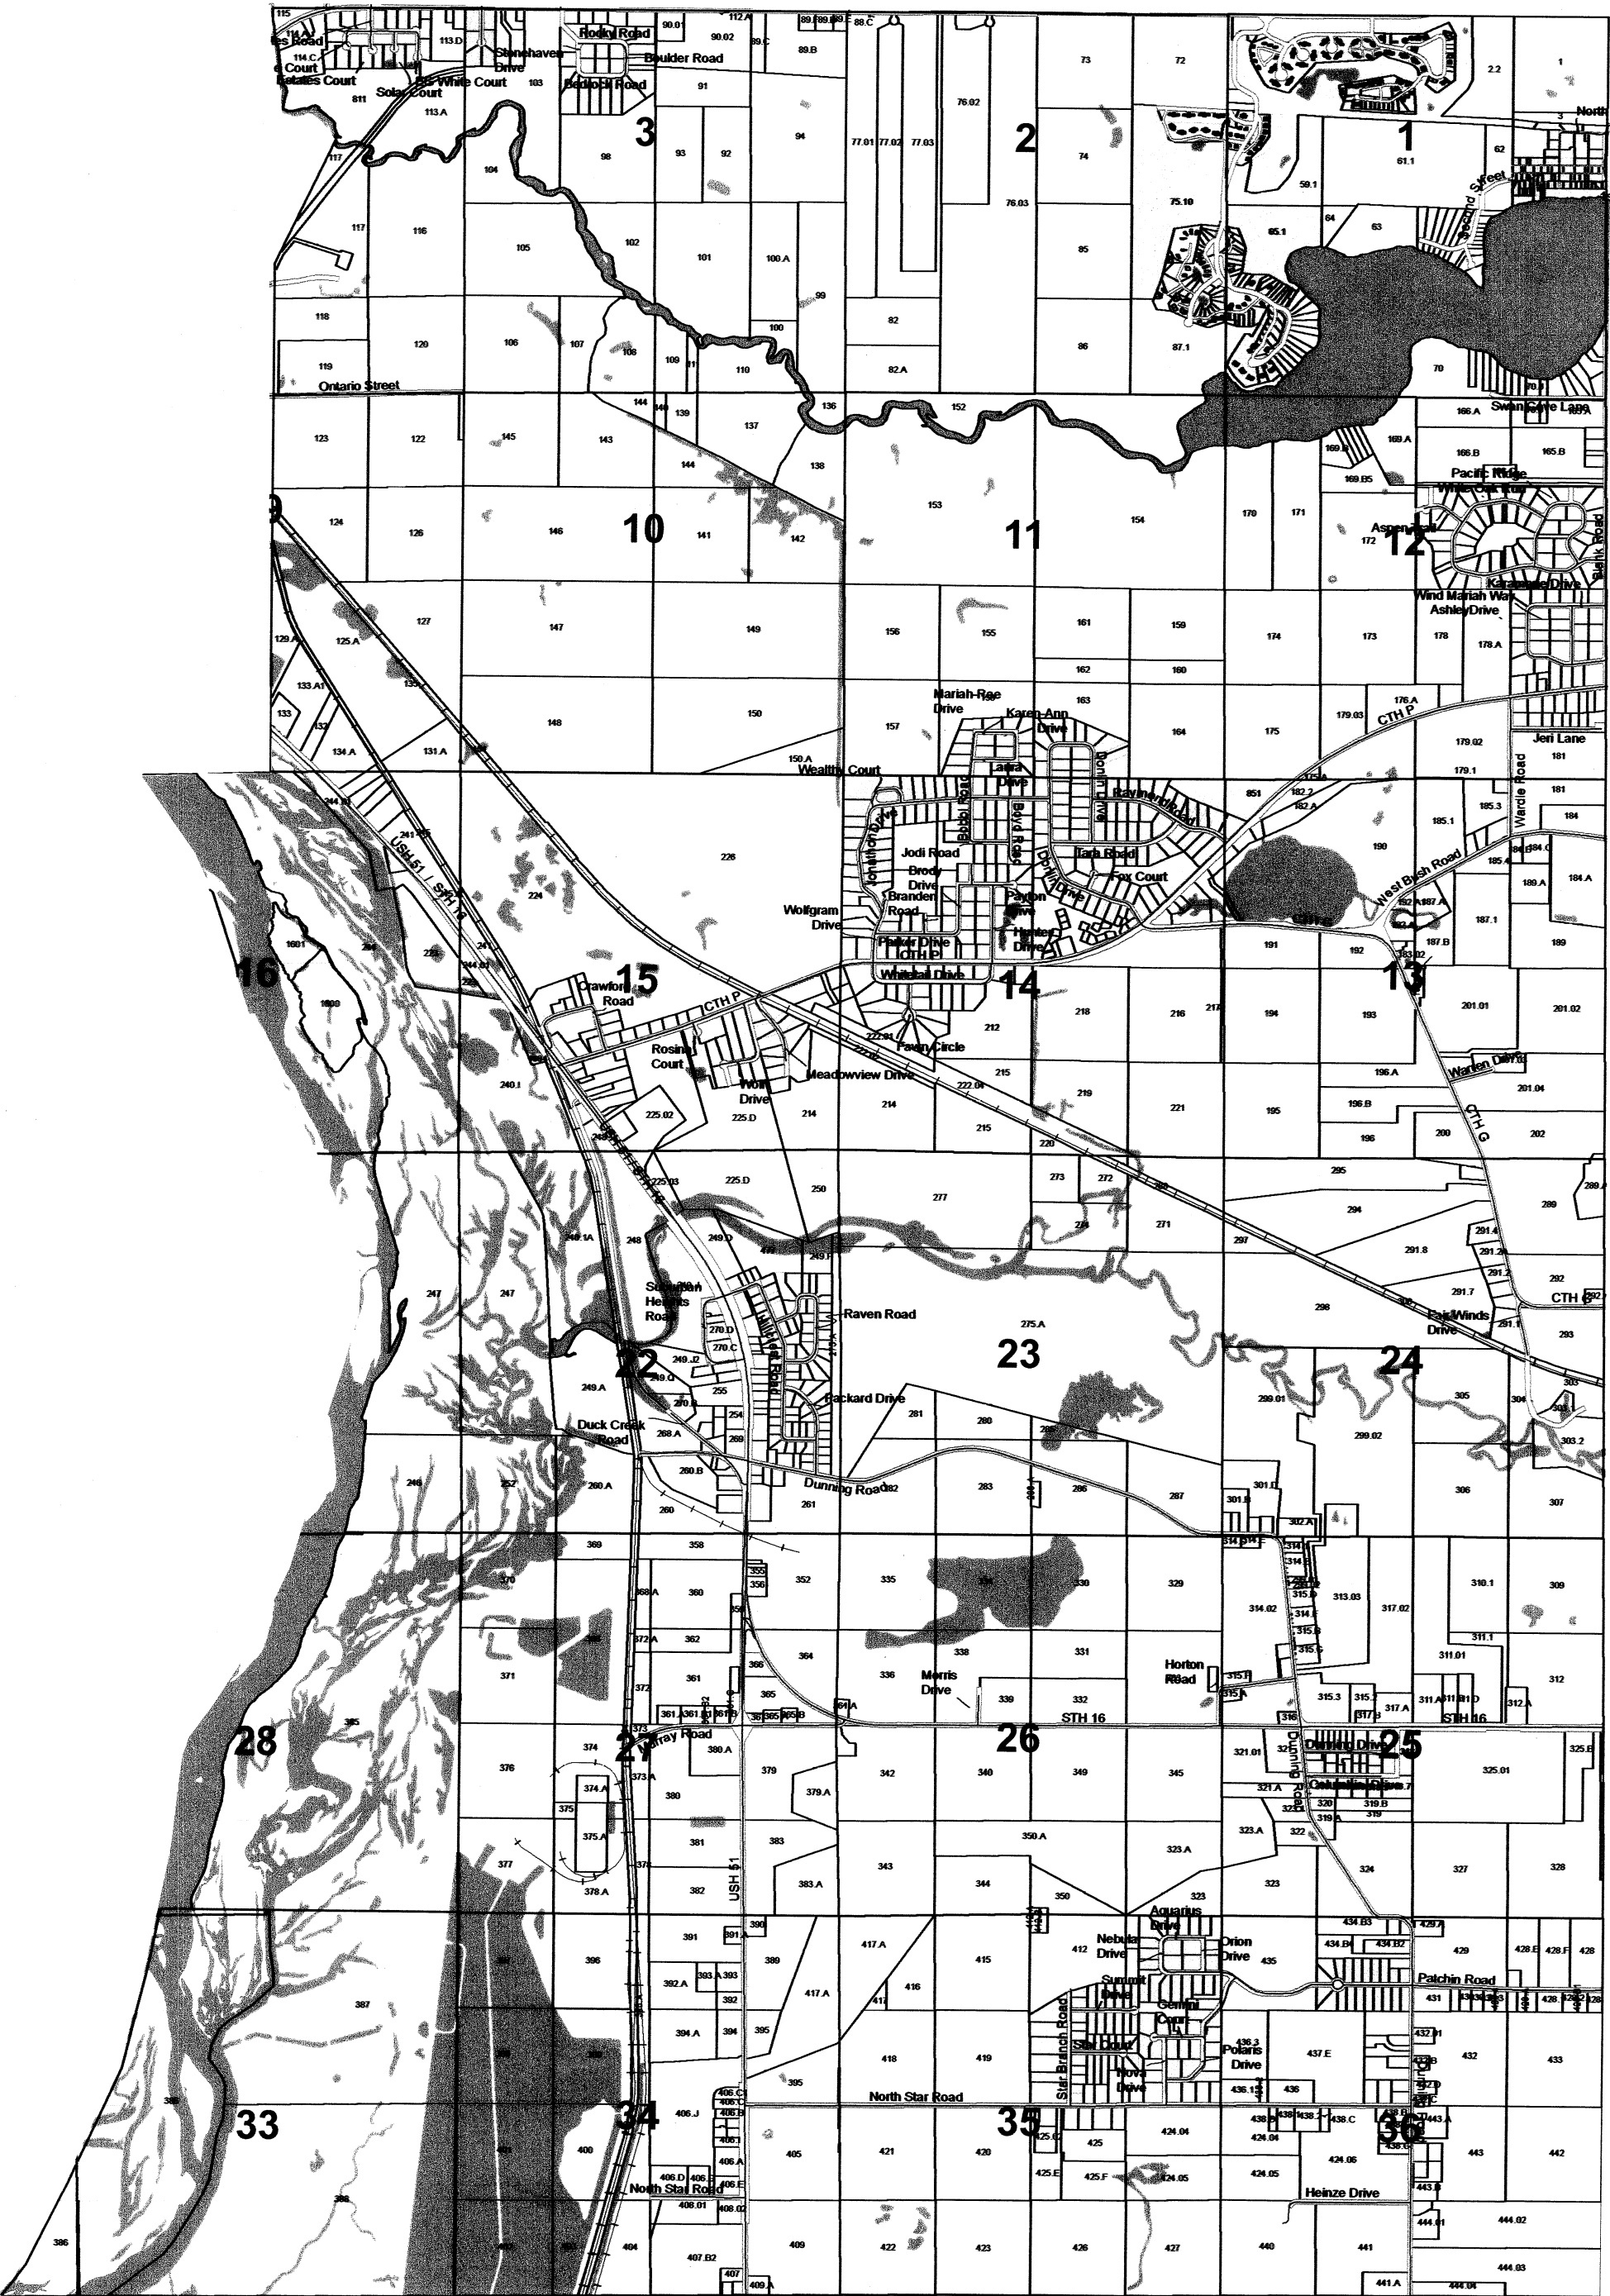

SEE TOWN OF CALEDONIA


SEE TOWN OF WYOCENA

SEE TOWN OF DEKORRA

TOWN OF PACIFIC

SECTION 25 T12N R9E

1 inch = 400 feet 1:4,800

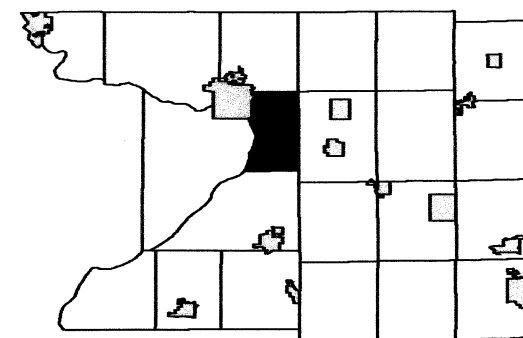


3	2	1
10	11	12
15	14	13
22	23	24
28	27	26
33	34	35

SEE SECTION 24 TOWN OF PACIFIC

SEE SECTION 26 TOWN OF PACIFIC


SEE SECTION 19 TOWN OF WYOCENA

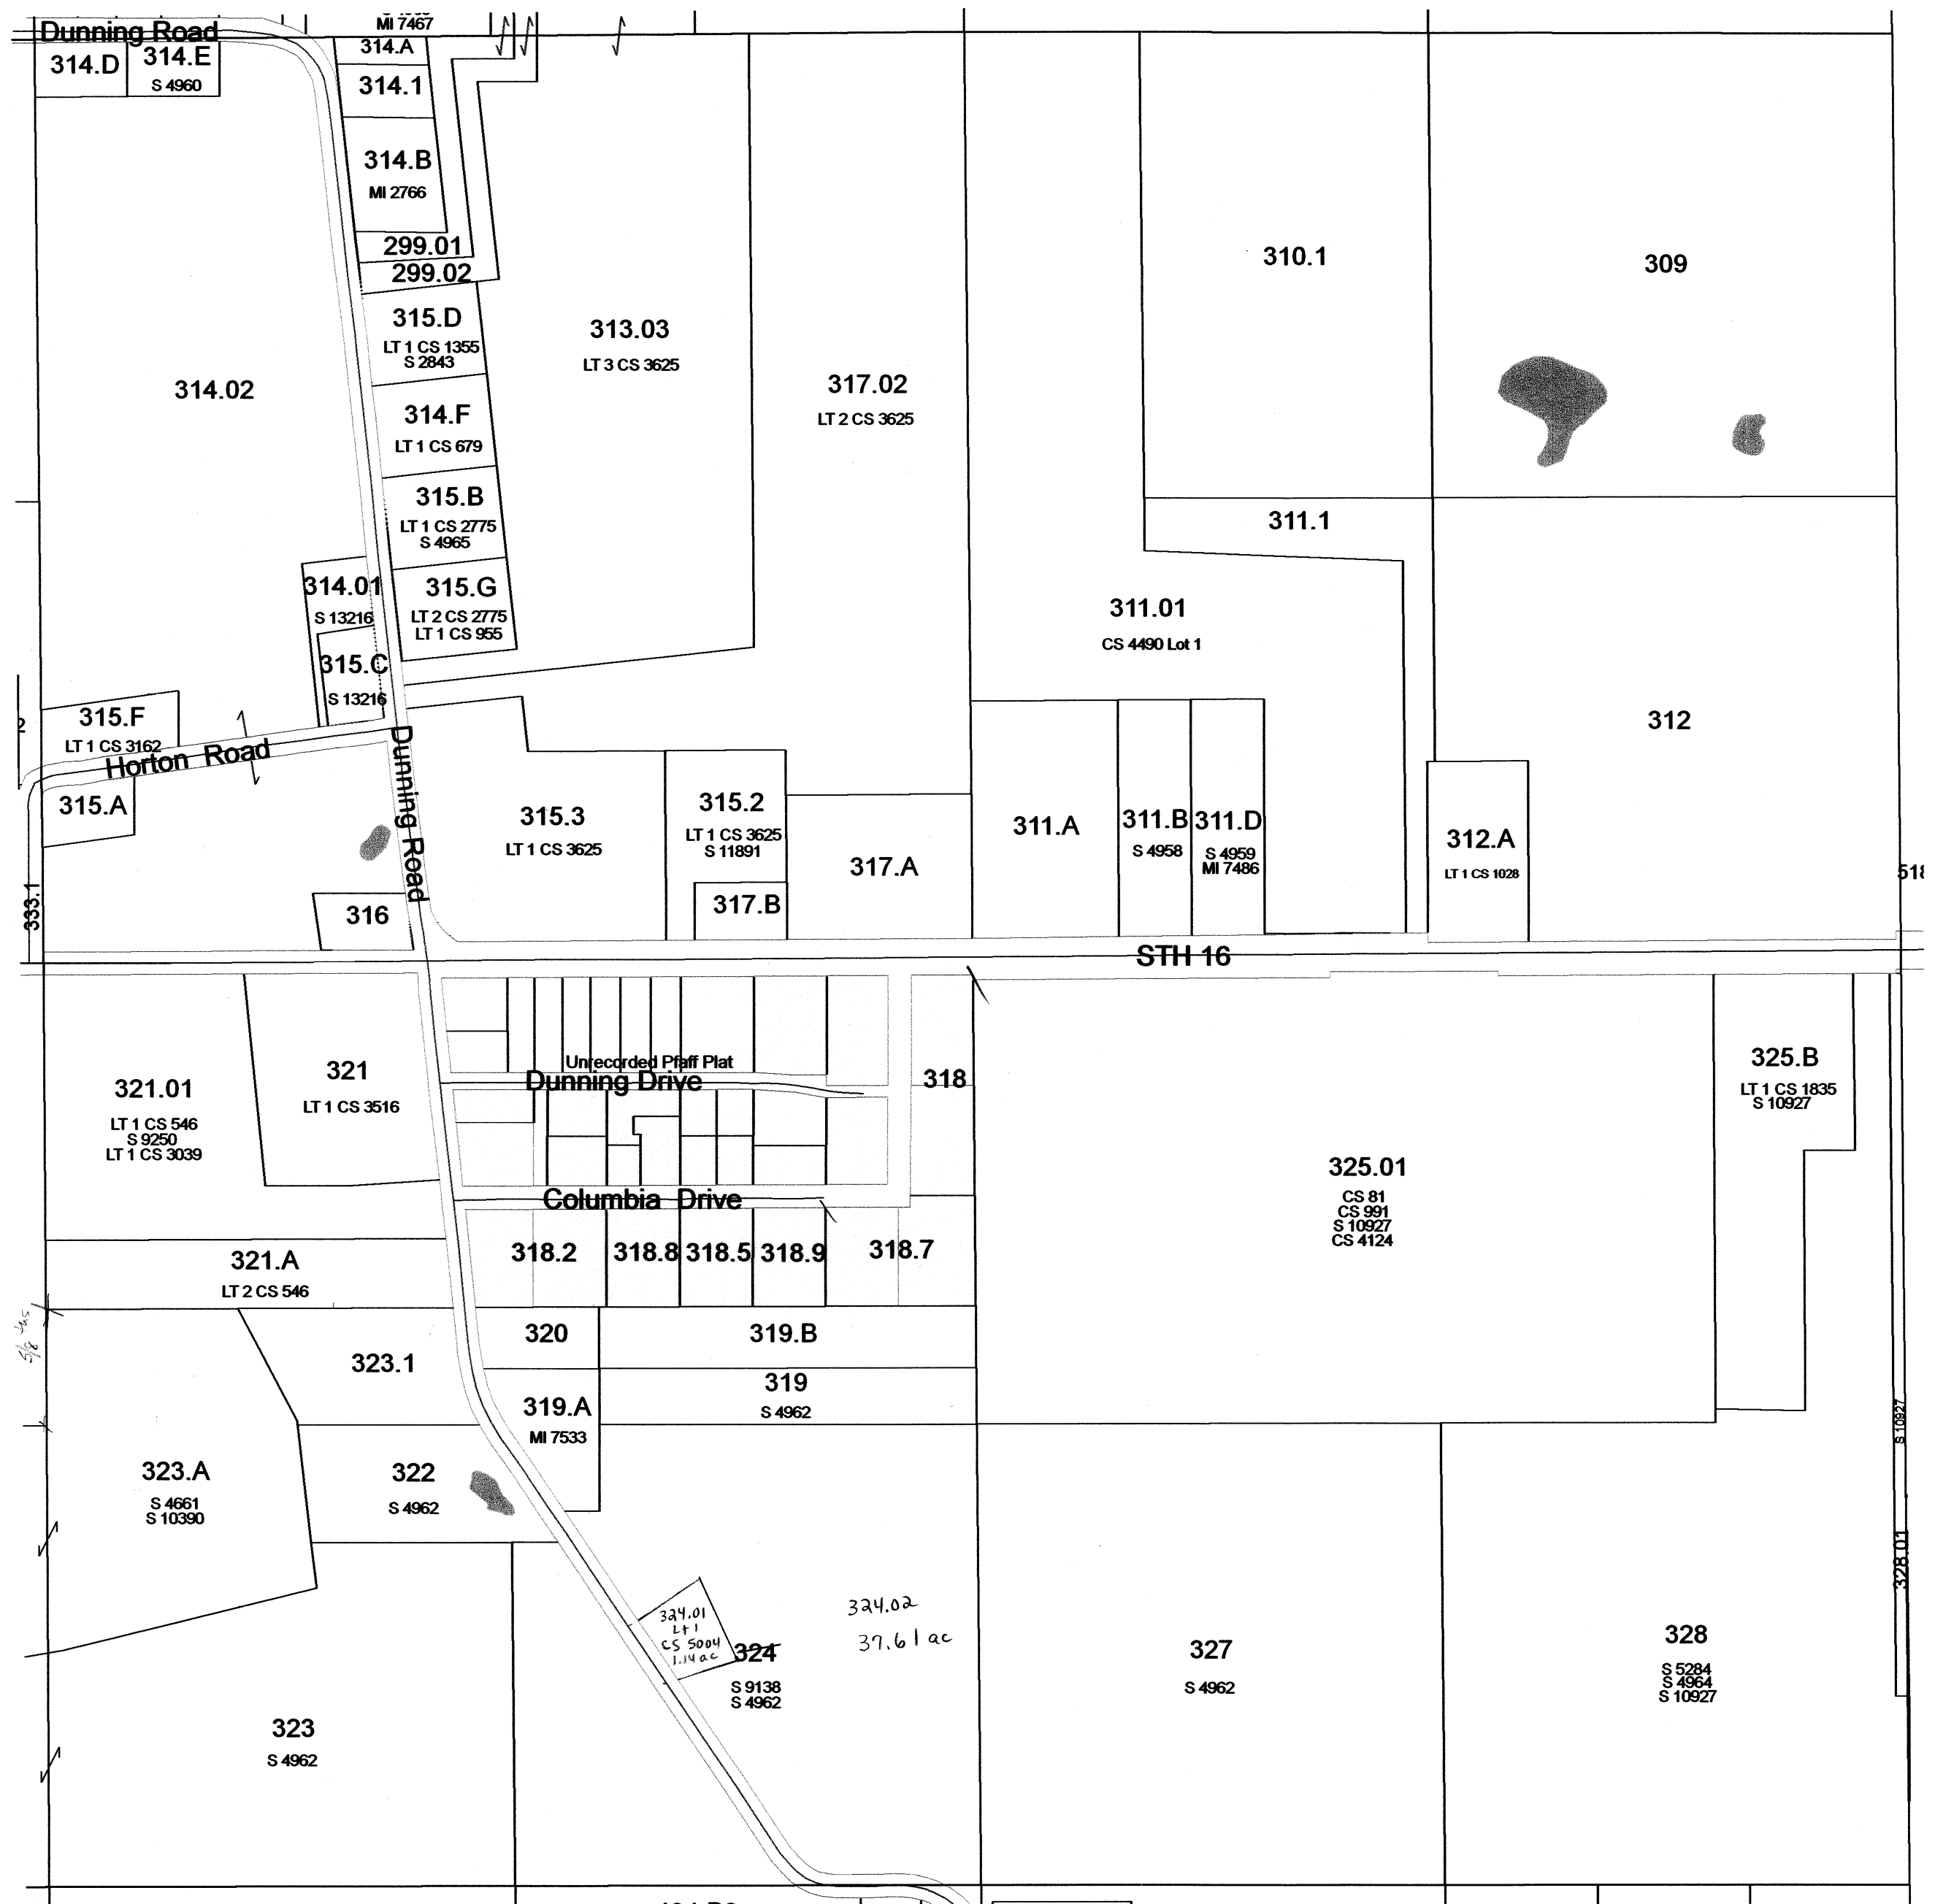

SEE SECTION 36 TOWN OF PACIFIC

1 inch = 400 feet 1:4,800

4	3	2	1
9	10		12
16	15	14	13
	22	23	24
28	27	26	25
33	34	35	36

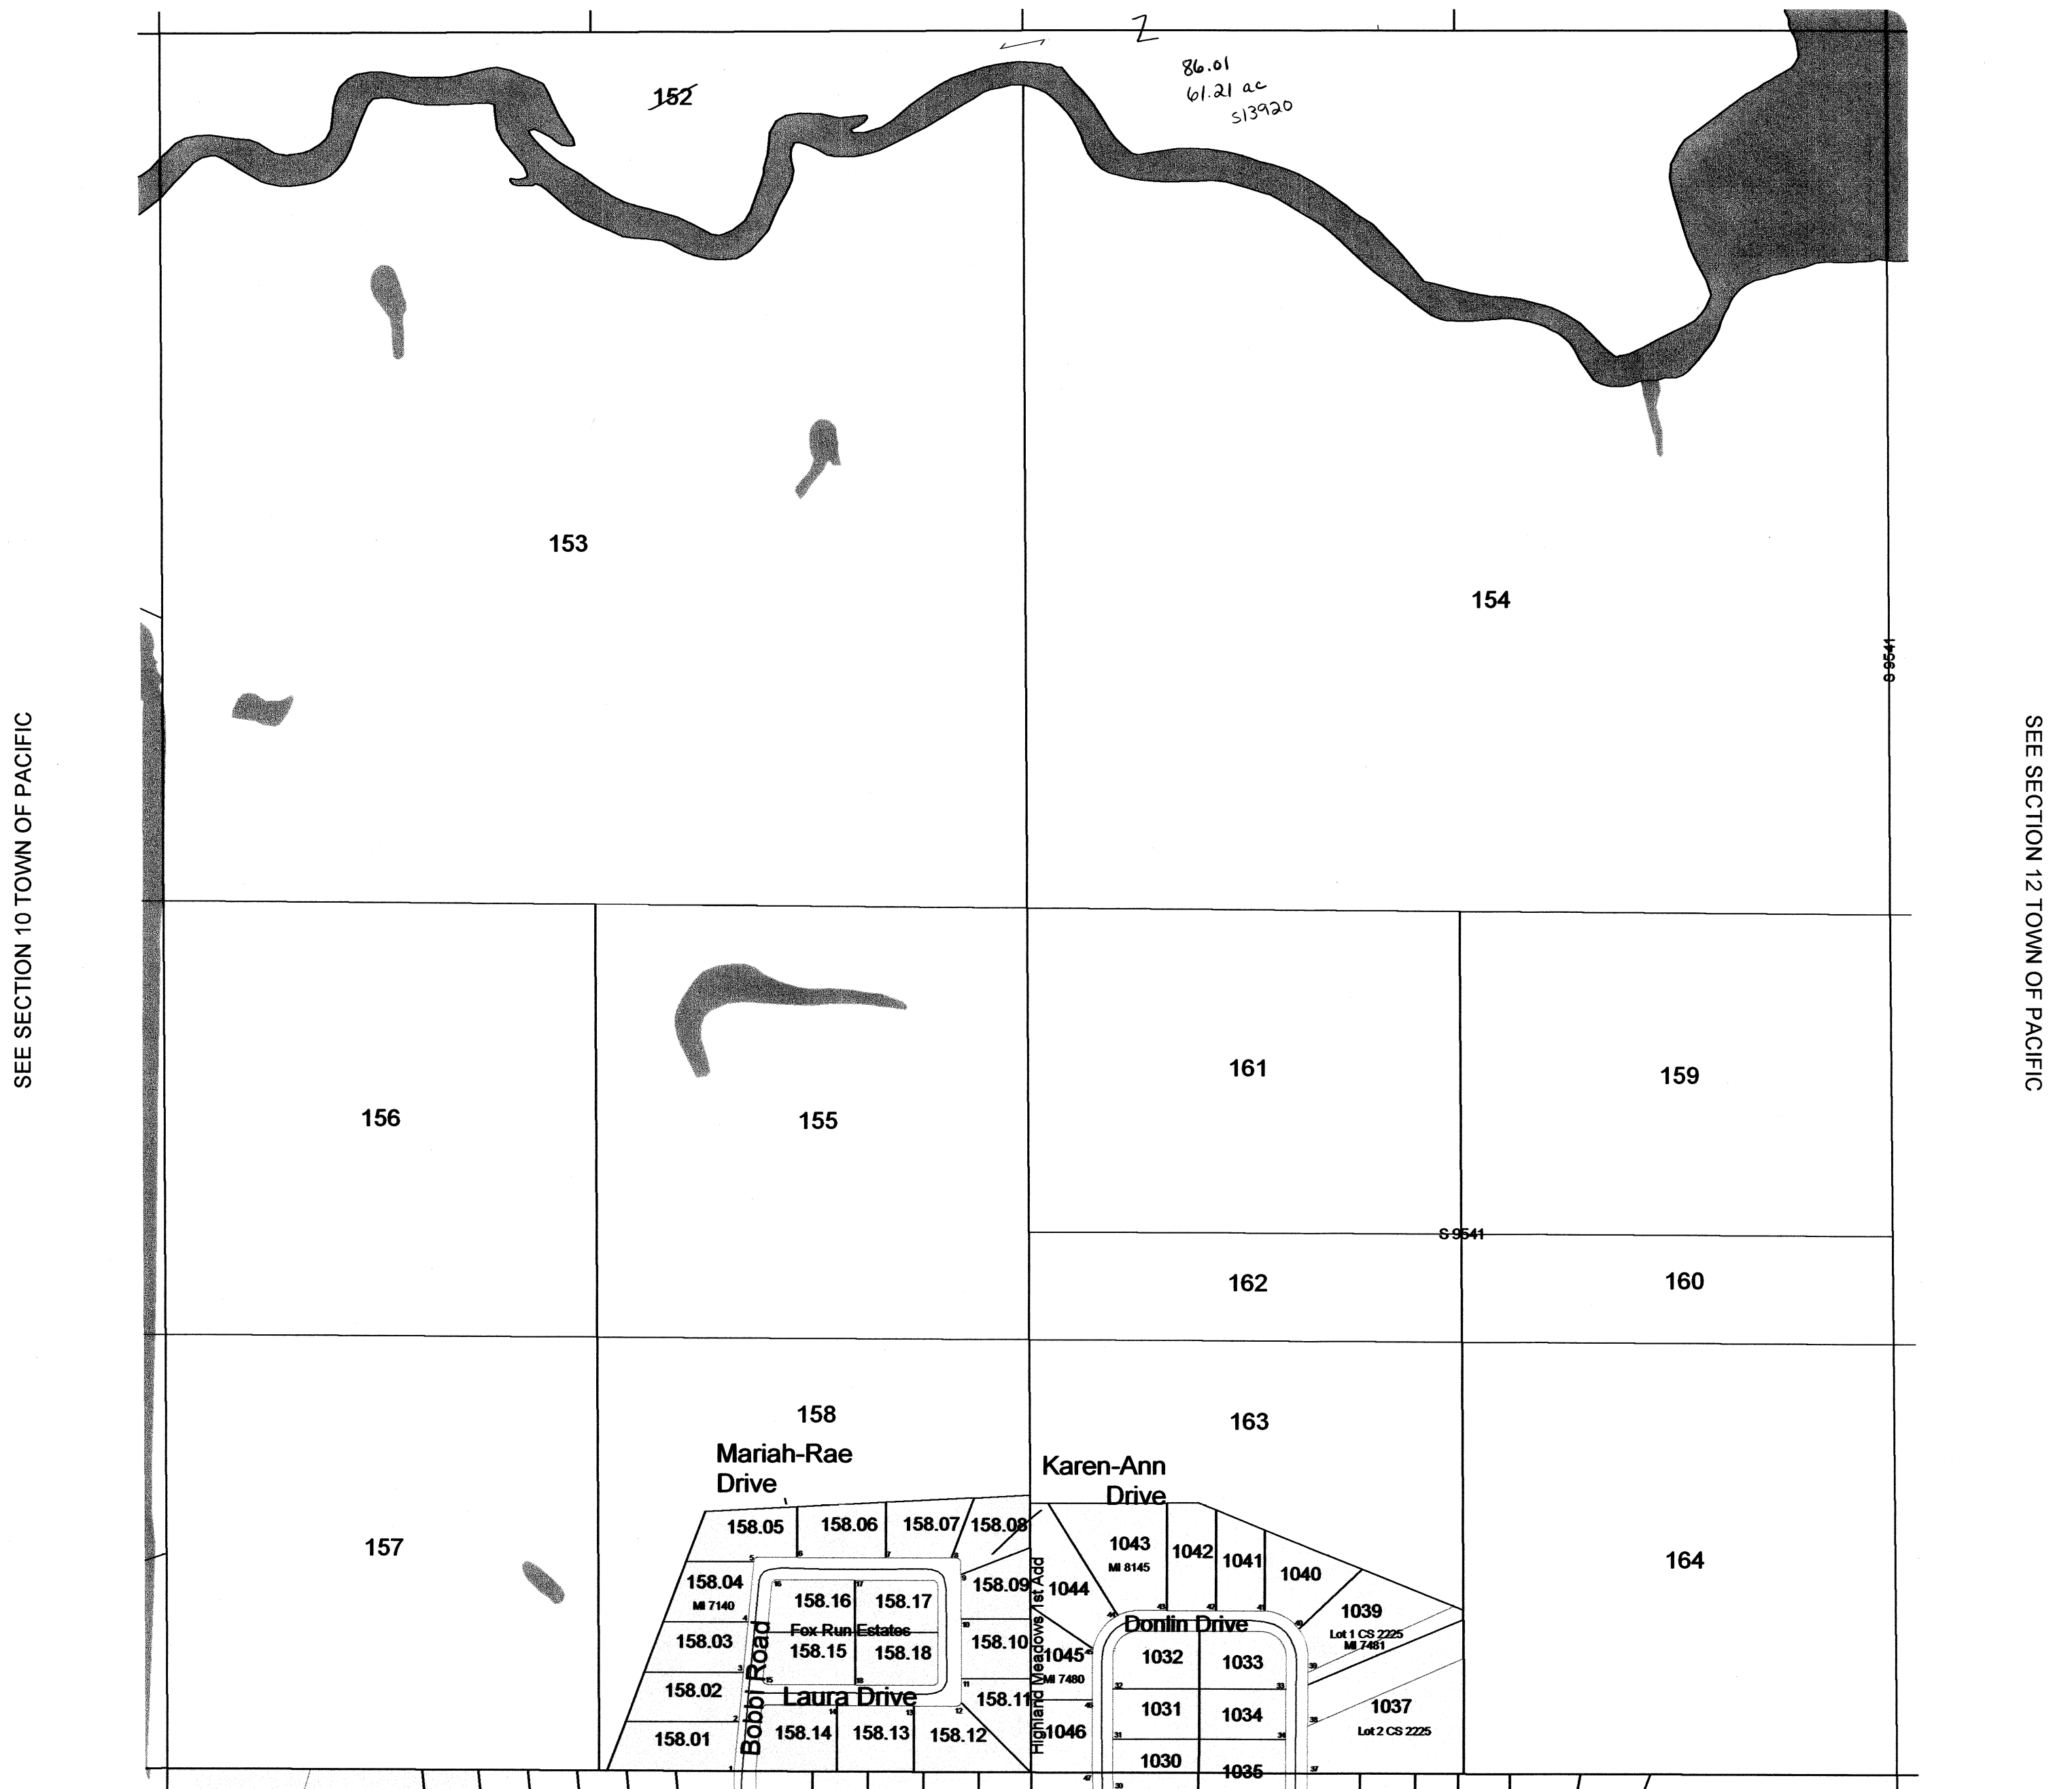

February 10, 2009
Columbia County Land Information


Replaced
2011

SECTION 11
T12N R9E

TOWN OF PACIFIC

SECTION 9 T12N R9E

1 inch = 400 feet 1:4,800

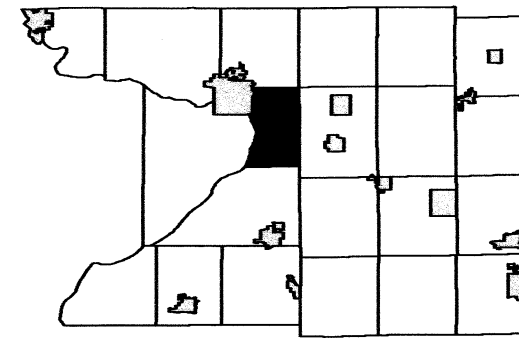


	3	2	1
10	11	12	
16	15	14	13
	22	23	24
28	27	26	25
33	34	35	36

SEE SECTION 04 TOWN OF PACIFIC

SEE CITY OF PORTAGE

SEE SECTION 10 TOWN OF PACIFIC

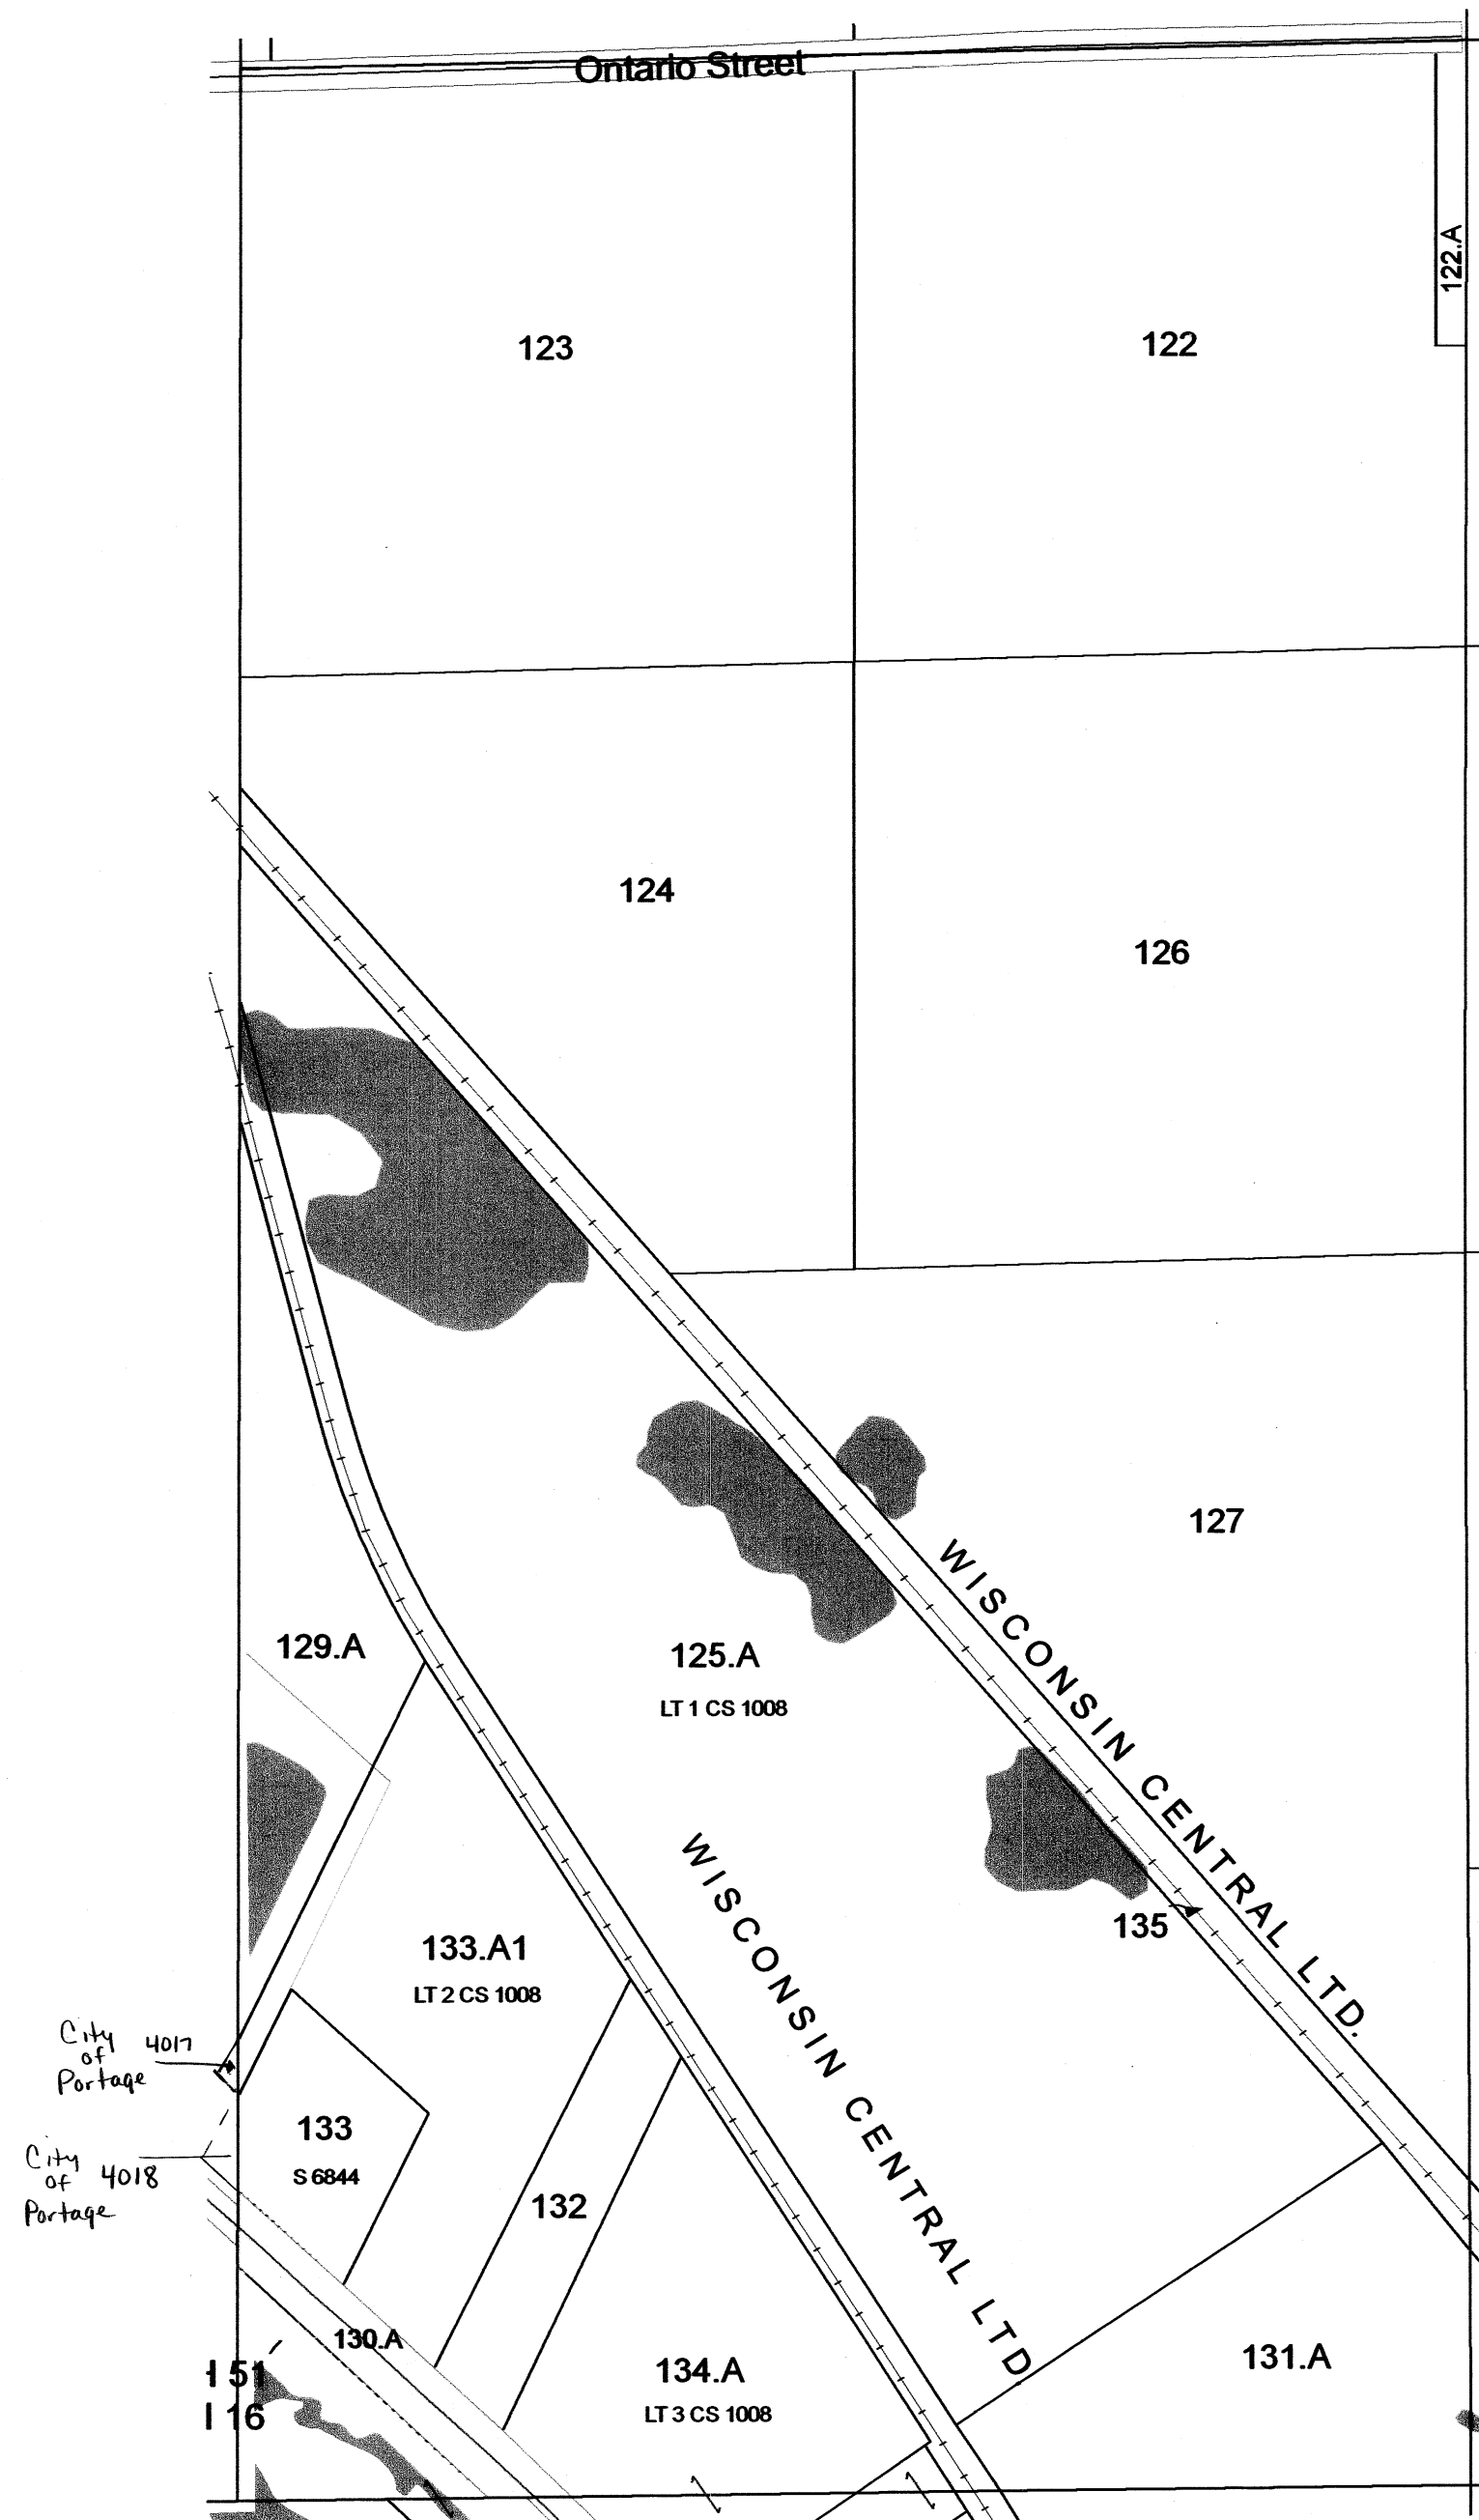


SEE SECTION 16 TOWN OF PACIFIC

1 inch = 400 feet 1:4,800

4	3		1
9	10	11	12
16	15	14	13
	22	23	24
28	27	26	25
33	34	35	36




TOWN OF PACIFIC

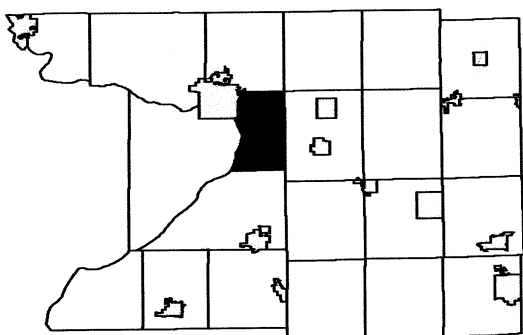

	3	2	1
9	10	11	12
16	15	14	13
	22	23	24
28	27	26	25
33	34	35	36

SEE TOWN OF FORT WINNEBAGO

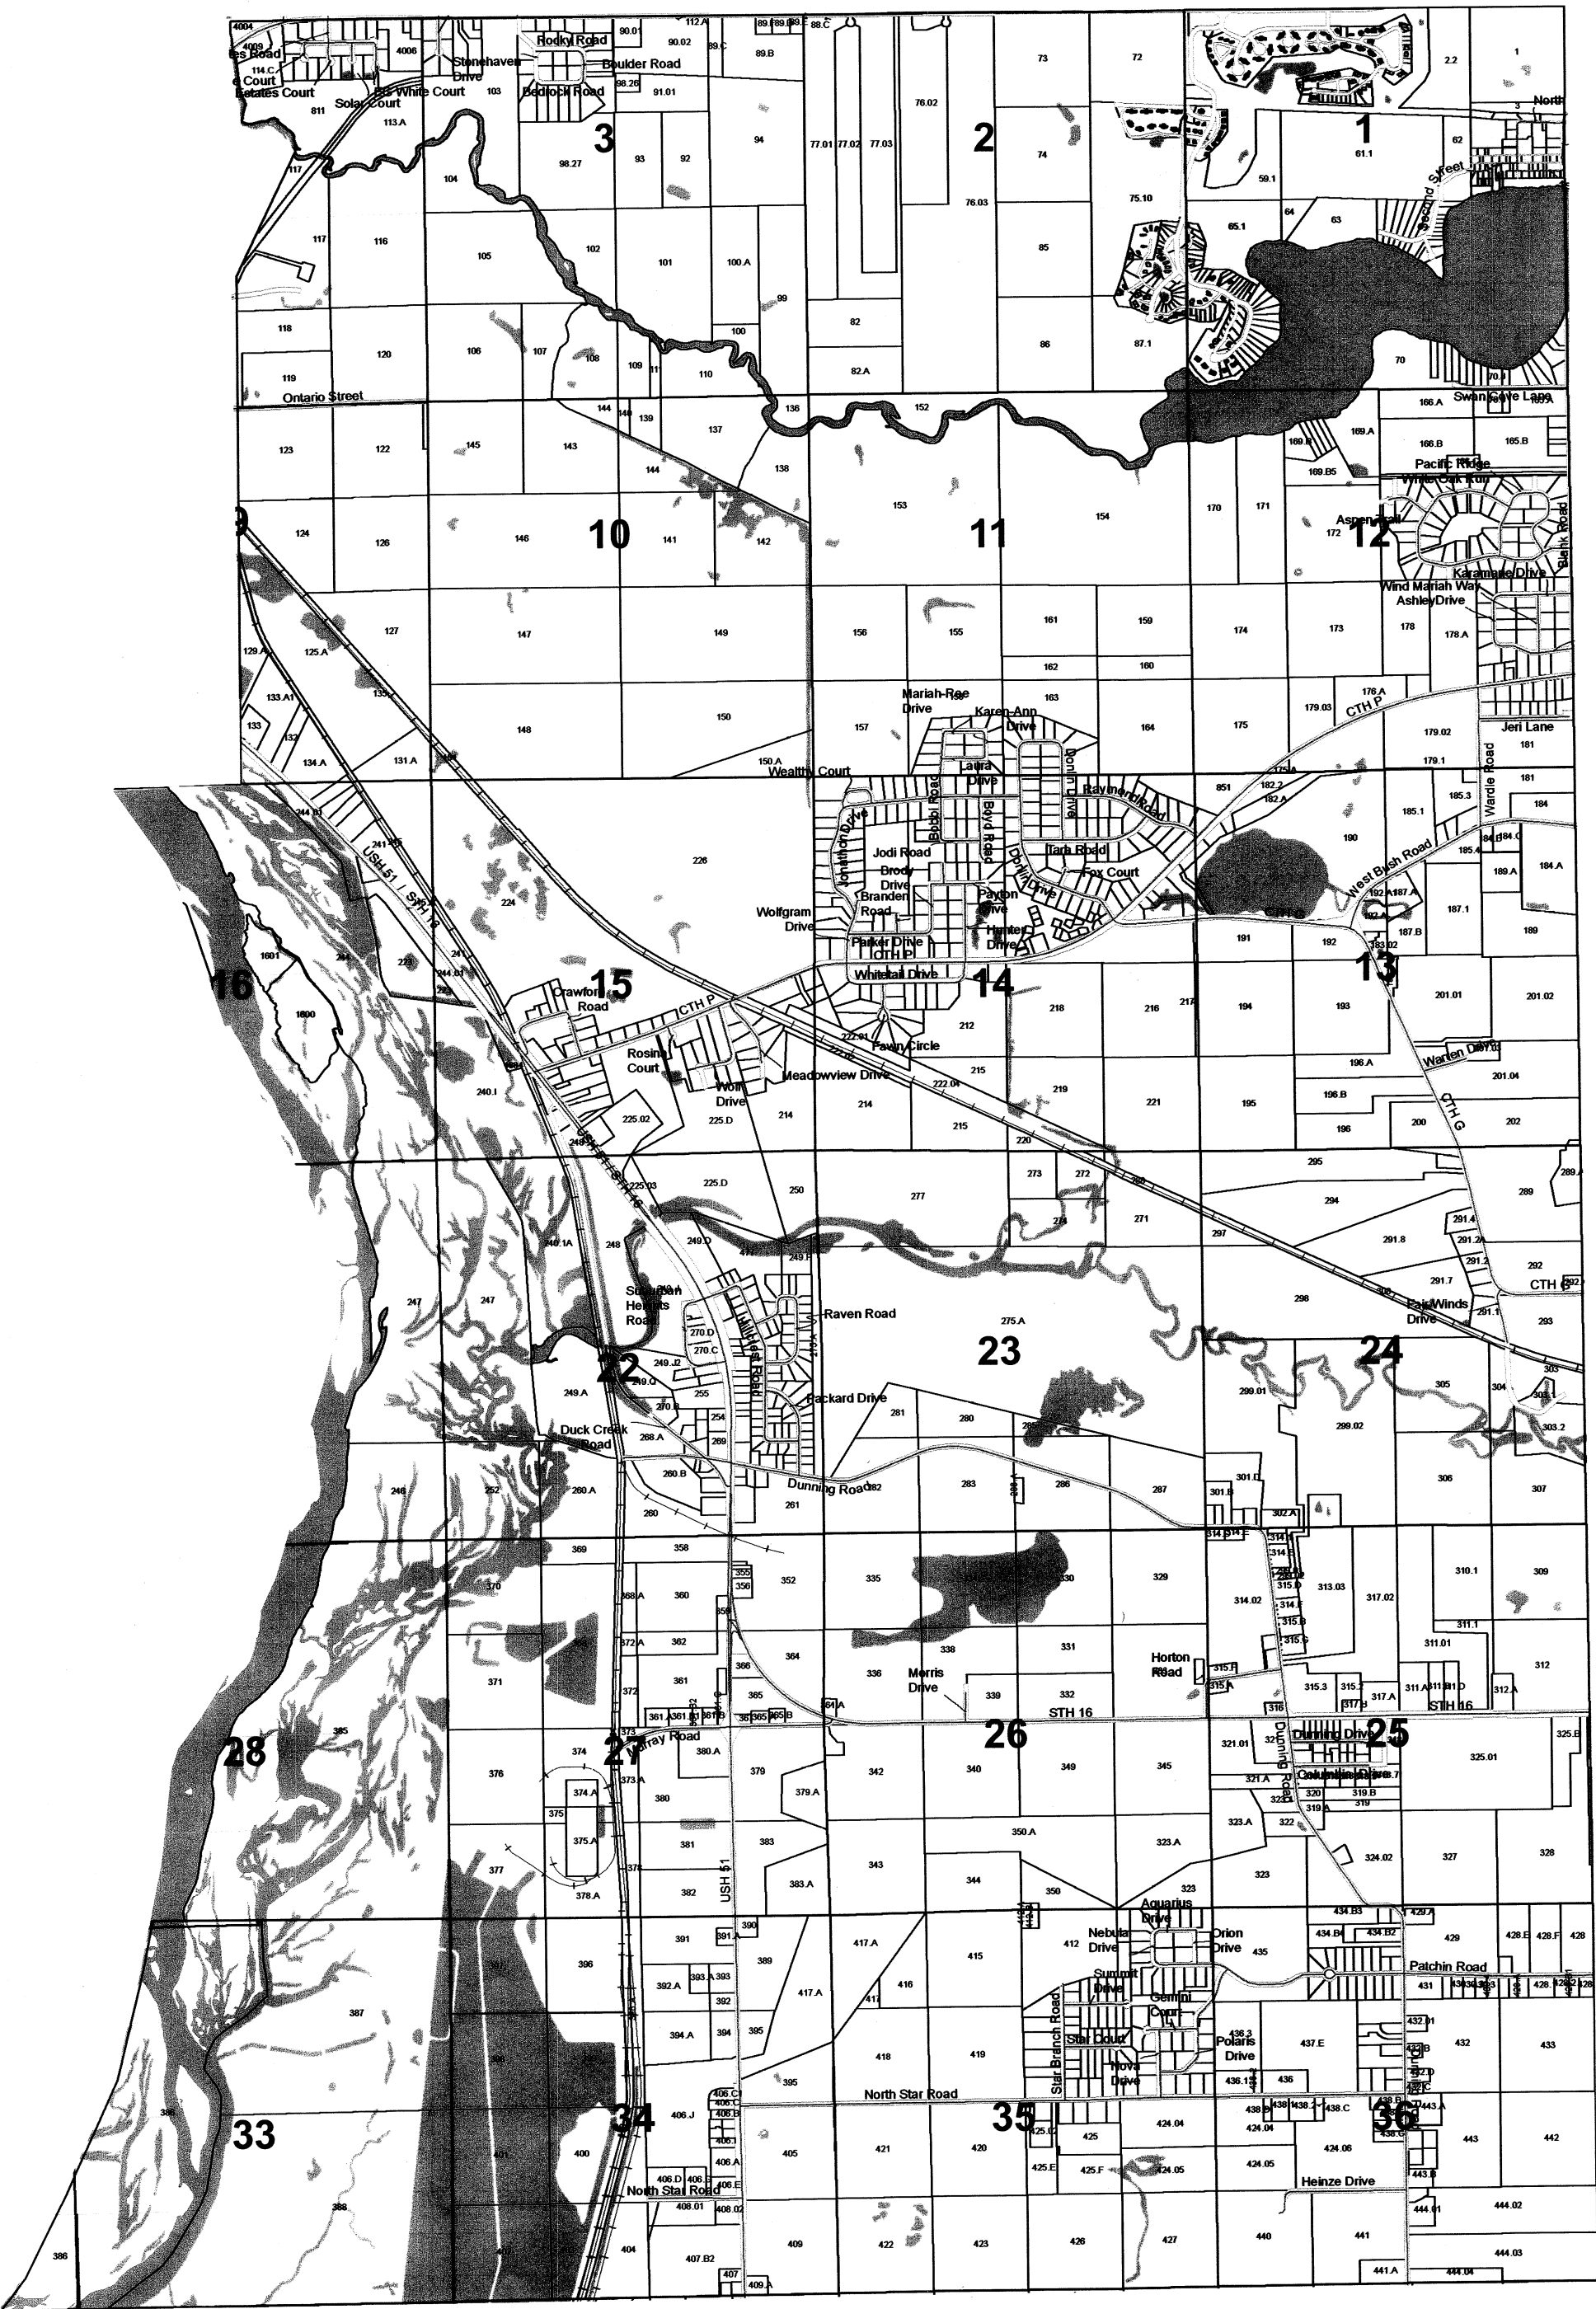

SEE TOWN OF CALEDONIA


SEE TOWN OF WYOCENA

SEE TOWN OF DEKORRA

TOWN OF PACIFIC

SECTION 1 T12N R9E


1 inch = 200 feet 1:2,400

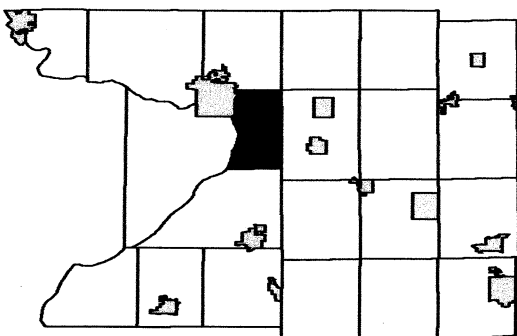

	3	2	
9	10	11	12
16	15	14	13
	22	23	24
28	27	26	25
33	34	35	36

SEE SECTION 01 TOWN OF PACIFIC

SEE SECTION 01 TOWN OF PACIFIC

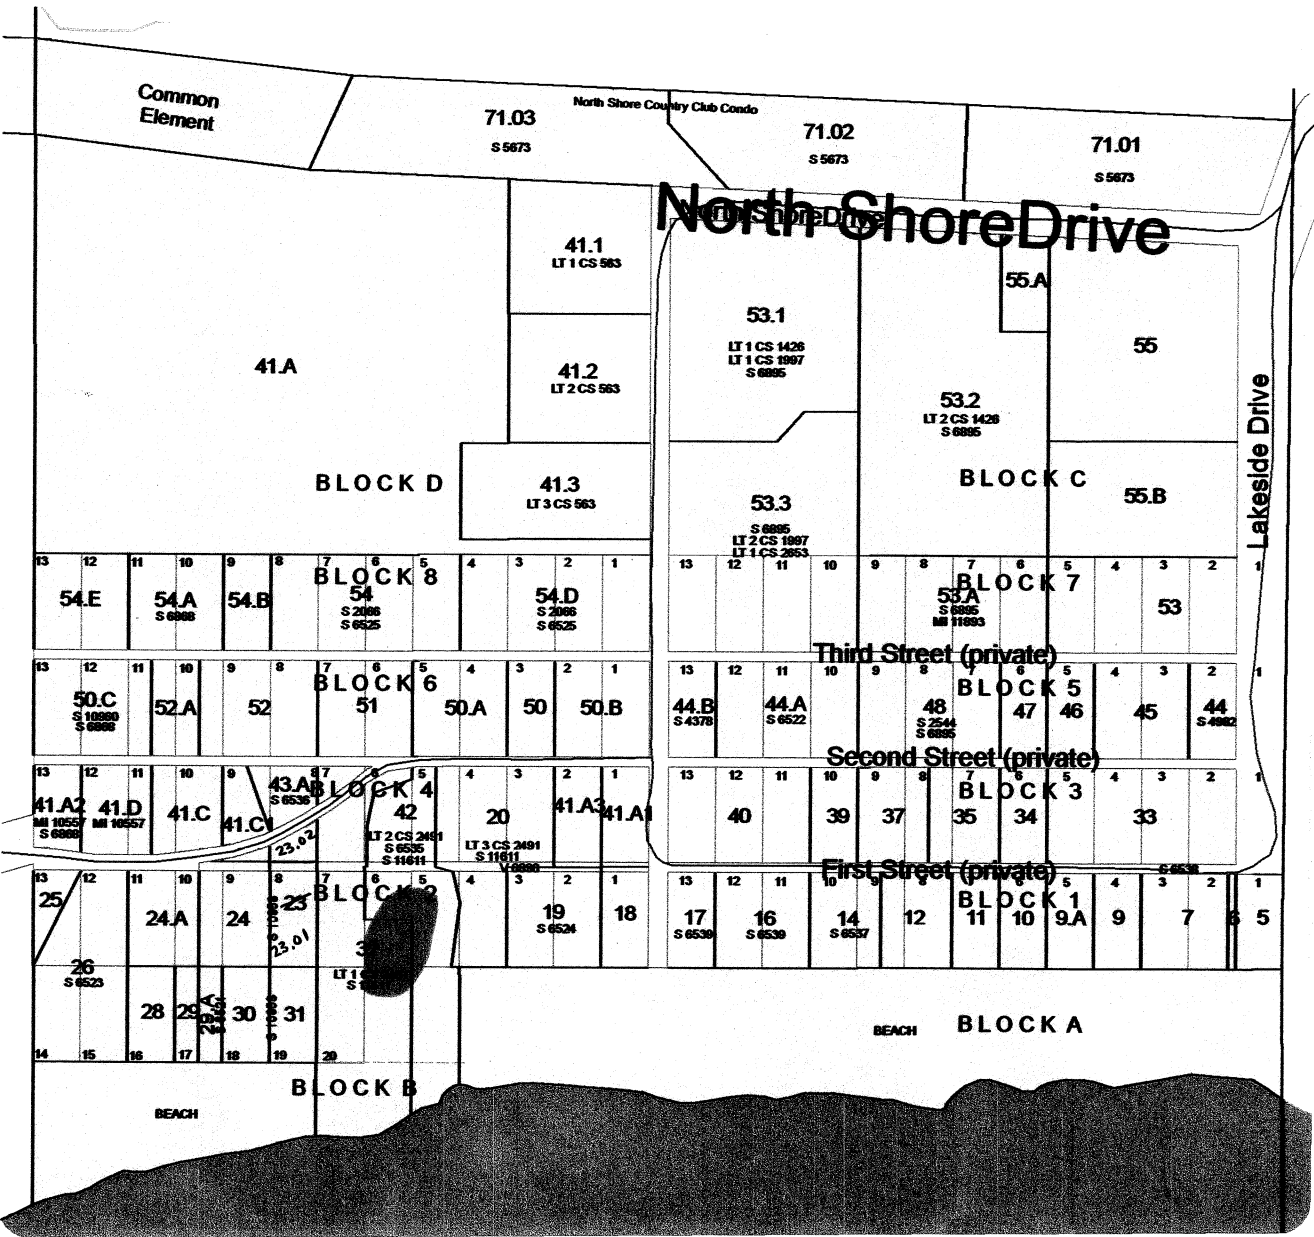

SEE SECTION 01 TOWN OF PACIFIC


SEE SECTION 01 TOWN OF PACIFIC

Replaced
2011

TOWN OF PACIFIC

SECTION 15 T12N R9E

1 inch = 400 feet 1:4,800

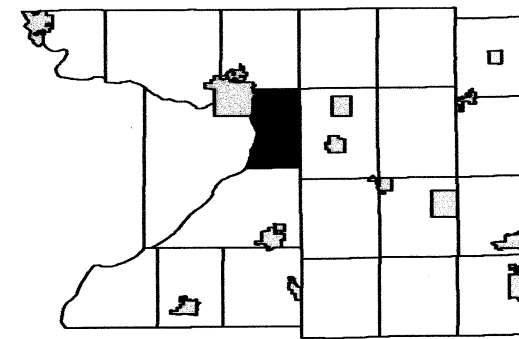


	3	2	1
9	10	11	12
6		14	13
	22	23	24
28	27	26	25
33	34	35	36

SEE SECTION 10 TOWN OF PACIFIC

SEE SECTION 16 TOWN OF PACIFIC

SEE SECTION 14 TOWN OF PACIFIC

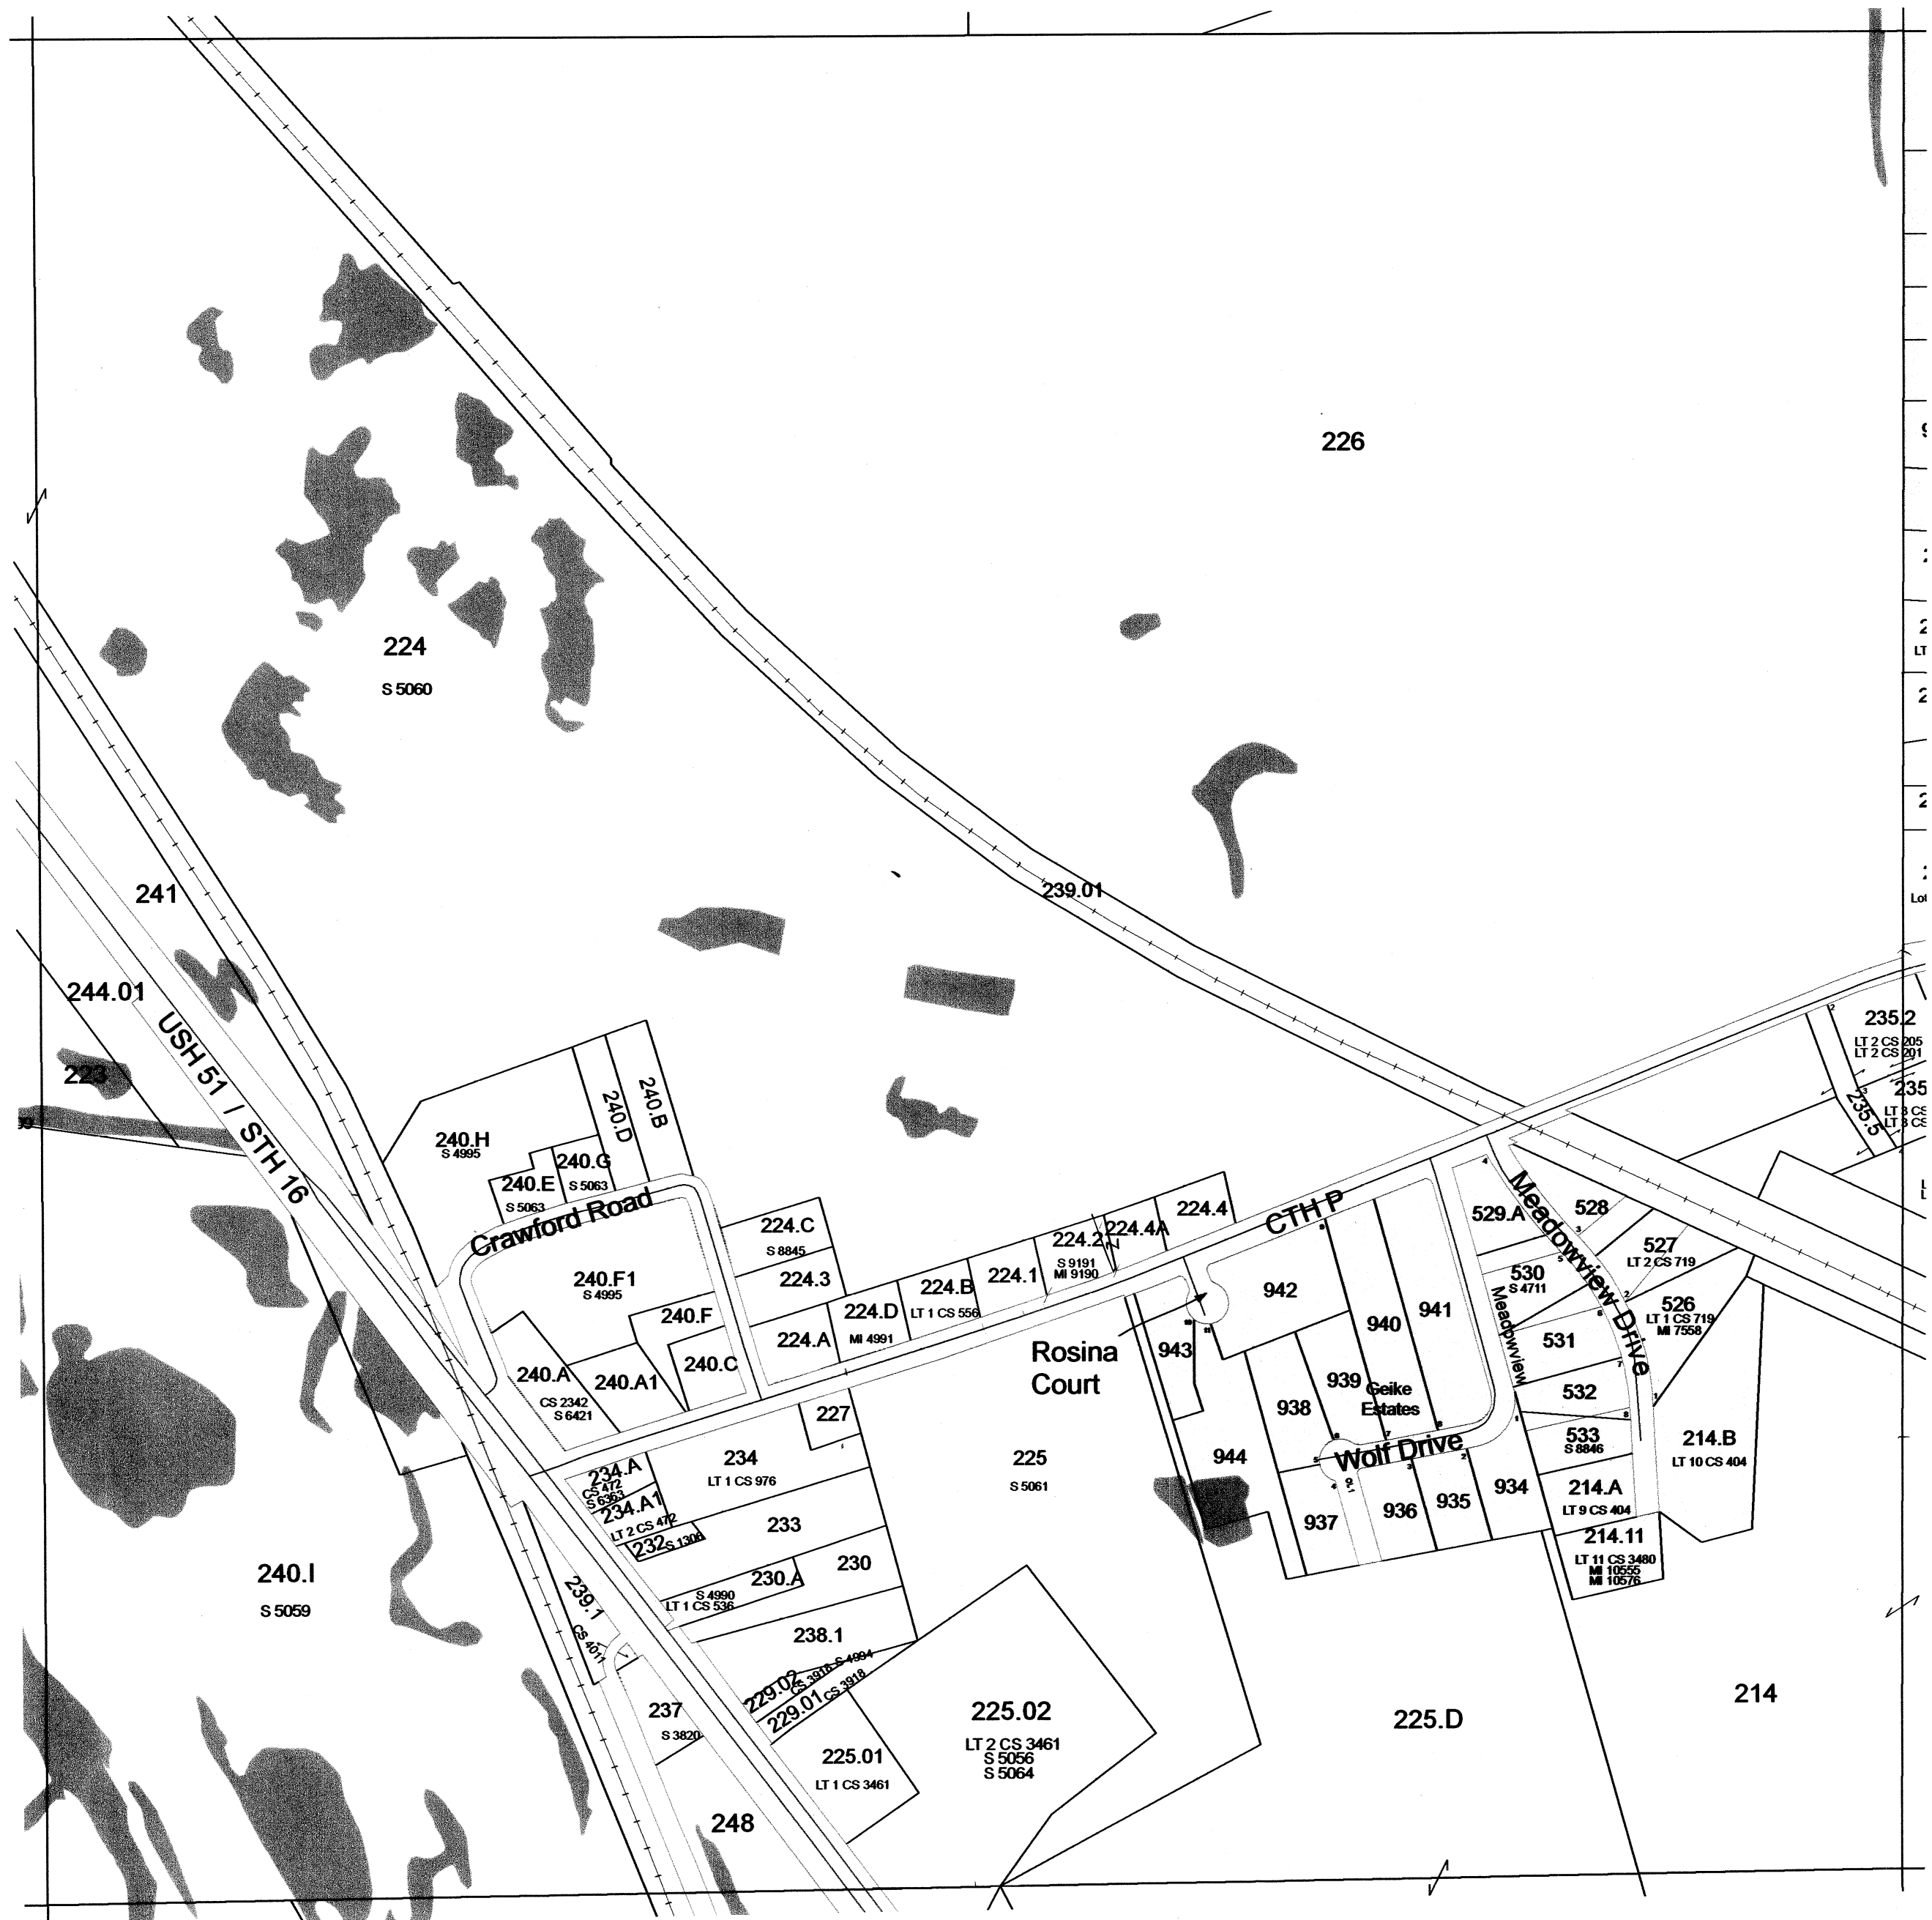


SEE SECTION 22 TOWN OF PACIFIC

Scanned
2012

TOWN OF PACIFIC


SECTION 2 T12N R9E

1 inch = 400 feet 1:4,800

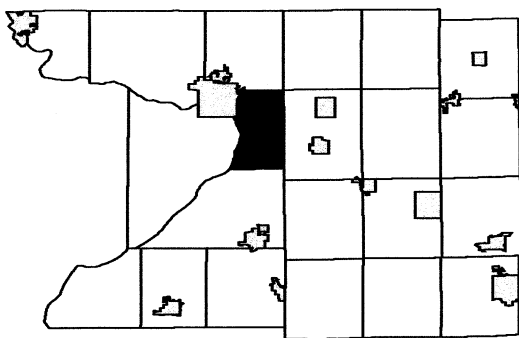

	3		1
9	10	11	12
6	15	14	13
	22	23	24
28	27	26	25
33	34	35	36

SEE SECTION 35 TOWN OF FORT WINNEBAGO

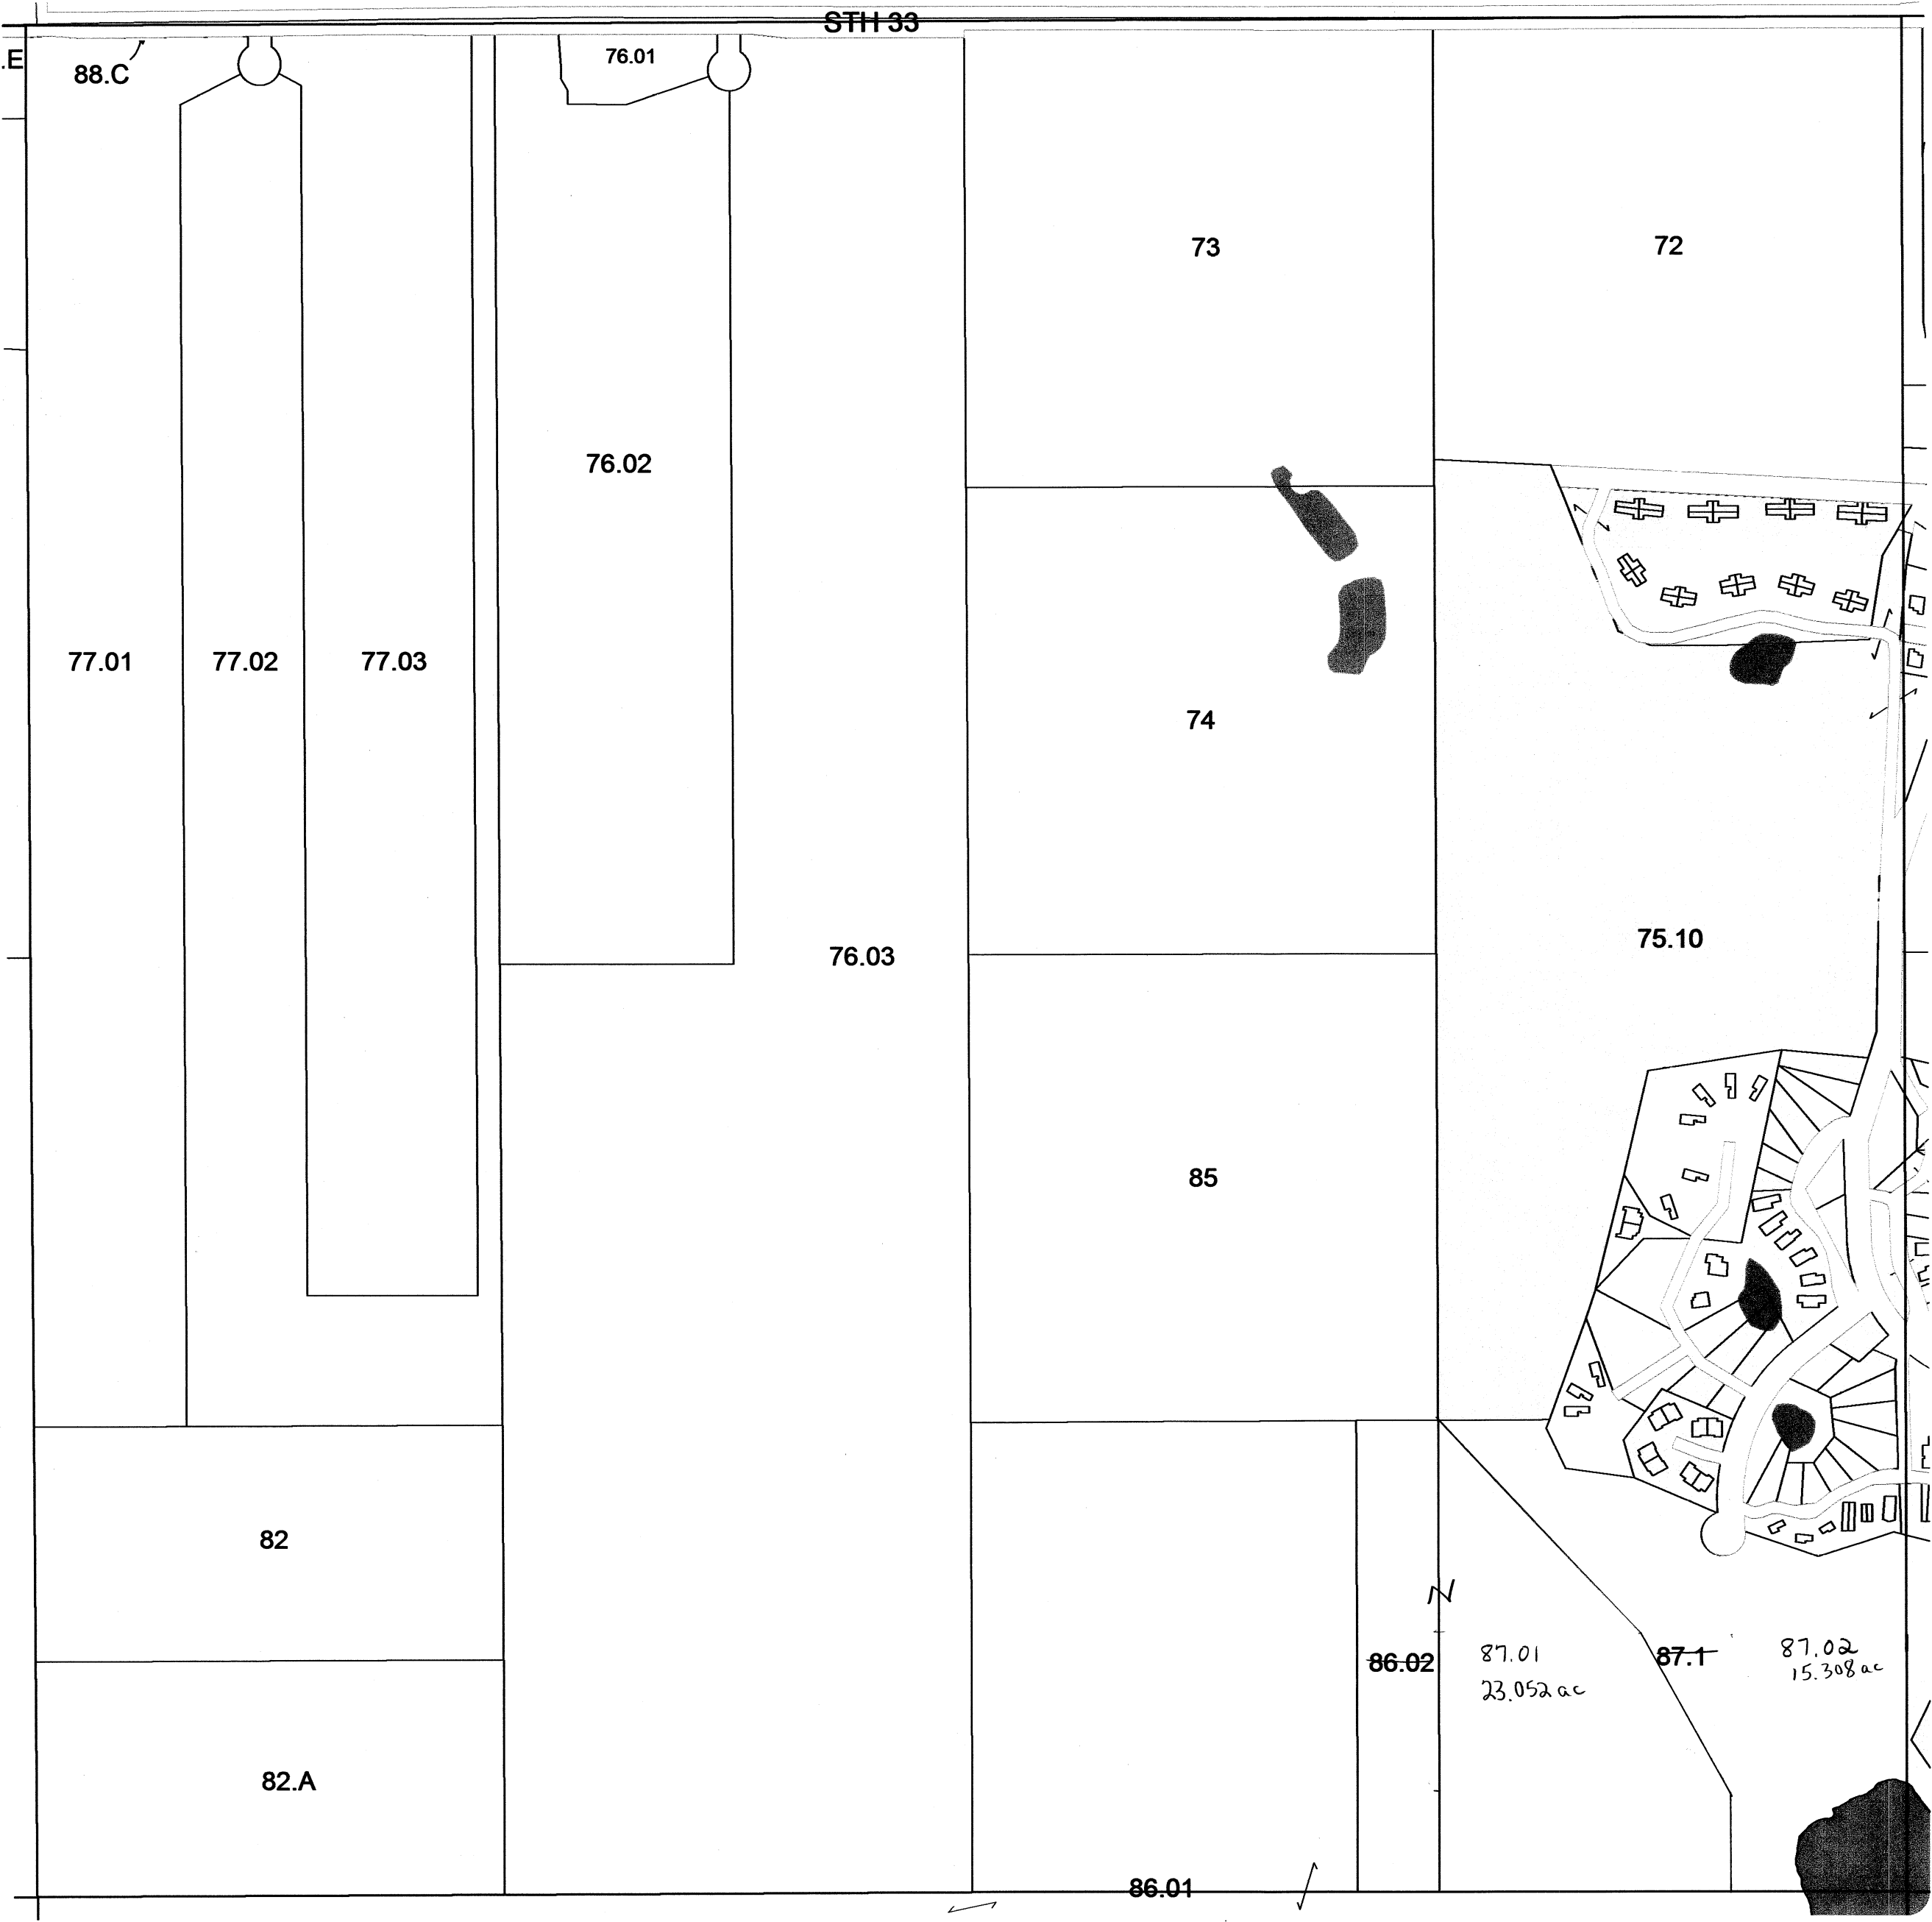

SEE SECTION 03 TOWN OF PACIFIC

SEE SECTION 01 TOWN OF PACIFIC


SEE SECTION 11 TOWN OF PACIFIC

TOWN OF PACIFIC

SECTION 1 T12N R9E

1 inch = 400 feet 1:4,800


SEE SECTION 36 TOWN OF FORT WINNEBAGO

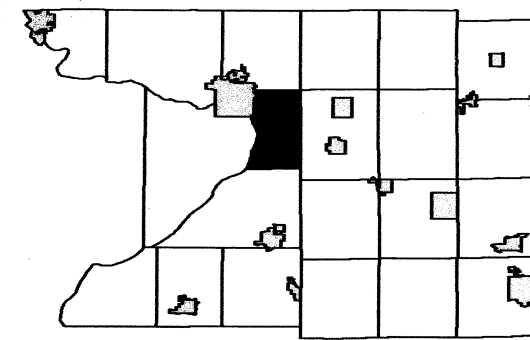

	3	2	
9	10	11	12
16	15	14	13
	22	23	24
28	27	26	25
33	34	35	36

SEE SECTION 02 TOWN OF PACIFIC


SEE SECTION 06 NORTH TOWN OF WYOCENA

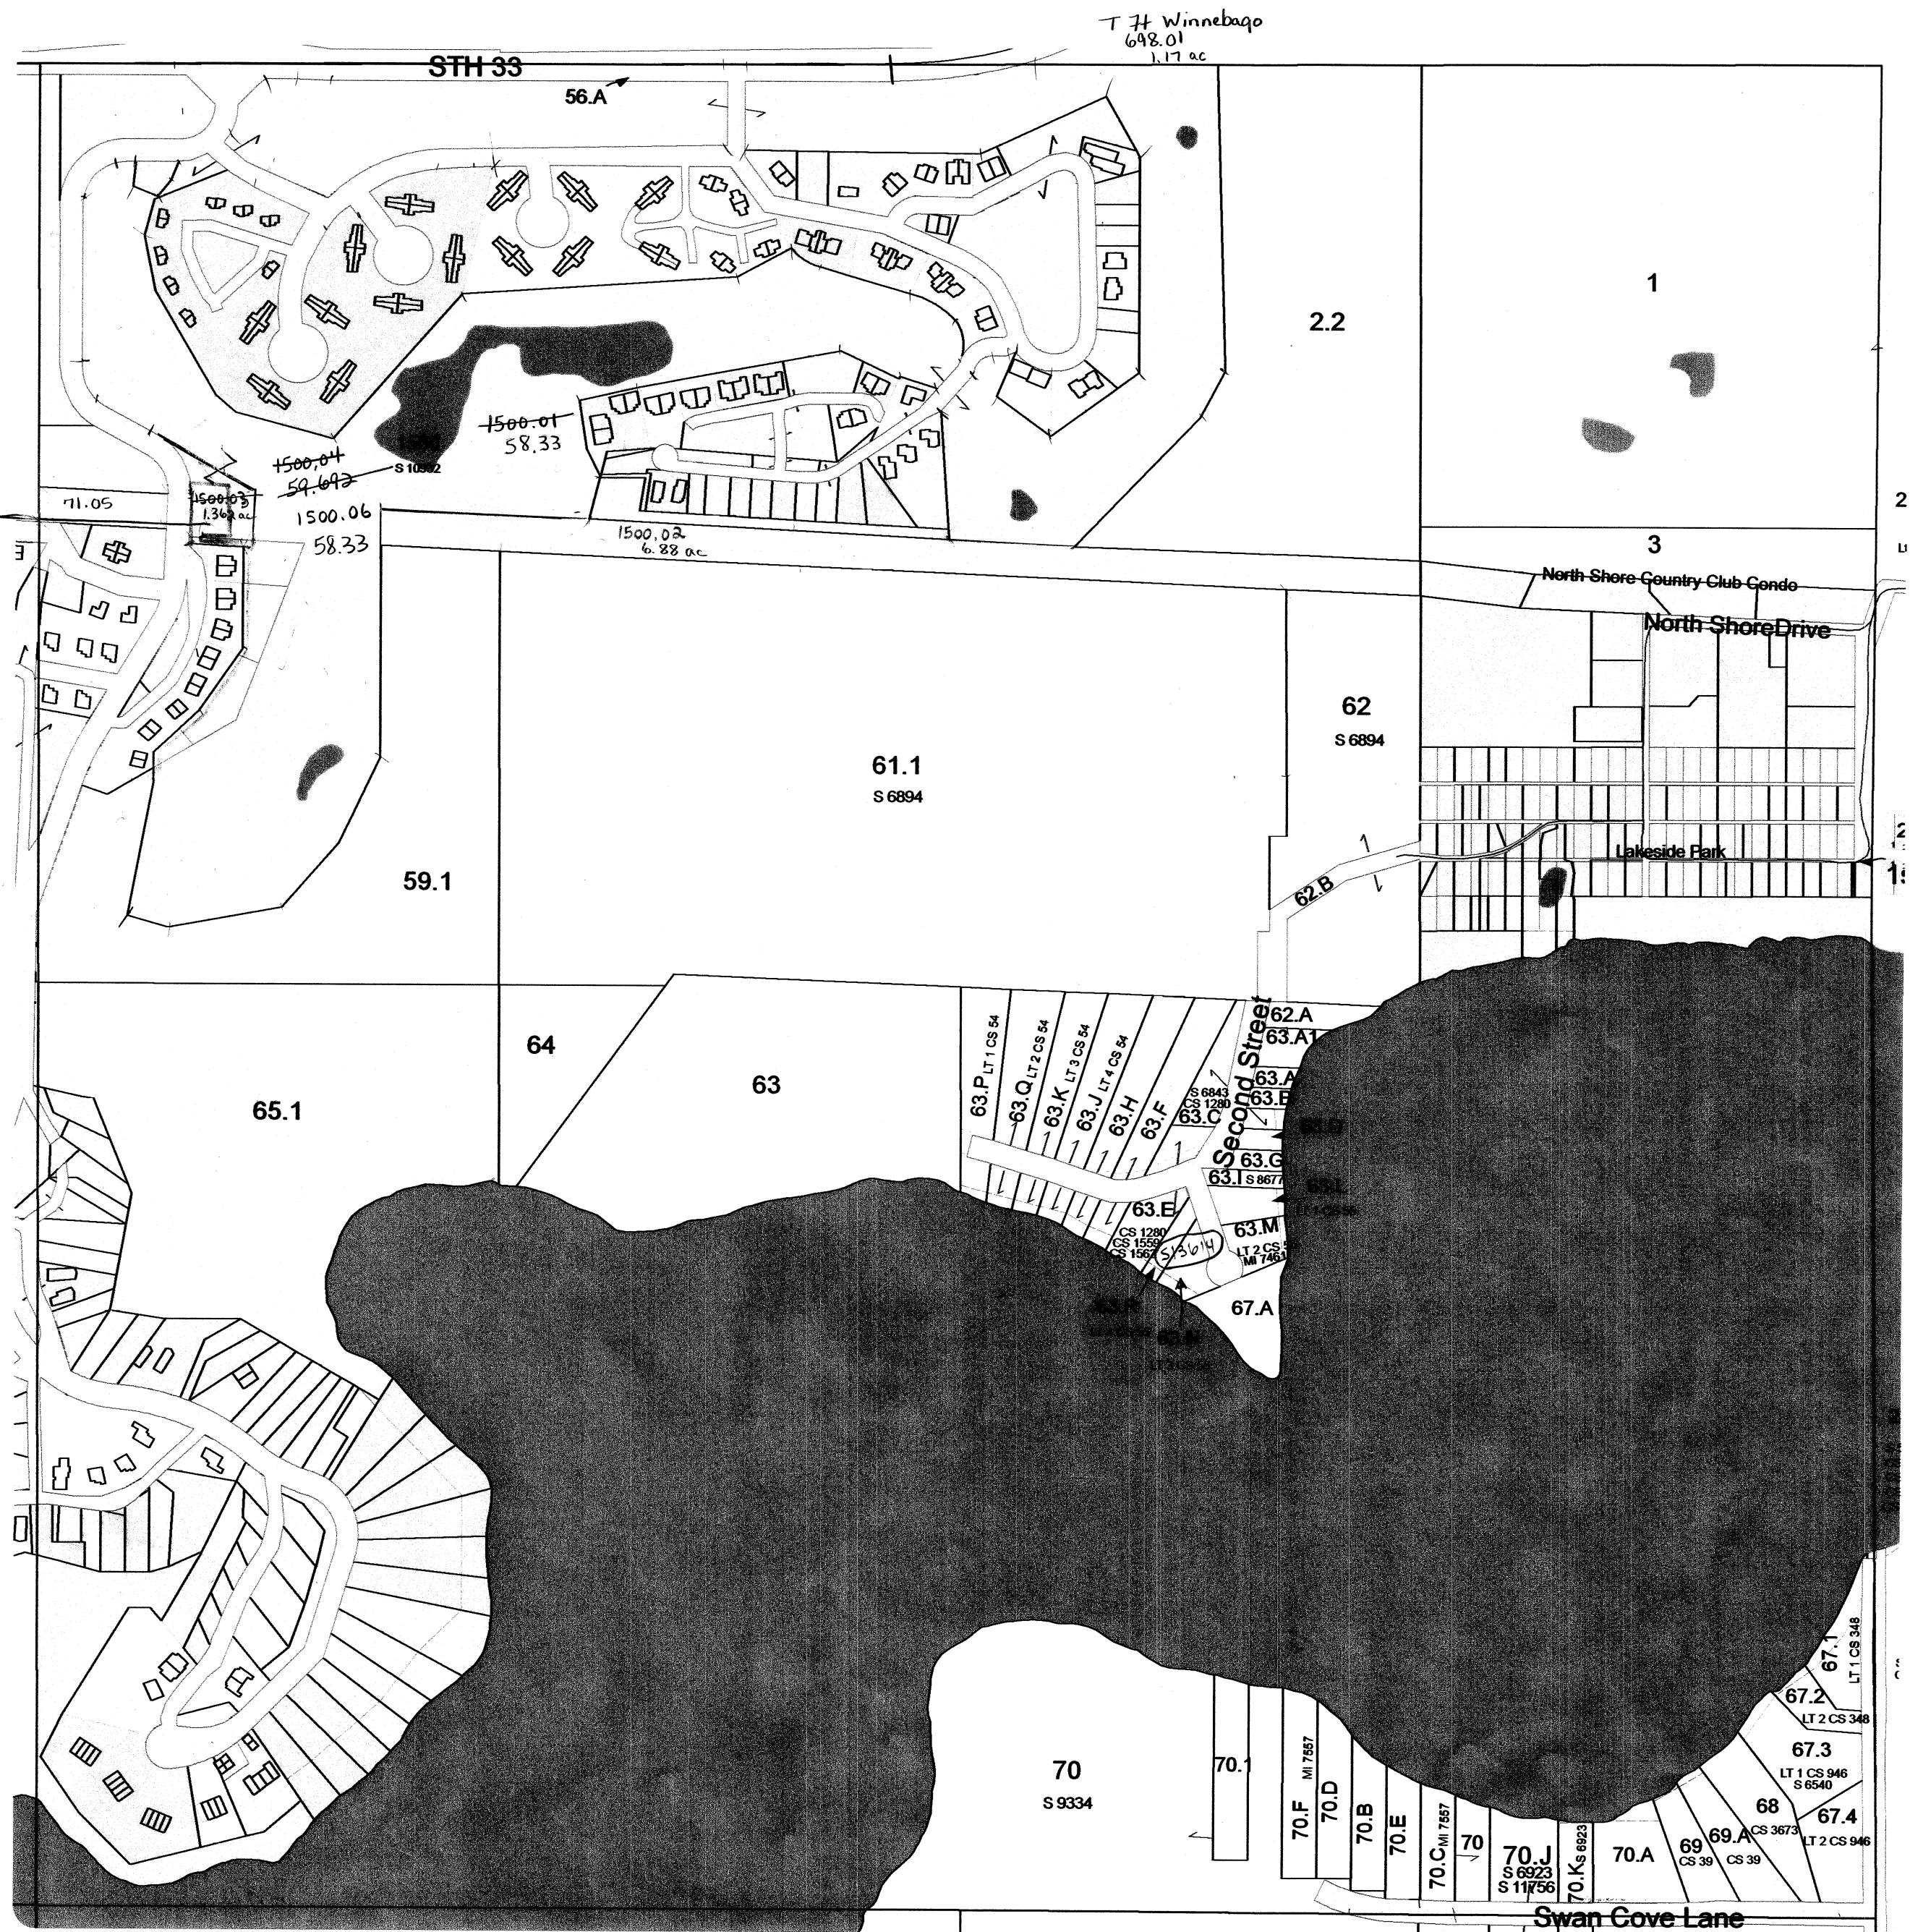

SEE SECTION 12 TOWN OF PACIFIC


Scanned
2012

TOWN OF PACIFIC

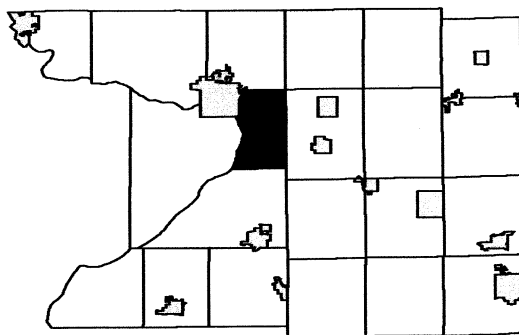

	3	2	1
	10	11	12
6	15	14	13
	22	23	24
28	27	26	25
33	34	35	36

SEE TOWN OF FORT WINNEBAGO

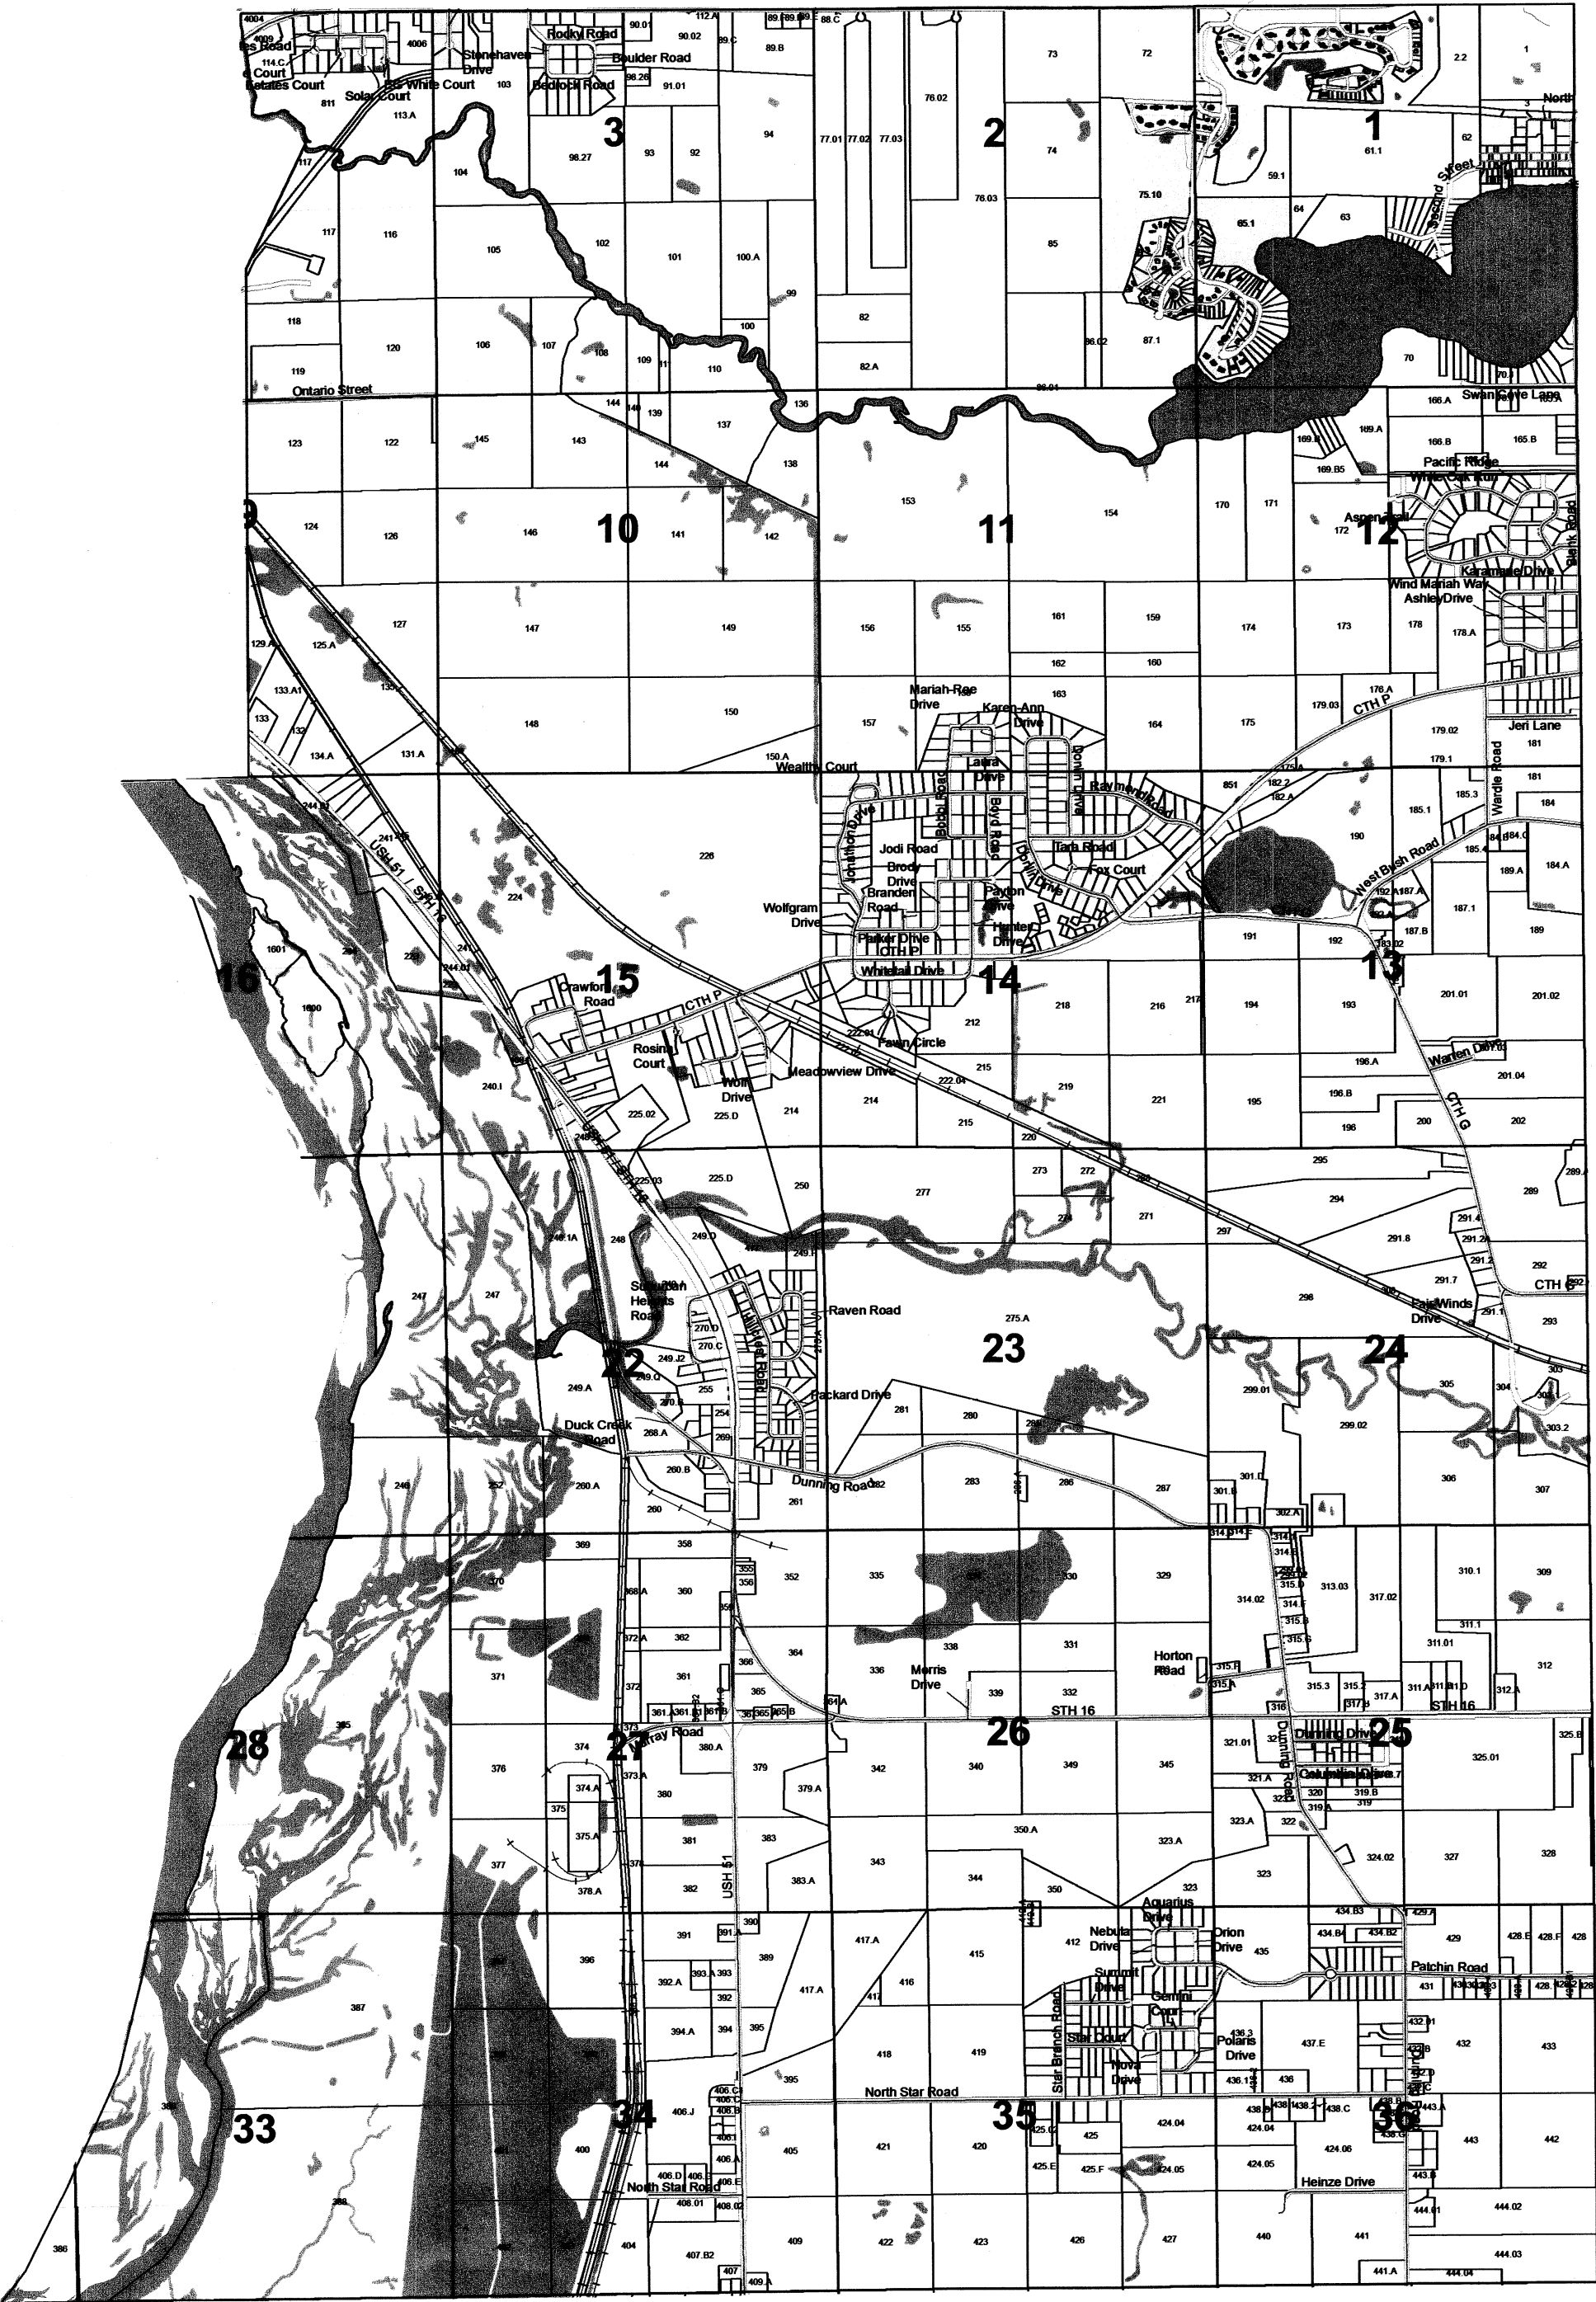

SEE TOWN OF CALEDONIA


SEE TOWN OF WYOCENA

SEE TOWN OF DEKORRA

TOWN OF PACIFIC

SECTION 24 T12N R9E

1 inch = 400 feet 1:4,800

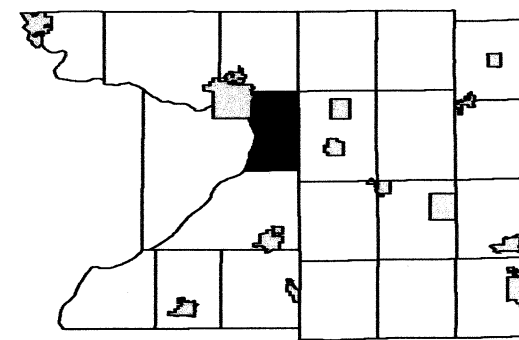


7	3	2	1
9	10	11	12
16	15	14	13
22	23		
28	27	26	25
33	34	35	36

SEE SECTION 13 TOWN OF PACIFIC


SEE SECTION 23 TOWN OF PACIFIC

SEE SECTION 18 TOWN OF WYOCENA

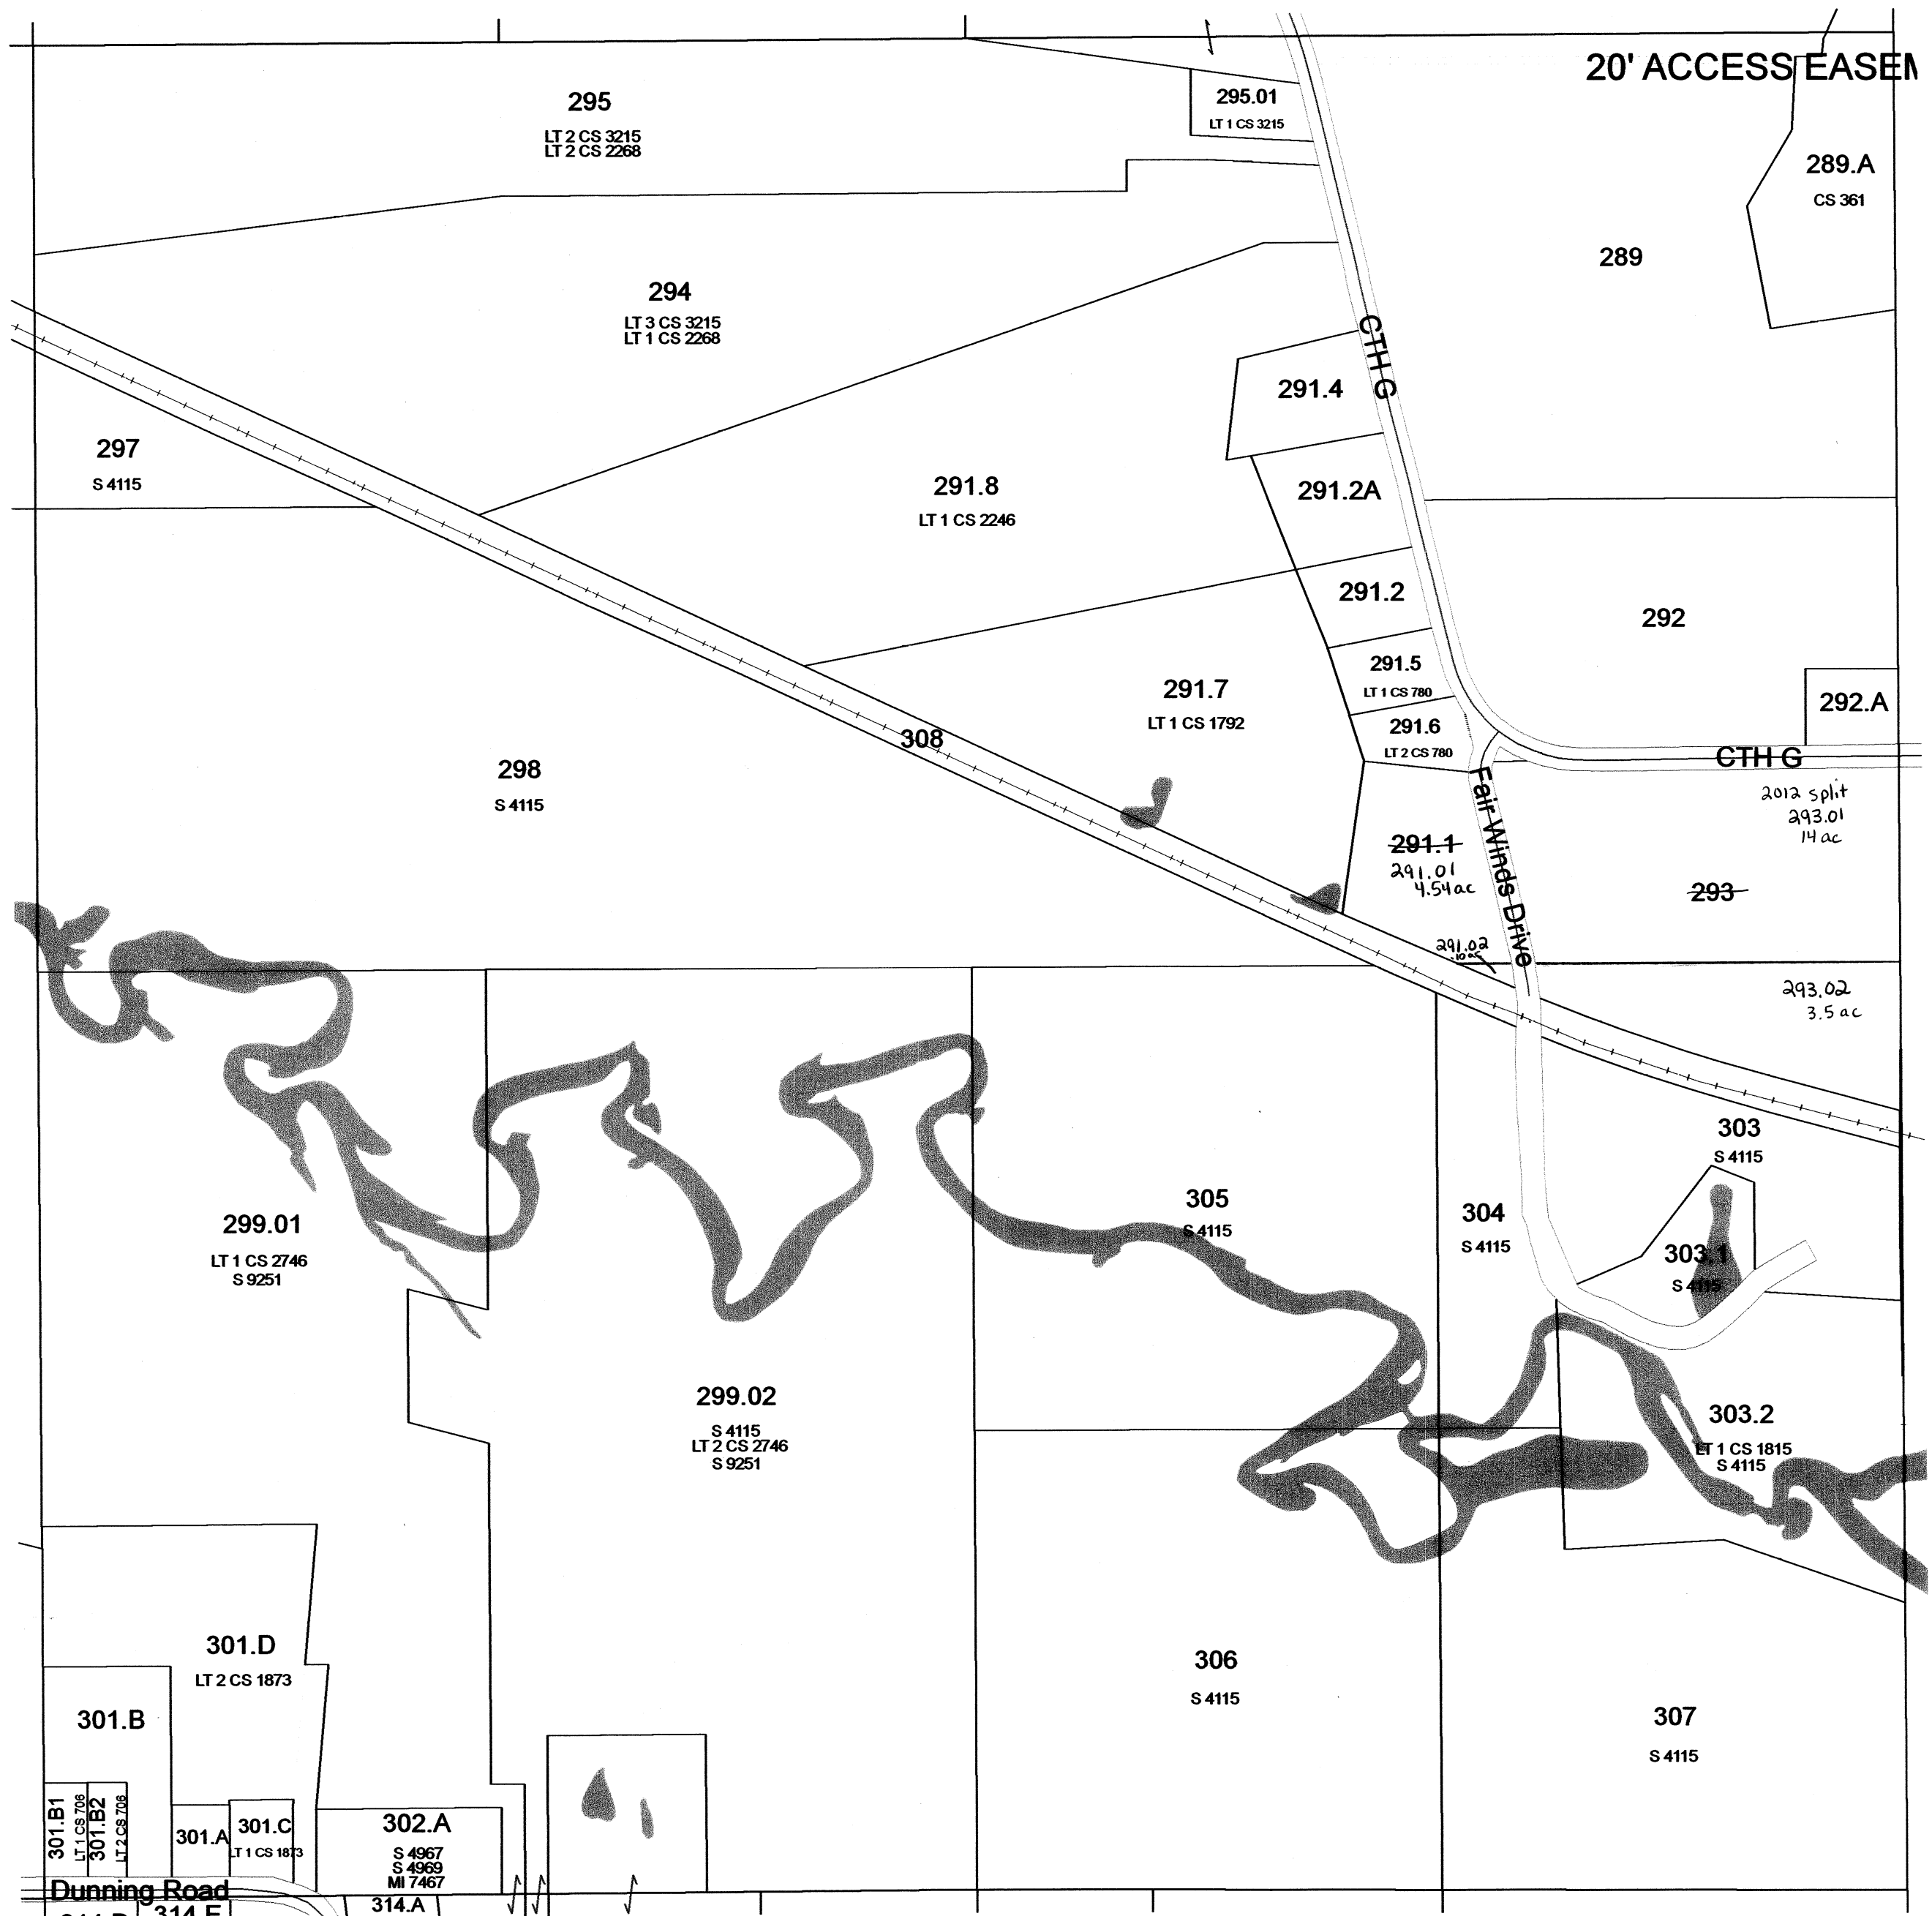

SEE SECTION 25 TOWN OF PACIFIC

TOWN OF PACIFIC

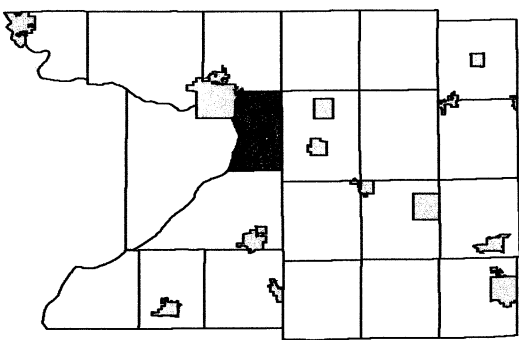


3	2	1
10	11	12
16	15	14
22	23	24
28	27	26
33	34	35
36		

SEE TOWN OF FORT WINNEBAGO

SEE TOWN OF CALEDONIA

SEE TOWN OF WYOCENA

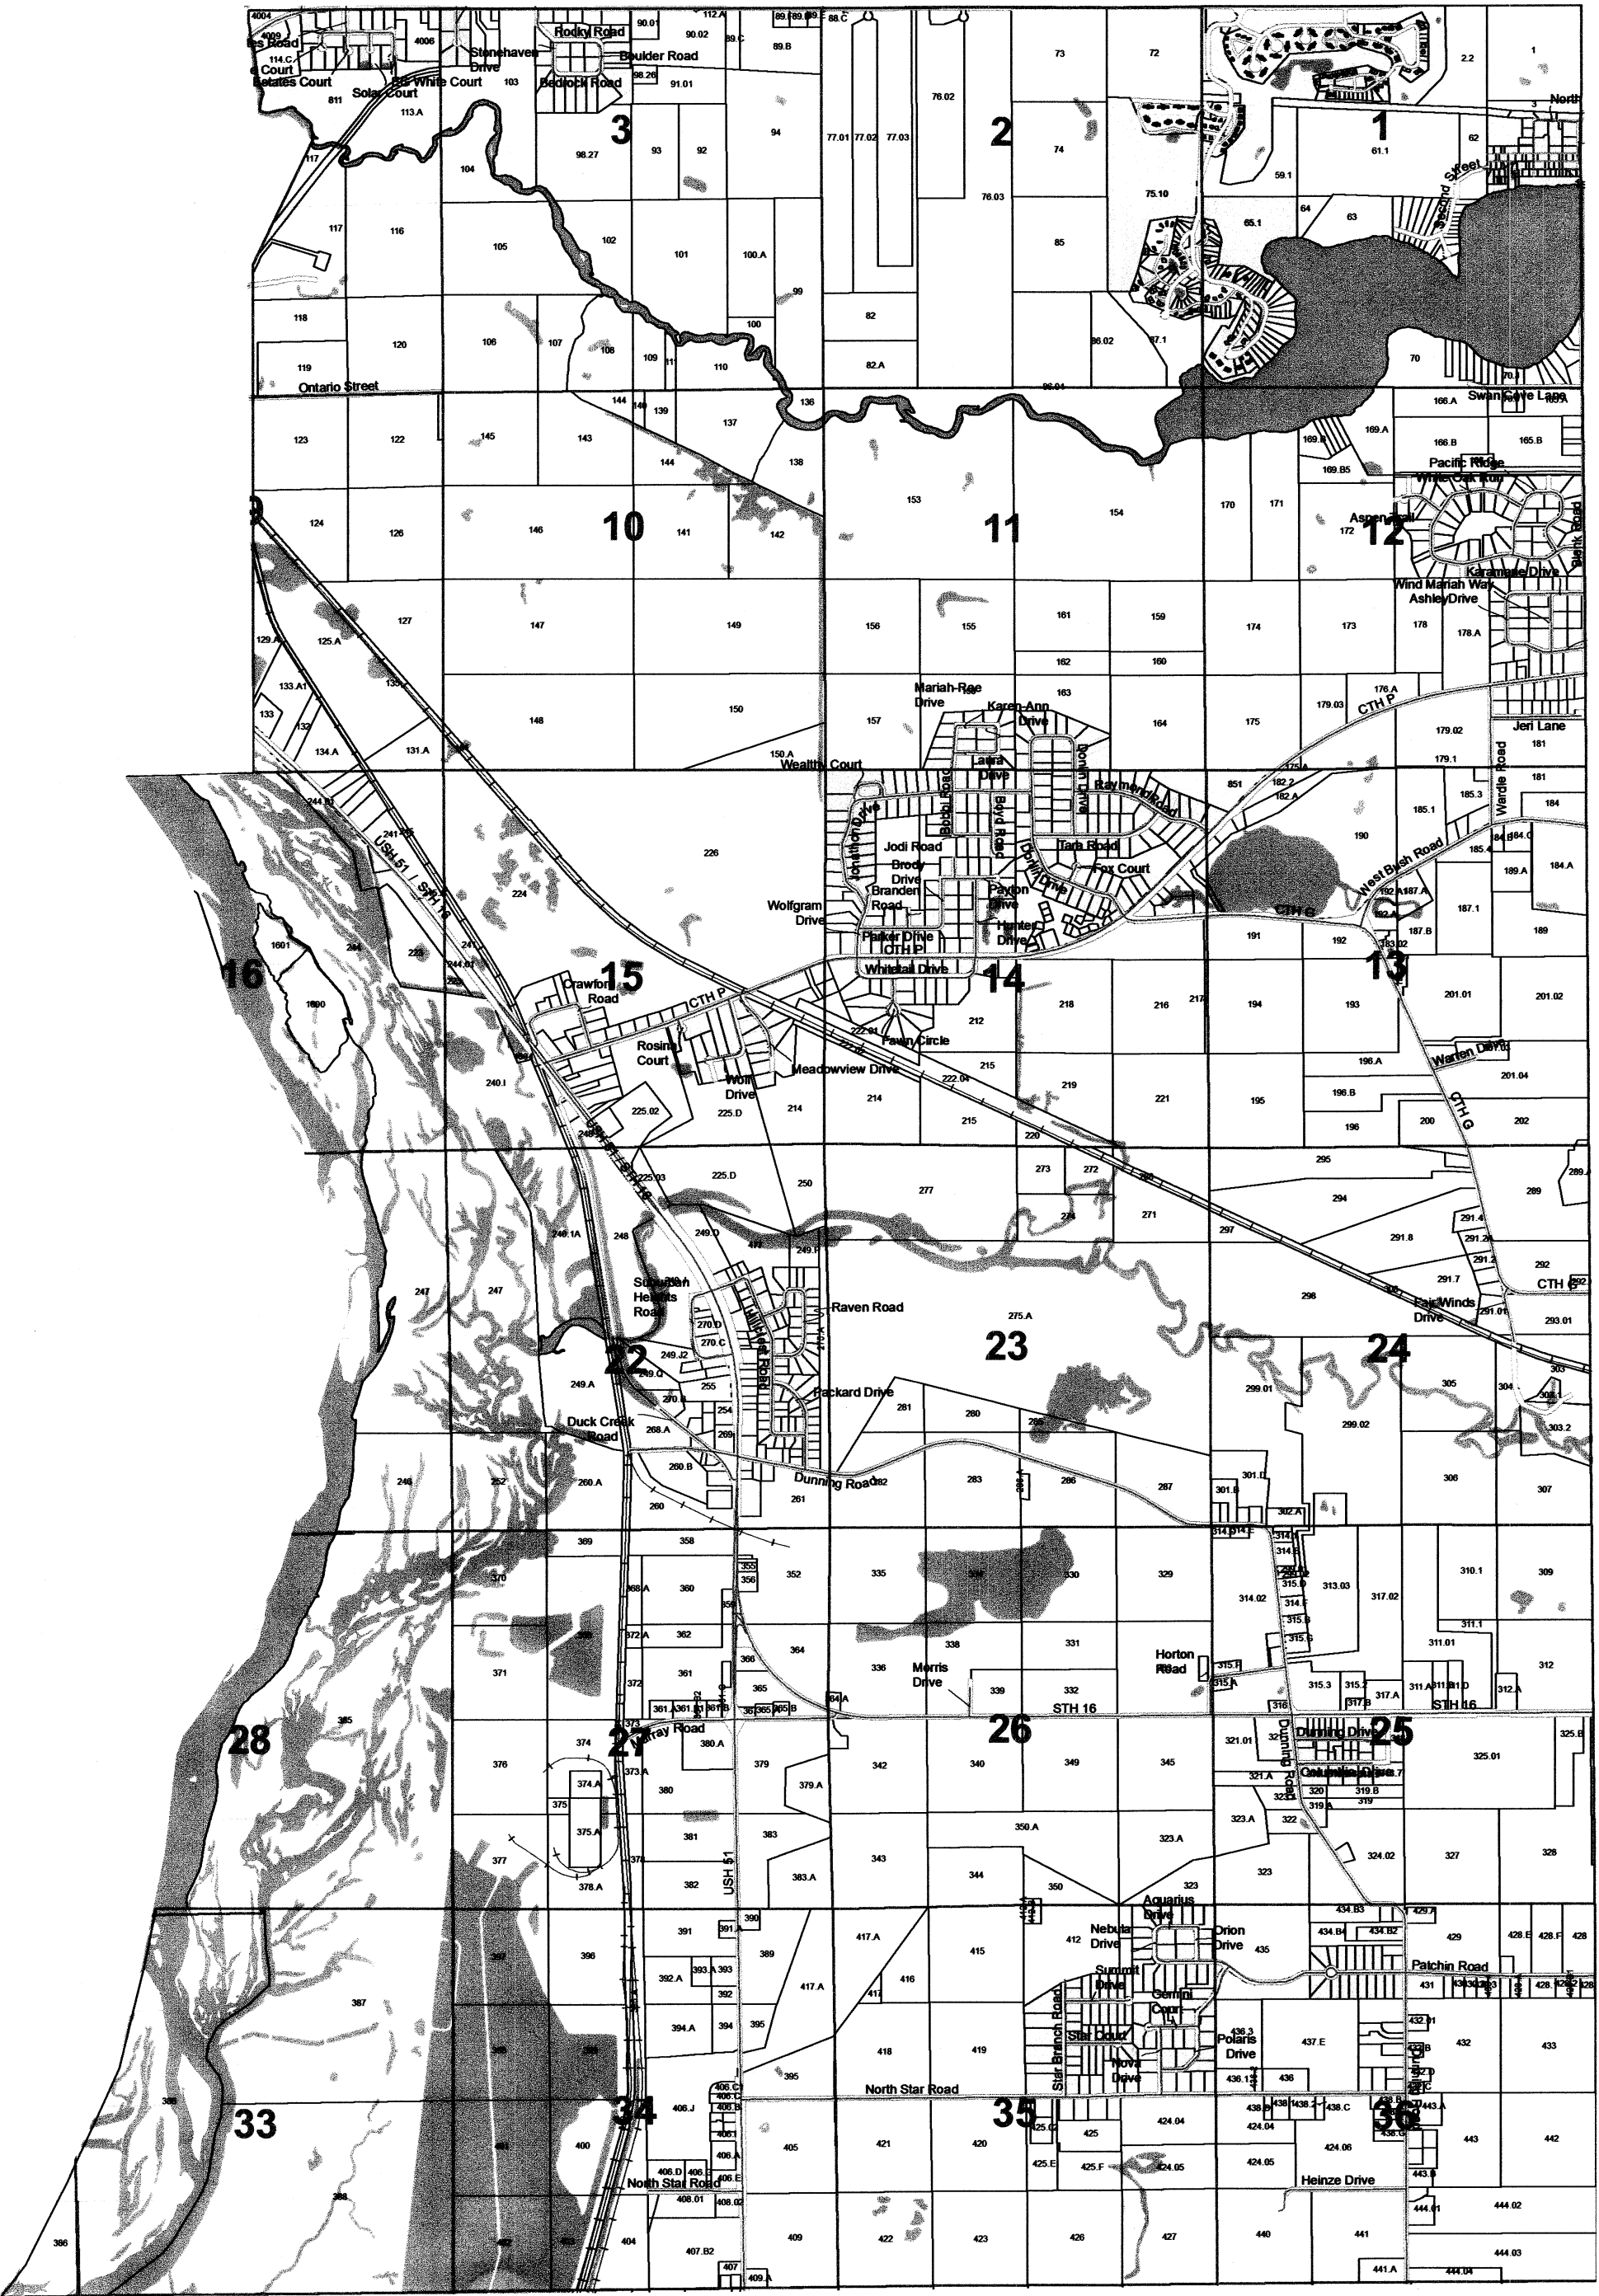


SEE TOWN OF DEKORRA

TOWN OF PACIFIC

SECTION 1 T12N R9E

1 inch = 400 feet 1:4,800


SEE SECTION 36 TOWN OF FORT WINNEBAGO

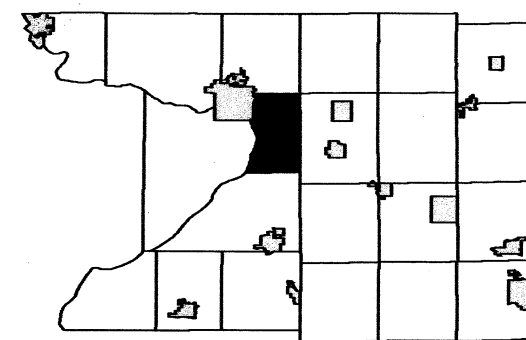

	3	2	
9	10	11	12
6	15	14	13
	22	23	24
28	27	26	25
33	34	35	36

I forgot to subtract the calculated ac (.431) from the 58.33 when this was previously divided

SEE SECTION 02 TOWN OF PACIFIC

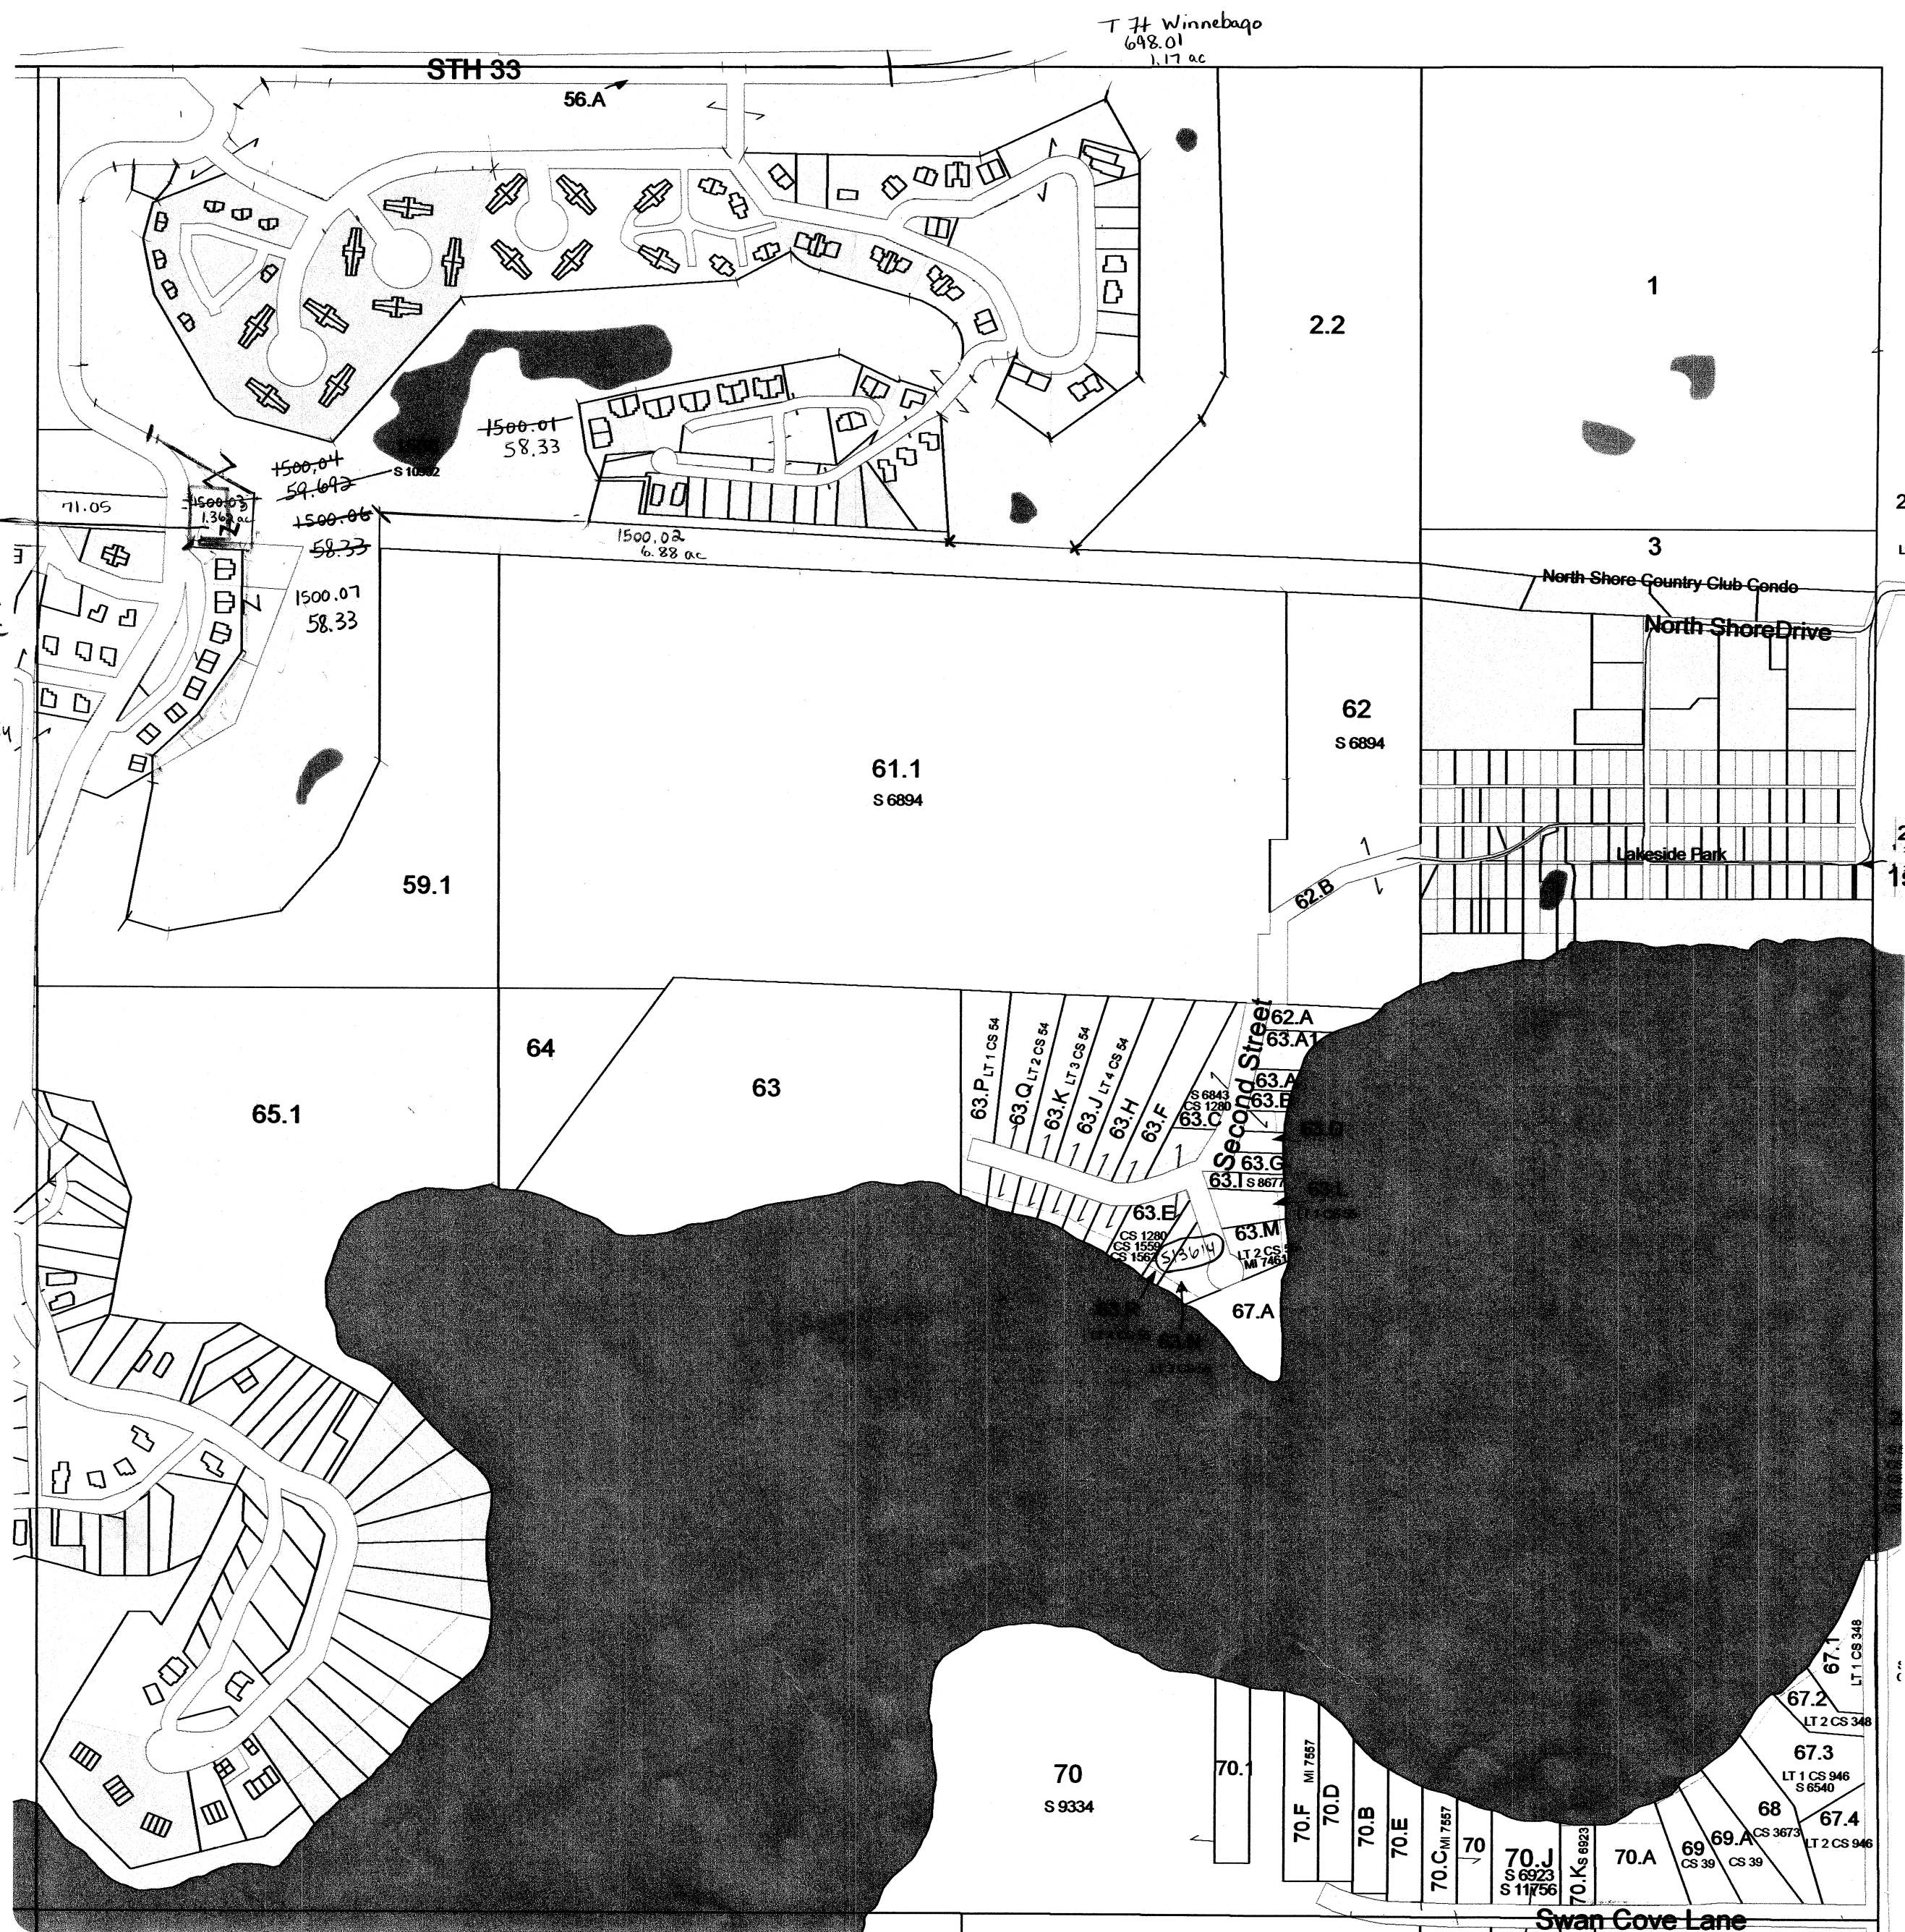


SEE SECTION 06 NORTH TOWN OF WYOCENA

TOWN OF PACIFIC

SECTION 12 T12N R9E


1 inch = 400 feet 1:4,800

SEE SECTION 01 TOWN OF PACIFIC

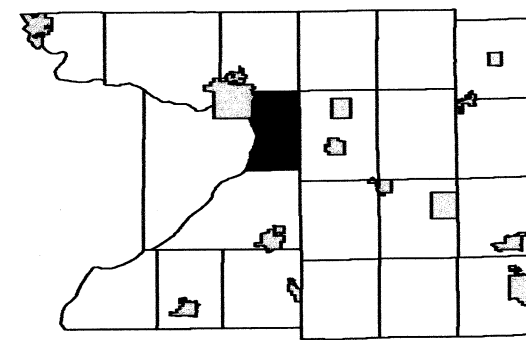

	3	2	1
9	10	11	
6	15	14	13
	22	23	24
28	27	26	25
33	34	35	36

SEE SECTION 11 TOWN OF PACIFIC

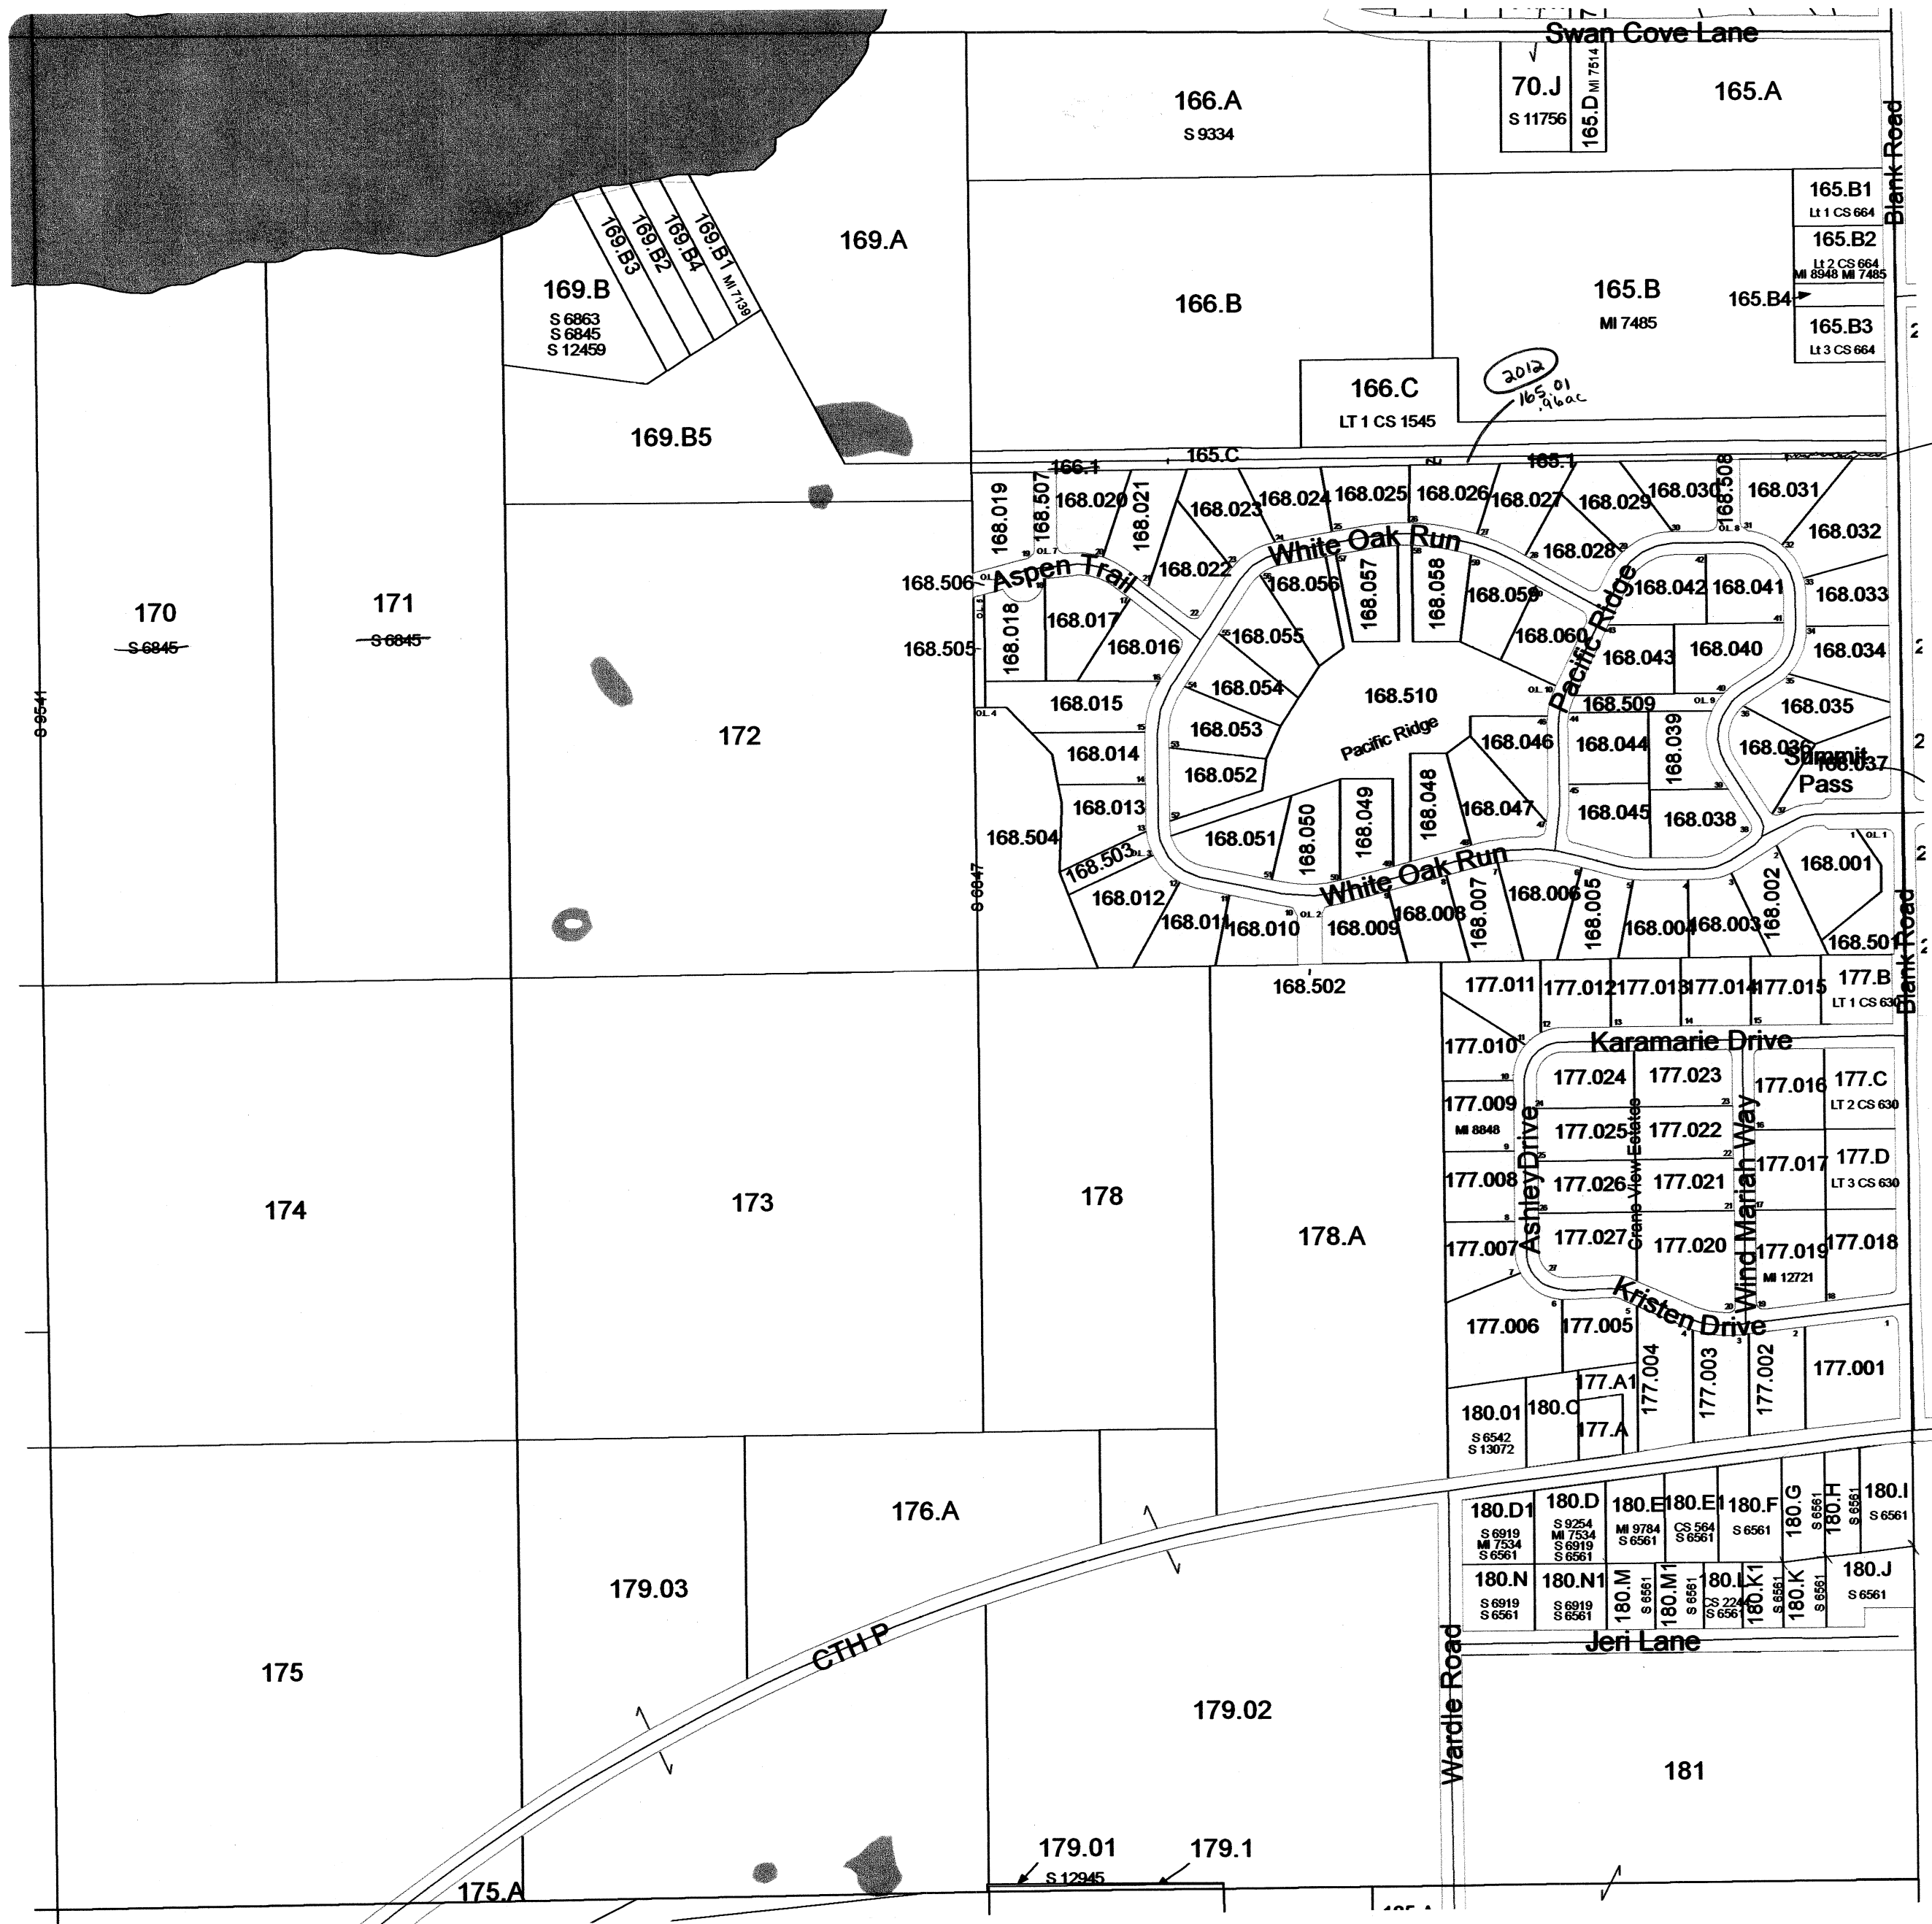

SEE SECTION 06 SOUTH TOWN OF WYOCENA


SEE SECTION 13 TOWN OF PACIFIC

TOWN OF PACIFIC

SECTION 22 T12N R9E


1 inch = 400 feet 1:4,800

SEE SECTION 15 TOWN OF PACIFIC

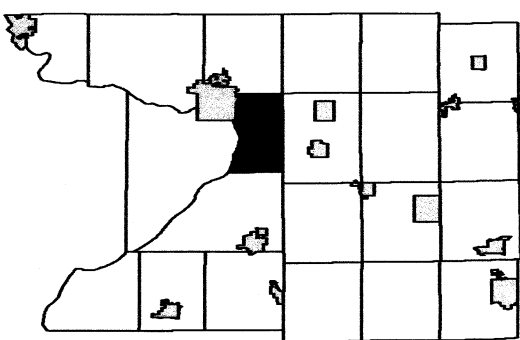

	3	2	1
9	10	11	12
6	15	14	13
		23	24
28	27	26	25
33	34	35	36

SEE SECTION 21 TOWN OF PACIFIC

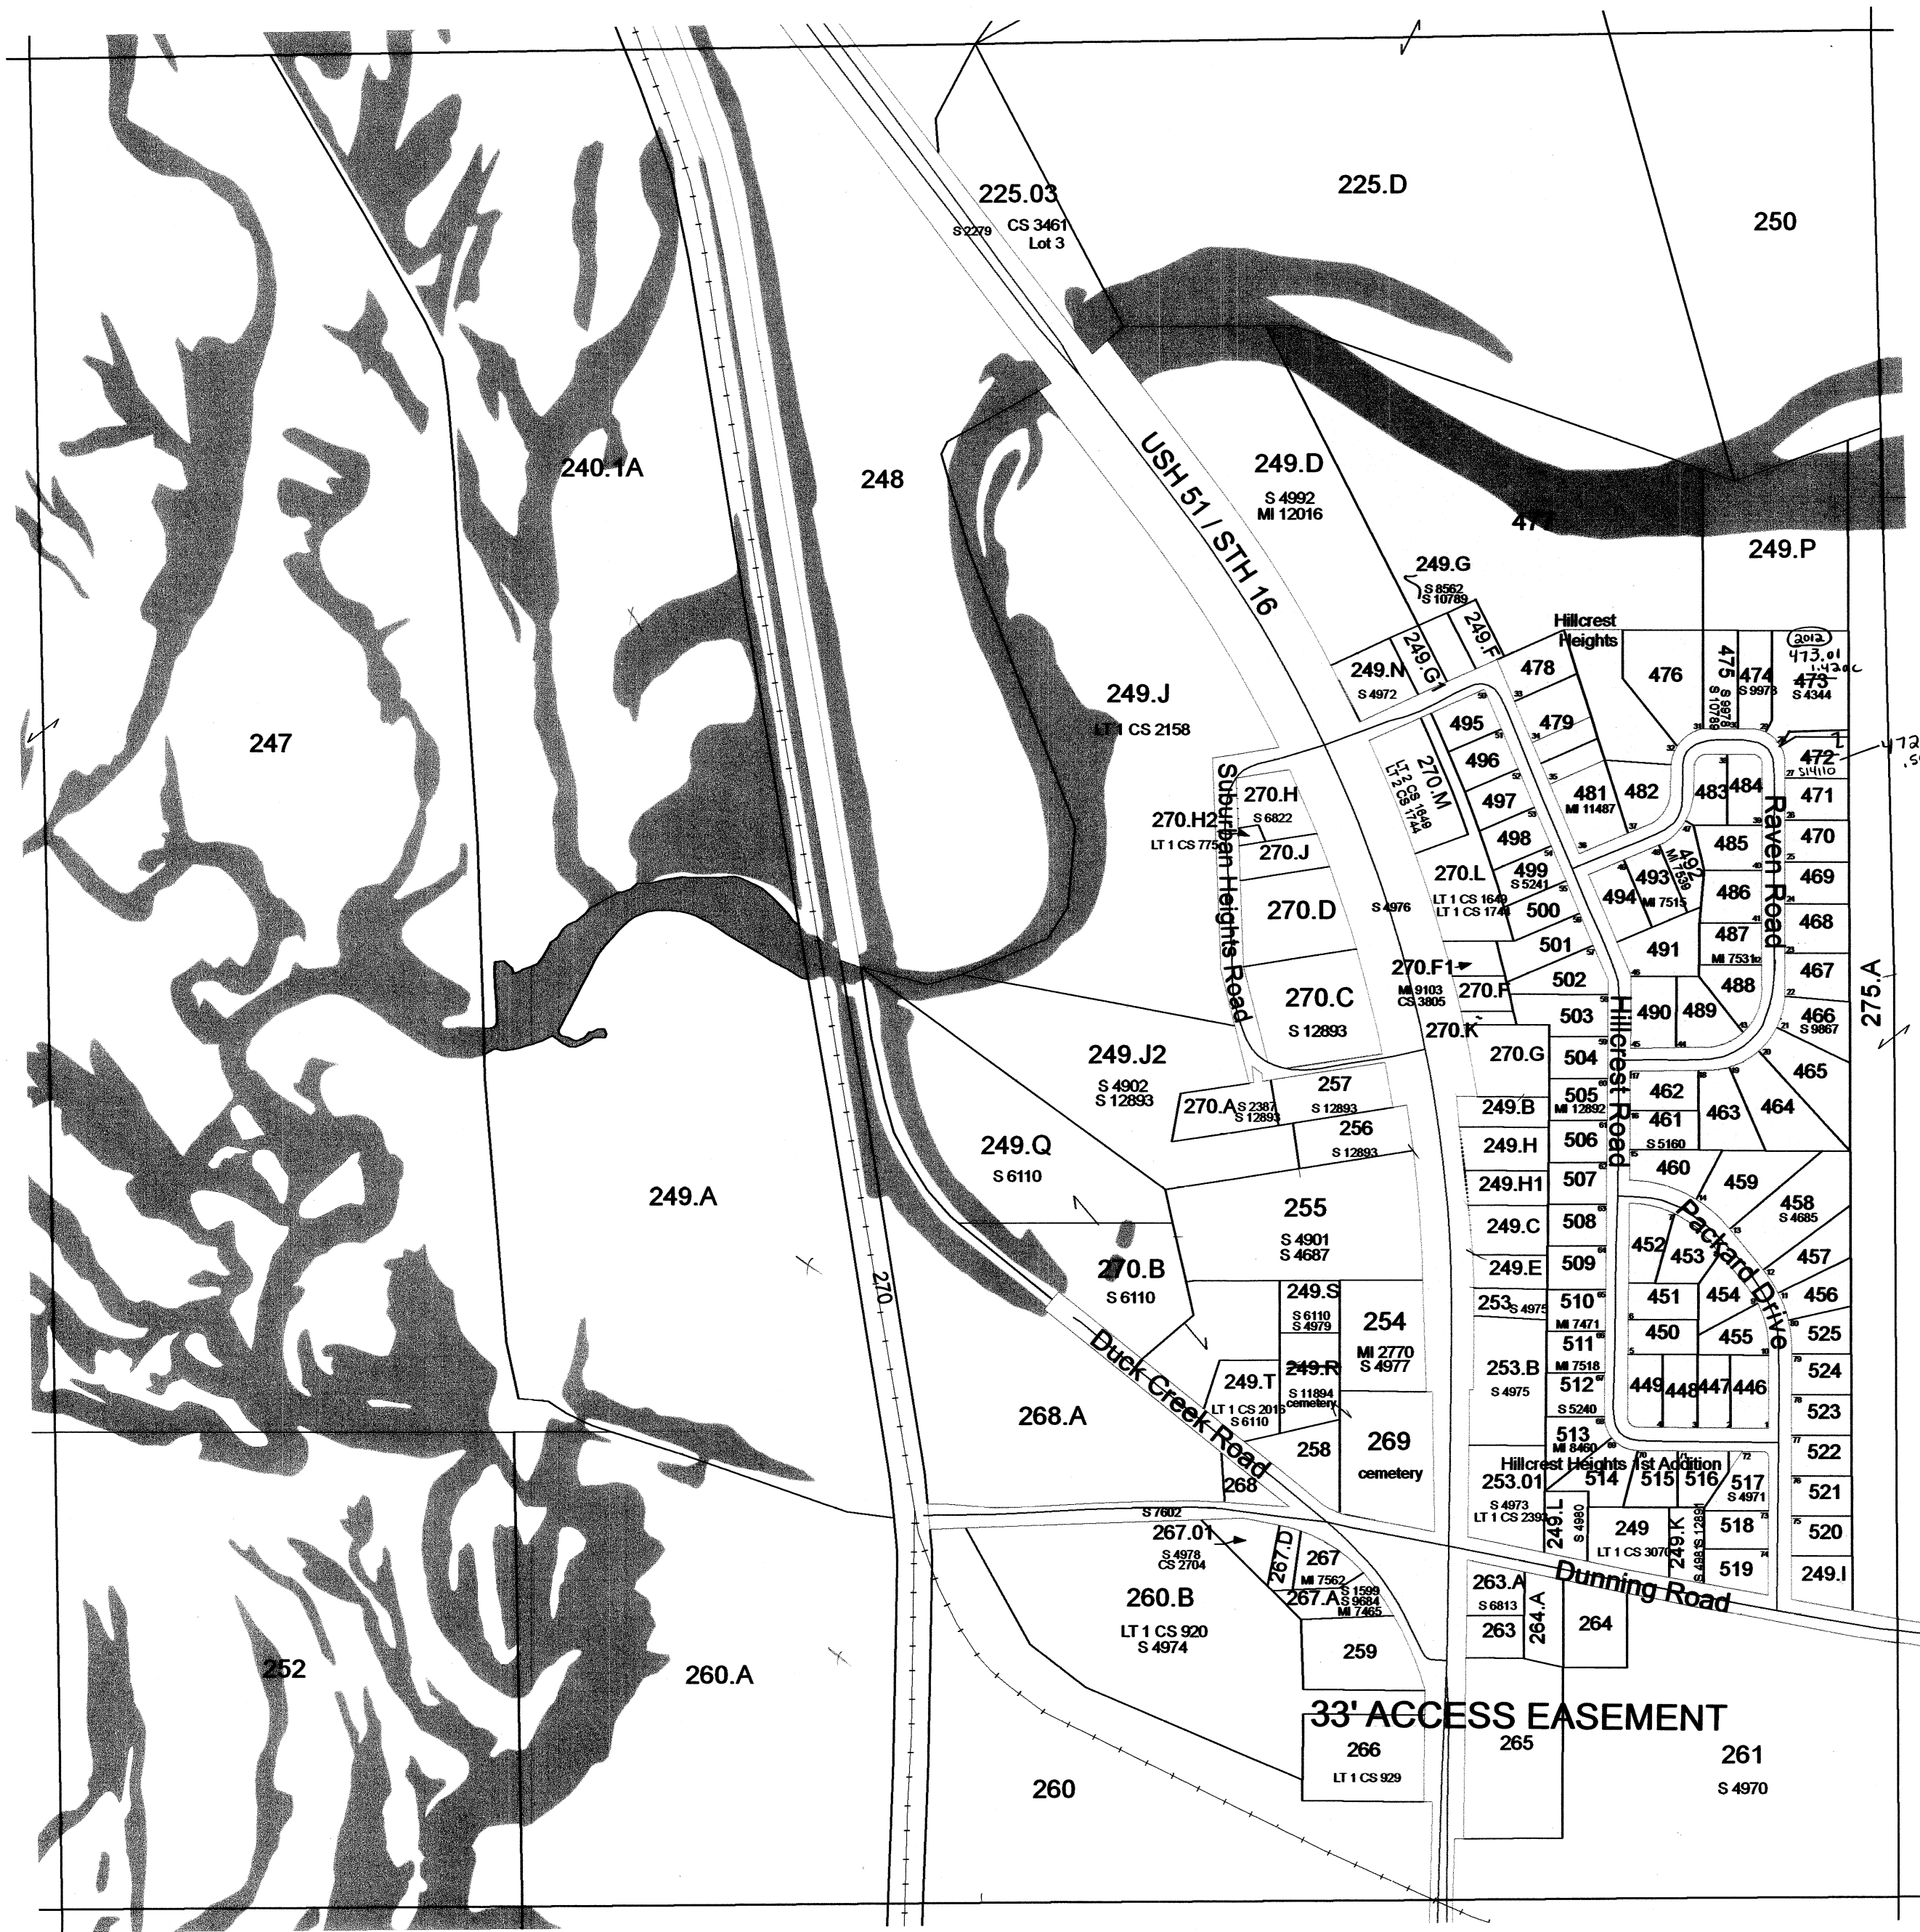


SEE SECTION 23 TOWN OF PACIFIC


SEE SECTION 27 TOWN OF PACIFIC

1 inch = 400 feet 1:4,800

SEE SECTION 26 TOWN OF PACIFIC

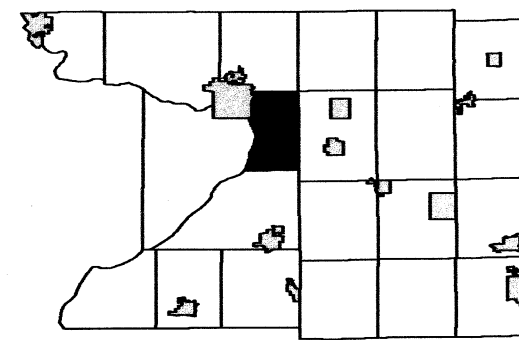

4	3	2	1
9	10	11	12
16	15	14	13
	22	23	24
28	27	26	25
33	34		36

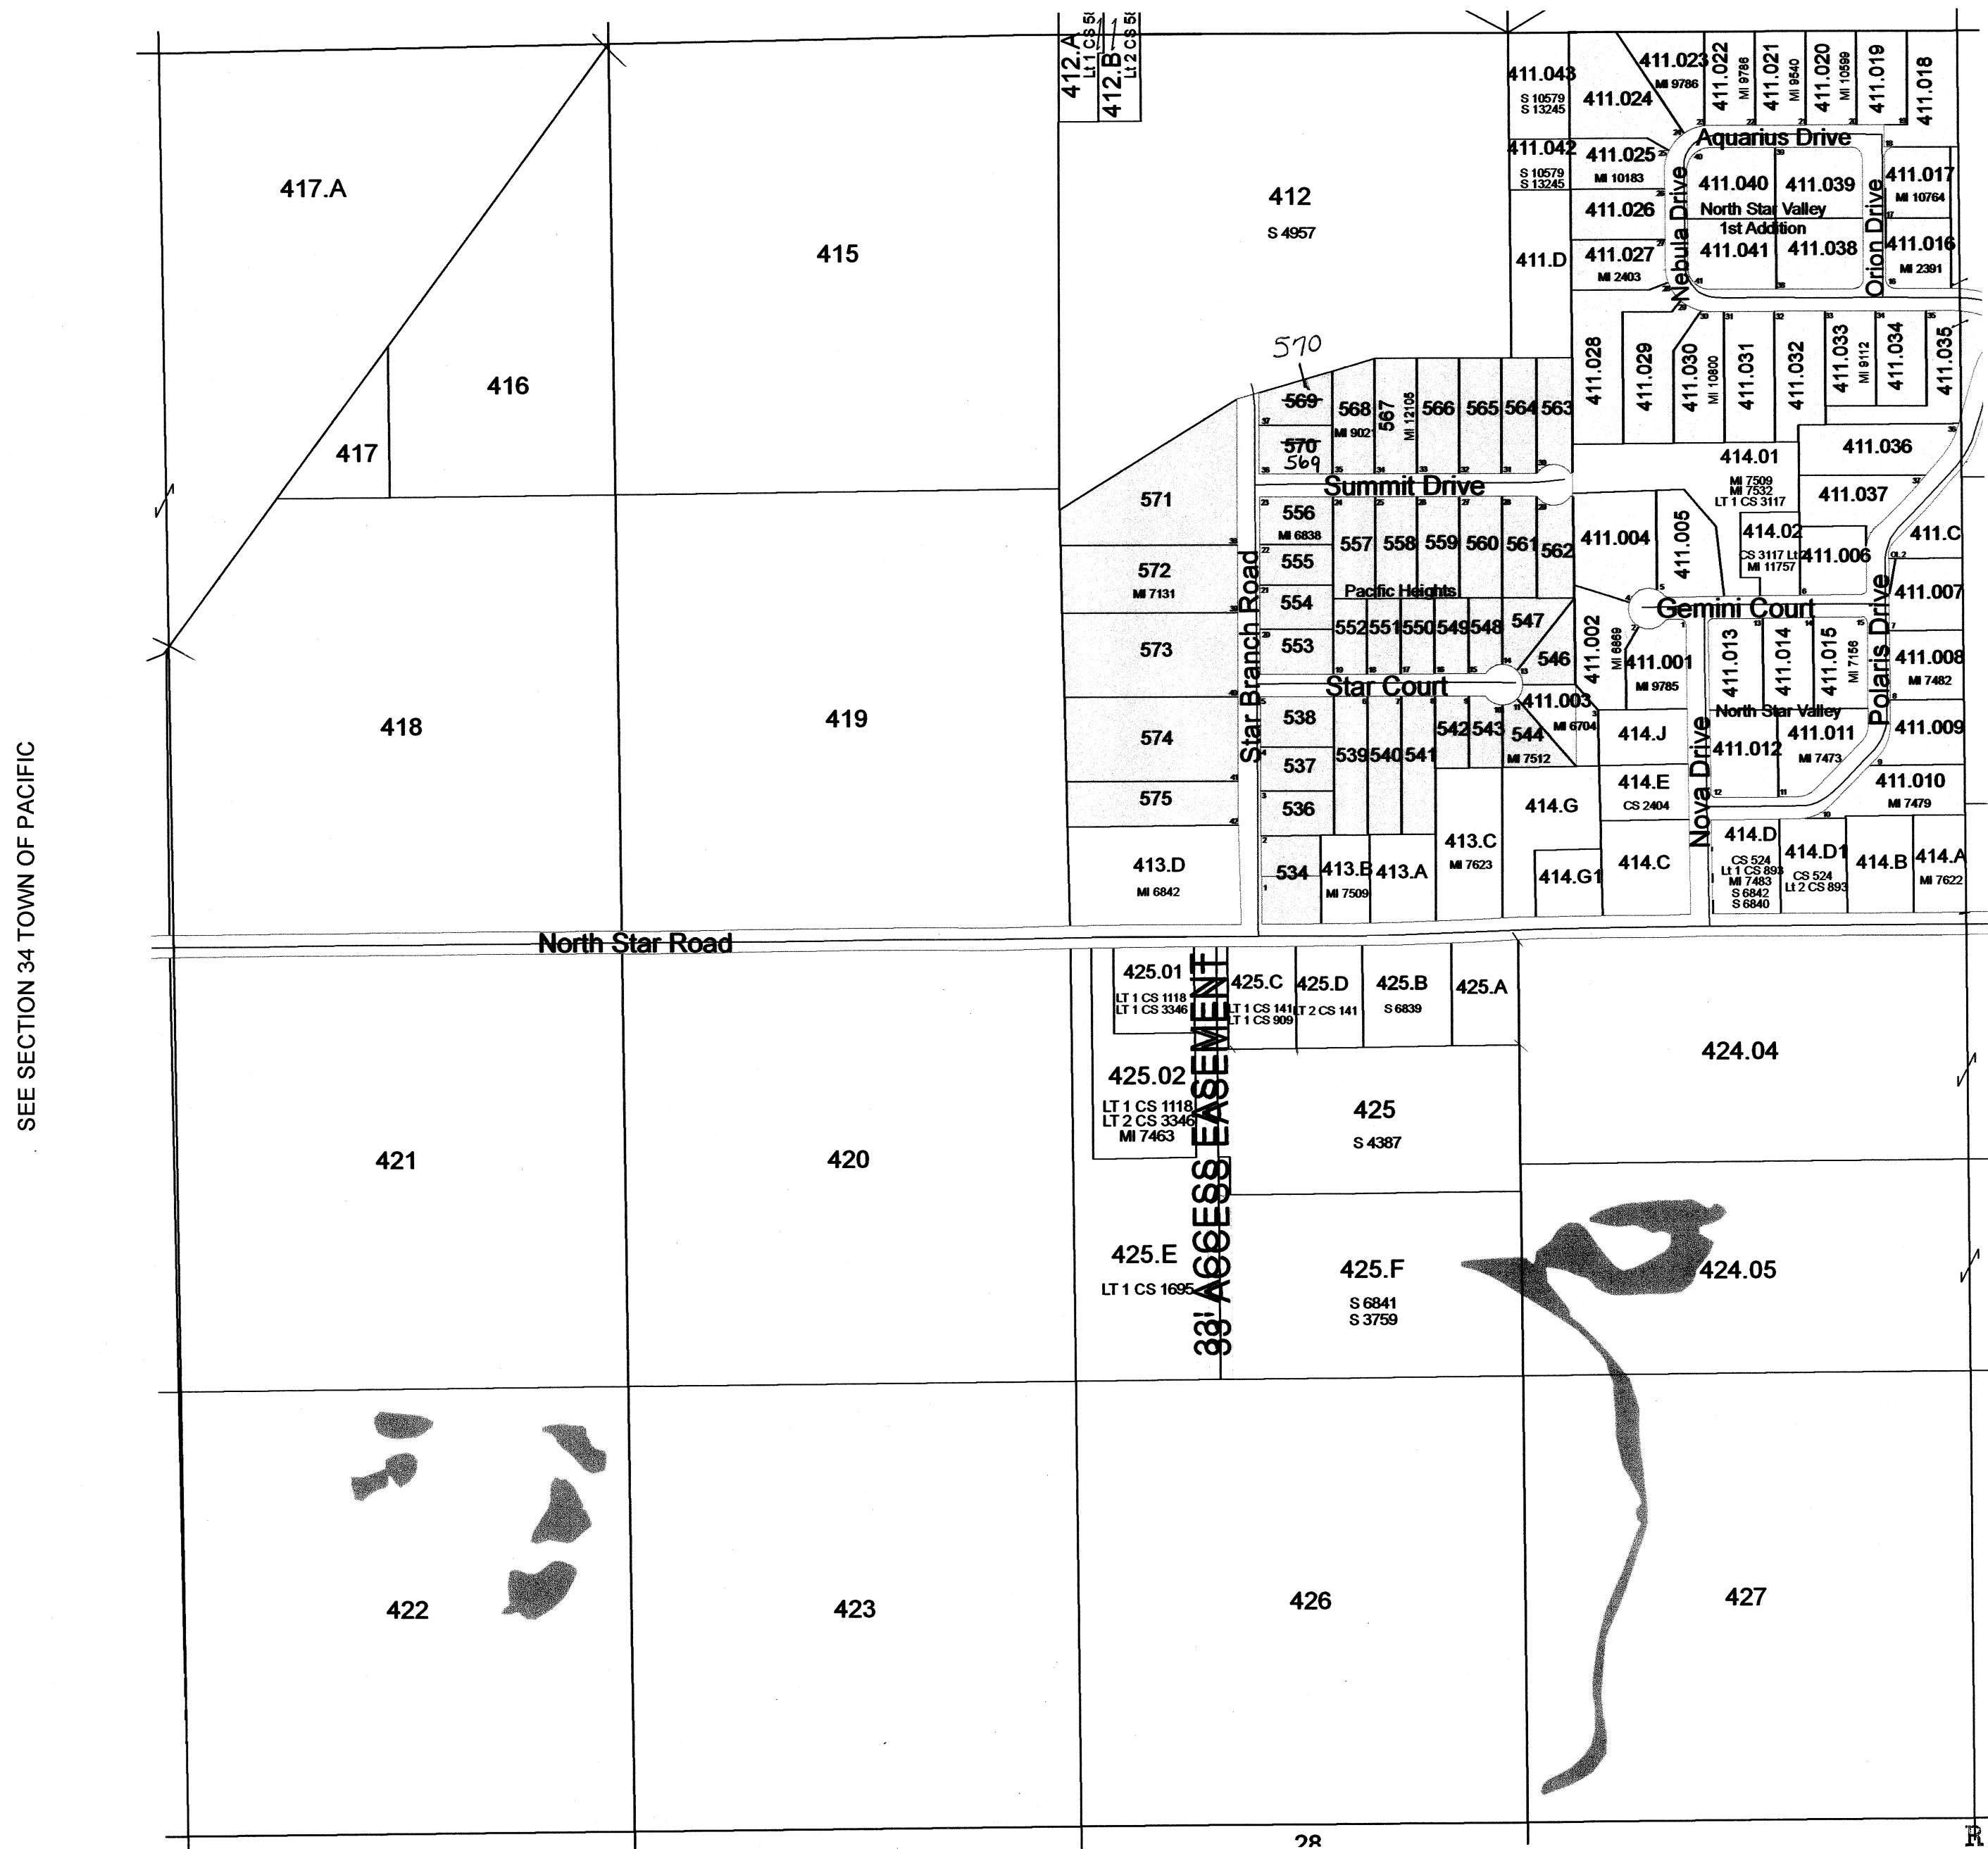

SEE SECTION 36 TOWN OF PACIFIC

REPLACED
2014

SEE SECTION 02 TOWN OF DEKORRA

February 10, 2009
Columbia County Land Information


SECTION 35
T12N R9E

TOWN OF PACIFIC

SECTION 25 T12N R9E

1 inch = 400 feet 1:4,800


SEE SECTION 24 TOWN OF PACIFIC

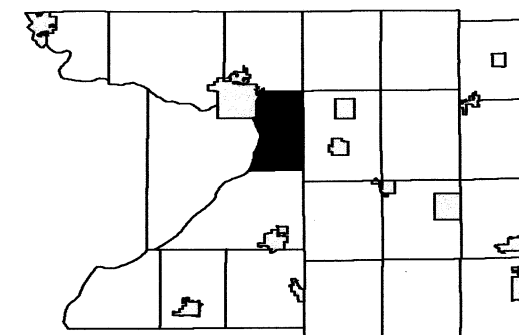

	3	2	1
9	10	11	12
6	15	14	13
	22	23	24
28	27	26	
33	34	35	36

SEE SECTION 26 TOWN OF PACIFIC

SEE SECTION 19 TOWN OF WYOCENA

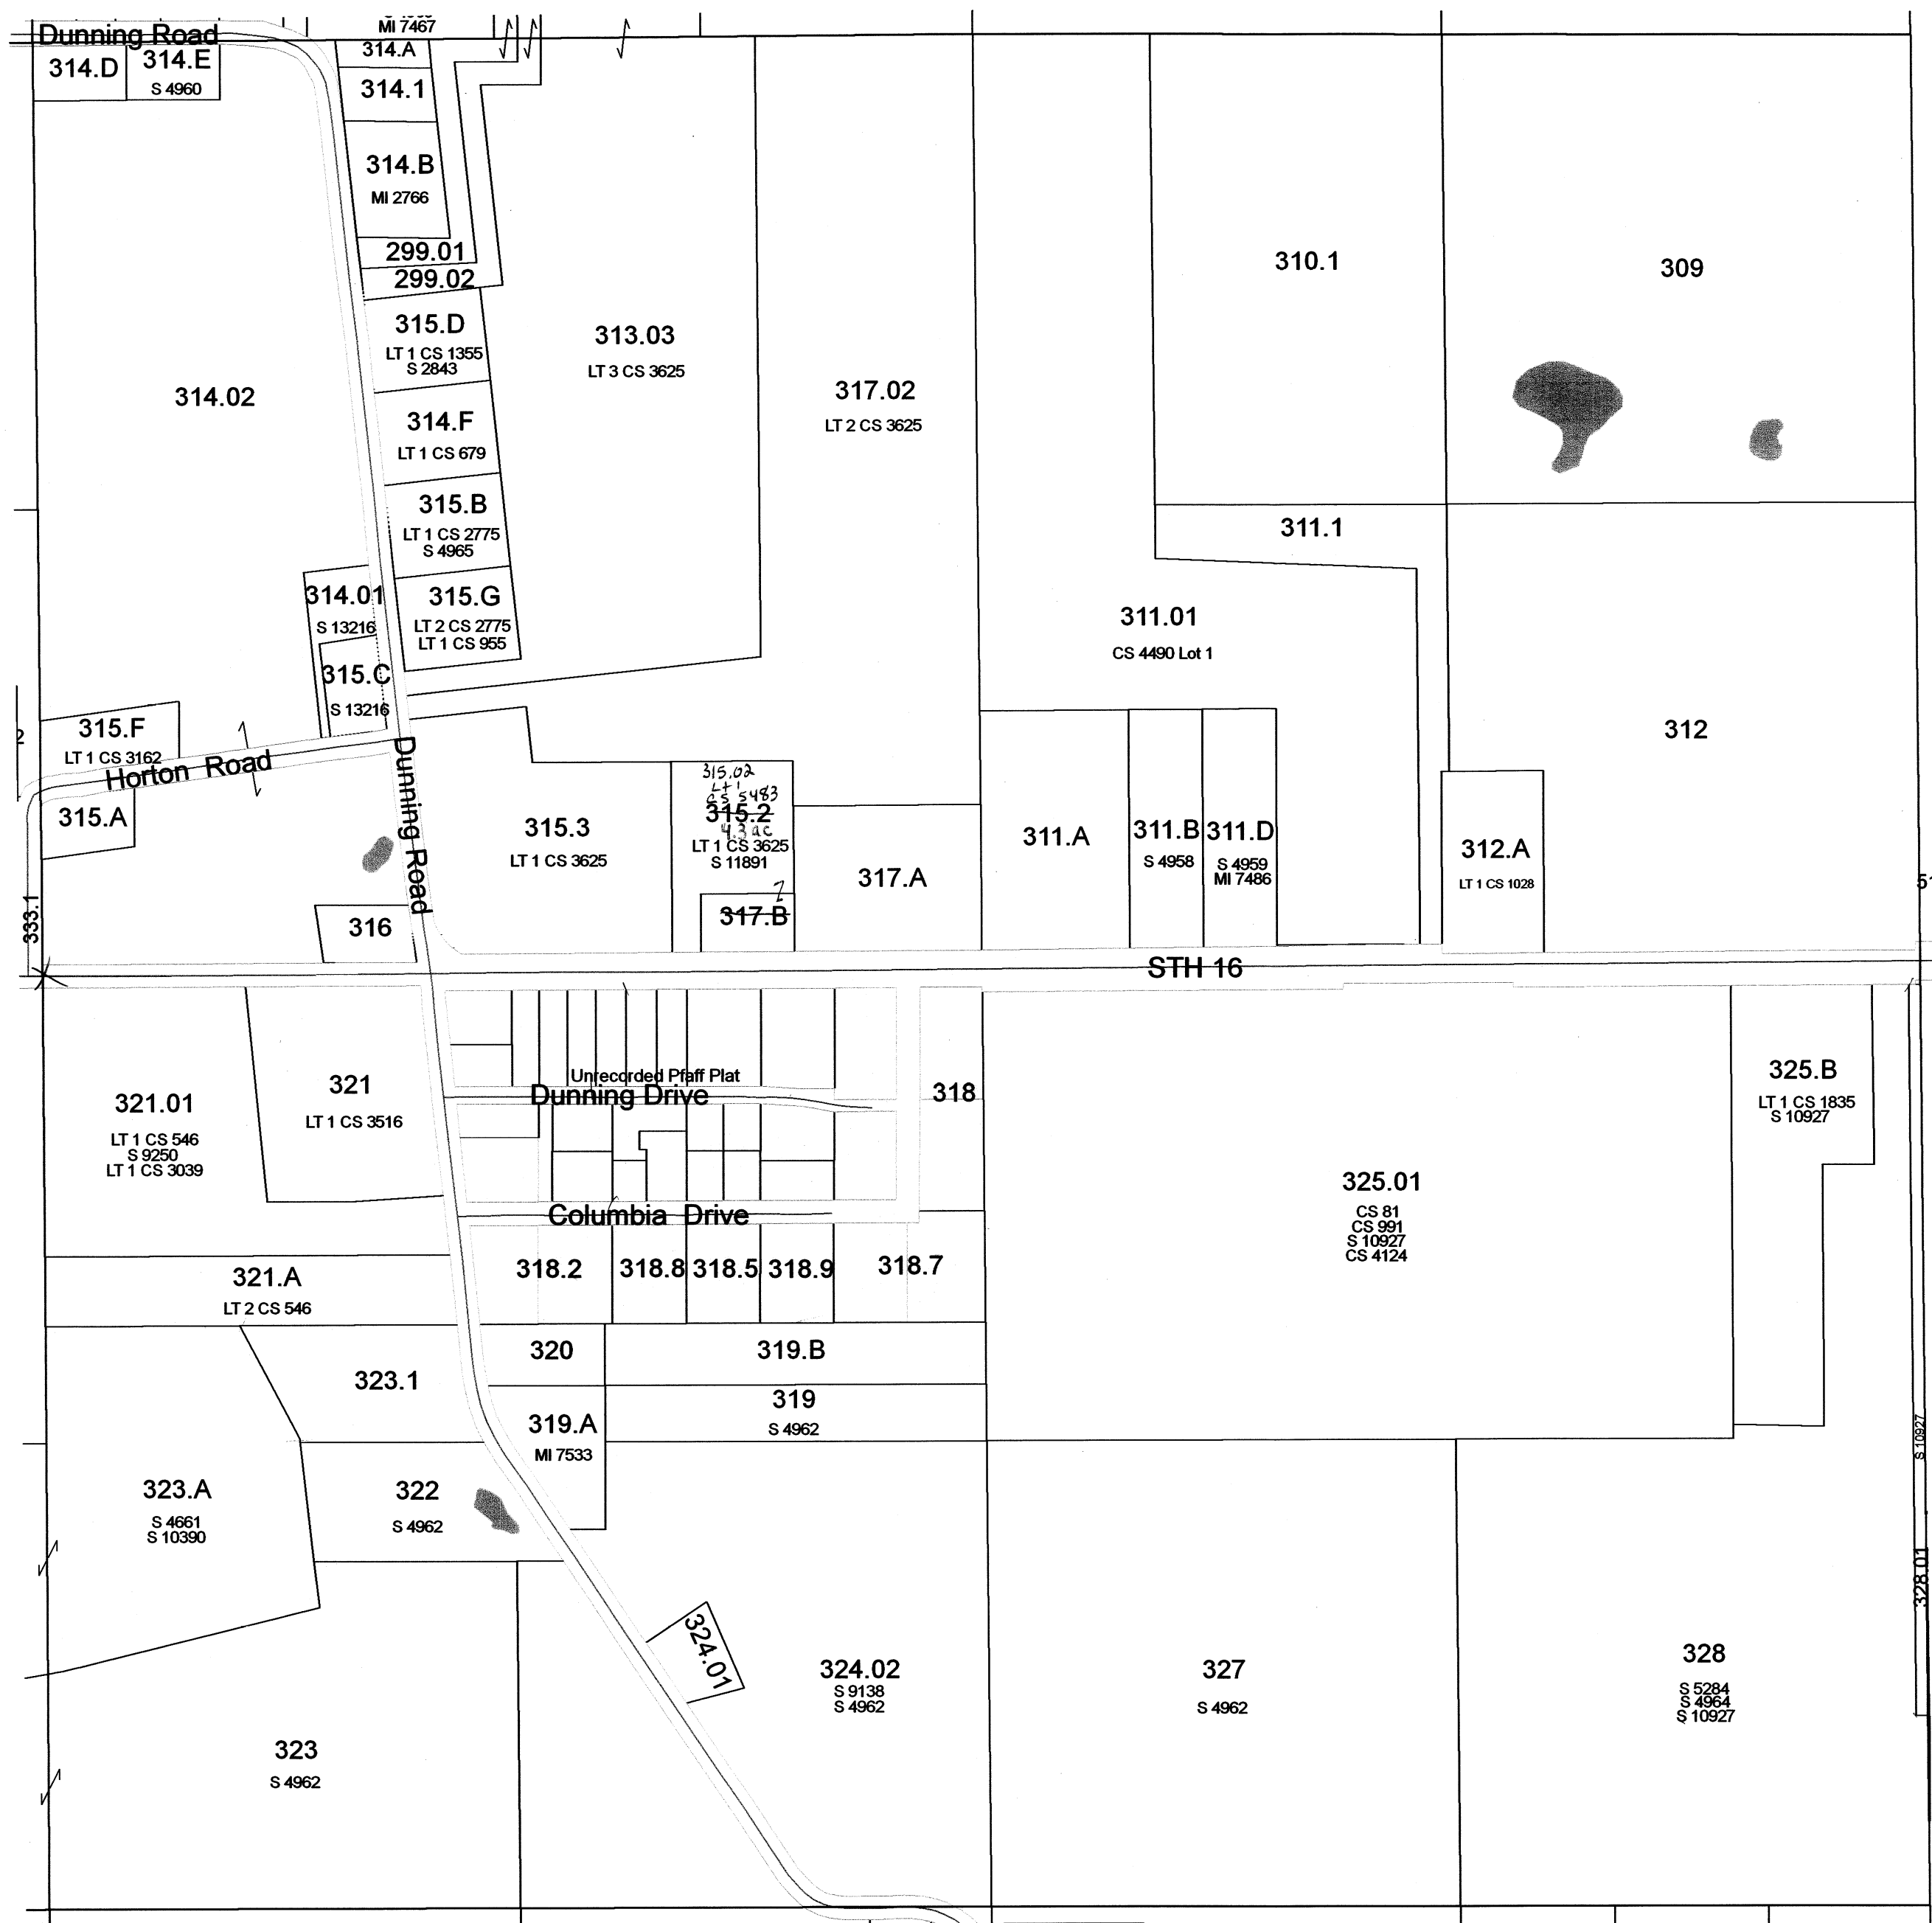

SEE SECTION 36 TOWN OF PACIFIC


REPLACED
2014

TOWN OF PACIFIC

SECTION 14 T12N R9E

1 inch = 400 feet 1:4,800

SEE SECTION 11 TOWN OF PACIFIC

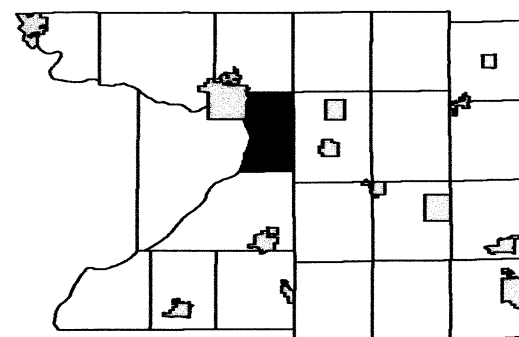

3	2	1
10	11	12
15	16	13
22	23	24
28	27	26
33	34	35

SEE SECTION 15 TOWN OF PACIFIC

SEE SECTION 13 TOWN OF PACIFIC



REPLACED
2014


SEE SECTION 23 TOWN OF PACIFIC

TOWN OF PACIFIC

SECTION 1 T12N R9E


1 inch = 200 feet 1:2,400

SEE SECTION 01 TOWN OF PACIFIC

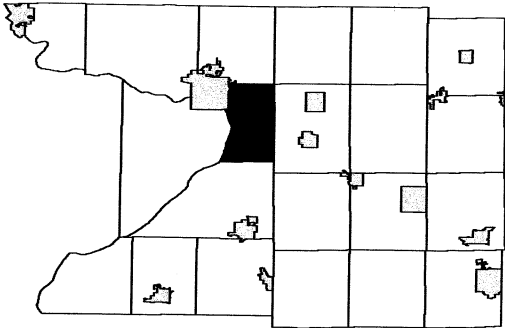

	3	2	
9	10	11	12
16	15	14	13
	22	23	24
28	27	26	25
33	34	35	36


SEE SECTION 01 TOWN OF PACIFIC

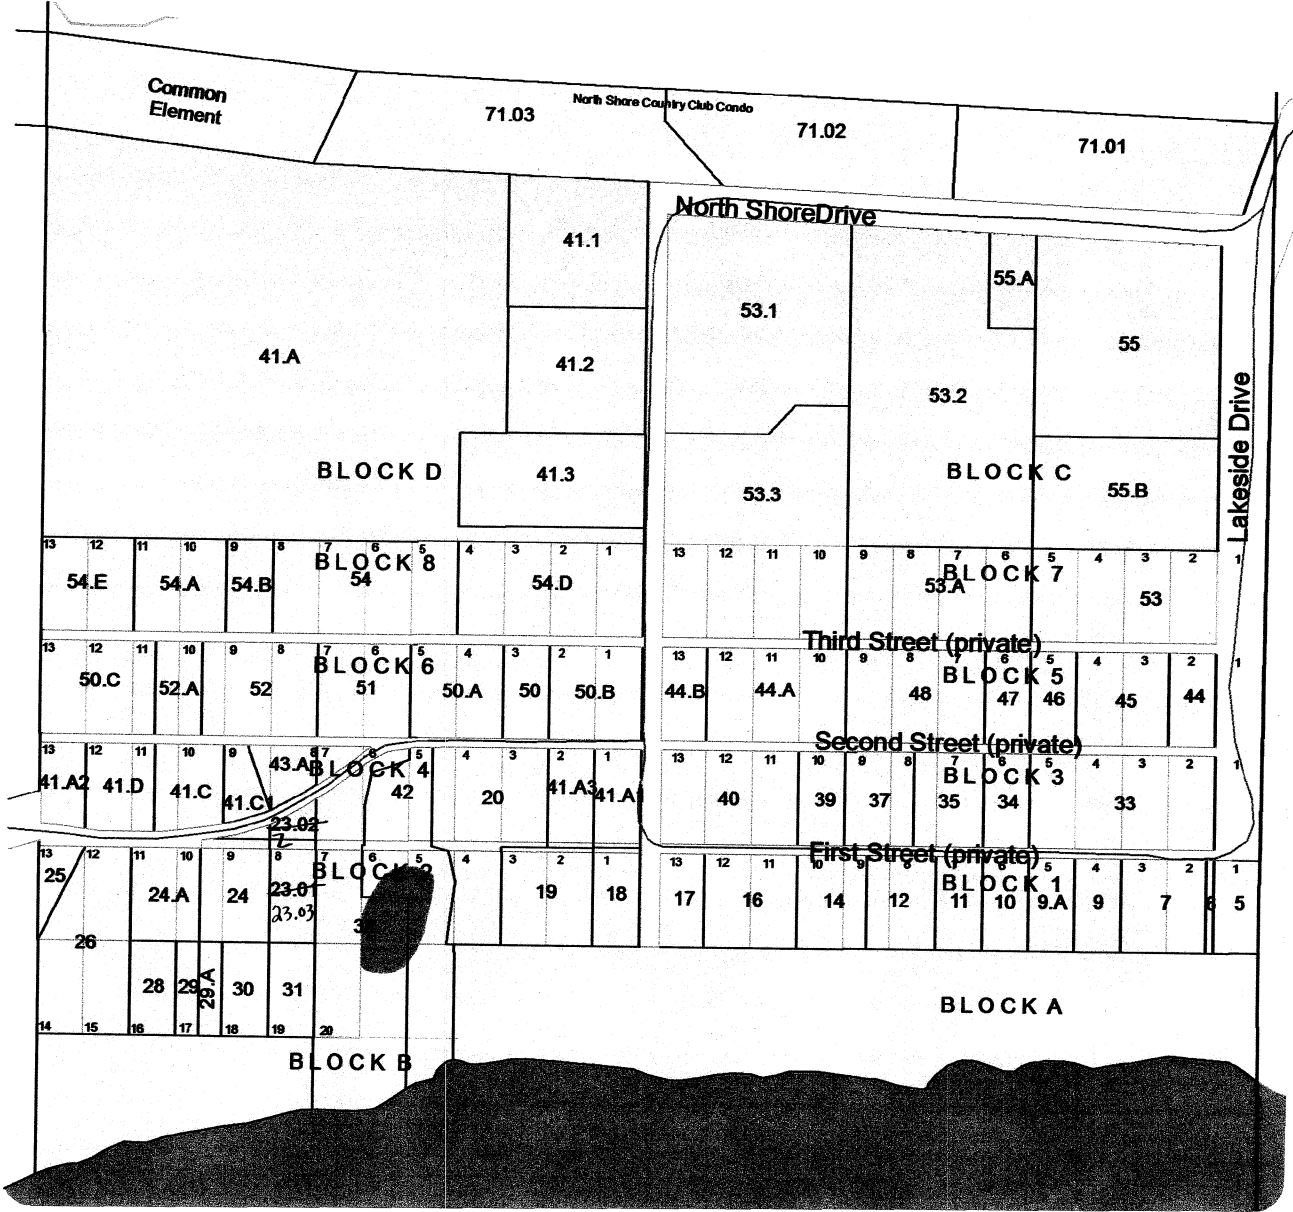

SEE SECTION 01 TOWN OF PACIFIC


SEE SECTION 01 TOWN OF PACIFIC

TOWN OF PACIFIC

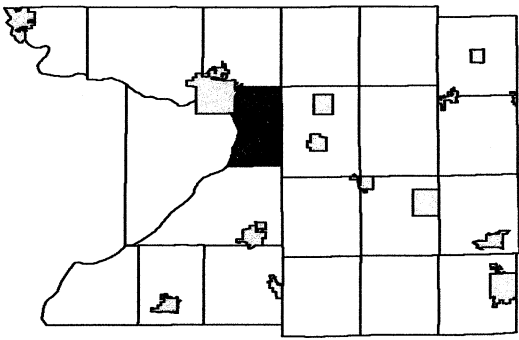

	3	2	1
9	10	11	12
6	15	14	13
	22	23	24
28	27	26	25
33	34	35	36

SEE TOWN OF FORT WINNEBAGO

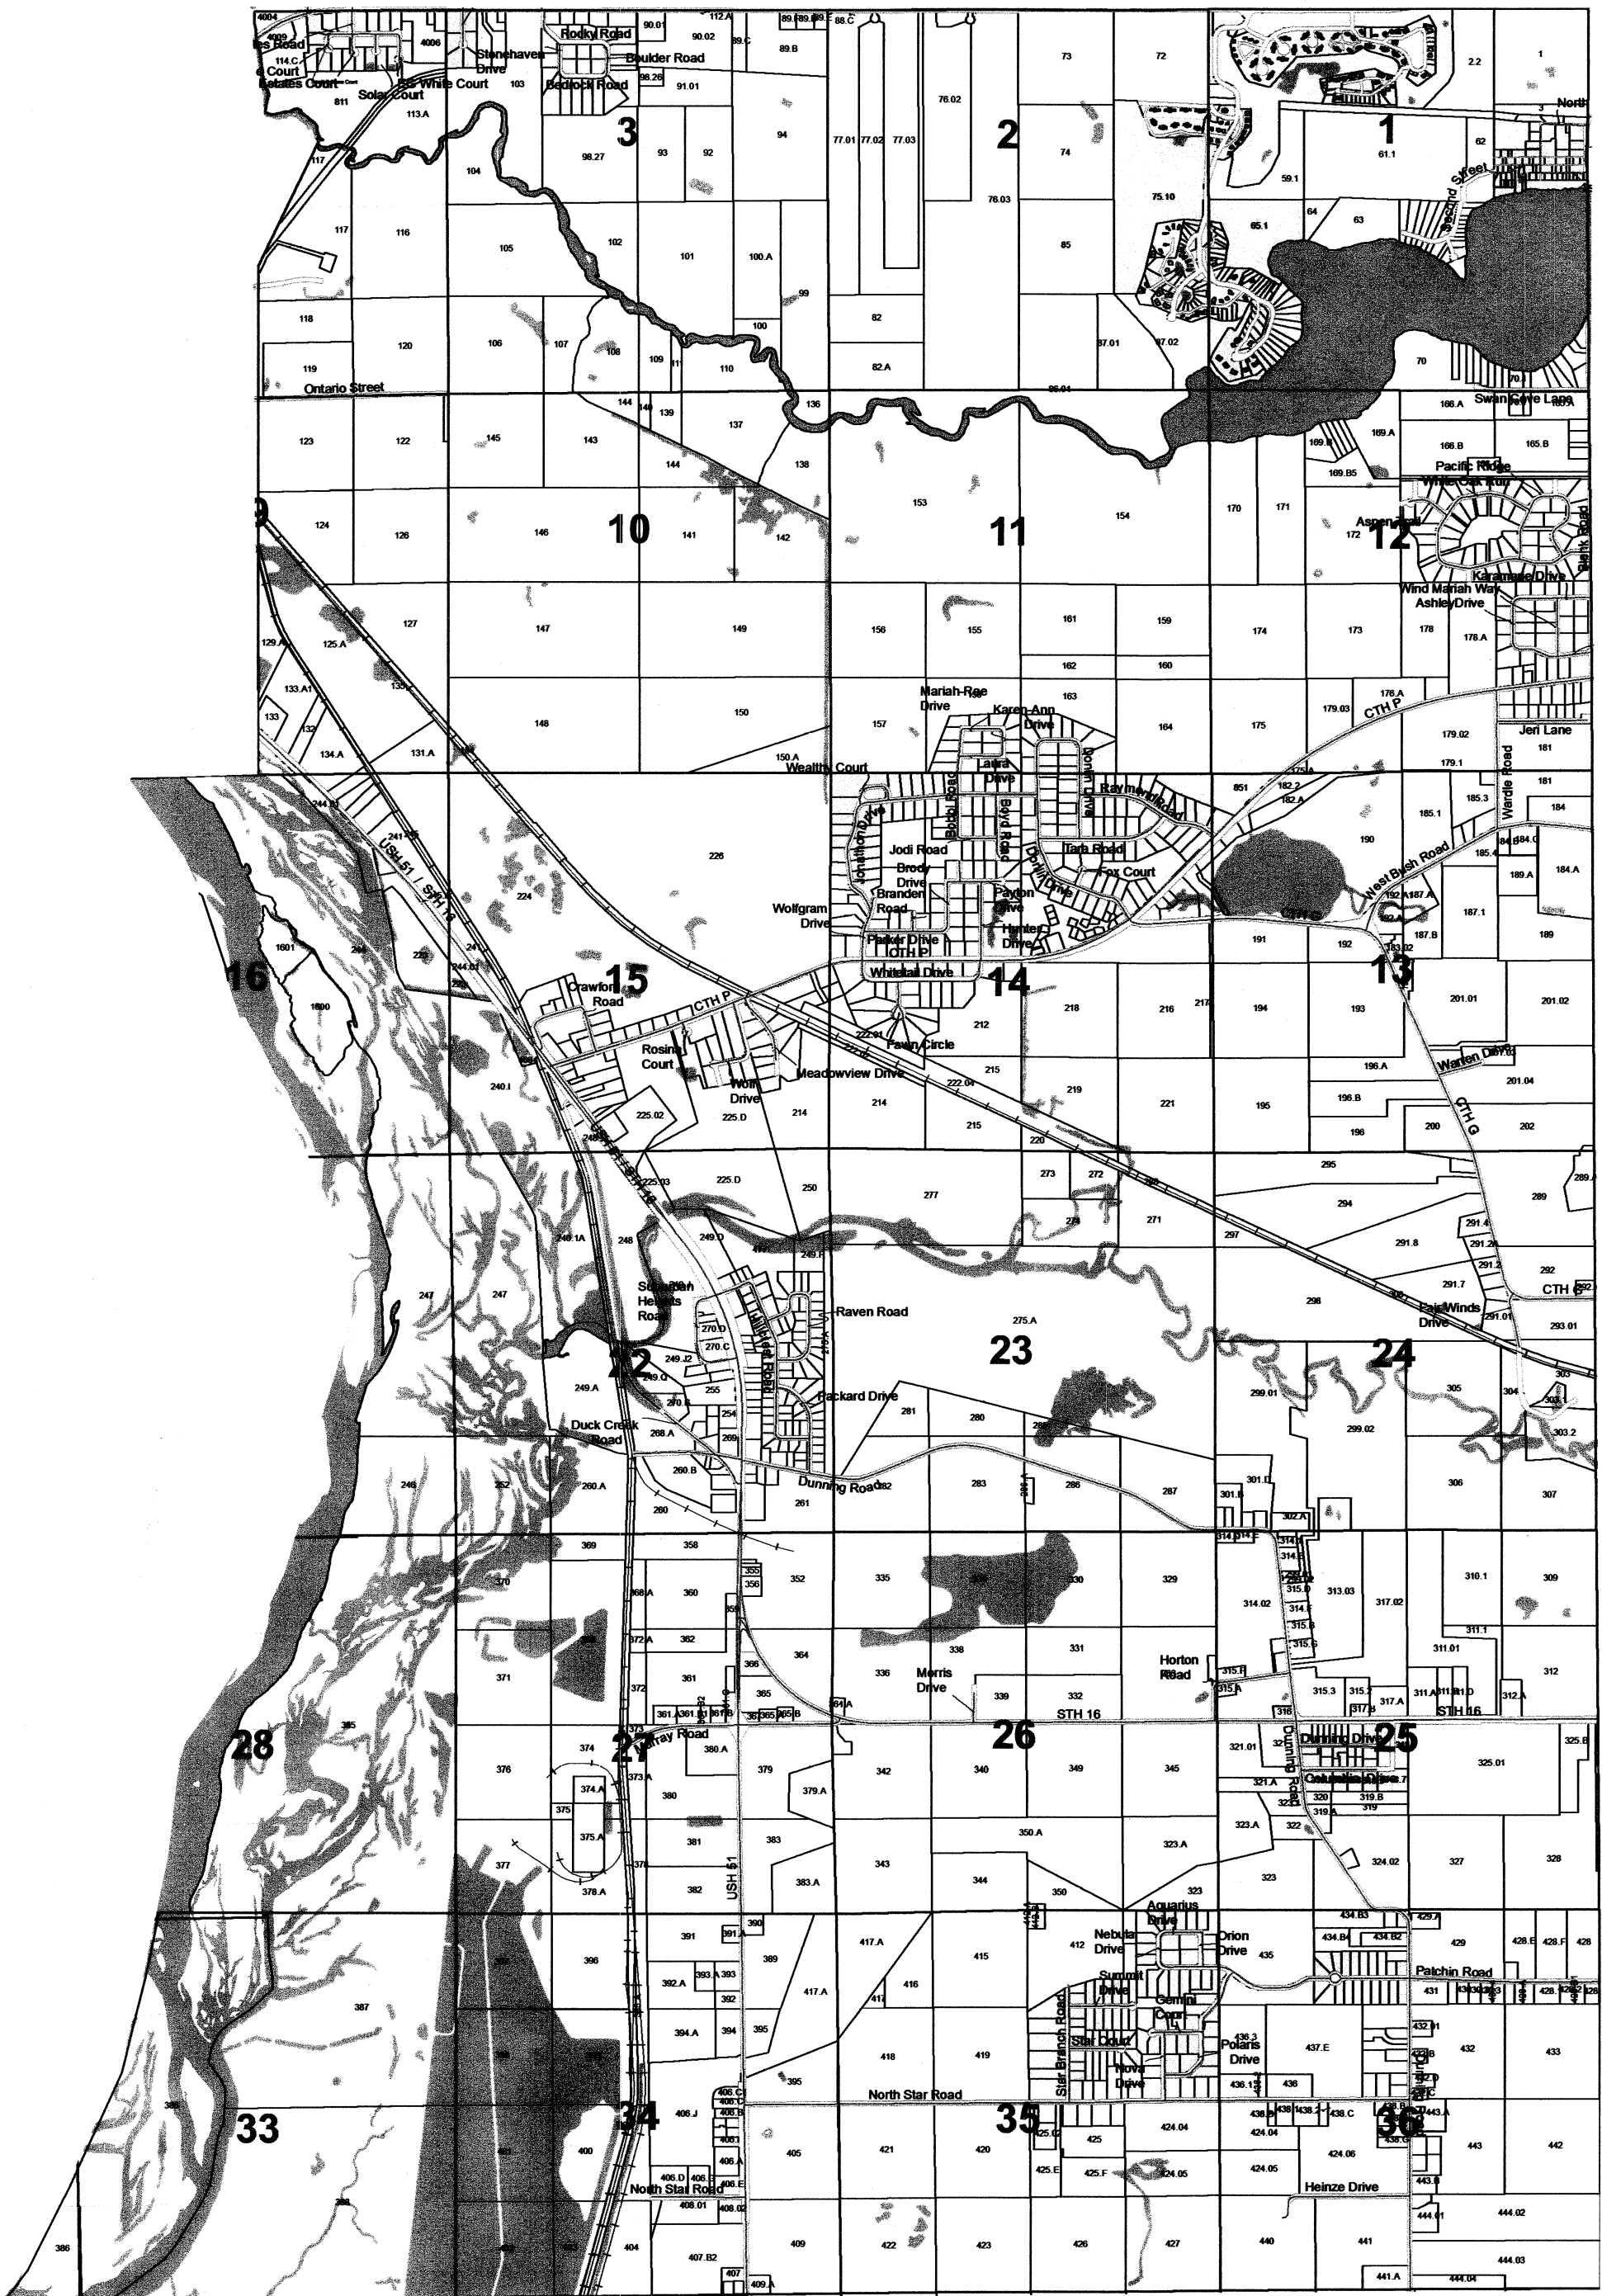

SEE TOWN OF CALEDONIA

SEE TOWN OF WOCENA

SEE TOWN OF DEKORRA

REPLACED
2014