


VILLAGE OF FRIESLAND

SECTION 16 T.13N. R.12E.


Replaced
2000

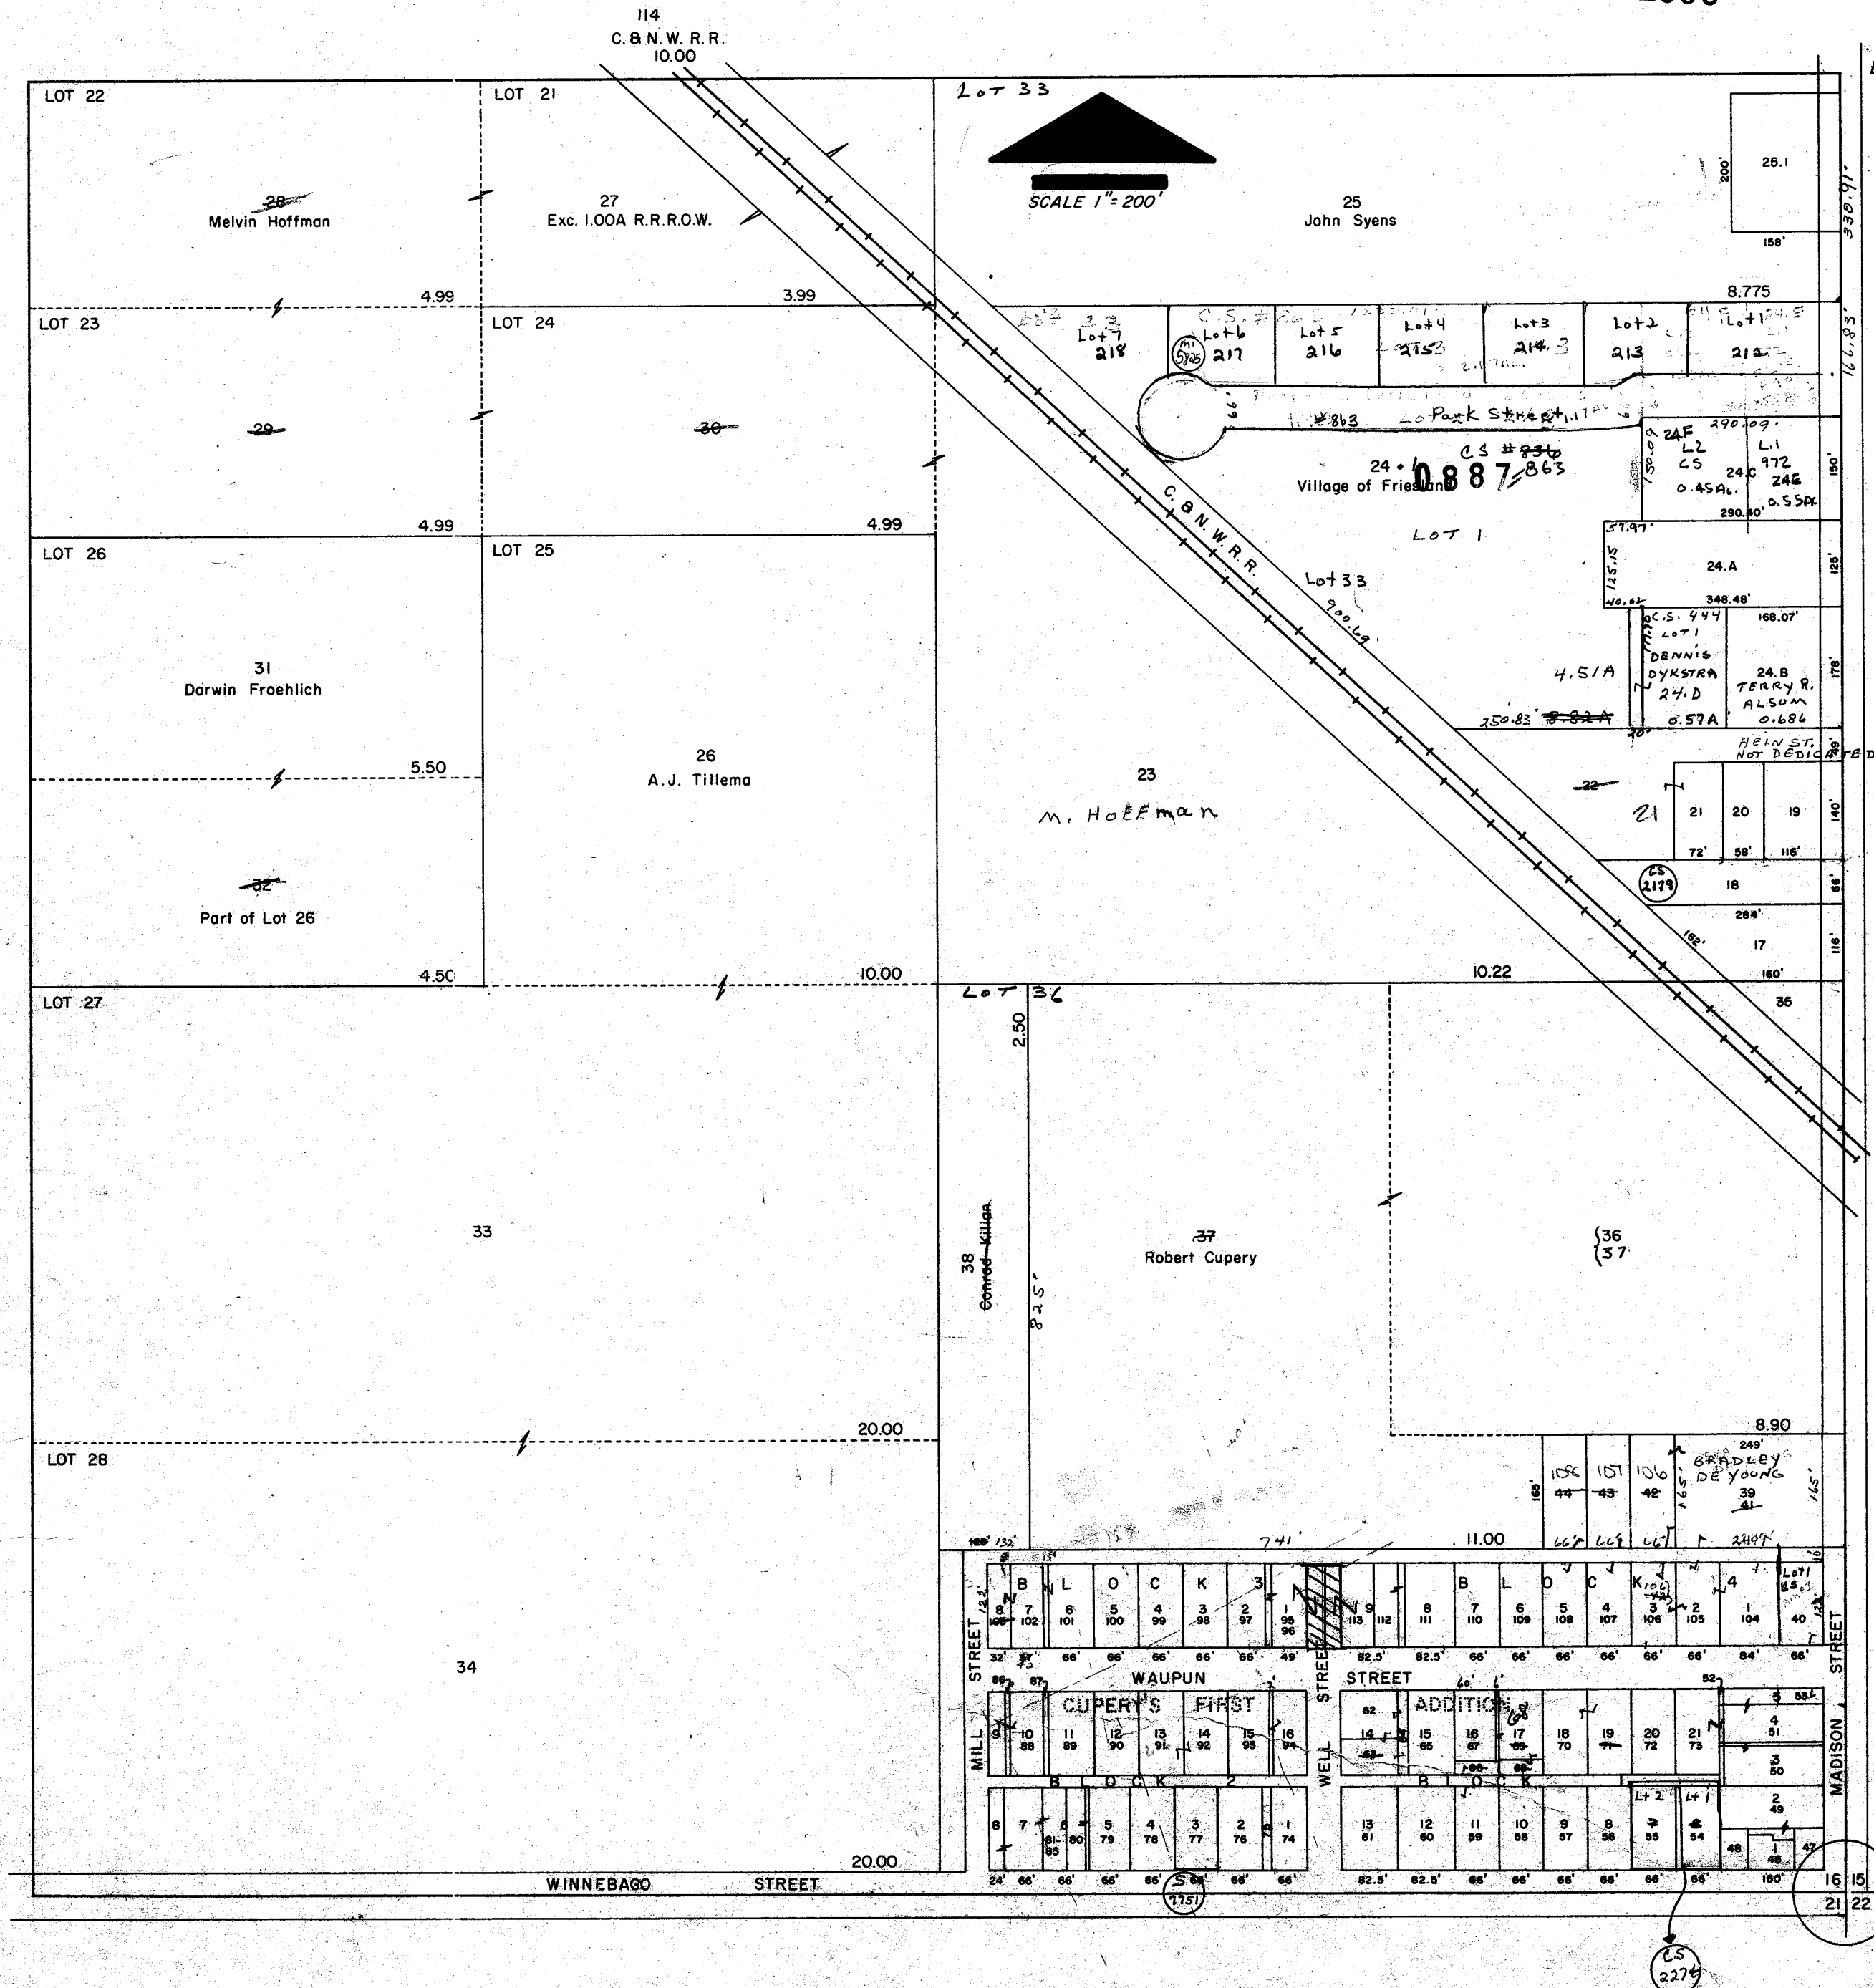

VILLAGE OF FRIESLAND

SECTION 15 T.13N. R.12E. SW¹/₄

Replaced
2000

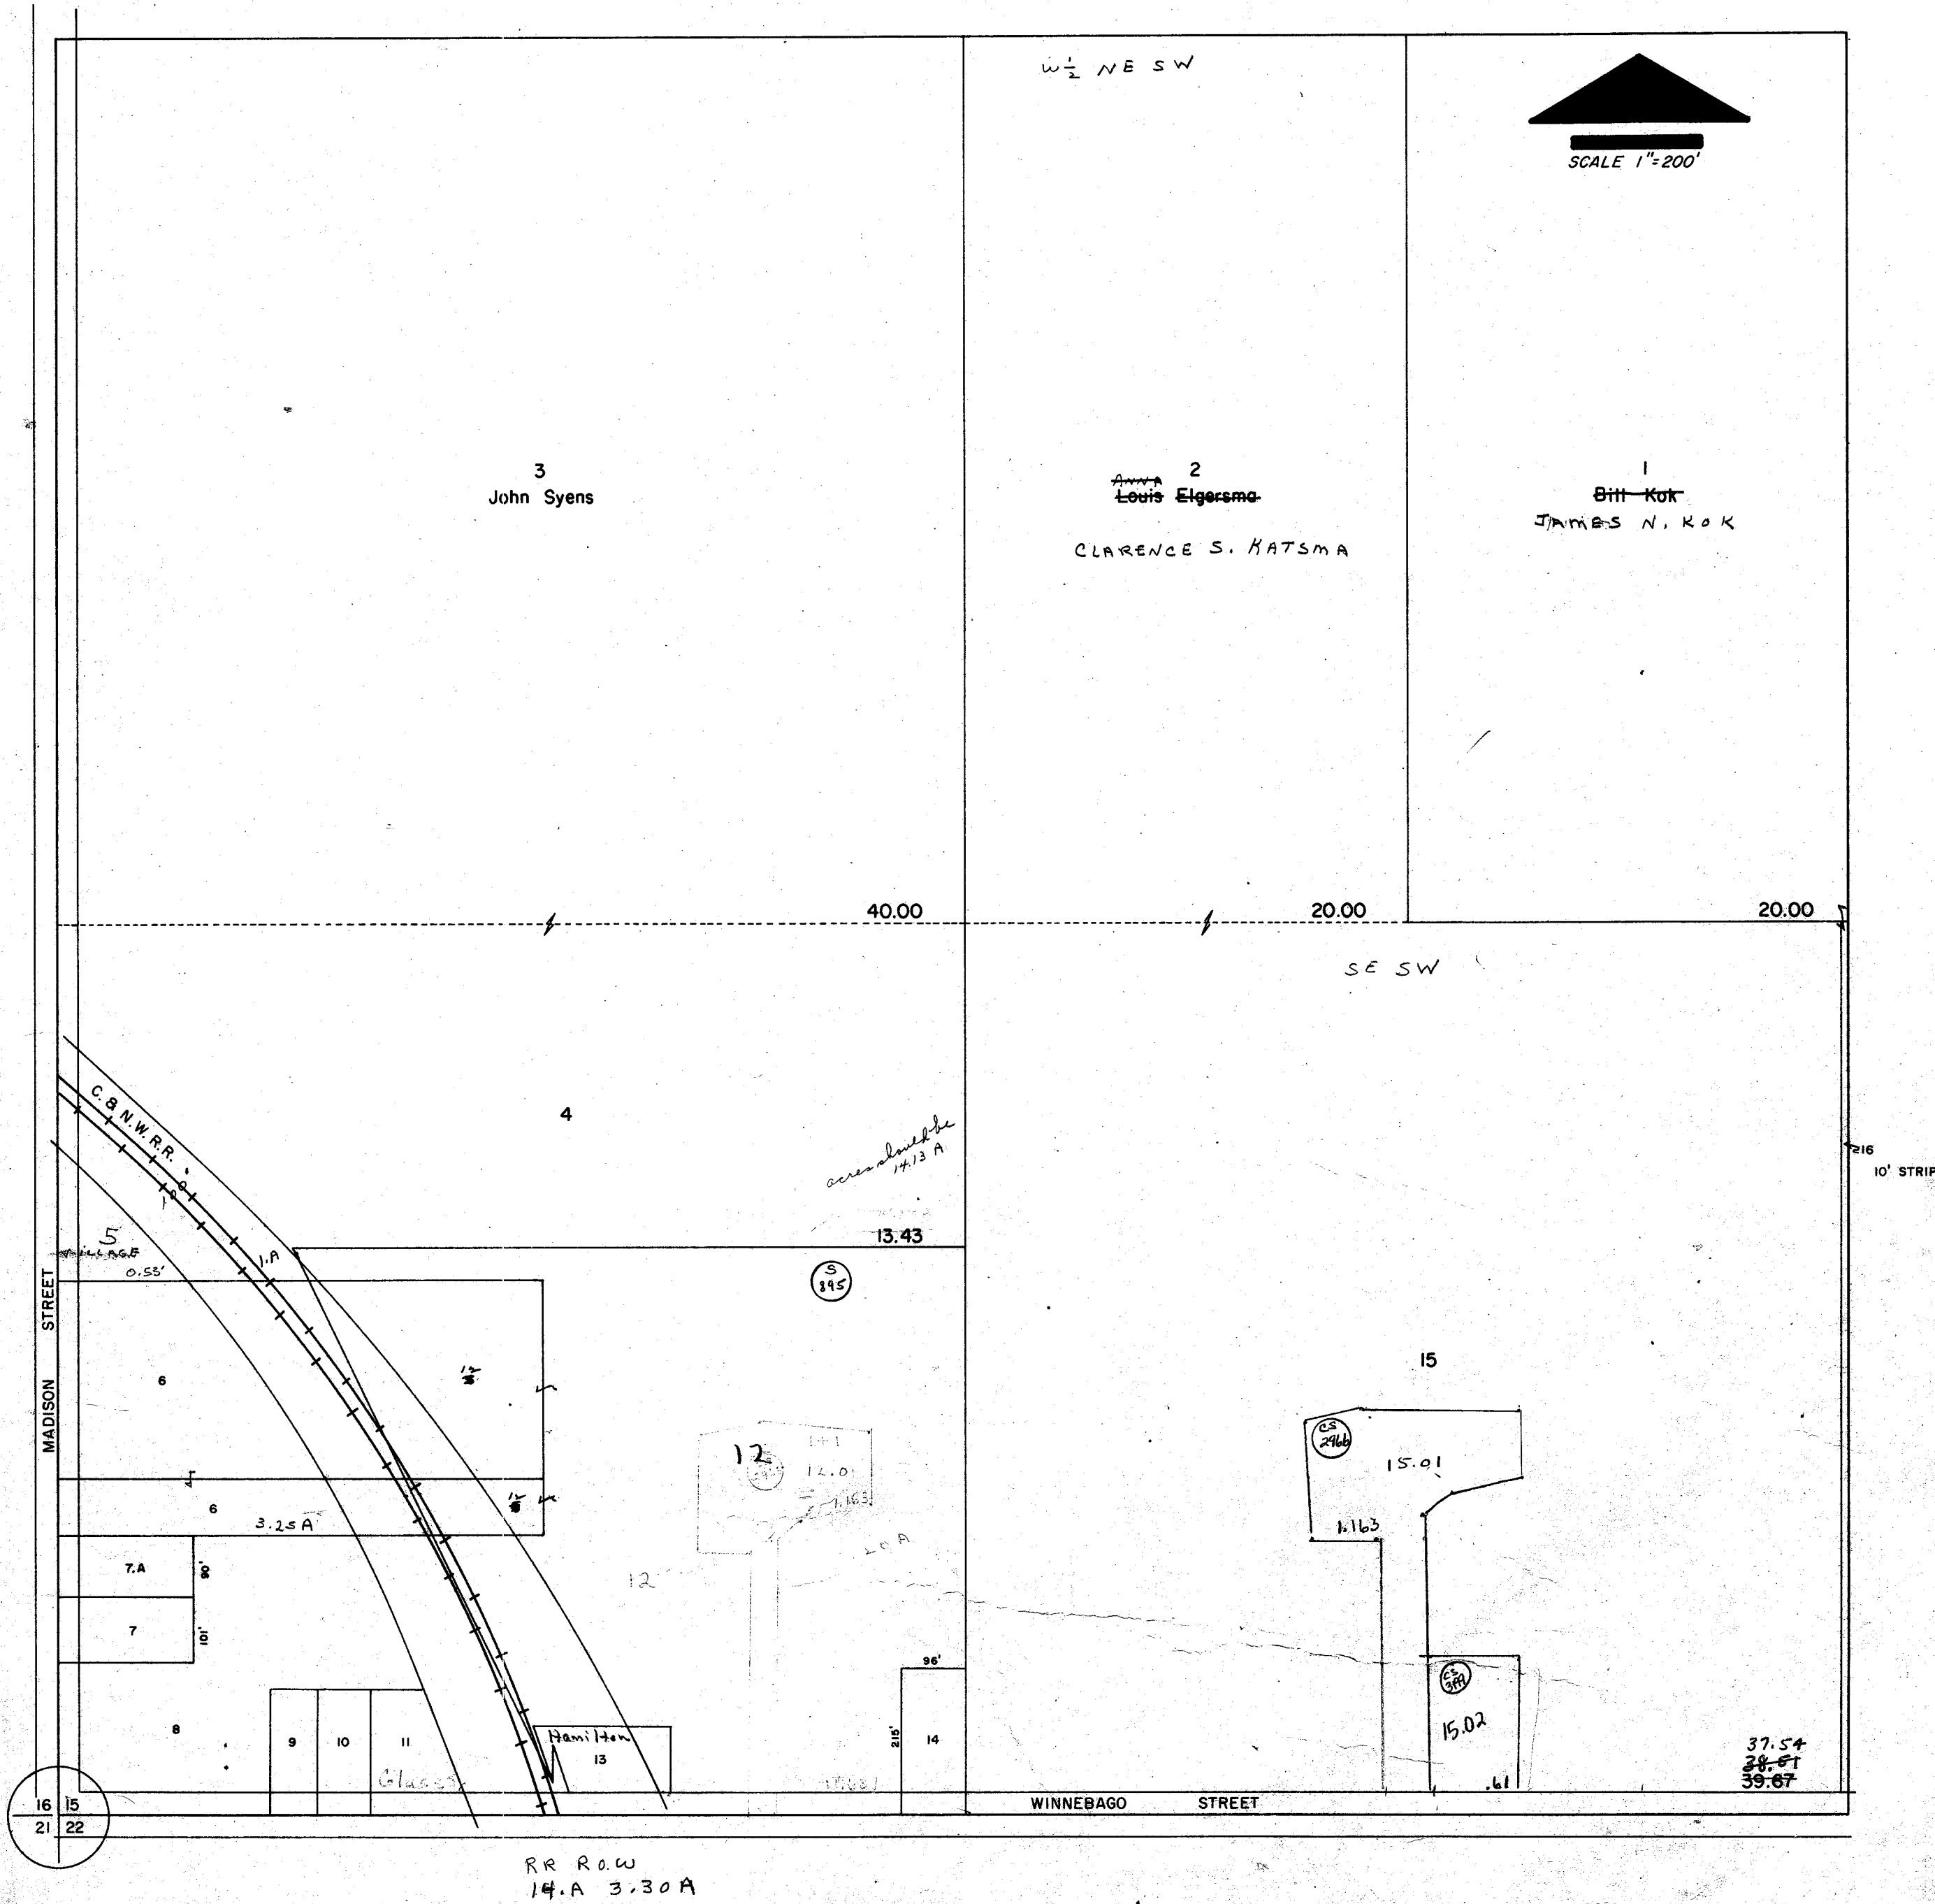

Replaced
2000

WINNEBAGO STREET

SCALE 1" = 200'

127
~~John Smedema~~
BRADLEY KEMIND

115
Margaret Froehlich
JESS

128
John Smedema

129
~~Harold Tessmann~~
WALTER TESSMANN, JR.

MARTHA
KOK

129. A

164'

265'

1

Sheet 3 of 4


VILLAGE OF FRIESLAND


NW 1/4 SECTION 22 T.13N. R.12E.

0896 Composite

Replaced
2000

15
22

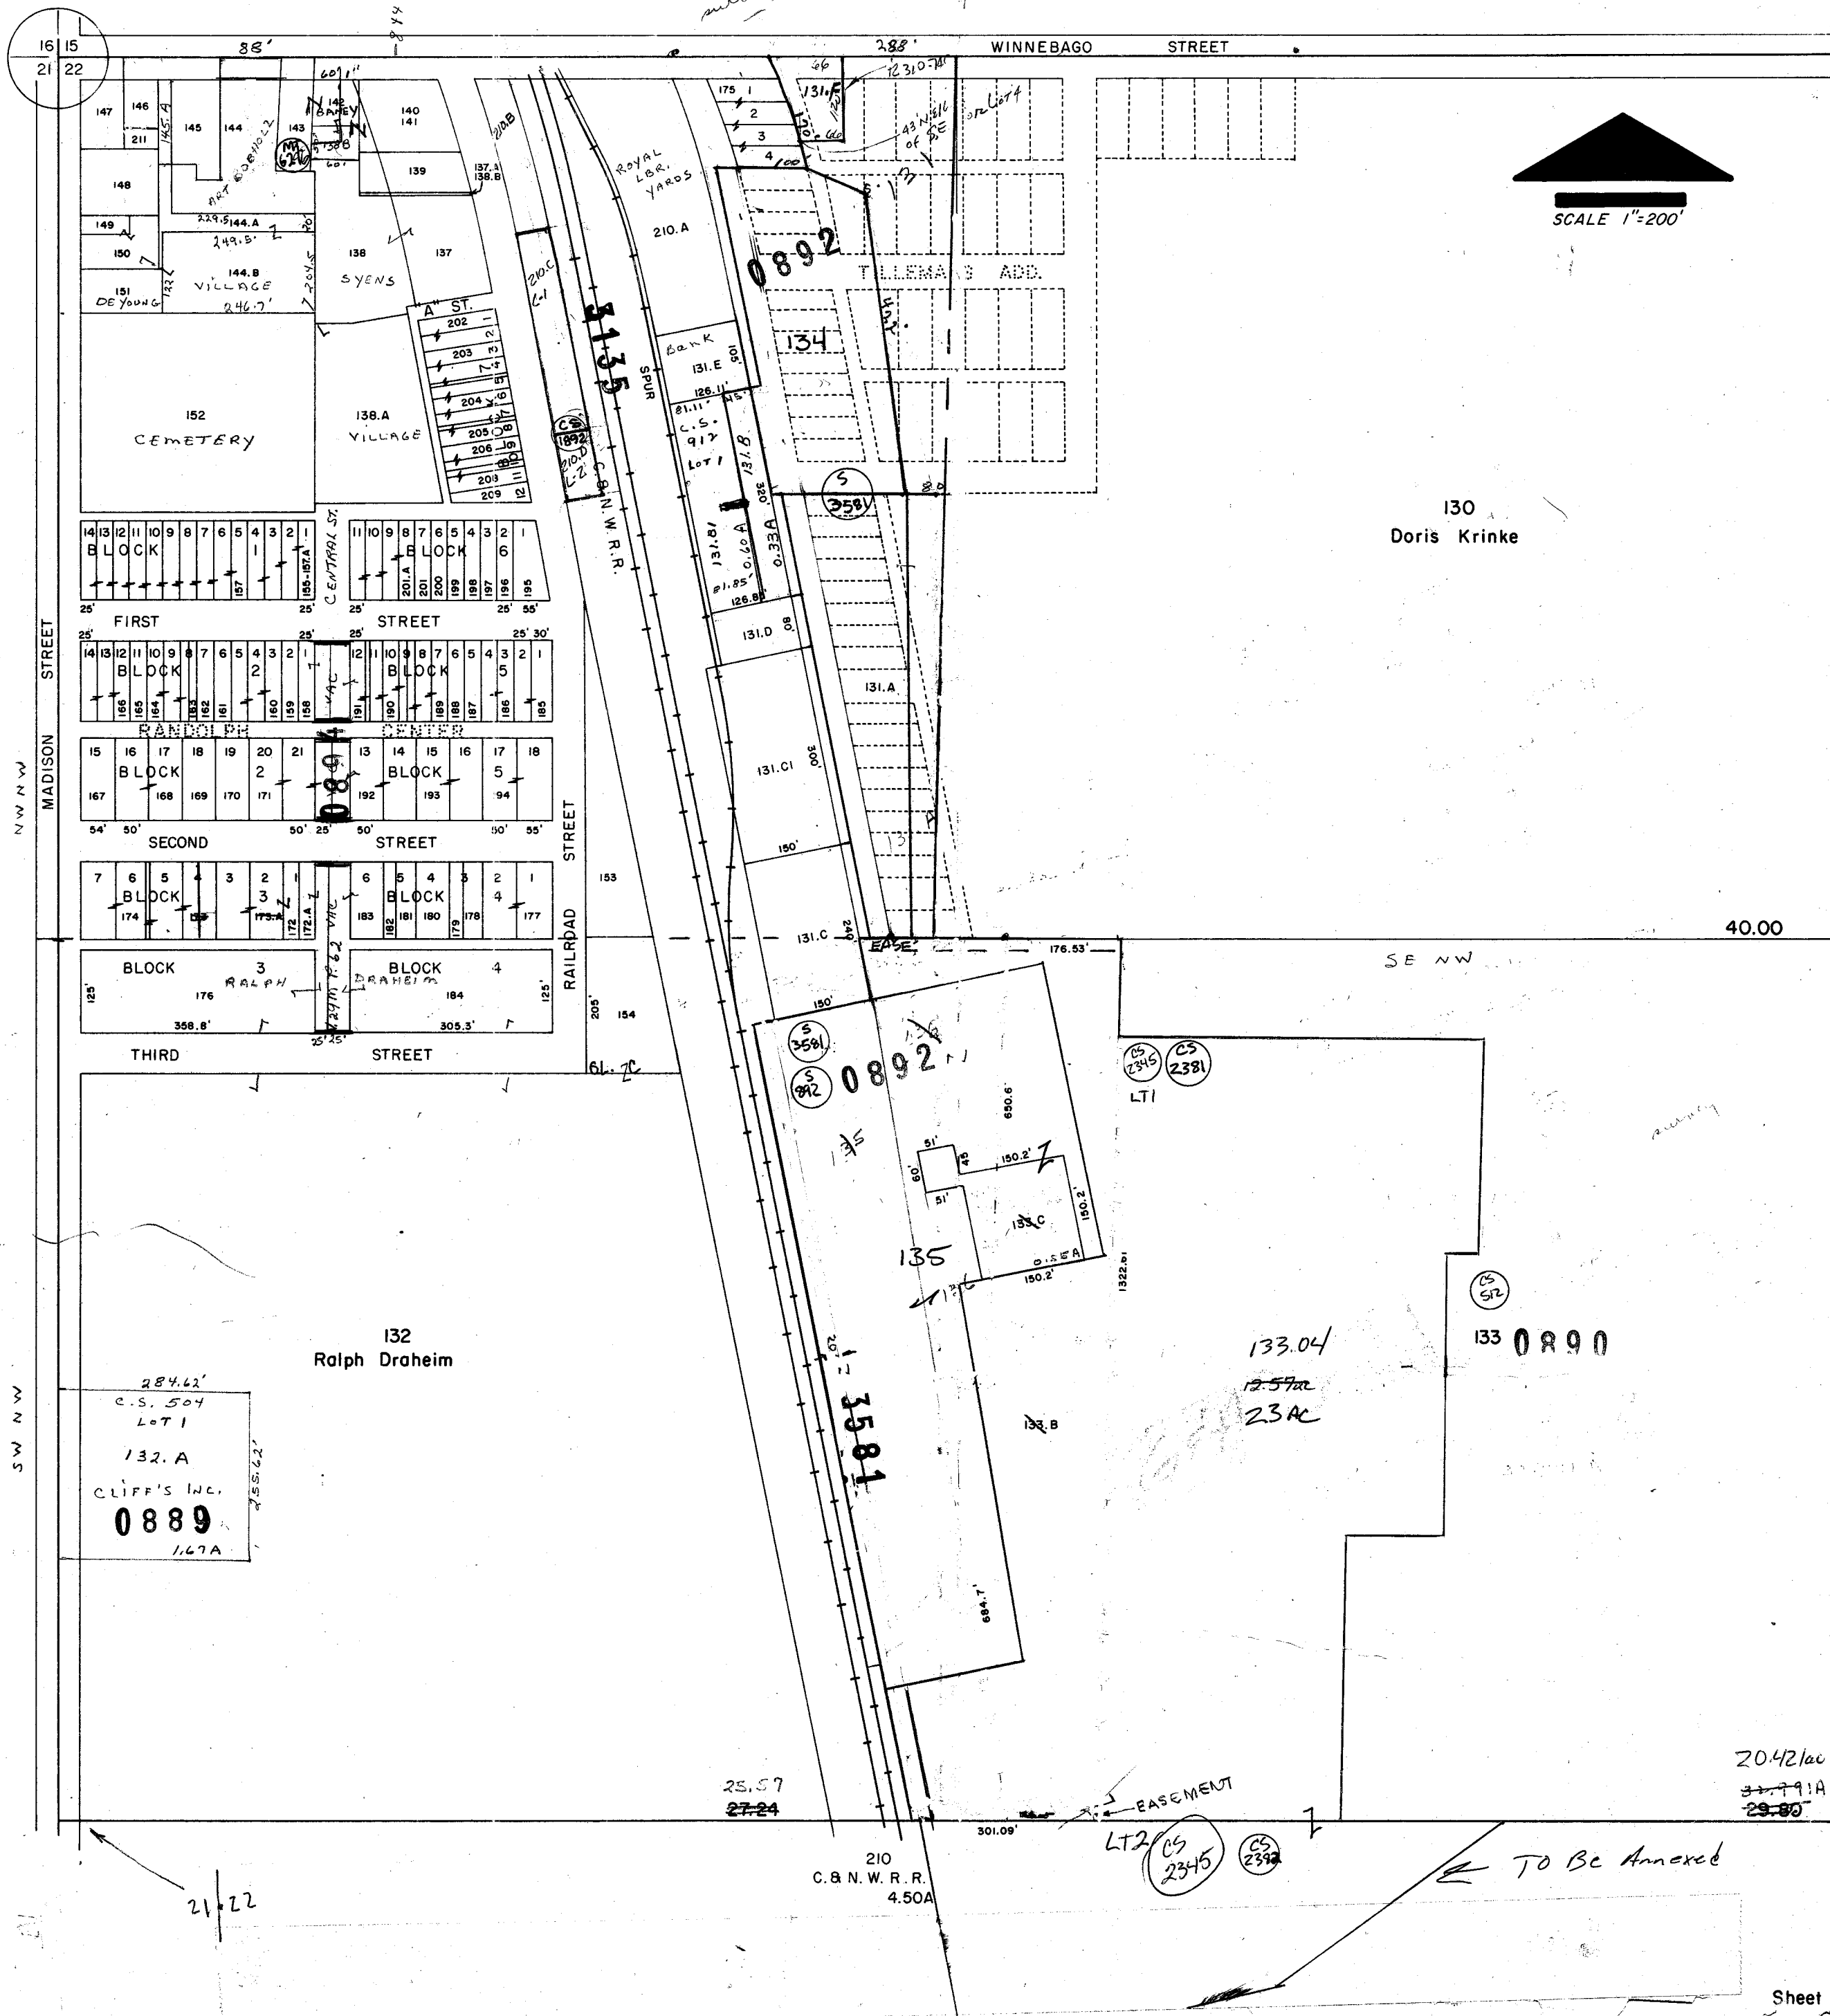

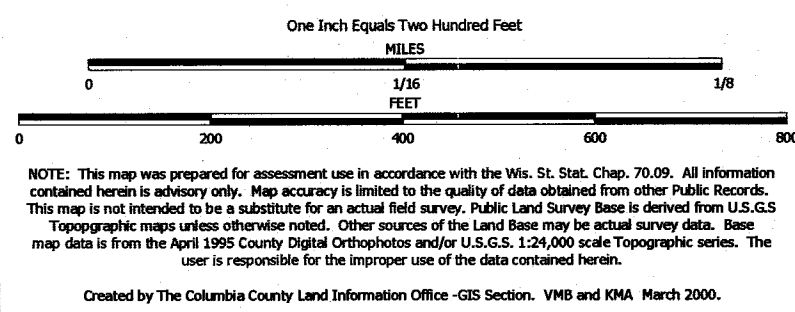


TAX PARCEL MAP


VILLAGE of FRIESLAND

TOWN 13 NORTH RANGE 12 EAST
COLUMBIA COUNTY, WISCONSIN

Replaced
2003

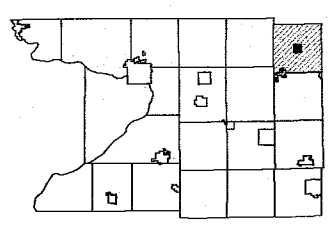


6	5	4	3	2	1
7	8	9	10	11	12
18	17			14	13
19	20			23	24
30	29	28	27	26	25
31	32	33	34	35	36

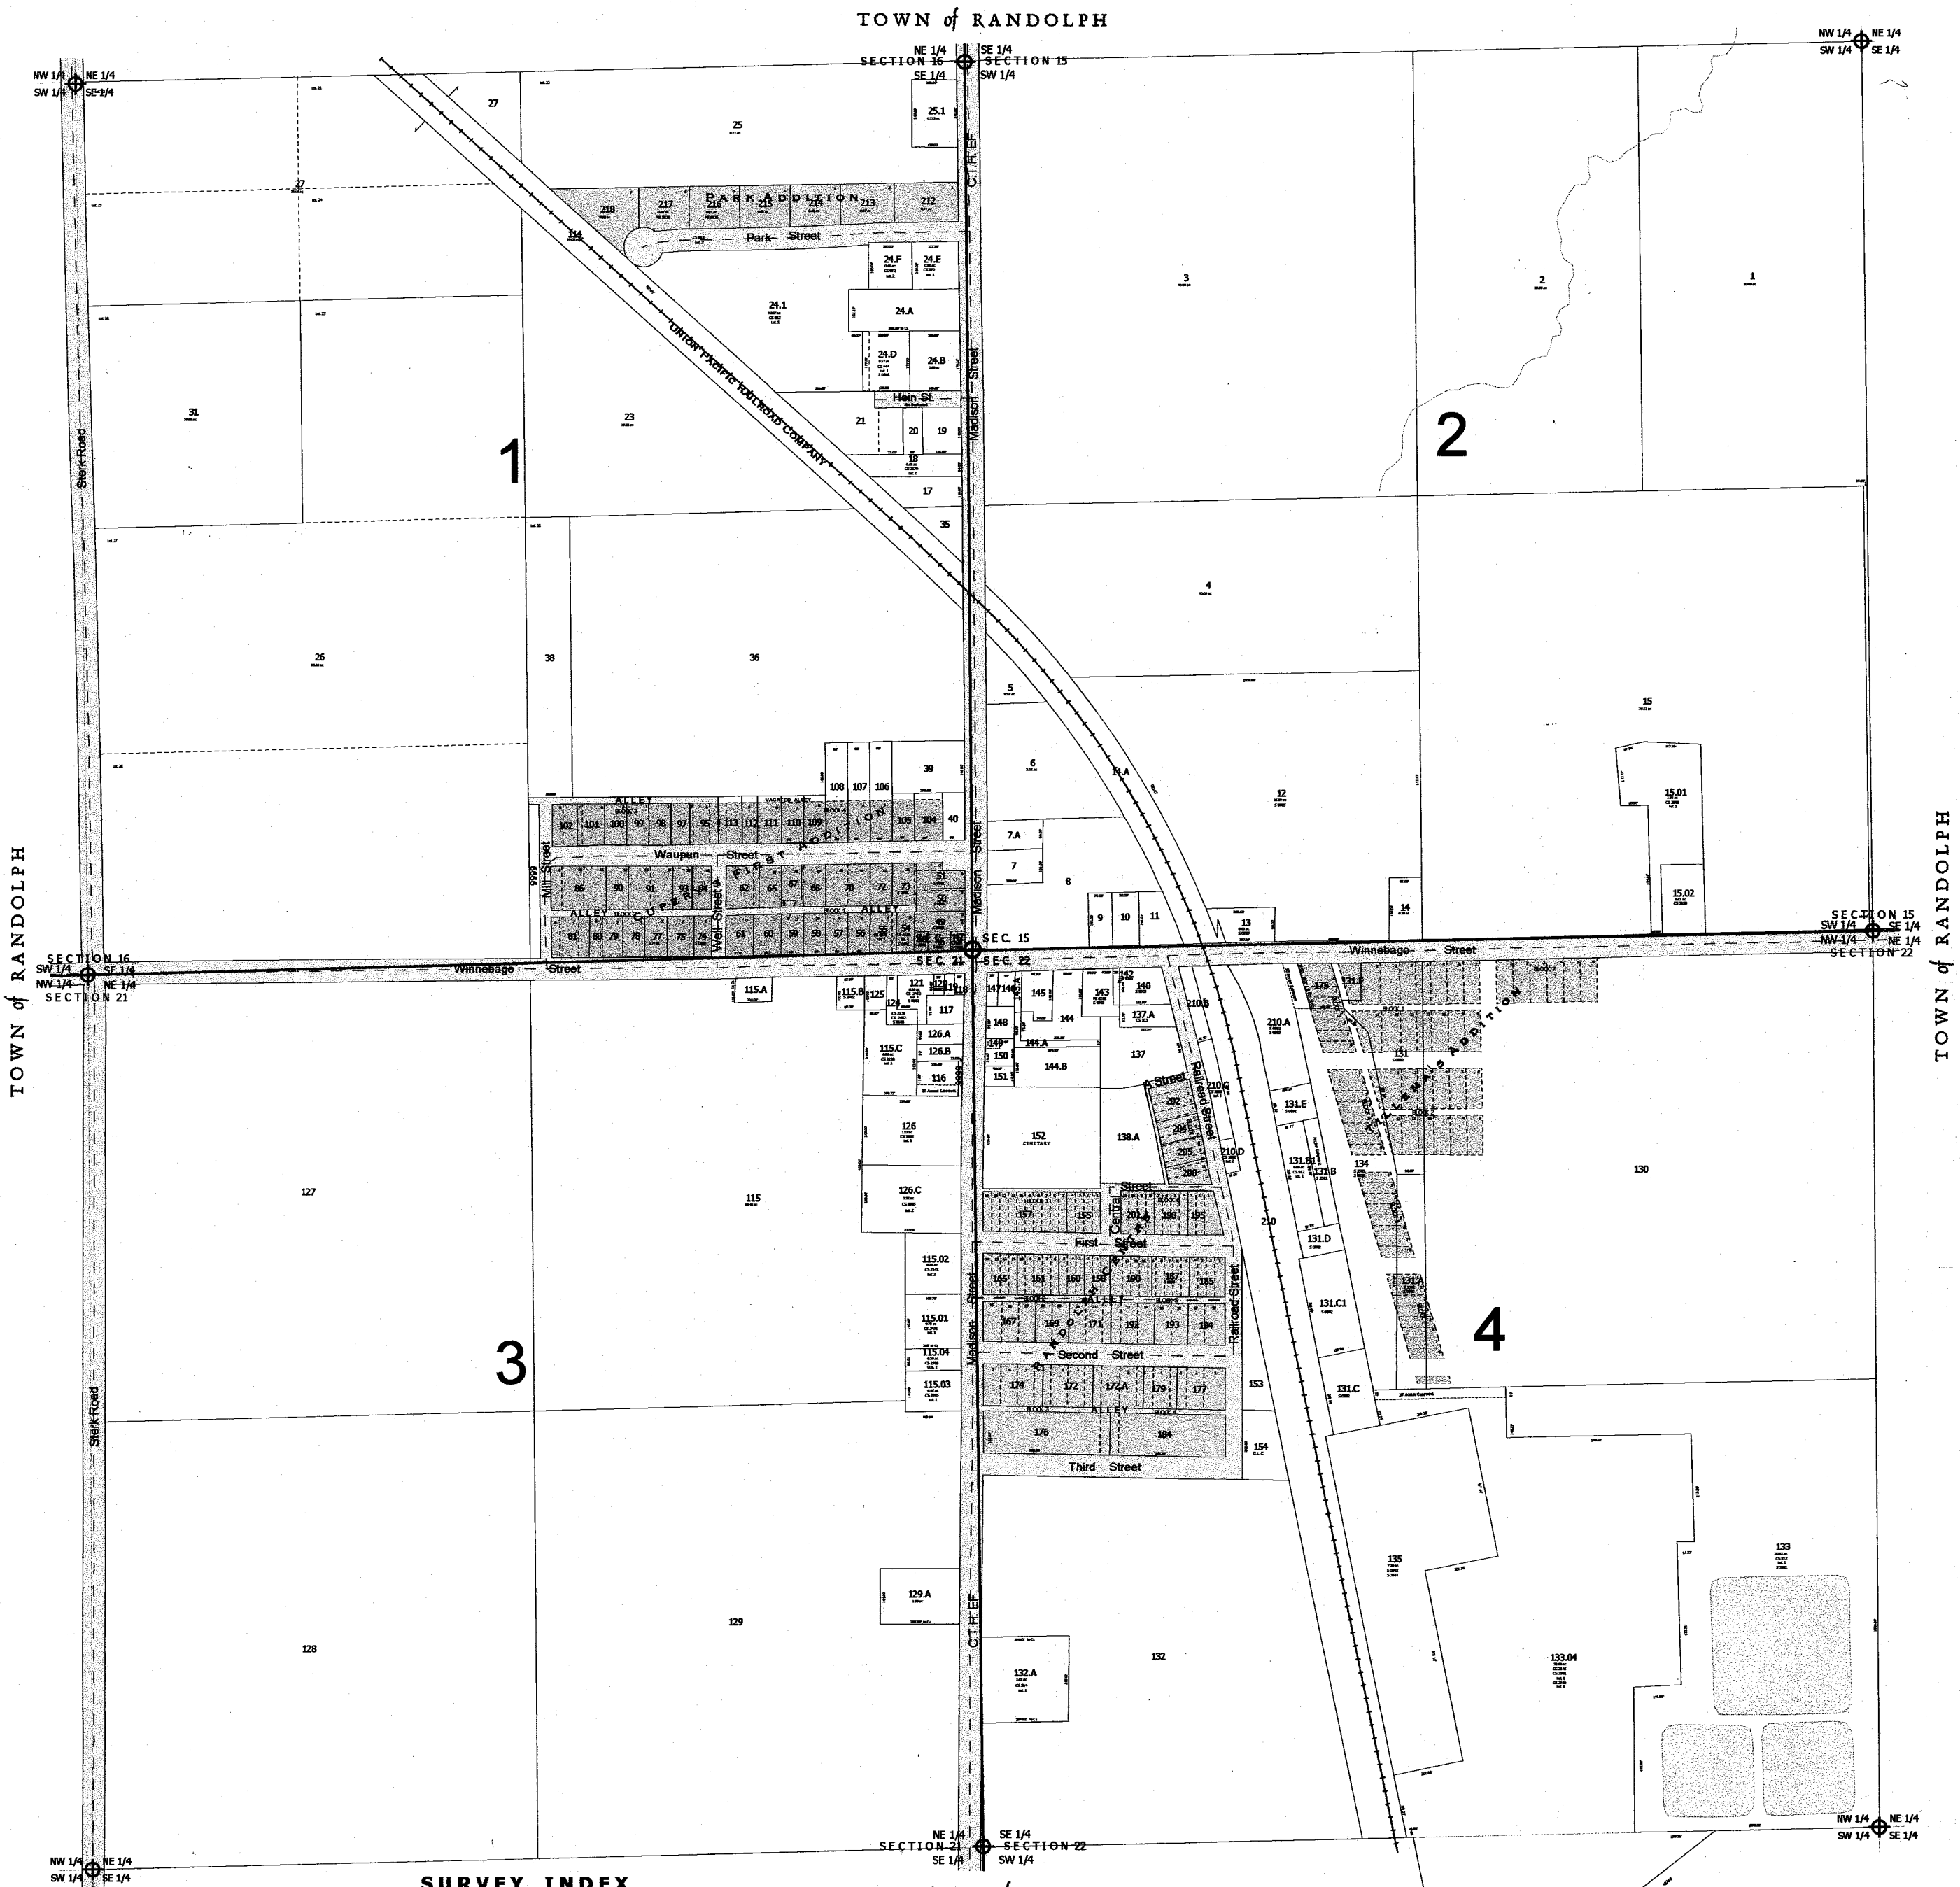

SURVEY INDEX	
CUPERY'S FIRST ADDITION	REGISTER OF DEEDS - SHEET 18 B
PARK ADDITION	R.O.D. - 184 B
RANDOLPH CENTRE	R.O.D. - 19
TILLEMA'S ADDITION	R.O.D. - 28
COMPOSITE VILLAGE MAP (1972)	S 0896

9999 - This number is used to represent tax parcels or a portion of a tax parcel that requires additional research to determine accurate boundaries and/or ownership.


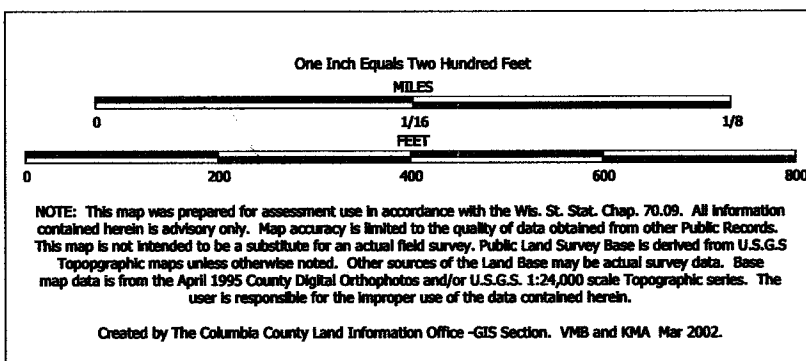


TAX PARCEL MAP


VILLAGE of FRIESLAND

TOWN 13 NORTH RANGE 12 EAST
COLUMBIA COUNTY, WISCONSIN

Replaced
2003

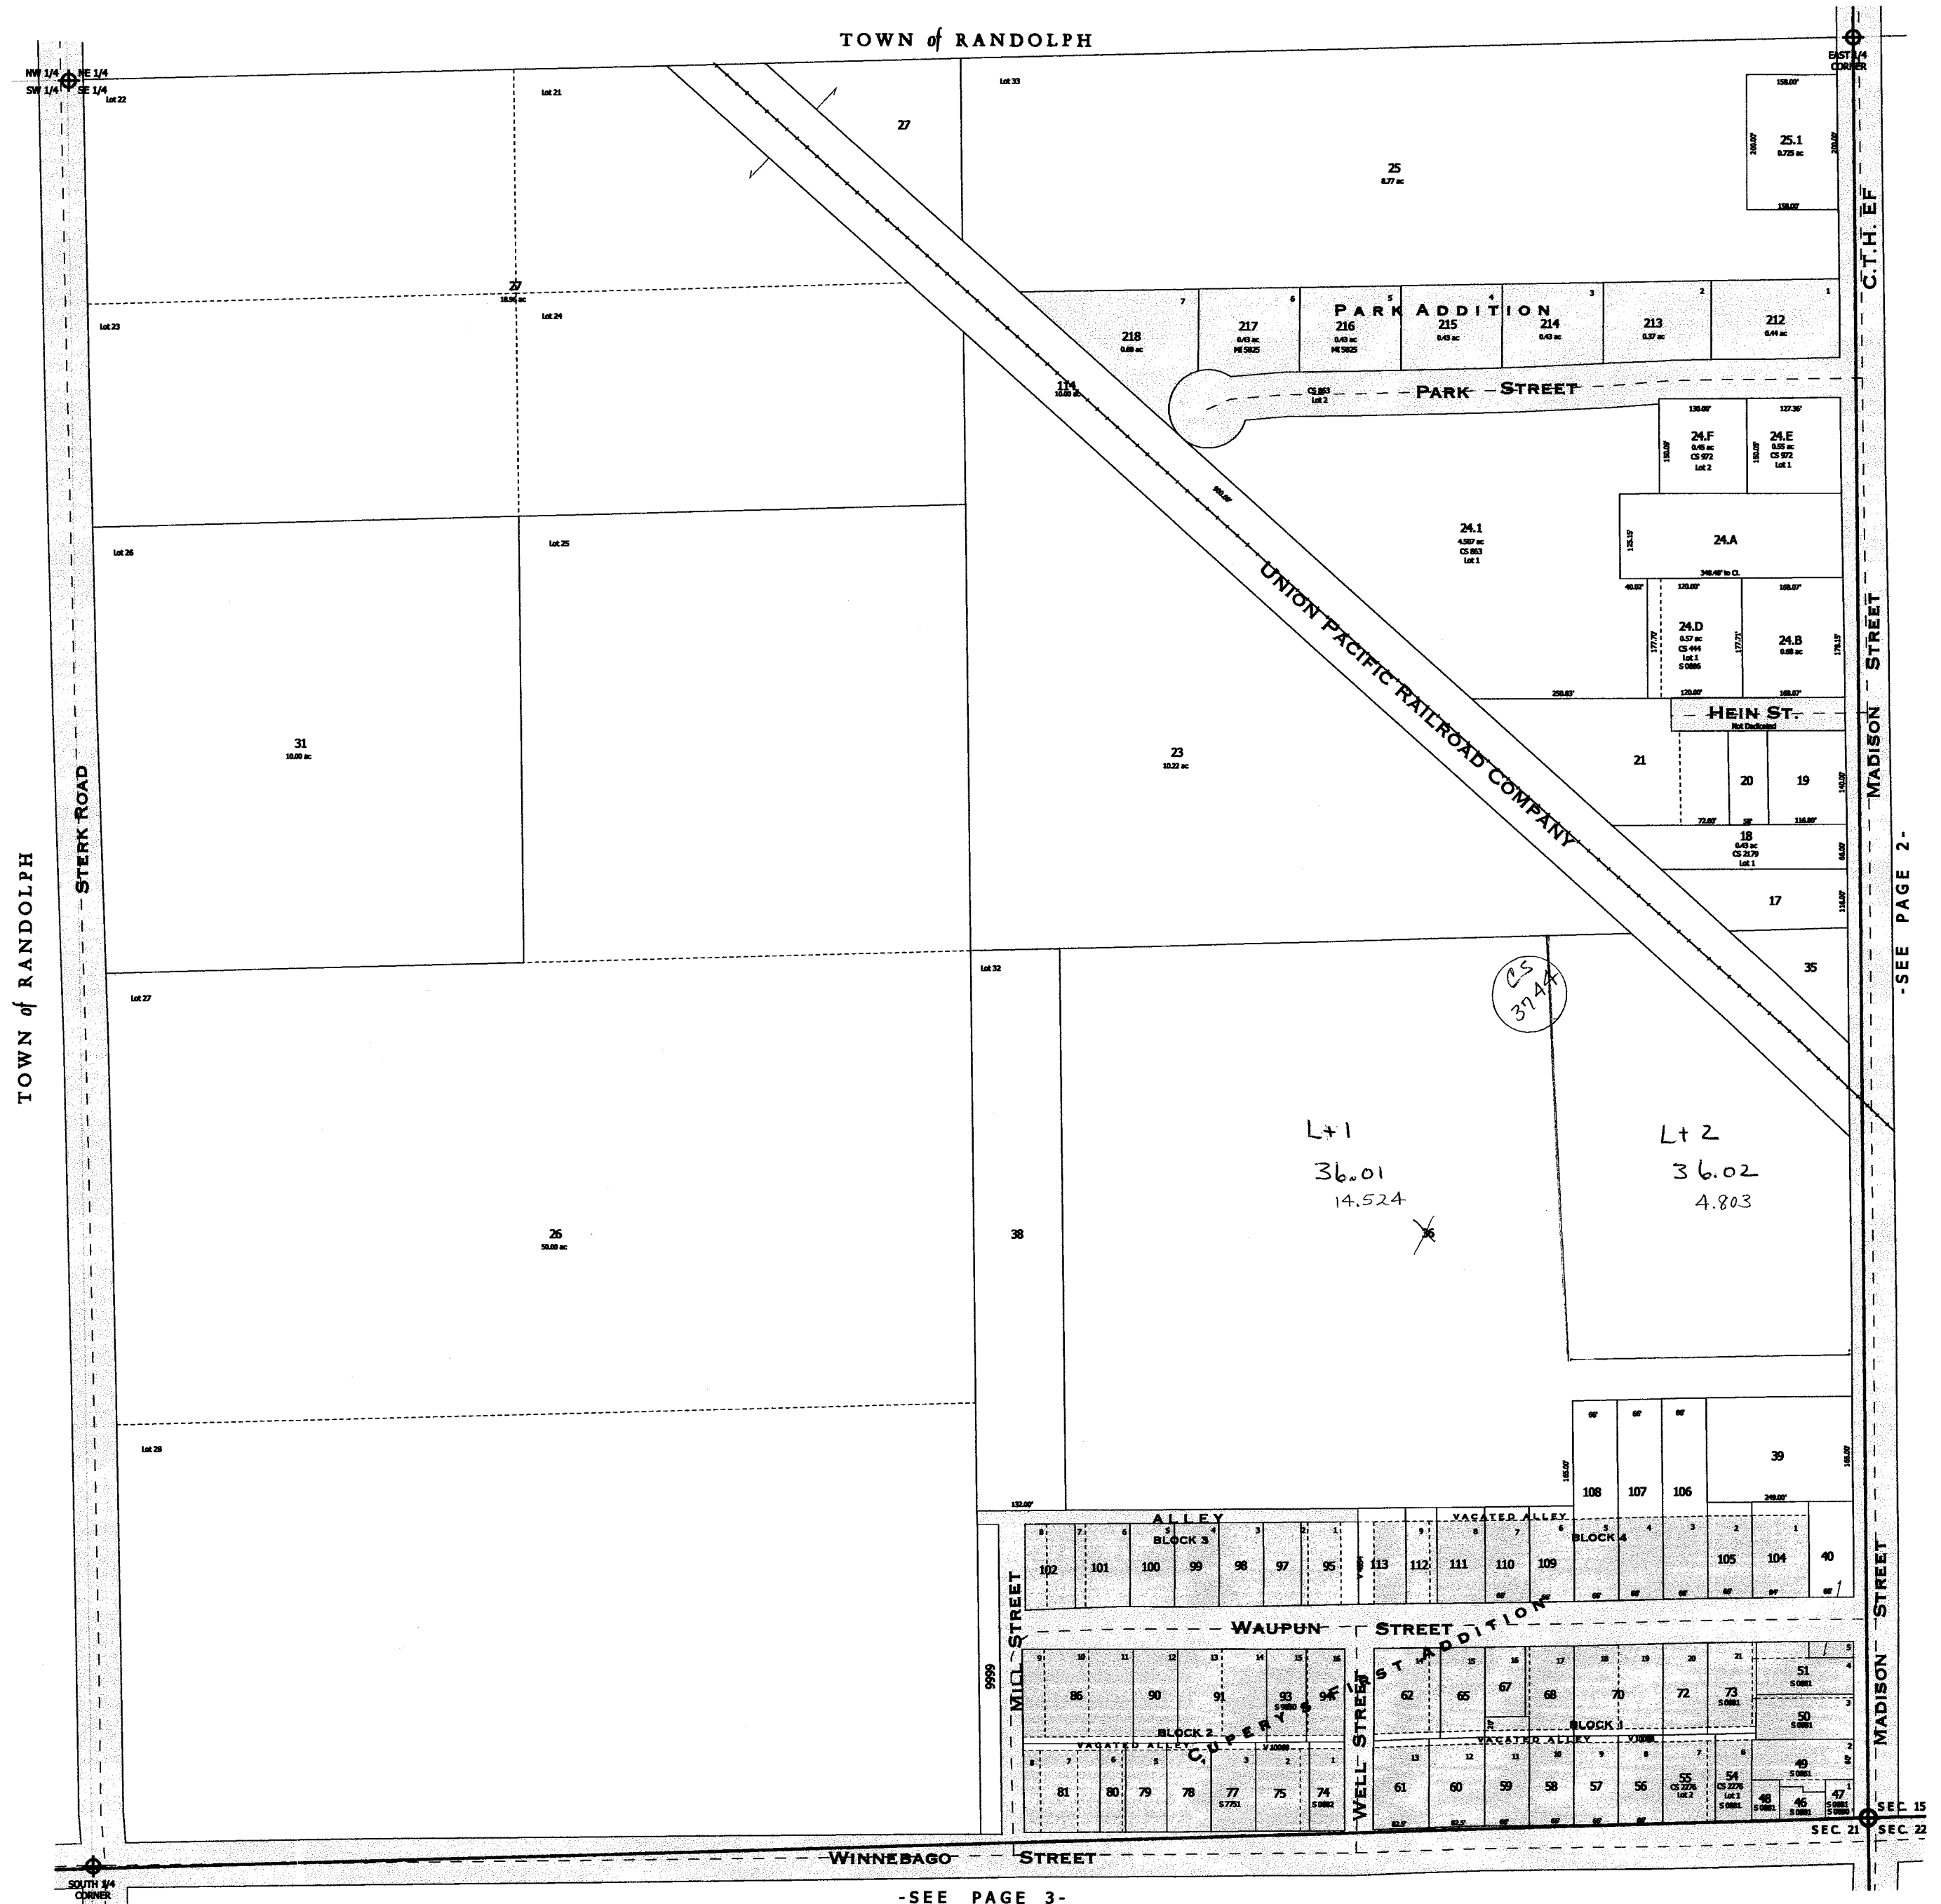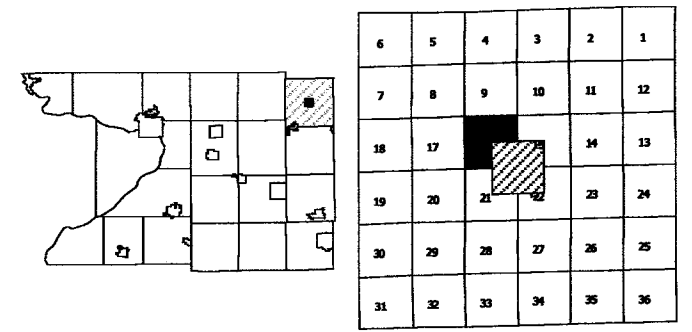

-SEE PAGE 3-

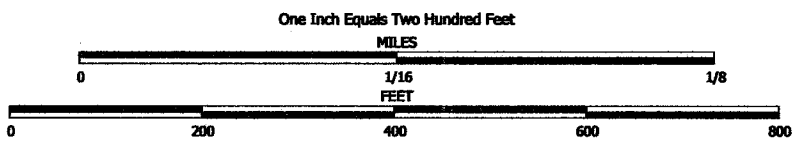

NOTE: This map was prepared for assessment use in accordance with the Wis. Stat. Chap. 70.09. All information contained herein is advisory only. Map accuracy is limited to the quality of data obtained from other Public Records. This map is not intended to be a substitute for an actual field survey. Public Land Survey Base is derived from U.S.G.S. Topographic maps unless otherwise noted. Other sources of the Land Base may be actual survey data. Base map data is from the April 1995 County Digital Orthophotos and/or U.S.G.S. 1:24,000 scale Topographic series. The user is responsible for the improper use of the data contained herein.


Created by The Columbia County Land Information Office -GIS Section. VMB and KMA Feb 2003.

TAX PARCEL MAP


VILLAGE of FRIESLAND

TOWN 13 NORTH RANGE 12 EAST
COLUMBIA COUNTY, WISCONSIN

Replaced
2004

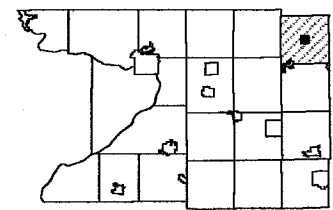

6	5	4	3	2	1
7	8	9	10	11	12
18	17	16	15	14	13
19	20	21	22	23	24
30	29	28	27	26	25
31	32	33	34	35	36

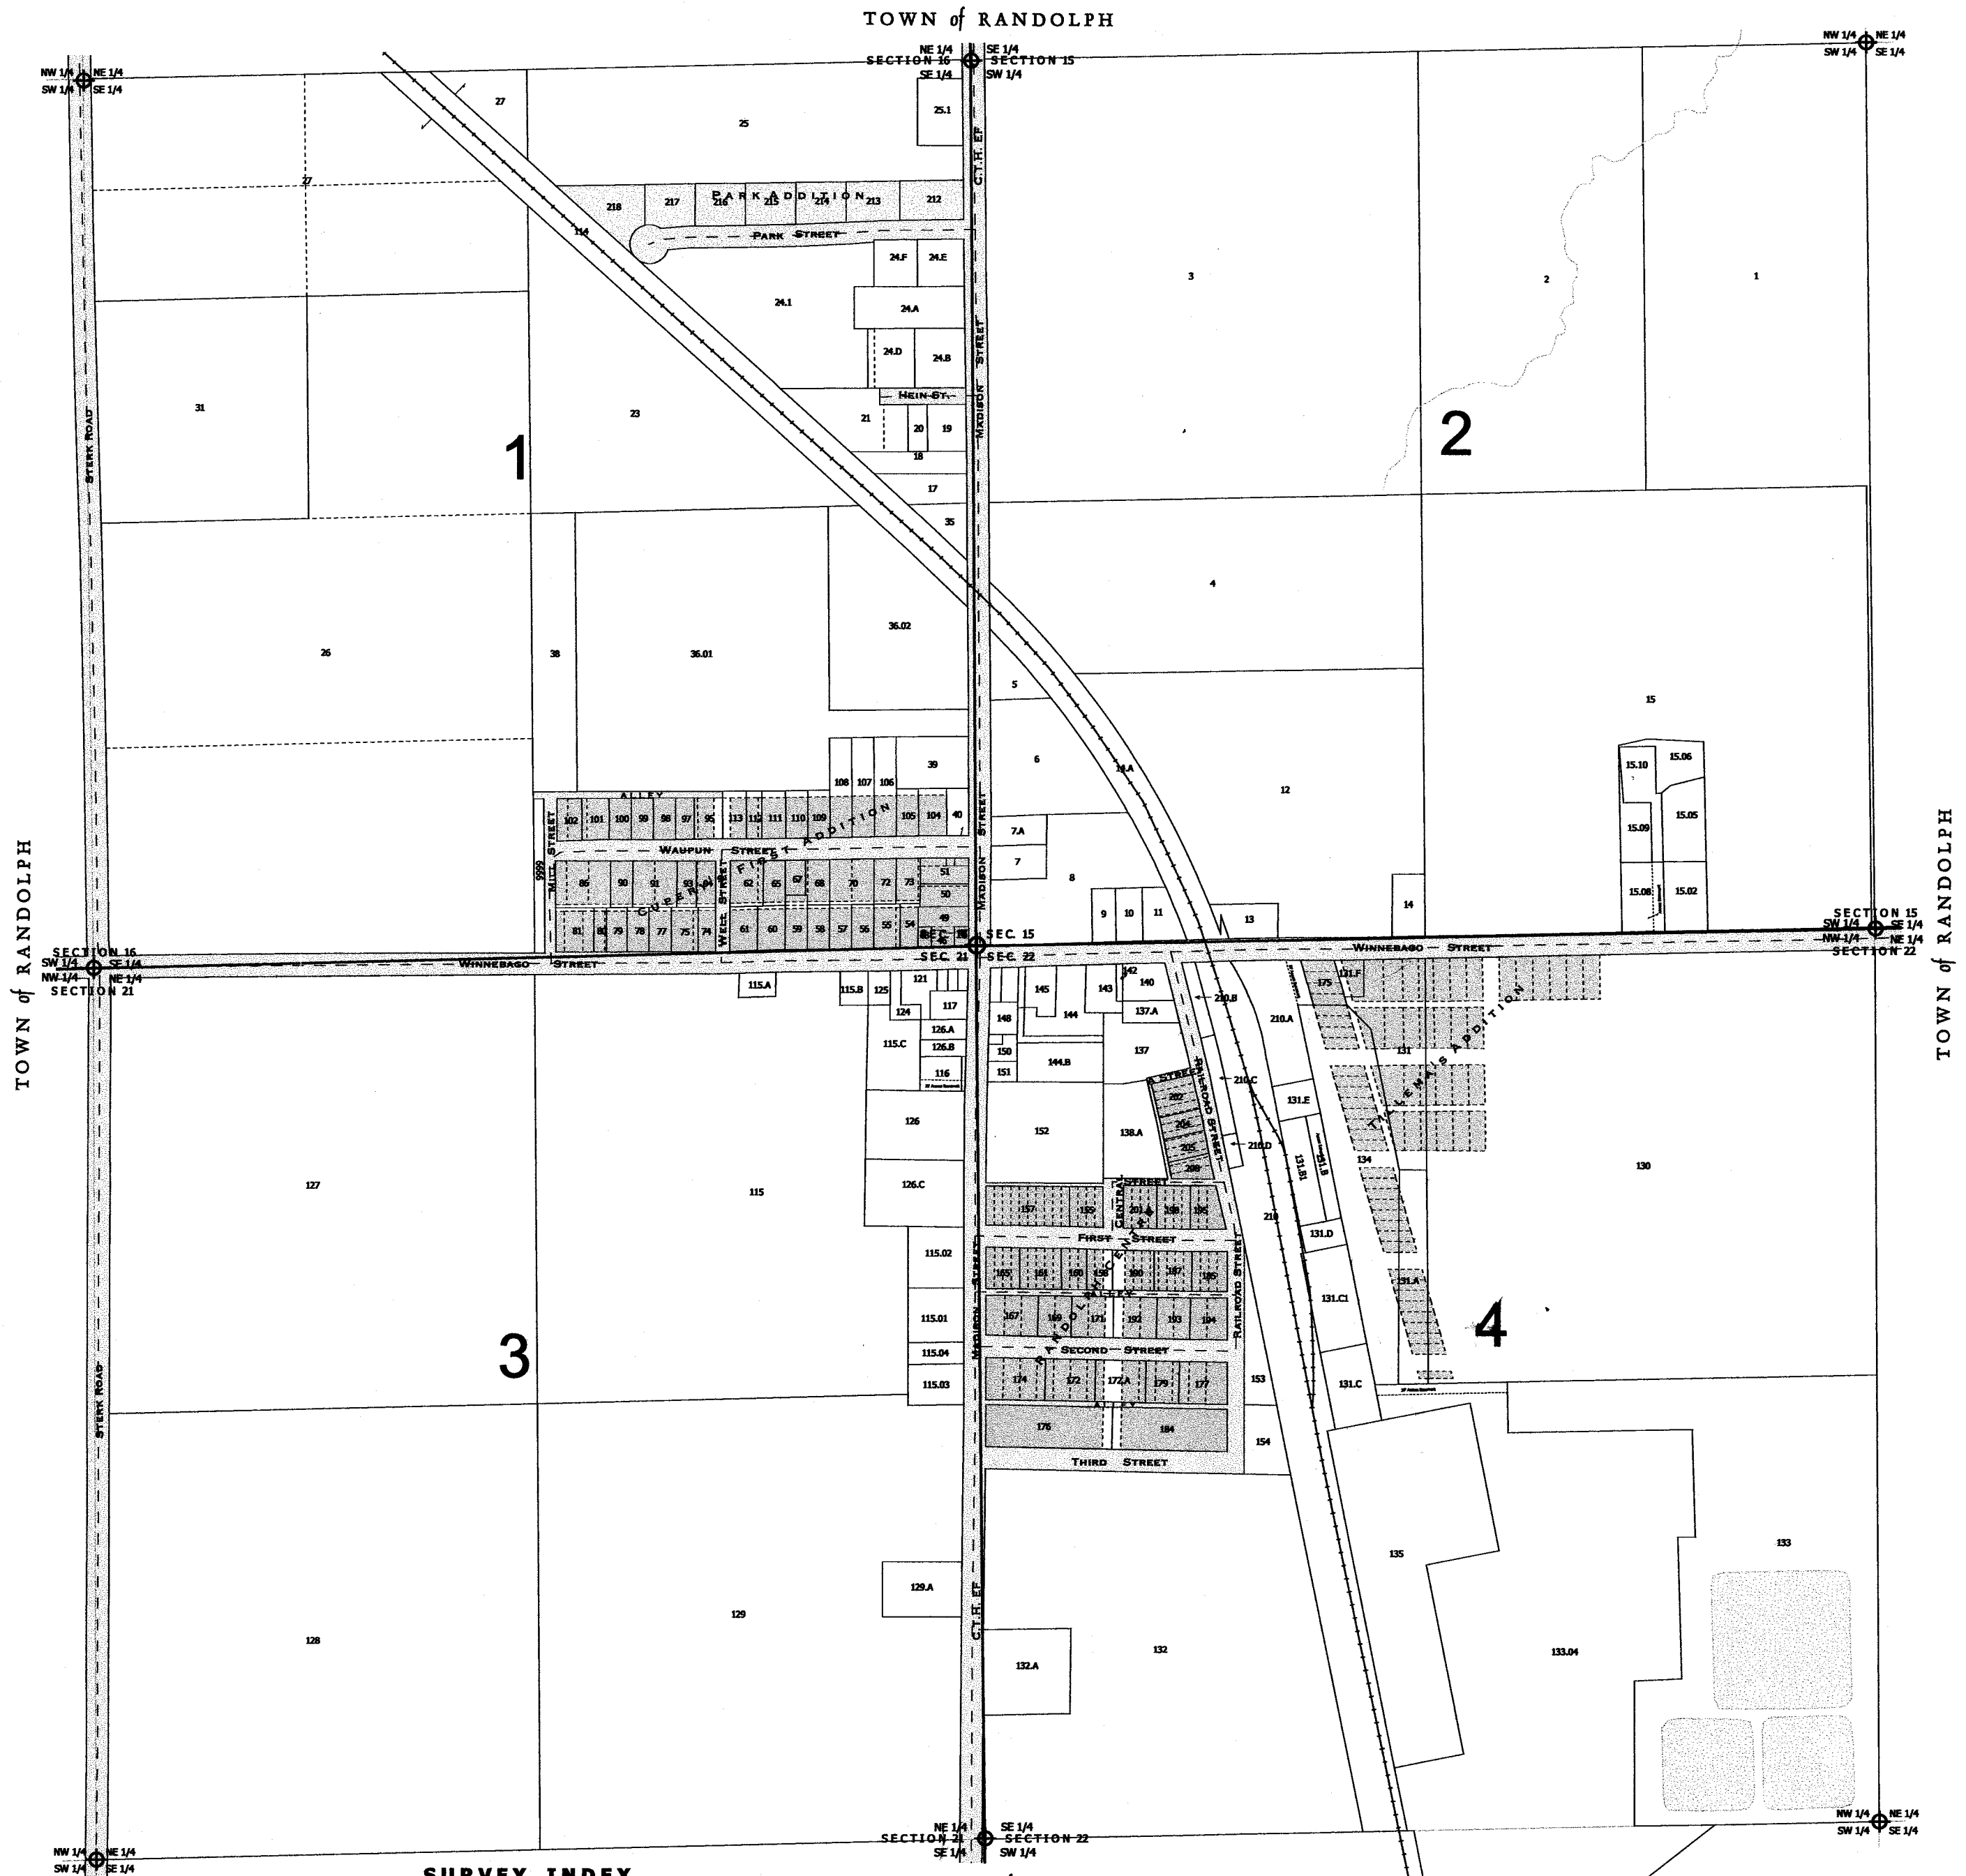


SURVEY INDEX

CUPERY'S FIRST ADDITION	REGISTER OF DEEDS - SHEET 18 B
PARK ADDITION	R.O.D. - 184 B
RANDOLPH CENTRE	R.O.D. - 19
TILLEMA'S ADDITION	R.O.D. - 28
COMPOSITE VILLAGE MAP (1972)	S 0896

TOWN of RANDOLPH

9999 - This number is used to represent tax parcels or a portion of a tax parcel that requires additional research to determine accurate boundaries and/or ownership.


replaced 2004
- PAGE & PLAT INDEX -

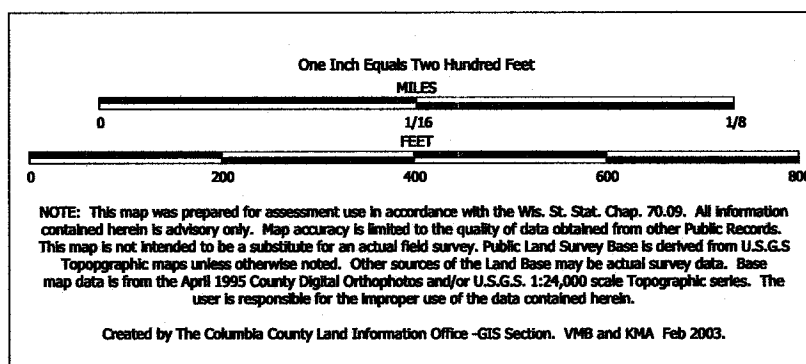

TAX PARCEL MAP

VILLAGE of FRIESLAND

TOWN 13 NORTH RANGE 12 EAST
COLUMBIA COUNTY, WISCONSIN

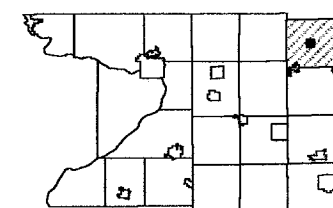


6	5	4	3	2	1
7	8	9	10	11	12
13	14	15	16	17	18
19	20	21	22	23	24
25	26	27	28	29	30
31	32	33	34	35	36

Replaced
2004



-SEE PAGE 4-

replaced 2004
-PAGE 2-


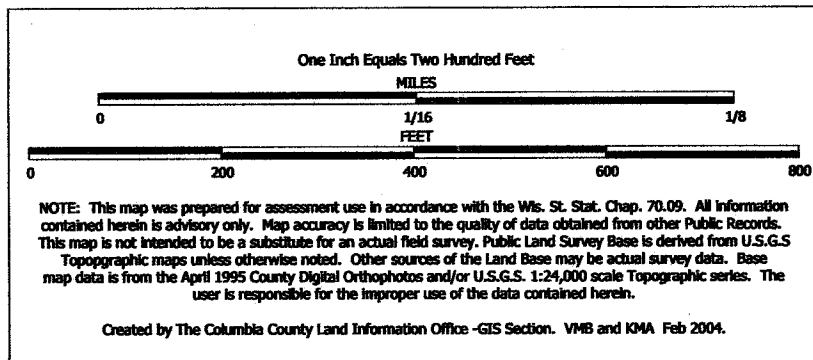


TAX PARCEL MAP

VILLAGE of FRIESLAND

TOWN 13 NORTH RANGE 12 EAST
COLUMBIA COUNTY, WISCONSIN

Replaced
2005

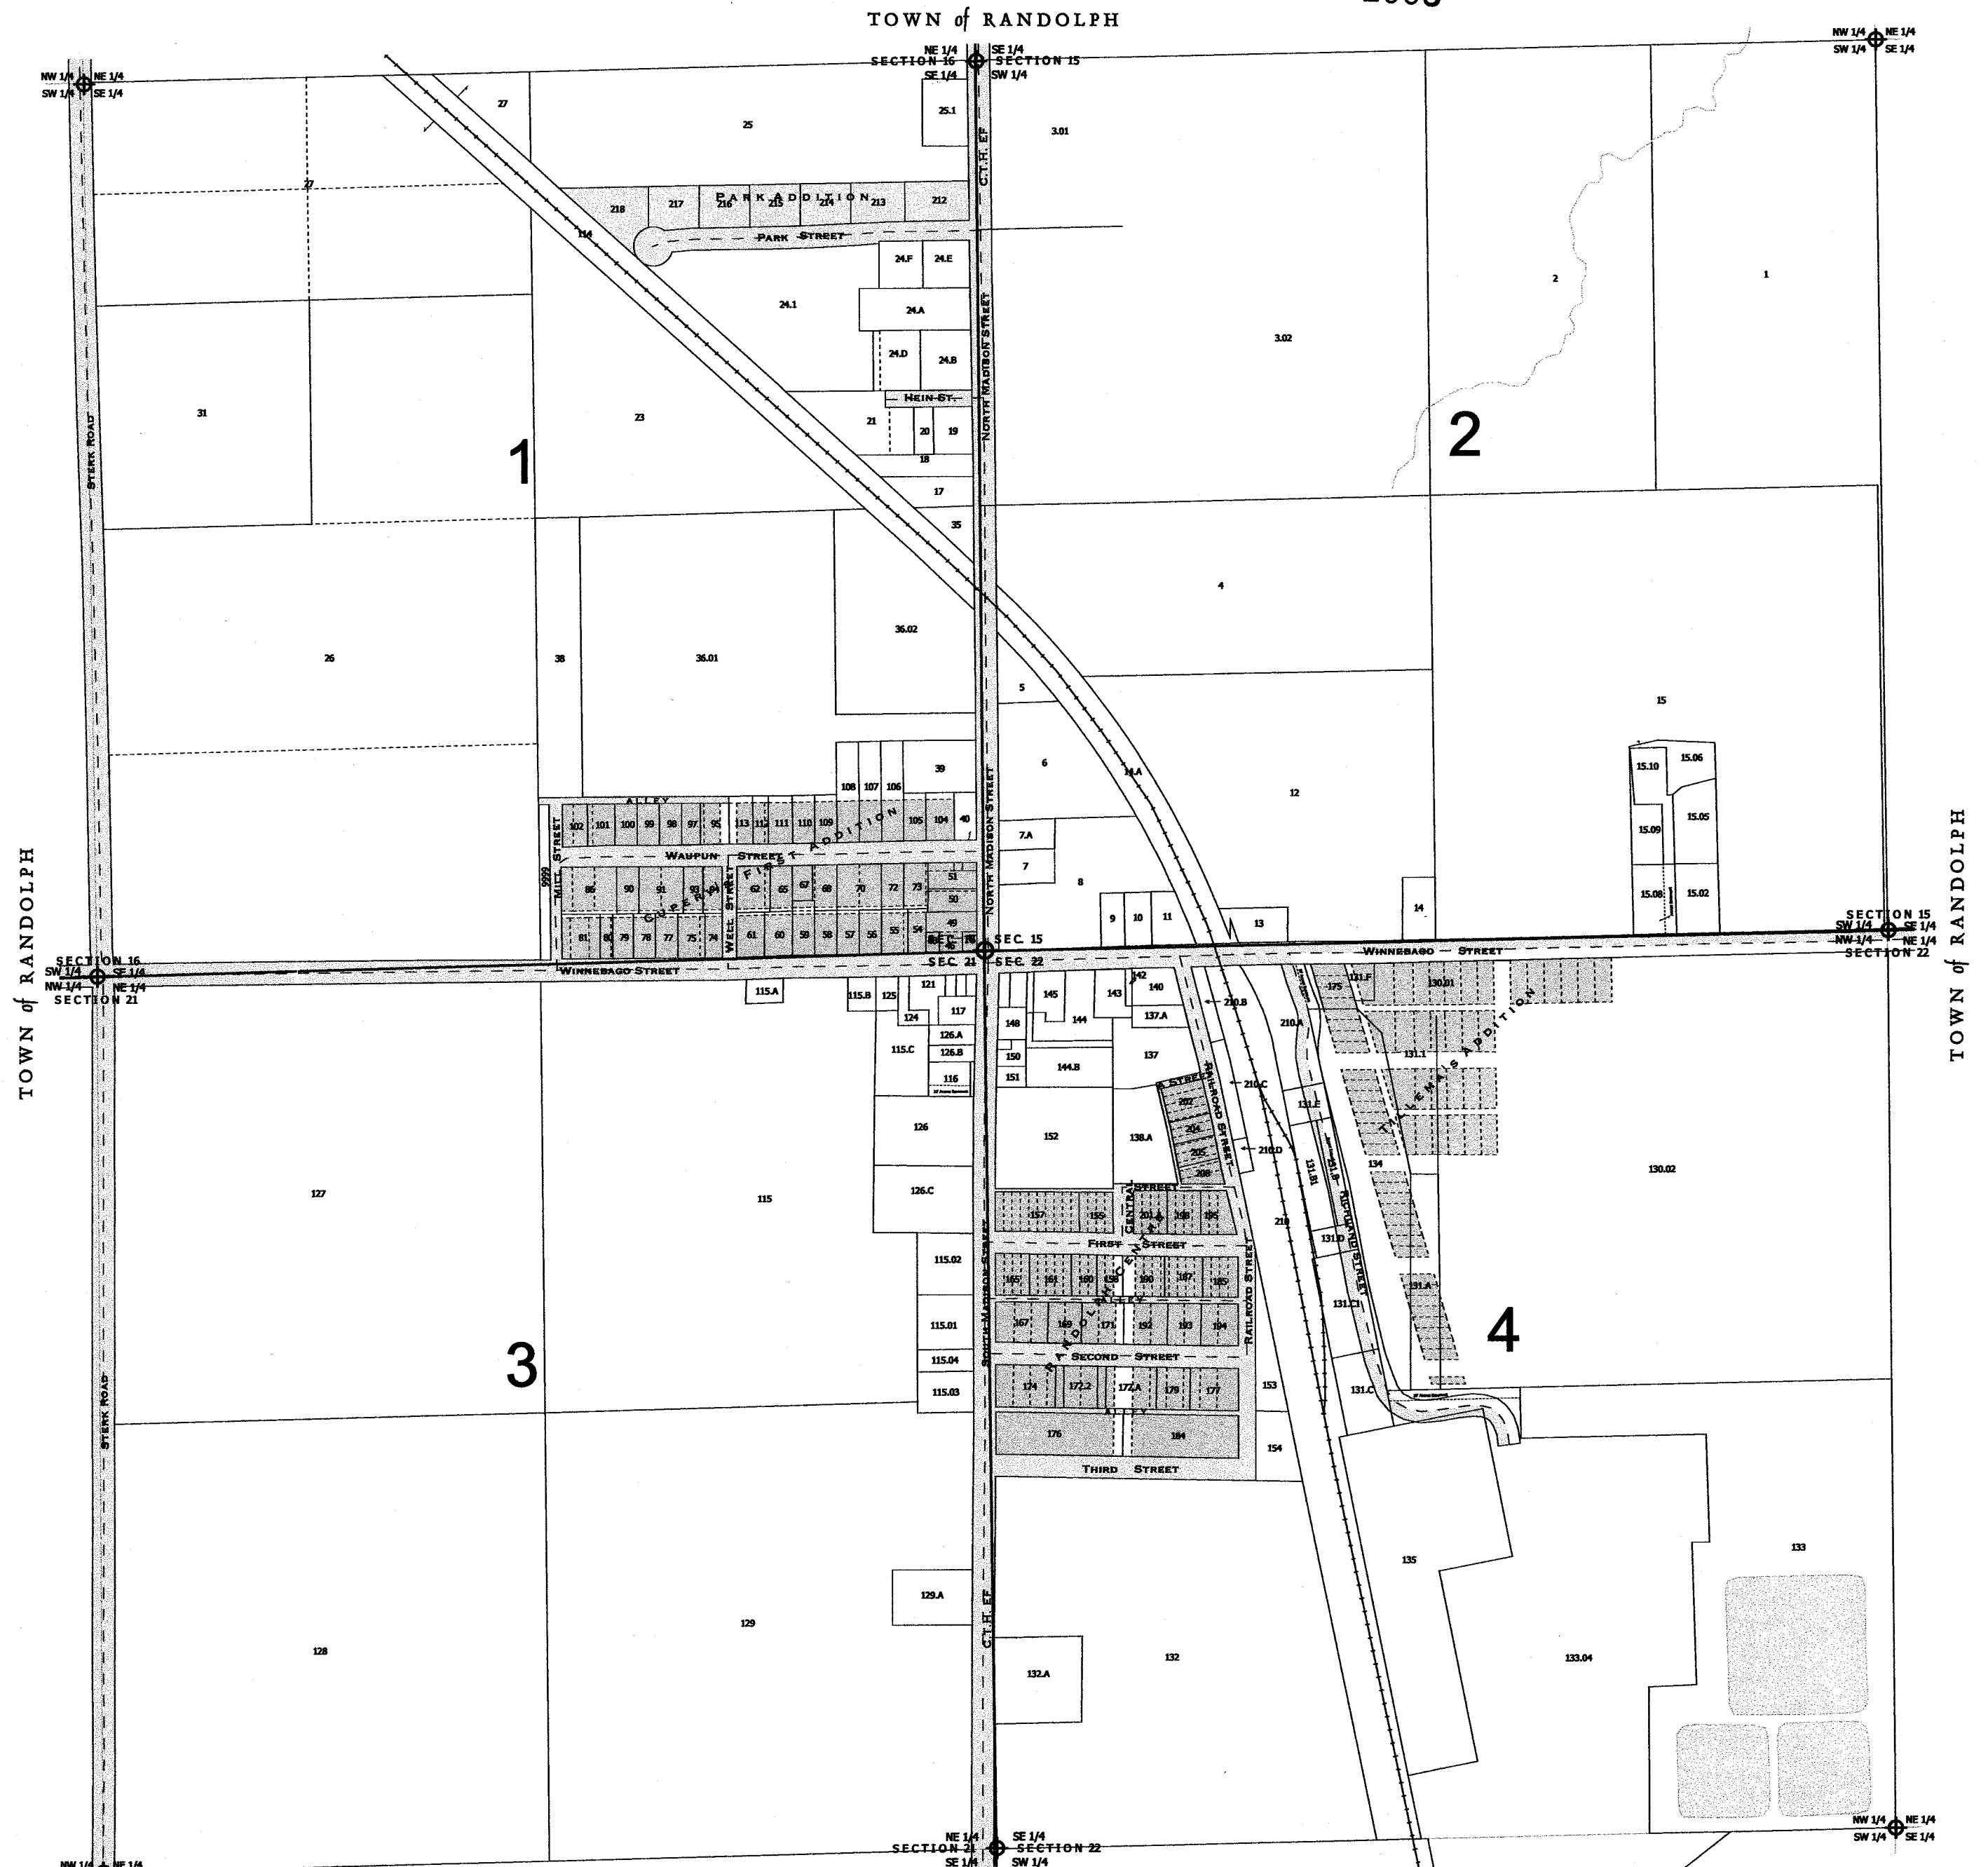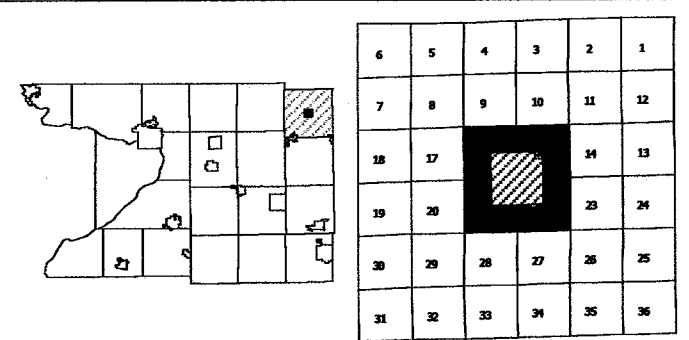

SURVEY INDEX	
CUPERY'S FIRST ADDITION	REGISTER OF DEEDS - SHEET 18 B
PARK ADDITION	R.O.D. - 184 B
RANDOLPH CENTRE	R.O.D. - 19
TILLEMA'S ADDITION	R.O.D. - 28
COMPOSITE VILLAGE MAP (1972)	S 0896

TOWN of RANDOLPH

9999 - This number is used to represent tax parcels or a portion of a tax parcel that requires additional research to determine accurate boundaries and/or ownership.

One Inch Equals Two Hundred Feet

MILES
0 1/8

FEET
0 200 400 600 800


NOTE: This map was prepared for assessment use in accordance with the Wis. St. Stat. Chap. 70.09. All information contained herein is advisory only. Map accuracy is limited to the quality of data obtained from other Public Records. This map is not intended to be a substitute for an actual field survey. Public Land Survey Base is derived from U.S.G.S. Topographic maps unless otherwise noted. Other sources of the Land Base may be actual survey data. Base map data is from the April 1995 County Digital Orthophotos and/or U.S.G.S. 1:24,000 scale Topographic series. The user is responsible for the improper use of the data contained herein.

Created by The Columbia County Land Information Office -GIS Section. VMB and KMA March 2000.

TAX PARCEL MAP

VILLAGE of FRIESLAND


TOWN 13 NORTH RANGE 12 EAST
COLUMBIA COUNTY, WISCONSIN

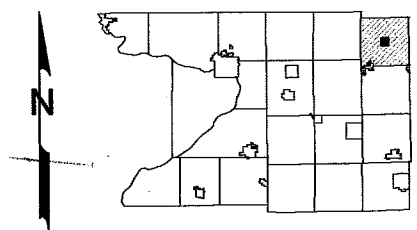

6	5	4	3	2	1
7	8	9	10	11	12
13	14	15	16	17	18
19	20	21	22	23	24
25	26	27	28	29	30
31	32	33	34	35	36

Replaced
2005

-SEE PAGE 1-

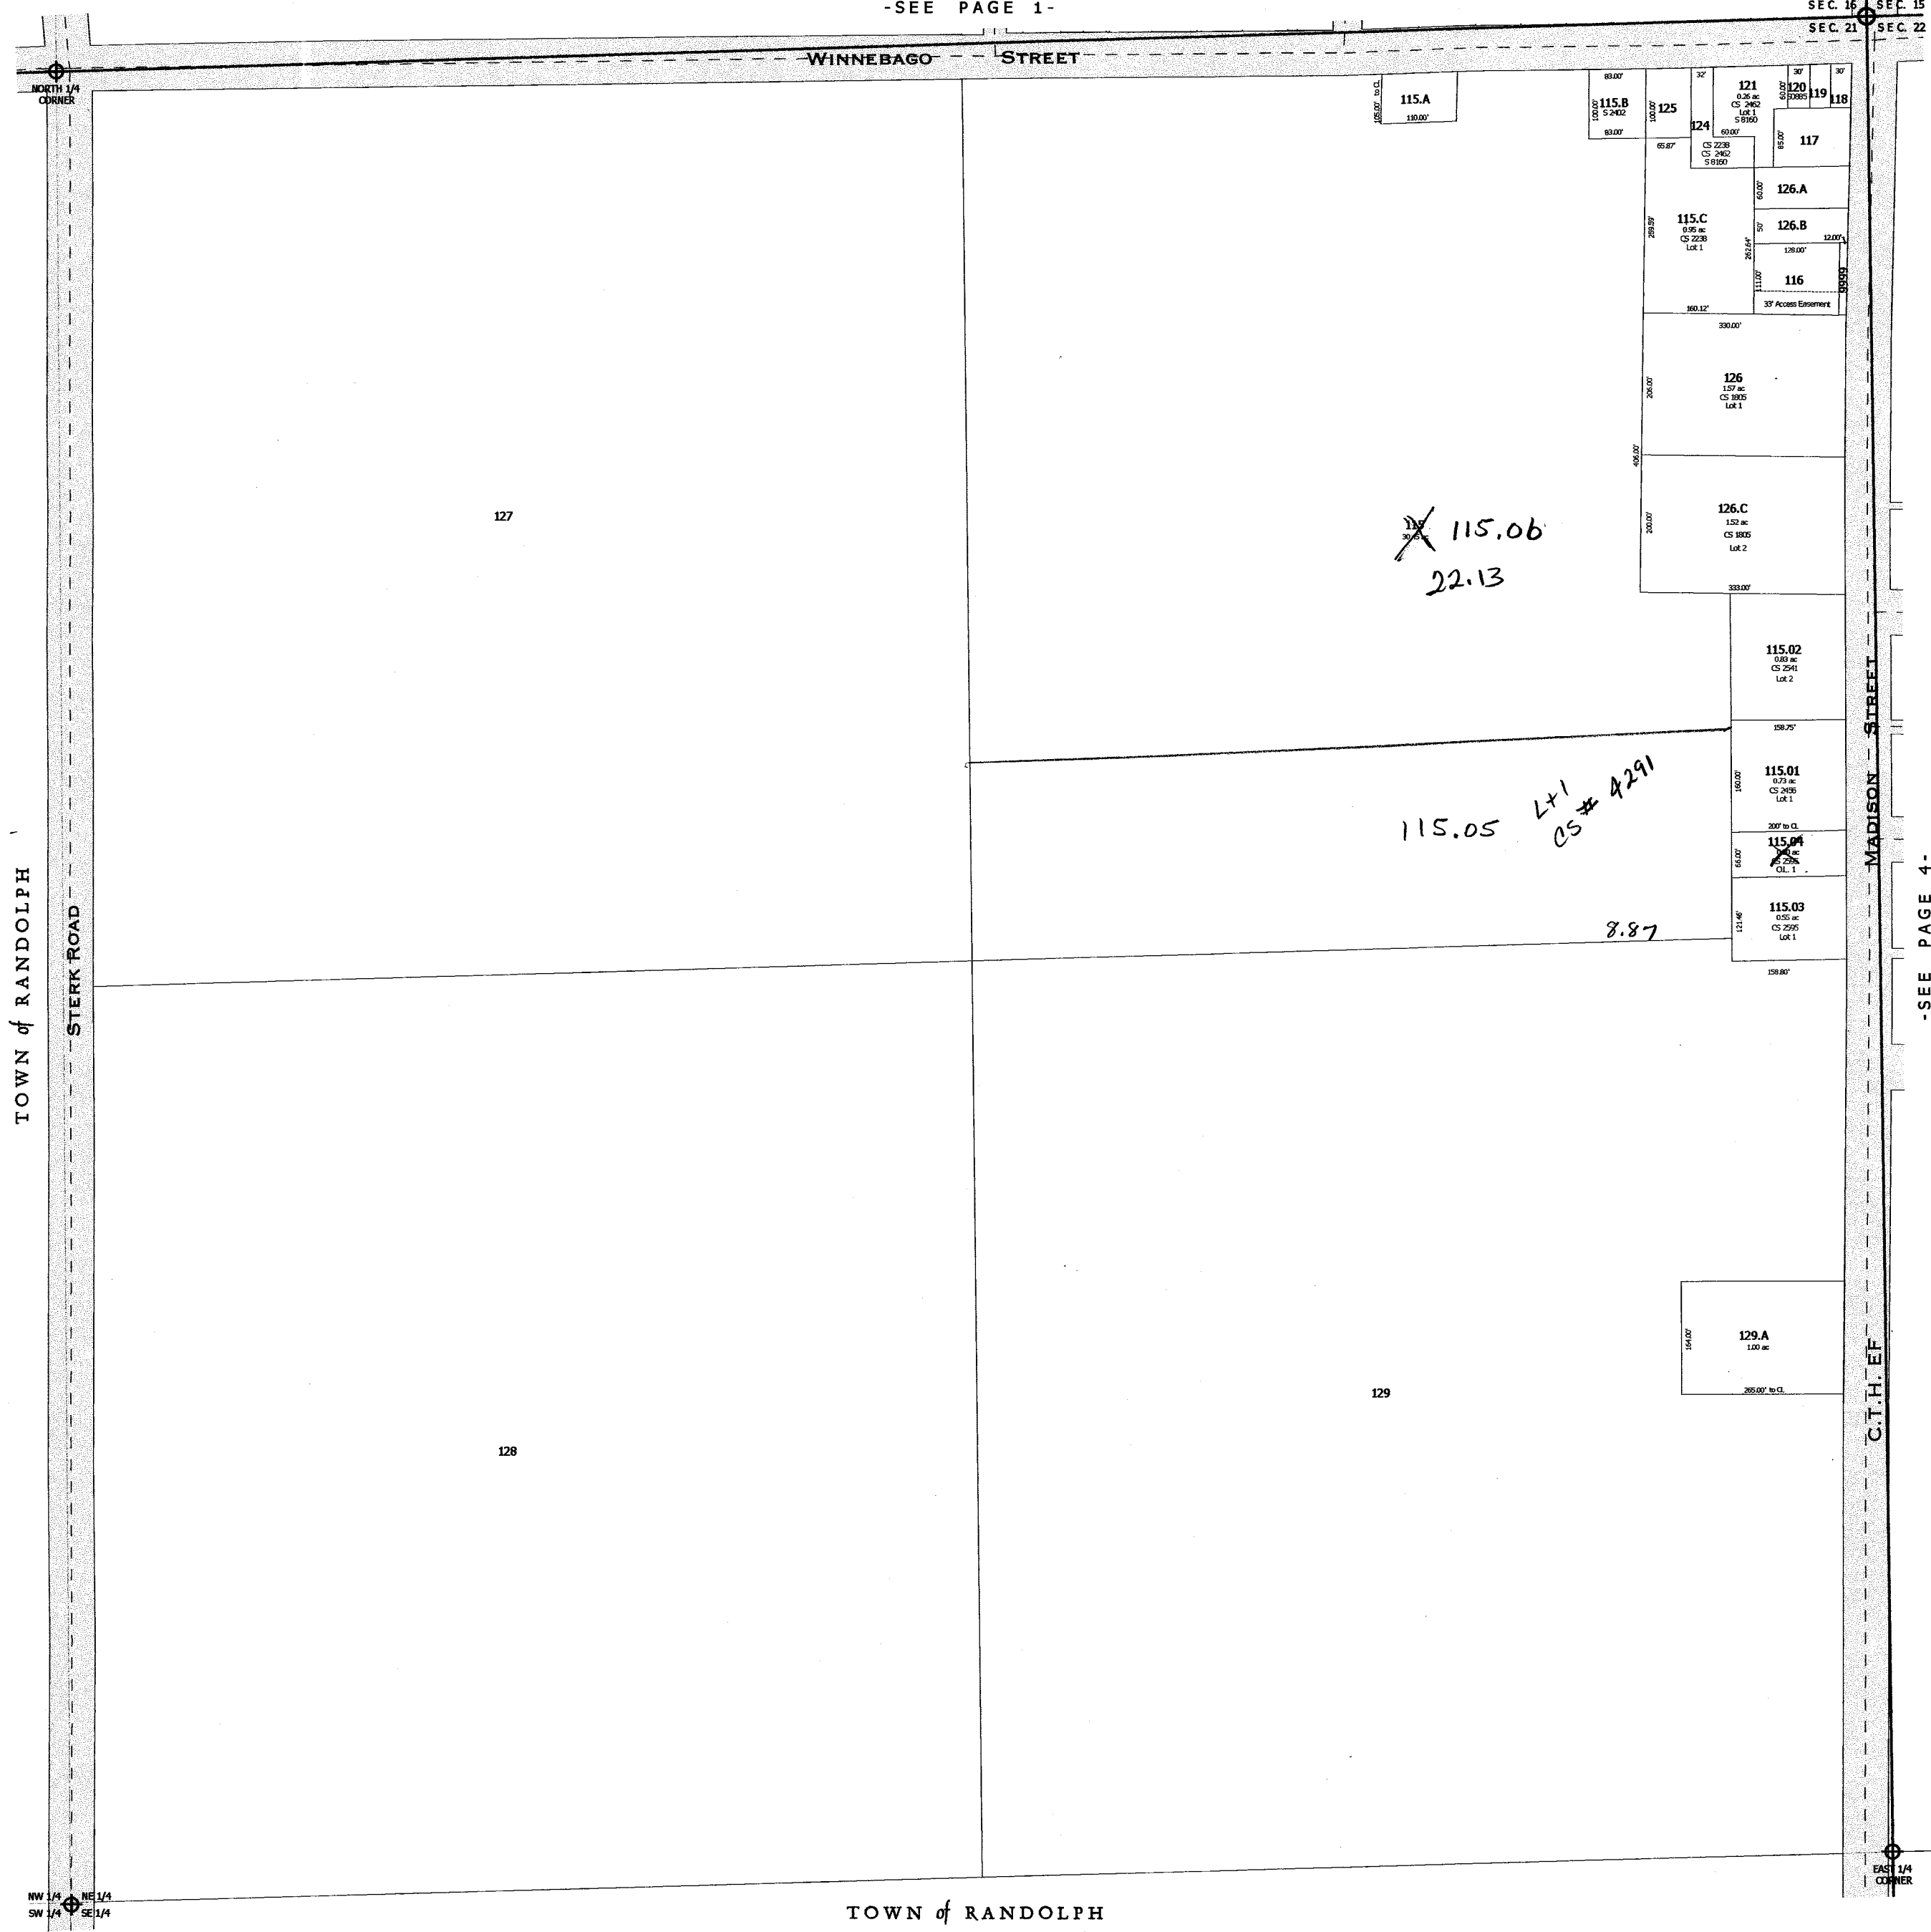


-SEE PAGE 4-

EAST 1/4 CORNER

NW 1/4 NE 1/4
SW 1/4 SE 1/4


TOWN of RANDOLPH

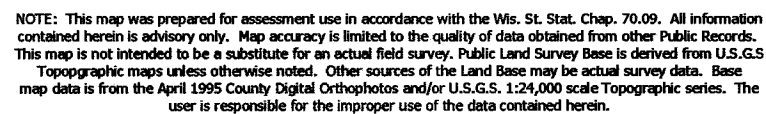

Created by The Columbia County Land Information Office -GIS Section. VMB and KMA March 2000.


TOWN 13 NORTH RANGE 12 EAST
COLUMBIA COUNTY, WISCONSIN

Replaced
2005

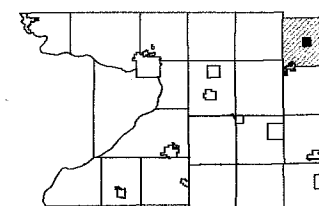

6	5	4	3	2	1
7	8	9	10	11	12
18	17	16		14	13
19	20	21		23	24
30	29	28	27	26	25
31	32	33	34	35	36

-SEE PAGE 2-

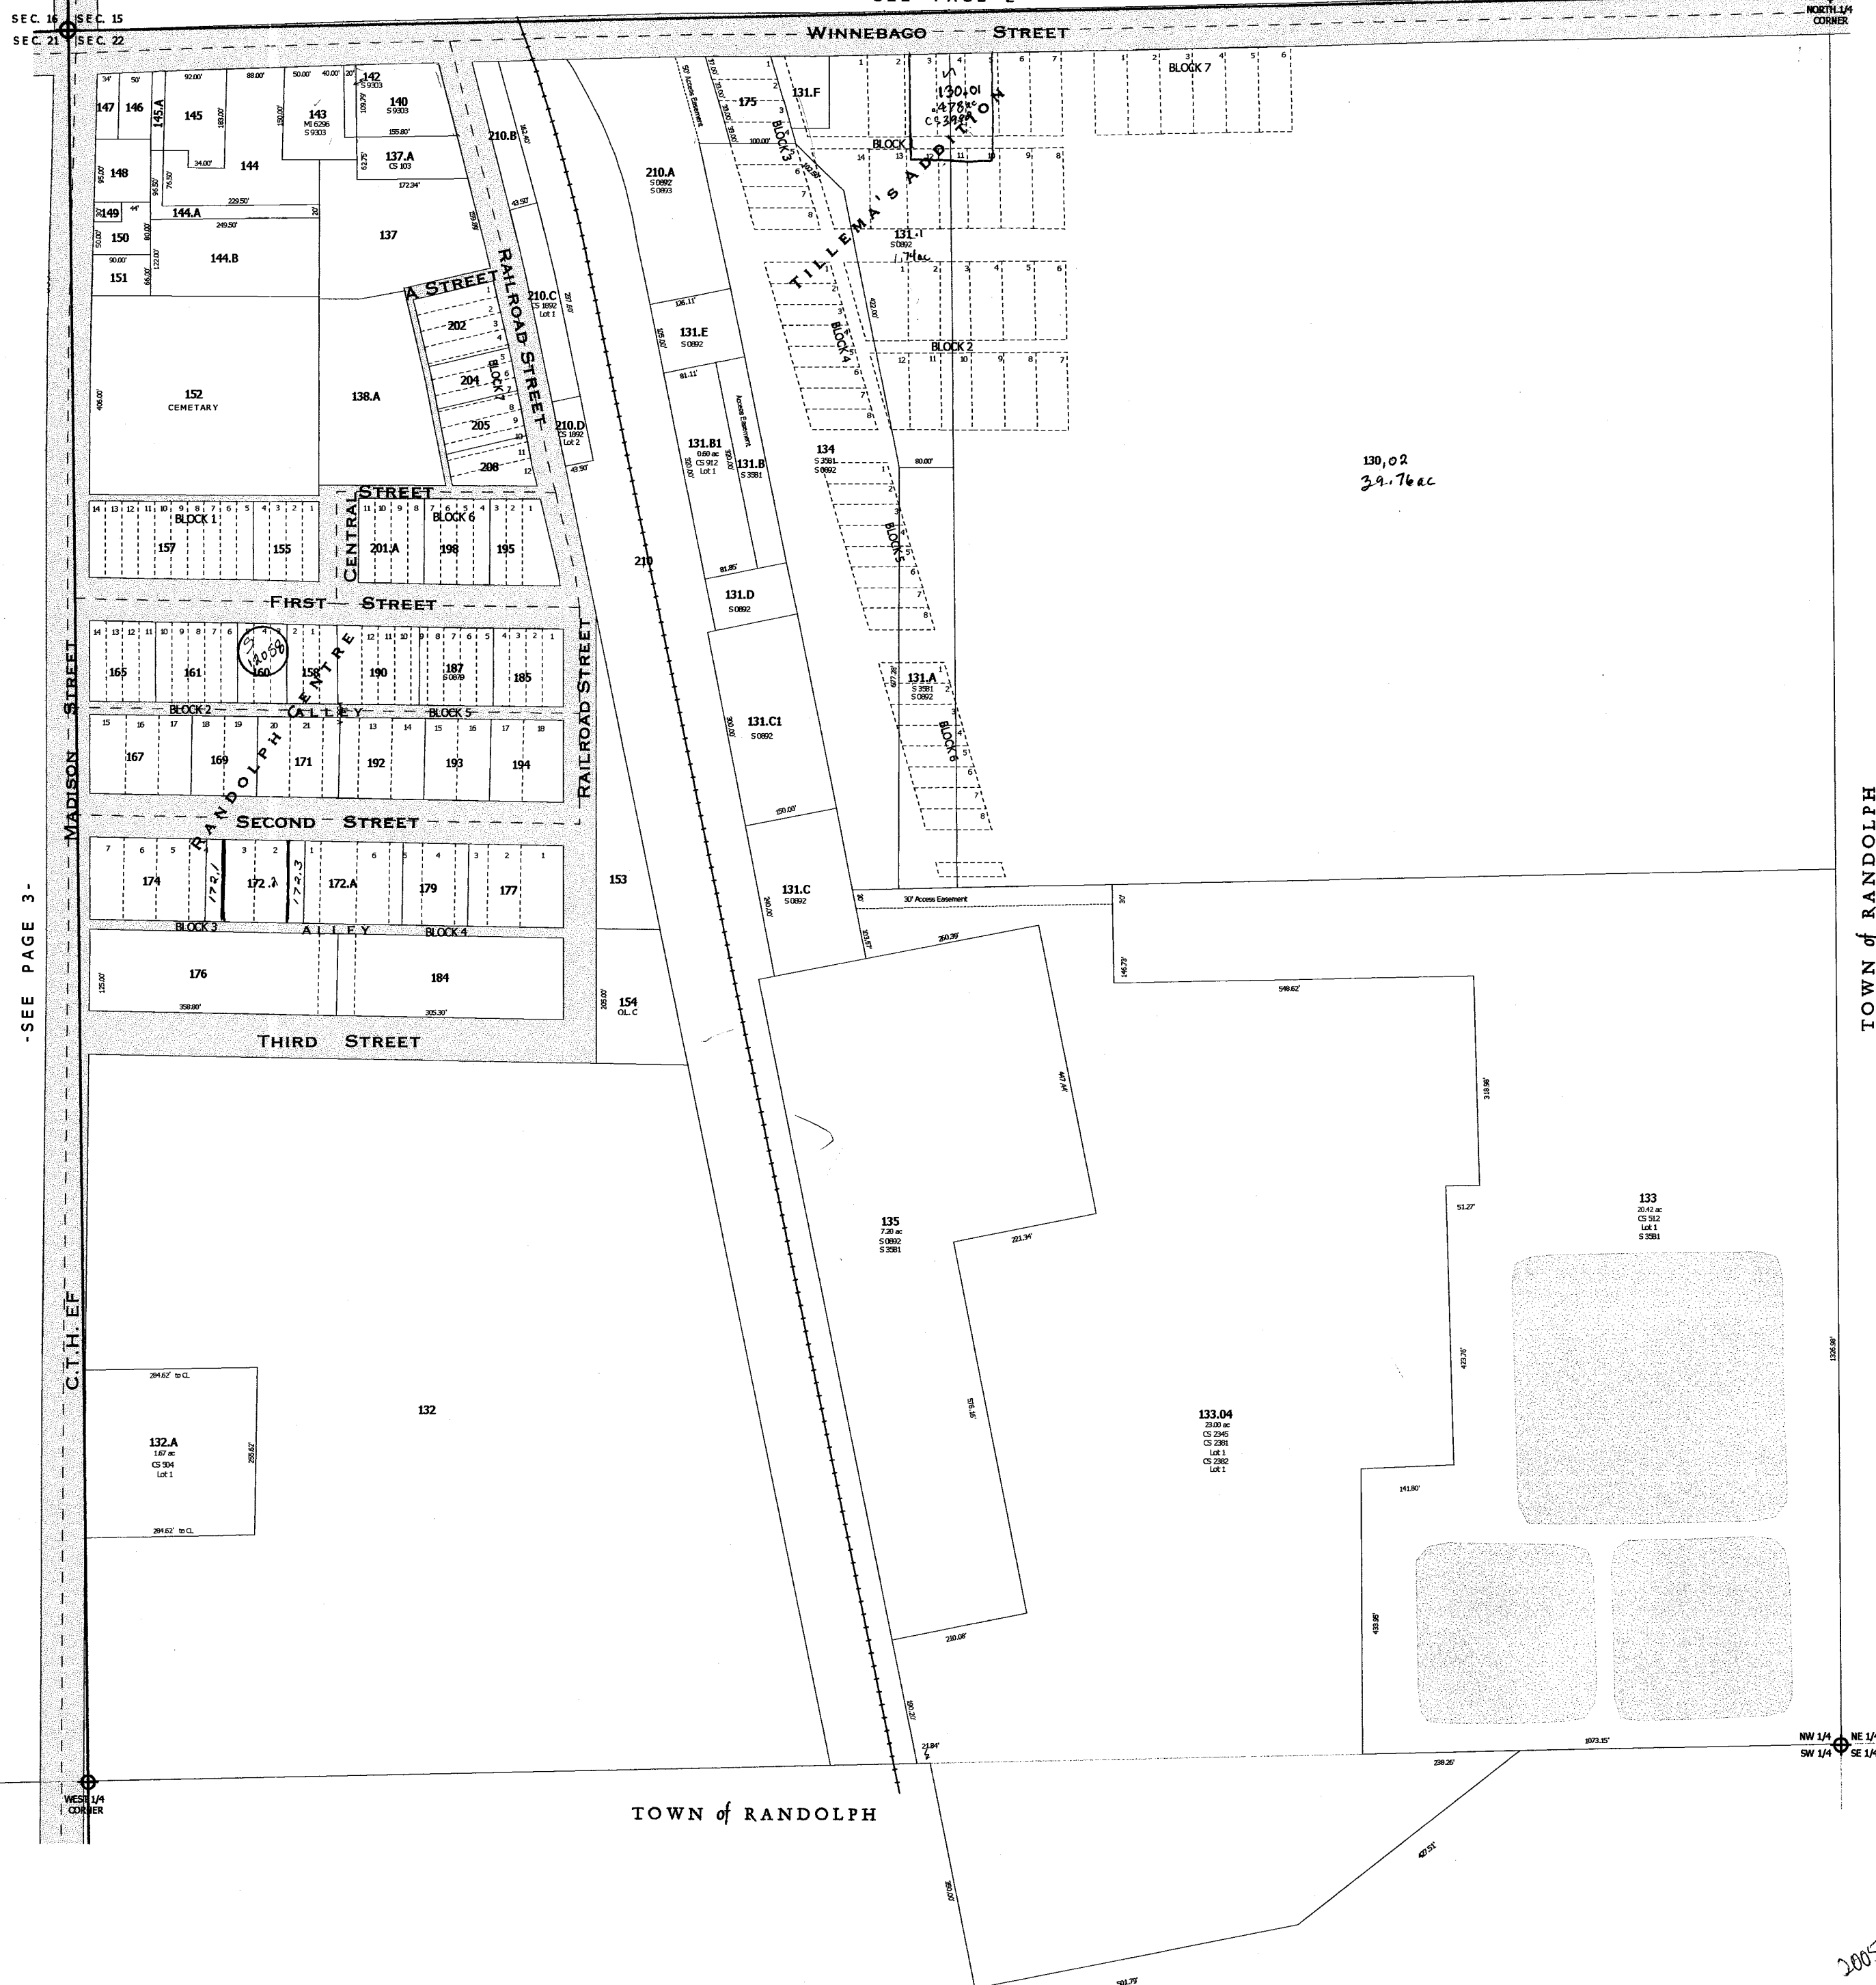

One Inch Equals Two Hundred Feet

NOTE: This map was prepared for assessment use in accordance with the Wis. Stat. Chap. 70.03. All information contained herein is advisory only. Map accuracy is limited to the quality of data obtained from other Public Records. This map is not intended to be a substitute for an actual field survey. Public Land Survey Base is derived from U.S.G.S. Topographic maps unless otherwise noted. Other sources of the Land Base may be actual survey data. Base map data is from the April 1995 County Digital Orthophotos and/or U.S.G.S. 1:24,000 scale Topographic series. The user is responsible for the improper use of the data contained herein.

Created by The Columbia County Land Information Office -GIS Section. VMB and KMA. Jan 2005.


TAX PARCEL MAP

VILLAGE of FRIESLAND

TOWN 13 NORTH RANGE 12 EAST
COLUMBIA COUNTY, WISCONSIN


6	5	4	3	2	1
7	8	9	10	11	12
18	17	16	15	14	13
19	20	21	22	23	24
28	29	28	27	26	25
31	32	33	34	35	36

Replaced
2006

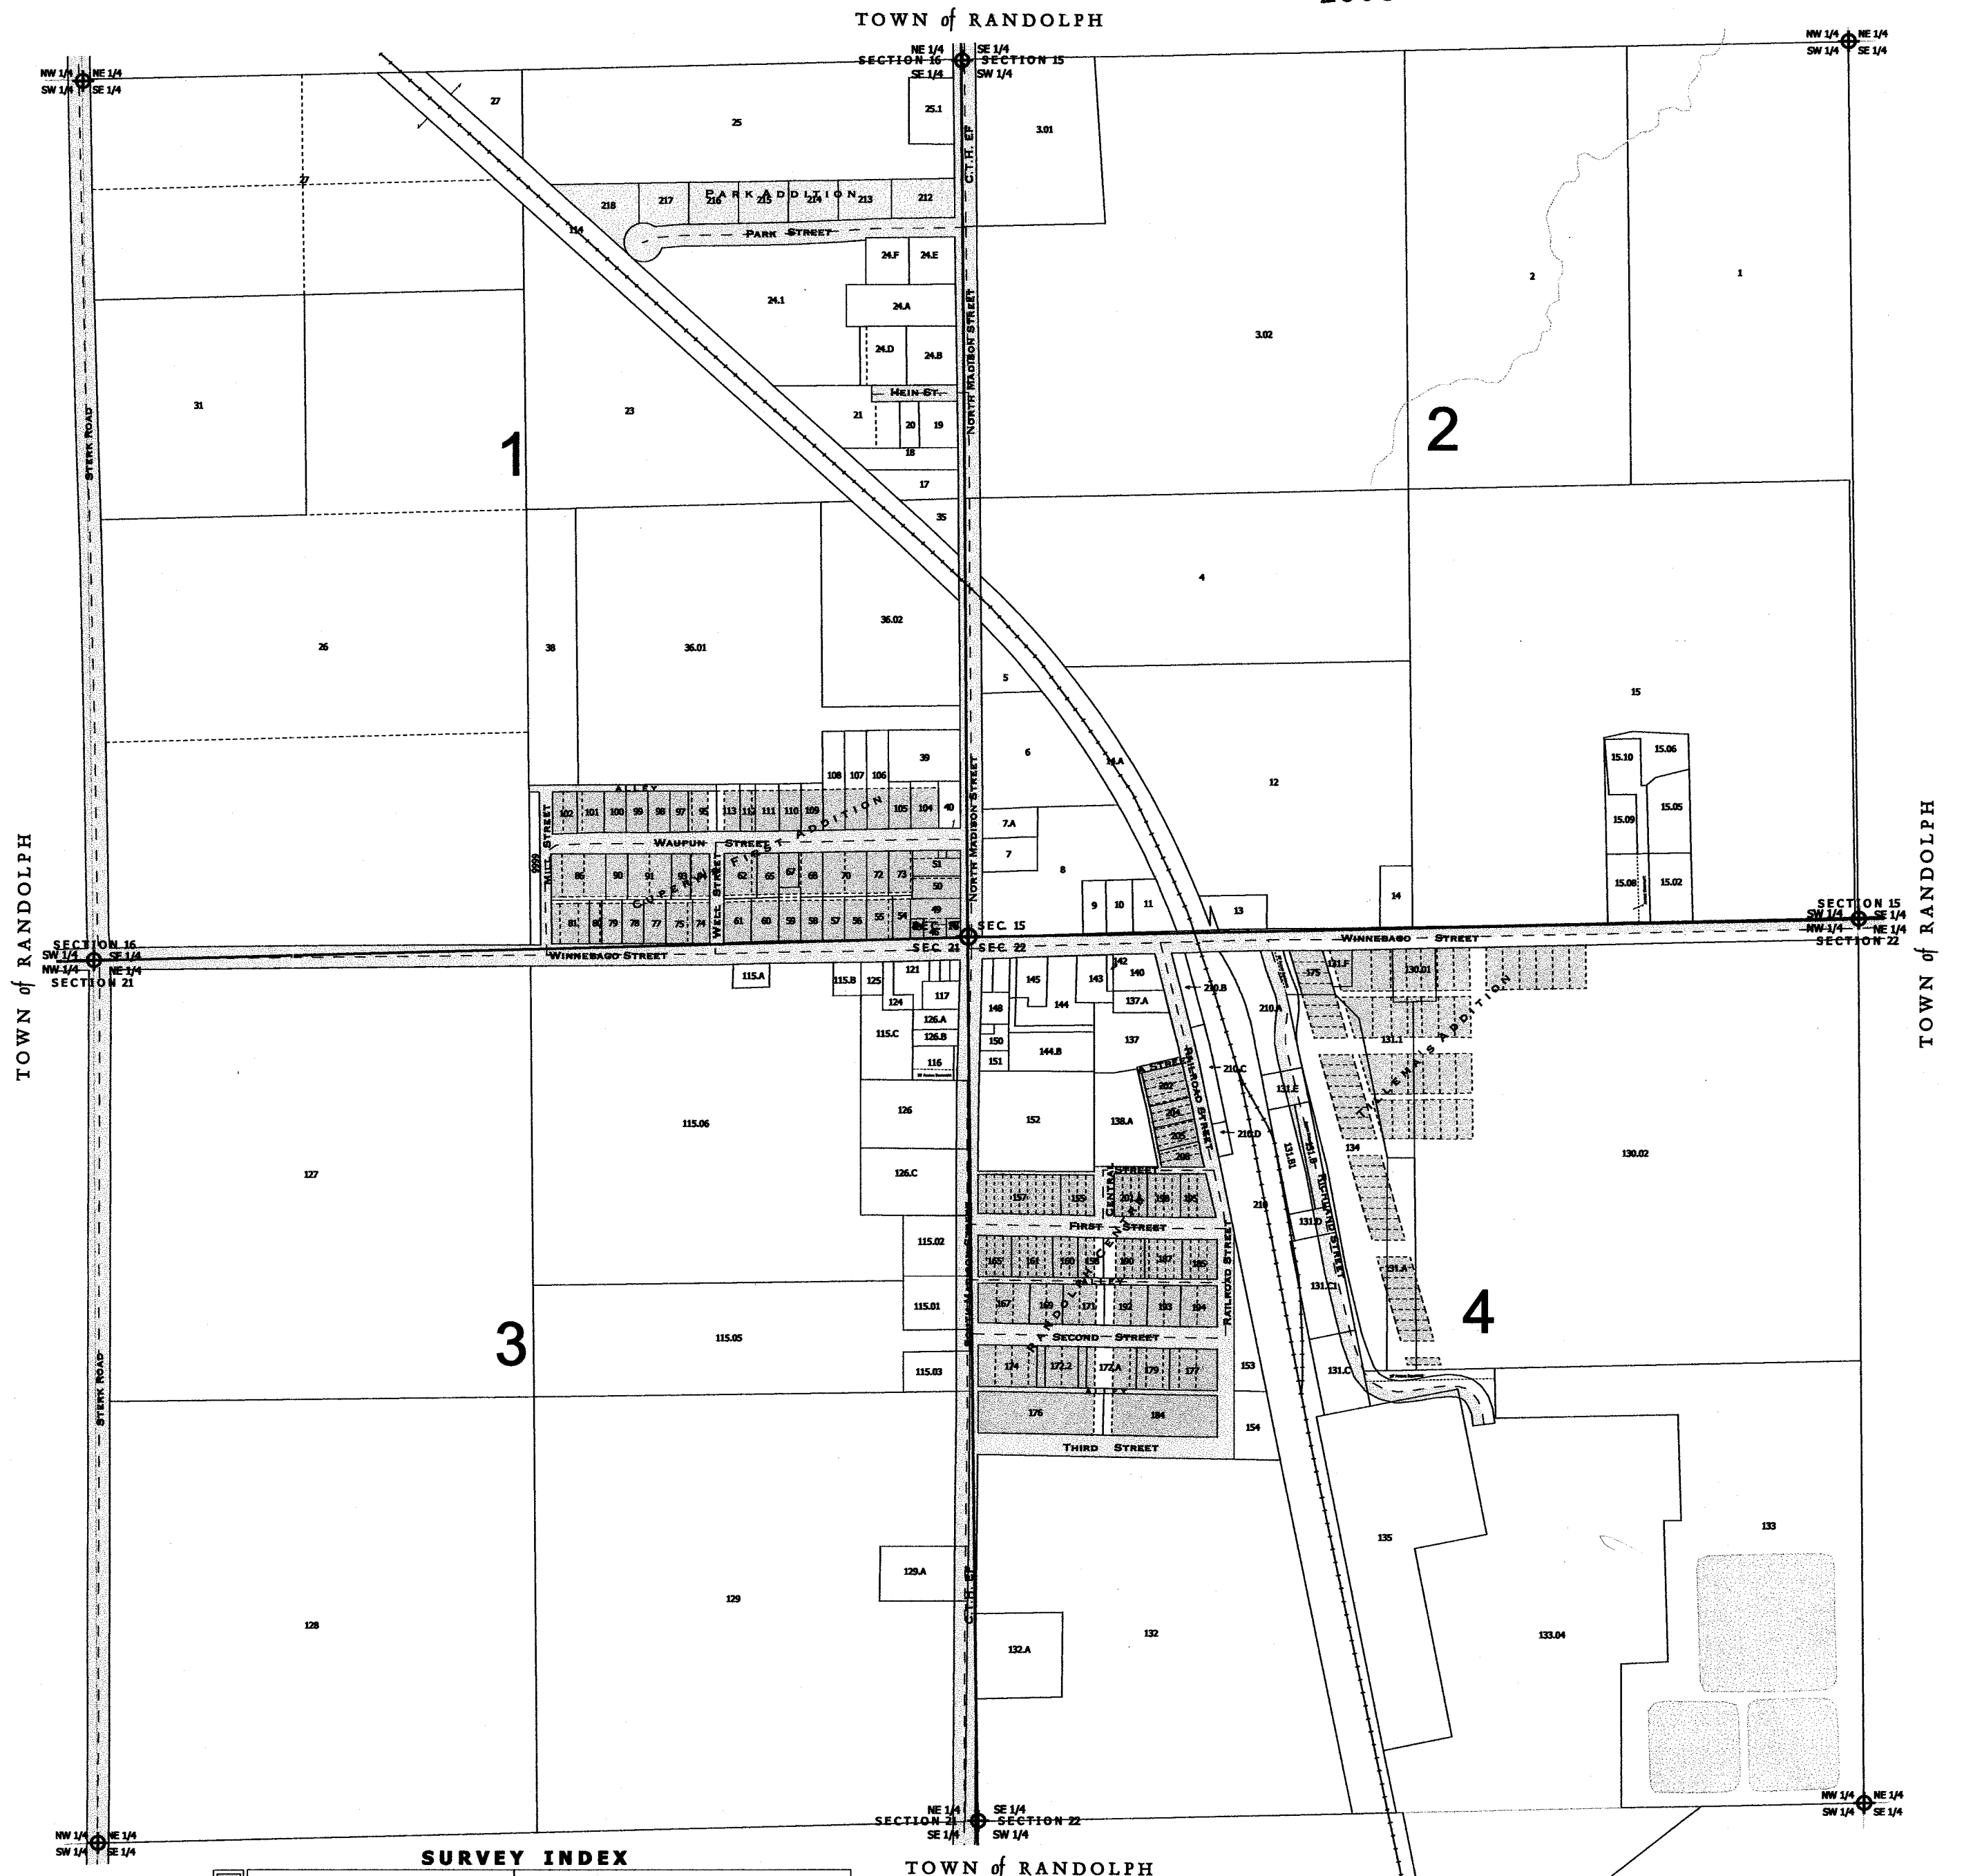

SURVEY INDEX	
	CUPER'S FIRST ADDITION
	PARK ADDITION
	RANDOLPH CENTRE
	TILLEMA'S ADDITION
	COMPOSITE VILLAGE MAP (1972)
REGISTER OF DEEDS - SHEET 18 B	
R.O.D. - 184 B	
R.O.D. - 19	
R.O.D. - 28	
S 0896	

9999 - This number is used to represent tax parcels or a portion of a tax parcel that requires additional research to determine accurate boundaries and/or ownership.

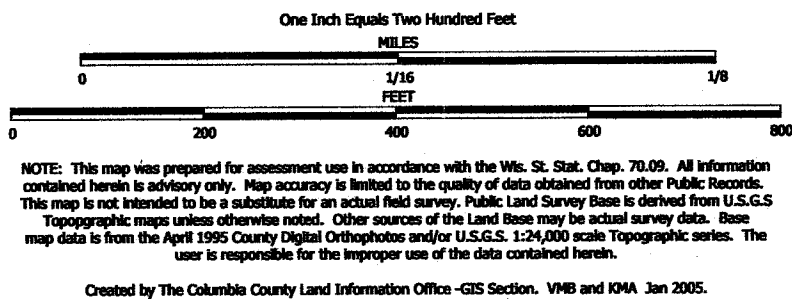


TAX PARCEL MAP


VILLAGE of FRIESLAND

TOWN 13 NORTH RANGE 12 EAST
COLUMBIA COUNTY, WISCONSIN

Replaced
2006

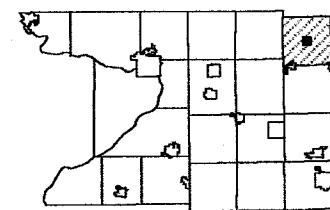

6	5	4	3	2	1
7	8	9	10	11	12
13	14	15	16	17	18
19	20	21	22	23	24
25	26	27	28	29	30
31	32	33	34	35	36

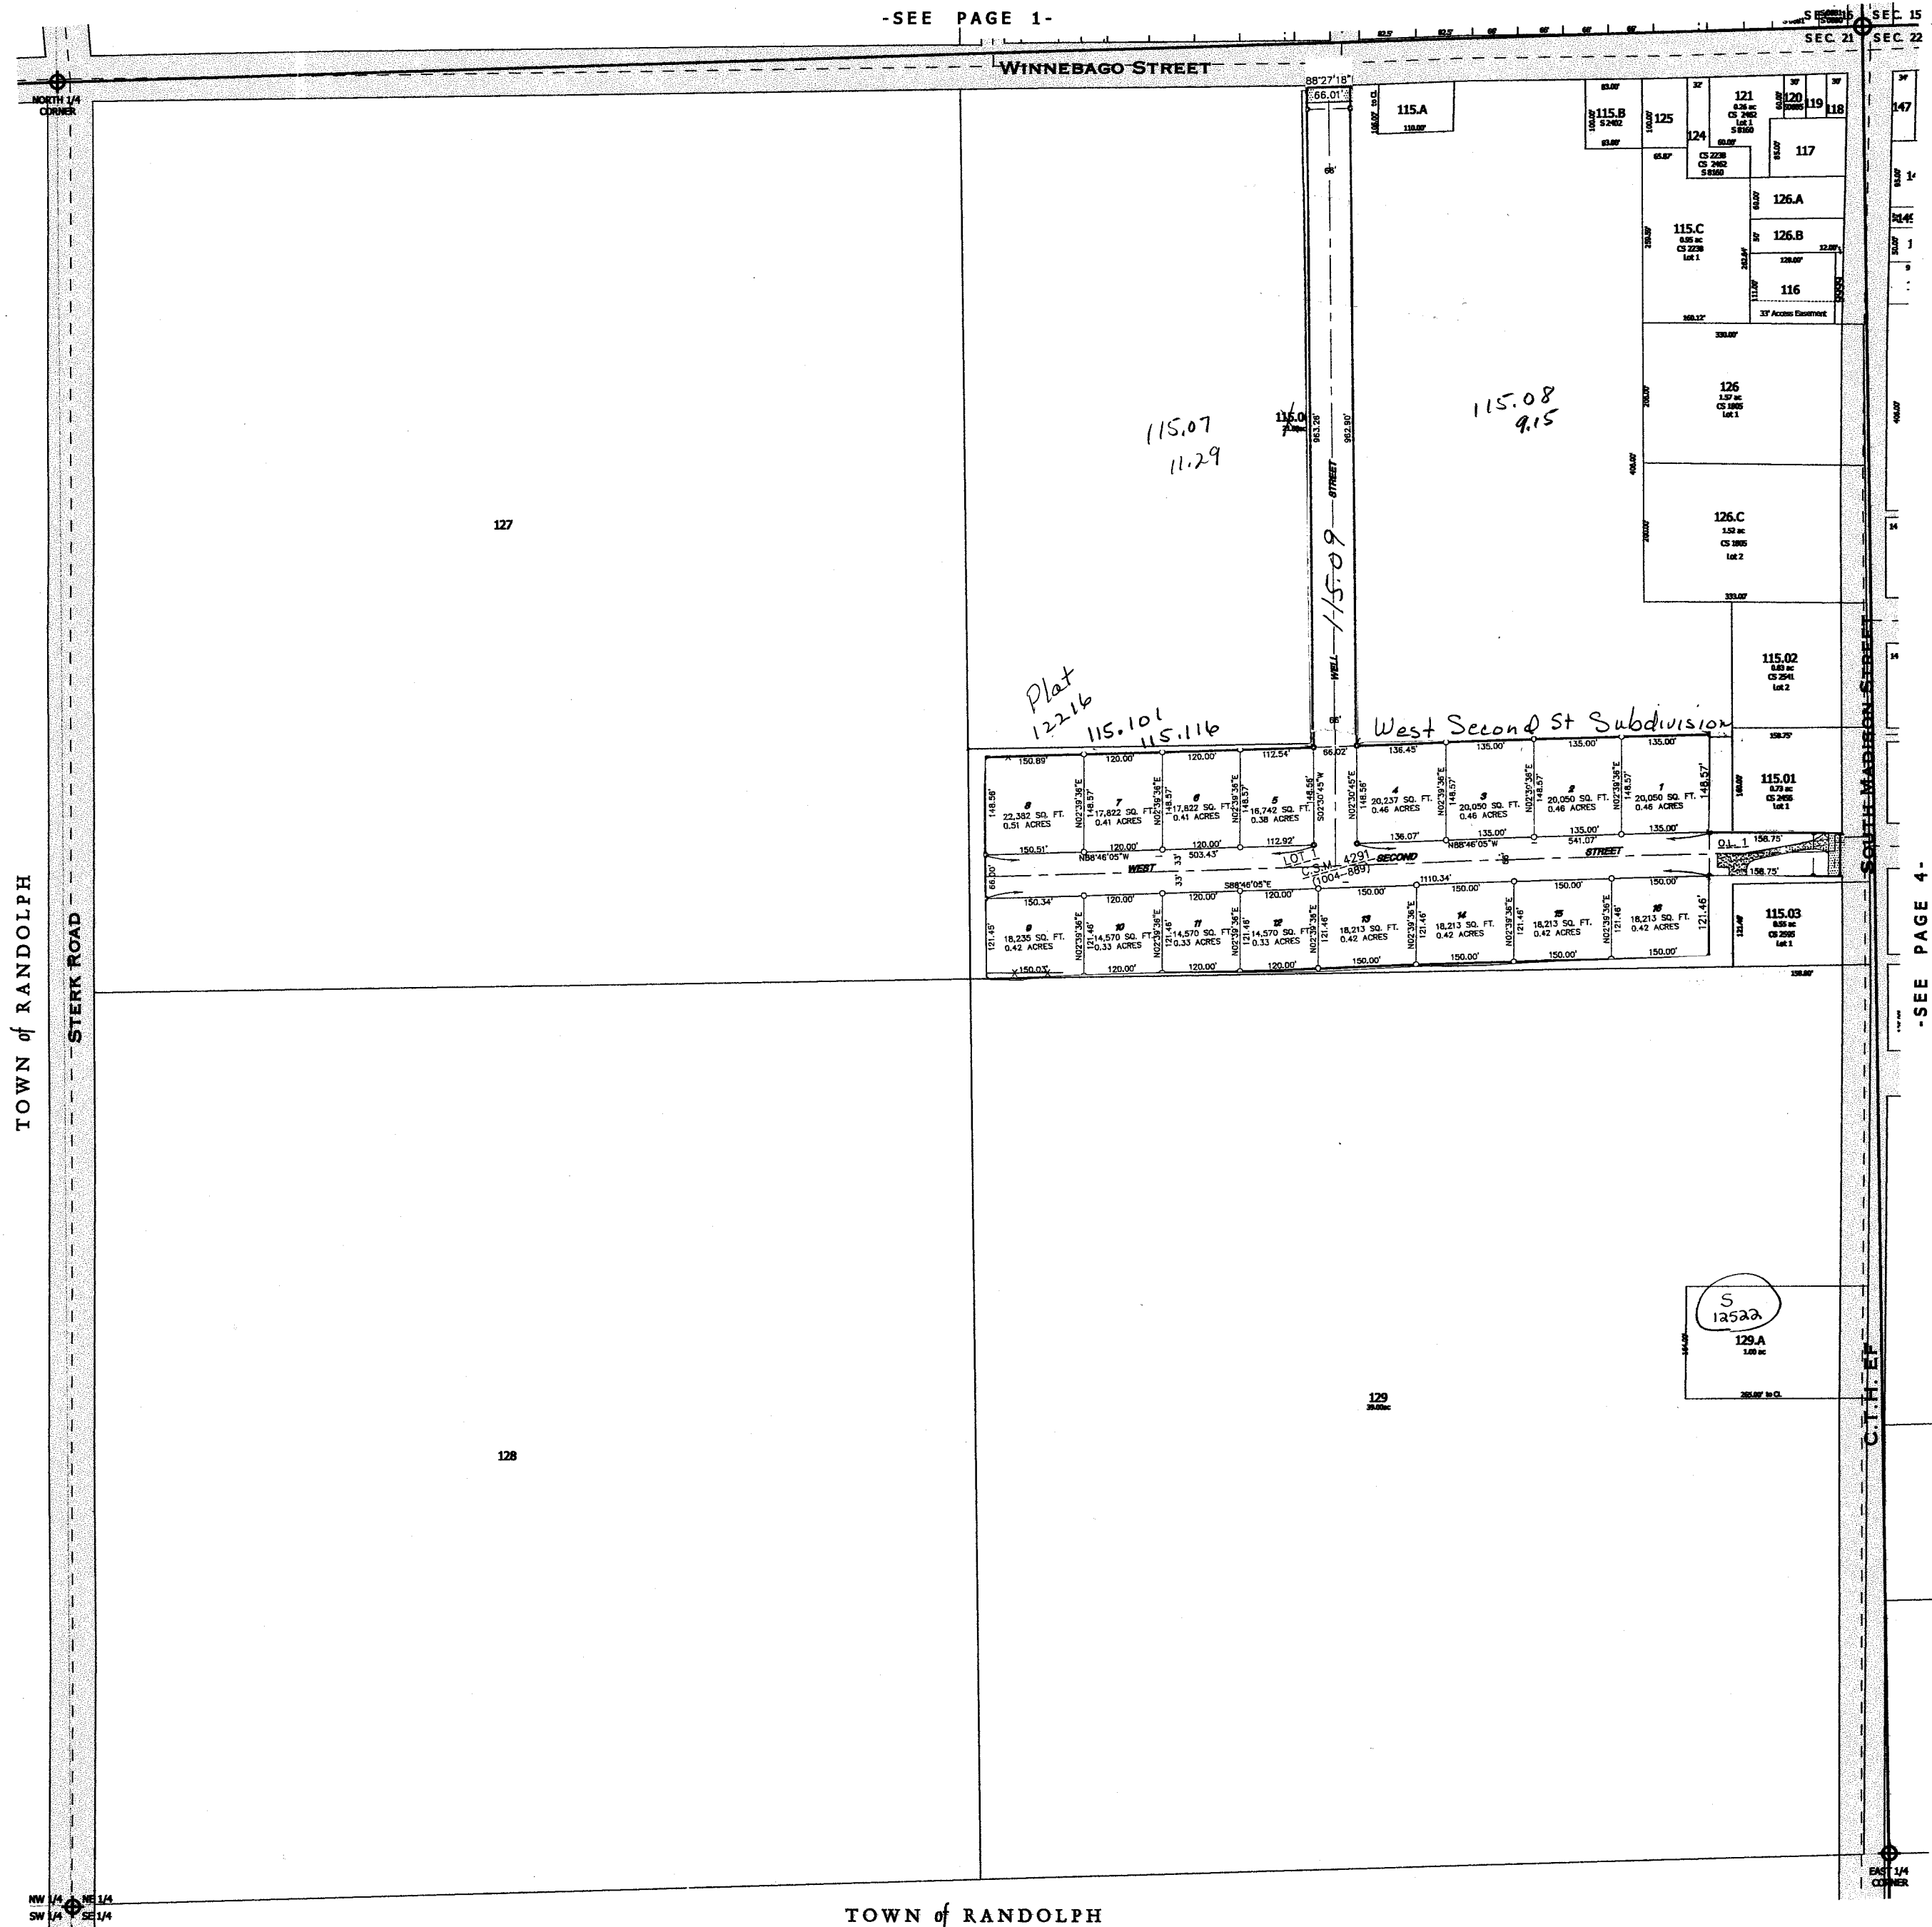

One Inch Equals Two Hundred Feet

MILES
0 1/16 1/8

FEET
0 200 400 600 800

NOTE: This map was prepared for assessment use in accordance with the Wis. Stat. Chap. 70.09. All information contained herein is advisory only. Map accuracy is limited to the quality of data obtained from other Public Records. This map is not intended to be a substitute for an actual field survey. Public Land Survey Base is derived from U.S.G.S Topographic maps unless otherwise noted. Other sources of the Land Base may be actual survey data. Base map data is from the April 1995 County Digital Orthophotos and/or U.S.G.S. 1:24,000 scale Topographic series. The user is responsible for the improper use of the data contained herein.



Created by The Columbia County Land Information Office -GIS Section. VMB and KMA Feb 2005.

TAX PARCEL MAP

VILLAGE of FRIESLAND


TOWN 13 NORTH RANGE 12 EAST
COLUMBIA COUNTY, WISCONSIN

Replaced
2007

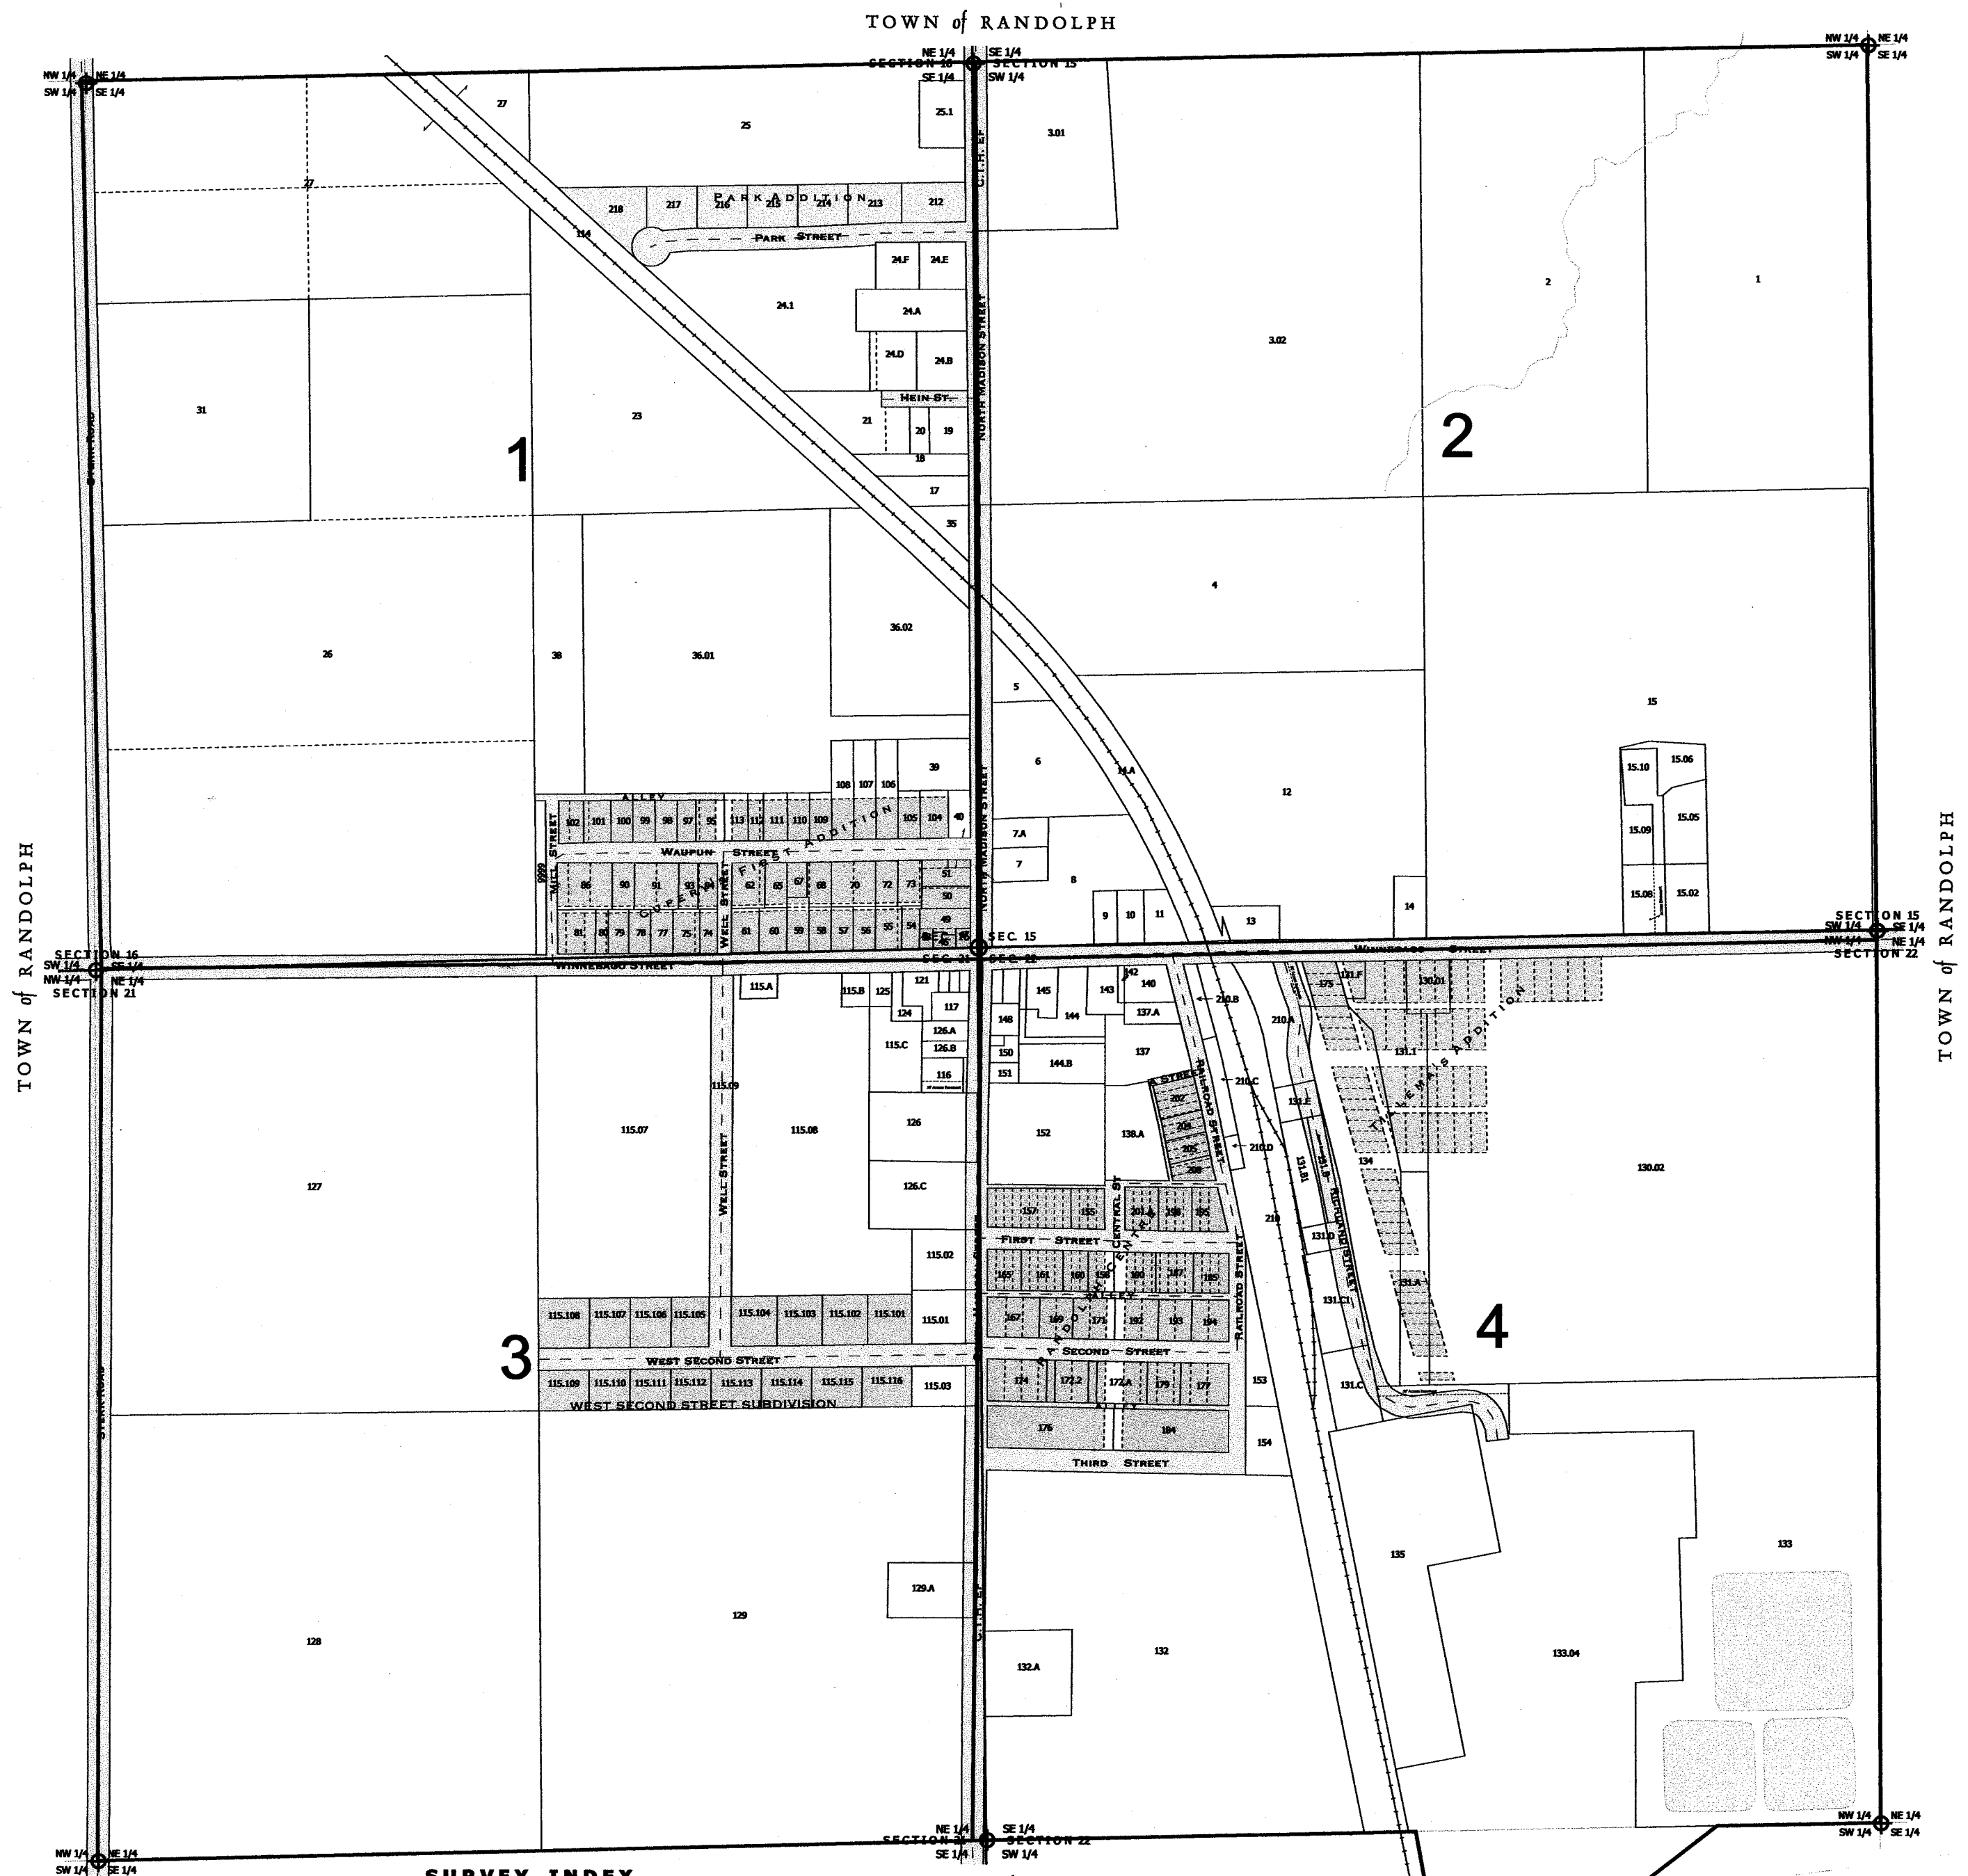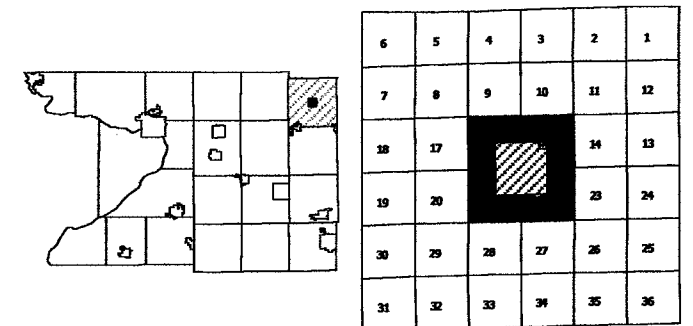

SURVEY INDEX	
CUPERY'S FIRST ADDITION	REGISTER OF DEEDS - SHEET 18 B
PARK ADDITION	R.O.D. - 184 B
RANDOLPH CENTRE	R.O.D. - 19
TILLEMA'S ADDITION	R.O.D. - 28
WEST SECOND STREET SUBDIVISION	S 12216
COMPOSITE VILLAGE MAP (1972)	S 0896


9999 - This number is used to represent tax parcels or a portion of a tax parcel that requires additional research to determine accurate boundaries and/or ownership.

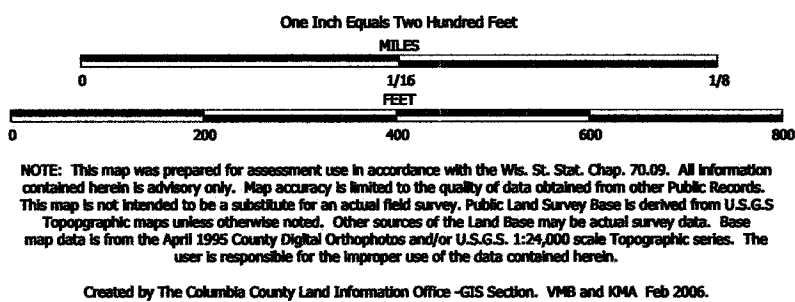

TAX PARCEL MAP

VILLAGE of FRIESLAND


TOWN 13 NORTH RANGE 12 EAST
COLUMBIA COUNTY, WISCONSIN

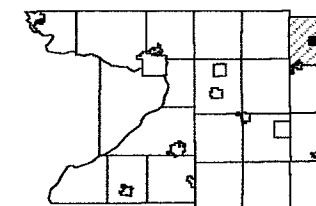

6	5	4	3	2	1
7	8	9	10	11	12
13	14	15	16	17	18
19	20	21	22	23	24
25	26	27	28	29	30
31	32	33	34	35	36


Replaced
2007

-SEE PAGE 1-

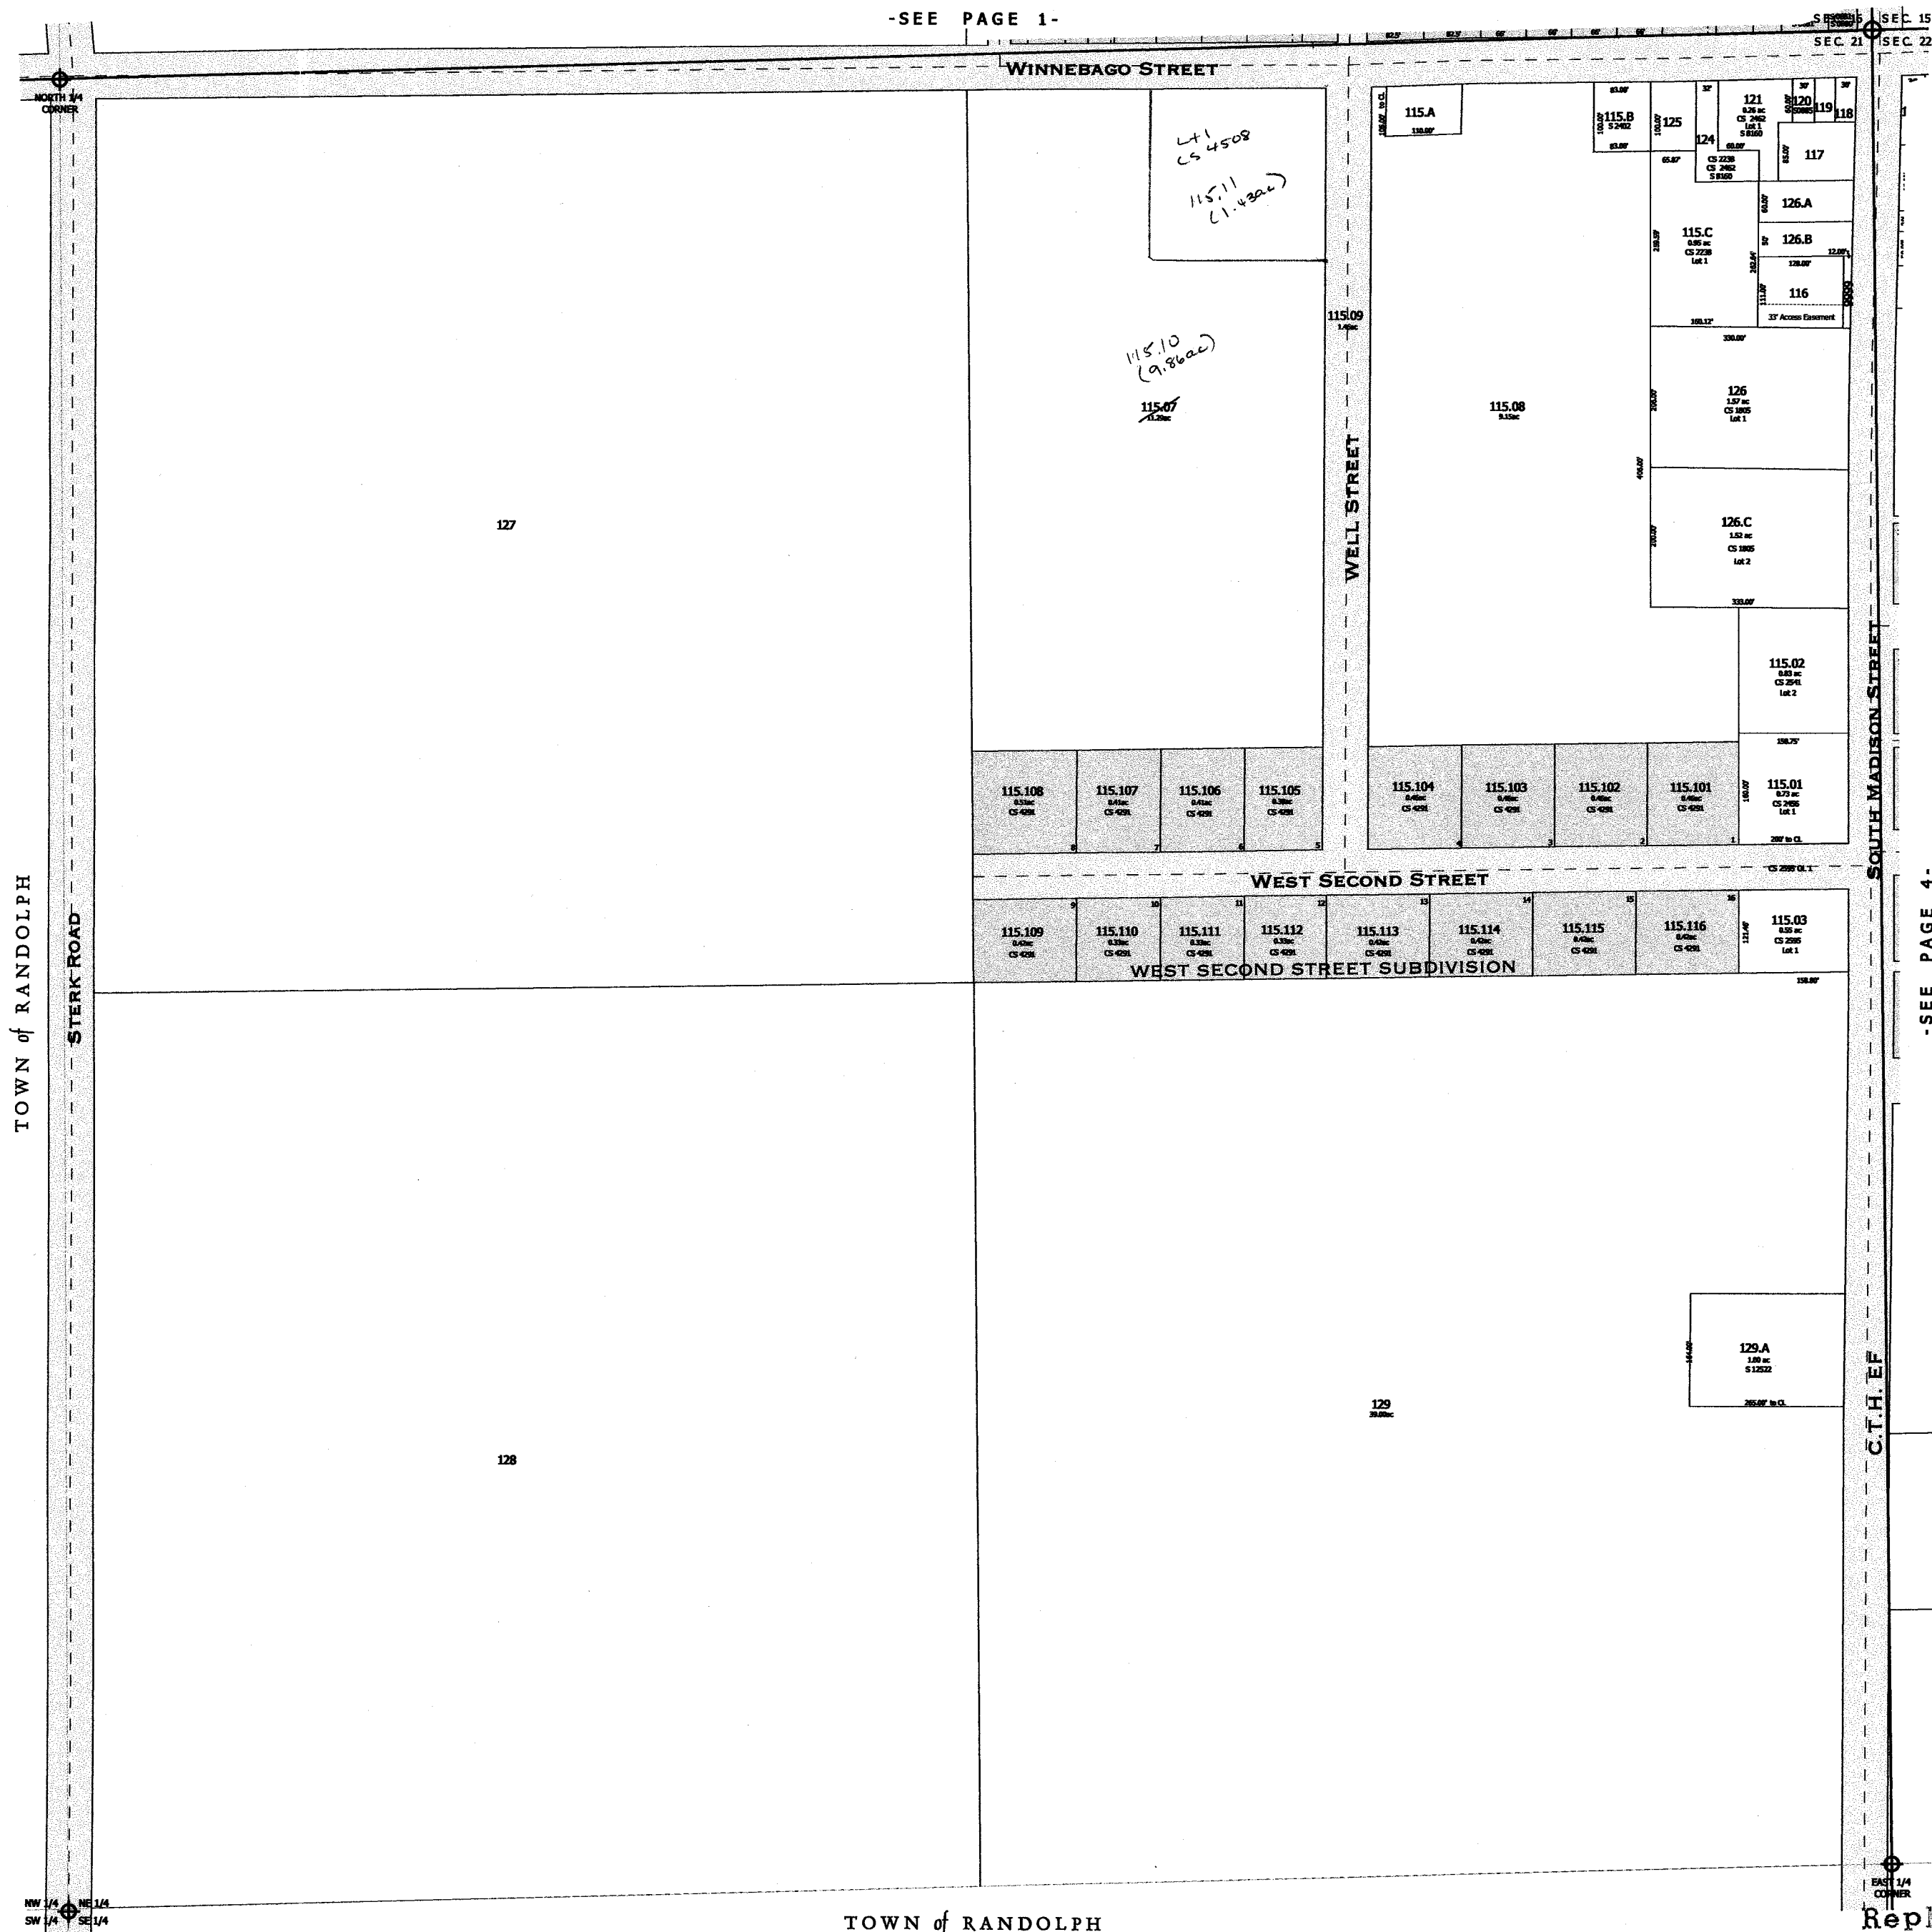


-SEE PAGE 4-

Replaced
2007

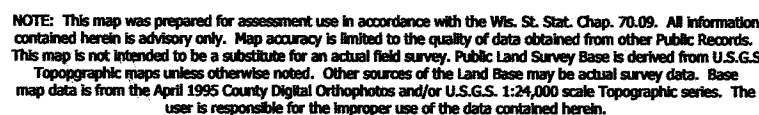


Created by The Columbia County Land Information Office -GIS Section. VMB and KMA Jan 2005

TOWN 13 NORTH RANGE 12 EAST
COLUMBIA COUNTY, WISCONSIN

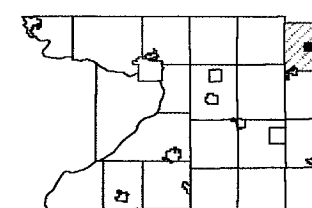

6	5	4	3	2	1
7	8	9	10	11	12
18	17	16		14	13
19	20	21		23	24
30	29	28	27	26	25
31	32	33	34	35	36


-SEE PAGE 2-

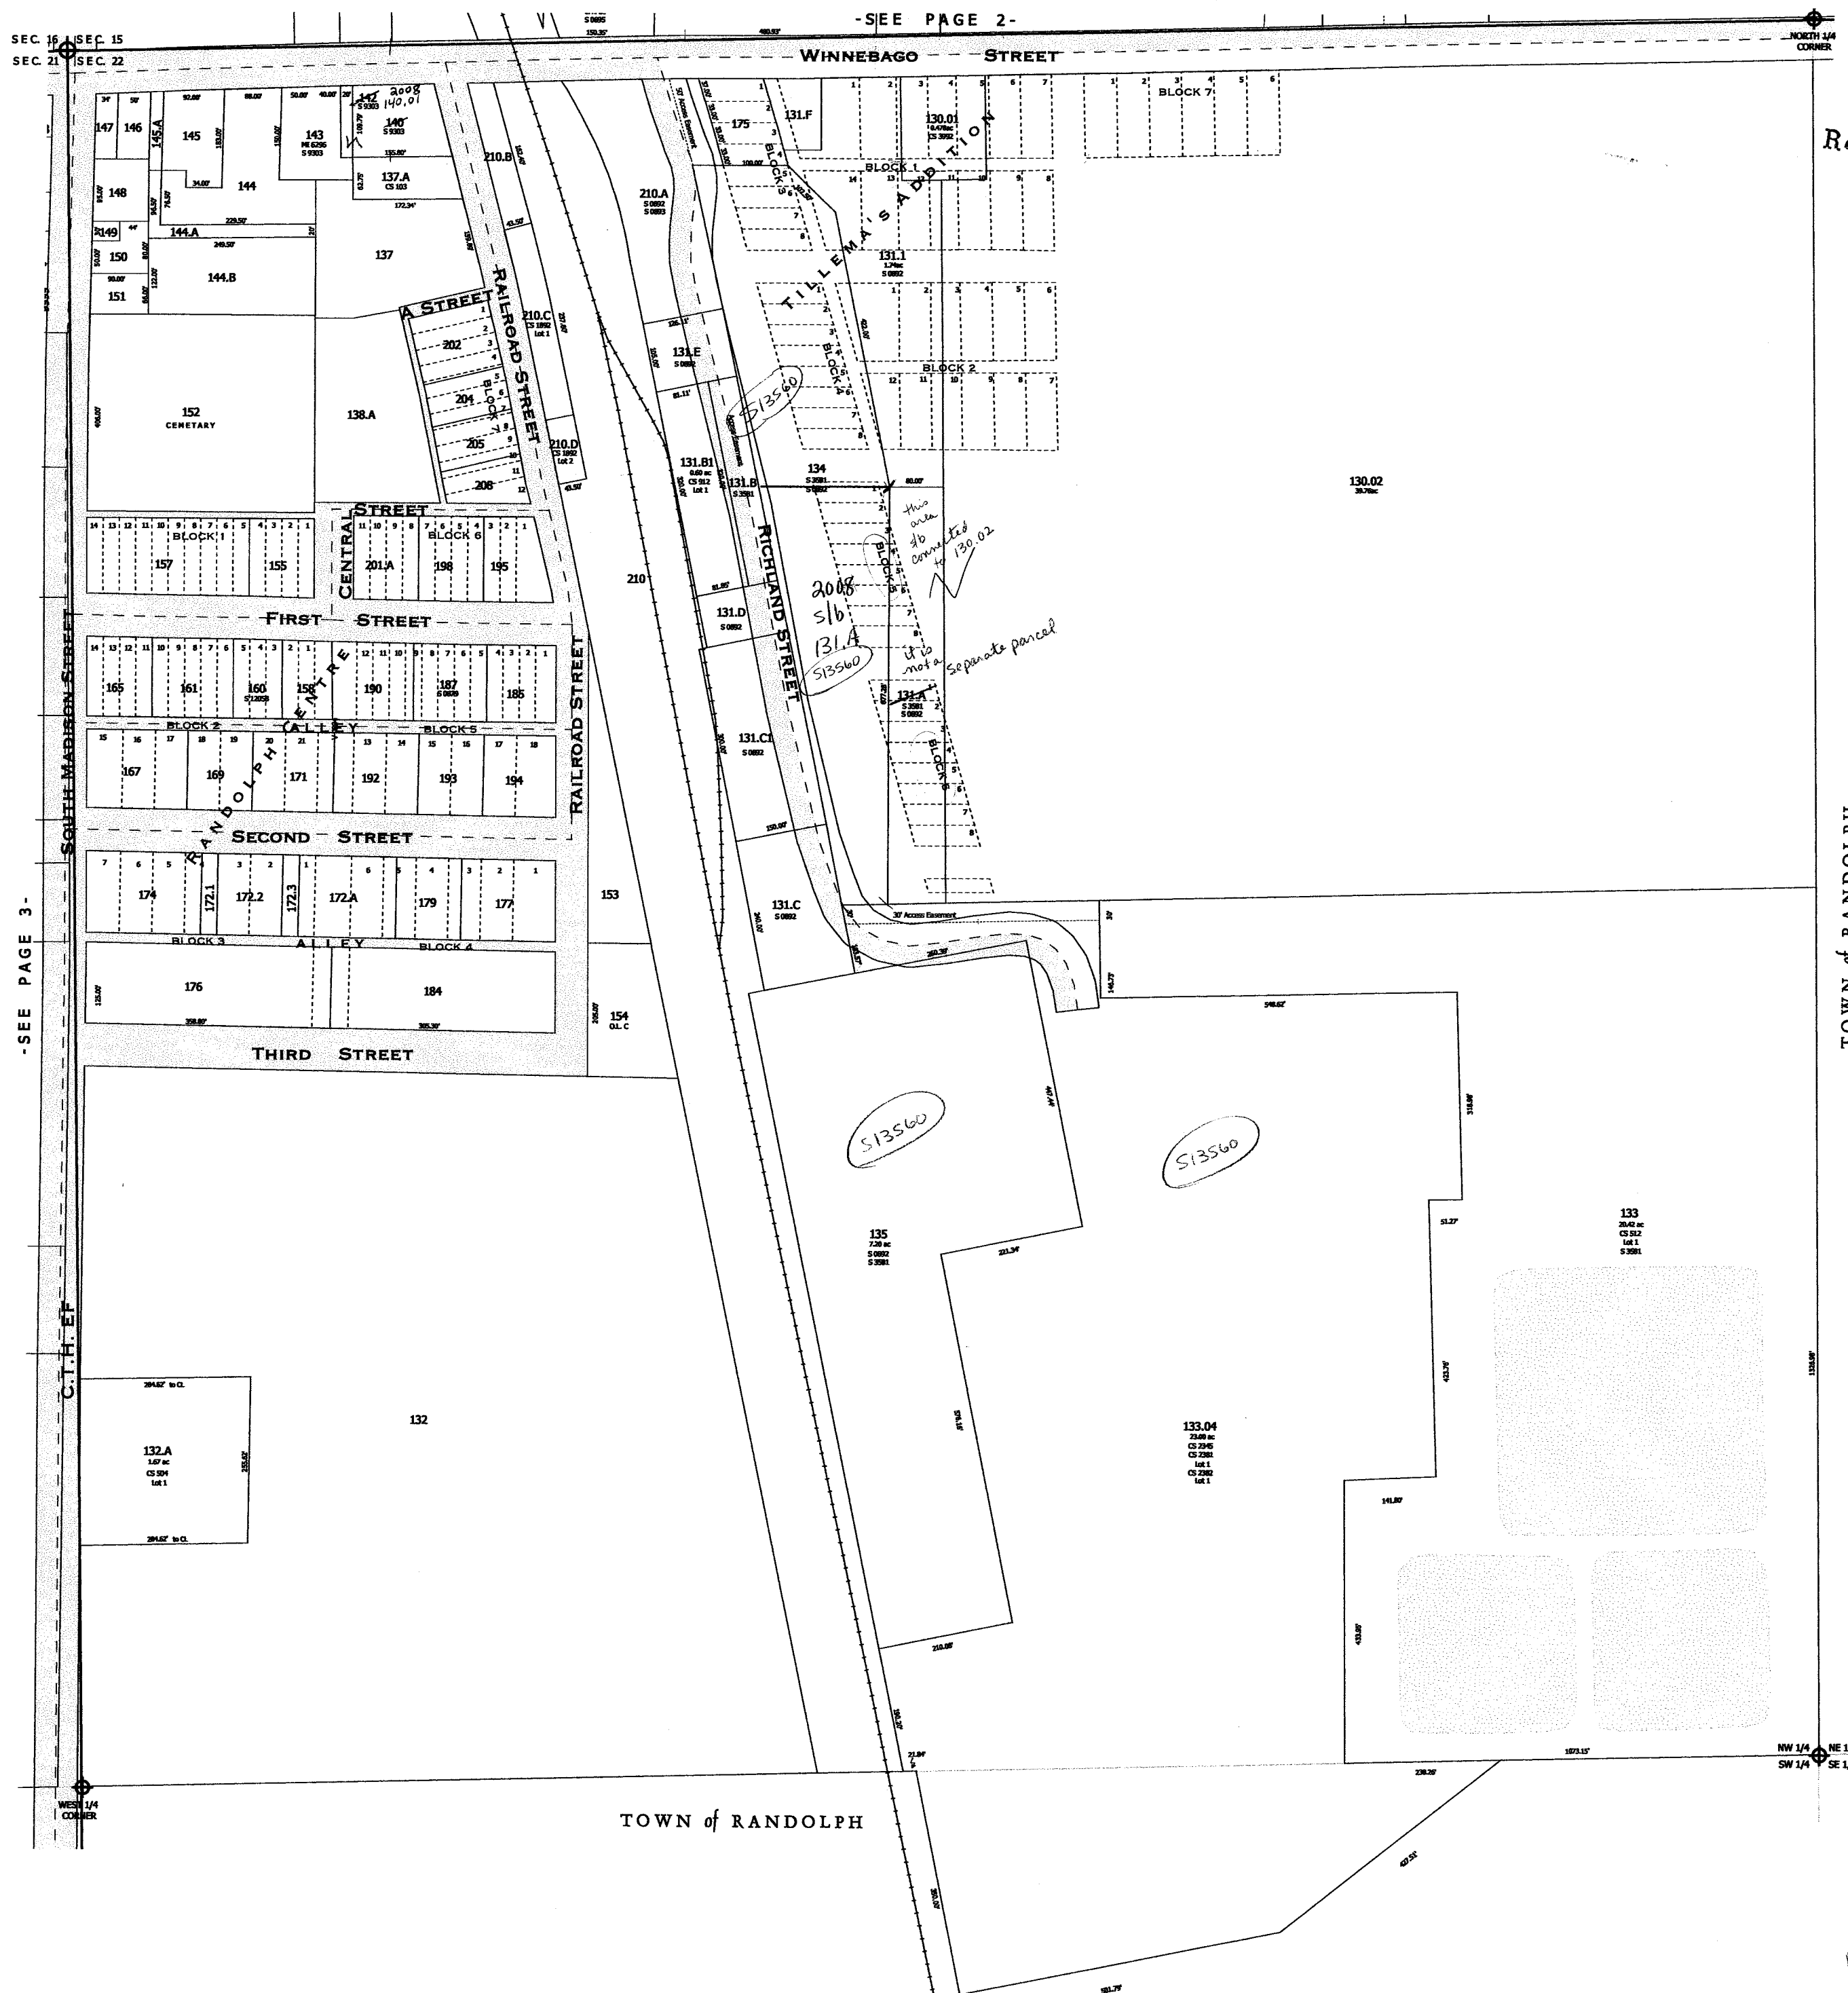

Replace
2009

TOWN of PANDORA


Also
2008

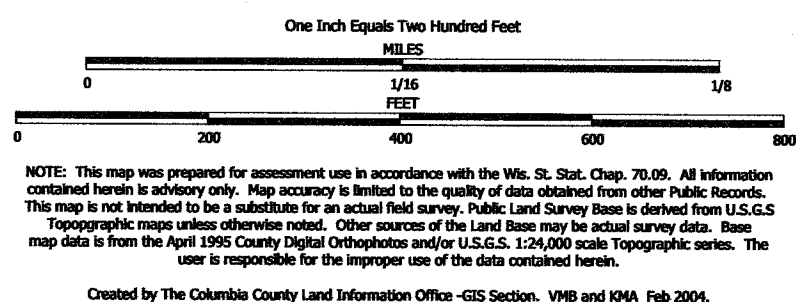

TAX PARCEL MAP

VILLAGE of FRIESLAND


TOWN 13 NORTH RANGE 12 EAST
COLUMBIA COUNTY, WISCONSIN

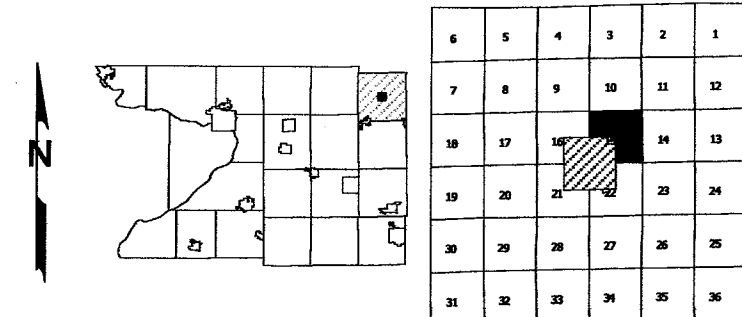

Replaced
2009




-SEE PAGE 4-

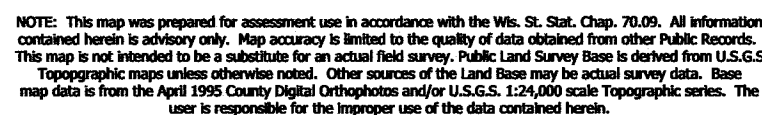

Created by The Columbia County Land Information Office -GIS Section. VMB and KMA Feb 2003


VILLAGE of FRIESLAND

TOWN 13 NORTH RANGE 12 EAST
COLUMBIA COUNTY, WISCONSIN

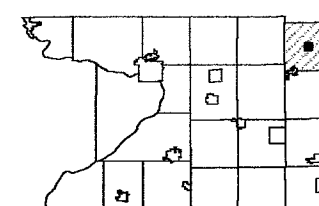

6	5	4	3	2	1
7	8	9	10	11	12
18	17			14	13
19	20	21	22	23	24
30	29	28	27	26	25
31	32	33	34	35	36

Replaced
2009

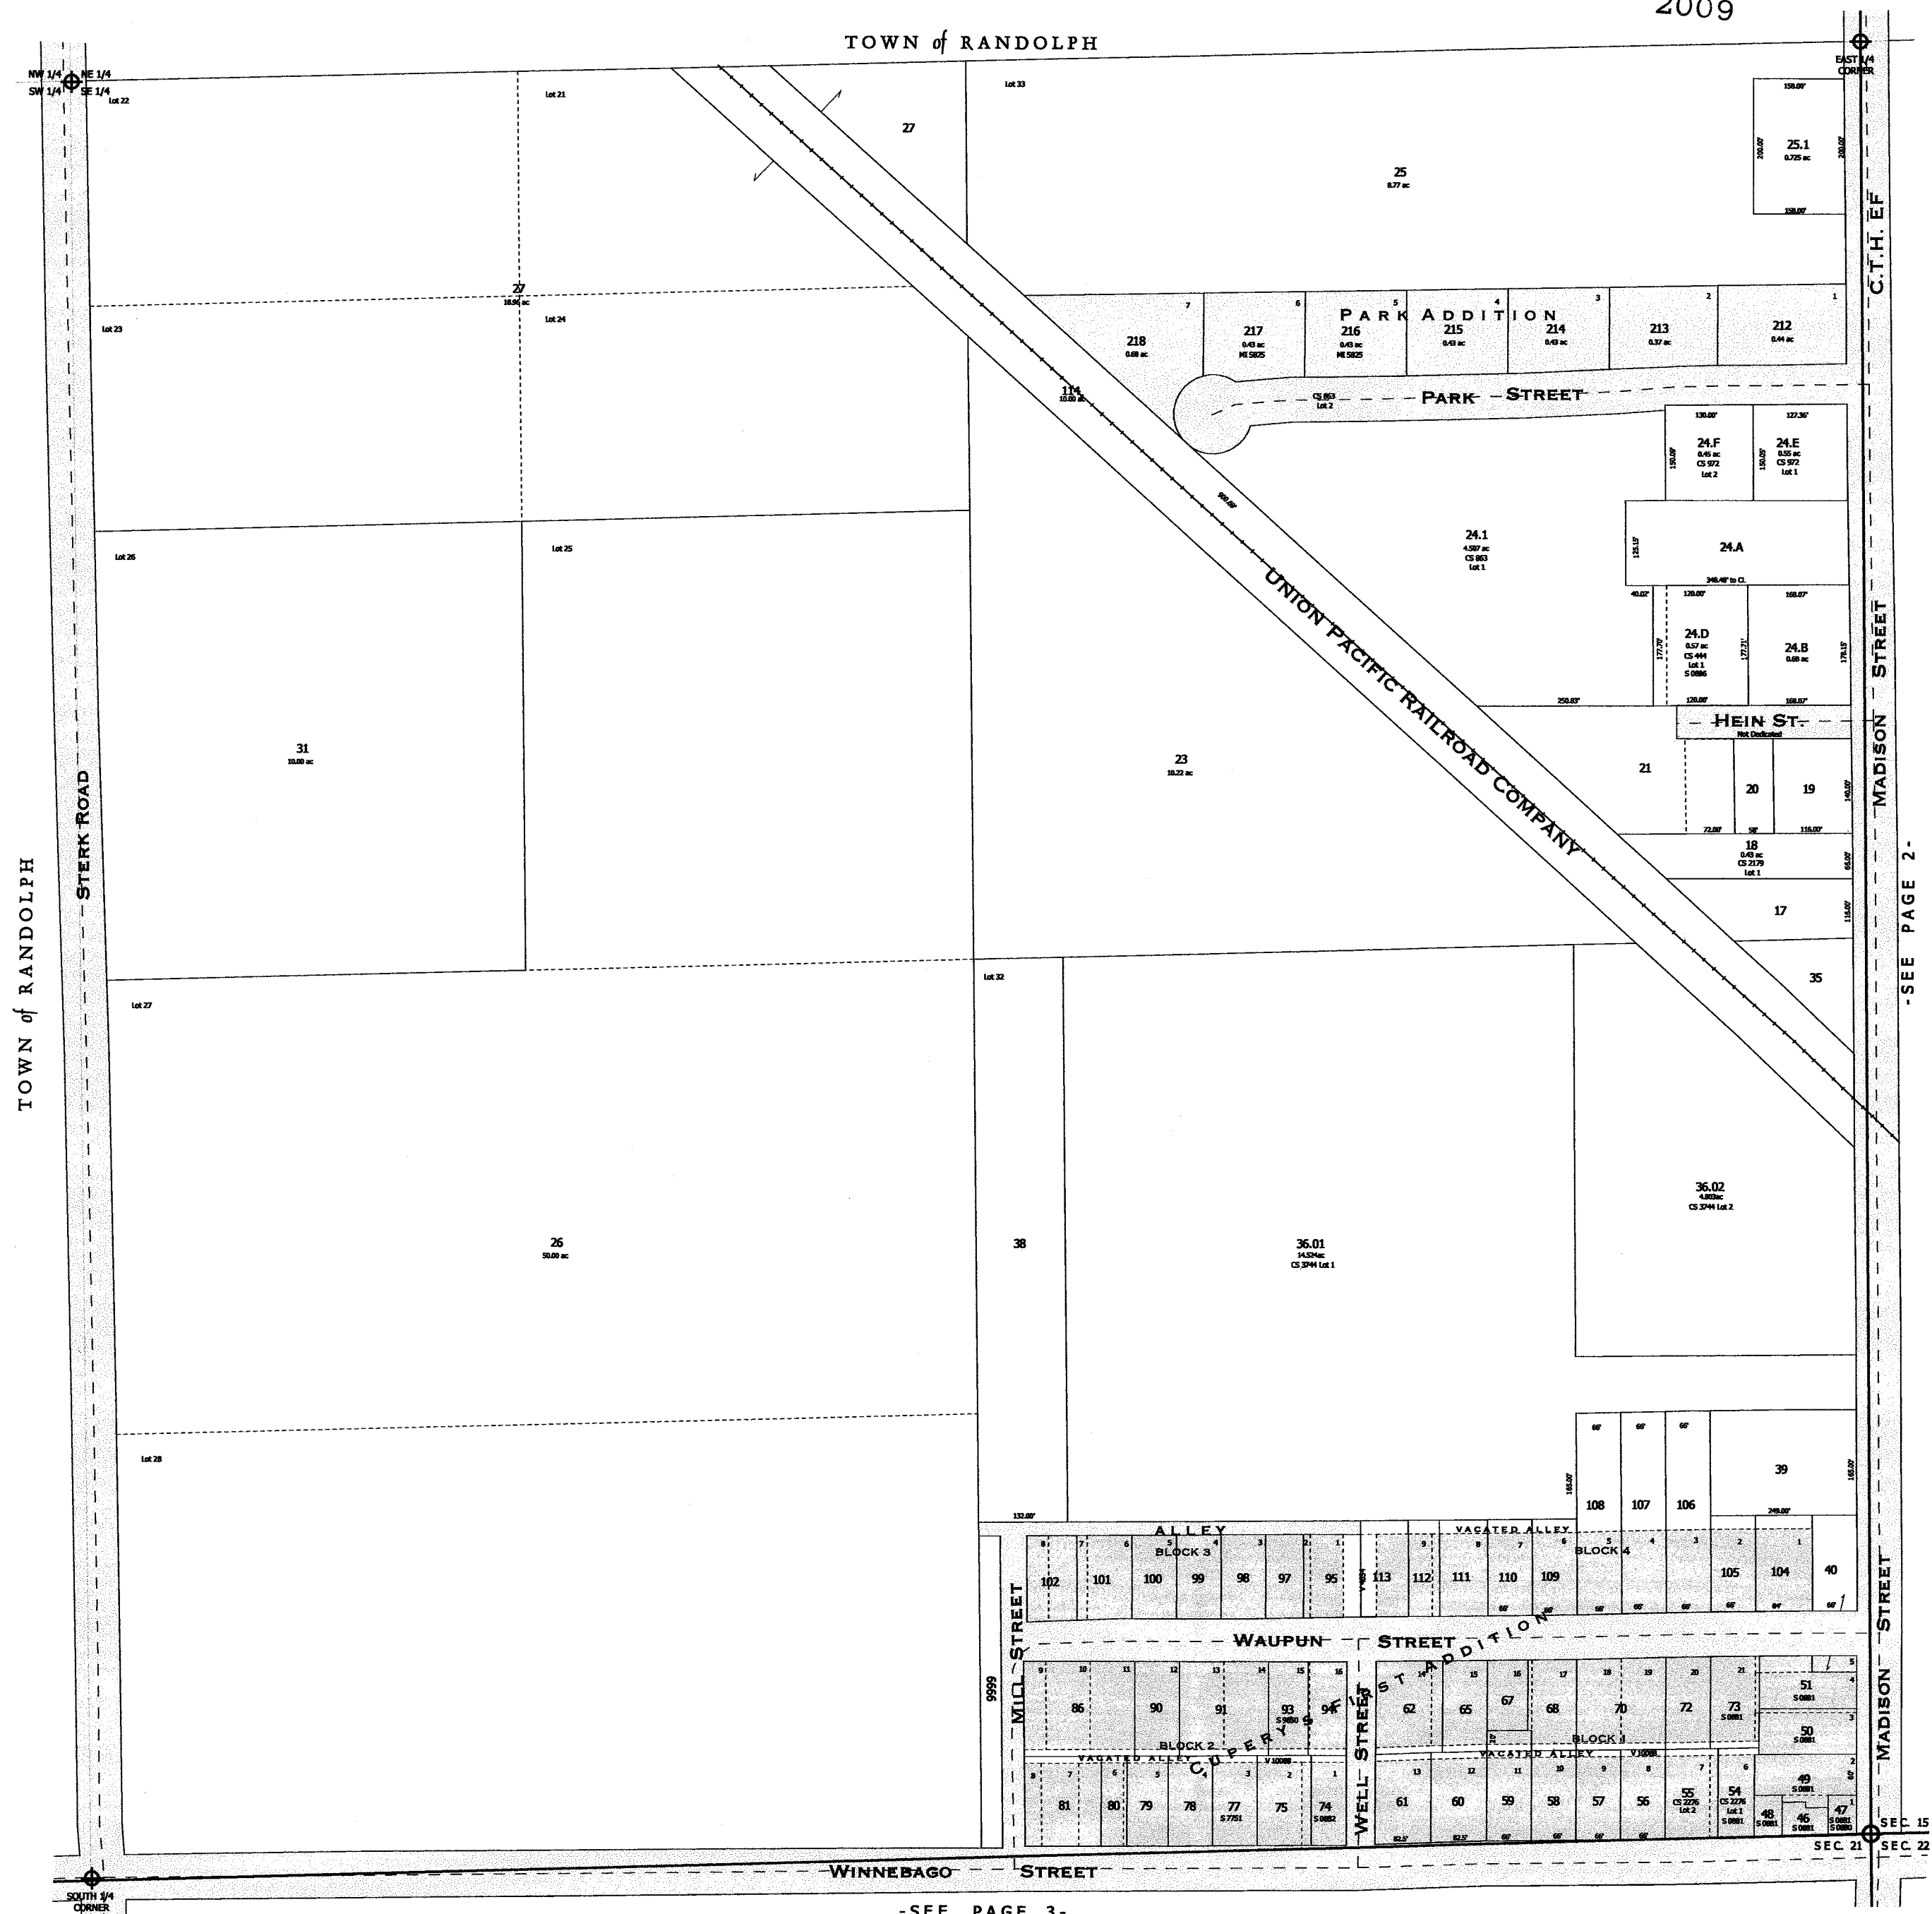

-SEE PAGE 3-

One Inch Equals Two Hundred Feet

NOTE: This map was prepared for assessment use in accordance with the Wis. St. Stat. Chap. 70.09. All information contained herein is advisory only. Map accuracy is limited to the quality of data obtained from other Public Records. This map is not intended to be a substitute for an actual field survey. Public Land Survey Base is derived from U.S.G.S. Topographic maps unless otherwise noted. Other sources of the Land Base may be actual survey data. Base map data is from the April 1995 County Digital Orthophotos and/or U.S.G.S. 1:24,000 scale Topographic series. The user is responsible for the improper use of the data contained herein.


Created by The Columbia County Land Information Office -GIS Section. VMB and KMA. Feb 2007

TAX PARCEL MAP


VILLAGE of FRIESLAND

TOWN 13 NORTH RANGE 12 EAST
COLUMBIA COUNTY, WISCONSIN


6	5	4	3	2	1
7	8	9	10	11	12
13	14	15	16	17	18
19	20	21	22	23	24
25	26	27	28	29	30
31	32	33	34	35	36

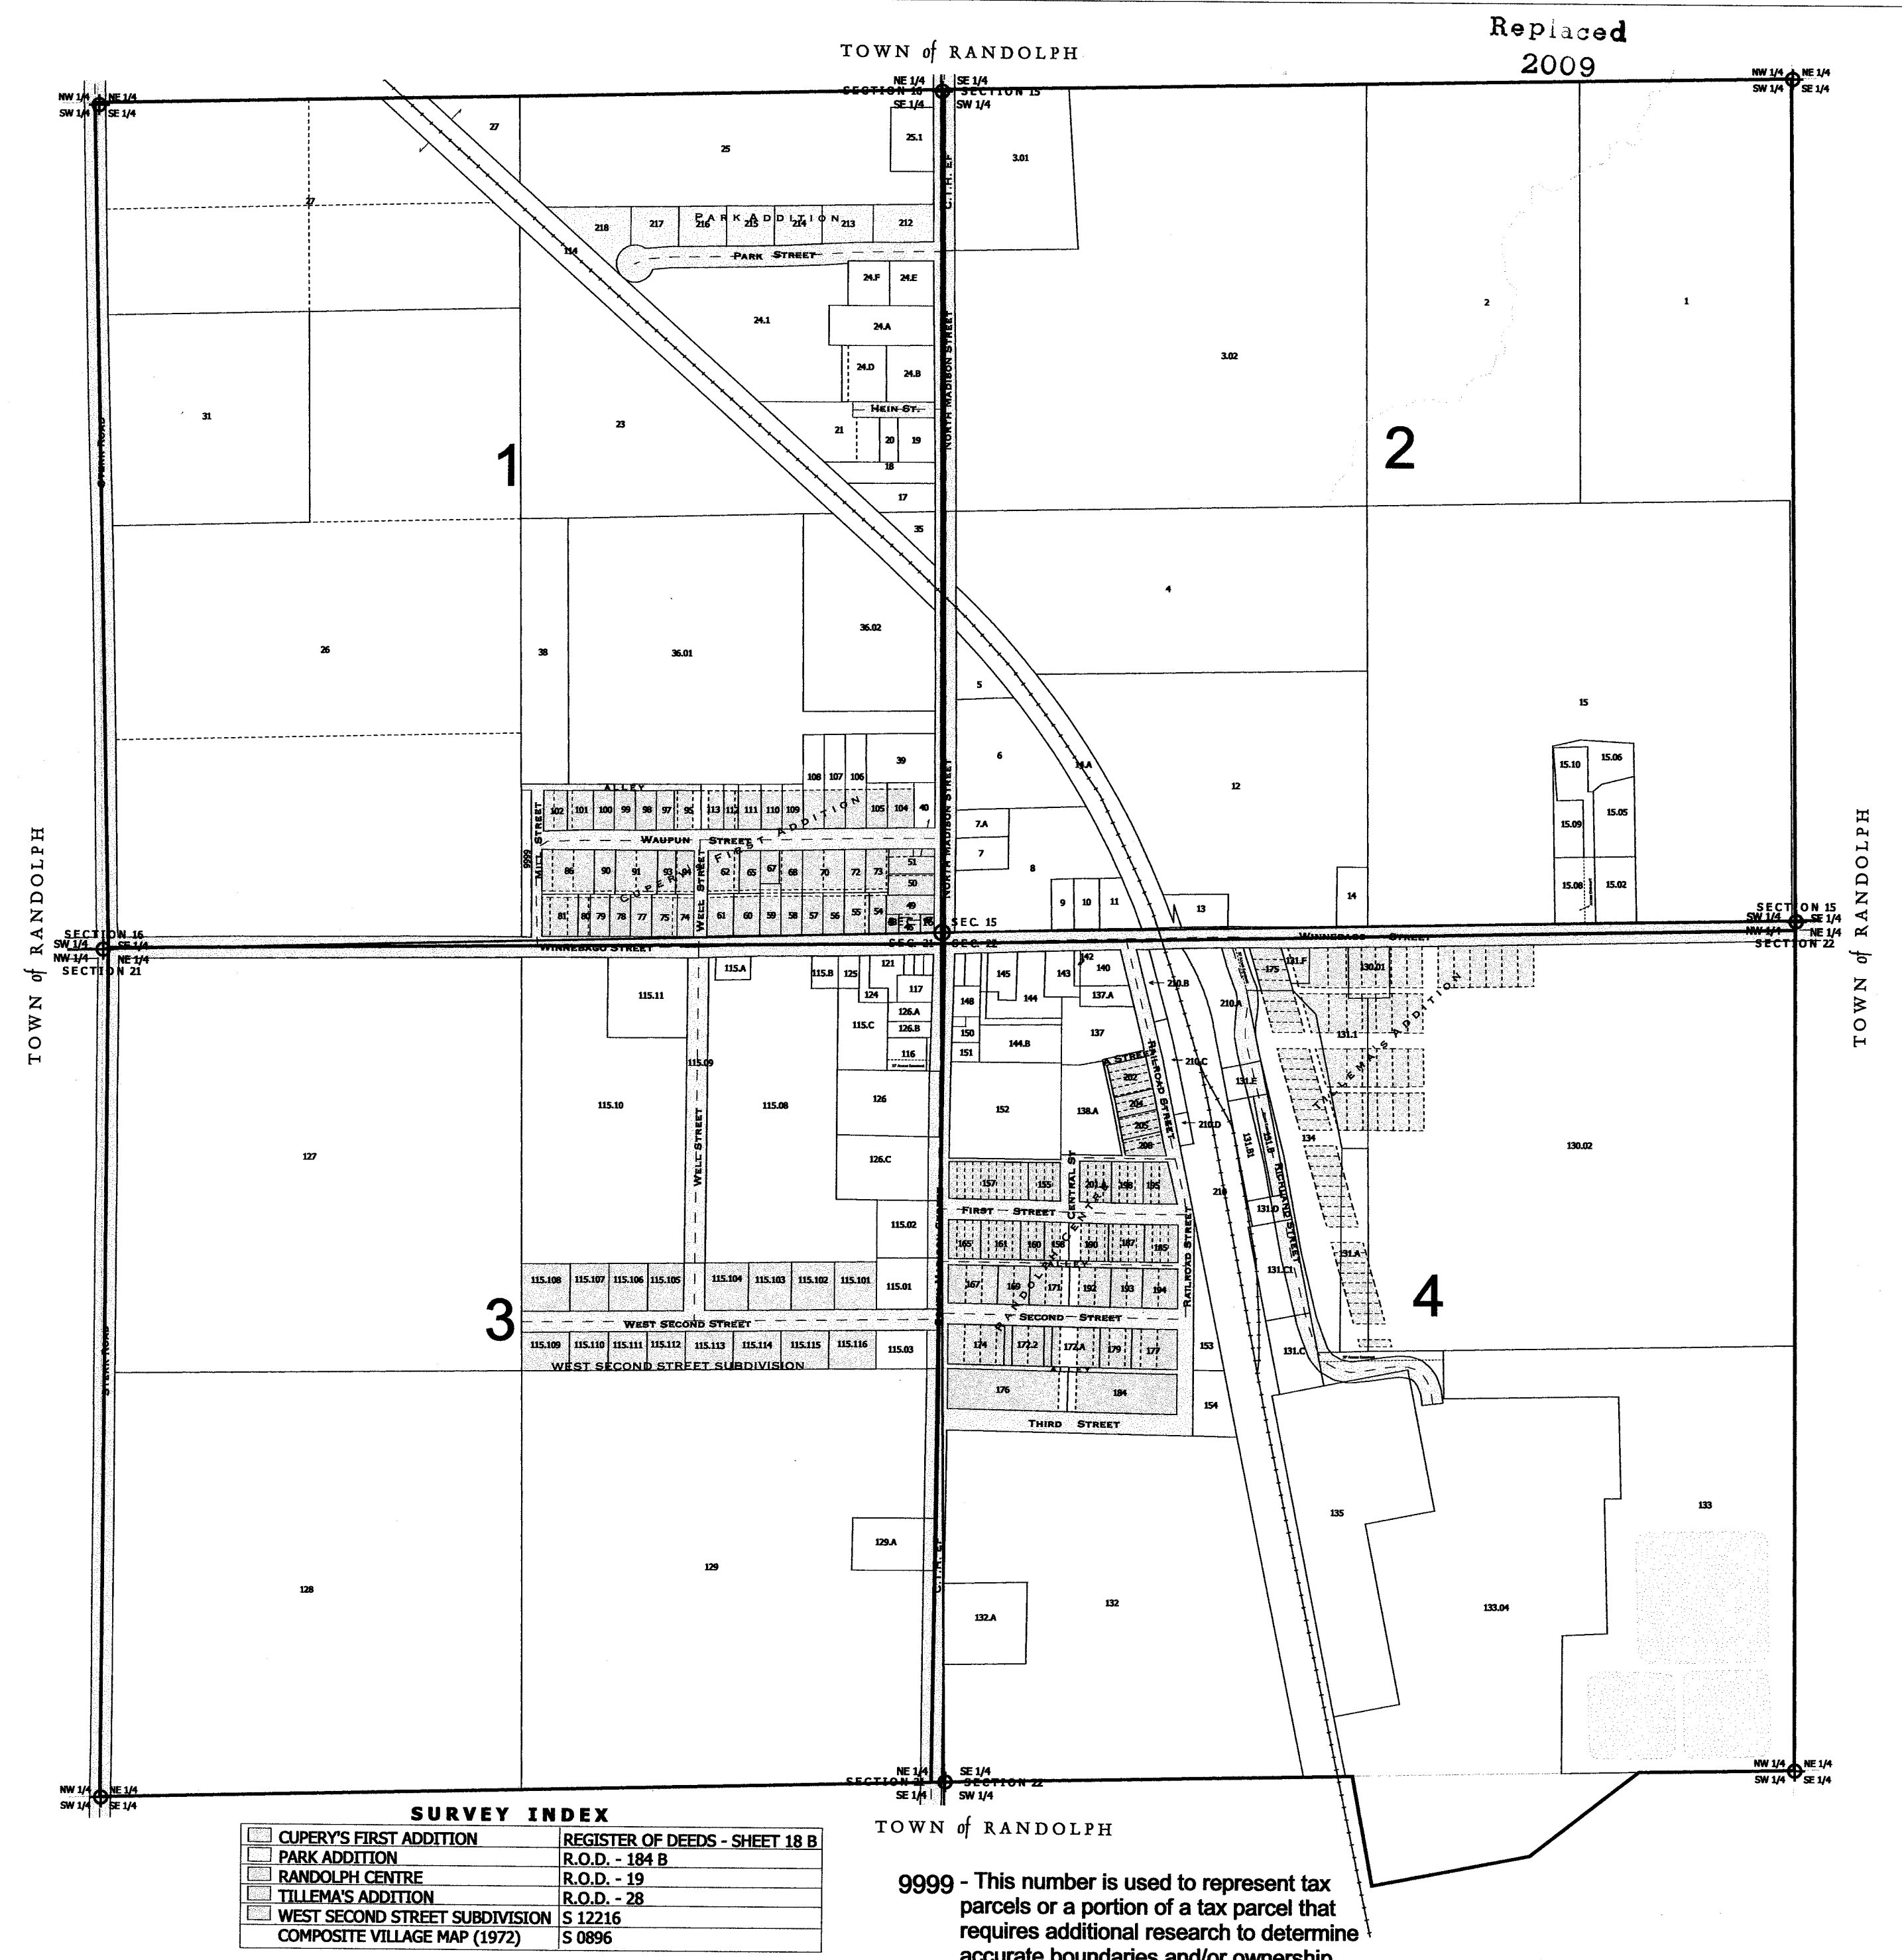

VILLAGE OF FRIESLAND

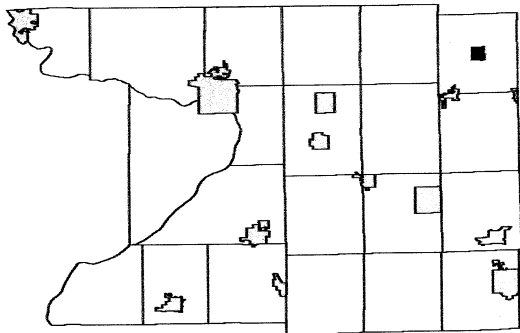


6	5	4	3	2	1
7	8	9	10	11	12
18	17	16	15	14	13
19	20	21	22	23	24
30	29	28	27	26	25
31	32	33	34	35	36

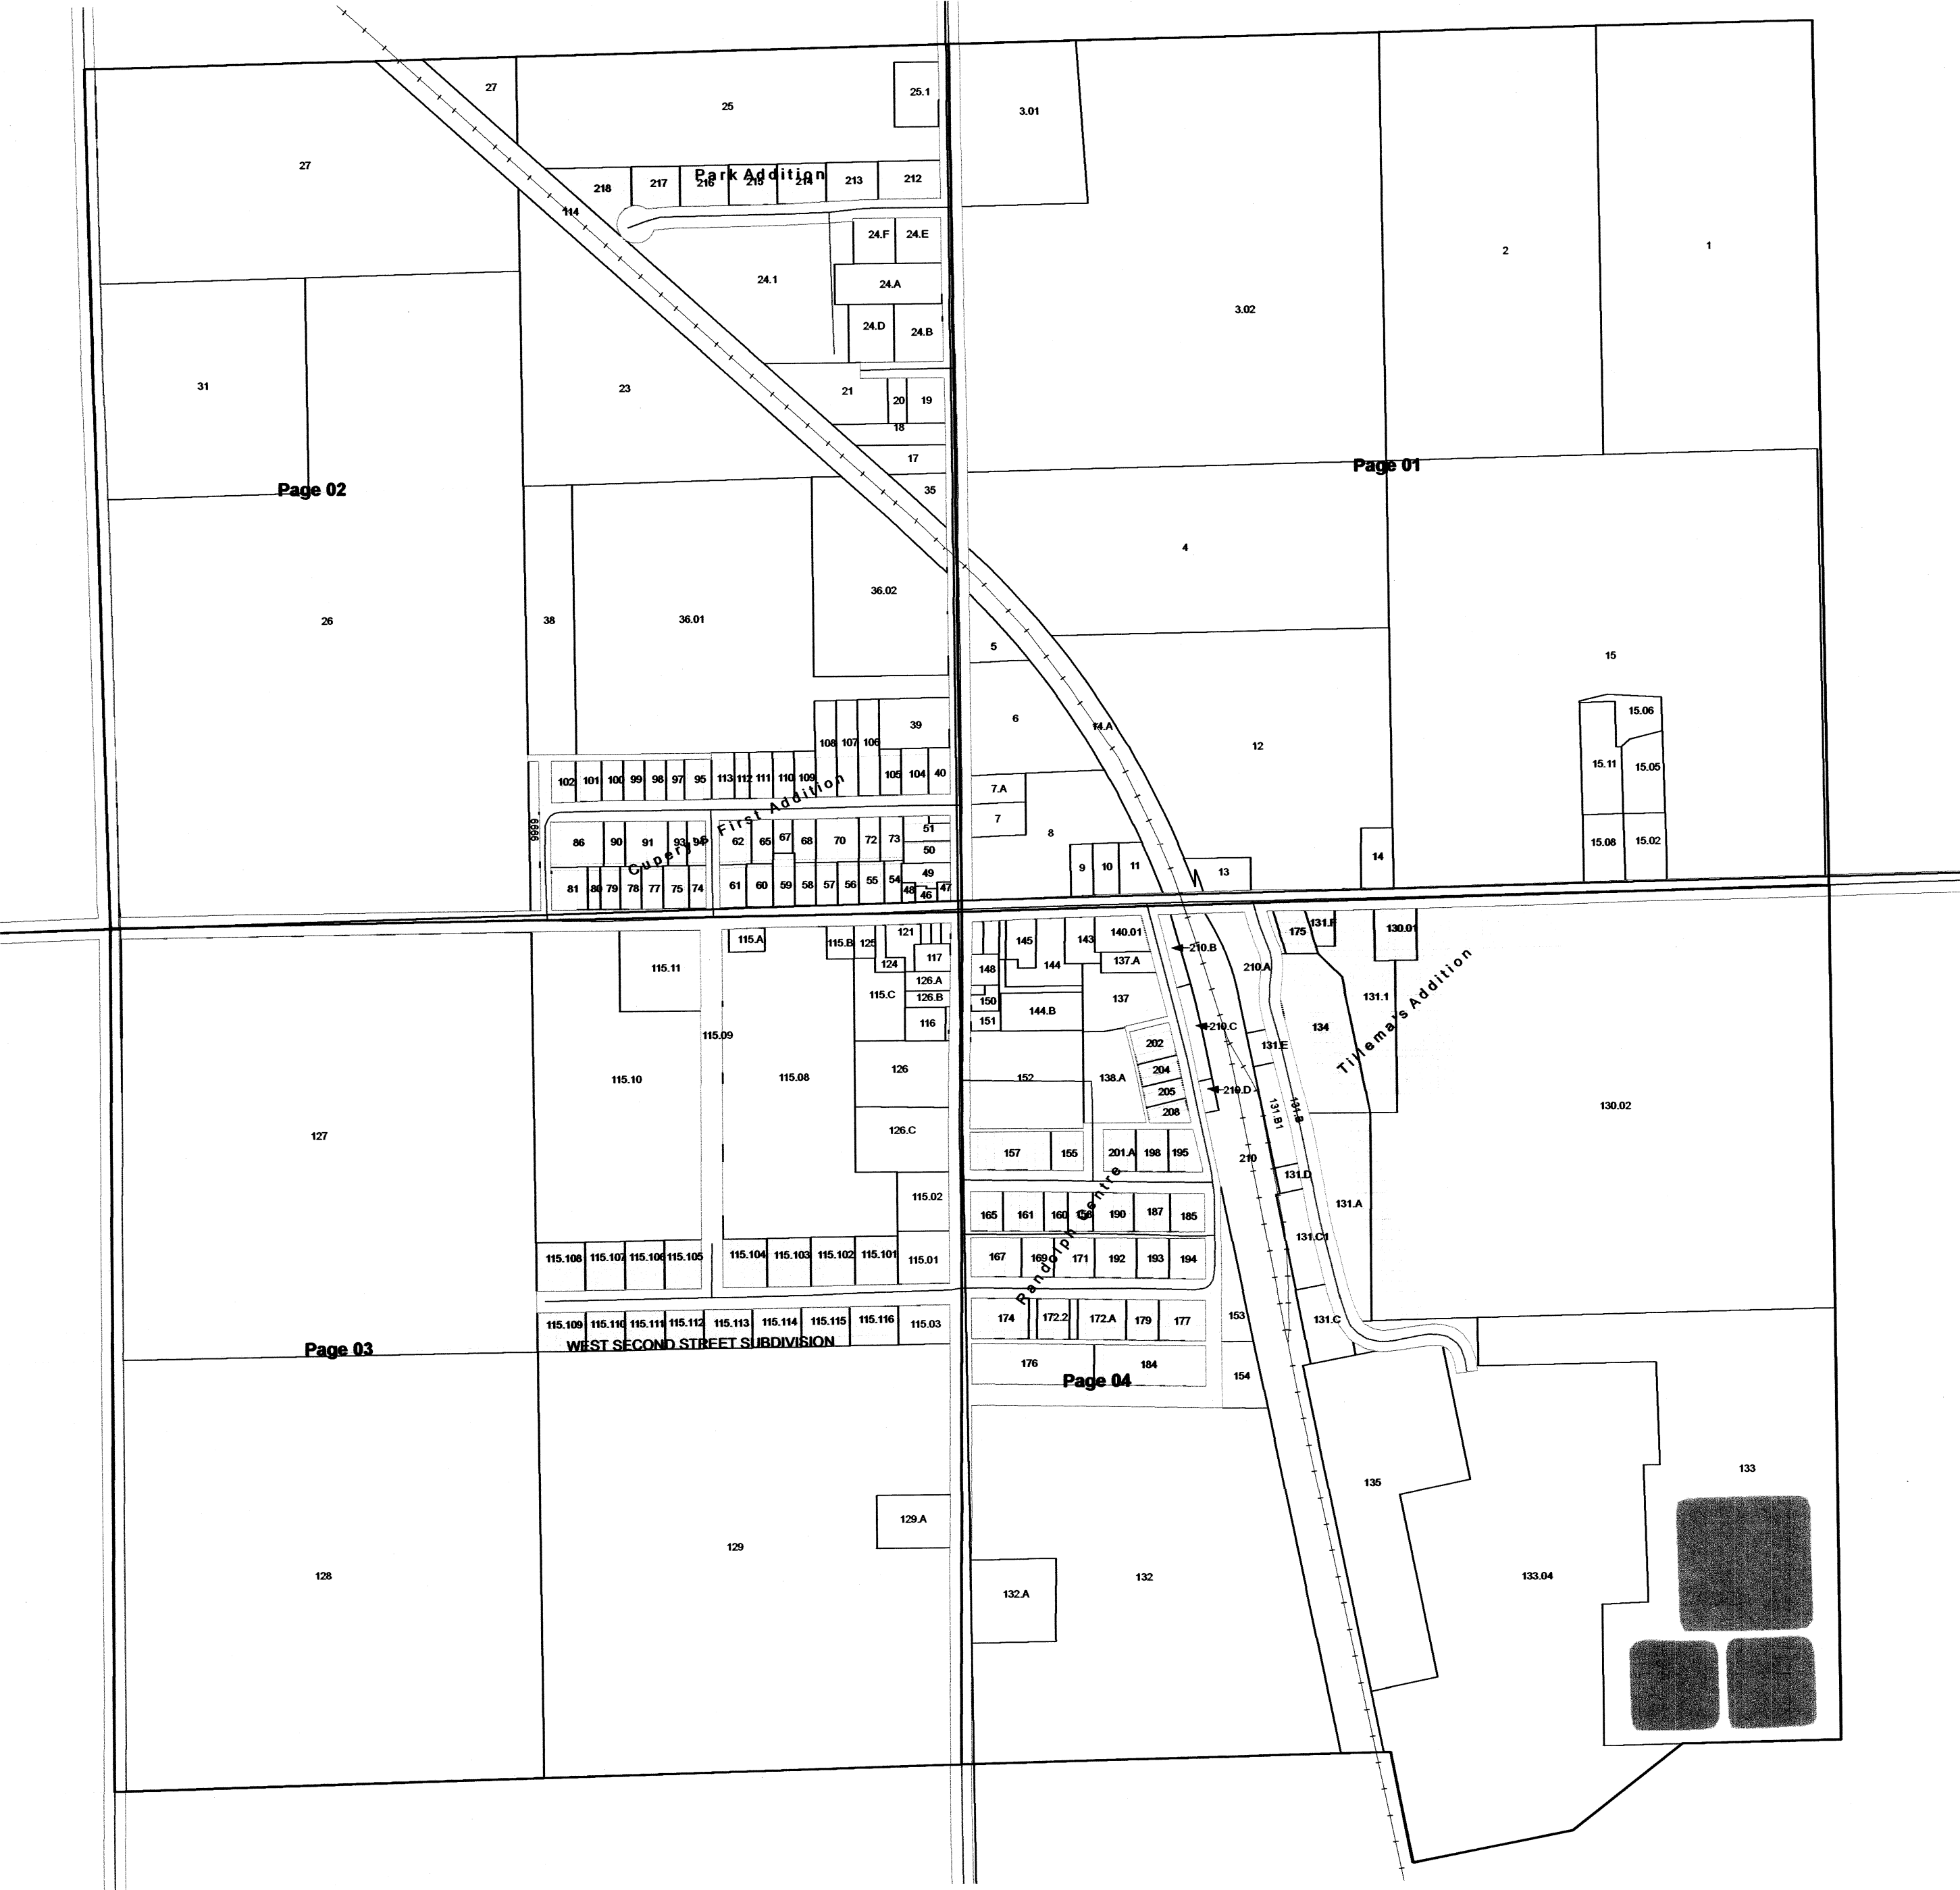


VILLAGE OF FRIESLAND_Page 04
T13N R12E

VILLAGE OF FRIESLAND

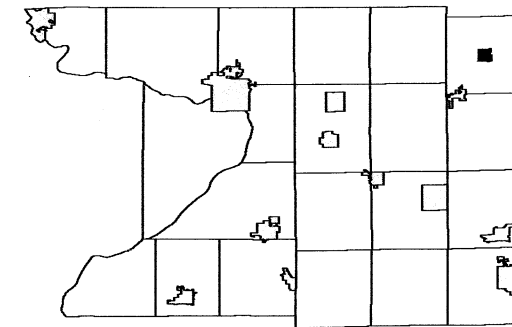

6	5	4	3	2	1
7	8	9	10	11	12
18	17	16	15	14	13
19	20	21	22	23	24
30	29	28	27	26	25
31	32	33	34	35	36


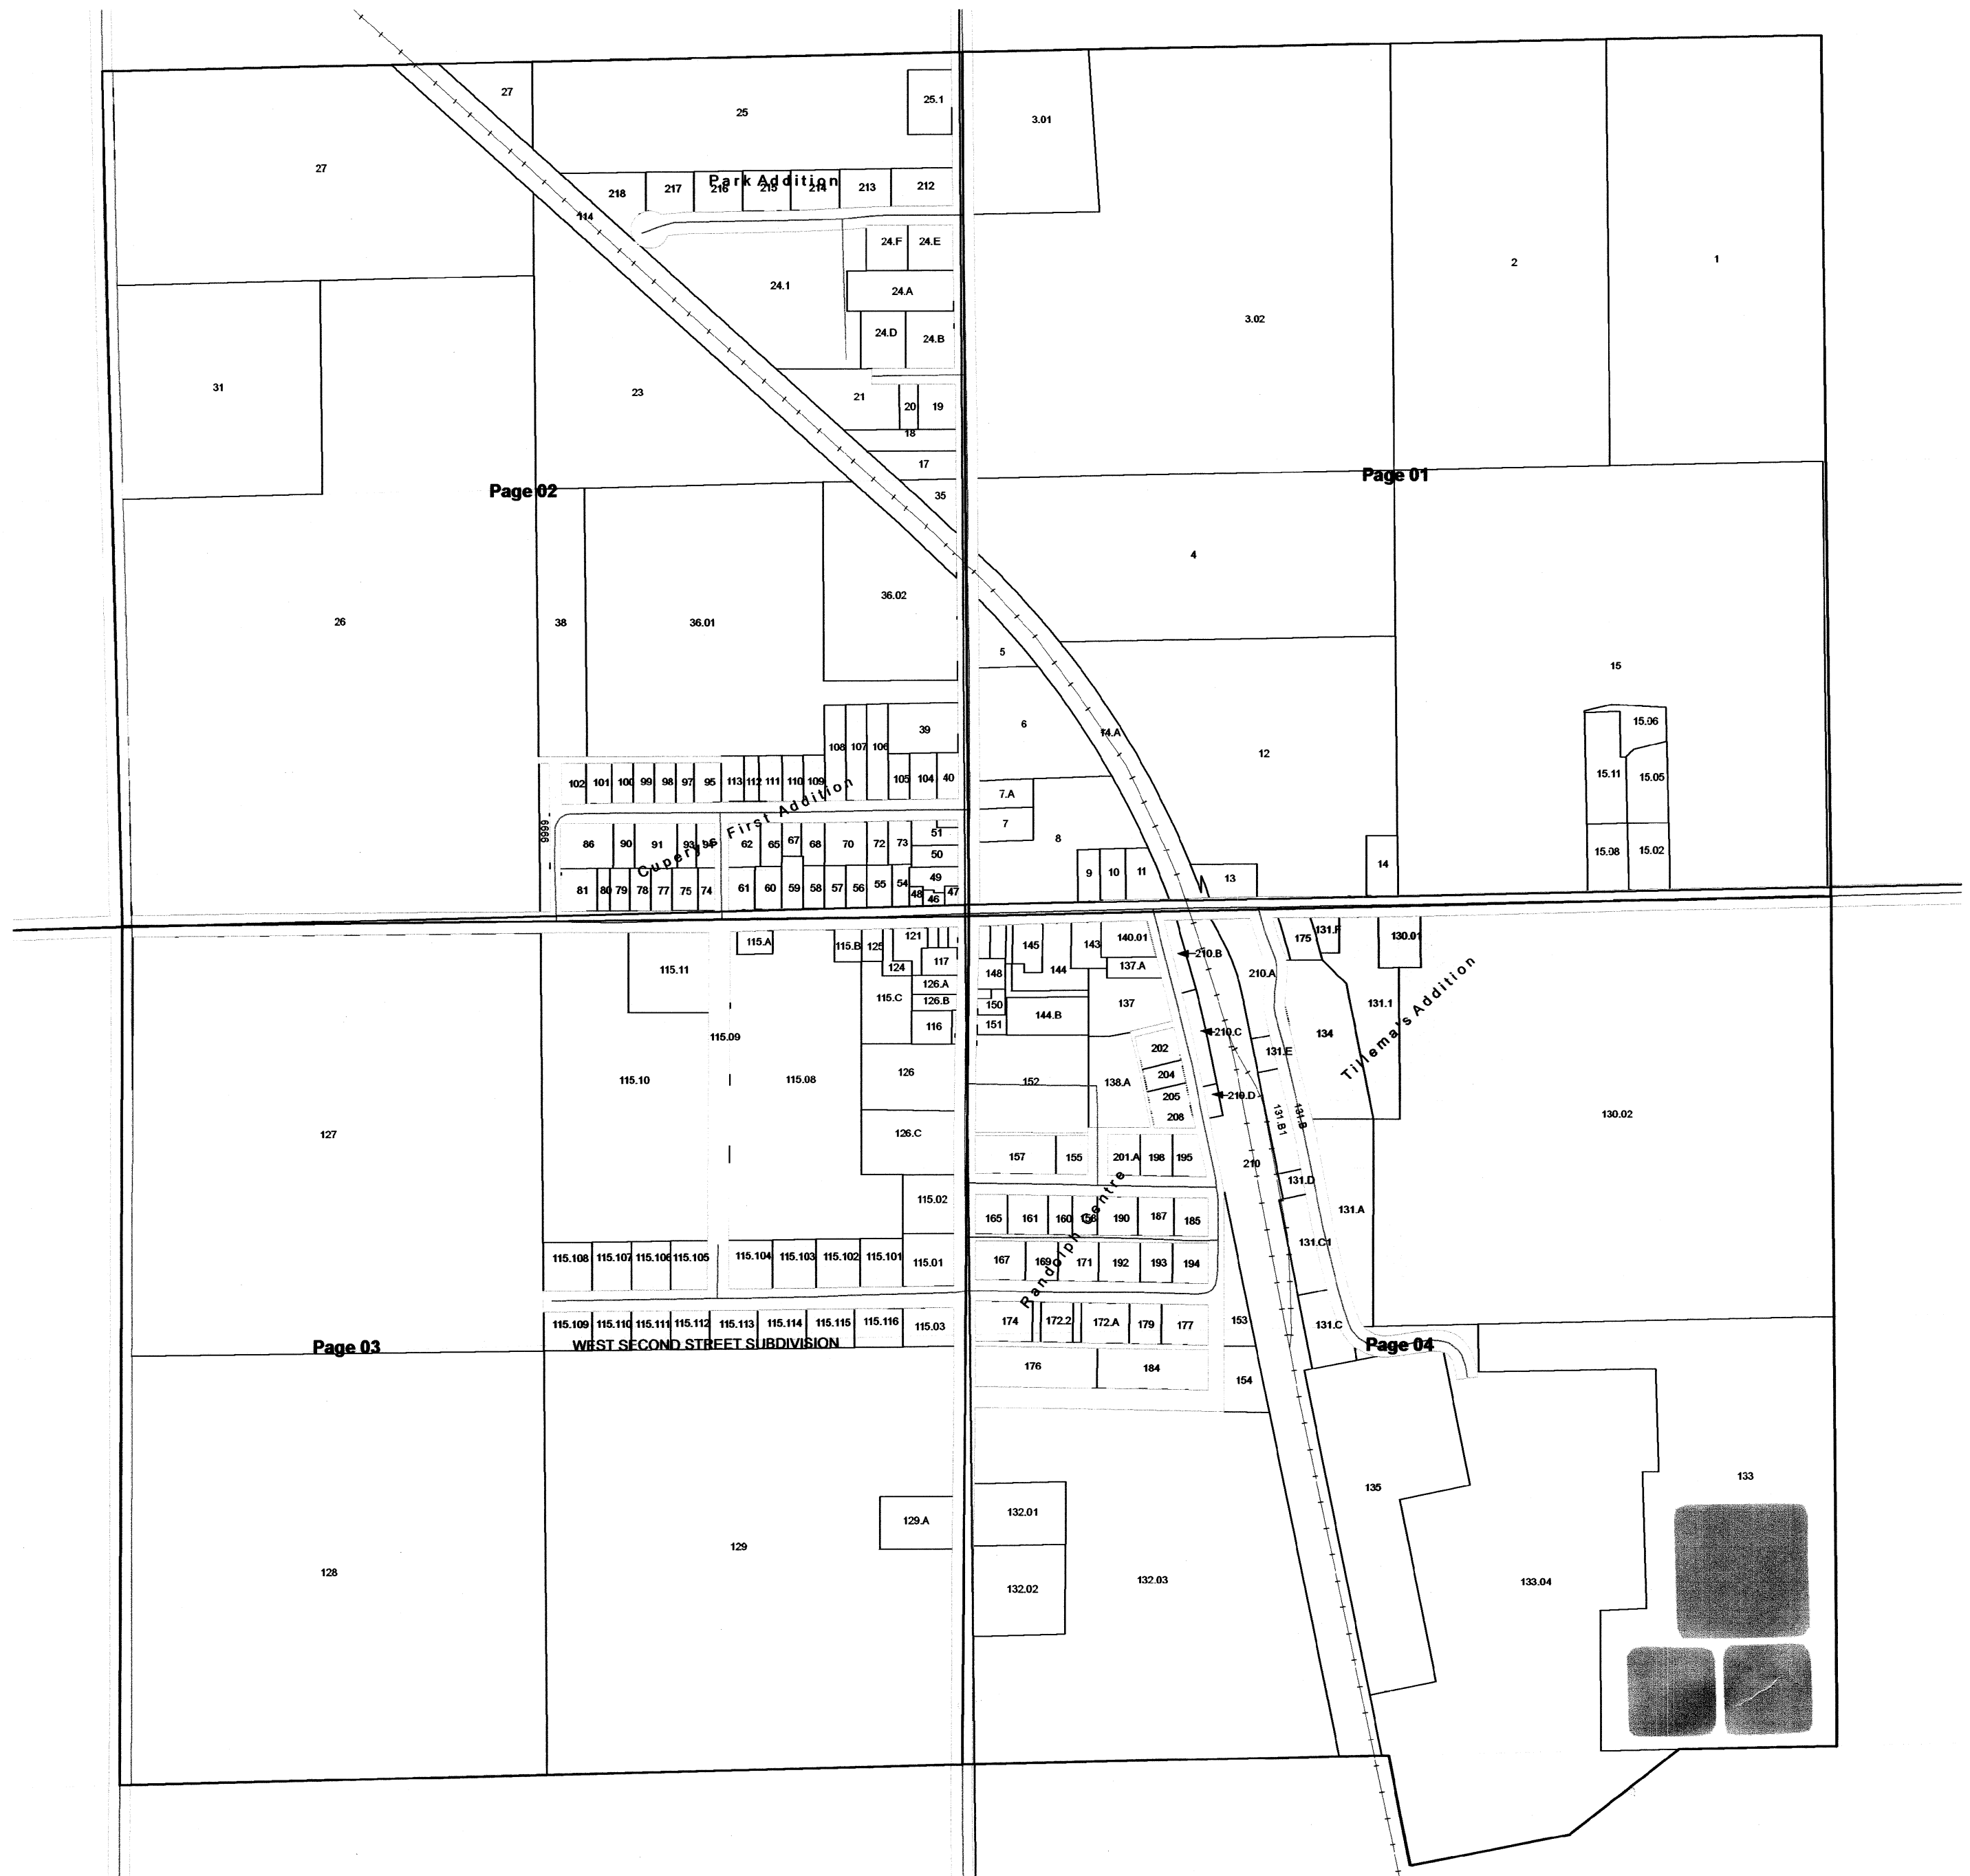


VILLAGE OF FRIESLAND

T13N R12E

1 inch = 200 feet 1:2,400

SEE TOWN OF RANDOLPH

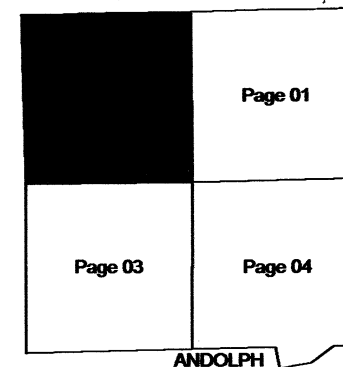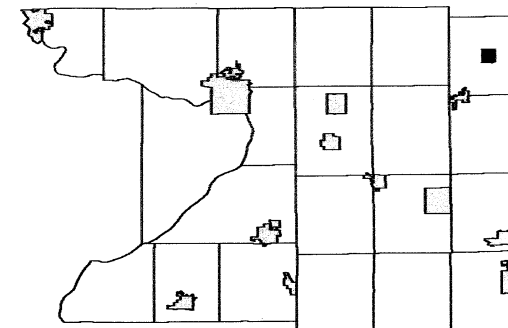


SEE TOWN OF RANDOLPH




SEE VILLAGE OF FRIESLAND Page 01

VILLAGE OF FRIESLAND

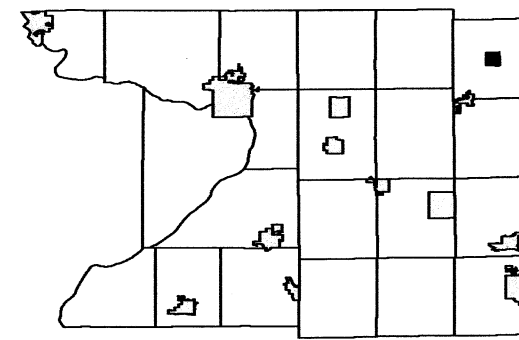

6	5	4	3	2	1
7	8	9	10	11	12
18	17	16	15	14	13
19	20	21	22	23	24
30	29	28	27	26	25
31	32	33	34	35	36


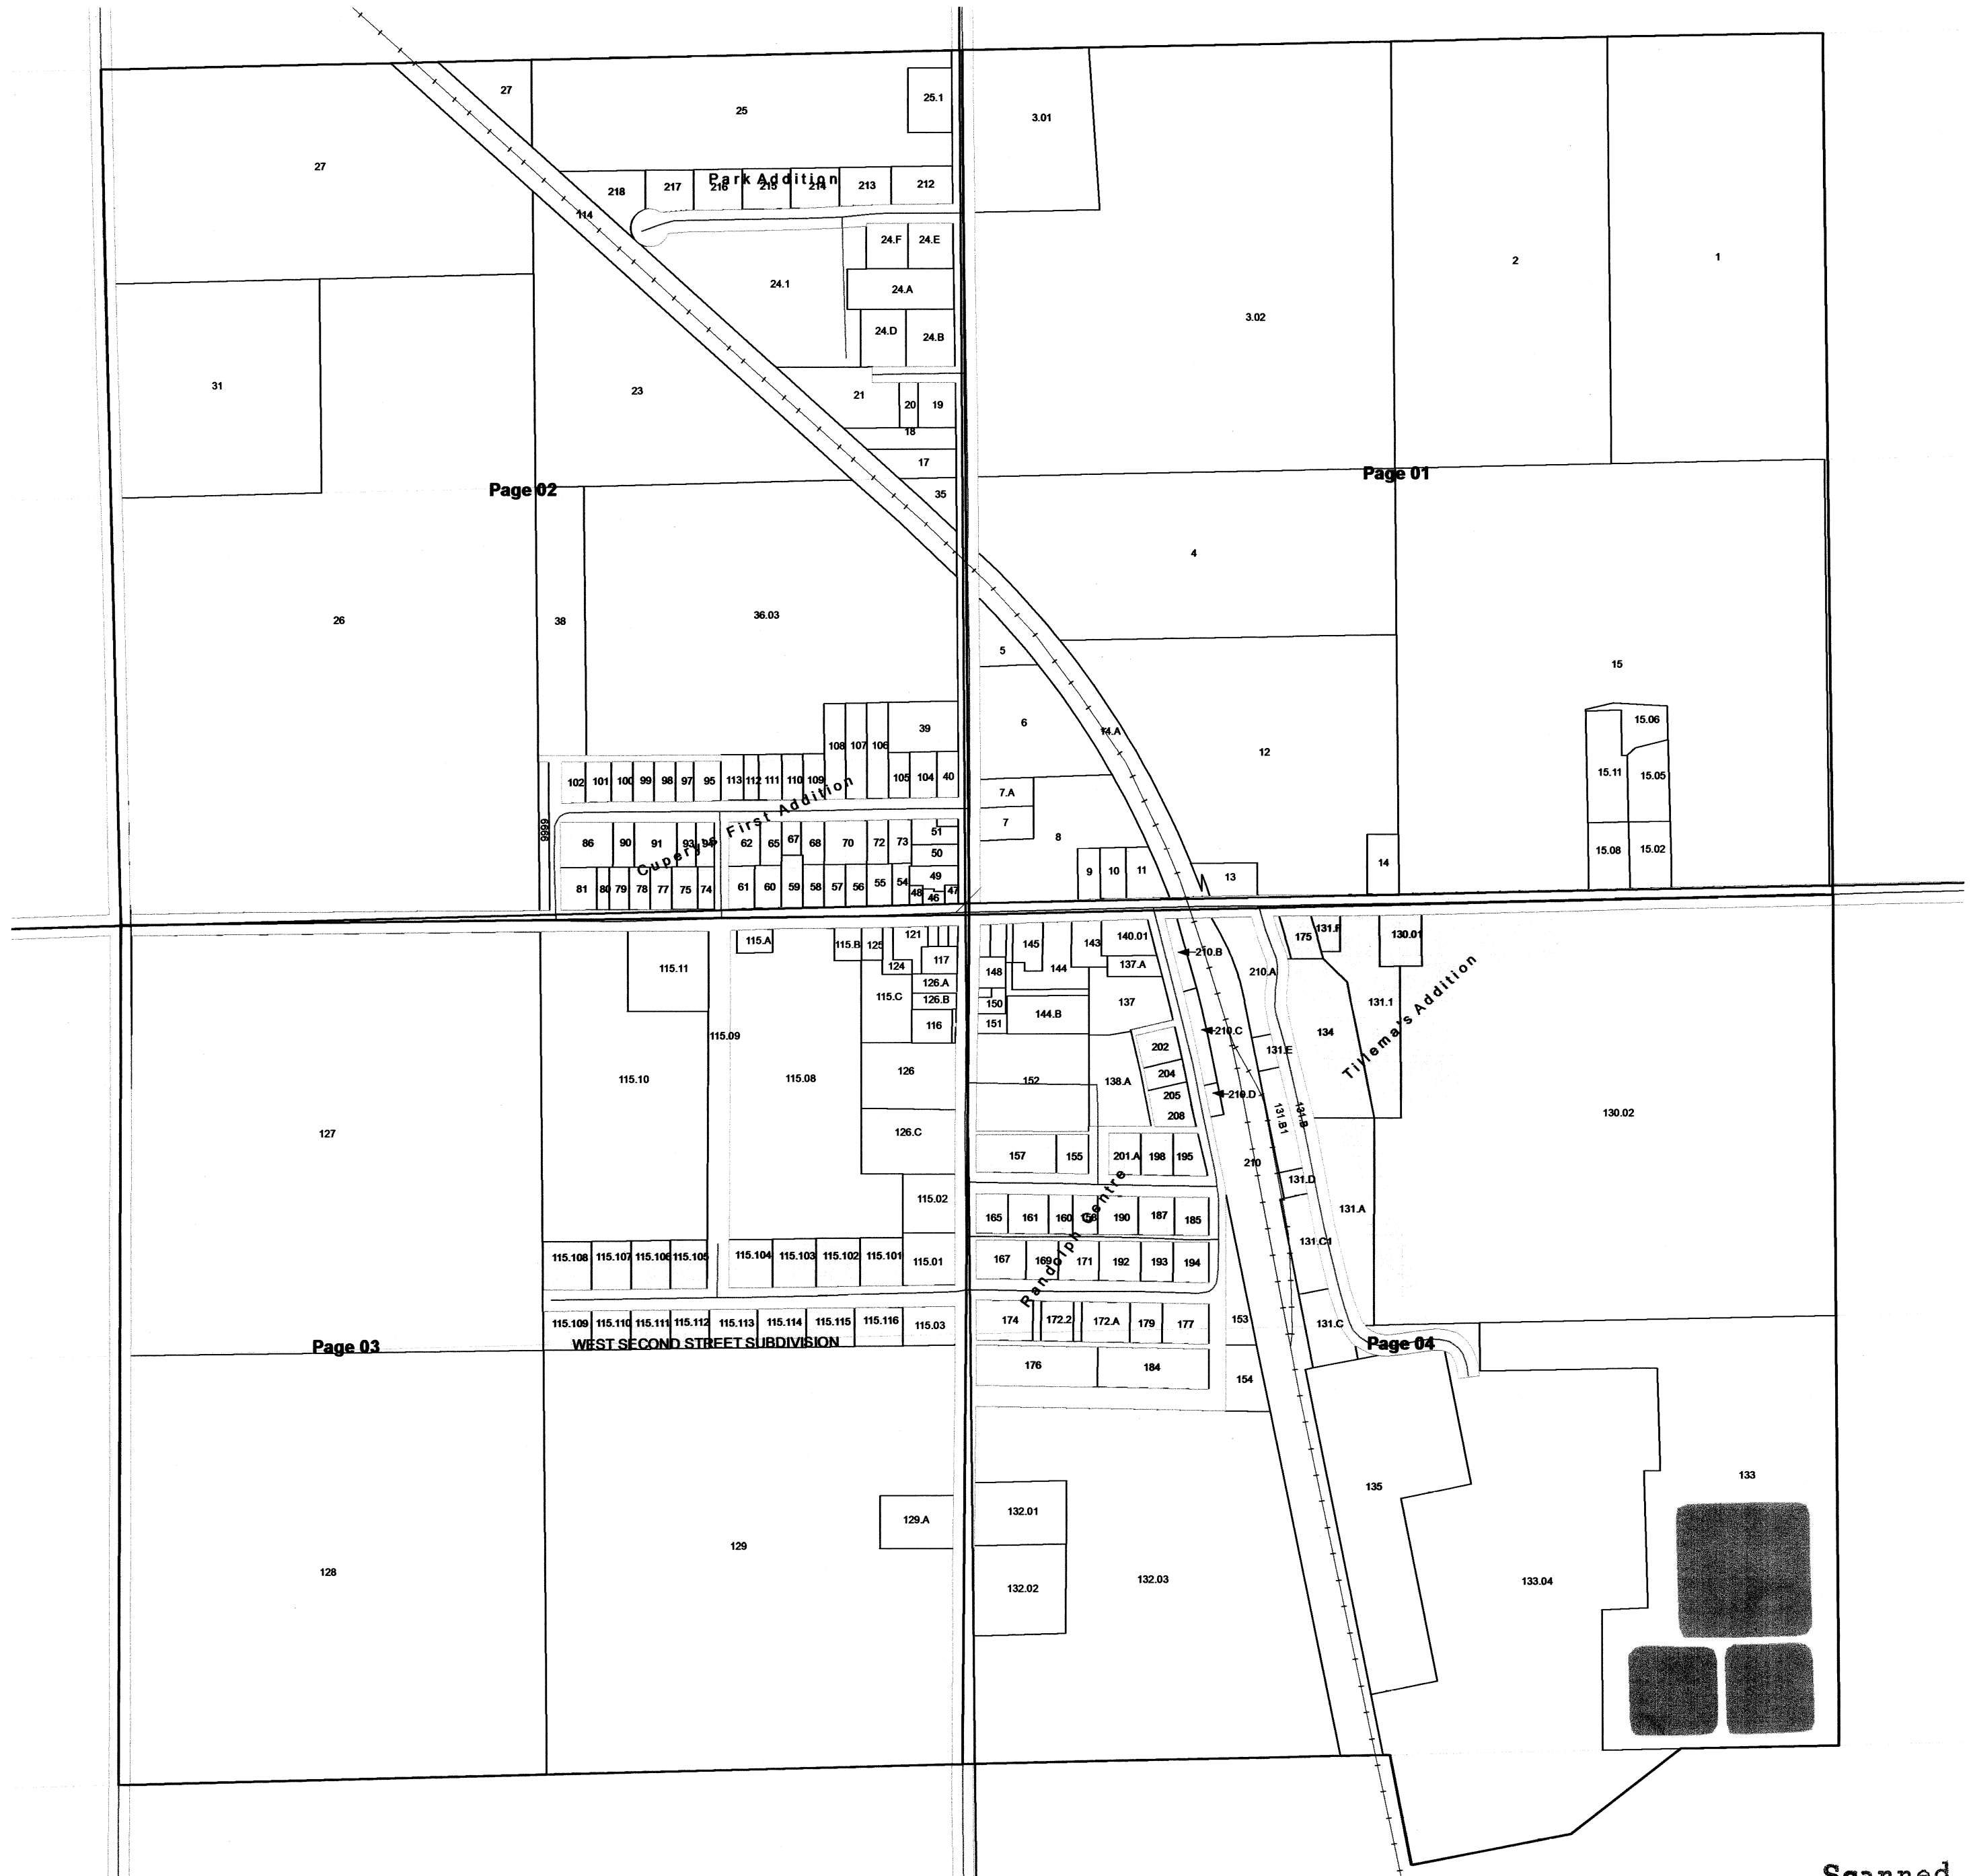


VILLAGE OF FRIESLAND

T13N R12E

1 inch = 200 feet 1:2,400

SEE TOWN OF RANDOLPH

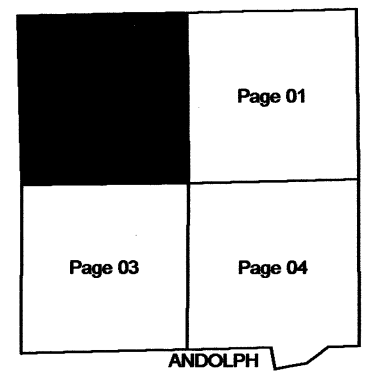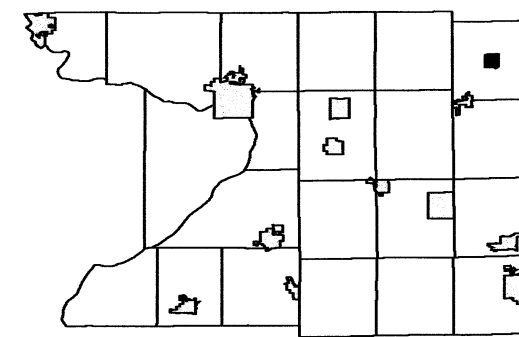

ANDOLPH

SEE TOWN OF RANDOLPH





SEE VILLAGE OF FRIESLAND Page 04

VILLAGE OF FRIESLAND

T13N R12E


1 inch = 200 feet 1:2,400

SEE VILLAGE OF FRIESLAND_Page 02

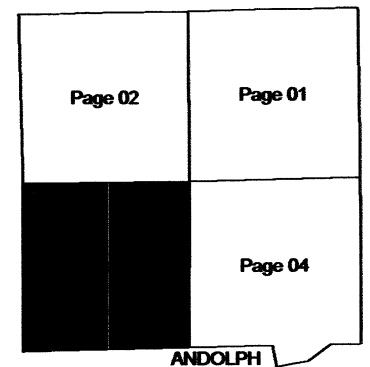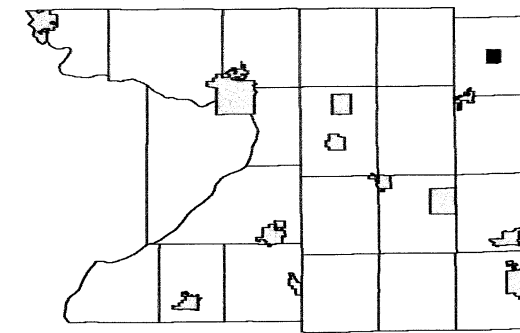



SEE TOWN OF RANDOLPH

Sterk Road

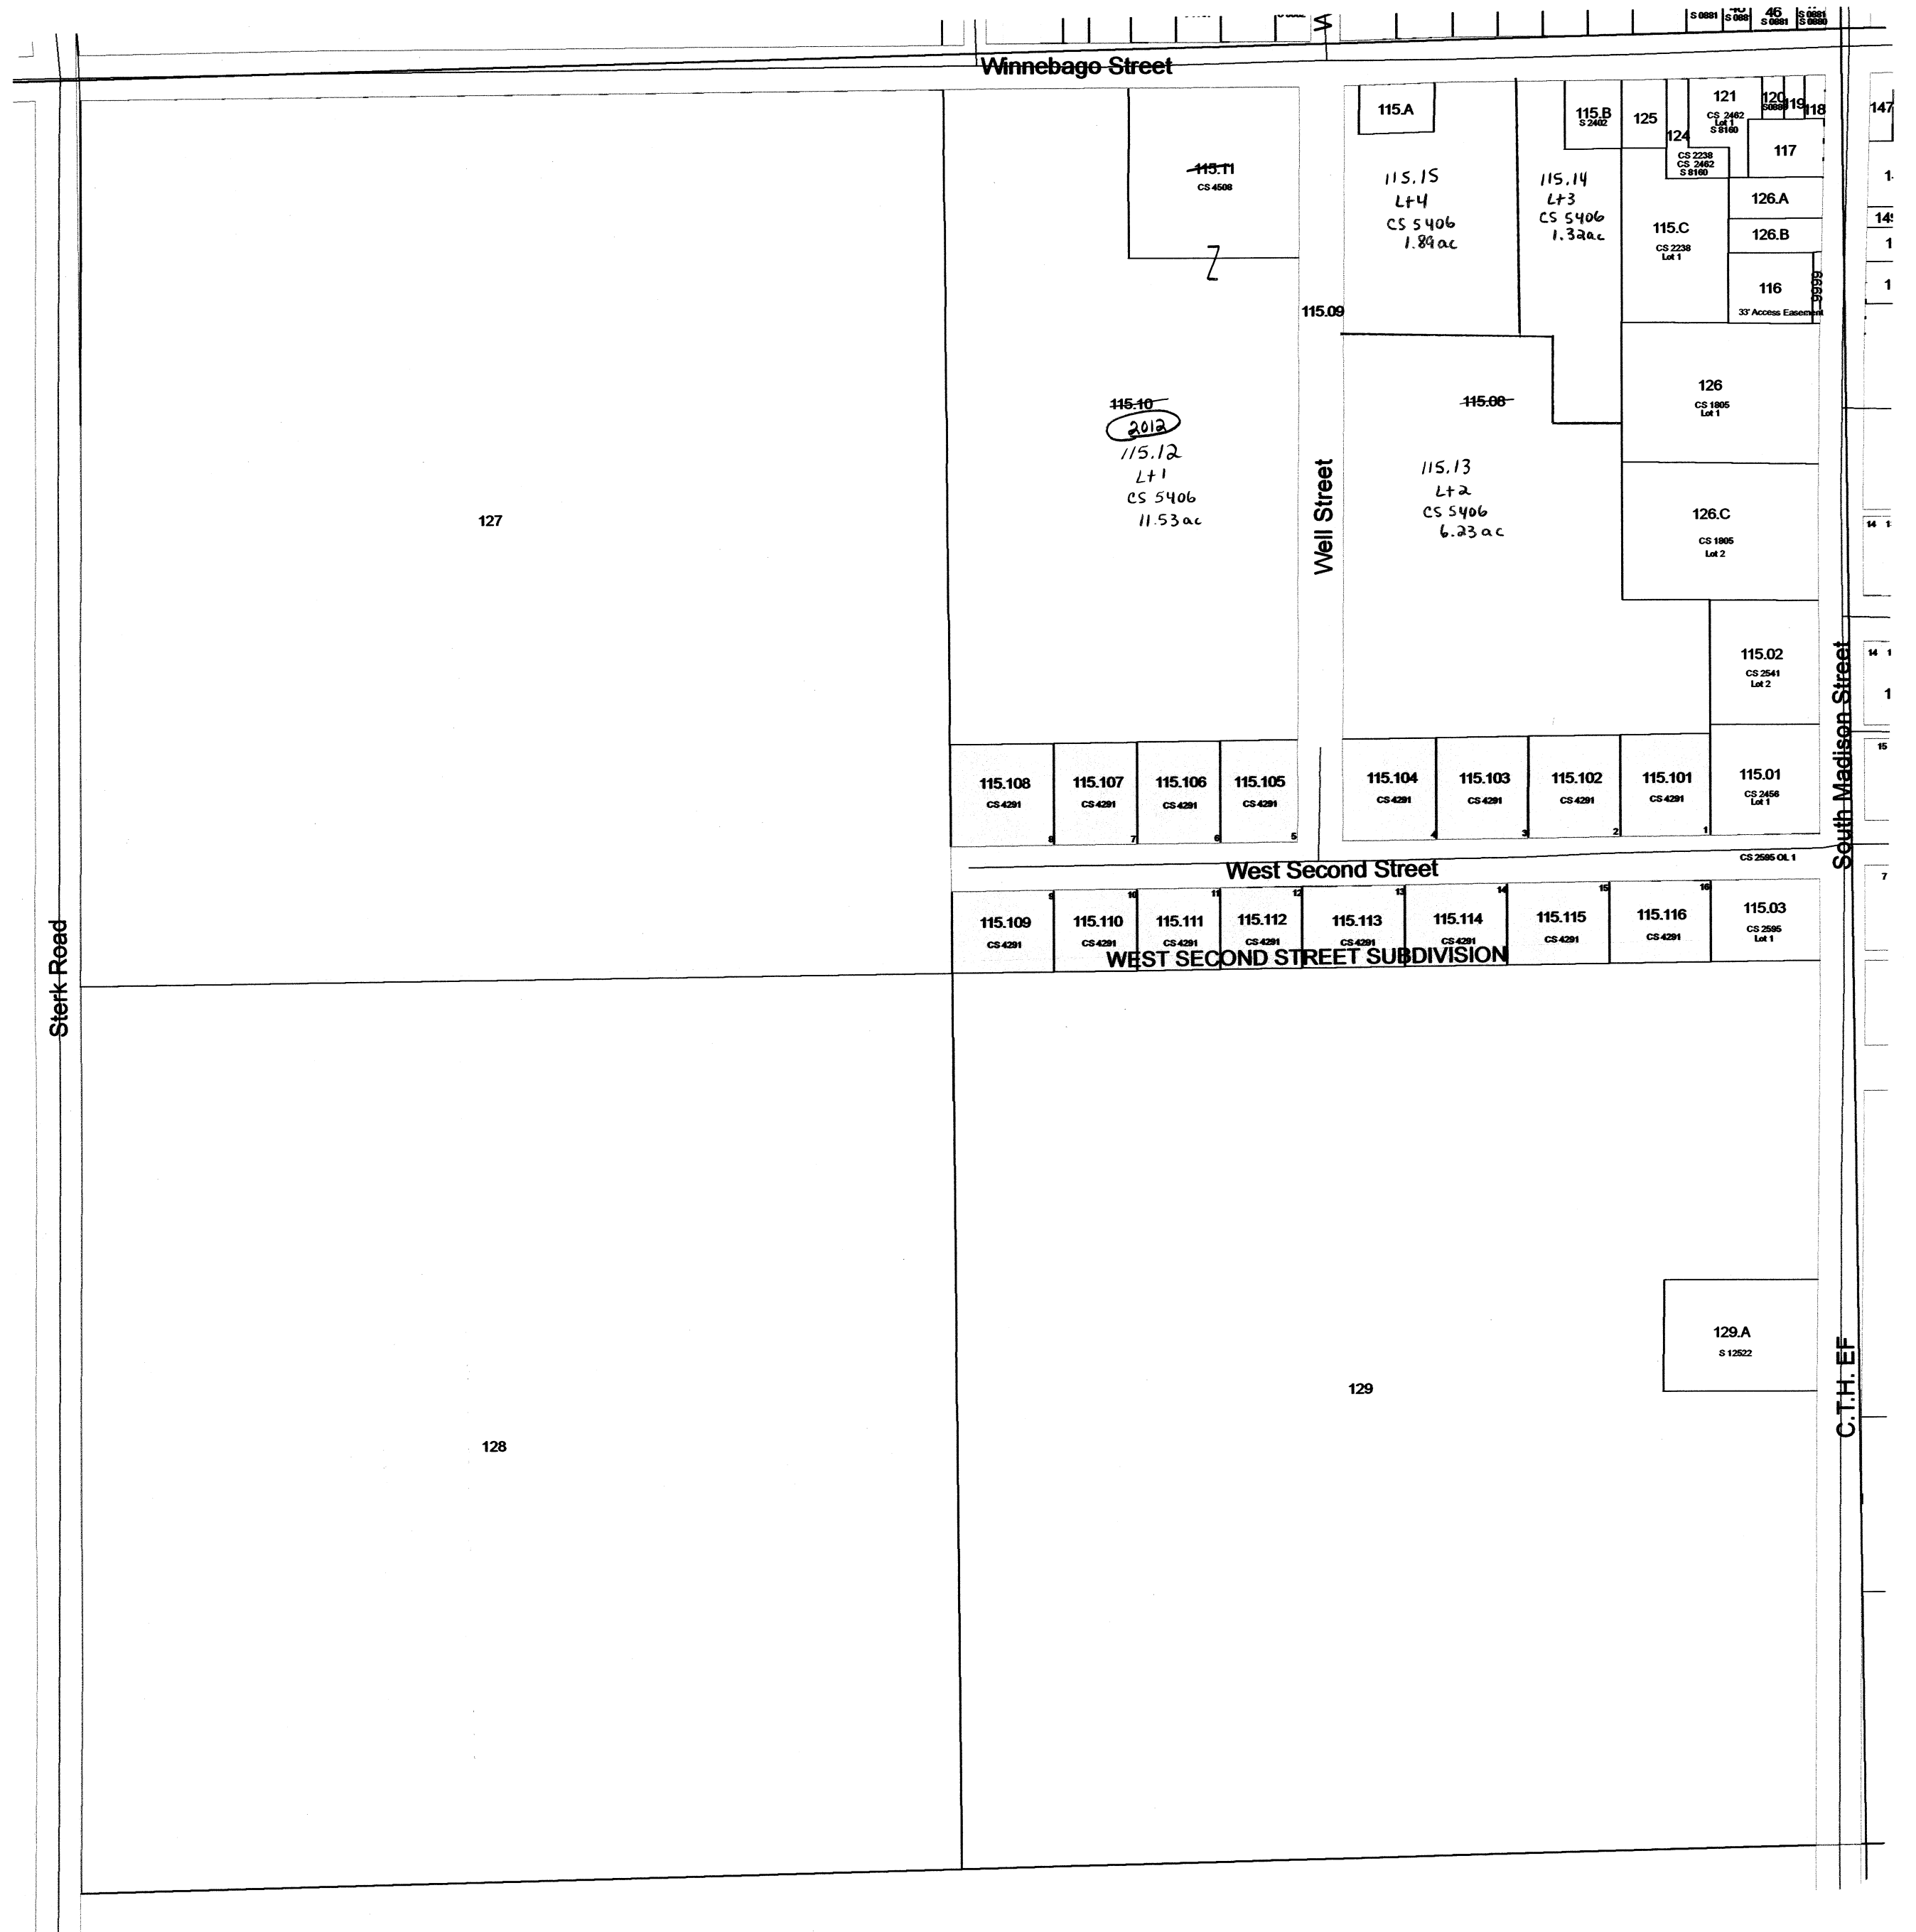

SEE VILLAGE OF FRIESLAND_Page 04

VILLAGE OF FRIESLAND

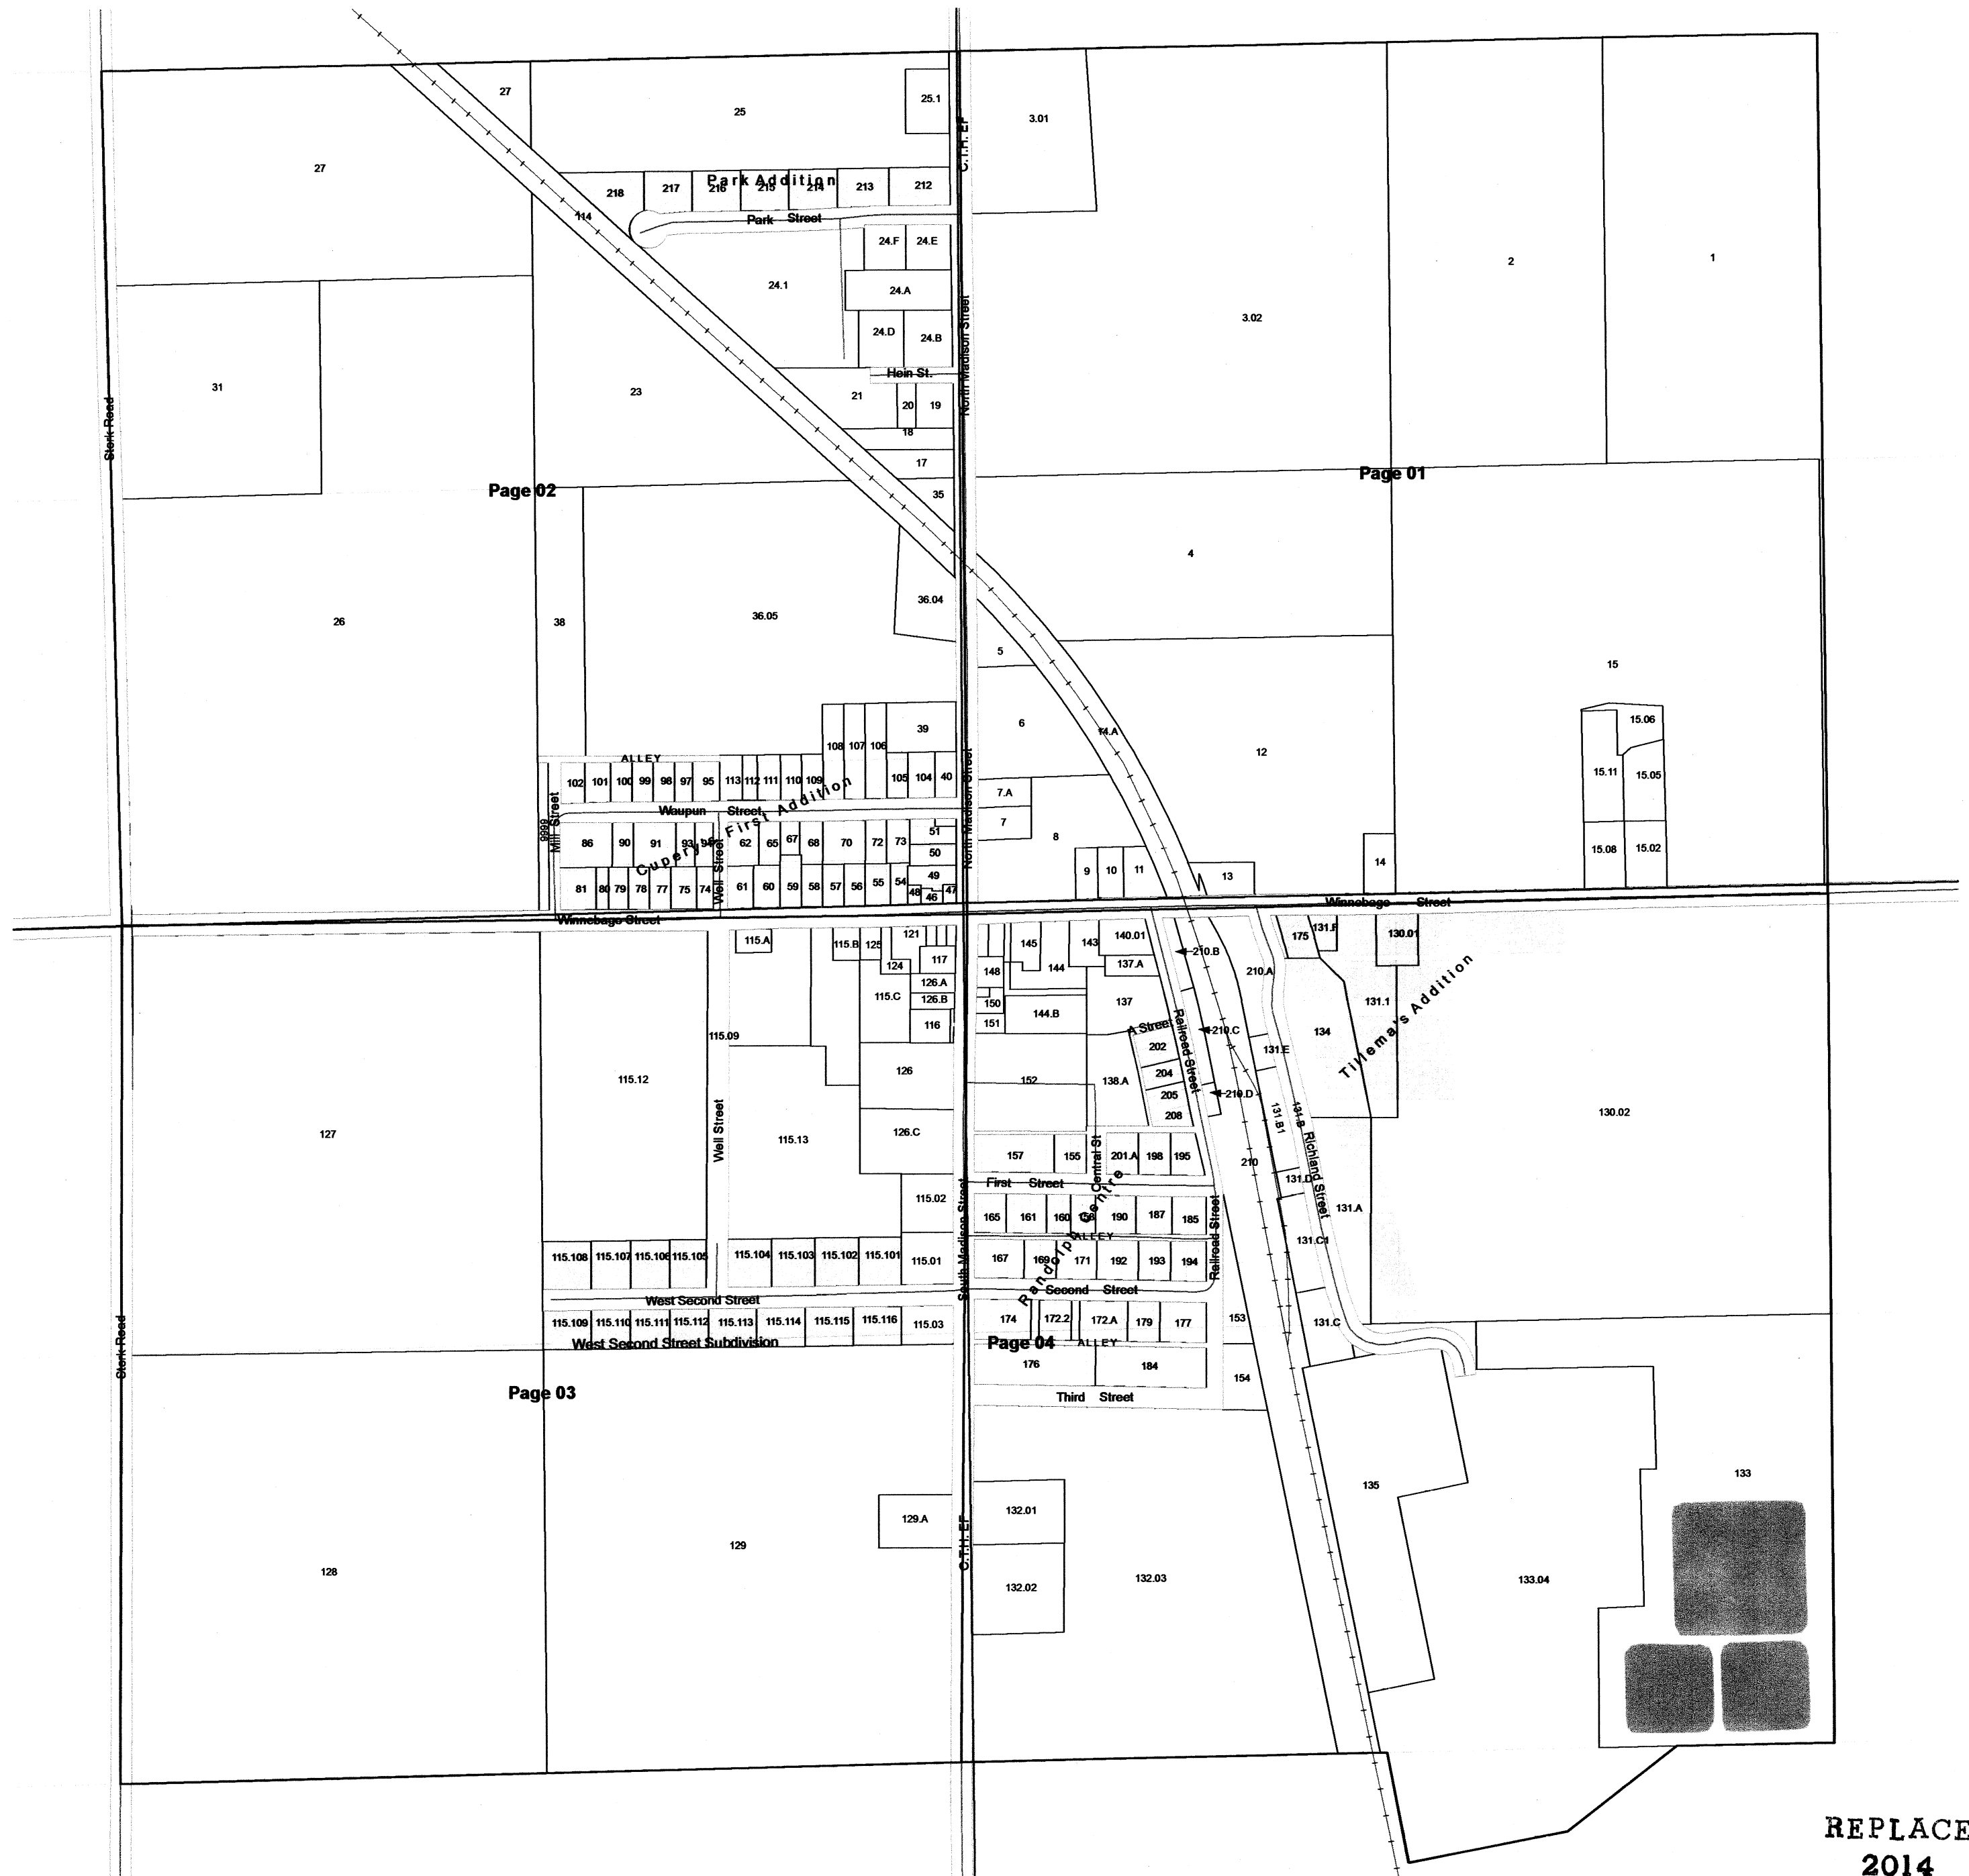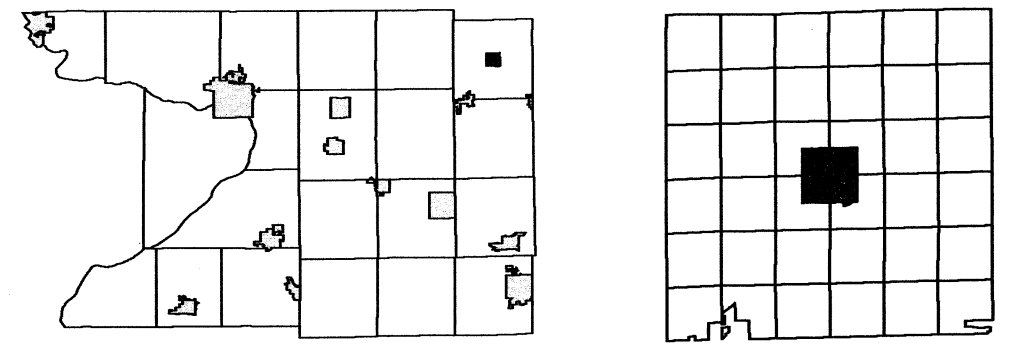



REPLACED
2014

VILLAGE OF FRIESLAND

T13N R12E

1 inch = 200 feet 1:2,400

SEE TOWN OF RANDOLPH

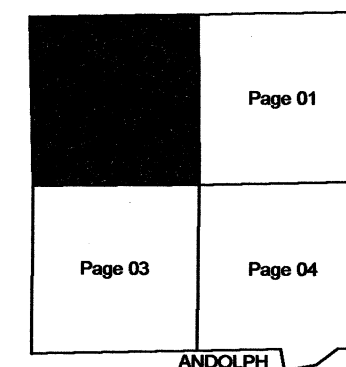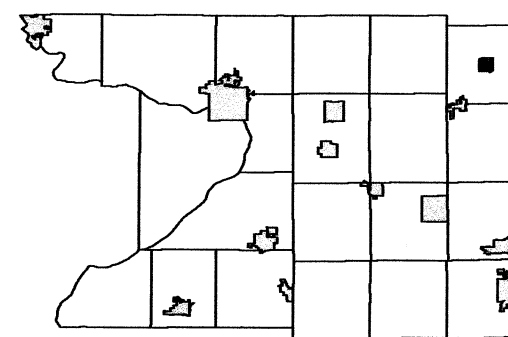

ANDOLPH

SEE TOWN OF RANDOLPH



SEE VILLAGE OF FRIESLAND Page 04