
# VILLAGE OF POYNETTE Replaced 2002


SECTION 3 TION. R9E.

1030 Composite (1973) 1034 Composite

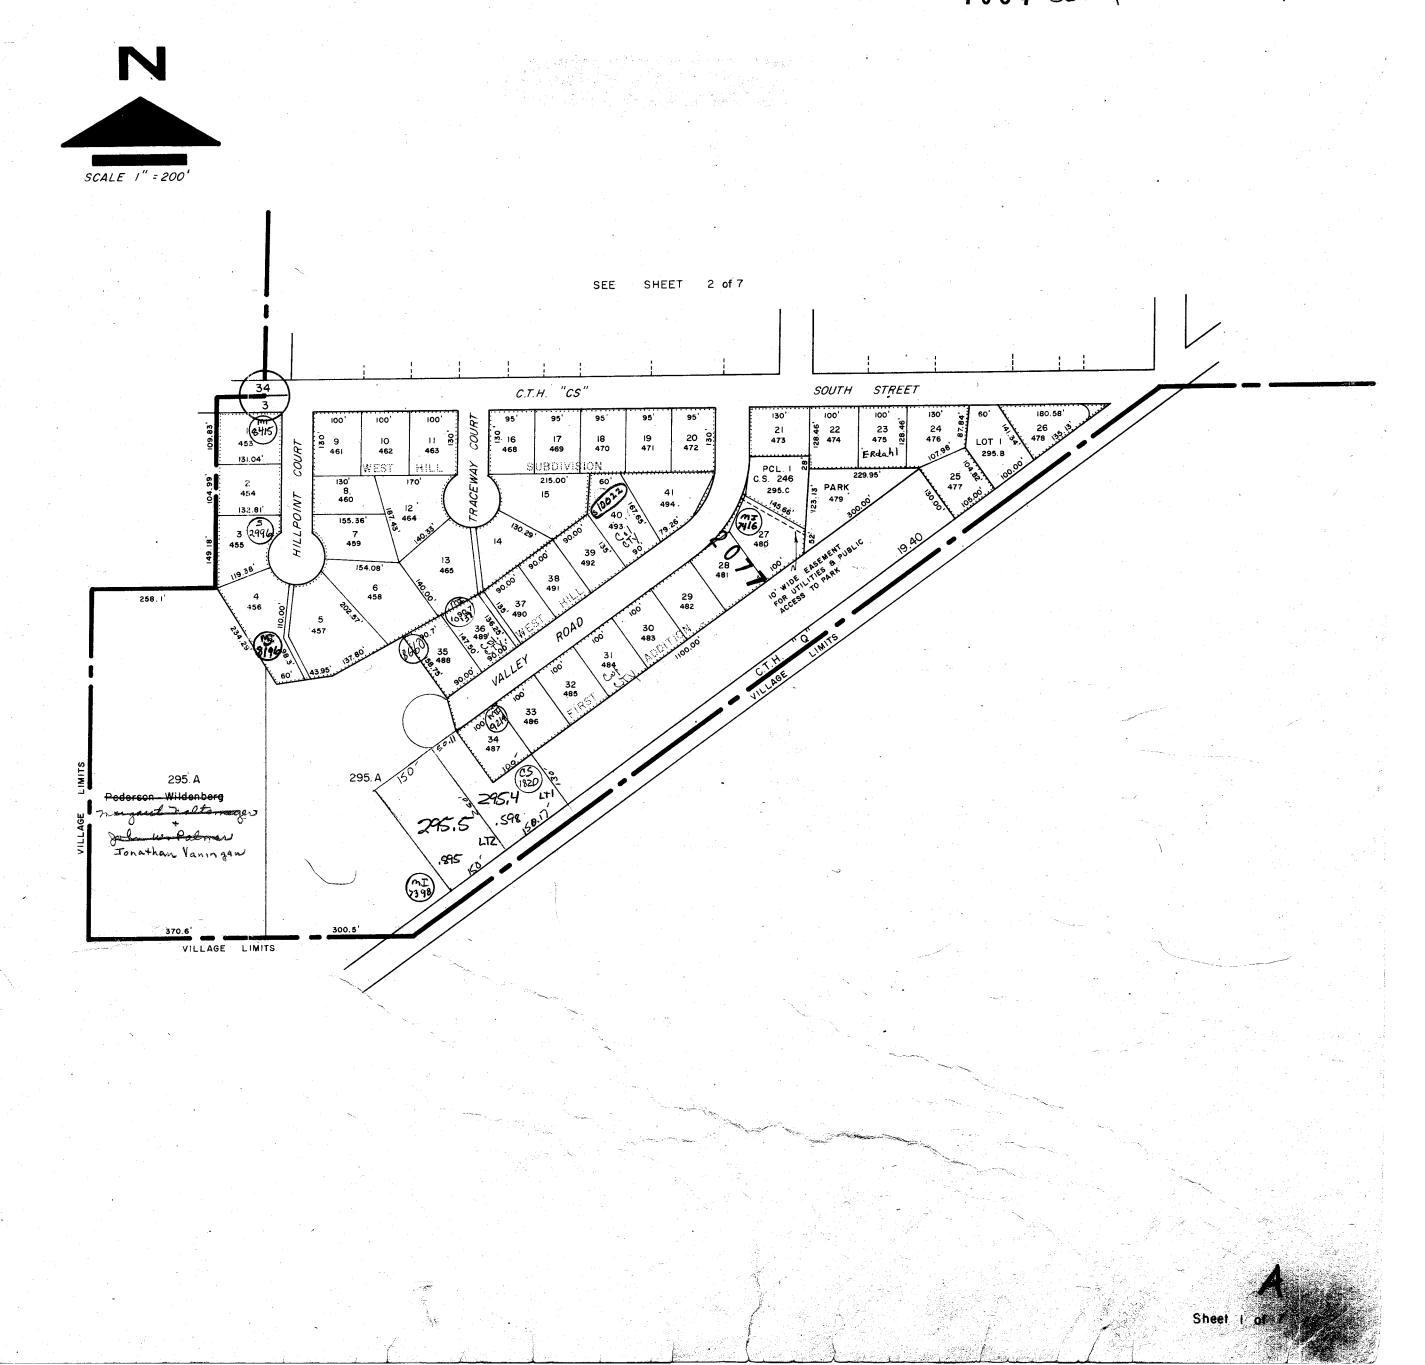



#### VILLAGE OF POYNEIIE


#### SECTION 26 TIIN. R9E.

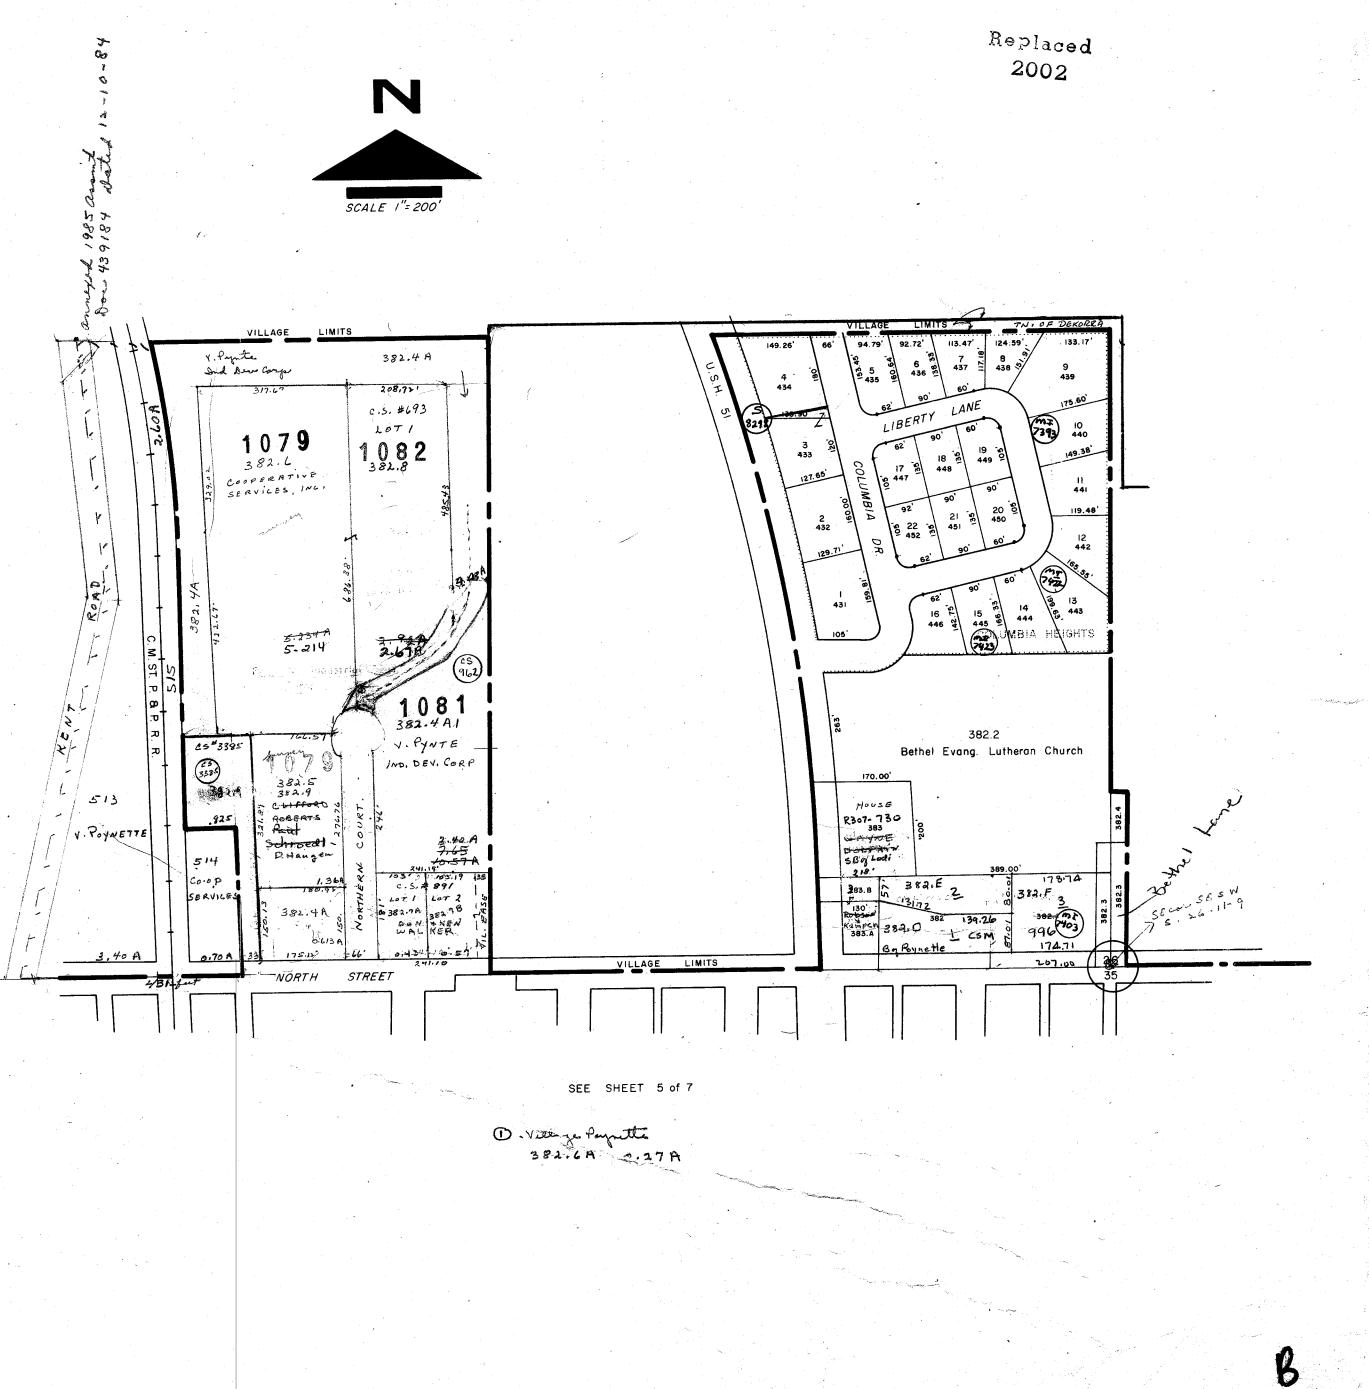



Sheet 7 of 7

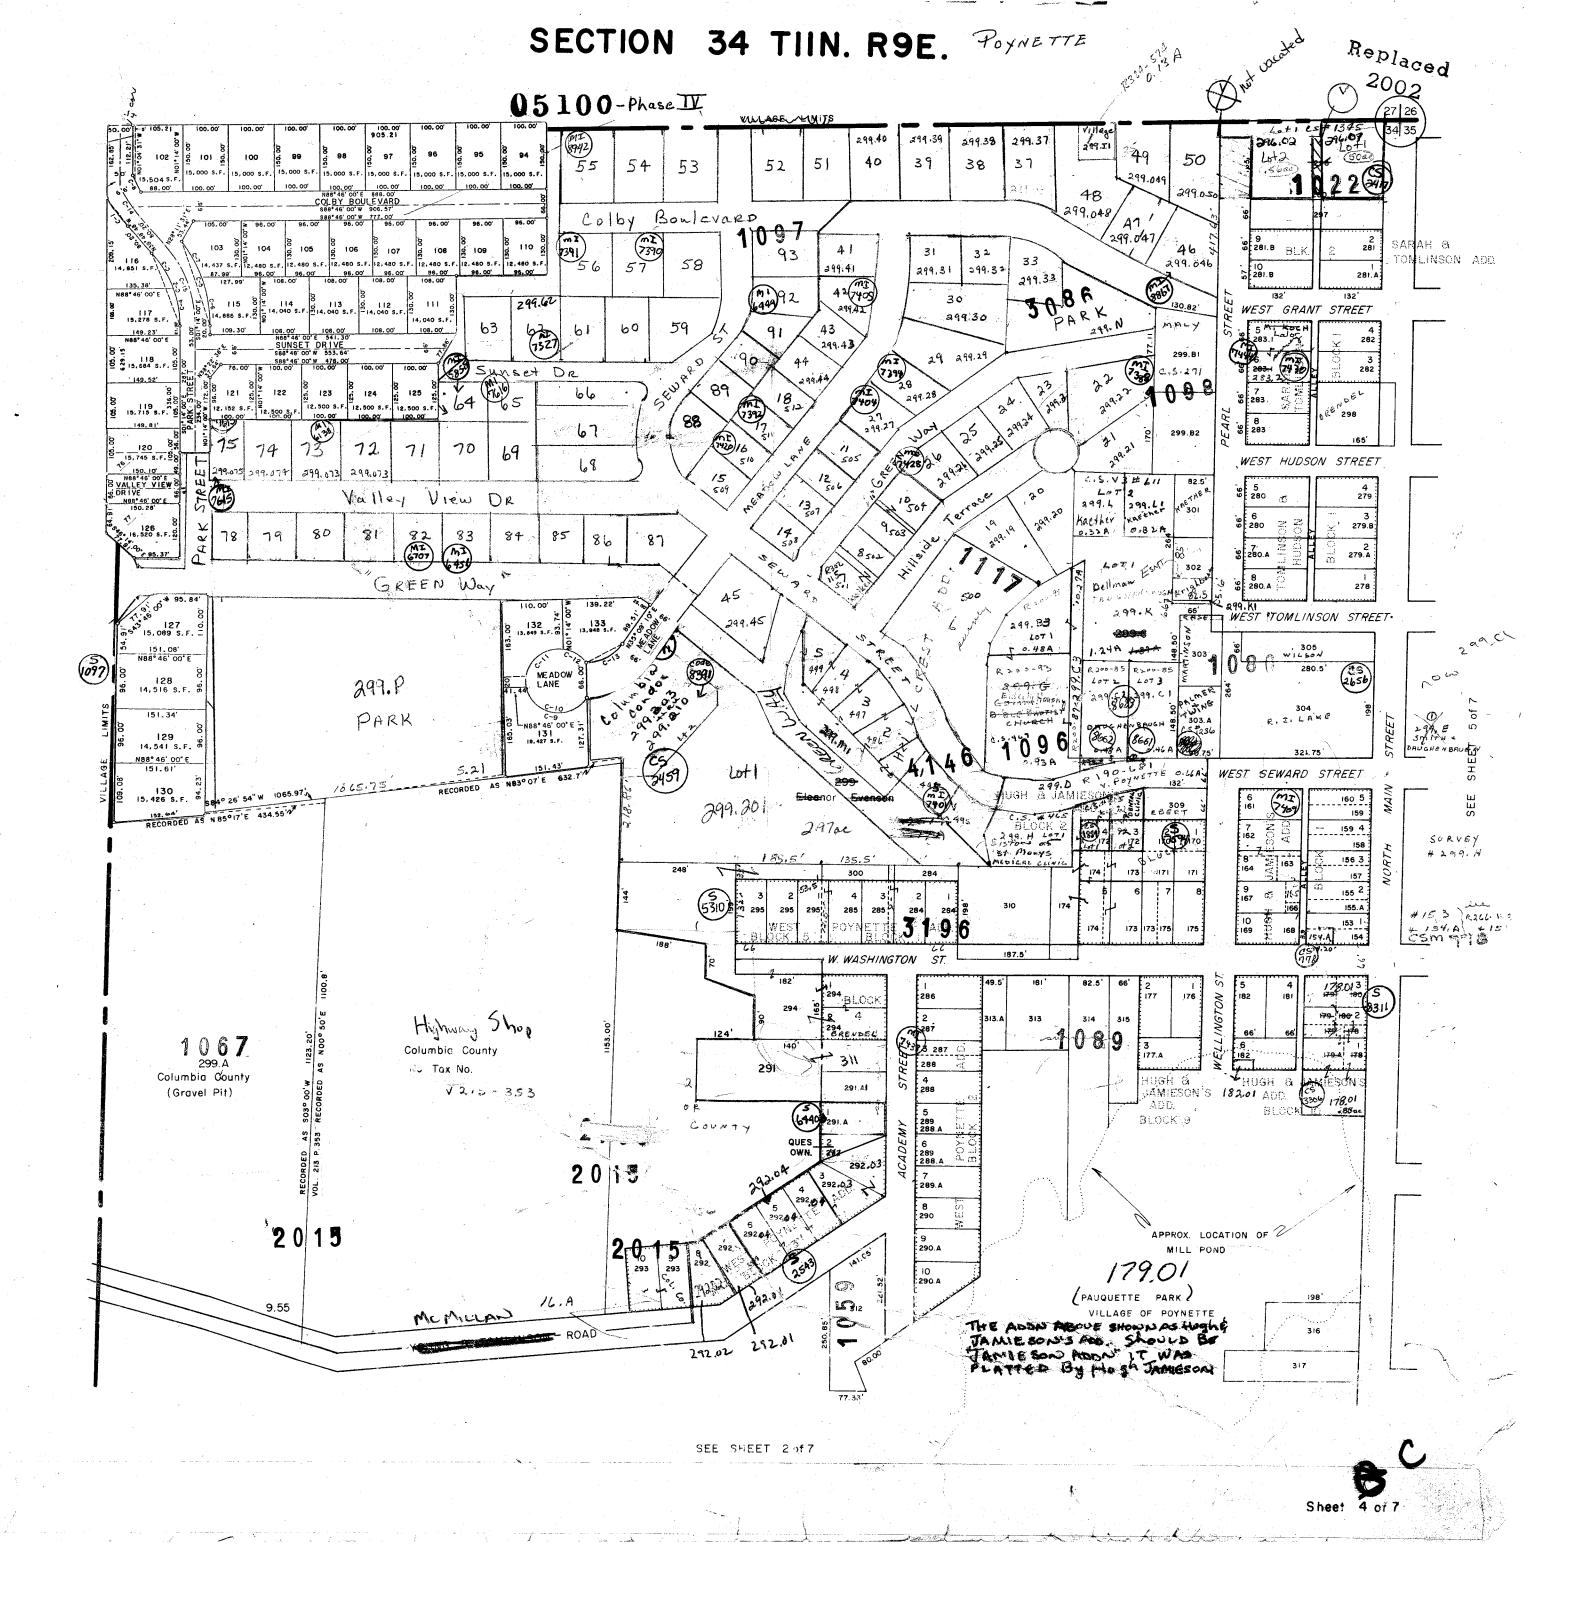


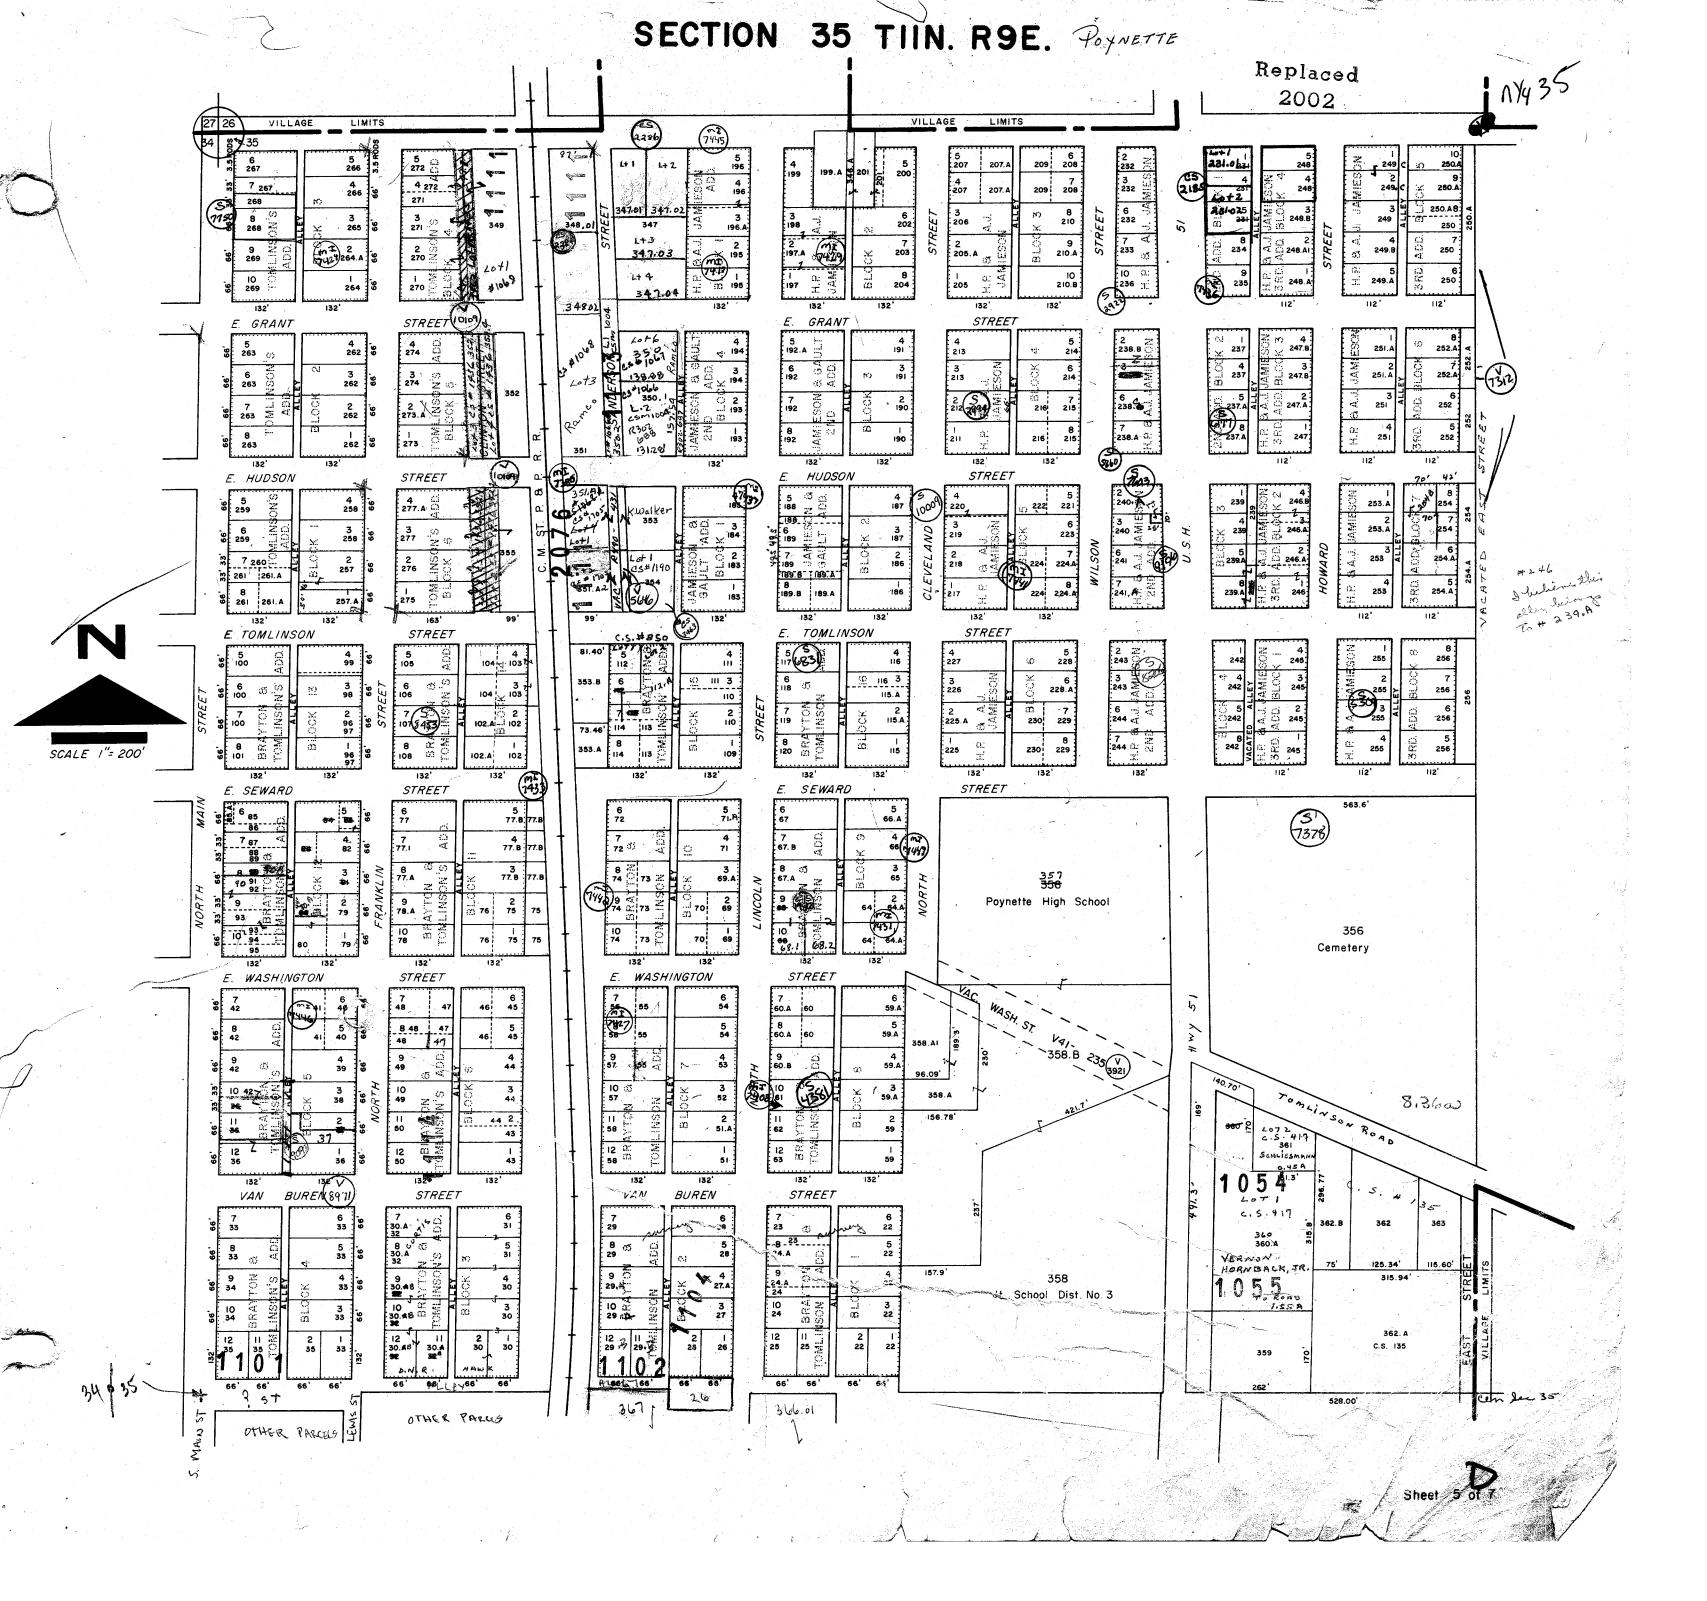

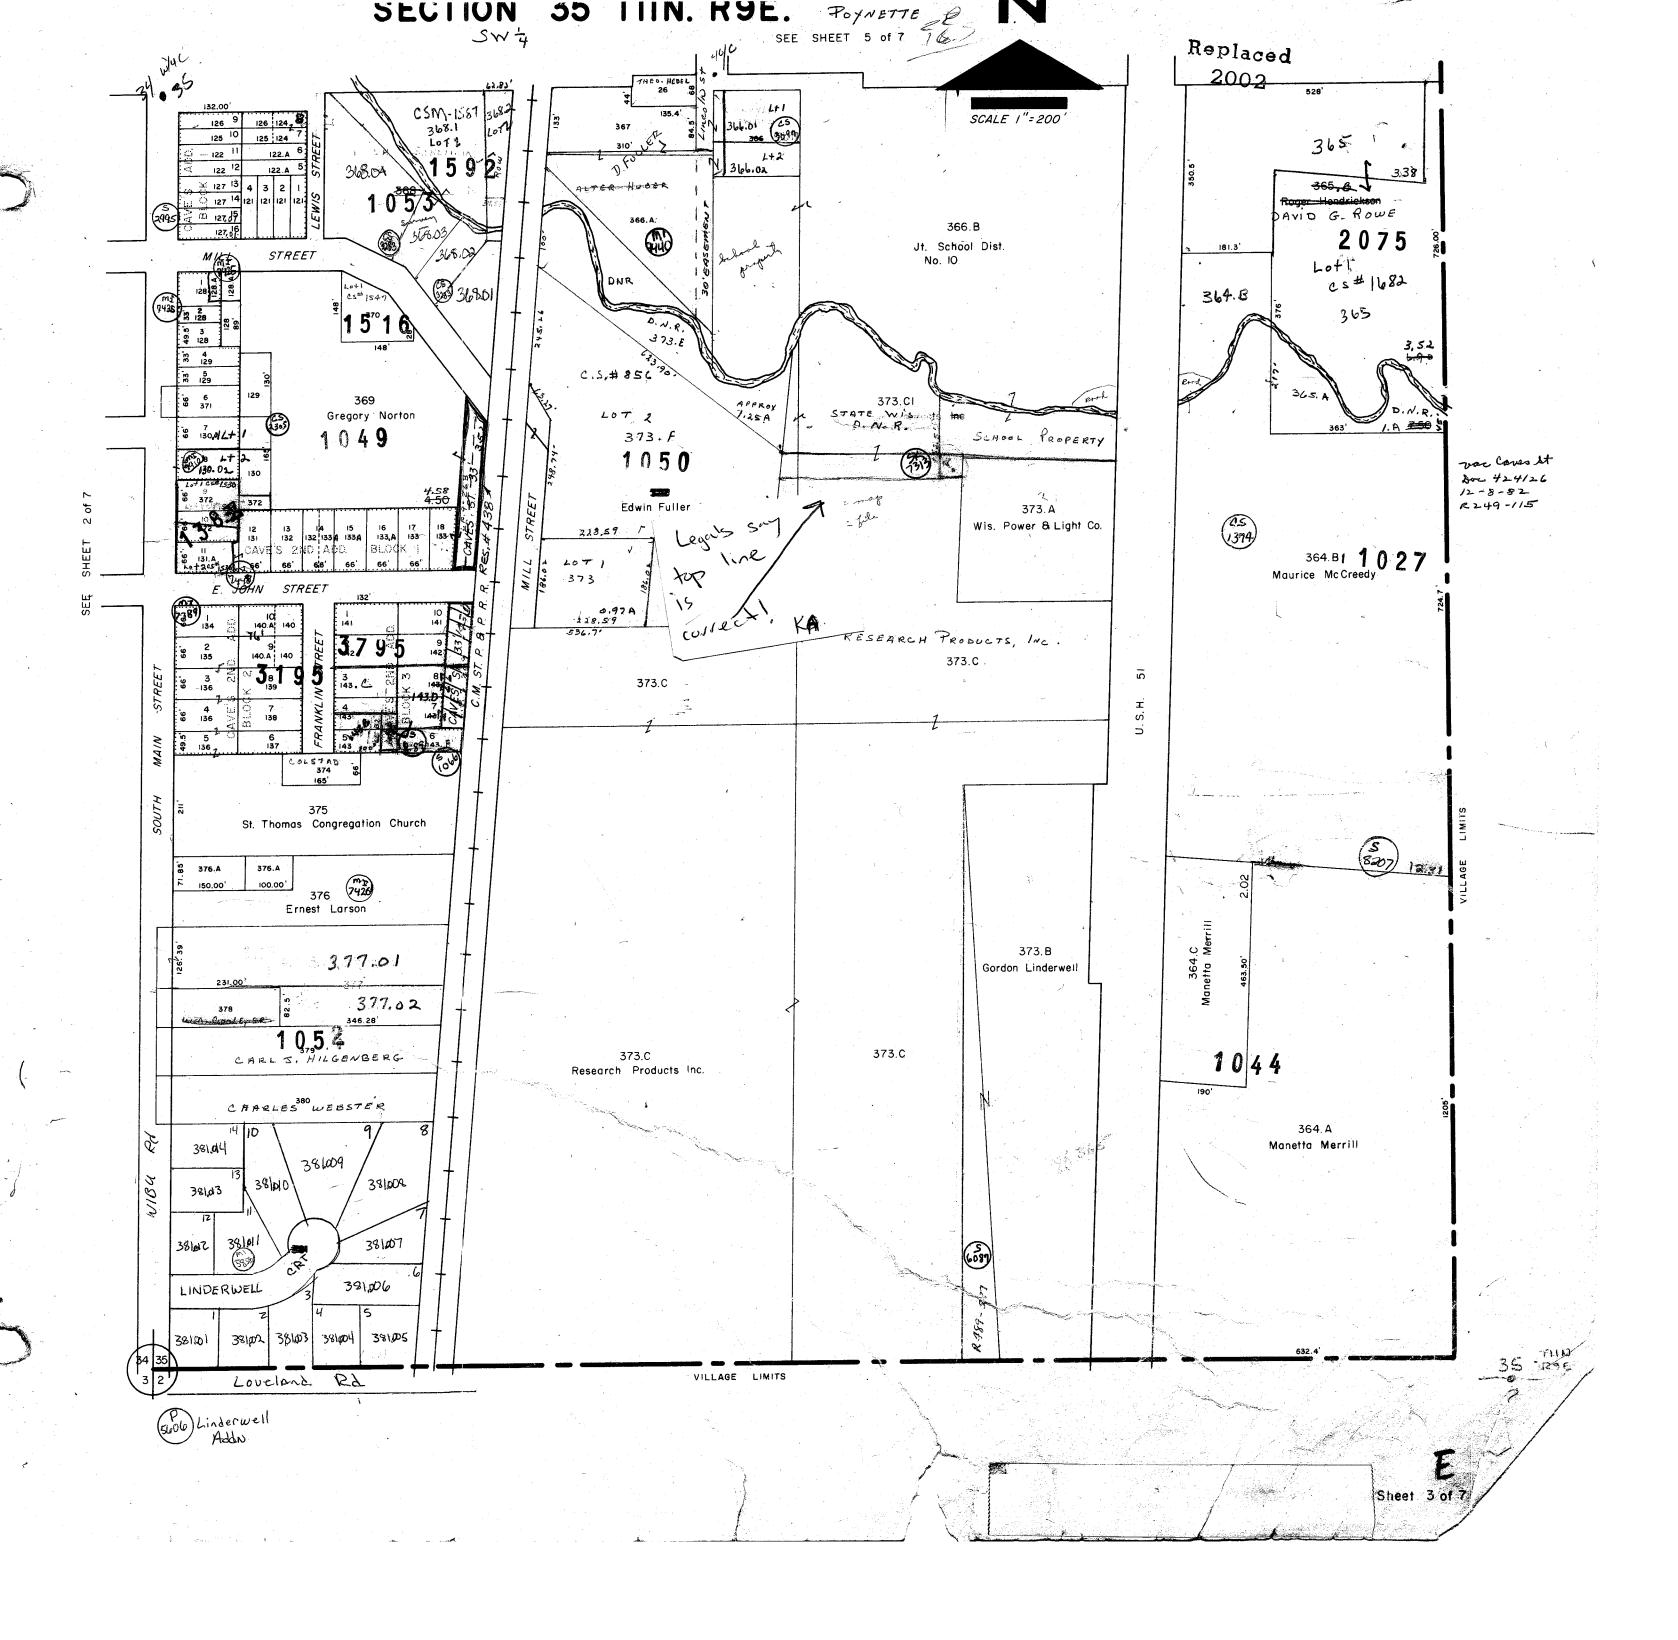


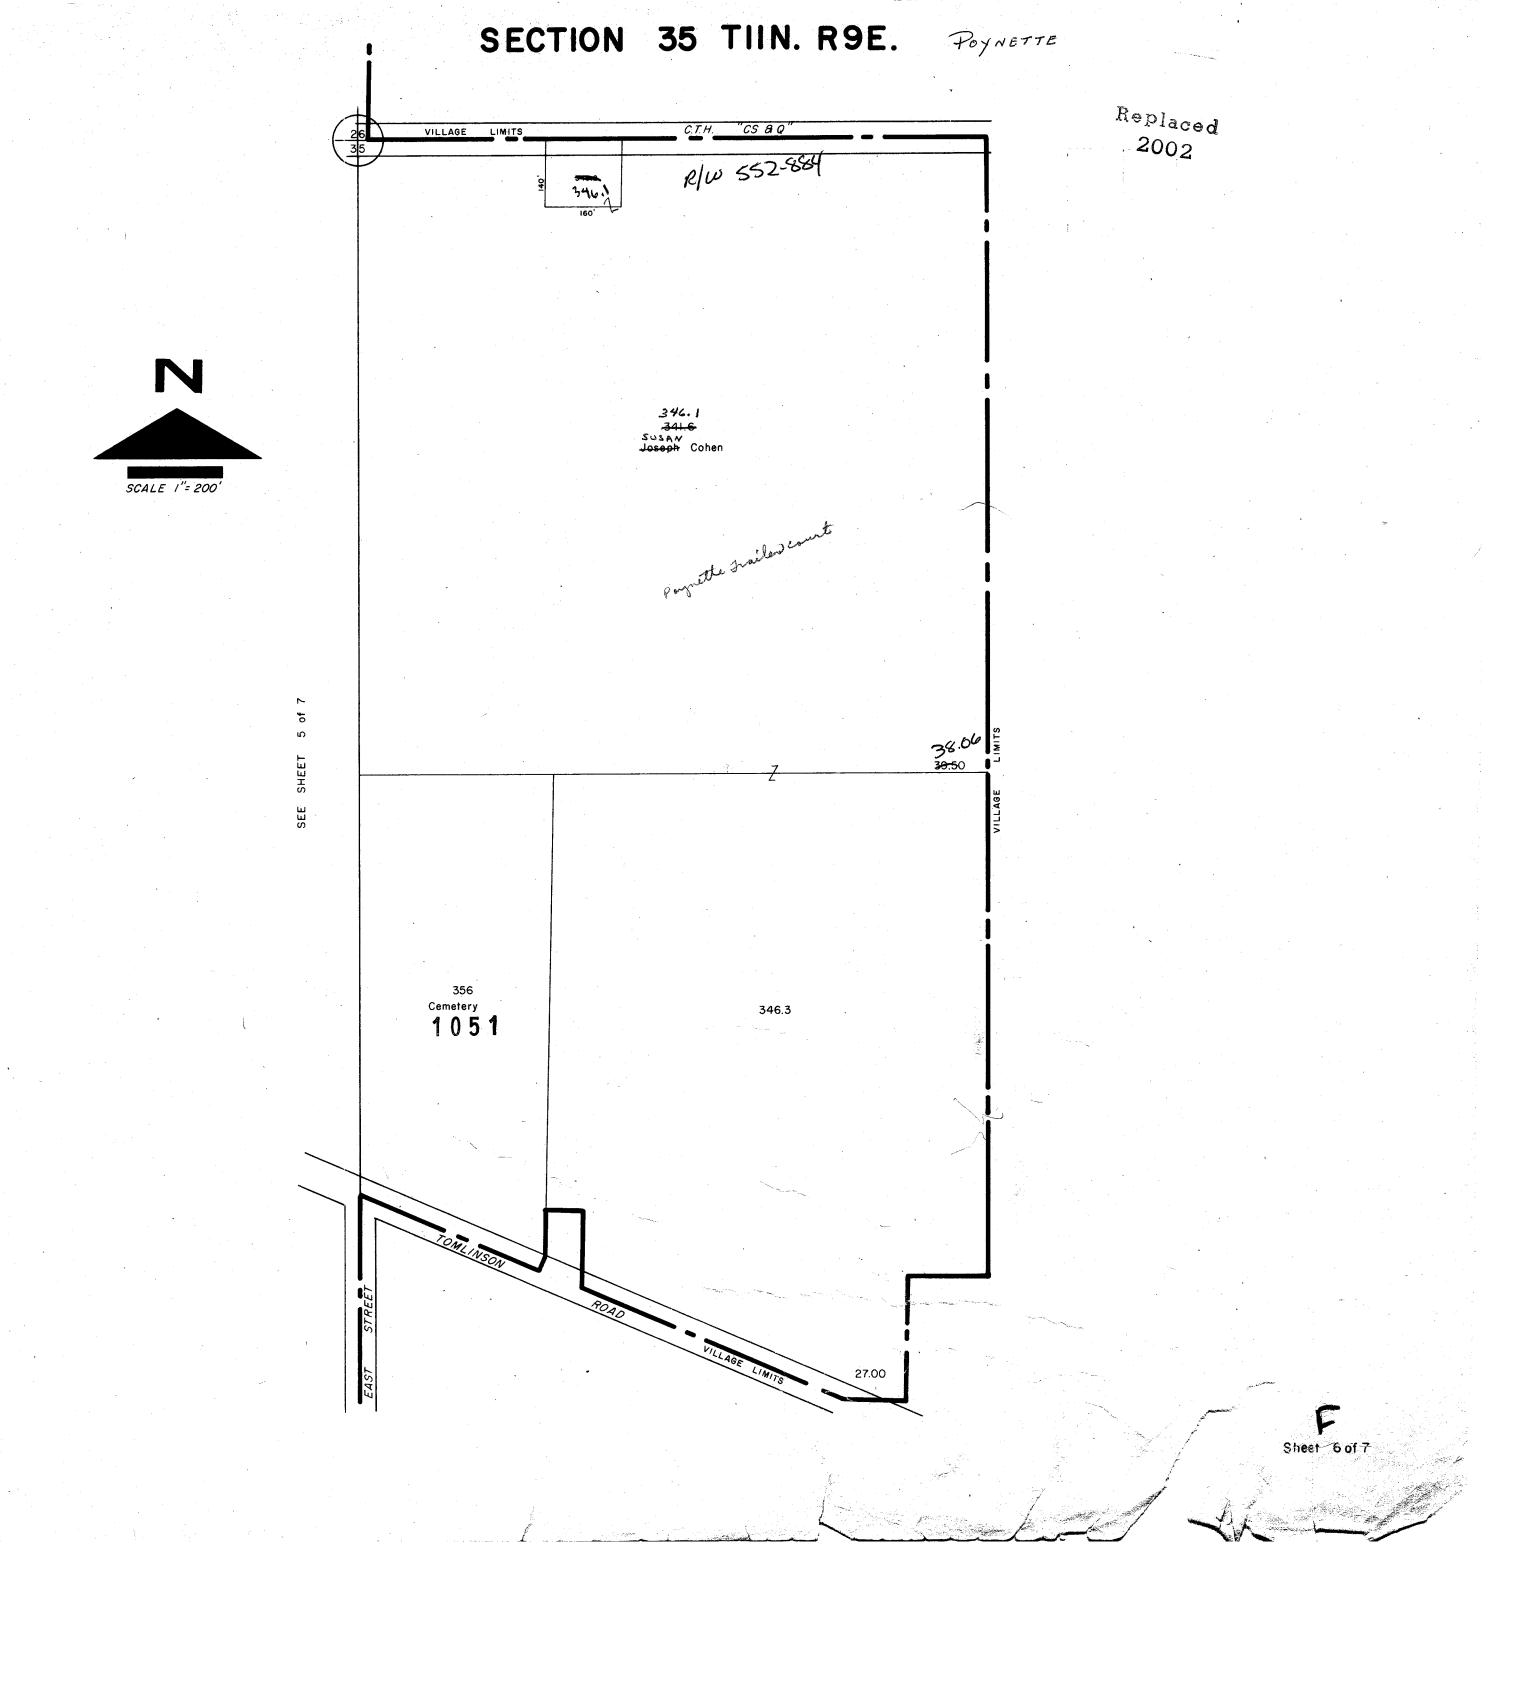

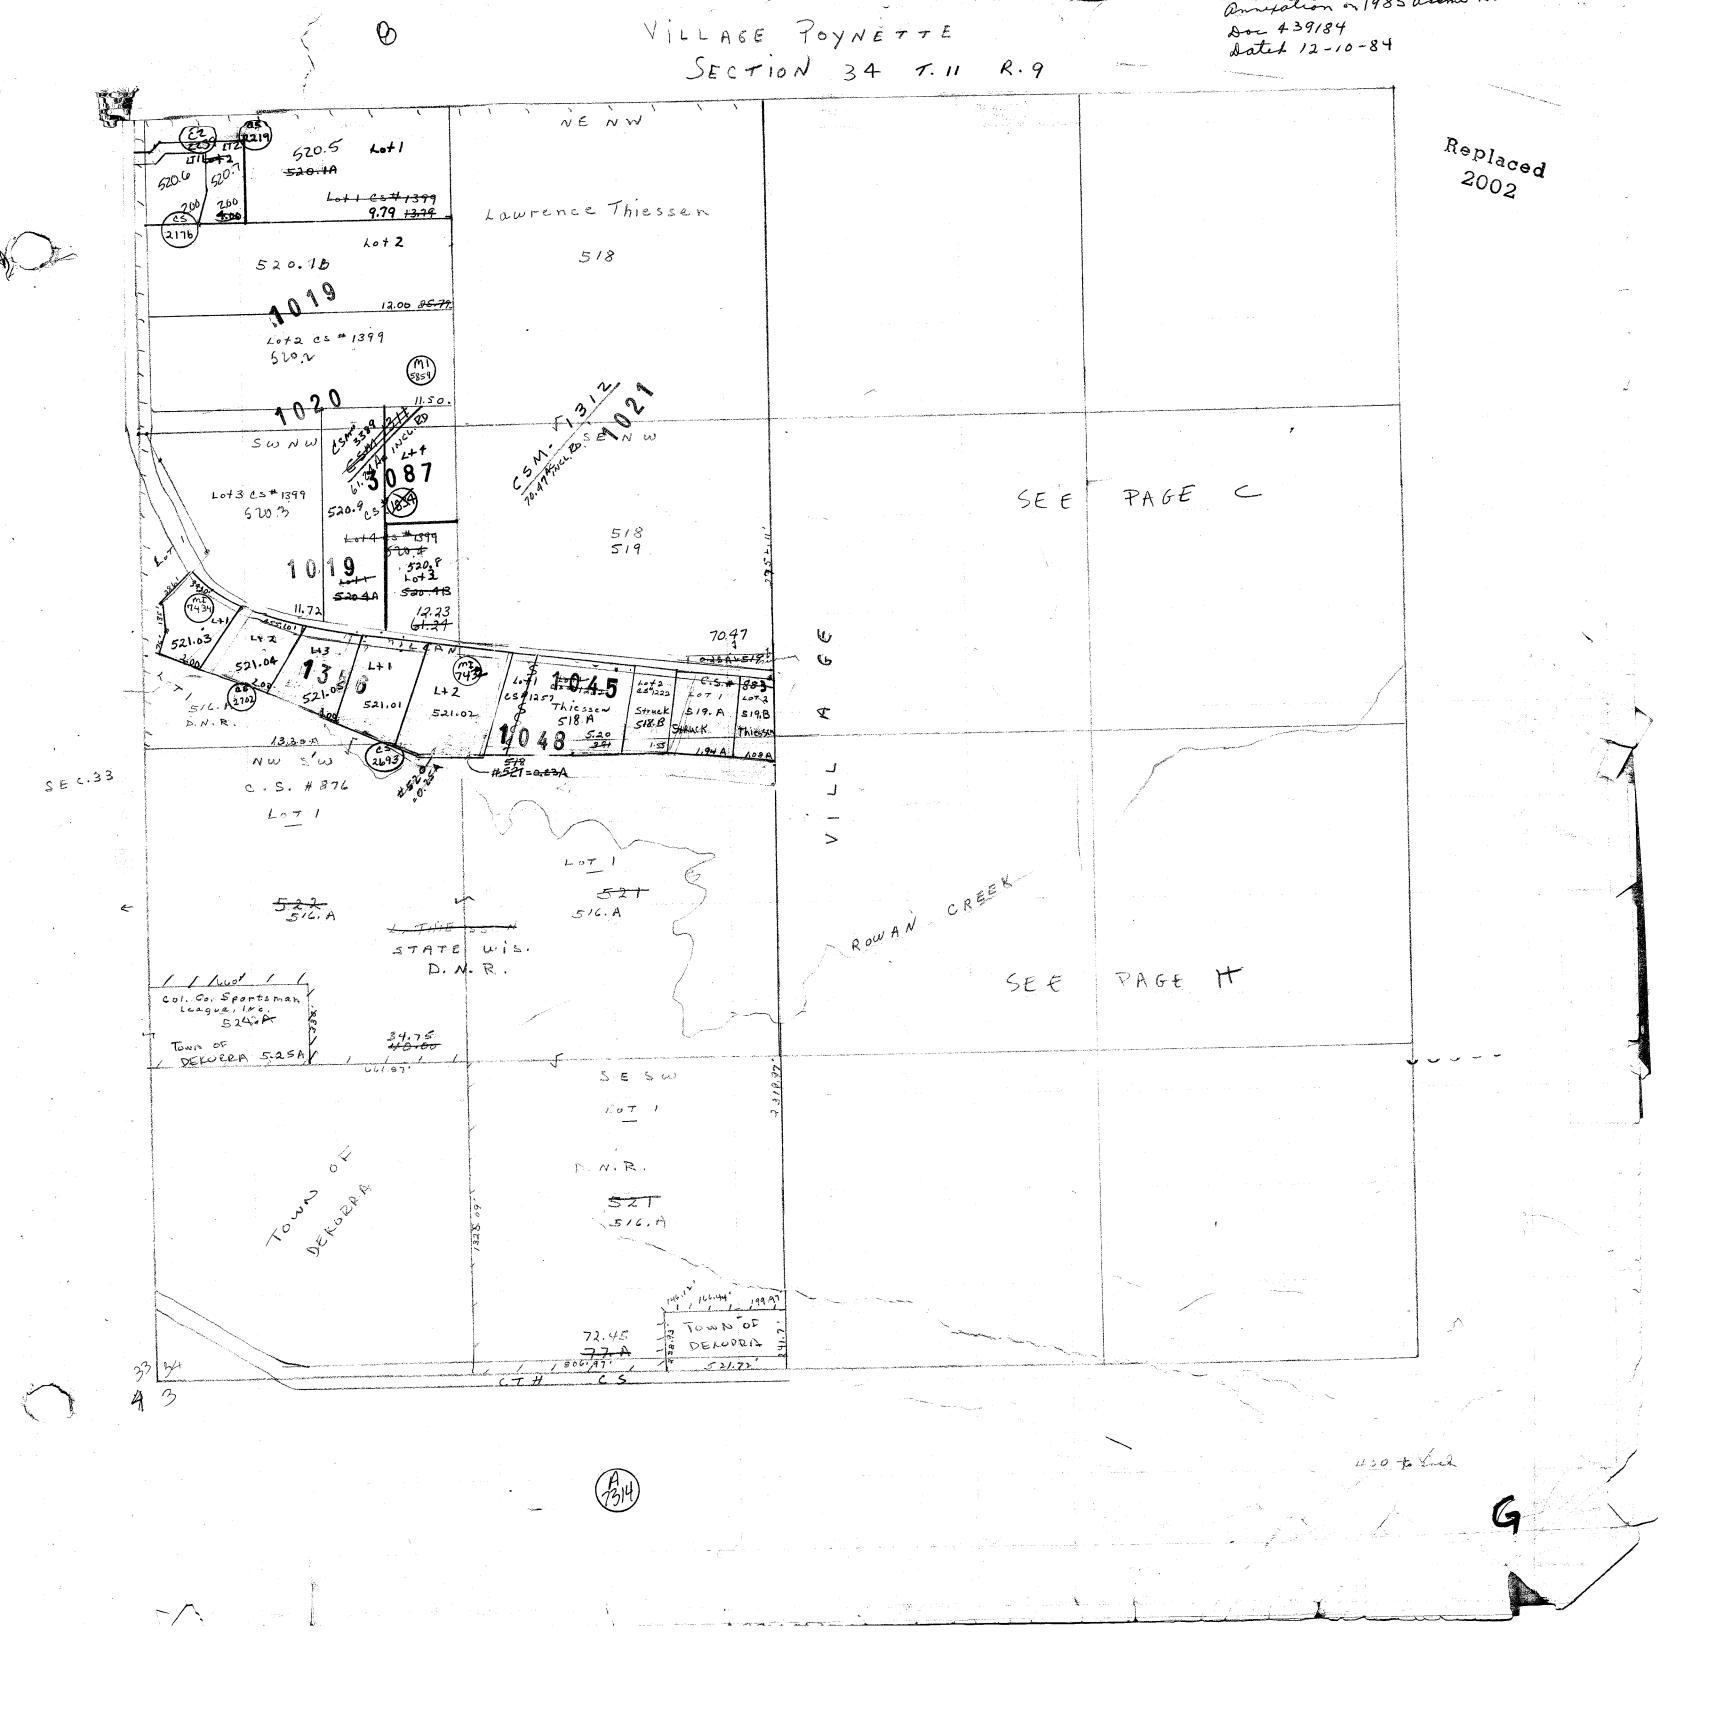

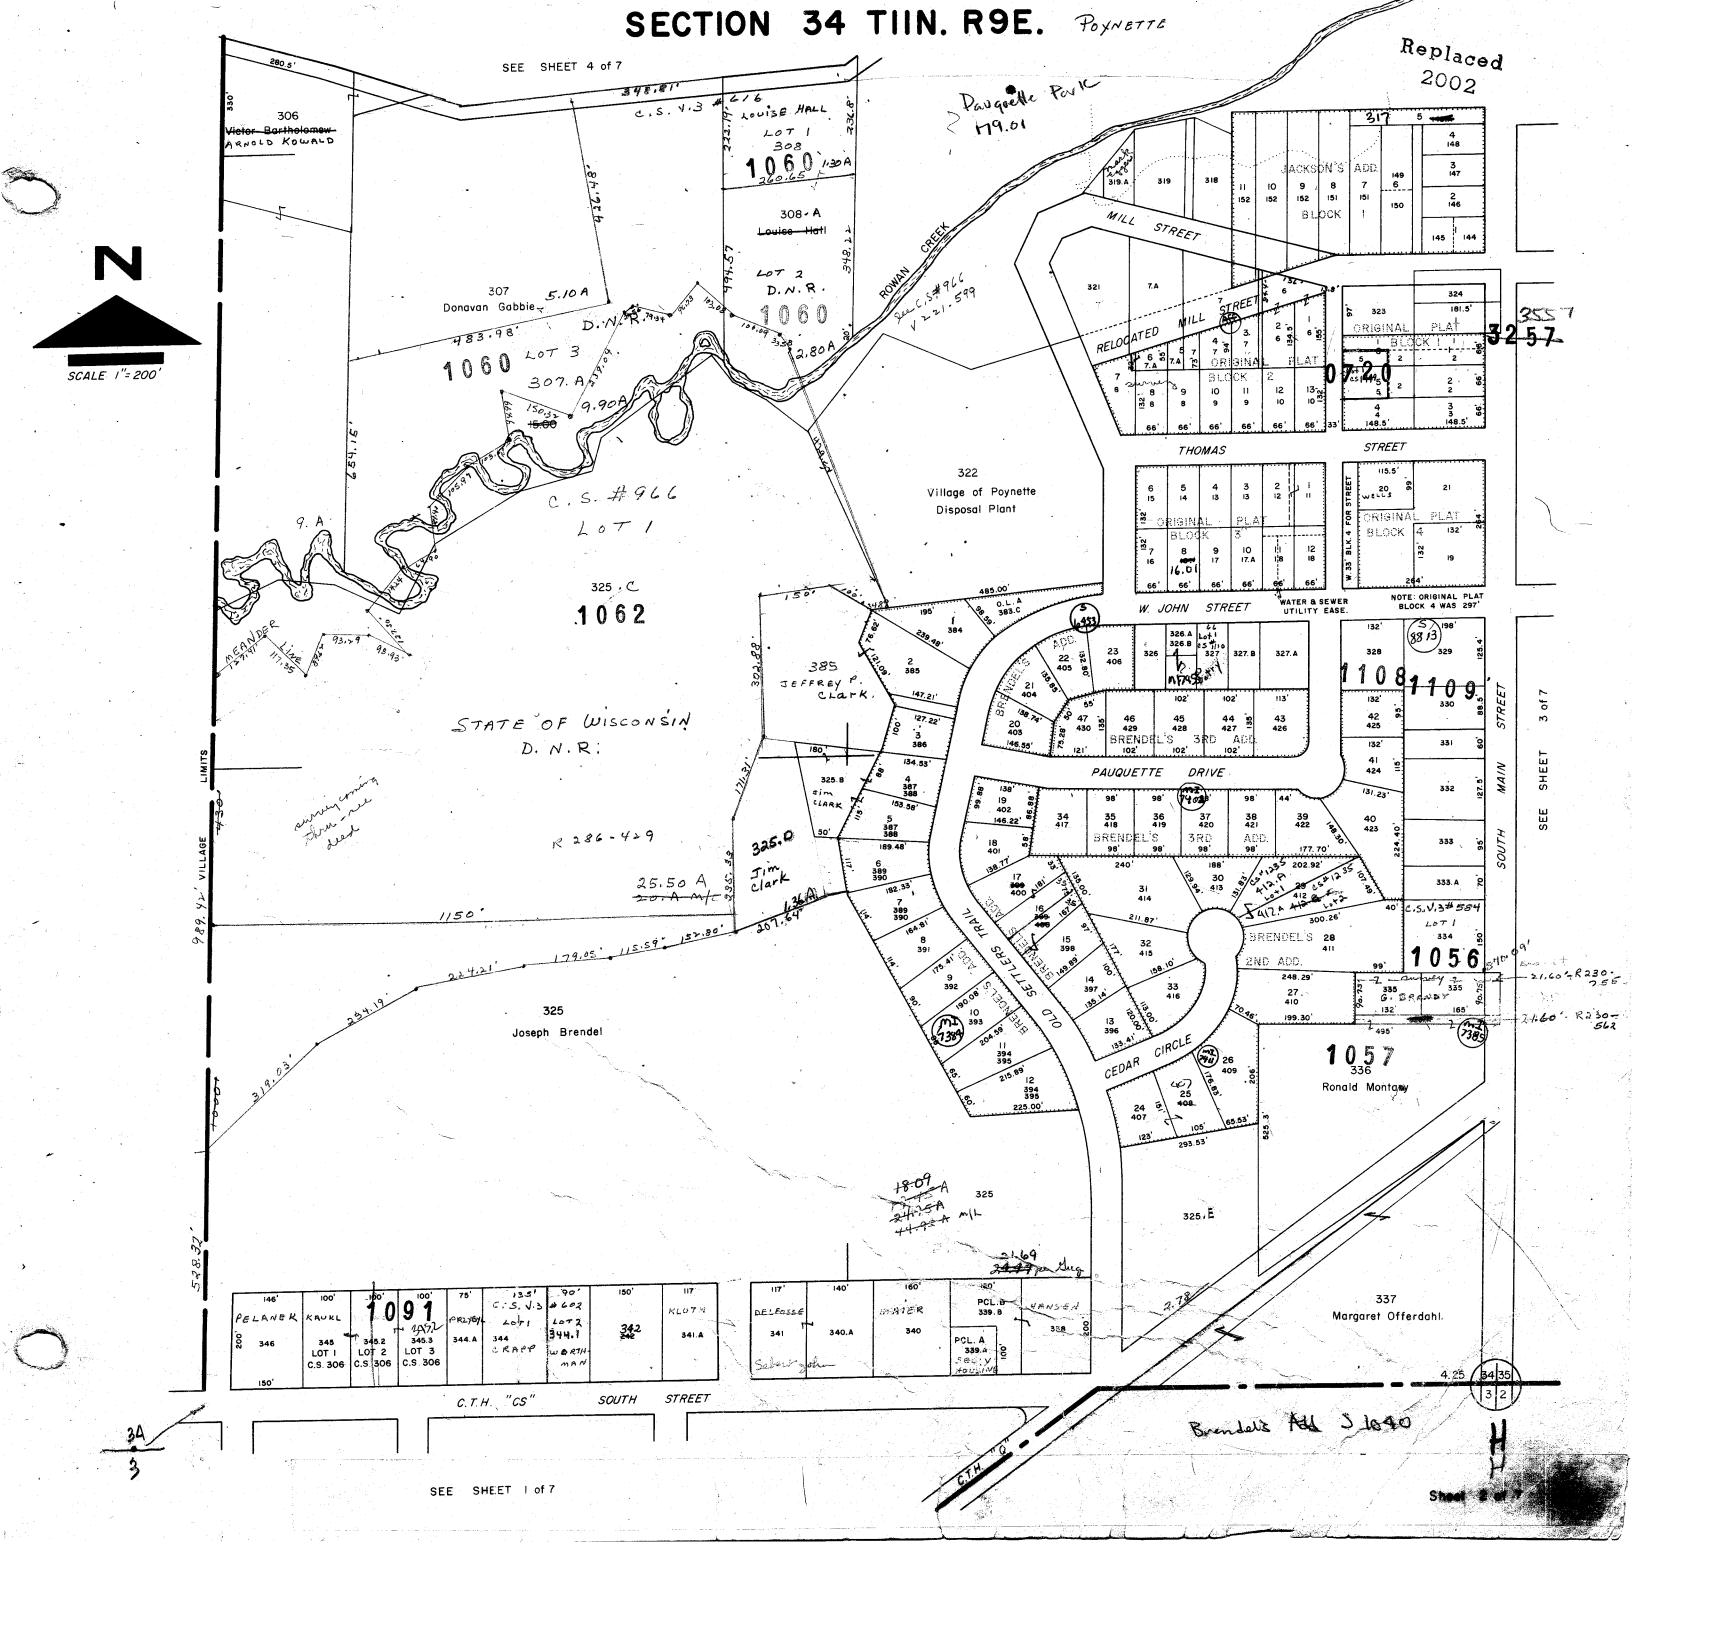


Amegation on 1985 aron't Roll Doc # 439/84 Satet 12-10-84 VILLAGE POYNETTE SECTION 33 T.11 R.9 Total 369.70 Ac. NET Replaced2002 503, A- fat 1 C.S. \$376 - 1.00 A 503, B \$42 C.S. \$376. 3.60 A CC0.30 LOT 2 503.B. ED.N.R. VILLAGE POYNETTE c.s. #876 516. A got Rut1-C.S. + 876-149,50 NE SE NW SE 516.8 pt 1. d. 2. 6.5. #876 - 2.00 LOT 1 STATE WIS. D. N.R. V. POYNETTE 42.34 516 516.A 5/7 (7515) TOT AL 11 / Jarma 1324.54. Col. Co. Sportsman League, luc TOWN OF 513. A TOWN DF PEKORPA

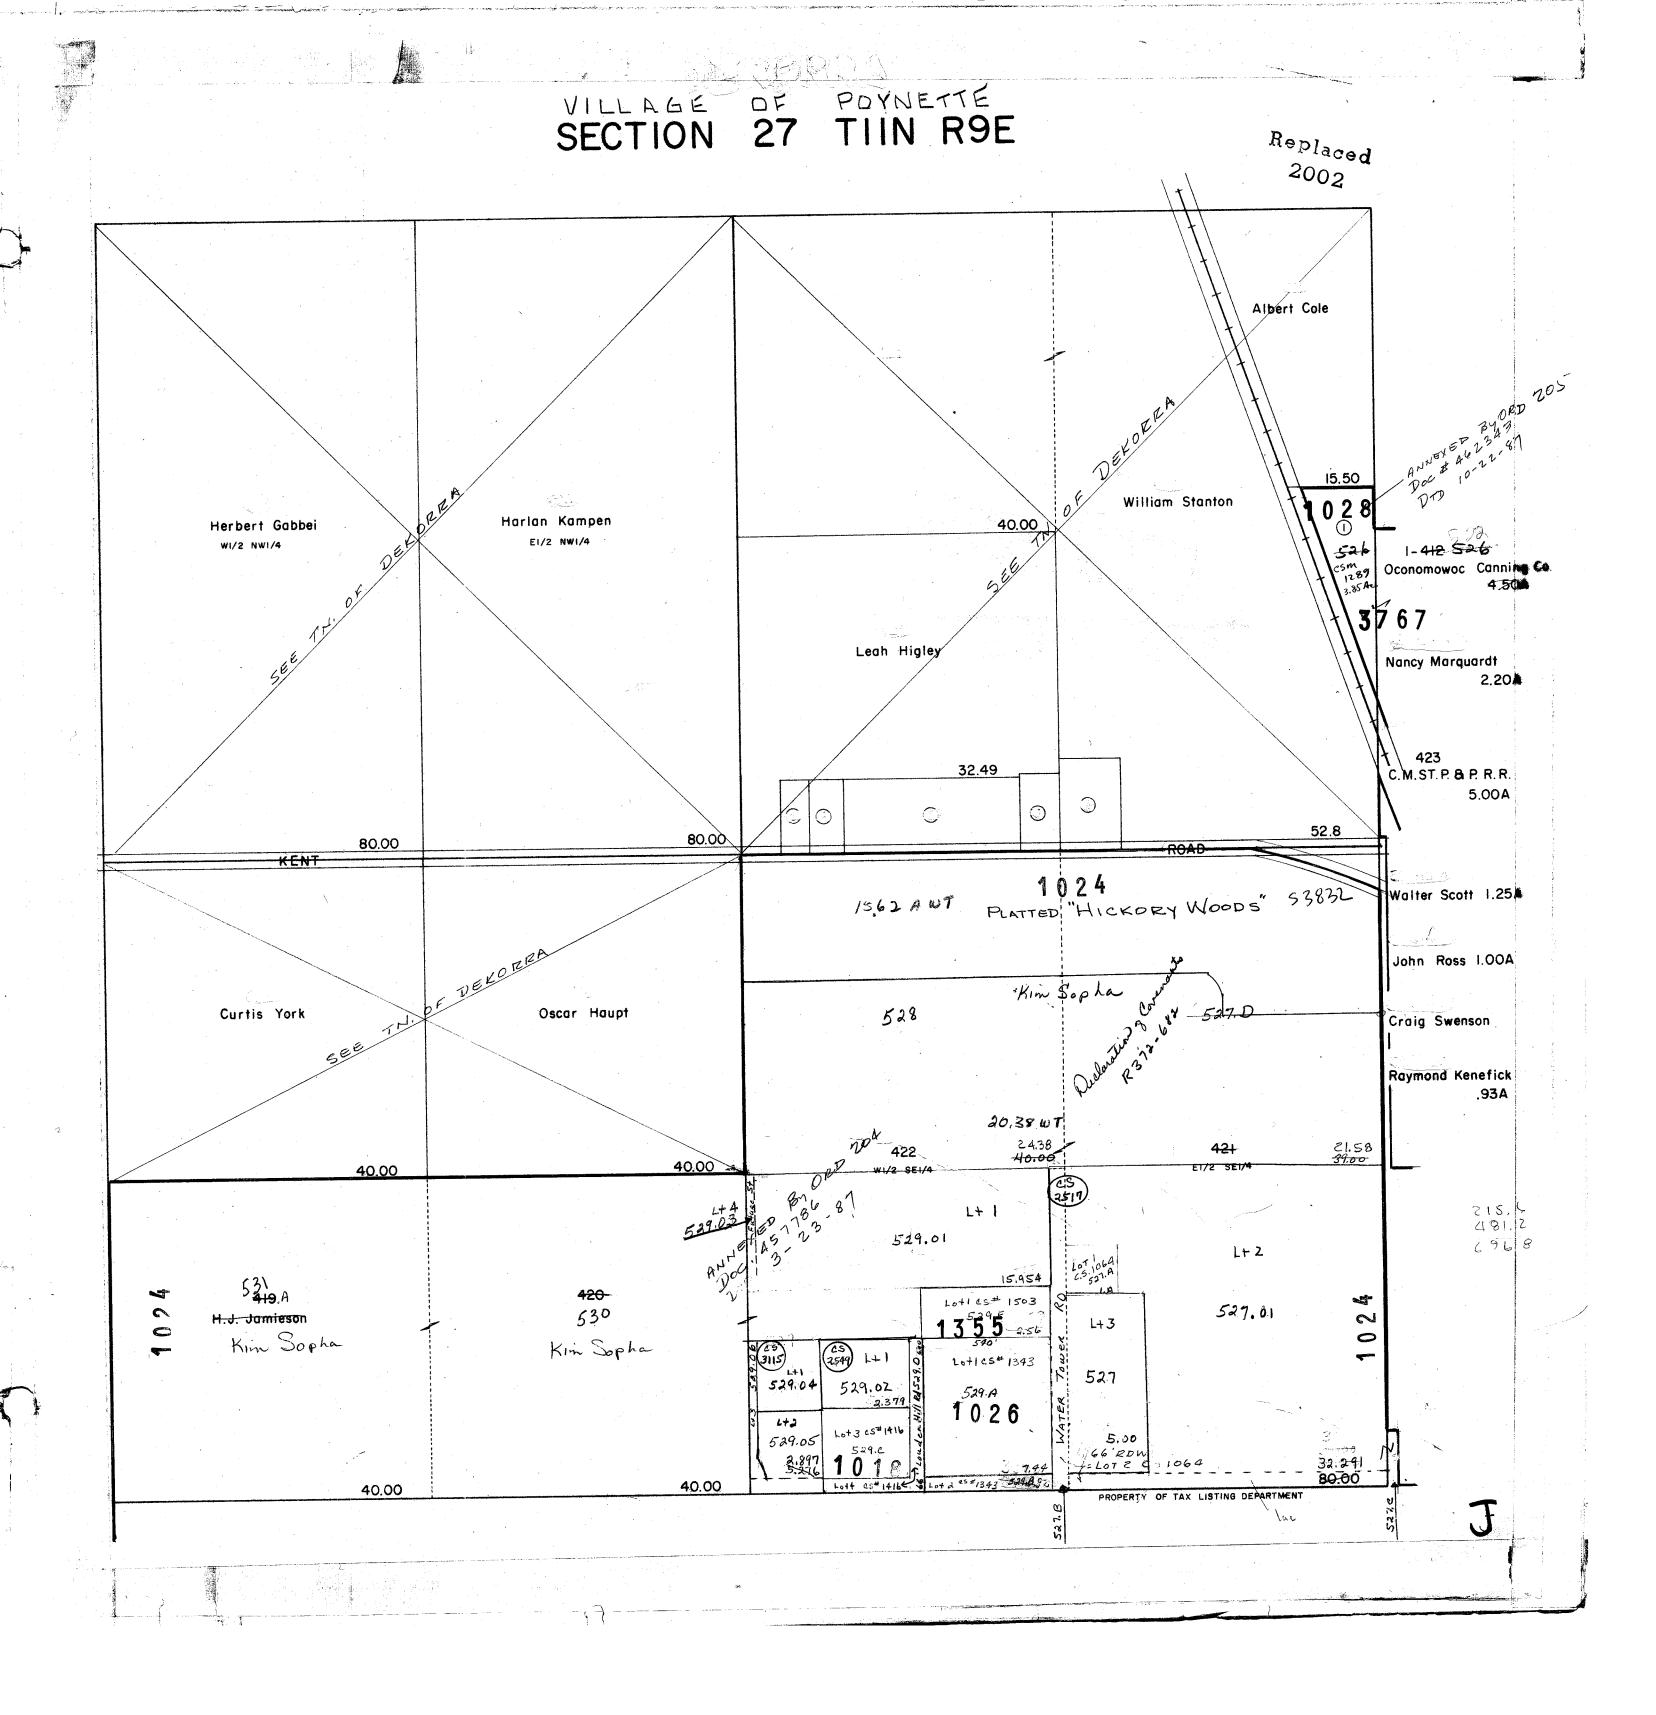

SUBDIVISION

TRAVE

BLOCK

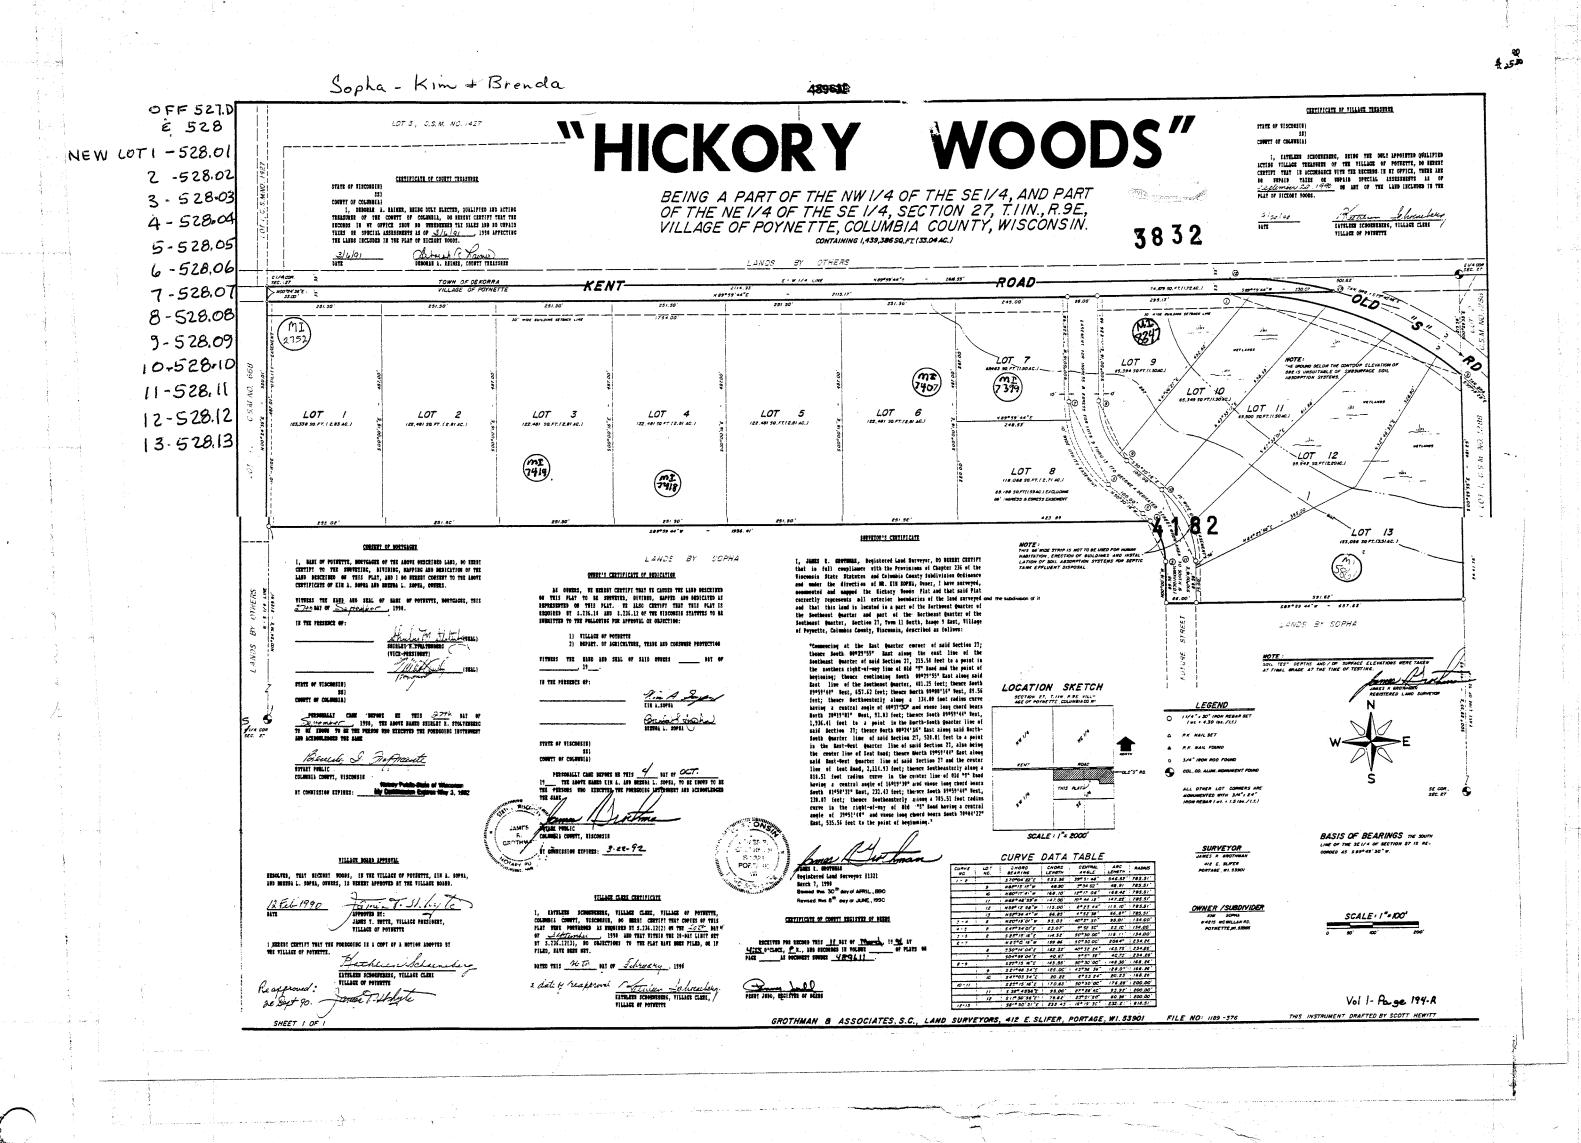

VILLAGE OF POYNETTE SECTION 26 TIIN R9E  $\frac{\text{Replaced}}{2002}$ James Genrich 6.00 0 Weldon Morse Dennis Gatling William Wolf NI/2 NWI/4 E. OF HWY. Weldon Morse 0 9.00A Marvin Kaukl 58.00 31.80 40.00 2.00A PART TAX NO. 388 Frank Richardsom 3767 4-398. A Csm 1289 5221028 Oconomowoc Canrago Co. 4.43A SI/2 NW1/4 EXC. W 22.00A Gregory Hofmeister Poynette Christian School Inc. Oconomowoc Canning Co. Leonard Thomps 0.46A Hubert Haight 4 2.23A 26.74 26.21 147.5 42.20 40.00 54.00 Kented 50 3 3 1.0 3 3 50 MEL 288 10.00 524 Plat 376Z Pauguette Pines 19233 E1/2 SE1/4 408 525 (2743) L+ 1 <del>10.35</del> 10.50 534.01 401. A Village of Jamieson Thomas Jamieson 382.2 . 3.08 L+ 2 534 534.0 Donald Stevenson 14.39 1.08 532 382.1 18.8**58** NORTH 16.12 11.88 80.00 PROPERTY OF TAX LISTING DEFARTMENT ANNEXED FROM TOWN OF DEKORRA TO VILLAGE OF POYNETTE 410

COLUMBIA COUNTY LAND INFORMATION DEPARTMENT SECTION-TOWN-RANGE 1/4 SEC KEY Portage, Wisconsin 27-11-09 MAP SCALE 1'' = 400'LATEST REVISION DATE: 2/20/97 DATE: 2/20/97 C.A.D Filename: 110927.dwg Currier Number 2110 22 23 Replaced 2002 670.90 27 27 28 Town 11 North-Range 9 East 411 15.5ac Section 27 Village of Poynette 414 416 39.346ac 416.A 41.084ac 672 S 672 417 72.92ac 1289 413 (CSM 1427) S 694 52.8ac (CSM 1427 417.B 415 8.597 AC 30.86ac ...Plat on File descrepancy 697 between CS1427 Survey on File & R390-528 CSM 1300 ...Certified Survey Map 415.C ... Mortage Inspection on File W8350 W8104 W8228 W8210 ...Monumented Section Corner W8486 W8452 W840( **251.50** 250 Kent Rd W8315 LT or Lot ....lot number of CSM/Plat W8401 W8425 528.06 2.81ac MI 7407 NOTE: This map was prepared for assessment use in 528.05 2.810c 528.04 2.81ec MI 7418 528.03 2.810c 528.02 2.810c MI 7419 CSM 夏 夏 528.01 2830c CSM 771 accordance with Wis. St. Stat. Chap. 70.09. 771 All information contained herein is advisory only. 528.08 2.71cc Map accuracy is limited to the quality of data obtained from other Public Records. This map is not intended to be a substitute for an actual field survey. Public Land Survey Base is derived from U.S.G.S. Topographic Maps unless otherwise noted. Other source of Land Base may be actual 418 31.475ac 419 20ac 419.B 20.276ac 11172-527.D 11172-528 Corporate Limits CSM 2517 CSM 2517 11172-529.01 (CSM 1503) 11172-527.01 32.291ac 11172-529.E 172-529.02 CODD 2.3790c SED (CSM) 2549 11172-531 11172-530 11172-529.A (CSM 2517) CSM 1343 172-529 NORTH STREET 28 34 35 34 33

RANGE NWOT

TAX PARCEL MAP NOTE: This map was prepared for assessment use in accordance with the Wis. St. Stat. Chap. 70.09. All information contained herein is advisory only. Map accuracy is limited to the quality of data obtained from other Public Records. This map is not intended to be a substitute for an actual field survey. Public Land Survey Base is derived from U.S.G.S. Topographic maps unless otherwise noted. Other sources of the Land Base may be actual survey data. Base map data is from the April 1995 County Digital Orthophotos and/or U.S.G.S. 1:24,000 scale Topographic series. The VILLAGE of POYNET user is responsible for the improper use of the data contained herein. TO A STATE OF THE PARTY OF THE Created by The Columbia County Land Information Office -GIS Section. VMB and KMA March 2002 TOWN 11 NORTH RANGE 9 EAST Replaced COLUMBIA COUNTY, WISCONSIN 2003 SUBDIVISION PLAT INDEX BRAYTON & TOMLINSON ADDITION | REGISTER OF DEEDS(R.O.D.) - SHEET 6A | 8 - TOWN of DEKORRA -**BRENDEL'S ADDITION** S 1040 R.O.D. 136B -2ND ADDITION -3RD ADDITION R.O.D. 144A 11 CAVE'S ADDITION R.O.D. 9E 10 -2ND ADDITION 10 7 3 8 8 4 7 7 7 R.O.D. 6E COLUMBIA CONDOMINIUMS S 8391 **COLUMBIA HEIGHTS** R.O.D. 153A H.P. & A.J. JAMIESON R.O.D. 7A -2ND ADDITION
HICKORY WOODS
HILLCREST ADDITION -PHASE I R.O.D. 14A S 3832 R.O.D. 176A HILLCREST ADDITION -PHASE II S 1590 - TOWN of DEKORRA -HILLCREST ADDITION -PHASE III S 3086 HILLCREST ADDITION -PHASE IV
HILLCREST ADDITION -PHASE V S 5100 S 8929 R.O.D. 9D 7 11 - TOWN of DEKORRA -JACKSON'S ADDITION JAMIESON & GAULT ADDITION R.O.D. 6C 8 8 7 -2ND ADDITION R.O.D. 7C JAMIESON'S ADDITION
JAMIESON'S 3RD ADDITION R.O.D. 10A 528.05 S 1041 8 JOHN WAYNE CONDOMINIUM PLAT S 10239 6 HICKORY WOOD 10 11 LINDERWELL ADDITION S 5606 ORIGINAL PLAT R.O.D. 6D 2, 3 7 7 8 14 14 PAUQUETTE PINES S 9233 SARAH A TOMLINSON ADDITION R.O.D. 8B TOMLINSON & HUDSON ADDITION R.O.D. 6B R.O.D. 10B TOMLINSON'S ADDITION R.O.D. 155B WEST HILL SUBDIVISION -1ST ADDITION S 1039 7 WEST POYNETTE ADDITION R.O.D. 7B & 8A 529.E - TOWN of DEKORRA -529.02 HILLCREST ADDITION PHASE IV ADDITIONAL SURVEYS - NOT FOUND ON MAPS -SEC. 28-11-9 SEC. 27-11-9
SEC. 33-11-9 SEC. 34-11-9 S 1030 COMPOSITE 1973 S 1034 COMPOSITE S 1097 520.6 A 7313 JAMIESON'S SRD ADDITION A 7314 A 7316 JOHN WAYNE CONDO PLAT 520.162 / 520.163 520.104 H.P. & A.J. JANIESON Z'NOSSIMAL NOITIDDA - TOWN of DEKORRA -521.01 362A 359 EAST STREET JACKSON'S THE 319 319 152 51 168 168 122 122 1224 1381 1381 15 STRO 10 - TOWN of DEKORRA -- TOWN of DEKORRA -BRENDELS ADDITION BRENDELS 373.8 LINDERWELL ADDITION SEC. 33-11-9 SEC. 4-10-9 SEC. 3-10-9 SEC. 3-10-9 SEC. 2-10-9 WEST HILL BUTTERNUT - TOWN of ARLINGTON -- TOWN of ARLINGTON replaced 2003 -PAGE & PLAT INDEX- One Inch Equals Two Hundred Feet 1/16 FEET


The Columbia County Land Information Office -GIS Section. VMB and KMA March 2002

TAX PARCEL MAP

VILLAGE of POYNE

TOWN 11 NORTH RANGE 9 EAST COLUMBIA COUNTY, WISCONSIN

> Replaced 2003

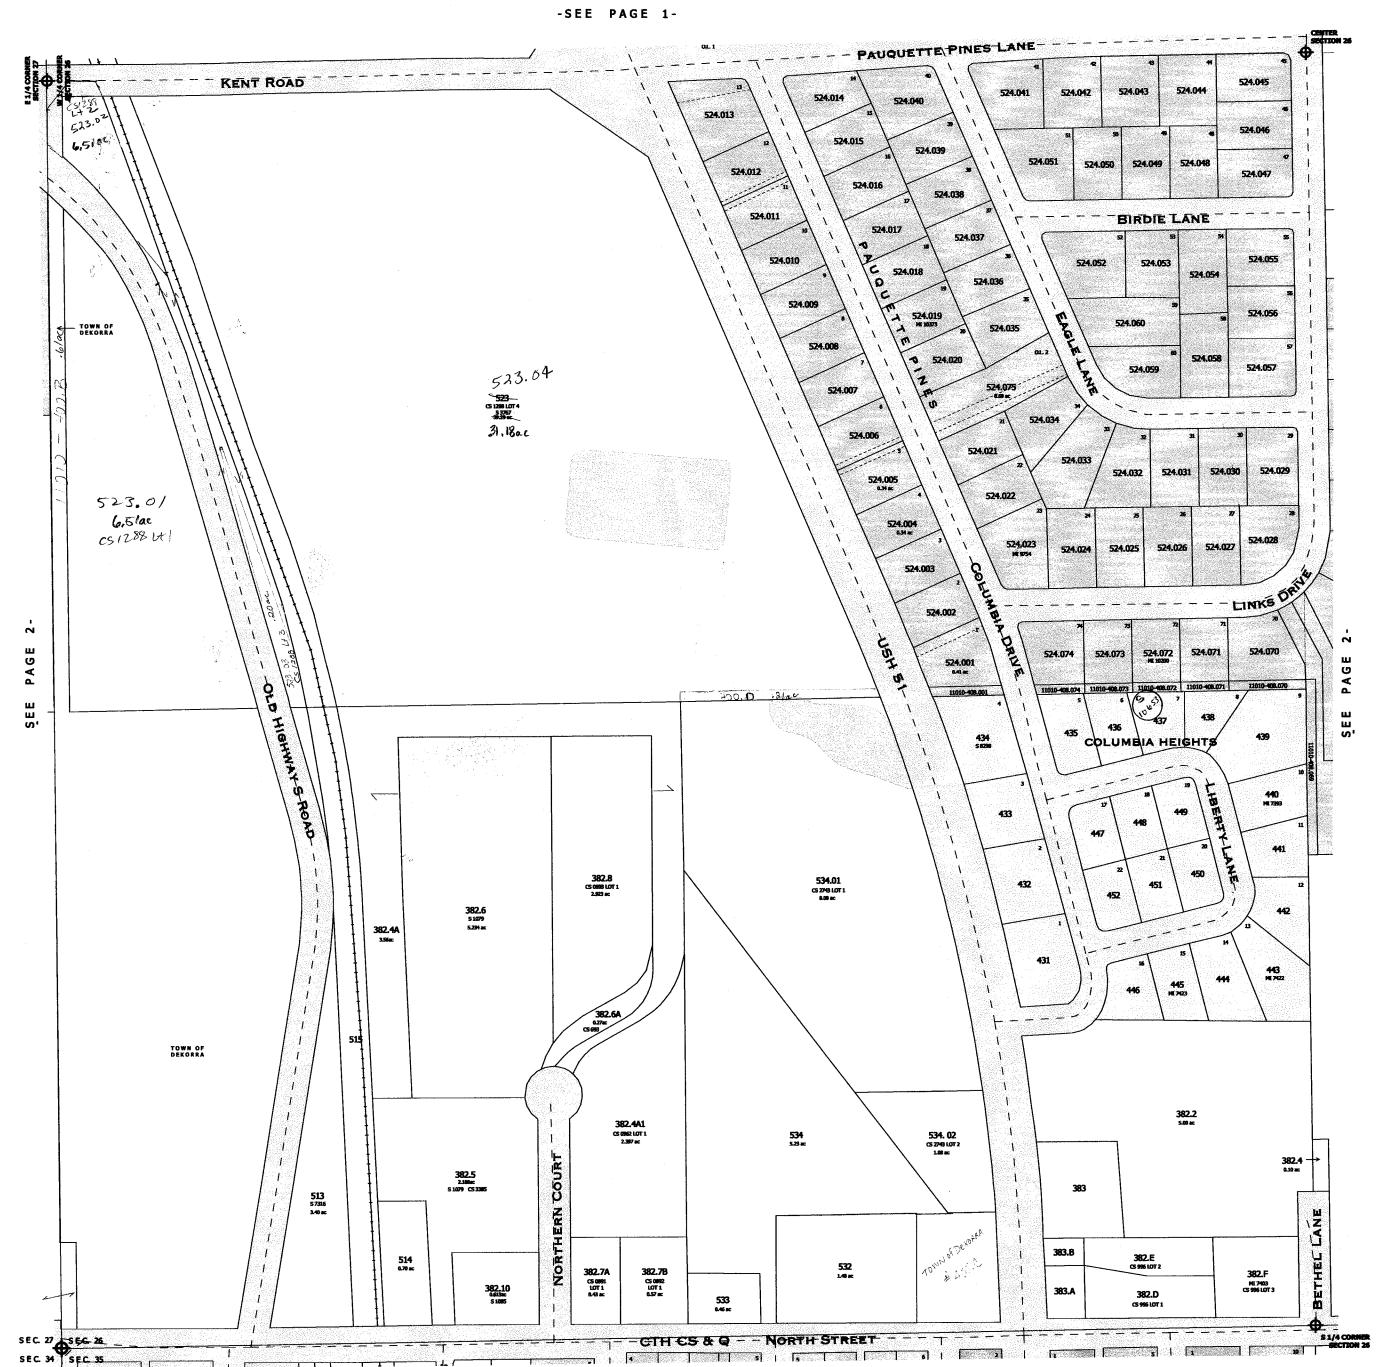

One Inch Equals Two Hundred Feet MILES 1/16 NOTE: This map was prepared for assessment use in accordance with the Wis. St. Stat. Chap. 70.09. All information contained herein is advisory only. Map accuracy is limited to the quality of data obtained from other Public Records. This map is not intended to be a substitute for an actual field survey. Public Land Survey Base is derived from U.S.G.S. Topographic maps unless otherwise noted. Other sources of the Land Base may be actual survey data. Base map data is from the April 1995 County Digital Orthophotos and/or U.S.G.S. 1:24,000 scale Topographic series. The user is responsible for the improper use of the data contained herein.

Created by The Columbia County Land Information Office -GIS Section. VMB and KMA March 2002

TAX PARCEL MAP

## VILLAGE of POYNETTE

TOWN 11 NORTH RANGE 9 EAST COLUMBIA COUNTY, WISCONSIN

Replaced

2003



One Inch Equals Two Hundred Feel TAX PARCEL MAP map was prepared for assessment use in accordance with the Wis. St. Stat. Chap. 70.09. All information rein is advisory only. Map accuracy is limited to the quality of data obtained from other Public Records. of intended to be a substitute for an accual field survey. Public Land Survey Base is derived from U.S.G.S plic maps unless otherwise noted. Other sources of the Land Base may be actual survey base from the April 1995 County Digital Orthophotos and/or U.S.G.S. 1:24,000 scale Topographic series. The user is responsible for the improper use of the data contained herein. TOWN 11 NORTH RANGE 9 EAST COLUMBIA COUNTY, WISCONSIN ited by The Columbia County Land Information Office -GIS Section. VMB and KMA March 2002 Replaced 2003 -SEE PAGE 4-SEC 27 SEC. 26 N 1/4 CORNER NORTH STREET 299.J1 296.02 \$ 1022 CS 1345 CS 2417 107 2 0.56 ac 296.01 299.049 299.094 634 ac 299.053 299.095 134 ac 299.055 ME 8942 299.054 299.099 134 sc 299.098 299.040 299.039 299.038 299.052 299.051 S 1022 CS 1345 CS 2417 LOT 1 0.50 ac 299.102 299.101 299.100 03## 299.037 HILLCREST ADDITION 299.048 COLBY BOULE NA PHASE 297 297 COLBY BOULEVARD 299.047 281 299.093 299.041 299.031 299.032 299.105 0.267 sc 299.106 €207 ×× 299.107 6297 æ 299,108 020 sc 299.109 6267 sc 299.103 0.331 ac 299.110 299.058 299.104 299.056 MI 7391 299.057 281.A 299.033 299.116 0341 ac PHASE ADDITION HIDLOREST ADDITION
HIDLOREST ADDITION
299.N
9,029 299.092 M 649 W. GRANT STREET 299.062 299.061 299.060 HILLCREST ADDITION 299.063 299.115 €342 æ 299.114 299.113 0322 sc 299.112 0322 sc 299.111 6322× 299.117 0361 ≈ 299.81 CS 0271 LOT 2 0.50 ac PHASE IV 299.043 299.029 SUNSET DRIVE MLINSONS 299.118 299.022 Nt 7388 299.023 299.066 299.121 0279 ac 299.122 0.30 sc 299.123 0207 sc 299.124 0267 sc 299.125 0.207 ac 299.064 HE 5858 ADDITION 299.027 HI 7404 299.B2 CS 0271 LDT 1 0.50 ac 299.024 HILLEREST 299.119 PHASE II 299.067 299.088 W. HUDSON STREET 299.073 ME 6138 299.075 NE 7615 299.074 299.072 299.071 299.071 299.120 0361 ac 299.068 301

HILLCREST ADDITION PHASE - - VALLEY-VIEW DRIVE 299.019 279.A 299.085 299.086 299.087 299.078 299.082 ME 6707 299.083 M 661 299.084 299.126 0371 ≈ 299.079 299.080 299.081 302 501 ME 7443 278 299.K CS 9611 LOT 1 1.24 ac GREENWAY W. TOMLINSON STREET 299.133 ..... MEADOW JAN 259 299.132 0.318 ec 299.127 303 **HILLCREST ADDITION** MAIN STREET PHASE V 299.128 0.333 ac COLBY PARK 299.P 5.21 ac 299.C1 S 1096 S 8662 S 8668 CS 0467 LOT 2 0.46 ac 299.C2 \$ 1096 \$ 8661 \$ 8668 CS 0467 LOT 3 0.46 ac 303.A 05 1236 LOT 1 PAGE 299.129 0334 sc 299.131 496 COLUMBIA CONDOS \_ W. SEWARD STREET 299.130 160 299.H \$1095 C\$465 LOT 1 0.42 ac 170 574 162 158 156 171 164 300 157 BLOCK 2 173 1739 155 310.02 CS 2092 LOT 2 167 174 155.A 295 <sub>|</sub>175 285 153 BLOCK 5 BLOCK I -WEST WASHINGTON STREET JAMIESON'S ADDITION 177 176 182 181 294.2 314 51089 COLUMBIA COUNTY HIGHWAY SHOP & GRAVEL PIT 178.01 313 s 1099 182 BLOCK 10 BLOCK 9 299.A \$1067 \$2015 31.46 ac 177.A 311 N 288 291 291.A1 STREET 291.A 5640 292.03 ACABEMY PAUQUETTE PARK L 290 ★ 179.01 292.04 293 52015 312 5 1059 CS# 3802 MCMILEAN ROAD 316 41 SURVEY INDEX COLUMBIA CONDOMINIUMS HILLCREST ADDITION PHASE REGISTER OF DEEDS(R.O.D.) - SHEET 176A -SEE PAGE 7-HILLCREST ADDITION PHASE II S 1590 HILLCREST ADDITION PHASE III HILLCREST ADDITION PHASE TV S 5100 HILLCREST ADDITION PHASE V S 8929 JAMIESON'S ADDITION R.O.D. 6C SARAH A TOMLINSON'S ADDITION R.O.D. 8B
TOMLINSON & HUDSON ADDITION R.O.D. 6B

WEST POYNETTE ADDITION

R.O.D. 7B & 8A

One Inch Equals Two Hundred Feet

MILES

0 1/16 1/8

FEET

0 200 400 600 80

NOTE: This map was prepared for assessment use in accordance with the Wis. St. Stat. Chap. 70.09. All information contained herein is advisory only. Map accuracy is limited to the quality of data obtained from other Public Records. This map is not intended to be a substitute for an actual field survey. Public Land Survey Base is derived from U.S.G.S. Topographic maps unless otherwise noted. Other sources of the Land Base may be actual survey data. Base map data is from the April 1995 County Digital Orthophotos and/or U.S.G.S. 1:24,000 scale Topographic series. The user is responsible for the improper use of the data contained herein.

VILLAGE of POYNETTE

TAX PARCEL MAP


Created by The Columbia County Land Information Office -GIS Section. VMB and KMA March 2002

TOWN 11 NORTH RANGE 9 EAST COLUMBIA COUNTY, WISCONSIN


Replaced

2003



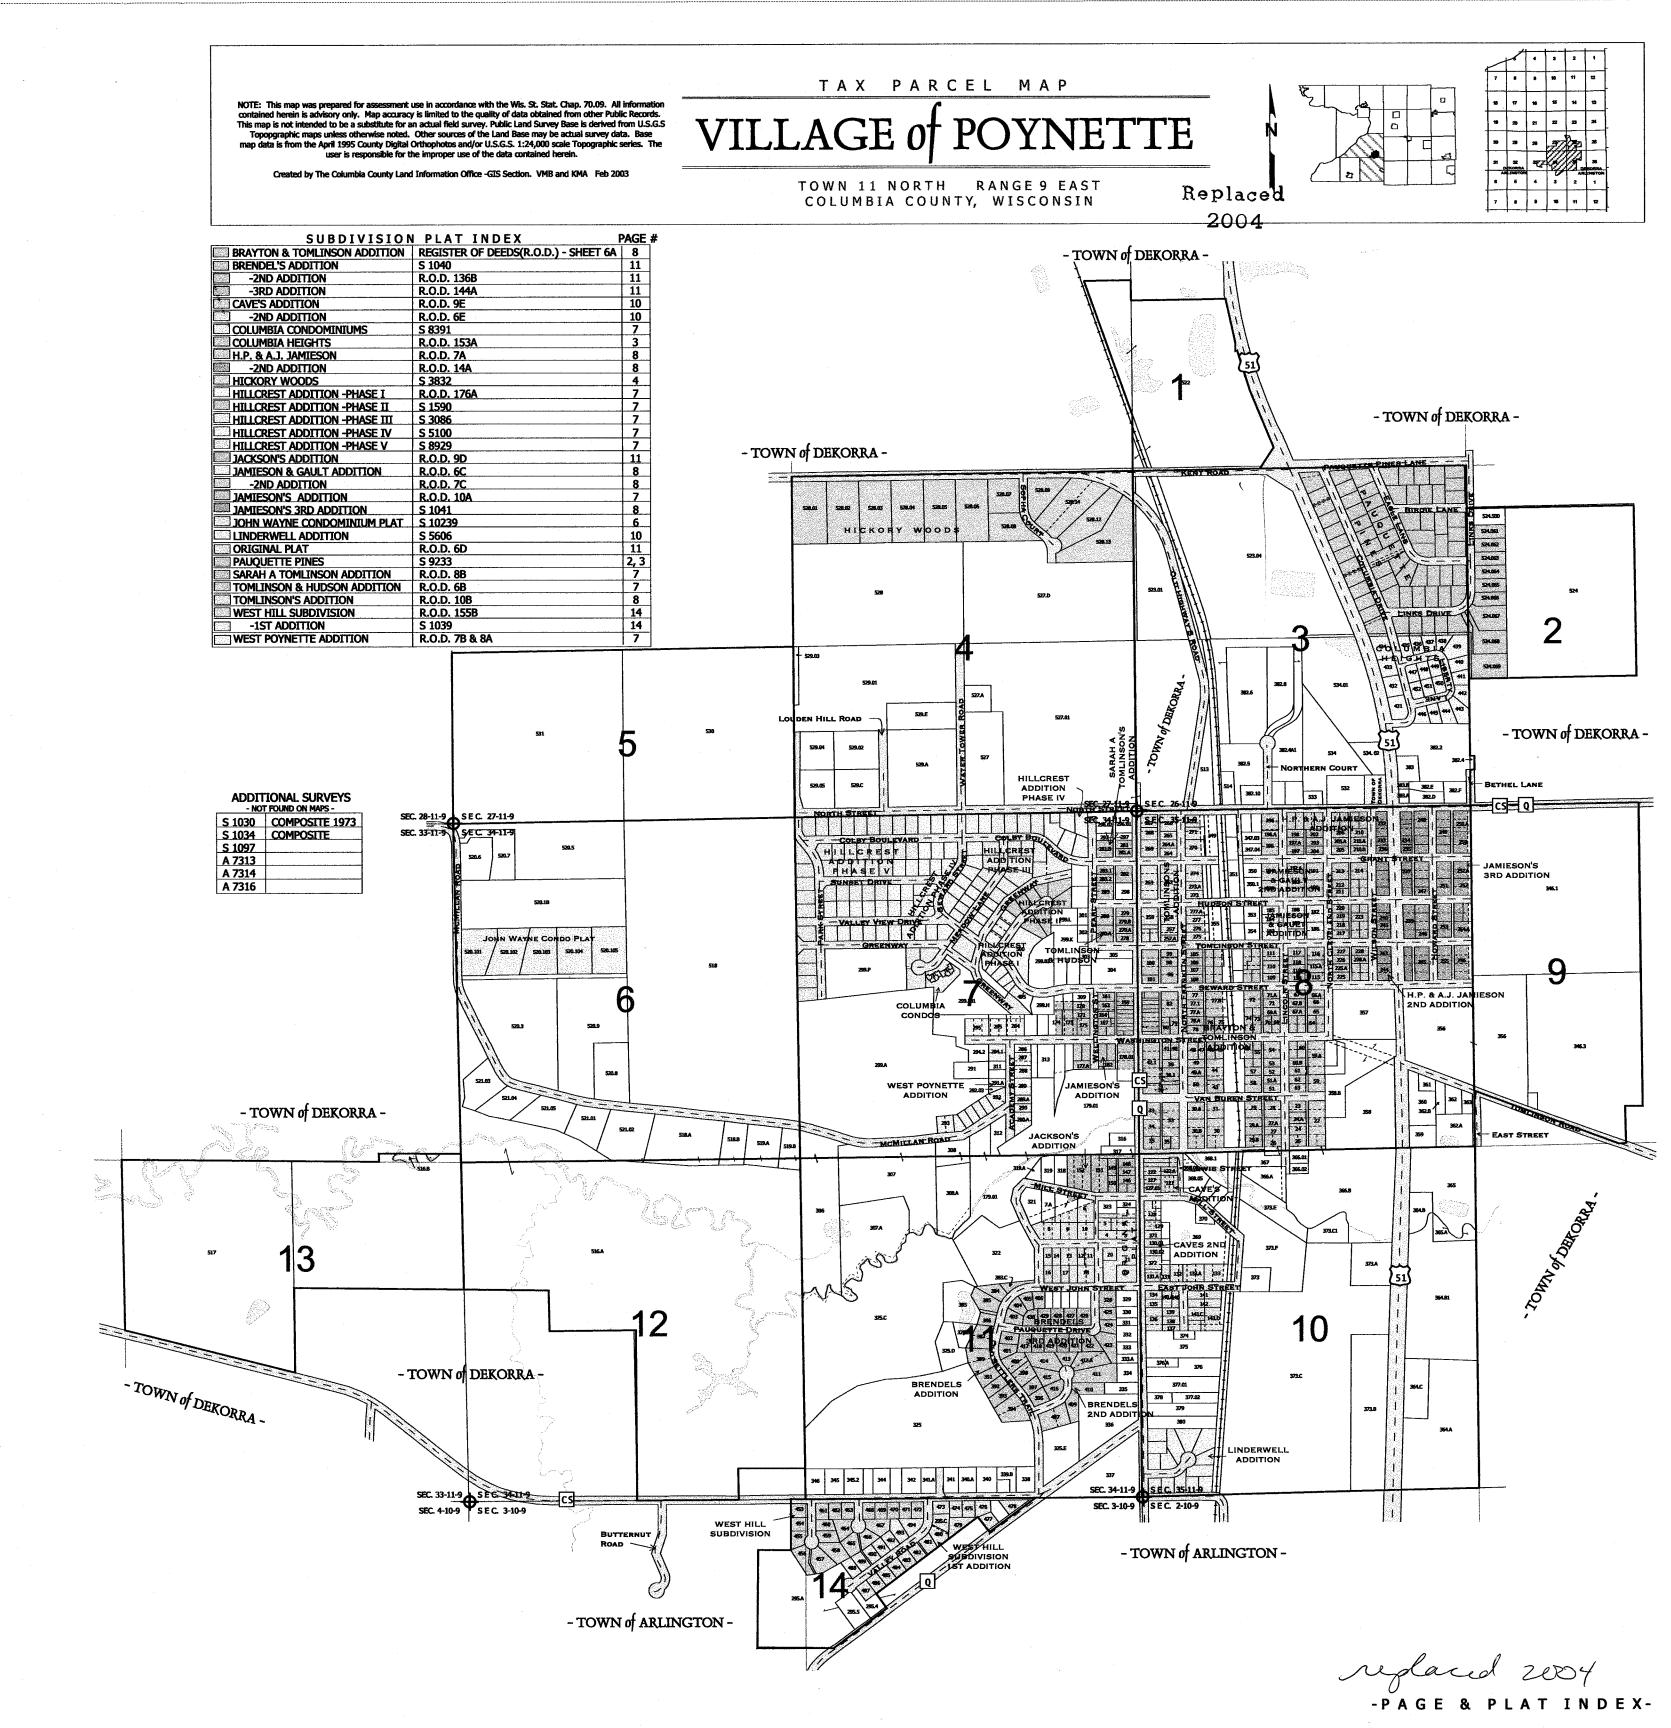

One Inch Equals Two Hundred Feet MILES TAX PARCEL MAP 1/16 s prepared for assessment use in accordance with the Wis. St. Stat. Chap. 70.09. All information of only. Map accuracy is limited to the quality of data obtained from other Public Records. ded to be a substitute for an actual field survey. Public Land Survey Base is derived from U.S.G.S or unless otherwise noted. Other sources of the Land Base may be actual survey data. Base April 1995 County Digital Orthophotos and/or U.S.G.S. 1:24,000 scale Topographic series. The TOWN 11 NORTH RANGE 9 EAST Replaced COLUMBIA COUNTY, WISCONSIN by The Columbia County Land Information Office -GIS Section. VMB and KMA Feb 2003 2004 -SEE PAGE 4-SEC. 27 N 1/4 CORNER ≪CTION 34 NORTH STREET SEC. 34 299.J1 296.01 296.02 299.049 S 1022 CS 1345 CS 2417 LOT 1 0.50 ac 299.055 ME 8942 299.054 299.053 299.039 299.038 299.040 299.037 299,050 299,095 934 ac 299.094 299.051 299,097 299.052 299.098 299.099 299.102 299.101 HILLCREST 299,048 ADDITION COLBY BOULE HAND PHASE ] 297 **→ 297** COLBY BOULEVARD 299.047 281 299.046 NE 8867 299.032 299.041 299.031 299.093 299.057 299.058 299.109 1297 sc 299,110 620 ± 299.056 NE 7391 299.106 299.107 299.108 299,103 •31≈ 299.104 020 ± 299.105 281.A 299.033 ADDIT 10 N 299,042 PE 7405 W. GRANT STREET 299.062 299.061 299.060 HILLCREST ADDITION 299.063 299.112 0.322 ac 299.114 632 x 299.111 0.322.ec 299.115 0.392 ac 299.117 0.351 ac

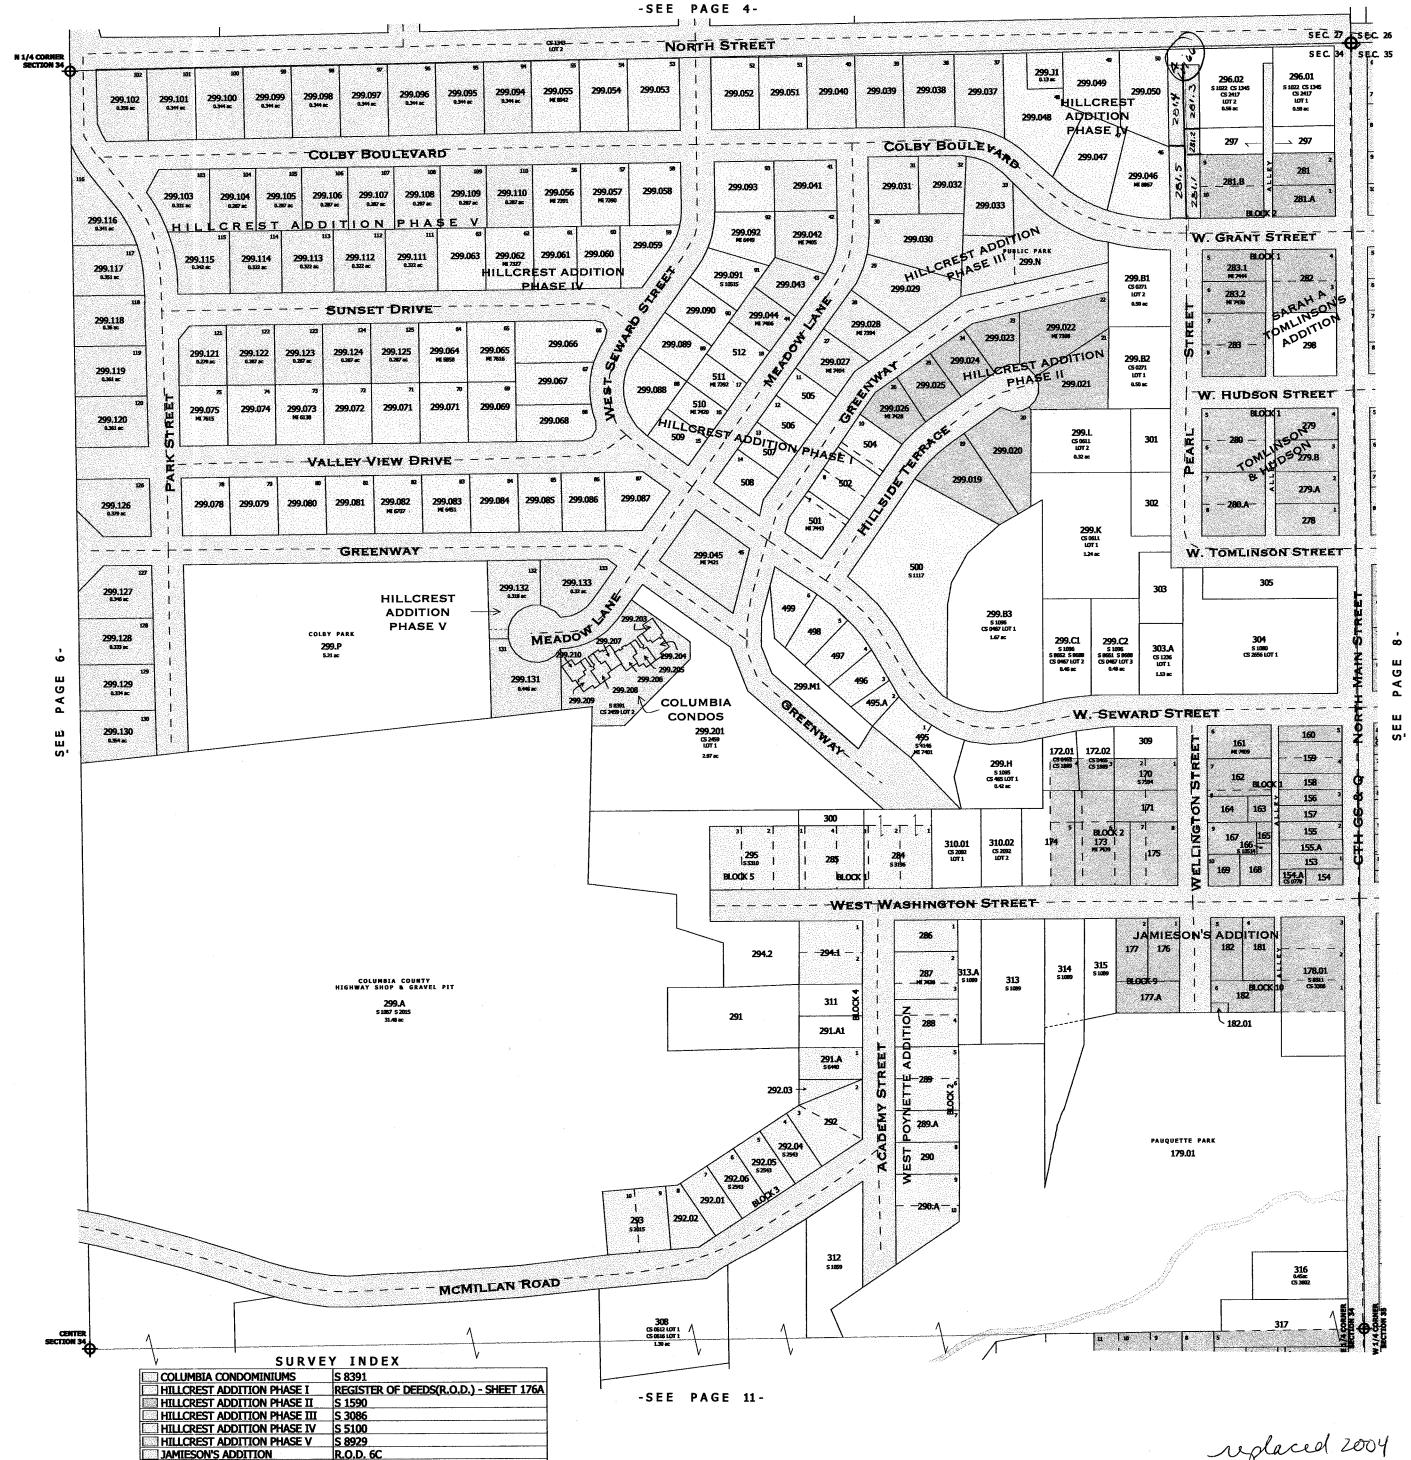

SARAH A TOMLINSON'S ADDITION R.O.D. 8B TOMLINSON & HUDSON ADDITION R.O.D. 6B

R.O.D. 7B & 8A

WEST POYNETTE ADDITION

One Inch Equals Two Hundred Feet MILES TAX PARCEL MAP NOTE: This map was prepared for assessment use in accordance with the Wis. St. Stat. Chap. 70.09. All information contained herein is advisory only. Map accuracy is limited to the quality of data obtained from other Public Records. This map is not intended to be a substitute for an actual field survey. Public Land Survey Base is derived from U.S.G.S. Topographic maps unless otherwise noted. Other sources of the Land Base may be actual survey data. Base map data is from the April 1995 County Digital Orthophotos and/or U.S.G.S. 1:24,000 scale Topographic series. The user is responsible for the improper use of the data contained herein. TOWN 11 NORTH RANGE 9 EAST COLUMBIA COUNTY, WISCONSIN Created by The Columbia County Land Information Office -GIS Section. VMB and KMA March 2002 Replaced 2004 -SEE PAGE 3-SEC 27 SEC 26. GTH ES & Q - - NORTH STREET - - - T N 1/4 CORNER 231.01 CS 285 1011 \_207\_ 347.01 cs 2266 LOT 1 347.02 cs 2266 LOT 2 **-- 209** 208 \_272\_ 199 199.A 201 348.01 cs 2284 iof 1 sitti 0.35 ac 196 HE 746 250.A V 7312 232 231.02 271 3 C\$ 2165 LOT 2 248.B 51041 349 S1111 202 210 249 265 198 206 ጛ 196.A 347.03 CS 2286 10T3 BLOCK 4 248.A1 51041 233 234 203 210.A 205.A 249.B 348.02 CS 2284 LOT 2 S 1111 0.36 ac 349.2 (51435 236 <sup>H</sup> 5292 235 HE 7436 248.A 51072 204 210.B 205 264 EAST GRANT STREET EAST GRANT STREET ADDITION Z O 238.B 192.A 350 cs 1067 1017 6 237 -51071 <del>-- 213</del> 274 351 (510%) STREET 352 BLOCK 5 BLOCK 4 262 263,⊅ 🎖 247.A 51011 192 2 ND 350.1 \$ 186 LST 2 273.A - 1**93** Z 238.A O 5586 211 ۱۵ 273 EAST HUDSON STREET STR 7 240.A 7 57005 221 51070 220 246.B 51041 222 185 351.A1 CS 1705 LOT 1 ME 7386 V 5646 277.A 254.B \_\_187 5 10009 353 v 5546 Ω 219 HOWAR 223 259.1 277 184 JAMIESON 355 BLOCK 6 L\_260-218 ou. 276 0.29± 5 10908 254.A - <del>Vau</del>- 5 1 351.A2 257 224 M 741 224.A G1725 SH -253-261.A a 261 217 V 5646 241.A 275 257.A BLOCK 1 :T EAST TOMLINSON STREET 227 228 112 104 103 CS 0850 TUT 1 353.B 112.A 226 228.A 118 106 242 -115.A 110 225.A 107 5963 119 230 229 PAGE 102.A 102 114 353.A 113 109 120 5 1090 115 225 EAST SEWARD STREET 71.A 77 72 BLOCK 77.B 4 66 NE 240 71 67.B 77.1 90.A 67.A 65 69.A 77.A 80.A 73 68.01 -9.877 78.A 68.02 9.897 64.A 64 69 <u>\_93</u>\_\_ 79 70. 80 CEMETERY 94 356 16.82x: \$ 1051 \$ 7378 BRAYTON & TOMLINSON ADDITION , VACATED WASHINGTON STREET \_ 46 L 358.A1 \_59\_A 51064 510516 53 60.B 42.1 358.A TOMLINGON ROAD -57 52 49.A 62 51.A 37 S9097 51 358.B VAN BUREN STREET 363 05 0135 107 1 0.53 ac 23 33 22 \_\_\_\_\_ 24 51103 EAST 30.B 359 WATER STREET SURVEY INDEX REGISTER OF DEEDS(R.O.D.) - SHEET 6A BRAYTON & TOMLINSON ADDITION replaced 2004 H.P. & A.J. JAMIESON ADDITION R.O.D. 7A R.O.D. 14A -SEE PAGE 10-H.P. & A.J. JAMIESON 2ND ADDITION JAMIESON'S 3RD ADDITION
JAMIESON AND GAULT ADDITION S 1041

R.O.D. 6C

R.O.D. 10B

JAMIESON AND GAULT 2ND ADDITION R.O.D. 7C

TOMLINSON'S ADDITION

One Inch Equals Two Hundred Feet

MILES

0 1/16 1/8

FEET

0 200 400 600 800


NOTE: This map was prepared for assessment use in accordance with the Wis. St. Stat. Chap. 70.09. All information contained herein is advisory only. Map accuracy is limited to the quality of data obtained from other Public Records. This map is not intended to be a substitute for an actual field survey. Public Land Survey Base is derived from U.S.G.S. Topopgraphic maps unless otherwise noted. Other sources of the Land Sees may be actual survey data. Base map data is from the April 1995 County Digital Orthophotos and/or U.S.G.S. 1:24,000 scale Topographic series. The user is responsible for the improper use of the data contained herein.

Created by The Columbia County Land Information Office -GIS Section. VMB and KMA. March 2002

VILLAGE of POYNETTE

TAX PARCEL MAP

TOWN 11 NORTH RANGE 9 EAST COLUMBIA COUNTY, WISCONSIN

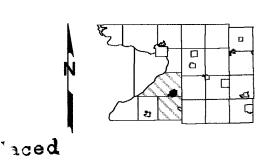

∠U0**4** 



One Inch Equals Two Hundred Feet MILES TAX PARCEL MAP 1/16 FEET NOTE: This map was prepared for assessment use in accordance with the Wis. St. Stat. Chap. 70.09. All information contained herein is advisory only. Map accuracy is limited to the quality of data obtained from other Public Records. This map is not intended to be a substitute for an actual field survey. Public land Survey Base is derived from U.S.G.S Topographic maps unless otherwise noted. Other sources of the Land Base may be acula survey data. Base map data is from the April 1995 County Digital Orthophotos and/or U.S.G.S. 1:24,000 scale Topographic series. The user is responsible for the improper use of the data contained herein. TOWN 11 NORTH RANGE 9 EAST COLUMBIA COUNTY, WISCONSIN Created by The Columbia County Land Information Office -GIS Section. VMB and KMA March 2002 2004 -SEE PAGE 7-JACKSON'S ADDITION 319 318 152 | 319.A BLOCK 1 MICL STREET 145 144 PAUQUETTE PARK 179.01 BLOCK 2 ORIGINAL PLAT STREET 12 11 15 BLOCK 3 17 16 16.01 17.A 19 WEST JOHN STREET 326 326.A 327 CS 1110 1071 329 S8813 328 \$1108 327.B 327.A SOUTH MAIN STREET PAGE 427 325.C © 0966 LOT 1 25.50 ac 331 BRENDEL'S SRD ADDITION **424** 53101 SEE PAUQUETTE DRIVE 325.B 332 420 HI 7402 421 422 5451 423 5 10309 417 325.D 8-0 333.A \$100 0.32 ac 414 335 HE 7386 - CEDAR CIRCL 336 \$1057 4.00 ac 325 21.69 ac Cth Ce & C 325.E 2.78 ≈: SETTLERS 339.B 51031 0.46 ac 338 344.1 CS 0602 LOT 2 342 340.A 341.A SEC. 34 SEC. 35

9999 - This number is used to represent tax parcels or a portion of a tax parcel that requires additional research to determine accurate boundaries and/or ownership.

-SEE PAGE 14-

SURVEY INDEX

BRENDEL'S ADDITION S 1040

BRENDEL'S 2ND ADDITION REGISTER OF DEEDS(R.O.D.) - SHEET 1368

BRENDEL'S 3RD ADDITION R.O.D. 144A

JACKSON'S ADDITION R.O.D. 9D

ORIGINAL PLAT R.O.D. 6D

replaced 2004 -PAGE 11-

- TOWN of ARLINGTON -


TAX PARCEL MAP NOTE: This map was prepared for assessment use in accordance with the Wis. St. Stat. Chap. 70.09. All information contained herein is advisory only. Map accuracy is limited to the quality of data obtained from other Public Records. This map is not intended to be a substitute for an actual field survey. Public Land Survey Base is derived from U.S.G.S. Topopgraphic maps unless otherwise noted. Other sources of the Land Base may be actual survey data. Base map data is from the April 1995 County Digital Orthophotos and/or U.S.G.S. 1:24,000 scale Topographic series. The user is responsible for the improper use of the data contained herein.

Created by The Columbia County Land Information Office -GIS Section. VMB and KMA Feb 2004

#### VILLAGE of POYNETTE

TOWN 11 NORTH RANGE 9 EAST COLUMBIA COUNTY, WISCONSIN

Replaced

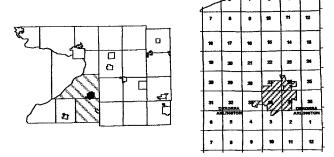

2005 SUBDIVISION PLAT INDEX PAGE #
BRAYTON & TOMLINSON ADDITION REGISTER OF DEEDS(R.O.D.) - SHEET 6A | 8 - TOWN of DEKORRA -BRENDEL'S ADDITION R.O.D. 136B -2ND ADDITION 11 10 R.O.D. 144A -3RD ADDITION CAVE'S ADDITION R.O.D. 9E 10 10 7 3 -2ND ADDITION R.O.D. 6E CAVE'S CONDOMINIUMS S 12049 COLUMBIA CONDOMINIUMS S 8391 COLUMBIA HEIGHTS R.O.D. 153A H.P. & A.J. JAMIESON R.O.D. 7A -2ND ADDITION

HICKORY WOODS

HILLCREST ADDITION -PHASE II

HILLCREST ADDITION -PHASE III

HILLCREST ADDITION -PHASE III R.O.D. 14A S 3832 R.O.D. 176A - TOWN of DEKORRA -S 1590 S 3086 HILLCREST ADDITION -PHASE IV S 5100 S 8929 HILLCREST ADDITION -PHASE V 11 8 8 7 JACKSON'S ADDITION R.O.D. 9D JAMIESON & GAULT ADDITION R.O.D. 6C -2ND ADDITION R.O.D. 70 JAMIESON'S ADDITION R.O.D. 10A 528.03 8 JAMIESON'S 3RD ADDITION S 1041 JOHN WAYNE CONDOMINIUM PLAT S 10239 6 LINDERWELL ADDITION
ORIGINAL PLAT 10 11 S 5606 R.O.D. 6D 2,3 7 7 8 14 14 7 S 9233 R.O.D. 8B PAUQUETTE PINES
SARAH A TOMLINSON ADDITION TOMLINSON & HUDSON ADDITION R.O.D. 6B TOMLINSON'S ADDITION R.O.D. 10B WEST HILL SUBDIVISION R.O.D. 155B -1ST ADDITION S 1039 R.O.D. 7B & 8A WEST POYNETTE ADDITION - TOWN of DEKORRA -527 HILLCREST ADDITION 529.C ADDITIONAL SURVEYS - NOT FOUND ON MAPS -SEC. 28-11-9 SEC. 27-11-9 SEC. 33-11-9 SEC. 34-11-9 S 1030 COMPOSITE 1973 S 1034 COMPOSITE S 1097 520.5 A 7313 3RD ADDITION A 7314 A 7316 JOHN WAYNE CONDO PLA 9 H.P. & A.J. JANIESON WEST POYNETTE 2015
ADDITION 302 361 JAMIESON'S - TOWN of DEKORRA -521.01 359 12 - TOWN of DEKORRA -SEC. 33-11-9 S E C. 3-10-9 SEC. 2-10-9 WEST HILL SUBDIVISION BUTTERNUT - TOWN of ARLINGTON -- TOWN of ARLINGTON -

MILES 1/16 FEET as prepared for assessment use in accordance with the Wis. St. Stat. Chap. 70.09. All information advisory only. Map accuracy is limited to the quality of data obtained from other Public Records. ended to be a substitute for an actual field survey. Public Land Survey Base is derived from U.S.G.S. saps unless otherwise noted. Other sources of the Land Base may be actual survey data. Base he April 1995 County Digital Orthophotos and/or U.S.G.S. 1:24,000 scale Topographic series. The user is responsible for the improper use of the data contained herein. The Columbia County Land Information Office -GIS Section. VMB and KMA Feb 2003


TOWN 11 NORTH RANGE 9 EAST COLUMBIA COUNTY, WISCONSIN

TAX PARCEL MAP

VILLAGE of POYNET

Replaced

2005

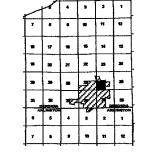



One Inch Equals Two Hundred Feet

MILES

0 1/16 1/8

FEET

0 200 400 600 800


NOTE: This map was prepared for assessment use in accordance with the Wis. St. Stat. Chap. 70.09. All information contained herein is advisory only. Map accuracy is limited to the quality of data obtained from other Public Records. This map is not intended to be a substitute for an actual field survey. Public Land Survey Base is derived from U.S.G.S. Topographic maps unless otherwise noted. Other sources of the Land Base may be actual survey data. Base map data is from the April 1995 County Digital Orthophotos and/or U.S.G.S. 1:24,000 scale Topographic series. The user is responsible for the improper use of the data contained herein.

Created by The Columbia County Land Information Office -GIS Section. VMB and KMA May 2001

VILLAGE of POYNETTE


TOWN 11 NORTH RANGE 9 EAST COLUMBIA COUNTY, WISCONSIN

ed

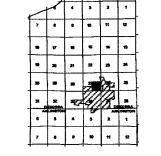

Ke

Replaced 2005

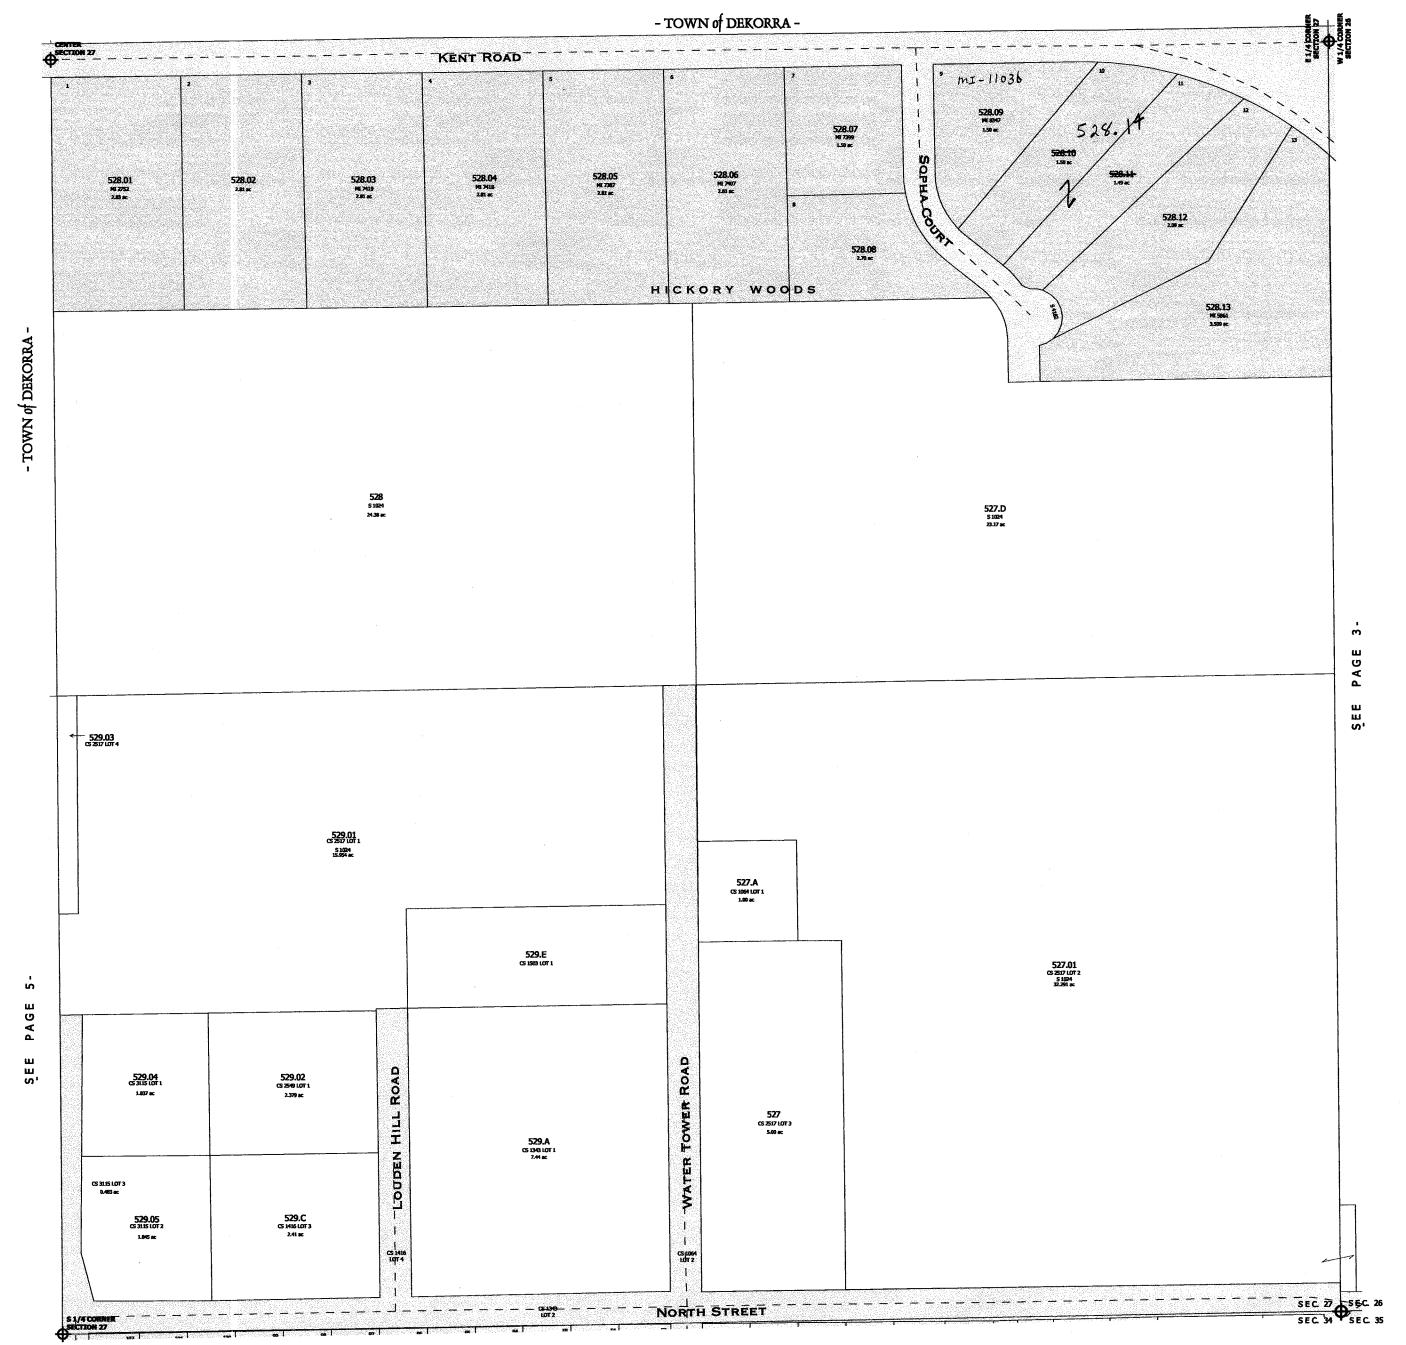

One Inch Equals Two Hundred Fee MILES TAX PARCEL MAP 1/16 FEET map was prepared for assessment use in accordance with the Wis. St. Stat. Chap. 70.09. All information erein is advisory only. Map accuracy is limited to the quality of data obtained from other Public Records. to intended to be a substitute for an actual field survey. Public Land Survey Base is derived from U.S.G.S phic maps unless otherwise noted. Other sources of the Land Base may be actual survey data. Base from the April 1995 County Digital Orthophotos and/or U.S.G.S. 1:24,000 scale Topographic series. The user is responsible for the improper use of the data contained herein. Replaced TOWN 11 NORTH RANGE 9 EAST COLUMBIA COUNTY, WISCONSIN 2005 -SEE PAGE 4-SEC. 27 SEC. 26 NORTH STREET N 1/4 CORNER SECTION 34 299.J1 0.13 ac 296.02 \$ 1022 CS 1345 CS 2417 LOT 2 8.56 ac 296.01 299.053 S 1022 CS 1345 CS 2417 LOT 1 0.50 ac 299.095 834 sc 299.094 0341 kc 299.055 ME 8942 299.054 299.051 299.040 299.039 299.038 299.037 299.096 ₀34 κ 299.052 299.050 299,098 \*\*\*\*\*\* 299.100 299.097 ω++ 299.101 299.102 HILLCREST ADDITION COLBY BOULE HA PHASE 297 × 297 COLBY BOULEVARD 299,047 281 299.046 NE 8657 299.032 299,041 299.031 299.093 299.056 MI 7391 299.057 MI 7390 299.058 299.108 299.107 299.103 €331 æ 299.104 €287 ac 299.105 €207 ±: 299.106 8.207 ac 0.287 ac 0.267 ac 299.033 299.116 •341 ± HILL CREST ADDITION ADDITION 299.092 N 649 299,042 NE 7405 TW. GRANT STREET CREST AUDITURE PARK 299.059 299.060 299.062 299.061 299.060 HILLCREST ADDITION 299.111 8322× 299.114 1322 ac 299.113 6322 sc 299.112 0322≈ 299.063 299.115 299.117 0351 sc 299.043 PHASE IV 299.029 SUNSET DRIVE 299.090 299,044 HI 7406 299.118 299.028 Ht 7394 299.023 299.066 299.065 M 7616 HILLEREST ADDITION 299,121 029≠ 299.122 420 sc 299.123 0.20 ≈ 299.124 299.125 0.287 ac 299.064 M 5858 299.027 Ht 789 299,024 299,119 0.361 ×: PHASE II 299.067 299.088 W. HUDSON STREET 299.071 299.075 M 7615 299.073 # 6138 299.071 299.069 299.074 299.072 299.120 0361 sc 299.068 HILLOREST ADDITION PHASE 301 05° 279.8 504 299.020 -VALLEY-VIEW BRIVE 279.A 299.087 299.085 299.086 299.082 299.083 ME 6451 299.084 299.078 299.079 299.080 299.081 299.126 4379 ac 302 278 GREENWAY W. TOMLINSON STREET 500 51117 299.133 132\*\* / 299.132 0378 ac MEADOW 299.20 299.127 303 HILLCREST ADDITION PHASE V COLBY PARK 299.128 299.C1 299.C2 \$ 1096 \$ 8661. \$ 8688 C\$ 0467 LOT 3 0.46 ac 304 \$ 1080 CS 2656 LOT 1 299.P 5.21 ac PAGE PAGE 299.131 496 299.129 Creennar. COLUMBIA \_W. SEWARD STREET CONDOS ш 299.130 0.354 ac 299.201 CS 2469 LOT 1 SEE 160 172.01 172.02 ELLINGTON STRE 299.H \$ 1095 CS 465 LOT 1 0.42 ac C5 1889 CS 0465 170 5794 162 158 156 171 164 157 BLOCK 2 173 173 155 310.01 CS 2092 LOT 1 310.02 cs 2092 LOT 2 174 155.A 175 295 153 168 169 BLOCK 5 BLOCK I -WEST-WASHINGTON STREET JAMIESON'S ADDITION 181 182 177 | 176 **294.2** S 5310 315 182 BLOCK 10 COLUMBIA COUNTY HIGHWAY SHOP & GRAVEL PIT 313 s 1089 BLOCK 9 177.A 311 291.A1 511787 291.A 5640 292.03 PAUQUETTE PARK 179.01 293 5205 312 s 1059 MCMILLAN ROAD

-SEE PAGE 11-

SURVEY INDEX

S 8391

S 1590

R.O.D. 6C

R.O.D. 7B & 8A

REGISTER OF DEEDS(R.O.D.) - SHEET 176A

COLUMBIA CONDOMINIUMS

**HILLCREST ADDITION PHASE I** 


HILLCREST ADDITION PHASE III S 3086 HILLCREST ADDITION PHASE IV S 5100 HILLCREST ADDITION PHASE V JAMIESON'S ADDITION

SARAH A TOMLINSON'S ADDITION R.O.D. 8B TOMLINSON & HUDSON ADDITION R.O.D. 6B

HILLCREST ADDITION PHASE II

WEST POYNETTE ADDITION

One Inch Equals Two Hundred Feet TAX PARCEL MAP MILES s map was prepared for assessment use in accordance with the Wis. St. Stat. Chap. 70.09. All information inverse in its advisory only. Map accuracy is limited to the quality of data obtained from other Public Records. not intended to be a substitute for an actual field survey. Public Land Survey Base is derived from U.S.G.S aphic maps unless otherwise noted. Other sources of the Land Base may be actual survey data. Base is from the April 1995 County Digital Orthophotos and/or U.S.G.S. 1:24,000 scale Topographic series. The user is responsible for the improper use of the data contained herein. TOWN 11 NORTH RANGE 9 EAST Replaced COLUMBIA COUNTY, WISCONSIN Created by The Columbia County Land Information Office -GIS Section. VMB and KMA Feb 2004 200**5** -SEE PAGE 3--CIH ES & Q - - NORTH STREET SEC 27 SEC 26 SEC 34 SEC 35 231.01 65.286 1571 250 A g 200 207 207.A - 209 347.01 cs 2286 lot 1 347.02 cs 2286 1072 201 196 16745 267\_ \_272\_ 348.01 CS 2284 1071 S 1111 0.35 ac 232 4 248.8 5100 T271 ☐3 202 206 210 198

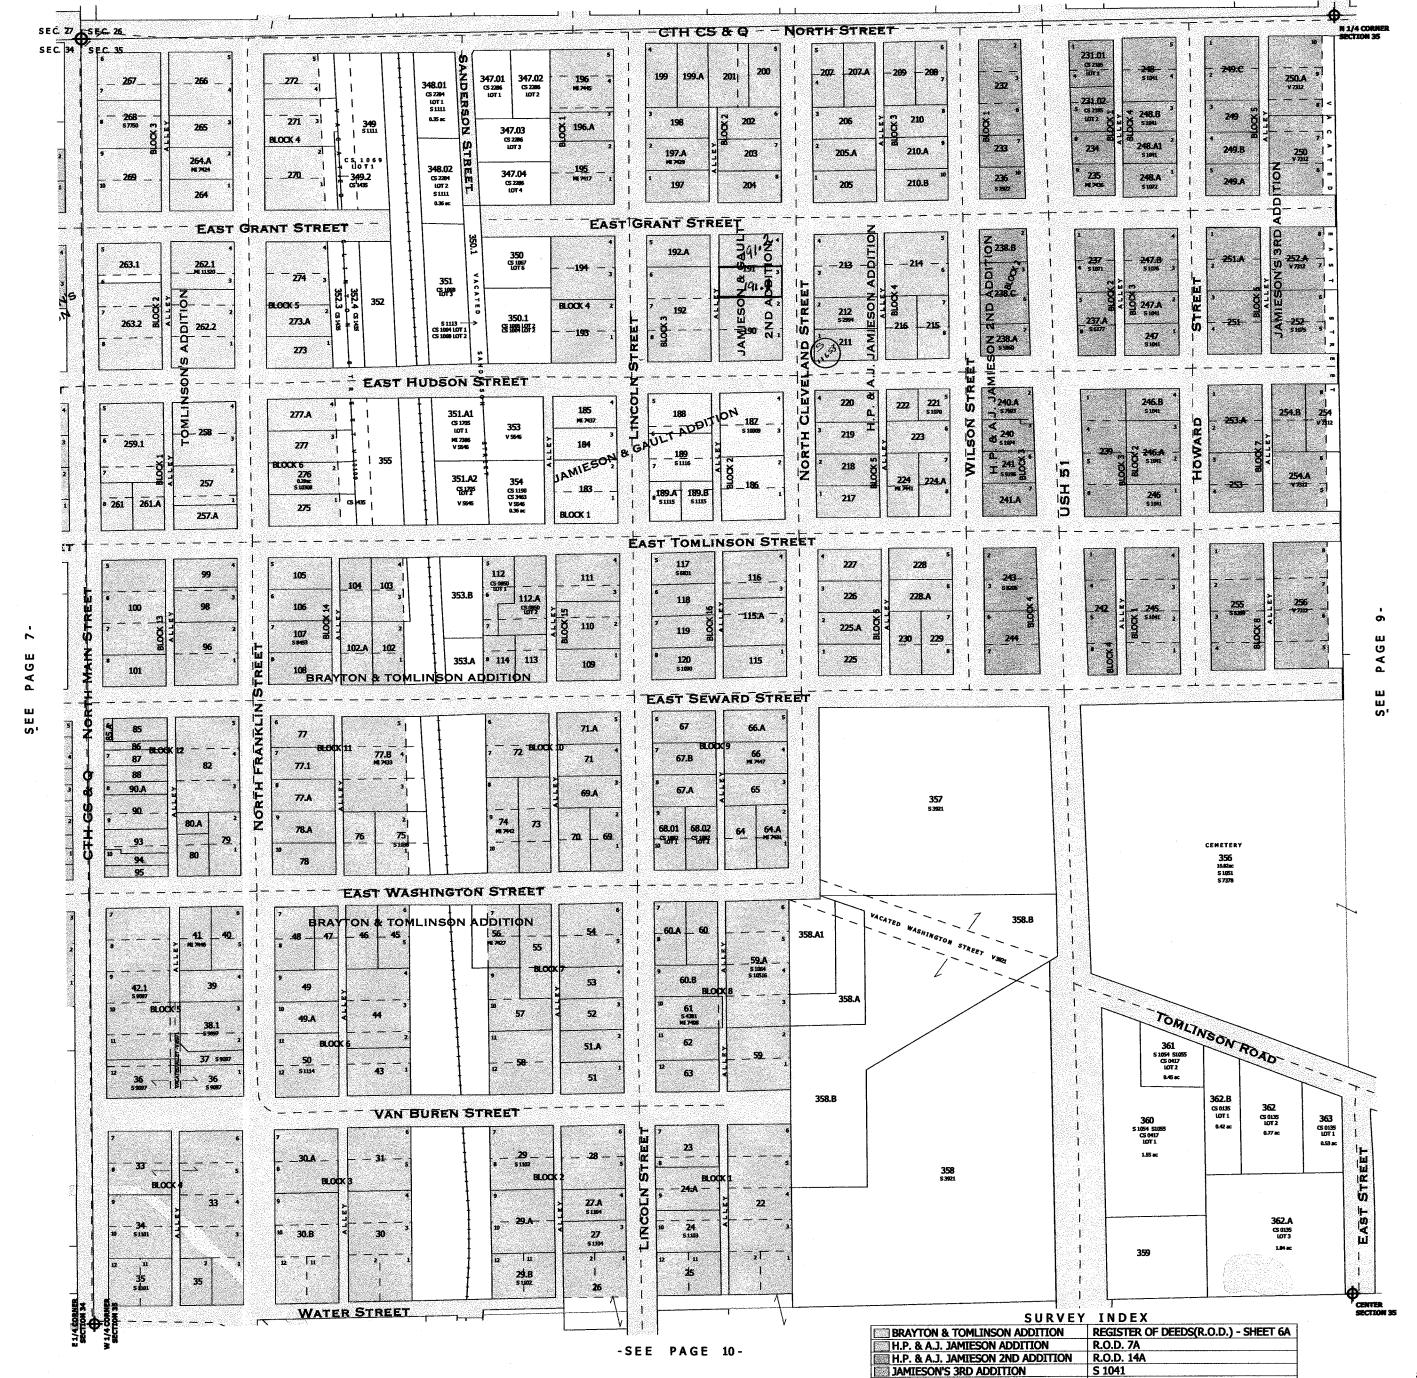

JAMIESON AND GAULT ADDITION

TOMLINSON'S ADDITION

JAMIESON AND GAULT 2ND ADDITION R.O.D. 7C

R.O.D. 6C

R.O.D. 10B

-PAGE 8-

One Inch Equals Two Hundred Feet

MILES

1/16

1/16

0 20

0 60


90

ON Enter Inside the pass prepared for assessment use in accordance with the Ws. St. Stat. Chap. 70.09. All information of contained herein is solvieury only. Map accuracy is limited to the quality of data challend from other Public Records. Tripopagaritic maps unless otherwise noted. Other accuracy is limited to the quality of data challend from the Public Records. Tripopagaritic maps unless otherwise noted. Other accuracy is limited to the quality of data challend from other Public Records. Tripopagaritic maps unless otherwise noted. Other accuracy is limited to the quality of data challend from other Public Records. Tripopagaritic maps unless otherwise noted. Other accuracy is limited to the quality of data challend survey. Public Land Survey State is from the July State County Digital Orthophous analyst U.S.G.S. 174,000 scale Tripopagaritic maps unless deliveration to ma actual field survey. Public Land Survey State is from the July State County Digital Orthophous analyst U.S.G.S. 174,000 scale Tripopagaritic maps unless colleveration from the County Land Information Office-GIS Section. VMB and VMA Feb 2004

VILLAGE of POYNETTE

TOWN 11 NORTH RANGE 9 EAST
COLUMBIA COUNTY, WISCONSIN
Replaced

7 Overled by The Columbia County Land Information Office-GIS Section. VMB and VMA Feb 2004

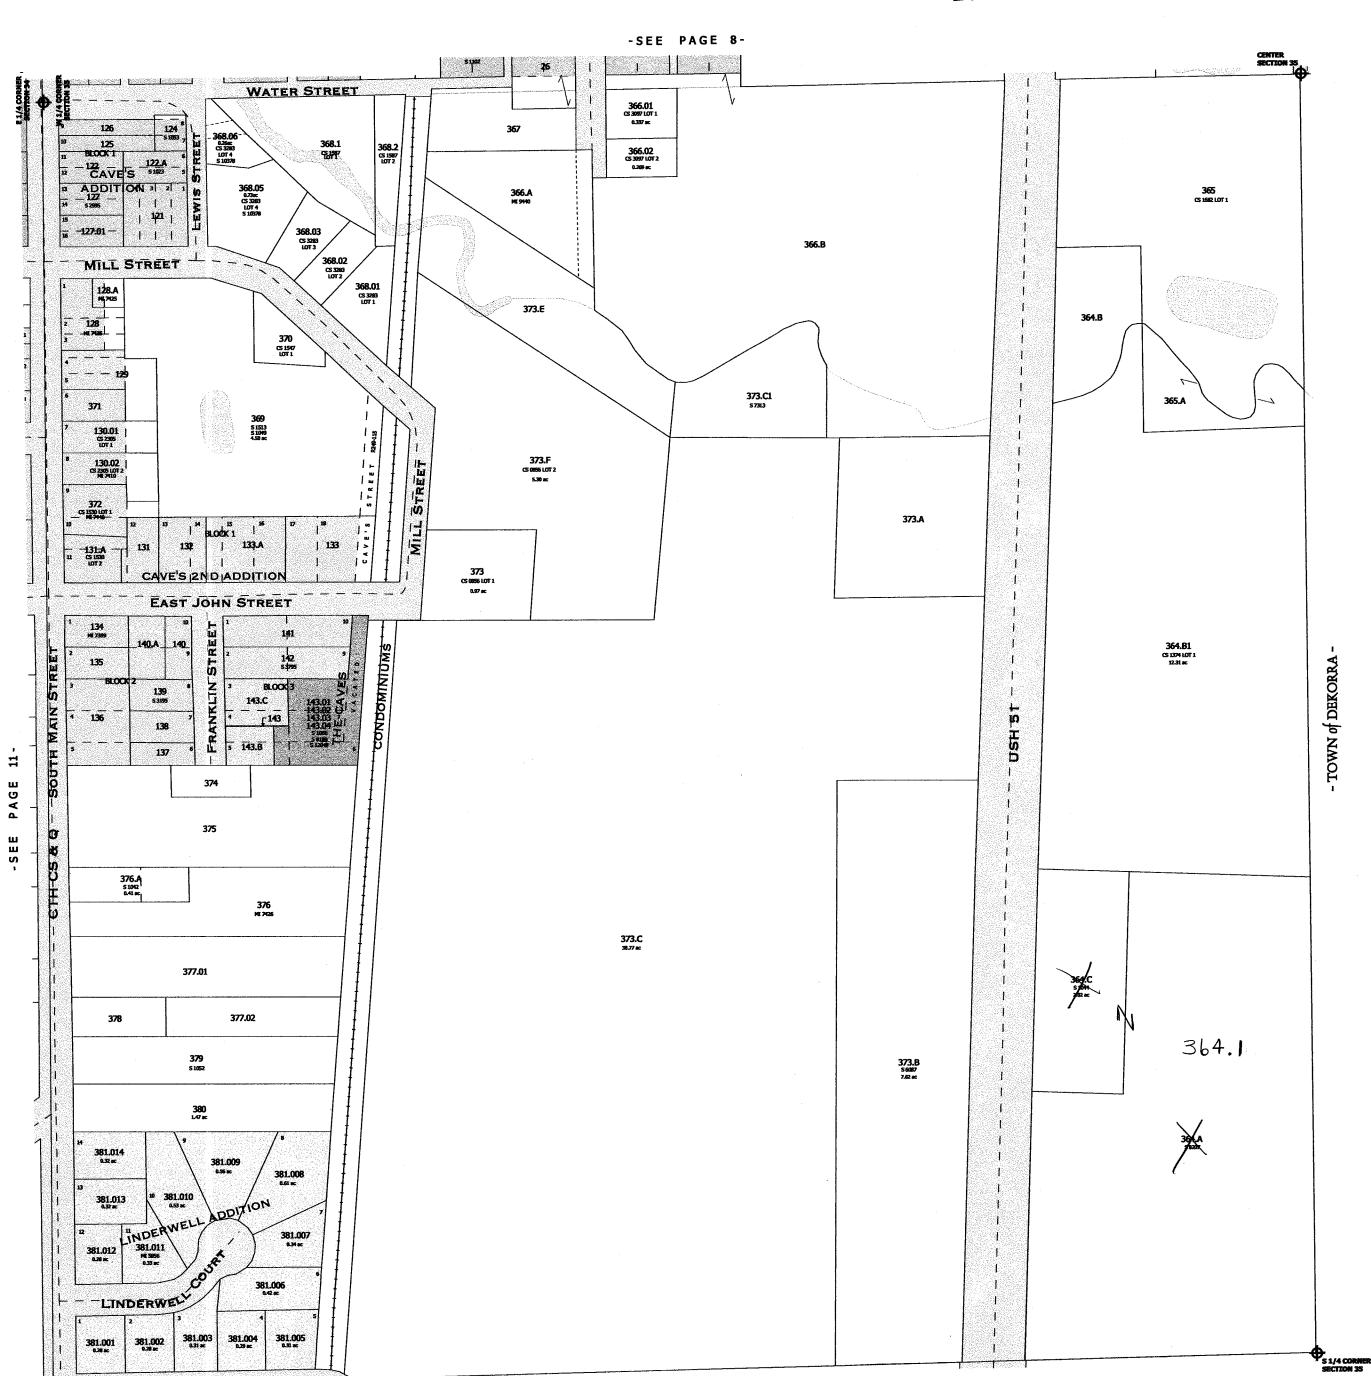

- TOWN of DEKORRA -

LOVELAND ROAD



9999 - This number is used to represent tax parcels or a portion of a tax parcel that requires additional research to determine accurate boundaries and/or ownership.

-SEE PAGE 14-

SURVEY INDEX

BRENDEL'S ADDITION S 1040

BRENDEL'S 2ND ADDITION REGISTER OF DEEDS(R.O.D.) - SHEET 136B

BRENDEL'S 3RD ADDITION R.O.D. 144A

JACKSON'S ADDITION R.O.D. 9D

ORIGINAL PLAT R.O.D. 6D

-PAGE 11

- TOWN of ARLINGTON -

TAX PARCEL MAP NOTE: This map was prepared for assessment use in accordance with the Wis. St. Stat. Chap. 70.09. All information contained herein is advisory only. Map accuracy is limited to the quality of data obtained from other Public Records. This map is not intended to be a substitute for an actual field survey. Public Land Survey Base is derived from U.S.G.S Topopgraphic maps unless otherwise noted. Other sources of the Land Base may be actual survey data. Base map data is from the April 1995 County Digital Orthophotos and/or U.S.G.S. 1:24,000 scale Topographic series. The user is responsible for the improper use of the data contained herein. VILLAGE of POYNET Created by The Columbia County Land Information Office -GIS Section. VMB and KMA Feb 2005 TOWN 11 NORTH RANGE 9 EAST Replaced COLUMBIA COUNTY, WISCONSIN 2006 SUBDIVISION PLAT INDEX PAGE # - TOWN of DEKORRA --3RD ADDITION 11 10 R.O.D. 144A CAVE'S ADDITION R.O.D. 9E -2ND ADDITION R.O.D. 6E 10 CAVE'S CONDOMINIUMS S 12049 10 COLUMBIA CONDOMINIUMS S 8391 COLUMBIA HEIGHTS R.O.D. 153A R.O.D. 7A R.O.D. 14A H.P. & A.J. JAMIESON -2ND ADDITION
HICKORY WOODS S 3832 R.O.D. 176A HILLCREST ADDITION -PHASE I 7 HILLCREST ADDITION -PHASE II S 1590 - TOWN of DEKORRA -HILLCREST ADDITION -PHASE III S 3086 HILLCREST ADDITION -PHASE IV S 5100 HILLCREST ADDITION -PHASE V S 8929 JACKSON'S ADDITION R.O.D. 9D JAMIESON & GAULT ADDITION R.O.D. 6C 8 -2ND ADDITION R.O.D. 7C 8 JAMIESON'S ADDITION R.O.D. 10A 7 8 6 10 11 2,3 7 7 8 14 JAMIESON'S 3RD ADDITION S 1041 JOHN WAYNE CONDOMINIUM PLAT | S 10239 LINDERWELL ADDITION
ORIGINAL PLAT S 5606 R.O.D. 6D PAUQUETTE PINES
SARAH A TOMLINSON ADDITION S 9233 R.O.D. 8B TOMLINSON & HUDSON ADDITION R.O.D. 6B TOMLINSON'S ADDITION R.O.D. 10B WEST HILL SUBDIVISION R.O.D. 155B 14 R.O.D. 7B & 8A WEST POYNETTE ADDITION 7 529.E - TOWN of DEKORRA -HILLCREST ADDITION PHASE IV ADDITIONAL SURVEYS - NOT FOUND ON MAPS -SEC. 28-11-9 SEC. 27-11-9
SEC. 33-11-9 SEC. 34-11-9 S 1030 COMPOSITE 1973 S 1034 COMPOSITE S 1097 520.6 A 7313 **3RD ADDITION** A 7316 JOHN WAYNE CONDO PLA 520.103 Q H.P. & A.J. JANIESON JAMIESON'S NOITIDDA - TOWN of DEKORRA -521.01 JACKSON'S 139 318 129 351 10 107 MILE STREET 10 12 BRENDELS ADDITION TOWN of DEKORRA -373.8 LINDERWELL ADDITION SEC. 33-11-9 SEC. 34-11-2 CS SEC. 4-10-9 SEC. 3-10-9 SEC. 2-10-9 WEST HILL BUTTERNUT - TOWN of ARLINGTON -- TOWN of ARLINGTON -

-PAGE & PLAT INDEX

One Inch Equals Two Hundred Feet

MILES

0 1/16 1/8

FEET

0 200 400 600 800

NOTE: This map was prepared for assessment use in accordance with the Wis. St. Stat. Chap. 70.09. All information contained herein is advisory only. Map accuracy is limited to the quality of data obtained from other Public Records.

This map is not intended to be a calculation of the public Records.

NOTE: This map was prepared for assessment use in accordance with the Wis. St. Stat. Chap. 70.09. All information contained herein is advisory only. Map accuracy is limited to the quality of data obtained from other Public Records. This map is not intended to be a substitute for an actual field survey. Public Land Survey Base is derived from U.S.G.S Topographic maps unless otherwise noted. Other sources of the Land Base may be actual survey data. Base map data is from the April 1995 County Digital Orthophotos and/or U.S.G.S. 1:24,000 scale Topographic series. The user is responsible for the improper use of the data contained herein.


Created by The Columbia County Land Information Office -GIS Section. VMB and KMA May 2001

TAX PARCEL MAP


#### VILLAGE of POYNETTE


TOWN 11 NORTH RANGE 9 EAST COLUMBIA COUNTY, WISCONSIN

SEC. 21 SEC. 23 SEC. 27 SEC. 26 Replaced

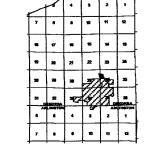

2006

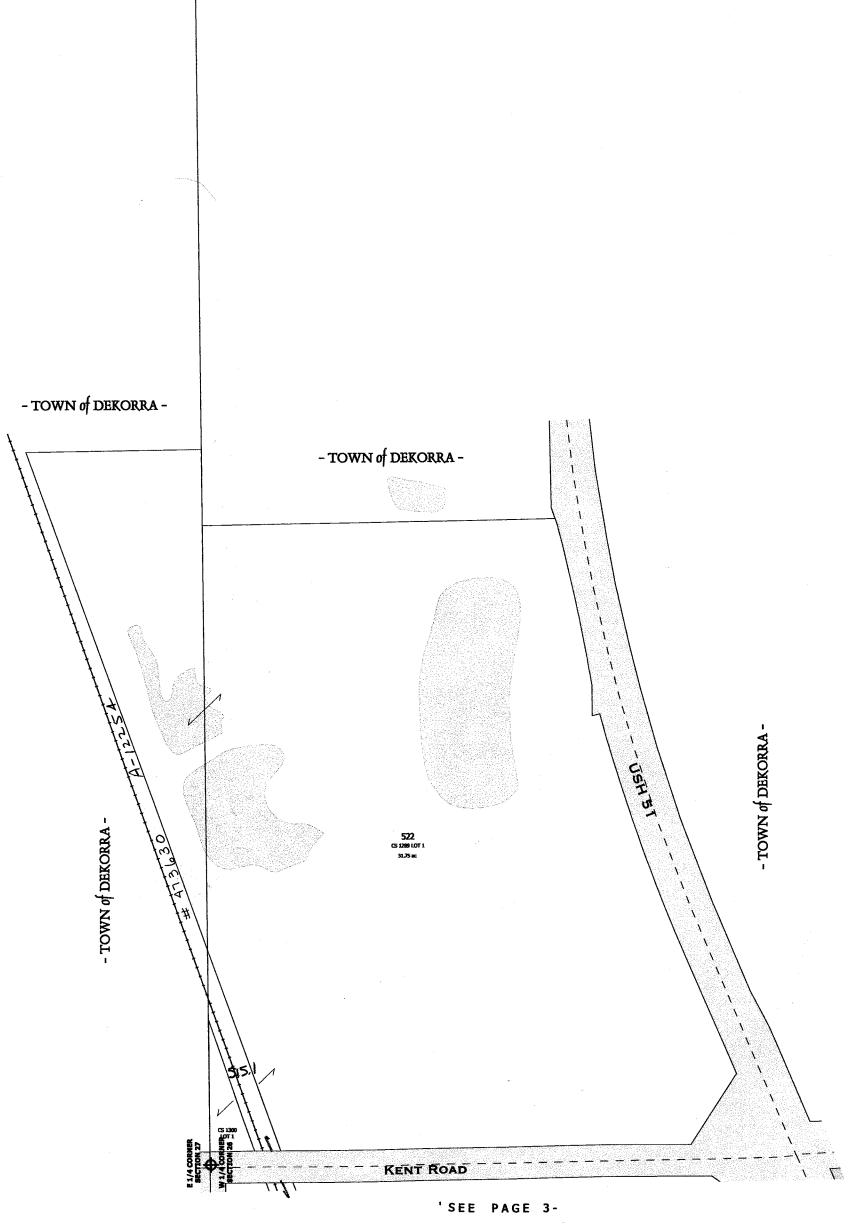

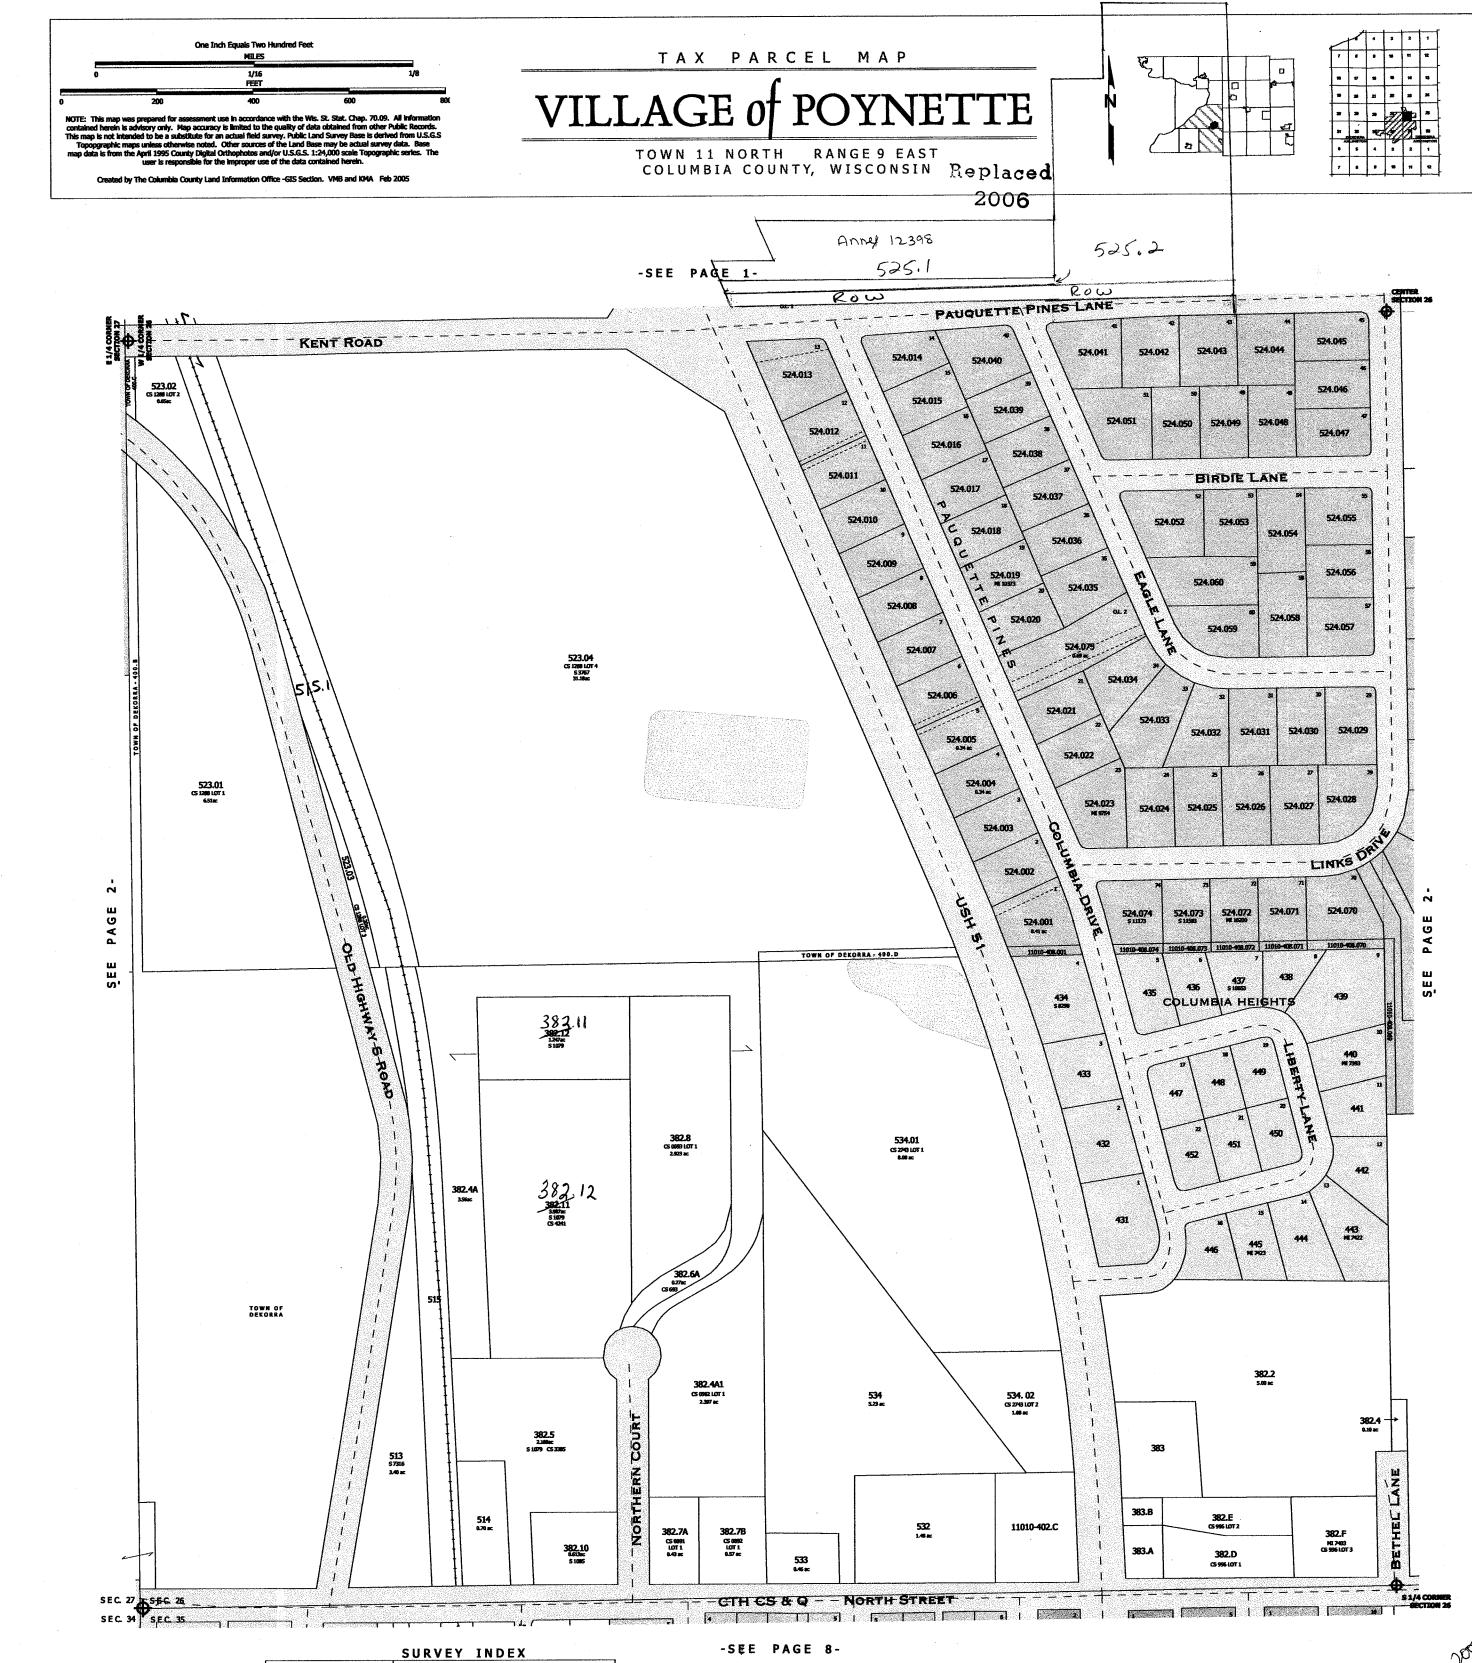

One Inch Equals Two Hundred Feet

MILES

0 1/16 1/8

FEET

0 200 400 600 800

NOTE: This map was prepared for assessment use in accordance with the Wiss St. Stat. Chap. 70.09. All information contained herein is advisory only. Map accuracy is limited to the quality of duotained from other Public Records. This map is not intended to be a substitute for an actual field survey. Public Land Survey Base is derived from U.S.G.S. Topoppraphic maps unless otherwise noted. Other sources of the Land Base may be actual survey data. Base map data is from the April 1995 County Digital Orthophotos and/or U.S.G.S. 1:24,000 scale Topographic series. The user is responsible for the improper use of the data contained herein.


VILLAGE of POYNETTE

TAX PARCEL MAP

TOWN 11 NORTH RANGE 9 EAST COLUMBIA COUNTY, WISCONSIN

Replaced

2006

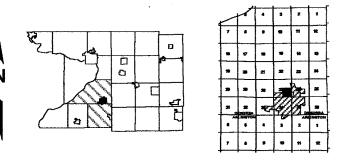




One Inch Equals Two Hundred Feet MILES 1/16 FEET NOTE: This map was prepared for assessment use in accordance with the Wis. St. Stat. Chap. 70.09. All information contained herein is advisory only. Map accuracy is limited to the quality of data obtained from other Public Records. This map is not intended to be a substitute for an actual field survey. Public Land Survey Base is derived from U.S.G.S. Topographic maps unless otherwise noted. Other sources of the Land Base may be actual survey data. Base map data is from the April 1995 County Digital Orthophotos and/or U.S.G.S. 1:24,000 scale Topographic series. The user is responsible for the improper use of the data contained herein. Created by The Columbia County Land Information Office -GIS Section. VMB and KMA  $\,$  Feb 2003  $\,$ 

TAX PARCEL MAP

### VILLAGE of POYNE

TOWN 11 NORTH RANGE 9 EAST COLUMBIA COUNTY, WISCONSIN

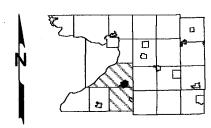

2006

Peplaced



One Inch Equals Two Hundred Feet TAX PARCEL MAP MILES 1/16 This map was prepared for assessment use in accordance with the Wis. St. Stat. Chap. 70.09. All information inted herein is advisory only. Map accuracy is limited to the quality of data obtained from other Public Records. map is not intended to be a substitute for an actual field survey. Public Land Survey Base is derived from U.S.G.S popgraphic maps unless otherwise noted. Other sources of the Land Base may be actual survey data. Base data is from the April 1995 County Digital Orthophotos and/or U.S.G.S. 1:24,000 scale Topographic series. The user is responsible for the Improper use of the data contained herein. TOWN 11 NORTH RANGE 9 EAST Replaced COLUMBIA COUNTY, WISCONSIN ted by The Columbia County Land Information Office -GIS Section. VMB and KMA Feb 2005 2006 -SEE PAGE 4-SEC. 27 SEC. 26 NORTH STREET \_S E.C. 34 S E.C. 35 N 1/4 CO 299.J1 296.01 295.02 3102 (\$136 (\$240 1012 155ac 299.049 (100) CS 1945 CS 2417 107 1 8.58 ac 299.054 299.053 299.038 299.037 299.055 299.040 299.094 1341 sc 299.051 299.096 □34 × 299,095 a3+1≠c 299.052 299.098 6344 ac 299.097 299.100 ™≈ "HILLCREST 299.101 299.102 MOITION 299.048 PHASE ) COLBY BOULE 14 297 🧠 .... 297 COLBY BOULEVARD 299.047 281 299.032 299,041 299.031 299.093 299,057 HK 7390 299.058 299.109 6267 sc 299,110 1297 tc 299.056 NE 7391 299.104 €287 ±c 299,106 299.103 038 ac 299.105 1207≈ 281.A 299.033 0.267 ac HILL CREST ADDITION ADDITION 299.092 HE 649 299.042 #1746 W. GRANT STREET REST AV JUBLIC PARK 299.059 299.062 299.061 299.060 HILLCREST ADDITION 299.061 299.112 6322 sc 299.063 299.113 9322 æ 299.111 0322≠ 299.114 632 x 299.115 299.091 5 10515 299.B1 CS 0271 LOT 2 0.50 ac 299.043 PHASEIV 299.029 283.2 H 750 SUNSET DRIVE 299.090 299,044 HI 7406 299.118 836 sc 299.028 HI 7394 299.022 ME7388 299.023 299.066 HILLEREST ADDITION 299.065 M 7616 299.064 299.121 0.29 ac 299,122 0207 sc 299.123 0.37 sc 299.124 \*\*\*\*\* 299.125 299.B2 CS 0271 LOT 1 0.50 ac 299.024 PHASE 11 299.021 299.119 299.067 299.025 299.088 W. HUDSON STREET 299.071 299.071 299.069 299.073 M 6138 299.075 ME 7615 299,074 299.072 HILLOREST ADDITION PHASE 299.068 299.120 €361 ± 301 1 5 279.B -VALLEY-VIEW DRIVE-279.A 299,085 299.086 299.087 299.082 M 6787 299.084 302 299.081 299.083 299.079 299.080 299.078 501 M 243 278 W. TOMLINSON STREET GREENWAY 500 51117 299.133 •∞× 305 299.132 638 sc MEADOW 18 200 -303 299.127 HILLCREST **ADDITION** PHASE V COLBY PARK 299.C1 5 1096 5 8662 5 8668 CS 0467 LOT 2 0.46 ac 299.128 299.C2 \$1996 \$8661 \$8688 C\$ 0467 LOT 3 0.48 ac 299.P 521 ac 299.131 046± 496 299.129 1391 =: PAG COLUMBIA \_W. SEWARD STREET CONDOS 299,201 CS 2469 LOT 1 2.97 ac 299.130 6354 to 160 172.02 172.01 299.H \$1095 CS 465 LOT 1 0.42 at CS 1889.3 170 5754 158 156 ELLINGTON 1971 164 163 157 155 BLOCK 173 | 167439 | 310.02 cs 2002 LOT 2 310.01 cs 2092 LOT 1 155.A 175 295 285 153 169 BLOCK 5 BLOCK I WEST WASHINGTON STREET JAMIESON'S ADDITION 177 29<del>4.</del>1 315 s 1089 314 178.01 BLOCK 10 313 s 1089 COLUMBIA COUNTY HIGHWAY SHOP & GRAVEL PIT 177.A 311 299.A 32.13ac \$1067 \$2015 \$11787 Z OIE 182.01 291.A1 ADD 291.A 5640 292.03 PAUQUETTE PARK 는 290 보 179.01 292.05

> 293 52015

> > -SEE PAGE 11-

MCMILLAN ROAD

REGISTER OF DEEDS(R.O.D.) - SHEET 176A

SURVEY INDEX

S 1590

S 5100

S 8929

R.O.D. 6C

R.O.D. 7B & 8A

COLUMBIA CONDOMINIUMS

JAMIESON'S ADDITION

HILLCREST ADDITION PHASE I

HILLCREST ADDITION PHASE II
HILLCREST ADDITION PHASE III
HILLCREST ADDITION PHASE IV

HILLCREST ADDITION PHASE V

WEST POYNETTE ADDITION

SARAH A TOMLINSON'S ADDITION R.O.D. 8B
TOMLINSON & HUDSON ADDITION R.O.D. 6B

312 51099

-PAGE 7-

316 0.65ec CS 3802 One Inch Equals Two Hundred Feet

MILES

1/16
FEET

1/8
FEET

0 200 400 600 800

NOTE: This map was prepared for assessment use in accordance with the Wis. St. Stat. Chap. 70.09. All information contained herein is advisory only. Map accuracy is limited to the quality of data obtained from other Public Records. This map is not intended to be a substitute for an actual field survey. Public Land Survey Base is derived from U.S.G.S. Topopgraphic maps unless otherwise noted. Other sources of the Land Base may be actual survey data. Base map data is from the April 1995 County Digital Orthophotos and/or U.S.G.S. 1:24,000 scale Topographic series. The user is responsible for the improper use of the data contained herein.

Created by The Columbia County Land Information Office -GIS Section. VMB and KMA Feb 2005

SEC. 34 SEC. 35 SEC. 3 SEC. 2

COVELAND ROAD

CAVE'S ADDITION
CAVE'S 2ND ADDITION

**CAVES CONDOMINIUMS** 

LINDERWELL ADDITION

SURVEY INDEX

R.O.D. 6E

S 12049


REGISTER OF DEEDS(R.O.D.) - SHEET 9E


TAX PARCEL MAP

## VILLAGE of POYNETTE

TOWN 11 NORTH RANGE 9 EAST COLUMBIA COUNTY, WISCONSIN


Replaced 2006

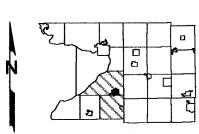

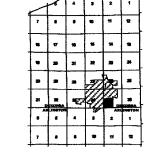

-SEE PAGE 8-CENTER SECTION 35 WATER STREET 12g12 367 \_\_\_\_\_\_8 \_\_\_124 \_\_\_\_\_5183 , 126 -366.03 ac 7 cs 3097 -366.04 .1345 ac 125 BLOCK 1 368.1 GJPY 368.2 CS 1587 LOT 2 ADDIT ON 31 2 368.03 cs.3283 cor 3 <del>-127:0</del>1 --368.02 cs ses cor 2 MILL STREET 368.01 CS 3283 LOT 1 128.A #47425 373.E 128 364B 370 CS 1547 LOT 1 373.C1 57313 130.01 cs 2305 tot 1 364.10b MILL STREET 373.A 3LOCK 1 15 | 133.A | 133 131 137 -131:A G (500 LDT 2 373 CS 0856 LOT 1 0.97 ac CAVE'S 2ND ADDITION EAST JOHN STREET 134 ni 7309 SOUTH MAIN STREET - TOWN of DEKORRA -135 BLOCK 3 143.C [1**43** 136 **USH** 143.B 137 374 S 11975 375 - ETH-CS & Q 376 HE 7426 377.01 377.02 381.014 832.# LODITION 381.013 42× \_LINDERWELY

- TOWN of DEKORRA -

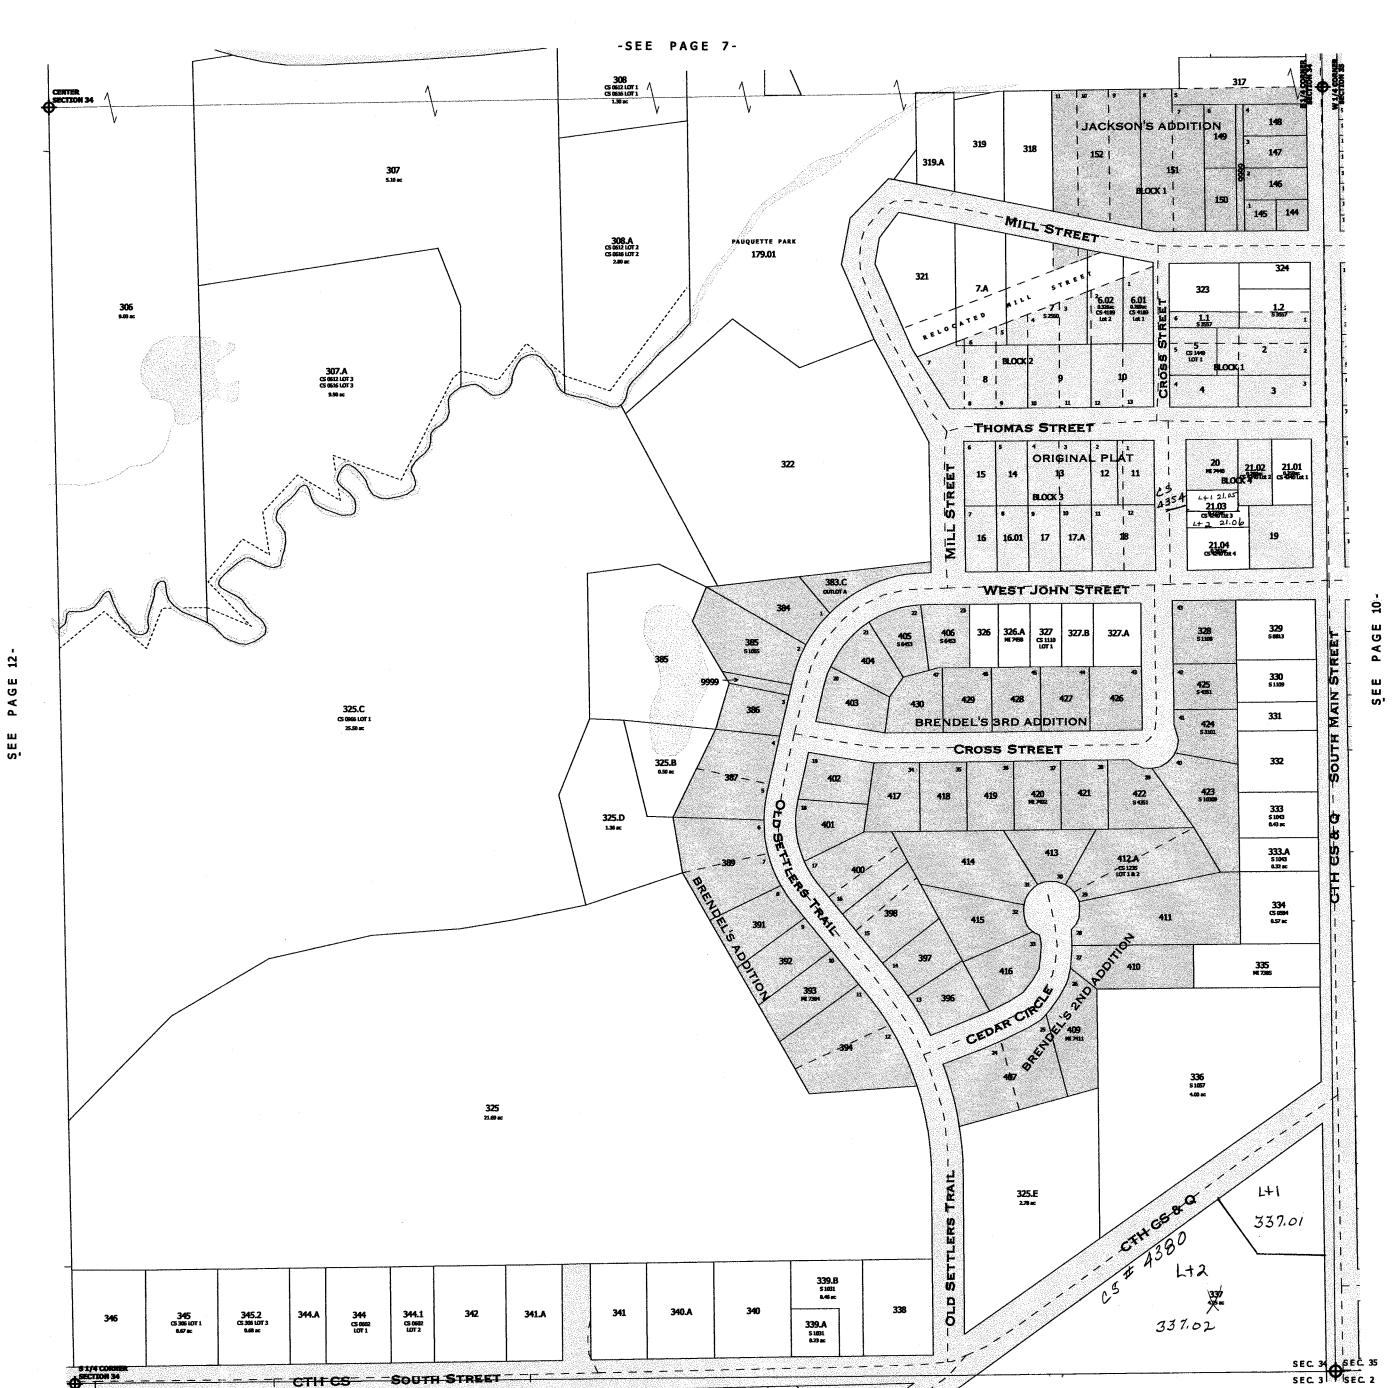

9999 - This number is used to represent tax parcels or a portion of a tax parcel that requires additional research to determine accurate boundaries and/or ownership.

-SEE PAGE 14-

SURVEY INDEX

BRENDEL'S ADDITION S 1040

BRENDEL'S 2ND ADDITION REGISTER OF DEEDS(R.O.D.) - SHEET 136B

BRENDEL'S 3RD ADDITION R.O.D. 144A

JACKSON'S ADDITION R.O.D. 9D

ORIGINAL PLAT R.O.D. 6D

-PAGE 11-

- TOWN of ARLINGTON -

TAX PARCEL MAP NOTE: This map was prepared for assessment use in accordance with the Wis. St. Stat. Chap. 70.09. All information contained herein is advisory only. Map accuracy is limited to the quality of data obtained from other Public Records. This map is not intended to be a substitute for an actual field survey. Public Land Survey Base is derived from U.S.G.S Topopgraphic maps unless otherwise noted. Other sources of the Land Base may be actual survey data. Base map data is from the April 1995 County Digital Orthophotos and/or U.S.G.S. 1:24,000 scale Topographic series. The user is responsible for the improper use of the data contained herein. VILLAGE of POYNETTE Created by The Columbia County Land Information Office -GIS Section. VMB and KMA Feb 2006 TOWN 11 NORTH RANGE 9 EAST Replaced COLUMBIA COUNTY, WISCONSIN 2007 PAGE # SUBDIVISION PLAT INDEX BRAYTON & TOMLINSON ADDITION | REGISTER OF DEEDS(R.O.D.) - SHEET 6A | 8 - TOWN of DEKORRA -11 11 11 10 10 **BRENDEL'S ADDITION** S 1040 -2ND ADDITION
-3RD ADDITION R.O.D. 136E R.O.D. 144A CAVE'S ADDITION

-2ND ADDITION

CAVE'S CONDOMINIUMS

COLUMBIA CONDOMINIUMS million of the contract of the R.O.D. 9E R.O.D. 6E S 12049 7 3 S 8391 - TOWN of DEKORRA -R.O.D. 153A COLUMBIA HEIGHTS
H.P. & A.J. JAMIESON 8 8 4 7 R.O.D. 7A 539 R.O.D. 14A -2ND ADDITION S 3832 HICKORY WOODS HTLLCREST ADDITION -PHASE I R.O.D. 176A 7 7 7 7 7 HTLLCREST ADDITION -PHASE II S 1590 HILLCREST ADDITION -PHASE III S 3086 HILLCREST ADDITION -PHASE IV S 5100 HILLCREST ADDITION -PHASE V S 8929 534 JACKSON'S ADDITION

JAMIESON & GAULT ADDITION R.O.D. 9D 537.02 8 R.O.D. 6C 8 R.O.D. 7C -2ND ADDITION JAMIESON'S ADDITION
JAMIESON'S 3RD ADDITION 7 R.O.D. 10A S 1041 8\_\_ 6 10 11 JOHN WAYNE CONDOMINIUM PLAT S 10239 LINDERWELL ADDITION S 5606 524.052 ORIGINAL PLAT
PAUQUETTE PINES R.O.D. 6D 524.063 524.064 524.065 524.066 2, 3 7 10 7 8 14 14 7 SARAH A TOMLINSON ADDITION R.O.D. 8B SHERNECKER CONDOMINIUM S 11975 TOMLINSON & HUDSON ADDITION R.O.D. 6B TOMLINSON'S ADDITION
WEST HILL SUBDIVISION R.O.D. 10B R.O.D. 155B -1ST ADDITION S 1039 R.O.D. 7B & 8A WEST POYNETTE ADDITION 362.11 529.E - TOWN of DEKORRA -HILLCREST ADDITION PHASE IV ADDITIONAL SURVEYS - NOT FOUND ON MAPS -SEC. 28-11-9 SEC. 33-7.1-9 SEC. 27-11-9 S 1030 COMPOSITE 1973 S 1034 COMPOSITE S 1097 520.6 JAMIESON'S A 7313 A 7314 A 7316 JOHN WAYNE CONDO PLA 9 520.103 520.104 H.P. & A.J. JANIESON 2ND ADDITION COLUMBIA 361 JAMIESON'S ADDITION - TOWN of DEKORRA -521.01 EAST STREET 519.A ADDITION 10 12 SHERNECKEI CONDOMINIUM BRENDELS ADDITION LINDERWELL - TOWN of DEKORRA -SEC. 34-11-9 SEC. 33-11-9 S E C. 3-10-9 CS WEST HILL SUBDIVISION BUTTERNUT ROAD - TOWN of ARLINGTON -Replaced - TOWN of ARLINGTON -2007

One Inch Equals Two Hundred Feet

MILES

0 1/16 1/8

FEET

0 200 400 600 800


NOTE: This map was prepared for assessment use in accordance with the Wis. St. Stat. Chap. 70.09. All information contained herein is advisory only. Map accuracy is limited to the quality of data obtained from other Public Records. This map is not intended to be a substitute for an actual field survey. Public Land Survey Base is derived from U.S.G.S. Topographic maps unless otherwise noted. Other sources of the Land Base may be actual survey data. Base map data is from the April 1995 County Digital Orthophotos and/or U.S.G.S. 12-4000 scale Topographic series. The


VILLAGE of POYNETTE

TAX PARCEL MAP


TOWN 11 NORTH RANGE 9 EAST COLUMBIA COUNTY, WISCONSIN Rep.

Replaced

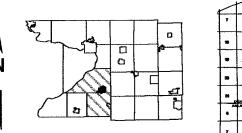

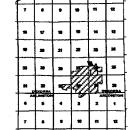

2007

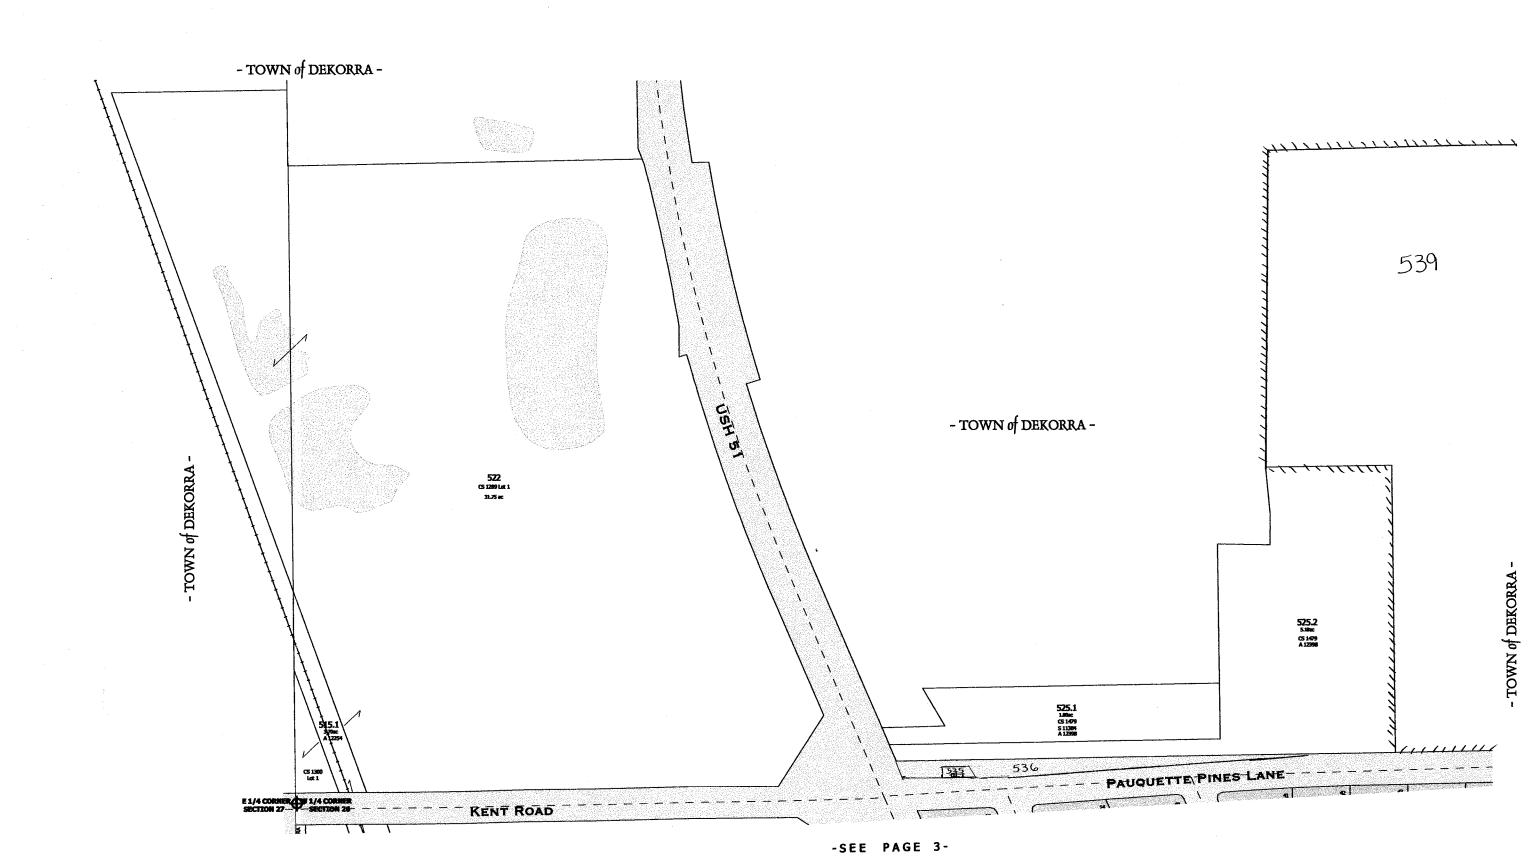

One Inch Equals Two Hundred Feet

MILES

1/16
FEET

1/16
FEET

1/8

NOTE: This map was prepared for assessment use in accordance with the Wis. St. Stat. Chap. 70.09. All information contained herein is advisory only. Map accuracy is limited to the quality of data obtained from other Public Records. This map is not intended to be a substitute for an actual field survey. Public Land Survey Base is derived from U.S.G.S Topographic maps unless otherwise noted. Other sources of the Land Base may be actual survey data. Base map data is from the April 1995 County Digital Orthophotos and/or U.S.G.S. 1:24,000 scale Topographic series. The user is responsible for the improper use of the data contained herein.

Created by The Columbia County Land Information Office -GIS Section. VMB and KMA. March 2002


TAX PARCEL MAP

## VILLAGE of POYNETTE

TOWN 11 NORTH RANGE 9 EAST COLUMBIA COUNTY, WISCONSIN

N

Replaced 2007

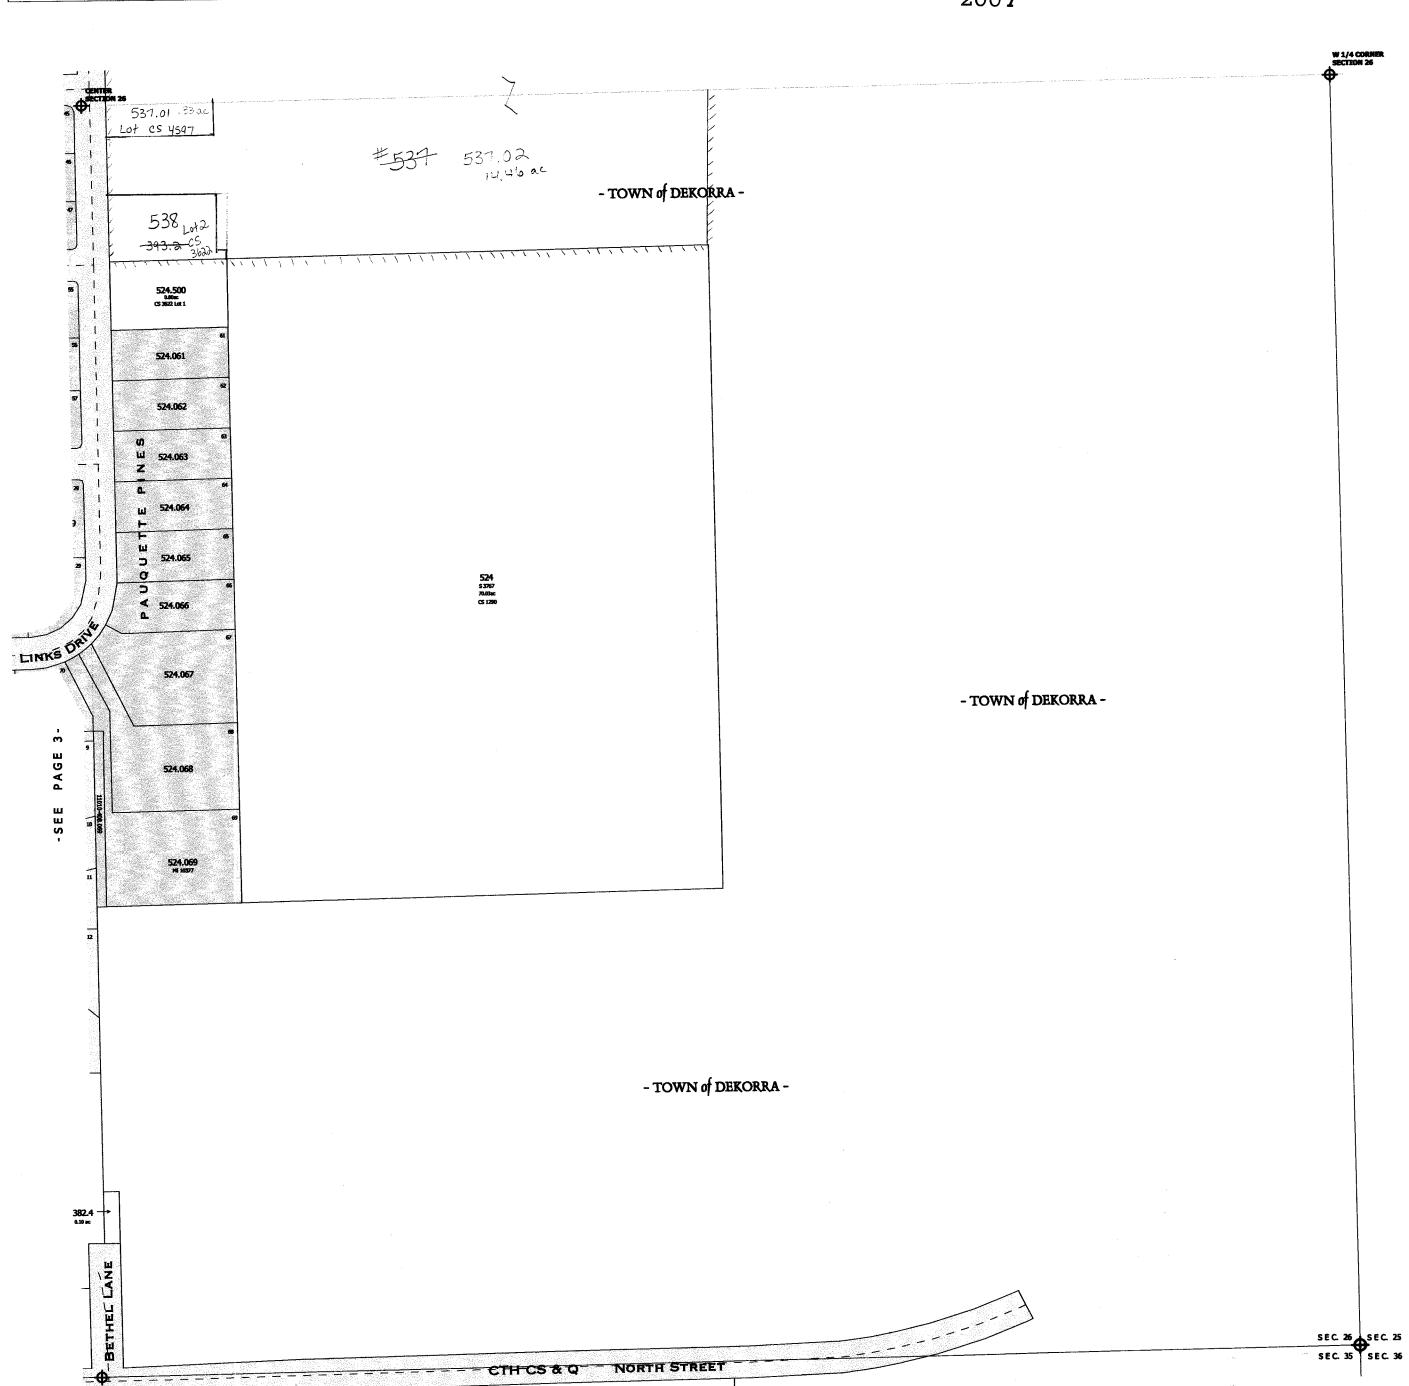

-SEE PAGE 9-

One Inch Equals Two Hundred Feet 1/16 NOTE: This map was prepared for assessment use in accordance with the Wis. St. Stat. Chap. 70.09. All information contained herein is advisory only. Map accuracy is limited to the quality of data obtained from other Public Records. This map is not intended to be a substitute for an actual field survey. Public Land Survey Base is derived from U.S.G.S. Topopgraphic maps unless otherwise noted. Other sources of the Land Base may be actual survey data. Base map data is from the April 1995 County Digital Orthophotos and/or U.S.G.S. 1:24,000 scale Topographic series. The user is responsible for the improper use of the data contained herein.


ited by The Columbia County Land Information Office -GIS Section. VMB and KMA Feb 2006

TAX PARCEL MAP


## VILLAGE of POYNET

TOWN 11 NORTH RANGE 9 EAST COLUMBIA COUNTY, WISCONSIN

Replaced 2007

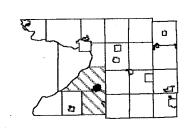

-SEE PAGE 1-

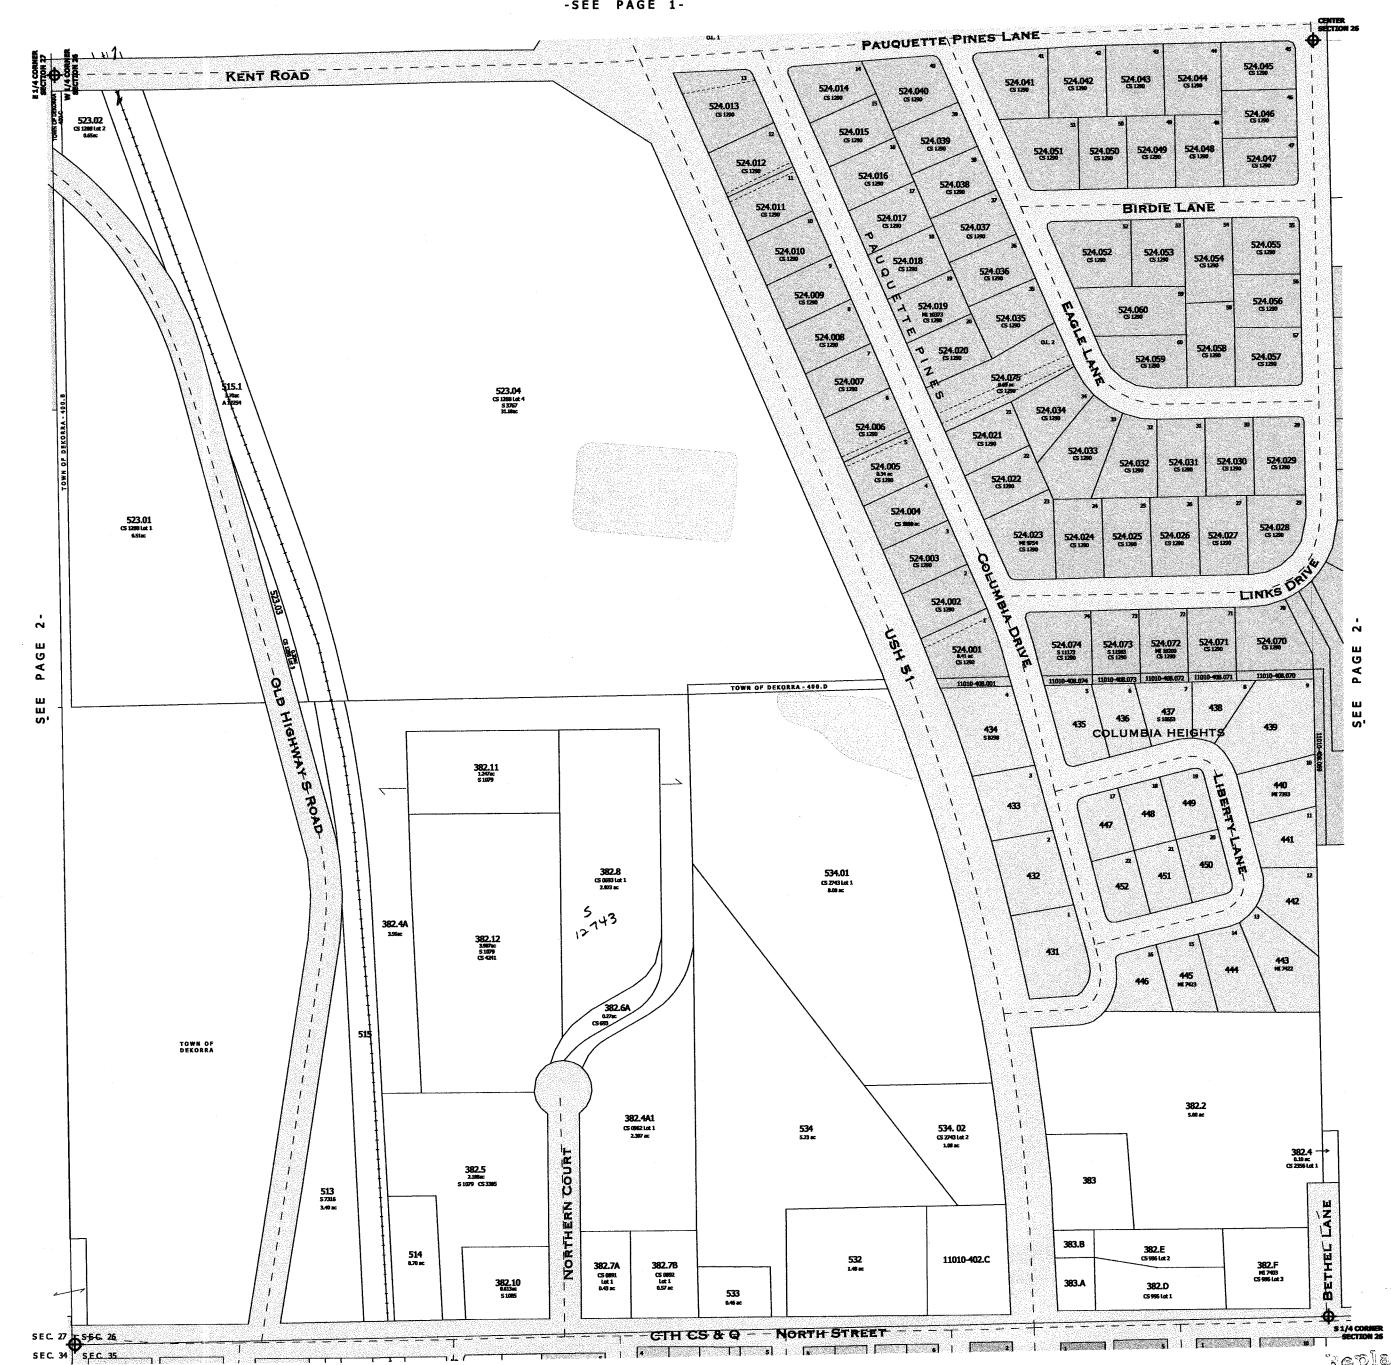

One Inch Equals Two Hundred Feet TAX PARCEL MAP 1/16 FEET owas prepared for assessment use in accordance with the Wis. St. Stat. Chap. 70.09. All information is advisory only. Map accuracy is limited to the quality of data obtained from other Public Records. Intended to be a substitute for an actual field survey. Public Land Survey Base is derived from U.S.G.S maps unless otherwise noted. Other sources of the Land Base may be actual survey data. Base in the April 1995 County Digital Orthophotos and/or U.S.G.S. 1:24,000 scale Topographic series. The user is responsible for the improper use of the data contained herein. TOWN 11 NORTH RANGE 9 EAST Replaced COLUMBIA COUNTY, WISCONSIN Columbia County Land Information Office -GIS Section. VMB and KMA Feb 2006 2007 -SEE PAGE 4-SEC. 34 SEC. 26 NORTH STREET N 1/4 CORNER SECTION 34 299.J1 813 æ 296.02 S1602 CS 1346 CS 2412 Let 2 Let 2 296.01 299.049 299.053 S 1607 (3.1345 (35.2417 (66.1 858 # 299.055 MI 8942 299.054 299.038 299.094 63H ac 299.097 299.096 1344 ac 299.052 299.051 299,039 299.037 299.100 299.102 835 € 299.099 299.098 299.101 HILLCREST ADDITION 299.048 PHASE ; COLBY BOULE MAN 297 ... .... 297 COLBY BOULEVARD 299.047 281 299,041 299.031 299.093 299.058 299.110 020 × 299.057 ME 7390 299.107 299.108 5.207 ac 299.056 Nr 7391 299.103 6331 ac 299.104 6267 ac 299.106 299.105 281.A 299.033 299.116 €341 ± ADDITION HILLCREST ADDITION 299.042 MI 2005 W. GRANT STREET CREST AD PUBLIC PARK CREST SE III 299,N 299.062 299.061 299.060 HILLCREST ADDITION 299.061 299,060 299.113 6322 ac 299.112 6322 sc 299.063 299.115 639 sc 299.114 6322 sc 299.111 4322 ≈ 299.117 299.B1 CS 0271 Lot 2 0.50 ac PHASE 299,043 283.2 W 750 SUNSET DRIVE 299,044 MI 7406 299.118 0.36 ac 299.023 299.066 299.064 MI 5858 299.065 ## 7636 HILLEREST ADDITION 299.125 0.207 € 299.121 299.122 1287 × 299.123 630 × 299.124 299.B2 cs 5271 lat 1 0.50 ac 299,027 HE 7404 299.024 299.119 PHAPE 11 299.021 299.067 299,025 299.088 W. HUDSON STREET 299.071 299.069 299.075 ME 7615 299.074 299.073 PE 6138 299.072 299.071 299.120 8361 sc HILLOREST ADDITION PHASE 299.068 301 N 105 279.B -VALLEY-VIEW DRIVE -279.A 299.087 299.083 ME 663 299.085 299.086 299,084 299.078 299.079 299.080 299.126 302 501 HE 7HIS 278 299.K CS 0611 Let 1 1.24 ac GREENWAY W. TOMLINSON STREET 299.133 832 × 299.132 •38 × MEADOW 1299-303 299.127 HILLCREST **ADDITION** 299.B3 \$ 1096 CS 0467 Let 1 1.67 ac PHASE V COLBY PARK 299.C1 \$1096 \$8662 \$8688 CS 0467 Lot 2 0.46 ac 299.C2 \$1096 \$8661 \$8688 C\$ 0467 Let 3 0.48 ac 299.P 5.21 ac 303.A CS 1236 Lot 1 1.53 ac PAGE 299,131 846± 299.129 COLUMBIA \_ W. SEWARD STREET CONDOS 299.130 0.54 ac 299.201 cs 2/69 lat 1 160 172.01 172.02 299.H 5 1095 CS 465 Lot 1 0.42 ac C2 1969 C2 1989 3 170 57504 158 156 171 157 300 ELLINGT BLOCK 2 173 | 16768 155 310.02 cs 2092 Let 2 284 53196 MI 1292 155,A 175 295 155310 153 BLOCK 5 | BLOCK WEST WASHINGTON STREET HOITIDDA E'HOESIMAL 182 181 177 176 COLUMBIA COUNTY HIGHWAY SHOP & GRAVEL PIT 313 s 1089 BLOCK 10 182 177.A 299.A 32.13ac \$ 1067 \$ 2015 \$ 11787 311 291 291.A1 STREET 291.A 5640 ACADEMY PAUQUETTE PARK L 290 179.01 292.05 292.06 52563 293 sabs 312 51059 316 0/5ec CS 3802 MCMILLAN ROAD SURVEY INDEX COLUMBIA CONDOMINIUMS HILLCREST ADDITION PHASE I REGISTER OF DEEDS(R.O.D.) - SHEET 176A -SEE PAGE 11-HILLCREST ADDITION PHASE II S 1590 Replaced HILLCREST ADDITION PHASE III S 3086 HILLCREST ADDITION PHASE IV S 5100 HILLCREST ADDITION PHASE V S 8929 2007 JAMIESON'S ADDITION R.O.D. 6C SARAH A TOMLINSON'S ADDITION R.O.D. 8B TOMLINSON & HUDSON ADDITION R.O.D. 6B

WEST POYNETTE ADDITION

-PAGE 7-

One Inch Equals Two Hundred Feet TAX PARCEL MAP NOTE: This map was prepared for assessment use in accordance with the Wis. St. Stat. Chap. 70.09. All information contained herein is advisory only. Map accuracy is limited to the quality of data obtained from other Public Records. This map is not intended to be a substitute for an actual field survey. Public Land Survey Base is derived from U.S.G.S. Topographic maps unless otherwise noted. Other sources of the Land Base may be acul survey data. Base map data is from the April 1995 County Digital Orthophotos and/or U.S.G.S. 1:24,000 scale Topographic series. The user is responsible for the improper use of the data contained herein. TOWN 11 NORTH RANGE 9 EAST Replaced COLUMBIA COUNTY, WISCONSIN Created by The Columbia County Land Information Office -GIS Section. VMB and KMA Feb 2005 200**7** -SEE PAGE 3-SEC 27 SEC 26 SEC 34 SEC 35 T- -CTH ES & Q - - NORTH STREET 231.01 03245 1071 250.A V.BU 200 \_207\_ 207.A \_272\_ \_\_ 347.01 cs 2286 LOT 1 347.02 cs 2286 LOT 2 199 199.A 201 348.01 (S 2284 (OT 1 51111 0.35 ac 231.02 55295 1072 210 202 206 349 51111 196.A 347.03 BLOCK 4 CS 2286 LOT 3 233 249.B 210.A 197.A # 729 203 205.A CS 1069 348.02 (S 2284 1072 51111 347.04 cs 2266 LOT 4 235 11748 236 5252 349.2 CS 1635 249.A 197 204 210.B 205 EAST GRANT STREET EAST GRANT STREET 350 G 1067 G 1067 263.1 ANIESON & G. 192.02 274 351 (5)/68 1-05/55° 1-05/55° 1-05/55° D STREE 352 -0- ---0- 2622 -0- -BLOCK 5 BLOCK 4 350.1 8 188 1873 263.2 🗟 273.A S 1113 ---CS 1004 LOT 1 CS 1066 LOT 2 \_216 -- 193 211 6264 51863 273 --- East Hudson Street STA 222 221 5 1000 185 M 737 351.A1 CS 1705 LOT 1 ML 7386 V 5546 277.A 254.B \_1.87 s 10009 HOWARD NORTH 223 184 259.1 277 JAMIESO! 355 BLOCK 6 N Q 276 0294: 510308 351.A2 LSH G175 ,189.A 189.B 51115 51115 217 ≠ <u>7</u>61 261.A 257.A BLOCK 1 EAST TOMLINSON STREET !T 227 228 112 104 CS 0050 103 353.B 226 228.A 112.A 118 -115A 225.A 119 107 5963 230 229 102.A 102 113 120 5 1090 225 114 353.A 115 109 EAST SEWARD STREET 85 71.A 77 72 BLOC 77.B 1 87 71 82 77.1 88 90.A 67.A 69.A 77.A 74 H1742 80.A 68.01 - 9.897 68.02 -9.893 78.A 75 51696 . 69 . 70. 79 \_93\_\_ ... -80 CEMETERY BRAYTON & TOMLINSON ADDITION 358.A1 TOMLINSON ROAD-60.8 42.1 358.4 57 52 62 51.A 63 358.B VAN BUREN STREET 363 CS 0135 LOT 1 360 \$ 1054 \$1055 C\$ 0417 LOT 1 **LINCOLN STREE** BLOO EAST 259 CS 4616 25 Lot 1 .813 ac WATER STREET SURVEY INDEX REGISTER OF DEEDS(R.O.D.) - SHEET 6A BRAYTON & TOMLINSON ADDITION H.P. & A.J. JAMIESON ADDITION R.O.D. 7A

-SEE PAGE 10-

H.P. & A.J. JAMIESON 2ND ADDITION

JAMIESON AND GAULT ADDITION JAMIESON AND GAULT 2ND ADDITION

JAMIESON'S 3RD ADDITION

TOMLINSON'S ADDITION

R.O.D. 14A

S 1041 R.O.D. 6C

R.O.D. 7C

R.O.D. 10B


2007

Replaced

-PAGE 8-

One Inch Equals Two Hundred Feet TAX PARCEL MAP 1/16 FEET s prepared for assessment use in accordance with the Wis. St. Stat. Chap. 70.09. All information dvisory only. Map accuracy is limited to the quality of data obtained from other Public Records. ded to be a substitute for an actual field survey. Public Land Survey Base is derived from U.S.G.S ps unless otherwise noted. Other sources of the Land Base may be actual survey data. Base April 1995 County Digital Orthophotos and/or U.S.G.S. 1:24,000 scale Topographic series. The user is responsible for the improper use of the data contained herein. TOWN 11 NORTH RANGE 9 EAST COLUMBIA COUNTY, WISCONSIN Replaced The Columbia County Land Information Office -GIS Section. VMB and KMA  $\,$  Feb 2006 2007 -SEE PAGE 8-WATER STREET 124 5883 , 368.06 0.26sc CS 3243 Lot 4 S 10828 125 9LOCK 1 368.2 CS 1587 Lat 2 -122 | 122A 6 CAVE S 51023 5 366.A ME 9440 1 121 1 <del>-127.0</del>1 -368.02 CS 3283 Lat 2 MILL STREET 368.01 cs 3283 Lat 1 373.E 364.B 370 CS 1547 Lat 1 373.C1 \$7313 371 MILL STREET 373.F CS 0896 Lat 2 5.30 ac 373.A 1 BLOOK 1 | 133 133.A 132 -131:A CS 1590 Lot 2 1 373 CS 0856 Lot 1 0.97 ac CAVE'S | 2ND | ADDITION SHERNECKER CONDOMINIUM EAST JOHN STREET 134 14 7389 FRANKLINSTREET 364,203 SOUTH MAIN STREET 135 - TOWN of DEKORRA 143.C USH 51 136 <sub>[</sub>143 364.202 143.B 137 364.106 1.55ec (5) 1374 Lot 1 PAGE 374 375 CTH-CS & 376.A 51042 0.41 ac 376 NE 2426 373.C 38.77 ≈ 377.01 377.02 378 381.014 032 at 381.009 0.56 ac 381.013 <sup>032</sup>≠ 381.011 M 955 039 ac 381.012 \*\*\* LINDERWELY 381.003 631 ec 381.004 0.29 sc 381.002 0.38 at SEC. 34 SEC. 35 SEC. 31 SEC. 2 LOVELAND ROAD Replaced 2007 - TOWN of DEKORRA -SURVEY INDEX CAVE'S ADDITION REGISTER
CAVE'S 2ND ADDITION R.O.D. 6E
CAVES CONDOMINIUMS S 12049
LINDERWELL ADDITION S 5606
SCHERNECKER CONDOMINIUM S 11975 REGISTER OF DEEDS(R.O.D.) - SHEET 9E R.O.D. 6E

-PAGE 10-

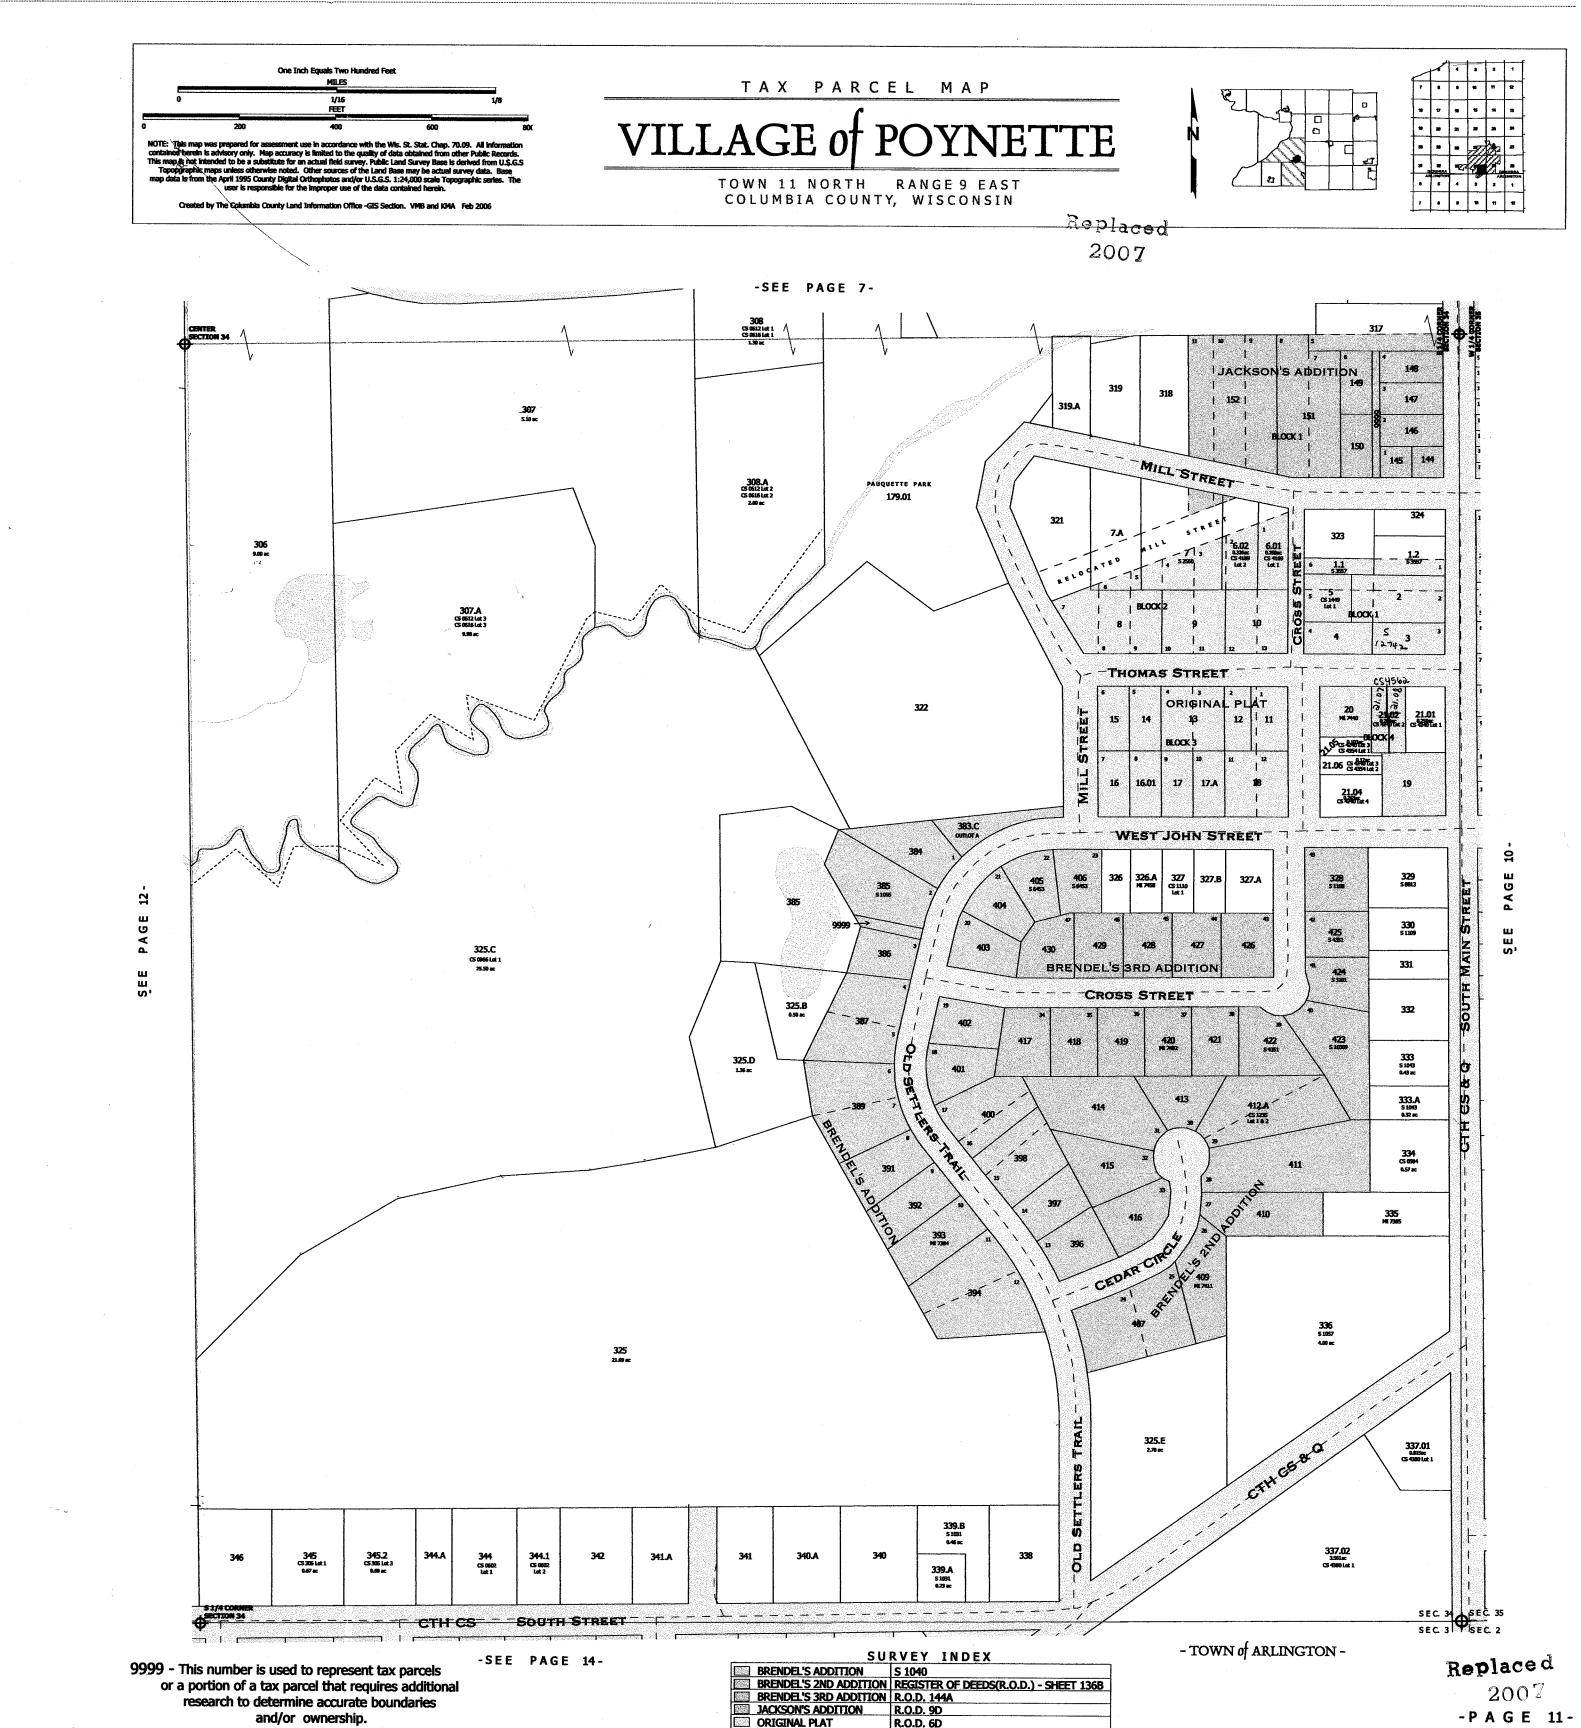

One Inch Equals Two Hundred Feet

MILES

0 1/16 1/8

FEET

0 200 400 600 80


NOTE: This map was prepared for assessment use in accordance with the Wis. St. Stat. Chap. 70.09. All information contained herein is advisory only. Map accuracy is limited to the quality of data obtained from other Public Records.


NOTE: This map was prepared for assessment use in accordance with the Wis. St. Stat. Chap. 70.09. All information contained herein is advisory only. Map accuracy is limited to the quality of data obtained from other Public Records. This map is not intended to be a substitute for an actual field survey. Public Land Survey Base is derived from U.S.G.S Topopgraphic maps unless otherwise noted. Other sources of the Land Base may be actual survey data. Base map data is from the April 1995 County Digital Orthophotos and/or U.S.G.S. 1:24,000 scale Topographic series. The user is responsible for the improper use of the data contained herein.

Created by The Columbia County Land Information Office -GIS Section. VMB and KMA Feb 2003

VILLAGE of POYNETTE


TOWN 11 NORTH RANGE 9 EAST COLUMBIA COUNTY, WISCONSIN

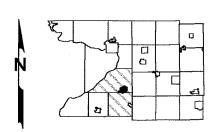


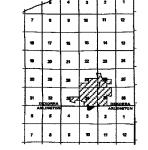


### Replaced

2009

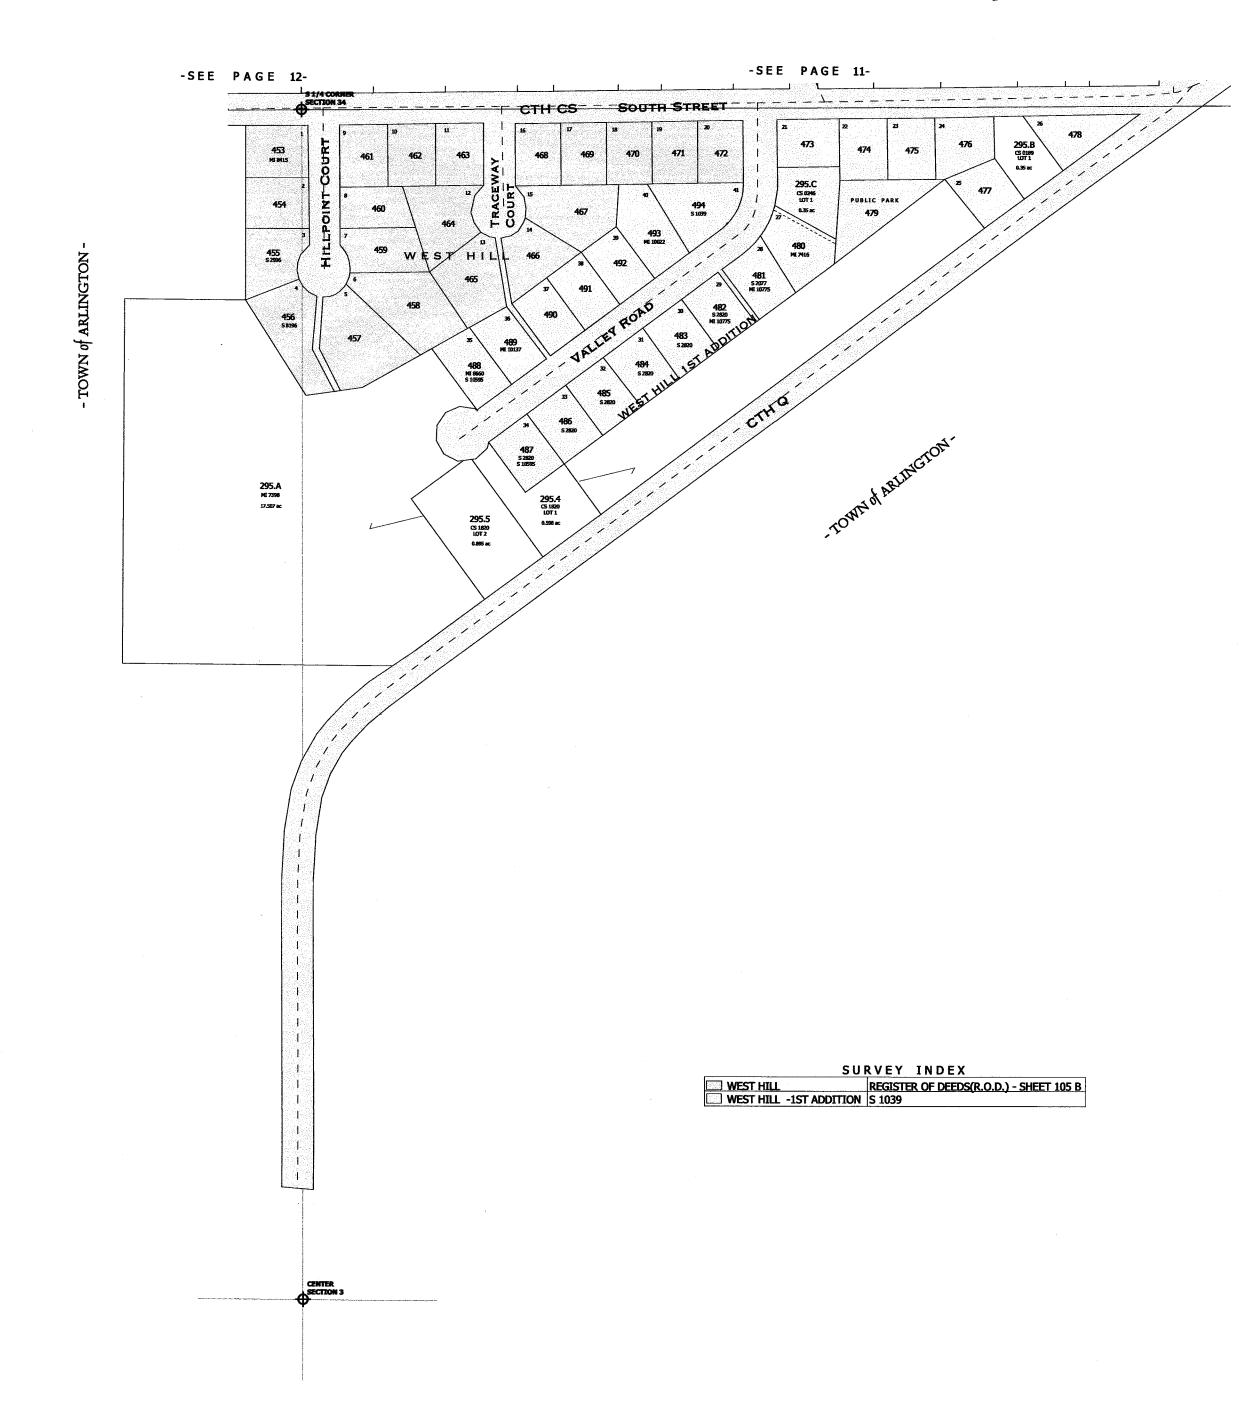

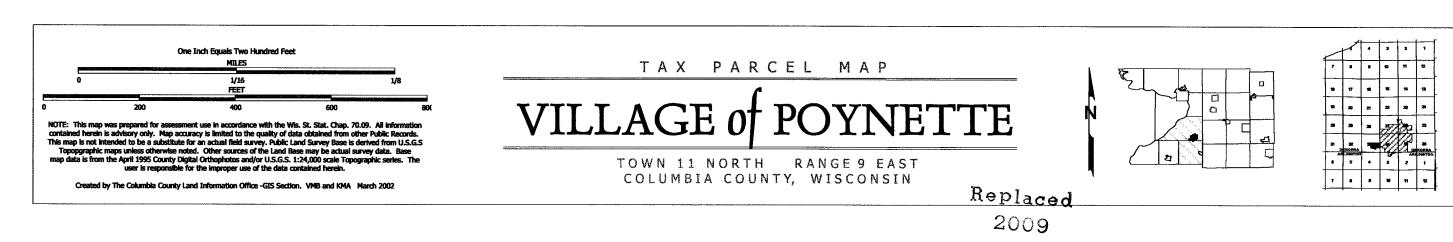



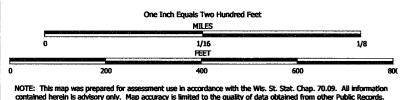


OTE: This map was prepared for assessment use in accordance with the Wis. St. Stat. Chap. 70.09. All information ontained herein is advisory only. Map accuracy is limited to the quality of data obtained from other Public Records. his map is not intended to be a substitute for an actual field survey. Public Land Survey Base is derived from U.S.G.S. Topopgraphic maps unless otherwise noted. Other sources of the Land Base may be actual survey data. Base map data is from the April 1995 County Digital Orthophotos and/or U.S.G.S. 1:24,000 scale Topographic series. The


Created by The Columbia County Land Information Office -GIS Section. VMB and KMA May 2001


TAX PARCEL MAP

## VILLAGE of POYNETTE

TOWN 11 NORTH RANGE 9 EAST COLUMBIA COUNTY, WISCONSIN

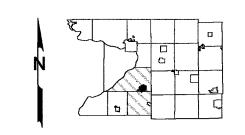

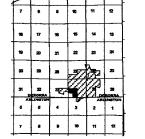

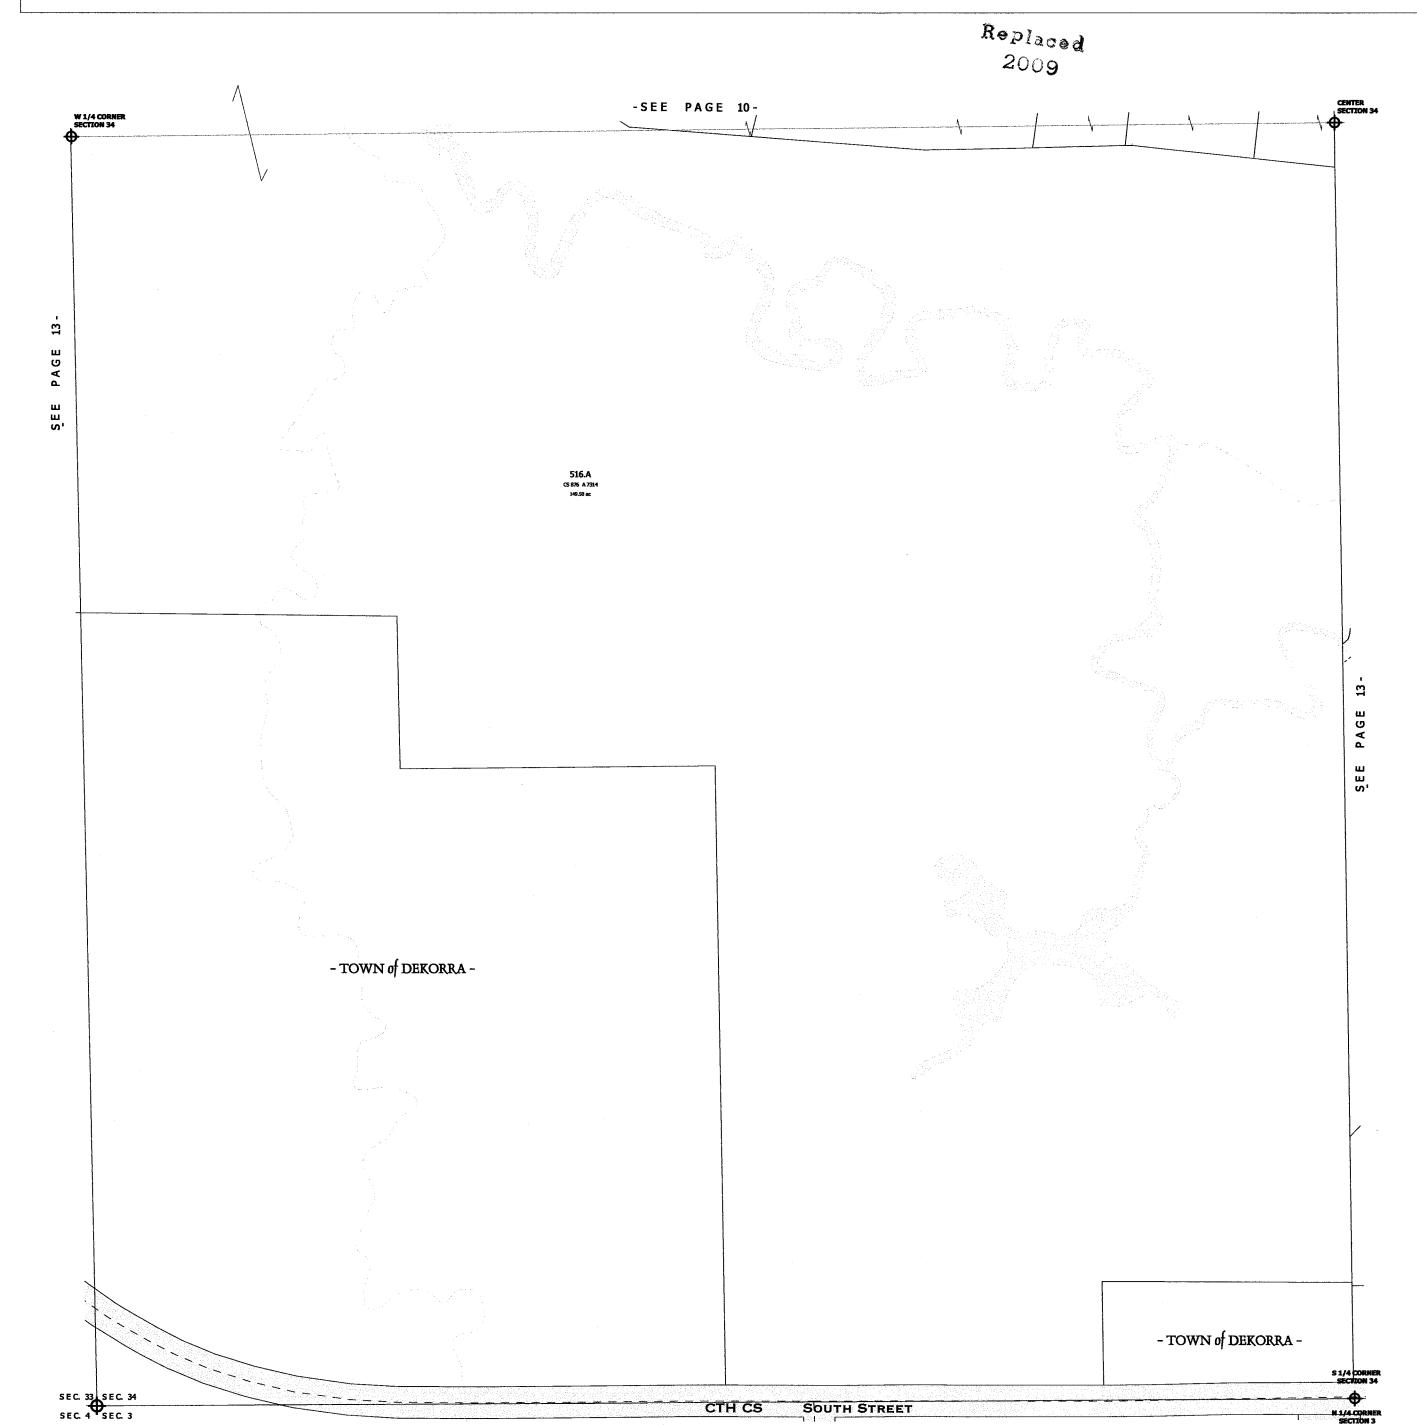

- TOWN of DEKORRA -

1/16 FEET E: This map was prepared for assessment use in accordance with the Wis. St. Stat. Chap. 70.09. All information tained herein is advisory only. Map accuracy is limited to the quality of data obtained from other Public Records. map is not intended to be a substitute for an actual field survey. Public Land Survey Base is derived from U.S.G.S Topographic maps unless otherwise noted. Other sources of the Land Base may be actual survey data. Base o data is from the April 1995 County Digital Orthophotos and/or U.S.G.S. 1:24,000 scale Topographic series. The user is responsible for the improper use of the data contained herein. The Columbia County Land Information Office -GIS Section. VMB and KMA Feb 2006

TAX PARCEL MAP

TOWN 11 NORTH RANGE 9 EAST COLUMBIA COUNTY, WISCONSIN




-SEE PAGE 14-

1/16 FEET NOTE: This map was prepared for assessment use in accordance with the Wis. St. Stat. Chap. 70.09. All information contained herein is advisory only. Map accuracy is limited to the quality of data obtained from other Public Records. This map is not intended to be a substitute for an actual field survey. Public Land Survey Base is derived from U.S.G.S Topopgraphic maps unless otherwise noted. Other sources of the Land Base may be actual survey data. Base map data is from the April 1995 County Digital Orthophotos and/or U.S.G.S. 1:24,000 scale Topographic series. The user is responsible for the improper use of the data contained herein. Created by The Columbia County Land Information Office -GIS Section. VMB and KMA  $\,$  Feb 200 $\overline{\phi}$ 


TAX PARCEL MAP

TOWN 11 NORTH RANGE 9 EAST COLUMBIA COUNTY, WISCONSIN

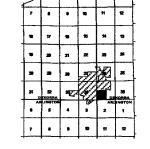

2009

Replaced

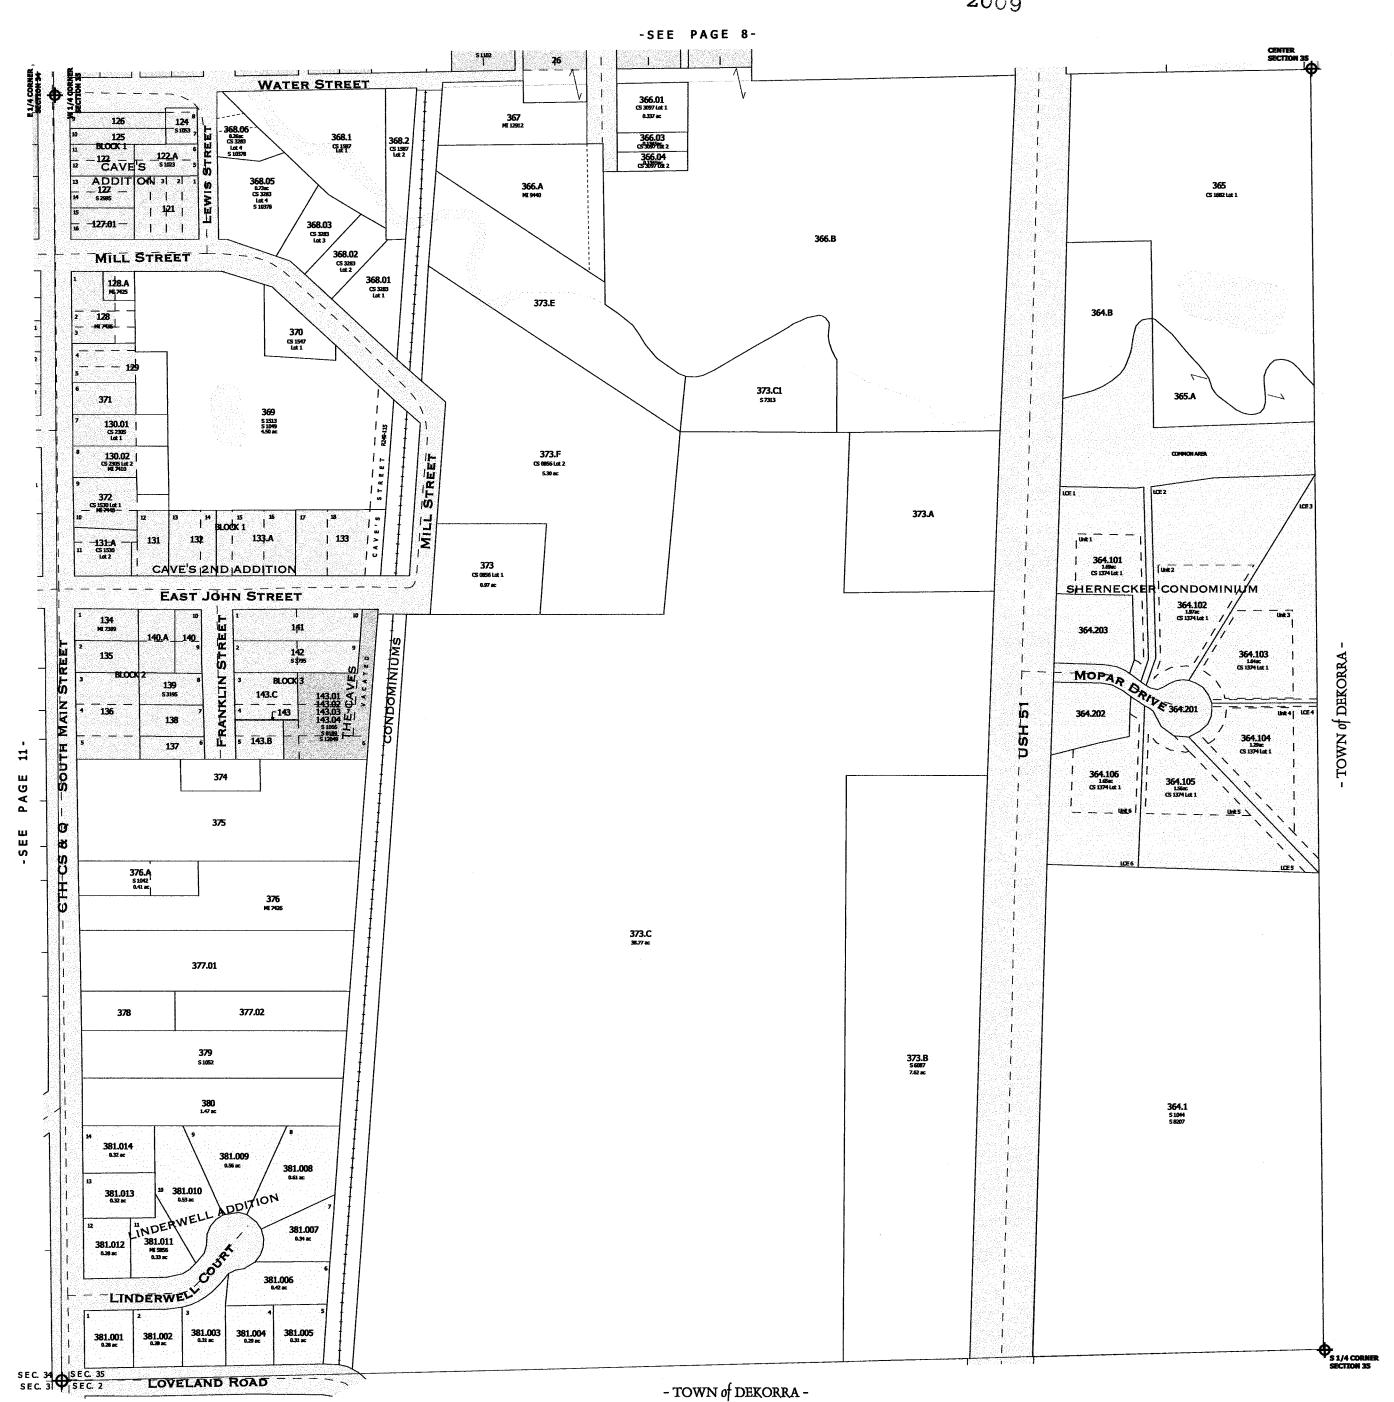

SURVEY INDEX

R.O.D. 6E

REGISTER OF DEEDS(R.O.D.) - SHEET 9E

CAVE'S ADDITION

CAVE'S 2ND ADDITION


CAVES CONDOMINIUMS S 12049
LINDERWELL ADDITION S 5606
SCHERNECKER CONDOMINIUM S 11975

One Inch Equals Two Hundred Feet MILES 1/16 FEET NOTE: This map was prepared for assessment use in accordance with the Wis. St. Stat. Chap. 70.09. All information contained herein is advisory only. Map accuracy is limited to the quality of data obtained from other Public Records. This map is not intended to be a substitute for an actual field survey. Public Land Survey Base is derived from U.S.G.S. Topographic maps unless otherwise noted. Other sources of the Land Base may be actual survey data. Base map data is from the April 1995 County Digital Orthophotos and/or U.S.G.S. 1:24,000 scale Topographic series. The user is responsible for the improper use of the data contained herein.


TAX PARCEL MAP

Created by The Columbia County Land Information Office -GIS Section. VMB and KMA May 2001

TOWN 11 NORTH RANGE 9 EAST COLUMBIA COUNTY, WISCONSIN

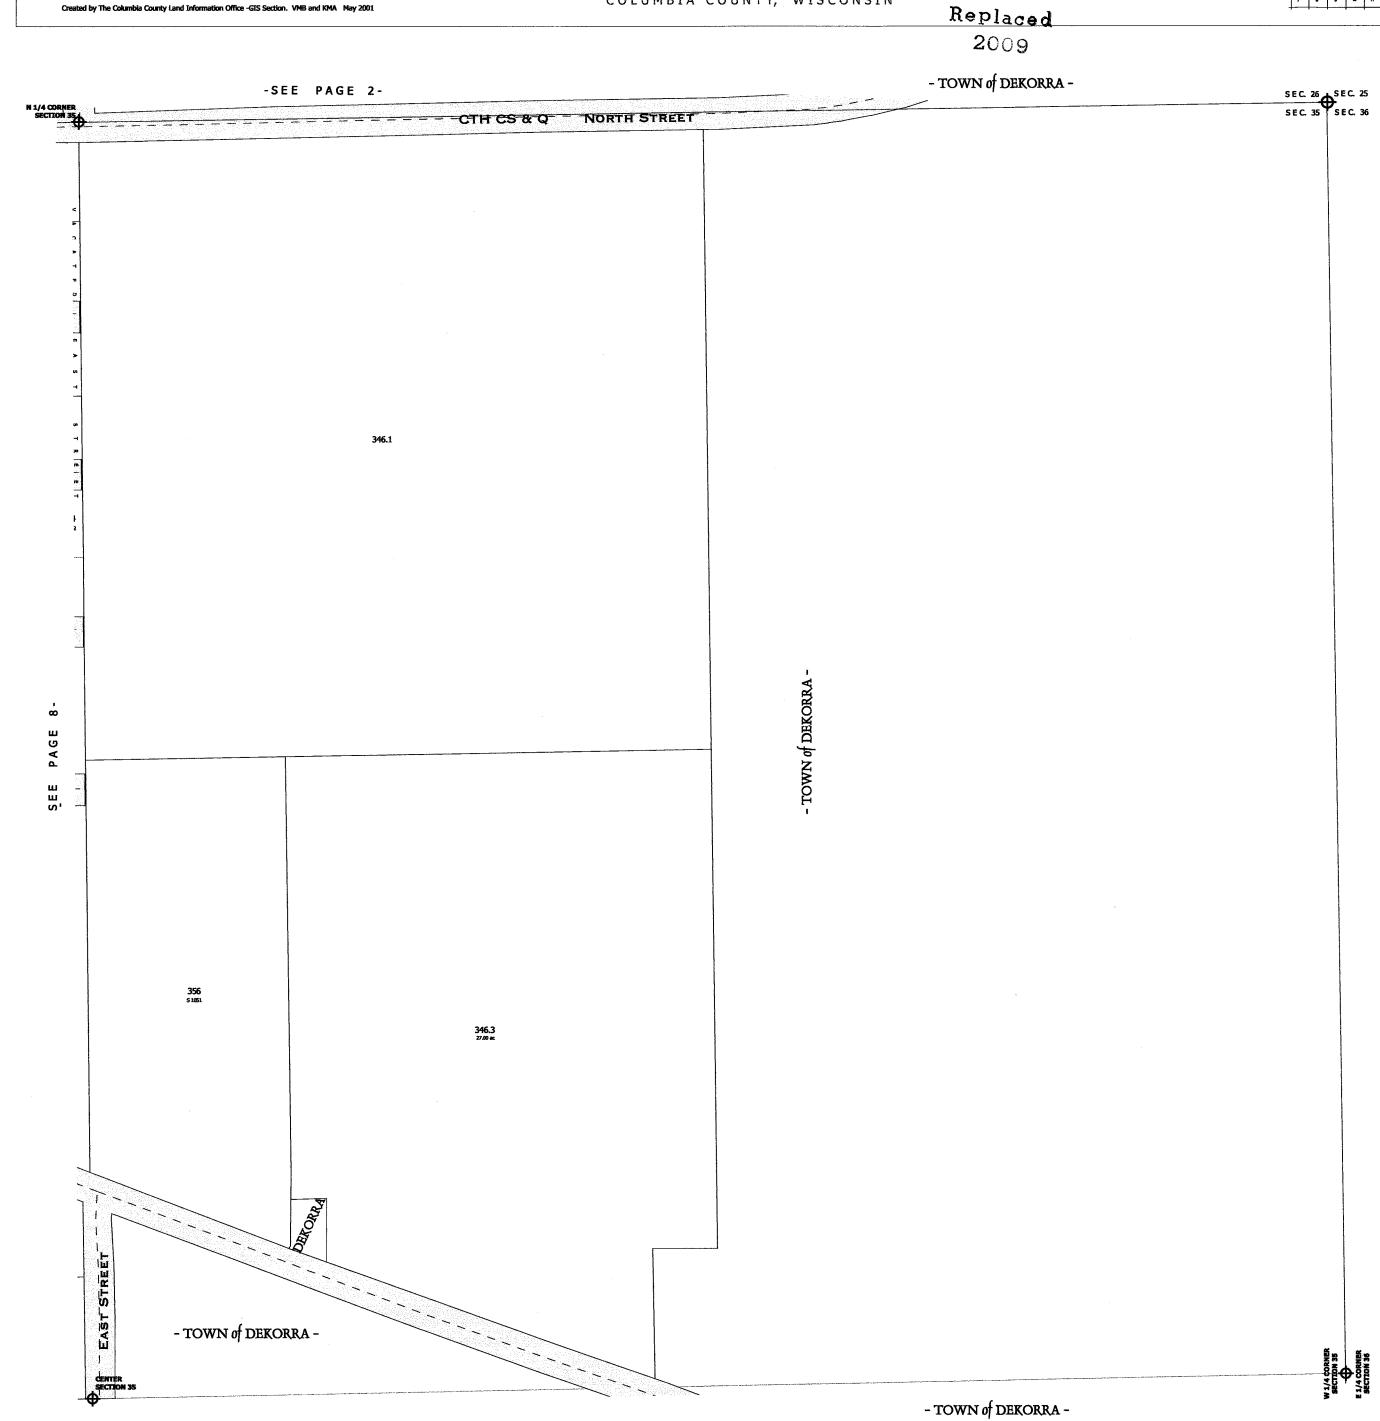

One Inch Equals Two Hundred Feet MILES TAX PARCEL MAP FEET NOTE: This map was prepared for assessment use in accordance with the Wis. St. Stat. Chap. 70.09. All information contained herein is advisory only. Map accuracy is limited to the quality of data obtained from other Public Records. This map is not intended to be a substitute for an actual field survey. Public Land Survey Base is derived from U.S.G.S Topopgraphic maps unless otherwise noted. Other sources of the Land Base may be actual survey data. Base map data is from the April 1995 County Digital Orthophotos and/or U.S.G.S. 1:24,000 scale Topographic series. The user is responsible for the improper use of the data contained herein. Replace TOWN 11 NORTH RANGE 9 EAST COLUMBIA COUNTY, WISCONSIN 2009 Created by The Columbia County Land Information Office -GIS Section. VMB and KMA Feb 20067 -SEE PAGE 3--CTH CS & Q - - NORTH STREET SEC\_ 27 SPC\_ 26 SEC\_ 34 SEC\_ 35 N 1/4 CORNER SECTION 35 231.01 cs 286 Ge 1 200 \_207\_ -249.E 199 347.01 cs 2286 Lat 1 347.02 CS 2286 Lat 2 199.A 201i 250.A v 7312 348.01 CS 2284 Lot 1 S 1111 232 249 210 202 206

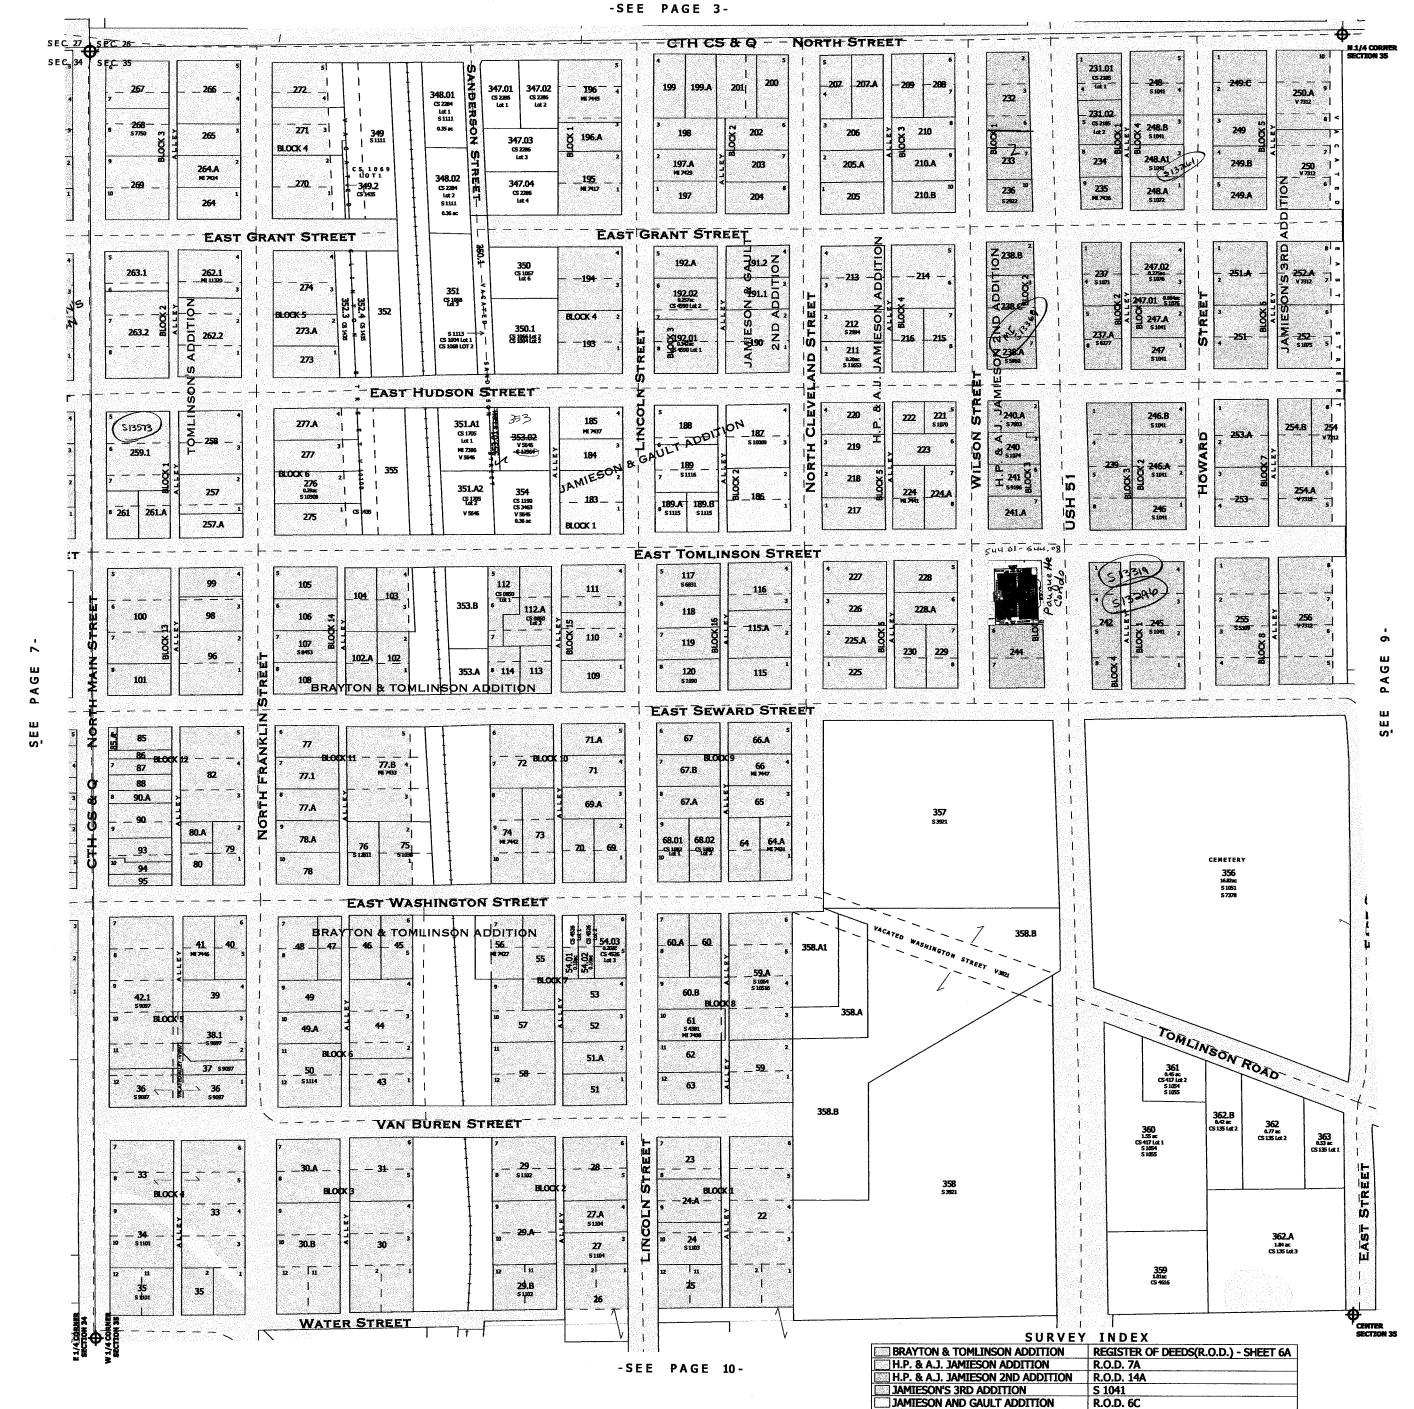

JAMIESON AND GAULT ADDITION

TOMLINSON'S ADDITION

JAMIESON AND GAULT 2ND ADDITION R.O.D. 7C

-PAGE 8-

One Inch Equals Two Hundred Feet MILES FEET NOTE: This map was prepared for assessment use in accordance with the Wis. St. Stat. Chap. 70.09. All information contained herein is advisory only. Map accuracy is limited to the quality of data obtained from other Public Records. This map is not intended to be a substitute for an actual field survey. Public Land Survey Base is derived from U.S.G.S Topopgraphic maps unless otherwise noted. Other sources of the Land Base may be acula survey data. Base map data is from the April 1995 County Digital Orthophotos and/or U.S.G.S. 1:24,000 scale Topographic series. The user is responsible for the improper use of the data contained herein.


WEST POYNETTE ADDITION

R.O.D. 7B & 8A

TAX PARCEL MAP Replaced 2009 N

TOWN 11 NORTH RANGE 9 EAST



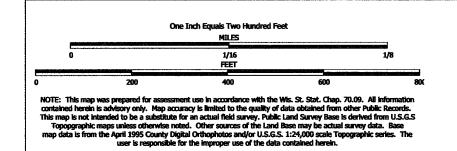


Created by The Columbia County Land Information Office -GIS Section. VMB and KMA  $\,$  Feb 2006  $\,$ 

VILLAGE of POYNETTE

TAX PARCEL MAP

TOWN 11 NORTH RANGE 9 EAST COLUMBIA COUNTY, WISCONSIN

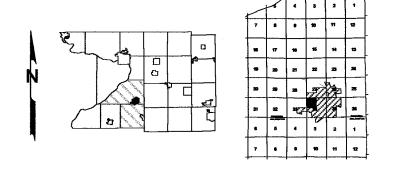




OTE: This map was prepared for assessment use in accordance with the Wis. St. Stat. Chap. 70.09. All information ontained herein is advisory only. Map accuracy is limited to the quality of data obtained from other Public Records. his map is not intended to be a substitute for an actual field survey. Public Land Survey Base is derived from U.S.G.S. Topopgraphic maps unless otherwise noted. Other sources of the Land Base may be actual survey data. Base map data is from the April 1995 County Digital Orthophotos and/or U.S.G.S. 1:24,000 scale Topographic series. The user is responsible for the improper use of the data contained herein.

Created by The Columbia County Land Information Office -GIS Section. VMB and KMA May 2001


TAX PARCEL MAP

## VILLAGE of POYNETTE

TOWN 11 NORTH RANGE 9 EAST COLUMBIA COUNTY, WISCONSIN

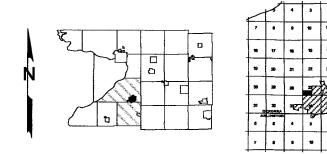

Replaced 2009

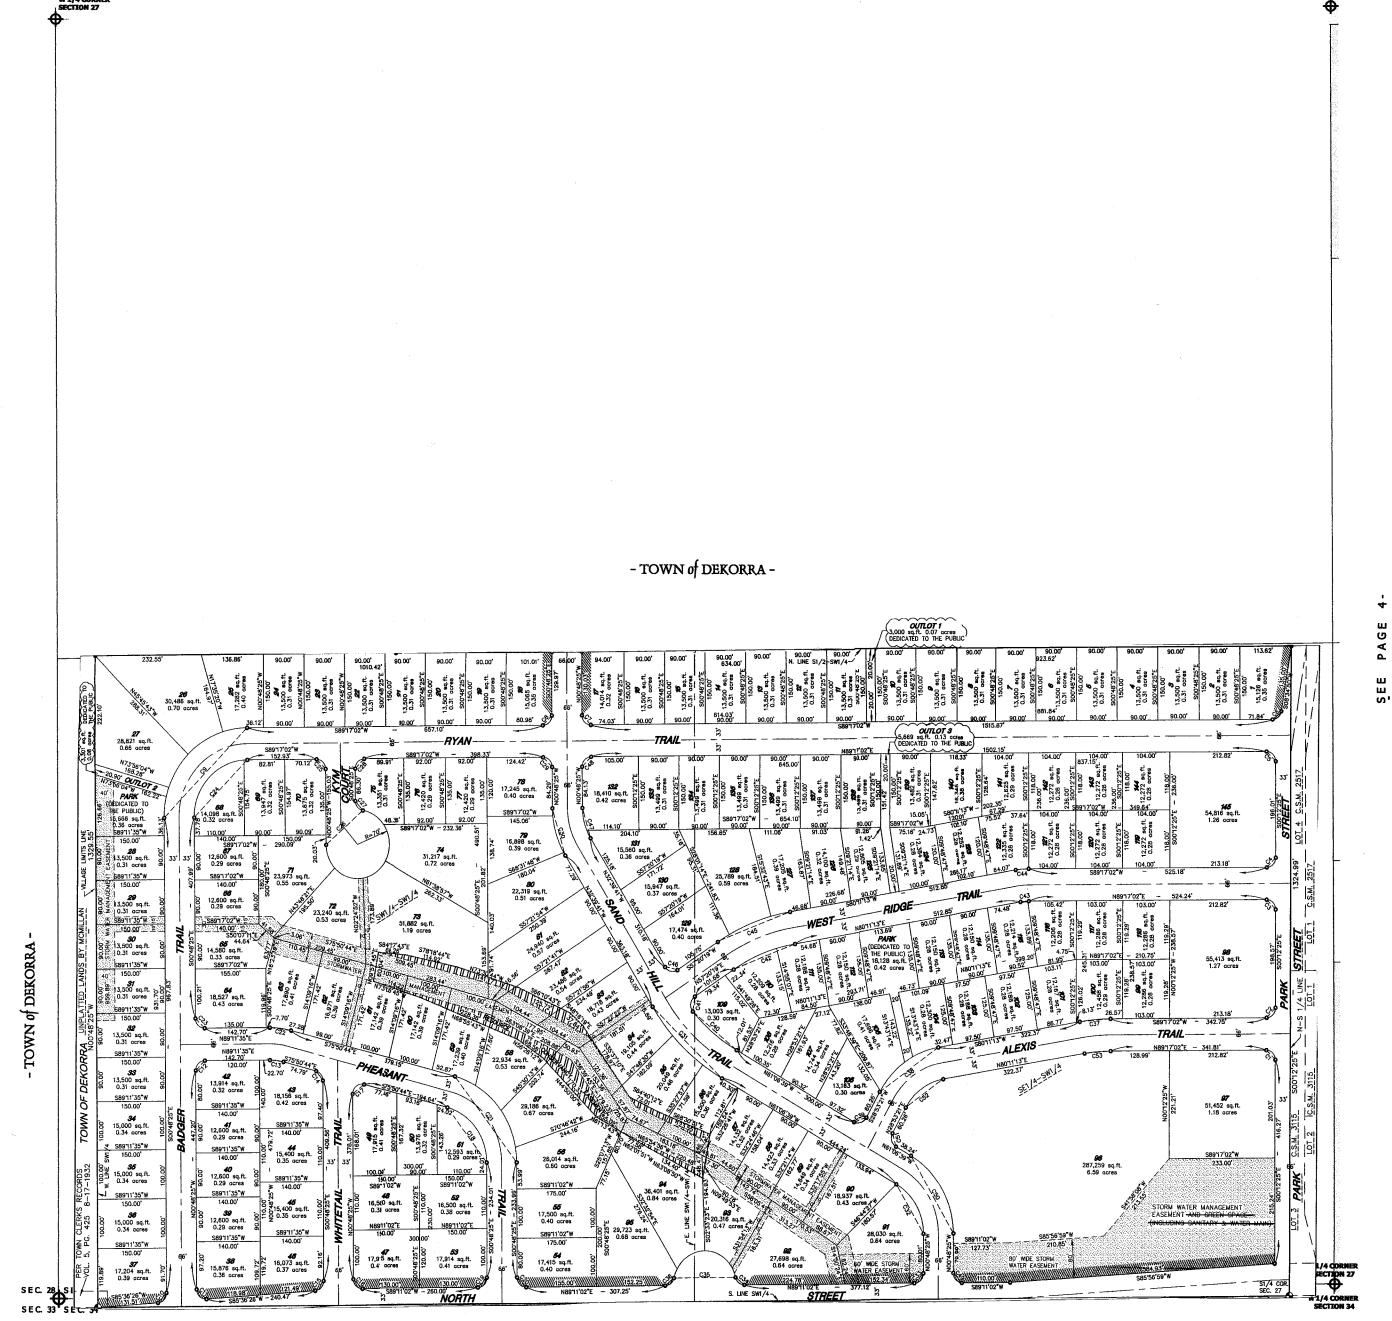

One Inch Equals Two Hundred Feet

MILES

0 1/16 1/8

FEET

0 200 400 600 800


NOTE: This map was prepared for assessment use in accordance with the Wis. St. Stat. Chap. 70.09. All information contained herein is advisory only. Map accuracy is limited to the quality of data obtained from other Public Records. This map is not intended to be a substitute for an actual field survey. Public Land Survey Base is derived from U.S.G.S Topographic maps unless otherwise noted. Other sources of the Land Base may be actual survey data. Base map data is from the April 1995 County Digital Orthophotos and/or U.S.G.S. 1:24,000 scale Topographic series. The user is responsible for the improper use of the data contained herein.

Created by The Columbia County Land Information Office -GIS Section. VMB and KMA Feb 2006

VILLAGE of POYNETTE

TAX PARCEL MAP

TOWN 11 NORTH RANGE 9 EAST COLUMBIA COUNTY, WISCONSIN

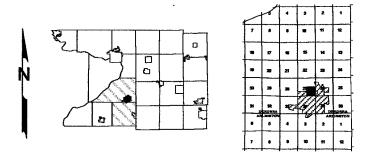




One Inch Equals Two Hundred Feet MILES 1/16 FEET NOTE: This map was prepared for assessment use in accordance with the Wis. St. Stat. Chap. 70.09. All information contained herein is advisory only. Map accuracy is limited to the quality of data obtained from other Public Records. This map is not intended to be a substitute for an actual field survey. Public Land Survey Base is derived from U.S.G.S Topopgraphic maps unless otherwise noted. Other sources of the Land Base may be actual survey data. Base map data is from the April 1995 County Digital Orthophotos and/or U.S.G.S. 1:24,000 scale Topographic series. The user is responsible for the improper use of the data contained herein.

Created by The Columbia County Land Information Office -GIS Section. VMB and KMA Feb 20067

TAX PARCEL MAP

TOWN 11 NORTH RANGE 9 EAST COLUMBIA COUNTY, WISCONSIN

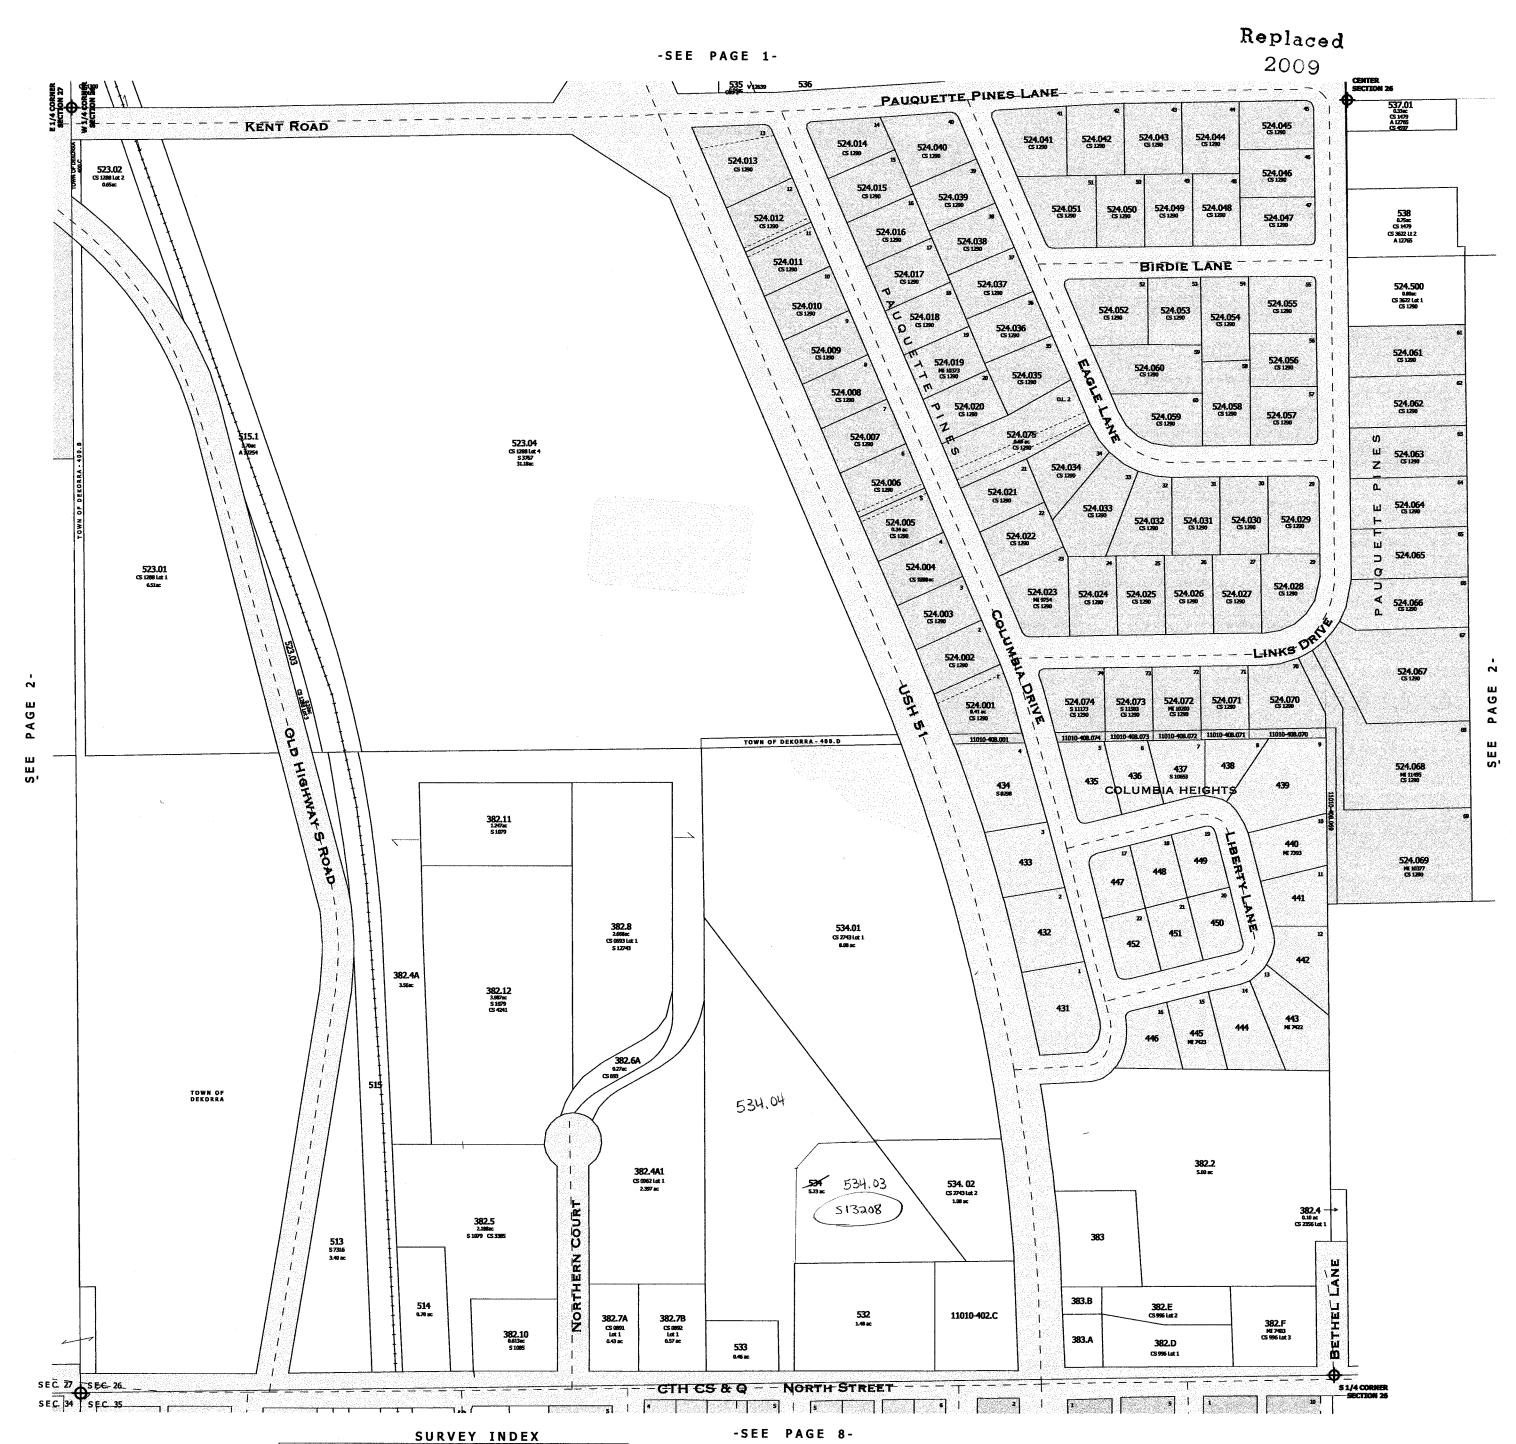

One Inch Equals Two Hundred Feet TAX PARCEL MAP 1/16 FEET NOTE: This map was prepared for assessment use in accordance with the Wis. St. Stat. Chap. 70.09. All information contained herein is advisory only. Map accuracy is limited to the quality of data obtained from other Public Records. This map is not intended to be a substitute for an actual field survey. Public Land Survey Base is derived from U.S.G.S Topopgraphic maps unless otherwise noted. Other sources of the Land Base may be actual survey data. Base map data is from the April 1995 County Digital Orthophotos and/or U.S.G.S. 1:24,000 scale Topographic series. The user is responsible for the improper use of the data contained herein. TOWN 11 NORTH RANGE 9 EAST COLUMBIA COUNTY, WISCONSIN The Columbia County Land Information Office -GIS Section. VMB and KMA Feb 2006 - TOWN of DEKORRA -11/56.11" / Replaced N. LINE SW1/4-NW1/4 TN. LINE SE1/4-NW1/4 LOT 1 C.S.M. 1479 2008 539.02 SE1 /4-NW1/4 4ac SW1/4-NW1/4 V Poynette Parcel # 542 539.01 543 PARCEL NO. 393.3 LANDS TO BE ANNEXED 2008 2008 539.04 1,119,760 SQ.FT.-25.71 ACRES 539.03 44.81 ac 43.451 ac PARCEL NO. 398.2 525.0Y TOWN OF DEKORRA 617.55 2008 525.05 8.12 ac 525.01 \_\_PAUQUETTE PINES LANE TOWN of DEKORRA --SEE PAGE 3-537,03 513149 43.79 ac 513469 -PAGE 2-- TOWN of DEKORRA -

USH BT

One Inch Equals Two Hundred Feet

MILES

0 1/16
FEET


0 200 400 600 800

NOTE: This map was prepared for assessment use in accordance with the Wis. St. Stat. Chap. 70.09. All information contained herein is advisory only. Map accuracy is limited to the quality of data obtained from other Public Records. This map is not intended to be a substitute for an actual field survey. Public Land Survey Base is derived from U.S.G.S Topographic maps unless otherwise noted. Other sources of the Land Base may be actual survey data. Base may be data is from the April 1995 County Digital Orthophotos and/or U.S.G.S. 1:24,000 scale Topographic series. The user is responsible for the improper use of the data contained herein.


Created by The Columbia County Land Information Office -GIS Section. VMB and KMA Feb 200F


VILLAGE of POYNETTE

TOWN 11 NORTH RANGE 9 EAST COLUMBIA COUNTY, WISCONSIN

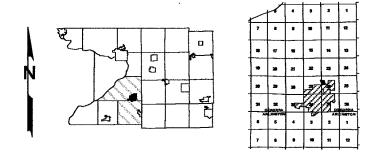

Replaced
2009

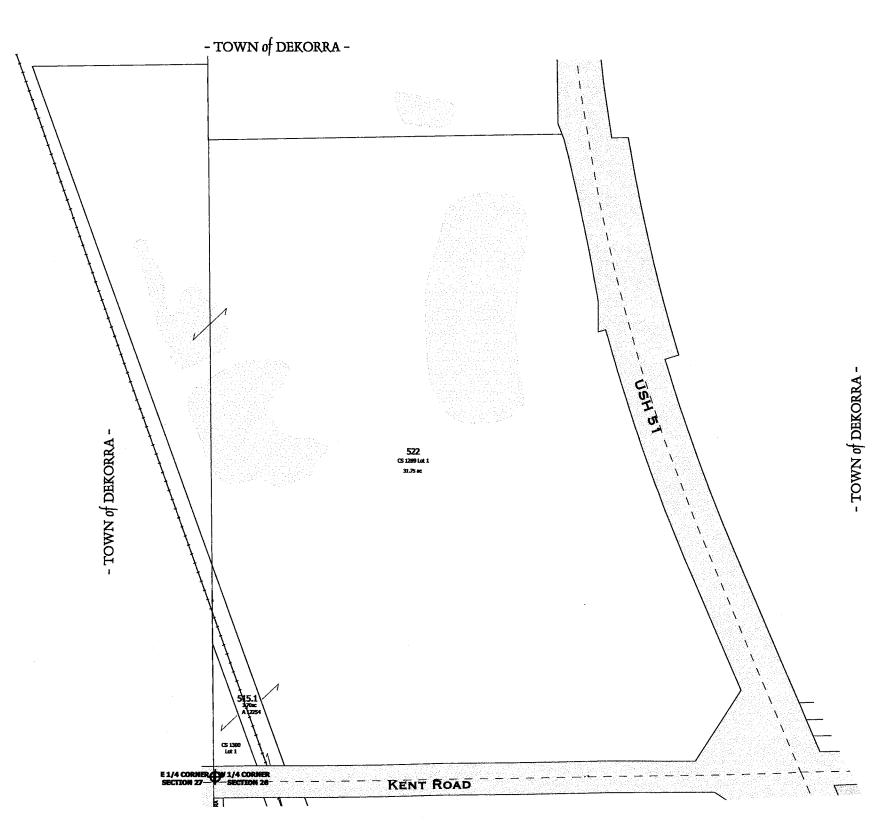


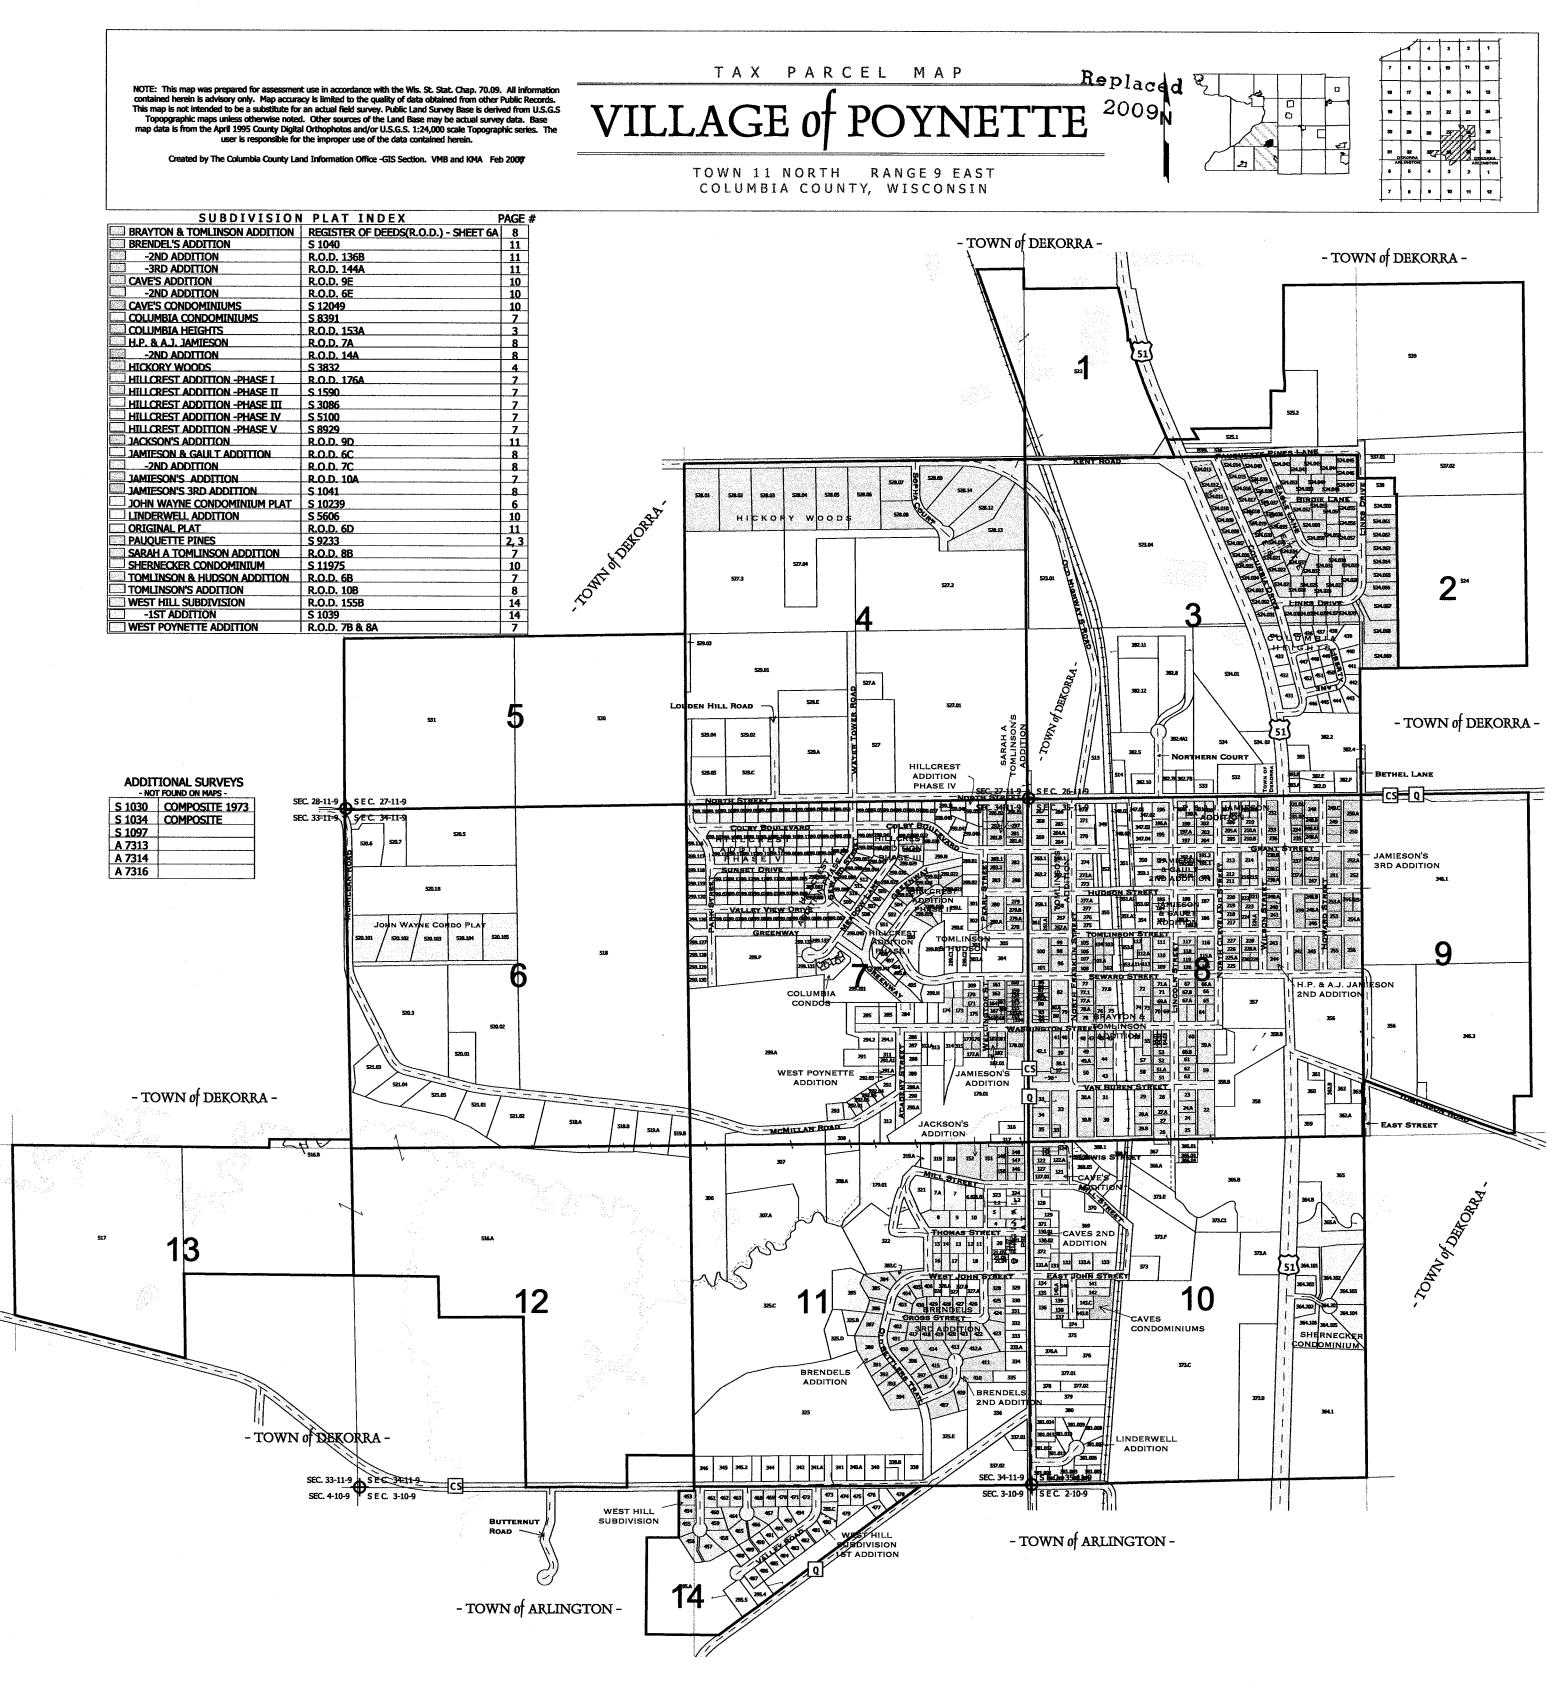


### VILLAGE OF POYNETTE T11N R9E

1 inch = 200 feet 1:2,400


SEE VILLAGE OF POYNETTE - Page 08

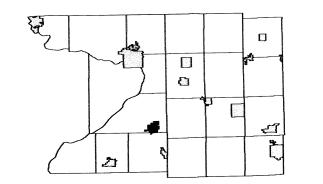

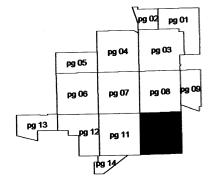




## VILLAGE OF POYNETTE T11N R9E

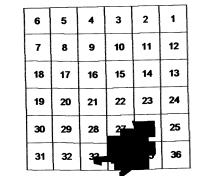


SEE TOWN OF DEKORRA

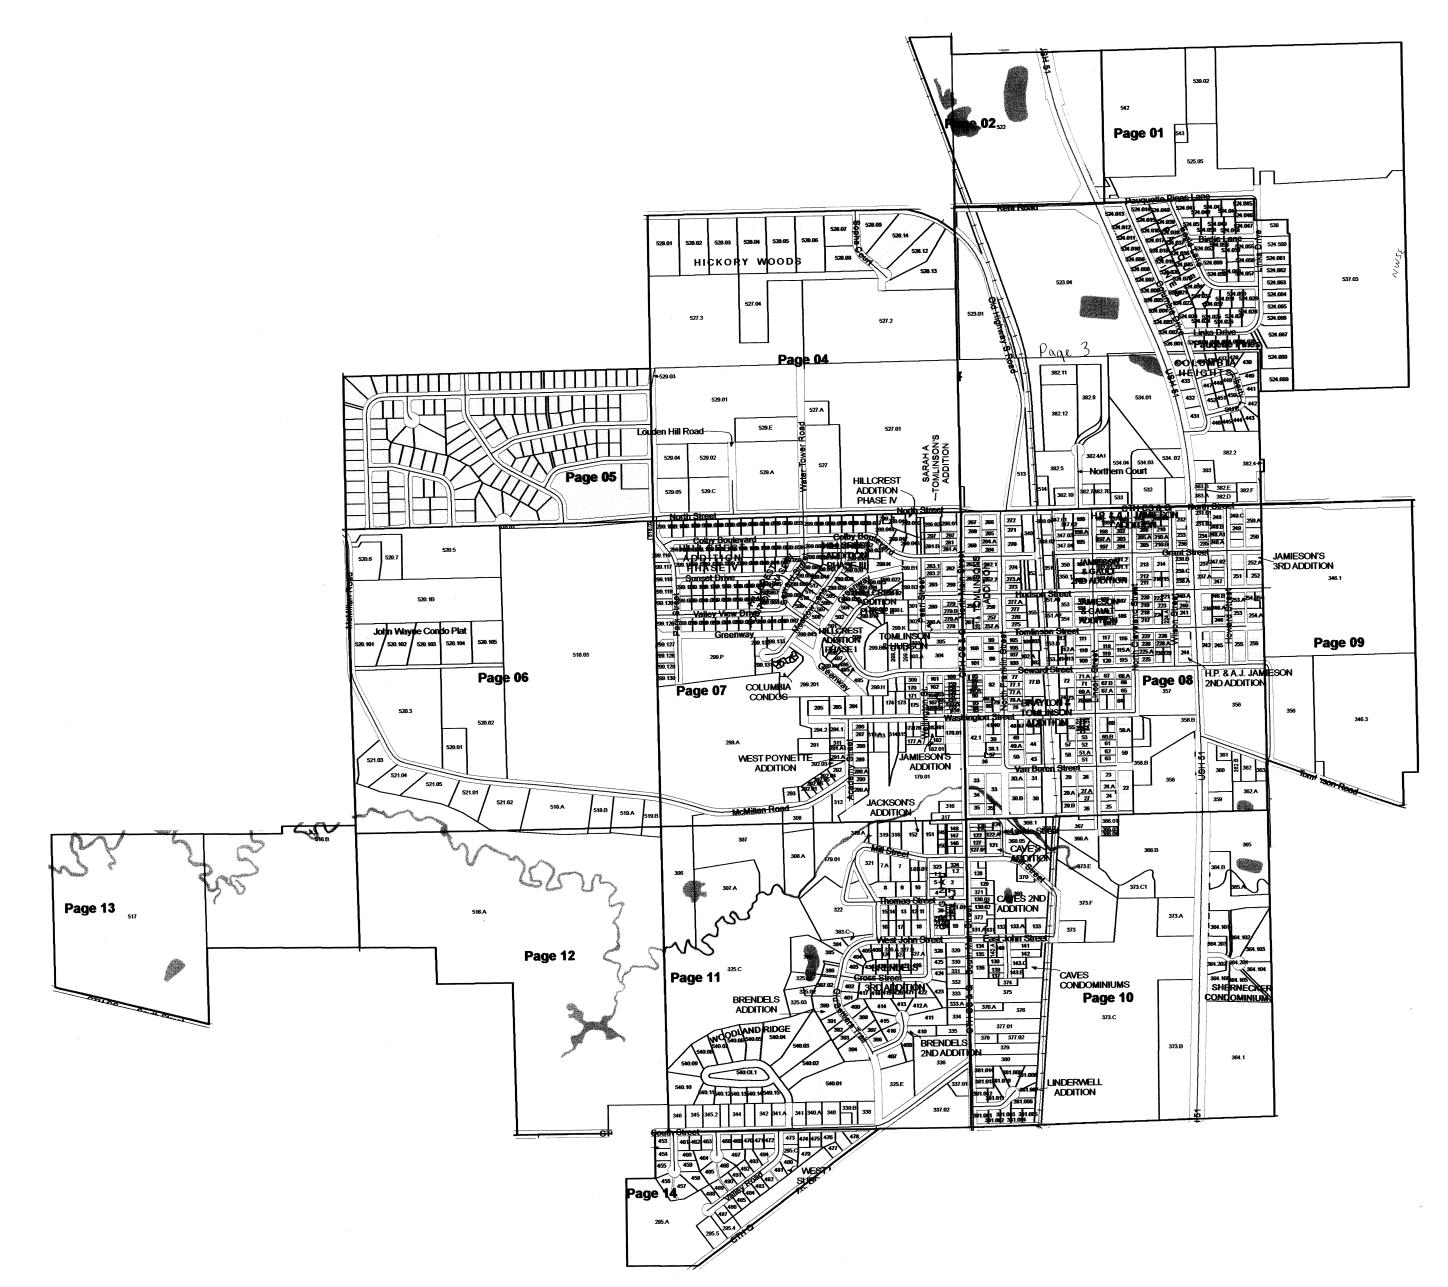


# VILLAGE OF POYNETTE T11N R9E

1 inch = 200 feet 1:2,400

SEE VILLAGE OF POYNETTE - Page 03

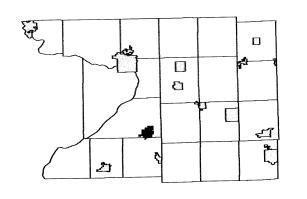

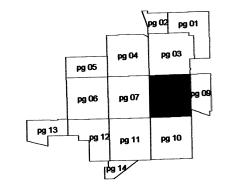




### VILLAGE OF POYNETTE **T11N R9E**

1 inch = 200 feet 1:2,400

O 4

pg 05 pg 07 pg 08 pg 06 pg 13 pg 11

SEE TOWN OF DEKORRA

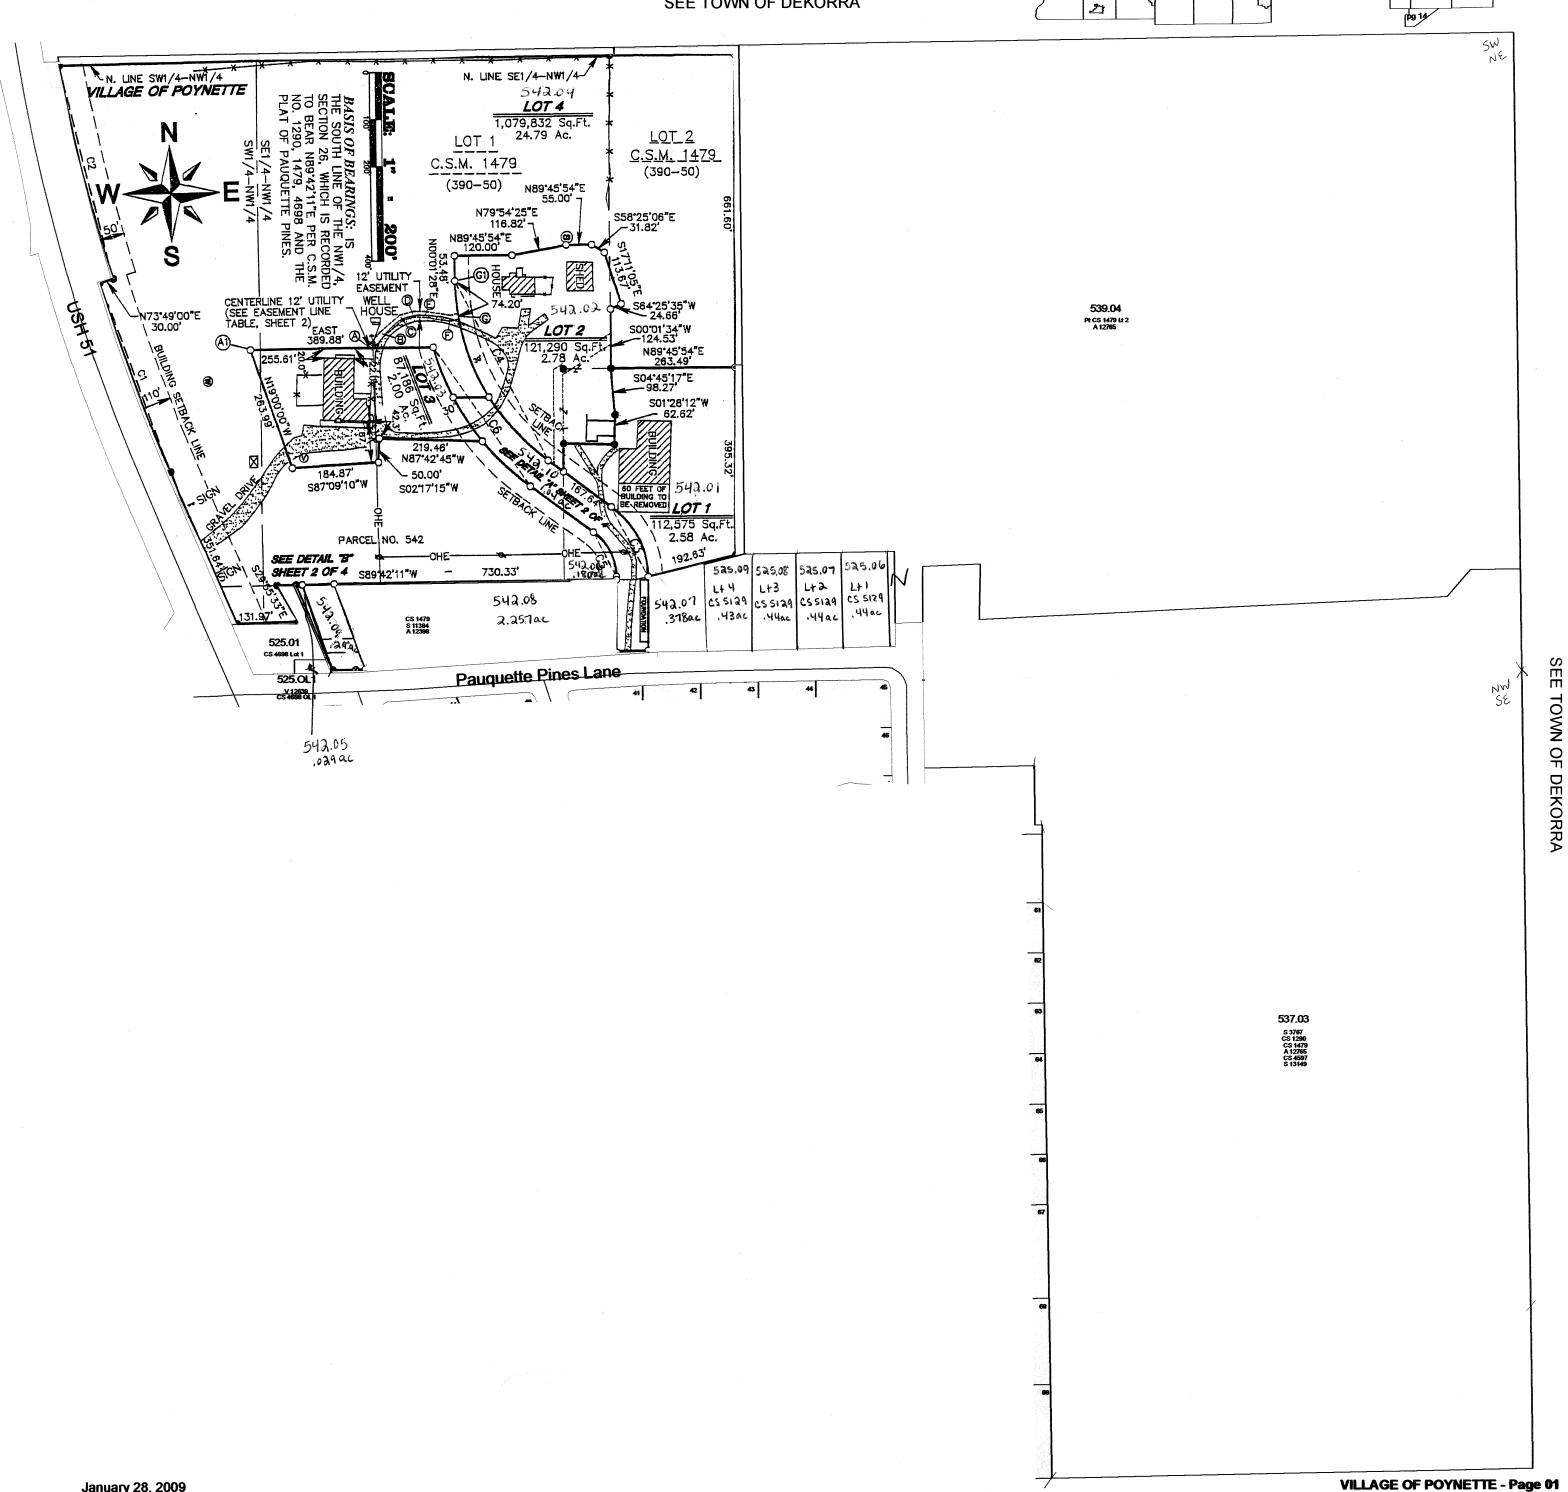

January 28, 2009 **Columbia County Land Information** 

SEE VILLAGE OF POYNETTE - Page 03


Replaced 2011

T11N R9E

## VILLAGE OF POYNETTE T11N R9E

6 5 4 3 2 1
7 8 9 10 11 12
18 17 16 15 14 13
19 20 21 22 23 24
30 29 28 27 25
31 32 32 36

SEE TOWN OF DEKORRA

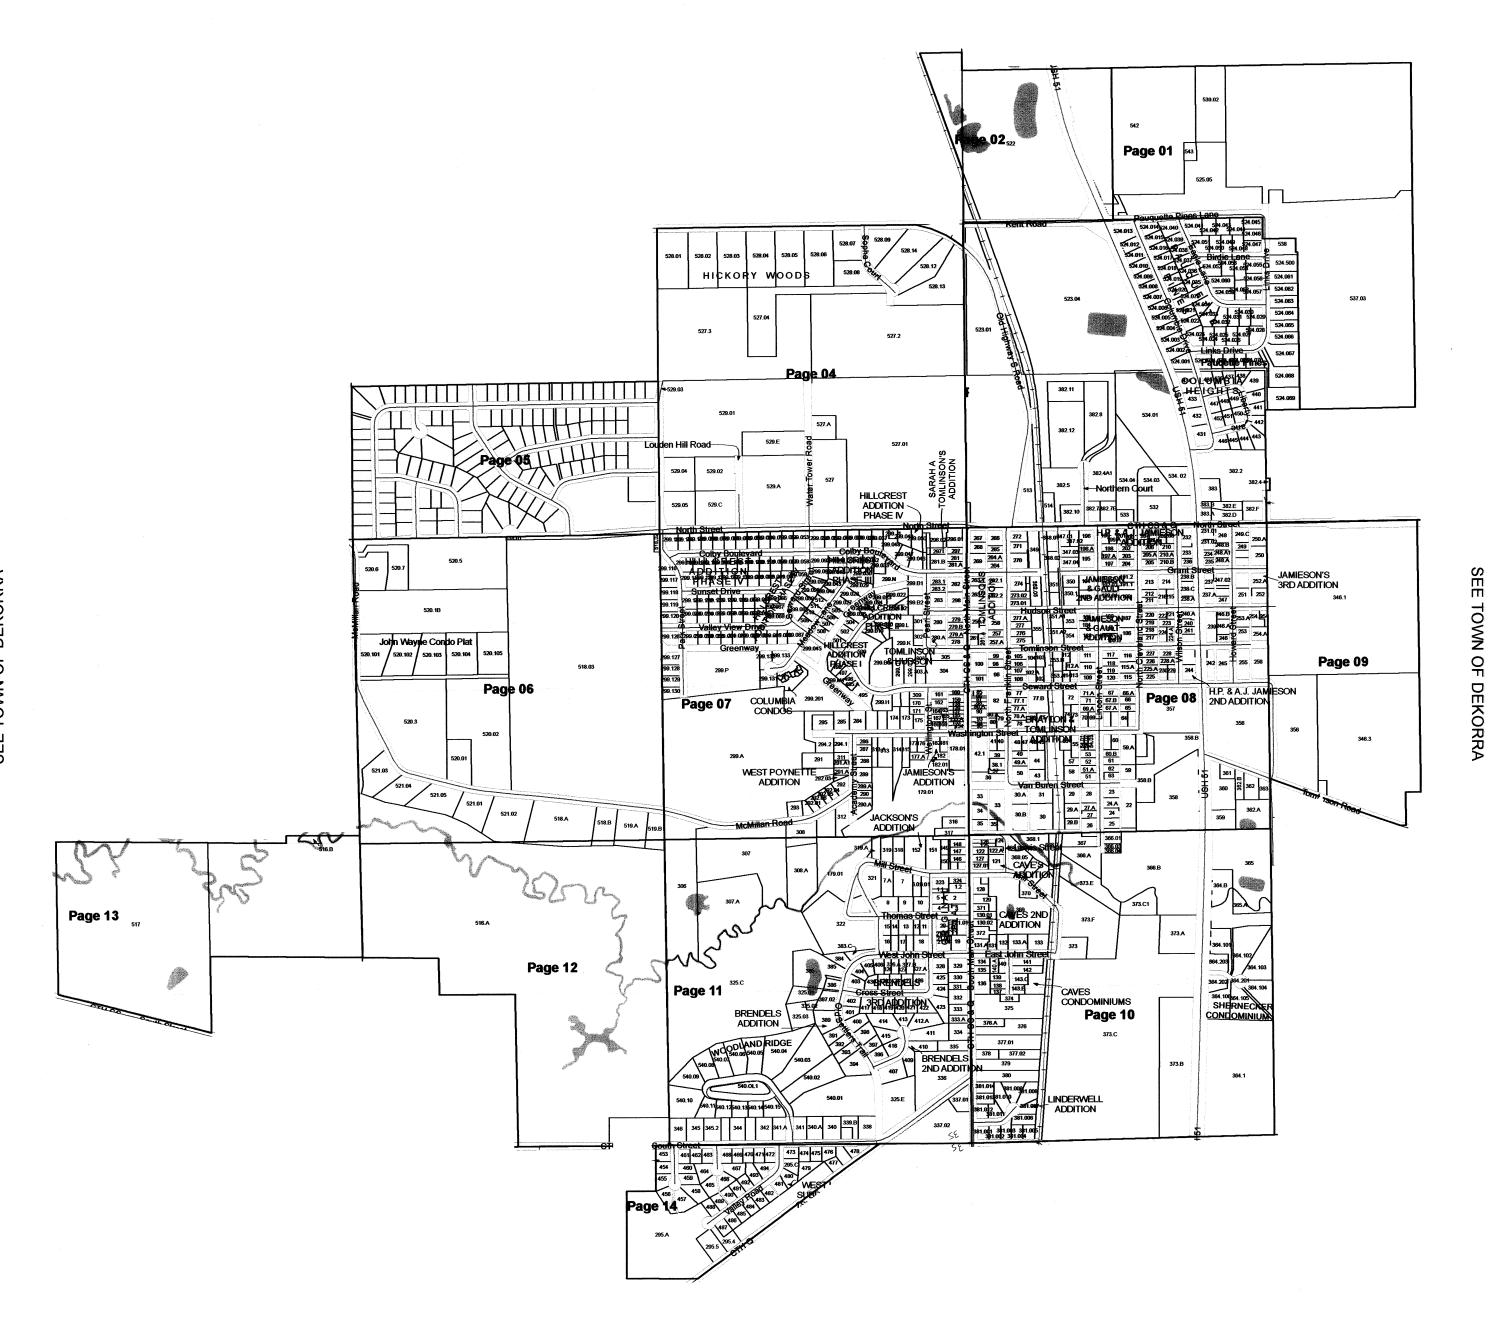

SEE TOWN OF DEKORRA


Replaced 2011


## VILLAGE OF POYNETTE

**T11N R9E** 

1 inch = 200 feet 1:2,400

SEE VILLAGE OF POYNETTE - Page 07

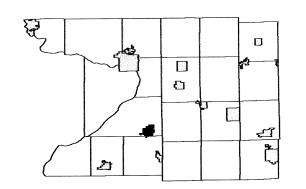

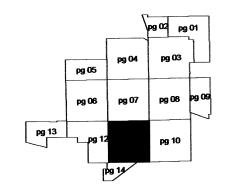





### VILLAGE OF POYNETTE **T11N R9E**

1 inch = 200 feet 1:2,400

SEE VILLAGE OF POYNETTE - Page 07

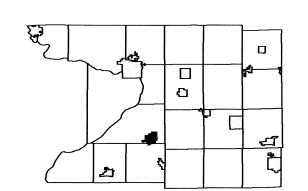

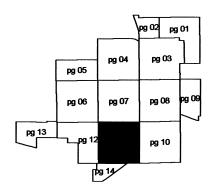

SEE VILLAGE OF POYNETTE - Page 10



CEE VILLAGE OF DOVMETTE DOGG 14

**VILLAGE OF POYNETTE - Page 11** 

**T11N R9E** 

SEE VILLAGE OF POYNETTE - Page 03

SEE VILLAGE OF POYNETTE - Page 10

SEE VILLAGE OF POYNETTE - Page 07

January 25, 2010

**Columbia County Land Information** 

Scannec 2012


VILLAGE OF POYNETTE - Page 08 T11N R9E


### VILLAGE OF POYNETTE

### **T11N R9E**

1 inch = 200 feet 1:2,400

SEE VILLAGE OF POYNETTE - Page 04

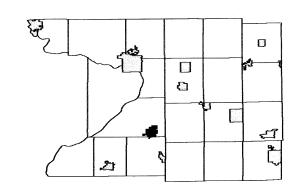

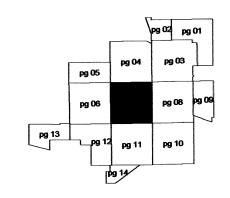






## VILLAGE OF POYNETTE T11N R9E

1 inch = 200 feet 1:2,400

SEE VILLAGE OF POYNETTE - Page 01

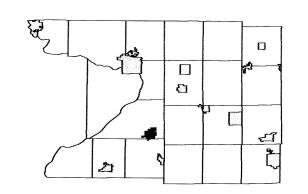

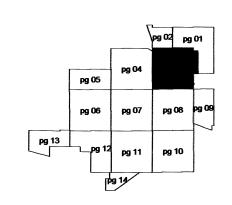


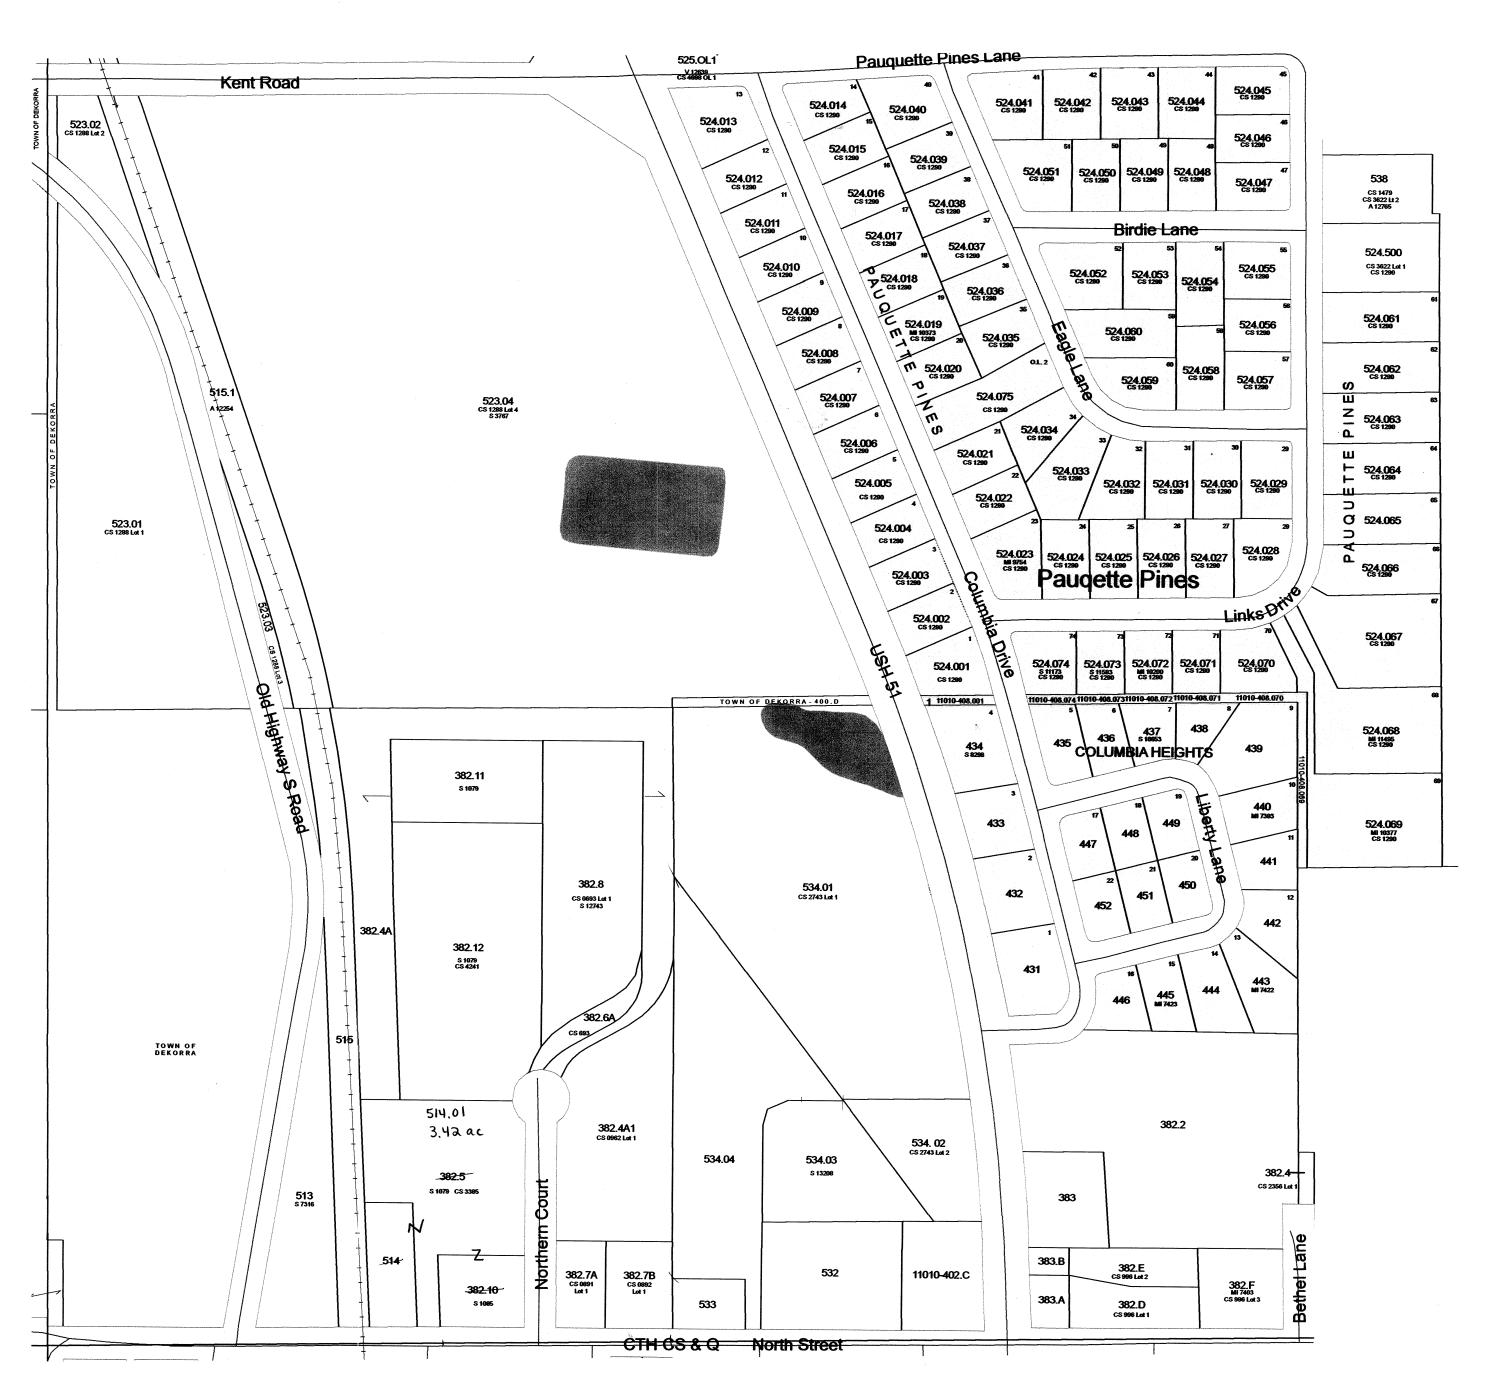

### VILLAGE OF POYNETTE T11N R9E

1 inch = 200 feet 1:2,400


pg 02
pg 04
pg 03
pg 06
pg 07
pg 08
pg 09
pg 13
pg 12
pg 11
pg 10

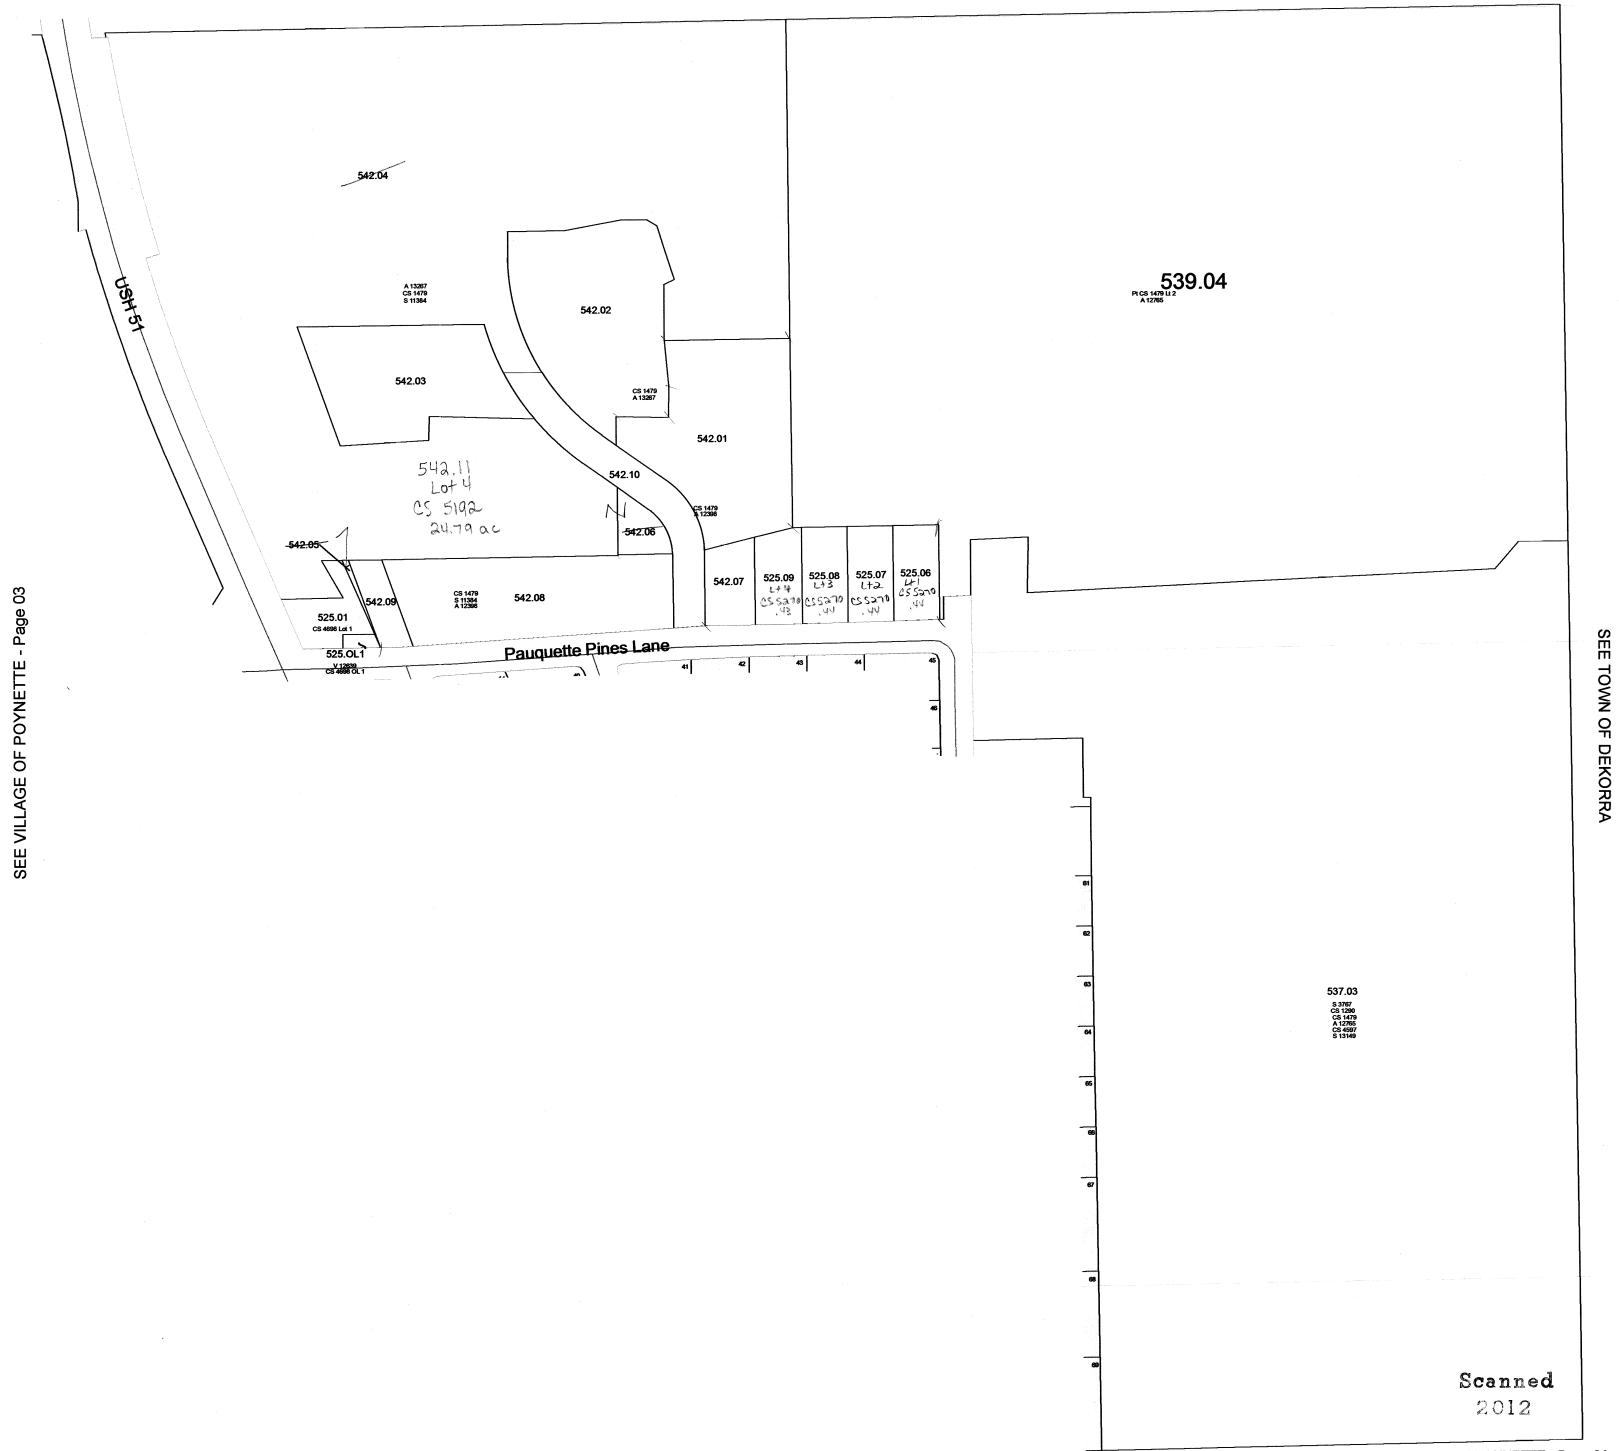

## VILLAGE OF POYNETTE T11N R9E

6 5 4 3 2 1
7 8 9 10 11 12
18 17 16 15 14 13
19 20 21 22 23 24
30 29 28 27 25
31 32 32 33


SEE TOWN OF DEKORRA

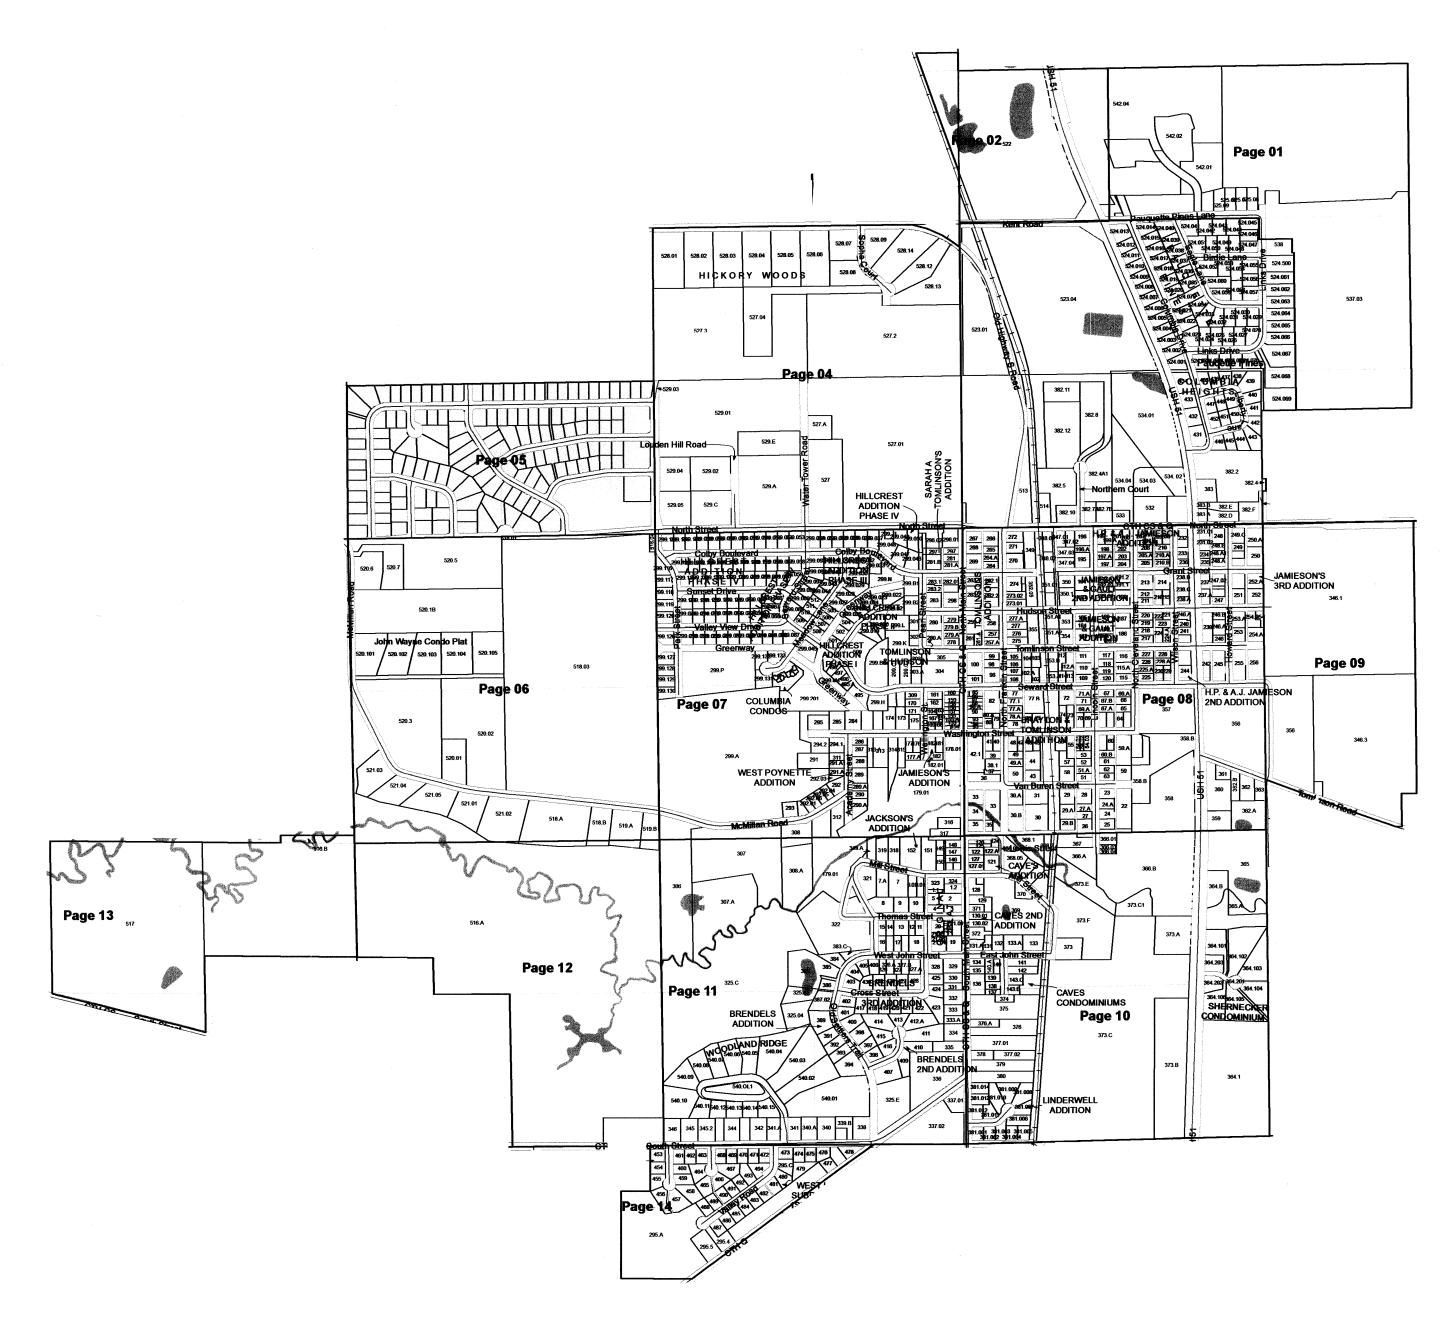


SEE TOWN OF DEKORRA

Scanned

## VILLAGE OF POYNETTE T11N R9E

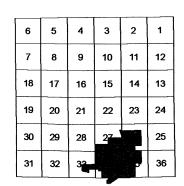

SEE TOWN OF DEKORRA

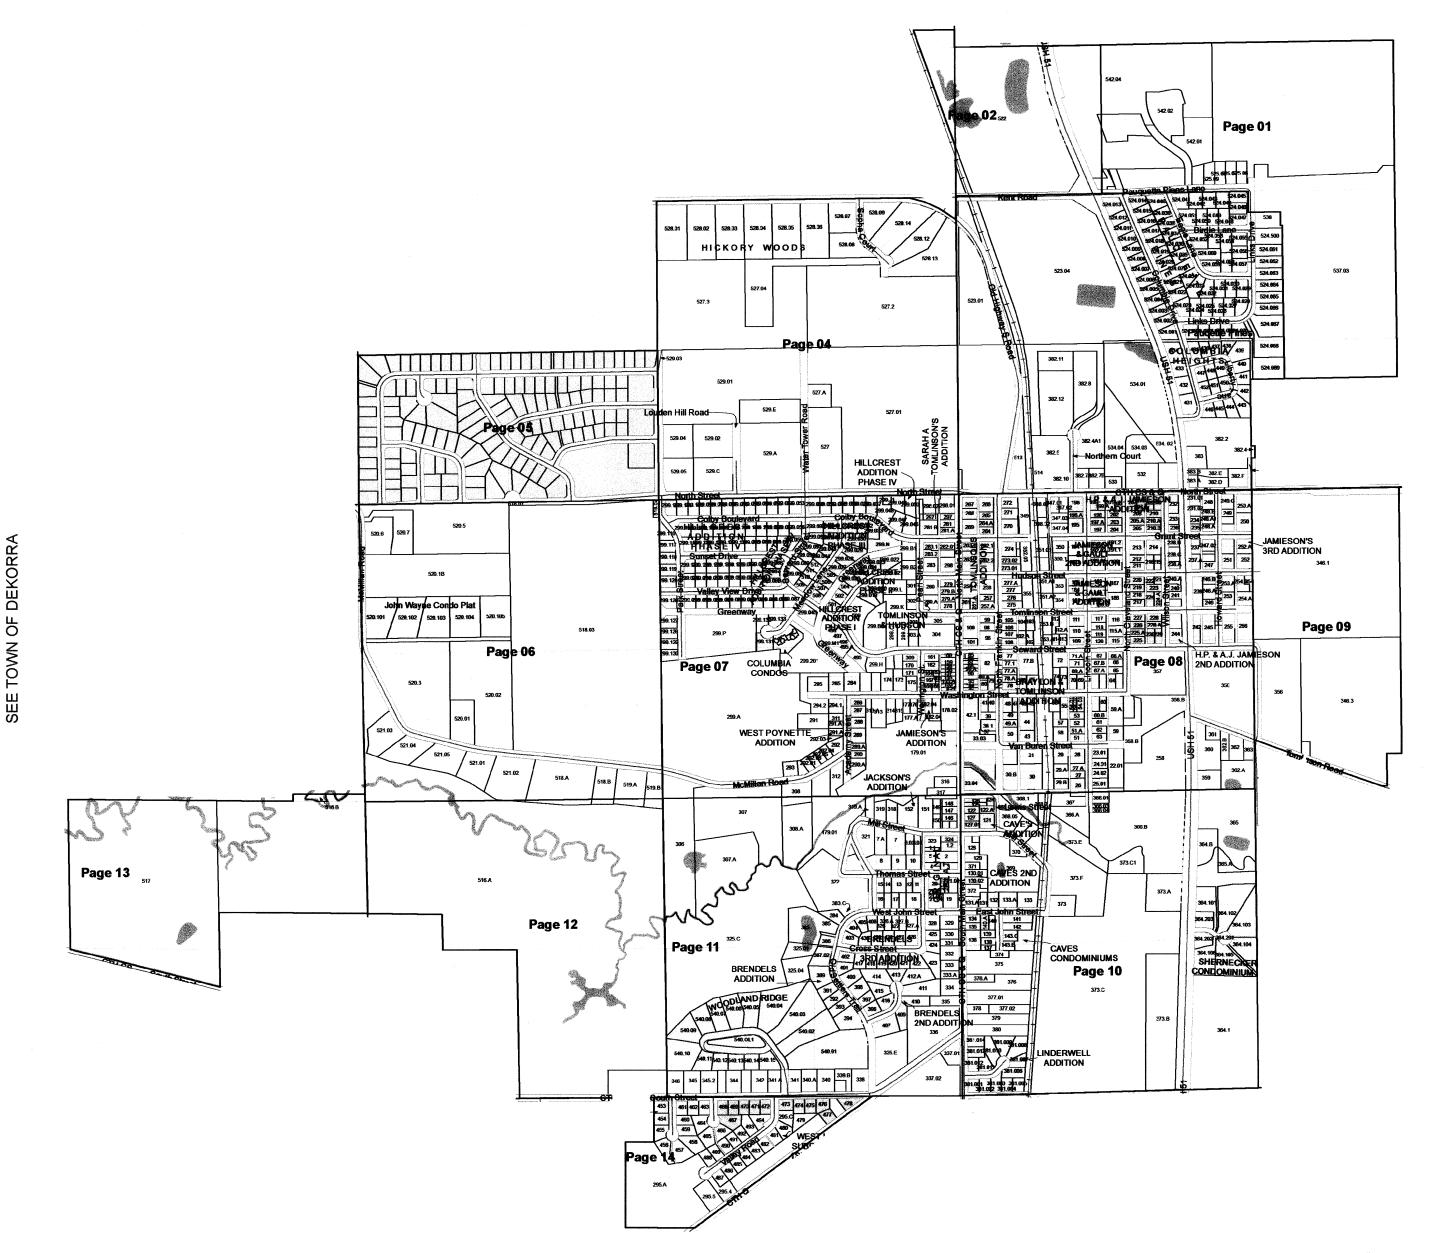



Scanned 2013

SEE TOWN OF DEKORRA

VILLAGE OF POYNETTE T11N R9E 1 inch = 200 feet 1:2,400

SEE VILLAGE OF POYNETTE - Page 04

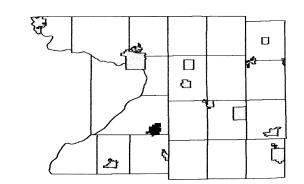

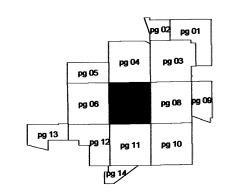



SEE VILLAGE OF POYNETTE - Page 06

January 28, 2009 **Columbia County Land Information** 


Scanned 2012


**VILLAGE OF POYNETTE - Page 07** 

**T11N R9E** 


### VILLAGE OF POYNETTE **T11N R9E**

1 inch = 200 feet 1:2,400

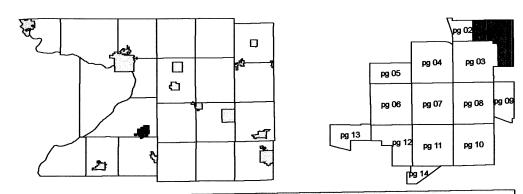


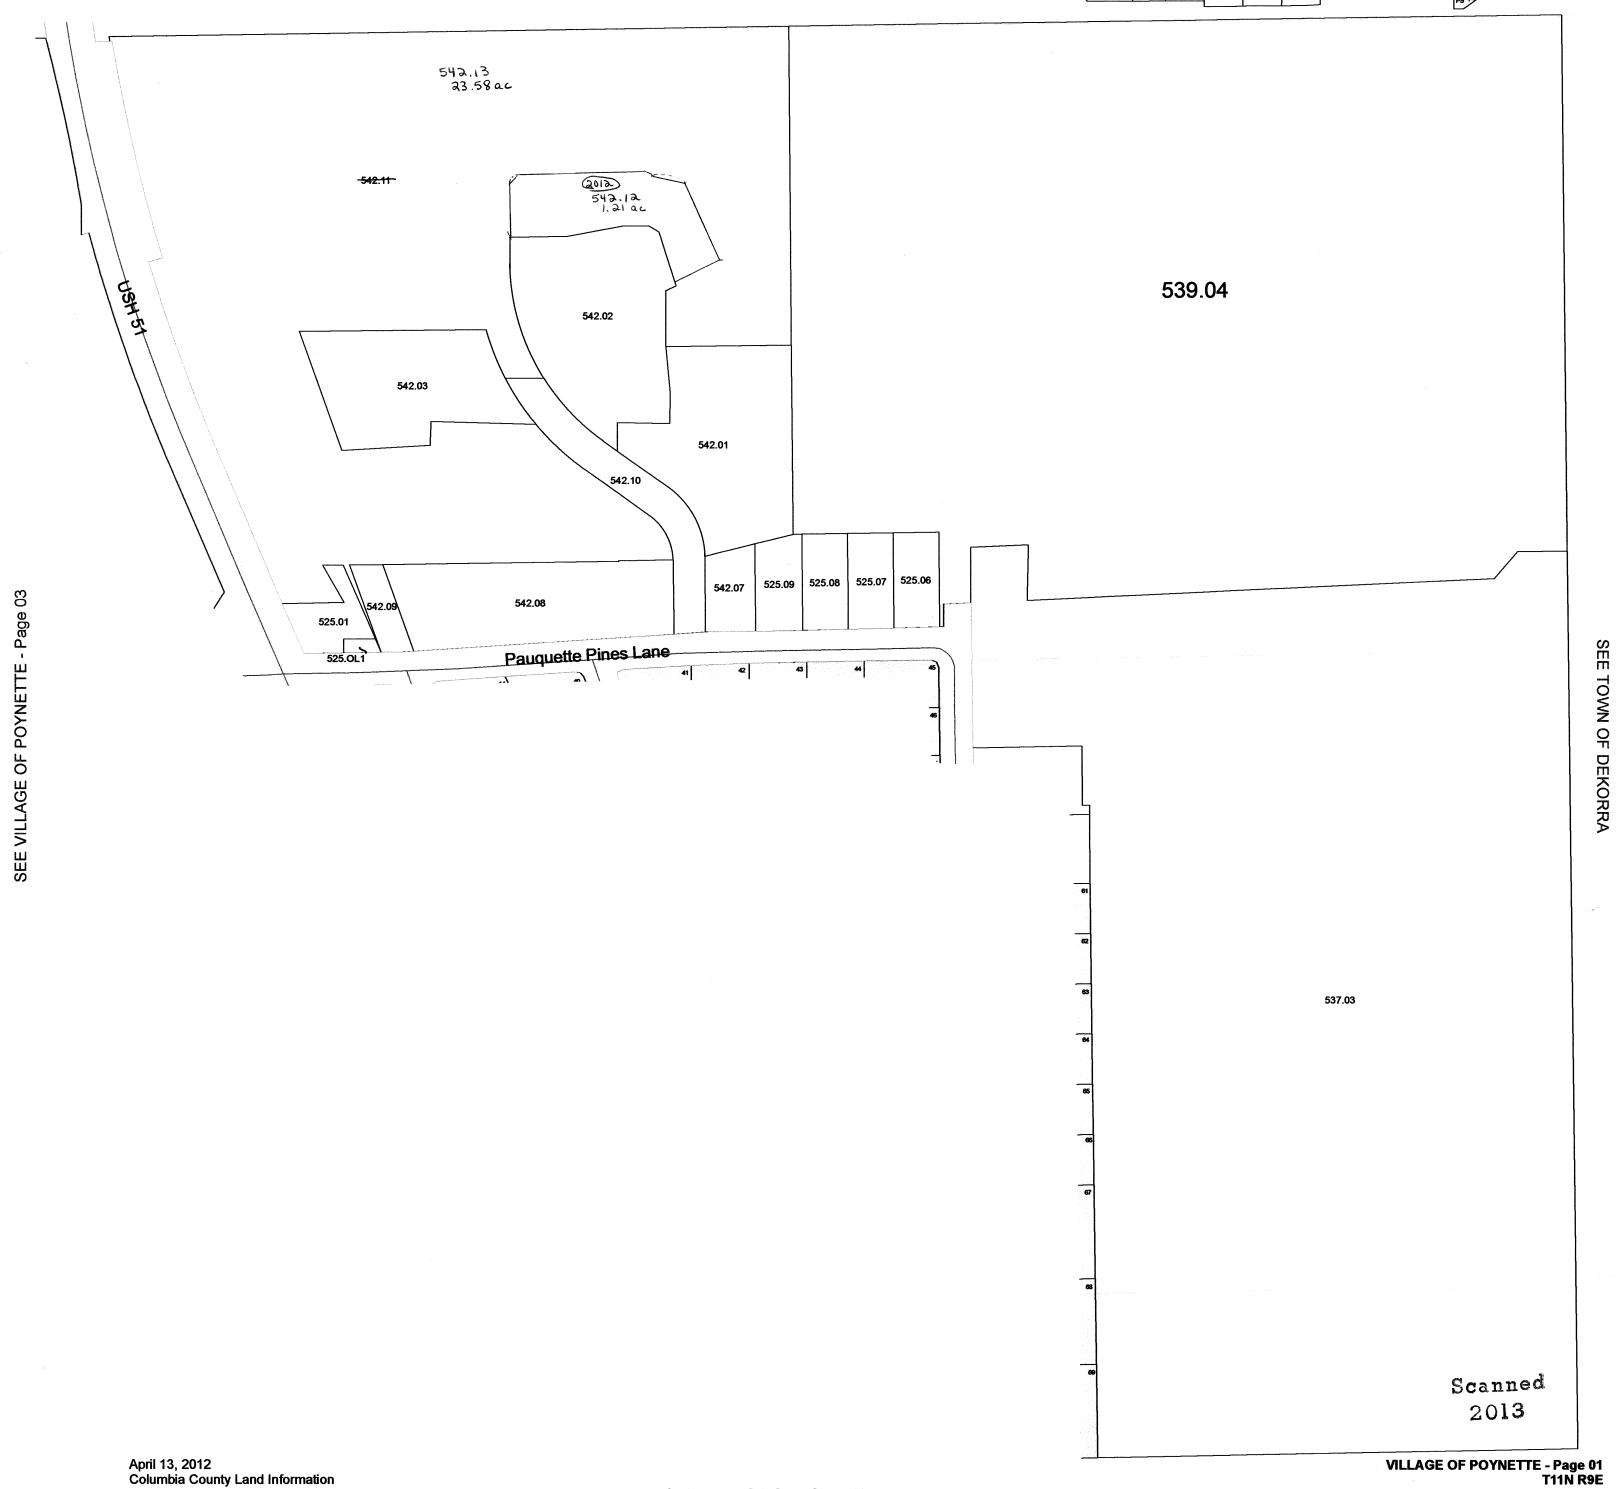

## VILLAGE OF POYNETTE T11N R9E

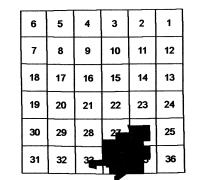


SEE TOWN OF DEKORRA

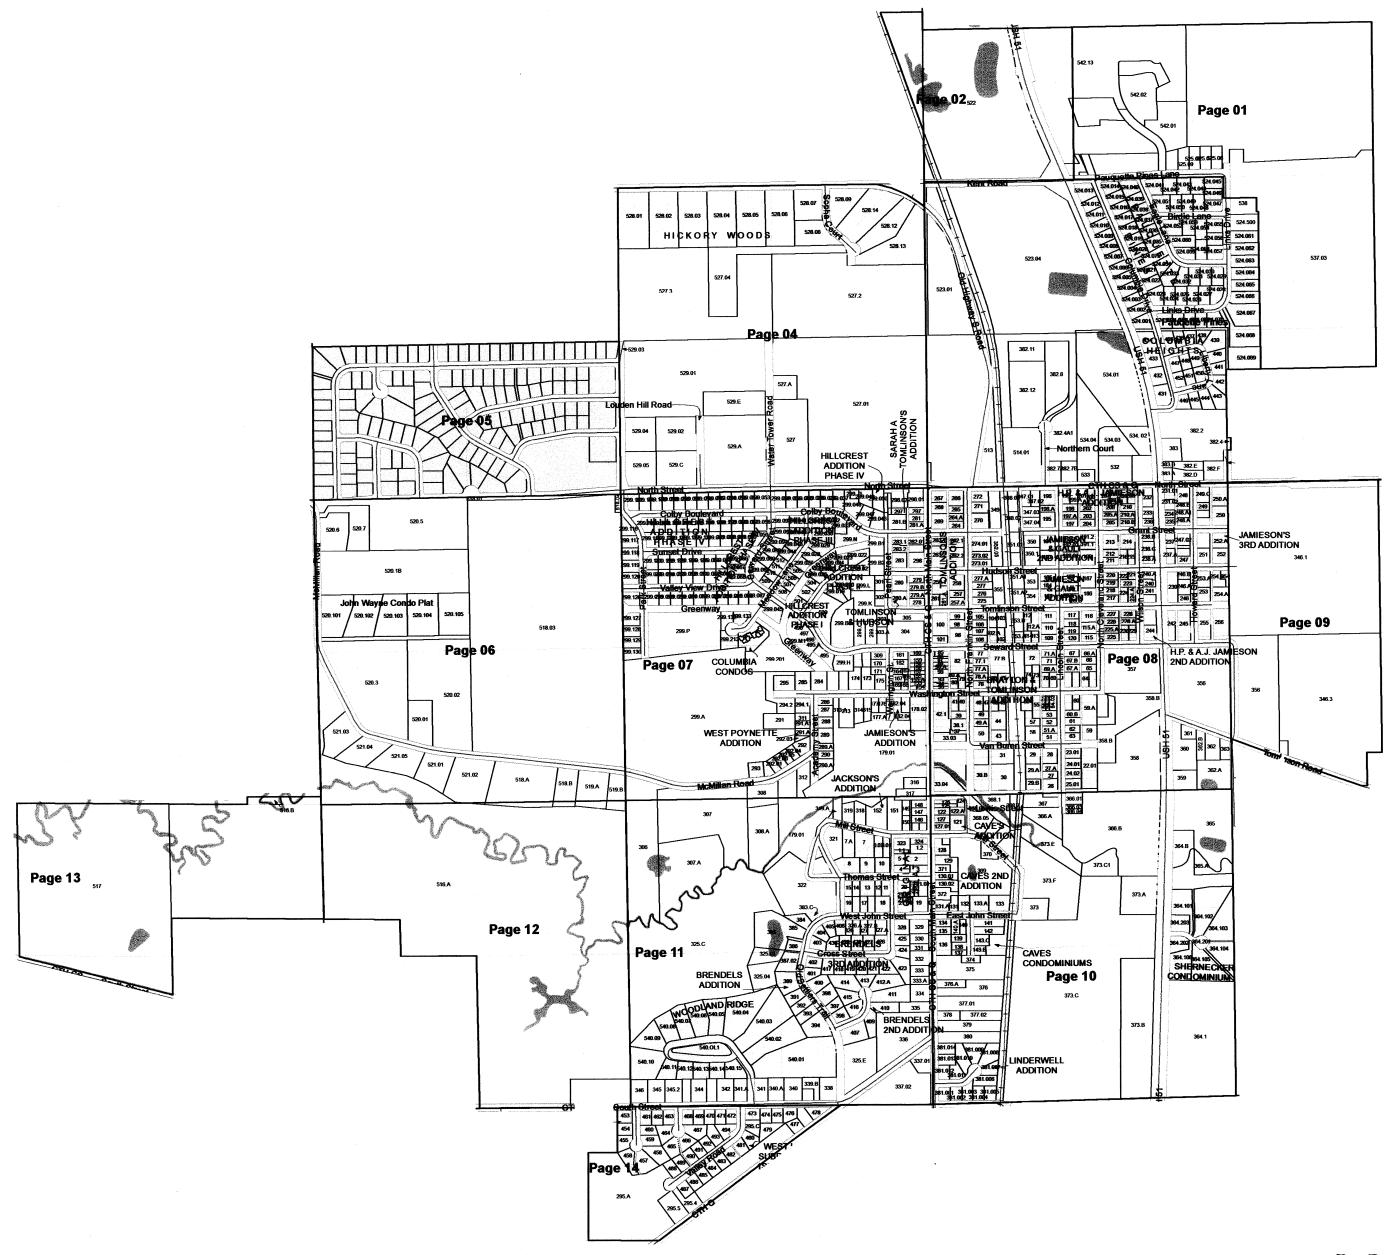


REPLACED 2014

## VILLAGE OF POYNETTE T11N R9E


1 inch = 200 feet 1:2,400

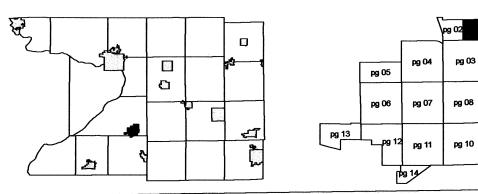


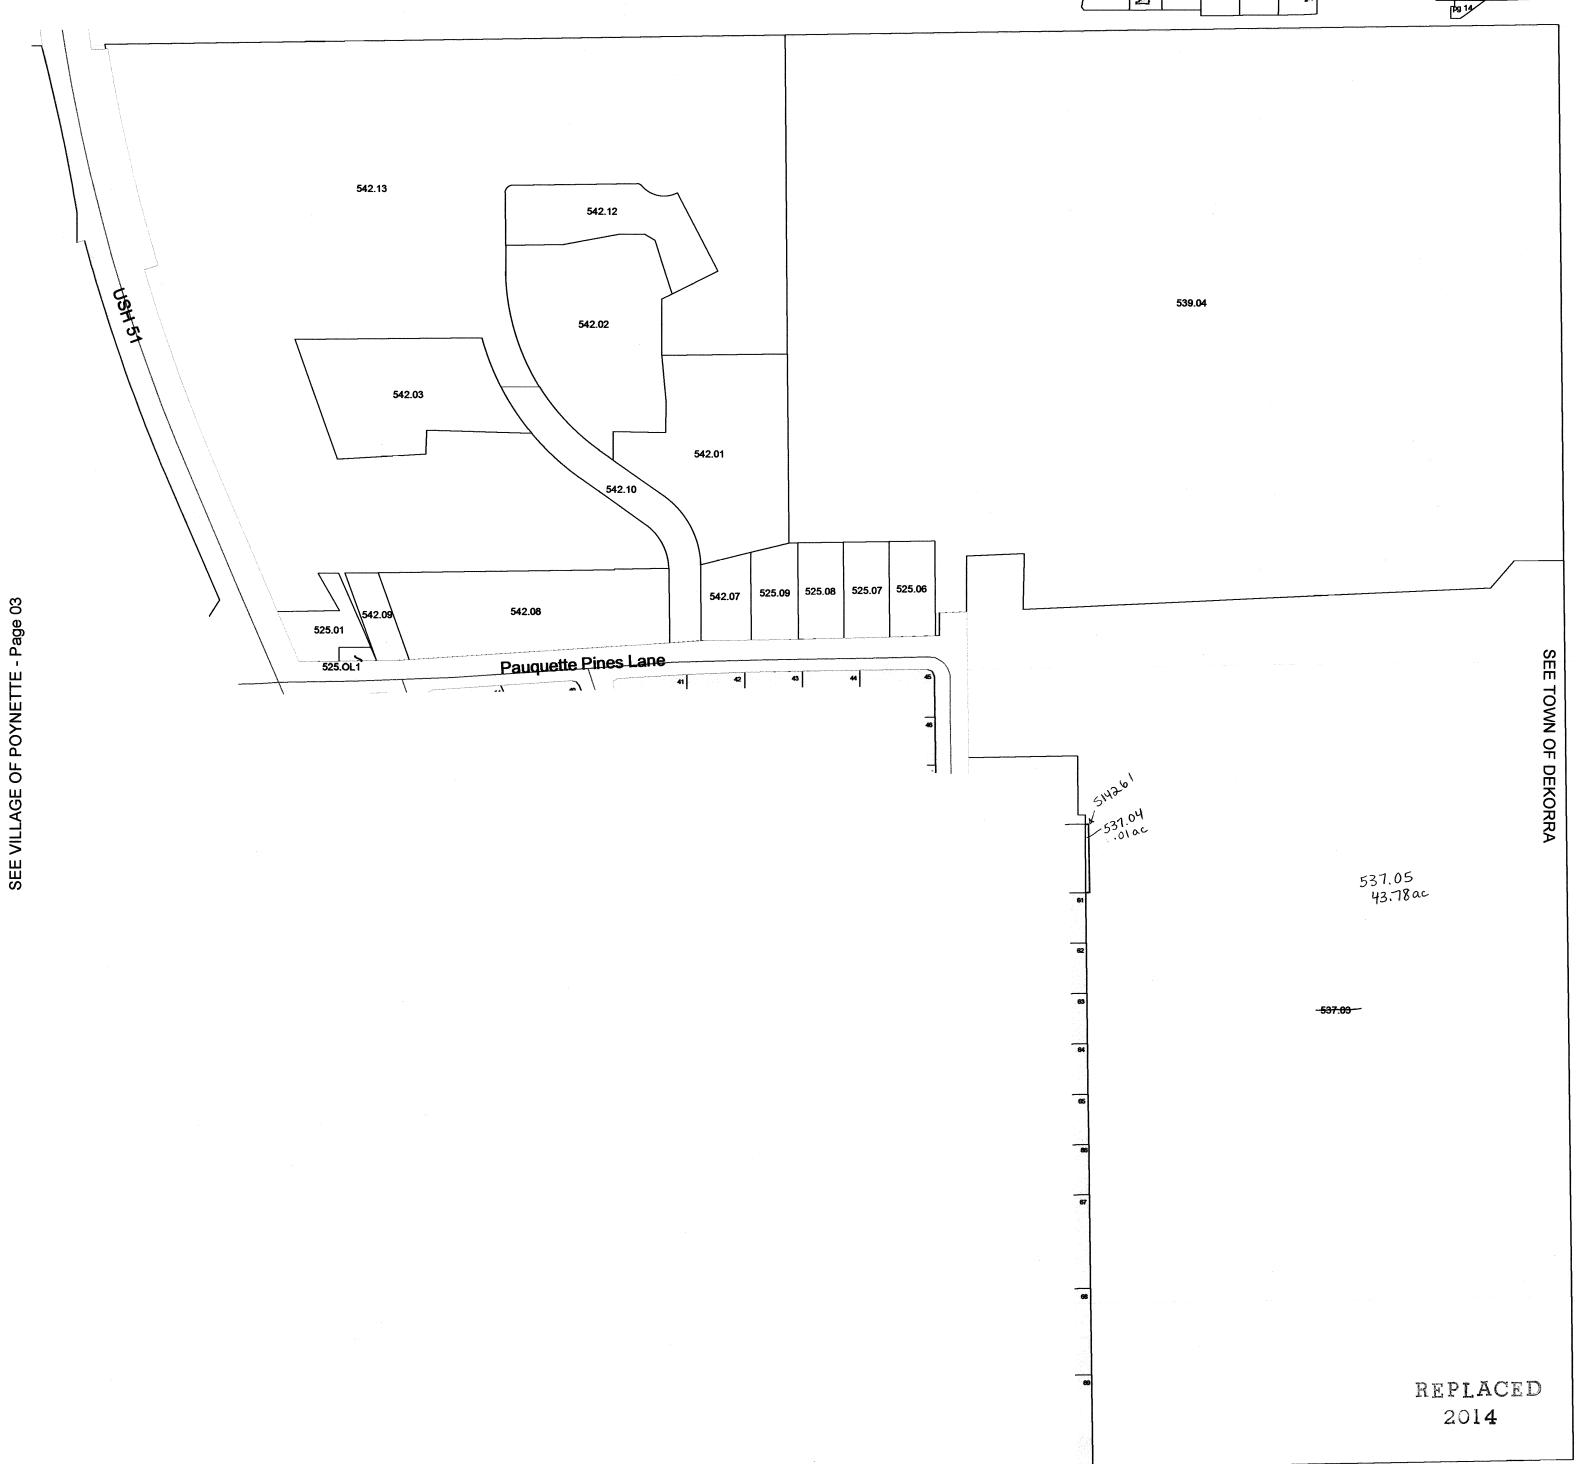

1 inch = 200 feet 1:2,400

SEE VILLAGE OF POYNETTE - Page 01

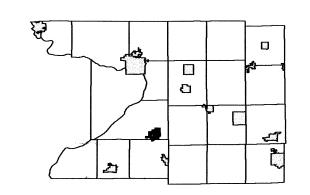

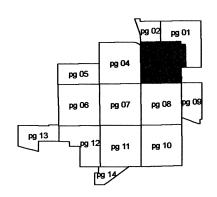



April 18, 2012 **Columbia County Land Information** 

SEE VILLAGE OF POYNETTE - Page 04

SEE VILLAGE OF POYNETTE - Page 08

VILLAGE OF POYNETTE - Page 03 T11N R9E

2014